



PLAN REVIEW APPROVAL STAMP

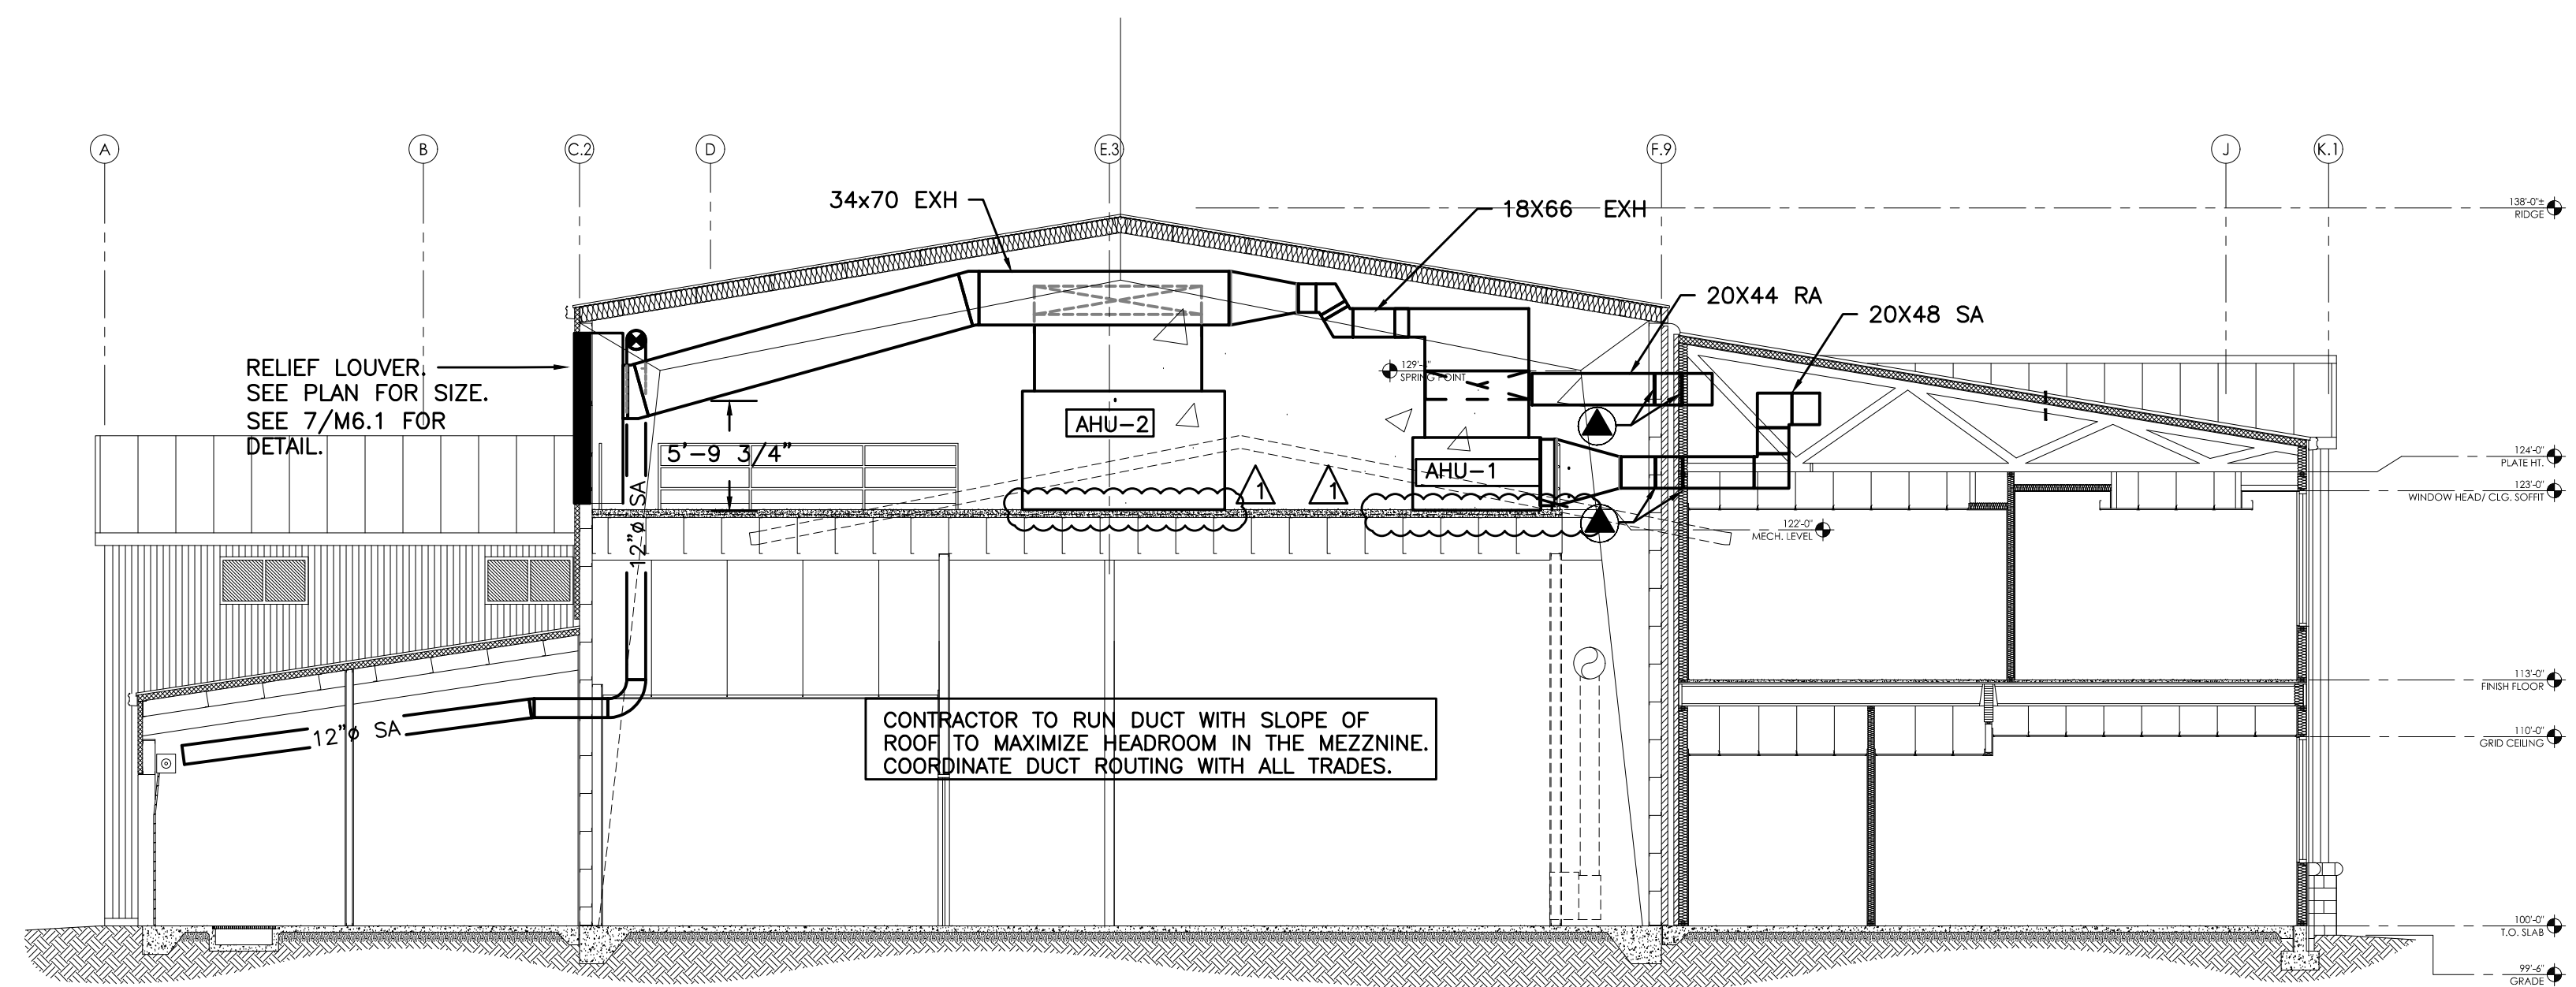


**1** MEZZ SECTION  
 M4.2 SCALE: 1/8"=1'-0"

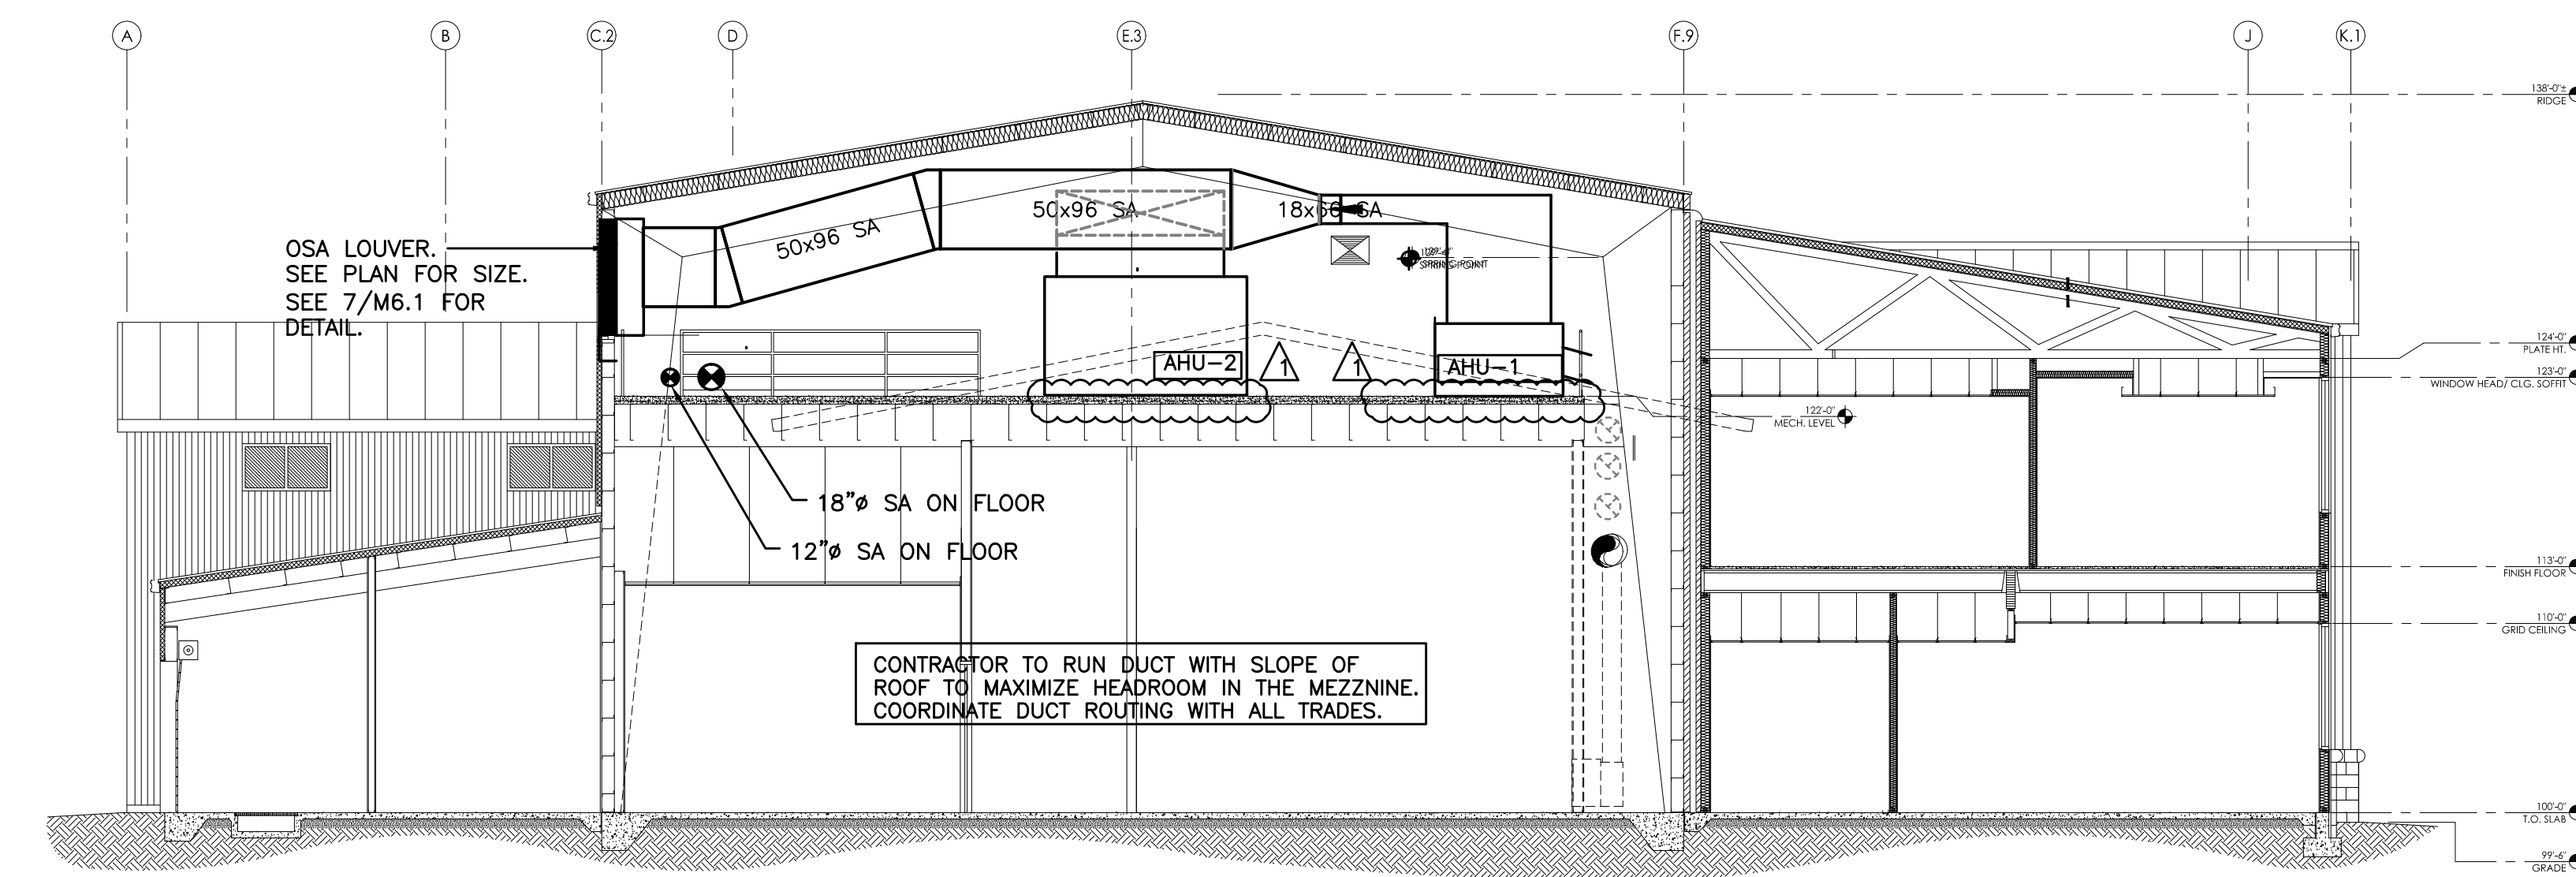

**2** MEZZ SECTION  
 M4.2 SCALE: 1/8"=1'-0"

**BEND RESEARCH, INC**  
 CORPORATE PLACE FACILITY - BUILDING EXPANSION NORTH

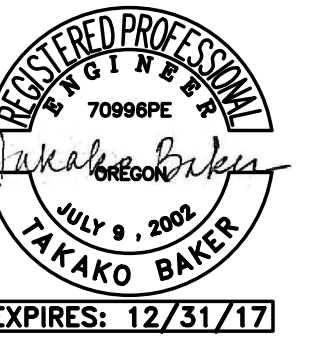

**BLAISE CACCIOLA**  
 ARCHITECT  
 1465 SW Knoll Avenue, Suite 250  
 Bend, OR 97702  
 Phone: 541.728.0375  
 www.BCA-Architect.com

DRAWN/ CHECKED: TB

ISSUES / REVISIONS:  
 BID SET 07/21/2017  
 PH 2 - GEN BLDG 07/28/2017  
 REV 1 09/13/2017

MECHANICAL SECTIONS

M4.2