

A

B

C

D

E

F


G

H

J

K

City Of Bend Approval Stamp:

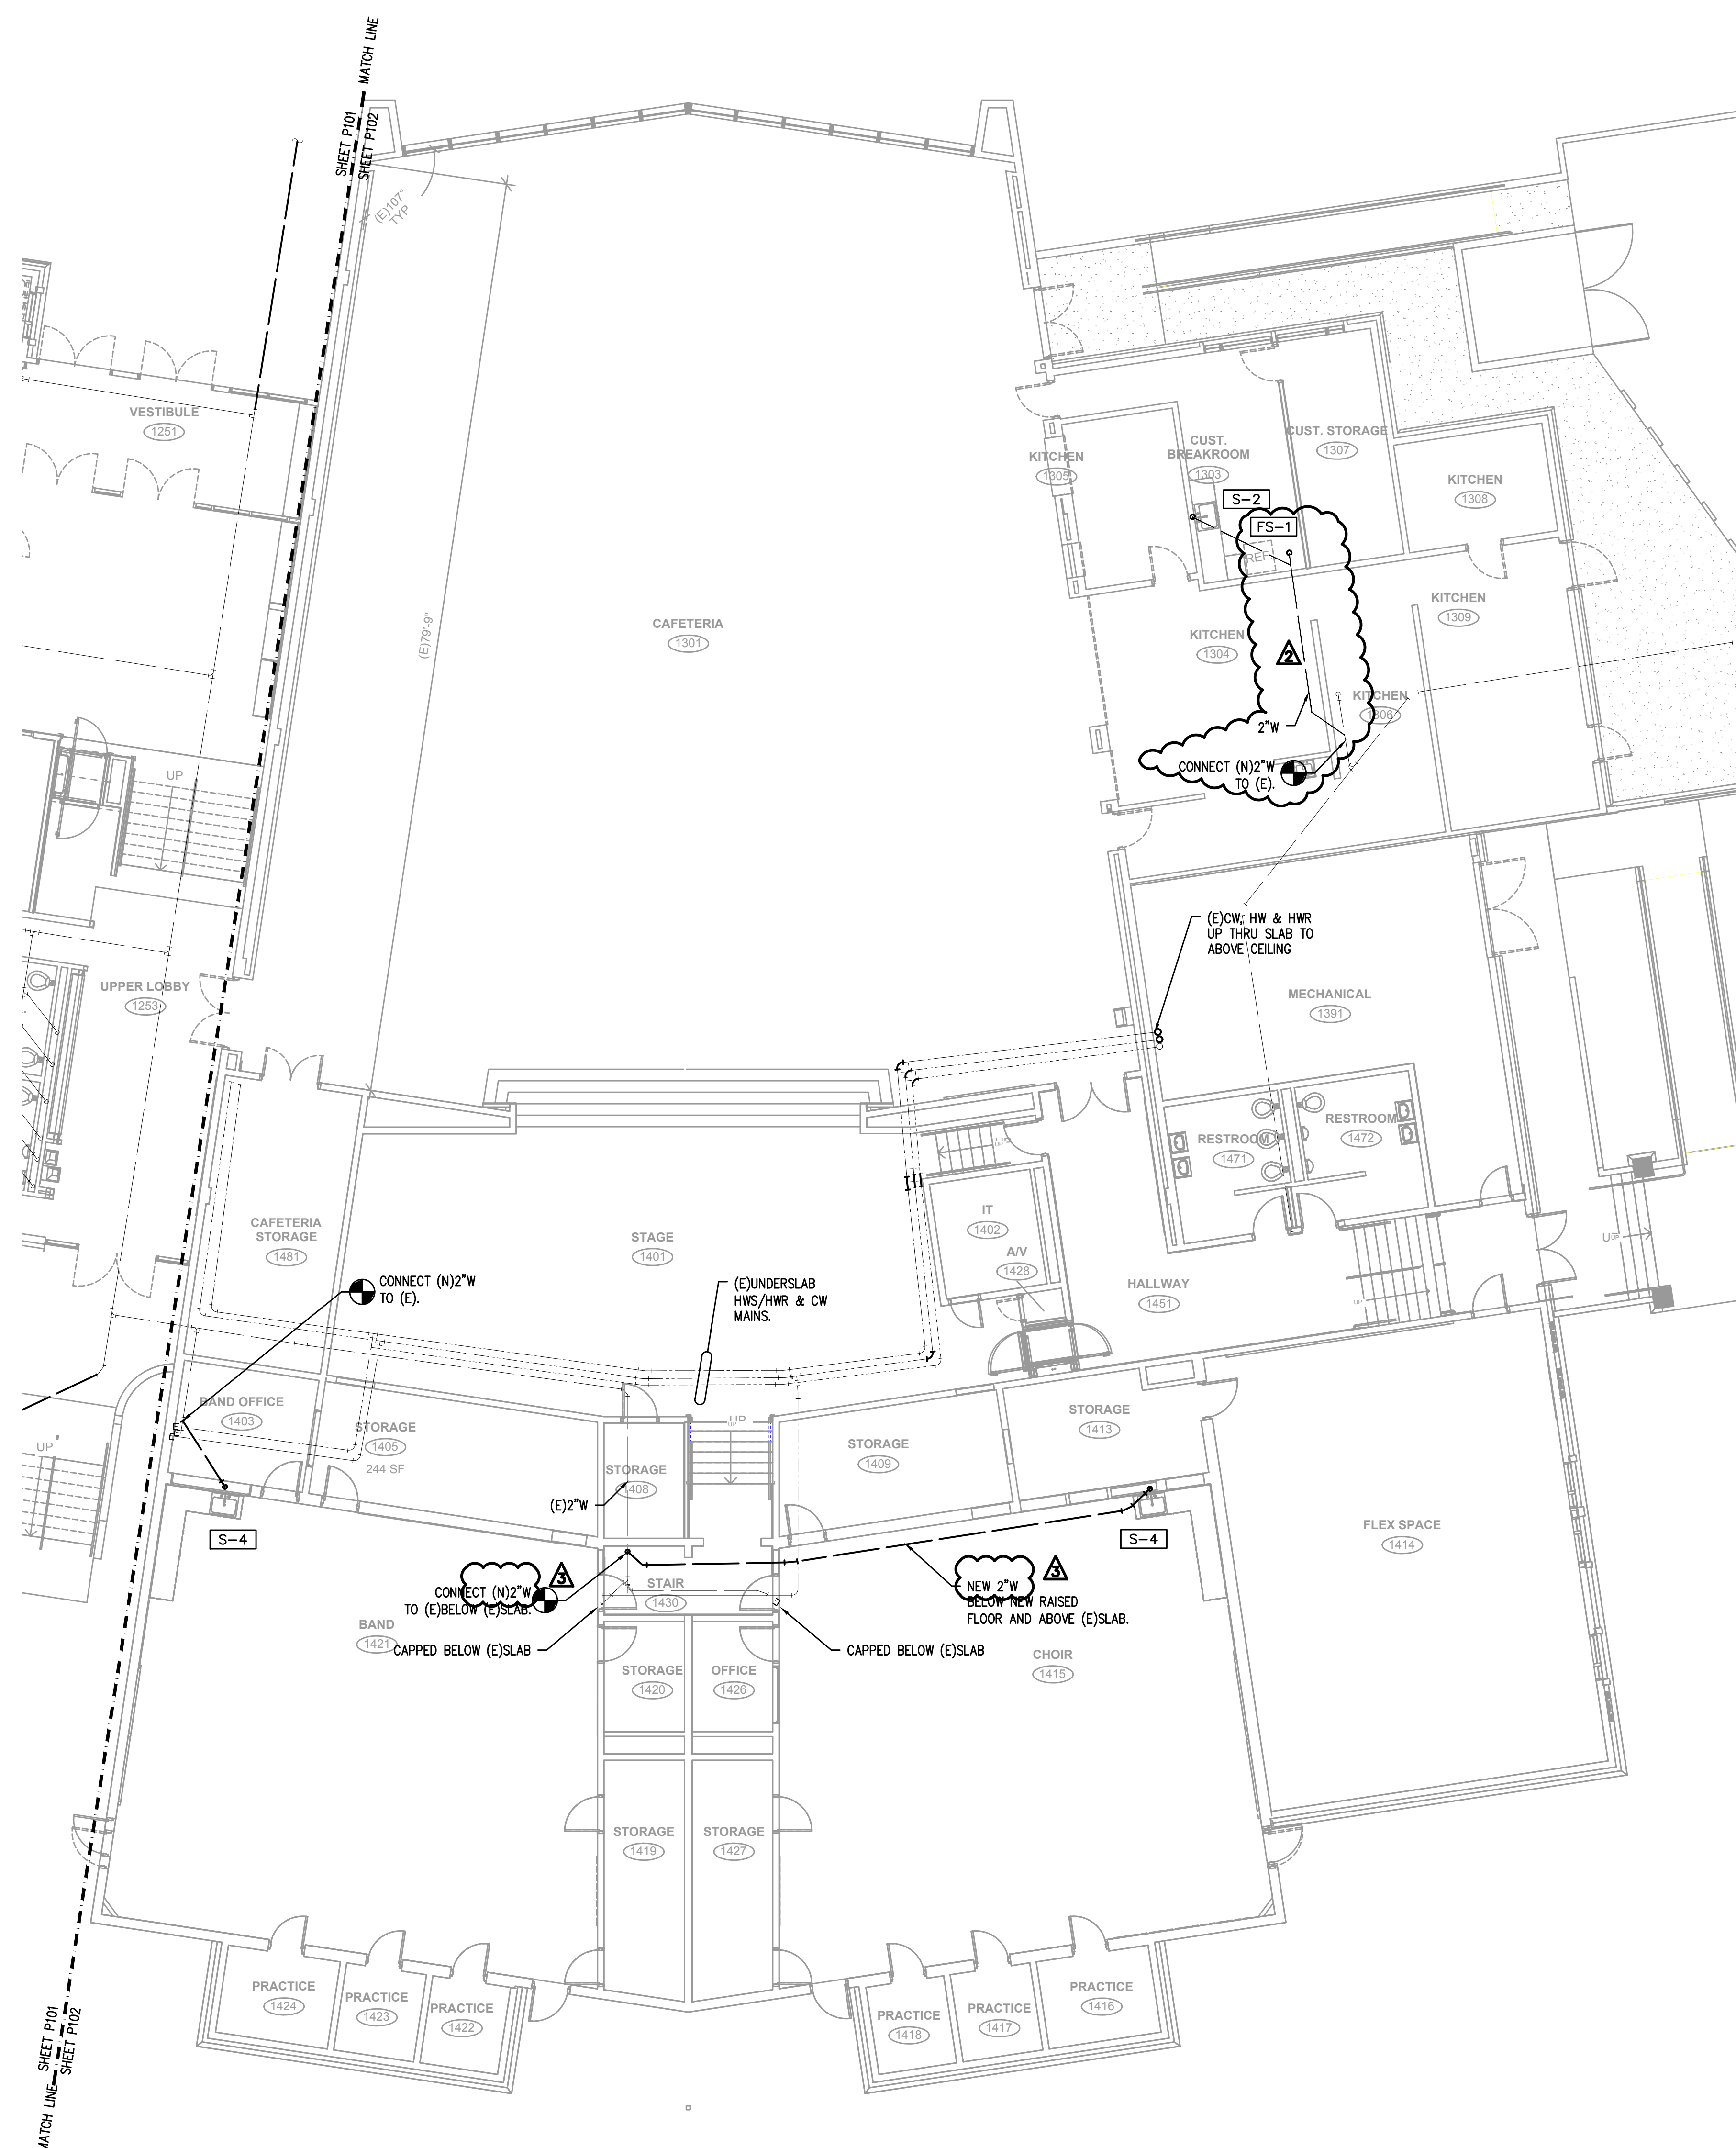



 1. UNDERSLAB PLUMBING FLOOR PLAN – BUILDING F
 P1.02 SCALE: 1/8"=1'-0"

3	3/15/18	PLAN REVIEW COMMENTS
2	3/13/18	ADDENDUM 1
1	2/19/18	DISTRICT REVIEW COMMENTS
#	Date	Description
Revision Schedule		

PERMIT & CONSTRUCTION SET

**PILOT BUTTE MIDDLE
SCHOOL - BLDGS E&F**

1501 NE Neff Road,
Bend OR 97701

BLRB architects

TACOMA	SPOKANE	PORTLAND	BEND
1250 Pacific Avenue Suite 700 Washington 98402 252.627.5599	505 W Riverside Suite 500 Washington 98201 509.252.5080	1001 SW 5th Avenue Suite T003 Oregon 97204 503.535.0707	404 SW Columbia Suite 120 Oregon 97702 541.330.6506

BLRB.com

Drawing Title:

UNDERSLAB PLUMBING
FLOOR PLAN -
BUILDING F

Date : 02.19.2018

Drawn By :	TB
------------	----


Revised Date

Project No.	17.34B
-------------	--------

Stamp

Sheet No.

MFI
INC. Consulting Engineers
2007 S.E. Ash St.
Portland, OR 97214
PHN: (503) 234-0548
FAX: (503) 234-0677
WWW.MFI-ENG.COM
CONTACT: TAKAKO BAKER

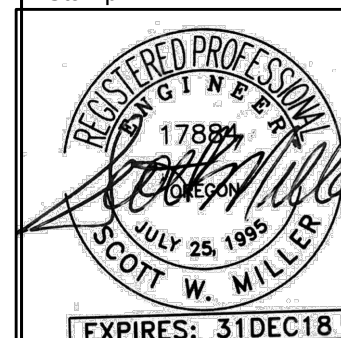

P1.02