



PIPE/CONDUIT PENETRATION DRYWALL CONSTRUCTION
TO BE APPLIED TO WALLS WITH STC ≥ 49

SEE ARCHITECTURAL DRAWINGS FOR ACOUSTICALLY IMPORTANT WALLS (WALL TYPES). SEAL PENETRATIONS IN THOSE WALLS PER THESE DETAILS

1 ACCOUSTICAL DUCT PENETRATION
SCALE: DETAIL

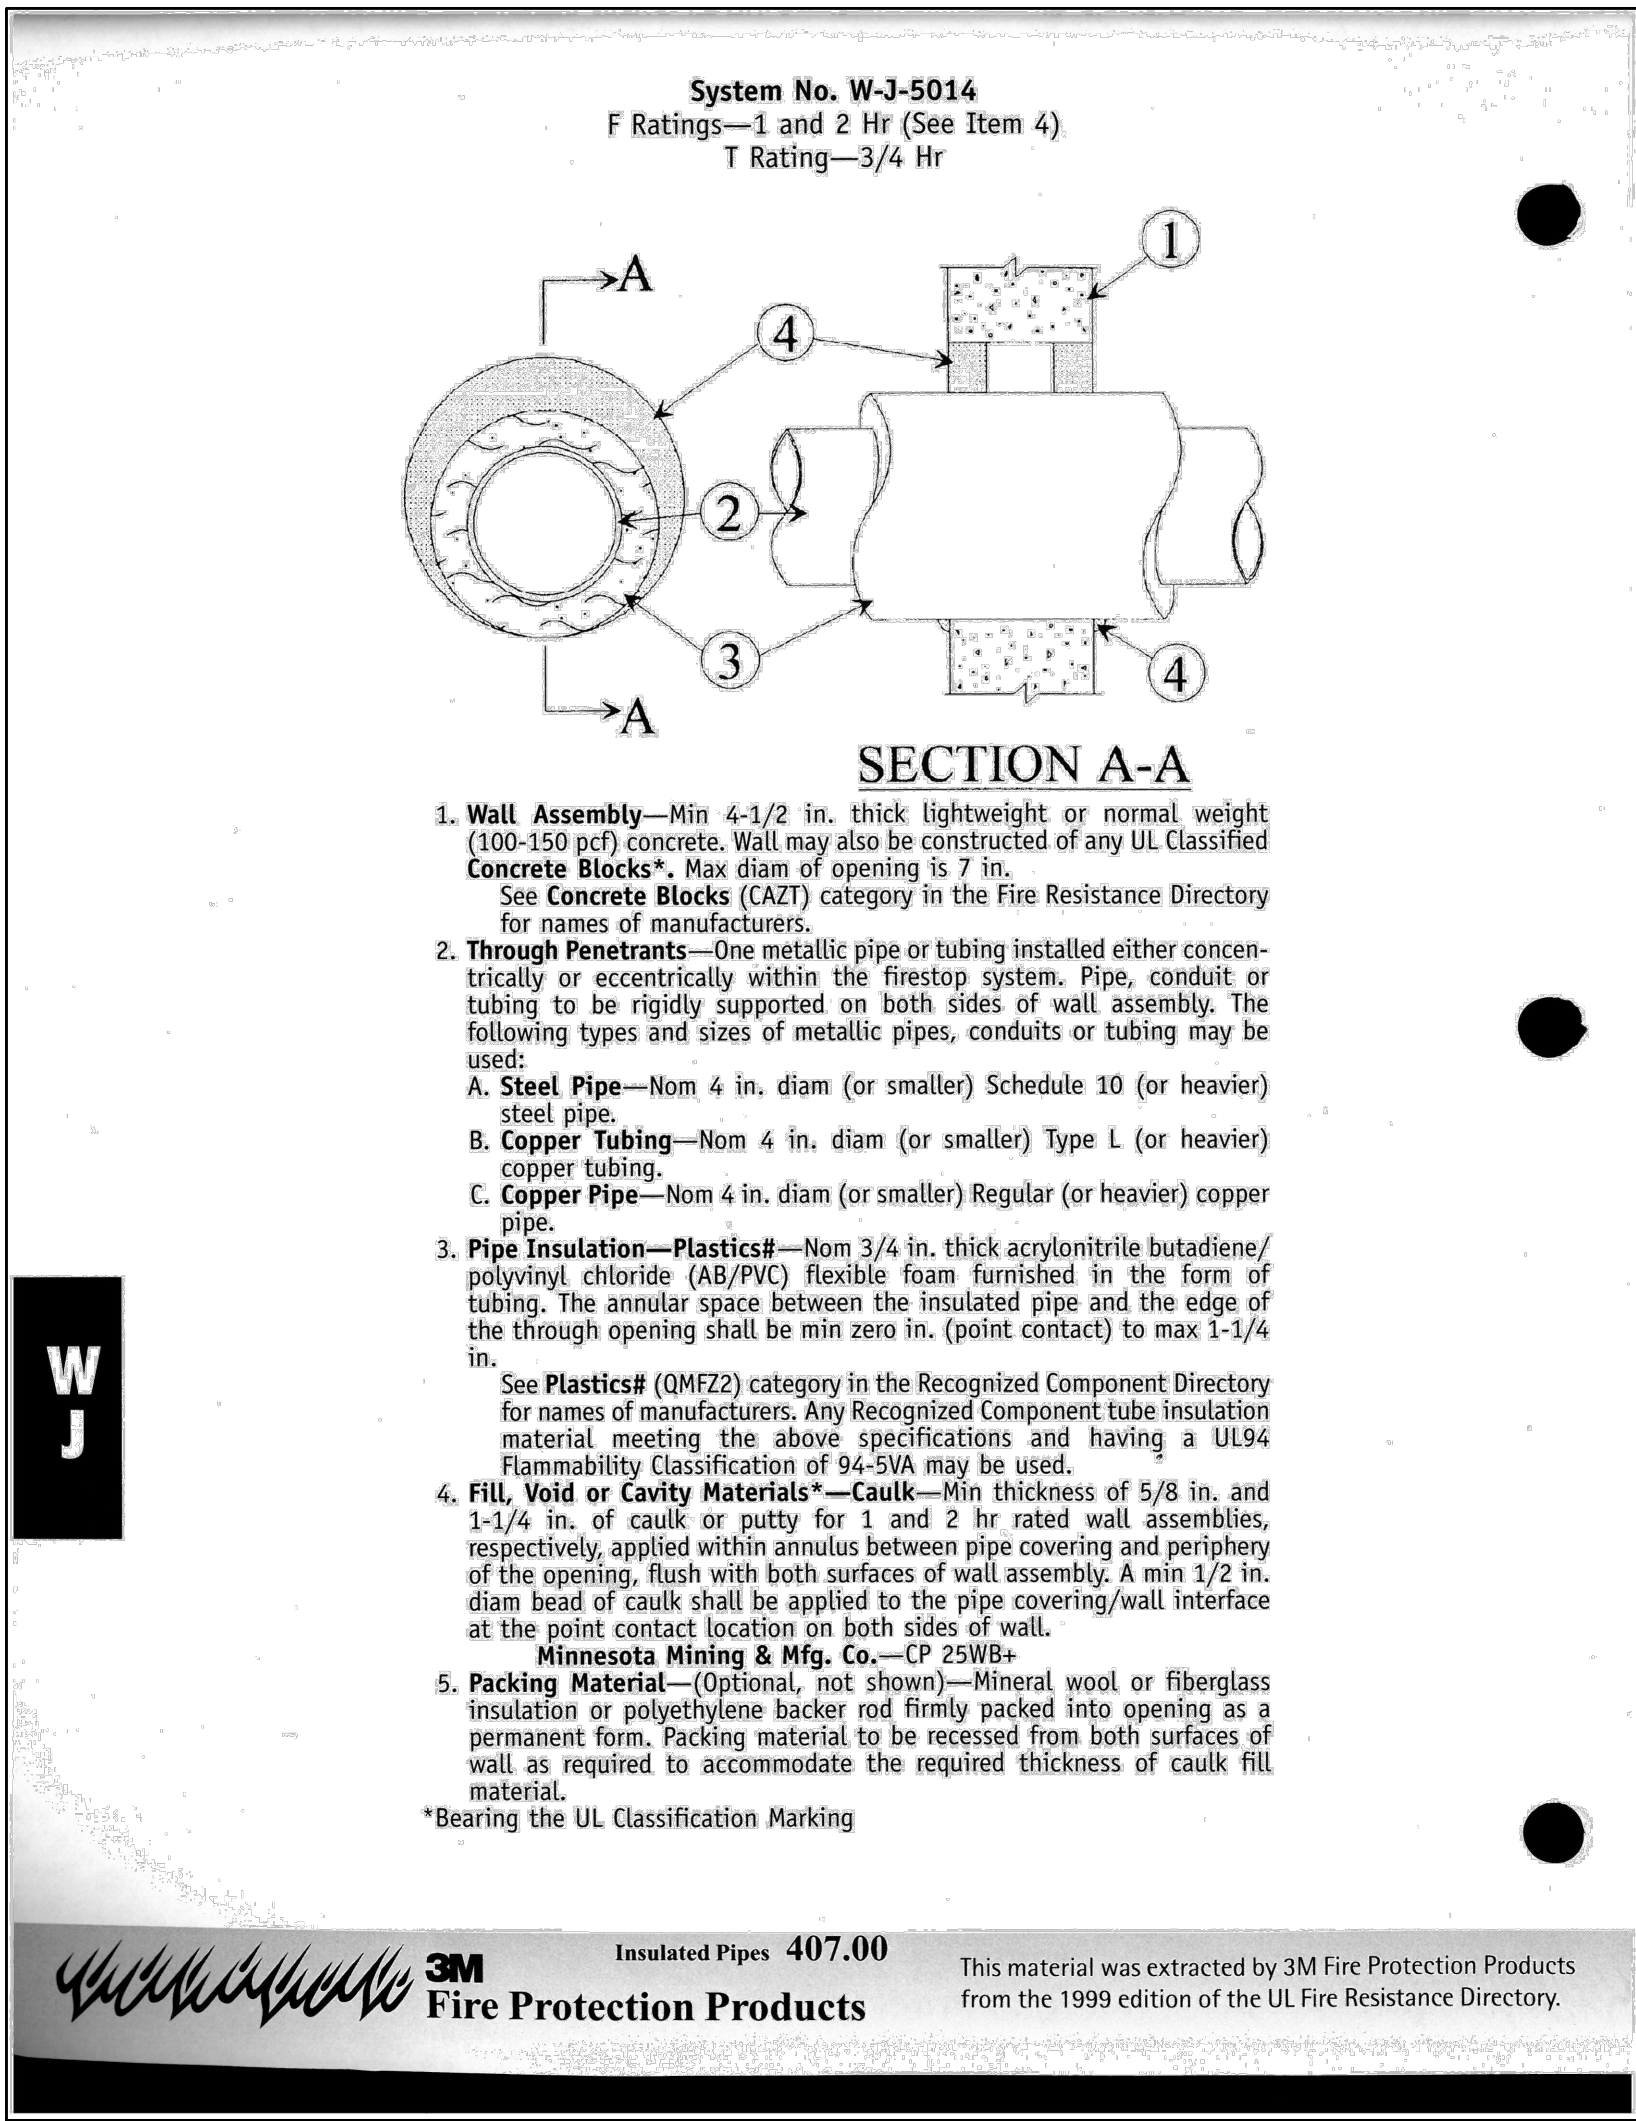

2 PIPE PENETRATION — RATED WALL
SCALE: DETAIL


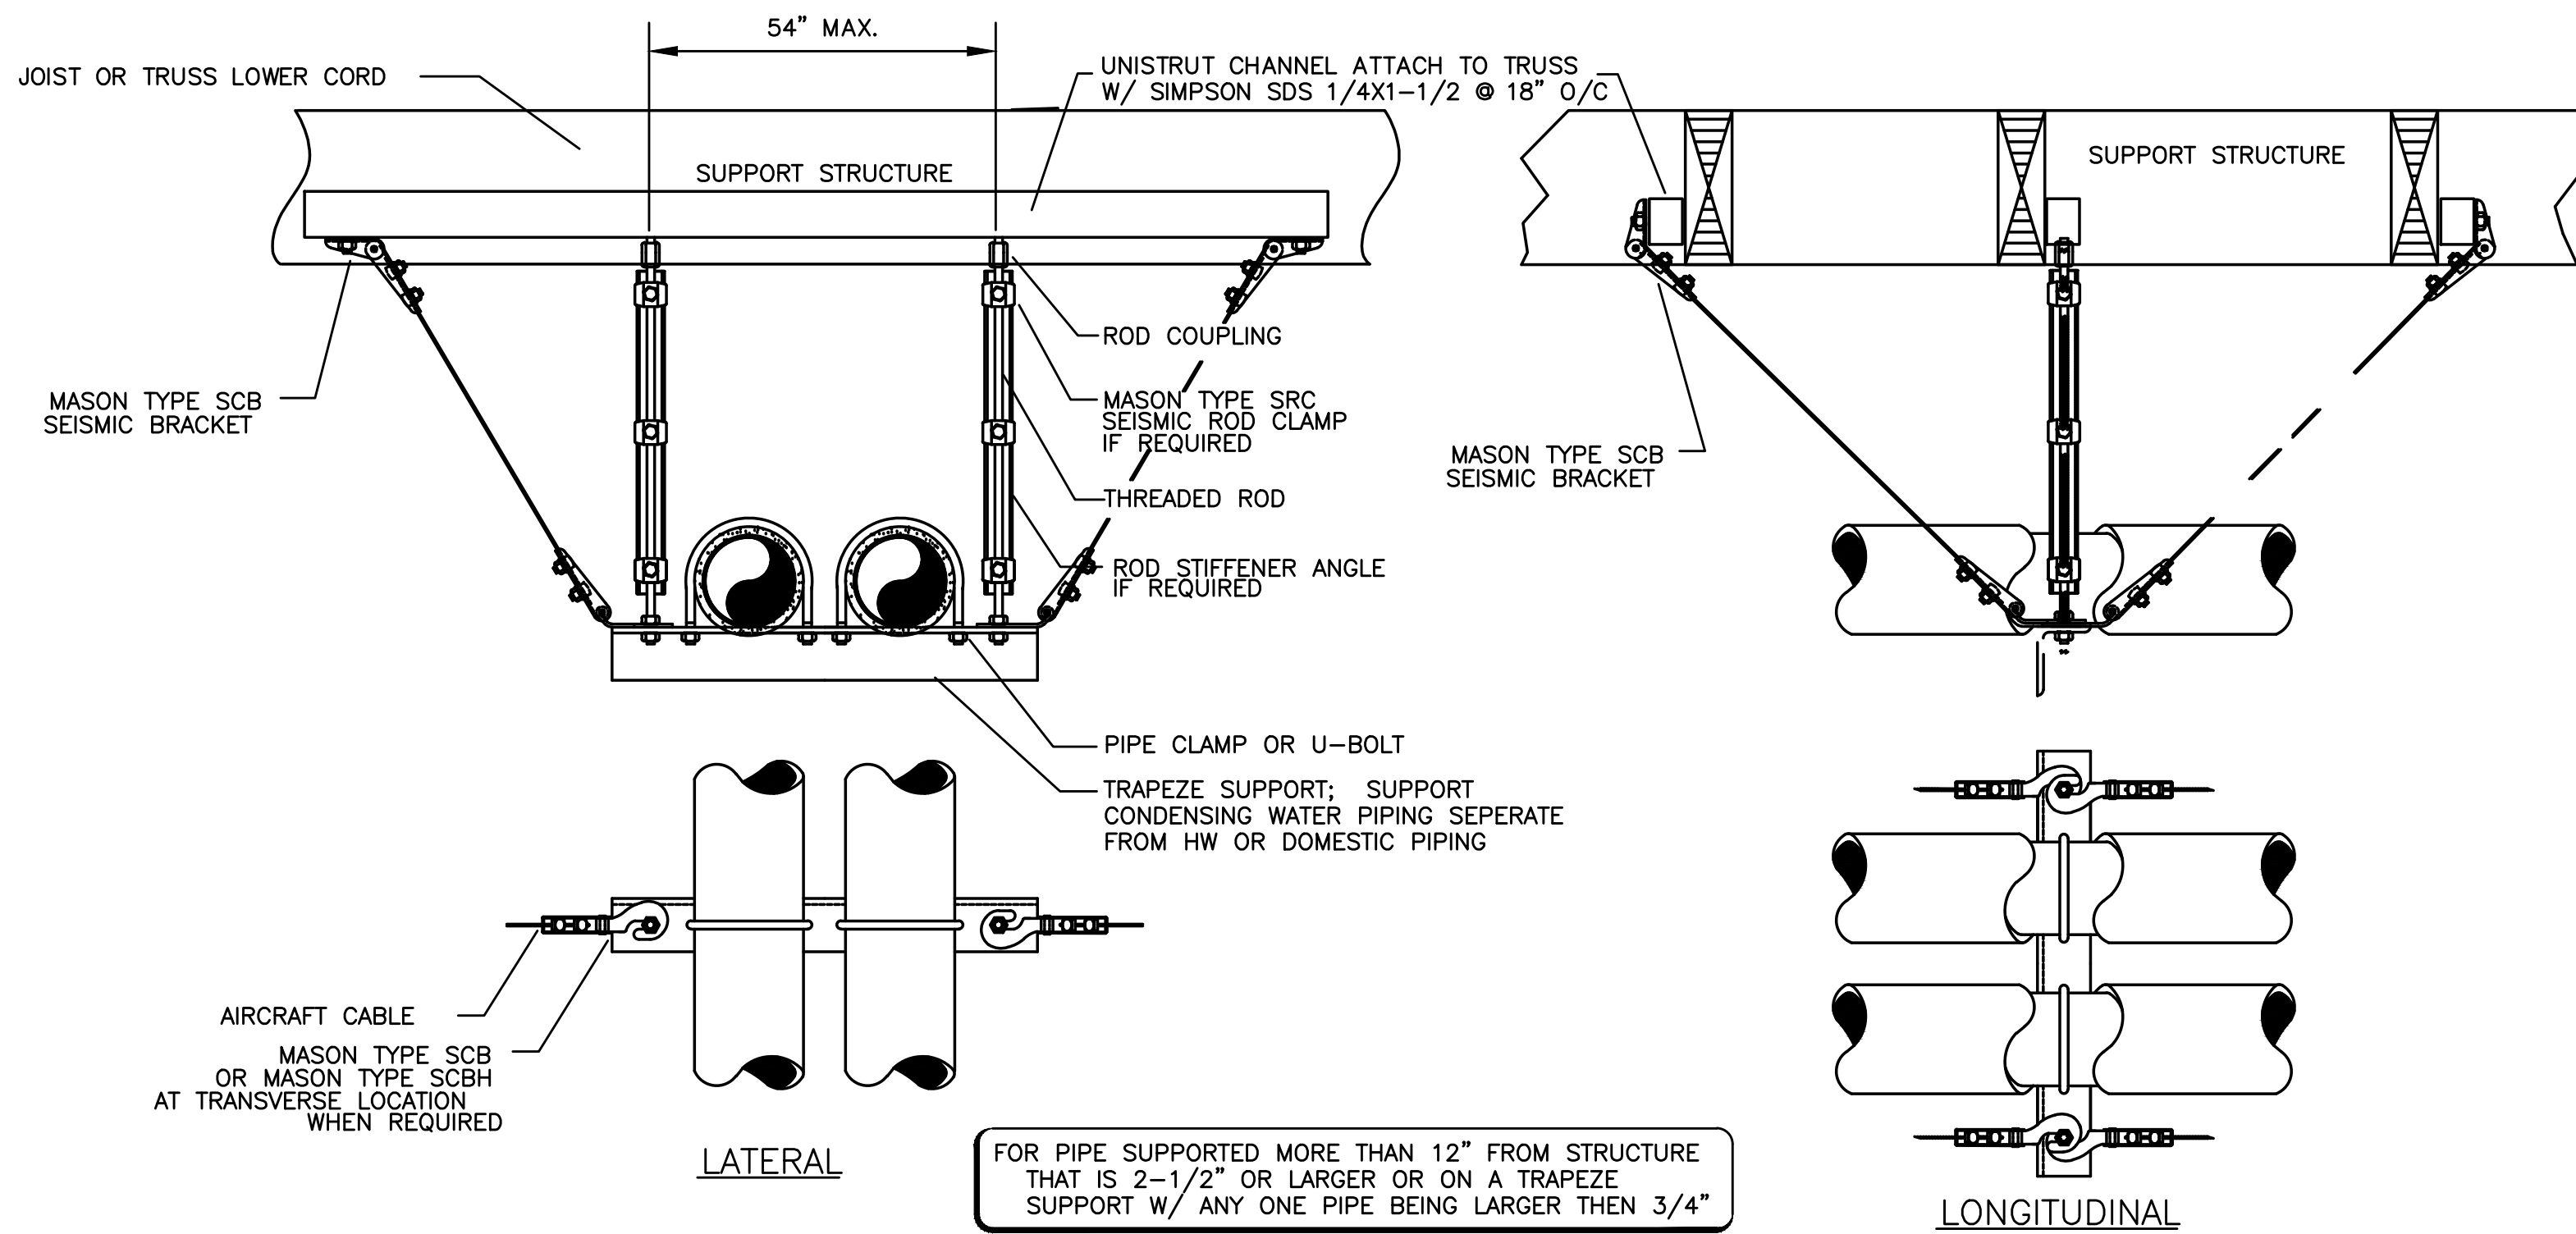


3 SEISMIC PIPE SUPPORT
SCALE: DETAIL


2/P6.02 NOTES

- 1-1/4" GALV. THREADED EYE BOLT @ CENTER OF WOOD MEMBER (TYP. OF 3). FOR Z-GIRT USE MACHINE THREAD EYE BOLT W/ JAMB NUT & 1/4" WASHER @ EACH SIDE OF GIRT

* — MAXIMUM HANGER SPACING SHALL BE AS FOLLOWS:
1-1/4" AND SMALLER PIPE 7' SPAN
1-1/2" PIPE 9' SPAN

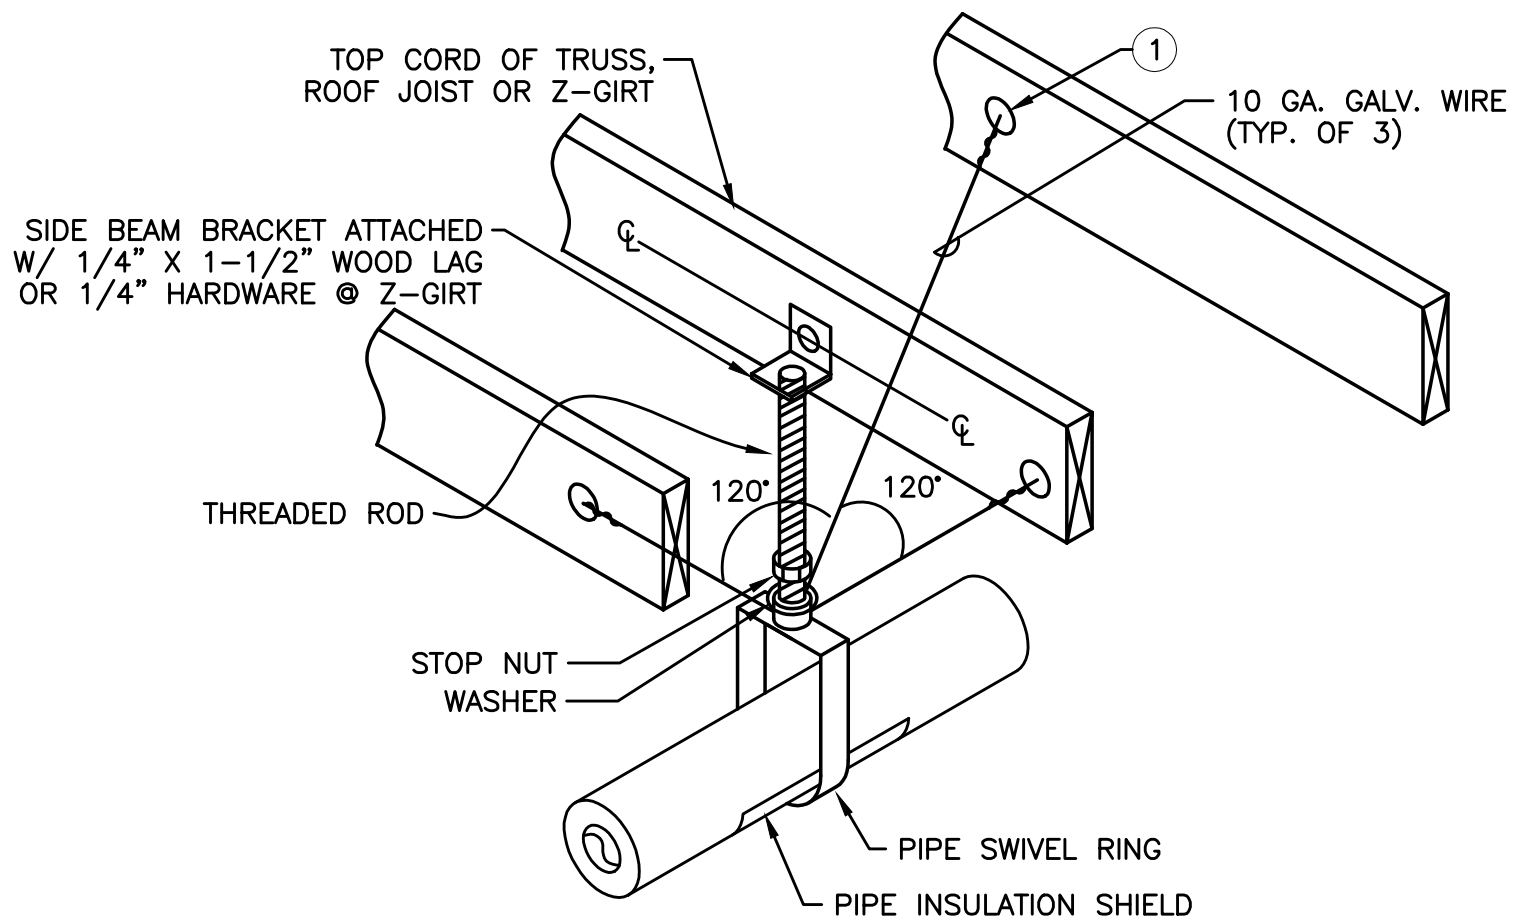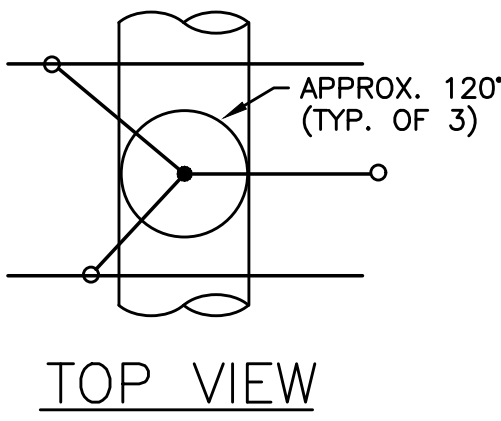

4 NON-SEISMIC PIPE SUPPORT
SCALE: DETAIL

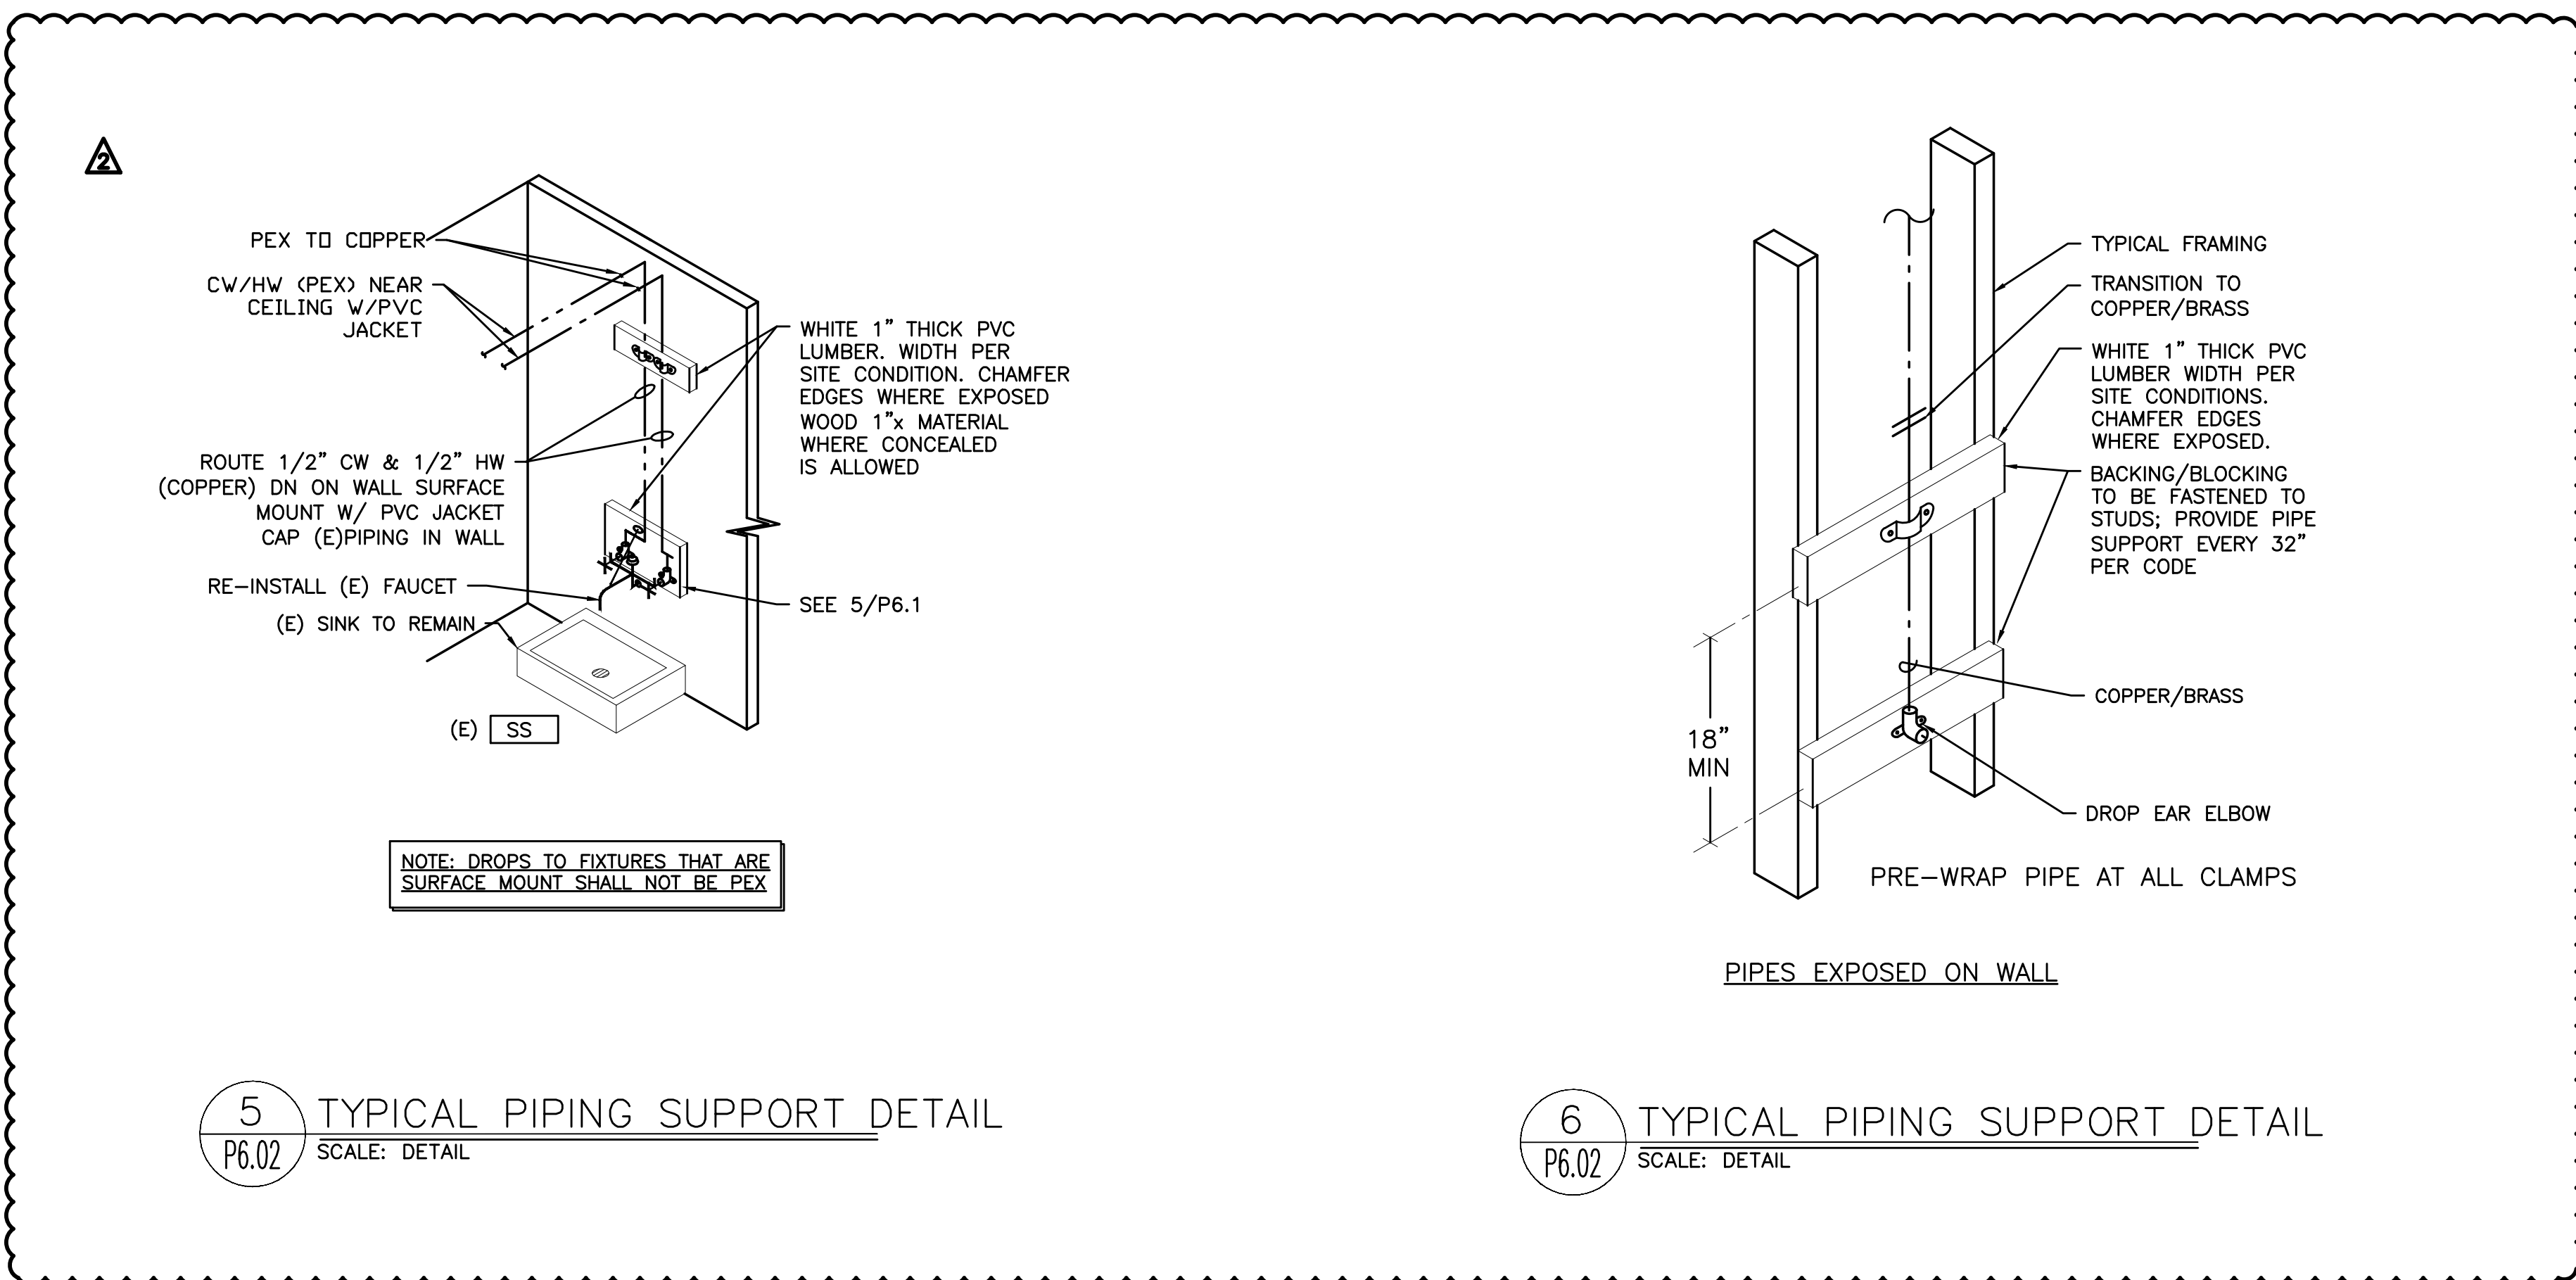

5 TYPICAL PIPING SUPPORT DETAIL
SCALE: DETAIL

6 TYPICAL PIPING SUPPORT DETAIL
SCALE: DETAIL

#	Date	Description
3	3/15/18	PLAN REVIEW COMMENTS
2	3/13/18	ADDENDUM 1
1	2/19/18	DISTRICT REVIEW COMMENTS
#	Date	Description

PERMIT & CONSTRUCTION SET

PILOT BUTTE MIDDLE SCHOOL - BLDGS E&F

1501 NE Neff Road,
Bend OR 97701

BLRB architects

TACOMA	SPOKANE	PORTLAND	BEND
1250 Pacific Avenue Suite 100 Westport 98402 253.627.5599	505 W Riverside Suite 500 Westport 98402 509.252.5285	1035 SW 5th Avenue Suite 100 Bend 97702 503.555.0707	404 SW Columbia St Suite 100 Bend 97702 541.536.6506

BLRB.com

Drawing Title:

PLUMBING DETAILS

Date : 02.19.2018 Drawn By : TB

Revised Date : Project No. 17.34B

Stamp Sheet No.



P6.02

BLRB ARCHITECTS, P.S.