














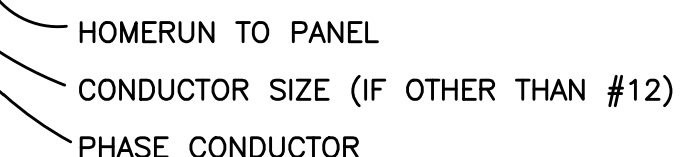




- ① RELOCATE EXISTING RECEPTACLE AS SHOWN. EXTEND EXISTING BRANCH CIRCUITING TO NEW LOCATION AND RE-CONNECT.
- ② CONNECT TO SPARE 20A/1P CIRCUIT BREAKER IN EXISTING PANEL.
- ③ DOOR CONTROLLER POWER SUPPLY CONNECTION. COORDINATE EXACT LOCATION WITH DOOR HARDWARE SPECIFICATIONS AND DOOR HARDWARE SUPPLIER.
- ④ EXTEND EXISTING BRANCH CIRCUIT TO SERVE NEW RECEPTACLE AS SHOWN.
- ⑤ EXISTING RECEPTACLE, RACEWAY, AND BRANCH CIRCUITING TO BE REMOVED.

   	<h2><u>LIGHTING SYMBOLS</u></h2> <p>LIGHT FIXTURE, RECESSED</p> <p>LIGHT FIXTURE, RECESSED EMERGENCY</p> <p>EXIT SIGN</p>		<h2><u>WIRING SYMBOLS</u></h2> 
  	<h2><u>SWITCH SYMBOLS</u></h2> <p>SWITCH, SPST +48" A.F.F.</p> <p>SWITCH, 3-WAY +48" A.F.F.</p> <p>OCCUPANCY SENSOR, CEILING MOUNT</p>		
     	<h2><u>POWER SYMBOLS</u></h2> <p>RECEPTACLE, DUPLEX +18" A.F.F.</p> <p>RECEPTACLE, DUPLEX ABOVE COUNTER</p> <p>RECEPTACLE, QUAD +18" A.F.F.</p> <p>ELECTRICAL DISTRIBUTION PANEL</p> <p>ELECTRICAL CONNECTION</p> <p>ELECTRICAL JUNCTION BOX</p>		<h2><u>NOTATIONS</u></h2> <p>CONDUIT, STUBBED &amp; CAPPED</p> <p>DRAWING NOTE</p> <p>DETAIL REFERENCE: TOP=DETAIL NO., BOTTOM=SHEET NO.</p>
			<h2><u>ABBREVIATIONS</u></h2> <p>'A' EXISTING</p> <p>(E) EXISTING</p> <p>G.F.I. GROUND FAULT INTERRUPTER</p> <p>(R) RELOCATED</p> <p>W.P. WEATHERPROOF</p>

Copyright © 2017 BBT Architects  
C:\Users\Brent Turner\OneDrive\Documents\2018\Bend-La Pine Schools Security Upgrades\Bend-La Pine Middle School\Bend-La Pine Middle School Lighting\Bend-La Pine Middle School Lighting.dwg, 02/14/2018, 9:41am

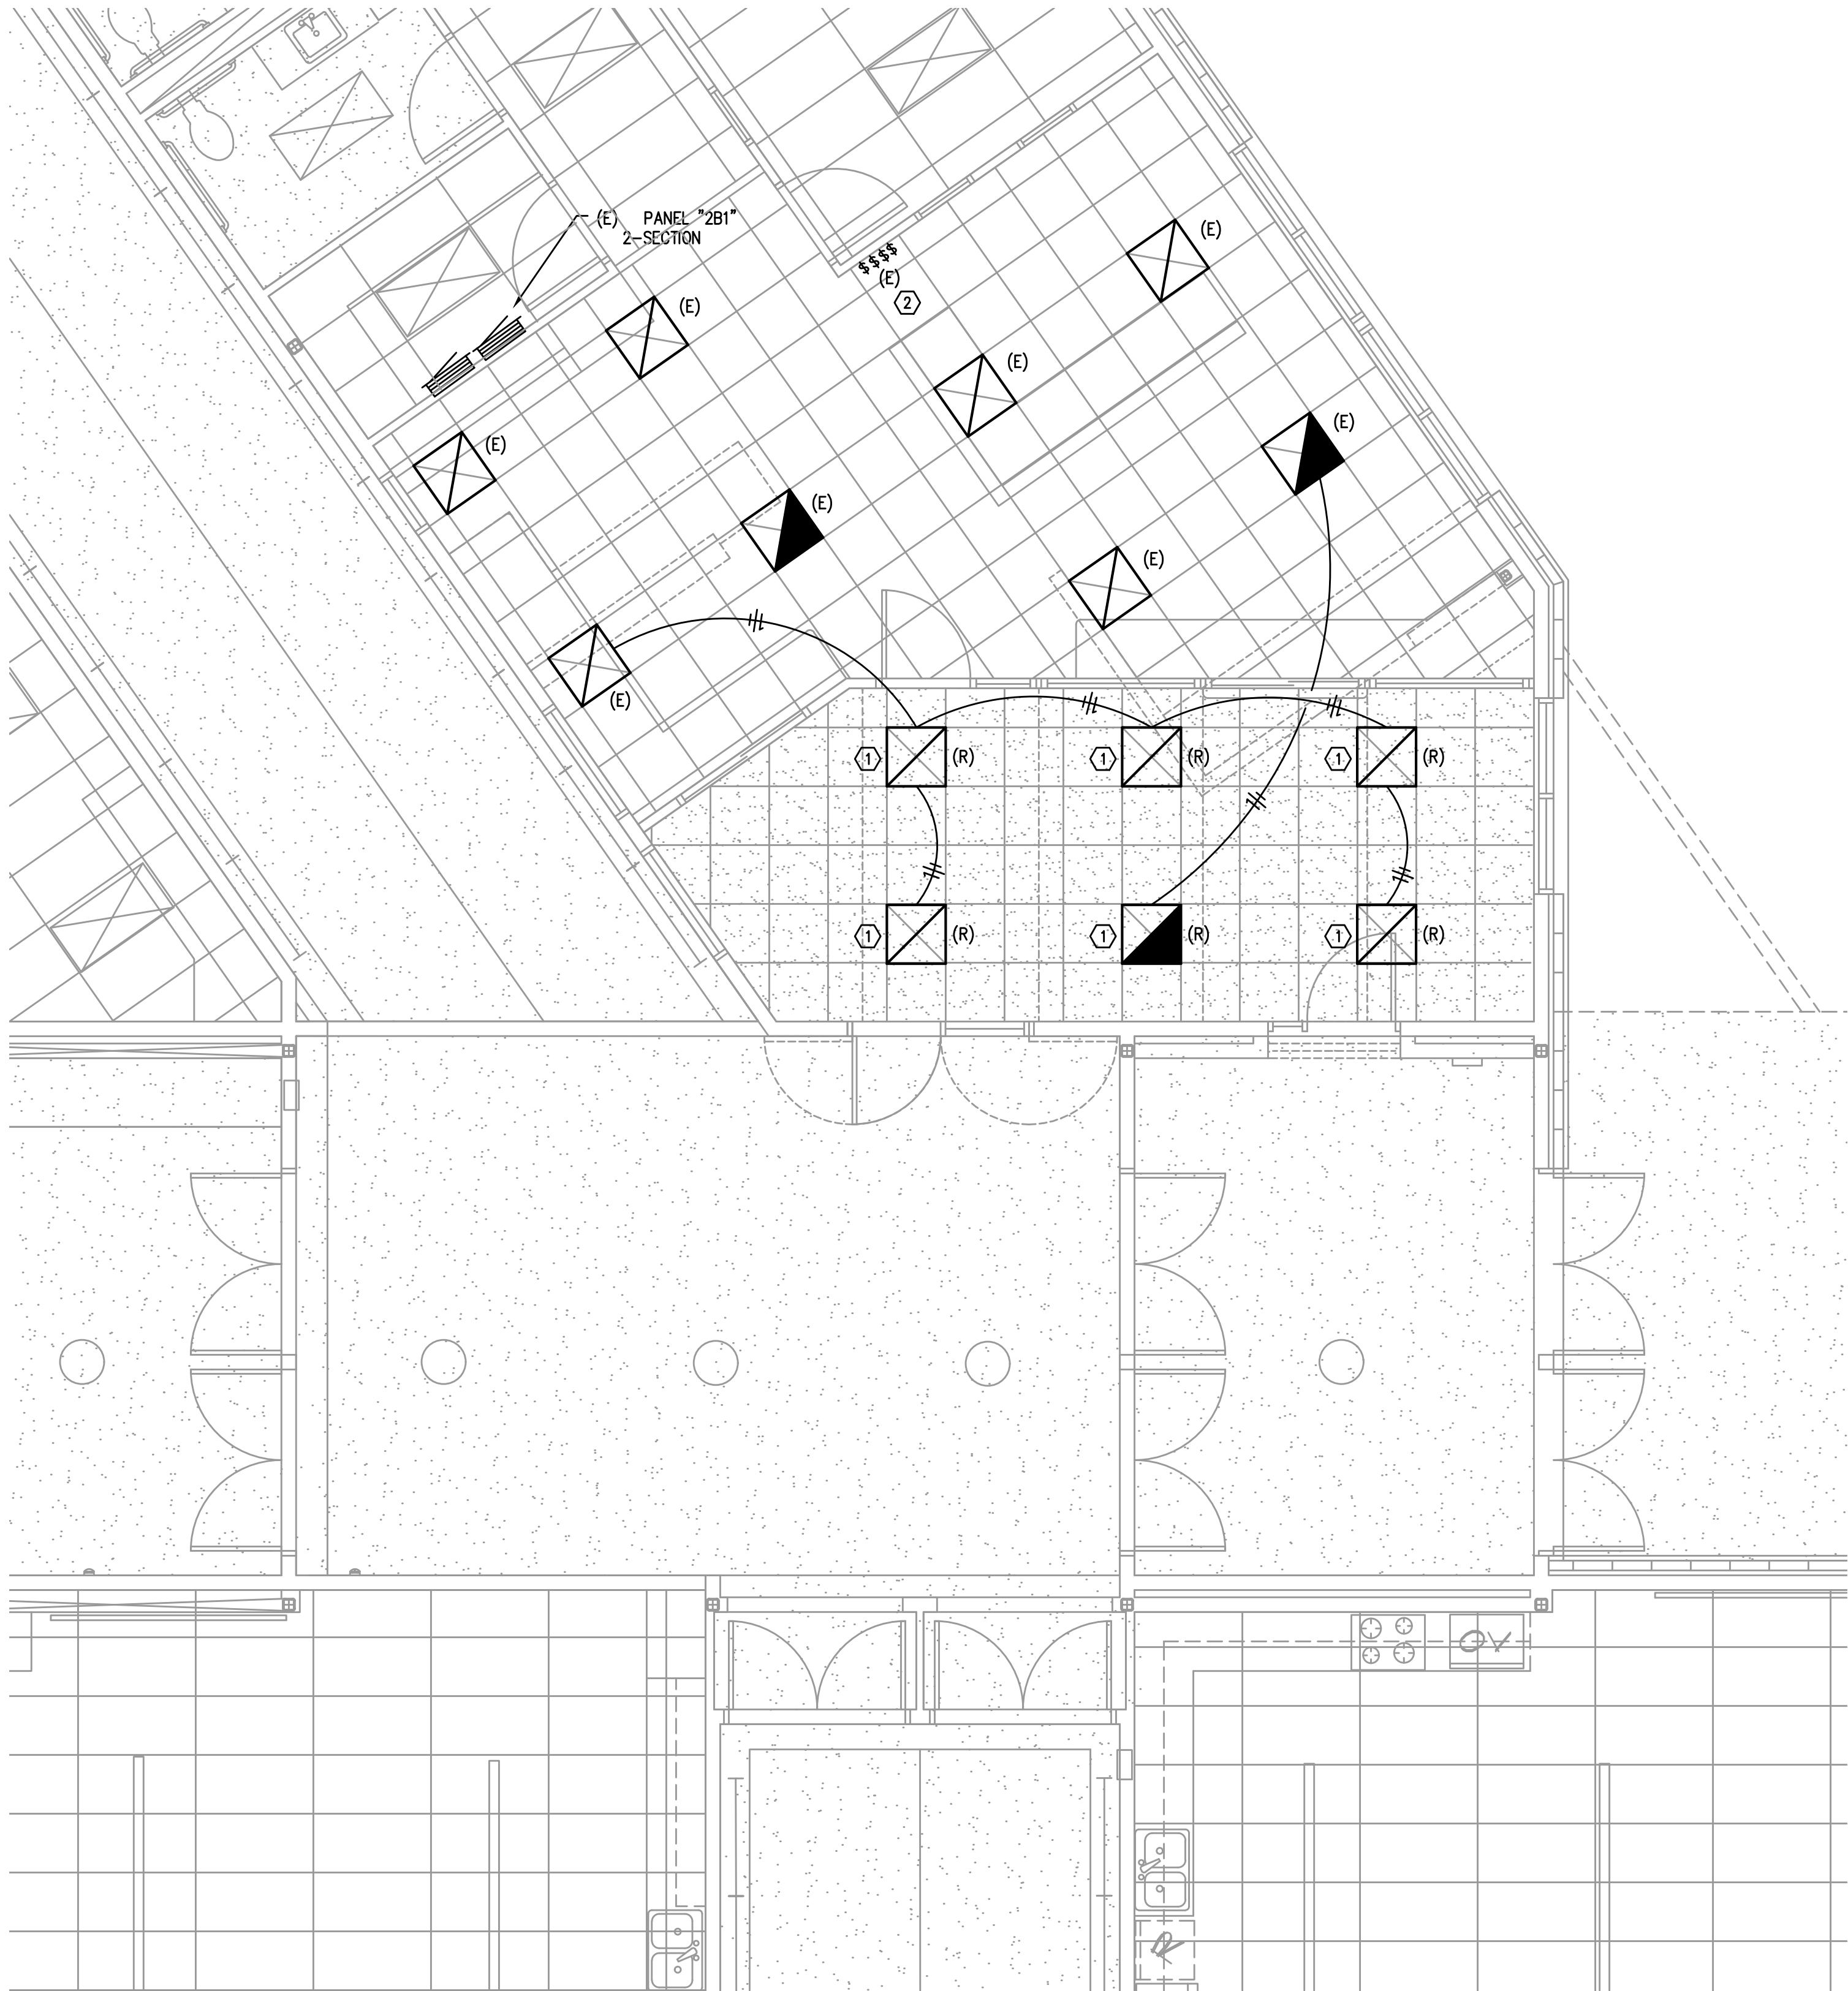

1  
E2.1 ENLARGED FLOOR PLAN – LIGHTING  
SCALE: 1/4" = 1'-0"

PLAN NOTES

- ① RELOCATED LIGHT FIXTURE. PROVIDE NEW BRANCH CIRCUITING AND RE-CONNECT TO EXISTING LIGHTING AS INDICATED.
- ② EXISTING LIGHTING CONTROL SWITCHES TO REMAIN.

Bend-La Pine Schools SECURITY UPGRADES  
Sky View Middle School  
63555 NE 18th Street  
Bend, Oregon 97701

ISSUED:	DATE:
PERMIT SET / BID SET	02/14/18
APR #1	03/28/18
CONFORMANCE SET	03/28/18
APR-06	05/16/18
AS-BUILT	09/04/18

JOB NUMBER:	1708
DRAWN BY:	CAW
CHECKED BY:	RLC

SHEET TITLE  
ENLARGED  
FLOOR PLAN  
LIGHTING

SHEET NUMBER  
E2.1

BBT  
ARCHITECTS  
1160 NW Simpson Ave. - Suite 100 - Bend, Oregon 97702  
t 541.382.5535 | f 541.389.8033