


1 ENLARGED HVAC FLOOR PLAN
M1.1 SCALE: 1/4" = 1'-0"

- GENERAL NOTES:
- SEE ARCHITECTURAL CONSTRUCTION DOCUMENTS FOR AREA OF WORK.
 - PROVIDE SPRINKLER HEADS AS REQUIRED IN LOBBY AND CORRIDOR; RELOCATE EXISTING SPRINKLER HEADS IN CORRIDOR AS REQUIRED;
 - CONTRACTOR TO KEEP RECORD OF NEW SYSTEM INSTALLED AS WELL AS EXISTING TO REMAIN, AND ITEMS DISCOVERED OR ENCOUNTERED ON SITE THAT WERE NOT SHOWN ON THE PLANS. THESE INCLUDE SYSTEMS, DUCTWORK, PIPE, ETC THAT DO NOT AFFECT OR ARE NOT PART OF THE PROJECT SCOPE, BUT ARE WITHIN THE BOUNDARIES OF THE PROJECT SCOPE. CONTRACTOR IS RESPONSIBLE FOR PROVIDING AS-BUILT DRAWINGS THAT ACCURATELY REFLECT THE CONDITIONS WITHIN THE BOUNDARY OF THE PROJECT SCOPE AT THE END OF THE PROJECT.
 - COORDINATE CEILING DIFFUSER LOCATION WITH ELECTRICAL, LOW VOLTAGE AND FIRE PROTECTION DISCIPLINES.
 - ALL SHOWN EXISTING DUCTWORK, DIFFUSERS, EQUIPMENT AND CAPACITIES ARE GATHERED FROM VARIOUS AS BUILTS AND SHOWN FOR REFERENCE ONLY. CONTRACTOR SHALL VERIFY SIZE AND LOCATION PRIOR TO COMMENCING WORK.

MECHANICAL LEGEND

	SUPPLY AIR DIFFUSER	AFF	ABOVE FINISH FLOOR
	RETURN AIR DIFFUSER	AHU	AIR HANDLING UNIT
	EXHAUST AIR DIFFUSER	BOG	BOTTOM OF GRILLE
	DIRECTIONAL AIR FLOW	BTU	BRITISH THERMAL UNITS
	MANUAL VOLUME DAMPER	CFM	CUBIC FEET PER MINUTE
	SUPPLY AIR DUCT UP & DOWN	CONN.	CONNECTION
	RETURN AIR DUCT UP & DOWN	CONT.	CONTINUATION
	EXHAUST OR OUTSIDE AIR DUCT UP & DOWN	EXH	EXHAUST AIR
	SUPPLY AIR DUCT UP & DOWN	FPM	FEET PER MINUTE
	RETURN AIR DUCT UP & DOWN	FPS	FEET PER SECOND
	EXHAUST OR OUTSIDE AIR DUCT UP & DOWN	FT.	FEET / FOOT
	VAV TERMINAL UNIT W/ REHEAT COIL	GA.	GAUGE
	CONNECT TO EXISTING	IN.	INCHES
	TEMPERATURE SENSOR	L	LENGTH
	NOTE	LBS.	POUNDS
	EQUIPMENT DESIGNATOR	MAX.	MAXIMUM
	FIRE DAMPER	MBH	THOUSANDS OF BTUs PER HOUR
	FIRE / SMOKE DAMPER	MD	MOTORIZED DAMPER
	SMOKE DAMPER	MIN.	MINIMUM
	CAP EXISTING DUCT	MVD	MANUAL VOLUME DAMPER
		OA	OUTSIDE AIR
		PSI	POUNDS PER SQUARE INCH
		R.A.	RETURN AIR
		REQ'D	REQUIRED
		S.A.	SUPPLY AIR
		TEMP.	TEMPERATURE
		TYP.	TYPICAL
		VAV	VARIABLE AIR VOLUME
		W	WIDTH
		WB	WET BULB
		Ø	DIAMETER
			DEMOLISH, (R) RELOCATE
			(E) EXISTING
			NEW WORK
			HWS (HWS) HEATING WATER SUPPLY
			HWR (HWR) HEATING WATER RETURN
			HWRR (HWRR) HEATING WATER REVERSE RETURN

AIR DISTRIBUTION DETAILS

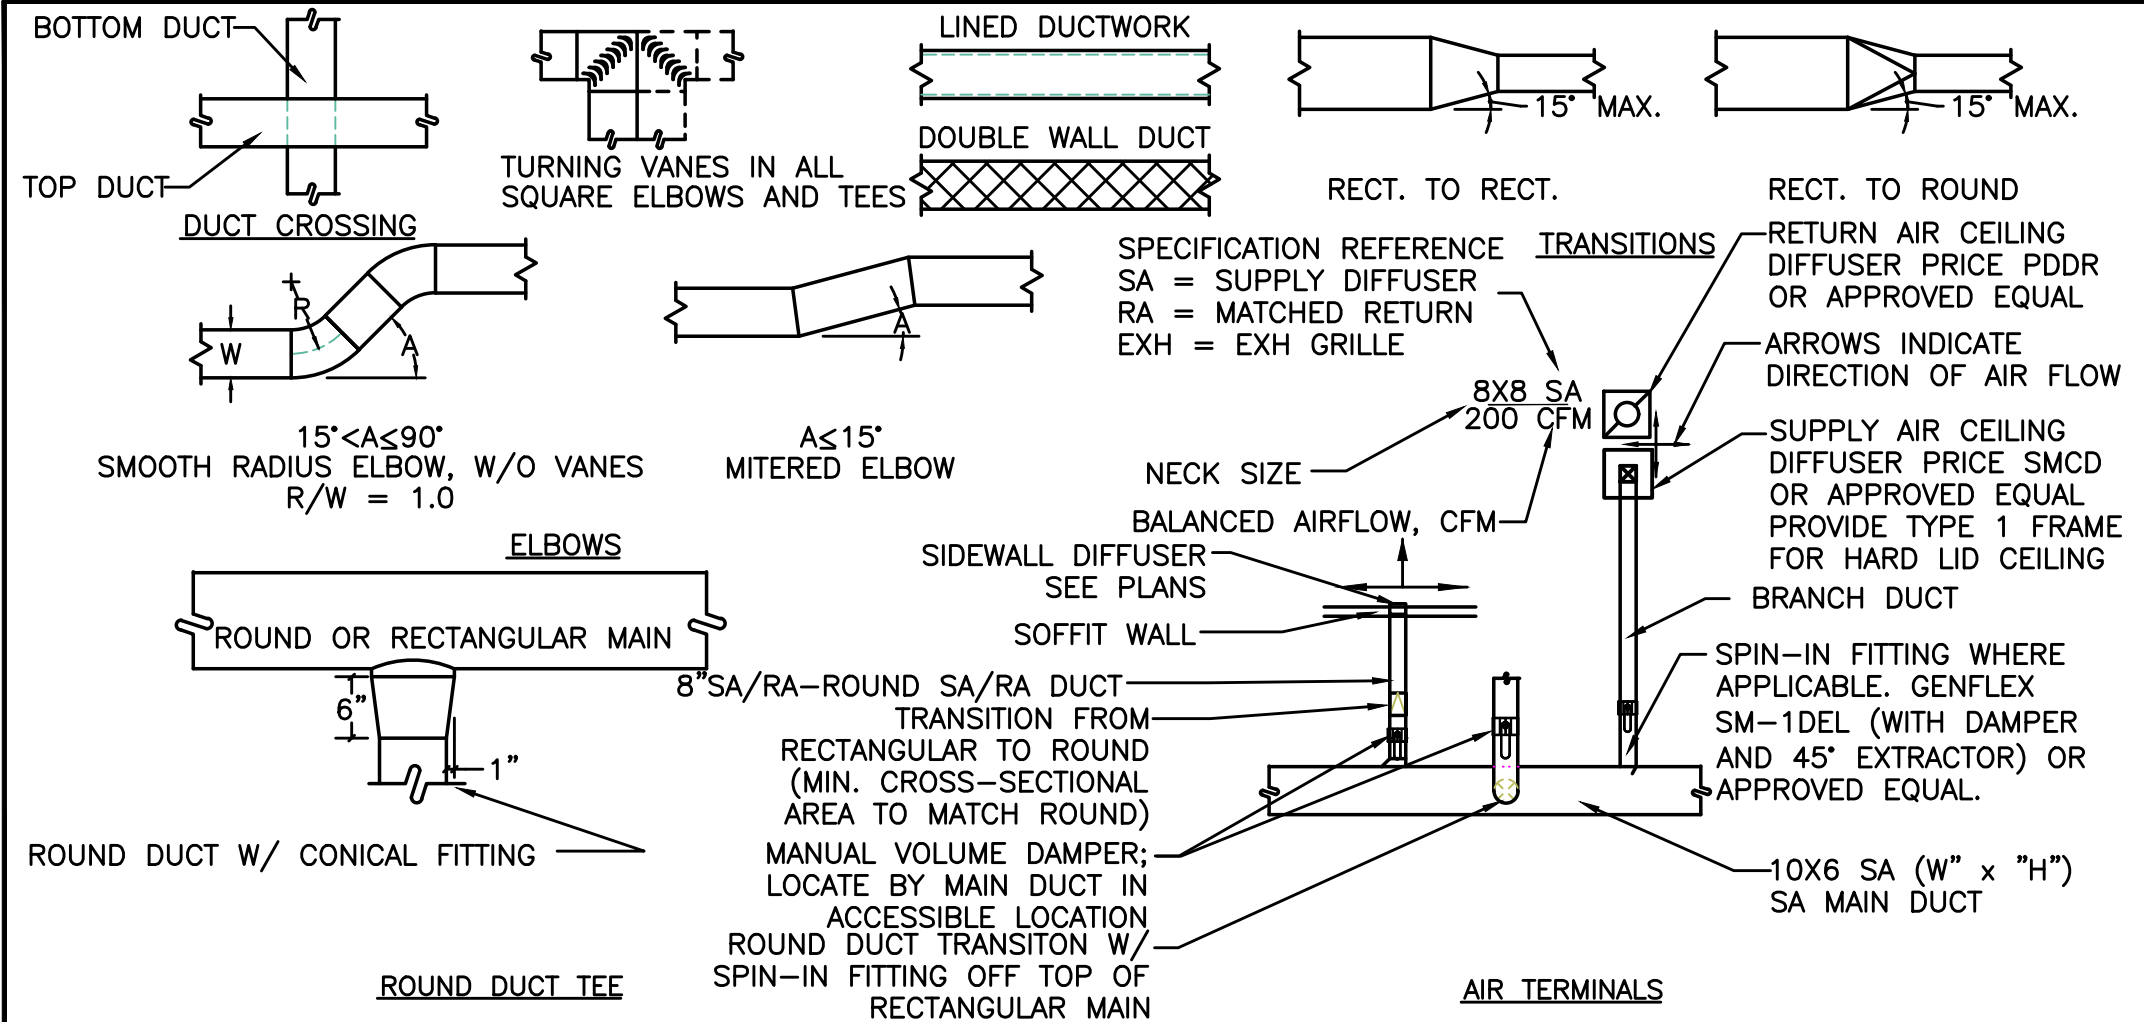

Bend-La Pine Schools SECURITY UPGRADES
Sky View Middle School
63555 NE 18th Street
Bend, Oregon 97701

ISSUED:	DATE:
PERMIT SET / BID SET	02/14/18
APR #1	03/28/18
CONFORMANCE SET	03/28/18
APR-06	05/16/18
AS-BUILT	09/04/18

JOB NUMBER:	1708
DRAWN BY:	EVK
CHECKED BY:	JVB

SHEET TITLE
ENLARGED
HVAC
FLOOR PLAN

SHEET NUMBER
M1.1