


C:\Users\demarcus\Documents\Bent-Lava Ridge Elementary\Bent-Lava Ridge Elementary.dwg, PLOT Date: 12/20/18, 12:20pm

Copyright © 2017 BBT Architects

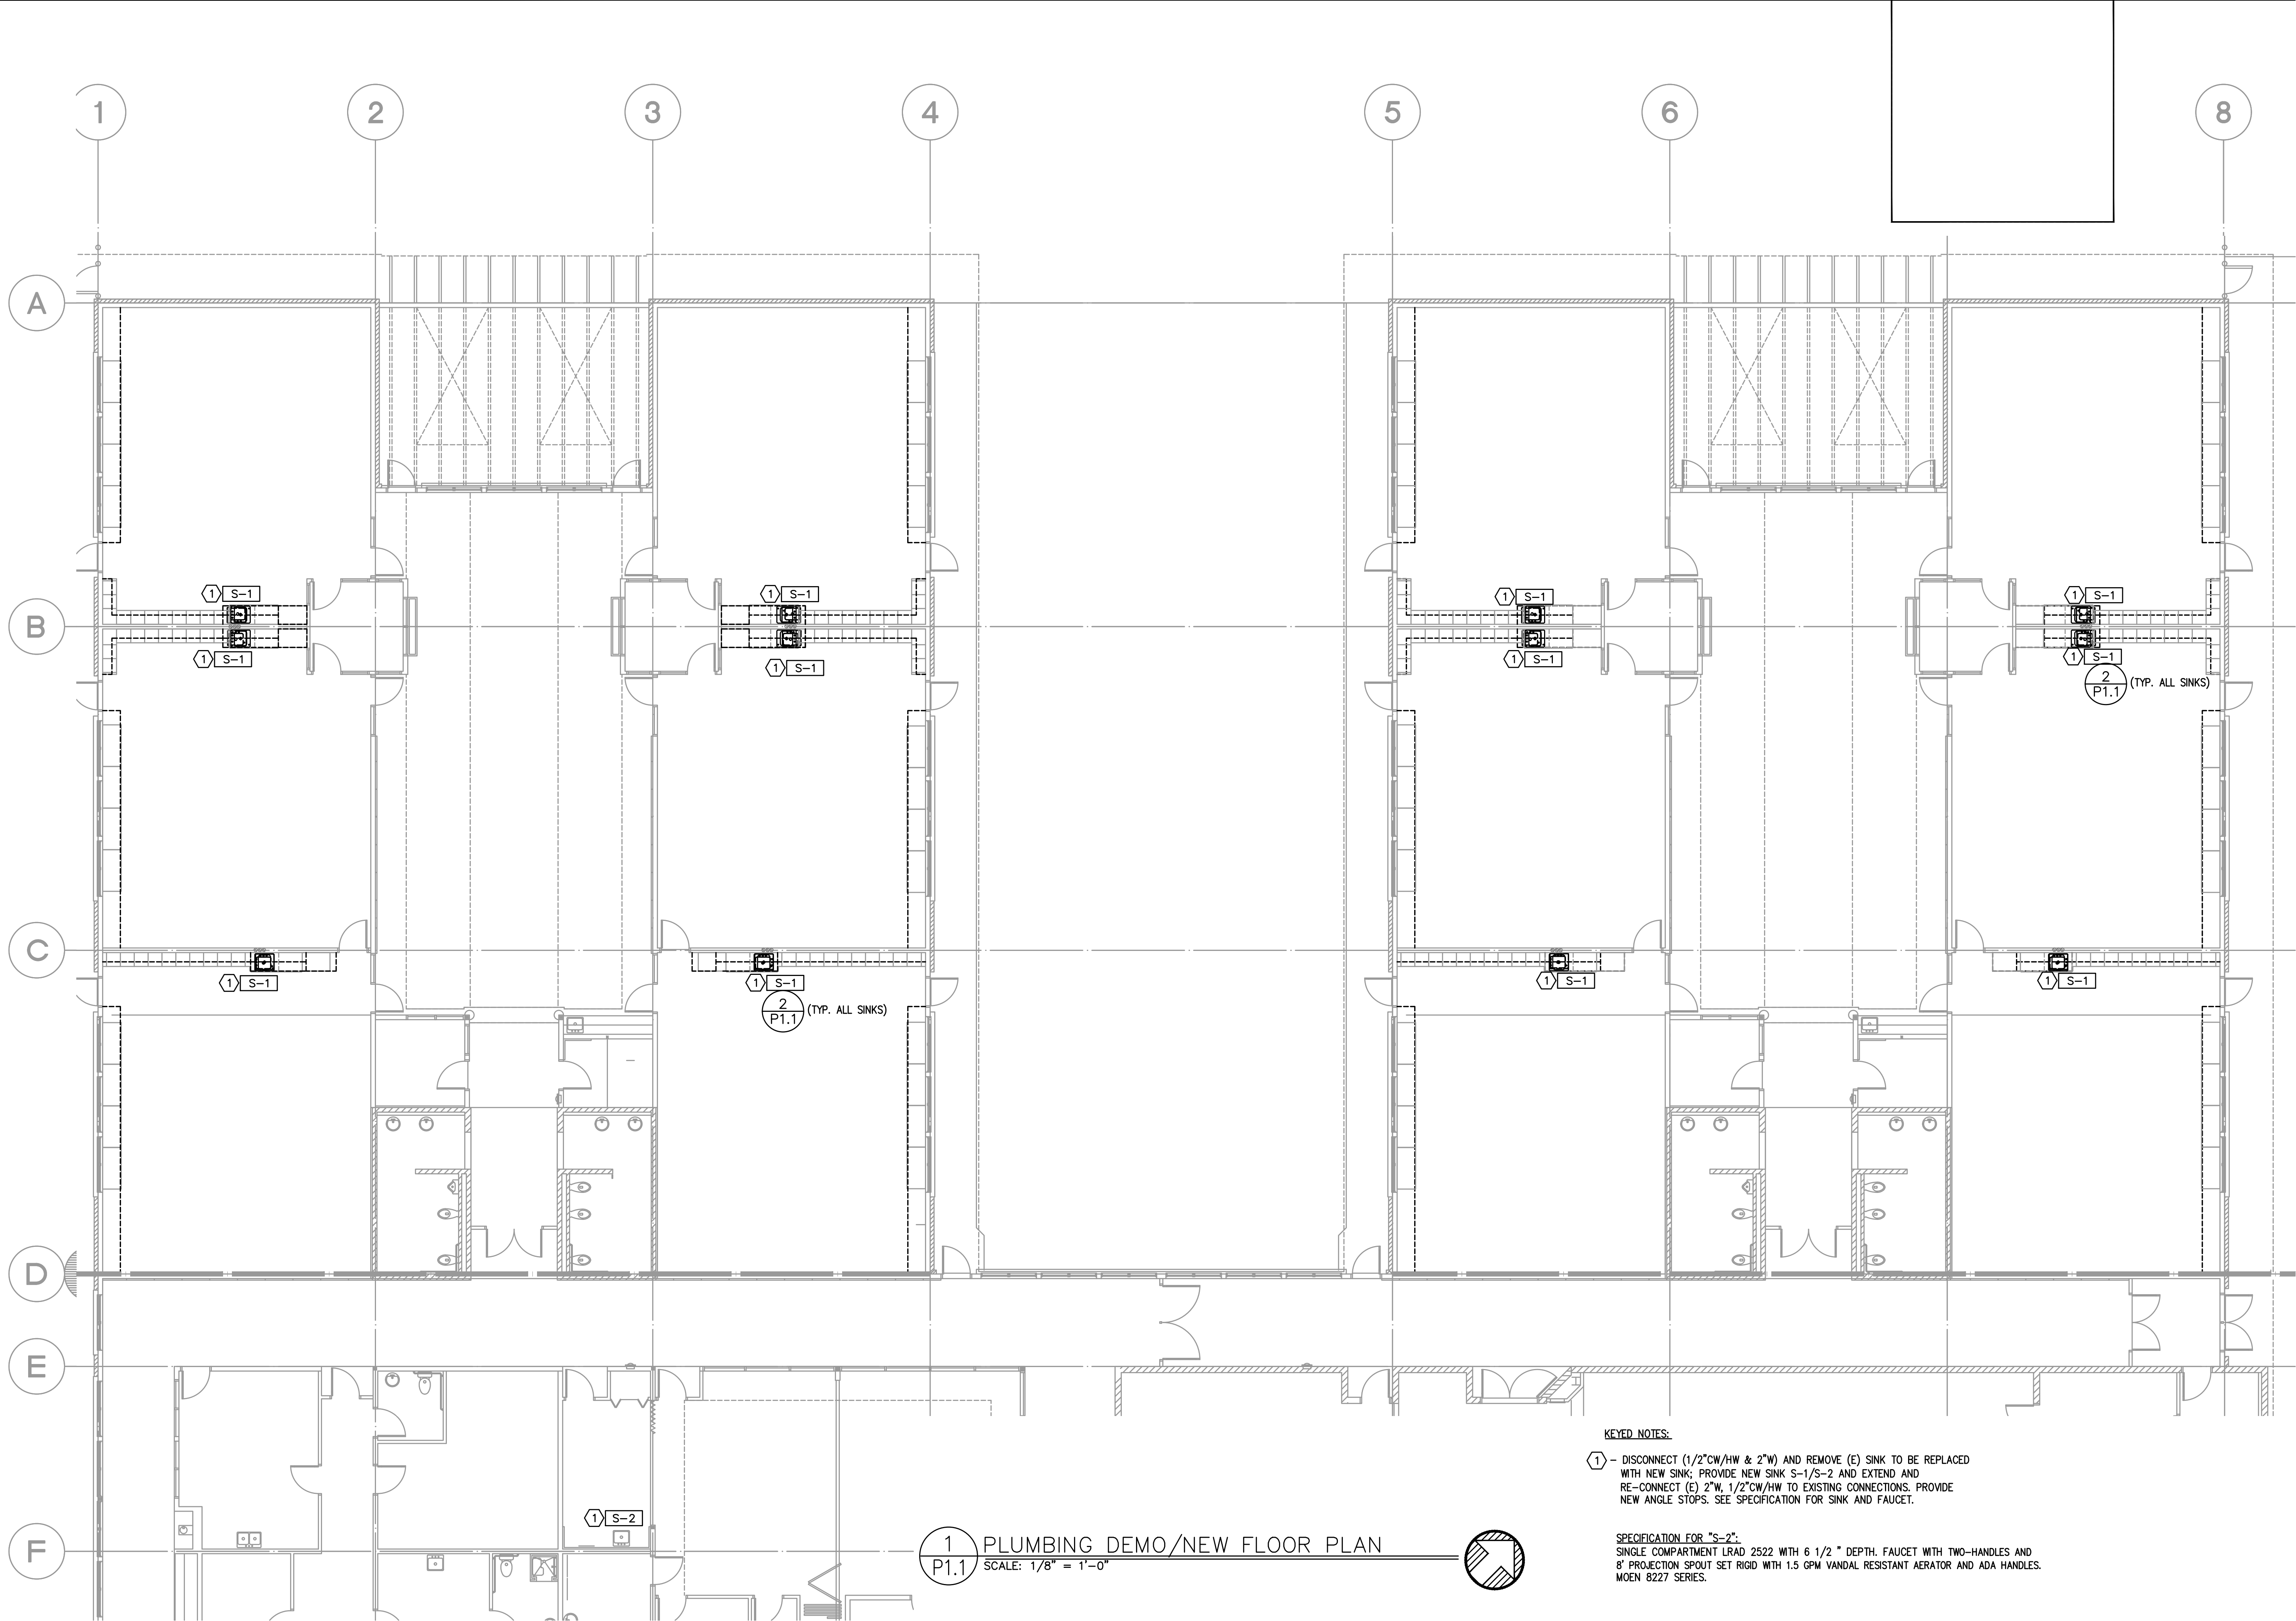

BBT

ARCHITECTS

1160 NW Simpson Ave. - Suite 100 - Bend, Oregon 97702  
t 541.389.5335 | f 541.389.8033

Bend-La Pine Schools SECURITY UPGRADES  
Lava Ridge Elementary

20805 Cooley Road  
Bend, Oregon 97701

ISSUED:	DATE:	02/14/18
	PERMIT SET / BID SET	03/07/18
	ADDENDUM #3	03/28/18
	CONFORMANCE SET	04/09/18
	APR #4	09/04/18
	AS-BUILT	


JOB NUMBER:	1708
DRAWN BY:	EVK
CHECKED BY:	JVB

SHEET TITLE

PLUMBING  
FLOOR PLAN

SHEET NUMBER

P1.1

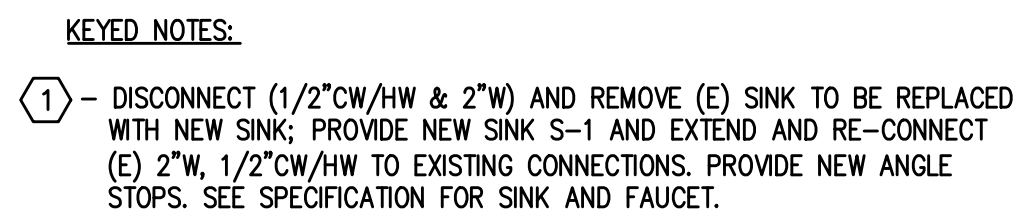

**A R C H I T E C T S**  
1160 SW Simpson Ave. - Suite 100 - Bend, Oregon 97702  
t 541.382.5535 | f 541.389.8033

**20805 Cooley Road  
Bend, Oregon 97701**

JOB NUMBER:	1708
DRAWN BY:	EVK
CHECKED BY:	JVB

SHEET TITLE

PLUMBING  
FLOOR PLAN

# P1.2