




## SIGNAL SYMBOLS

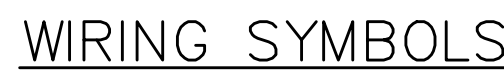


## FIRE ALARM SYMBOLS

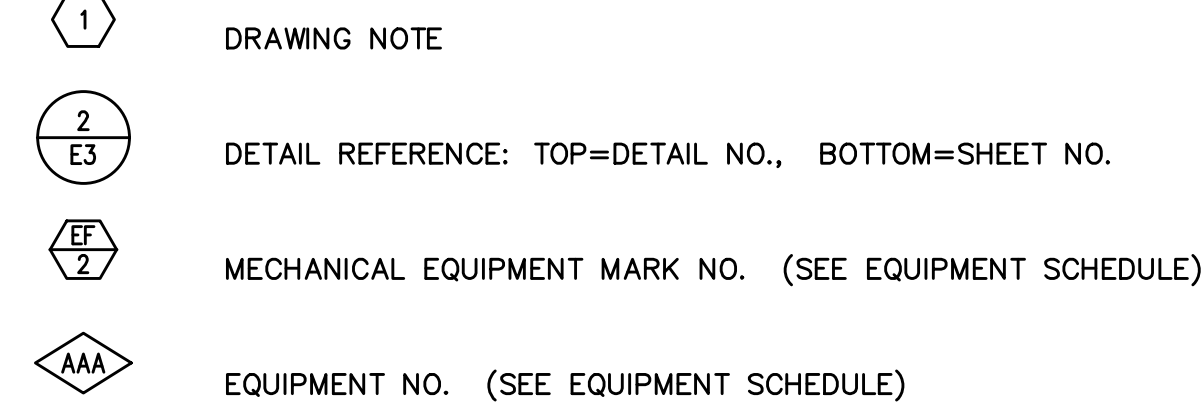


## SECURITY SYMBOLS

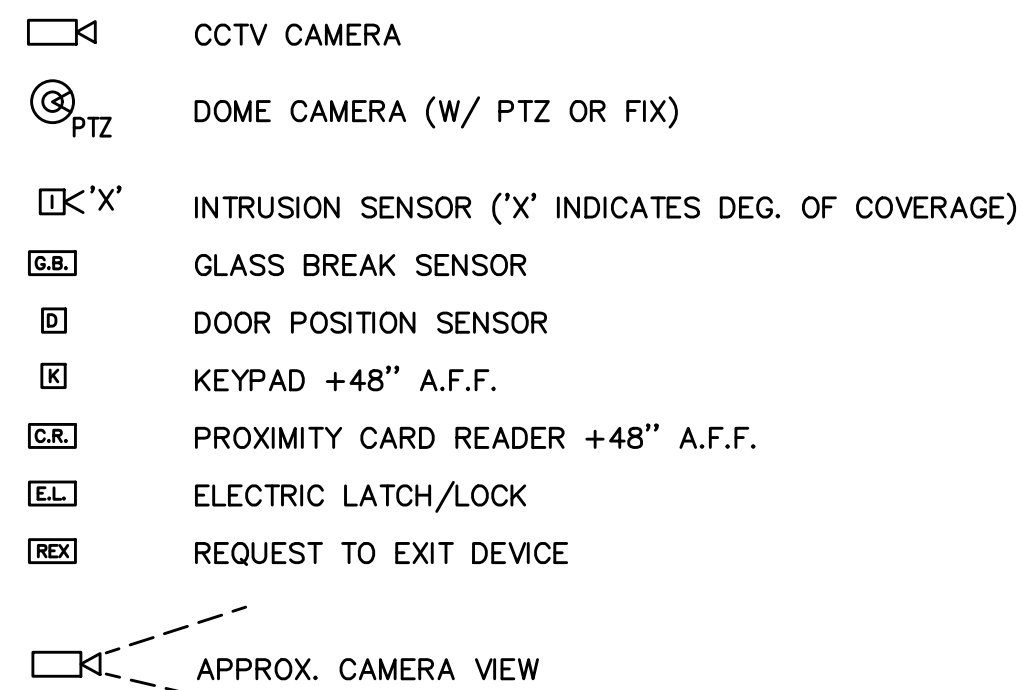

## PAGING AND INTERCOM SYMBOLS

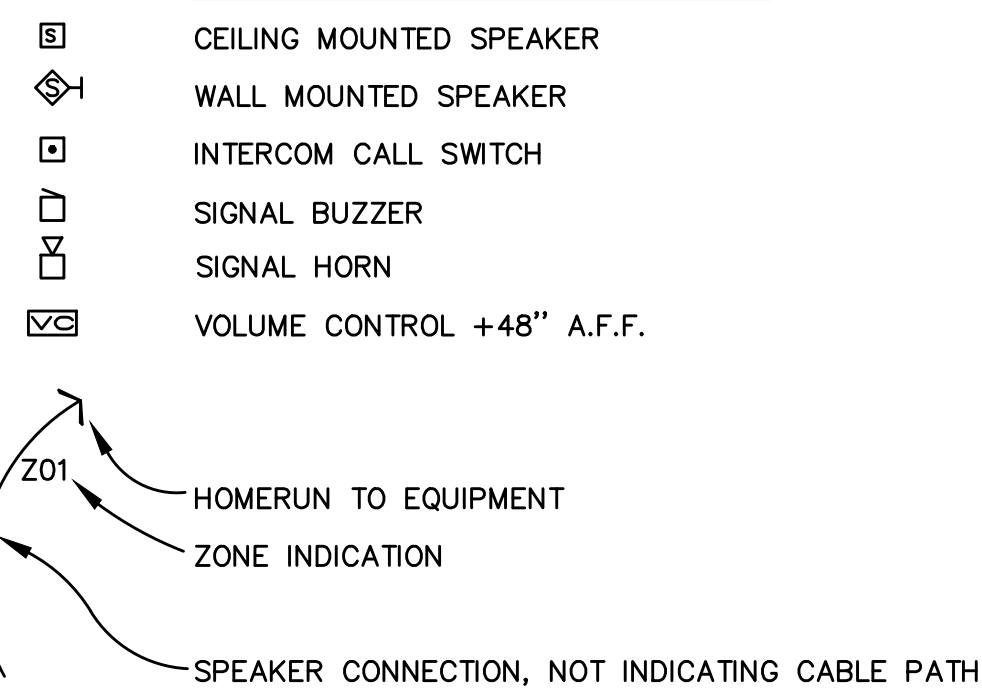

## ABBREVIATIONS

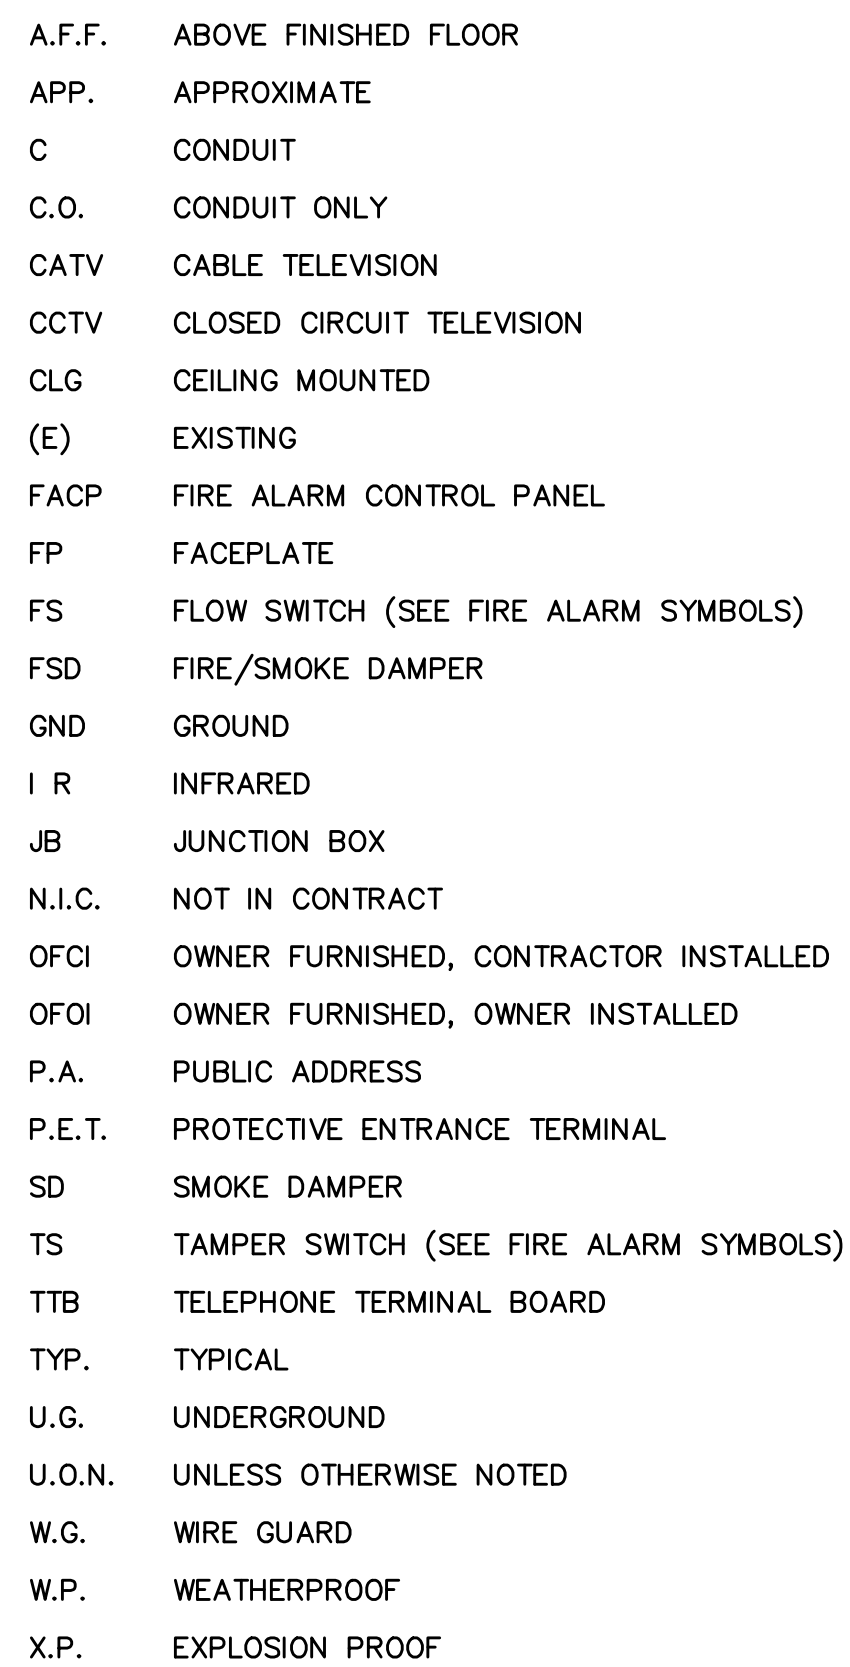

RECORD DRAWING:

THIS DRAWING HAS BEEN UPDATED TO REFLECT CHANGES MADE DURING CONSTRUCTION BASED UPON INFORMATION FURNISHED TO THE ENGINEER BY THE INSTALLATION CONTRACTOR. NO WARRANTY EITHER EXPLICIT OR IMPLIED IS GIVEN BY MFIA, INC. AS TO THE ACCURACY AND/OR COMPLETENESS OF THIS INFORMATION.

**BBT**

**A R C H I T E C T S**

1160 sw Simpson Ave. - Suite 100 - Bend, Oregon 97702  
t 541.382.5535 f 541.389.8033

# Bend-La Pine Schools SECURITY UPGRADES Ponderosa Elementary School

**3790 NE Purcell Blvd  
Bend, Oregon 97701**

ISSUED:	DATE:
PERMIT SET / BID SET	02/14/18
CONFORMANCE SET	03/28/18
APR-05	05/15/18
APR-11	06/08/18
AS-BUILT	09/04/18

JOB NUMBER:	1708
DRAWN BY:	GMA
CHECKED BY:	RLC

SHEET TITLE

## TELCOM SYMBOL LIST

SHEET NUMBER

# T0.0