


NTS



NTS

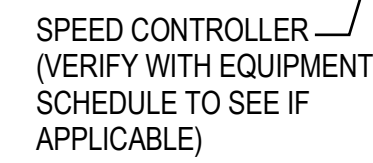

NTS



NTS



NT:



NTS



Domestic dryer models

BEST PERFORMANCE			
Maximum length of 4" dia rigid metal duct			
Exhaust hood type			
	Number of 90° turns	A 4" opening	B 2-1/2" opening
Domestic dryer models	0	200 ft.	175 ft.
	1	185 ft.	165 ft.
	2	175 ft.	155 ft.
	3	165 ft.	145 ft.
	4	155 ft.	135 ft.
	5	145 ft.	125 ft.

14 DRYER VENTING CHART