

- GENERAL NOTES:**
- OVERHEAD SERVICE CONDUCTORS AT POINT OF ATTACHMENT SHALL HAVE MINIMUM VERTICAL CLEARANCE OF 10 FEET ABOVE FINISHED FLOOR PER NEC 230.24 (B)(1).
 - REPLACE EXISTING EXTERIOR WALL PACK WITH NEW FIXTURE TYPE SHOWN. FIXTURES TO BE RE-CIRCUITED VIA PHOTO CELL FOR DUSK-TO-DAWN OPERATION. PROVIDE UN-SWITCHED CIRCUIT FOR BATTERY PACK. REFER TO E2.1 AND ELECTRICAL SCHEDULE.


RECORD DRAWING:
 THIS DRAWING HAS BEEN UPDATED TO REFLECT CHANGES MADE DURING CONSTRUCTION BASED UPON INFORMATION FURNISHED TO THE ENGINEER BY THE INSTALLATION CONTRACTOR. NO WARRANTY, EITHER EXPRESSED OR IMPLIED, IS GIVEN BY THE ENGINEER AS TO THE ACCURACY AND/OR COMPLETENESS OF THIS INFORMATION.

AS-BUILT PREPARED 1.22.2020


- SHEET NOTES:**
- PROVIDE LEVELED GROUND WORKING SPACE CLEARANCE PER PGE REQUIREMENT. SEE E3.4.
 - PROVIDE A PANEL SECURELY ATTACHED TO TRASH CAN ENCLOSURE METAL COLUMN AT 8 FEET ABOVE FINISHED FLOOR. MOUNT FIXTURE TO THE PANEL OVER THE FENCE. SEE DETAIL 2&3/E0.1.
 - MOUNT FIXTURE CLOSER TO EDGE.
 - PROVIDE MOUNTING TO FENCE AS HIGH AS POSSIBLE.
 - MOUNT AND ANGLE THE FIXTURE TO GET LIGHT BEAM FALLS ON GENERAL AREA SHOWN. FIXTURE SHALL BE WIRED TO DUSK TO DAWN CIRCUIT WITH INDIVIDUAL MOTION SENSOR CONTROLLED DIMMING.
 - MOUNT FIXTURE TO ROOF RAFTER. FIXTURE SHALL BE WIRED TO DUSK TO DAWN CIRCUIT WITH INDIVIDUAL MOTION SENSOR CONTROLLED DIMMING.
 - PROVIDE VANDAL GUARD.
 - PROVIDE BACK PANEL ATTACHED TO ROOF RAFTERS OR TRUSSES FOR MOUNTING CLOSE TO WINDOW PANE.

1
 E0.1
 ELECTRICAL SITE PLAN
 SCALE: 3/32" = 1'-0"

LEGEND:
 AHAP = AS HIGH AS POSSIBLE

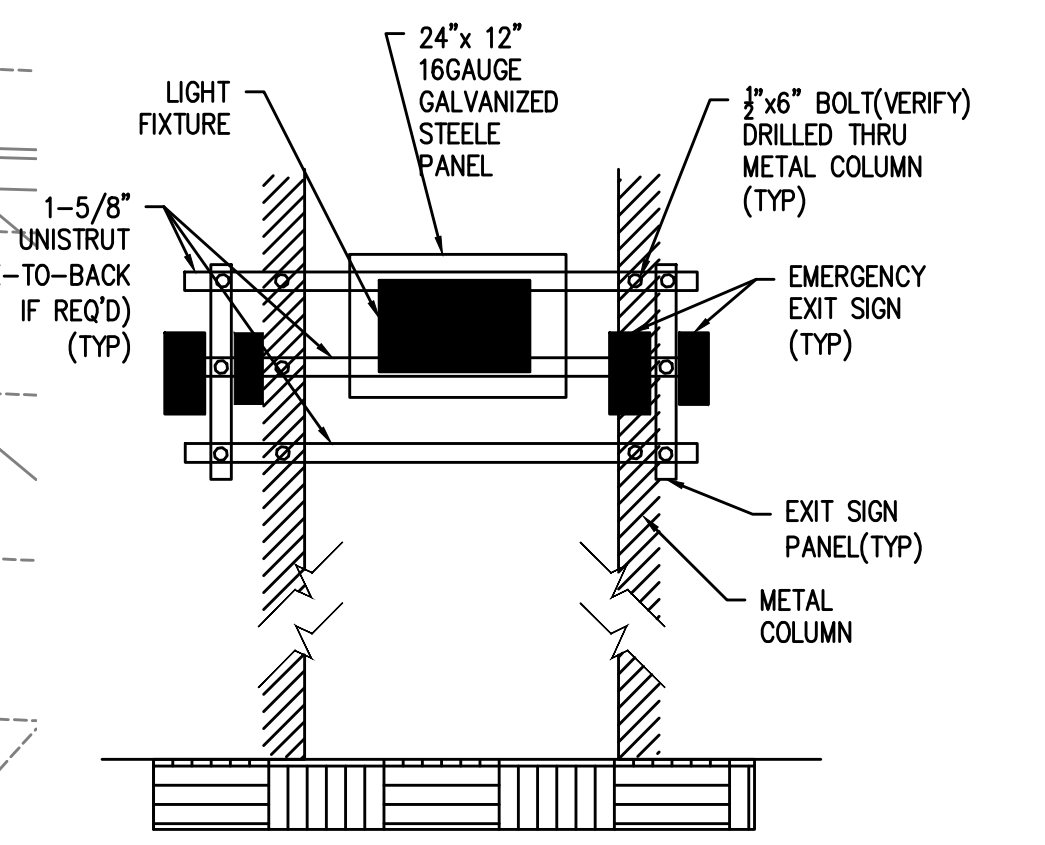

2
 E0.1
 FIXTURE MOUNTING DETAIL
 SCALE: NTS

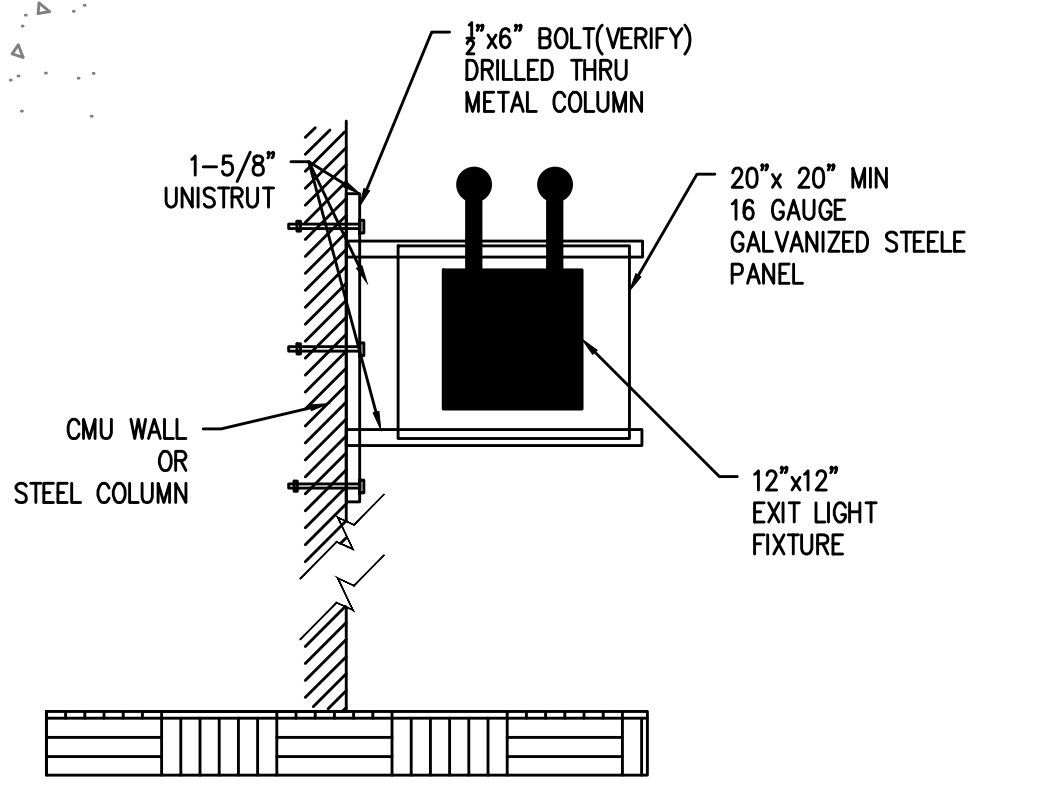

3
 E0.1
 EXIT SIGN MOUNTING DETAIL
 SCALE: NTS

FOSTER SHELTER
 6144 SE FOSTER RD, PORTLAND, OREGON 97206
 CLIENT: MULTNOMAH COUNTY



PROJECT NO.	ISSUE DATE
17-0918	05.04.2018
REVISIONS	CHECKSHEET 5.23.2018
	OWNER CHANGES 2.26.2019

SHEET
 ELECTRICAL
 SITE PLAN
E0.1
 PERMIT SET
 © MERRYMAN BARNES ARCHITECTS, INC.