


DON'T DRAW DOTTED LINE

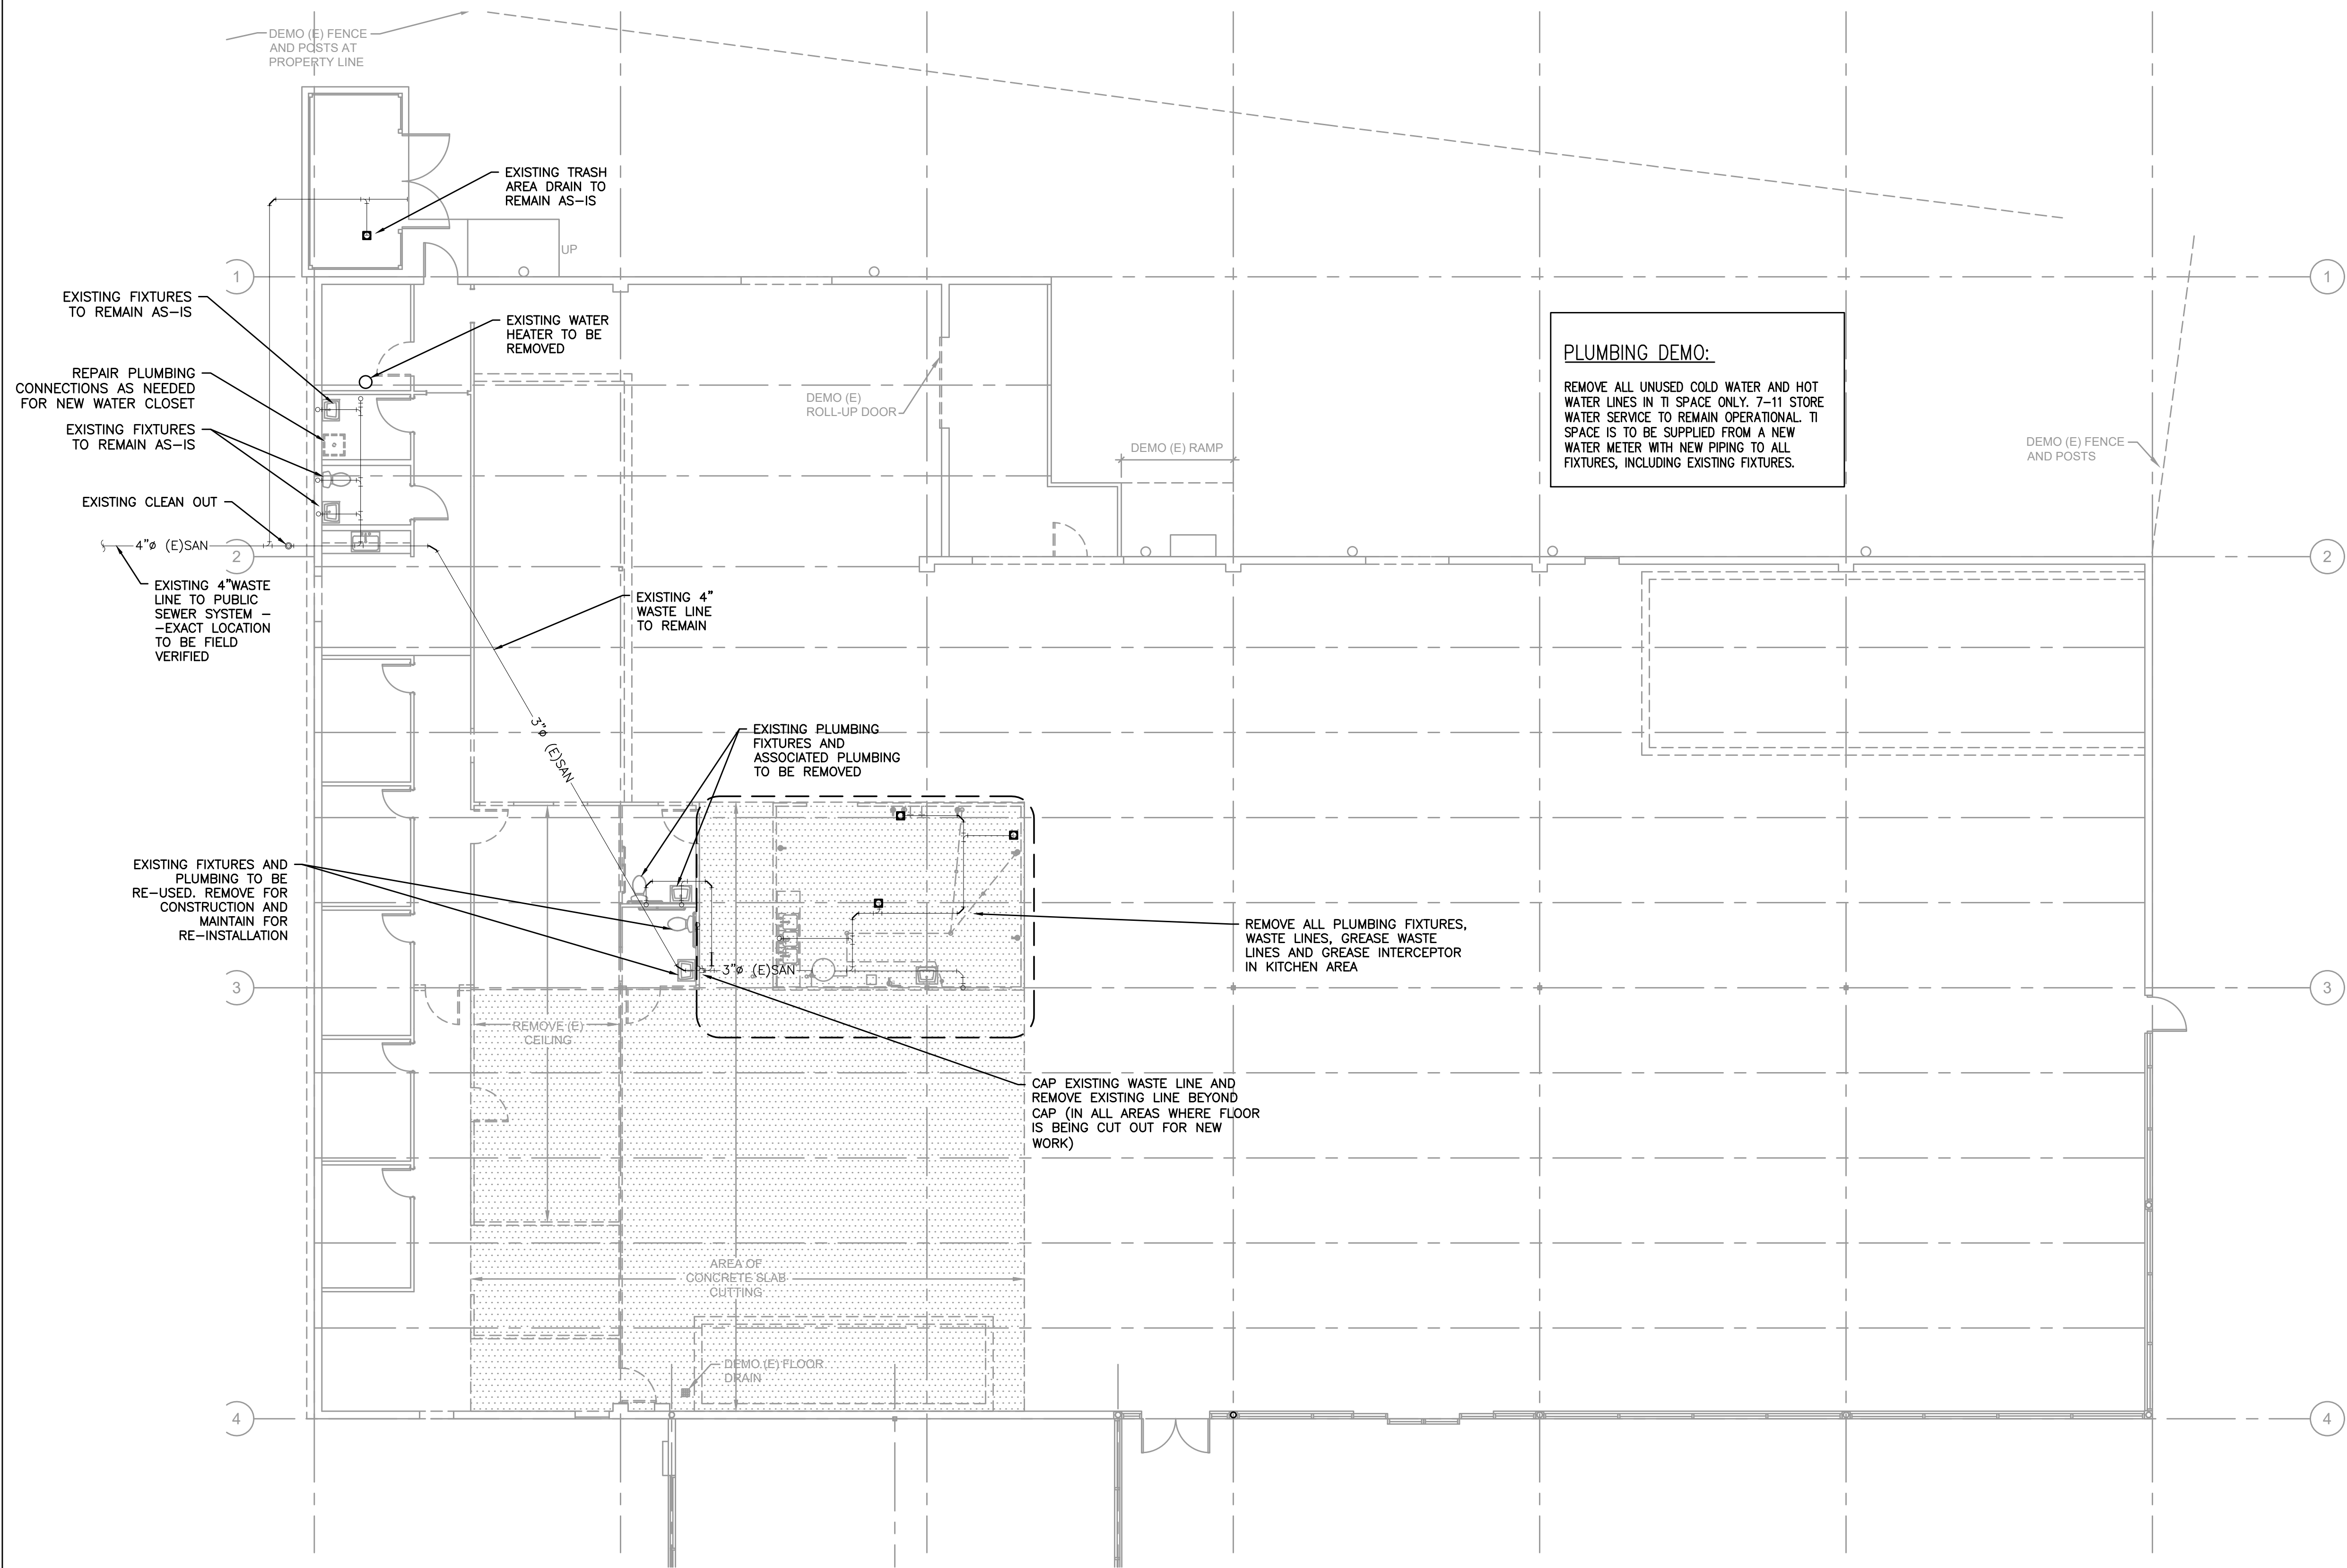

DON'T DRAW PAST LINE

DON'T DRAW PAST LINE

RECORD DRAWING:
 THIS DRAWING HAS BEEN UPDATED TO REFLECT CHANGES MADE TO THE ORIGINAL CONSTRUCTION PERMIT. THIS INFORMATION IS FOR THE ENGINEER'S USE ONLY. THE INSTALLATION CONTRACTOR SHALL BE RESPONSIBLE FOR VERIFYING THE ACCURACY AND/OR COMPLETENESS OF THIS INFORMATION.

AS-BUILT PREPARED 1.22.2020

FOSTER SHELTER
 6144 SE FOSTER RD., PORTLAND, OREGON 97206
 CLIENT: MULTNOMAH COUNTY

MBA MERRIMAN BARNES ARCHITECTS 4713 N ALBINA AVE. SUITE 304 PORTLAND, OREGON 97217 P-503.222.2753

PROJECT NO.	ISSUE DATE
17-0918	05.04.2018
REVISIONS	
△ CHECKSHEET 5.23.2018	
△ OWNER CHANGES 2.26.2019	

SHEET

PLUMBING
 EXISTING FLOOR PLAN
P1.0
 PERMIT SET
 © MERRIMAN BARNES ARCHITECTS, INC.

1 PLUMBING DEMO PLAN
 P1.0 SCALE: 1/8"=1'-0"