


DON'T DRAW DOTTED LINE

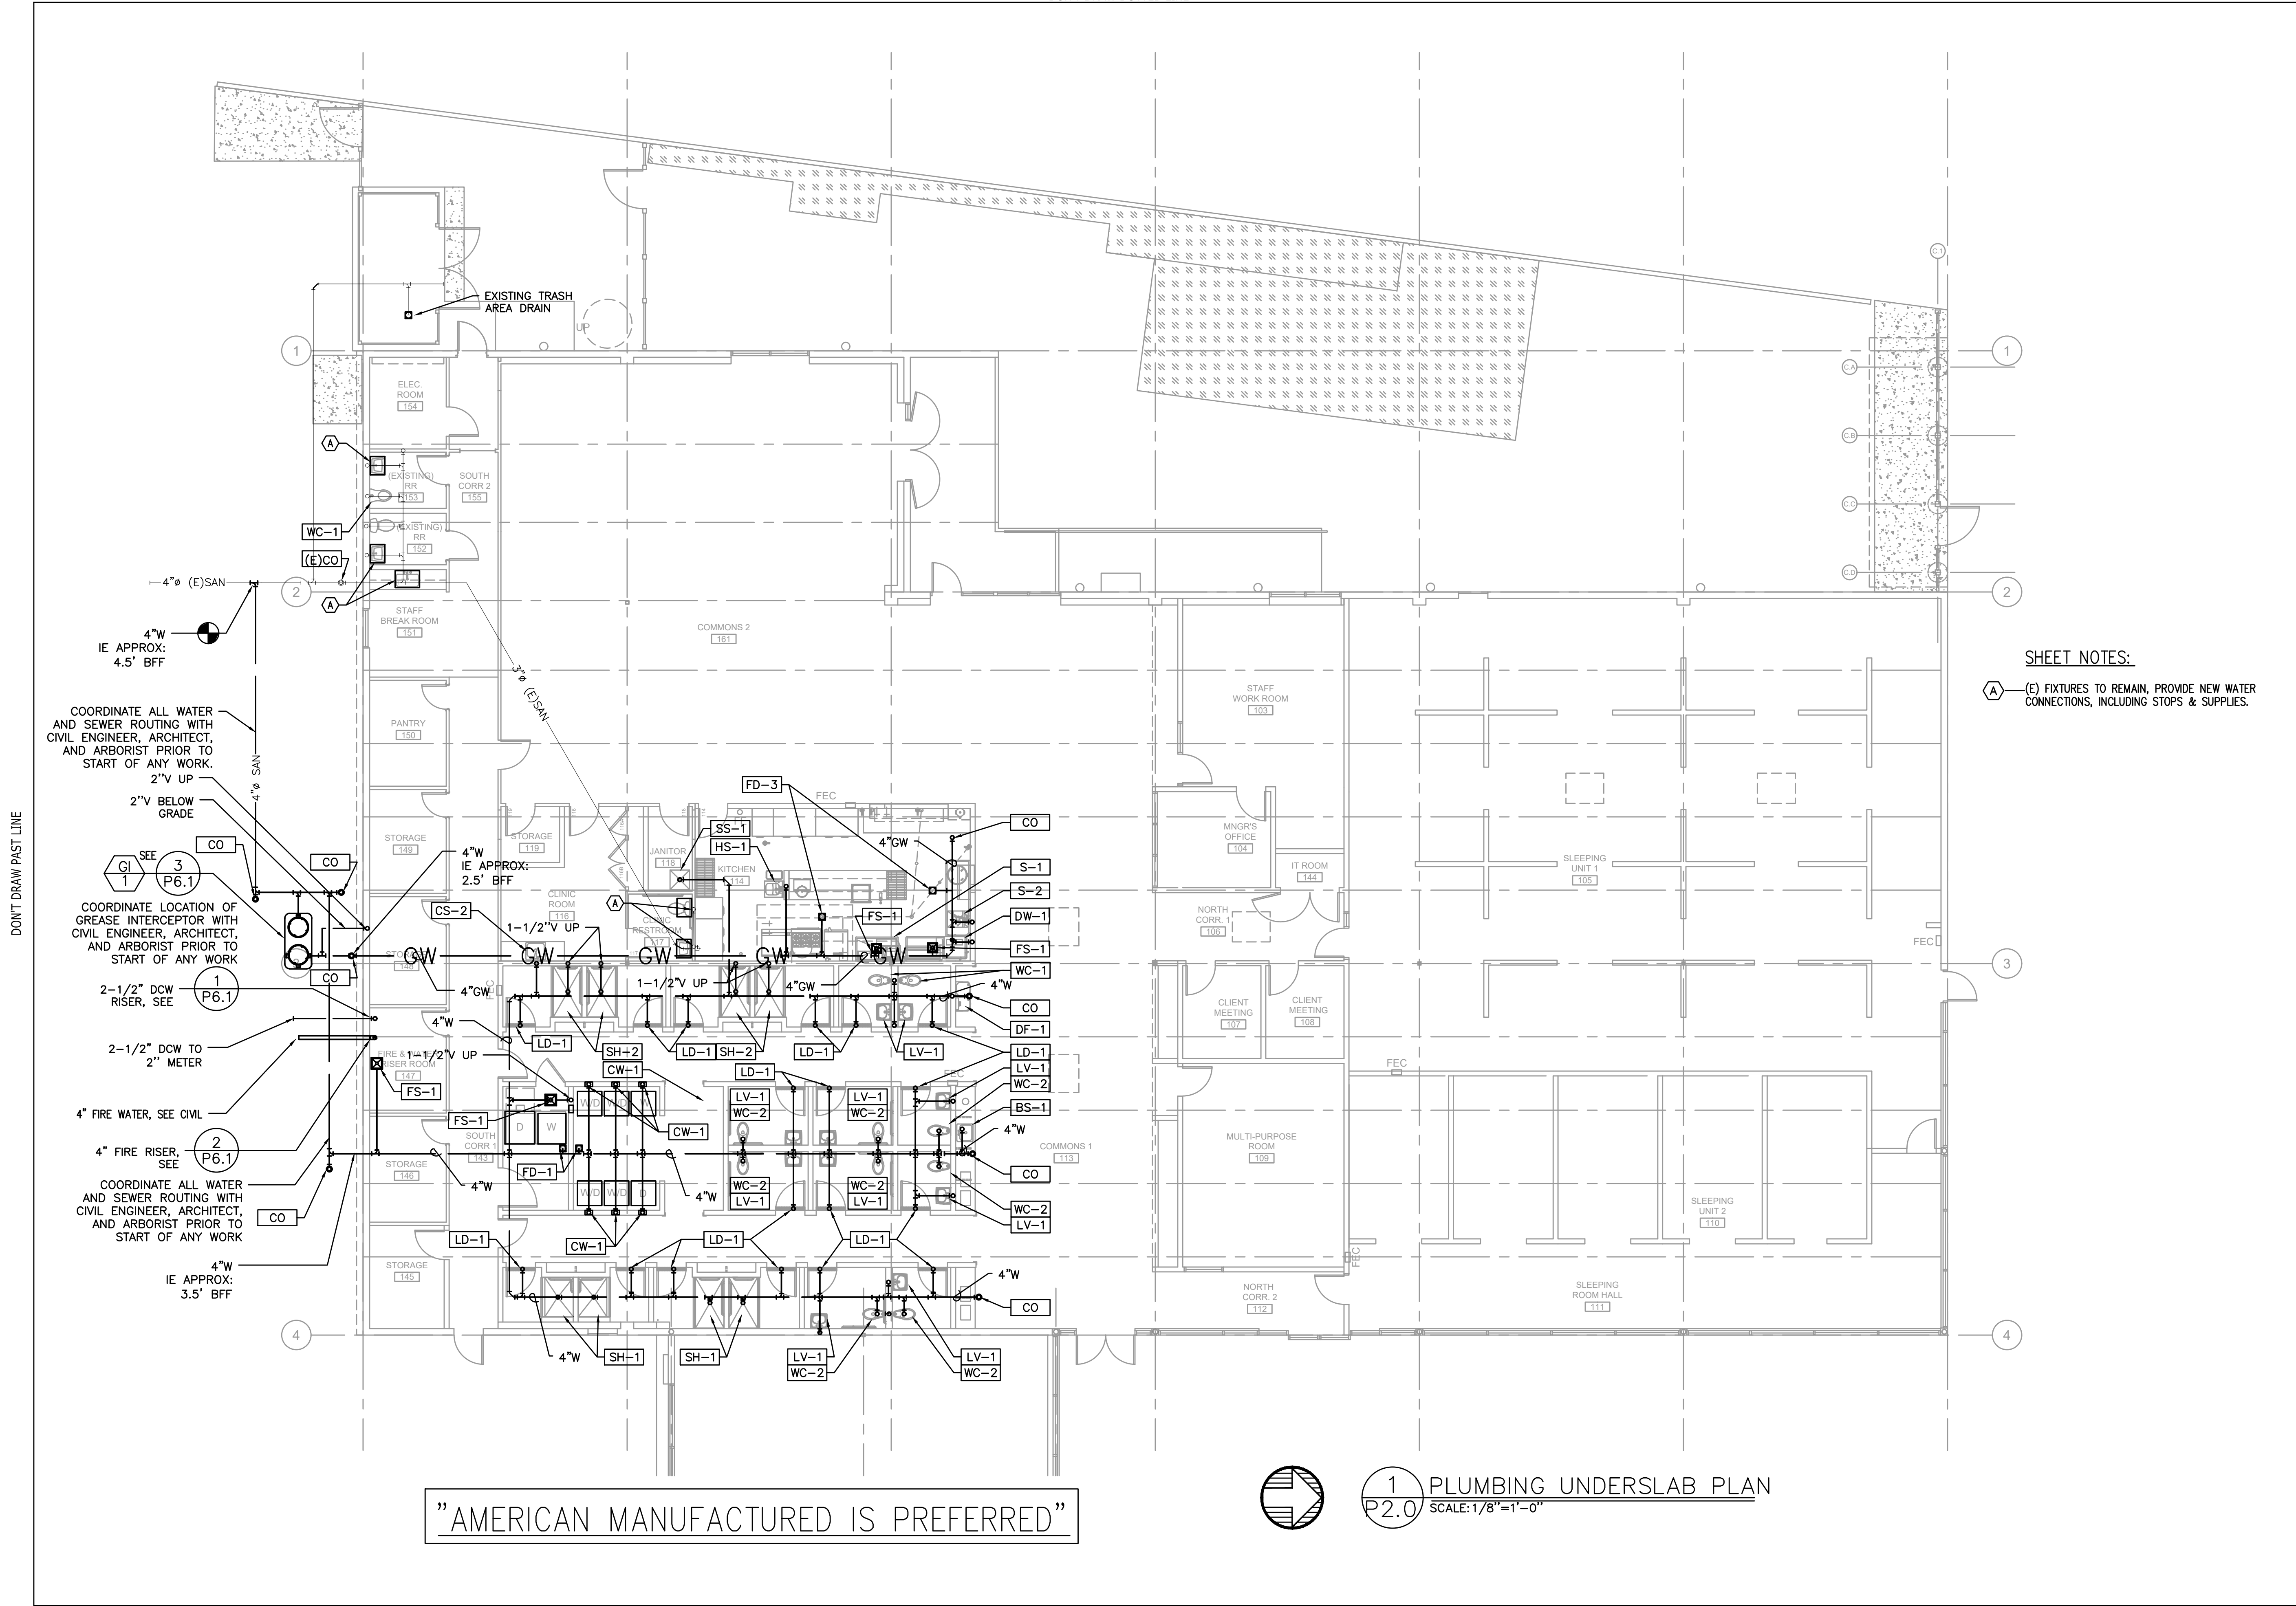


**RECORD DRAWING:**  
 THIS DRAWING HAS BEEN UPDATED TO REFLECT CHANGES MADE TO THE CONSTRUCTION PERMIT UPON INFORMATION FURNISHED TO THE ENGINEER BY THE INSTALLATION CONTRACTOR. NO WARRANTY EITHER EXPLICIT OR IMPLIED IS GIVEN BY MEA, INC. AS TO THE ACCURACY AND/OR COMPLETENESS OF THIS INFORMATION.

AS-BUILT PREPARED 1.22.2020

PROJECT NO. 17-0918  
 ISSUE DATE 05.04.2018  
 REVISIONS  
 CHECKSHEET 5.23.2018  
 OWNER CHANGES 2.26.2019


**FOSTER SHELTER**  
 6144 SE FOSTER RD., PORTLAND, OREGON 97206  
 CLIENT: MULTNOMAH COUNTY

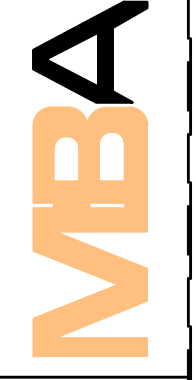

PROJECT NO.	ISSUE DATE
17-0918	05.04.2018
REVISIONS	
△ CHECKSHEET 5.23.2018	
△ OWNER CHANGES 2.26.2019	
SHEET	

PLUMBING  
 UNDERSLAB PLAN  
**P2.0**  
 PERMIT SET  
 © MERRYMAN BARNES ARCHITECTS, INC.

"AMERICAN MANUFACTURED IS PREFERRED"

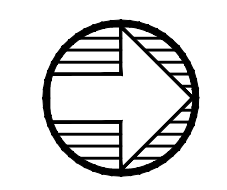

**1** PLUMBING UNDERSLAB PLAN  
 P2.0 SCALE: 1/8" = 1'-0"

DON'T DRAW PAST LINE

22 X 34 SHEET