

phase | RECORD DRAWING


date | 11/09/2015

revisions |


project # | 11082

LEVEL 1 SECTOR 'E'
MECHANICAL PLAN

M2.15

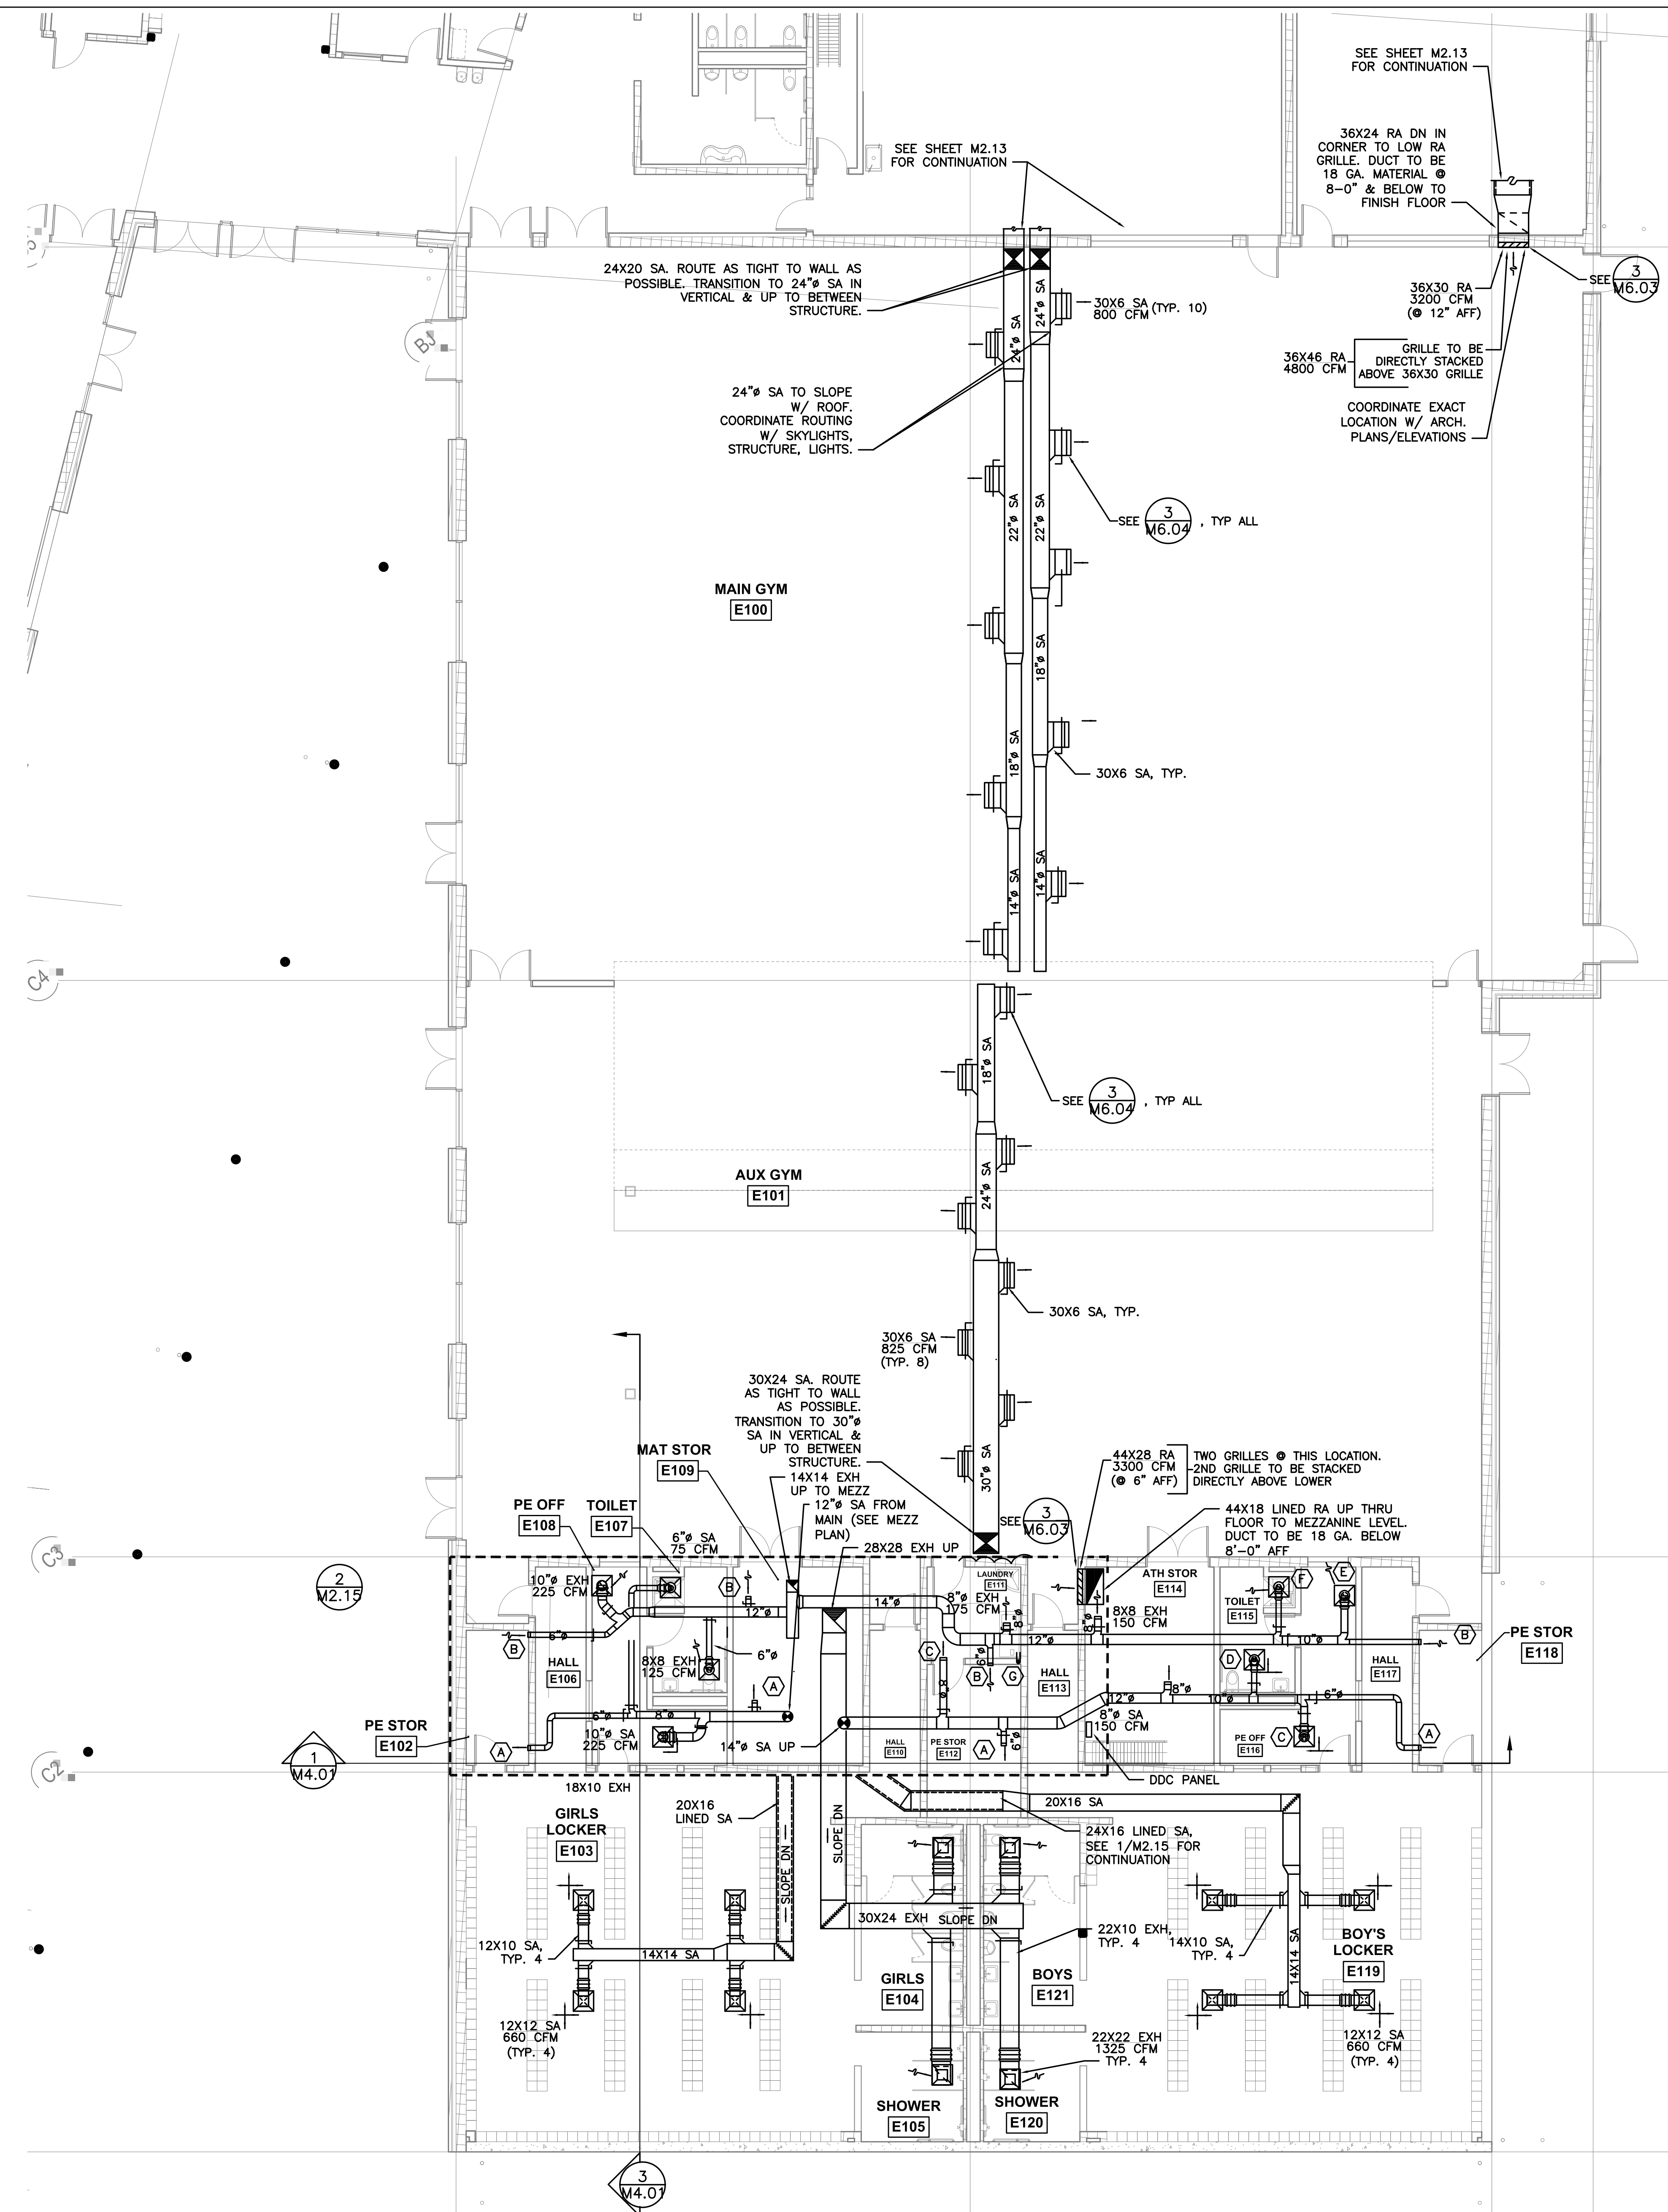

1 LEVEL 1 SECTOR 'E' MECHANICAL PLAN
SCALE: 1/8"=1'-0"

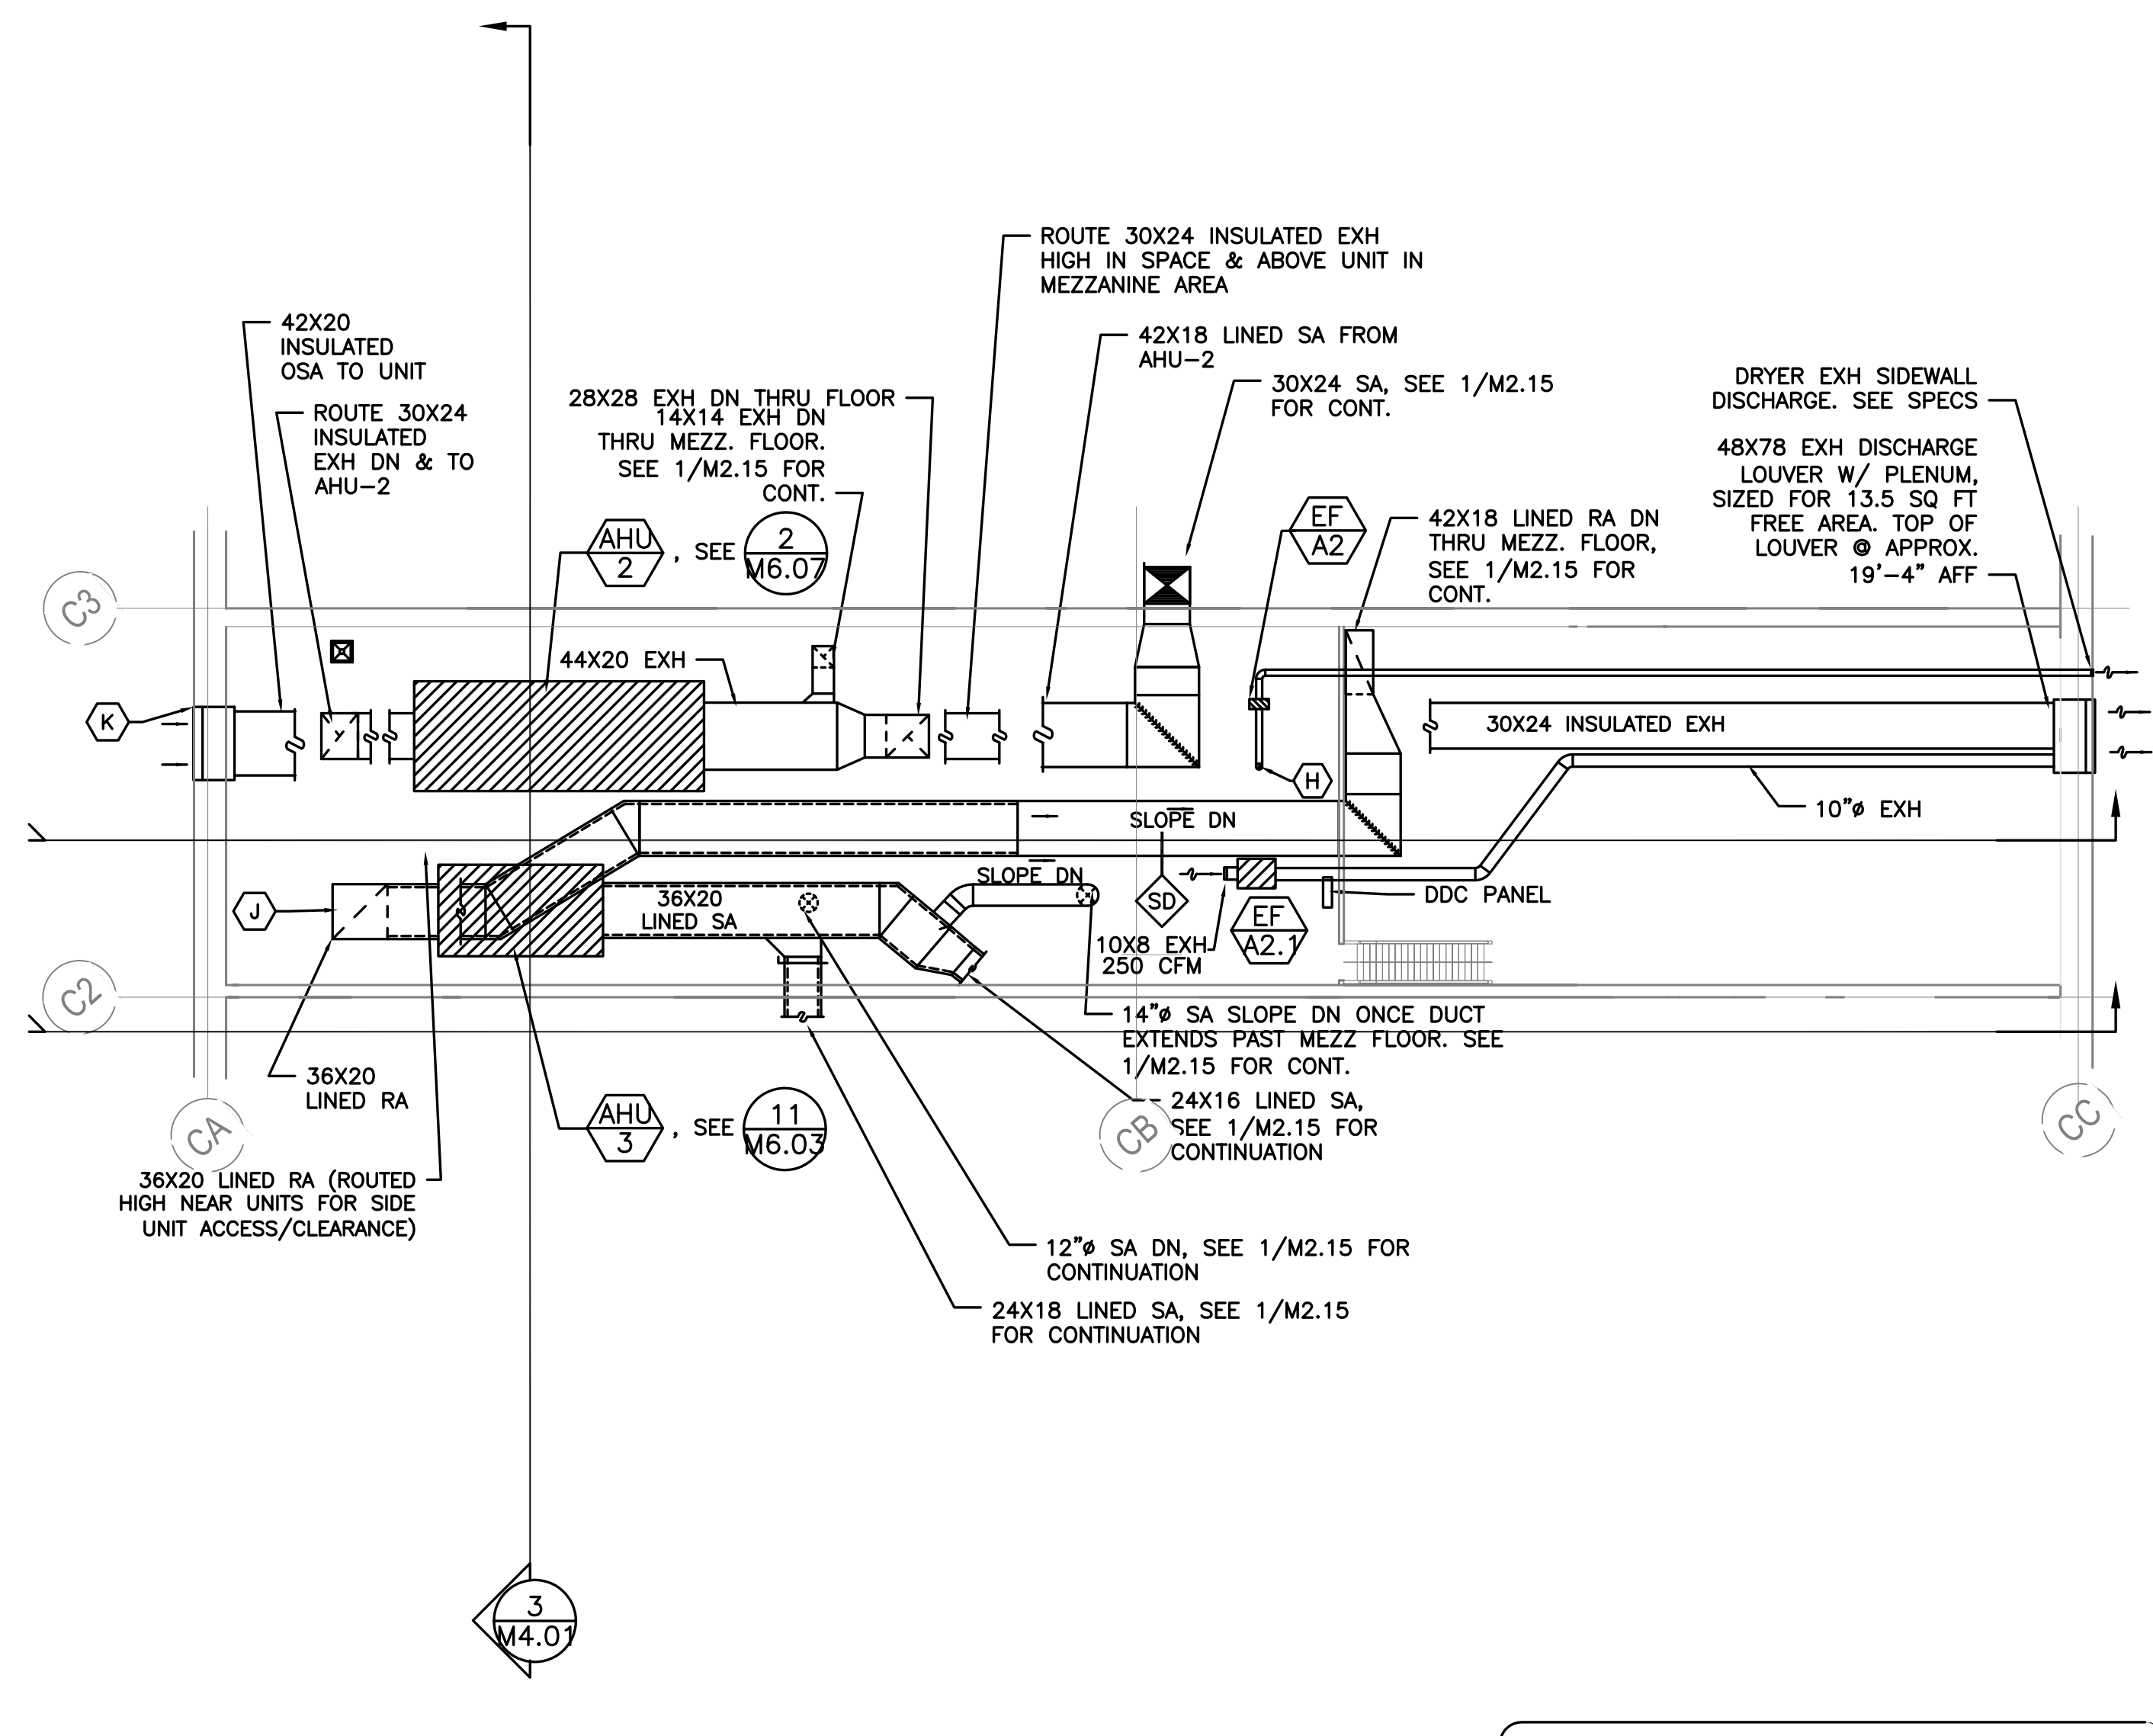

2 SECTOR 'E' MEZZANINE PLAN
SCALE: 1/8"=1'-0"

- M2.15 SHEET NOTES:**
- (A) - 6X6 SA 100 CFM
 - (B) - 6X6 EXH 100 CFM
 - (C) - 8X6 SA 175 CFM
 - (D) - 6X8 SA 95 CFM
 - (E) - 8X8 EXH 200 CFM
 - (F) - 8X6 EXH 125 CFM
 - (G) - 4" DRYER DUCT UP IN WALL TO EXHAUST FAN @ MEZZANINE
 - (H) - 4" DRYER DUCT UP THRU ROOF TO VENT. SEE ROOF PLAN
 - (I) - NOT USED
 - (J) - TRANSITION RA FROM HIGH IN SPACE DN TO ELEVATION FOR CONNECTION TO AHU-3.
 - (K) - 48X78 OSA INTAKE LOUVER W/ PLENUM, SIZED FOR 13.5 SQ FT FREE AREA. TOP BOTTOM OF LOUVER @ APPROX 20'-6" AFF.
 - (L) - 16X16 TRANSFER GRILLE (BOTH SIDES) FOR AIR TRANSFER FROM GYM TO MEZZANINE SPACE

- GENERAL NOTES**
- SEE DETAIL 10/M6.03 FOR NON-SEISMIC DUCT SUPPORT
 - SEE DETAIL 8/M6.05 FOR SEISMIC DUCT SUPPORT (SEE SPECS FOR DESIGN REQUIREMENT)
 - PAINT ALL EXPOSED DUCTS. SEE ARCHITECT FOR COLOR
 - SEE ARCHITECTURAL DRAWINGS FOR ACOUSTICALLY IMPORTANT WALLS (WALL TYPES). SEAL PENETRATIONS IN THOSE WALLS PER DETAIL 10/M6.04

RECORD DRAWING:
THIS DRAWING HAS BEEN UPDATED TO REFLECT CHANGES MADE DURING CONSTRUCTION BASED UPON INFORMATION FURNISHED TO THE ENGINEER BY THE INSTALLATION CONTRACTOR. NO WARRANTY EITHER EXPLICIT OR IMPLIED IS GIVEN BY MFA, INC. AS TO THE ACCURACY AND/OR COMPLETENESS OF THIS INFORMATION.

g:\dowa_architects\6470_parkrose_middle_school\m2\record\record.dwg 11/09/2015 8:09 AM