




308 SW First Avenue  
Suite 200  
Portland, OR 97204  
Phone: (503) 226-2840  
Fax: (503) 226-2807  
leebarc.com

Leeb Architects

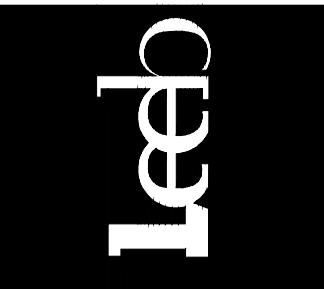


Consulting Engineers  
2007 S.E. Ash St.  
Portland, OR 97214  
PH: (503) 234-0548  
FAX: (503) 234-0877  
INC. WWW.MPIA-ENG.COM  
CONTACT: MARK DENYER

Project Title: MODERA WOODSTOCK APARTMENTS  
MILL CREEK RESIDENTIAL  
2200 NW 2ND AVENUE SUITE 900  
PORTLAND, OR 97209

Drawing Title:	MECH PLAN - BASEMENT
Date:	12.20.19
Revision:	4.29.20 - ADD #2 Permit Checksheet Response #2
Drawn by:	MFA/Jacobs
Project No.:	AS107.9.17.20 - Plan Check / CMP
	AS110 - 9.16.22 Construction Set Revisions

M02.00

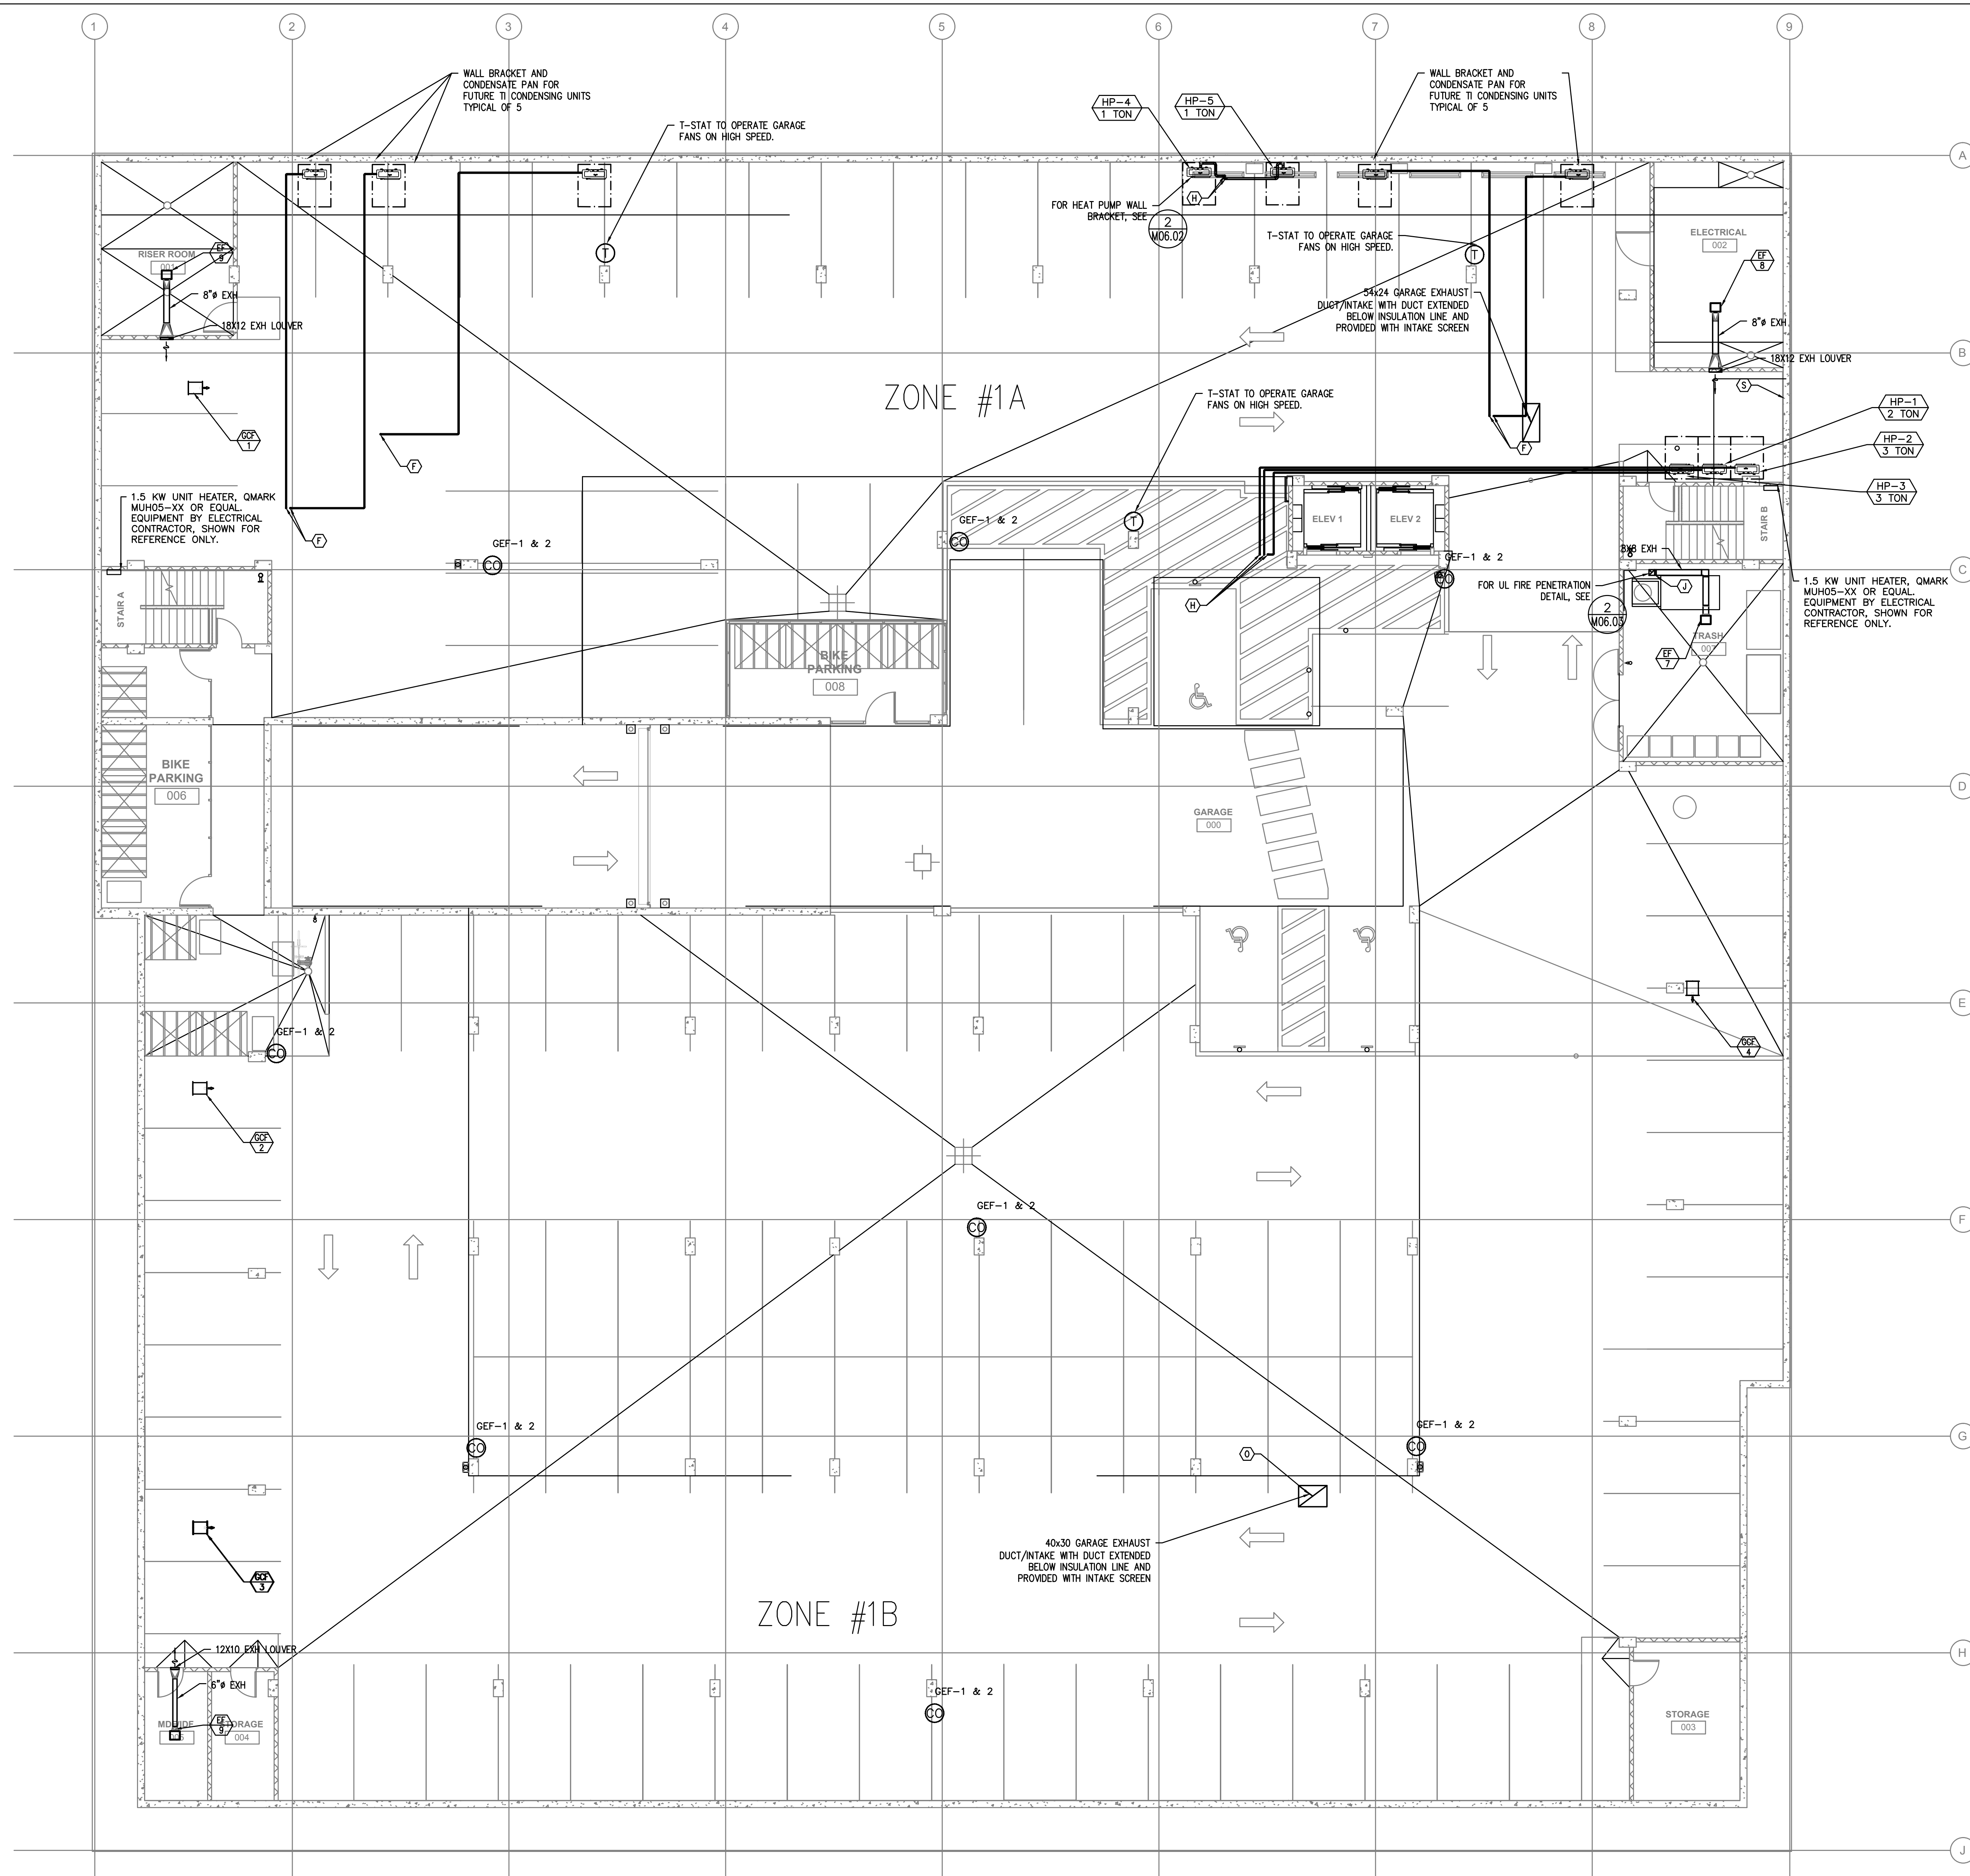

GENERAL NOTES:

- (A) SUPPLY DUCT FROM ROOF TO 2ND FLOOR CEILING - TRANSITION TO SMALLER DUCT SIZES AFTER SUPPLY BRANCH TAKE OFF, SEE CHART.
- (B) SUPPLY AIR OR RETURN GRILLE, SIZED FOR BOTH FREE AREA AND FOR ACTUATOR ACCESS, SEE (1) FOR GRILLE INSTALLATION, AND SEE (2) FOR TYPICAL F/S INSTALLATION. (M06.01)
- (C) 44X32 & 51X32 (SHOWN IN ARCH) INTAKE AND EXHAUST GRILLES FOR FUTURE TI SPACES, LOUVERS TO BE CAPPED AT INTERIOR FOR FUTURE CONNECTIONS - COORDINATE WITH SOFFIT/STORE FRONT SYSTEM. (M06.01)
- (D) 4" DRYER EXHAUST-ROUTED SIDEWALL, SEE (8) (M06.01)
- (E) TYPICAL DRYER DUCT TO BE CONSTRUCTED AS FOLLOWS: MATERIAL SHALL HAVE A SMOOTH INTERIOR FINISH AND 0.016 INCH THICK. RIVETS OR SCREWS PENETRATING THE DUCT WALL ARE NOT ACCEPTABLE. DRYER DUCT SHALL BE SUPPORTED EVERY 4 FOOT INTERVAL.
- (F) REFRIGERANT LINES CAPPED AND SEALED FOR FUTURE TI CONNECTION. ROUTED FROM 1ST FLOOR CEILING SPACE TO WALL BRACKET FOR FUTURE CONDENSING UNIT.
- (G) 10" OUTSIDE AIR TO FAN COIL, PROVIDE WITH 2-POSITION DAMPER TO OPEN WHENEVER FAN COIL OPERATES. DAMPER TO BE A LOW LEAK CLASS 1 DAMPER.
- (H) REFRIGERANT LINES ROUTED FROM PARKING GARAGE TO 1ST FLOOR FAN COILS.
- (I) 20X20 GREASE EXHAUST (WITH FIRE WRAP IN 30X30 SHAFT) ROUTED FROM ROOF (CAPPED) TO TI SPACE (CAPPED FOR FUTURE TI). PROVIDE VENTED CURB ADAPTER AND CAP FOR FUTURE GREASE EXHAUST FAN.
- (J) FOUR 4" & 8X8 TRASH EXHAUST UP TO ROOF DOG HOUSE.
- (K) DWELLING UNIT BATHROOM EXHAUST FAN TO BE SUPPLIED AND INSTALLED BY MECHANICAL CONTRACTOR. MECHANICAL TO PROVIDE VENTING FROM FAN TO SIDE WALL DISCHARGE. (M06.01) (EF 1)
- (L) 6" RANGE HOOD EXHAUST ROUTED FROM RANGE TO EXTERIOR WALL, KEEP DUCT AS HIGH IN SPACE AS POSSIBLE, AND TERMINATE WITH A SIDE WALL VENT, WITH A BACKDRAFT DAMPER. INSULATE FINAL 5' OF DUCTWORK.
- (M) PTHP DETAIL, SEE (M06.01)
- (N) EXTERIOR EXHAUST PLENUM, SEE (5) (M06.01)
- (O) 54X24 OR 40X30 GARAGE EXHAUSTS UP FROM GARAGE, THROUGH PT AND UP THROUGH ROOF.
- (P) 8X8 BASEMENT TRASH EXHAUST, TRANSITION TO 10" INTO GREENHECK GRSR WITH 10" THROAT.
- (Q) 4" BATH EXHAUST FROM 1ST LEVEL TO CONNECT INTO 6" BATH EXHAUST FROM 2ND LEVEL LOFT TO SIDEWALL PLENUM.
- (R) VENT TYPE-2 RANGE HOOD TO SIDE WALL TERMINATION.
- (S) 4" BATH EXHAUST & DRYER AND 6" RANGE VENT UP TO LEVEL 2.

SEQUENCE OF OPERATIONS CO & NO2 SENSORS:

PROVIDE A COMBINATION ELECTROCHEMICAL CARBON MONOXIDE & NITROGEN DIOXIDE SENSOR (SYSTEM) TO OPERATE GEF-1 & 2 (VFD HIGH SPEED SETTING) AND GEF 1, 2 & 3 WHENEVER SPACE CO & NO2 LEVELS RISE ABOVE SET POINT. SYSTEM TO BE SET TO FAIL WITH THE FAN (S) IN THE "HIGH SPEED" SETTING. SET SENSORS AT 60" AFF. PROVIDE 8 SENSOR(S) AS SHOWN ON THE PLAN, AND WIRE TO A CENTRAL CONTROLLER TO OPERATE GEF-1&2 AND GEF 1, 2 & 3 ON HIGH SPEED WHENEVER ANY SENSOR(S) CALLS FOR OPERATION. SENSORS TO BE RATED FOR MIN 50' RADIUS.

- GEF-1 & 2 TO OPERATE CONTINUOUSLY AT LOW SPEED VFD SET POINT.
- RISING TRIP POINT - ENGAGE VFD HIGH SPEED WHEN CO LEVELS RISE ABOVE 35 PPM AND NO2 LEVELS RISE ABOVE 2.0 PPM.
- FALLING TRIP POINT - DISENGAGE VFD HIGH SPEED WHEN CO LEVELS DROP TO 15 PPM AND NO2 LEVELS DROP TO 1.0 PPM.
- PROVIDE WITH AUDIBLE ALARM WHEN CO LEVELS RISE ABOVE 50 PPM AND NO2 LEVELS RISE ABOVE 2.8 PPM.

GARAGE EXHAUST CALCULATIONS:

**Zone #1A - Basement North**  
 16,577 sq ft x 0.05 cfm/sq ft = 828 CFM  
 16,577 sq ft x 0.75 cfm/sq ft = 12,432 CFM  
 54X24 EXH DUCT  
 ONE FAN (13,000 CFM) 2-SPEED VFD

**Zone #1B - Basement South**  
 16,577 sq ft X 0.05 cfm/sq ft = 828 CFM  
 16,577 sq ft X 0.75 cfm/sq ft = 12,432 CFM  
 54X24 EXH DUCT  
 ONE FAN (13,000 CFM) 2-SPEED VFD


MECH PLAN - BASEMENT SCALE: 1/8" = 1'-0"





308 SW First Avenue  
Suite 200  
Portland, OR 97204  
Phone: (503) 226-2840  
Fax: (503) 226-2807  
leebarc.com

Leeb Architects

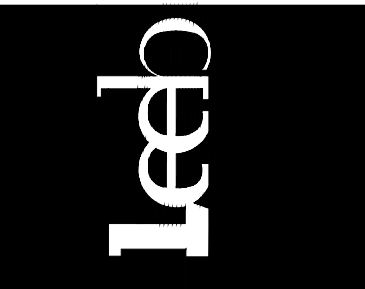

Consulting Engineers  
2007 S.E. Ash St.  
Portland, OR 97214  
PH: (503) 234-0844  
FAX: (503) 234-0877  
WWW.MFIA-ENG.COM  
CONTACT: MARK DEVITA


Project Title: MODERA WOODSTOCK APARTMENTS  
MILL CREEK RESIDENTIAL  
2200 NW 2ND AVENUE SUITE 900  
PORTLAND, OR 97209

Revision:  
4.29.20 - ADD #2 Permit Checklist Response #2  
AS 07.9.17.20 - Plan Check / CMP  
AS 10.9.16.22 Construction Set Revisions

Date: 12.20.19  
Drawn by: MFJ/leeb  
Project No.: A19-20

Drawing Title: MECH PLAN - LEVEL 1

M02.01

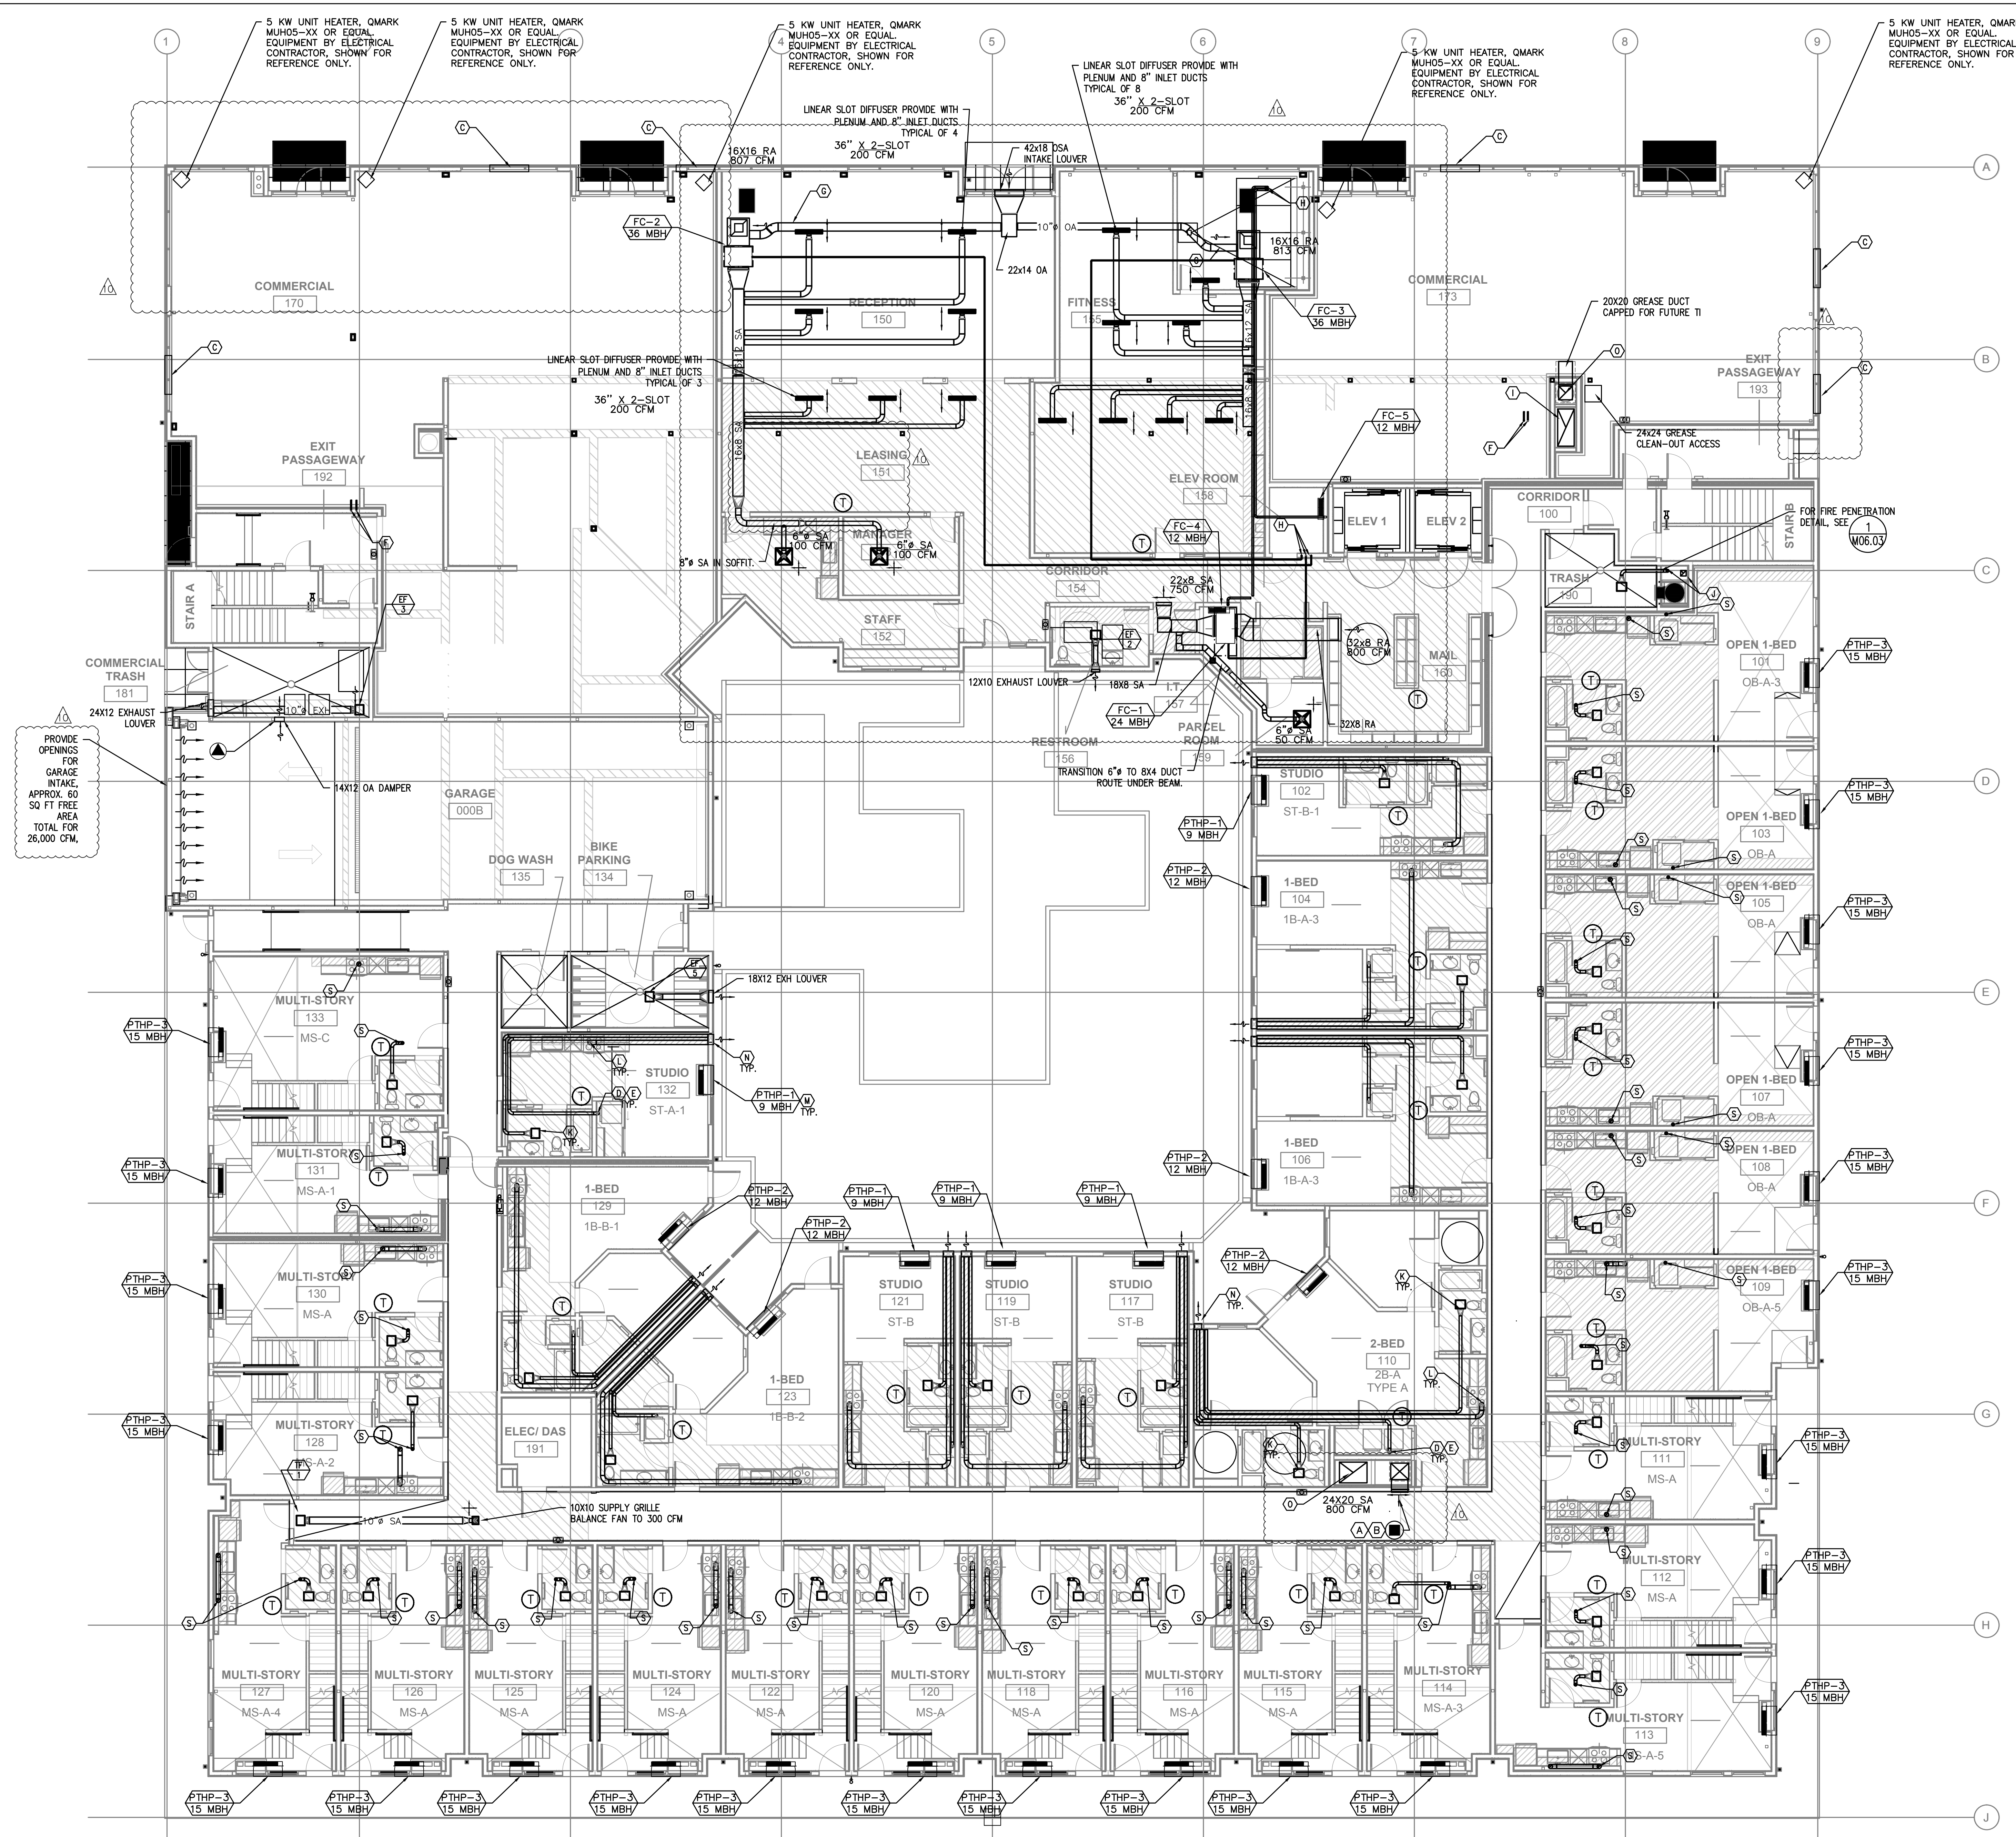

- GENERAL NOTES:**
- (A) SUPPLY DUCT FROM ROOF TO 2ND FLOOR CEILING - TRANSITION TO SMALLER DUCT SIZES AFTER SUPPLY BRANCH TAKE OFF, SEE CHART.
  - (B) SUPPLY AIR OR RETURN AIR, SEE FOR BOTH FREE AREA AND FOR ACTUATOR ACCESS, SEE (1) FOR GRILLE INSTALLATION, AND SEE (2) FOR TYPICAL F/S INSTALLATION, (3) AND CONTROLS.
  - (C) 44X32 & 51X32 (SHOWN IN ARCH) INTAKE AND EXHAUST GRILLES FOR FUTURE TI SPACES, LOUVERS TO BE CAPPED AT INTERIOR FOR FUTURE CONNECTIONS - COORDINATE WITH SOFFIT/STORE FRONT SYSTEM, (3)
  - (D) 4" DRYER EXHAUST-ROUTED SIDEWALL, SEE (8)
  - (E) TYPICAL DRYER DUCT TO BE CONSTRUCTED AS FOLLOWS: MATERIAL SHALL HAVE A SMOOTH INTERIOR FINISH AND 0.016 INCH THICK. RIVETS OR SCREWS PENETRATING THE DUCT WALL ARE NOT ACCEPTABLE. DRYER DUCT SHALL BE SUPPORTED EVERY 4 FOOT INTERVAL.
  - (F) REFRIGERANT LINES CAPPED AND SEALED FOR FUTURE TI CONNECTION. ROUTED FROM 1ST FLOOR CEILING SPACE TO WALL BRACKET FOR FUTURE CONDENSING UNIT.
  - (G) 10" OUTSIDE AIR TO FAN COIL, PROVIDE WITH 2-POSITION DAMPER TO OPEN WHENEVER FAN COIL OPERATES. DAMPER TO BE A LOW LEAK CLASS 1 DAMPER.
  - (H) REFRIGERANT LINES ROUTED FROM PARKING GARAGE TO 1ST FLOOR FAN COILS.
  - (I) 20X20 GREASE EXHAUST (WITH FIRE WRAP IN 30X30 SHAFT) ROUTED FROM ROOF (CAPPED) TO TI SPACE (CAPPED FOR FUTURE TI). PROVIDE VENTED CURB ADAPTER AND CAP FOR FUTURE GREASE EXHAUST FAN.
  - (J) FOUR 4" & 8X8 TRASH EXHAUST UP TO ROOF DOG HOUSE.
  - (K) DWELLING UNIT BATHROOM EXHAUST FAN TO BE SUPPLIED AND INSTALLED BY MECHANICAL CONTRACTOR. MECHANICAL TO PROVIDE VENTING FROM FAN TO SIDE WALL DISCHARGE. (6) (EF) (1)
  - (L) 6" RANGE HOOD EXHAUST ROUTED FROM RANGE TO EXTERIOR WALL, KEEP DUCT AS HIGH IN SPACE AS POSSIBLE, AND TERMINATE WITH A SIDE WALL VENT, WITH A BACKDRAFT DAMPER, INSULATE FINAL 5' OF DUCTWORK.
  - (M) PTHP DETAIL, SEE (7)
  - (N) EXTERIOR EXHAUST PLENUM, SEE (5)
  - (O) 54X24 OR 40X30 GARAGE EXHAUSTS UP FROM GARAGE, THROUGH PT AND UP THROUGH ROOF
  - (P) 8X8 BASEMENT TRASH EXHAUST, TRANSITION TO 10" INTO GREENHECK GRSR WITH 10" THROAT.
  - (Q) 4" BATH EXHAUST FROM 1ST LEVEL TO CONNECT INTO 6" BATH EXHAUST FROM 2ND LEVEL LOFT TO SIDEWALL PLENUM.
  - (R) VENT TYPE-2 RANGE HOOD TO SIDE WALL TERMINATION.
  - (S) 4" BATH EXHAUST & DRYER AND 6" RANGE VENT UP TO LEVEL 2.

**SHAFT DUCT SIZES**

FLOOR	SUPPLY AIR	CFM	RETURN AIR	CFM	UNIT
ATTIC	24 X 26	4000	NA	NA	RTU-1
5TH	24 X 26	4000	NA	NA	RTU-1
4TH	24 X 24	3200	NA	NA	RTU-1
3RD	24 X 24	2400	NA	NA	RTU-1
2ND	24 X 22	1600	NA	NA	RTU-1
1ST	24 X 20	800	NA	NA	RTU-1

**SHAFT DUCT SIZES**

FLOOR	SUPPLY AIR	CFM	RETURN AIR	CFM	UNIT
ATTIC	24 X 26	4000	NA	NA	RTU-2
5TH	24 X 26	4000	NA	NA	RTU-2
4TH	24 X 24	3000	NA	NA	RTU-2
3RD	24 X 24	2000	NA	NA	RTU-2
2ND	24 X 24	1000	NA	NA	RTU-2

**VENTILATION CALCULATIONS:**

ALL DWELLING UNITS ARE VENTILATED BY MECHANICAL VENTILATION, BATHROOM EXHAUST FANS RUN CONTINUOUSLY (SIZED PER ASHRAE 62.2) AND MAKE UP AIR IS PROVIDED BY PTHP'S.

COMMON SPACES AND HALLWAYS ARE VENTILATED BY PACKAGED ROOF TOP UNITS SIZED TO EXCEED THE MINIMUM 0.06 CFM/SQ FT REQUIREMENT

SEE VENTILATION SCHEDULES FOR OTHER UNITS


MECH PLAN - LEVEL 1  
M02.01 SCALE: 1/8" = 1'-0"





308 SW First Avenue  
Suite 200  
Portland, OR 97204  
Phone: (503) 226-2640  
Fax: (503) 226-2607  
leebarc.com

Leeb Architects

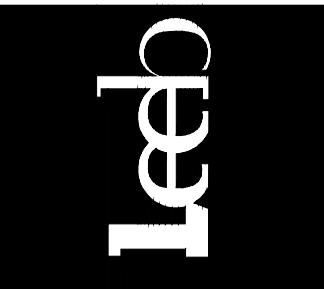


M Consulting Engineers  
2007 S.E. Ash St.  
Portland, OR 97214  
PH: (503) 234-0544  
FAX: (503) 234-0877  
INC. WWW.MPEA-ENG.COM  
CONTACT: MARK DENVER

Project Title: MODERA WOODSTOCK  
APARTMENTS  
MILL CREEK RESIDENTIAL  
2200 NW 2ND AVENUE SUITE 900  
PORTLAND, OR 97209

Drawing Title: MECH PLAN - LEVEL 2  
Date: 12.20.19  
Revision: 4.29.20 - ADD #2 Permit Checklist Response #2  
AS 07.9.17.20 - Plan Check / CMP  
Project No.: A19-20

M02.02

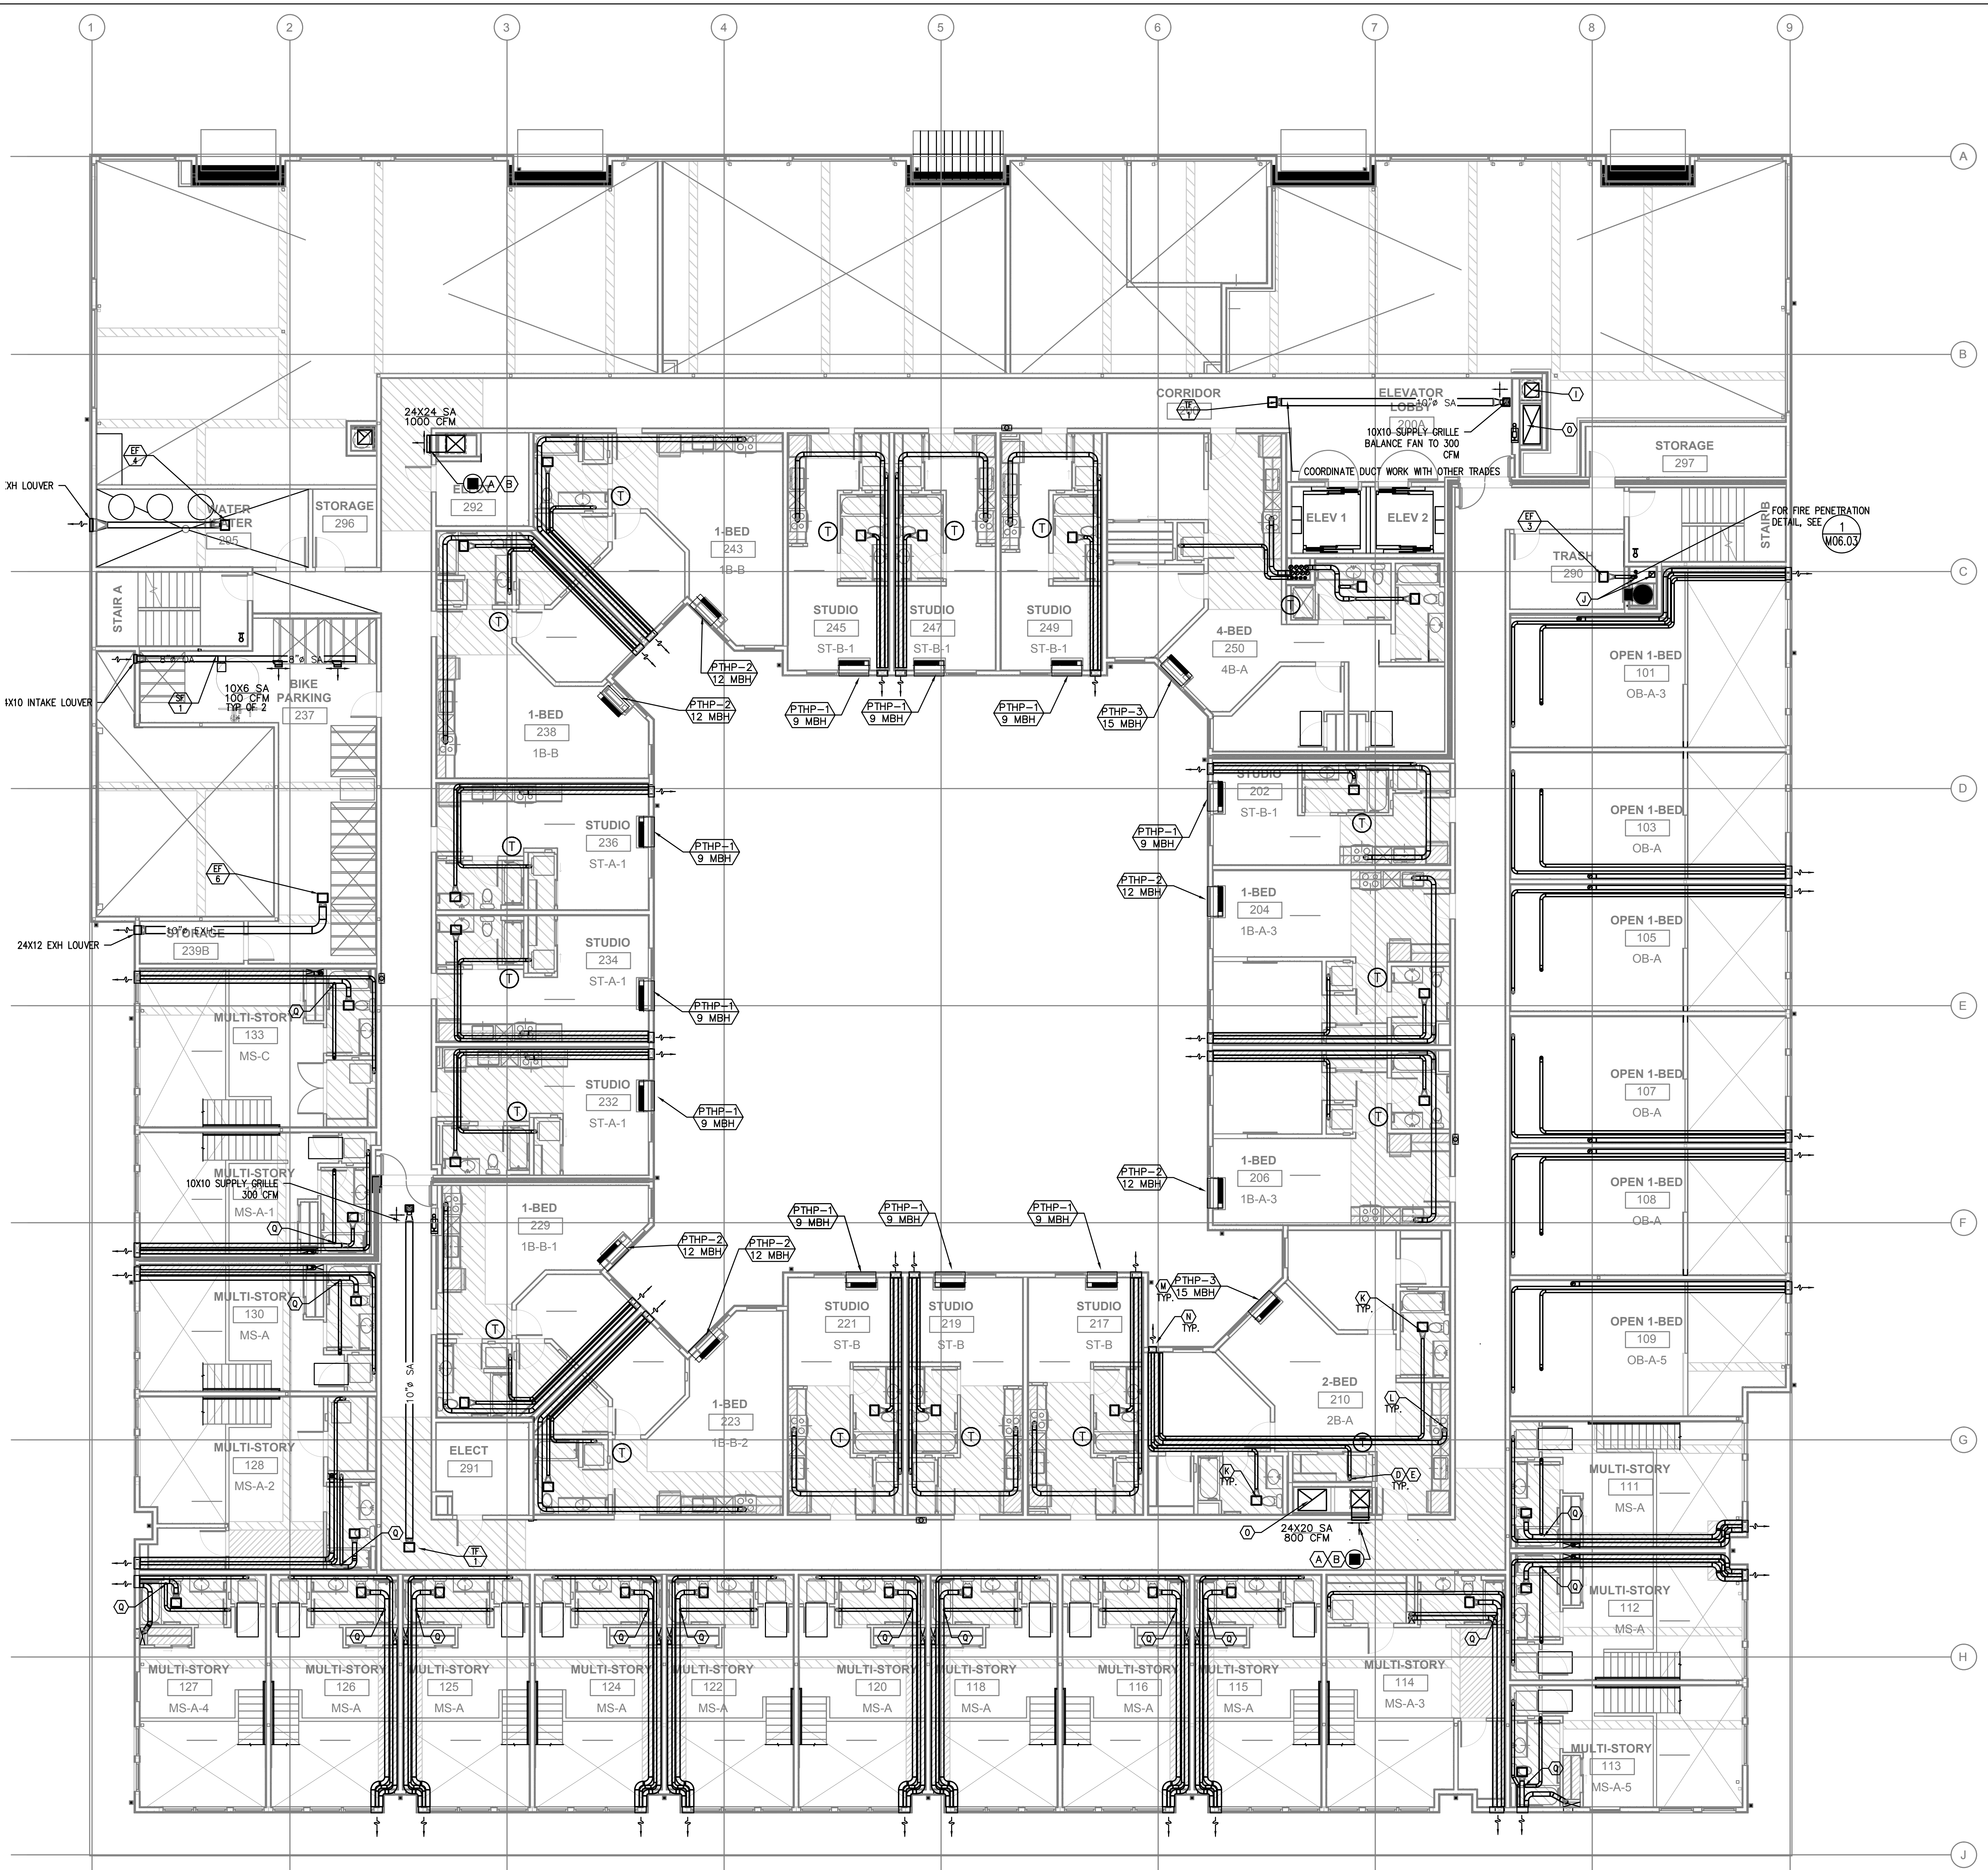

- GENERAL NOTES:**
- (A) SUPPLY DUCT FROM ROOF TO 2ND FLOOR CEILING - TRANSITION TO SMALLER DUCT SIZES AFTER SUPPLY BRANCH TAKE OFF. SEE CHART.
  - (B) SUPPLY AIR OR RETURN GRILLE, SIZED FOR BOTH FREE AREA AND FOR ACTUATOR ACCESS. SEE 1 FOR GRILLE INSTALLATION, AND SEE 2 FOR TYPICAL F/S INSTALLATION, 1 AND CONTROLS.
  - (C) 44X32 & 51X32 (SHOWN IN ARCH) INTAKE AND EXHAUST GRILLES FOR FUTURE TI SPACES. LOUVERS TO BE CAPPED AT INTERIOR FOR FUTURE CONNECTIONS - COORDINATE WITH SOFFIT/STORE FRONT SYSTEM. 3
  - (D) 4" DRYER EXHAUST-ROUTED-SIDEWALL. SEE 8
  - (E) TYPICAL DRYER DUCT TO BE CONSTRUCTED AS FOLLOWS: MATERIAL SHALL HAVE A SMOOTH INTERIOR FINISH AND 0.016 INCH THICK. RIVETS OR SCREWS PENETRATING THE DUCT WALL ARE NOT ACCEPTABLE. DRYER DUCT SHALL BE SUPPORTED EVERY 4 FOOT INTERVAL.
  - (F) REFRIGERANT LINES CAPPED AND SEALED FOR FUTURE TI CONNECTION. ROUTED FROM 1ST FLOOR CEILING SPACE TO WALL BRACKET FOR FUTURE CONDENSING UNIT.
  - (G) 10" OUTSIDE AIR TO FAN COIL. PROVIDE WITH 2-POSITION DAMPER TO OPEN WHENEVER FAN COIL OPERATES. DAMPER TO BE A LOW LEAK CLASS 1 DAMPER.
  - (H) REFRIGERANT LINES ROUTED FROM PARKING GARAGE TO 1ST FLOOR FAN COILS.
  - (I) 20X20 GREASE EXHAUST (WITH FIRE WRAP IN 30X30 SHAFT) ROUTED FROM ROOF (CAPPED) TO TI SPACE (CAPPED FOR FUTURE TI). PROVIDE VENTED CURB ADAPTER AND CAP FOR FUTURE GREASE EXHAUST FAN.
  - (J) FOUR 4" & 8X8 TRASH EXHAUST UP TO ROOF DOG HOUSE.
  - (K) DWELLING UNIT BATHROOM EXHAUST FAN TO BE SUPPLIED AND INSTALLED BY MECHANICAL CONTRACTOR. MECHANICAL TO PROVIDE VENTING FROM FAN TO SIDE WALL DISCHARGE. 6
  - (L) 6" RANGE HOOD EXHAUST ROUTED FROM RANGE TO EXTERIOR WALL. KEEP DUCT AS HIGH IN SPACE AS POSSIBLE, AND TERMINATE WITH A SIDE WALL VENT, WITH A BACKDRAFT DAMPER. INSULATE FINAL 5' OF DUCTWORK.
  - (M) PTHP DETAIL, SEE 7
  - (N) EXTERIOR EXHAUST PLENUM, SEE 5
  - (O) 54X24 OR 40X30 GARAGE EXHAUSTS UP FROM GARAGE, THROUGH PT AND UP THROUGH ROOF
  - (P) 8X8 BASEMENT TRASH EXHAUST, TRANSITION TO 10" INTO GREENHECK GRSR WITH 10" THROAT.
  - (Q) 4" BATH EXHAUST FROM 1ST LEVEL TO CONNECT INTO 6" BATH EXHAUST FROM 2ND LEVEL LOFT TO SIDEWALL PLENUM.
  - (R) VENT TYPE-2 RANGE HOOD TO SIDE WALL TERMINATION.
  - (S) 4" BATH EXHAUST & DRYER AND 6" RANGE VENT UP TO LEVEL 2.

**SHAFT DUCT SIZES**

FLOOR	SUPPLY AIR	CFM	RETURN AIR	CFM	UNIT
ATTIC	24 X 26	4000	NA	NA	RTU-1
5TH	24 X 26	4000	NA	NA	RTU-1
4TH	24 X 24	3200	NA	NA	RTU-1
3RD	24 X 24	2400	NA	NA	RTU-1
2ND	24 X 22	1600	NA	NA	RTU-1
1ST	24 X 20	800	NA	NA	RTU-1

**SHAFT DUCT SIZES**

FLOOR	SUPPLY AIR	CFM	RETURN AIR	CFM	UNIT
ATTIC	24 X 26	4000	NA	NA	RTU-2
5TH	24 X 26	4000	NA	NA	RTU-2
4TH	24 X 24	3000	NA	NA	RTU-2
3RD	24 X 24	2000	NA	NA	RTU-2
2ND	24 X 24	1000	NA	NA	RTU-2

**VENTILATION CALCULATIONS:**

ALL DWELLING UNITS ARE VENTILATED BY MECHANICAL VENTILATION, BATHROOM EXHAUST FANS RUN CONTINUOUSLY (SIZED PER ASHRAE 62.2) AND MAKE UP AIR IS PROVIDED BY PTHP'S.

COMMON SPACES AND HALLWAYS ARE VENTILATED BY PACKAGED ROOF TOP UNITS SIZED TO EXCEED THE MINIMUM 0.06 CFM/SQ FT REQUIREMENT

SEE VENTILATION SCHEDULES FOR OTHER UNITS


MECH PLAN - LEVEL 2  
SCALE: 1/8" = 1'-0"





308 SW First Avenue  
Suite 200  
Portland, OR 97204  
Phone: (503) 226-2640  
Fax: (503) 226-2607  
leebarc.com

Leeb Architects

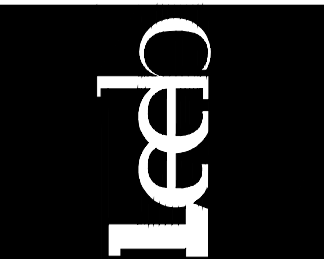


Consulting Engineers  
2007 S.E. Ash St.  
Portland, OR 97214  
PH: (503) 234-0548  
FAX: (503) 234-0877  
WWW.MFIA-ENG.COM  
CONTACT: MARK DEWITT

Project Title: MODERA WOODSTOCK APARTMENTS  
MILL CREEK RESIDENTIAL  
2200 NW 2ND AVENUE SUITE 900  
PORTLAND, OR 97209

Revision:  
4.29.20 - ADD #2 Permit Checksheet Response #2  
AS 07.9.17.20 - Plan Check / CMP  
AS 10 - 9.16.22 Construction Set Revisions

Date: 12.20.19  
Drawn by: MFA/Jacobs  
Project No.: A19-20

M02.03

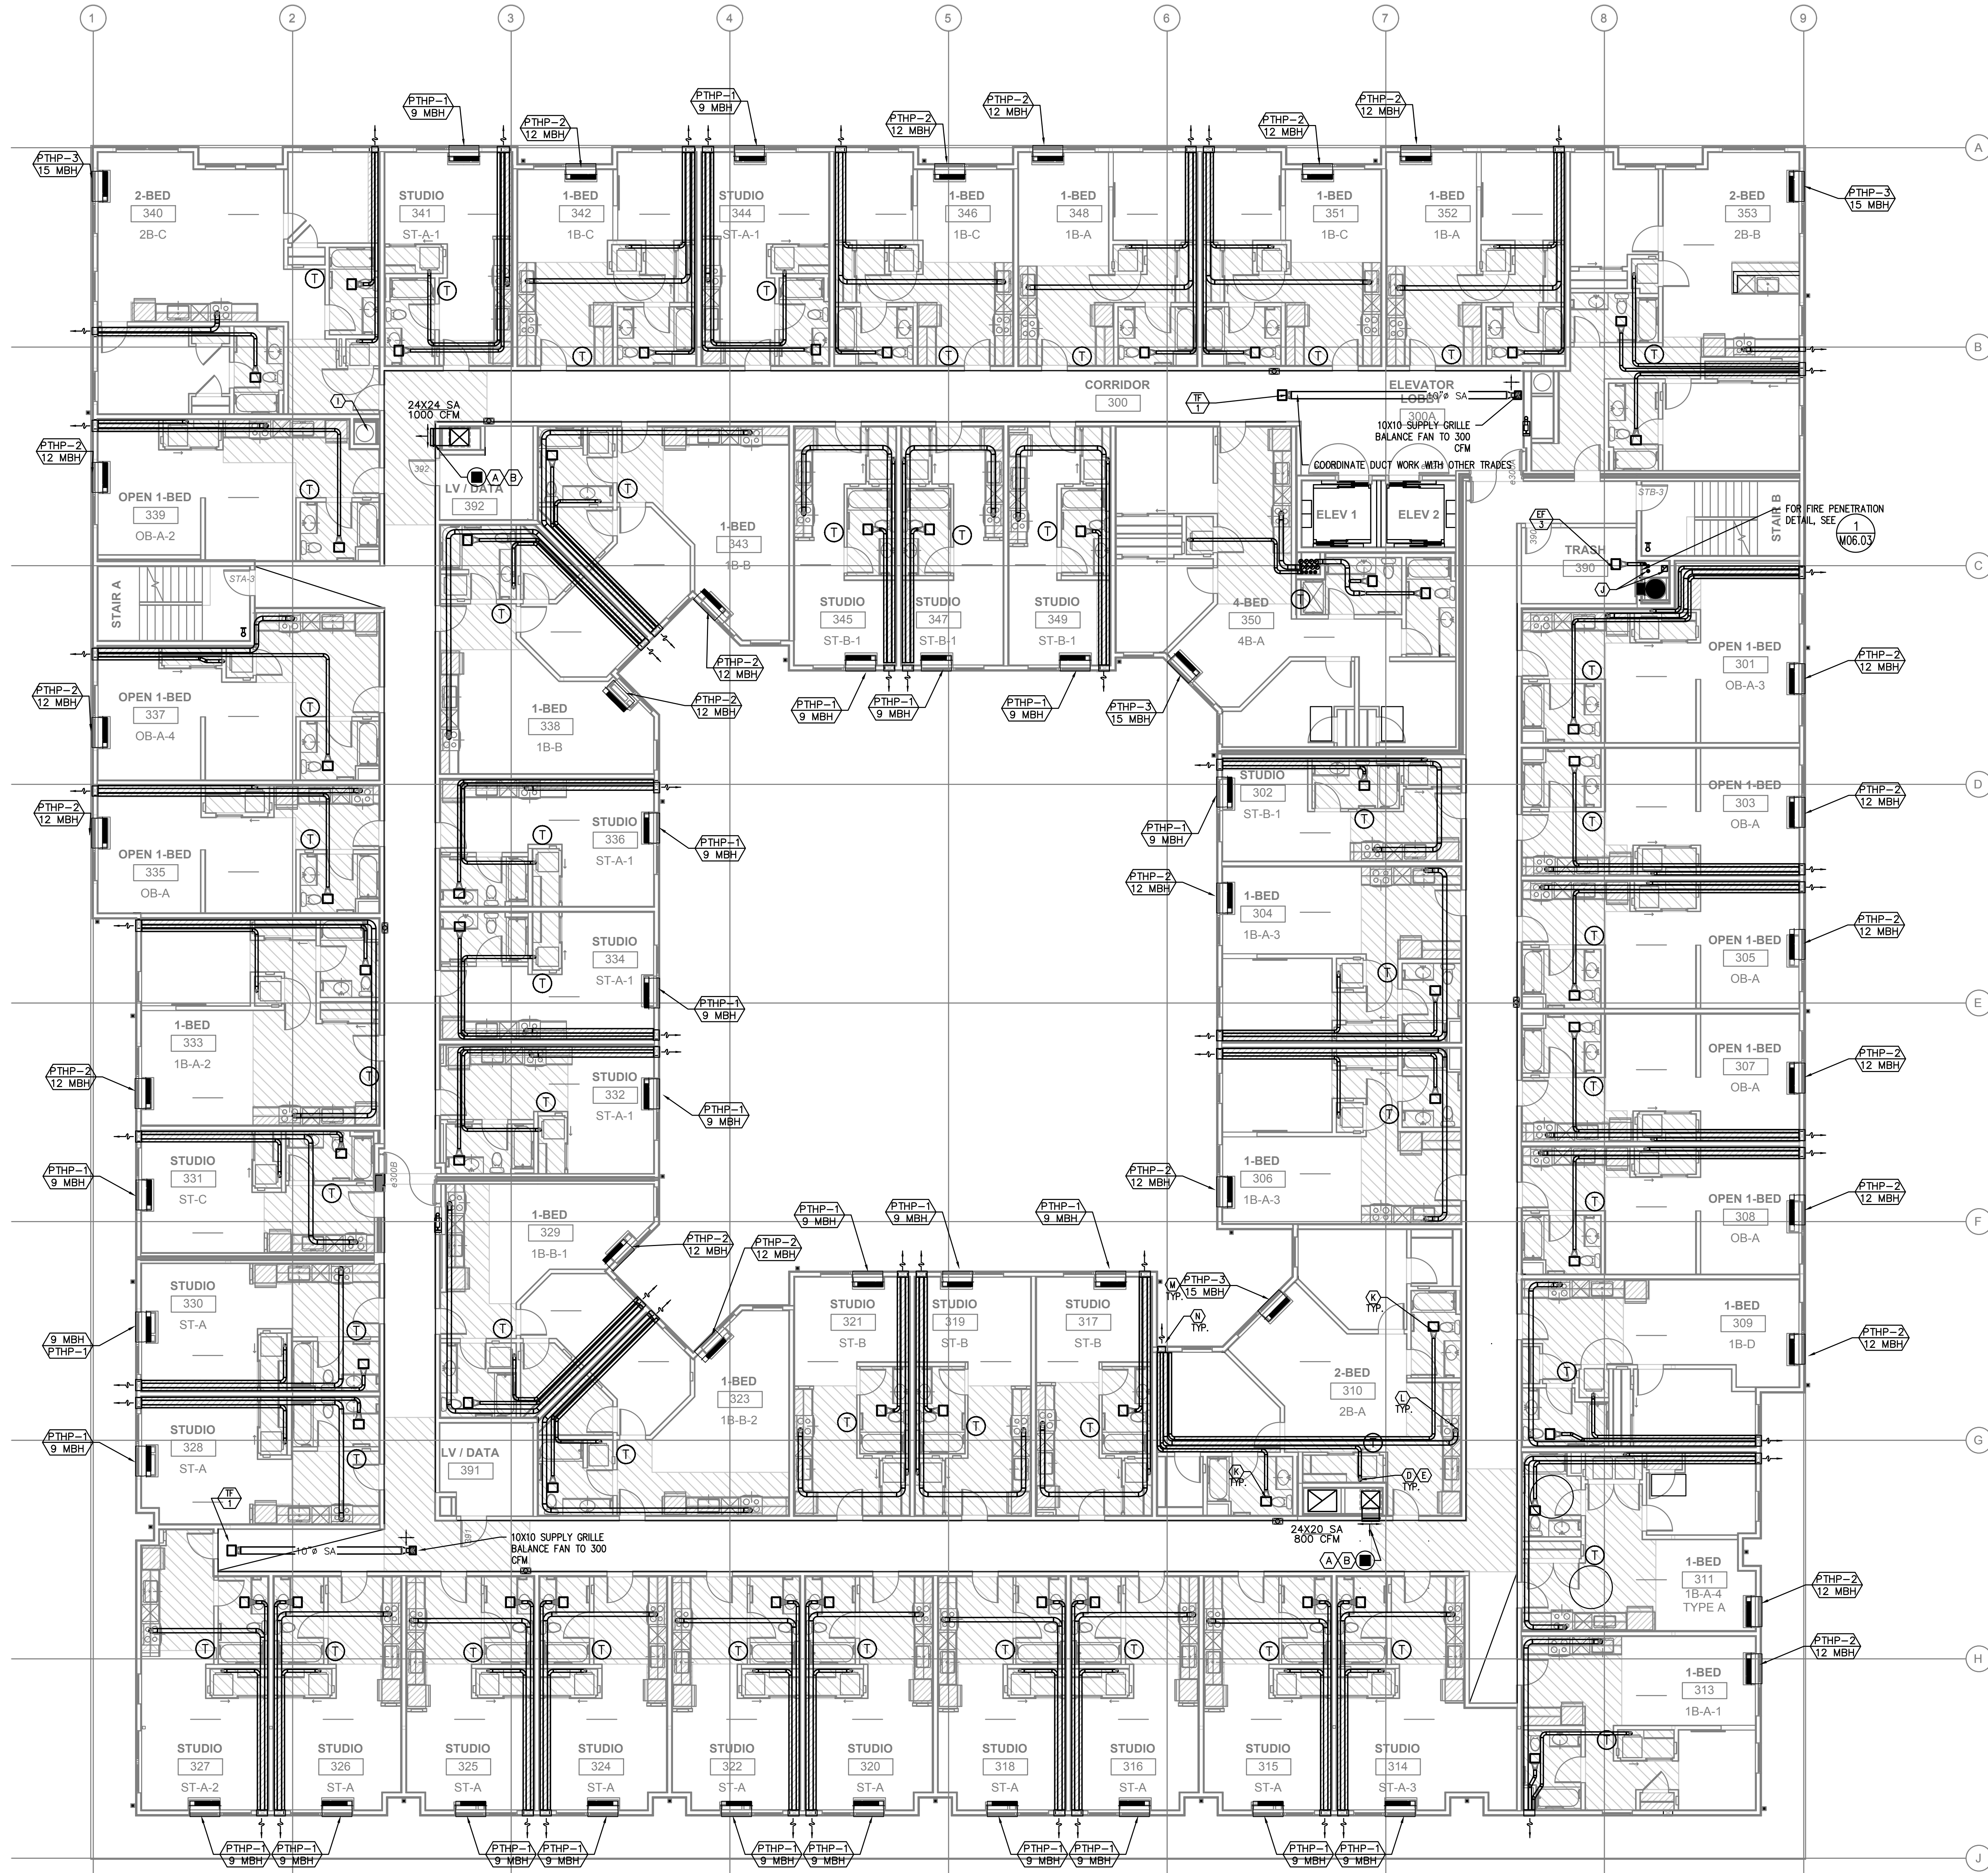

GENERAL NOTES:

- (A) SUPPLY DUCT FROM ROOF TO 2ND FLOOR CEILING - TRANSITION TO SMALLER DUCT SIZES AFTER SUPPLY BRANCH TAKE OFF, SEE CHART.
- (B) SUPPLY AIR OR RETURN AIR, SIZED FOR BOTH FREE AREA AND FOR ACTUATOR ACCESS, SEE 1 FOR GRILLE INSTALLATION, AND SEE 2 FOR TYPICAL F/S INSTALLATION, 1 AND 2.
- (C) 44X32 & 51X32 (SHOWN IN ARCH) INTAKE AND EXHAUST GRILLES FOR FUTURE TI SPACES, LOUVERS TO BE CAPPED AT INTERIOR FOR FUTURE CONNECTIONS - COORDINATE WITH SOFFIT/STORE FRONT SYSTEM, 3.
- (D) 4" DRYER EXHAUST-ROUTED-SIDEWALL, SEE 8.
- (E) TYPICAL DRYER DUCT TO BE CONSTRUCTED AS FOLLOWS: MATERIAL SHALL HAVE A SMOOTH INTERIOR FINISH AND 0.016 INCH THICK. RIVETS OR SCREWS PENETRATING THE DUCT WALL ARE NOT ACCEPTABLE. DRYER DUCT SHALL BE SUPPORTED EVERY 4 FOOT INTERVAL.
- (F) REFRIGERANT LINES CAPPED AND SEALED FOR FUTURE TI CONNECTION, ROUTED FROM 1ST FLOOR CEILING SPACE TO WALL BRACKET FOR FUTURE CONDENSING UNIT.
- (G) 10" OUTSIDE AIR TO FAN COIL, PROVIDE WITH 2-POSITION DAMPER TO OPEN WHENEVER FAN COIL OPERATES. DAMPER TO BE A LOW LEAK CLASS 1 DAMPER.
- (H) REFRIGERANT LINES ROUTED FROM PARKING GARAGE TO 1ST FLOOR FAN COILS.
- (I) 20X20 GREASE EXHAUST (WITH FIRE WRAP IN 30X30 SHAFT) ROUTED FROM ROOF (CAPPED) TO TI SPACE (CAPPED FOR FUTURE TI). PROVIDE VENTED CURB ADAPTER AND CAP FOR FUTURE GREASE EXHAUST FAN.
- (J) FOUR 4" & 8X8 TRASH EXHAUST UP TO ROOF DOG HOUSE.
- (K) DWELLING UNIT BATHROOM EXHAUST FAN TO BE SUPPLIED AND INSTALLED BY MECHANICAL CONTRACTOR, MECHANICAL TO PROVIDE VENTING FROM FAN TO SIDE WALL DISCHARGE, 6 AND 1.
- (L) 6" RANGE HOOD EXHAUST ROUTED FROM RANGE TO EXTERIOR WALL, KEEP DUCT AS HIGH IN SPACE AS POSSIBLE, AND TERMINATE WITH A SIDE WALL VENT, WITH A BACKDRAFT DAMPER, INSULATE FINAL 5' OF DUCTWORK.
- (M) PTHP DETAIL, SEE 1.
- (N) EXTERIOR EXHAUST PLENUM, SEE 5.
- (O) 54X24 OR 40X30 GARAGE EXHAUSTS UP FROM GARAGE, THROUGH PT AND UP THROUGH ROOF.
- (P) 8X8 BASEMENT TRASH EXHAUST, TRANSITION TO 10" INTO GREENHECK GRSR WITH 10" THROAT.
- (Q) 4" BATH EXHAUST FROM 1ST LEVEL TO CONNECT INTO 6" BATH EXHAUST FROM 2ND LEVEL LOFT TO SIDEWALL PLENUM.
- (R) VENT TYPE-2 RANGE HOOD TO SIDE WALL TERMINATION.
- (S) 4" BATH EXHAUST & DRYER AND 6" RANGE VENT UP TO LEVEL 2.

SHAFT DUCT SIZES

FLOOR	SUPPLY AIR	CFM	RETURN AIR	CFM	UNIT
ATTIC	24 X 26	4000	NA	NA	RTU-1
5TH	24 X 26	4000	NA	NA	RTU-1
4TH	24 X 24	3200	NA	NA	RTU-1
3RD	24 X 24	2400	NA	NA	RTU-1
2ND	24 X 22	1600	NA	NA	RTU-1
1ST	24 X 20	800	NA	NA	RTU-1

SHAFT DUCT SIZES

FLOOR	SUPPLY AIR	CFM	RETURN AIR	CFM	UNIT
ATTIC	24 X 26	4000	NA	NA	RTU-2
5TH	24 X 26	4000	NA	NA	RTU-2
4TH	24 X 24	3000	NA	NA	RTU-2
3RD	24 X 24	2000	NA	NA	RTU-2
2ND	24 X 24	1000	NA	NA	RTU-2

VENTILATION CALCULATIONS:

ALL DWELLING UNITS ARE VENTILATED BY MECHANICAL VENTILATION, BATHROOM EXHAUST FANS RUN CONTINUOUSLY (SIZED PER ASHRAE 62.2) AND MAKE UP AIR IS PROVIDED BY PTHP'S.

COMMON SPACES AND HALLWAYS ARE VENTILATED BY PACKAGED ROOF TOP UNITS SIZED TO EXCEED THE MINIMUM 0.06 CFM/SQ FT REQUIREMENT

SEE VENTILATION SCHEDULES FOR OTHER UNITS


MECH PLAN - LEVEL 3  
SCALE: 1/8" = 1'-0"





308 SW First Avenue  
Suite 200  
Portland, OR 97204  
Phone: (503) 234-2640  
Fax: (503) 234-2647  
leebarc.com

Leeb Architects

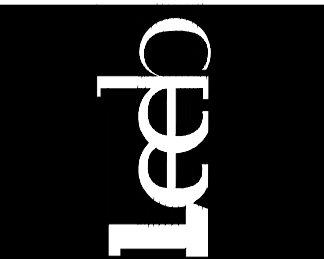


Consulting Engineers  
2007 S.E. Ash St.  
Portland, OR 97214  
PH: (503) 234-0548  
FAX: (503) 234-0877  
INC. WWW.MFLA-ENG.COM  
CONTACT: MARK DELNER

Project Title: MODERA WOODSTOCK APARTMENTS  
MILL CREEK RESIDENTIAL  
2200 NW 2ND AVENUE SUITE 900  
PORTLAND, OR 97209

Revision:  
4.29.20 - ADD #2 Permit Checksheet Response #2  
AS 07 9 17.20 - Plan Check / CMP  
AS 10 - 9 16.22 Construction Set Revisions

M02.04

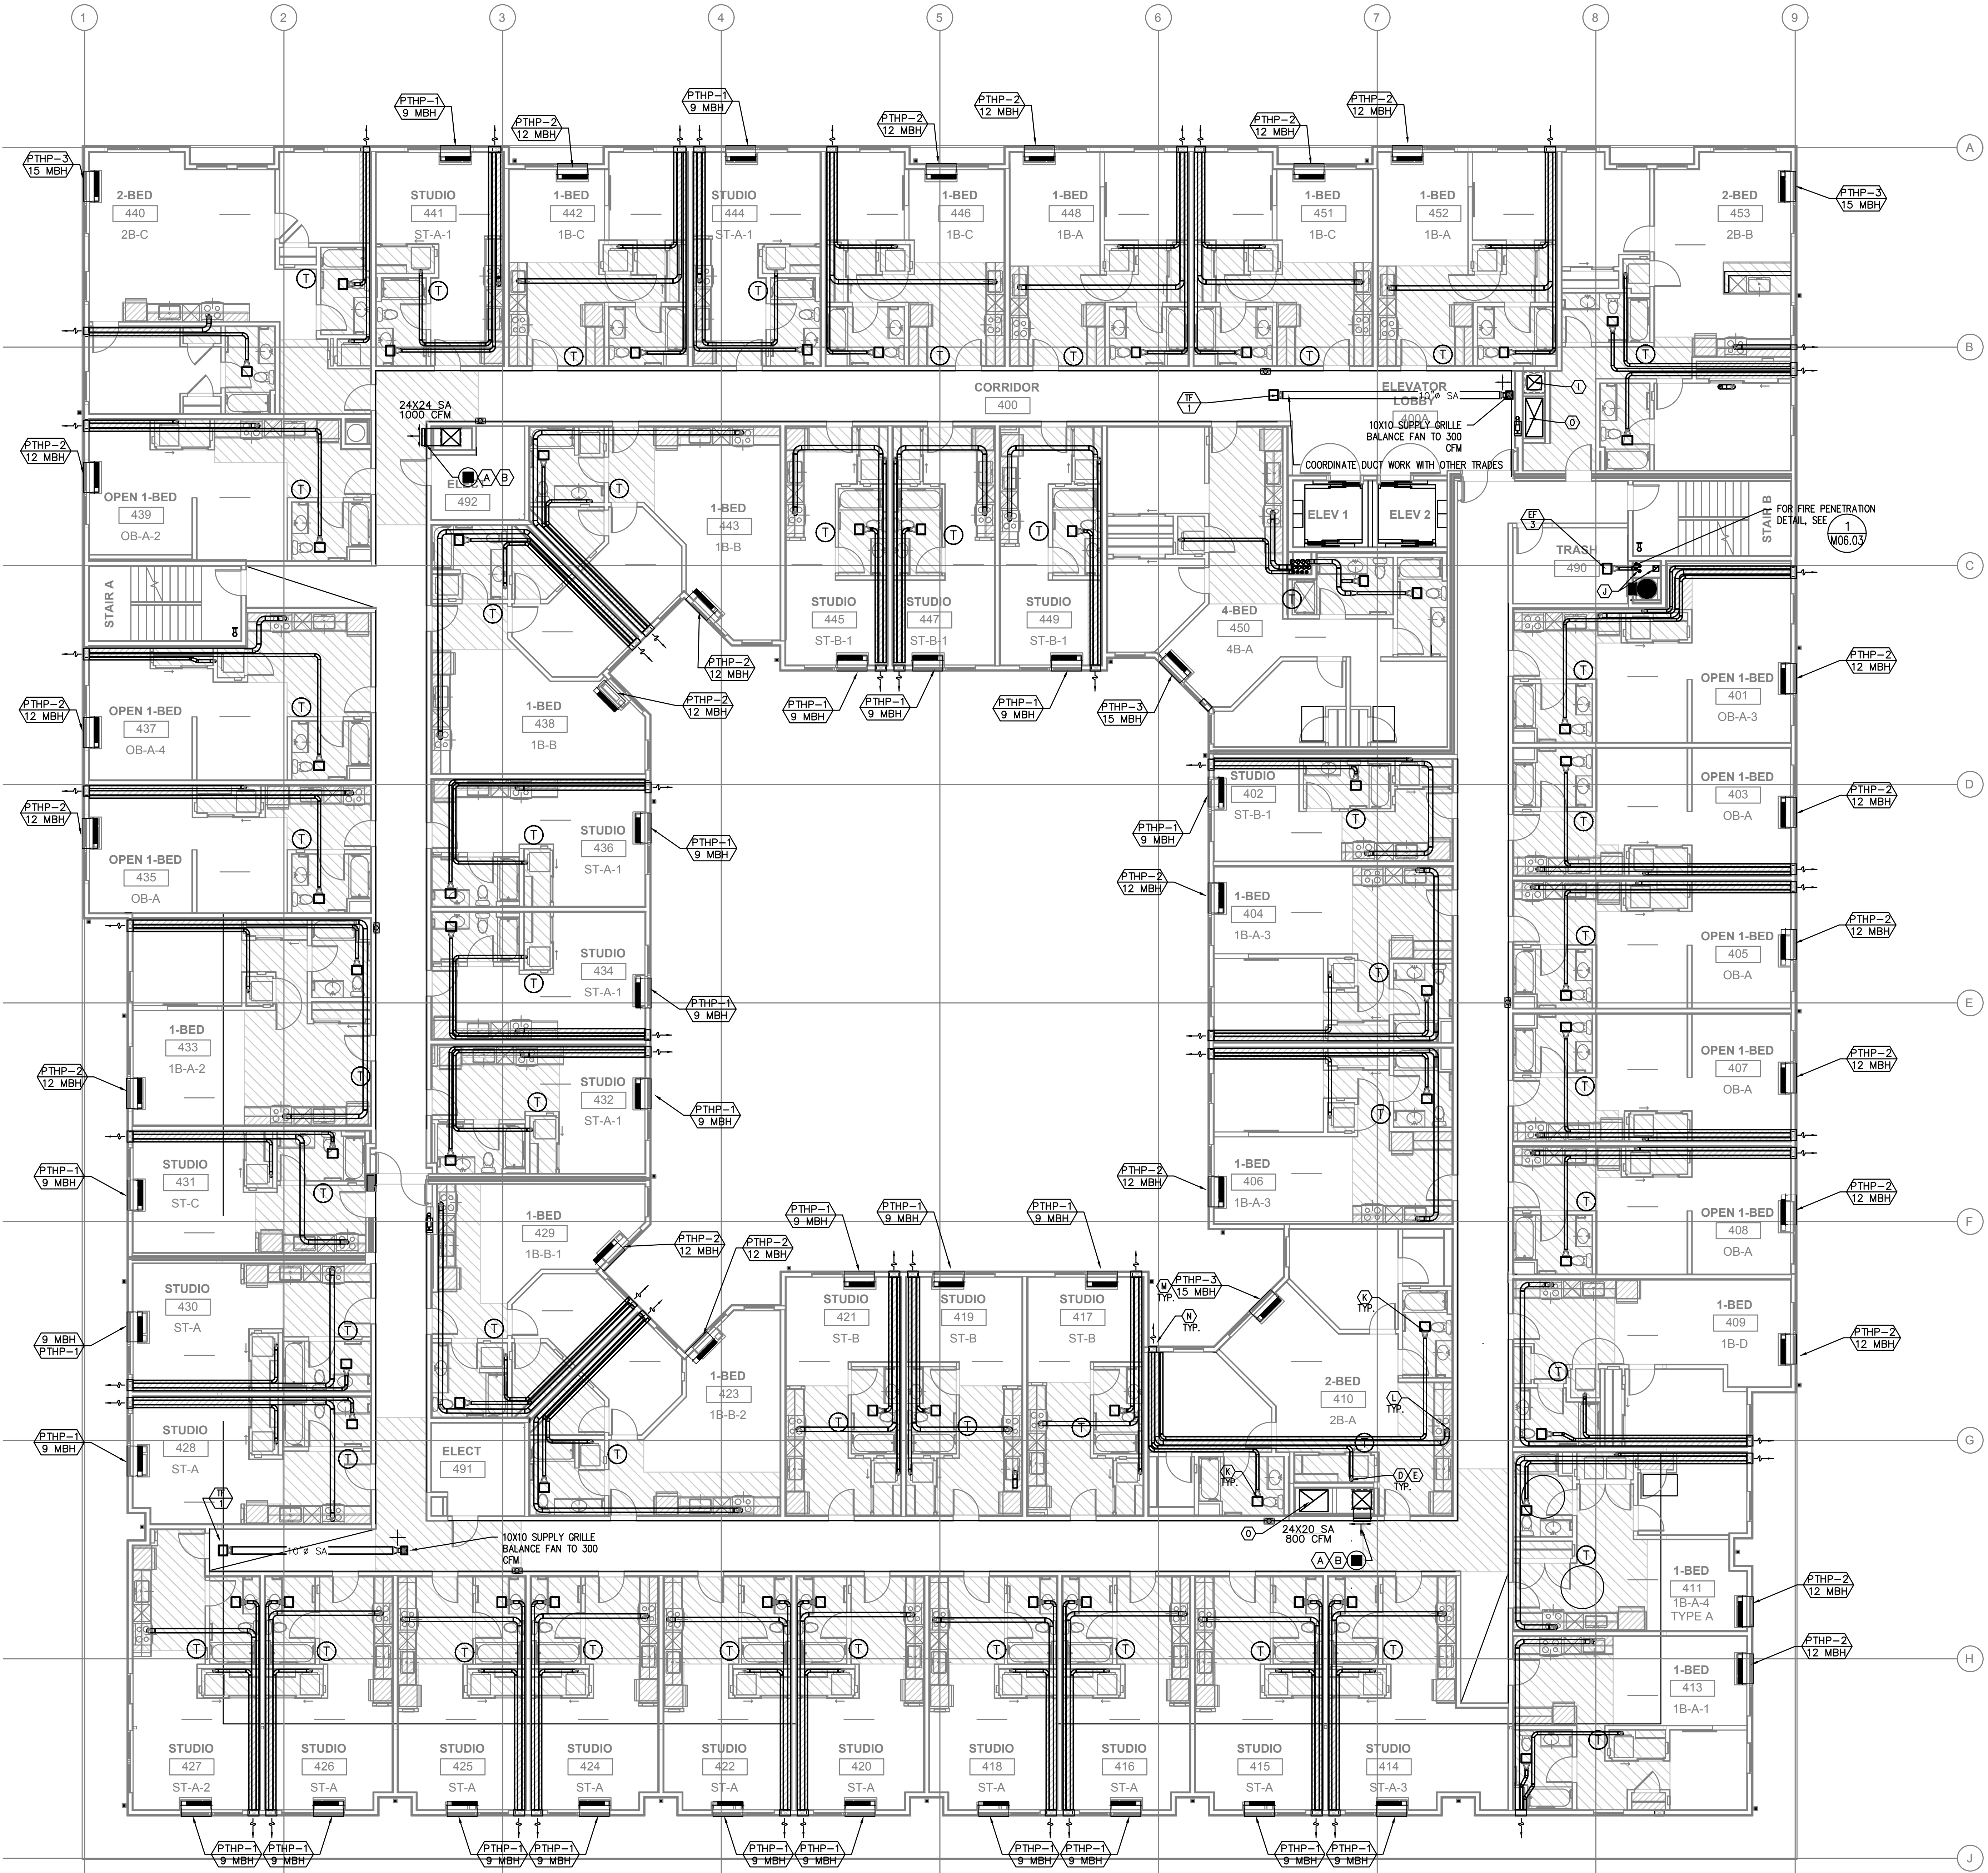

- GENERAL NOTES:**
- (A) SUPPLY DUCT FROM ROOF TO 2ND FLOOR CEILING - TRANSITION TO SMALLER DUCT SIZES AFTER SUPPLY BRANCH TAKE OFF, SEE CHART.
  - (B) SUPPLY AIR OR RETURN GRILLE, SIZED FOR BOTH FREE AREA AND FOR ACTUATOR ACCESS, SEE 1 FOR GRILLE INSTALLATION, AND SEE 2 FOR TYPICAL F/S INSTALLATION. (M06.01) (M06.02)
  - (C) 44X32 & 51X32 (SHOWN IN ARCH) INTAKE AND EXHAUST GRILLES FOR FUTURE TI SPACES, LOUVERS TO BE CAPPED AT INTERIOR FOR FUTURE CONNECTIONS - COORDINATE WITH SOFFIT/STORE FRONT SYSTEM. (M06.03)
  - (D) 4" DRYER EXHAUST-ROUTED-SIDEWALL; SEE 8 (M06.01)
  - (E) TYPICAL DRYER DUCT TO BE CONSTRUCTED AS FOLLOWS: MATERIAL SHALL HAVE A SMOOTH INTERIOR FINISH AND 0.016 INCH THICK. RIVETS OR SCREWS PENETRATING THE DUCT WALL ARE NOT ACCEPTABLE. DRYER DUCT SHALL BE SUPPORTED EVERY 4 FOOT INTERVAL.
  - (F) REFRIGERANT LINES CAPPED AND SEALED FOR FUTURE TI CONNECTION. ROUTED FROM 1ST FLOOR CEILING SPACE TO WALL BRACKET FOR FUTURE CONDENSING UNIT.
  - (G) 10" OUTSIDE AIR TO FAN COIL, PROVIDE WITH 2-POSITION DAMPER TO OPEN WHENEVER FAN COIL OPERATES. DAMPER TO BE A LOW LEAK CLASS 1 DAMPER.
  - (H) REFRIGERANT LINES ROUTED FROM PARKING GARAGE TO 1ST FLOOR FAN COILS.
  - (I) 20X20 GREASE EXHAUST (WITH FIRE WRAP IN 30X30 SHAFT) ROUTED FROM ROOF (CAPPED) TO TI SPACE (CAPPED FOR FUTURE TI). PROVIDE VENTED CURB ADAPTER AND CAP FOR FUTURE GREASE EXHAUST FAN.
  - (J) FOUR 4" & 8X8 TRASH EXHAUST UP TO ROOF DOG HOUSE.
  - (K) DWELLING UNIT BATHROOM EXHAUST FAN TO BE SUPPLIED AND INSTALLED BY MECHANICAL CONTRACTOR. MECHANICAL TO PROVIDE VENTING FROM FAN TO SIDE WALL DISCHARGE. (M06.01) (EF 1)
  - (L) 6" RANGE HOOD EXHAUST ROUTED FROM RANGE TO EXTERIOR WALL, KEEP DUCT AS HIGH IN SPACE AS POSSIBLE, AND TERMINATE WITH A SIDE WALL VENT, WITH A BACKDRAFT DAMPER. INSULATE FINAL 5' OF DUCTWORK.
  - (M) PTHP DETAIL, SEE (M06.01)
  - (N) EXTERIOR EXHAUST PLENUM, SEE (M06.01)
  - (O) 54X24 OR 40X30 GARAGE EXHAUSTS UP FROM GARAGE, THROUGH PT AND UP THROUGH ROOF.
  - (P) 8X8 BASEMENT TRASH EXHAUST, TRANSITION TO 10" INTO GREENHECK GRSR WITH 10" THROAT.
  - (Q) 4" BATH EXHAUST FROM 1ST LEVEL TO CONNECT INTO 6" BATH EXHAUST FROM 2ND LEVEL LOFT TO SIDEWALL PLENUM.
  - (R) VENT TYPE-2 RANGE HOOD TO SIDE WALL TERMINATION.
  - (S) 4" BATH EXHAUST & DRYER AND 6" RANGE VENT UP TO LEVEL 2.

**SHAFT DUCT SIZES**

FLOOR	SUPPLY AIR	CFM	RETURN AIR	CFM	UNIT
ATTIC	24 X 26	4000	NA	NA	RTU-1
5TH	24 X 26	4000	NA	NA	RTU-1
4TH	24 X 24	3200	NA	NA	RTU-1
3RD	24 X 24	2400	NA	NA	RTU-1
2ND	24 X 22	1600	NA	NA	RTU-1
1ST	24 X 20	800	NA	NA	RTU-1

**SHAFT DUCT SIZES**

FLOOR	SUPPLY AIR	CFM	RETURN AIR	CFM	UNIT
ATTIC	24 X 26	4000	NA	NA	RTU-2
5TH	24 X 26	4000	NA	NA	RTU-2
4TH	24 X 24	3000	NA	NA	RTU-2
3RD	24 X 24	2000	NA	NA	RTU-2
2ND	24 X 24	1000	NA	NA	RTU-2

**VENTILATION CALCULATIONS:**

ALL DWELLING UNITS ARE VENTILATED BY MECHANICAL VENTILATION, BATHROOM EXHAUST FANS RUN CONTINUOUSLY (SIZED PER ASHRAE 62.2) AND MAKE UP AIR IS PROVIDED BY PTHP'S.

COMMON SPACES AND HALLWAYS ARE VENTILATED BY PACKAGED ROOF TOP UNITS SIZED TO EXCEED THE MINIMUM 0.06 CFM/SQ FT REQUIREMENT

SEE VENTILATION SCHEDULES FOR OTHER UNITS


1 MECH PLAN - LEVEL 4  
SCALE: 1/8" = 1'-0"





308 SW First Avenue  
Suite 200  
Portland, OR 97204  
Phone: (503) 226-2640  
Fax: (503) 226-2607  
leebarc.com

Leeb Architects

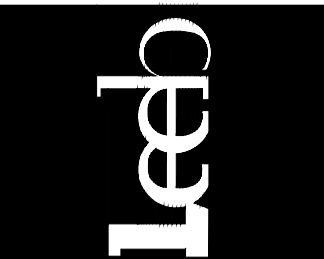


M Consulting Engineers  
2007 S.E. Ash St.  
Portland, OR 97214  
PH: (503) 234-0544  
FAX: (503) 234-0877  
INC. WWW.MFLA-ENG.COM  
CONTACT: MARK DENVER

Project Title: MODERA WOODSTOCK  
APARTMENTS  
MILL CREEK RESIDENTIAL  
2200 NW 2ND AVENUE SUITE 900  
PORTLAND, OR 97209

Drawing Title: MECH PLAN - LEVEL 5  
Date: 12.20.19  
Revision: 4.29.20 - ADD #2 Permit Checksheet Response #2  
Drawn by: MFL/Jacobs  
Project No.: A16-20

M02.05

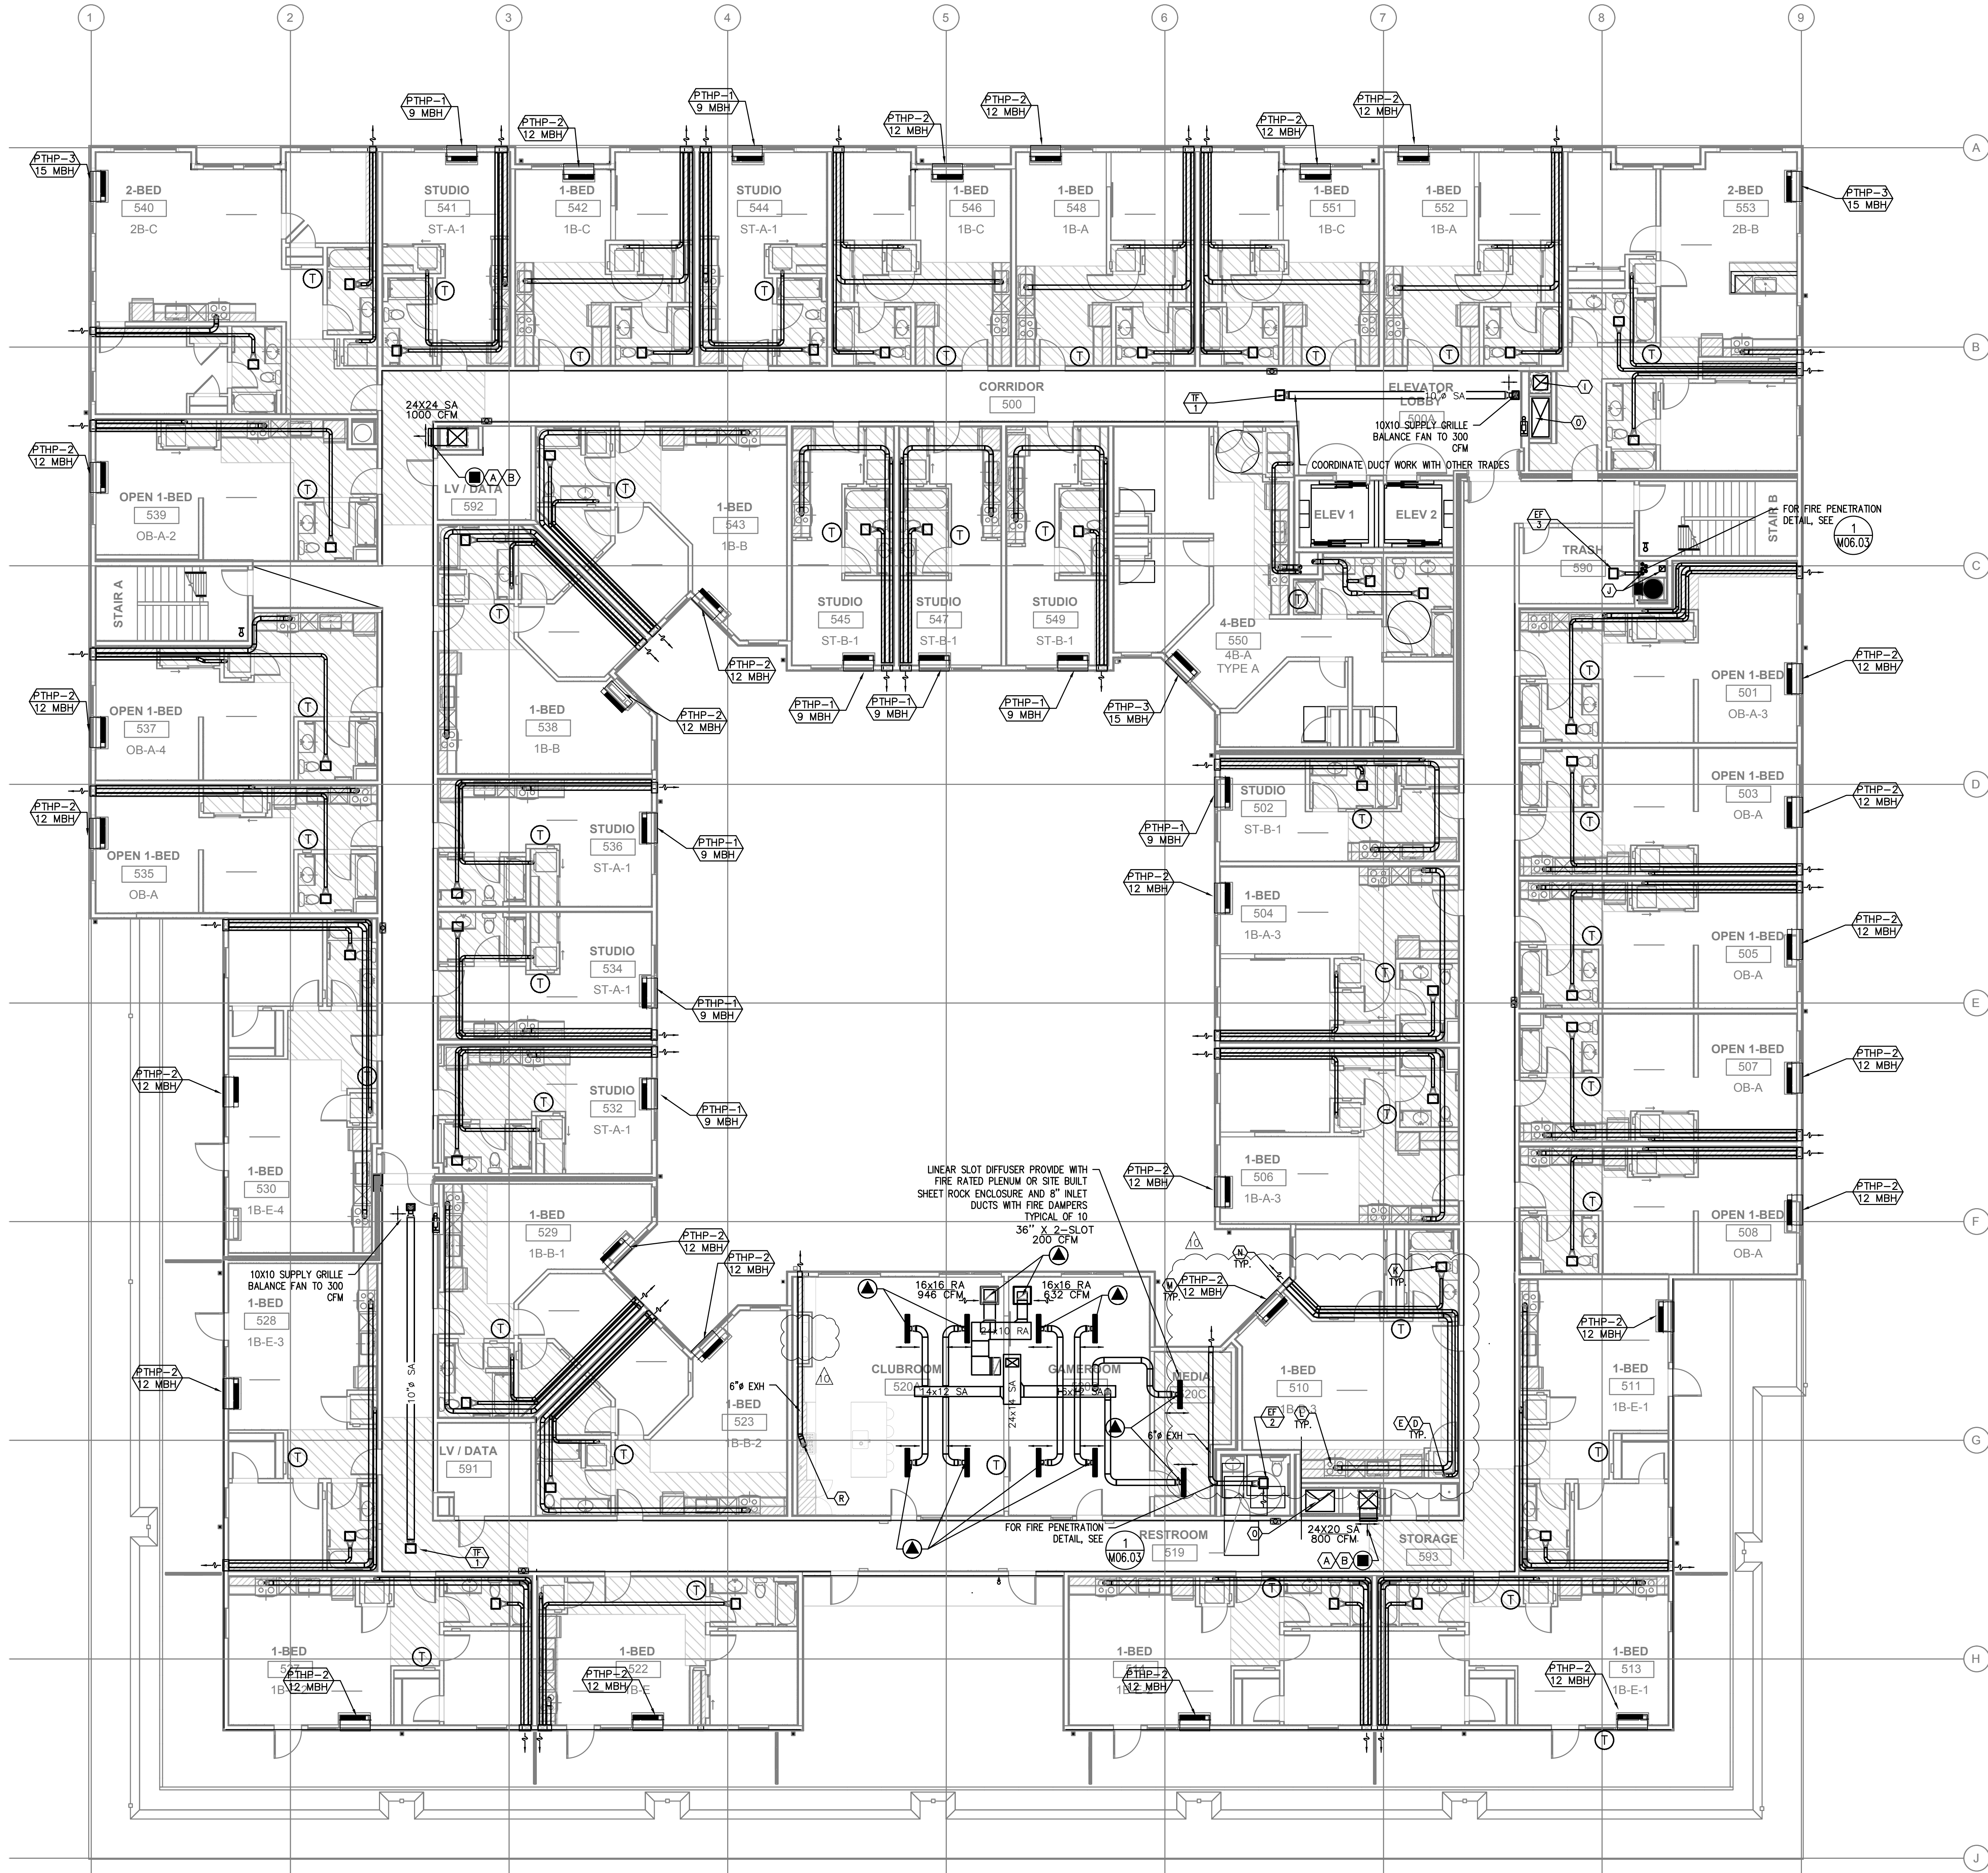

- GENERAL NOTES:**
- (A) SUPPLY DUCT FROM ROOF TO 2ND FLOOR CEILING - TRANSITION TO SMALLER DUCT SIZES AFTER SUPPLY BRANCH TAKE OFF, SEE CHART.
  - (B) SUPPLY AIR OR RETURN GRILLE, SIZED FOR BOTH FREE AREA AND FOR ACTUATOR ACCESS, SEE 1 FOR GRILLE INSTALLATION, AND SEE 2 FOR TYPICAL F/S INSTALLATION. (M06.01)
  - (C) 44X32 & 51X32 (SHOWN IN ARCH) INTAKE AND EXHAUST GRILLES FOR FUTURE TI SPACES, LOUVERS TO BE CAPPED AT INTERIOR FOR FUTURE CONNECTIONS - COORDINATE WITH SOFFIT/STORE FRONT SYSTEM. (M06.03)
  - (D) 4" DRYER EXHAUST-ROUTED SIDEWALL, SEE 8 (M06.01)
  - (E) TYPICAL DRYER DUCT TO BE CONSTRUCTED AS FOLLOWS: MATERIAL SHALL HAVE A SMOOTH INTERIOR FINISH AND 0.016 INCH THICK. RIVETS OR SCREWS PENETRATING THE DUCT WALL ARE NOT ACCEPTABLE. DRYER DUCT SHALL BE SUPPORTED EVERY 4 FOOT INTERVAL.
  - (F) REFRIGERANT LINES CAPPED AND SEALED FOR FUTURE TI CONNECTION. ROUTED FROM 1ST FLOOR CEILING SPACE TO WALL BRACKET FOR FUTURE CONDENSING UNIT.
  - (G) 10" OUTSIDE AIR TO FAN COIL, PROVIDE WITH 2-POSITION DAMPER TO OPEN WHENEVER FAN COIL OPERATES. DAMPER TO BE A LOW LEAK CLASS 1 DAMPER.
  - (H) REFRIGERANT LINES ROUTED FROM PARKING GARAGE TO 1ST FLOOR FAN COILS.
  - (I) 20X20 GREASE EXHAUST (WITH FIRE WRAP IN 30X30 SHAFT) ROUTED FROM ROOF (CAPPED) TO TI SPACE (CAPPED FOR FUTURE TI). PROVIDE VENTED CURB ADAPTER AND CAP FOR FUTURE GREASE EXHAUST FAN.
  - (J) FOUR 4" & 8X8 TRASH EXHAUST UP TO ROOF DOG HOUSE.
  - (K) DWELLING UNIT BATHROOM EXHAUST FAN TO BE SUPPLIED AND INSTALLED BY MECHANICAL CONTRACTOR. MECHANICAL TO PROVIDE VENTING FROM FAN TO SIDE WALL DISCHARGE. (M06.01) (EF 1)
  - (L) 6" RANGE HOOD EXHAUST ROUTED FROM RANGE TO EXTERIOR WALL, KEEP DUCT AS HIGH IN SPACE AS POSSIBLE, AND TERMINATE WITH A SIDE WALL VENT, WITH A BACKDRAFT DAMPER. INSULATE FINAL 5' OF DUCTWORK.
  - (M) PTHP DETAIL, SEE (M06.01)
  - (N) EXTERIOR EXHAUST PLENUM, SEE (M06.01)
  - (O) 54X24 OR 40X30 GARAGE EXHAUSTS UP FROM GARAGE, THROUGH PT AND UP THROUGH ROOF.
  - (P) 8X8 BASEMENT TRASH EXHAUST, TRANSITION TO 10" INTO GREENHECK GRSR WITH 10" THROAT.
  - (Q) 4" BATH EXHAUST FROM 1ST LEVEL TO CONNECT INTO 6" BATH EXHAUST FROM 2ND LEVEL LOFT TO SIDEWALL PLENUM.
  - (R) VENT TYPE-2 RANGE HOOD TO SIDE WALL TERMINATION.
  - (S) 4" BATH EXHAUST & DRYER AND 6" RANGE VENT UP TO LEVEL 2.

**SHAFT DUCT SIZES**

FLOOR	SUPPLY AIR	CFM	RETURN AIR	CFM	UNIT
ATTIC	24 X 26	4000	NA	NA	RTU-1
5TH	24 X 26	4000	NA	NA	RTU-1
4TH	24 X 24	3200	NA	NA	RTU-1
3RD	24 X 24	2400	NA	NA	RTU-1
2ND	24 X 22	1600	NA	NA	RTU-1
1ST	24 X 20	800	NA	NA	RTU-1

**SHAFT DUCT SIZES**

FLOOR	SUPPLY AIR	CFM	RETURN AIR	CFM	UNIT
ATTIC	24 X 26	4000	NA	NA	RTU-2
5TH	24 X 26	4000	NA	NA	RTU-2
4TH	24 X 24	3000	NA	NA	RTU-2
3RD	24 X 24	2000	NA	NA	RTU-2
2ND	24 X 24	1000	NA	NA	RTU-2

**VENTILATION CALCULATIONS:**

ALL DWELLING UNITS ARE VENTILATED BY MECHANICAL VENTILATION, BATHROOM EXHAUST FANS RUN CONTINUOUSLY (SIZED PER ASHRAE 62.2) AND MAKE UP AIR IS PROVIDED BY PTHP'S.

COMMON SPACES AND HALLWAYS ARE VENTILATED BY PACKAGED ROOF TOP UNITS SIZED TO EXCEED THE MINIMUM 0.06 CFM/SQ FT REQUIREMENT

SEE VENTILATION SCHEDULES FOR OTHER UNITS


1 MECH PLAN - LEVEL 5  
SCALE: 1/8" = 1'-0"





308 SW First Avenue  
 Suite 200  
 Portland, OR 97204  
 Phone: (503) 226-2840  
 Fax: (503) 226-2807  
 leebarc.com

Leeb Architects

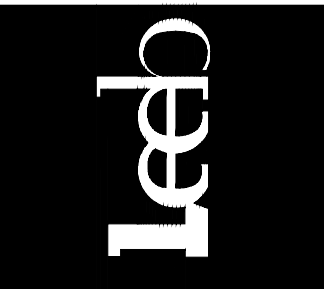


Consulting Engineers  
 2007 S.E. Ash St.  
 Portland, OR 97214  
 PHN: (503) 234-0548  
 FAX: (503) 234-0877  
 WWW.MFLA-ENG.COM  
 CONTACT: MARK DENYER

Project Title: MODERA WOODSTOCK APARTMENTS  
 MILL CREEK RESIDENTIAL  
 2200 NW 2ND AVENUE SUITE 900  
 PORTLAND, OR 97209

Revision:  
 4.29.20 - ADD #2 Permit Checksheet Response #2  
 AS 07 9 17.20 - Plan Check / CMP  
 AS 10 - 9 16.22 Construction Set Revisions

Drawing Title: MECH PLAN - ROOF  
 Date: 12.20.19  
 Drawn by: MFL/Jacobs  
 Project No.: A16-20

M02.08

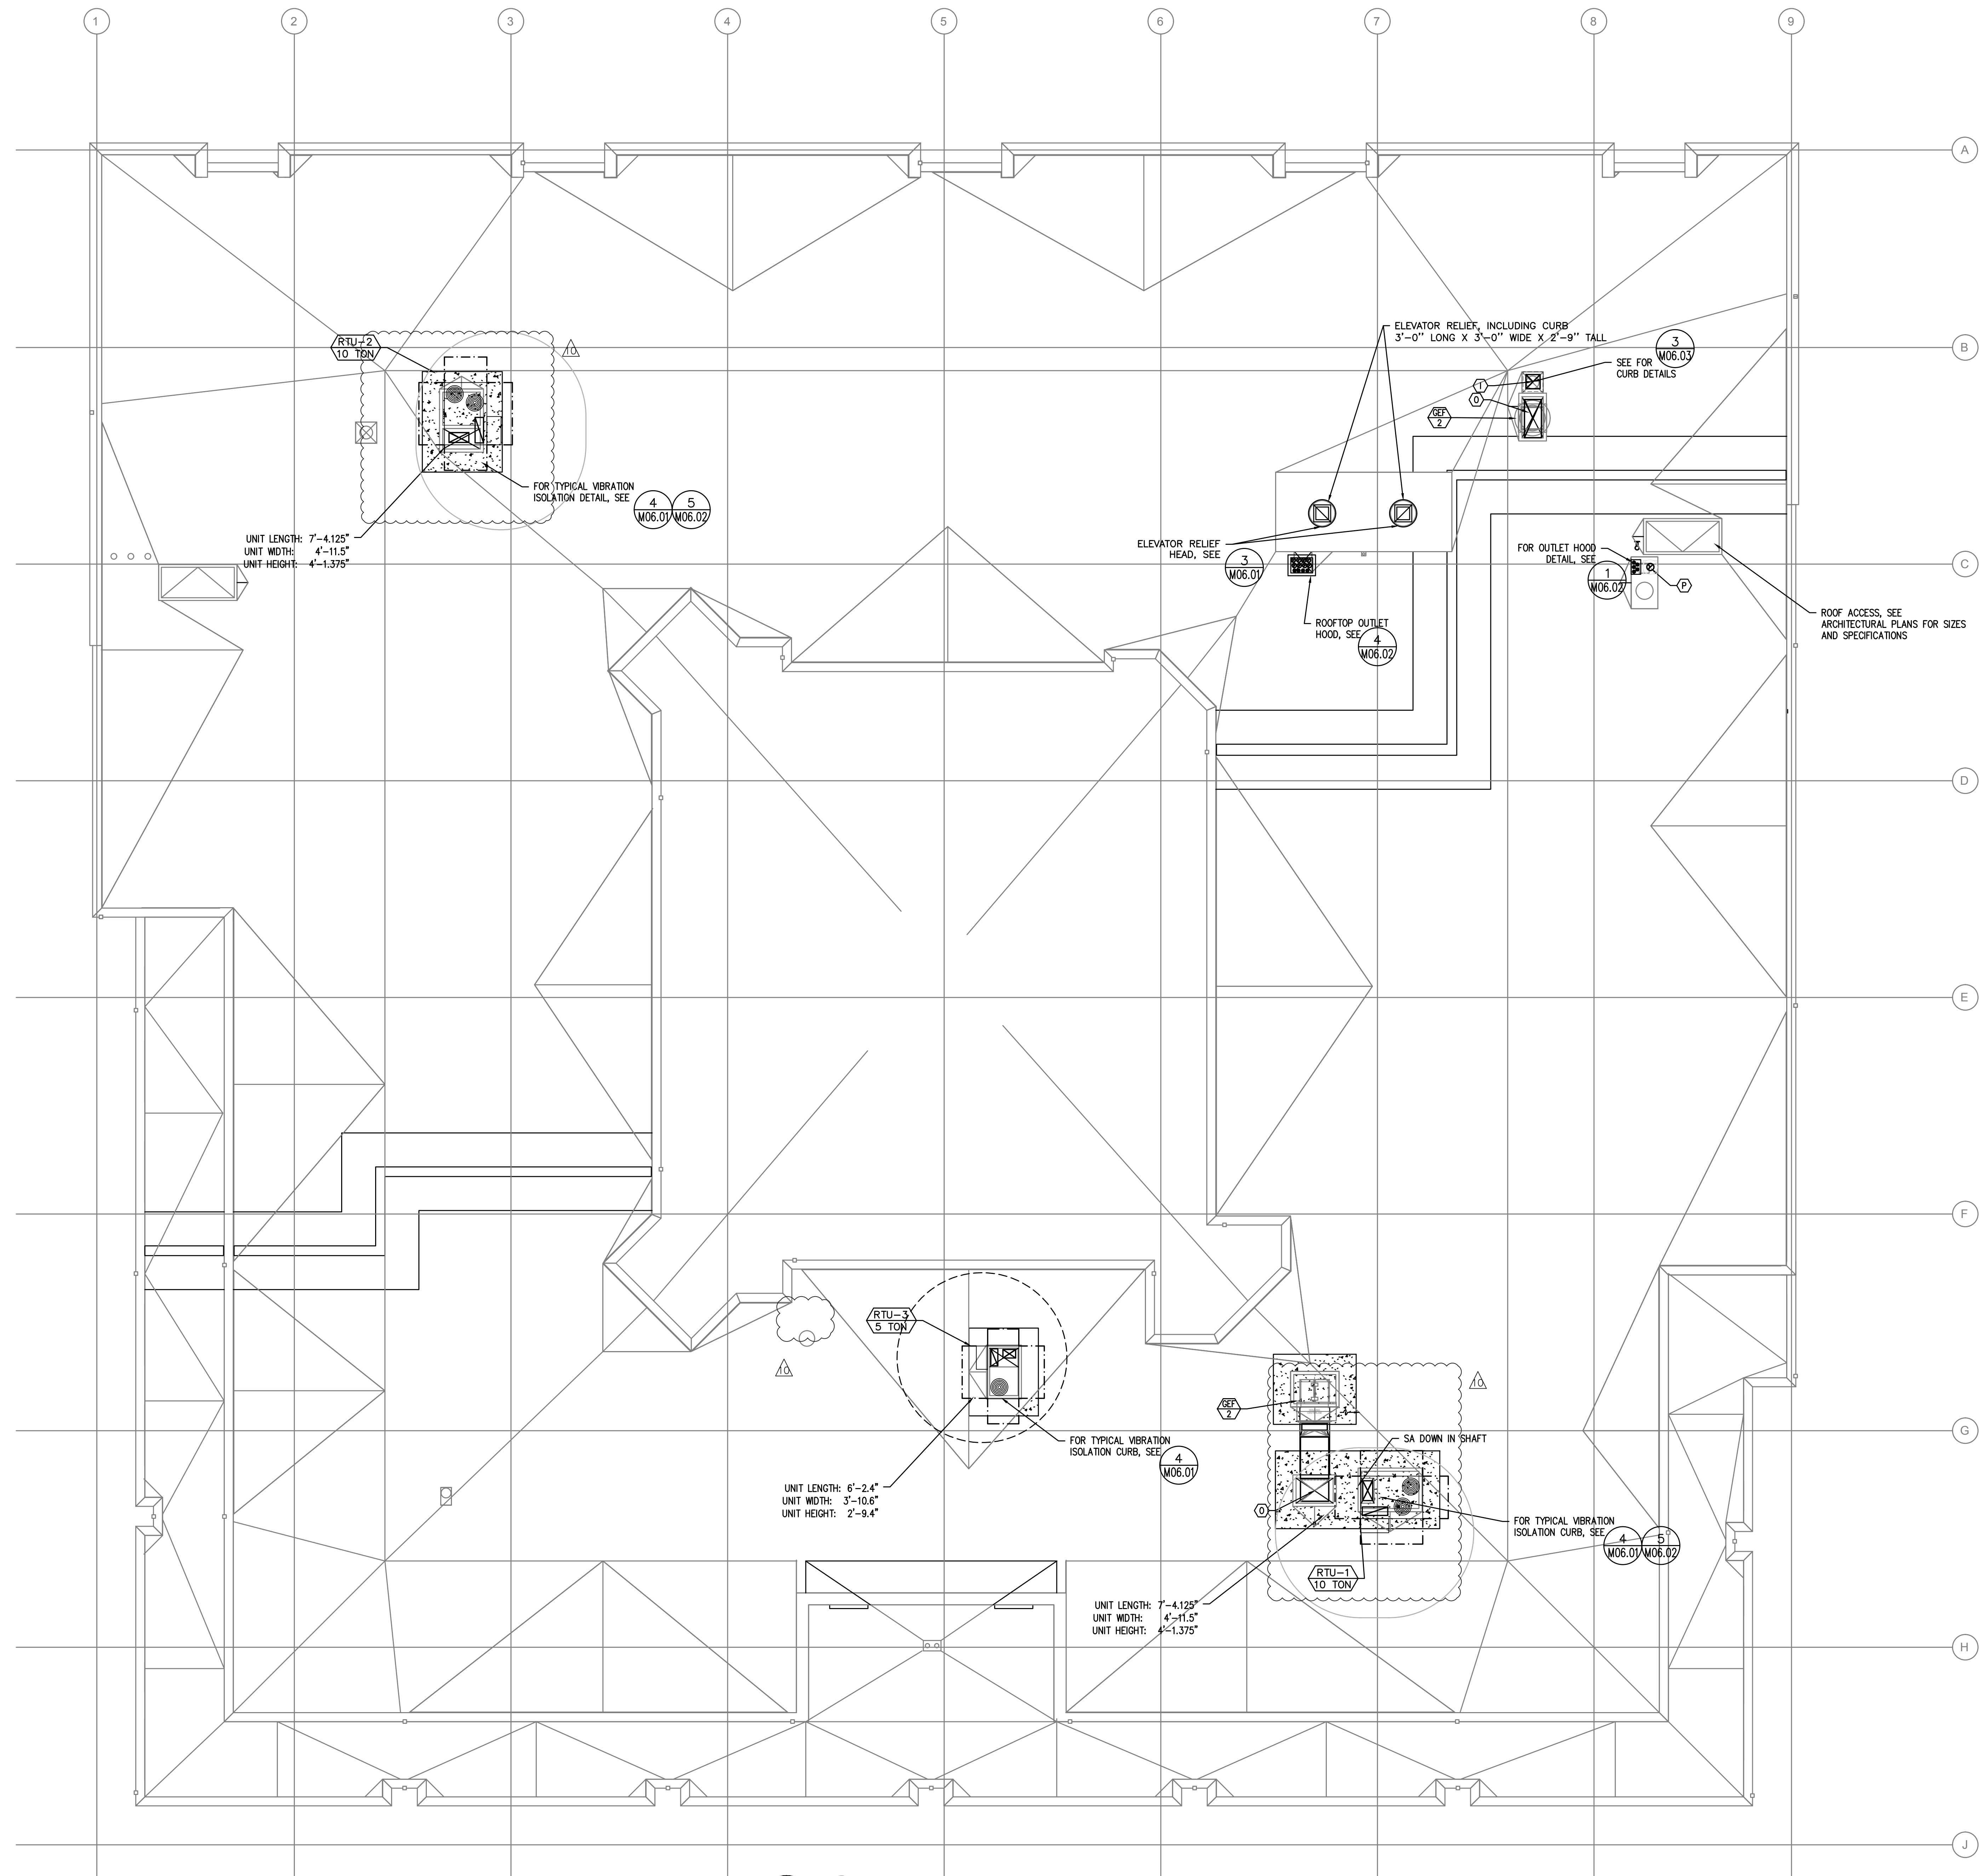

**GENERAL NOTES:**

- (A) SUPPLY DUCT FROM ROOF TO 2ND FLOOR CEILING - TRANSITION TO SMALLER DUCT SIZES AFTER SUPPLY BRANCH TAKE OFF, SEE CHART.
- (B) SUPPLY AIR OR RETURN GRILLE, SIZED FOR BOTH FREE AREA AND FOR ACTUATOR ACCESS, SEE 1 FOR GRILLE INSTALLATION, AND SEE 2 FOR TYPICAL F/S INSTALLATION. (M06.01)
- (C) 44X32 & 51X32 (SHOWN IN ARCH) INTAKE AND EXHAUST GRILLES FOR FUTURE TI SPACES, LOUVERS TO BE CAPPED AT INTERIOR FOR FUTURE CONNECTIONS - COORDINATE WITH SOFFIT/STORE FRONT SYSTEM. (M06.03)
- (D) 4" DRYER EXHAUST-ROUTED SIDEWALL, SEE 8 (M06.01)
- (E) TYPICAL DRYER DUCT TO BE CONSTRUCTED AS FOLLOWS: MATERIAL SHALL HAVE A SMOOTH INTERIOR FINISH AND 0.016 INCH THICK. RIVETS OR SCREWS PENETRATING THE DUCT WALL ARE NOT ACCEPTABLE. DRYER DUCT SHALL BE SUPPORTED EVERY 4 FOOT INTERVAL.
- (F) REFRIGERANT LINES CAPPED AND SEALED FOR FUTURE TI CONNECTION. ROUTED FROM 1ST FLOOR CEILING SPACE TO WALL BRACKET FOR FUTURE CONDENSING UNIT.
- (G) 10" OUTSIDE AIR TO FAN COIL, PROVIDE WITH 2-POSITION DAMPER TO OPEN WHENEVER FAN COIL OPERATES. DAMPER TO BE A LOW LEAK CLASS 1 DAMPER.
- (H) REFRIGERANT LINES ROUTED FROM PARKING GARAGE TO 1ST FLOOR FAN COILS.
- (I) 20X20 GREASE EXHAUST (WITH FIRE WRAP IN 30X30 SHAFT) ROUTED FROM ROOF (CAPPED) TO TI SPACE (CAPPED FOR FUTURE TI). PROVIDE VENTED CURB ADAPTER AND CAP FOR FUTURE GREASE EXHAUST FAN.
- (J) FOUR 4" & 8X8 TRASH EXHAUST UP TO ROOF DOG HOUSE.
- (K) DWELLING UNIT BATHROOM EXHAUST FAN TO BE SUPPLIED AND INSTALLED BY MECHANICAL CONTRACTOR. MECHANICAL TO PROVIDE VENTING FROM FAN TO SIDE WALL DISCHARGE. (M06.01) (EF 1)
- (L) 6" RANGE HOOD EXHAUST ROUTED FROM RANGE TO EXTERIOR WALL, KEEP DUCT AS HIGH IN SPACE AS POSSIBLE, AND TERMINATE WITH A SIDE WALL VENT, WITH A BACKDRAFT DAMPER. INSULATE FINAL 5' OF DUCTWORK.
- (M) PTHP DETAIL, SEE 7 (M06.01)
- (N) EXTERIOR EXHAUST PLENUM, SEE 5 (M06.01)
- (O) 54X24 OR 40X30 GARAGE EXHAUSTS UP FROM GARAGE, THROUGH PT AND UP THROUGH ROOF.
- (P) 8X8 BASEMENT TRASH EXHAUST, TRANSITION TO 10" INTO GREENHECK GRSR WITH 10" THROAT.
- (Q) 4" BATH EXHAUST FROM 1ST LEVEL TO CONNECT INTO 6" BATH EXHAUST FROM 2ND LEVEL LOFT TO SIDEWALL PLENUM.
- (R) VENT TYPE-2 RANGE HOOD TO SIDE WALL TERMINATION.
- (S) 4" BATH EXHAUST & DRYER AND 6" RANGE VENT UP TO LEVEL 2.

**SHAFT DUCT SIZES**

FLOOR	SUPPLY AIR	CFM	RETURN AIR	CFM	UNIT
ATTIC	24 X 26	4000	NA	NA	RTU-1
5TH	24 X 26	4000	NA	NA	RTU-1
4TH	24 X 24	3200	NA	NA	RTU-1
3RD	24 X 24	2400	NA	NA	RTU-1
2ND	24 X 22	1600	NA	NA	RTU-1
1ST	24 X 20	800	NA	NA	RTU-1

**SHAFT DUCT SIZES**

FLOOR	SUPPLY AIR	CFM	RETURN AIR	CFM	UNIT
ATTIC	24 X 26	4000	NA	NA	RTU-2
5TH	24 X 26	4000	NA	NA	RTU-2
4TH	24 X 24	3000	NA	NA	RTU-2
3RD	24 X 24	2000	NA	NA	RTU-2
2ND	24 X 24	1000	NA	NA	RTU-2

**VENTILATION CALCULATIONS:**

ALL DWELLING UNITS ARE VENTILATED BY MECHANICAL VENTILATION, BATHROOM EXHAUST FANS RUN CONTINUOUSLY (SIZED PER ASHRAE 62.2) AND MAKE UP AIR IS PROVIDED BY PTHP'S.

COMMON SPACES AND HALLWAYS ARE VENTILATED BY PACKAGED ROOF TOP UNITS SIZED TO EXCEED THE MINIMUM 0.06 CFM/SQ FT REQUIREMENT

SEE VENTILATION SCHEDULES FOR OTHER UNITS


1 MECH PLAN - ROOF  
 SCALE: 1/8" = 1'-0"





308 SW First Avenue  
Suite 200  
Portland, OR 97204  
Phone: (503) 226-2840  
Fax: (503) 226-2807  
leebarc.com

Leeb Architects

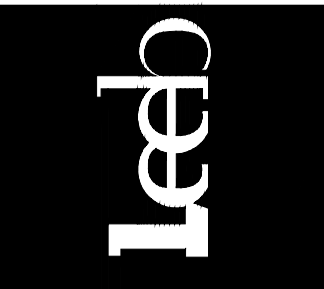


MPIA Consulting Engineers  
2007 S.E. Ash St.  
Portland, OR 97214  
PH: (503) 234-0548  
FAX: (503) 234-0877  
WWW.MPIA-ENG.COM  
CONTACT: MARK DENYER

Project Title:  
**MODERA WOODSTOCK**  
APARTMENTS  
MILL CREEK RESIDENTIAL  
2200 NW 2ND AVENUE SUITE 900  
PORTLAND, OR 97209

Revision	Date
4.29.20 - ADD #2 Permit Checksheet Response #2	12.20.19
AS 07 9.17.20 - Plan Check / CMP	
AS 10 - 9.16.22 Construction Set Revisions	

Drawing Title:  
**CONDENSATE PLAN - BASEMENT**

M03.00

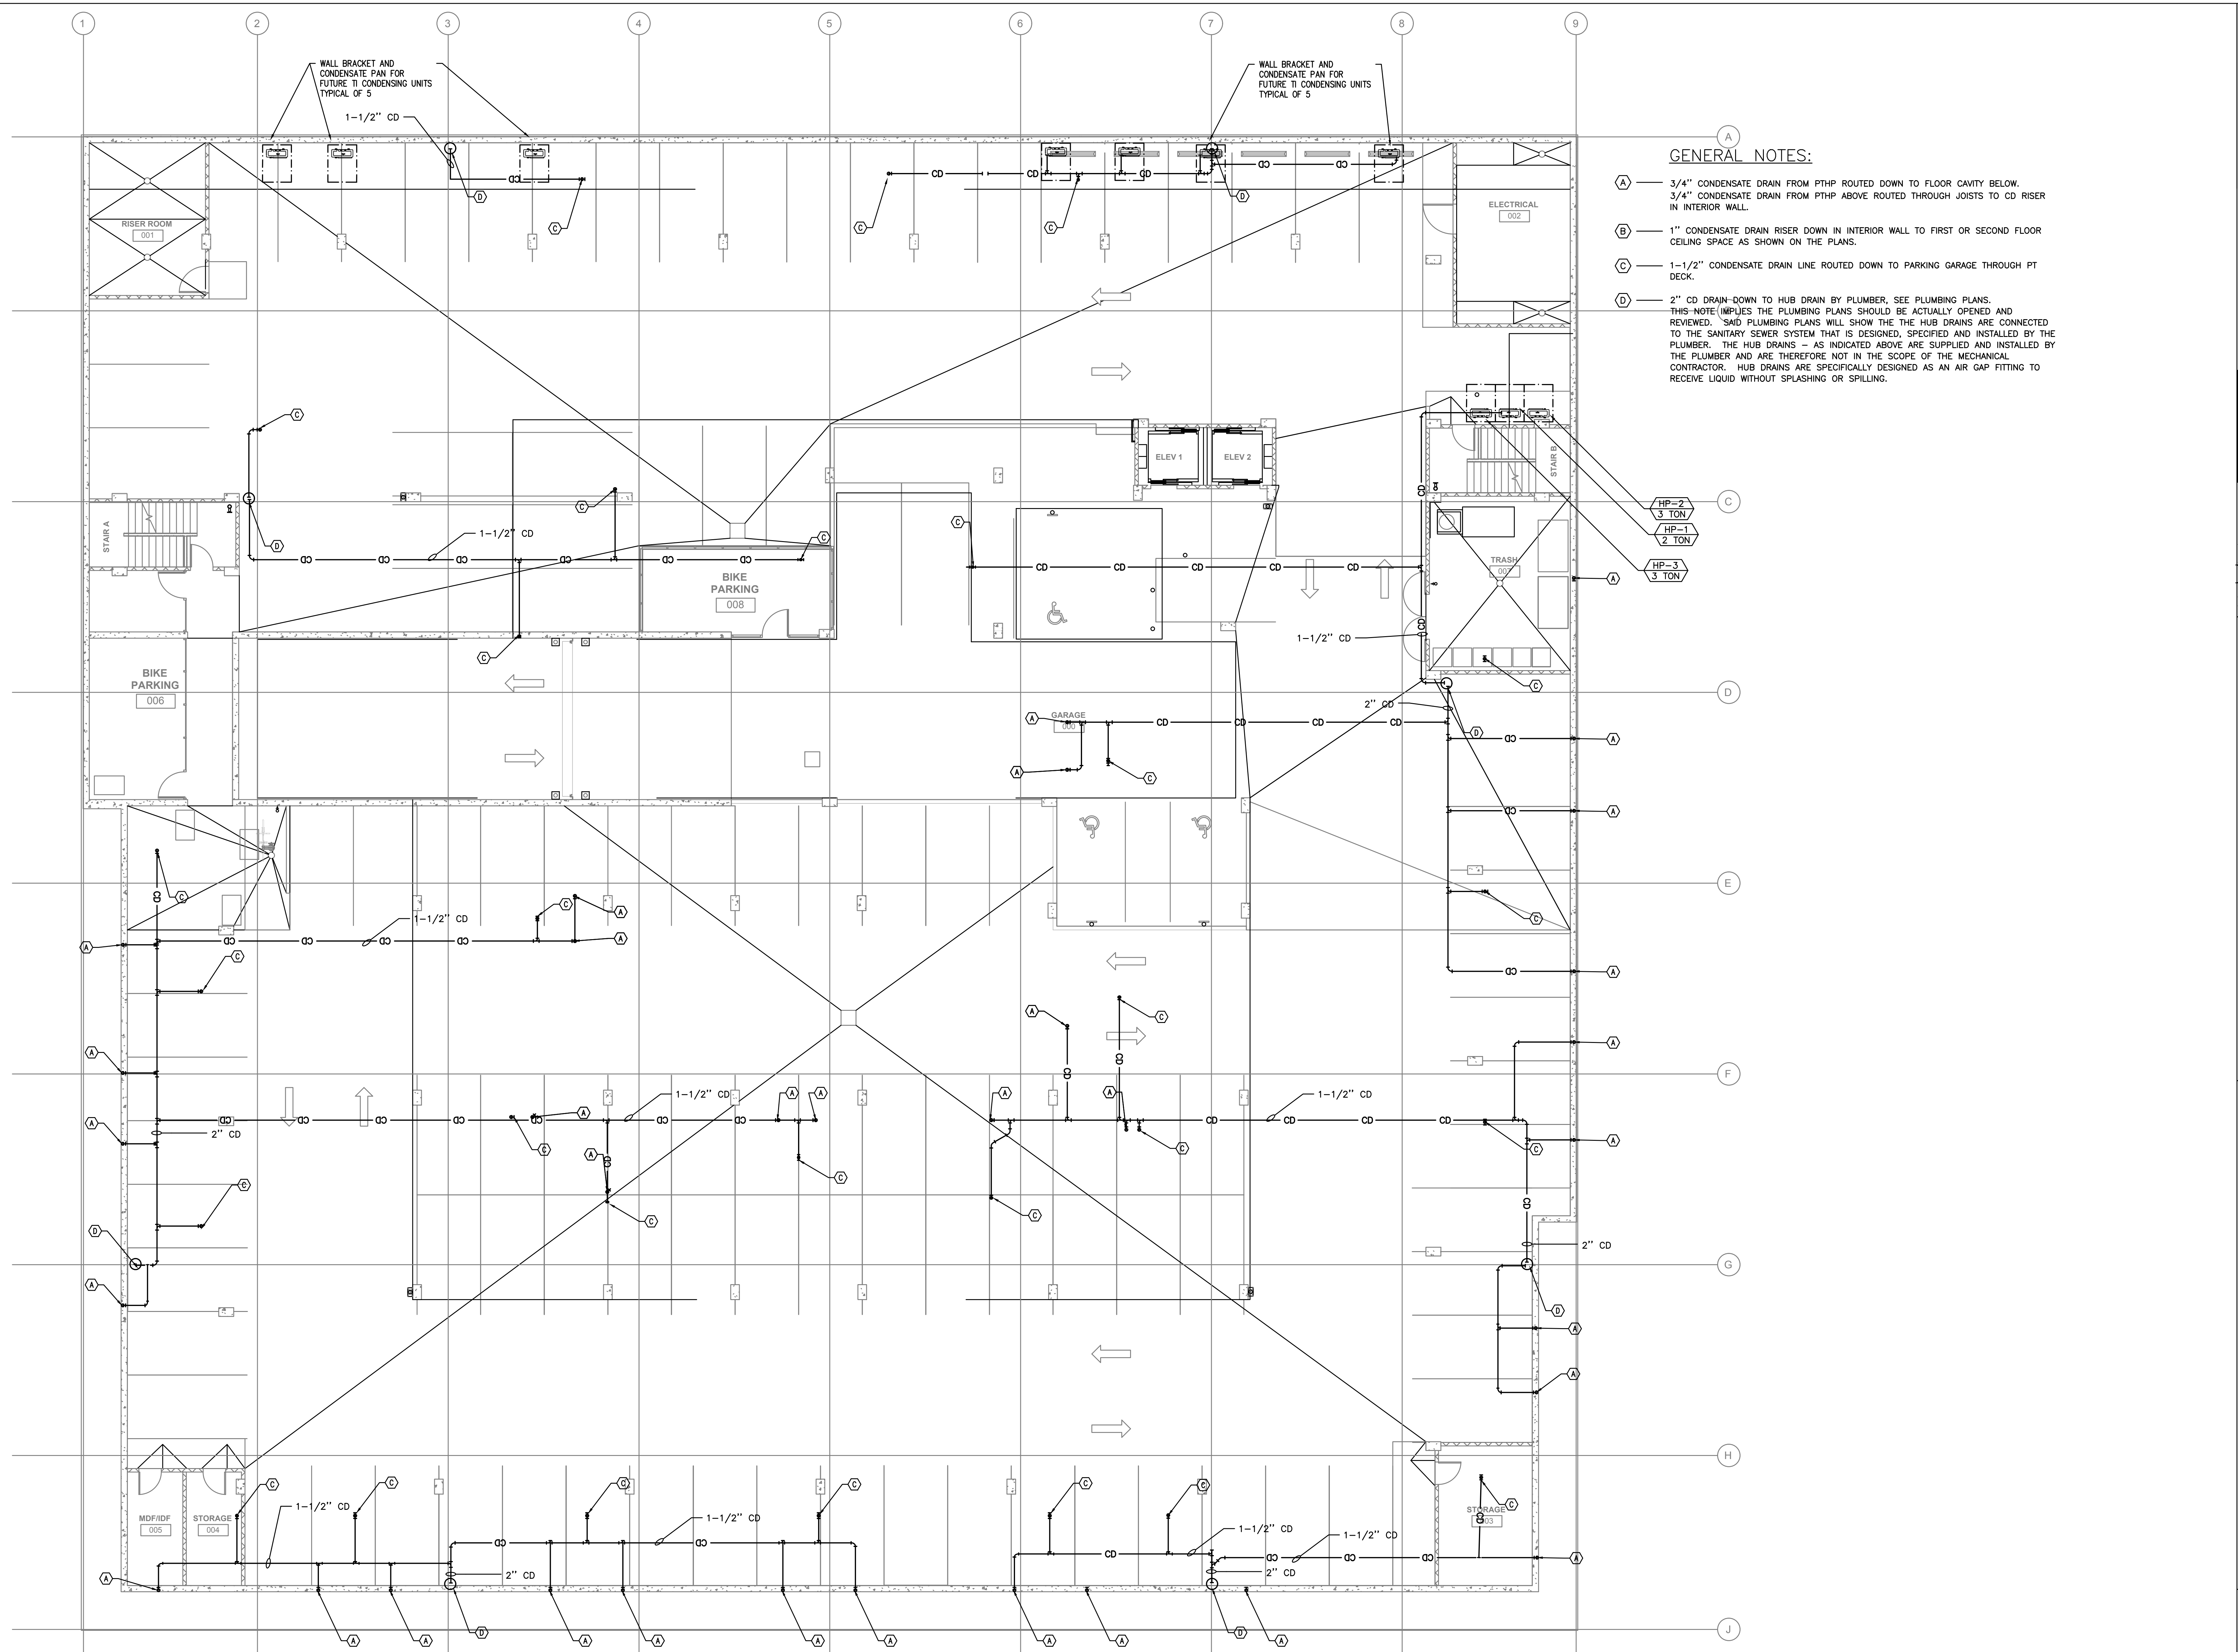

- GENERAL NOTES:**
- (A) 3/4" CONDENSATE DRAIN FROM PTHP ROUTED DOWN TO FLOOR CAVITY BELOW. 3/4" CONDENSATE DRAIN FROM PTHP ABOVE ROUTED THROUGH JOISTS TO CD RISER IN INTERIOR WALL.
  - (B) 1" CONDENSATE DRAIN RISER DOWN IN INTERIOR WALL TO FIRST OR SECOND FLOOR CEILING SPACE AS SHOWN ON THE PLANS.
  - (C) 1-1/2" CONDENSATE DRAIN LINE ROUTED DOWN TO PARKING GARAGE THROUGH PT DECK.
  - (D) 2" CD DRAIN-DOWN TO HUB DRAIN BY PLUMBER. SEE PLUMBING PLANS. THIS NOTE IMPLIES THE PLUMBING PLANS SHOULD BE ACTUALLY OPENED AND REVIEWED. SAID PLUMBING PLANS WILL SHOW THE HUB DRAINS ARE CONNECTED TO THE SANITARY SEWER SYSTEM THAT IS DESIGNED, SPECIFIED AND INSTALLED BY THE PLUMBER. THE HUB DRAINS - AS INDICATED ABOVE ARE SUPPLIED AND INSTALLED BY THE PLUMBER AND ARE THEREFORE NOT IN THE SCOPE OF THE MECHANICAL CONTRACTOR. HUB DRAINS ARE SPECIFICALLY DESIGNED AS AN AIR GAP FITTING TO RECEIVE LIQUID WITHOUT SPLASHING OR SPILLING.


**1 CONDENSATE PLAN - BASEMENT**  
SCALE: 1/8" = 1'-0"





308 SW First Avenue  
Suite 200  
Portland, OR 97204  
Phone: (503) 226-2840  
Fax: (503) 226-2807  
leebarc.com

Leeb Architects

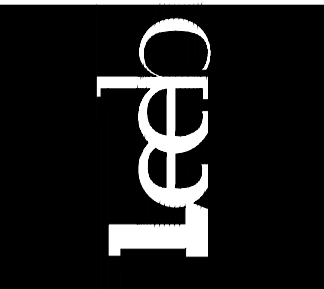


Consulting Engineers  
2007 S.E. Ash St.  
Portland, OR 97214  
PH: (503) 234-0548  
FAX: (503) 234-0877  
WWW.MPIA-ENG.COM  
CONTACT: MARK DENYER

Project Title:  
**MODERA WOODSTOCK**  
APARTMENTS  
MILL CREEK RESIDENTIAL  
2200 NW 2ND AVENUE SUITE 900  
PORTLAND, OR 97209

Revision:	4.29.20 - ADD #2 Permit Checklist Response #2
Date:	12.20.19
Drawn by:	MFA/Jacobs
Project No.:	ATB-20

Drawing Title:  
**CONDENSATE PLAN - LEVEL 1**


M03.01

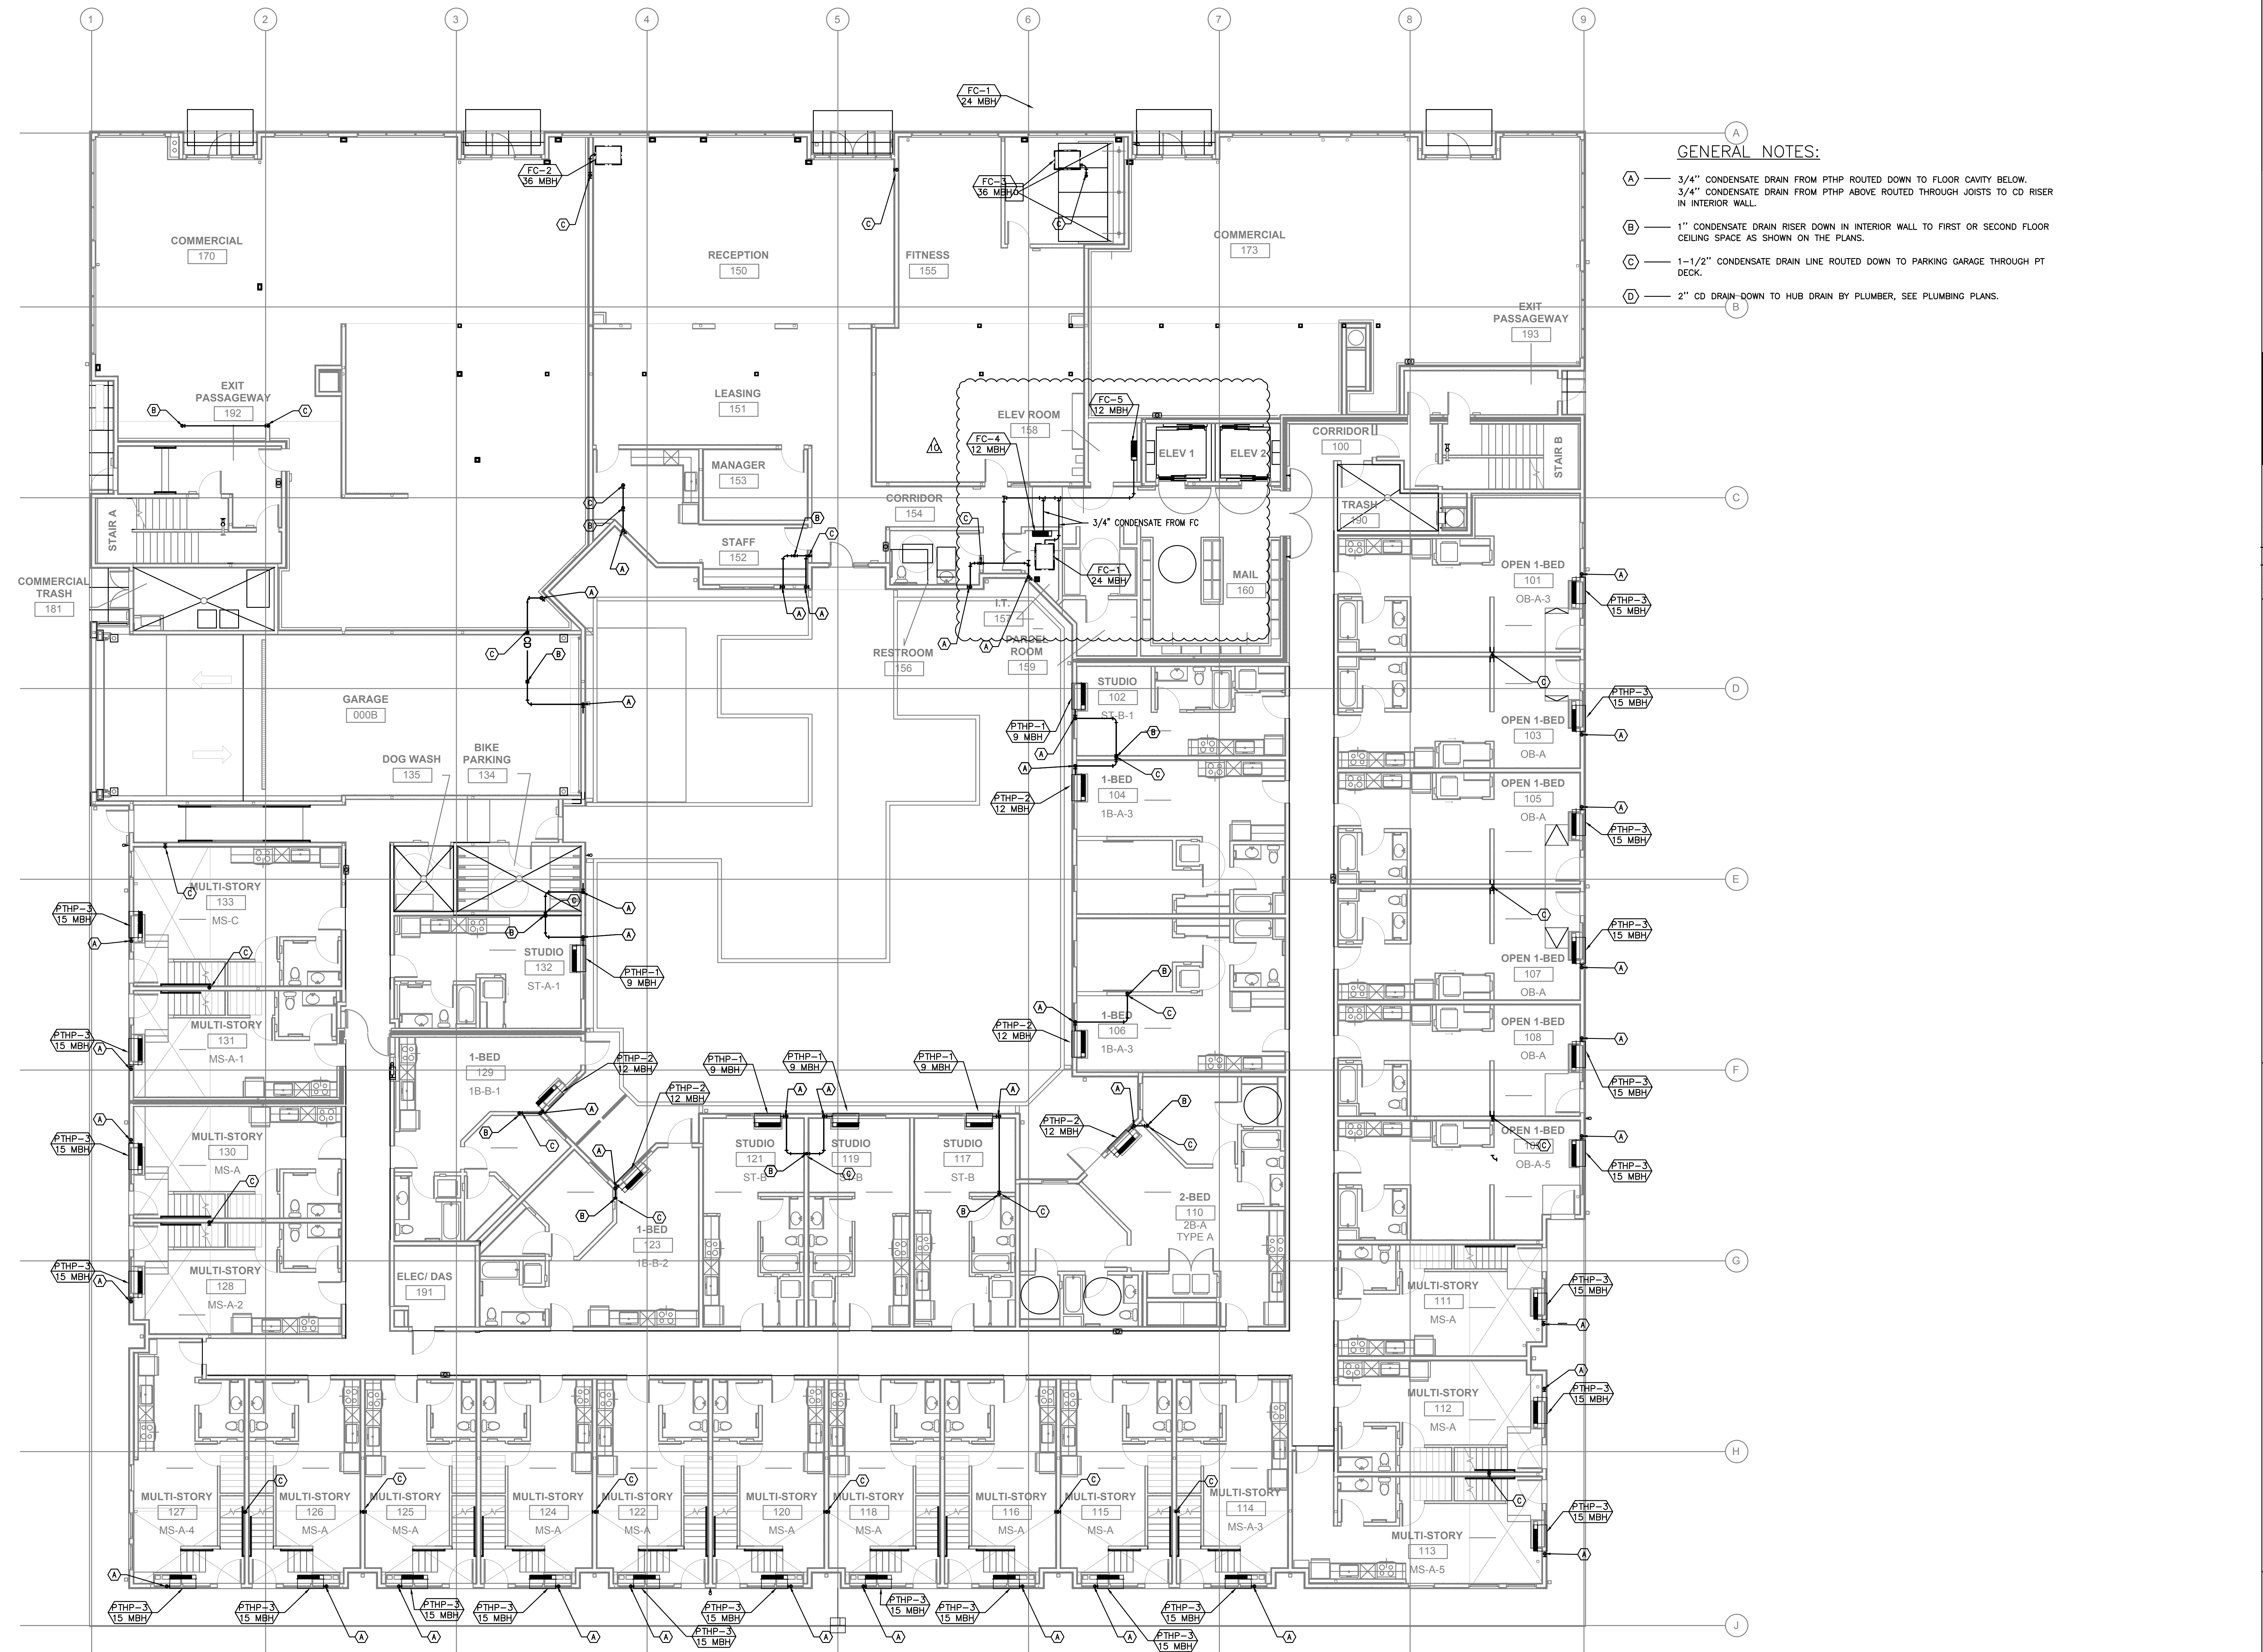

- GENERAL NOTES:**
- (A) 3/4" CONDENSATE DRAIN FROM PTHP ROUTED DOWN TO FLOOR CAVITY BELOW.  
3/4" CONDENSATE DRAIN FROM PTHP ABOVE ROUTED THROUGH JOISTS TO CD RISER IN INTERIOR WALL.
  - (B) 1" CONDENSATE DRAIN RISER DOWN IN INTERIOR WALL TO FIRST OR SECOND FLOOR CEILING SPACE AS SHOWN ON THE PLANS.
  - (C) 1-1/2" CONDENSATE DRAIN LINE ROUTED DOWN TO PARKING GARAGE THROUGH PT DECK.
  - (D) 2" CD DRAIN-DOWN TO HUB DRAIN BY PLUMBER, SEE PLUMBING PLANS.

**1 CONDENSATE PLAN - LEVEL 1**  
SCALE: 1/8" = 1'-0"



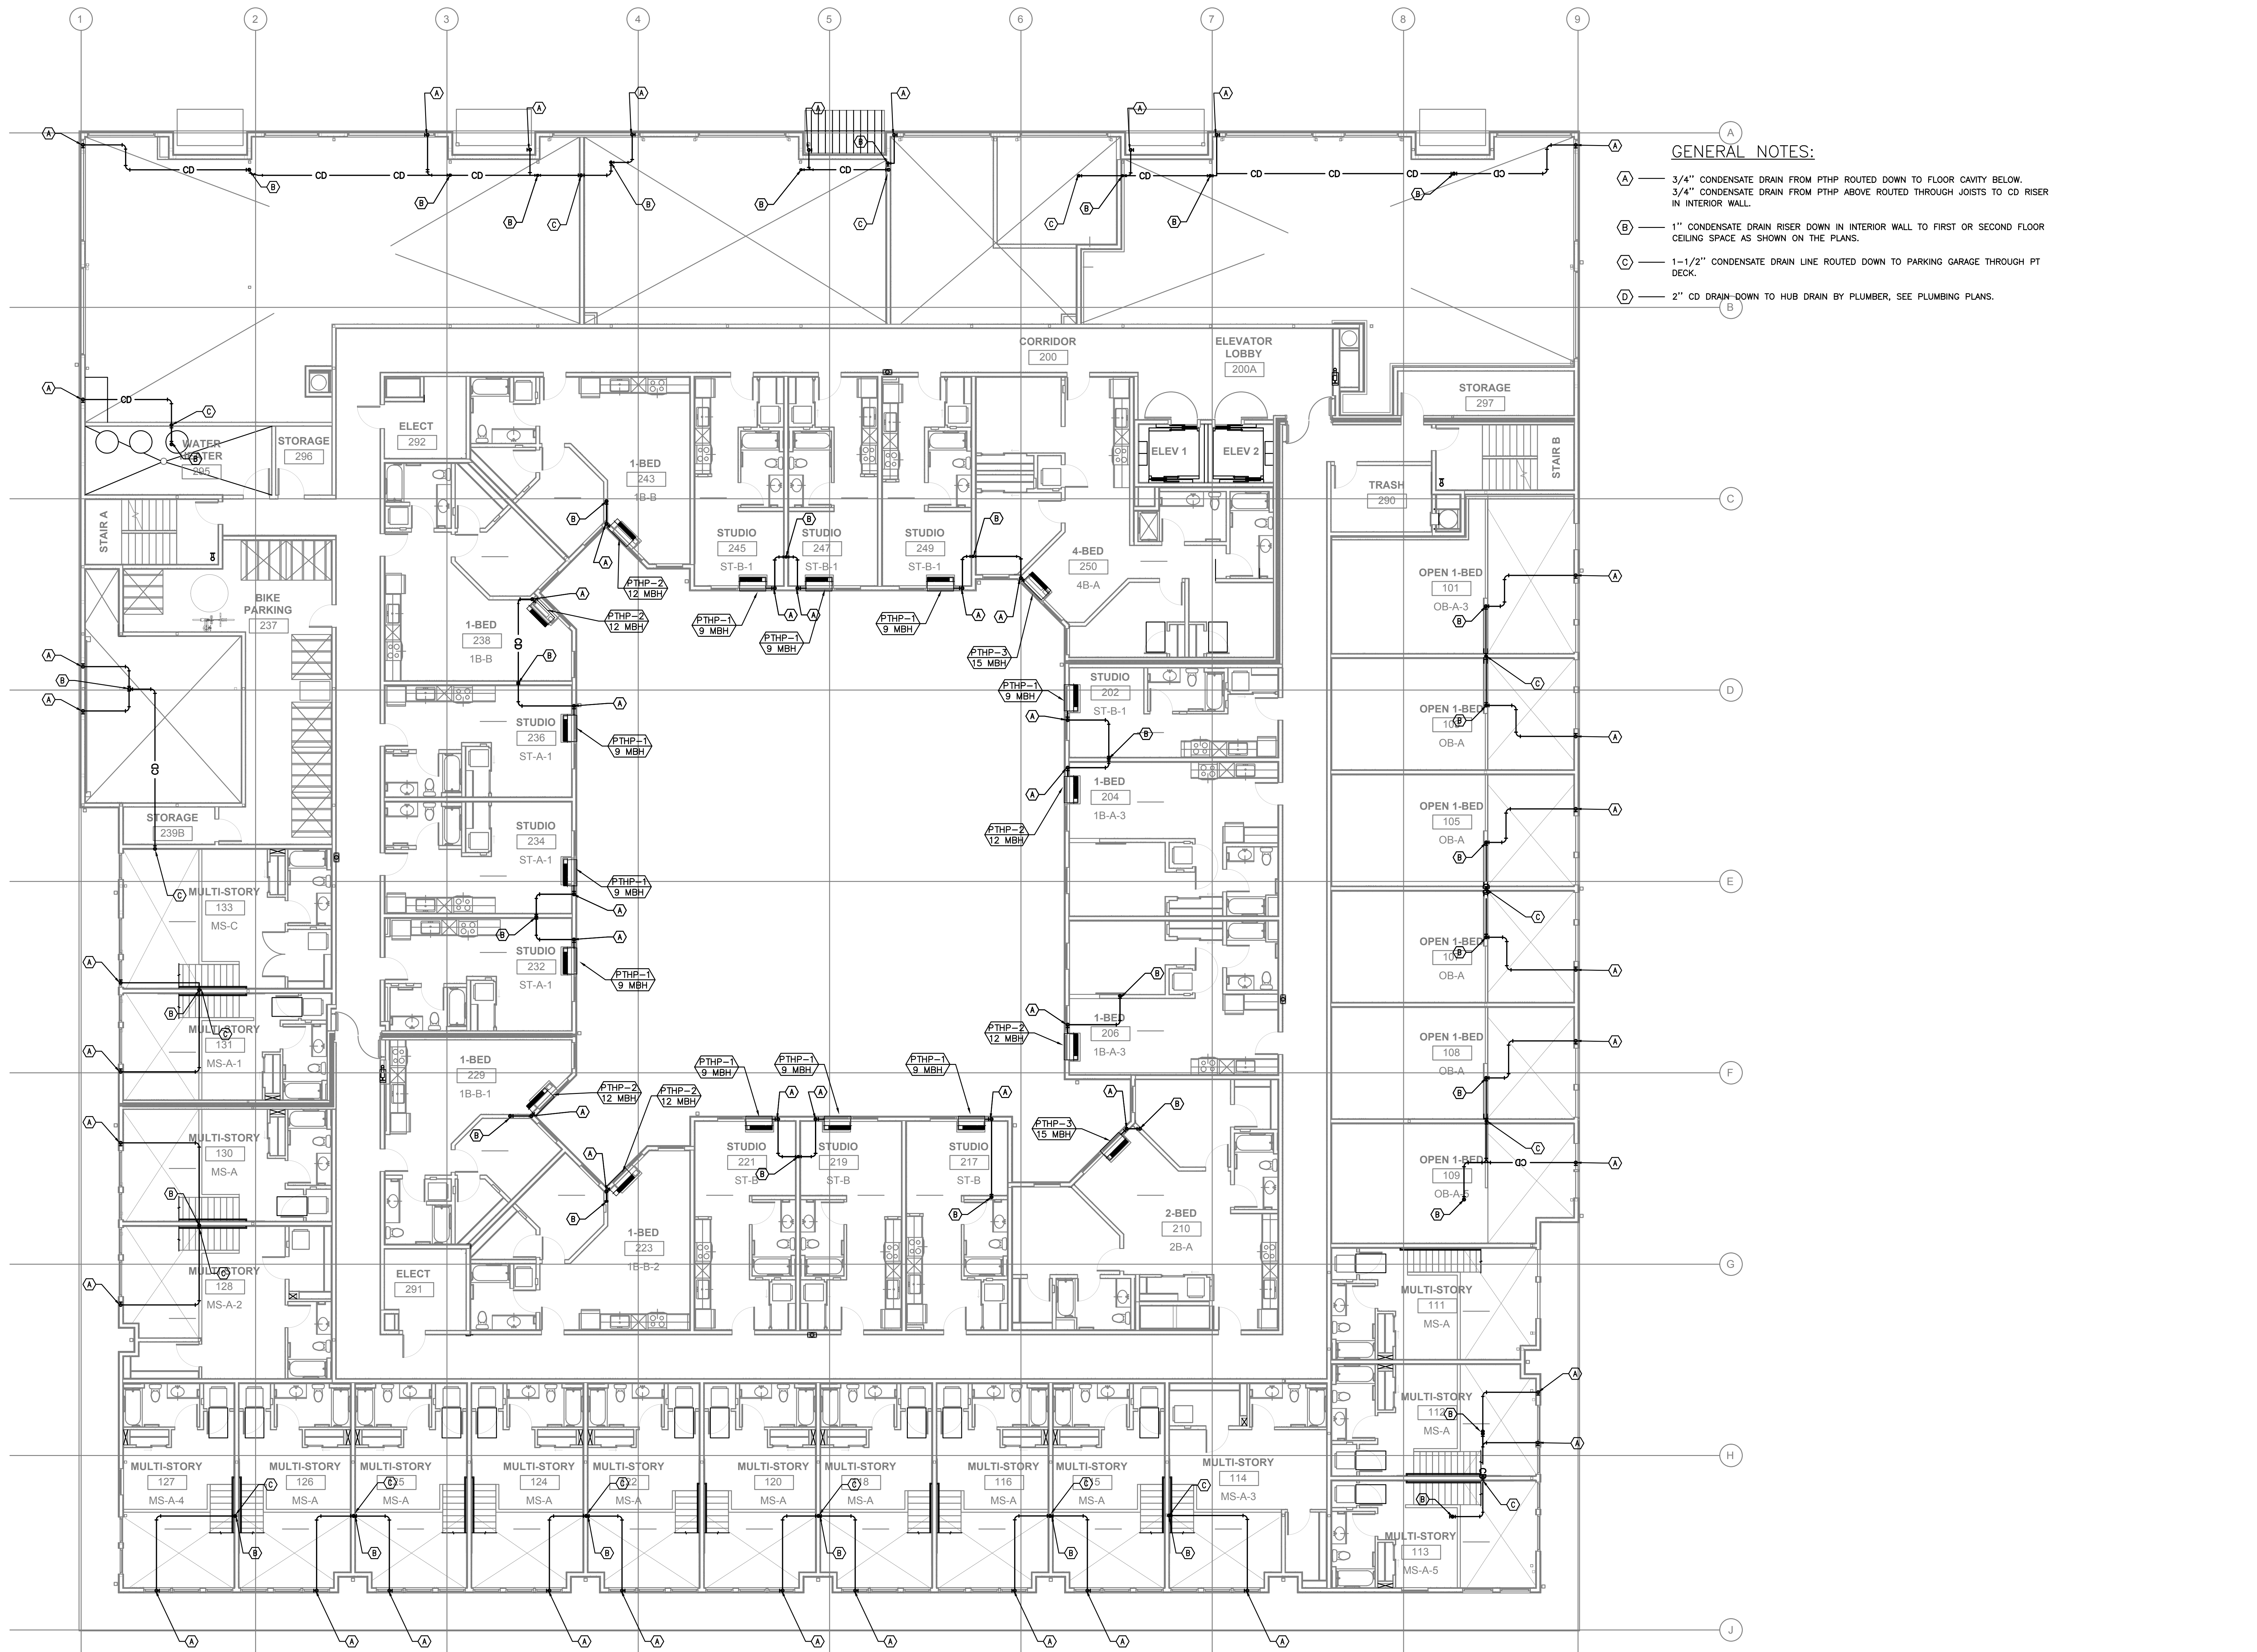

**GENERAL NOTES:**


- (A) 3/4" CONDENSATE DRAIN FROM PTHP ROUTED DOWN TO FLOOR CAVITY BELOW.
- (B) 3/4" CONDENSATE DRAIN FROM PTHP ABOVE ROUTED THROUGH JOISTS TO CD RISER IN INTERIOR WALL.
- (C) 1" CONDENSATE DRAIN RISER DOWN IN INTERIOR WALL TO FIRST OR SECOND FLOOR CEILING SPACE AS SHOWN ON THE PLANS.
- (D) 1-1/2" CONDENSATE DRAIN LINE ROUTED DOWN TO PARKING GARAGE THROUGH PT DECK.
- (E) 2" CD DRAIN-DOWN TO HUB DRAIN BY PLUMBER, SEE PLUMBING PLANS.

**1 CONDENSATE PLAN - LEVEL 2**  
 SCALE: 1/8" = 1'-0"



308 SW First Avenue  
 Suite 200  
 Portland, OR 97204  
 Phone: (503) 234-2640  
 Fax: (503) 234-2607  
 leebarc.com

**Leeb Architects**

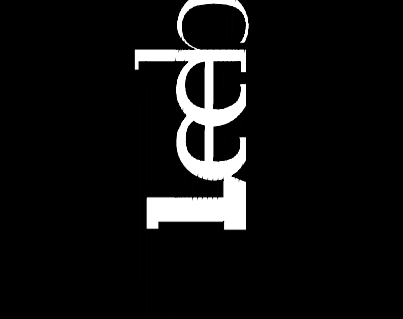

**M&A** Consulting Engineers  
 2007 S.E. Ash St.  
 Portland, OR 97214  
 PHN: (503) 234-0548  
 FAX: (503) 234-0877  
 WWW.M&A-ENG.COM  
 CONTACT: MARK DENYER

Project Title: **MODERA WOODSTOCK**  
 APARTMENTS  
 MILL CREEK RESIDENTIAL  
 2200 NW 2ND AVENUE SUITE 900  
 PORTLAND, OR 97209

Drawing Title:	CONDENSATE PLAN - LEVEL 2
Date:	12.20.19
Revision:	4.29.20 - ADD #2 Permit Checksheet Response #2
Drawn by:	MFA/Jacobs
Project No.:	ATB-20


**M03.02**





308 SW First Avenue  
Suite 200  
Portland, OR 97204  
Phone: (503) 229-2940  
Fax: (503) 229-2947  
leebarc.com

Leeb Architects

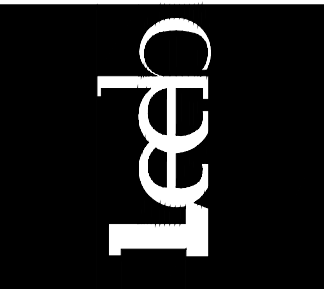


Consulting Engineers  
2007 S.E. Ash St.  
Portland, OR 97214  
PH: (503) 234-0548  
FAX: (503) 234-0877  
WWW.MFIA-ENG.COM  
CONTACT: MARK DENVER

Project Title:  
**MODERA WOODSTOCK**  
APARTMENTS  
MILL CREEK RESIDENTIAL  
2200 NW 2ND AVENUE SUITE 900  
PORTLAND, OR 97209

Revision:	4.29.20 - ADD #2 Permit Checksheet Response #2
Date:	12.20.19
Drawn by:	MF/leeb
Project No.:	A19-20

M03.03

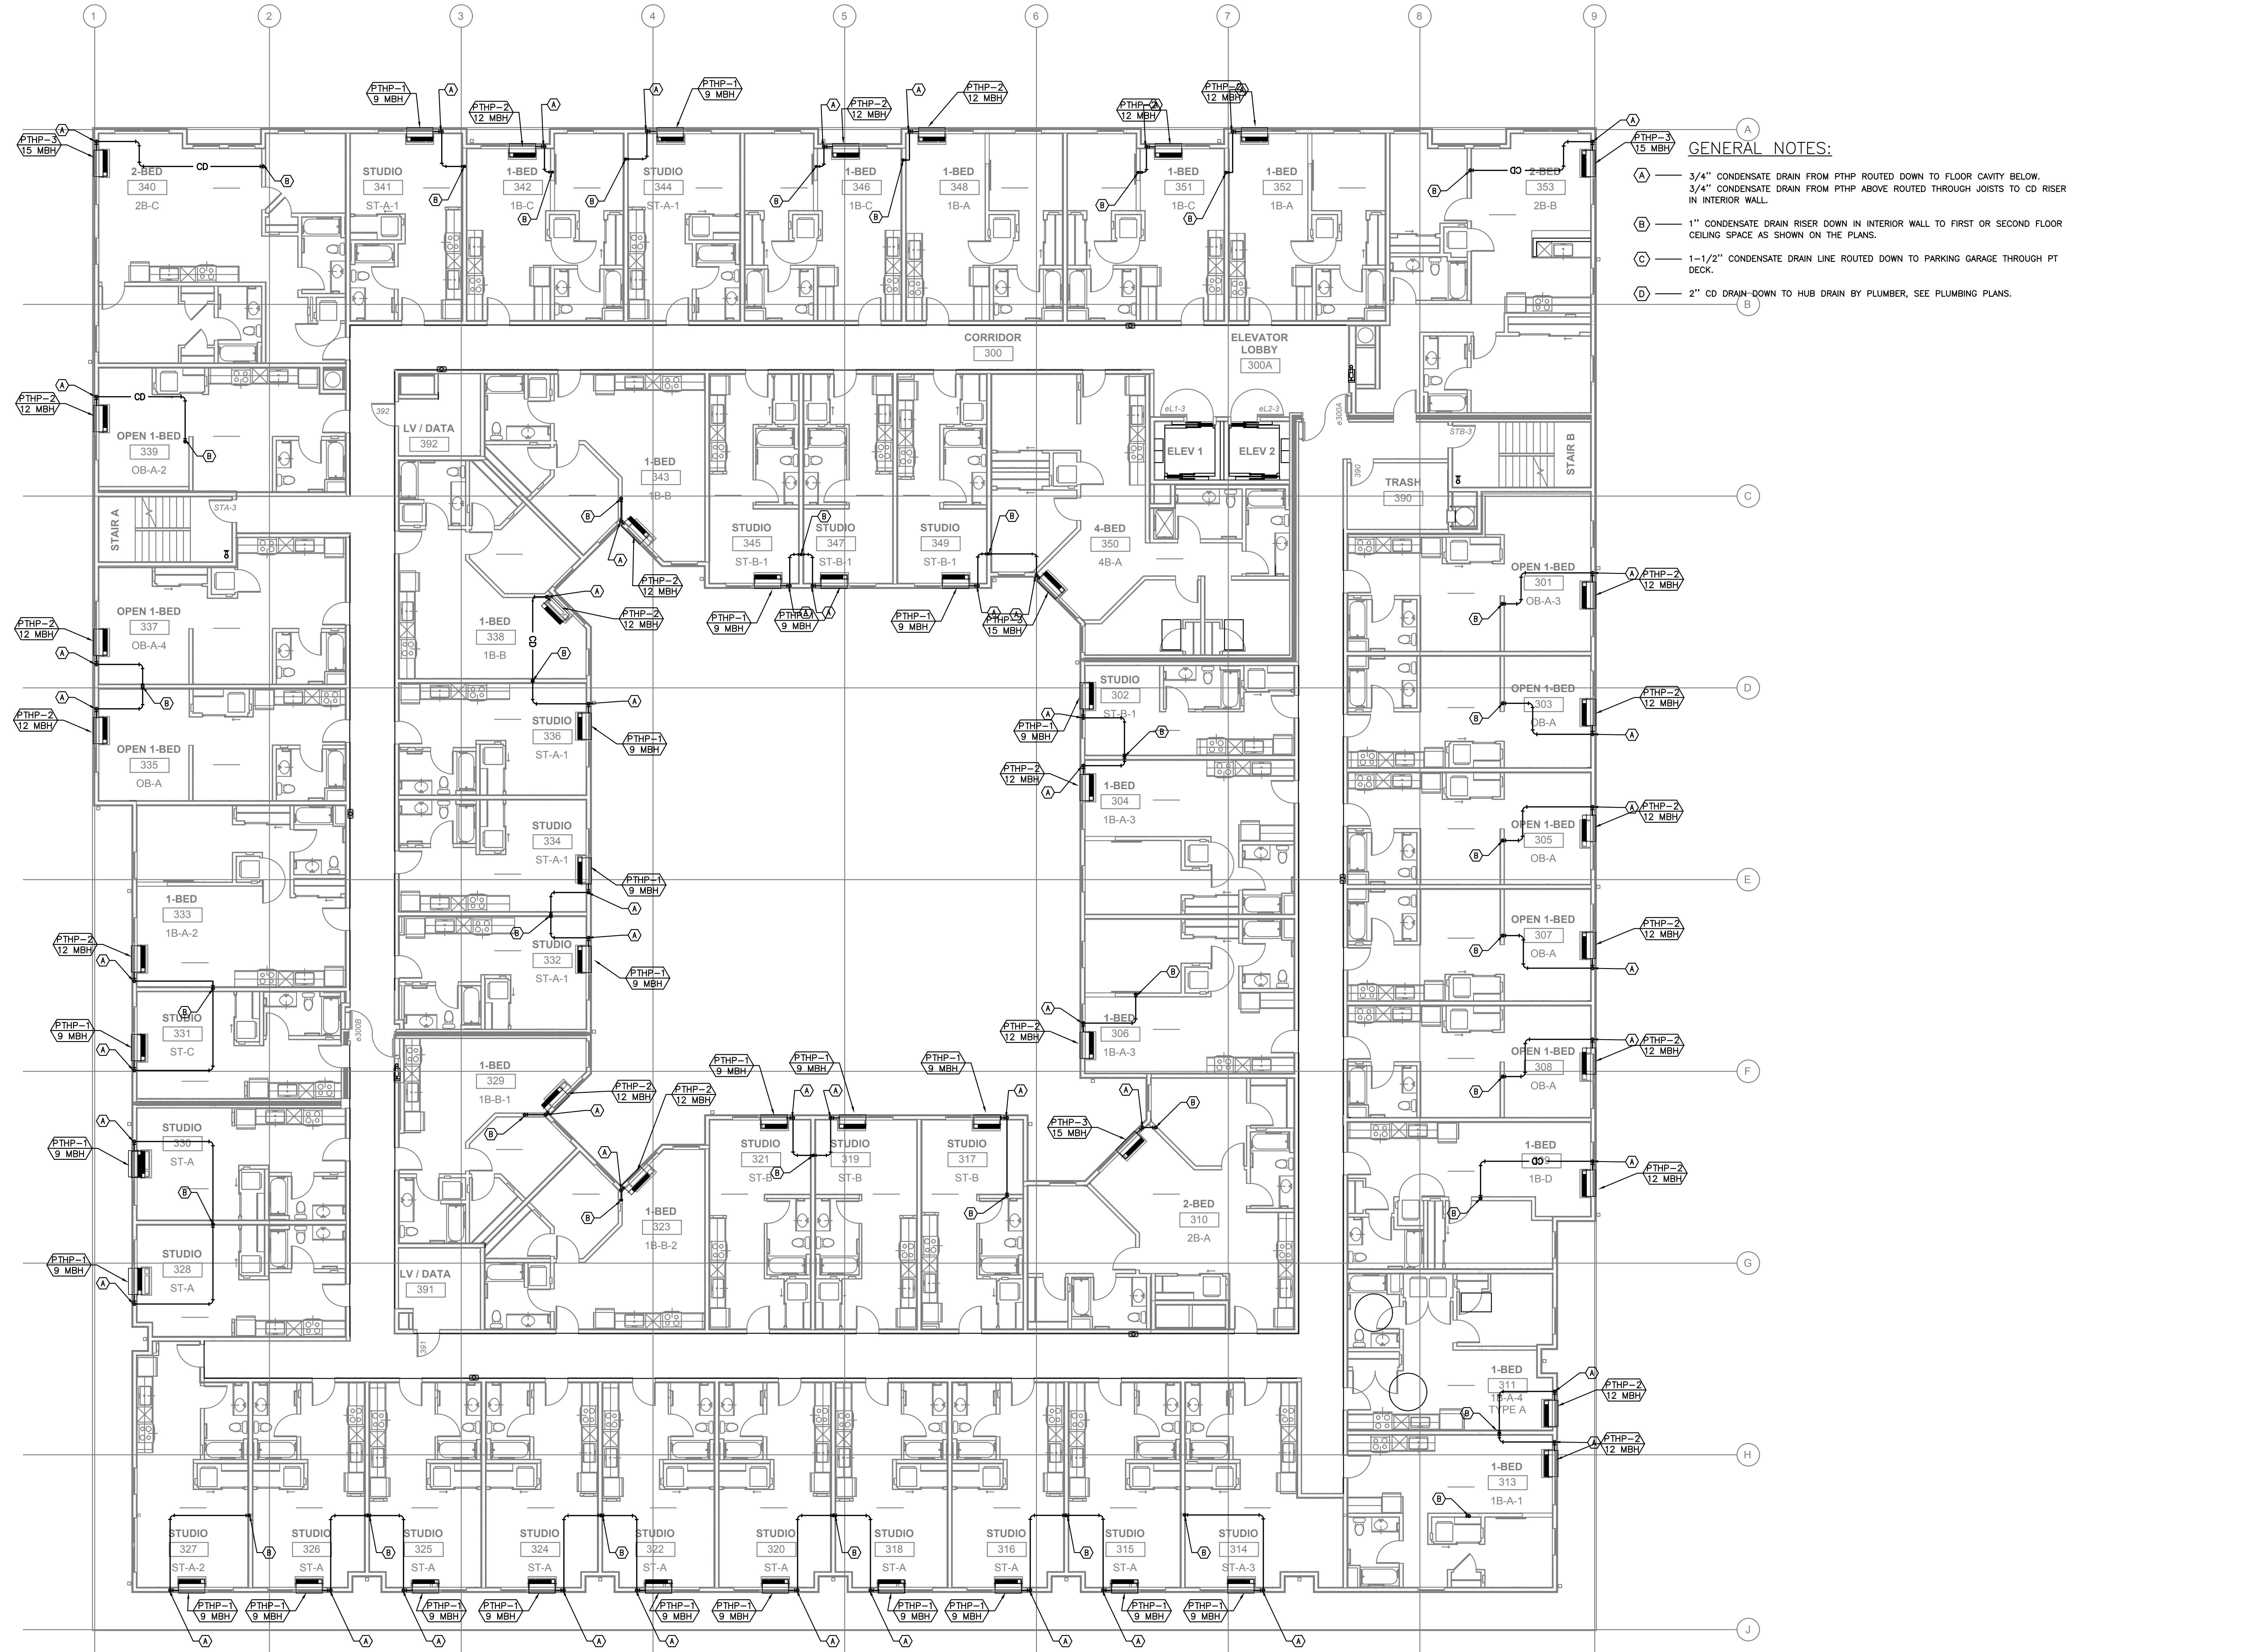

- GENERAL NOTES:**
- (A) 3/4" CONDENSATE DRAIN FROM PTHP ROUTED DOWN TO FLOOR CAVITY BELOW.  
3/4" CONDENSATE DRAIN FROM PTHP ABOVE ROUTED THROUGH JOISTS TO CD RISER IN INTERIOR WALL.
  - (B) 1" CONDENSATE DRAIN RISER DOWN IN INTERIOR WALL TO FIRST OR SECOND FLOOR CEILING SPACE AS SHOWN ON THE PLANS.
  - (C) 1-1/2" CONDENSATE DRAIN LINE ROUTED DOWN TO PARKING GARAGE THROUGH PT DECK.
  - (D) 2" CD DRAIN-DOWN TO HUB DRAIN BY PLUMBER, SEE PLUMBING PLANS.

**1 CONDENSATE PLAN -- LEVEL 3**  
M03.03 SCALE: 1/8" = 1'-0"


Drawing Title:  
**CONDENSATE PLAN - LEVEL 3**





308 SW First Avenue  
Suite 200  
Portland, OR 97204  
Phone: (503) 234-2840  
Fax: (503) 226-2807  
leebarc.com

Leeb Architects

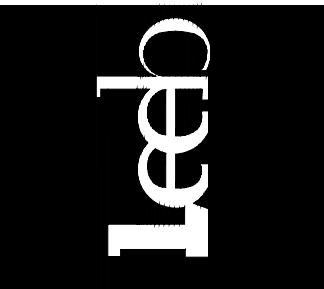


M&A Consulting Engineers  
2007 S.E. Ash St.  
Portland, OR 97214  
PH: (503) 234-0548  
FAX: (503) 234-0877  
WWW.M&A-ENG.COM  
CONTACT: MARK DENYER

Project Title: MODERA WOODSTOCK APARTMENTS  
MILL CREEK RESIDENTIAL  
2200 NW 2ND AVENUE SUITE 900  
PORTLAND, OR 97209

Revision:	4.29.20 - ADD #2, Permit Checklist Response #2
Date:	12.20.19
Drawn by:	MFA/Jacobs
Project No.:	A16-20

M03.04

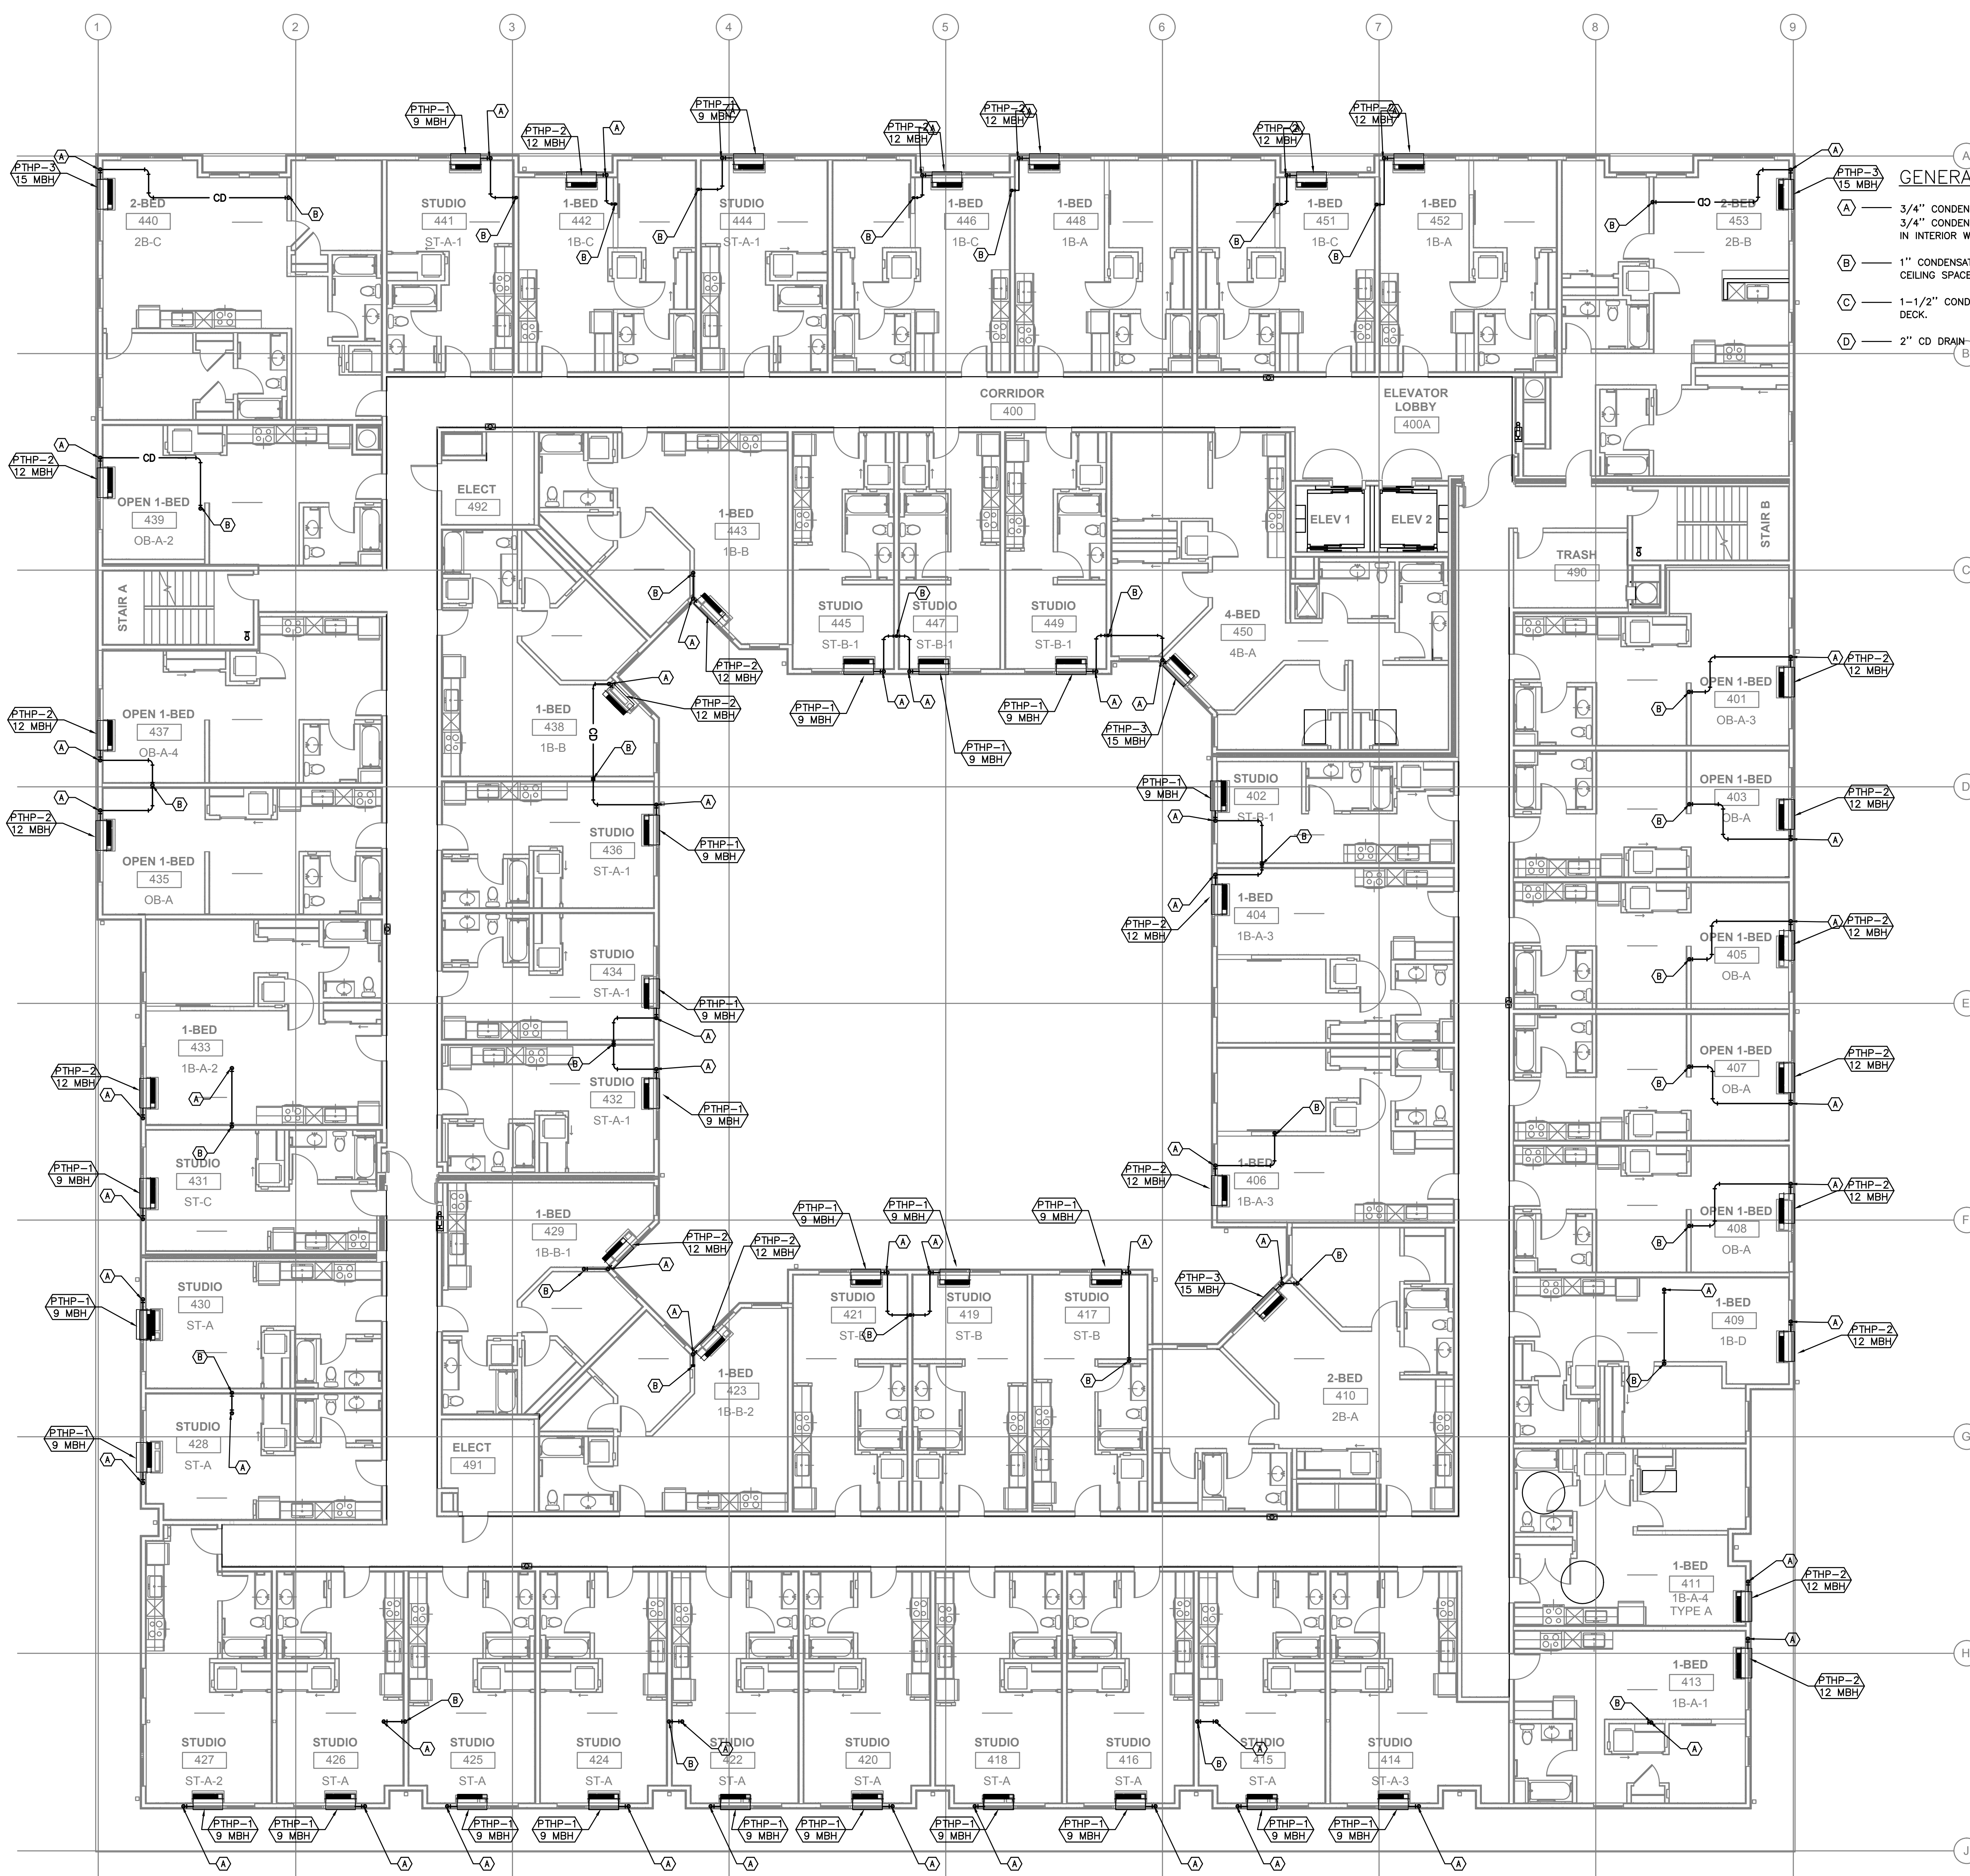

GENERAL NOTES:

- (A) 3/4" CONDENSATE DRAIN FROM PTHP ROUTED DOWN TO FLOOR CAVITY BELOW.  
3/4" CONDENSATE DRAIN FROM PTHP ABOVE ROUTED THROUGH JOISTS TO CD RISER IN INTERIOR WALL.
- (B) 1" CONDENSATE DRAIN RISER DOWN IN INTERIOR WALL TO FIRST OR SECOND FLOOR CEILING SPACE AS SHOWN ON THE PLANS.
- (C) 1-1/2" CONDENSATE DRAIN LINE ROUTED DOWN TO PARKING GARAGE THROUGH PT DECK.
- (D) 2" CD DRAIN-DOWN TO HUB DRAIN BY PLUMBER, SEE PLUMBING PLANS.


1 CONDENSATE PLAN - LEVEL 4  
SCALE: 1/8" = 1'-0"





308 SW First Avenue  
Suite 200  
Portland, OR 97204  
Phone: (503) 226-2640  
Fax: (503) 226-2607  
leebarc.com

Leeb Architects

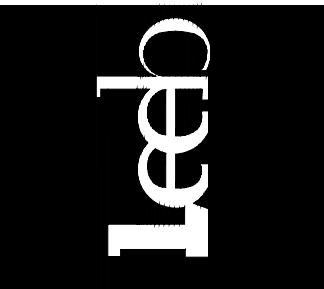


Consulting Engineers  
2007 S.E. Ash St.  
Portland, OR 97214  
PHN: (503) 234-0548  
FAX: (503) 234-0877  
WWW.MFIA-ENG.COM  
CONTACT: MARK DENYER

Project Title:  
**MODERA WOODSTOCK**  
APARTMENTS  
MILL CREEK RESIDENTIAL  
2200 NW 2ND AVENUE SUITE 900  
PORTLAND, OR 97209

Drawing Title:	CONDENSATE PLAN - LEVEL 5
Date:	12.20.19
Drawn by:	MFA/Jacobs
Project No.:	A16-20
Revision:	4.29.20 - ADD #2 Permit Checksheet Response #2
	AS107.9.17.20 - Plan Check / CMP
	AS110 - 9.16.22 Construction Set Revisions

M03.05

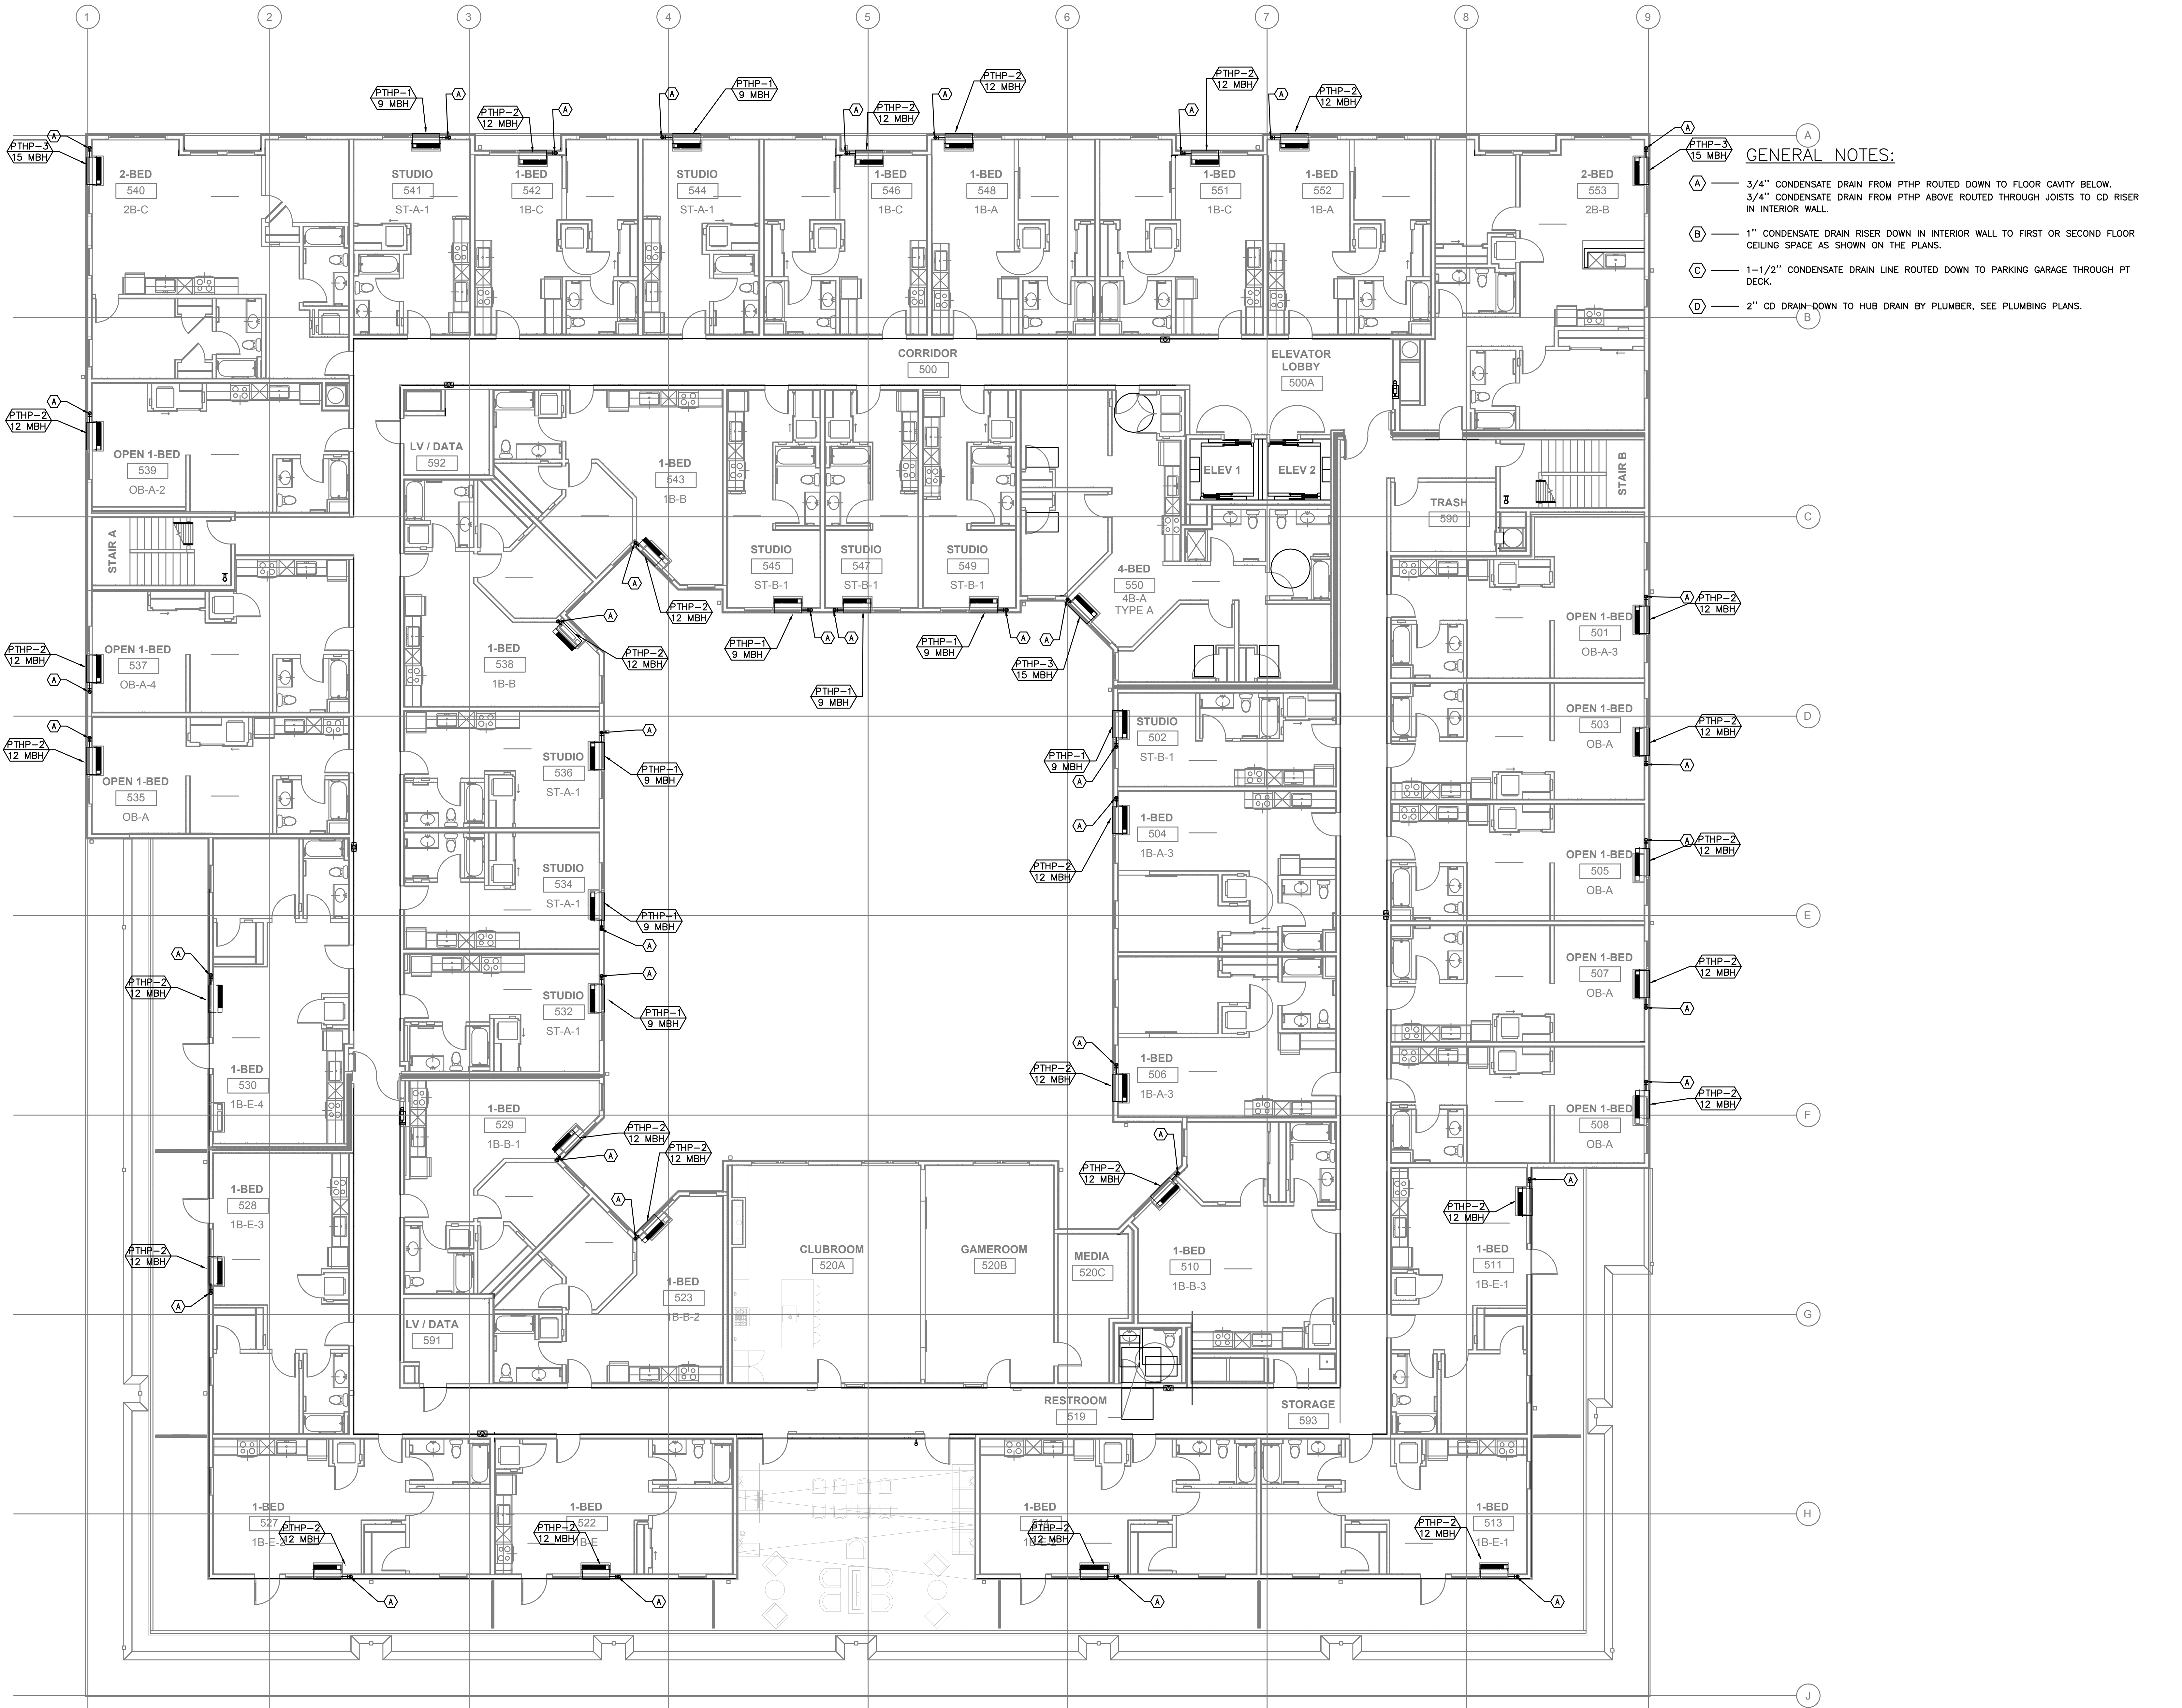

- GENERAL NOTES:**
- (A) 3/4" CONDENSATE DRAIN FROM PTHP ROUTED DOWN TO FLOOR CAVITY BELOW. 3/4" CONDENSATE DRAIN FROM PTHP ABOVE ROUTED THROUGH JOISTS TO CD RISER IN INTERIOR WALL.
  - (B) 1" CONDENSATE DRAIN RISER DOWN IN INTERIOR WALL TO FIRST OR SECOND FLOOR CEILING SPACE AS SHOWN ON THE PLANS.
  - (C) 1-1/2" CONDENSATE DRAIN LINE ROUTED DOWN TO PARKING GARAGE THROUGH PT DECK.
  - (D) 2" CD DRAIN-DOWN TO HUB DRAIN BY PLUMBER, SEE PLUMBING PLANS.

**1** CONDENSATE PLAN - LEVEL 5  
SCALE: 1/8" = 1'-0"

**MECHANICAL LEGEND**

	SUPPLY AIR DIFFUSER	AFF	ABOVE FINISH FLOOR
	RETURN AIR GRILLE	AHU	AIR HANDLING UNIT
	EXHAUST AIR GRILLE	B.D.	BOTTOM OF DUCT
	PERFORATED RETURN AIR PANEL	BHP	BRAKE HORSEPOWER
	DIRECTIONAL AIR FLOW	BTU	BRITISH THERMAL UNITS
	MANUAL VOLUME DAMPER	CFM	CUBIC FEET PER MINUTE
	SUPPLY OR OUTSIDE AIR DUCT UP & DOWN	CON.	CONTINUATION
	RETURN AIR DUCT UP & DOWN	CW	DOMESTIC COLD WATER
	EXHAUST AIR DUCT UP & DOWN	DB	DRY BULB TEMPERATURE
	SUPPLY OR OUTSIDE AIR DUCT UP & DOWN	DI.	DIAMETER
	RETURN AIR DUCT UP & DOWN	DIST.	DISTRIBUTION
	EXHAUST AIR DUCT UP & DOWN	EA	EXHAUST AIR
	SUPPLY OR OUTSIDE AIR DUCT UP & DOWN	EDB	ENTERING DRY BULB TEMPERATURE
	RETURN AIR DUCT UP & DOWN	EWB	ENTERING WET BULB TEMPERATURE
	EXHAUST AIR DUCT UP & DOWN	EWT	ENTERING WATER TEMPERATURE
	SUPPLY OR OUTSIDE AIR DUCT UP & DOWN	FF	FINISH FLOOR
	RETURN AIR DUCT UP & DOWN	FIXT.	FIXTURE
	EXHAUST AIR DUCT UP & DOWN	FPM	FEET PER MINUTE
	SUPPLY OR OUTSIDE AIR DUCT UP & DOWN	FPS	FEET PER SECOND
	RETURN AIR DUCT UP & DOWN	FT.	FEET / FOOT
	EXHAUST AIR DUCT UP & DOWN	GA.	GAUGE
	VAV TERMINAL UNIT	GPM	GALLONS PER MINUTE
	VAV TERMINAL UNIT	H	HEIGHT
	VAV TERMINAL UNIT	HP	HORSEPOWER
	VAV TERMINAL UNIT	I.D.	INSIDE DIAMETER
	VAV TERMINAL UNIT	IN.	INCHES
	VAV TERMINAL UNIT	L	LENGTH
	VAV TERMINAL UNIT	LBS.	POUNDS
	VAV TERMINAL UNIT	LDB	LEAVING DRY BULB TEMPERATURE
	VAV TERMINAL UNIT	LWB	LEAVING WET BULB TEMPERATURE
	VAV TERMINAL UNIT	LWT	LEAVING WATER TEMPERATURE
	VAV TERMINAL UNIT	MAX.	MAXIMUM
	VAV TERMINAL UNIT	MBH	THOUSANDS OF BTUS PER HOUR
	VAV TERMINAL UNIT	MIN.	MINIMUM
	VAV TERMINAL UNIT	N.C.	NORMALLY CLOSED
	VAV TERMINAL UNIT	N.O.	NORMALLY OPEN
	VAV TERMINAL UNIT	N.O.A.	NORMALLY OPEN AIR
	VAV TERMINAL UNIT	P.	PERSON
	VAV TERMINAL UNIT	PSI	POUNDS PER SQUARE INCH
	VAV TERMINAL UNIT	P/T	PRESSURE / TEMPERATURE
	VAV TERMINAL UNIT	R.A.	RETURN AIR
	VAV TERMINAL UNIT	RECT.	RECTANGULAR
	VAV TERMINAL UNIT	REQ'D	REQUIRED
	VAV TERMINAL UNIT	S.A.	SUPPLY AIR
	VAV TERMINAL UNIT	S.P.	STATIC PRESSURE
	VAV TERMINAL UNIT	SQ.	SQUARE
	VAV TERMINAL UNIT	TEMP.	TEMPERATURE
	VAV TERMINAL UNIT	TYP.	TYPICAL
	VAV TERMINAL UNIT	VAV	VARIABLE AIR VOLUME
	VAV TERMINAL UNIT	W	WIDTH
	VAV TERMINAL UNIT	WB	WET BULB TEMPERATURE
	VAV TERMINAL UNIT	WPD	WATER PRESSURE DROP
	VAV TERMINAL UNIT	Ø	DIAMETER
	VAV TERMINAL UNIT	(E)	EXISTING
	VAV TERMINAL UNIT	(D)	DEMOLISH
	VAV TERMINAL UNIT	---	NEW WORK
	VAV TERMINAL UNIT	HWS	(HWS) HEATING WATER SUPPLY
	VAV TERMINAL UNIT	HWR	(HWR) HEATING WATER RETURN
	VAV TERMINAL UNIT	▲	FIRE DAMPER
	VAV TERMINAL UNIT	■	FIRE / SMOKE DAMPER
	VAV TERMINAL UNIT	⊗	SMOKE DAMPER
	VAV TERMINAL UNIT	⊕	SEISMIC BRACING
	VAV TERMINAL UNIT	⊥	LATERAL BRACING
	VAV TERMINAL UNIT	⊥	LONGITUDINAL BRACING
	VAV TERMINAL UNIT	⊥	LONGITUDINAL & LATERAL BRACING

**EXHAUST FANS**

MARK NUMBER	EF 1	EF 2	EF 3	EF 4	EF 5	EF 6	EF 7	EF 8	EF 9	EF 10	EF 11
TYPE	CEILING CABINET	CEILING CABINET	CEILING CABINET	CEILING CABINET	CEILING CABINET	CEILING CABINET	CEILING CABINET	CEILING CABINET	CEILING CABINET	CEILING CABINET	CEILING CABINET
SYSTEM	BATHROOM	RESTROOM	COMM. TRASH	WATER HEATER ROOM	BIKE PARKING	BIKE STORAGE	TRASH ROOM BASEMENT	ELECTRICAL 002	WATER 001	MDF/IDF	CORRIDOR
CFM	30/90	110	300	200	200	300	300	200	200	100	300
TOTAL SP. (IN H2O)	0.20	0.125	0.125	0.125	0.125	0.125	0.125	0.125	0.125	0.125	0.125
RPM	1062/1146	1190	2500	740	740	2500	2500	740	740	1250	2500
TIP SPEED (FPM)	NA	---	---	---	---	---	---	---	---	---	---
MOTOR WATTS OR HP	5/11.7 W	47.3 W	135 W	127 W	127 W	135 W	127 W	127 W	127 W	100 W	135 W
CONTROLLED BY	**	LIGHTS	CONTINUOUS	T-STAT	HUMIDISTAT	HUMIDISTAT	CONTINUOUS	T-STAT	T-STAT	T-STAT	CONTINUOUS
INTERLOCK WITH	MOTION SENSOR	NONE	NONE	NONE	NONE	NONE	NONE	NONE	NONE	NONE	NONE
FAN SPEED CONTROLLER	YES	NO	YES	YES	YES	YES	YES	YES	YES	NO	YES
WHEEL TYPE	BI	FC	BI	BI	BI	BI	BI	BI	BI	FC	BI
BACK DRAFT DAMPER	YES	GRAVITY	GRAVITY	GRAVITY	GRAVITY	GRAVITY	GRAVITY	GRAVITY	GRAVITY	GRAVITY	GRAVITY
ISOLATION	RUBBER	RUBBER	RUBBER	RUBBER	RUBBER	RUBBER	RUBBER	RUBBER	RUBBER	RUBBER	RUBBER
DESIGN WEIGHT (LBS)	25	25	25	23	23	25	25	23	23	25	25
MAX. SONES	0.3/0.6	3.0	4.5	1.7	1.7	4.5	4.5	1.7	1.7	1.5	4.5
MAX AMPS - ***	0.27	0.40	1.34	1.8	1.8	1.34	1.34	1.8	1.8	1.3	1.34
POWER (VOLTS/PHASE/HZ) - ***	120/1/60	120/60/1	120/60/1	120/60/1	120/60/1	120/60/1	120/60/1	120/60/1	120/60/1	120/60/1	120/60/1
BASIS OF DESIGN:	PANASONIC * FV-05-11VKS2	BROAN A110	BROAN SP-A390	BROAN L200	BROAN L200	BROAN SP-A390	BROAN SP-A390	BROAN L200	BROAN L200	BROAN L100	BROAN SP-A390


**GARAGE EXHAUST FANS**

MARK NUMBER	GEF 1	GEF 2	GCF 1	GCF 2	GCF 3	GCF 4
TYPE	ROOF DIRECT DRIVE	UTILITY SET DIRECT DRIVE	AXIAL DIRECT DRIVE			
SYSTEM	GARAGE EXHAUST #1A	GARAGE EXHAUST #1B	GARAGE CIRCULATION			
CFM *	13,000	13,000	5103			
TOTAL SP. (IN H2O)	0.50	0.50	0.287			
RPM	830	696	3500			
TIP SPEED (FPM)	6627	6016	---			
MOTOR WATTS OR HP	5 HP	7.5	2 HP			
CONTROLLED BY	VFD	VFD	---			
INTERLOCK WITH	CO/NO2	CO/NO2	CO/NO2			
FAN SPEED CONTROLLER	YES	YES	YES			
WHEEL TYPE	BI	BI	BI			
BACK DRAFT DAMPER	NONE	NONE	NONE			
ISOLATION	RUBBER	RUBBER	RUBBER			
DESIGN WEIGHT (LBS)	400	952	60			
MAX. SONES OR dBA	27 SONES	25 SONES	83 dBA			
MAX AMPS - ***	---	---	---			
POWER (VOLTS/PHASE/HZ) - ***	230/60/3	230/60/3	230/60/3			
BASIS OF DESIGN:	GREENHECK CUE-300-C-VGD	GREENHECK USF-33	GREENHECK GJX-41-160			

\* - FAN TO INCLUDE 10 WATT DIMMABLE LED CHIP PANEL - COORDINATE SWITCHING WITH ELECTRICAL CONTRACTOR.  
 \*\* - FAN TO RUN AT LOW SPEED CONTINUOUSLY, AND INCREASE TO HIGH SPEED UPON ACTIVATION OF THE MOTION SENSOR.  
 \*\*\* - ELECTRICAL DATA LISTED FOR REFERENCE ONLY. COORDINATE WITH ELECTRICAL DESIGN BUILD CONTRACTOR FOR VOLTAGE AND PHASE REQUIREMENTS.

\* - FAN TO RUN AT LOW SPEED CONTINUOUSLY, AND INCREASE TO HIGH SPEED UPON ACTIVATION OF THE MOTION SENSOR. SEE GARAGE PLANS.  
 \*\* - ELECTRICAL DATA LISTED FOR REFERENCE ONLY. COORDINATE WITH ELECTRICAL DESIGN BUILD CONTRACTOR FOR VOLTAGE AND PHASE REQUIREMENTS.

**AIR DISTRIBUTION DETAILS**

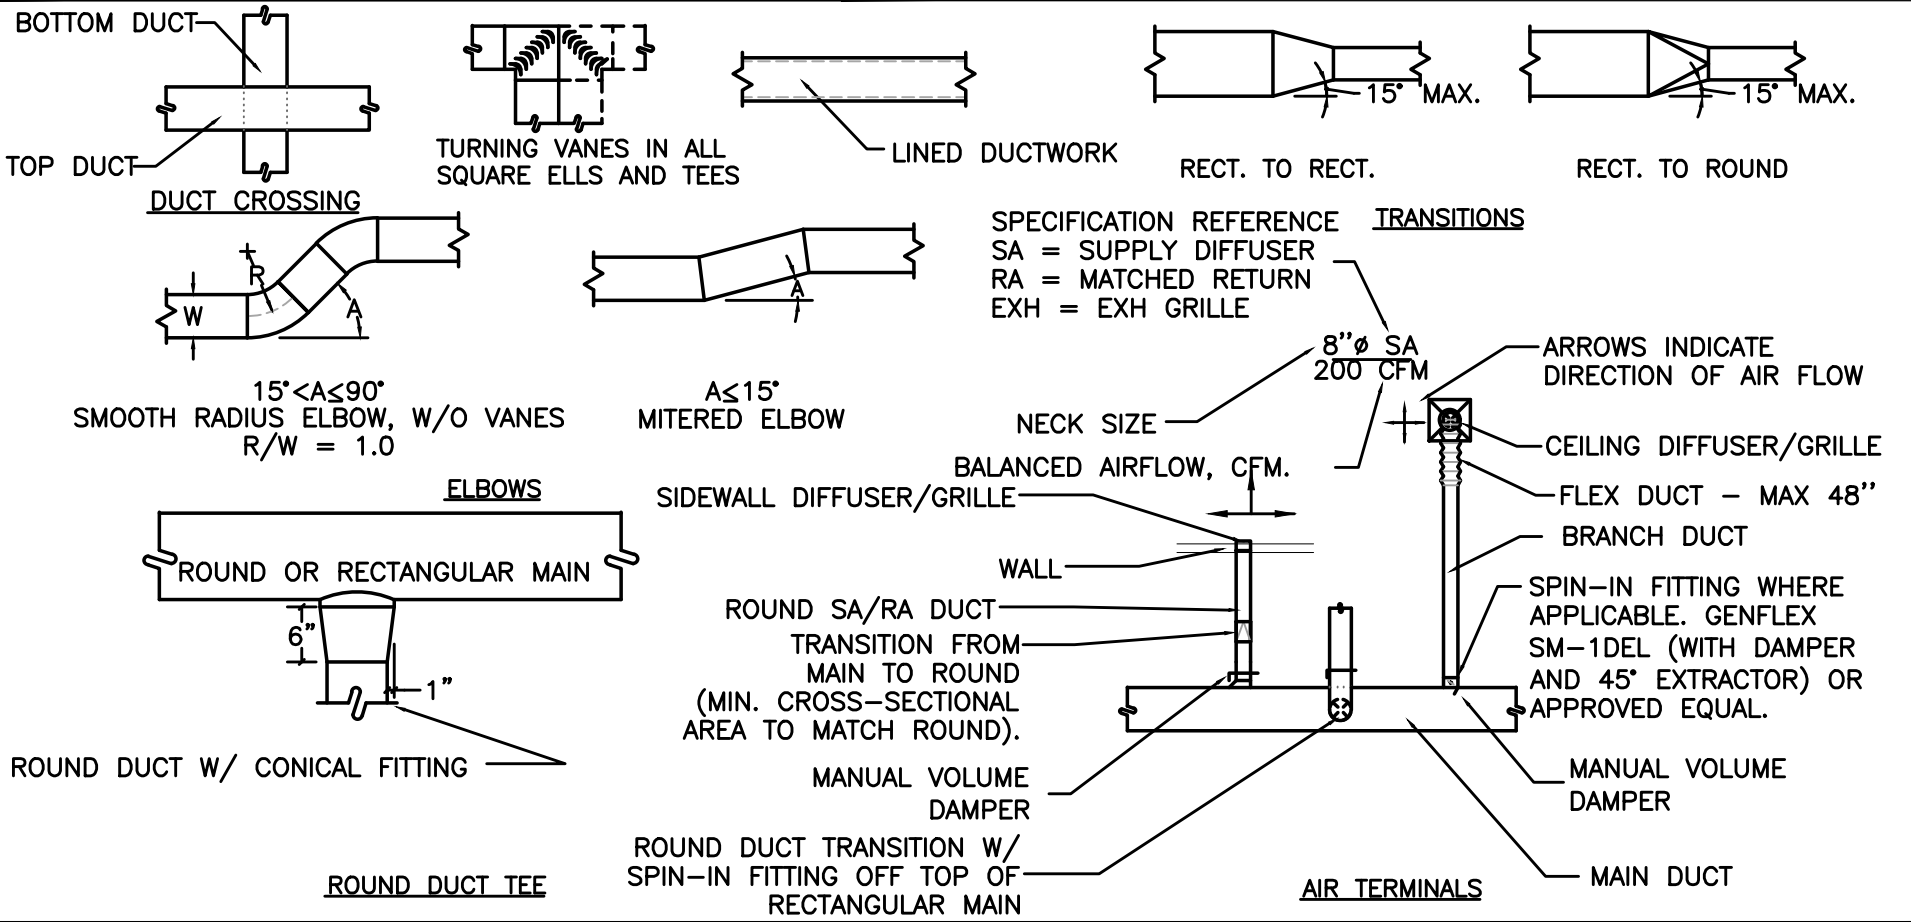

**INDOOR UNITS - \***

MARK NUMBER	FC-1 24 MBH **	FC-2 36 MBH ***	FC-3 36 MBH ***	FC-4 12 MBH	FC-5 12 MBH
SYSTEM	STAFF-MANAGER-CORR-MAIL	RECEPTION/LEASING	FITNESS	IT ROOM	ELEVATOR EQUIP. ROOM
TYPE	DUCTED	DUCTED	DUCTED	WALL MOUNTED	WALL MOUNTED
EFFICIENCY	SEE OUTDOOR UNIT	SEE OUTDOOR UNIT	SEE OUTDOOR UNIT	SEE OUTDOOR UNIT	SEE OUTDOOR UNIT
NOMINAL COOLING CAPACITY	23,600 BTUH	33,000 BTUH	33,000 BTUH	12,000 BTUH	12,000 BTUH
HEATING CAPACITY	24,000-BTUH/6-KW-ELECT.	33,000-BTUH/10-KW-ELECT.	33,000-BTUH/10-KW-ELECT.	12,000 BTUH	12,000 BTUH
FILTER TYPE	MERV 8	MERV 8	MERV 8	---	---
TOTAL SUPPLY CFM	850	1200	1200	380	380
OSA CFM	174	393	387	---	---
EXTERNAL SP. (H2O)	0.25	0.25	0.25	0.25	0.25
VOLTS/PHASE	208/1	208/1	208/1	208/1	208/1
MCA/MOP	29.4/35	45.5/60	45.5/60	SEE OUTDOOR UNIT	SEE OUTDOOR UNIT
WEIGHT	135	135	135	20	20
BASIS OF DESIGN	CARRIER FMC4Z3000AL	CARRIER FMC4Z3600AL	CARRIER FMC4Z3600AL	CARRIER 40MAQB12B-3	CARRIER 40MAQB12B-3
OUTDOOR UNIT	HP-1 2 TON	HP-2 3 TON	HP-3 3 TON	HP-4 1 TON	HP-5 1 TON

\* - PROVIDE ALL UNITS THAT CANNOT BE DRAINED BY GRAVITY WITH CONDENSATE PUMP, ROUTE ALL CONDENSATE LINES HIDDEN WITHIN STRUCTURE TO AN APPROVED LOCATION PROVIDED BY THE PLUMBER.  
 \*\* - PROVIDE ACCESS PANEL, MODEL # KFA9P0201COV. PROVIDE ELECTRIC HEAT KIT, MODEL # EHK3-06B.  
 \*\*\* - PROVIDE ACCESS PANEL, MODEL # KFA9P0201COV. PROVIDE ELECTRIC HEAT KIT, MODEL # EHK3-10B.

**OUTDOOR UNITS - SPLIT SYSTEM HEAT PUMP**

MARK NUMBER	HP-1 2 TON	HP-2 3 TON	HP-3 3 TON	HP-4 1 TON	HP-5 1 TON
SYSTEM	STAFF-MANAGER-CORR-MAIL	RECEPTION/LEASING	FITNESS	IT ROOM	ELEVATOR EQUIP. ROOM
TYPE	1-PORT HEAT PUMP	1-PORT HEAT PUMP	1-PORT HEAT PUMP	1-PORT HEAT PUMP	1-PORT HEAT PUMP
NORMAL COOLING CAPACITY	23,000 BTUH	33,000 BTUH	33,000 BTUH	12,000 BTUH	12,000 BTUH
NORMAL HEATING CAPACITY	24,400 BTUH	33,000 BTUH	33,000 BTUH	12,000 BTUH	12,000 BTUH
EFFICIENCY SEER/EER	14.0/11.0	14.0/11.0	14.0/11.0	22.5/13	22.5/13
EFFICIENCY HSPF/COP	8.2/4.02	8.2/4.14	8.2/4.14	12/3.56	12/3.56
REFRIGERANT	410 A	410 A	410 A	410 A	410 A
REFRIGERANT CHARGE	X LBS	X LBS	X LBS	X LBS	X LBS
MAX OPERATING TEMPS	115/5	115/5	115/5	115/5	115/5
MAX PIPING LENGTH	98 FT	200 FT	200 FT	82 FT	82 FT
MAX PIPING HEIGHT	65 FT	80 FT	80 FT	32 FT	32 FT
VOLTS-PHASE - **	208/230-1 PHASE	208/230-3 PHASE	208/230-3 PHASE	208/230-1 PHASE	208/230-1 PHASE
MCA/MOP - **	16.5/25.0 AMPS	12.8/20.0 AMPS	12.8/20.0 AMPS	9/15 AMPS	9/15 AMPS
COMPRESSOR	CONSTANT SPEED	CONSTANT SPEED	CONSTANT SPEED	VARIABLE SPEED	VARIABLE SPEED
WEIGHT	165 LBS	227 LBS	227 LBS	100 LBS	100 LBS
BASIS OF DESIGN	CARRIER 25HHA424A003	CARRIER 25HHA436A005	CARRIER 25HHA436A005	CARRIER 38MAQB12R-3	CARRIER 38MAQB12R-3

\*\* - ELECTRICAL DATA LISTED FOR REFERENCE ONLY. COORDINATE WITH ELECTRICAL DESIGN BUILD CONTRACTOR FOR VOLTAGE AND PHASE REQUIREMENTS. ELECTRICAL CONTRACTOR RESPONSIBLE FOR SIZING ALL CONDUCTORS & OVERCURRENT PROTECTION. VERIFY WITH EQUIPMENT SUBMITTALS FOR EQUIPMENT ELECTRICAL REQUIREMENTS.

**PACKAGED TERMINAL HEAT PUMP**



MARK NUMBER	PTH-1 9 MBH	PTH-2 12 MBH	PTH-3 15 MBH
TYPE	THRU-THE-WALL HEAT PUMP	THRU-THE-WALL HEAT PUMP	THRU-THE-WALL HEAT PUMP
SYSTEM	STUDIO	1-BEDROOM	2&4-BEDROOM
NOMINAL COOLING CAPACITY (BTUH)	9,000	11,500	14,000
HEATING CAPACITY (BTUH)	8,300	11,500	13,800
47°F OUTDOOR AIR TEMP			
ELECTRIC HEATING CAPACITY (KW)	3.5	3.5	5.0
CFM (HI/LOW) (WET COIL)	290/264	290/264	340/314
MIN OSA (CFM)	65 CFM	65 CFM	65 CFM
LVG. AIR TEMP (°F)	55°F	55°F	55°F
REMOTE THERMOSTAT	YES	YES	YES
EFFICIENCY (EER)	11.1	10.2	9.6
EFFICIENCY (COP)	3.3	3.1	2.9
ARCHITECTURAL GRILLE 42x16	YES	YES	YES
DESIGN WT. (LBS)	115	120	130
ELECT (VOLTS/PHASE/HTZ) - ***	230/1/60	230/1/60	230/1/60
TOTAL AMPS - ***	11.2	15.5	15.5
MCA/MOP - ***	14.1/15	19.5/20	19.5/20
REFRIGERANT	410a	410a	410a
REFRIGERANT CHARGE	1.325 LBS	1.34 LBS	1.95 LBS
CONDENSATE DRAIN KIT *	YES - *	YES - *	YES - *
BASIS OF DESIGN: GE	GE	GE	GE

\* - CONDENSATE DRAIN KIT PROVIDED BY MECHANICAL CONTRACTOR. ALL CONDENSATE PIPING TO BE PROVIDED AND INSTALLED BY PLUMBING CONTRACTOR FROM PTHP TO HUB DRAINS PROVIDED BY PLUMBING CONTRACTOR.  
 \*\*\* - ELECTRICAL DATA LISTED FOR REFERENCE ONLY. COORDINATE WITH ELECTRICAL DESIGN BUILD CONTRACTOR FOR VOLTAGE AND PHASE REQUIREMENTS.

**ROOFTOP HVAC UNITS**

MARK NUMBER	RTU-1 10 TON	RTU-2 10 TON	RTU-3 5 TON
SYSTEM	SOUTH SECTION	NORTH SECTION	CLUB/GAME ROOM
TYPE	SZVAV **	SZVAV **	C.V.
DISCHARGE	VERTICAL	VERTICAL	



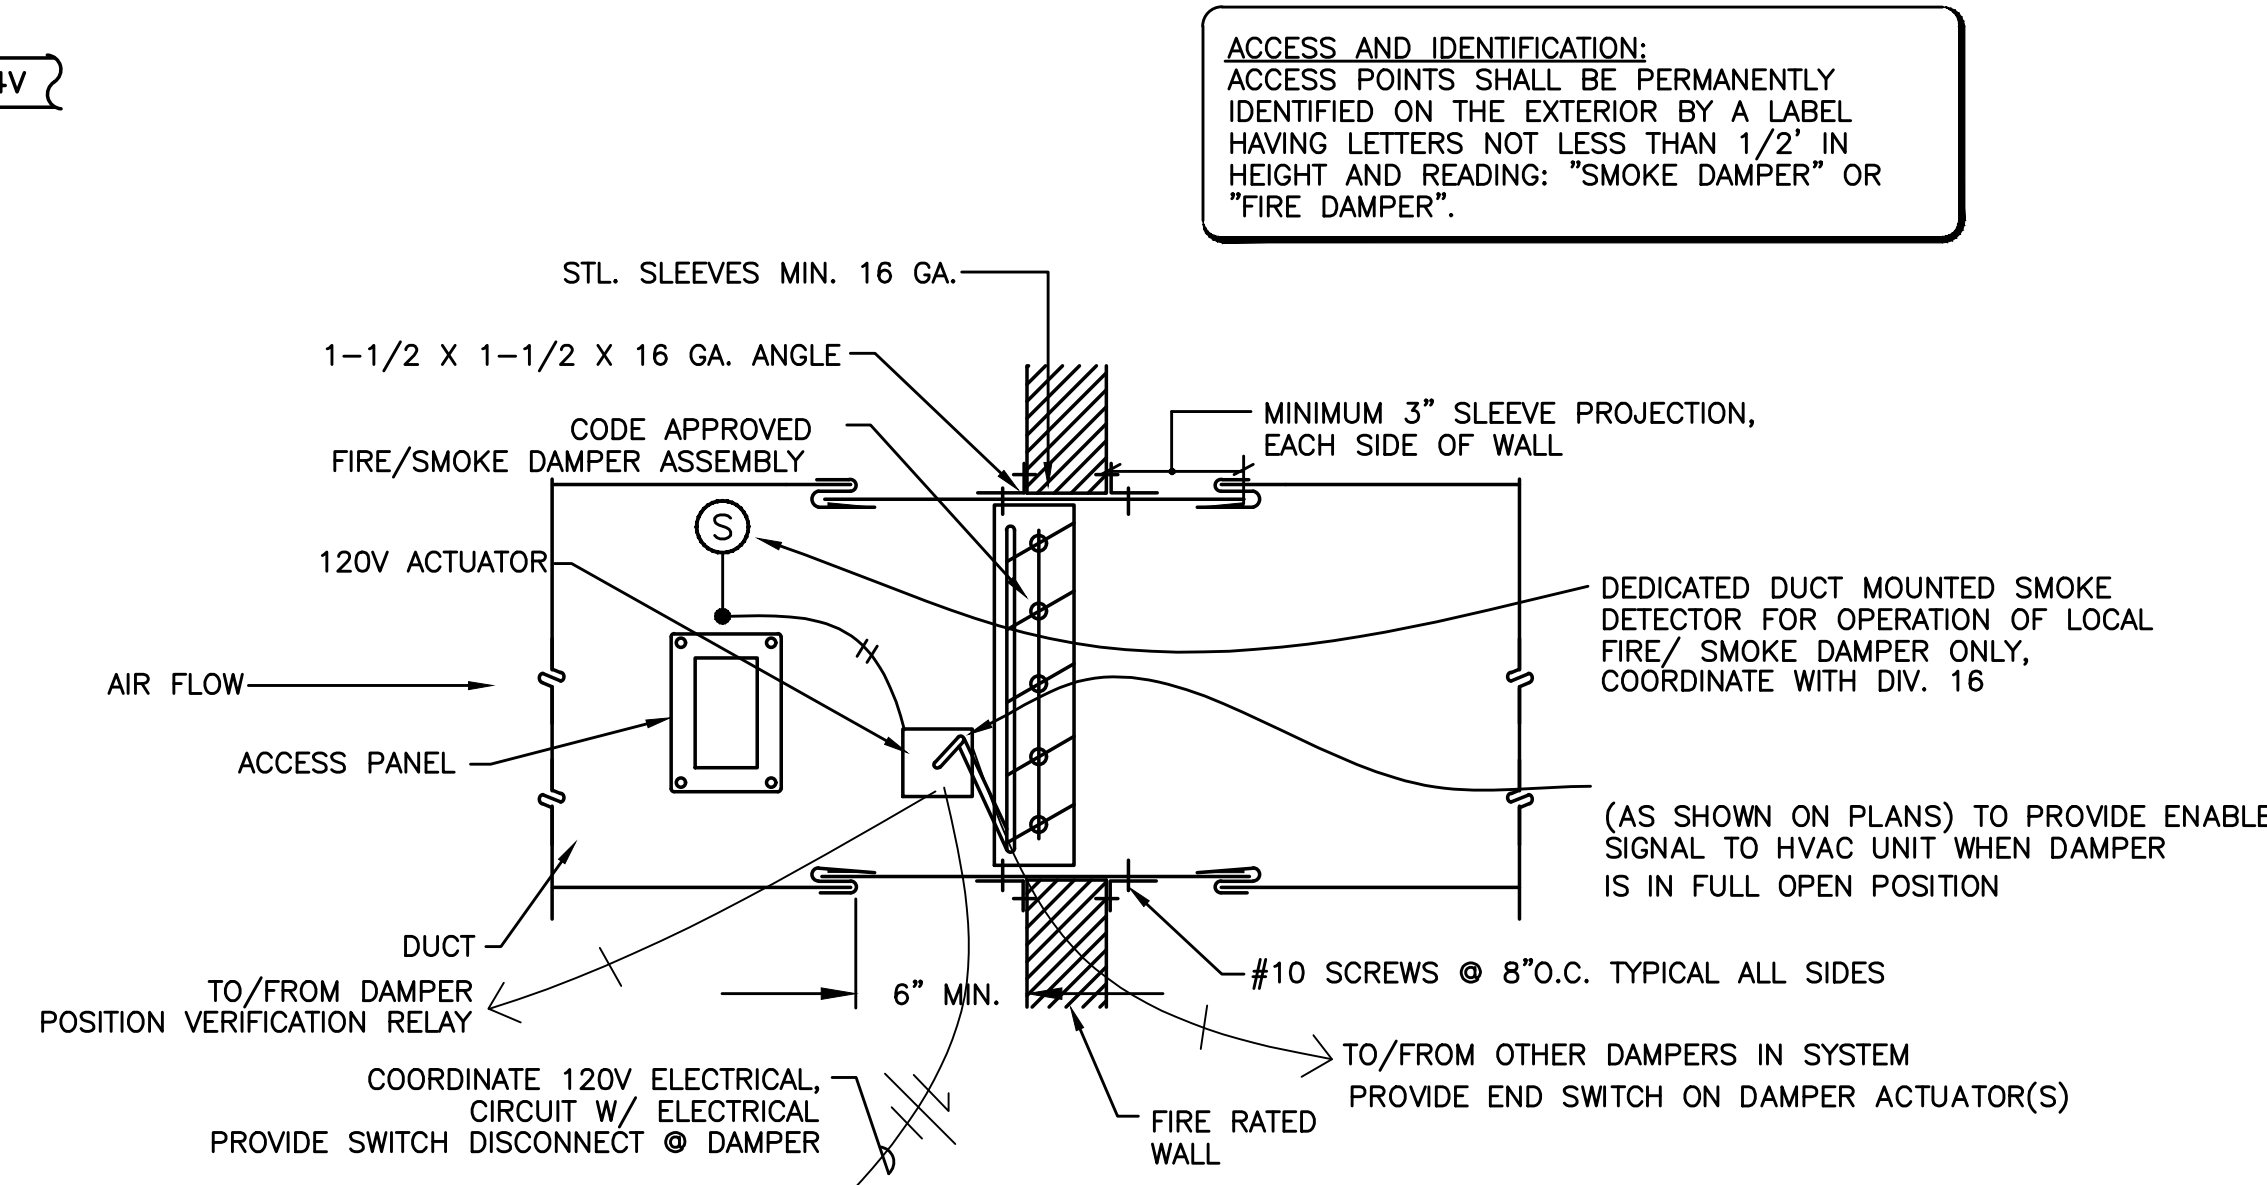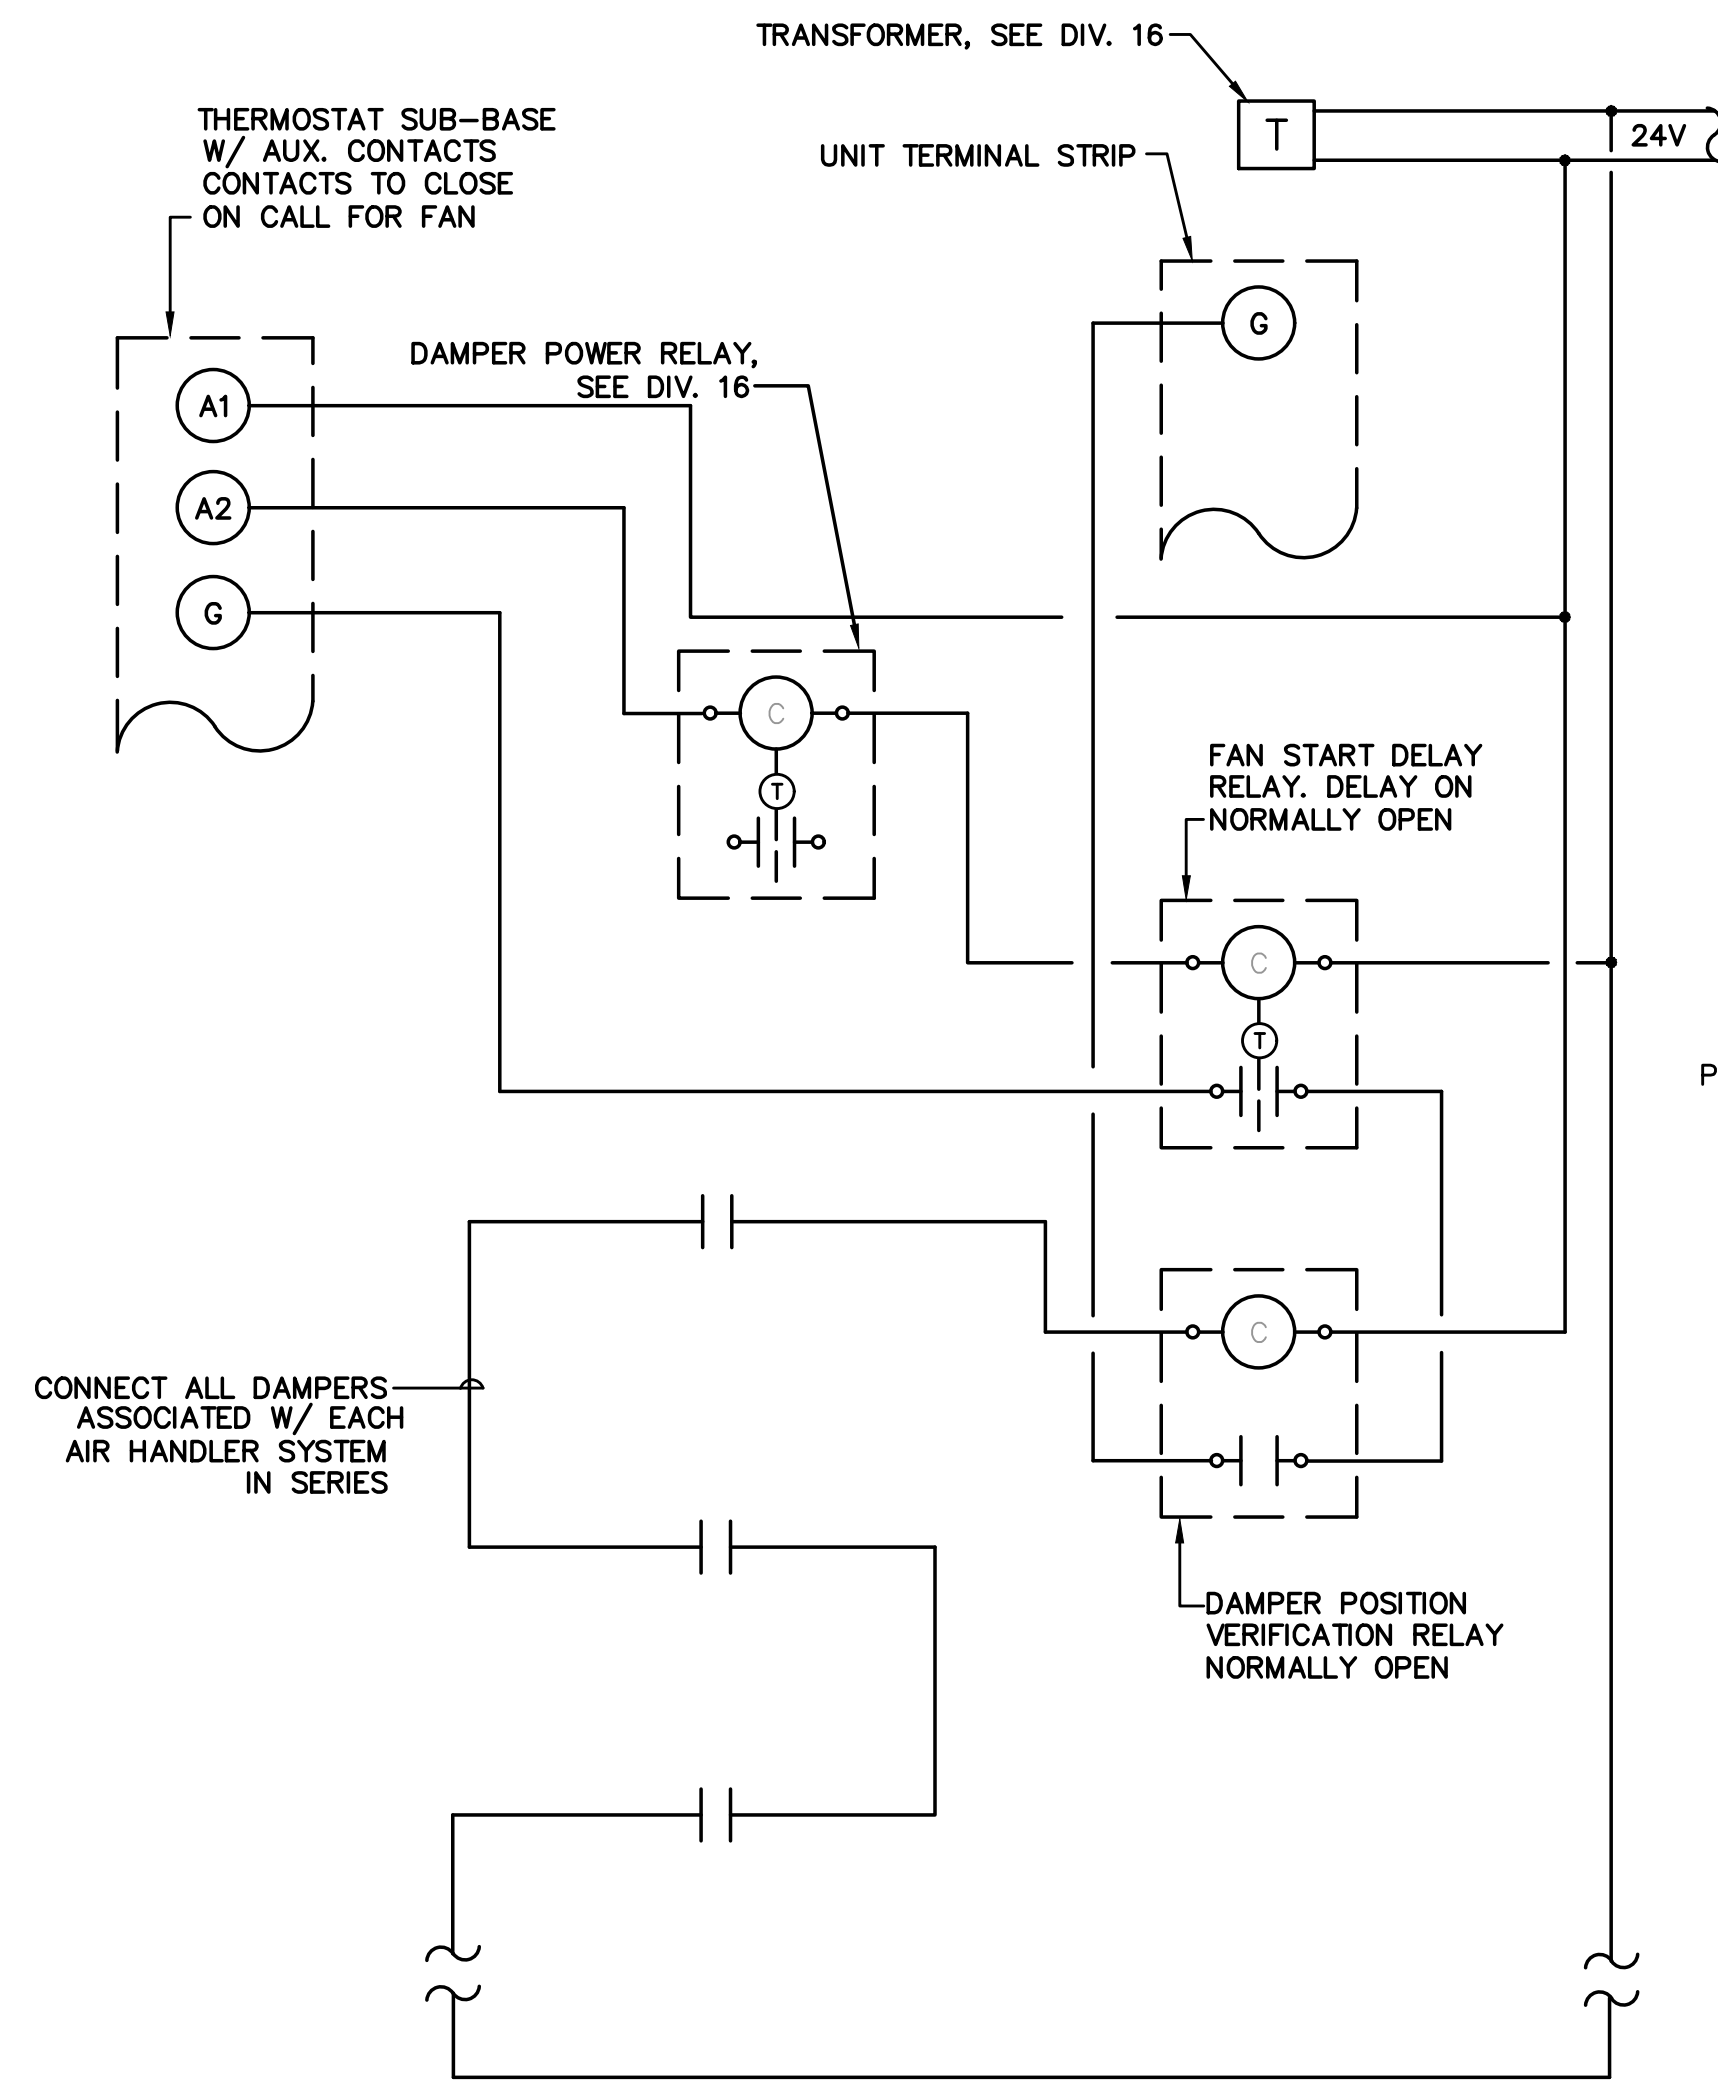


1 FIRE/SMOKE DAMPER W/SMOKE DETECTOR  
M06.01 NOT TO SCALE

**NOTE:**


PROVIDE ALL REQUIRED CONTROL WIRING TO ACCOMPLISH:  
**FIRE/SMOKE DAMPER** - FIRE/SMOKE DAMPER TO CLOSE UPON ACTIVATION OF LOCAL SMOKE DETECTOR  
**EXHAUST DUCTS/FANS** - FIRE/SMOKE DAMPER TO CLOSE UPON SHUTDOWN OF ASSOCIATED EXHAUST FAN.  
**SUPPLY OR RETURN DUCTS/FANS** - FIRE/SMOKE DAMPER TO CLOSE UPON SHUTDOWN OF ASSOCIATED AIR HANDLING UNIT.

**GENERAL NOTES:**


PROVIDE ACCESS IN CEILING OR WALL FOR DAMPER AND SMOKE DETECTOR  
 SEE ELECTRICAL DRAWINGS FOR WIRING INSTALLATION

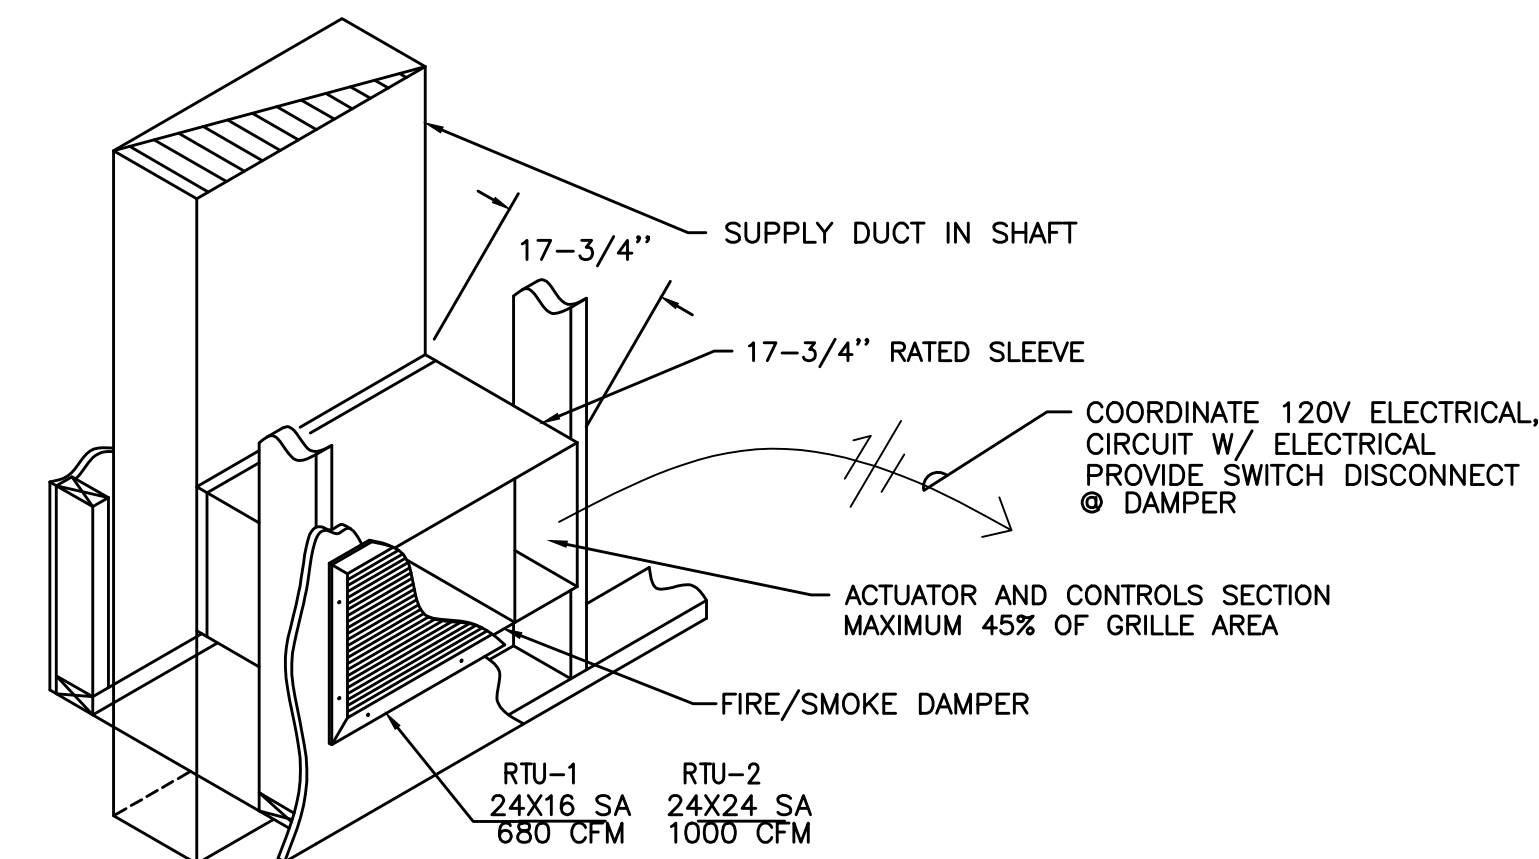

2 HIGH SUPPLY W/ FIRE/SMOKE DAMPER  
M06.01 SCALE: DETAIL

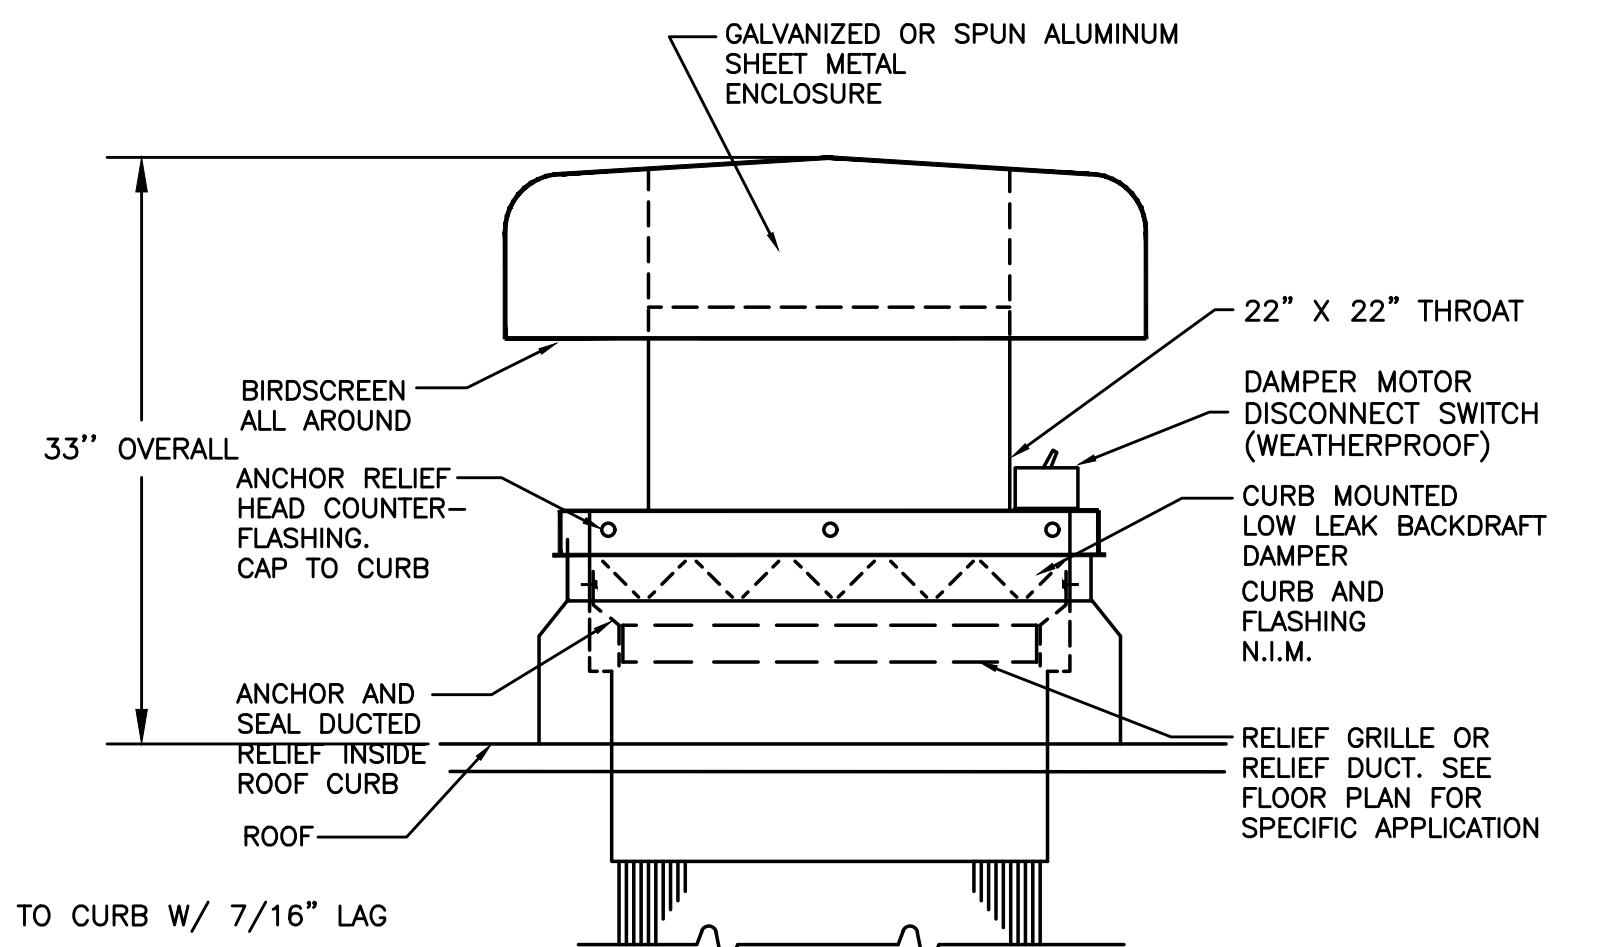


3 ELEVATOR SHAFT RELIEF VENT  
M06.01 SCALE: DETAIL

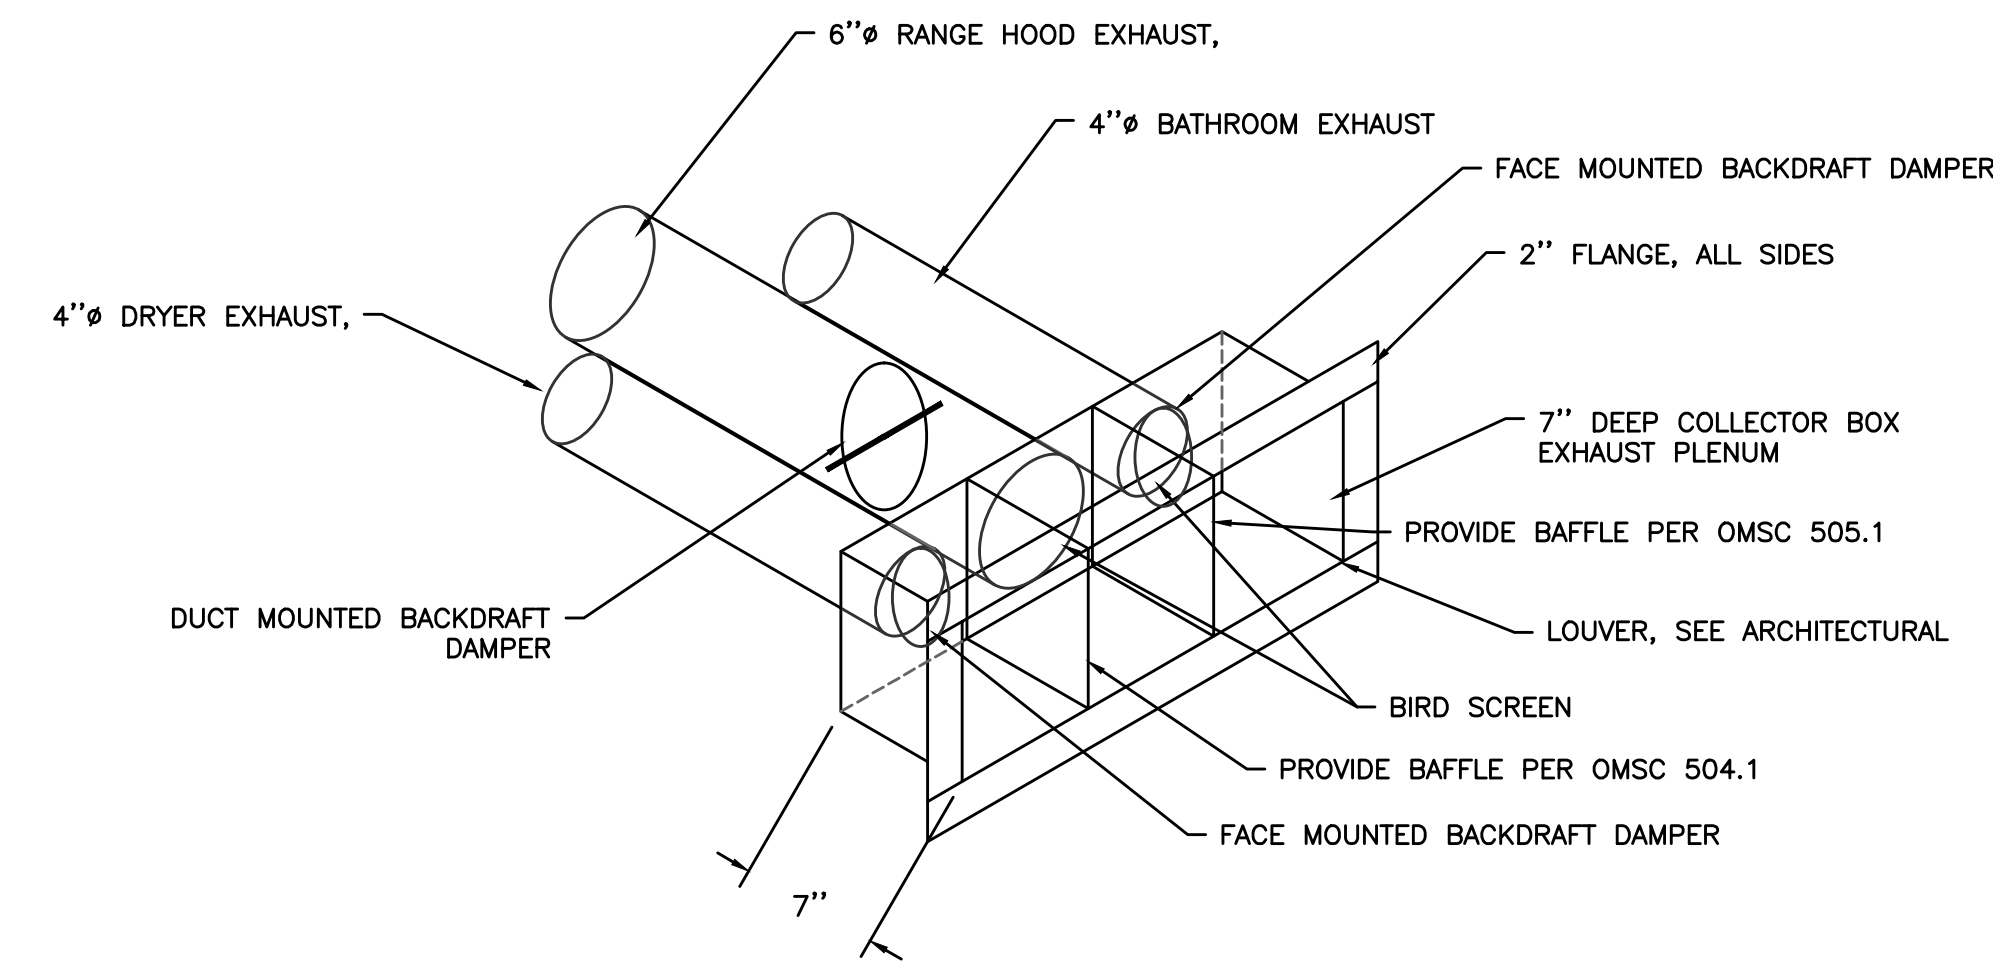


5 SIDE WALL DWELLING UNIT VENTING  
M06.01 NOT TO SCALE


SEE SHEET A841:  
 • FOR DUCT CONFIGURATIONS  
 • SIZES OF PLENUM BOXES  
 • SHROUD DETAILS

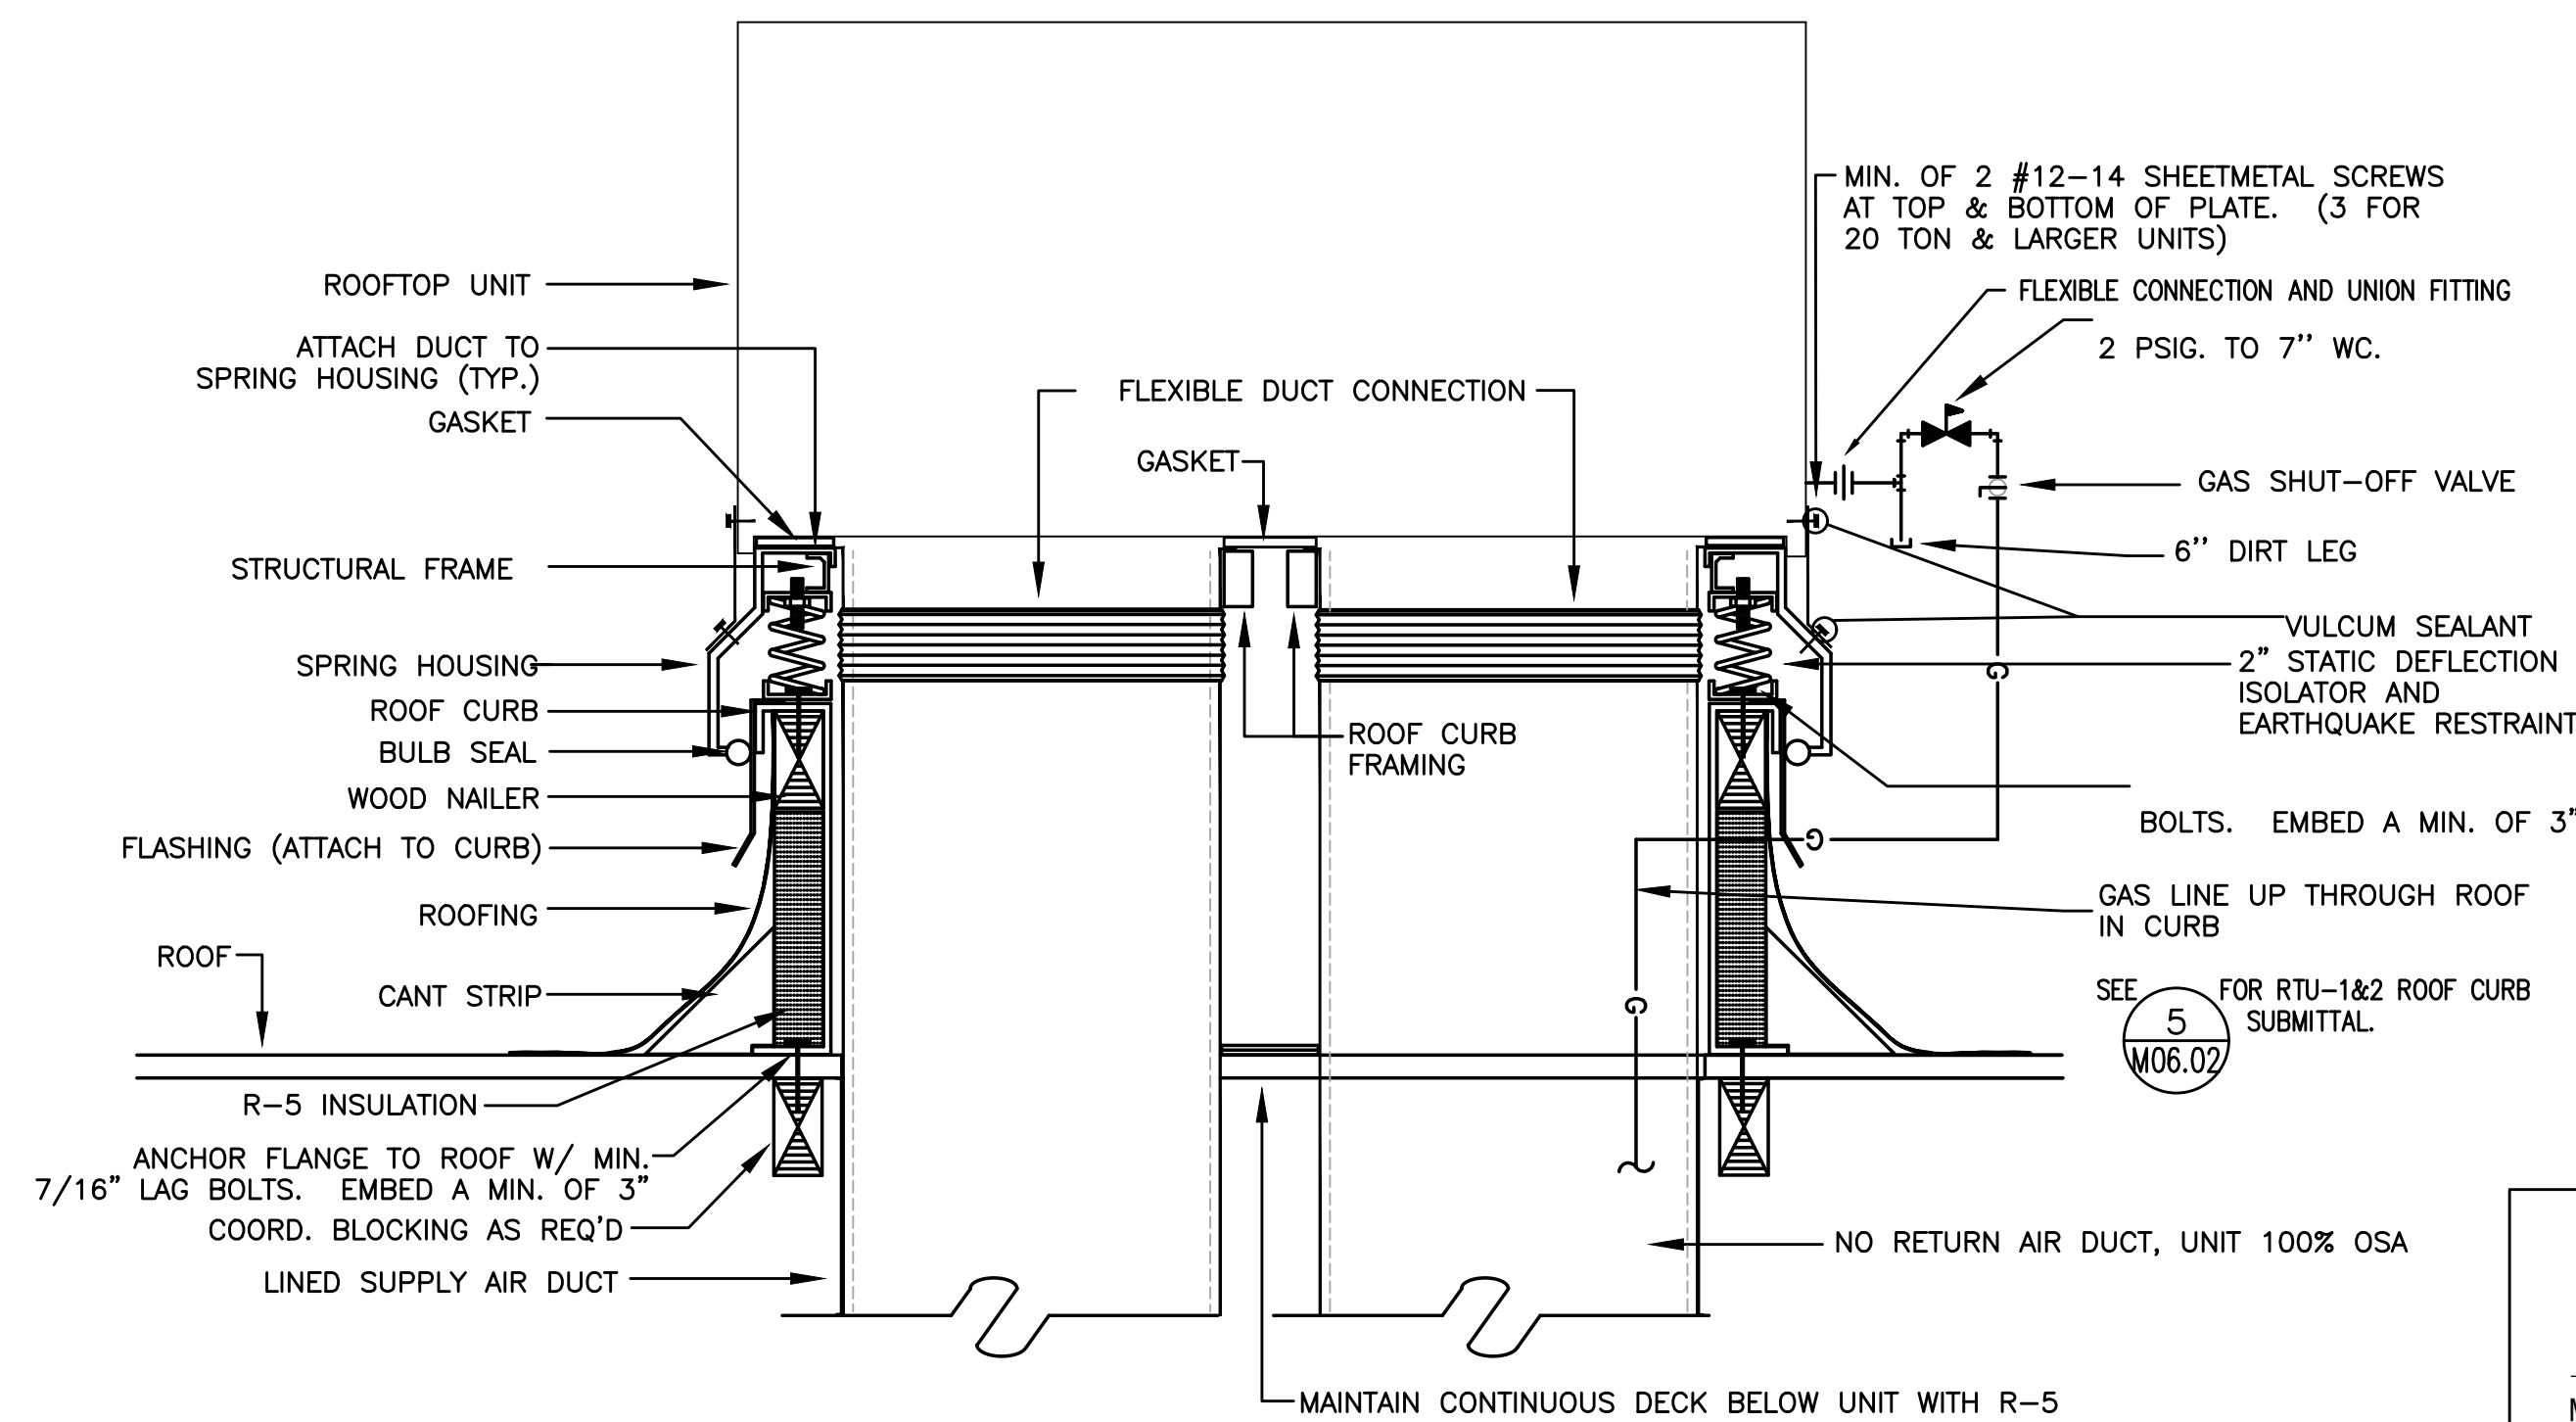


4 ROOF TOP UNIT W/ VIBRATION ISOLATION CURB  
M06.01 SCALE: DETAIL

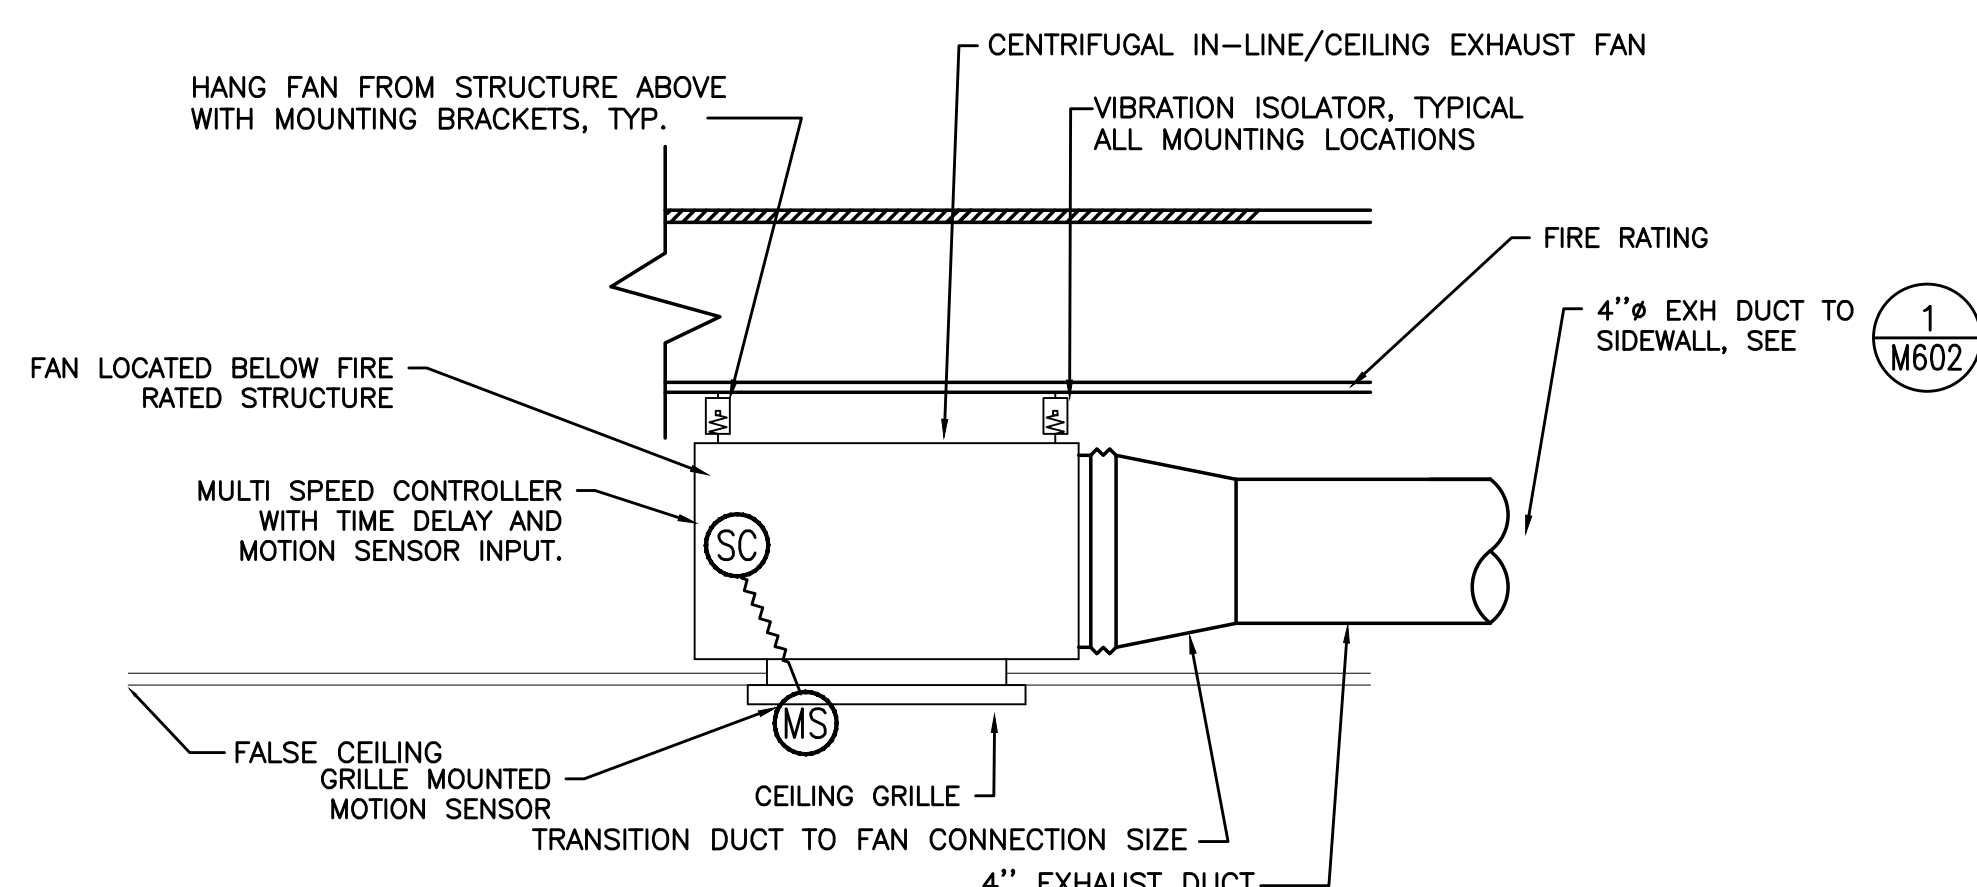

6 BATHROOM EXHAUST FAN  
M06.01 SCALE: DETAIL

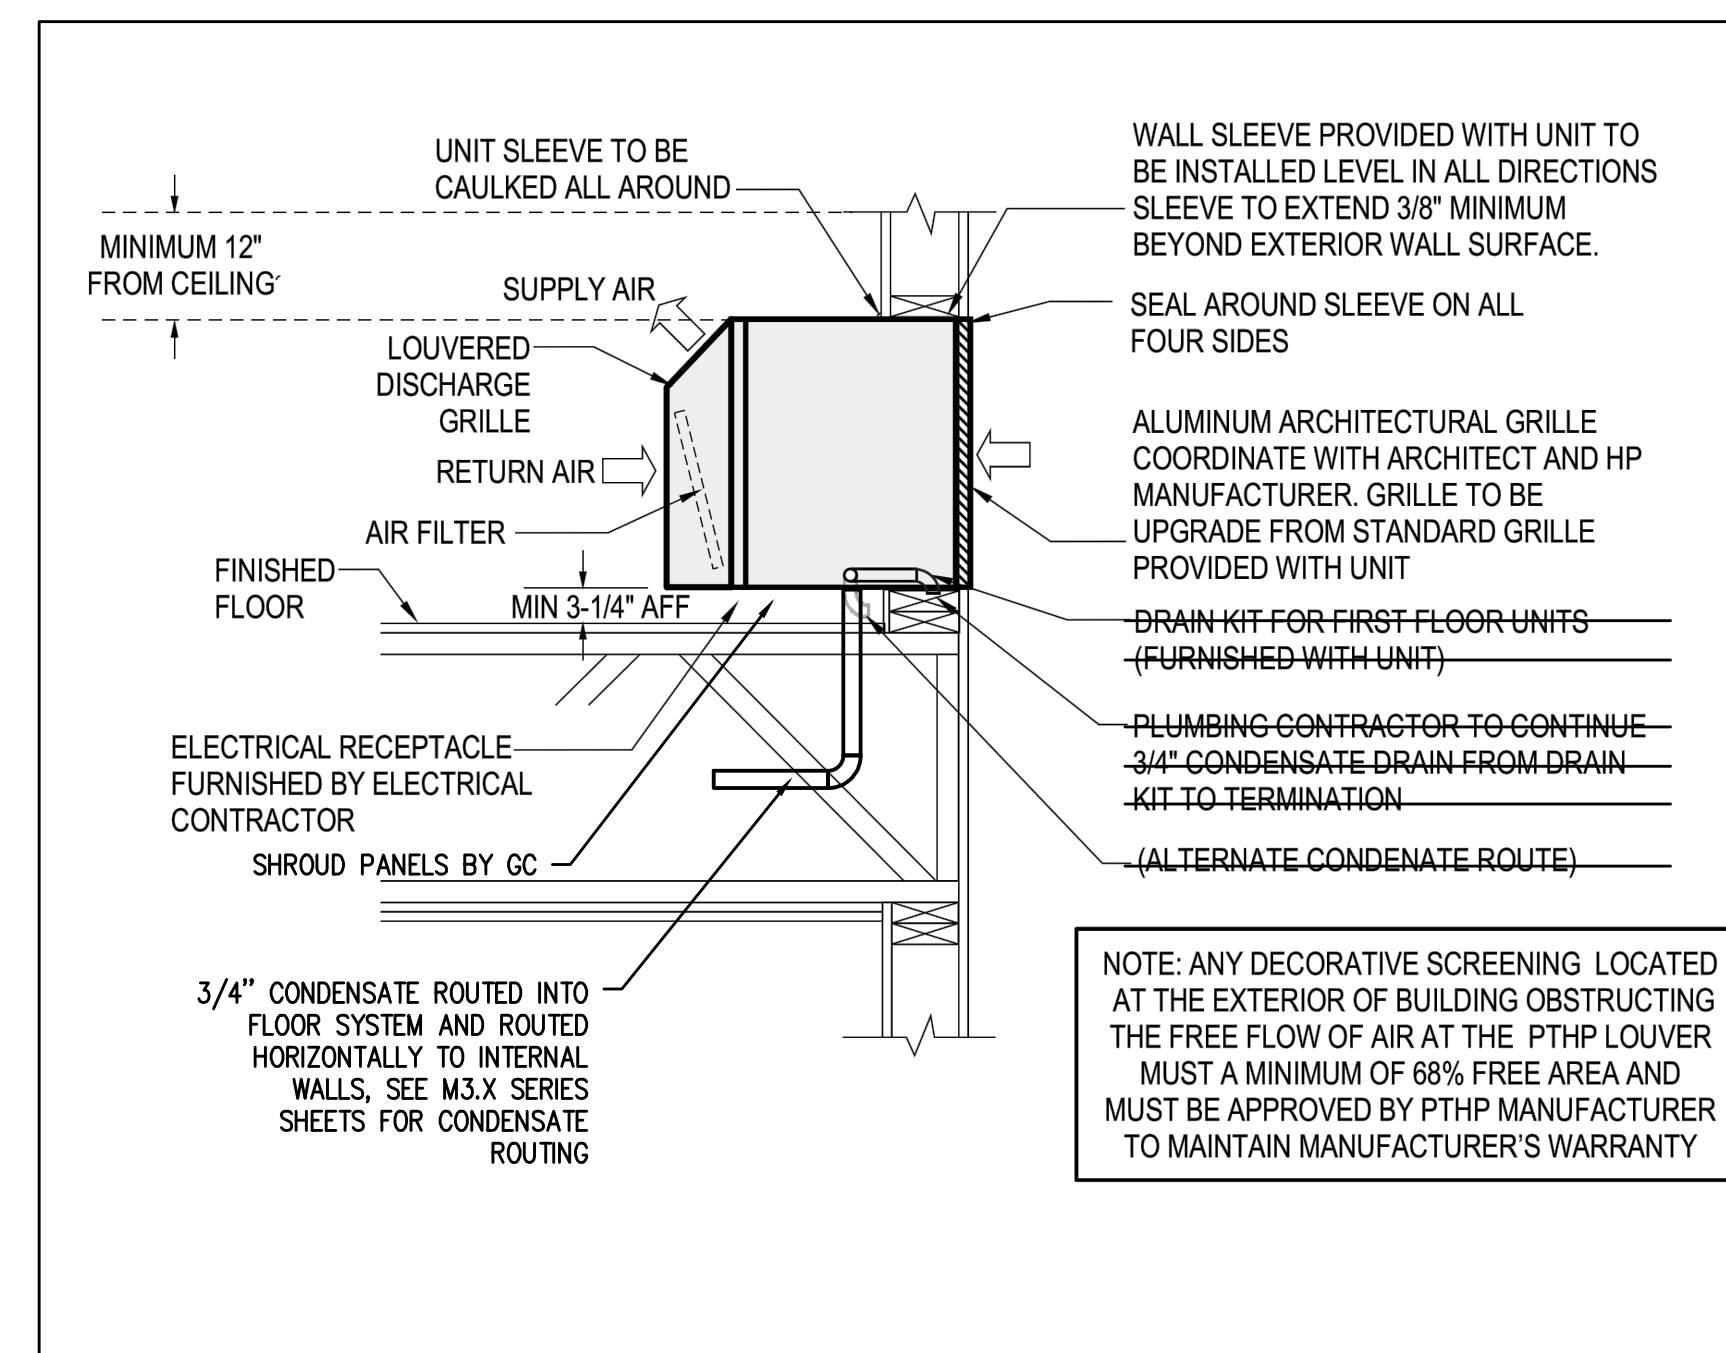

7 PTHP AT EXTERIOR WALL  
M06.01 NOT TO SCALE

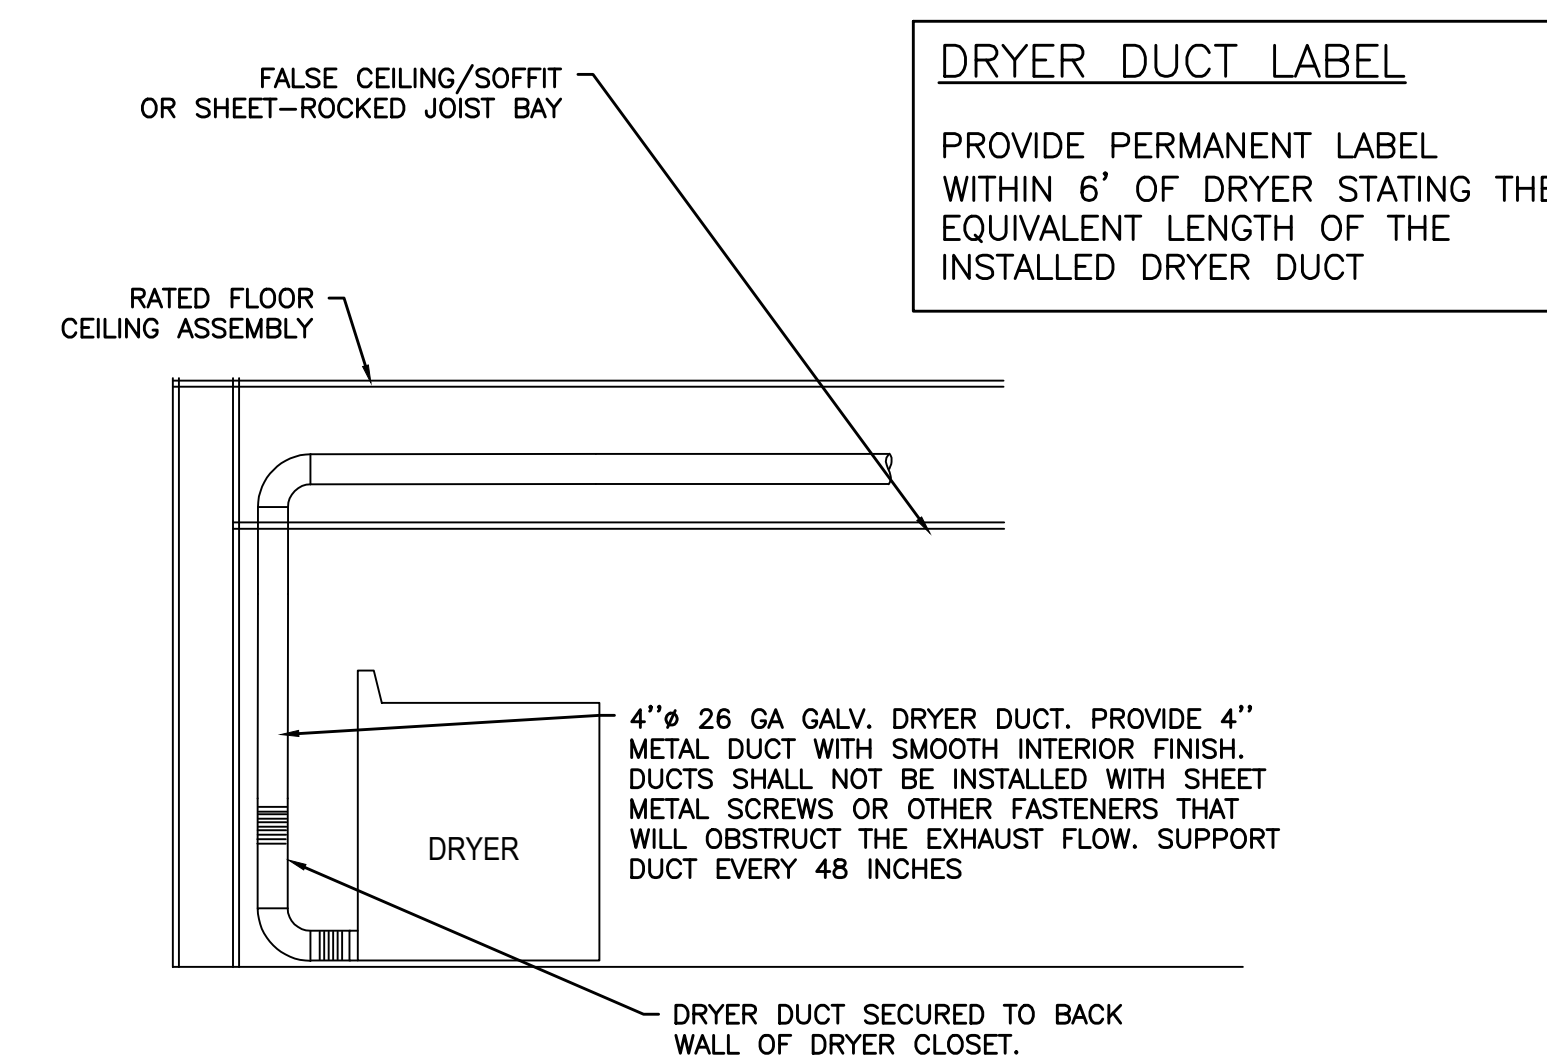


8 TYPICAL DRYER INSTALLATION  
M06.01 NOT TO SCALE









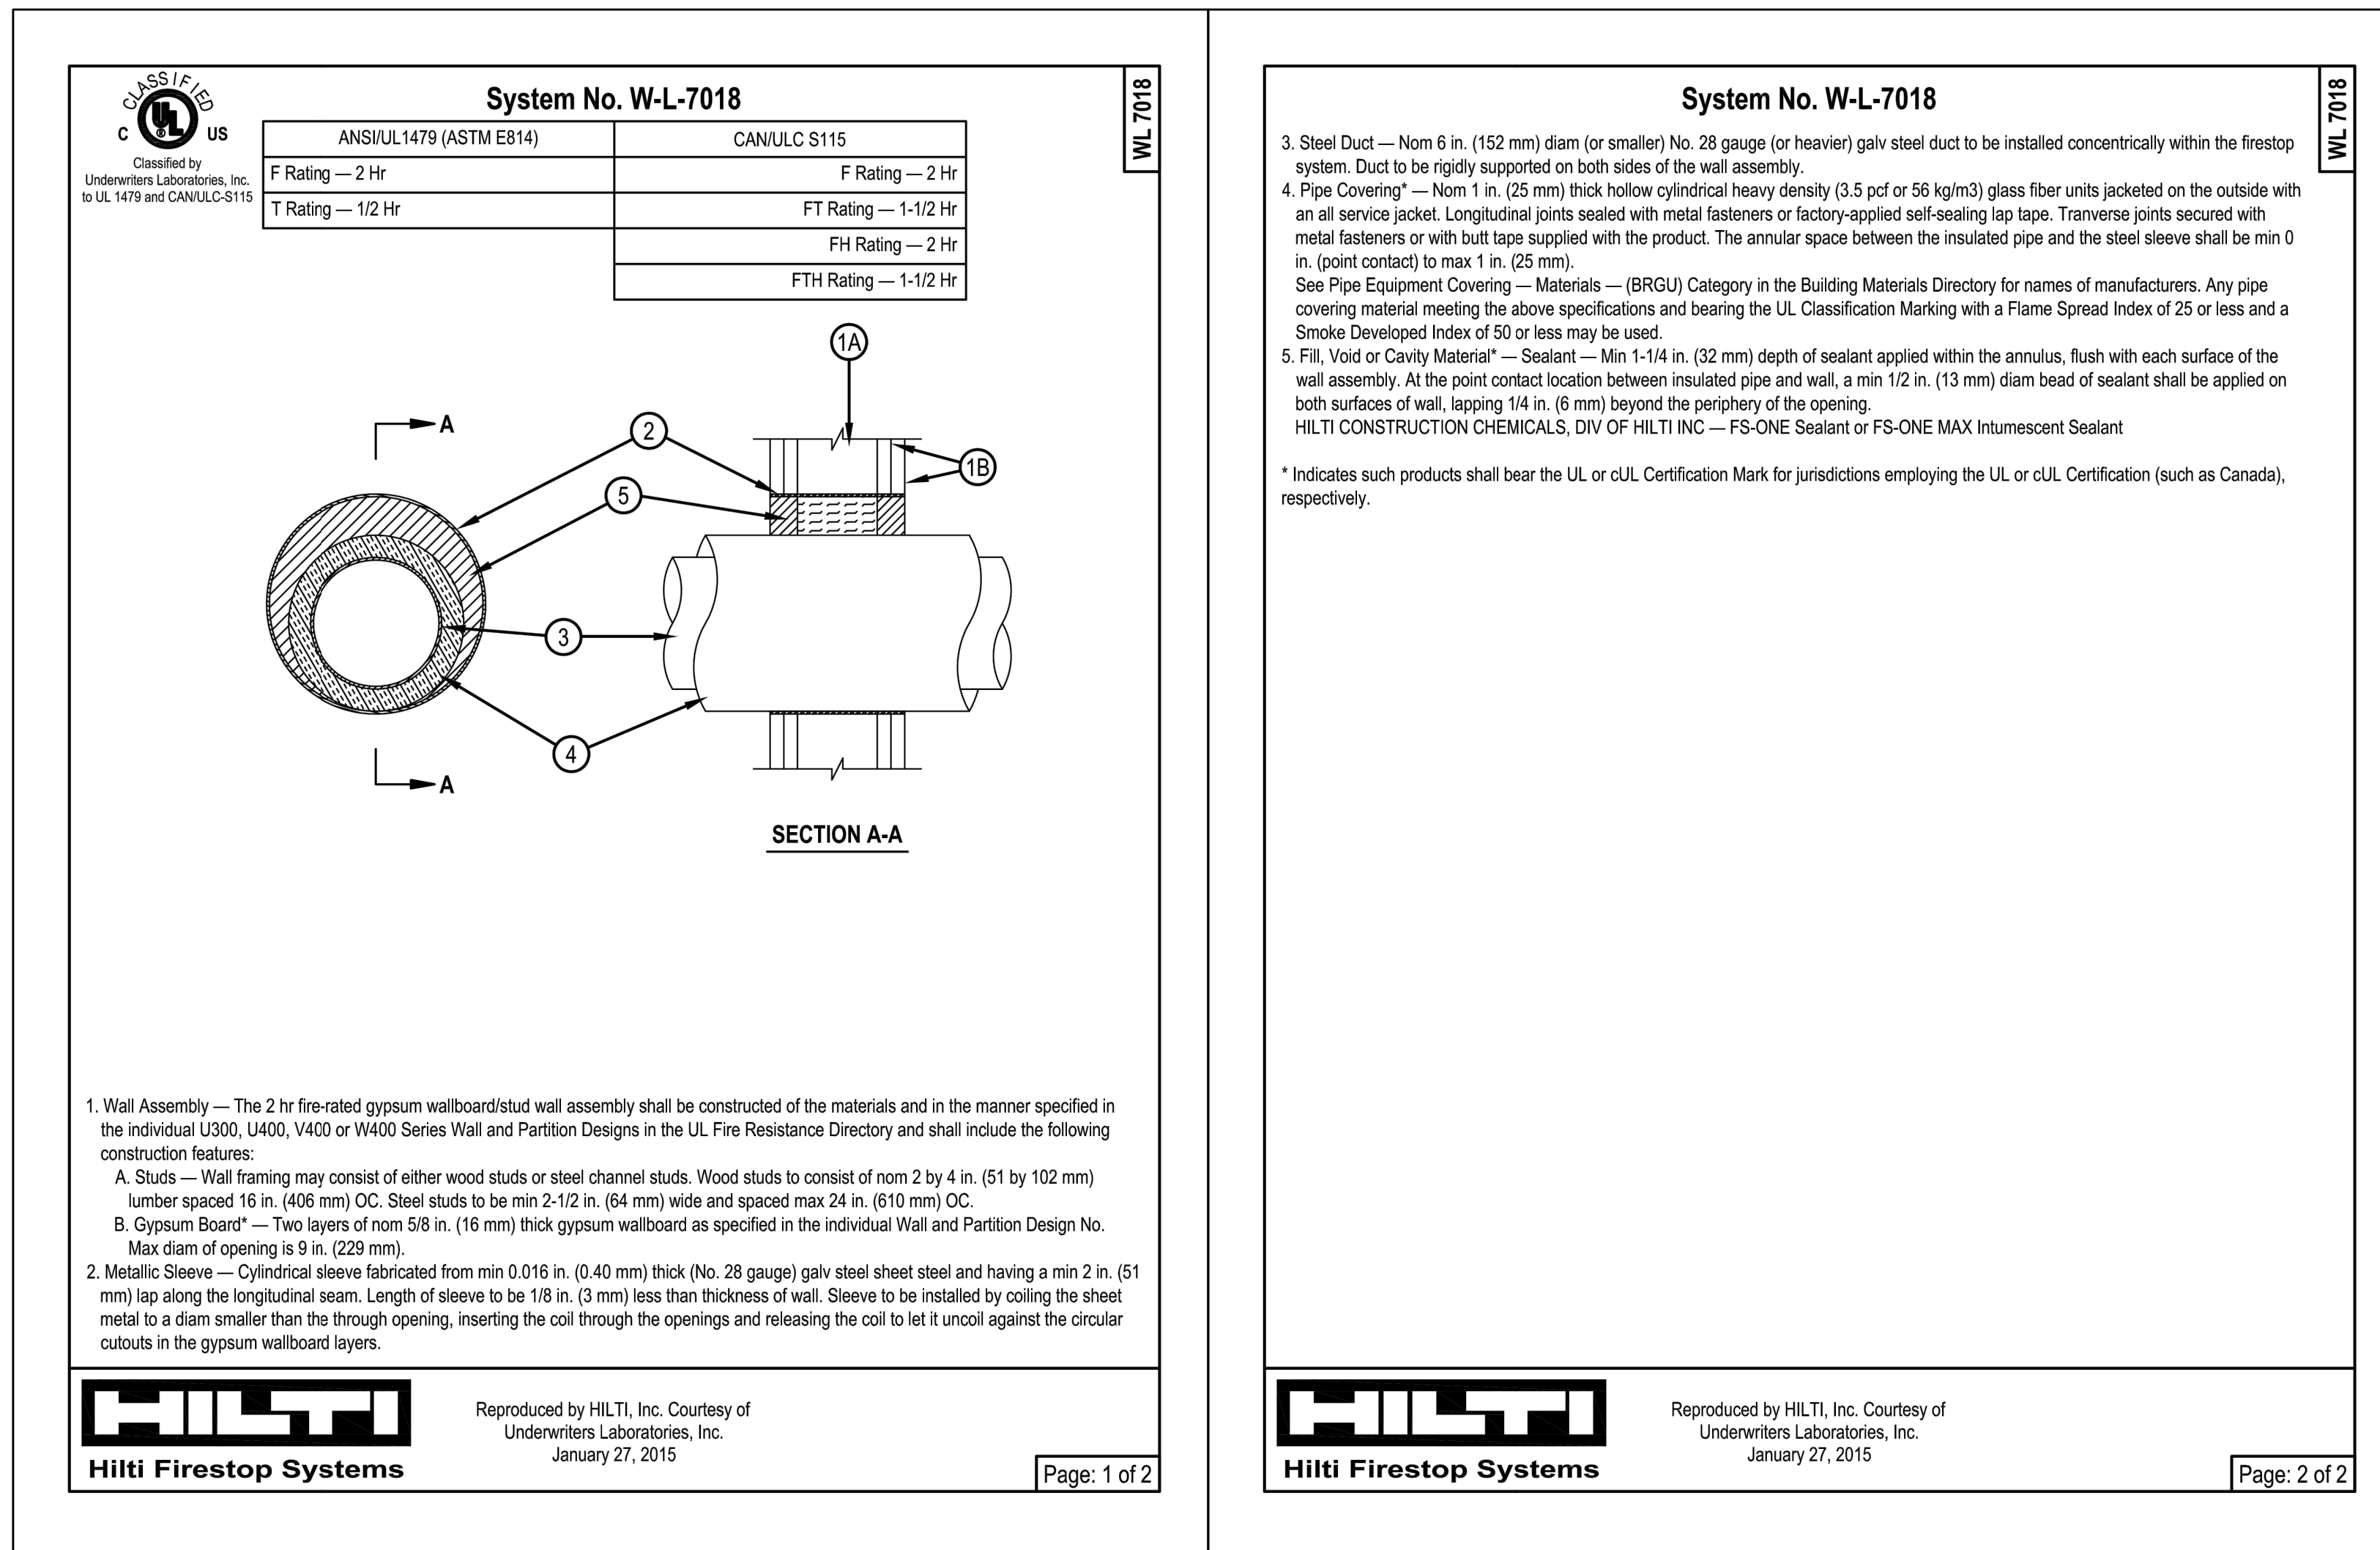

1 6" Ø UL FIRE PENETRATION DETAIL  
M06.03 NOT TO SCALE

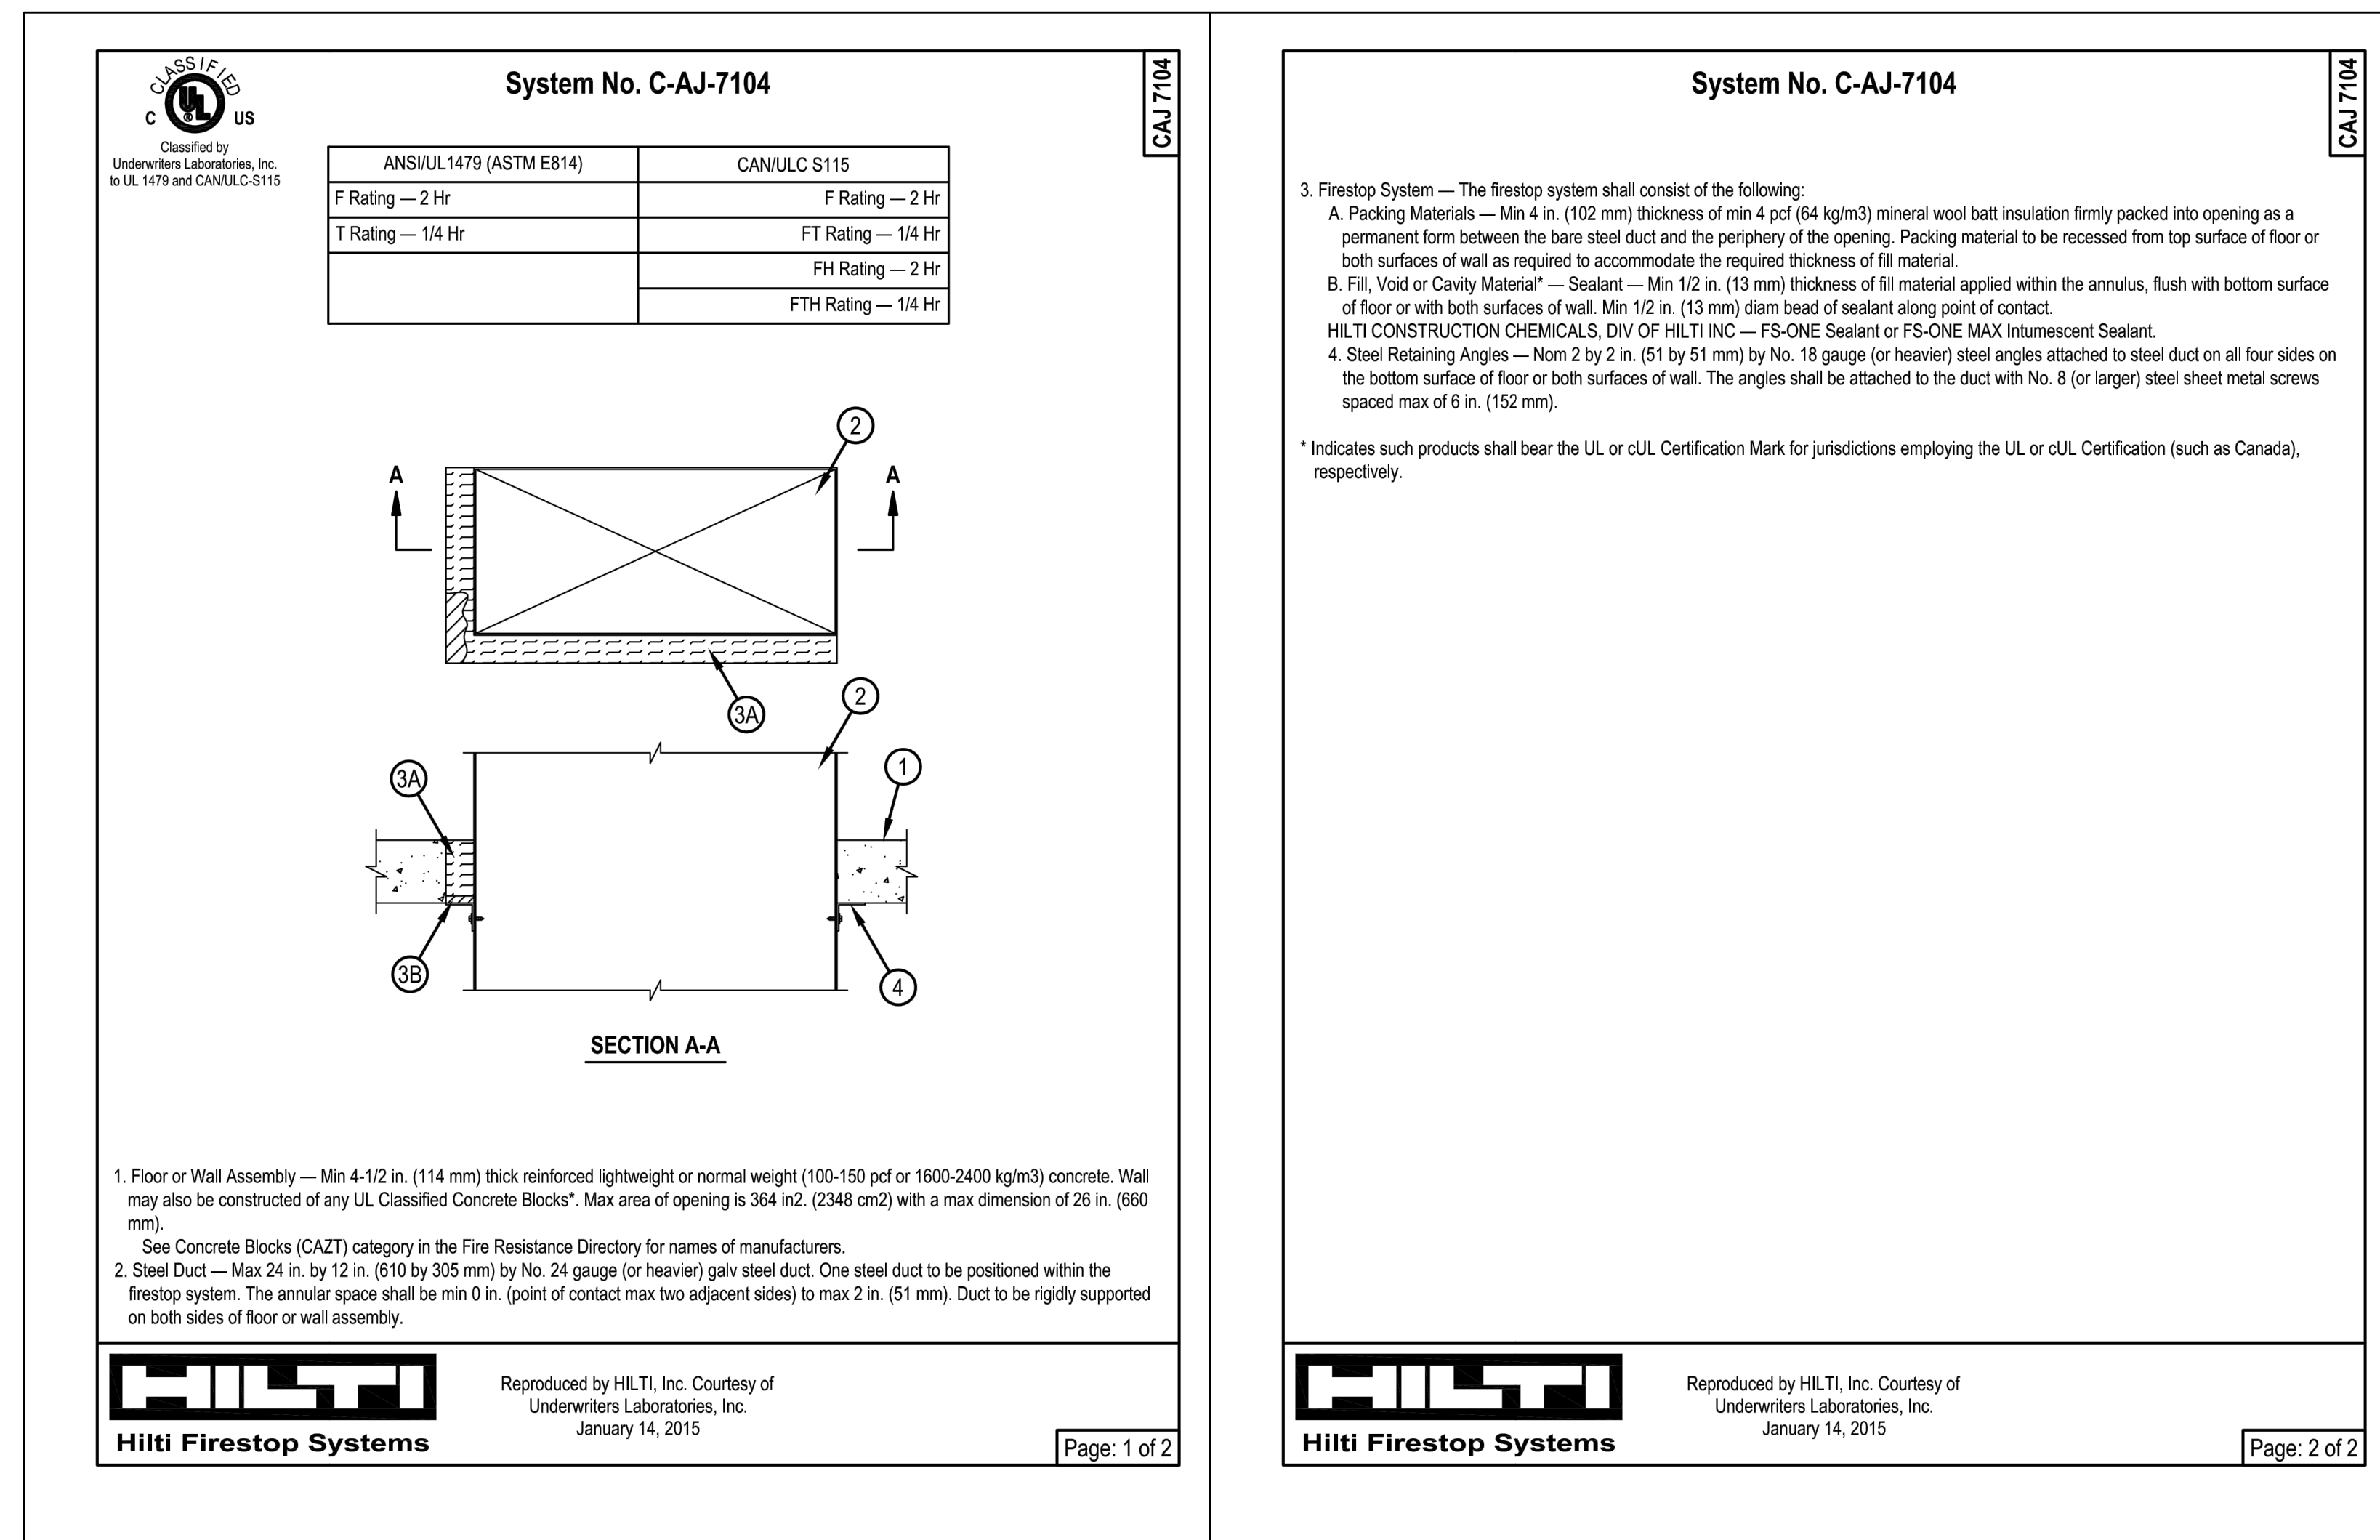

2 24X12 UL FIRE PENETRATION DETAIL — F/C  
M06.03 NOT TO SCALE

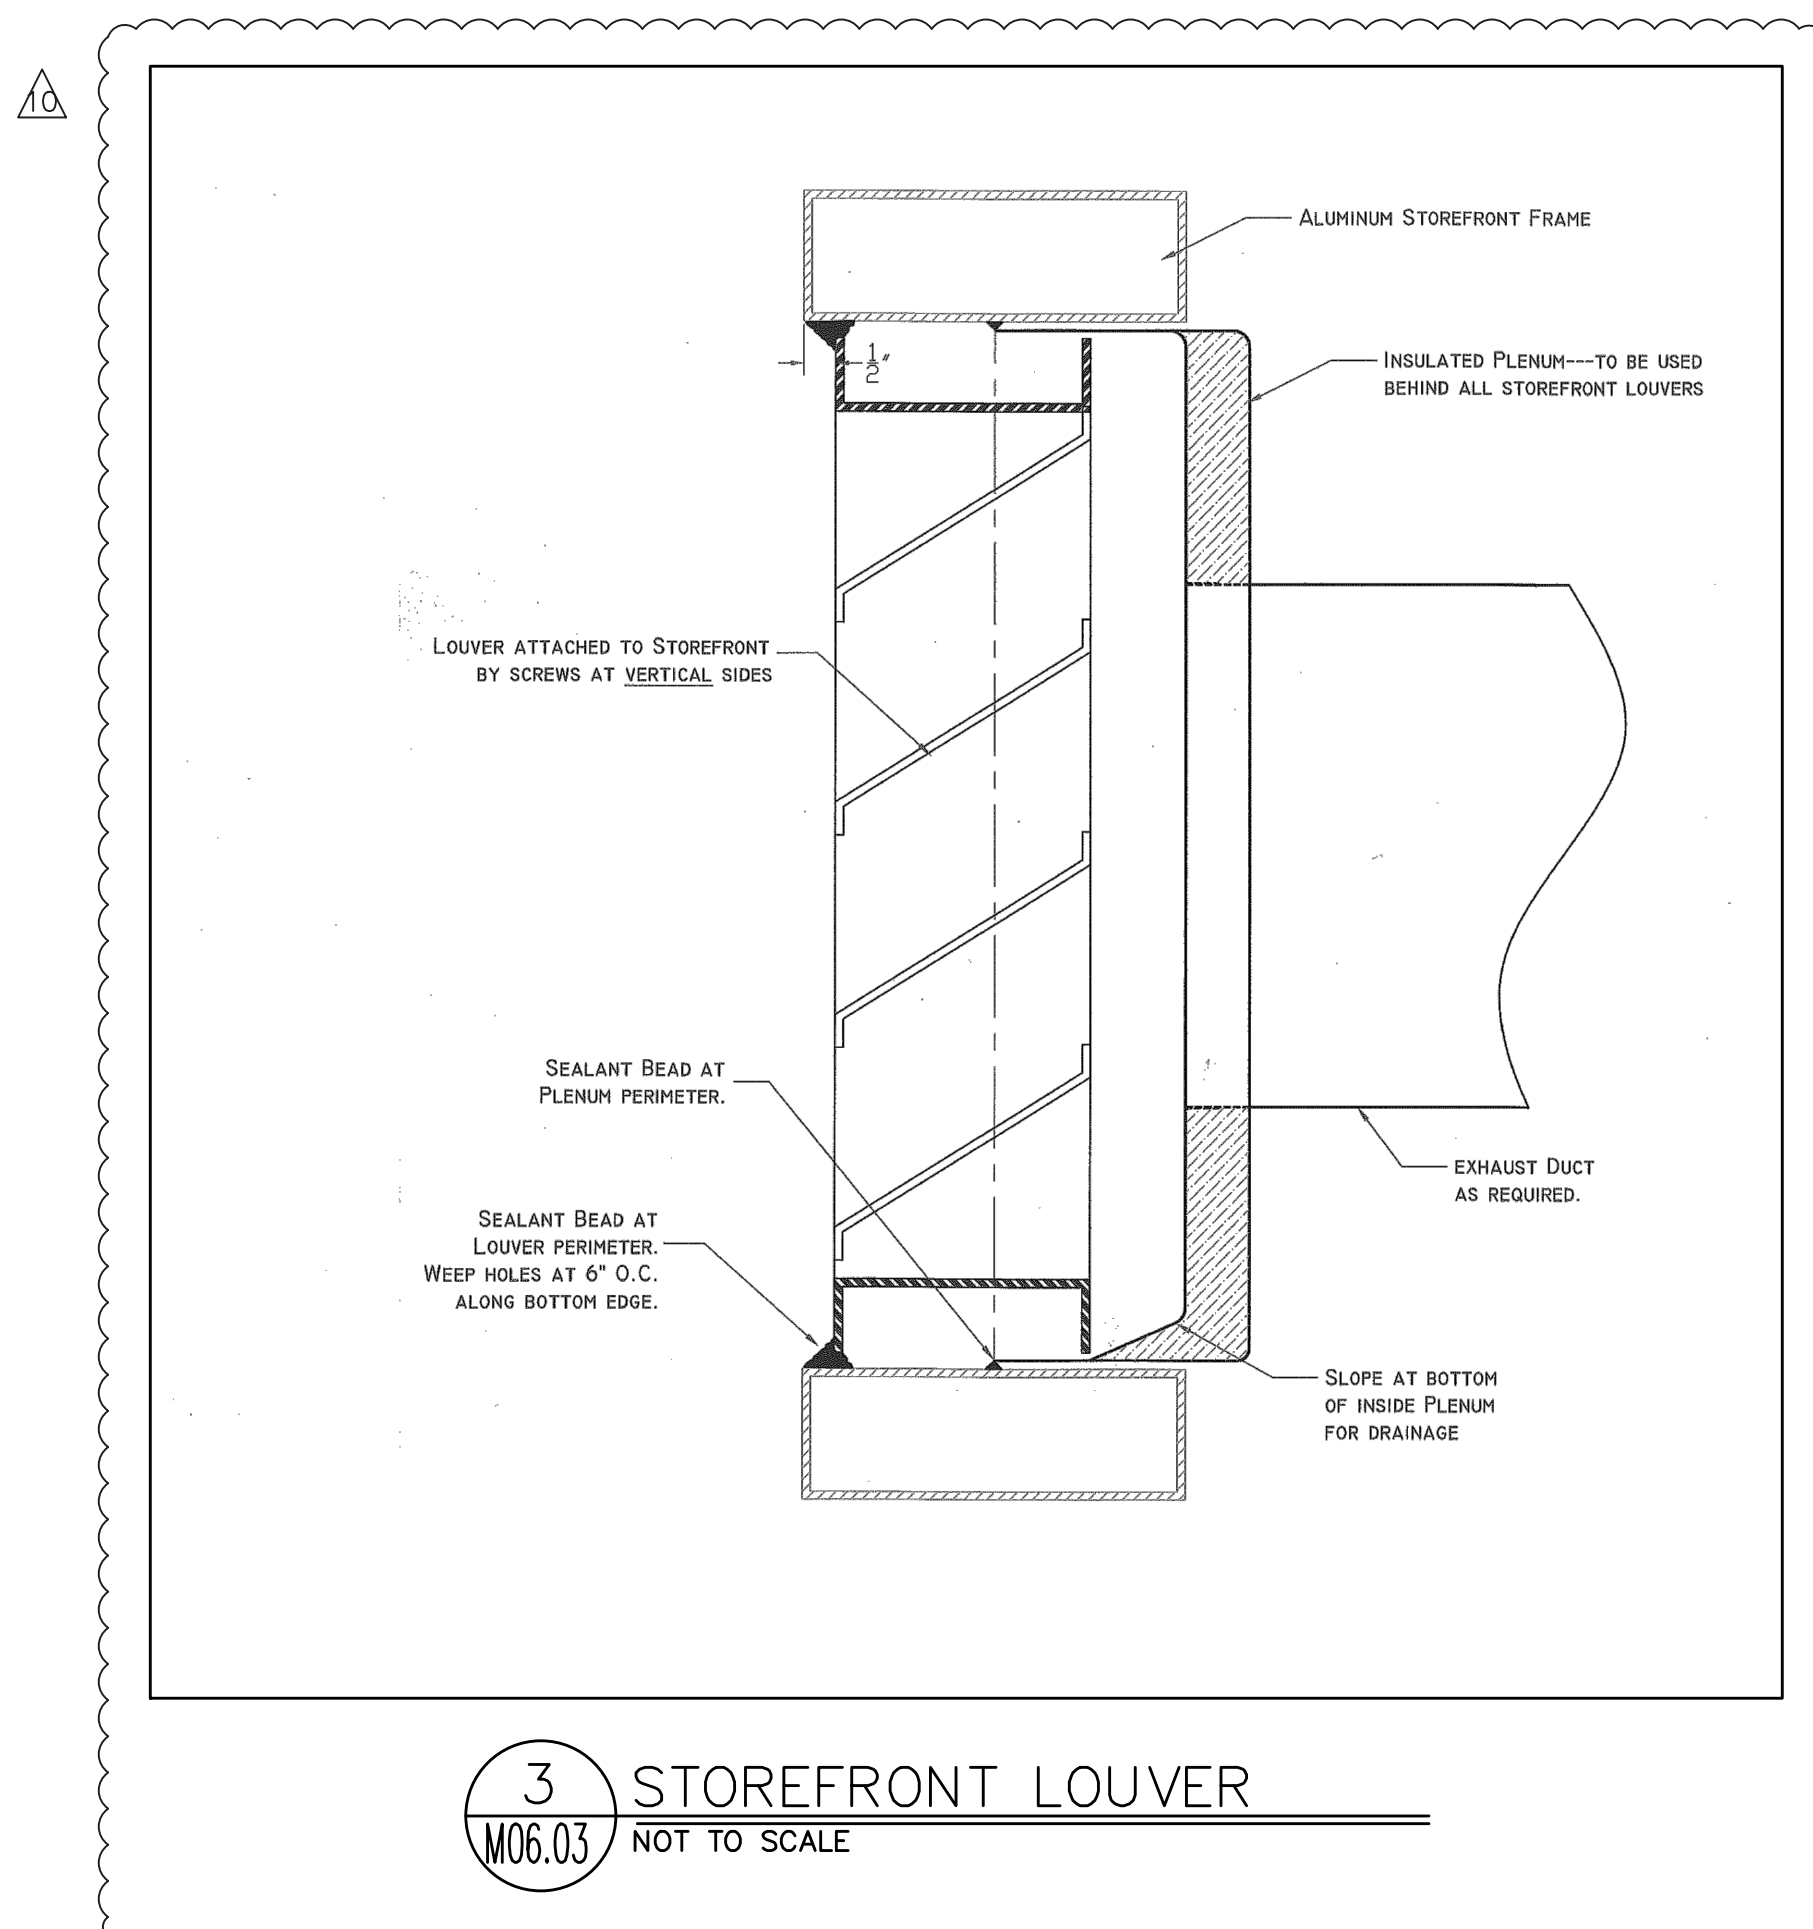

Revision:	4.29.20 - ADD #2 Permit Checksheet Response #2
Date:	12.20.19
Drawn by:	MFA/Jacobs
Project No.:	ATB-20