

KING+PARKS MULTI-FAMILY RESIDENCES

PROJECT SITE: NE Martin Luther King Jr. Boulevard & N Rosa Parks Way
OWNER: Portland Community Reinvestment Initiatives Inc. (PCRI)
6329 NE Martin Luther King Jr. Blvd. Portland, Oregon 97211



PROJECT NO.	ISSUE DATE
16-0602	11.15.2017
REVISIONS	PLAN CHECK RESPONSE
1	07.15.2018

SHEET
MECHANICAL 1ST
FLOOR PLAN - SOUTH

M2.0A

PERMIT SET
© MERRYMAN BARNES ARCHITECTS, INC.

MERRYMAN BARNES ARCHITECTS
Consulting Engineers
2007 S.E. Ash St.
Portland, OR 97214
PHN: (503) 234-0548
FAX: (503) 234-0677
CONTACT: Takako Baker

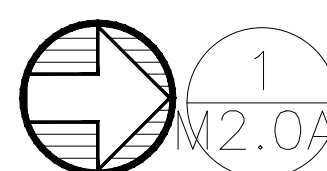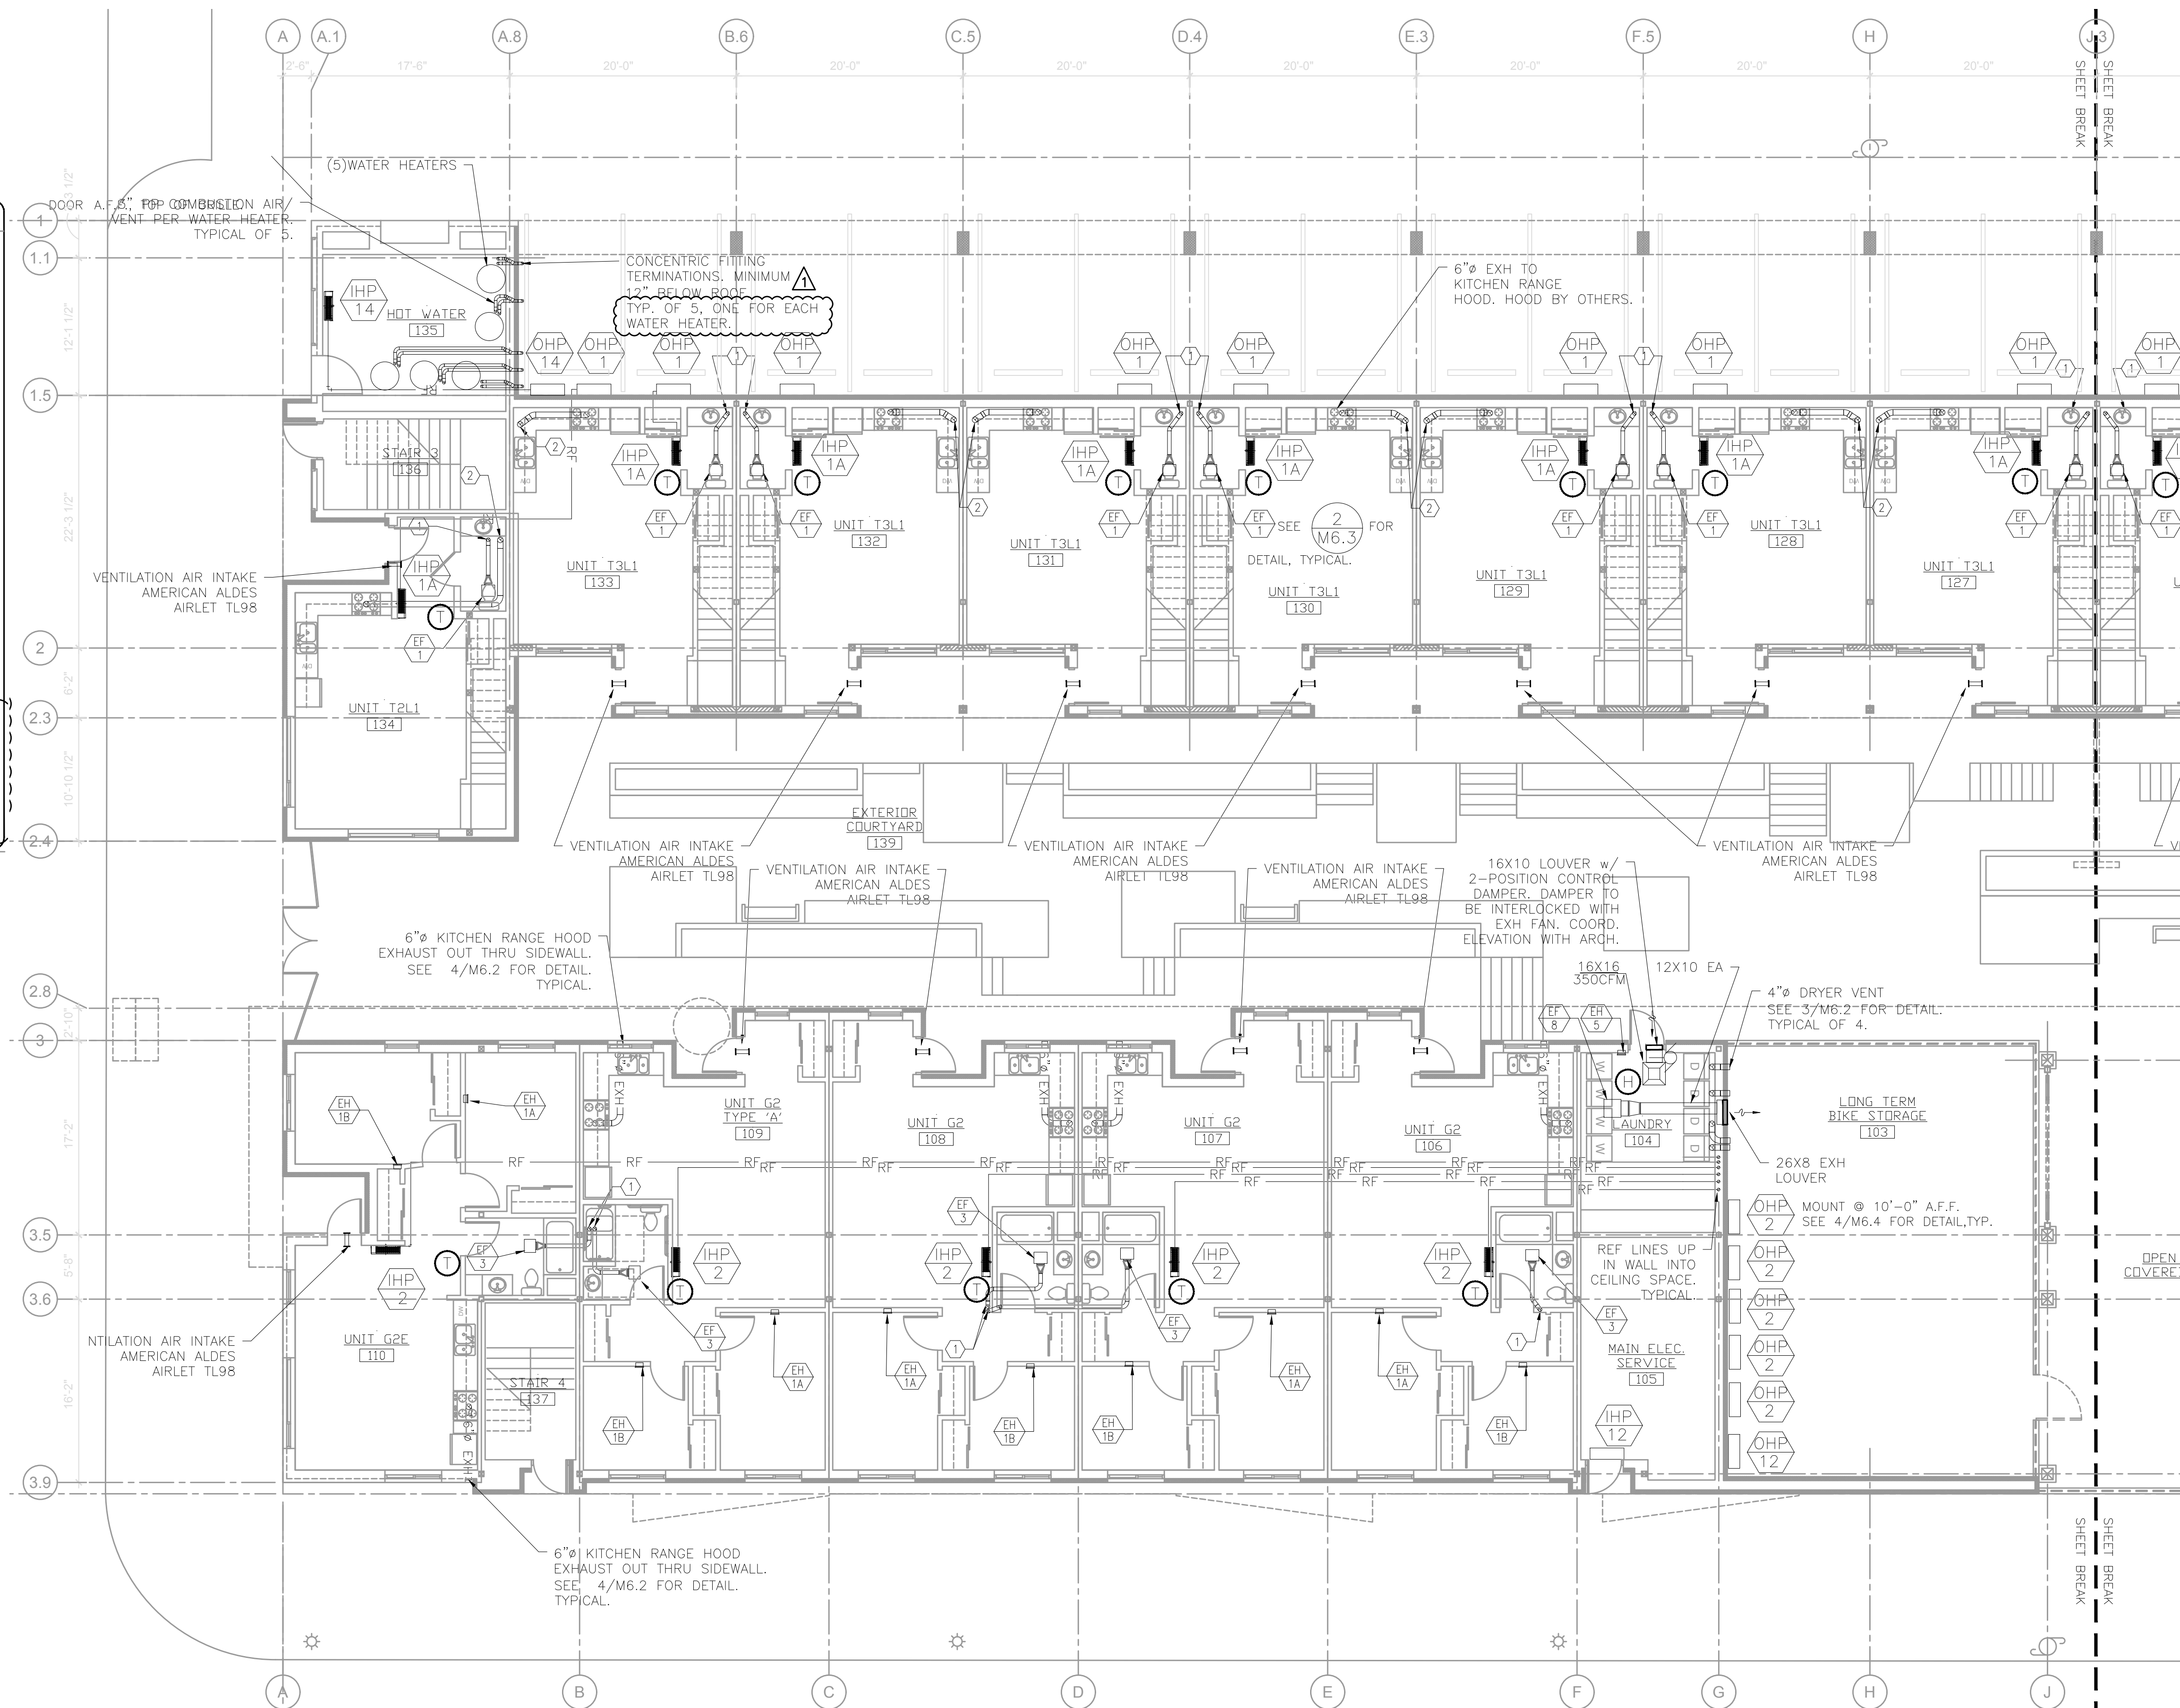

1 MECHANICAL FIRST FLOOR PLAN - SOUTH
SCALE: 1/8" = 1'-0"