


- KEYED NOTES:
- 6"Ø RANGE HOOD VENT TERMINATION AT ROOF. SEE 4/M6.3 FOR DETAIL.
- GENERAL NOTES:
- LIQ & SUCTION REF LINES ARE SHOWN AS A SINGLE PIPE FOR THE PURPOSE OF SHOWING ROUTING OF THE PIPING.
 - OSA INTAKES AT RTU'S TO BE LOCATED MINIMUM OF 10'-0" RADIUS FROM ANY EXHAUST VENTS, PLUMBING VENTS OR FLUE TERMINATIONS.

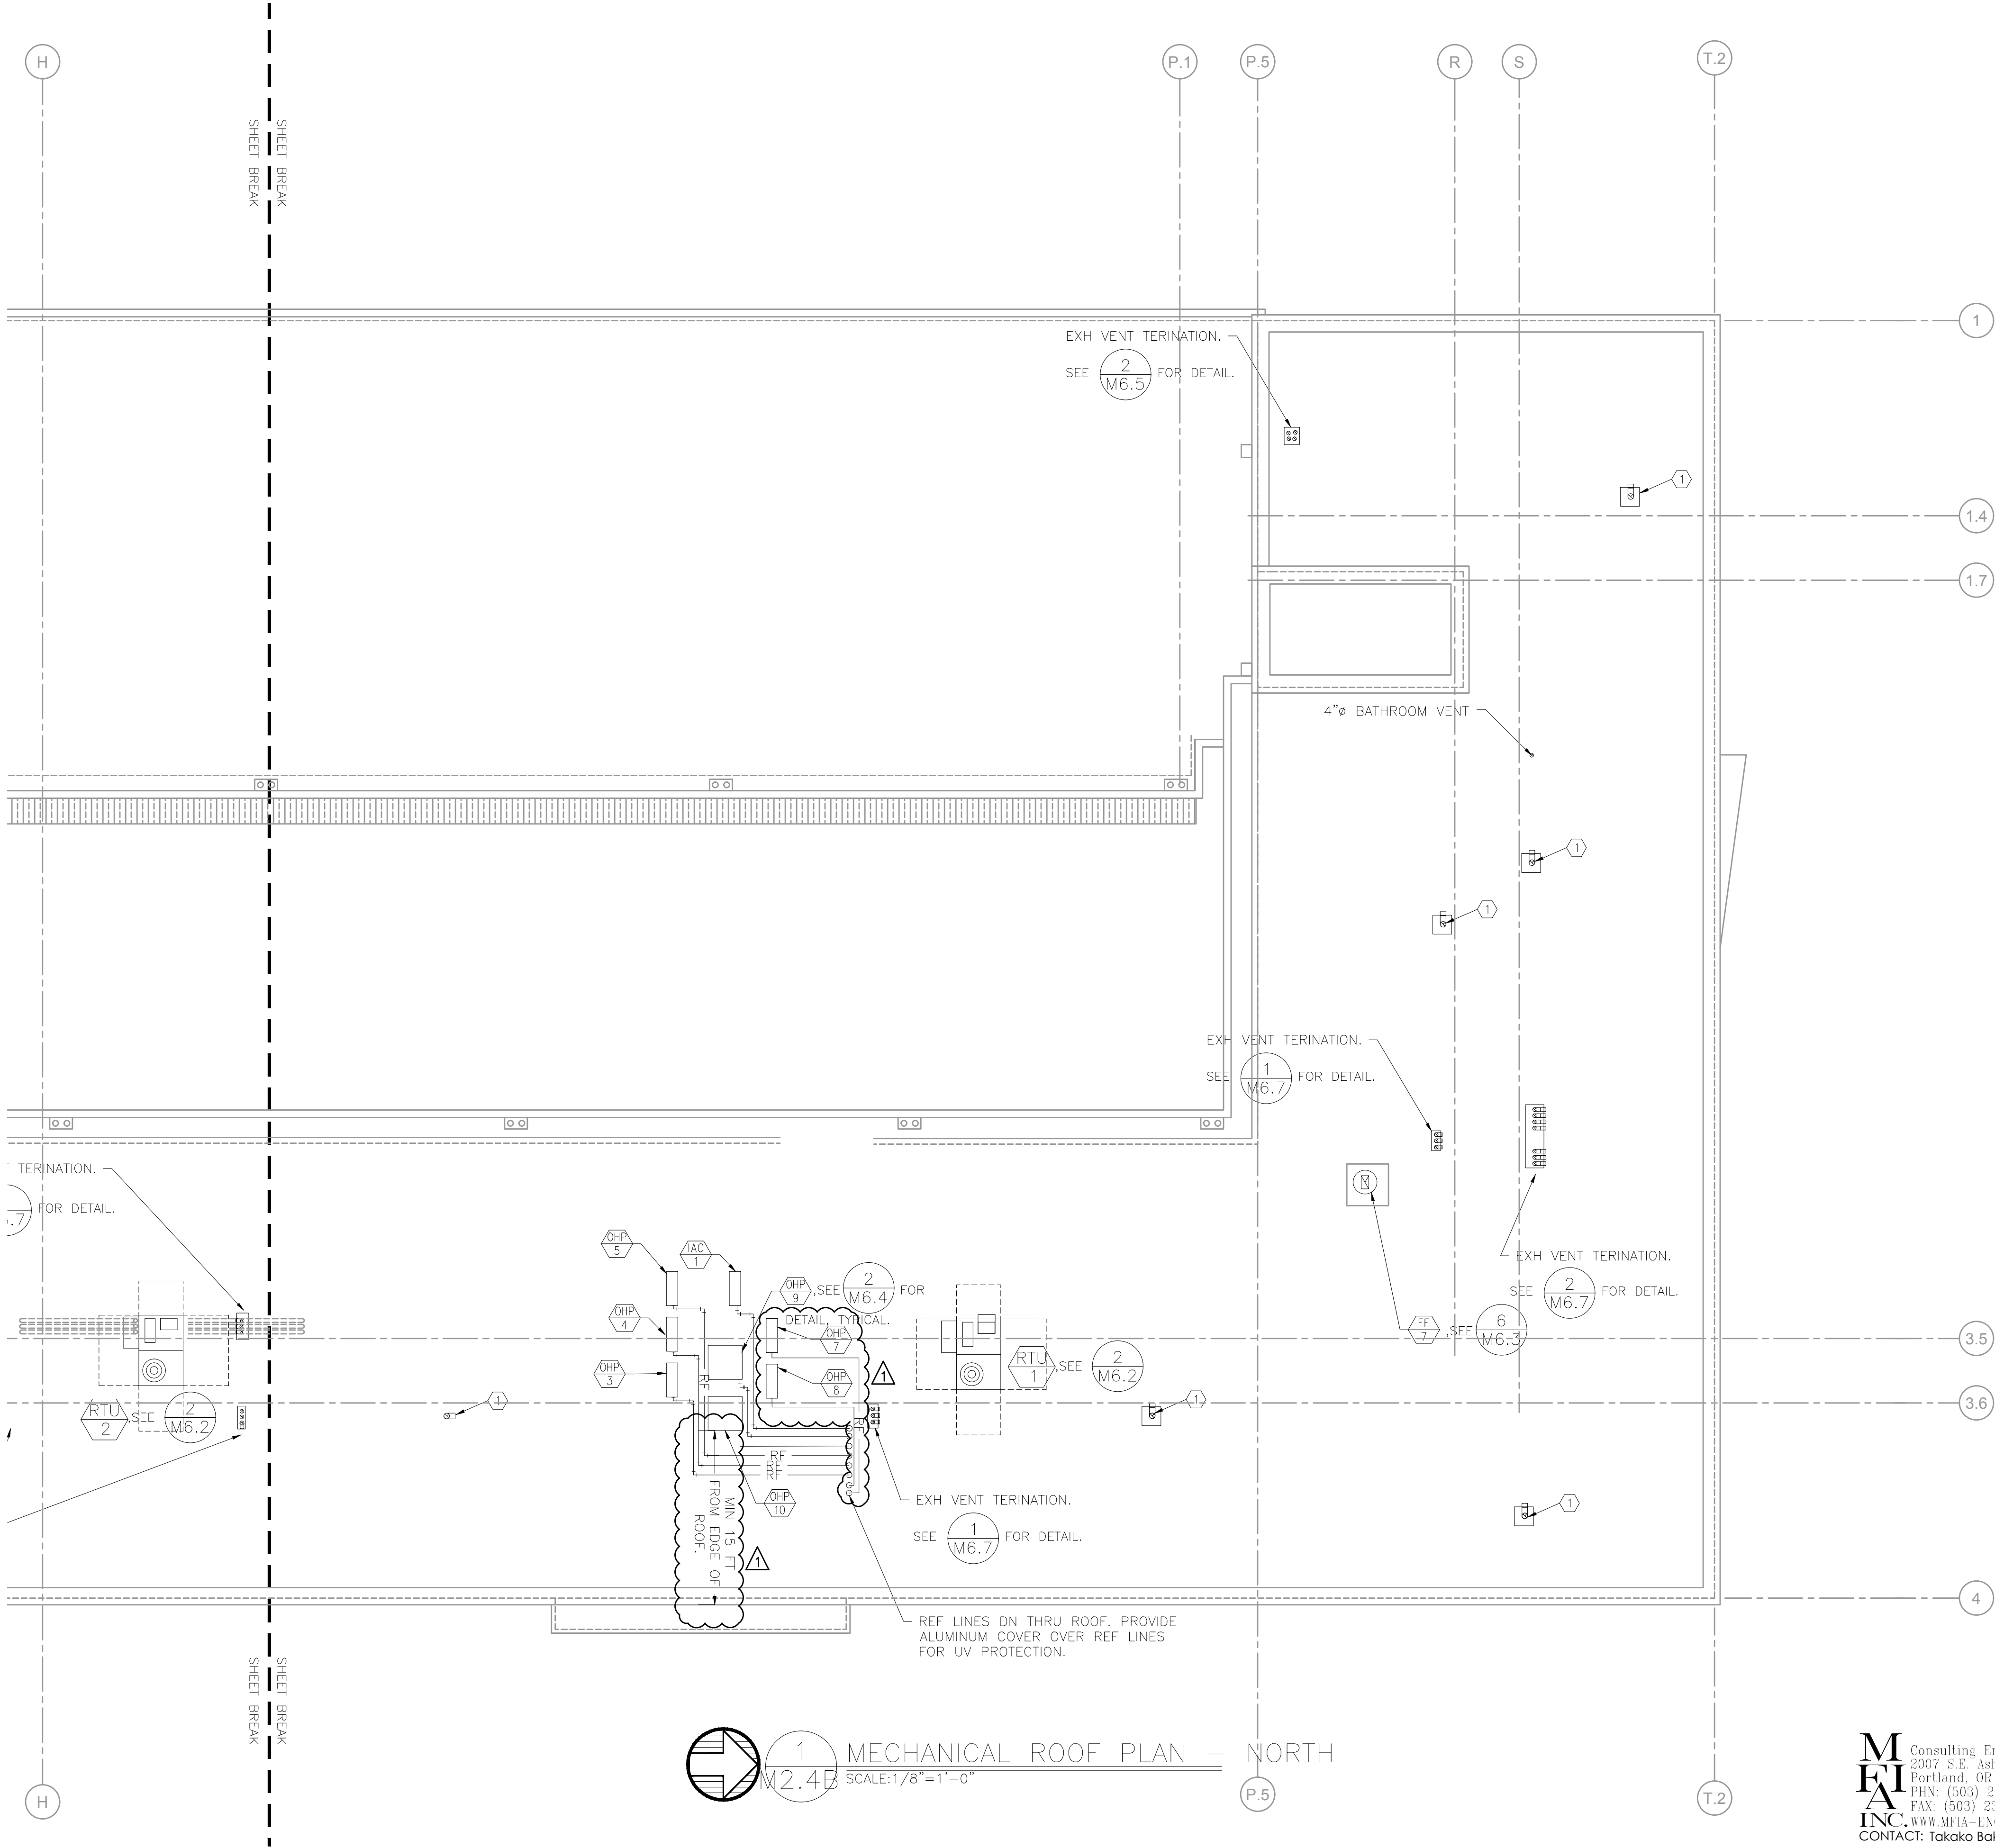

1 MECHANICAL ROOF PLAN — NORTH
M2.4B SCALE: 1/8" = 1'-0"

M Consulting Engineers
2007 S.E. Ash St.
Portland, OR 97214
PHN: (503) 234-0548
FAX: (503) 234-0677
WWW.MFIA-ENG.COM
CONTACT: Takako Baker



KING+PARKS MULTI-FAMILY RESIDENCES

PROJECT SITE: NE Martin Luther King Jr. Boulevard & N Rosa Parks Way
OWNER: Portland Community Reinvestment Initiatives Inc. (PCRI)
6329 NE Martin Luther King Jr. Blvd. Portland, Oregon 97211



PROJECT NO.	ISSUE DATE
16-0602	11.15.2017
REVISIONS	PLAN CHECK RESPONSE
1	07.15.2018

SHEET
MECHANICAL
ROOF PLAN - NORTH
M2.4B

PERMIT SET
© MERRYMAN BARNES ARCHITECTS, INC.