

**Domestic Water and  
Ventilation Analysis**

**Report**

**For**

**METRO, PORTLAND'S CENTER  
FOR THE ARTS**

**ARLENE SCHNITZER CONCERT HALL**

**ANTOINETTE HATFIELD HALL**

**AND**

**KELLER AUDITORIUM**

1111 SW Broadway | Portland, OR 97205

**MFIA, Inc.**  
2007 SE Ash Street  
Portland, Oregon 97214  
503-234-0548

 **Consulting Engineers**



James L. Tormey, P.E.  
 Mark Denyer, P.E., LEED AP  
 Robert L. Connell, P.E.  
 Scott Miller, P.E.  
 Takako Baker, P.E.

---

CONSULTING ENGINEERS • 2007 SE Ash St., Portland, OR 97214 • 503-234-0548

November 8, 2021

To: Portland'5 Centers for the Arts  
 Nancy Strening  
 Ed Williams

Subject: Domestic Water and Ventilation analysis Report for Arlene Schnitzer Concert Hall,  
 Antoinette Hatfield Hall and Keller Auditorium

This report covers the domestic water and mechanical systems analysis for Arlene Schnitzer Concert Hall, Antoinette Hatfield Hall and Keller Auditorium. The potable water supply analysis included sampling and testing for *Escherichia coli* (*E. coli*) and *Legionella* bacteria in each building. The mechanical systems were tested to determine performance of the existing air-handling units. These systems were also analyzed to determine code compliance with the *2019 Oregon Mechanical Specialty Code* and *ASHRAE 62.1-2016 Ventilation for Acceptable Indoor Air Quality*.

### **Plumbing Domestic Water System**

The domestic water supply sampling and testing was performed by Watercare Industrial Services, Inc. and Columbia Laboratories. On May 26, 2021 we witnessed water samples being taken from multiple remotely located plumbing fixtures in each building. A set of these samples were sent to Environmental Safety Technologies, Inc. to be tested for *Legionella*. The microbiological analysis showed no bacteria detection in any of the samples. This lab analysis is included in *Appendix 5a - Portland 5 Water Legionella Report*. The *Escherichia coli* testing, was done by Columbia Laboratory from another set of the samples taken. No *E. coli* was found in any of the samples. The lab analysis for *E. coli* is included in *Appendix 5b - Portland 5 Water Escherichia Coli Report*.

### **Mechanical Ventilation and Exhaust System**

The mechanical study was based on the as-built documents and the airflow measurement and testing performed in the field between the dates of 05/24/2021 and 08/03/2021. The HVAC as-built documents are included in *Appendixes 7a, 7b, and 7c*. Our comments and suggestions in this document are based on the provided record drawings and documents. If the installation is completed differently than detailed or changes where not captured in the record drawings then these observations would potentially be incorrect.

The outside airflow ventilation calculations for code compliance include the space supply airflow rates. This is done to account for the system's outdoor airflow's mixing and distribution effectiveness in reaching the occupied level. The space supply airflow rates included in the calculations have been taken from the HVAC as-built floor plans. In order to meet the newer code's ventilation airflow requirements, control adjustments will need to be made and most of the existing air-handlers' fans will be required to operate at full airflow rate when the building is fully occupied. The calculated occupancy rate has also been adjusted to code minimum in certain spaces. Verification of the possible number of people in the building is required prior to accepting the calculated ventilation airflow rates for these systems. Also some of the rooms' supply airflow rates have been adjusted in the calculation and this will require field rebalancing to ensure the listed supply airflow is provided in the space. These adjusted airflow rates have been specifically noted in the calculation tables shown in the appendixes at the end of this document.

In addition, calculations were also performed to determine current performance of the room air change rates for the supply, exhaust and ventilation airflow rates; these values were based on the air balancing data reported and the as-built documents. The air change rate calculations tables for each building are provided as separate files for individual distribution. For Arlene Schnitzer Concert Hall see Appendix 8a; for Antoinette Hatfield Hall see Appendix 8b and for Keller Auditorium see Appendix 8c.

The energy code has been requiring demand control ventilation or CO2 control to reduce outside airflow when there is no demand. For the time being, this code section has been recently superseded by the CDC to reduce risk exposure to the SARS-CoV-2 viral particles and to reduce the spread of the disease. The minimum CO2 ventilation rate calculated and noted below shows the minimum ventilation airflow rate allowed in compliance with the previous requirements. If the systems have demand-controlled ventilation (DCV) that reduce air supply based on occupancy or temperature during occupied hours, this strategy must be disabled until further guidance and recommendations are put in place.

Airflow measurement and testing was done at each air-handling unit at the system level; this field work was conducted by Air Balancing Specialty, Inc. The air balancing report data is included in *Appendix 4 – Portland 5 Air Balancing Report* following the ventilation calculation appendixes. Some of the air-handling systems did not have testing capability. As a result reliable test information is not available.

#### General Balancing Report Review Comments

In our review of the balancing report we noticed ventilation airflow being supplied to the space during the warm-up operation or 0% outdoor airflow test. Most of the air-handlers have a minimum and a maximum outside air damper. The 0% ventilation testing should measure close to 0 CFM of outdoor airflow. The balancing data measured various airflow rates at this test; verify operation of the minimum and maximum outdoor air dampers (where two dampers are installed). Per the original design the minimum outside air dampers shall open for minimum ventilation operation. For maximum outside airflow ventilation or economizer function, in addition to the minimum damper, the maximum outside air damper shall open as well. The maximum ventilation airflow for economizer function does not match the fan total at the 100% outdoor air test for most of the air-handlers. Verify return air damper is closed and outside air damper is open to prevent recirculating air for economizer function.

The balancing report shows a number of the system's exhaust/relief fans not operating within their design airflow range; these are noted below. Code requires adequate relief airflow for space pressure control.

The information below is arranged to addresses each building in a separate section. The building's HVAC systems installation and operation and common aspects are described at the beginning of the building section. Then, in consecutive order, each air-handler system is addressed in detail. A summary of the air-handling units' original design airflow rates is included at the bottom of the building section, under the System Design Parameter Table. The section is also followed by the Air Balancing Summary Table which summarizes the final test data for each air-handler unit.

## **Arlene Schnitzer Concert Hall**

### System Descriptions

Arlene Schnitzer Concert Hall is heated, ventilated and air-conditioned by six indoor air-handling units originally installed in 1983. A roof-top unit was added later to condition the projection spaces. The air-handlers are located in mechanical rooms on various building levels. Ventilation outdoor airflow is ducted to the air-handling units from wall louvers or roof hoods. Relief air is ducted from the air-handling units to wall louvers or roof hoods. The ventilation calculation analysis table for this building is included under *Appendix 1 - Outside Ventilation Airflow Code Analysis Calculation Table – Arlene Schnitzer*.

The air-handling units have a minimum and a maximum outside air damper. The field balancing data shows outdoor ventilation airflow rates inconsistent with the design conditions. Both outside air dampers shall be closed at the 0% ventilation testing. Unless noted differently below, only the minimum outside air dampers shall be opened for the minimum ventilation operation. During maximum outside airflow ventilation, in addition to the minimum damper, the maximum outside air damper shall also be opened.

### ASU-1 and ASU-2 Systems

Unit ASU-1 and ASU-2 are designed for two speed operation. Each air-handler is comprised of a supply fan, return air damper, minimum outside air damper, and maximum outside air damper. The system provides minimum ventilation outside airflow through the minimum outside air damper. Economizer outside airflow is provided by opening both the minimum and maximum outdoor air dampers; the total outdoor airflow is limited by the duct and louver size and cannot be increased beyond what is shown in the calculations table. The associated exhaust fan (EF-5 with ASU-1; EF-4 with ASU-2) must operate to provide space exhaust when the maximum outside air damper is open for economizer function. During the warm-up mode, the associated exhaust fan shall be off and both outside air dampers shall be closed.

#### ASU-1: Auditorium System

This system is designed to supply 41,000 CFM and 28,700 CFM during normal occupied and unoccupied operation modes respectively. The minimum outdoor ventilation airflow is designed to provide 6,950 CFM and 13,750 CFM during unoccupied and occupied operation modes respectively.

The code's ventilation calculations for normal occupancy require 13,750 CFM outdoor airflow with the supply fan providing full airflow to each space. For this air-handler both minimum and maximum dampers need to be open to meet this ventilation rate of 13,750 CFM. The heating and cooling coils are sized to handle the design maximum outdoor airflow rate. The code space area outdoor ventilation rate for minimum CO<sub>2</sub> control equates to 1,450 CFM. The original design's lower ventilation rate is above this code requirement. For the time being, the low ventilation operation is annulled by CDC.

Balancing data shows the supply fan providing between 38,453 CFM and 41,170 CFM depending on dampers position and operation mode. The outside airflow measured between 350 CFM and 10,370 CFM. The measured supply airflow falls within design parameters. The measured outside airflow minimum and maximum ventilation is not per design. The air-handler outside airflow must be rebalanced to meet its design condition and the code ventilation rates noted above. Additional controls and equipment verification must be performed for optimum performance during warm-up and normal occupancy operation modes.

The balancing report shows the auditorium exhaust/relief fan, EF-5 below its design range. This unit was designed for 6,800 CFM and the balancing data measured 397 CFM. The discharge air

damper is noted not to function properly. The pertaining dampers and control functions must be fixed and corrected and the system must be rebalanced.

#### ASU-2: Lobbies System

This system is designed to supply 23,500 CFM and 16,500 CFM during normal occupied and unoccupied operation modes respectively. The minimum outdoor ventilation airflow is designed to provide 1,400 CFM and 8,400 CFM during unoccupied and occupied operation modes respectively.

The code's ventilation calculations for normal occupancy require 8,400 CFM outdoor airflow with the supply fan providing full airflow to the space. For this air-handler, both minimum and maximum dampers need to be open to meet this ventilation rate of 8,400 CFM. The cooling coil is sized to handle the maximum outdoor airflow load. The heating coil is closely sized and most likely able to handle this load. In some spaces, the supply airflow must be rebalanced to meet the ventilation code. The code space area outdoor ventilation rate for minimum CO2 control equates to approximately 2,300 CFM. The original design lower ventilation rate did not meet this minimum outdoor airflow and will need to be increased. For the time being, the low ventilation operation is annulled by CDC.

Balancing data shows the supply fan providing between 26,387 CFM and 30,043 CFM depending on dampers position and operation mode. The outside airflow measured between 126 CFM and 7,614 CFM. The supply airflow's higher rate is above design and should be rebalanced. The outside airflow lower ventilation rate is not per design and the maximum ventilation airflow is slightly below design. The outside airflow rate must be rebalanced to meet design and the code ventilation rates noted above. Additional controls and equipment verification must be performed for optimum performance during warm-up and normal occupancy operation modes.

The balancing report shows the lobby exhaust/relief fan EF-4, below its design range. This unit was designed for 7,000 CFM and the balancing data measured 3,744 CFM. The pertaining dampers and control functions must be fixed and corrected and the system must be rebalanced.

#### ASU-3 System: Studio Rooms

Unit ASU-3 is designed for single speed operation. This air-handler is comprised of a supply fan, return fan, return air damper, minimum outside air damper, maximum outside air damper and exhaust air damper. The system provides minimum ventilation outside airflow through the minimum outside air dampers. Economizer cooling outside airflow is provided by opening both the minimum and the maximum outdoor air dampers. The associated space exhaust fan EF-6, must operate to provide general exhaust airflow during the building's occupied schedule. During warm-up mode the associated exhaust fan is off and both outside air dampers are closed.

This system is designed to supply 4,400 CFM for the heating and cooling operation modes. The minimum outdoor ventilation airflow is designed to provide 400 CFM during the building's occupied schedule.

The code's ventilation calculations for normal occupancy require 1,190 CFM outdoor airflow with the supply fan providing full airflow to the space. The existing ventilation airflow of 400 CFM does not meet current code. The maximum outdoor air damper actuator needs to be a modulating damper to increase the ventilation airflow per code; new control damper actuators may be required if modulation is not possible. The cooling coil has capacity to handle the added ventilation load. The heating coil is tightly sized to handle this load. The code space area outdoor ventilation rate for minimum CO2 control equates to 575 CFM. The original design lower

ventilation rate did not meet this minimum outdoor airflow and will need to be increased. For the time being, the low ventilation operation is annulled by CDC.

Balancing data shows the supply fan providing between 4,722 CFM and 5,779 CFM depending on dampers position and operation mode. The outside airflow measured between 357 CFM and 4,323 CFM. The supply airflow during normal and warm up operation is above design range and should be rebalanced. Intake air louvers and screens must be cleaned, and the outside airflow must be rebalanced to meet the minimum code ventilation rate noted above.

The exhaust fan EF-6, serving the studio toilets, was not included in the balancing report. The exhaust fan must operate during building occupancy per design and ventilation calculations.

#### ASU-4 System: Dressing Rooms

Unit ASU-4 is designed for single speed operation. The air-handler is comprised of a supply fan, return fan, return and exhaust air damper, minimum outside air damper, and maximum outside air damper. The system provides minimum ventilation outside airflow through the minimum outside air damper. Economizer cooling outside airflow is provided by opening both the minimum and the maximum outdoor air dampers. The associated exhaust fan EF-1, must operate to provide general space exhaust airflow during the building's occupied schedule. During warm-up mode the associated exhaust fan is off and the outside dampers are closed.

This system is designed to supply 5,450 CFM for the heating and cooling operation modes. The minimum outdoor ventilation airflow is designed to provide 1,900 CFM during the building's occupied schedule.

The code's ventilation calculations for normal occupancy require 1,900 CFM outdoor airflow with the supply fan providing full airflow to the space. The supply airflow rates must be rebalanced in some spaces to meet the ventilation code. The cooling coil is sized to handle this maximum outdoor airflow load. The heating coil is tightly sized to handle the load. The code space area outdoor ventilation rate for minimum CO<sub>2</sub> control equates to 975 CFM. The original design's lower ventilation rate met this code requirement. For the time being, the low ventilation operation is annulled by CDC.

Balancing data shows the supply fan providing between 3,705 CFM and 7,053 CFM depending on the dampers position and operation mode. The outside airflow measured between 42 CFM and 6,486 CFM. The supply airflow is above the design range during normal occupied mode operation and below design range during warm-up mode. The outside airflow minimum ventilation operation is outside its design range as well. The outside and supply airflow must be rebalanced to meet design and the code ventilation rates noted above. Additional controls and equipment verification must be performed for optimum performance during warm-up and normal occupancy operation modes.

The balancing report show the exhaust fan EF-1, operating below its design range. The pertaining dampers and control functions must be fixed and corrected and the system must be rebalanced.

#### ASU-5 System: Projection

Unit ASU-5 is designed for single speed operation. The air-handler is comprised of a supply fan, return and exhaust air damper, minimum outside air damper, and maximum outside air damper. The system provides minimum ventilation outside airflow through the minimum outside air damper. Economizer cooling outside airflow is provided by opening both the minimum and the maximum outdoor air dampers. The associated space exhaust fan EF-3, must operate to provide general exhaust airflow during the building's occupied schedule.

This system is designed to supply 2700 CFM for the heating and cooling operation modes. The minimum outdoor ventilation airflow is designed to provide 1100 CFM during the building's occupied schedule.

The minimum ventilation airflow of 1100 CFM is above code requirements (320 CFM per code). The cooling coil is sized to handle the design minimum outdoor airflow load. The heating coil is only sized for about half of the design airflow. The code space area outdoor ventilation rate for minimum CO2 control equates to 100 CFM. The original design's lower ventilation rate met this code requirement. For the time being, the low ventilation operation is annulled by CDC.

Balancing data showed the supply fan providing 2,272 CFM and 2,642 CFM depending on dampers position and operation mode. The outside airflow measured between 64 CFM and 2425 CFM. 1,187 CFM was measured at the minimum ventilation testing. The minimum ventilation measurement was within design parameters. The outside and supply airflow must be rebalanced to meet heating coil design conditions and the code ventilation rates noted above. Additional controls and equipment verification must be performed for optimum performance during warm-up, heating and economizer cooling operation modes.

The balancing data for system exhaust fan EF-3, shows operation within its design range. This unit was designed for 2,265 CFM and the balancing data measured 1,230 CFM. A number of dressing rooms do not have direct room exhaust airflow. These rooms are adjacent to toilet rooms with higher exhaust airflow than required by code and a retrofit is possible. The dressing rooms must be provided with exhaust airflow as noted in the calculations table. The fan system must be verified and spaces rebalanced after the retrofit.

#### ASU-6 System: Stage

Unit ASU-6 is designed for two speed operation. The air-handler is comprised of a supply fan, return fan, return air damper, minimum outside air damper, and maximum outside air damper and minimum exhaust air damper and maximum exhaust air damper. The system provides minimum ventilation outside airflow through the minimum outside air damper. Economizer cooling outside airflow is provided by opening both the minimum and the maximum outdoor air dampers.

This system is designed to supply 8,000 CFM 5,000 CFM during normally occupied and unoccupied operation modes respectively. The minimum outdoor ventilation airflow is designed to provide 600 CFM during the building's occupied schedule.

Balancing data showed the supply fan providing between 7,347 CFM and 10,122 CFM depending on dampers position and operation mode. The outside airflow measured between 547 CFM and 7,349 CFM. The supply airflow and outside airflow readings at 100% outdoor air testing do not match. The outdoor airflow at minimum ventilation operation meets the code requirements noted above. Additional controls and equipment verification must be performed for optimum performance during warm-up, and economizer cooling operation modes.

The code's ventilation calculations for normal occupancy require 1,850 CFM outdoor airflow with the supply fan providing full airflow to each space. The cooling and heating coils have enough capacity to handle the new ventilation outdoor airflow load. The code space area outdoor ventilation rate for minimum CO2 control equates to 150 CFM. The original design's lower ventilation rate met this code requirement. For the time being, the low ventilation operation is annulled by CDC.

System Design Parameters Table - Schnitzer

UNIT	SERVES	Design MIN OA	Design MAX OA	Design SA CFM normal flow / low flow	Normal ventilation exhaust fan	Max outdoor air relief fan	Minimum Code Req'd Ventilation Airflow CFM
ASU-1	AUDITORIUM	6950	13750	41000/28700	EF-2	EF-5	13750
ASU-2	LOBBIES	1400	8400	23500/16500	EF-2	EF-4	8400
ASU-3	STUDIO	400	4400	4400	EF-6	ASU-Return fan	1190
ASU-4	DRESSING	1900	5400	5450	EF-1	ASU-Return fan	1900
ASU-5	PROJECT	1100	2700	2700	EF-3	-	575
ASU-6	STAGE	600	8000	8000/5000	-	ASU-Return fan	1850
RTU-1 [1]	PROJECTION						

1. No as-built documents provided.

Field Test Data

For Air Balancing Specialty's completed air balancing data see *Appendix 1b - 10218 Portland 5 Schnitzer-Pretest Air Balancing Report*.

The table below is the air balancing summary from the air balancing report.

Air balancing Summary Table

UNIT	Tested Unit SA at Ventilation OA Ratio of: 0%   min   100% CFM	Tested Unit OA at Ventilation OA Ratio of: 0%   min   max CFM
ASU-1	41,170   38,453   38,617	342   9,630   10,368
ASU-2	30043   27118   26387	126   3708   7614
ASU-3	5052   5779   4722	375   431   4323
ASU-4	3705   6603   7053	42   3636   6486
ASU-5	2272   2642   2491	64   1187   2425
ASU-6	7347   8200   10122	547   1812   7349
RTU-1	[TAB not provided]	185   346   1764



## Antoinette Hatfield Hall

### System Descriptions

Antoinette Hatfield Hall is heated, ventilated and air-conditioned by seven indoor air-handling units originally installed in 1984. An additional air-handler, ASU-8 was installed in 1999 for the remodeled 4<sup>th</sup> floor rehearsal space. The air-handlers are located in mechanical rooms on the various building levels. Ventilation outdoor airflow is ducted to the air-handling units from wall or penthouse louvers. Relief air is ducted from the air-handling units to wall or penthouse louvers. Return air from each space is ducted back to the air-handling units. The ventilation calculation analysis table for this building is included in *Appendix 2 - Outside Ventilation Airflow Code Analysis Calculation Table – Antoinette Hatfield*.

The air-handling units are designed to provide minimum ventilation outdoor airflow for the building's normal occupied schedule and 100% outside airflow for economizer cooling function. Each system (except ASU-9) is comprised of a supply fan, return/relief air fan, a minimum and a maximum outside air damper, return air damper, and relief air damper. Unit ASU-9 is a multi-zone unit comprised of a supply fan, hot and cold deck and zone mixing. All the air-handlers have a filter, and cooling coil. Heating coils inside the air-handlers are provided in all units except for ASU-1. Variable air volume terminal units with re-heat coils provide the heating required at the spaces served by ASU-1.

At the air-handling units with return fans, the associated return fan must be interlocked to operate when the supply fan operates to provide return air and space relief. The associated exhaust fans must also operate to provide general exhaust airflow during the building's occupied schedule. Unit ASU-1 does not have adequate outdoor airflow during normal occupancy operation to replenish the air exhausted by all the exhaust fans installed within this system. Air transfer from ASU-2, ASU-3, and ASU-5 will need to provide the additional make-up airflow.

### ASU-1: Back of House System

Unit ASU-1 is designed to supply 26,000 CFM for the heating and cooling operation modes. The minimum outdoor ventilation airflow is designed to provide up to 2,600 CFM during the building's occupied schedule.

The code's ventilation calculations for normal occupancy require 5,580 CFM outdoor airflow. A number of the VAV boxes will be limited on reducing airflow; these will need to operate at a higher rate than 50% (see ventilation table for minimum airflow rate allowed per space). The cooling coil is short of the added capacity however the new load will most likely be handled by increasing the coil fluid flow. An additional heating coil may be required in the air-handling unit to account for the higher ventilation rate. The code space area outdoor ventilation rate for minimum CO<sub>2</sub> control equates to 3,605 CFM of outdoor airflow. The original design lower ventilation rate did not meet this minimum outdoor airflow and will need to be increased. For the time being, the low ventilation operation is annulled by CDC.

Balancing data shows the supply fan providing between 26,492 CFM and 27,416 CFM depending on damper positions and operation mode. The outside airflow measured between 528 and 22,131 CFM. The supply airflow and outside airflow readings at 100% outdoor air testing do not match. The measured minimum ventilation outside airflow of 1,281 does not meet code as noted above. Additional controls and equipment verification must be performed for optimum performance during warm-up, normal ventilation and economizer cooling operation modes.

The balancing data for exhaust fans EF-1, and -3 shows current operation slightly below their acceptable design range. This may be resolved by simple rebalancing methods. The exhaust fans EF-2 and -4 are operating below acceptable range and will require additional fan motor and duct connection verifications. A number of rooms do not have direct room exhaust airflow. The

calculations table for this building notes the rooms that require exhaust airflow rates adjustments to meet code. The fan system must be verified and spaces rebalanced after the retrofit.

#### ASU-2: Interior Theater System

Unit ASU-2 is designed to supply 21,600 CFM for the heating and cooling operation modes. The minimum outdoor ventilation airflow is designed to provide 4,750 CFM during the building's occupied schedule.

The code's ventilation calculations for normal occupancy require 7,550 CFM outdoor airflow with the supply fan providing full airflow to the space. The cooling coil is short of the added capacity however the new load most likely will be handled by increasing the coil fluid flow. The heating coil seems not to have the capacity required for the new ventilation load. The code space area outdoor ventilation rate for minimum CO2 control equates to 1,180 CFM. The original design's lower ventilation rate met this code requirement. For the time being, the low ventilation operation is annulled by CDC.

Balancing data shows the supply fan providing between 16,280 CFM and 19,844 CFM depending on dampers position and operation mode. The outside airflow measured between 3,293 and 17,665 CFM. The outside airflow measured at the 0% outside air test is very high; this should be close to 0 CFM. The minimum ventilation airflow of 6,926 CFM is above design however does not meet the code ventilation shown above. The maximum ventilation airflow for economizer function does not match the fan total at the 100% outdoor air test. Additional controls and equipment verification must be performed for optimum performance during warm-up, normal ventilation and economizer cooling operation modes.

#### ASU-3: Lower Lobby System

Unit ASU-3 is designed to supply 30,120 CFM for the heating and cooling operation modes. The minimum outdoor ventilation airflow is designed to provide 2,900 CFM during the building's occupied schedule.

The code's ventilation calculations for normal occupancy require 8,200 CFM outdoor airflow with the supply fan providing full airflow to the space. The cooling coil is short of the added capacity however the new load most likely will be handled by increasing the coil fluid flow. The heating coil seems not to have the capacity for the new ventilation load. The code space area outdoor ventilation rate for minimum CO2 control equates to 1,970 CFM. The original design's lower ventilation rate met this code requirement. For the time being, the low ventilation operation is annulled by CDC.

Balancing data shows the supply fan's ability to provide between 26,000 CFM and 32,600 CFM depending on dampers position and operation mode. The outside airflow measured between 1,100 CFM and 29,000 CFM. The supply airflow during normal operation is within the design range. The outside airflow measured at the 0% outside air test is very high; this should be close to 0 CFM. The measured minimum ventilation outside airflow of 7,960 CFM is above design however slightly below the calculated value noted above. The maximum ventilation airflow measured for economizer function does not match the total supply fan airflow at the 100% outdoor air test. Additional controls and equipment verification must be performed for optimum performance during warm-up, normal ventilation and economizer cooling operation modes.

#### ASU-4: Showcase Theater System

Unit ASU-4 is designed to supply 14,200 CFM for the heating and cooling operation modes. The minimum outdoor ventilation airflow is designed to provide 2,270 CFM during the building's occupied schedule.

The code's ventilation calculations for normal occupancy require 3,750 CFM outdoor airflow with the supply fan providing full airflow to the space. The cooling coil has adequate capacity to handle the total coil load. The heating coil seems not to have the capacity for the new ventilation load. The code space area outdoor ventilation rate for minimum CO<sub>2</sub> control equates to 665 CFM of outdoor airflow. The original design's lower ventilation rate met this code requirement. For the time being, the low ventilation operation is annulled by CDC.

Balancing data shows the supply fan providing between 15,800 CFM and 16,900 CFM depending on dampers position and operation mode. The outside airflow measured between 1,380 and 15,800 CFM. The 16,900 CFM supply airflow at normal operation is slightly above design. Verify the cooling coil velocity; this must be below 500 FPM to prevent condensate carryover. The 5,100 CFM outside airflow at minimum ventilation is above the original design and also the calculated ventilation airflow noted above. The outside airflow measured at the 0% outside air test is very high; this should be close to 0 CFM. Additional controls and equipment verification must be performed for optimum performance during warm-up, normal ventilation and economizer cooling operation modes.

#### ASU-5: Upper Lobby System

Unit ASU-5 is designed to supply 16,800 CFM for the heating and cooling operation modes. The minimum outdoor ventilation airflow is designed to provide 1,680 CFM during the building's occupied schedule.

The code's ventilation calculations for normal occupancy require 7,750 CFM outdoor airflow with the supply fan providing full airflow to the space. The cooling coil is short of the added capacity however the new load most likely will be handled by increasing the coil fluid flow. The heating coil does not have enough capacity to meet the new ventilation load. The code space area outdoor ventilation rate for minimum CO<sub>2</sub> control equates to 1,400 CFM of outdoor airflow. The original design's lower ventilation rate met this code requirement. For the time being, the low ventilation operation is annulled by CDC.

Balancing data shows the supply fan providing between 10,350 CFM and 12,000 CFM depending on dampers position and operation mode. The outside airflow measured between 2,080 CFM and 11,030 CFM. The 12,170 CFM supply airflow at normal operation is below design. The 2,350 CFM outside airflow at minimum ventilation is above the original design however it does not meet the calculated ventilation airflow noted above. The outside airflow measured at the 0% outside air test is very high; this should be close to 0 CFM. Additional controls and equipment verification must be performed for optimum performance during warm-up, normal ventilation and economizer cooling operation modes.

#### ASU-7: Projection Space System

Unit ASU-7 is designed to supply 3,200 CFM for the heating and cooling operation modes. The minimum outdoor ventilation airflow is designed to provide 300 CFM during the building's occupied schedule.

The code's ventilation calculations for normal occupancy require 1,310 CFM outdoor airflow with the supply fan providing full airflow to the space. The cooling coil does not seem to have enough capacity for the new ventilation load. The heating coil is also short of the capacity required by the new ventilation load. The code space area outdoor ventilation rate for minimum CO<sub>2</sub> control equates to 560 CFM of outdoor airflow. The original design lower ventilation rate did not meet this minimum outdoor airflow and will need to be increased. For the time being, the low ventilation operation is annulled by CDC.

Balancing data shows the supply fan providing between 2,560 CFM and 5,700 CFM depending on dampers position and operation mode. The outside airflow measured between 60 CFM and 1,800 CFM. The 5,740 CFM supply airflow measured at the minimum ventilation test is above design; verify cooling coil velocity is below 500 FPM to prevent condensate carryover into the air stream. The 510 CFM outside airflow measured at the minimum ventilation test is above original design however, it does not meet the calculated ventilation airflow noted above. The maximum ventilation airflow measured for economizer function does not match the total supply fan airflow at the 100% outdoor air test. Additional controls and equipment verification must be performed for optimum performance during warm-up, normal ventilation and economizer cooling operation modes.

#### ASU-8: Rehearsal System

Unit ASU-8 is designed to supply 7,950 CFM for the heating and cooling operation modes. The minimum outdoor ventilation airflow is designed to provide 3,720 CFM during the building's occupied schedule.

The code's ventilation calculations for normal occupancy require 3,720 CFM outdoor airflow with the supply fan providing full airflow to the space. The cooling and heating coils have adequate capacity for the ventilation load. The code space area outdoor ventilation rate for minimum CO<sub>2</sub> control equates to 300 CFM of outdoor airflow. The original design's lower ventilation rate met this code requirement. For the time being, the low ventilation operation is annulled by CDC.

Balancing data shows the supply fan providing considerably different airflow measurements between the first test and the second test. In the first test, the supply airflow measured between 6,300 CFM and 6,400 CFM depending on dampers position and operation mode. In the second test, the supply airflow measured between 1,800 CFM and 2,200 CFM. In the first test, the outside airflow measured between 0 CFM and 8800 CFM. In the second test, the outside airflow measured between 1,400 CFM and 7,300 CFM. The supply airflow measured in both tests is below design. The maximum ventilation airflow measured for economizer function does not match the total supply fan airflow at the 100% outdoor air test. Additional controls and equipment verification must be performed for optimum performance during warm-up, normal ventilation and economizer cooling operation modes.

A number of rooms do not have direct room exhaust airflow. The building calculations table notes the rooms that require added exhaust and exhaust airflow rates adjustments to meet code.

#### ASU-9: Gallery System

Unit ASU-9 is designed to supply 2,800 CFM for the heating and cooling operation modes. The system's minimum outdoor ventilation airflow is designed to provide 280 CFM during the building's occupied schedule.

The code's ventilation calculations for normal occupancy require 340 CFM outdoor airflow with the supply fan providing full airflow to the space. The cooling coil has adequate capacity to provide for the additional ventilation airflow. The heating coil is short of the added capacity however the new load most likely will be handled by increasing the coil fluid flow. The code space area outdoor ventilation rate for minimum CO<sub>2</sub> control equates to 100 CFM of outdoor airflow. The original design's lower ventilation rate met this code requirement. For the time being, the low ventilation operation is annulled by CDC.

Balancing data shows the supply fan providing between 2,900 CFM and 3,200 CFM depending on dampers position and operation mode. The outside airflow measured between 420CFM and 2,800 CFM. These measurements came from the pre-test data prior to new filters being installed. The new filters have not been completely installed and the final test has not been completed.

Currently the measured supply airflow exceeds the design range and the measured outside minimum ventilation airflow is above the design range. The outside airflow measured at the 0% outside air test is very high; this should be close to 0 CFM. Filter installation must be completed prior to the system must be tested again. Additional controls and equipment verification must be performed for optimum performance during warm-up, normal ventilation and economizer cooling operation modes.

### Summary - Hatfield

With the exception of ASU-8, the existing air-handlers have not been designed to handle the new ventilation airflow loads. For this building and depending on spaces served, the code requires between 30 to 45% outdoor airflow for normal occupancy. The existing air-handling units were designed with very low outside airflow (9%-20% outside air). In the original design, the heating coils were tightly sized and some coils seem to be short of their required heating capacity. For most of the air-handlers, heating coil replacement will be needed in order to increase ventilation airflow rates. The cooling coils have some ability for additional ventilation load but most of them cannot handle the new ventilation load without changing fluid flowrates and possibly control valves.

The air balancing test report indicates a few of the air-handlers cannot attain the supply airflow rates listed on the floor plans. The outdoor air system is designed to provide full economizer cooling function on all units. The outside air, exhaust air and return air (mixing) damper positions and the exhaust fans operation must verified for proper control.

### System Design Parameters Table - Hatfield

UNIT	SERVES	Design MIN OA	Design MAX OA	Design SA CFM	Normal ventilation exhaust fan	Min. Code Ventilation Req'd OA rate CFM
ASU-1	BACK OF HOUSE	2600	26000	26000	EF-1,EF-3, EF-4, EF-2	5580
ASU-2	INT THEATER	4750	21600	21600		7550
ASU-3	LOWER LOBBY	2900	29000	32500		8200
ASU-4	SHOWCASE THEATER	2270	14200	14200		3750
ASU-5	UPPER LOBBY	1680	16800	16800		7750
ASU-6	FUTURE FOUNDERS RM	0	0	0		
ASU-7	PROJECTION	300	3200	3200	EF-5	1310
ASU-8	REHEARSAL	3750	7950	7950		3720/2355
ASU-9	GALLERY	280	2800	2800		340

Field Test Data

For Air Balancing Specialty's completed air balancing data see *Appendix 2b - 10218 Portland 5 Antoinette Hatfield Air Balancing Report*.

The table below is the air balancing summary from the air balancing report.

Air balancing Summary Table

UNIT	Tested Unit SA at Ventilation OA Ratio of: 0%   min   100% CFM	Tested Unit OA at Ventilation OA Ratio of: 0%   min   max CFM
ASU-1	27416   28534   26492	528   1281   22131
ASU-2	16280   18744   19844	3293   6926   17665
ASU-3	26028   30618   32616	1123   7958   28975
ASU-4	15764   16912   16800	1380   5097   15822
ASU-5	10,346   12,170   11,201	2,080   2,353   11,024
ASU-6	0	0
ASU-7	RA-5416   5738   2558	56   514   1792
ASU-8*	6297-1833   6287-2156   6454-1985	0-1378   4847-1558   8782-7301
ASU-9**	RA-3141   3233   2899	417   1334   2824

- 
- \* data shows pre-test and post-test data. The post-test data is outside design range
- \*\* system was not provided with a post-test after the filter installation and supply air test.

## **Keller Auditorium**

### **System Descriptions**

Keller Auditorium is heated, ventilated and air-conditioned by ten indoor air-handling units originally installed in 1966. The air-handlers are located in mechanical rooms on various building levels. Ventilation outdoor airflow is ducted to the air-handling units from intake well/pit louvers. Relief air is ducted from the air-handling units to exhaust well/pit louvers. The ventilation calculation analysis table for this building is included in *Appendix 3 - Outside Ventilation Airflow Code Analysis Calculation Table - Keller Auditorium*.

The balancing data did not include measurements of the outside airflow for a good number of units. On some of the units, the data shows ventilation airflow being supplied to the spaces during warm-up operation or the 0% outdoor airflow test. The air-handlers' outside air dampers must be closed at the 0% OA test. On other units the minimum ventilation airflow test measured higher than designed ventilation rates. The as-built plans and documents are not clear whether the air-handlers have a minimum outside air damper or not and a maximum outside air damper. If there are minimum outdoor air dampers, only the minimum outside air dampers shall be opened for minimum ventilation operation. For maximum outside airflow ventilation in addition to the minimum damper the maximum outside air damper shall also open.

The balancing report noted higher velocities than allowed for cooling coils on a number of units. The test location for the noted airflow velocities must be verified. The coil velocity must be below the allowable cooling coil velocity to prevent condensate carry over during the cooling operation.

### **SU-1 System: Stage and Rehearsal 238**

Unit SU-1 is designed to provide minimum ventilation for normal occupancy at 50% of supply airflow. The air-handling system is comprised of a supply fan, filter, heating coil (this coil also has a chilled water piping connection to provide limited cooling), and the outside air damper. The system also includes an exhaust fan with a control damper. The associated exhaust fan must operate to provide general exhaust airflow during the building's occupied schedule. 100% outdoor airflow cooling economizer operation is not available. During the warm-up mode the associated exhaust fan is off and outside damper is closed.

Unit SU-1 is designed to supply 3,500 CFM for the heating and cooling operation modes. The minimum outdoor ventilation airflow is designed to provide 1,750 CFM during the building's occupied schedule.

The ventilation calculations require a higher outdoor airflow rate. The system's 1,750 CFM outdoor airflow is not adequate to meet the new ventilation code. At the current supply airflow rate, the code's space area outdoor ventilation rate for minimum CO2 control equates to 1,900 CFM. The original room design supply airflow is about 0.50 CFM/sq. ft. Because of the very low room supply airflow the new calculated outdoor airflow rate is extremely high. First the space supply airflow must be increased to about 1 CFM /sq. ft. or 8,800 CFM. At this supply airflow rate the system level required ventilation airflow rate is 2,850 CFM for normal occupancy ventilation and 900 CFM minimum when CO2 control code is back in effect. The original design's lower ventilation rate met this low ventilation code requirement. For the time being, the low ventilation operation is annulled by CDC.

Balancing data shows the supply fan providing between 3,100 CFM and 3,890 CFM depending on dampers position and operation mode. The balancing data did not provide a measurement of the actual outside airflow rate. The supply airflow at normal operation is within the original design range which is below the recommended space airflow. To determine code compliance, the actual outdoor ventilation airflow measurement is still required for this unit. Additional control and equipment verification of outside air and exhaust air damper positions and exhaust fan operation must be confirmed for proper operation as well.

The balancing report shows higher than allowed velocity for cooling coils; the testing location must be verified.

The balancing data for exhaust fan EF-1, shows operation below its original design range. This unit was designed for 1,750 CFM and the balancing data measured 1,280 CFM. This exhaust fan will not be able to perform at the higher ventilation rate noted above.

For ventilation code compliance, the supply airflow rates in some of the spaces must be adjusted and rebalanced as noted in the ventilation calculation tables.

### SU-2, -4, -5, & -6 Systems

The air-handling units SU-2, SU-4, SU-5, & SU-6 are designed to provide minimum ventilation for normal occupancy and 100% outside airflow for economizer cooling. Each system is comprised of a supply fan, filter, heating coil, cooling coil, exhaust/return fan, outside air damper, return air damper, and exhaust air damper. The units also have a two stage cooling coil and a single stage heating coil. The exhaust fans function as relief air fans during full outdoor air economizer cooling operation. The exhaust air and return air dampers must be controlled properly for each of these applications. The associated exhaust fan must be interlocked with the supply fan to provide space relief airflow. For unit SU-2 the associated exhaust fan also functions as a return air fan during warm-up or normal occupied operation modes. During warm-up mode at units SU-4, -5, & -6 the associated exhaust fan is off and the outside damper is closed.

The scheduled cooling coils capacities for these units are sized for the full outdoor ventilation airflow rates indicated below. The scheduled heating coils capacities are sized for about half of cooling outdoor ventilation airflow rates. If the winter design space heating load cannot be maintained at the required ventilation airflow rate, the coils and control valves will need to be replaced.

With the exception of unit SU-6, the balancing data did not provide a measurement of the actual system outside airflow. To determine code compliance, the actual outdoor ventilation airflow measurement is still required for these units. Also all the units except for SU-6, had higher noted velocities than allowed for cooling coils. The test location for the listed airflow velocities must be verified. The coil velocity must be within design limits to prevent condensate carry over during cooling operations.

#### SU-2: Rehearsal

Unit SU-2 is designed to supply 3,300 CFM for the heating and cooling operation modes. The minimum outdoor ventilation airflow is designed to provide up to 660 CFM. The cooling coil is sized for this ventilation load but not the heating coil. The available heating coil capacity is for about 330 CFM of outdoor airflow load.

The code's ventilation calculations for normal occupancy require 570 CFM outdoor airflow with the supply fan providing full airflow to the space; the lower ventilation rate allowed by the heating coil design data does not meet code. This coil may need to be replaced. The code's space area outdoor ventilation rate for minimum CO2 control equates to 120 CFM of outdoor airflow. The original design's lower ventilation rate met this code requirement. For the time being, the low ventilation operation is annulled by CDC.

Balancing data shows the supply fan providing between 3,480 CFM and 3,900 CFM depending on dampers position and operation mode. The supply airflow of 3,880 CFM at normal ventilation operation is within the original design range of the floor plans airflow rates. Outside airflow measurement is still required. Additional control and equipment verification of outside air and exhaust air damper positions and exhaust fan operation must be confirmed for proper operation.



The balancing data for exhaust fan EF-2, shows operation below its original design range. This unit was designed for 3,300 CFM and the balancing data measured 2,490 CFM.

#### SU-4: Orchestra level Foyer and Lobby

Unit SU-4 is designed to supply 8,200 CFM for the heating and cooling operation modes. The minimum outdoor ventilation airflow is designed to provide up to 1,640 CFM. The cooling coil is sized for this ventilation load but not the heating coil. The available heating coil capacity provides for about half of this outdoor ventilation airflow load.

The code's ventilation calculations for normal occupancy require 2,040 CFM outdoor airflow with the supply fan providing full airflow to the space. The code's space area outdoor ventilation rate for minimum CO2 control equates to 690 CFM. The cooling coil is tightly sized but will most likely handle the capacity of the additional ventilation load. The heating coil and control valve may need to be replaced. The original design's lower ventilation rate met this code requirement. For the time being, the low ventilation operation is annulled by CDC.

The balancer observed plugged coils and the supply suction and discharge pressure measured was too high. The balancing report only provided the supply fan airflow at 5,580 CFM. This was measured at the minimum outdoor ventilation test. This supply airflow is not within the original design range. Outside airflow measurement was not provided and must be verified. Additional control and equipment verification of outside airflow rate, exhaust air damper positions and exhaust fan operation must be confirmed for proper operation.

The balancing data for exhaust fan, EF-4 shows the high fan speed operation within its original higher design range. This unit was designed for 14,400 CFM at high speed. The balancing data measured 13,160 CFM. The low speed operation was designed for 9,600 CFM which is more in-line with the supply fan operation for this system. Further analysis is needed to determine when the fan needs to run at the higher speed. Detailed balancing measurements are required for economizer and normal ventilation operating modes to determine the correct speed for this fan to provide space relief. Running the fan at the higher speed will cause a negative pressure and higher air leakage in the building.

#### SU-5: 1<sup>st</sup> Balcony Foyer and Lobby

Unit SU-5 is designed to supply 11,000 CFM for the heating and cooling operation modes. The minimum outdoor ventilation airflow is designed to provide up to 2,750 CFM during cooling but not for heating. The heating coil was sized for less outdoor ventilation airflow load.

The code's ventilation calculations for normal occupancy require 2,750 CFM outdoor airflow with the supply fan providing full airflow to the space; a lower ventilation rate does not meet code. The cooling coil appears to have enough capacity to provide for this code ventilation load. The heating coil and control valve may need to be replaced. The code's space area outdoor ventilation rate for minimum CO2 control equates to 670 CFM. The original design's lower ventilation rate met this code requirement. For the time being, the low ventilation operation is annulled by CDC.

Balancing data shows the supply fan providing between 11,520 CFM and 8,780 CFM depending on dampers position and operation mode. The minimum outdoor airflow test measured the supply fan operating within its design range. The supply airflow measured at 100% OA is below the design range. The outside airflow test was not performed. Control damper position and exhaust fan operation must be verified.

The balancing data for exhaust fan EF-5 shows the fan's high speed operation above its original design range. This unit is designed for 15,300 CFM at high speed. This unit's balancing data

measured 17,350 CFM. The fan's low speed operation of 10,200 CFM is more in-line with the supply fan operation. Further analysis is needed to determine when the fan needs to run at the higher speed. Detailed balancing measurements are required for economizer and normal ventilation operating modes to determine the correct speed for this exhaust fan.

#### SU-6 System: 2<sup>nd</sup> Balcony Foyer and Lobby

Unit SU-6 is designed to supply 7,800 CFM for the heating and cooling operation modes. The minimum outdoor ventilation airflow is designed to provide up to 1,950 CFM during cooling but not for heating. The heating coil is sized for less outdoor ventilation airflow load.

The code's ventilation calculations for normal occupancy require 2,200 CFM outdoor airflow with the supply fan providing full airflow to the space. The cooling coil appears to have enough capacity to provide for the code ventilation load. The heating coil and control valve may need to be replaced. The code's space area outdoor ventilation rate for minimum CO2 control equates to 390 CFM of outdoor airflow. The original design's lower ventilation rate met this code requirement. For the time being, the low ventilation operation is annulled by CDC.

Balancing data shows the supply fan providing between 7,000 CFM and 8,500 CFM depending on dampers position and operation mode. The outside airflow measured between 36 and 10,330 CFM. The supply airflow at normal operation is within the original design range. The measured 640 CFM outside airflow at the minimum ventilation test is below the original design and does not meet the calculated ventilation airflow noted above. The maximum ventilation airflow measured for economizer function does not match the total supply fan airflow measure at the 100% outdoor air test. Additional controls and equipment verification must be performed for optimum performance during warm-up, normal ventilation and economizer cooling operation modes.

The balancing data for exhaust fan EF-6 shows the fan operation below its original design range. This unit's balancing data measured 7,210 CFM and 6,510 CFM.

#### SU-3 System: West Vestibule

Unit SU-3 is designed to supply 5,400 CFM for the heating and cooling operation modes. The unit is not provided with outside airflow. The system is a three zone, multi-zone unit comprised of a supply fan, hot and cold deck and mixing dampers. Return air is ducted back to the unit.

The balancing data shows the system ability to provide 7,605 CFM at the normal operation mode. The test measured the unit's return airflow. The return airflow measure is above design range. The cooling coil velocity must be verified.

The current code requires outdoor ventilation airflow be provided to the spaces served by this system. Using the original design supply airflow rate, the calculations equate to 150 CFM of outdoor air to meet the code required ventilation airflow.

The airflow rate for exhaust fan, EF-3 was not measured and no balancing data was provided. This unit is designed to exhaust 1,000 CFM.

#### SU-7, -8, & -10 Systems

Units SU-7, SU-8 & SU-10 do not have capability for economizer cooling function at 100% outside airflow. On these systems the outside air ducts and intake air louver is limited in size. Each system is a multi-zone unit comprised of a supply fan, filter, hot and cold deck with heating and cooling coils in parallel and zone mixing dampers to supply mixed air to their zones. Static pressure dampers are located upstream of the coils. For units SU-8 and SU-10, the cooling coil is also designed to provide a second stage of

heating. Return air is ducted back to the units. Additional exhaust fans provide building exhaust and space relief airflow. The units include outside air, and exhaust air dampers.

The associated exhaust fans must operate to provide general exhaust airflow during the building's occupied schedule. During warm-up mode the associated exhaust fans are off and outside dampers are closed.

The supply fans have been sized to provide a higher airflow than the cooling and the heating coils selections indicate. It is unclear if the units have coil bypasses and what the space airflow is during the cooling and heating modes. Balancing data should be provided for both of these operations. The ventilation analysis was done under the assumption the indicated fan airflow can reach the spaces. For reduced supply airflow rates the ventilation assessments below do not apply.

#### SU-7: North Rooms

The supply fan is sized to provide 7,000 CFM supply airflow. The cooling coil is sized for 5,000 CFM and the heating coil is only sized for 3,500 CFM. Flapper type dampers are installed for the zone mixing dampers. The minimum outdoor ventilation airflow is designed to supply up to 1,500 CFM during cooling but not for heating. The heating coil and control valve size available capacity is for about half of this airflow.

The code's ventilation calculations for normal occupancy require 1,750 CFM outdoor airflow with the supply fan providing full airflow to the space; the lower ventilation rate during heating does not meet code. The cooling coil has enough capacity to provide for the additional ventilation load. The heating coil and control valve will need to be replaced. The code's space area outdoor ventilation rate for minimum CO2 control equates to 830 CFM. The original design's lower ventilation rate met this code requirement. For the time being, the low ventilation operation is annulled by CDC.

Balancing data shows the supply fan providing between 6,170 CFM and 6,390 CFM depending on dampers position and operation mode. The outside airflow measured between 1,180 and 1,290 CFM. The supply airflow of 6170 CFM measured at the minimum ventilation test is below the original design range. The 1,190 CFM outside airflow measured at the minimum ventilation is below the original cooling design and does not meet the calculated ventilation airflow noted above. Additional controls and equipment verification must be performed for optimum performance during warm-up and normal ventilation operation modes.

The balancing data for exhaust fan EF-7, shows operation below its original design range. This fan was designed for 1,750 CFM and the balancing data measured between 180 CFM and 1,500 CFM.

The supply airflow rates in some of the spaces must be rebalanced as noted in the ventilation calculation table. The exhaust airflow rates in some spaces are not adequate or missing and must be adjusted. The calculations table for this building notes the rooms that require exhaust airflow rates adjustments to meet code.

#### SU-8: South Rooms

The supply fan is sized to provide 4,800 CFM supply airflow. The cooling and heating coils are sized for 3,600 CFM total supply airflow. Flapper type dampers are installed for the zone mixing dampers. The minimum outdoor ventilation airflow is designed to provide up to 1,980 CFM during the building's occupied schedule.

The ventilation calculations meet code at 2,560 CFM outdoor airflow with the supply fan providing full airflow to the space; the lower ventilation rate does not meet code. Using the fan airflow, the

cooling coil seems to have enough capacity to provide the additional ventilation load. The heating coil is tightly sized but seems to have adequate capacity for the additional ventilation airflow load (using the fan airflow). The code's space area outdoor ventilation rate for minimum CO2 control equates to 1,320 CFM. The original design's lower ventilation rate met this code requirement. For the time being, the low ventilation operation is annulled by CDC.

The balancing data indicates supply airflow between 6,000 and 7,260 CFM. Outside air measurement test was not performed. The measured supply airflow exceeds the fan design range. Verification of the cooling coil airflow is required to determine acceptable coil velocity. Actual outdoor airflow must be measured to determine availability for code compliance.

The balancing data for exhaust fan EF-8, shows operation below its original design range. This unit was designed for 2,700 CFM and the balancing data measured 1,820 CFM.

The supply airflow rates in some of the spaces must be rebalanced as noted in the ventilation calculation table. The exhaust airflow rates in some spaces are not adequate or missing and must be adjusted. The calculations table for this building notes the rooms that require exhaust airflow rates adjustments to meet code.

#### SU-10: Dressing

The supply fan is sized to provide 8,000 CFM of supply airflow. This adds up to the sum of the supply airflow rates noted on plans. From the IOM data the cooling coil is sized for 6,800 CFM. The minimum outdoor ventilation airflow is designed to provide 6,250 CFM during the building's occupied schedule. IOM data is not available for the heating coil. This coil is smaller than the cooling coil however it seems to be sized to meet the capacity for 6,800 CFM and this ventilation rate. Opposed blade type dampers are installed for the zone mixing dampers. This system is set up to provide 92% outside airflow constantly. The exhaust fan shall operate when the supply fan is on to provide space relief and exhaust. This system has limited recirculating capabilities; only a few rooms have return air ducted back to the air-handler. The building will be over-pressurized when the exhaust fan is not operating.

The balancing data measured supply airflow between 3,090 CFM and 5,800 CFM. The measured supply airflow rate is less than the design supply fan airflow. The measured outside airflow is between 1,100 CFM to 6,170 CFM. Outside airflow is designed to be constantly supplied at 6,250 CFM. Reducing outdoor airflow is not possible because the system does not have adequately sized return ductwork routed back to the air-handler. The supply fan, exhaust fan and dampers must be verified for proper operation.

The ventilation airflow is high due the original design space exhaust airflow and surpasses the code requirements of 3,880 CFM.

The balancing data for exhaust fan EF-10, shows operation below its original design range. This unit was designed for 7,100 CFM and the balancing data measured 4,630 CFM. The exhaust airflow is not adequate or is missing in some of the rooms. Exhaust airflow must be added or adjusted in these rooms. The calculations table for this building notes the rooms that require exhaust airflow rates adjustments to meet code.

The balancing data for exhaust fan EF-11, shows operation below its original design range. This unit was designed for 3,000 CFM and the balancing data measured 1,870 CFM. Exhaust fan, EF-11 operates based on temperature control to exhaust the Board Patch room. Transfer air is ducted back to the mechanical room for make-up air.

### SU-9 System: Auditorium & Orchestra

This system is a multi-zone unit comprised of a supply fan, filters, a hot and a cold deck with two heating and one cooling coil in parallel and zone mixing dampers to supply mixed air to each zone. Static pressure dampers are located upstream of the coils. The supply fan is sized to provide 45,000 CFM, which closely adds up to meet the space supply airflow rates. From the IOM data the cooling coil is sized for 45,000 CFM supply airflow. There are two heating coils each sized for 25,000 CFM. The unit design provides for a minimum ventilation of 15,750 CFM during cooling and 14,400 CFM during heating. 100% outside airflow full economizer cooling function is provided. Return air is ducted to both the main exhaust fan and to a discharge opening in the mechanical room. The main exhaust fan is used for space exhaust and relief. The exhaust fan shall operate to provide general exhaust airflow during the building's occupied schedule and for economizer cooling space relief. During warm-up mode the associated exhaust fan is off and outside damper is closed.

The code's ventilation calculations for normal occupancy require 19,350 CFM outdoor airflow; the existing lower ventilation rate of 15,750 CFM does not meet code for normal occupancy operation. The cooling coil and heating coil seems to have enough capacity to provide for the additional ventilation load. The heating coil's control valve may need to be replaced. The code's space area outdoor ventilation rate for minimum CO2 control equates to 2,530. The original design's lower ventilation rate met this code requirement. For the time being, the low ventilation operation is annulled by CDC.

The balancing data indicates supply airflow between 35,170 CFM and 44,760 CFM. The outside airflow test measured between 20,040 CFM and 42,550 CFM. The supply airflow measured at normal operation is slightly less than the design supply fan airflow. The 24,560 CFM outside airflow at minimum ventilation is above the original design and above the calculated ventilation airflow noted above. Outdoor airflow at the 0% outside air test must be 0 CFM; damper and exhaust fan operation must be verified. The supply airflow varies significantly between the various tests performed; the supply fan speed, exhaust fan and dampers positions must be verified for proper operation.

The balancing data for exhaust fan EF-9, shows operation below its original design range. This unit was designed for 45,000 CFM and the balancing data measured 26,650 CFM.

The supply airflow rates in some of the spaces must be rebalanced as noted in the ventilation calculation table. The exhaust airflow rate in some spaces is not adequate or missing and must be adjusted. The calculations table for this building notes the rooms that require exhaust airflow rates adjustments to meet code.

System Design Parameters Table - Keller

UNIT	SERVES	Design MIN OA	Design MAX OA	Design SA CFM	Normal ventilation exhaust fan	Max outdoor air relief fan	Minimum Code Ventilation Airflow CFM
SU-1	STAGE	1,750	1,750	3,500	EF-1		5310 (2850 at 8810 CFM SA)
SU-2	REHEARSAL	660	3,300	3,300	EF-2		570
SU-3	ENTRY VEST. W	0	0	5,400	NONE		150
SU-4	ORCHESTRA	1,640	8,200	8,200	EF-4		2040
SU-5	1ST BALC	2,750	11,000	11,000	EF-5		2750
SU-6	2ND BALC	1,950	7,800	7,800	EF-6		2200
SU-7	NORTH RMS	1,500	2,046	7,000	EF-7		1750
SU-8	SOUTH RMS	1,980	2,602	4800	EF-8		2560
SU-9	AUDITORIUM	19,350	45,350	45,350	EF-9	EF-12	19350
SU-10	DRESSING	6,256	7512	8000	EF-10	EF-11	6256 (3880)

Field Test Data

For Air Balancing Specialty's completed air balancing data see *Appendix 3a - 10218 Portland 5 Keller Pretest Air Balancing Report*. The table below is the air balancing summary from the air balancing report.

Air balancing Summary Table

UNIT	Tested Unit SA at Ventilation OA Ratio of: 0%   min   100% CFM	Tested Unit OA at Ventilation OA Ratio of: 0%   min   max CFM
SU-1	3090   3066   3888	0
SU-2	3481   3877   3898	0
SU-3	7605 RA only	0
SU-4	0   5580   0	0
SU-5	11520   10904   8780	0
SU-6	8524   8421   7186	36   639   10332
SU-7	6392   6169   6303	1214   1193   1188
SU-8	6000   7258   6757	0
SU-9	35167   40736   44758	20042   24564   42551
SU-10	3089   4442   5795	1098   2958   6174

MFIA, Inc.



OUTSIDE VENTILATION AIRFLOW CODE ANALYSIS CALCULATION TABLE -ARLENE SCHNITZER

Table with 22 columns: UNIT, ROOM, REMARKS, MECH CODE CLASSIFICATION, SPACE AREA (FT^2) - Az, OCCUPANCY MAX(PEOPLE / 1000FT^2), PLUMBING FIXTURES, OA CFM / PERSON (FIXTURE) - Rp, OA CFM/FT^2 - Ra, EA REQUIRED CFM / FIXTURE OR SF, CODE PEOPLE, OCCUPANT OSA CFM Vbzp =Rp\*Pz, AREA OSA CFM Vbza =Ra\*Az, MECH CODE REQUIRED EXHAUST CFM, PROVIDED 100% EXHAUST CFM (2), REQUIRED OA CFM Vbz =Sum(Vbz), MECH CODE REQ'D OA CFM Voz =(Vbz)/Ez, MAXIMUM PROVIDED ROOM SUPPLY AIR CFM, MINIMUM PROVIDED SUPPLY AIR CFM Vpz, ZONE EFFECT FACTOR Ez(3), MAXIMUM OUTDOOR AIR FRACTION Zp =Voz/Vpz, SYSTEM VENTILATION EFFICIENCY AT MAX Zp - Ev (4)100%DIRECT OA=1, OCCUPANT DIVERSITY - D =Ps/(sum Pz), UNCORREC OA INTAKE - Vou = DxSum(Rp x Pz)+Sum(Ra x Az), MIN CODE OUTDOOR AIR CFM - Vot = Vou / Ev, REQUIRED OUTDOOR AIR INTAKE CFM - Vot, MINIMUM OSA CFM (1).



UNIT	ROOM	REMARKS	MECH CODE CLASSIFICATION	SPACE AREA (FT²) - Az	OCCUPANCY MAX(PEOPLE / 1000FT²)	PLUMBING FIXTURES	OA CFM / PERSON (FIXTURE) - Rp	OA CFM/FT² - Ra	EA REQUIRED CFM / FIXTURE OR SF	CODE PEOPLE	OCCUPANT OSA CFM VBz =Rp*Pz	AREA OSA CFM Vbza =Ra*Az	MECH CODE REQUIRED EXHAUST CFM	PROVIDED 100% EXHAUST CFM (2)	REQUIRED OA CFM Vbz =Sum(Vbz)	MECH CODE REQ'D OA CFM Voz =(Vbz)/Ez	MAXIMUM PROVIDED ROOM SUPPLY AIR CFM	MINIMUM PROVIDED SUPPLY AIR CFM Vpz	ZONE EFFECT. FACTOR Ez(3)	MAXIMUM OUTDOOR AIR FRACTION Zp =Voz/Vpz	SYSTEM VENTILATION EFFICIENCY AT MAX Zp - Ev (4)100%DIRECT OA=1	OCCUPANT DIVERSITY - D =Ps/(sum Pz)	UNCORRECTED OA INTAKE - Vou = DxSum(Rp x Pz)+Sum(Ra x Az)	MIN CODE OUTDOOR AIR CFM - Vot = Vou / Ev	REQUIRED OUTDOOR AIR INTAKE CFM - Vot	MINIMUM OSA CFM (1)
	025 - INSTRUMENTS	[4]	COMPUTER	491	4	1	5	0.06	0	1	10	29.5	0	0	39.5	49	80	80	0.8	61%						
	026 - INSTRUMENTS	[4]	COMPUTER	425	4		5	0.06	0	1	10	25.5	0	0	35.5	44	70	70	0.8	63%						
	027 - EQUIP		UTILITY	61	10		0	0	50	0	0	0	0	160	0	0	100	100	0.8							
	028 - VESTIBULE		MAIN LOBBY	201	10		5	0.06	0	1	5	12.1	0	0	17.1	21	50	50	0.8	42%						
	029 - STORAGE		WAREHOUSE	266	2		10	0.06	0	0	0	20	0	0	20	25	50	50	0.8	50%						
	030 - HALL	[4]	CORRIDOR	679	3		0	0.06	0	0	0	50	0	0	50	63	110	110	0.8	57%						
	031 - LOUNGE		BAR, LOUNGES	712	100		7.5	0.18	0	36	270	130	0	0	400	500	1000	1000	0.8	50%						
	033 - KITCHEN		KITCHEN	54	20		7.5	0.12	0.7	1	7.5	10	40	100	17.5	22	100	100	0.8	22%						
	034 - RESTROOM		TOILET	337	20	7	0	0	0	7	0	0	350	550	0	0	400	400	0.8							
	036 - TOILET		TOILET	74	20	1	0	0	50	1	0	0	50	150	0	0	100	100	0.8							
	037 - JAN		UTILITY	49	10		0	0	50	1	0	0	50	50	0	0	0	0	0.8							
	038 - OFFICE		OFFICE	166	5		5	0.06	0	0	10	10	0	140	20	25	130	130	0.8	19%						
	039 - WORKSHOP		COMPUTER	68	4		5	0.06	0	0	0	10	0	125	10	13	80	80	0.8	16%						
	041 - WORKSHOP		COMPUTER	114	4		5	0.06	0	0	0	10	0	125	10	13	80	80	0.8	16%						
	042 - ELECTRICAL		UTILITY	145	10		0	0	50	0	0	0	50	0	0	0	130	130	0.8							
	044 - ORCHESTRA	[4]	STAGES-STUDIOS	658	70		10	0.06	0	23	230	40	0	0	270	338	550	550	0.8	61%						
	114 - TOILET		TOILET	35	20	1	0	0	50	0	0	0	50	75	0	0	0	0	0.8							
	118 - HALL		CORRIDOR	298	3		0	0.06	0	0	0	20	0	0	20	25	100	100	0.8	25%						
	121 - DRESSING		LOCKER DRESSING	141	20		0	0	0.25	0	0	0	40	50	0	0	200	200	0.8							
	122 - DRESSING		LOCKER DRESSING	188	20		0	0	0.25	0	0	0	50	50	0	0	250	250	0.8							
	126 - HALL		CORRIDOR	267	3		0	0.06	0	0	0	20	0	0	20	25	100	100	0.8	25%						
	203 - HALL		CORRIDOR	285	3		0	0.06	0	0	0	20	0	0	20	25	230	230	0.8	11%						
	204 - DRESSING	[5]	LOCKER DRESSING	97	20		0	0	0.25	0	0	0	30	0	0	0	180	180	0.8							
	205 - DRESSING	[5]	LOCKER DRESSING	75	20		0	0	0.25	0	0	0	20	0	0	0	180	180	0.8							
	206 - TOILET		TOILET	43	20	1	0	0	50	0	0	0	50	100	0	0	0	0	0.8							
	318 - DRESSING	[5]	LOCKER DRESSING	149	20		0	0	0.25	0	0	0	40	0	0	0	200	200	0.8							
	319 - TOILET		TOILET	55	20	1	0	0	50	0	0	0	50	100	0	0	0	0	0.8							
	320 - DRESSING	[5]	LOCKER DRESSING	75	20		0	0	0.25	0	0	0	20	0	0	0	180	180	0.8							
	321 - HALL		CORRIDOR	217	3		0	0.06	0	0	0	20	0	0	20	25	80	80	0.8	31%						
	422 - HALL		CORRIDOR	217	3		0	0.06	0	0	0	20	0	0	20	25	80	80	0.8	31%						
	423 - TOILET		TOILET	55	20	1	0	0	50	0	0	0	50	100	0	0	0	0	0.8							
	424 - DRESSING	[5]	LOCKER DRESSING	149	20		0	0	0.25	0	0	0	40	0	0	0	200	200	0.8							
	425 - DRESSING	[5]	LOCKER DRESSING	79	20		0	0	0.25	0	0	0	20	0	0	0	180	180	0.8							
	507 - HALL		CORRIDOR	272	3		0	0.06	0	0	0	20	0	0	20	25	80	80	0.8	31%						
	508 - DRESSING	[5]	LOCKER DRESSING	183	20		0	0	0.25	0	0	0	50	0	0	0	350	350	0.8							
	509 - TOILET		TOILET	37	20	1	0	0	50	0	0	0	50	100	0	0	0	0	0.8							
	510 - DIMMER		COMPUTER	167	4		5	0.06	0	0	0	20	0	0	20	25	400	400	0.8	6%						
ASU-4	TOTALS			7584						72	542.5	487.1	1100	1975	1029.6	1288	5580	5450	0.8	62.9%	0.5	0.85	948	1896	1896	1900
	401 - SOUND BOOTH		DATA/TEL ENTRY	98	60		5	0.06	0	3	15	5.9	0	0	20.9	26	200	200	0.8	13%						
	402 - EQUIPMENT		DATA/TEL ENTRY	207	60		5	0.06	0	6	30	12.4	0	0	42.4	53	500	500	0.8	11%						
	702 - PROJECTION		DATA/TEL ENTRY	135	60		5	0.06	0	4	20	8.1	0	0	28.1	35	600	600	0.8	6%						
	703 - CORRIDOR		CORRIDOR	66	3		0	0.06	0	0	0	4	0	0	4	5	0	0	0.8							
	704 - LIGHTING		DATA/TEL ENTRY	161	60		5	0.06	0	5	25	9.7	0	0	34.7	43	200	200	0.8	22%						
	705 - PROJECTION		DATA/TEL ENTRY	130	60		5	0.06	0	4	20	7.8	0	0	27.8	35	600	600	0.8	6%						
	706 - SOUND		DATA/TEL ENTRY	149	60		5	0.06	0	4	20	8.9	0	0	28.9	36	250	250	0.8	14%						
	707 - PROJECTION		DATA/TEL ENTRY	189	60		5	0.06	0	6	30	11.3	0	0	41.3	52	550	550	0.8	9%						
ASU-5	TOTALS			1135						32	160	68.1	0	0	228.1	285	2900	2700	0.8	22%	0.9	1	285	317	317	1100
	119 - STAGE		STAGES-STUDIOS	1609	70		10	0.06	0	56	1150	96.5	0	0	1246.5	1247	6000	6000	1	21%						
	120 - STAGE		STAGES-STUDIOS	565	70		10	0.06	0	20	380	33.9	0	0	413.9	414	1900	1900	1	22%						
	128 - MANAGER		OFFICE	67	5		5	0.06	0	0	0	4	0	0	4	5	100	100	0.8	5%						
ASU-6	TOTALS			2241						76	1530	134.4	0	0	1664.4	1666	8000	8000	0.8	22%	0.9	1	1664	1849	1849	1858

NOTES:  
 (1) OUTDOOR AIR SUPPLIED DIRECTLY THROUGH THE UNIT.  
 (2) ADDITIONAL EXHAUST AIR WILL BE PROVIDED BY TRANSFER ROOM AIR NOT OSA.  
 (3) ZONE AIR DISTRIBUTION EFFECTIVENESS PER CODE TABLE 3.1.2  
 (4) EXISTING SUPPLY AIRFLOW IN THIS SPACE MUST BE REBALANCED TO THE LISTED SUPPLY AIRFLOW.  
 (5) DIRECT EXHAUST AIRFLOW MUST BE ADDED TO SPACE AS REQUIRED TO MEET CODE.

### OUTSIDE VENTILATION AIRFLOW CODE ANALYSIS CALCULATION TABLE - ANTOINETTE HATFIELD HALL

UNIT	ROOM	REMARKS	MECH CODE CLASSIFICATION	SPACE AREA (FT^2) - Az	OCCUPANCY MAX(PEOPLE / 1000FT^2)	PLUMBING FIXTURES	OA CFM / PERSON (FIXTURE) - Rp	OA CFM/FT^2 - Ra	EA REQUIRED CFM / FIXTURE OR SF	CODE PEOPLE	OCCUPANT OSA CFM VBzp =Rp*Pz	AREA OSA CFM Vbza =Ra*Az	MECH CODE REQUIRED EXHAUST CFM	PROVIDED 100% EXHAUST CFM (2)	REQUIRED OA CFM Vbz =Sum(Vbz)	MECH CODE REQ'D OA CFM Voz =(Vbz)/Ez	MAXIMUM PROVIDED ROOM SUPPLY AIR CFM	MINIMUM PROVIDED SUPPLY AIR CFM Vpz	ZONE EFFECT. FACTOR Ez(3)	MAXIMUM OUTDOOR AIR FRACTION Zp =Voz/Vpz	SYSTEM VENTILATION EFFICIENCY AT MAX Zp - Ev (4)100%DIRECT OA=1	OCCUPANT DIVERSITY - D =Ps(sum Pz)	UNCORREC OA INTAKE - Vou = DxSum(Rp x Pz)+Sum(Ra x Az)	MIN CODE OUTDOOR AIR CFM / Ev = Vou / Ev	REQUIRED OUTDOOR AIR INTAKE CFM - Vot	MINIMUM OSA CFM (1)	
TU-101	615 - MANAGER		OFFICE	340	5		5	0.06	0	1	5	20	0	0	25	31	410	205	0.8	15.2%				-			
TU-102	616 - RECEPTION		RECEPTION	428	30		5	0.06	0	9	45	26	0	0	71	89	1200	600	0.8	14.8%				-			
TU-103	617 - DEVELOPMENT		OFFICE	247	5		5	0.06	0	1	5	15	0	0	20	25	450	225	0.8	11.1%				-			
TU-104	618 - ACCOUNTING		OFFICE	179	5		5	0.06	0	1	5	11	0	0	16	20	250	125	0.8	16.0%				-			
	619 - CORRIDOR		CORRIDOR	583	3		0	0.06	0	1	0	35	0	0	35	44	270	135	0.8	32.4%				-			
	620 - COPY	[5]	COPY PRINTING	66	4		5	0.06	0.5	0	0	4	40	0	4	5	230	115	0.8	4.3%				-			
	621 - WOMEN		TOILET	33	20	1	0	0	50	1	0	0	50	50	0	0	0	0	0.8					-			
	622 - MEN		TOILET	33	20	1	0	0	50	1	0	0	50	50	0	0	0	0	0.8					-			
	623 - STORAGE		STORAGE-RET	67	2		0	0.12	0	0	0	8	0	0	8	10	0	0	0.8					-			
TU-105	624 - OFFICE		OFFICE	371	5		5	0.06	0	1	5	22	0	0	27	34	680	340	0.8	9.9%				-			
TU-106	625A - RECEPTION		RECEPTION	371	30		5	0.06	0	7	35	22	0	0	57	71	480	240	0.8	29.7%				-			
TU-107	625 - RECEPTION		RECEPTION	362	30		5	0.06	0	7	35	22	0	0	57	71	960	480	0.8	14.8%				-			
	626 - CANTEEN		DINING	39	70		7.5	0.18	0	2	15	7	0	0	22	28	0	0	0.8					-			
TU-108	627 - CONFERENCE		CONFERENCE	281	50		5	0.06	0	9	45	17	0	0	62	78	850	425	0.8	18.2%				-			
TU-110	628 - OFFICE		OFFICE	1795	5		5	0.06	0	6	30	108	0	0	138	173	1180	590	0.8	29.2%				-			
TU-111	515 - COSTUME		LOCKER DRESSING	474	20		0	0	0.25	6	0	0	120	200	0	0	250	125	0.8					-			
TU-112	516 - TOILET		TOILET	32	20	1	0	0	50	1	0	0	50	50	0	0	0	0	0.8					-			
	517 - STUDIO	[4]	STAGES-STUDIOS	681	70		10	0.06	0	19	190	41	0	0	231	289	600	600	0.8	48.1%				-			
	518 - CANTEEN		DINING	181	70		7.5	0.18	0	8	60	33	0	150	93	116	0	0	0.8					-			
TU-114	519 - MANAGER		OFFICE	286	5		5	0.06	0	1	5	17	0	0	22	28	150	75	0.8	36.7%				-			
TU-116	415 - TOILET		TOILET	87	20	2	0	0	50	2	0	0	100	190	0	0	100	50	0.8					-			
	416 - DRESS	[5]	LOCKER DRESSING	372	20		0	0	0.25	5	0	0	100	0	0	0	700	350	0.8					-			
TU-117	418 - GREEN	[4]	ASSEMBLY-MULTIUSE	832	100		7.5	0.06	0	41	309.4	50	0	0	359.4	449	910	910	0.8	49.4%				-			
TU-118	417 - TOILET		TOILET	31	20	1	0	0	50	1	0	0	50	50	0	0	0	0	0.8					-			
	420 - DRESS	[5]	LOCKER DRESSING	87	20		0	0	0.25	1	0	0	30	0	0	0	70	35	0.8					-			
	421 - TOILET		TOILET	49	20	1	0	0	50	1	0	0	50	170	0	0	70	35	0.8					-			
	422 - TOILET		TOILET	46	20	1	0	0	50	1	0	0	50	200	0	0	70	35	0.8					-			
	423 - DRESS	[5]	LOCKER DRESSING	76	20		0	0	0.25	1	0	0	20	0	0	0	100	50	0.8					-			
TU-119	324 - TOILET		TOILET	87	20	2	0	0	50	2	0	0	100	200	0	0	120	60	0.8					-			
	325 - DRESS	[5]	LOCKER DRESSING	317	20		0	0	0.25	4	0	0	80	0	0	0	870	435	0.8					-			
TU-120	327 - CONFERENCE		CONFERENCE	406	50		5	0.06	0	14	70	24	0	0	94	118	810	405	0.8	29.0%				-			
TU-122	329 - DRESS	[5]	LOCKER DRESSING	82	20		0	0	0.25	1	0	0	30	0	0	0	90	45	0.8					-			
	330 - TOILET		TOILET	46	20	1	0	0	50	1	0	0	50	200	0	0	70	35	0.8					-			
	331 - TOILET		TOILET	49	20	1	0	0	50	1	0	0	50	175	0	0	70	35	0.8					-			
	332 - DRESS	[5]	LOCKER DRESSING	93	20		0	0	0.25	1	0	0	30	0	0	0	140	70	0.8					-			
TU-123	123 - CLOSET		STORAGE-RET	53	2		0	0.12	0	0	0	6	0	0	6	8	50	25	0.8	30.0%				-			
	124 - OFFICE		OFFICE	307	5		5	0.06	0	1	5	18	0	0	23	29	360	180	0.8	16.0%				-			
TU-124	131 - STORAGE		STORAGE-RET	145	2		0	0.12	0	0	0	17	0	0	17	21	230	115	0.8	18.5%				-			
	132 - WAITING		RECEPTION	123	30		5	0.06	0	2	10	7	0	0	17	21	230	115	0.8	18.5%				-			
TU-125	140 - DRESS	[5]	LOCKER DRESSING	298	20		0	0	0.25	4	0	0	80	0	0	0	300	240	0.8					-			
	141 - STORAGE		STORAGE-RET	284	2		0	0.12	0	0	0	34	0	0	34	43	150	120	0.8	35.4%				-			
	143 - UNDERSTAGE		COMPUTER	561	4		5	0.06	0	1	5	34	0	0	39	49	280	224	0.8	21.8%				-			
	145 - STORAGE		STORAGE-RET	132	2		0	0.12	0	0	0	16	0	0	16	20	50	40	0.8	50.0%				-			
TU-126	135 - MEN		TOILET	54	20	1	0	0	50	1	0	0	50	75	0	0	0	0	0.8					-			
	136 - WOMEN		TOILET	54	20	1	0	0	50	1	0	0	50	75	0	0	0	0	0.8					-			
	138 - MANAGER		OFFICE	273	5		5	0.06	0	1	5	16	0	0	21	26	200	110	0.8	23.9%				-			
	139 - CREW		COMPUTER	286	4		5	0.06	0	1	5	17	0	0	22	28	230	126.5	0.8	21.7%				-			
	142 - CORRIDOR		CORRIDOR	764	3		0	0.06	0	2	0	46	0	200	46	58	200	110	0.8	52.3%				-			
	119 - STORAGE		STORAGE-RET	93	2		0	0.12	0	0	0	11	0	0	11	14	50	27.5	0.8	50.0%				-			
TU-127	121 - OFFICE		OFFICE	264	5		5	0.06	0	1	5	16	0	0	21	26	280	140	0.8	18.8%				-			
	123A - STAIR		CORRIDOR	233	3		0	0.06	0	0	0	14	0	0	14	18	150	75	0.8	23.3%				-			
	126 - VESTIBULE		MAIN LOBBY	390	10		5	0.06	0	3	15	23	0	0	38	48	200	100	0.8	47.5%				-			

UNIT	ROOM	REMARKS	MECH CODE CLASSIFICATION	SPACE AREA (FT^2) - Az	OCCUPANCY MAX/PEOPLE / 1000FT^2)	PLUMBING FIXTURES	OA CFM / PERSON (FIXTURE) - Rp	OA CFM/FT^2 - Ra	EA REQUIRED CFM / FIXTURE OR SF	CODE PEOPLE	OCCUPANT OSA CFM Vbzp =Rp*Pz	AREA OSA CFM Vbza =Ra*Az	MECH CODE REQUIRED EXHAUST CFM	PROVIDED 100% EXHAUST CFM (2)	REQUIRED OA CFM Vbz =Sum(Vbz)	MECH CODE REQ'D OA CFM Voz =(Vbz)/Ez	MAXIMUM PROVIDED ROOM SUPPLY AIR CFM	MINIMUM PROVIDED SUPPLY AIR CFM Vpz	ZONE EFFECT. FACTOR Ez(3)	MAXIMUM OUTDOOR AIR FRACTION Vpz/Voz	SYSTEM VENTILATION EFFICIENCY AT MAX Zp - Ev (4)100%DIRECT OA=1	OCCUPANT DIVERSITY - D =Ps/(sum Pz)	UNCORRECTED OA INTAKE - Vou = DxSum(Rp x Pz)+Sum(Ra x Az)	MIN CODE OUTDOOR AIR CFM - Ev	REQUIRED OUTDOOR AIR INTAKE CFM - Vot	MINIMUM OSA CFM (1)
	128 - TICKET	[4]	DATA/TEL ENTRY	107	60		5	0.06	0	4	20	6	0	0	26	33	150	75	0.8	43.3%				54		
TU-128	111 - STORAGE	[4]	STORAGE-RET	146	2		0	0.12	0	0	0	18	0	0	18	23	100	50	0.8	45.0%				38		
	112 - COATS		STORAGE-RET	304	2		0	0.12	0	0	0	36	0	0	36	45	530	265	0.8	17.0%				75		
	114 - CORRIDOR		CORRIDOR	260	3		0	0.06	0	1	0	16	0	0	16	20	150	75	0.8	26.7%				33		
	146 - HALL		CORRIDOR	387	3		0	0.06	0	1	0	23	0	0	23	29	200	100	0.8	28.8%				48		
TU-129	118 - RESTAURANT	[4]	DINING	1191	70		7.5	0.18	0	42	315	214	0	0	529	661	1700	1360	0.8	48.6%				1,102		
TU-130	117 - KITCHEN	[4]	KITCHEN	472	20		7.5	0.12	0.7	6	45	57	340	0	102	128	500	375	0.8	34.0%				213		
TU-133	104 - CONTROL		COMPUTER	110	4		5	0.06	0	0	0	7	0	0	7	9	450	225	0.8	3.9%				15		
TU-134	107 - WOMEN		TOILET	248	20	7	0	0	50	7	0	0	350	350	0	0	200	160	0.8					-		
	108 - MEN		TOILET	214	20	6	0	0	50	6	0	0	300	300	0	0	200	160	0.8					-		
	203 - OFFICE		OFFICE	249	5		5	0.06	0	1	5	15	0	0	20	25	150	120	0.8	20.8%				42		
	204 - STORE	[4]	SALES	282	15		7.5	0.12	0	3	22.5	34	0	0	56.5	71	170	136	0.8	51.9%				118		
	308 - MEN		TOILET	239	20	6	0	0	50	6	0	0	300	300	0	0	200	160	0.8					-		
	309 - WOMEN		TOILET	270	20	7	0	0	50	7	0	0	350	350	0	0	200	160	0.8					-		
	405 - MEN		TOILET	216	20	6	0	0	50	6	0	0	300	300	0	0	200	160	0.8					-		
	406 - WOMEN		TOILET	242	20	7	0	0	50	7	0	0	350	350	0	0	200	160	0.8					-		
	507 - MEN		TOILET	214	20	6	0	0	50	6	0	0	300	300	0	0	200	160	0.8					-		
	508 - WOMEN		TOILET	243	20	7	0	0	50	7	0	0	350	350	0	0	200	160	0.8					-		
TU-135	011 - DRESS	[5]	LOCKER DRESSING	85	20		0	0	0.25	1	0	0	30	0	0	0	150	75	0.8					-		
	012 - TOILET		TOILET	52	20	1	0	0	50	1	0	0	50	100	0	0	0	0	0.8					-		
	013 - TOILET		TOILET	53	20	1	0	0	50	1	0	0	50	100	0	0	0	0	0.8					-		
	014 - DRESS	[5]	LOCKER DRESSING	80	20		0	0	0.25	1	0	0	20	0	0	0	150	75	0.8					-		
	015 - HALL		CORRIDOR	255	3		0	0.06	0	1	0	15	0	0	15	19	200	100	0.8	18.8%				31		
TU-136	002 - GARBAGE		STORAGE-RET	348	2		0	0.12	0	0	0	42	0	295	42	53	200	100	0.8	52.5%				88		
	003 - DRESS	[5]	LOCKER DRESSING	220	20		0	0	0.25	3	0	0	60	0	0	0	240	120	0.8					-		
	004 - TOILET		TOILET	76	20	2	0	0	50	2	0	0	100	150	0	0	80	40	0.8					-		
	006 - CORRIDOR		CORRIDOR	809	3		0	0.06	0	2	0	49	0	0	49	61	380	190	0.8	32.2%				102		
	007 - UNDERSTAGE		COMPUTER	356	4		5	0.06	0	1	5	21	0	0	26	33	200	100	0.8	32.5%				54		
	024 - JANITOR		UTILITY	54	10		0	0.12	0	1	0	6	0	75	6	8	0	0	0.8					13		
TU-137	018 - TOILET		TOILET	25	20	1	0	0	50	1	0	0	50	75	0	0	0	0	0.8					-		
	020 - DRESS		LOCKER DRESSING	336	20		0	0	0.25	4	0	0	90	100	0	0	350	175	0.8					-		
	023 - DRESS		LOCKER DRESSING	376	20		0	0	0.25	5	0	0	100	100	0	0	350	175	0.8					-		
	025 - TOILET		TOILET	24	20	1	0	0	50	1	0	0	50	75	0	0	0	0	0.8					-		
	027 - ELEV LOBBY		CORRIDOR	336	3		0	0.06	0	1	0	20	0	0	20	25	180	90	0.8	27.8%				42		
	028 - JANITOR		UTILITY	82	10		0	0.12	0	1	0	10	0	75	10	13	0	0	0.8					21		
TU-138	030 - WORKSHOP	[4][5]	WOOD-METAL SHOPS	163	20		10	0.18	0.5	2	20	29	90	0	49	61	190	152	0.8	40.3%				102		
	031A - CORRIDOR		CORRIDOR	602	3		0	0.06	0	1	0	36	0	0	36	45	150	120	0.8	37.5%				75		
	033 - MAINTENANCE	[5]	SHOP-AUTO REPAIR	363	10		0	0.05	1	2	0	18	370	0	18	23	280	224	0.8	10.0%				38		
	034 - OFFICE		OFFICE	160	5		5	0.06	0	1	5	10	0	0	15	19	130	104	0.8	18.0%				31		
	046 - CLEANERS	[4]	LAUNDRY	362	20		7.5	0.12	0	3	22.5	43	0	0	65.5	82	200	160	0.8	51.2%				136		
TU-139	041 - MEN		TOILET	36	20	1	0	0	50	1	0	0	50	50	0	0	0	0	0.8					-		
	043 - WOMEN		TOILET	37	20	1	0	0	50	1	0	0	50	50	0	0	0	0	0.8					-		
	045 - CORRIDOR		CORRIDOR	752	3		0	0.06	0	2	0	45	0	0	45	56	200	170	0.8	33.1%				94		
	048 - WORKSHOP	[4][5]	WOOD-METAL SHOPS	434	20		10	0.18	0.5	5	50	78	220	0	128	160	340	289	0.8	55.4%				267		
	049 - CARPENTRY	[4][5]	WOOD-METAL SHOPS	502	20		10	0.18	0.5	7	70	90	260	0	160	200	430	365.5	0.8	54.7%				333		
	050 - DIMMERS	[4]	COMPUTER	170	4		5	0.06	0	0	0	10	0	0	10	13	420	357	0.8	3.5%				21		
	051 - STORE	[4]	SALES	332	15		7.5	0.12	0	3	22.5	40	0	0	62.5	78	220	187	0.8	41.8%				130		
TU-140	031 - STORAGE		STORAGE-RET	354	2		0	0.12	0	0	0	42	0	0	42	53	190	130	0.8	40.4%				88		
	047 - STORAGE		STORAGE-RET	1490	2		0	0.12	0	2	0	179	0	0	179	224	760	510	0.8	43.9%				373		
TU-141	035 - MECH	[5]	UTILITY	506	10		0	0.12	0	3	0	61	0	0	61	76	250	150	0.8	50.8%				127		
	036 - TELEPHONE	[4]	DATA/TEL ENTRY	240	60		5	0.06	0	7	35	14	0	0	49	61	190	114	0.8	53.7%				102		
	037 - ELECTRICAL		UTILITY	246	10		0	0.12	0	2	0	30	0	0	30	38	120	72	0.8	52.1%				63		
	038 - ELECTRICAL		UTILITY	312	10		0	0.12	0	2	0	37	0	0	37	46	240	144	0.8	32.1%				77		
	038A - ELECTRICAL		UTILITY	99	10		0	0.12	0	1	0	12	0	0	12	15	100	60	0.8	25.0%				25		
	040 - LAUNDRY		LAUNDRY	151	20		7.5	0.12	0	2	15	18	0	600	33	41	150	90	0.8	45.8%				69		
	042 - WORKSHOP	[4][5]	WOOD-METAL SHOPS	131	20		10	0.18	0.5	2	20	24	70	0	44	55	170	102	0.8	53.9%				92		
	044 - COSTUME	[5]	LOCKER DRESSING	345	20		0	0	0.25	5	0	0	90	0	0	0	130	78	0.8					-		
ASU-1	TOTALS	[6]		30571						368.25	1582	2162	5970	6480	3744	4680	28150	17457.5	0.800	55%	0.6	0.75	3348	5580	5580	5,580
	314 - VESTIBULE		MAIN LOBBY	115																						

UNIT	ROOM	REMARKS	MECH CODE CLASSIFICATION	SPACE AREA (FT^2) - Az	OCCUPANCY MAX(PEOPLE / 1000FT^2)	PLUMBING FIXTURES	OA CFM / PERSON (FIXTURE) - Rp	OA CFM/FT^2 - Ra	EA REQUIRED CFM / FIXTURE OR SF	CODE PEOPLE	OCCUPANT OSA CFM Vbzp =Rp*Pz	AREA OSA CFM Vbz =Ra*Az	MECH CODE REQUIRED EXHAUST CFM	PROVIDED 100% EXHAUST CFM (2)	REQUIRED OA CFM Vbz =Sum(Vbz)	MECH CODE REQ'D OA CFM Voz =Vbz)/Ez	MAXIMUM PROVIDED ROOM SUPPLY AIR CFM	MINIMUM PROVIDED SUPPLY AIR CFM Vpz	ZONE EFFECT. FACTOR Ez(3)	MAXIMUM OUTDOOR AIR FRACTION Zp =Voz/Vpz	SYSTEM VENTILATION EFFICIENCY AT MAX Zp - Ev (4)100%DIRECT OA=1	OCCUPANT DIVERSITY - D =Ps/(sum Pz)	UNCORREC OA INTAKE - Vou = DxSum(Rp x Pz)+Sum(Ra x Az)	MIN CODE OUTDOOR AIR CFM - Vot = Vou / Ev	REQUIRED OUTDOOR AIR INTAKE CFM - Votr	MINIMUM OSA CFM (1)
	412 - BALCONY		AUDITORIUM	2209	150		5	0.06	0	221	1105	133	0	0	1238	1238	3500	3500	1	35.4%						
	413 - VESTIBULE		MAIN LOBBY	90	10		5	0.06	0	1	5	5	0	0	10	10	0	0	1							
	510 - VESTIBULE		MAIN LOBBY	96	10		5	0.06	0	1	5	6	0	0	11	11	0	0	1							
	512 - BALCONY		AUDITORIUM	2208	150		5	0.06	0	221	1105	132	0	0	1237	1237	3500	3500	1	35.3%						
	513 - VESTIBULE		MAIN LOBBY	90	10		5	0.06	0	1	5	5	0	0	10	10	0	0	1							
	334 - STAGE		STAGES-STUDIOS	2547	70		10	0.06	0	119	1190	153	0	0	1343	1343	6000	6000	1	22.4%						
	334A - ORCHESTRA		STAGES-STUDIOS	942	70		10	0.06	0	44	440	57	0	0	497	497	3250	3250	1	15.3%						
	353 - BACKSTAGE		STORAGE-RET	1807	2		0	0.12	0	2	0	217	0	0	217	217	750	750	1	28.9%						
ASU-2	TOTALS			13880						972	5665	941	0	0	6606	6606	25640	21600	1	35%	0.8	0.9	6040	7550	7550	7,550
																			30120							
	103 - LOBBY		T-LOBBIES	902	150		5	0.06	0	107	537	64	0	0	601	601	2140	2140	1	28.1%						
	103A - STAIR		CORRIDOR	491	3		0	0.06	0	1	0	29	0	0	29	36	200	200	0.8	18.0%						
	115 - LOBBY		T-LOBBIES	4348	150		5	0.06	0	435	2175	261	0	0	2436	2436	9950	9950	1	24.5%						
	115A - STAIR		CORRIDOR	785	3		0	0.06	0	2	0	47	0	0	47	59	400	400	0.8	14.8%						
	115B - STAIR		CORRIDOR	525	3		0	0.06	0	1	0	32	0	0	32	40	400	400	0.8	10.0%						
	115C - LOBBY		T-LOBBIES	1032	150		5	0.06	0	77	386.3	62	0	0	448.3	448	1930	1930	1	23.2%						
	306 - LOBBY		T-LOBBIES	826	150		5	0.06	0	83	415	50	0	0	465	465	6600	6600	1	7.0%						
	323 - BAR		BAR, LOUNGES	1266	100		7.5	0.18	0	63	472.5	228	0	0	700.5	701	1500	1500	1	46.7%						
	414 - BAR		BAR, LOUNGES	1280	100		7.5	0.18	0	64	478.1	230	0	0	708.1	708	1500	1500	1	47.2%						
	514 - BAR		BAR, LOUNGES	1232	100		7.5	0.18	0	62	461.3	222	0	0	683.3	683	1500	1500	1	45.5%						
ASU-3	TOTALS			13761						985	5375	1279	0	0	6654.2	6807	30120	29000	0.93	47%	0.65	0.75	5310	8169	8169	8200
	105 - REHEARSAL		MUSIC-DANCE	2182	35		10	0.06	0	51	509	131	0	0	640	800	7500	7500	0.8	10.7%						
	105A - STAGE		STAGES-STUDIOS	1288	70		10	0.06	0	60	601	77	0	0	678	848	3800	3800	0.8	22.3%						
	105B - HALL		CORRIDOR	144	3		0	0.06	0	0	0	9	0	0	9	50	50	50	1	18.0%						
	105C - HALL		CORRIDOR	152	3		0	0.06	0	0	0	9	0	0	9	9	50	50	1	18.0%						
	202 - BALCONY		AUDITORIUM	923	150		5	0.06	0	92	461.5	55	0	0	516.5	517	1000	1000	1	51.7%						
	202A - HALL		CORRIDOR	152	3		0	0.06	0	0	0	9	0	0	9	9	50	50	1	18.0%						
	202B - HALL		CORRIDOR	157	3		0	0.06	0	0	0	9	0	0	9	9	50	50	1	18.0%						
	304 - BALCONY		AUDITORIUM	923	150		5	0.06	0	92	461.5	55	0	0	516.5	517	1000	1000	1	51.7%						
	304A - HALL		CORRIDOR	152	3		0	0.06	0	0	0	9	0	0	9	11	50	50	0.8	22.0%						
	304B - HALL		CORRIDOR	157	3		0	0.06	0	0	0	9	0	0	9	11	50	50	0.8	22.0%						
	403A - STAIR		CORRIDOR	145	3		0	0.06	0	0	0	9	0	0	9	11	50	50	0.8	22.0%						
	403B - STAIR		CORRIDOR	141	3		0	0.06	0	0	0	8	0	0	8	10	50	50	0.8	20.0%						
	409 - DIMMERS		COMPUTER	174	4		5	0.06	0	1	2.5	10	0	0	12.5	16	380	380	0.8	4.2%						
ASU-4	TOTALS			6690						298.5	2036	399	0	0	2434.5	2777	14200	14200	0.89	52%	0.6	0.9	2231	3718	3718	3750
	316 - LOBBY		T-LOBBIES	4332	150		5	0.06	0	325	1625	260	0	0	1884.5	2356	4950	4950	0.8	47.6%						
	316A - STAIR		CORRIDOR	795	3		0	0.06	0	0	0	48	0	0	48	60	150	150	0.8	40.0%						
	316B - STAIR		CORRIDOR	516	3		0	0.06	0	0	0	31	0	0	31	39	100	100	0.8	39.0%						
	411 - LOBBY		T-LOBBIES	4134	150		5	0.06	0	310	1550	248	0	0	1798.3	2248	4600	4600	0.8	48.9%						
	411B - STAIR		CORRIDOR	518	3		0	0.06	0	0	0	31	0	0	31	39	200	200	0.8	19.5%						
	511 - LOBBY		T-LOBBIES	4326	150		5	0.06	0	324	1622	260	0	0	1882.3	2353	5500	5500	0.8	42.8%						
	511B - STAIR		CORRIDOR	504	3		0	0.06	0	0	0	30	0	0	30	38	500	500	0.8	7.6%						
ASU-5	TOTALS			15125						959	4797	908	0	0	5705.1	7133	16800	16800	0.8	48.9%	0.65	0.86	5034	7745	7745	7750
	303 - LIGHTING		COMPUTER	89	4		5	0.06	0	0	1	5	0	0	6	8	100	100	0.8	8.0%						
	315 - RECEPTION		RECEPTION	80	30		5	0.06	0	2	8	5	0	0	13	16	40	40	0.8	40.0%						
	317 - BROADCAST		COMPUTER	122	4		5	0.06	0	0	1.5	7	0	0	8.5	11	80	80	0.8	13.8%						
	318 - SOUND		COMPUTER	178	4		5	0.06	0	1	2.5	11	0	0	13.5	17	800	800	0.8	2.1%						
	320 - OFFICE		OFFICE	124	5		5	0.06	0	0	2	7	0	0	9	11	80	80	0.8	13.8%						
	321 - RECEPTION		RECEPTION	85	30		5	0.06	0	2	8.5	5	0	0	13.5	17	40	40	0.8	42.5%						
	605 - CORRIDOR		CORRIDOR	124	3		0	0.06	0	0	0	7	0	0	7	9	0	0	0.8							
	606 - DIMMERS		COMPUTER	123	4		5	0.06	0	0	1.5	7	0	0	8.5	11	200	200	0.8	5.5%						
	606A - STAIR		CORRIDOR	335	3		0	0.06	0	0	0	20	0	0	20	25	400	400	0.8	6.3%						
	607 - JAN		UTILITY	52	10		0	0.12	0	0	0	6	0	75	6	8	0	0	0.8							
	608 - TOILET		TOILET	69	20	1	0	0	50	0	0	0	50	50	0	0	0	0	0.8							
	609 - LOBBY		T-LOBBIES	187	150		5	0.06	0	14	70.1	11	0	0	81.1	101	180	180	0.8	56.1%						
	610 - OFFICE		OFFICE	183	5		5	0.06	0	1	3	11	0	0	14	18	160	160	0.8	11.3%						
	611 - MULTI-PURPOSE	[4]	MUSEUM GALLERIES	2452	40		7.5	0.06	0	34	255.4	147	0	0	402.4	503	900	900	0.8	55.9%						

UNIT	ROOM	REMARKS	MECH CODE CLASSIFICATION	SPACE AREA (FT^2) - Az	OCCUPANCY MAX(PEOPLE / 1000FT^2)	PLUMBING FIXTURES	OA CFM / PERSON (FIXTURE) - Rp	OA CFM/FT^2 - Ra	EA REQUIRED CFM / FIXTURE OR SF	CODE PEOPLE	OCCUPANT OSA CFM VBzp =Rp*Pz	AREA OSA CFM Vbza =Ra*Az	MECH CODE REQUIRED EXHAUST CFM	PROVIDED 100% EXHAUST CFM (2)	REQUIRED OA CFM Vbz =Sum(Vbz)	MECH CODE REQ'D OA CFM Voz =(Vbz)/Ez	MAXIMUM PROVIDED ROOM SUPPLY AIR CFM	MINIMUM PROVIDED SUPPLY AIR CFM Vpz	ZONE EFFECT. FACTOR Ez(3)	MAXIMUM OUTDOOR AIR FRACTION Zp =Voz/Vpz	SYSTEM VENTILATION EFFICIENCY AT MAX Zp - Ev (4)100%DIRECT OA=1	OCCUPANT DIVERSITY - D =Ps/(sum Pz)	UNCORRECTED OA INTAKE - Vou = DxSum(Rp x Pz)+Sum(Ra x Az)	MIN CODE OUTDOOR AIR CFM - Vot = Vou / Ev	REQUIRED OUTDOOR AIR INTAKE CFM - Vot	MINIMUM OSA CFM (1)
	301 - LOBBY		T-LOBBIES	712	150		5	0.06	0	53	267	43	0	0	310	388	2500	2500	0.8	15.5%						
	302A - STAIR		CORRIDOR	502	3		0	0.06	0	0	0	30	0	0	30	38	300	300	0.8	12.7%						
ASU-9	TOTALS			1214						53	267	73	0	0	340	426	2800	2800	0.8	16%	1	1	340	340	340	340

NOTES:

- (1) OUTDOOR AIR SUPPLIED DIRECTLY THROUGH THE UNIT.
- (2) ADDITIONAL EXHAUST AIR WILL BE PROVIDE BY TRANSFER ROOM AIR NOT OSA.
- (3) ZONE AIR DISTRIBUTION EFFECTIVENESS PER CODE TABLE 3.1.2
- (4) EXISTING SUPPLY AIRFLOW IN THIS SPACE MUST BE REBALANCED TO THE LISTED SUPPLY AIRFLOW.
- (5) DIRECT EXHAUST AIRFLOW MUST BE ADDED TO SPACE AS REQUIRED TO MEET CODE.
- (6) ADDITIONAL EXHAUST AIRFLOW PROVIDED BY TRANSFER AIR FROM OTHER SYSTEMS AND NOT BY DIRECT OUTDOOR AIRFLOW.

OUTSIDE VENTILATION AIRFLOW CODE ANALYSIS CALCULATION TABLE - KELLER AUDITORIUM																											
UNIT	ROOM	REMARKS	MECH CODE CLASSIFICATION	SPACE AREA (FT^2) - Az	OCCUPANCY MAX(PEOPLE / 1000FT^2)	PLUMBING FIXTURES	OA CFM / PERSON (FIXTURE) - Rp	OA CFM/FT^2 - Ra	EA REQUIRED CFM / SF	CODE PEOPLE	OCCUPANT OSA CFM VBzp =Rp*Pz	AREA OSA CFM Vbza =Ra*Az	MECH CODE REQUIRED EXHAUST CFM	PROVIDED 100% EXHAUST CFM (2)	REQUIRED OA CFM Vbz =Sum(Vbz)	MECH CODE REQ'D OA CFM Voz =Vbz/Ez	MAXIMUM PROVIDED ROOM SUPPLY AIR CFM	MINIMUM PROVIDED SUPPLY AIR CFM Vpz	ZONE EFFECT. FACTOR Ez(3)	MAXIMUM OUTDOOR AIR FRACTION Zp =Voz/Vpz	SYSTEM VENTILATION EFFICIENCY AT MAX Zp - Ev (4)100%DIRECT OA=1	OCCUPANT DIVERSITY - D =Ps/(sum Pz)	UNCORREC OA INTAKE - Vou = DxSum(Rp x Pz)+Sum(Ra x Az)	MIN CODE OUTDOOR AIR CFM - Ev = Vou / Ev	REQUIRED OUTDOOR AIR INTAKE CFM - Vot	SYSTEM MINIMUM OSA CFM (1)	
	230 - STAGE		STAGES-STUDIOS	4822	70		10	0.06	0	161	1610	289	0	0	1899	1899	2650	2650	1	71.7%							
	230B - BACKSTAGE		STORAGE-RET	2048	2		0	0.12	0	2	0	246	0	0	246	246	350	350	1	70.3%							
	238 - REHEARSAL	[4]	MUSIC-DANCE	2014	35		10	0.06	0	38	376	121	0	0	467	467	810	810	1	57.7%							
SU-101	TOTALS			8884						200.6	1986	656	0	0	2612	2612	3810	3810	1	72%	0.4	0.75	2123	5308	5308	1.750	
	538 - REHEARSAL		MUSIC-DANCE	1848	35		10	0.06	0	43	430	111	0	0	541	676	3300	3300	0.8	20.5%							
SU-102	TOTALS			1848						43	430	111	0	0	541	676	3300	3300	0.8	20%	0.95	1	541	569	569	570	
	326 - VESTIBULE		MAIN LOBBY	147	10		5	0.06	0	1	5	9	0	0	14	14	980	980	1	1.4%							
	327 - TICKET		DATA/TEL ENTRY	127	60		5	0.06	0	5	25	8	0	0	33	33	100	100	1	33.0%							
	328 - VESTIBULE		MAIN LOBBY	405	10		5	0.06	0	3	15	24	0	0	39	39	2160	2160	1	1.8%							
	330 - VESTIBULE		MAIN LOBBY	352	10		5	0.06	0	2	10	21	0	0	31	31	2160	2160	1	1.4%							
SU-103	TOTALS			1031						11	55	62	0	0	117	117	5400	5400	1	33%	0.8	1	117	146	146	150	
	304 - LOBBY		T-LOBBIES	671	150		5	0.06	0	67	335	40	0	0	375	375	750	750	1	50.0%							
	305A - VESTIBULE		MAIN LOBBY	138	10		5	0.06	0	1	5	8	0	0	13	13	50	50	1	26.0%							
	329 - FOYER		RECEPTION	4967	30		5	0.06	0	99	495	298	0	0	793	793	6200	6200	1	12.8%							
	331 - COATS		STORAGE-RET	332	2		0	0.12	0	0	0	40	0	0	40	40	400	400	1	10.0%							
	333 - OFFICE		OFFICE	102	5		5	0.06	0	0	0	6	0	0	6	6	30	30	1	20.0%							
	338 - OFFICE		OFFICE	115	5		5	0.06	0	0	0	7	0	0	7	7	30	30	1	23.3%							
	341 - LOBBY		T-LOBBIES	652	150		5	0.06	0	65	325	39	0	0	364	364	750	750	1	48.5%							
	345 - VESTIBULE		MAIN LOBBY	136	10		5	0.06	0	1	5	8	0	0	13	13	50	50	1	26.0%							
SU-104	TOTALS			7113						233	1165	446	0	0	1611	1611	8320	8320	1	50%	0.65	0.75	1320	2031	2031	2040	
	401 - FOYER		RECEPTION	796	30		5	0.06	0	16	80	48	0	0	128	160	950	950	0.8	16.8%							
	401B - HALL		CORRIDOR	144	3		0	0.06	0	0	0	9	0	0	9	11	50	50	0.8	22.0%							
	502 - LOBBY		T-LOBBIES	932	150		5	0.06	0	93	465	56	0	0	521	651	1300	1300	0.8	50.1%							
	502B - HALL		CORRIDOR	230	3		0	0.06	0	0	0	14	0	0	14	18	50	50	0.8	36.0%							
	521 - FOYER		RECEPTION	4176	30		5	0.06	0	84	420	251	0	0	671	839	8280	8280	0.8	10.1%							
	529 - LOBBY		T-LOBBIES	948	150		5	0.06	0	95	475	57	0	0	532	665	1350	1350	0.8	49.3%							
SU-105	TOTALS			7226	1.65790202					288	1440	435	0	0	1875	2344	11980	11980	0.8	50.1%	0.65	0.95	1803	2774	2774	2750	
	702 - LOBBY		T-LOBBIES	930	150		5	0.06	0	93	465	56	0	0	521	651	1530	1530	0.8	42.5%							
	712 - FOYER		RECEPTION	2587	30		5	0.06	0	52	260	155	0	0	415	519	4740	4740	0.8	10.9%							
	719 - LOBBY		T-LOBBIES	940	150		5	0.06	0	94	470	56	0	0	526	658	1530	1530	0.8	43.0%							
SU-106	TOTALS			4457						239	1195	267	0	0	1462	1828	7800	7800	0.8	43%	0.7	0.8	1529	2184	2184	2200	
	108 - EQUIPMENT		COMPUTER	200	4		5	0.06	0	1	5	12	0	300	17	17	0	0	1								
	109 - JAN	[5]	UTILITY	33	10		0	0	50	0	0	0	50	30	0	0	0	0	1								
	202 - MANAGER		OFFICE	255	5		5	0.06	0	1	5	15	0	0	20	25	230	230	0.8	10.9%							
	204A - TOILET	[5]	TOILET	23	20	1	0	0	50	0	0	0	50	0	0	0	0	0	0.8								
	206 - OFFICE		OFFICE	226	5		5	0.06	0	1	5	14	0	0	19	24	210	210	0.8	11.4%							
	207 - VESTIBULE		MAIN LOBBY	221	10		5	0.06	0	1	5	13	0	0	18	18	0	0	1								
	208 - STAIR		CORRIDOR	323	3		0	0.06	0	0	0	19	0	0	19	24	60	60	0.8	40.0%							
	209 - CORRIDOR		CORRIDOR	190	3		0	0.06	0	0	0	11	0	0	11	14	0	0	0.8								
	226 - OFFICE	[4]	OFFICE	259	5		5	0.06	0	1	5	16	0	0	21	26	50	50	0.8	52.0%							
	231 - OFFICE	[4]	OFFICE	234	5		5	0.06	0	1	5	14	0	0	19	24	50	50	0.8	48.0%							
	305 - CORRIDOR		CORRIDOR	197	3		0	0.06	0	0	0	12	0	0	12	15	50	50	0.8	30.0%							
	306 - LOUNGE		BAR, LOUNGES	187	100		7.5	0.18	0	9	67.5	34	0	180	101.5	127	230	230	0.8	55.2%							
	308 - MEN	[5]	TOILET	509	20	14	0	0	50	0	0	0	700	450	0	0	250	250	0.8								
	402 - CORRIDOR		CORRIDOR	512	3		0	0.06	0	0	0	31	0	0	31	39	100	100	0.8	39.0%							
	404 - MEETING		CONFERENCE	266	50		5	0.06	0	9	45	16	0	0	61	76	550	550	0.8	13.8%							
	503 - LOUNGE		BAR, LOUNGES	201	100		7.5	0.18	0	10	75	36	0	160	111	139	240	240	0.8	57.9%							
	504 - WOMEN	[5]	TOILET	248	20	6	0	0	50	0	0	0	300	260	0	0	80	80	0.8								
	505 - JAN		UTILITY	68	10		0	0	50	0	0	0	50	50	0	0	0	0	0.8								
	506 - MEETING		CONFERENCE	507	50		5	0.06	0	17	85	30	0	0	115	144	1050	1050	0.8	13.7%							
	507 - CORRIDOR		CORRIDOR	502	3		0	0.06	0	0	0	30	0	0	30	38	100	100	0.8	38.0%							
	509 - MEETING		CONFERENCE	280	50		5	0.06	0	9	45	17	0	0	62	78	580	580	0.8	13.4%							
	602 - CORRIDOR		CORRIDOR	445	3		0	0.06	0	0	0	27	0	0	27	34	100	100	0.8	34.0%							
	702B - HALL		CORRIDOR	192	3		0	0.06	0	0	0	12	0	0	12	15	70	70	0.8	21.4%							
	703 - LOUNGE		BAR, LOUNGES	180	100		7.5	0.18	0	9	67.5	32	0	230	99.5	124	220	220	0.8	56.4%							

UNIT	ROOM	REMARKS	MECH CODE CLASSIFICATION	SPACE AREA (FT^2) - Az	OCCUPANCY MAX(PEOPLE / 1000FT^2)	PLUMBING FIXTURES	OA CFM / PERSON (FIXTURE) - Rp	OA CFM/FT^2 - Ra	EA REQUIRED CFM / SF	CODE PEOPLE	OCCUPANT OSA CFM VBzP =Rp*Pz	AREA OSA CFM VbzA =Ra*Az	MECH CODE REQUIRED EXHAUST CFM	PROVIDED 100% EXHAUST CFM (2)	REQUIRED OA CFM Vbz =Sum(Vbz)	MECH CODE REQ'D OA CFM Voz =(Vbz)/Ez	MAXIMUM PROVIDED ROOM SUPPLY AIR CFM	MINIMUM PROVIDED SUPPLY AIR CFM Vpz	ZONE EFFECT. FACTOR Ez(3)	MAXIMUM OUTDOOR AIR FRACTION Zp =Voz/Vpz	SYSTEM VENTILATION EFFICIENCY AT MAX Zp - Ev (4)100%DIRECT OA=1	OCCUPANT DIVERSITY - D =Ps/(sum Pz)	UNCORREC OA INTAKE - Vou = DxSum(Rp x Pz)+Sum(Ra x Az)	MIN CODE OUTDOOR AIR CFM - Vot = Vou / Ev	REQUIRED OUTDOOR AIR INTAKE CFM - Vot	SYSTEM MINIMUM OSA CFM (1)
	704 - MEN		TOILET	194	20	5	0	0	50	0	0	0	250	380	0	0	220	220	0.8							
	705 - JANITOR		UTILITY	63	10		0	0	50	0	0	0	50	50	0	0	0	0	0.8							
	706 - CORRIDOR		CORRIDOR	530	3		0	0.06	0	0	0	32	0	0	32	40	100	100	0.8	40.0%						
	707 - MEETING		CONFERENCE	562	50		5	0.06	0	19	95	34	0	0	129	161	1280	1280	0.8	12.6%						
SU-107	TOTALS	[6]		7607						88	510	457	1450	2090	967	1202	5770	5770	0.8	58%	0.55	1	967	1758	2090	1750
	235 - REHEARSAL	[4]	MUSIC-DANCE	395	35		10	0.06	0	7	70	24	0	0	94	94	110	110	1	85.5%						
	237 - EQUIPMENT		COMPUTER	272	4		5	0.06	0	1	5	16	0	0	21	26	260	260	0.8	10.0%						
	346 - LOUNGE		BAR, LOUNGES	278	100		7.5	0.18	0	14	105	50	0	400	155	194	400	400	0.8	48.5%						
	348 - CORRIDOR		CORRIDOR	480	3		0	0.06	0	0	0	29	0	0	29	36	100	100	0.8	36.0%						
	349 - WOMEN	[5]	TOILET	488	20	12	0	0	50	0	0	0	600	440	0	0	350	350	0.8							
	421 - FOYER		RECEPTION	606	30		5	0.06	0	12	60	36	0	0	96	120	750	750	0.8	16.0%						
	421A - CORRIDOR		CORRIDOR	146	3		0	0.06	0	0	0	9	0	0	9	11	50	50	0.8	22.0%						
	422 - CORRIDOR		CORRIDOR	569	3		0	0.06	0	0	0	34	0	0	34	43	100	100	0.8	43.0%						
	531 - LOUNGE		BAR, LOUNGES	301	100		7.5	0.18	0	13	97.5	54	0	350	151.5	189	350	350	0.8	54.0%						
	532 - WOMEN	[5]	TOILET	205	20	4	0	0	50	0	0	0	200	300	0	0	200	200	0.8							
	533 - JAN		UTILITY	54	10		0	0	50	0	0	0	50	50	0	0	0	0	0.8							
	534 - CORRIDOR		CORRIDOR	868	3		0	0.06	0	0	0	52	0	0	52	65	100	100	0.8	65.0%						
	535 - MEETING		CONFERENCE	531	50		5	0.06	0	18	90	32	0	0	122	153	1250	1250	0.8	12.2%						
	619 - CORRIDOR		CORRIDOR	637	3		0	0.06	0	0	0	38	0	0	38	48	100	100	0.8	48.0%						
	721 - LOUNGE		BAR, LOUNGES	218	100		7.5	0.18	0	11	82.5	39	0	180	121.5	152	360	360	0.8	42.2%						
	722 - CORRIDOR		CORRIDOR	824	3		0	0.06	0	0	0	49	0	0	49	61	220	220	0.8	27.7%						
	723 - JAN		UTILITY	63	10		0	0	50	0	0	0	50	50	0	0	0	0	0.8							
	724 - WOMEN	[5]	TOILET	188	20	4	0	0	50	0	0	0	200	180	0	0	260	260	0.8							
SU-108	TOTALS	[5]		7123						76	510	462	1100	1950	972	1192	4960	4960	0.8	85%	0.35	0.85	896	2560	2560	2560
	112 - ORCHESTRA	[4]	STAGES-STUDIOS	1462	70		10	0.06	0	49	490	88	0	0	578	723	1450	1450	0.8	49.9%						
	236 - CORRIDOR		CORRIDOR	184	3		0	0.06	0	0	0	11	0	0	11	14	0	0	0.8							
	340 - AUDITORIUM		AUDITORIUM	13340	150		5	0.06	0	1334	6670	800	0	0	7470	9338	18800	18800	0.8	49.7%						
	528 - BALCONY		AUDITORIUM	6709	150		5	0.06	0	671	3355	403	0	0	3758	4698	12050	12050	0.8	39.0%						
	718 - BALCONY		AUDITORIUM	5244	150		5	0.06	0	524	2620	315	0	0	2935	3669	12300	12300	0.8	29.8%						
	803 - PROJECTION		COMPUTER	396	4		5	0.06	0	1	5	24	0	0	29	36	750	750	0.8	4.8%						
	804 - TOILET	[5]	TOILET	28	20	1	0	0	50	0	0	0	50	30	0	0	0	0	0.8							
SU-109	TOTALS			27363						2579	13140	1641	50	30	14781	18478	45350	45350	0.8	49.9%	0.65	0.83	12547	19303	19303	19350
	101 - MEN	[5]	TOILET	210	20	5	0	0	50	0	0	0	250	160	0	0	120	60	0.8							
	102 - WOMEN	[5]	TOILET	173	20	4	0	0	50	0	0	0	200	160	0	0	110	50	0.8							
	103 - LOCKER		LOCKER SPORTS	165	20		0	0	0.5	0	0	0	90	160	0	0	100	50	0.8							
	103A - HALL		CORRIDOR	98	3		0	0.06	0	0	0	6	0	0	6	8	70	30	0.8	26.7%						
	104 - LOCKER		LOCKER SPORTS	158	20		0	0	0.5	0	0	0	80	90	0	0	90	40	0.8							
	105 - LIBRARY		LIBRARY	226	10		5	0.12	0	2	10	27	0	0	37	46	200	90	0.8	51.1%						
	106 - CORRIDOR		CORRIDOR	568	3		0	0.06	0	0	0	34	0	0	34	43	100	50	0.8	86.0%						
	107 - LOUNGE		BAR, LOUNGES	467	100		7.5	0.18	0	23	172.5	84	0	300	256.5	321	450	210	0.8	152.9%						
	107B - STORAGE		STORAGE-RET	88	2		0	0.12	0	0	0	11	0	40	11	14	0	0	0.8							
	210 - MEN	[5]	TOILET	73	20	2	0	0	50	0	0	0	100	80	0	0	60	30	0.8							
	211 - WOMEN		TOILET	68	20	1	0	0	50	0	0	0	50	60	0	0	40	20	0.8							
	212 - STAIR		CORRIDOR	99	3		0	0.06	0	0	0	6	0	0	6	8	80	40	0.8	20.0%						
	213 - CORRIDOR		CORRIDOR	428	3		0	0.06	0	0	0	26	0	0	26	33	150	70	0.8	47.1%						
	214 - DRESS	[5]	LOCKER DRESSING	62	20		0	0	0.25	0	0	0	0	0	0	0	80	40	0.8							
	215 - JAN	[5]	UTILITY	36	10		0	0	50	0	0	0	50	30	0	0	0	0	0.8							
	216 - TOILET		TOILET	42	20	1	0	0	50	0	0	0	50	75	0	0	0	0	0.8							
	217 - VESTIBULE		MAIN LOBBY	65	10		5	0.06	0	0	0	4	0	0	4	5	0	0	0.8							
	218 - HALL		CORRIDOR	136	3		0	0.06	0	0	0	8	0	0	8	10	50	20	0.8	50.0%						
	219 - STAIR		CORRIDOR	101	3		0	0.06	0	0	0	6	0	0	6	8	80	40	0.8	20.0%						
	220 - DRESS		LOCKER DRESSING	62	20		0	0	0.25	0	0	0	0	0	0	0	80	40	0.8							
	221 - TOILET		TOILET	46	20	1	0	0	50	0	0	0	50	50	0	0	0	0	0.8							
	222 - GREEN		ASSEMBLY-MULTIUSE	509	100		7.5	0.06	0	34	255	31	0	286	358	410	190	0.8	188.4%							
	223 - MANAGER		OFFICE	140	5		5	0.06	0	0	0	8	0	0	8	10	100	50	0.8	20.0%						
	311 - SHOWER	[5]	SHOWER	107	20		0	0	50	0	0	0	200	150	0	0	100	50	0.8							
	313 - TOILET	[5]	TOILET	15	20	1	0	0	50	0	0	0	50	25	0	0	60	30	0.8							
	314 - CORRIDOR		CORRIDOR	347	3		0	0.06	0	0	0	21	0	0	21	26	100	50	0.8	52.0%						
	315 - DRESS		LOCKER DRESSING	74	20		0	0	0.25	0	0	0	20	55	0	0	160	70	0.8							
	316 - DRESS																									

UNIT	ROOM	REMARKS	MECH CODE CLASSIFICATION	SPACE AREA (FT^2) - Az	OCCUPANCY MAX(PEOPLE / 1000FT^2)	PLUMBING FIXTURES	OA CFM / PERSON (FIXTURE) - Rp	OA CFM/FT^2 - Ra	EA REQUIRED CFM / FIXTURE OR SF	CODE PEOPLE	OCCUPANT OSA CFM VBzp =Rp*Pz	AREA OSA CFM Vbza =Ra*Az	MECH CODE REQUIRED EXHAUST CFM	PROVIDED 100% EXHAUST CFM (2)	REQUIRED OA CFM Vbz =Sum(Vbz)	MECH CODE REQ'D OA CFM Voz =(Vbz)/Ez	MAXIMUM PROVIDED ROOM SUPPLY AIR CFM	MINIMUM PROVIDED SUPPLY AIR CFM Vpz	ZONE EFFECT. FACTOR Ez(3)	MAXIMUM OUTDOOR AIR FRACTION Zp =Voz/Vpz	SYSTEM VENTILATION EFFICIENCY AT MAX Zp - Ev (4)100%DIRECT OA=1	OCCUPANT DIVERSITY - D =Ps/(sum Pz)	UNCORREC OA INTAKE - Vou = DxSum(Rp x Pz)+Sum(Ra x Az)	MIN CODE OUTDOOR AIR CFM - Vot = Vou / Ev	REQUIRED OUTDOOR AIR INTAKE CFM - Vot	SYSTEM MINIMUM OSA CFM (1)	
	410 - DRESS		LOCKER DRESSING	103	20		0	0	0.25	0	0	0	30	100	0	0	130	60	0.8								
	411 - DRESS		LOCKER DRESSING	72	20		0	0	0.25	0	0	0	20	70	0	0	100	50	0.8								
	411A - TOILET	[5]	TOILET	19	20	1	0	0	50	0	0	0	50	25	0	0	0	0	0.8								
	412 - JAN	[5]	UTILITY	33	10		0	0	50	0	0	0	50	30	0	0	0	0	0.8								
	415 - DRESS		LOCKER DRESSING	162	20		0	0	0.25	0	0	0	50	210	0	0	240	110	0.8								
	415A - TOILET	[5]	TOILET	13	20	1	0	0	50	0	0	0	50	25	0	0	0	0	0.8								
	417A - TOILET	[5]	TOILET	22	20	1	0	0	50	0	0	0	50	25	0	0	0	0	0.8								
	419A - TOILET	[5]	TOILET	22	20	1	0	0	50	0	0	0	50	25	0	0	0	0	0.8								
	420 - DRESS		LOCKER DRESSING	532	20		0	0	0.25	0	0	0	140	250	0	0	600	280	0.8								
	511 - CORRIDOR		CORRIDOR	368	3		0	0.06	0	0	0	22	0	0	22	28	100	50	0.8	56.0%							
	512 - DRESS	[5]	LOCKER DRESSING	111	20		0	0	0.25	0	0	0	30	130	0	0	130	60	0.8								
	514 - DRESS		LOCKER DRESSING	181	20		0	0	0.25	0	0	0	50	220	0	0	230	110	0.8								
	515 - JAN	[5]	UTILITY	33	10		0	0	50	0	0	0	50	30	0	0	0	0	0.8								
	516 - SHOWER		SHOWER	69	20		0	0	50	0	0	0	100	150	0	0	90	40	0.8								
	517 - DRESS		LOCKER DRESSING	142	20		0	0	0.25	0	0	0	40	205	0	0	210	100	0.8								
	519 - TOILET		TOILET	113	20	3	0	0	50	0	0	0	150	150	0	0	90	40	0.8								
	520 - DRESS		LOCKER DRESSING	670	20		0	0	0.25	0	0	0	170	350	0	0	700	320	0.8								
	606 - CORRIDOR		CORRIDOR	375	3		0	0.06	0	0	0	23	0	0	23	29	100	50	0.8	58.0%							
	607 - DRESS		LOCKER DRESSING	111	20		0	0	0.25	0	0	0	30	130	0	0	130	60	0.8								
	609 - DRESS		LOCKER DRESSING	181	20		0	0	0.25	0	0	0	50	220	0	0	220	100	0.8								
	610 - JAN	[5]	UTILITY	36	10		0	0	50	0	0	0	50	30	0	0	0	0	0.8								
	611 - SHOWER	[5]	SHOWER	64	20		0	0	50	0	0	0	100	75	0	0	90	40	0.8								
	612A - DRESS		LOCKER DRESSING	133	20		0	0	0.25	0	0	0	40	210	0	0	210	100	0.8								
	614 - TOILET		TOILET	97	20	3	0	0	50	0	0	0	150	150	0	0	90	40	0.8								
	615 - DRESS		LOCKER DRESSING	604	20		0	0	0.25	0	0	0	160	300	0	0	630	290	0.8								
	710 - JAN	[5]	UTILITY	36	10		0	0	50	0	0	0	50	30	0	0	0	0	0.8								
SU-110	TOTALS			10508						71	557.5	385	3880	5405	942.5	1182	8230	3800	0.8	188%	0.3	1	943	3143	3880	6256	

NOTES:  
 (1) OUTDOOR AIR SUPPLIED DIRECTLY THROUGH THE UNIT.  
 (2) ADDITIONAL EXHAUST AIR WILL BE PROVIDE BY TRANSFER ROOM AIR NOT OSA.  
 (3) ZONE AIR DISTRIBUTION EFFECTIVENESS PER CODE TABLE 3.1.2  
 (4) EXISTING SUPPLY AIRFLOW IN THIS SPACE MUST BE REBALANCED TO THE LISTED SUPPLY AIRFLOW.  
 (5) DIRECT EXHAUST AIRFLOW MUST BE ADDED TO SPACE AS REQUIRED TO MEET CODE.  
 (6) ADDITIONAL EXHAUST AIRFLOW PROVIDED BY TRANSFER AIR FROM OTHER SYSTEMS AND NOT BY DIRECT OUTDOOR AIRFLOW.





# **AIR BALANCING SPECIALTY INC.**

## **METRO PORTLAND 5 THEATERS PORTLAND, OREGON**

**PROJECT NO: 21-4266-DW**

AIR BALANCING SPECIALTY INC. 3532 S.E. MILWAUKIE AVENUE PORTLAND, OREGON 97202-2751  
IN BUSINESS SINCE 1964 CERTIFIED NEBB FIRM - CERTIFICATION NO. 2984  
PHONE (503) 230-2332 FAX (503) 230-2820

PROJECT NAME: **METRO PORTLAND - 5 THEATERS - PORTLAND, OREGON**

ARCHITECT: DATE STARTED: 05/24/21 DATE FINISHED: 08/03/21

MECHANICAL ENGINEER: MFIA INC. CONSULTING ENGINEERS WORK PERFORMED BY: DALE NEFFENDORF  
2007 SE ASH ST. WILLIAM NEFENDORF  
PORTLAND, OR. 97214

GENERAL CONTRACTOR: CERTIFIED BY: Dale Neffendorf

MECHANICAL CONTRACTOR: DATE: 9/9/2021

SHEET METAL CONTRACTOR:

CONTROL CONTRACTOR:



IN BUSINESS SINCE 1964

**AIR BALANCING SPECIALTY INC.**

CERTIFIED NEBB No. 2984

3532 SE Milwaukie Avenue Portland, Oregon 97202-2751 Phone (503) 230-2332 Fax (503) 230-2820

**CERTIFIED TEST AND BALANCE REPORT**

**PROJECT NO.: 21-4266-DW**

INSTRUMENT AIR	MODEL NO.	SERIAL NO.	RANGE	CALIBRATION DATE
(D) Shortridge Airdata Multimeter ADM Accessories	ADM860	M98375	0.0001 to 60.00" WC.	1/12/2021
(DH) Datameter Flow Hood	8400		25 - 2500 CFM	
(DP) Datameter Pitot Tube	12", 18", 24", 36", 48" & 60"		50 - 30000 FPM	
(DA) Datameter Airfoil	AFP18		50 - 5000 FPM	
(DG) Datameter Velgrid	VLG84		50 - 2500 FPM	
Rotating Vane Anemometer	A4/-4"	83072B	200 - 10000 FPM	1/14/2021
Amprobe Ammeter	Fluke 335	99330394	0 - 750 Volts / 0 - 300 Amps	1/8/2021
Shimpo Tachometer	DT-207L	D26B0033	6 - 30,000 RPM	1/12/2021
WATER				
Hydrodata Meter	HDM-250	W01025	DP -10 to +300 PSI	1/12/2021

IN BUSINESS SINCE 1964

## AIR BALANCING SPECIALTY INC.

CERTIFIED NEBB No. 2984

3532 SE Milwaukie Avenue Portland, Oregon 97202-2751 Phone (503) 230-2332 Fax (503) 230-2820

### EQUIPMENT USED IN BALANCING

PROJECT: METRO PORTLAND - 5 THEATERS - PORTLAND, OREGON

PROJECT NO.: 21-4266-DW

Ref	Ins	AREA SERVED	Rm.#	No.	OUTLET		Blow	DESIGN		TEST #1		TEST #2		TEST #3		FINAL		Pct
					Size	AK		Vel	CFM	FPM	CFM	FPM	CFM	FPM	CFM	FPM	CFM	
<b>KELLER AUDITORIUM</b>																		
<b>SU-1</b>																		
	DG	Fan Total @ discharge -0% OSA			36x12		3.00			1055	3165	1030	3090					
	DG	Fan Total @ discharge -20% Min OSA			36x12		3.00			1067	3201	1022	3066					
	DG	Fan Total @ discharge -100% OSA			36x12		3.00			1280	3840	1296	3888					
1		OSA (by temp)																
<b>SU-2</b>																		
	DG	Fan Total @ discharge -0% OSA			24x14		2.33			1706	3975	1494	3481					
	DG	Fan Total @ discharge -20% Min OSA			24x14		2.33			1689	3935	1664	3877					
	DG	Fan Total @ discharge -100% OSA			24x14		2.33			1665	3879	1673	3898					
1		OSA (by temp)																
<b>SU-3</b>																		
	DA	Fan Total @ Return			60x36		15.00			425	6375	507	7605					
<b>SU-4</b>																		
	Coil or coils are plugged. Supply has high suction pressure and the exhaust has high discharge pressure. This is observed when in 100% return.																	
	DG	Fan Total @ discharge -20% Min OSA			30x36		7.50					744	5580					
	SU-4 in 0% OSA - BFF +0.79 / FS -2.07 / FD +0.89																	
	SU-4 in 100% OSA - BFF -0.39 / FS -2.72 / FD +0.70																	
<b>SU-5</b>																		
	DA	Fan Total @ discharge -0% OSA			50x24		8.33			1388	11562	1383	11520					
	DA	Fan Total @ discharge -20% Min OSA			50x24		8.33			1346	11212	1309	10904					
	DA	Fan Total @ discharge -100% OSA			50x24		8.33			998	8313	1054	8780					
1		OSA (by temp)																

Ref. Note: (1) System layout does not allow for a OSA reading. Attempted to measure OSA by temperature but the differential was insufficient for an accurate OSA%.

AIR BALANCING SPECIALTY, INC. 3532 SE Milwaukie Avenue, Portland, Oregon 97202-2751 Phone: (503) 230-2332 Fax: (503) 230-2820

CONSTANT VOLUME - FPM

**AIR BALANCE DATA SHEET**

PROJECT NO.: 05/24/21

PROJECT: METRO PORTLAND - 5 THEATERS - PORTLAND, OREGON (KELLER AUDITORIUM)

DATE START: 05/24/21 FINISH: 08/03/21

SYSTEM: SU-1, SU-2, SU-3, SU-4 & SU-5

SECTION:

BY: DN / WN

PAGE: 1 OF 4

Ref	Ins	AREA SERVED	Rm.#	No.	OUTLET		DESIGN			TEST #1		TEST #2		TEST #3		FINAL		Pct
					Size	Blow	AK	Vel	CFM	FPM	CFM	FPM	CFM	FPM	CFM	FPM	CFM	
<b>KELLER AUDITORIUM</b>																		
<b>SU-6</b>																		
	DG	Fan Total @ filter -0% OSA			76x32.5		17.15			490	8404	497	8524					
	DG	Fan Total @ filter -100% OSA			76x32.5		17.15			456	7820	419	7186					
	DG	Fan Total @ filter - 20% Min OSA			76x32.5		17.15					491	8421					
	DG	OSA - 0% OSA			24x54		9.00					4	36					
	DG	OSA - 20% Min OSA			24x54		9.00			101	909	71	639					
	DG	OSA -100% OSA			24x54		9.00			878	7902	1148	10332					
<b>SU-7</b>																		
	DG	Fan Total @ filter -0% OSA			56x37		14.90			490	7301	429	6392					
	DG	Fan Total @ filter -100% OSA			56x37		14.90			477	7107	423	6303					
	DG	Fan Total @ filter - 20% Min OSA			56x37		14.90					414	6169					
	DG	OSA - 0% OSA (1)			16x16		1.77			805	1425	718	1271					
	DG	OSA - Min OSA (1)			16x16		1.77					715	1266					
	DG	OSA -100% OSA (1)			16x16		1.77			818	1448	730	1292					
	DG	OSA - 0% OSA (2)			16x16		1.77			673	1191	686	1214					
	DG	OSA - 20% Min OSA (2)			16x16		1.77					674	1193					
	DG	OSA -100% OSA (2)			16x16		1.77			713	1262	667	1181					
<b>SU-8</b>																		
	DG	Fan Total @ suction -0% OSA			61x27.5		11.65			505	5883	515	6000					
	DG	Fan Total @ suction - 20% Min OSA			61x27.5		11.65			512	5965	623	7258					
	DG	Fan Total @ suction -100% OSA			61x27.5		11.65			519	6046	580	6757					
1		OSA (by temp)																

Ref. Note: (1) System layout does not allow for a OSA reading. Attempted to measure OSA by temperature but the differential was insufficient for an accurate OSA%.

AIR BALANCING SPECIALTY, INC. 3532 SE Milwaukie Avenue, Portland, Oregon 97202-2751 Phone: (503) 230-2332 Fax: (503) 230-2820

CONSTANT VOLUME - FPM

**AIR BALANCE DATA SHEET**

PROJECT NO.: 05/24/21

PROJECT: METRO PORTLAND - 5 THEATERS - PORTLAND, OREGON (KELLER AUDITORIUM)

DATE START: 05/24/21 FINISH: 08/03/21

SYSTEM: SU-6, SU-7 & SU-8

SECTION:

BY: DN / WN

PAGE: 2 OF 4

Ref	Ins	AREA SERVED	Rm.#	No.	OUTLET		DESIGN			TEST #1		TEST #2		TEST #3		FINAL		Pct
					Size	Blow	AK	Vel	CFM	FPM	CFM	FPM	CFM	FPM	CFM	FPM	CFM	
<b>KELLER AUDITORIUM</b>																		
<b>SU-9</b>																		
<b>60 HZ</b>																		
											<b>PRE-TEST</b>		<b>POST-TEST</b>					
	DG	Fan Total @ filter -0% OSA			150x99		103.13				330	34033	341	35167				
	DG	Fan Total @ filter -20% OSA			150x99		103.13						395	40736				
	DG	Fan Total @ filter -100% OSA			150x99		103.13				427	44037	434	44758				
2	DG	OSA - 0% OSA			148x100		102.78				125	12848	195	20042				
	DG	OSA - 20% Min			148x100		102.78						239	24564				
	DG	OSA -100% OSA			148x100		102.78				472	48512	414	42551				
<b>SU-10</b>																		
The only return duct for this fan is a 12x12 duct so the fan is under high suction pressure. The fan is being starved in this mode.																		
	DG	Fan Total @ filter -0% OSA			56x47		18.28				153	2797	169	3089				
	DG	Fan Total @ filter -20% OSA			56x47		18.28				214	3912	243	4442				
	DG	Fan Total @ filter -100% OSA			56x47		18.28				352	6435	317	5795				
	DG	OSA - 0% OSA			36x24		6.00				225	1350	183	1098				
	DG	OSA - 20% Primary Min			36x24		6.00				323	1938	493	2958				
	DG	OSA -100% OSA			36x24		6.00				1148	6888	1029	6174				

Ref. Note: (2) Primary and minimum damper not closed 100%. Bottom 15%. Top 20%.

AIR BALANCING SPECIALTY, INC. 3532 SE Milwaukie Avenue, Portland, Oregon 97202-2751 Phone: (503) 230-2332 Fax: (503) 230-2820

CONSTANT VOLUME - FPM

**AIR BALANCE DATA SHEET**

PROJECT NO.: 05/24/21

PROJECT: METRO PORTLAND - 5 THEATERS - PORTLAND, OREGON (KELLER AUDITORIUM)

DATE START: 05/24/21 FINISH: 08/03/21

SYSTEM: SU-9 & SU-10

SECTION:

BY: DN / WN

PAGE: 3 OF 4

Ref	Ins	AREA SERVED			OUTLET			DESIGN		TEST #1		TEST #2		TEST #3		FINAL		Pct
		Rm.#	No.	Size	Blow	AK	Vel	CFM	FPM	CFM	FPM	CFM	FPM	CFM	FPM	CFM		
		<b>KELLER AUDITORIUM</b>																
		<b>EF-12</b>																
	DA			16x16		0.25				300	75							
		<b>EF-8</b>																
	DA			20x18		2.50				729	1823							
		<b>EF-9</b>																
	DG			126x46		40.25				662	26646							
		<b>EF-2</b>																
	DA	0% OSA		20x20		2.78				1230	3419							
	DA	20\$ Min. OSA		20x20		2.78				1214	3375							
	DA	100% OSA		20x20		2.78				890	2474							
		<b>EF-5</b>																
	DG	Fan Intake		96x62		41.33				420	17359							
		<b>EF-6</b>																
	DG	0% OSA		24x54		9.00				801	7209							
	DG	100% OSA		24x54		9.00				723	6507							
3		<b>EF-7</b>																
	DG	0% OSA		16x16		1.78				100	178							
	DG	100% OSA		16x16		1.78				844	1502							
		<b>EF-11</b>																
	DA			28x14		2.72				686	1866							
		<b>EF-10</b>																
3	DA	Fan Disc 100% OSA		35x24		5.67				817	4632							
		<b>EF-1</b>																
	DA	Fan Suction		16x16		1.78				717	1276							
		<b>EF-2</b>																
	DA	100% OSA		20x20		2.78				896	2491							
		<b>EF-4</b>																
	DA	100% OSA		30x30		6.25				High 2105	13156							

Ref. Note: (3) At 0% OSA on SU-7 discharge damper is closed modulates open with OSA command to SU-7.

AIR BALANCING SPECIALTY, INC. 3532 SE Milwaukie Avenue, Portland, Oregon 97202-2751 Phone: (503) 230-2332 Fax: (503) 230-2820

CONSTANT VOLUME - FPM

**AIR BALANCE DATA SHEET**

PROJECT NO.: 05/24/21

PROJECT: METRO PORTLAND - 5 THEATERS - PORTLAND, OREGON (KELLER AUDITORIUM)

DATE START: 05/24/21 FINISH: 8/03/21

SYSTEM: SU-9 & SU-10

SECTION:

BY: DN / WN

PAGE: 4 OF 4



Ref	Ins	AREA SERVED			OUTLET			DESIGN		TEST #1		TEST #2		TEST #3		FINAL		Pct
		Rm.#	No.	Size	Blow	AK	Vel	CFM	FPM	CFM	FPM	CFM	FPM	CFM	FPM	CFM		
<b>HATFIELD HALL</b>																		
<b>ASU-1</b>																		
										<b>PRE-TEST</b>		<b>PRE-TEST</b>		<b>POST-TEST</b>				
										<b>58.2 HZ</b>		<b>60 HZ</b>		<b>60 HZ</b>				
	DG	Fan Total @ filter -0% OSA			100x70		48.61			581	28242	587	28534	564	27416			
	DG	Fan Total @ Minimum			100x70		48.61					591	28729	587	28534			
1	DG	Fan Total @ filter -100% OSA			100x70		48.61			593	28826	605	29409	545	26492			
	DG	OSA @ 0% OSA			79.5x45.5	Plenum	25.12			59	1482	80	2010	21	528			
	DG	OSA @ Low Minimum			79.5x44.5	Plenum	25.12											
	DG	OSA @ High Minimum @ 25%			79.5x44.5	Plenum	25.12			147	3693	140	3517	51	1281			
1	DG	OSA @ 100% OSA			79.5x44.5	Plenum	25.12			946	23764	893	22432	881	22131			
<b>ASU-2</b>																		
	DG	Fan Total @ filter -0% OSA			108x60		44.00			456	20064	372	16368	370	16280			
	DG	Fan Total @ Minimum			108x60		44.00					423	18612	426	18744			
	DG	Fan Total @ filter -100% OSA			108x60		44.00			480	21120	476	20944	451	19844			
2	DG	OSA @ 0% OSA			91.25x31.5	Plenum	19.96			198	3952	193	3852	165	3293			
	DG	OSA @ Low Minimum			91.25x31.5	Plenum	19.96											
	DG	OSA @ High Minimum @ 25%			91.25x31.5	Plenum	19.96			370	7385	358	7146	347	6926			
	DG	OSA @ 100% OSA			91.25x31.5	Plenum	19.96			967	19301	900	17964	885	17665			
<b>ASU-3</b>																		
	DG	Fan Total @ filter -0% OSA			108x72		54.00			<b>HIGH SPEED</b>		<b>HIGH SPEED</b>		<b>HIGH SPEED</b>				
	DG	Fan Total @ Minimum			108x72		54.00			507	27378	490	26460	482	26028			
	DG	Fan Total @ filter -100% OSA			108x72		54.00			657	35478	531	28674	604	32616			
	DG	OSA @ 0% OSA			106.5x33	Plenum	24.41			64	1562	37	903	46	1123			
	DG	OSA @ Low Minimum			106.5x33	Plenum	24.41											
	DG	OSA @ High Minimum @ 25%			106.5x33	Plenum	24.41			338	8251	333	8129	326	7958			
	DG	OSA @ 100% OSA			106.5x33	Plenum	24.41			1181	28828	1060	25875	1187	28975			

Ref. Note: (1) RA damper approximately 10% open when in 100% OSA. (2) Minimum OSA damper closed, primary OSA damper is 15% open.

AIR BALANCING SPECIALTY, INC. 3532 SE Milwaukie Avenue, Portland, Oregon 97202-2751 Phone: (503) 230-2332 Fax: (503) 230-2820

CONSTANT VOLUME - FPM

**AIR BALANCE DATA SHEET**

PROJECT NO.: 05/24/21

PROJECT: METRO PORTLAND - 5 THEATERS - PORTLAND, OREGON (HATFIELD HALL)

DATE START: 05/24/21 FINISH: 07/21/21

SYSTEM: ASU-1, ASU-2 ASU-3

SECTION:

BY: DN / WN

PAGE: 1 OF 4

Ref	Ins	AREA SERVED	Rm.#	No.	OUTLET		Blow	DESIGN		TEST #1		TEST #2		TEST #3		FINAL		Pct
					Size	AK		Vel	CFM	FPM	CFM	FPM	CFM	FPM	CFM	FPM	CFM	
<b>HATFIELD HALL</b>																		
<b>ASU-4 (2 Speed)</b>																		
										<b>PRE-TEST</b>		<b>PRE-TEST</b>		<b>POST-TEST</b>				
										<b>LOW SPEED</b>		<b>HIGH SPEED</b>		<b>HIGH SPEED</b>				
	DG	Fan Total @ filter -0% OSA			84x48	28.00				275	7700	555	15540	563	15764			
	DG	Fan Total @ Minimum			84x48	28.00								604	16912			
	DG	Fan Total @ filter -100% OSA			84x48	28.00						558	15624	600	16800			
3	DG	OSA @ 0% @ dampers			78x28	15.17				63	956	125	1896	91	1380			
	DG	OSA @ Low Min. @ damper																
	DG	OSA @ High Min. @ damper			78x28	15.17						754	11438	336	5097			
	DG	OSA @ 100% @ damper			78x28	15.17								1043	15822			
<b>ASU-5</b>																		
										<b>PRE-TEST</b>		<b>POST-TEST</b>						
	DG	Fan Total @ filter -0% OSA			72x57	28.50				381	10859	363	10346					
	DG	Fan Total @ Minimum			72x57	28.50				439	12512	427	12170					
	DG	Fan Total @ filter -100% OSA			72x57	28.50				397	11315	393	11201					
														0				
	DG	OSA @ 0% @ damper			78x24	13.00				152	1976	160	2080					
	DG	OSA @ Minimum @ damper			78x24	13.00				201	2613	181	2353					
	DG	OSA @ 100% @ damper			78x24	13.00				804	10452	848	11024					
<b>AHU-7</b>																		
	DA	Return - 100% RA			40x14	3.89				1438	5594	1378	5360					
	DA	Minimum OSA - 0% OSA			24x12	2.00				39	78	28	56					
		<b>Fan Total</b>									<b>5672</b>		<b>5416</b>					
	DA	Return - 100% RA			40x14	3.89				1348	5244	1343	5224					
	DA	Minimum OSA - Min OSA			24x12	2.00				261	522	257	514					
		<b>Fan Total</b>									<b>5766</b>		<b>5738</b>					
	DA	Return - 0% RA			40x14	3.89				198	770	197	766					
	DA	Minimum OSA -100% OSA			24x12	2.00				893	1786	896	1792					
		<b>Fan Total</b>									<b>2556</b>		<b>2558</b>					

Ref. Note: (3) Minor leakage of approx. a finger width on both Min. & Max. OSA damper when closed.

AIR BALANCING SPECIALTY, INC. 3532 SE Milwaukie Avenue, Portland, Oregon 97202-2751 Phone: (503) 230-2332 Fax: (503) 230-2820

CONSTANT VOLUME - FPM

**AIR BALANCE DATA SHEET**

PROJECT NO.: 05/24/21

PROJECT: METRO PORTLAND - 5 THEATERS - PORTLAND, OREGON (HATFIELD HALL)

DATE START: 05/24/21 FINISH: 07/21/21

SYSTEM: ASU-4, AHU-5 & AHU-7

SECTION:

BY: DN / WN

PAGE: 2 OF 4

Ref	Ins	AREA SERVED	Rm.#	No.	OUTLET		Blow	DESIGN		TEST #1		TEST #2		TEST #3		FINAL		Pct
					Size	AK		Vel	CFM	FPM	CFM	FPM	CFM	FPM	CFM	FPM	CFM	
<b>HATFIELD HALL</b>																		
<b>ASU-8</b>																		
	DG	Fan Total @ Disc. Trav.-0% OSA			36x28		5.05			1247	6297	363	1833					
	DG	Fan Total @ Disc. Trav. -Minimum			36x28		5.05			1245	6287	427	2156					
	DG	Fan Total @ Disc. Trav. -100% OSA			36x28		5.05			1278	6454	393	1985					
													0					
	DG	OSA @ 0% - OSA Trav.			60x20		8.61			0	0	160	1378					
	DG	OSA @ Minimum - OSA Trav.			60x20		8.61			563	4847	181	1558					
	DG	OSA @ 100% - OSA Trav.			60x20		8.61			1020	8782	848	7301					
<b>ASU-9</b>																		
	DA	Return @ 100%			36x12		3.00			908	2724	(4)						
	DA	OSA @ 0%			40x10		2.78			150	417	(4)						
		<b>Fan Total</b>									<b>3141</b>							
	DA	Return @ Minimum			36x12		3.00			633	1899	(4)						
	DA	OSA @ Minimum			40x10		2.78			480	1334	(4)						
		<b>Fan Total</b>									<b>3233</b>							
	DA	Return @ 0%			36x12		3.00			25	75	(4)						
	DA	OSA @ 100%			40x10		2.78			1016	2824	(4)						
		<b>Fan Total</b>									<b>2899</b>							

Ref. Note: (4) Unit was missing one or more merv 13 filters.

AIR BALANCING SPECIALTY, INC. 3532 SE Milwaukie Avenue, Portland, Oregon 97202-2751 Phone: (503) 230-2332 Fax: (503) 230-2820

CONSTANT VOLUME - FPM

**AIR BALANCE DATA SHEET**

PROJECT NO.: 05/24/21

PROJECT: METRO PORTLAND - 5 THEATERS - PORTLAND, OREGON (HATFIELD HALL)

DATE START: 05/24/21 FINISH: 07/21/21

SYSTEM: ASU-8 & ASU-9

SECTION:

BY: DN / WN

PAGE: 3 OF 4

Ref	Ins	AREA SERVED	Rm.#	No.	OUTLET		Blow	DESIGN		TEST #1		TEST #2		TEST #3		FINAL		Pct	
					Size	AK		Vel	CFM	FPM	CFM	FPM	CFM	FPM	CFM	FPM	CFM		
<b>HATFIELD HALL</b>																			
<b>EF-1 (By ASU-3)</b>																			
	DA				16x22		2.44		2730	927	2262								
<b>EF-2 (By ASU-4)</b>																			
	DA				26x14		2.53		3000	688	1741								
<b>EF-3 (Same level as ASU-5)</b>																			
	DG	Discharge Louver			36x17.5		2.63		1345	389	1023								
<b>EF-4 (Same level as ASU-5)</b>																			
	DG				18x8		1.00		1000	372	372								

AIR BALANCING SPECIALTY, INC. 3532 SE Milwaukie Avenue, Portland, Oregon 97202-2751 Phone: (503) 230-2332 Fax: (503) 230-2820

CONSTANT VOLUME - FPM

**AIR BALANCE DATA SHEET**

PROJECT NO.: 05/24/21

PROJECT: METRO PORTLAND - 5 THEATERS - PORTLAND, OREGON (HATFIELD HALL)

DATE START: 05/24/21 FINISH: 07/21/21

SYSTEM: EF-1, EF-2, EF-3 & EF-4

SECTION:

BY: DN / WN

PAGE: 4 OF 4

Ref	Ins	AREA SERVED	Rm.#	No.	OUTLET		Blow	DESIGN		TEST #1		TEST #2		TEST #3		FINAL		Pct
					Size	AK		Vel	CFM	FPM	CFM	FPM	CFM	FPM	CFM	FPM	CFM	
<b>ARLENE SCHNITZER</b>																		
<b>ASU-1</b>																		
<b>PRE-TEST</b>																		
<b>HIGH SPEED (3)</b>																		
1	DG	Fan Total @ filter -0% OSA			139.5x85		82.34			1096	90245	500	41170					
	DG	Fan Total @ filter -10% OSA			139.5x85		82.34			1093	89998	467	38453					
	DG	Fan Total @ filter -100% OSA			139.5x85		82.34			1082	89092	469	38617					
	DA	Minimum OSA - 0% OSA			108x24		18.00			36	648	19	342					
	DA	Minimum OSA - 10% OSA			108x24		18.00			488	8784	535	9630					
	DA	Minimum OSA -100% OSA			108x24		18.00			530	9540	576	10368					
<b>ASU-2</b>																		
<b>HIGH SPEED (3)</b>																		
1	DG	Fan Total @ filter -0% OSA			117x75		60.94			914	55699	493	30043					
	DG	Fan Total @ filter -10% OSA			117x75		60.94			933	56857	445	27118					
	DG	Fan Total @ filter -100% OSA			117x75		60.94			1061	64657	433	26387					
	DA	Minimum OSA - 0% OSA			72x36		18.00			35	630	7	126					
	DA	Minimum OSA - 10% OSA			72x36		18.00			256	4608	206	3708					
	DA	Minimum OSA -100% OSA			72x36		18.00			351	6318	423	7614					
<b>ASU-3</b>																		
	DG	Fan Total @ filter -0% OSA			58x41		16.51			285	4705	306	5052					
	DG	Fan Total @ filter -10% OSA			58x41		16.51			289	4771	350	5779					
	DG	Fan Total @ filter -100% OSA			58x41		16.51			268	4425	286	4722					
2	DG	Minimum OSA - 0% OSA			15x48	(2)	3.50			115	403	102	357					
2	DG	Minimum OSA - 10% OSA			15x48		3.50			121	424	123	431					
2	DG	Minimum OSA -100% OSA			15x48		3.50			1155	4043	1235	4323					

Ref. Note: (1) No motorized return damper. (2) Screen behind discharge louver is mostly plugged. (3) Fan is operating at a much higher suction pressure (@ filters) than during pre-testing.

AIR BALANCING SPECIALTY, INC. 3532 SE Milwaukie Avenue, Portland, Oregon 97202-2751 Phone: (503) 230-2332 Fax: (503) 230-2820

CONSTANT VOLUME - FPM

**AIR BALANCE DATA SHEET**

PROJECT NO.: 05/24/21

PROJECT: METRO PORTLAND - 5 THEATERS - PORTLAND, OREGON (ARLENE SCHNITZER)

DATE START: 05/24/21 FINISH: 07/20/21

SYSTEM: ASU-1, ASU-2 ASU-3

SECTION:

BY: DN / WN

PAGE: 1 OF 3

Ref	Ins	AREA SERVED	Rm.#	No.	OUTLET		DESIGN			TEST #1		TEST #2		TEST #3		FINAL		Pct
					Size	Blow	AK	Vel	CFM	FPM	CFM	FPM	CFM	FPM	CFM	FPM	CFM	
<b>ARLENE SCHNITZER</b>																		
<b>AHU-4</b>																		
	DG	Fan Total @ filter -0% OSA			62x36		15.50			235	3643	239	3705					
	DG	Fan Total @ filter -10% OSA			62x36		15.50			277	4294	426	6603					
	DG	Fan Total @ filter -100% OSA			62x36		15.50			449	6960	455	7053					
	DG	Minimum OSA - 0% OSA			36x24		6.00			8	48	7	42					
	DG	Minimum OSA - 35% OSA			36x24		6.00			614	3684	606	3636					
	DG	Minimum OSA -100% OSA			36x24		6.00			1034	6204	1081	6486					
<b>AHU-5</b>																		
	DG	Return - 100% RA			24x16		2.67			935	2496	827	2208					
	DG	Minimum OSA - 0% OSA			27x11		2.06			41	84	31	64					
		<b>Fan Total</b>									<b>2580</b>		<b>2272</b>					
	DG	Return - 100% RA			24x16		2.67			614	1639	545	1455					
	DG	Minimum OSA - Min OSA			27x11		2.06			604	1244	576	1187					
		<b>Fan Total</b>									<b>2883</b>		<b>2642</b>					
	DG	Return - 0% RA			24x16		2.67			42	112	25	67					
	DG	Minimum OSA -100% OSA			27x11		2.06			1206	2484	1177	2425					
		<b>Fan Total</b>									<b>2596</b>		<b>2491</b>					
<b>AHU-6</b>																		
<b>HIGH SPEED</b>																		
	DG	Fan Total @ filter -0% OSA			62x36		15.50			453	7022	474	7347					
	DG	Fan Total @ filter -10% OSA			62x36		15.50			506	7843	529	8200					
	DG	Fan Total @ filter -100% OSA			62x36		15.50			679	10525	653	10122					
													0					
	DG	Minimum OSA - 0% OSA			25x45		7.81			70	547	70	547					
	DG	Minimum OSA - 10% OSA			25x45		7.81			244	1906	232	1812					
	DG	Minimum OSA -100% OSA			25x45		7.81			964	7529	941	7349					
<b>RTU-1</b>																		
	DG	@ OSA Intake - 0% OSA			32x11		2.44			86	210	76	185					
	DG	@ OSA Intake - 10% OSA			32x11		2.44			115	281	142	346					
	DG	@ OSA Intake - 100% OSA			32x11		2.44			76	185	723	1764					

AIR BALANCING SPECIALTY, INC. 3532 SE Milwaukie Avenue, Portland, Oregon 97202-2751 Phone: (503) 230-2332 Fax: (503) 230-2820

CONSTANT VOLUME - FPM

**AIR BALANCE DATA SHEET**

PROJECT NO.: 05/24/21

PROJECT: METRO PORTLAND - 5 THEATERS - PORTLAND, OREGON (ARLENE SCHNITZER)

DATE START: 05/24/21 FINISH: 07/20/21

SYSTEM: AHU-4, AHU-5, AHU-6 & RTU-1

SECTION:

BY: DN / WN

PAGE: 2 OF 3

Ref	Ins	AREA SERVED	Rm.#	No.	OUTLET		Blow	DESIGN		TEST #1		TEST #2		TEST #3		FINAL		Pct
					Size	AK		Vel	CFM	FPM	CFM	FPM	CFM	FPM	CFM	FPM	CFM	
<b>ARLENE SCHNITZER</b>																		
<b>EF-1</b>																		
	DA	Main Traverse			44x8		2.44		2265	504	1230							
<b>EF-2</b>																		
	DA	Fan Intake Traverse (Fan Pressures)			28"O		4.27		6045	1316	5619							
<b>EF-3</b>																		
	DA	Toilet			6x6		0.19		700	460	87							
	DA	Control Rm			9"O		0.44			1000	440							
	DA	Control Rm			9"O		0.44			685	301							
<b>Total</b>																		
<b>EF-4</b>																		
	DG	Discharge Backdraft			22x22		2.52			591	1489							
	DG	Discharge with hood			21x23		3.35		7000	673	2255							
<b>Total</b>																		
Meas. RPM 356																		
4	<b>EF-5</b>																	
	DA	Fan Intake Traverse (Fan Pressures)			33"O		5.93			67	397							
<b>EF-7</b>																		
	DG	Discharge Backdraft			9x9		0.42			368	155							
	DG	Discharge Backdraft			9x9		0.42			485	204							
<b>Total</b>																		
Meas. RPM 883																		

Ref. Note: (4) Fan has no suction pressure. Discharge motorized damper was commanded open and closed with no change. Suspect damper is not operating or not tight to damper shaft.

AIR BALANCING SPECIALTY, INC. 3532 SE Milwaukie Avenue, Portland, Oregon 97202-2751 Phone: (503) 230-2332 Fax: (503) 230-2820

CONSTANT VOLUME - FPM

**AIR BALANCE DATA SHEET**

PROJECT NO.: 05/24/21

PROJECT: METRO PORTLAND - 5 THEATERS - PORTLAND, OREGON (ARLENE SCHNITZER)

DATE START: 05/24/21 FINISH: 07/20/21

SYSTEM: EF-1, EF-2, EF-3, EF-4, EF-5 & EF-7

SECTION:

BY: DN / WN

PAGE: 3 OF 3







Report Date: 6/3/2021  
**Microbiological Analyses**



1815 Brownsboro Road., Suite 200  
Louisville, Kentucky 40206  
Phone: 502.893.6080  
Fax: 502.893.6088  
Email: est@estechlab.com  
Web: www.estechlab.com

Company Information  
Watercare Industrial Services, Inc.  
P.O. Box 464  
Washougal, WA 98671

Job Site:

Batch Number: 210527019  
Sampled By: Tom Carroll  
P.O. Number:  
Report Status: Original

Client Sample ID:  
Location: SV9 MCH Sink 711

Lab Sample ID: 285032

Collection Date: 5/26/2021

Receive Date: 5/27/2021

Analyte	Test Code	Media Type	Sample Result	Units	Detection Limit	Analysis Date	Priority
Legionella pneumophila SG1	L011 - Legionella Potable Water	BCYE & GVPC	None Detected	CFU/mL	0.10 CFU/mL	6/3/2021	Standard
Legionella pneumophila SG2-14	L011 - Legionella Potable Water	BCYE & GVPC	None Detected	CFU/mL	0.10 CFU/mL	6/3/2021	Standard
Legionella non-pneumophila	L011 - Legionella Potable Water	BCYE & GVPC	None Detected	CFU/mL	0.10 CFU/mL	6/3/2021	Standard

Client Sample ID:  
Location: 504 Shower C

Lab Sample ID: 285033

Collection Date: 5/26/2021

Receive Date: 5/27/2021

Analyte	Test Code	Media Type	Sample Result	Units	Detection Limit	Analysis Date	Priority
Legionella pneumophila SG1	L011 - Legionella Potable Water	BCYE & GVPC	None Detected	CFU/mL	0.10 CFU/mL	6/3/2021	Standard
Legionella pneumophila SG2-14	L011 - Legionella Potable Water	BCYE & GVPC	None Detected	CFU/mL	0.10 CFU/mL	6/3/2021	Standard
Legionella non-pneumophila	L011 - Legionella Potable Water	BCYE & GVPC	None Detected	CFU/mL	0.10 CFU/mL	6/3/2021	Standard

Client Sample ID:  
Location: 504 Shower H

Lab Sample ID: 285034

Collection Date: 5/26/2021

Receive Date: 5/27/2021

Analyte	Test Code	Media Type	Sample Result	Units	Detection Limit	Analysis Date	Priority
Legionella pneumophila SG1	L011 - Legionella Potable Water	BCYE & GVPC	None Detected	CFU/mL	0.10 CFU/mL	6/3/2021	Standard
Legionella pneumophila SG2-14	L011 - Legionella Potable Water	BCYE & GVPC	None Detected	CFU/mL	0.10 CFU/mL	6/3/2021	Standard
Legionella non-pneumophila	L011 - Legionella Potable Water	BCYE & GVPC	None Detected	CFU/mL	0.10 CFU/mL	6/3/2021	Standard



Client Sample ID:  
Location: Proj 803

Lab Sample ID: 285035

Analyte	Test Code	Media Type	Sample Result	Units	Detection Limit	Analysis Date	Priority
Legionella pneumophila SG1	L011 - Legionella Potable Water	BCYE & GVPC	None Detected	CFU/mL	0.10 CFU/mL	6/3/2021	Standard
Legionella pneumophila SG2-14	L011 - Legionella Potable Water	BCYE & GVPC	None Detected	CFU/mL	0.10 CFU/mL	6/3/2021	Standard
Legionella non-pneumophila	L011 - Legionella Potable Water	BCYE & GVPC	None Detected	CFU/mL	0.10 CFU/mL	6/3/2021	Standard

Client Sample ID: Lab Sample ID: 285036 Collection Date: 5/26/2021 Receive Date: 5/27/2021  
Location: SB 721 C

Analyte	Test Code	Media Type	Sample Result	Units	Detection Limit	Analysis Date	Priority
Legionella pneumophila SG1	L011 - Legionella Potable Water	BCYE & GVPC	None Detected	CFU/mL	0.10 CFU/mL	6/3/2021	Standard
Legionella pneumophila SG2-14	L011 - Legionella Potable Water	BCYE & GVPC	None Detected	CFU/mL	0.10 CFU/mL	6/3/2021	Standard
Legionella non-pneumophila	L011 - Legionella Potable Water	BCYE & GVPC	None Detected	CFU/mL	0.10 CFU/mL	6/3/2021	Standard

Client Sample ID: Lab Sample ID: 285037 Collection Date: 5/26/2021 Receive Date: 5/27/2021  
Location: SB 721 H

Analyte	Test Code	Media Type	Sample Result	Units	Detection Limit	Analysis Date	Priority
Legionella pneumophila SG1	L011 - Legionella Potable Water	BCYE & GVPC	None Detected	CFU/mL	0.10 CFU/mL	6/3/2021	Standard
Legionella pneumophila SG2-14	L011 - Legionella Potable Water	BCYE & GVPC	None Detected	CFU/mL	0.10 CFU/mL	6/3/2021	Standard
Legionella non-pneumophila	L011 - Legionella Potable Water	BCYE & GVPC	None Detected	CFU/mL	0.10 CFU/mL	6/3/2021	Standard

Client Sample ID: Lab Sample ID: 285038 Collection Date: 5/26/2021 Receive Date: 5/27/2021  
Location: SB 704 C

Analyte	Test Code	Media Type	Sample Result	Units	Detection Limit	Analysis Date	Priority
Legionella pneumophila SG1	L011 - Legionella Potable Water	BCYE & GVPC	None Detected	CFU/mL	0.10 CFU/mL	6/3/2021	Standard
Legionella pneumophila SG2-14	L011 - Legionella Potable Water	BCYE & GVPC	None Detected	CFU/mL	0.10 CFU/mL	6/3/2021	Standard
Legionella non-pneumophila	L011 - Legionella Potable Water	BCYE & GVPC	None Detected	CFU/mL	0.10 CFU/mL	6/3/2021	Standard



Client Sample ID:  
Location: SB 704 H

Lab Sample ID: 285039

Analyte	Test Code	Media Type	Sample Result	Units	Detection Limit	Analysis Date	Priority
Legionella pneumophila SG1	L011 - Legionella Potable Water	BCYE & GVPC	None Detected	CFU/mL	0.10 CFU/mL	6/3/2021	Standard
Legionella pneumophila SG2-14	L011 - Legionella Potable Water	BCYE & GVPC	None Detected	CFU/mL	0.10 CFU/mL	6/3/2021	Standard
Legionella non-pneumophila	L011 - Legionella Potable Water	BCYE & GVPC	None Detected	CFU/mL	0.10 CFU/mL	6/3/2021	Standard

Client Sample ID:  
Location: SB Sink 705

Lab Sample ID: 285040

Collection Date: 5/26/2021 Receive Date: 5/27/2021

Analyte	Test Code	Media Type	Sample Result	Units	Detection Limit	Analysis Date	Priority
Legionella pneumophila SG1	L011 - Legionella Potable Water	BCYE & GVPC	None Detected	CFU/mL	0.10 CFU/mL	6/3/2021	Standard
Legionella pneumophila SG2-14	L011 - Legionella Potable Water	BCYE & GVPC	None Detected	CFU/mL	0.10 CFU/mL	6/3/2021	Standard
Legionella non-pneumophila	L011 - Legionella Potable Water	BCYE & GVPC	None Detected	CFU/mL	0.10 CFU/mL	6/3/2021	Standard

Client Sample ID:  
Location: 609 Sink C

Lab Sample ID: 285041

Collection Date: 5/26/2021 Receive Date: 5/27/2021

Analyte	Test Code	Media Type	Sample Result	Units	Detection Limit	Analysis Date	Priority
Legionella pneumophila SG1	L011 - Legionella Potable Water	BCYE & GVPC	None Detected	CFU/mL	0.10 CFU/mL	6/3/2021	Standard
Legionella pneumophila SG2-14	L011 - Legionella Potable Water	BCYE & GVPC	None Detected	CFU/mL	0.10 CFU/mL	6/3/2021	Standard
Legionella non-pneumophila	L011 - Legionella Potable Water	BCYE & GVPC	None Detected	CFU/mL	0.10 CFU/mL	6/3/2021	Standard

Client Sample ID:  
Location: 624 Sink C

Lab Sample ID: 285042

Collection Date: 5/26/2021 Receive Date: 5/27/2021

Analyte	Test Code	Media Type	Sample Result	Units	Detection Limit	Analysis Date	Priority
Legionella pneumophila SG1	L011 - Legionella Potable Water	BCYE & GVPC	None Detected	CFU/mL	0.10 CFU/mL	6/3/2021	Standard
Legionella pneumophila SG2-14	L011 - Legionella Potable Water	BCYE & GVPC	None Detected	CFU/mL	0.10 CFU/mL	6/3/2021	Standard
Legionella non-pneumophila	L011 - Legionella Potable Water	BCYE & GVPC	None Detected	CFU/mL	0.10 CFU/mL	6/3/2021	Standard



Client Sample ID:  
Location: 624 Sink H

Lab Sample ID: 285043

Analyte	Test Code	Media Type	Sample Result	Units	Detection Limit	Analysis Date	Priority
Legionella pneumophila SG1	L011 - Legionella Potable Water	BCYE & GVPC	None Detected	CFU/mL	0.10 CFU/mL	6/3/2021	Standard
Legionella pneumophila SG2-14	L011 - Legionella Potable Water	BCYE & GVPC	None Detected	CFU/mL	0.10 CFU/mL	6/3/2021	Standard
Legionella non-pneumophila	L011 - Legionella Potable Water	BCYE & GVPC	None Detected	CFU/mL	0.10 CFU/mL	6/3/2021	Standard

Client Sample ID:  
Location: 609 Sink H

Lab Sample ID: 285044

Collection Date: 5/26/2021 Receive Date: 5/27/2021

Analyte	Test Code	Media Type	Sample Result	Units	Detection Limit	Analysis Date	Priority
Legionella pneumophila SG1	L011 - Legionella Potable Water	BCYE & GVPC	None Detected	CFU/mL	0.10 CFU/mL	6/3/2021	Standard
Legionella pneumophila SG2-14	L011 - Legionella Potable Water	BCYE & GVPC	None Detected	CFU/mL	0.10 CFU/mL	6/3/2021	Standard
Legionella non-pneumophila	L011 - Legionella Potable Water	BCYE & GVPC	None Detected	CFU/mL	0.10 CFU/mL	6/3/2021	Standard

Client Sample ID:  
Location: 543 Sink C

Lab Sample ID: 285045

Collection Date: 5/26/2021 Receive Date: 5/27/2021

Analyte	Test Code	Media Type	Sample Result	Units	Detection Limit	Analysis Date	Priority
Legionella pneumophila SG1	L011 - Legionella Potable Water	BCYE & GVPC	None Detected	CFU/mL	0.10 CFU/mL	6/3/2021	Standard
Legionella pneumophila SG2-14	L011 - Legionella Potable Water	BCYE & GVPC	None Detected	CFU/mL	0.10 CFU/mL	6/3/2021	Standard
Legionella non-pneumophila	L011 - Legionella Potable Water	BCYE & GVPC	None Detected	CFU/mL	0.10 CFU/mL	6/3/2021	Standard

Client Sample ID:  
Location: 543 Sink H

Lab Sample ID: 285046

Collection Date: 5/26/2021 Receive Date: 5/27/2021

Analyte	Test Code	Media Type	Sample Result	Units	Detection Limit	Analysis Date	Priority
Legionella pneumophila SG1	L011 - Legionella Potable Water	BCYE & GVPC	None Detected	CFU/mL	0.10 CFU/mL	6/3/2021	Standard
Legionella pneumophila SG2-14	L011 - Legionella Potable Water	BCYE & GVPC	None Detected	CFU/mL	0.10 CFU/mL	6/3/2021	Standard
Legionella non-pneumophila	L011 - Legionella Potable Water	BCYE & GVPC	None Detected	CFU/mL	0.10 CFU/mL	6/3/2021	Standard



09/13/2021  
11/10/2021  
Client Sample ID:  
Location: 421 Shower C

Lab Sample ID: 285047

Portland5\_Mechanical\_Report\_for\_Schnitz\_Keller\_Hatfield.pdf  
Collection Date: 5/26/2021 Receive Date: 5/27/2021

Analyte	Test Code	Media Type	Sample Result	Units	Detection Limit	Analysis Date	Priority
Legionella pneumophila SG1	L011 - Legionella Potable Water	BCYE & GVPC	None Detected	CFU/mL	0.10 CFU/mL	6/3/2021	Standard
Legionella pneumophila SG2-14	L011 - Legionella Potable Water	BCYE & GVPC	None Detected	CFU/mL	0.10 CFU/mL	6/3/2021	Standard
Legionella non-pneumophila	L011 - Legionella Potable Water	BCYE & GVPC	None Detected	CFU/mL	0.10 CFU/mL	6/3/2021	Standard

Client Sample ID:  
Location: 421 Shower H

Lab Sample ID: 285048

Collection Date: 5/26/2021 Receive Date: 5/27/2021

Analyte	Test Code	Media Type	Sample Result	Units	Detection Limit	Analysis Date	Priority
Legionella pneumophila SG1	L011 - Legionella Potable Water	BCYE & GVPC	None Detected	CFU/mL	0.10 CFU/mL	6/3/2021	Standard
Legionella pneumophila SG2-14	L011 - Legionella Potable Water	BCYE & GVPC	None Detected	CFU/mL	0.10 CFU/mL	6/3/2021	Standard
Legionella non-pneumophila	L011 - Legionella Potable Water	BCYE & GVPC	None Detected	CFU/mL	0.10 CFU/mL	6/3/2021	Standard

Client Sample ID:  
Location: 23 Shower C

Lab Sample ID: 285049

Collection Date: 5/26/2021 Receive Date: 5/27/2021

Analyte	Test Code	Media Type	Sample Result	Units	Detection Limit	Analysis Date	Priority
Legionella pneumophila SG1	L011 - Legionella Potable Water	BCYE & GVPC	None Detected	CFU/mL	0.10 CFU/mL	6/3/2021	Standard
Legionella pneumophila SG2-14	L011 - Legionella Potable Water	BCYE & GVPC	None Detected	CFU/mL	0.10 CFU/mL	6/3/2021	Standard
Legionella non-pneumophila	L011 - Legionella Potable Water	BCYE & GVPC	None Detected	CFU/mL	0.10 CFU/mL	6/3/2021	Standard

Client Sample ID:  
Location: 23 Shower H

Lab Sample ID: 285050

Collection Date: 5/26/2021 Receive Date: 5/27/2021

Analyte	Test Code	Media Type	Sample Result	Units	Detection Limit	Analysis Date	Priority
Legionella pneumophila SG1	L011 - Legionella Potable Water	BCYE & GVPC	None Detected	CFU/mL	0.10 CFU/mL	6/3/2021	Standard
Legionella pneumophila SG2-14	L011 - Legionella Potable Water	BCYE & GVPC	None Detected	CFU/mL	0.10 CFU/mL	6/3/2021	Standard
Legionella non-pneumophila	L011 - Legionella Potable Water	BCYE & GVPC	None Detected	CFU/mL	0.10 CFU/mL	6/3/2021	Standard



Client Sample ID:  
Location: 708 Sink

Lab Sample ID: 285051

Analyte	Test Code	Media Type	Sample Result	Units	Detection Limit	Analysis Date	Priority
Legionella pneumophila SG1	L011 - Legionella Potable Water	BCYE & GVPC	None Detected	CFU/mL	0.10 CFU/mL	6/3/2021	Standard
Legionella pneumophila SG2-14	L011 - Legionella Potable Water	BCYE & GVPC	None Detected	CFU/mL	0.10 CFU/mL	6/3/2021	Standard
Legionella non-pneumophila	L011 - Legionella Potable Water	BCYE & GVPC	None Detected	CFU/mL	0.10 CFU/mL	6/3/2021	Standard

Client Sample ID:  
Location: 401 Sink C

Lab Sample ID: 285052

Collection Date: 5/26/2021 Receive Date: 5/27/2021

Analyte	Test Code	Media Type	Sample Result	Units	Detection Limit	Analysis Date	Priority
Legionella pneumophila SG1	L011 - Legionella Potable Water	BCYE & GVPC	None Detected	CFU/mL	0.10 CFU/mL	6/3/2021	Standard
Legionella pneumophila SG2-14	L011 - Legionella Potable Water	BCYE & GVPC	None Detected	CFU/mL	0.10 CFU/mL	6/3/2021	Standard
Legionella non-pneumophila	L011 - Legionella Potable Water	BCYE & GVPC	None Detected	CFU/mL	0.10 CFU/mL	6/3/2021	Standard

Client Sample ID:  
Location: 401 Sink H

Lab Sample ID: 285053

Collection Date: 5/26/2021 Receive Date: 5/27/2021

Analyte	Test Code	Media Type	Sample Result	Units	Detection Limit	Analysis Date	Priority
Legionella pneumophila SG1	L011 - Legionella Potable Water	BCYE & GVPC	None Detected	CFU/mL	0.10 CFU/mL	6/3/2021	Standard
Legionella pneumophila SG2-14	L011 - Legionella Potable Water	BCYE & GVPC	None Detected	CFU/mL	0.10 CFU/mL	6/3/2021	Standard
Legionella non-pneumophila	L011 - Legionella Potable Water	BCYE & GVPC	None Detected	CFU/mL	0.10 CFU/mL	6/3/2021	Standard

Client Sample ID:  
Location: 514 Sink C

Lab Sample ID: 285054

Collection Date: 5/26/2021 Receive Date: 5/27/2021

Analyte	Test Code	Media Type	Sample Result	Units	Detection Limit	Analysis Date	Priority
Legionella pneumophila SG1	L011 - Legionella Potable Water	BCYE & GVPC	None Detected	CFU/mL	0.10 CFU/mL	6/3/2021	Standard
Legionella pneumophila SG2-14	L011 - Legionella Potable Water	BCYE & GVPC	None Detected	CFU/mL	0.10 CFU/mL	6/3/2021	Standard
Legionella non-pneumophila	L011 - Legionella Potable Water	BCYE & GVPC	None Detected	CFU/mL	0.10 CFU/mL	6/3/2021	Standard



09/13/2021  
11/10/2021

Client Sample ID:

Location: 514 Sink H

Lab Sample ID: 285055

Portland5\_Mechanical\_Report\_for\_Schnitz\_Keller\_Hatfield.pdf  
Collection Date: 5/26/2021 Receive Date: 5/27/2021

Analyte	Test Code	Media Type	Sample Result	Units	Detection Limit	Analysis Date	Priority
Legionella pneumophila SG1	L011 - Legionella Potable Water	BCYE & GVPC	None Detected	CFU/mL	0.10 CFU/mL	6/3/2021	Standard
Legionella pneumophila SG2-14	L011 - Legionella Potable Water	BCYE & GVPC	None Detected	CFU/mL	0.10 CFU/mL	6/3/2021	Standard
Legionella non-pneumophila	L011 - Legionella Potable Water	BCYE & GVPC	None Detected	CFU/mL	0.10 CFU/mL	6/3/2021	Standard

Client Sample ID:

Location: 332 Shower C

Lab Sample ID: 285056

Collection Date: 5/26/2021 Receive Date: 5/27/2021

Analyte	Test Code	Media Type	Sample Result	Units	Detection Limit	Analysis Date	Priority
Legionella pneumophila SG1	L011 - Legionella Potable Water	BCYE & GVPC	None Detected	CFU/mL	0.10 CFU/mL	6/3/2021	Standard
Legionella pneumophila SG2-14	L011 - Legionella Potable Water	BCYE & GVPC	None Detected	CFU/mL	0.10 CFU/mL	6/3/2021	Standard
Legionella non-pneumophila	L011 - Legionella Potable Water	BCYE & GVPC	None Detected	CFU/mL	0.10 CFU/mL	6/3/2021	Standard

Client Sample ID:

Location: 332 Shower H

Lab Sample ID: 285057

Collection Date: 5/26/2021 Receive Date: 5/27/2021

Analyte	Test Code	Media Type	Sample Result	Units	Detection Limit	Analysis Date	Priority
Legionella pneumophila SG1	L011 - Legionella Potable Water	BCYE & GVPC	None Detected	CFU/mL	0.10 CFU/mL	6/3/2021	Standard
Legionella pneumophila SG2-14	L011 - Legionella Potable Water	BCYE & GVPC	None Detected	CFU/mL	0.10 CFU/mL	6/3/2021	Standard
Legionella non-pneumophila	L011 - Legionella Potable Water	BCYE & GVPC	None Detected	CFU/mL	0.10 CFU/mL	6/3/2021	Standard

Environmental Safety Technologies, Inc.



Richard D. Miller, Ph.D.  
President, Chief Scientific Officer



## Report Notes Applicable to All Analyses

- All samples were received in accordance with recommended transit times as detailed in Environmental Safety Technologies Sample Guidelines located online at [www.estechlab.com](http://www.estechlab.com). Samples received outside of the suggested sample transit times processed with the approval of the customer, with the understanding that transit delay may affect the viability of the sample results.
- Data are not corrected based on results for blank samples. Results relate only to items tested.
- Raw counts (available upon request) are used to calculate test results using all significant figures. Results found at or above the analytical sensitivity are reported to three significant figures; amounts below the analytical sensitivity are listed as None Detected.
- Analytical Sensitivity is defined as the lowest concentration that can be detected by a test method based on the amount or portion of sample analyzed and is reported without rounding. For qualitative samples, results found at or above this level are reported as "Present"; amounts below this limit are reported as "Absent". Scheduled analyses are performed during routine business hours. Otherwise, analyses are completed on the next business day.
- Results apply to samples as received.
- Samples collected by EST's Industrial Hygiene Department are indicated on reports by the suffix, /EST, appearing after the "Sampled By" field. EST is responsible for all the information provided on issued reports unless information is provided by the customer. Chain of Custody (COC) records accompanying samples submitted to laboratory are scanned and included with issued reports; see COC records for traceability of provided information including but not limited to sample collection time, sample rate, transport conditions, sampling media, and lot numbers. If pertinent information needed for sample processing or calculation of reported results is omitted from a COC record, customers are contacted for verification and information is recorded on the submitted COC record or a proxy COC record if one has not been provided.

## Abbreviations

- Media Types : ACN = Acinetobacter CHROMagar™, BART = Biological Activity Reaction Test, BCSA = *Burkholderia cepacia* Selective Agar, BCYE = Buffered Charcoal Yeast Extract Agar, Cetrimide = *Pseudomonas aeruginosa* Selective Agar, GVPC = BCYE Selective Agar with antibiotics (Glycine, Vancomycin, Polymyxin, and Cycloheximide), Leeds = Leeds Acinetobacter Medium, ME\* = Malt Extract with 0.01% Chloramphenicol, R2A = Reasoner's 2A Agar, SMA = Standard Methods Agar (a.k.a. Plate Count Agar), SSA = Stenotrophomonas Selective Agar, TSA = Tryptic Soy Agar, TSA\* = Tryptic Soy Agar with 0.005% Cycloheximide, TSLT = Tryptic Soy Agar Contact Plate with Lecithin and Tween 80, 7H11S = Middlebrook 7H11 Selective Agar.
- Units: C= Celsius, CFU = Colony Forming Unit, F = Fahrenheit, g = gram, L = liter, m = meter, ml = milliliter, SG = serogroup, N/A = Not Applicable, N/R = Not Requested.
- Miscellaneous: AIHA-LAP, LLC = American Industrial Hygiene Association - Laboratory Accreditation Program, Limited Liability Company, EMLAP = Environmental Microbiology Laboratory Accreditation Program (ISO/IEC 17025:2017), ELITE = Environmental *Legionella* Isolation Techniques Evaluation Program, HPC = Heterotrophic Plate Count, N/A = Not Applicable, N/R = Not Requested.

## Bacteria – Standard Heterotrophic Plate Counts for Water Samples

- Test Codes: B010 (Aerobic), B011 (Anaerobic)
- Total viable heterotrophic plate bacteria counts are obtained using the spread plate method.
- Samples are routinely processed on SMA under aerobic conditions at 35°C for 2-4 days or anaerobically at 35°C for 2-4 days using BD GasPak™ EZ Anaerobic Gas Generating Systems.

## Bacteria – Plate Counts for Air, Swab, Bulk-Solid, and Contact Plates

- Test Codes: B002 (Air), B004 (Swab), B007 (Bulk-solid), B027 (Contact)
- Plate counts are routinely obtained utilizing SMA agar plates for air, swab, and bulk-solid samples as described above.
- Other agars may be utilized upon customer request (e.g. TSA plates incubated for 3-5 days at 35°C or R2A plates incubated for 5-7 days at 30°C).
- Bacteria plate counts are obtained for bulk-liquid and bulk-solid samples using the spread plate method.
- Surface contact plates (e.g. TSLT) are incubated directly at room temperature for 3-5 days unless otherwise requested and noted.
- Anaerobic plate counts are obtained using BD GasPak™ EZ Anaerobic Gas Generating Systems.

## Legionella Culture Analysis

- Test Codes: Non-potable L001 (Bulk-Liquid/Water), L002 (Swab), L003 (Bulk-Solid), L099 (Air)
- Test Codes: Potable L011 (Bulk-Liquid/Water), L012 (Swab), L013 (Bulk-Solid)
- Total Viable *Legionella*: Viable *Legionella* counts (*Legionella pneumophila* SG1, *Legionella pneumophila* SG2-14, or *Legionella non-pneumophila* species) are obtained using an in-house modified method based on CDC and ISO 11731:2017(E) procedures for the recovery of *Legionella* from the environment. *Legionella non-pneumophila* species include *L. anisa*, *L. bozemanii* 1 & 2, *L. dumoffii*, *L. feelei*, *L. gormanii*, *L. jordanis*, *L. longbeachae* 1 & 2, and *L. micdadei*.





## Microbial Corrosion Screen (Water, Solid/Sludge, or Swab)

- Test Codes and Organisms: Acid Producing Bacteria (M001, M011, M021), Denitrifying Bacteria (M002, M012, M022), Iron Related Bacteria (M003, M013, M023), Slime Forming Bacteria (M004, M014, M024), Sulfate Reducing Bacteria (M005, M015, M025), Fluorescent Pseudomonads (M006, M016, M026), Nitrifying Bacteria (M007, M017, M027) and Algae (M008, M018, M028).
- Daily monitoring of microbial reactions using organism specific BART™ testers (Dryocon Bioconcepts Inc.) enables the semi-quantitative projection of population sizes and associated activities (aggressiveness). Observation durations range from two to nine days at room temperature as specified by each BART™ tester.
- These listed microbial corrosion screen test methods are not covered under AIHA LAP, LLC's scope of accreditation.

## Environmental Pathogen Monitoring - Listeria and Salmonella Immunoassay Tests

- Test Code B041: *Listeria*. Swabs are enriched in indicator broth for enhanced recovery and selection.
- Test Code B041: *Salmonella*. Swabs are enriched in indicator broth for enhanced recovery and selection.
- Test methods AOAC Research Institute approved for monitoring environmental surfaces.

## Pathogen Screen Culture Analysis – Potable Water Samples

- Test Code: PS01/GC10 (Water)
- Pathogen Screen Analyses on selective agar: *Acinetobacter* species, *Burkholderia cepacia*, *Pseudomonas aeruginosa*, *Stenotrophomonas maltophilia*, Rapidly growing non-tuberculosis mycobacteria, Fungal Count (mold and yeast) and Mold Identification (Genus level; common *Aspergillus* species).

## *Pseudomonas aeruginosa* and other *Pseudomonas* species Culture Analysis

- Test Codes: B018 (Water), B019 (Swab); *Pseudomonas aeruginosa* isolation and identification on Cetrimide selective agar incubated for 2-4 days at 41°C.
- Test Codes: B062 (Water), B063 (Swab); *Pseudomonas* species screen on Cetrimide selective agar incubated for 5-7 days at 30°C.

## *Pseudomonas aeruginosa* Screen; Presence/Absence

- Test Codes: B052 (Water), B053 (Swab)
- Presence/Absence using IDEXX™ test reagents for the detection *P. aeruginosa* (Pseudalert®)

## Sewage Contamination Screens

- Tests are applicable for the detection of environmental fecal contamination, not for potable drinking water certification.

### Total Coliform & *E. coli*; Presence/Absence

- Test Codes: B022 (Water), B023 (Swab)
- Presence/Absence using IDEXX™ test reagents for the detection of Total Coliforms and *E. coli* (Colisure®)

### Sewage Screen – *E. coli* & Enterococci; Presence/Absence

- Test Codes: B012 (Water), B013 (Swab)
- Presence/Absence using IDEXX™ test reagents for the detection of *E. coli* (Colisure®)
- Presence/Absence using IDEXX™ test reagents for the detection of Enterococci (Enterolert®).

### Sewage Screen – Enterococci; Presence/Absence

- Test Codes: B024 (Water), B025 (Swab)
- Presence/Absence using IDEXX™ test reagents for the detection of Enterococci (Enterolert®).

Microbiological Analyses Endnotes Revision 1-1





12423 NE Whitaker Way  
Portland, OR 97230  
503-254-1794



**Report Number:** 21-005780/D002.R00  
**Report Date:** 05/28/2021  
**ORELAP#:** OR100028  
**Purchase Order:**  
**Project Name:**  
**Project No:**

**Cover Letter**

Watercare Industries  
P.O. Box 464  
Washougal, WA 98671  
United States of America (USA)

Dear Cathy Elie,

Enclosed please find Columbia Laboratories analytical report for samples received as order number 21-005780 on 05/26/2021 at 14:04. Should you have any questions about this report or any other matter, please do not hesitate to contact us. We are here to help you.

Thank you for allowing Columbia Laboratories to be of service to you, we appreciate your business.

Sincerely,

Derrick Tanner  
General Manager



12423 NE Whitaker Way  
Portland, OR 97230  
503-254-1794



**Report Number:** 21-005780/D002.R00  
**Report Date:** 05/28/2021  
**ORELAP#:** OR100028  
**Purchase Order:**  
**Project Name:**  
**Project No:**

**Sample Results**

**Sample:** 708 Slnk Collected: 5/26/21 12:16 Temp: 15 °C Matrix:  
Lab ID: 21-005780-0001 Received: 5/26/21 14:04 Evidence of Cooling: Y Drinking Water

**Method: SM9223BColilert**

Analyte	Result	Limit	Units	LOQ	Dil.	Batch	Start/Extract	Analyzed	Notes
E. coli	Absent	Absent	/100 mL		1.00	2104706	05/26/21 16:13	05/27/21 16:30	
Total Coliform	Absent		/100 mL		1.00	2104706	05/26/21 16:13	05/27/21 16:30	

**Sample Results**

**Sample:** 401 Sink C Collected: 5/26/21 12:25 Temp: 15 °C Matrix:  
Lab ID: 21-005780-0002 Received: 5/26/21 14:04 Evidence of Cooling: Y Drinking Water

**Method: SM9223BColilert**

Analyte	Result	Limit	Units	LOQ	Dil.	Batch	Start/Extract	Analyzed	Notes
E. coli	Absent	Absent	/100 mL		1.00	2104706	05/26/21 16:13	05/27/21 16:30	
Total Coliform	Absent		/100 mL		1.00	2104706	05/26/21 16:13	05/27/21 16:30	

**Sample Results**

**Sample:** 401 Sink H Collected: 5/26/21 12:27 Temp: 15 °C Matrix:  
Lab ID: 21-005780-0003 Received: 5/26/21 14:04 Evidence of Cooling: Y Drinking Water

**Method: SM9223BColilert**

Analyte	Result	Limit	Units	LOQ	Dil.	Batch	Start/Extract	Analyzed	Notes
E. coli	Absent	Absent	/100 mL		1.00	2104706	05/26/21 16:13	05/27/21 16:30	
Total Coliform	Absent		/100 mL		1.00	2104706	05/26/21 16:13	05/27/21 16:30	

**Sample Results**

**Sample:** 518 Sink C Collected: 5/26/21 12:35 Temp: 15 °C Matrix:  
Lab ID: 21-005780-0004 Received: 5/26/21 14:04 Evidence of Cooling: Y Drinking Water

**Method: SM9223BColilert**

Analyte	Result	Limit	Units	LOQ	Dil.	Batch	Start/Extract	Analyzed	Notes
E. coli	Absent	Absent	/100 mL		1.00	2104706	05/26/21 16:13	05/27/21 16:30	
Total Coliform	Absent		/100 mL		1.00	2104706	05/26/21 16:13	05/27/21 16:30	

*Test results relate only to the parameters tested and to the samples as received by the laboratory. Test results meet all requirements of NELAP and the Columbia Laboratories quality assurance plan unless otherwise noted. This report shall not be reproduced, except in full, without the written consent of this laboratory. Samples will be retained for a maximum of 30 days from the receipt date unless prior arrangements have been made.*



12423 NE Whitaker Way  
Portland, OR 97230  
503-254-1794



**Report Number:** 21-005780/D002.R00  
**Report Date:** 05/28/2021  
**ORELAP#:** OR100028  
**Purchase Order:**  
**Project Name:**  
**Project No:**

**Sample Results**

**Sample:** 514 Sink H Collected: 5/26/21 12:37 Temp: 15 °C Matrix:  
Lab ID: 21-005780-0005 Received: 5/26/21 14:04 Evidence of Cooling: Y Drinking Water

**Method: SM9223BColilert**

Analyte	Result	Limit	Units	LOQ	Dil.	Batch	Start/Extract	Analyzed	Notes
E. coli	Absent	Absent	/100 mL		1.00	2104706	05/26/21 16:13	05/27/21 16:30	
Total Coliform	Absent		/100 mL		1.00	2104706	05/26/21 16:13	05/27/21 16:30	

**Sample Results**

**Sample:** 332 Shower C Collected: 5/26/21 12:41 Temp: 15 °C Matrix:  
Lab ID: 21-005780-0006 Received: 5/26/21 14:04 Evidence of Cooling: Y Drinking Water

**Method: SM9223BColilert**

Analyte	Result	Limit	Units	LOQ	Dil.	Batch	Start/Extract	Analyzed	Notes
E. coli	Absent	Absent	/100 mL		1.00	2104706	05/26/21 16:13	05/27/21 16:30	
Total Coliform	Absent		/100 mL		1.00	2104706	05/26/21 16:13	05/27/21 16:30	

**Sample Results**

**Sample:** 332 Shower H Collected: 5/26/21 12:43 Temp: 15 °C Matrix:  
Lab ID: 21-005780-0007 Received: 5/26/21 14:04 Evidence of Cooling: Y Drinking Water

**Method: SM9223BColilert**

Analyte	Result	Limit	Units	LOQ	Dil.	Batch	Start/Extract	Analyzed	Notes
E. coli	Absent	Absent	/100 mL		1.00	2104706	05/26/21 16:13	05/27/21 16:30	
Total Coliform	Absent		/100 mL		1.00	2104706	05/26/21 16:13	05/27/21 16:30	

**Sample Results**

**Sample:** SU9 MCH Sink 711 Collected: 5/26/21 10:42 Temp: 15 °C Matrix:  
Lab ID: 21-005780-0008 Received: 5/26/21 14:04 Evidence of Cooling: Y Drinking Water

**Method: SM9223BColilert**

Analyte	Result	Limit	Units	LOQ	Dil.	Batch	Start/Extract	Analyzed	Notes
E. coli	Absent	Absent	/100 mL		1.00	2104706	05/26/21 16:13	05/27/21 16:30	
Total Coliform	Absent		/100 mL		1.00	2104706	05/26/21 16:13	05/27/21 16:30	

*Test results relate only to the parameters tested and to the samples as received by the laboratory. Test results meet all requirements of NELAP and the Columbia Laboratories quality assurance plan unless otherwise noted. This report shall not be reproduced, except in full, without the written consent of this laboratory. Samples will be retained for a maximum of 30 days from the receipt date unless prior arrangements have been made.*



12423 NE Whitaker Way  
Portland, OR 97230  
503-254-1794



**Report Number:** 21-005780/D002.R00  
**Report Date:** 05/28/2021  
**ORELAP#:** OR100028  
**Purchase Order:**  
**Project Name:**  
**Project No:**

**Sample Results**

**Sample:** 504 Shower C  
Lab ID: 21-005780-0009  
Collected: 5/26/21 10:47  
Received: 5/26/21 14:04  
Temp: 15 °C  
Evidence of Cooling: Y  
Matrix: Drinking Water

**Method:** SM9223BColilert

Analyte	Result	Limit	Units	LOQ	Dil.	Batch	Start/Extract	Analyzed	Notes
E. coli	Absent	Absent	/100 mL		1.00	2104706	05/26/21 16:13	05/27/21 16:30	
Total Coliform	Absent		/100 mL		1.00	2104706	05/26/21 16:13	05/27/21 16:30	

**Sample Results**

**Sample:** 504 Shower H  
Lab ID: 21-005780-0010  
Collected: 5/26/21 10:47  
Received: 5/26/21 14:04  
Temp: 15 °C  
Evidence of Cooling: Y  
Matrix: Drinking Water

**Method:** SM9223BColilert

Analyte	Result	Limit	Units	LOQ	Dil.	Batch	Start/Extract	Analyzed	Notes
E. coli	Absent	Absent	/100 mL		1.00	2104706	05/26/21 16:13	05/27/21 16:30	
Total Coliform	Absent		/100 mL		1.00	2104706	05/26/21 16:13	05/27/21 16:30	

**Sample Results**

**Sample:** PROJ 803  
Lab ID: 21-005780-0011  
Collected: 5/26/21 11:02  
Received: 5/26/21 14:04  
Temp: 15 °C  
Evidence of Cooling: Y  
Matrix: Drinking Water

**Method:** SM9223BColilert

Analyte	Result	Limit	Units	LOQ	Dil.	Batch	Start/Extract	Analyzed	Notes
E. coli	Absent	Absent	/100 mL		1.00	2104706	05/26/21 16:13	05/27/21 16:30	
Total Coliform	Absent		/100 mL		1.00	2104706	05/26/21 16:13	05/27/21 16:30	

**Sample Results**

**Sample:** SB 721 C  
Lab ID: 21-005780-0012  
Collected: 5/26/21 11:06  
Received: 5/26/21 14:04  
Temp: 15 °C  
Evidence of Cooling: Y  
Matrix: Drinking Water

**Method:** SM9223BColilert

Analyte	Result	Limit	Units	LOQ	Dil.	Batch	Start/Extract	Analyzed	Notes
E. coli	Absent	Absent	/100 mL		1.00	2104706	05/26/21 16:13	05/27/21 16:30	
Total Coliform	Absent		/100 mL		1.00	2104706	05/26/21 16:13	05/27/21 16:30	

*Test results relate only to the parameters tested and to the samples as received by the laboratory. Test results meet all requirements of NELAP and the Columbia Laboratories quality assurance plan unless otherwise noted. This report shall not be reproduced, except in full, without the written consent of this laboratory. Samples will be retained for a maximum of 30 days from the receipt date unless prior arrangements have been made.*



12423 NE Whitaker Way  
Portland, OR 97230  
503-254-1794



**Report Number:** 21-005780/D002.R00  
**Report Date:** 05/28/2021  
**ORELAP#:** OR100028  
**Purchase Order:**  
**Project Name:**  
**Project No:**

**Sample Results**

**Sample:** SB 721 H Collected: 5/26/21 11:08 Temp: 15 °C Matrix:  
Lab ID: 21-005780-0013 Received: 5/26/21 14:04 Evidence of Cooling: Y Drinking Water

**Method:** SM9223BColilert

Analyte	Result	Limit	Units	LOQ	Dil.	Batch	Start/Extract	Analyzed	Notes
E. coli	Absent	Absent	/100 mL		1.00	2104706	05/26/21 16:13	05/27/21 16:30	
Total Coliform	Absent		/100 mL		1.00	2104706	05/26/21 16:13	05/27/21 16:30	

**Sample Results**

**Sample:** SB 704 C Collected: 5/26/21 11:12 Temp: 15 °C Matrix:  
Lab ID: 21-005780-0014 Received: 5/26/21 14:04 Evidence of Cooling: Y Drinking Water

**Method:** SM9223BColilert

Analyte	Result	Limit	Units	LOQ	Dil.	Batch	Start/Extract	Analyzed	Notes
E. coli	Absent	Absent	/100 mL		1.00	2104706	05/26/21 16:13	05/27/21 16:30	
Total Coliform	Absent		/100 mL		1.00	2104706	05/26/21 16:13	05/27/21 16:30	

**Sample Results**

**Sample:** SB 704 H Collected: 5/26/21 11:14 Temp: 15 °C Matrix:  
Lab ID: 21-005780-0015 Received: 5/26/21 14:04 Evidence of Cooling: Y Drinking Water

**Method:** SM9223BColilert

Analyte	Result	Limit	Units	LOQ	Dil.	Batch	Start/Extract	Analyzed	Notes
E. coli	Absent	Absent	/100 mL		1.00	2104706	05/26/21 16:13	05/27/21 16:30	
Total Coliform	Absent		/100 mL		1.00	2104706	05/26/21 16:13	05/27/21 16:30	

**Sample Results**

**Sample:** SB Sink 705 Collected: 5/26/21 11:16 Temp: 15 °C Matrix:  
Lab ID: 21-005780-0016 Received: 5/26/21 14:04 Evidence of Cooling: Y Drinking Water

**Method:** SM9223BColilert

Analyte	Result	Limit	Units	LOQ	Dil.	Batch	Start/Extract	Analyzed	Notes
E. coli	Absent	Absent	/100 mL		1.00	2104706	05/26/21 16:13	05/27/21 16:30	
Total Coliform	Absent		/100 mL		1.00	2104706	05/26/21 16:13	05/27/21 16:30	

*Test results relate only to the parameters tested and to the samples as received by the laboratory. Test results meet all requirements of NELAP and the Columbia Laboratories quality assurance plan unless otherwise noted. This report shall not be reproduced, except in full, without the written consent of this laboratory. Samples will be retained for a maximum of 30 days from the receipt date unless prior arrangements have been made.*



12423 NE Whitaker Way  
Portland, OR 97230  
503-254-1794



**Report Number:** 21-005780/D002.R00  
**Report Date:** 05/28/2021  
**ORELAP#:** OR100028  
**Purchase Order:**  
**Project Name:**  
**Project No:**

**Sample Results**

**Sample:** 609 Sink C Collected: 5/26/21 11:39 Temp: 15 °C Matrix:  
Lab ID: 21-005780-0017 Received: 5/26/21 14:04 Evidence of Cooling: Y Drinking Water

**Method: SM9223BColilert**

Analyte	Result	Limit	Units	LOQ	Dil.	Batch	Start/Extract	Analyzed	Notes
E. coli	Absent	Absent	/100 mL		1.00	2104706	05/26/21 16:13	05/27/21 16:30	
Total Coliform	Absent		/100 mL		1.00	2104706	05/26/21 16:13	05/27/21 16:30	

**Sample Results**

**Sample:** 624 Sink C Collected: 5/26/21 11:42 Temp: 15 °C Matrix:  
Lab ID: 21-005780-0018 Received: 5/26/21 14:04 Evidence of Cooling: Y Drinking Water

**Method: SM9223BColilert**

Analyte	Result	Limit	Units	LOQ	Dil.	Batch	Start/Extract	Analyzed	Notes
E. coli	Absent	Absent	/100 mL		1.00	2104706	05/26/21 16:13	05/27/21 16:30	
Total Coliform	Absent		/100 mL		1.00	2104706	05/26/21 16:13	05/27/21 16:30	

**Sample Results**

**Sample:** 624 Sink H Collected: 5/26/21 11:45 Temp: 15 °C Matrix:  
Lab ID: 21-005780-0019 Received: 5/26/21 14:04 Evidence of Cooling: Y Drinking Water

**Method: SM9223BColilert**

Analyte	Result	Limit	Units	LOQ	Dil.	Batch	Start/Extract	Analyzed	Notes
E. coli	Absent	Absent	/100 mL		1.00	2104706	05/26/21 16:13	05/27/21 16:30	
Total Coliform	Absent		/100 mL		1.00	2104706	05/26/21 16:13	05/27/21 16:30	

**Sample Results**

**Sample:** 609 Sink H Collected: 5/26/21 11:47 Temp: 15 °C Matrix:  
Lab ID: 21-005780-0020 Received: 5/26/21 14:04 Evidence of Cooling: Y Drinking Water

**Method: SM9223BColilert**

Analyte	Result	Limit	Units	LOQ	Dil.	Batch	Start/Extract	Analyzed	Notes
E. coli	Absent	Absent	/100 mL		1.00	2104706	05/26/21 16:13	05/27/21 16:30	
Total Coliform	Absent		/100 mL		1.00	2104706	05/26/21 16:13	05/27/21 16:30	

*Test results relate only to the parameters tested and to the samples as received by the laboratory. Test results meet all requirements of NELAP and the Columbia Laboratories quality assurance plan unless otherwise noted. This report shall not be reproduced, except in full, without the written consent of this laboratory. Samples will be retained for a maximum of 30 days from the receipt date unless prior arrangements have been made.*



12423 NE Whitaker Way  
Portland, OR 97230  
503-254-1794



**Report Number:** 21-005780/D002.R00  
**Report Date:** 05/28/2021  
**ORELAP#:** OR100028  
**Purchase Order:**  
**Project Name:**  
**Project No:**

**Sample Results**

**Sample:** 543 Sink C      Collected: 5/26/21 11:52      Temp: 15 °C      Matrix:  
Lab ID: 21-005780-0021      Received: 5/26/21 14:04      Evidence of Cooling: Y      Drinking Water

**Method: SM9223BColilert**

Analyte	Result	Limit	Units	LOQ	Dil.	Batch	Start/Extract	Analyzed	Notes
E. coli	Absent	Absent	/100 mL		1.00	2104706	05/26/21 16:13	05/27/21 16:30	
Total Coliform	Absent		/100 mL		1.00	2104706	05/26/21 16:13	05/27/21 16:30	

**Sample Results**

**Sample:** 543 Sink H      Collected: 5/26/21 11:55      Temp: 15 °C      Matrix:  
Lab ID: 21-005780-0022      Received: 5/26/21 14:04      Evidence of Cooling: Y      Drinking Water

**Method: SM9223BColilert**

Analyte	Result	Limit	Units	LOQ	Dil.	Batch	Start/Extract	Analyzed	Notes
E. coli	Absent	Absent	/100 mL		1.00	2104706	05/26/21 16:13	05/27/21 16:30	
Total Coliform	Absent		/100 mL		1.00	2104706	05/26/21 16:13	05/27/21 16:30	

**Sample Results**

**Sample:** 421 Shower C      Collected: 5/26/21 11:59      Temp: 15 °C      Matrix:  
Lab ID: 21-005780-0023      Received: 5/26/21 14:04      Evidence of Cooling: Y      Drinking Water

**Method: SM9223BColilert**

Analyte	Result	Limit	Units	LOQ	Dil.	Batch	Start/Extract	Analyzed	Notes
E. coli	Absent	Absent	/100 mL		1.00	2104706	05/26/21 16:13	05/27/21 16:30	
Total Coliform	Absent		/100 mL		1.00	2104706	05/26/21 16:13	05/27/21 16:30	

**Sample Results**

**Sample:** 23 Shower C      Collected: 5/26/21 12:04      Temp: 15 °C      Matrix:  
Lab ID: 21-005780-0024      Received: 5/26/21 14:04      Evidence of Cooling: Y      Drinking Water

**Method: SM9223BColilert**

Analyte	Result	Limit	Units	LOQ	Dil.	Batch	Start/Extract	Analyzed	Notes
E. coli	Absent	Absent	/100 mL		1.00	2104706	05/26/21 16:13	05/27/21 16:30	
Total Coliform	Absent		/100 mL		1.00	2104706	05/26/21 16:13	05/27/21 16:30	

*Test results relate only to the parameters tested and to the samples as received by the laboratory. Test results meet all requirements of NELAP and the Columbia Laboratories quality assurance plan unless otherwise noted. This report shall not be reproduced, except in full, without the written consent of this laboratory. Samples will be retained for a maximum of 30 days from the receipt date unless prior arrangements have been made.*





12423 NE Whitaker Way  
Portland, OR 97230  
503-254-1794



**Report Number:** 21-005780/D002.R00  
**Report Date:** 05/28/2021  
**ORELAP#:** OR100028  
**Purchase Order:**  
**Project Name:**  
**Project No:**

**Sample Results**

**Sample:** 23 Shower H      Collected: 5/26/21 12:05      Temp: 15 °C      Matrix:  
Lab ID: 21-005780-0025      Received: 5/26/21 14:04      Evidence of Cooling: Y      Drinking Water

**Method: SM9223BColilert**

Analyte	Result	Limit	Units	LOQ	Dil.	Batch	Start/Extract	Analyzed	Notes
E. coli	Absent	Absent	/100 mL		1.00	2104706	05/26/21 16:13	05/27/21 16:30	
Total Coliform	Absent		/100 mL		1.00	2104706	05/26/21 16:13	05/27/21 16:30	

**Sample Results**

**Sample:** 421 Shower H      Collected: 5/26/21 12:02      Temp: 15 °C      Matrix:  
Lab ID: 21-005780-0026      Received: 5/26/21 14:04      Evidence of Cooling: Y      Drinking Water

**Method: SM9223BColilert**

Analyte	Result	Limit	Units	LOQ	Dil.	Batch	Start/Extract	Analyzed	Notes
E. coli	Absent	Absent	/100 mL		1.00	2104706	05/26/21 16:13	05/27/21 16:30	
Total Coliform	Absent		/100 mL		1.00	2104706	05/26/21 16:13	05/27/21 16:30	


**Units of Measure**

/100 mL = per 100 milliliter


**Abbreviations**

LOQ Limit of quantification

*Test results relate only to the parameters tested and to the samples as received by the laboratory. Test results meet all requirements of NELAP and the Columbia Laboratories quality assurance plan unless otherwise noted. This report shall not be reproduced, except in full, without the written consent of this laboratory. Samples will be retained for a maximum of 30 days from the receipt date unless prior arrangements have been made.*

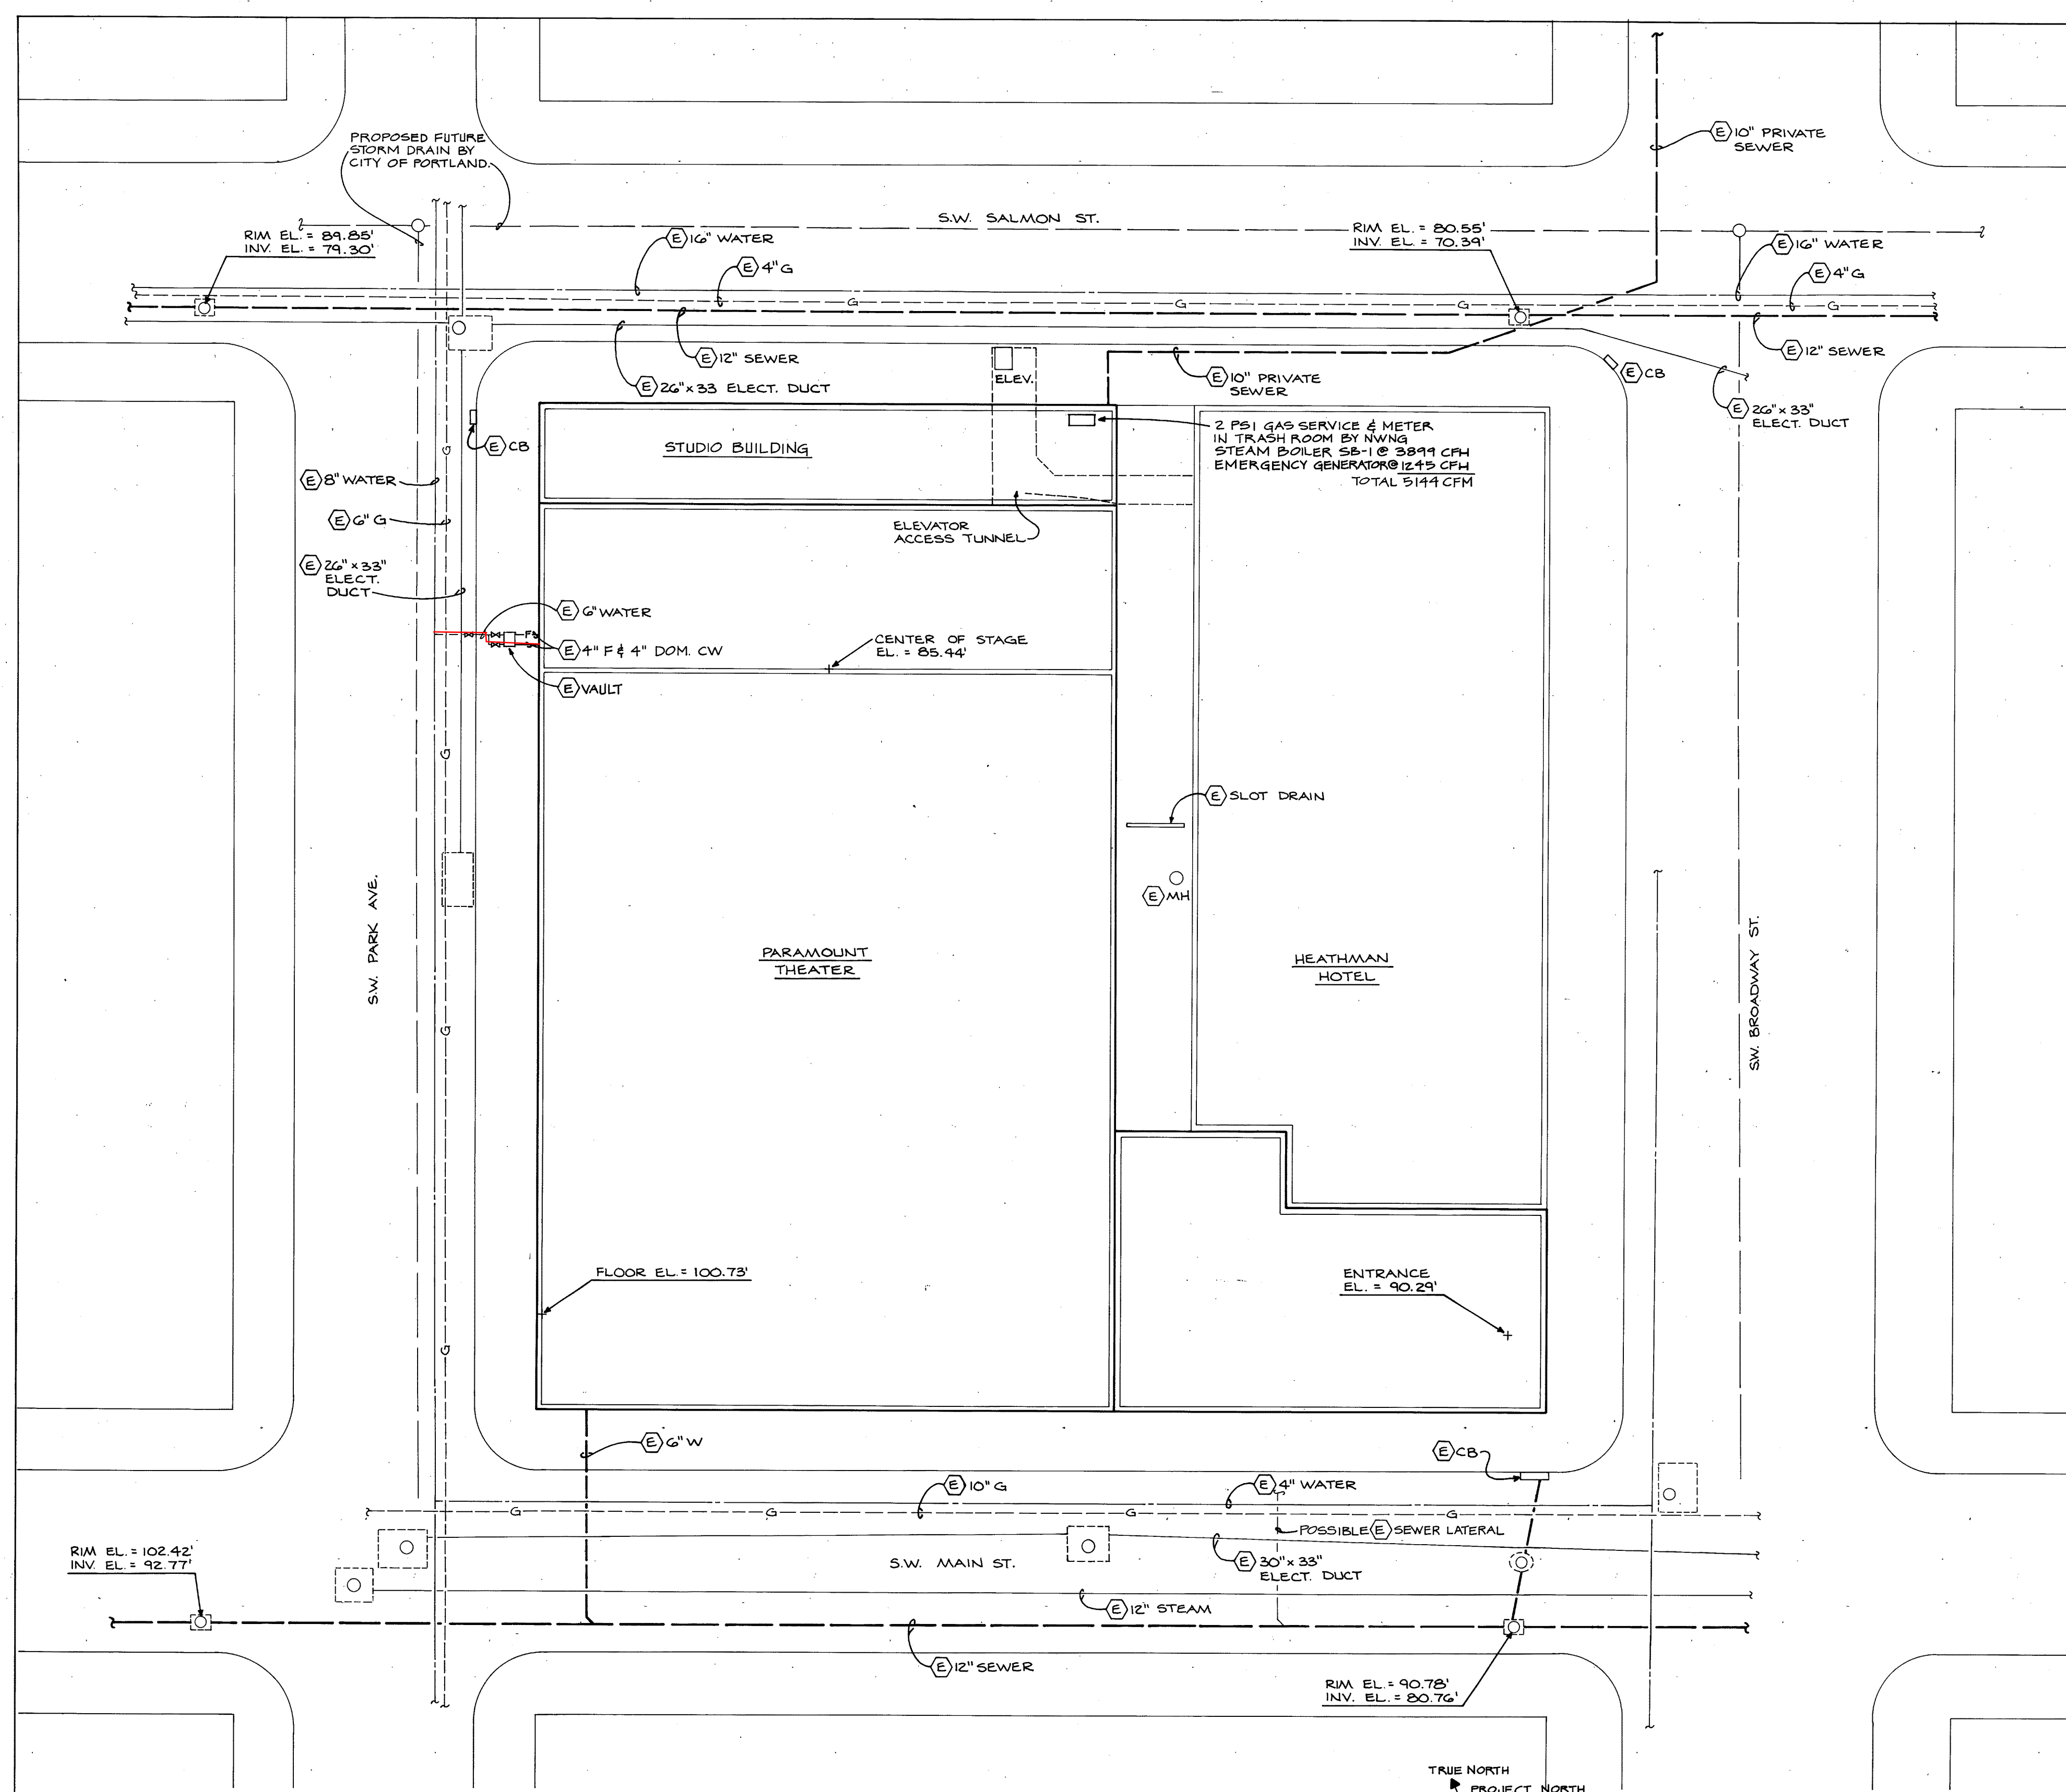

**MECHANICAL SITE PLAN**  
1"=20'-0"

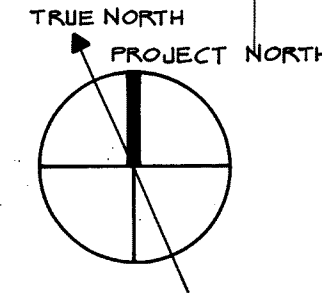

**GENERAL NOTES**

1. INFORMATION PERTAINING TO EXISTING HVAC EQUIPMENT, FIRE PROTECTION, AND PLUMBING PIPING, FIXTURES, ITEMS, ETC., SHOWN ON THESE DRAWINGS HAS BEEN TAKEN FROM C.W. & GEO. L. RAPP DRAWINGS DATED JAN. 29, 1927, AND SEVERAL SUPPLEMENT DRAWINGS, ALSO SOME FIELD INVESTIGATION.
2. THESE DRAWINGS DO NOT INDICATE ACCURATE PIPE ROUTING IN ALL AREAS. SOME CONCEALED DUCT AND PIPING RUNS & OTHER NON-VISIBLE ITEMS HAVE BEEN SHOWN IN AN ASSUMED LOCATION BUT NOT VERIFIED. THE CONTRACTOR WILL BE RESPONSIBLE FOR FIELD LOCATING ALL POINTS OF CONNECTION.
3. PRIOR TO INSTALLATION OF ANY NEW PIPING, CONTRACTOR SHALL EXPOSE ALL POINTS OF CONNECTION AND VERIFY EXACT SIZE, LOCATION, CONDITION, ELEVATION, & TYPE OF MATERIAL. HE SHALL DETERMINE THAT THE EXISTING PIPE IS THE CORRECT SIZE & THAT THE ELEVATION IS LOW ENOUGH TO ACHIEVE THE REQUIRED SLOPE BEFORE NEW PIPING IS CONNECTED; IF NOT, HE SHALL NOTIFY ARCHITECT AND NOT PROCEED WITH INSTALLATION UNTIL INSTRUCTED TO DO SO. SEE SPECIFICATIONS FOR PIPE TESTS AND CLEANING.
4. ALL EXISTING DUCTS AND PIPING WHICH ARE NO LONGER REQUIRED AND WHICH INTERFERE WITH CONSTRUCTION OR WILL BE EXPOSED SHALL BE REMOVED AND BE DISPOSED OF AS DIRECTED BY THE OWNER. IF IT IS CONCEALED AND/OR DOES NOT INTERFERE WITH CONSTRUCTION, IT MAY BE CAPPED AND ABANDONED IN PLACE. SEE SPECIFICATIONS. CAP ALL PIPING AS CLOSE TO MAIN AS POSSIBLE TO ELIMINATE DEAD END RUNS. LIMIT ALL NEW & EXISTING CAPPED DEAD END RUNS TO 2'-0" MAXIMUM FOR ALL SERVICES EXCEPT INACCESSIBLE BELOW GRADE WASTE PIPING.
5. ALL EXISTING MECHANICAL EQUIPMENT, FIRE PROTECTION ITEMS, PLUMBING FIXTURES, & APPURTENANCES WHICH ARE REMOVED AND NOT RELOCATED SHALL BE TURNED OVER TO THE OWNER. SEE SPECIFICATIONS & NOTE 9.
6. ALL EXISTING MECHANICAL EQUIPMENT, PLUMBING, AND FIRE PROTECTION ITEMS & APPURTENANCES WHICH ARE TO BE RELOCATED UNDER THIS CONTRACT SHALL BE COMPLETELY CLEANED AND INSPECTED. IF REPAIR IS REQUIRED TO PUT THEM IN A SATISFACTORY WORKING CONDITION, NOTIFY OWNER BEFORE REINSTALLING.
7. ALL INVERT ELEVATIONS, PIPE SIZES, LOCATIONS, AND DEVIATIONS FROM CONTRACT DRAWINGS, INCLUDING EXISTING, SHALL BE RECORDED ON AS-BUILT DRAWINGS.
8. ALL END OF PIPING RUN LAVATORIES, SINKS, AND DRINKING FOUNTAINS SHALL HAVE A WALL CLEANOUT BELOW FIXTURE.
9. REMOVE EXISTING FIXTURES, EQUIPMENT, AND ALL LOCAL RELATED PIPING, FITTINGS, AND APPURTENANCES WHERE INDICATED AND AS REQUIRED. CAP ALL SERVICE PIPING IN A CONCEALED LOCATION. SEE NOTE 4.
10. REFER TO ARCHITECTURAL DOCUMENTS FOR EXACT LOCATION AND HEIGHT OF ALL PLUMBING FIXTURES. COORDINATE WITH ALL OTHER TRADES.
11. PRIOR TO DISCONNECTING, REMOVING, OR CAPPING ANY EXISTING SERVICES, VERIFY THAT THEY DO NOT SERVE ANY EXISTING FIXTURES OR EQUIPMENT. IF THEY DO, LEAVE SYSTEM INTACT OR WHERE POSSIBLE AND/OR TO SIMPLIFY OR CLEAN UP SYSTEM, CONNECT TO CLOSEST NEW SERVICES. RECORD ON AS-BUILT DRAWINGS.
12. PROVIDE & INSTALL SHUTOFF VALVES ON ALL BRANCH WATER PIPING SERVING FIXTURES AND/OR GROUPS OF FIXTURES OR EQUIPMENT. INSTALL IN LIFTOUT CEILING WHERE POSSIBLE, BEHIND CEILING OR WALL ACCESS PANELS WHERE LIFTOUT CEILING IS NOT AVAILABLE OR AS INDICATED ON THE DRAWINGS. COORDINATE WITH ARCHITECTURAL AND ALL OTHER TRADES.
13. BECAUSE OF THE SMALL SCALE OF THE DRAWINGS, IT IS NOT POSSIBLE TO INDICATE ALL OFFSETS, FITTINGS, VALVES, AND ACCESSORIES WHICH MAY BE REQUIRED. THE CONTRACTOR SHALL CAREFULLY INVESTIGATE THE CONDITIONS SURROUNDING THE INSTALLATION OF HIS WORK AND SHALL FURNISH THE NECESSARY FITTINGS, VALVES, TRAPS, ETC., WHICH MAY BE REQUIRED TO COMPLETE THE INSTALLATION IN A SATISFACTORY AND CODE APPROVED MANNER.
14. WHERE BRANCH PIPE SIZE IS NOT SHOWN ON DRAWINGS, REFER TO FIXTURE ROUGH-IN SCHEDULE FOR REQUIRED PIPE SIZE.
15. IF ANY EXISTING RISERS OR SERVICE PIPING STILL REQUIRED TO REMAIN IN SERVICE AND WHICH INTERFERES WITH NEW CONSTRUCTION IS ENCOUNTERED DURING REMODEL WORK, THE CONTRACTOR SHALL RELOCATE TO THE NEAREST ACCEPTABLE LOCATION AND RECONNECT.
16. ALL ORIGINAL INSULATION IS ASSUMED TO BE ASBESTOS TYPE. SEE SPECIFICATIONS FOR SPECIAL CONDITIONS SURROUNDING ITS HANDLING.
17. THE RECORD DRAWINGS DO NOT INDICATE THE RAIN DRAIN/STORM DRAIN ROUTING FROM BASEMENT RISER LOCATIONS TO OUTSIDE OF BUILDING. THE CONTRACTOR SHALL FIELD INVESTIGATE AND WHERE POSSIBLE, DETERMINE WHERE RAIN DRAINS EXIT BUILDING AND RECORD ON AS-BUILT DRAWINGS. IF IT IS FOUND THAT ANY RAIN DRAINS CONNECT TO SANITARY SEWER EITHER WITHIN OR OUTSIDE BUILDING, HE SHALL REPORT THIS INFORMATION TO THE ARCHITECT AND ENGINEER.
18. A NEW CODE APPROVED VALVE, RACK, HOSE, NOZZLE, AND APPURTENANCES SHALL BE INSTALLED IN ALL EXISTING FIRE HOSE CABINETS TO BE RELOCATED OR TO REMAIN.
19. ALL FIRE SPRINKLER HEADS HAVE NOT BEEN SHOWN OR SCHEDULED. IT IS THE RESPONSIBILITY OF THE CONTRACTOR TO LOCATE AND INSTALL A COMPLETE FIRE SPRINKLER SYSTEM IN ALL PORTIONS OF THE BUILDING EXCEPT AUDITORIUM AND OTHER AREAS THE FIRE MARSHAL HAS EXEMPTED.
20. ALL FIRE PROTECTION WITHIN THE BUILDING WHICH IS SERVED BY THE DOMESTIC WATER SERVICE INCLUDING REMOVING EXISTING FIRE HOSE CABINETS SHALL BE THE RESPONSIBILITY OF THE PLUMBING CONTRACTOR.
21. WHERE NEW OR RELOCATED DIFFUSERS OR GRILLES ARE SHOWN, REFER TO ARCHITECTURAL CEILING PLANS & ELEVATIONS FOR THEIR EXACT LOCATION.
22. ALL ELEVATIONS SHOWN ON THESE DRAWINGS MAY BE APPROXIMATE, SEE ARCHITECTURAL DRAWING FOR ACTUAL ELEVATIONS.

**LEGEND**

<p>LPS LPR HWS HWR CWS CMR CLW CRW RRV RL RS CD W M SD SD OSD V CW PCW HW RHW F FS DP WSP CSP MG G V(G)</p> <p>REMOVE EXISTING PIPING OR ABANDON IN PLACE</p> <p>OS&amp;Y OS&amp;Y/TS GV GLV BV GC CKV BFV BAL FCV MV MV MV PRV RV WH DV HB AV VB WHA STR FS PTT CTG FCO WCO CO TPV GPR</p> <p>FLD FLD FLD FLD</p>	<p>LPS LOW PRESSURE STEAM SUPPLY LPR LOW PRESSURE CONDENSATE RETURN HWS HEATING WATER SUPPLY HWR HEATING WATER RETURN CWS CHILLED WATER SUPPLY CMR CHILLED WATER RETURN CLW CONDENSER LEAVING WATER CRW CONDENSER RETURN WATER RRV REFRIGERANT RELIEF VENT RL REFRIGERANT LIQUID RS REFRIGERANT SUCTION CD CONDENSATE DRAIN W SANITARY SOIL OR WASTE ABOVE FLOOR M SANITARY SOIL OR WASTE BELOW FLOOR OR GRADE SD STORM DRAIN ABOVE FLOOR SD STORM DRAIN BELOW FLOOR OR GRADE OSD OVERFLOW STORM DRAIN ABOVE FLOOR V VENT CW COLD WATER PCW PROCESS COLD WATER HW HOT WATER RHW RECIRCULATED HOT WATER F FIRE PROTECTION (WET) FS FIRE PROTECTION (SPRINKLER FROM FCS) DP FIRE PROTECTION (DRY) WSP WET STANDPIPE (CLASS II FROM DOMESTIC WATER) CSP COMBINATION STANDPIPE MG NATURAL GAS (MEDIUM PRESSURE - 2 PSI) G NATURAL GAS (LOW PRESSURE - 1/2" W.C.) V(G) VENT (GAS)</p> <p>OS&amp;Y OUTSIDE SCREW AND YOKE VALVE OS&amp;Y/TS OS&amp;Y VALVE WITH TAMPER SWITCH GV GATE VALVE GLV GLOBE VALVE BV BALL VALVE GC GAS COCK CKV CHECK VALVE BFV BUTTERFLY VALVE BAL BALANCING FITTING FCV FLOW CONTROL VALVE MV TWO-WAY MOTORIZED VALVE MV THREE-WAY MOTORIZED VALVE MV MOTORIZED BUTTERFLY VALVE PRV PRESSURE REDUCING VALVE RV PRESSURE RELIEF VALVE WH WALL HYDRANT DV HOSE END DRAIN VALVE HB HOSE BIBB AV AIR VENT VB VACUUM BREAKER WHA WATER HAMMER ARRESTOR (SIZE C) STR STRAINER WITH HOSE END DRAIN VALVE FS PIPE ANCHOR PTT FLEXIBLE CONNECTOR CTG UNION, FLANGE FCO PIPE REDUCER WCO SPRINKLER HEAD - UPRIGHT, PENDENT, RECESSED &amp; FLUSH CO SPRINKLER HEAD - SIDEWALL &amp; PENDENT SIDEWALL TPV PRESSURE GAGE WITH GAGE COCK GPR GAGE COCK FS THERMOMETER PTT FLOW SWITCH CTG IMMERSION THERMOSTAT FCO PITCHED DOWN WCO PRESSURE TEMPERATURE TAP CO DIRECTION OF FLOW TPV VALVE IN RISER GPR CAP OR PLUG GPR CLEANOUT TO GRADE GPR FLOOR CLEANOUT GPR WALL CLEANOUT GPR CLEANOUT GPR TRAP PRIMER VALVE GPR GAS PRESSURE GPR AIR FLOW DIRECTION GPR SUPPLY OR OSA DUCT SECTION ROUND, RECTANGULAR GPR RETURN OR EXHAUST DUCT SECTION ROUND, RECTANGULAR GPR INTERNALLY INSULATED DUCT DOUBLE LINE, SINGLE LINE GPR FLEXIBLE EQUIPMENT CONNECTION FLD FUSIBLE LINK DAMPER DOUBLE LINE, SINGLE LINE FLD BUTTERFLY VOLUME DAMPER DOUBLE LINE, SINGLE LINE FLD DUCT LAGGING DOUBLE LINE</p>	<p>HX HEAT EXCHANGER SHB STEAM HEATING BOILER ET EXPANSION TANK WCU WATER CHILLER UNIT HWP HEATING WATER PUMP CWP CHILLED WATER PUMP CDP CONDENSER WATER PUMP CCC CLOSED CIRCUIT COOLER ACCU AIR COOLED CONDENSING UNIT ASU AIR SUPPLY UNIT ACU AIR CONDITIONING UNIT SF SUPPLY FAN RF RETURN FAN EF EXHAUST FAN REF ROOF EXHAUST FAN RC RELIEF CAP RDR STEAM RADIATOR CV CONVECTOR CUH CABINET UNIT HEATER UH UNIT HEATER BHC BOOSTER HEATING COIL HC HEATING COIL CC COOLING COIL OSA OUTSIDE AIR AUD AUTOMATIC DAMPER OAD OUTSIDE AIR DAMPER RAD RETURN AIR DAMPER EAD EXHAUST AIR DAMPER SMD SMOKE DAMPER 6Φ ROUND DUCT DIAMETER, INCHES 32x14 RECTANGULAR DUCT SIZE, INCHES CS CEILING SUPPLY DIFFUSER CR CEILING RETURN GRILLE CE CEILING EXHAUST GRILLE HS HIGH SUPPLY GRILLE HR HIGH RETURN GRILLE HE HIGH EXHAUST GRILLE LS LOW SUPPLY GRILLE LR LOW RETURN GRILLE LCS LINEAR CEILING SUPPLY DIFFUSER WG WALL GRILLE SMB STARTER MOUNTING BOARD (SEE ELECT.) DDCU DIRECT DIGITAL CONTROL UNIT MCC MOTOR CONTROL CENTER (SEE ELECT.) T ROOM THERMOSTAT OR SENSOR ZONE AIR DUCT</p> <p>N.O. NORMALLY OPEN N.C. NORMALLY CLOSED D.A. DIRECT ACTING R.A. REVERSE ACTING P.E. PNEUMATIC - ELECTRIC SAV SOLENOID AIR VALVE NLL NIGHT LOW LIMIT</p> <p>WC WATER CLOSET U URINAL L LAVATORY S SINK SS SERVICE SINK MS MOP SINK SHR SHOWER DF DRINKING FOUNTAIN EWH ELECTRIC WATER HEATER RHPW RECIRCULATING HOT WATER PUMP RPBP REDUCED PRESSURE BACKFLOW PREVENTER DCA DOUBLE CHECK VALVE ASSEMBLY DDCA DOUBLE DETECTOR CHECK VALVE ASSEMBLY FCS FLOOR CONTROL STATION (FIRE SPRINKLER) FHC FIRE HOSE CABINET FHR FIRE HOSE REEL FHV FIRE HOSE VALVE FDC FIRE DEPARTMENT CONNECTION</p> <p>FD FLOOR DRAIN SHD SHOWER DRAIN DS DOWNSPOUT RD ROOF DRAIN ORD OVERFLOW ROOF DRAIN VTR VENT THROUGH ROOF CIP CAST IRON PIPE I.E. INVERT ELEVATION EL ELEVATION FF FINISHED FLOOR</p> <p>NIM NOT IN MECHANICAL - ANOTHER DIVISION SPECIFIED UNDER ANOTHER DIVISION</p> <p>ACCESS DOOR CONNECT TO EXISTING EXISTING TO REMAIN CAP OR PLUG NEW RELOCATE EXISTING THROUGH TRUSS WEB LOCATE IN WALL SPACE REMOVE EXISTING</p> <p>NEW PLUMBING FIXTURE REMOVE EXISTING FIXTURE, EQUIPMENT OR ITEM</p>
--	---	--

# Portland Center for the Performing Arts


The City of Portland  
Honorable Mildred A. Schwab,  
Commissioner in Charge  
Ronald K. Ragen, Chairman  
Performing Arts Center  
Committee

Broomer, Oringdolph, O'Toole, Rudolf & Associates, P.C.  
ELS Design Group  
Barton Myers  
Theatre Projects, Inc.  
R. Lawrence Kirkegaard & Associates  
Interface Engineering, Inc.  
C.W. Timmer & Associates  
CH2M Hill  
Project Address:  
733 N.W. 20th Avenue  
Portland, Oregon 97209  
(503) 226-1575



**SITE PLAN AND LEGEND**

Job No.	Date
Set No.	Sheet No.
<b>8.1</b>	

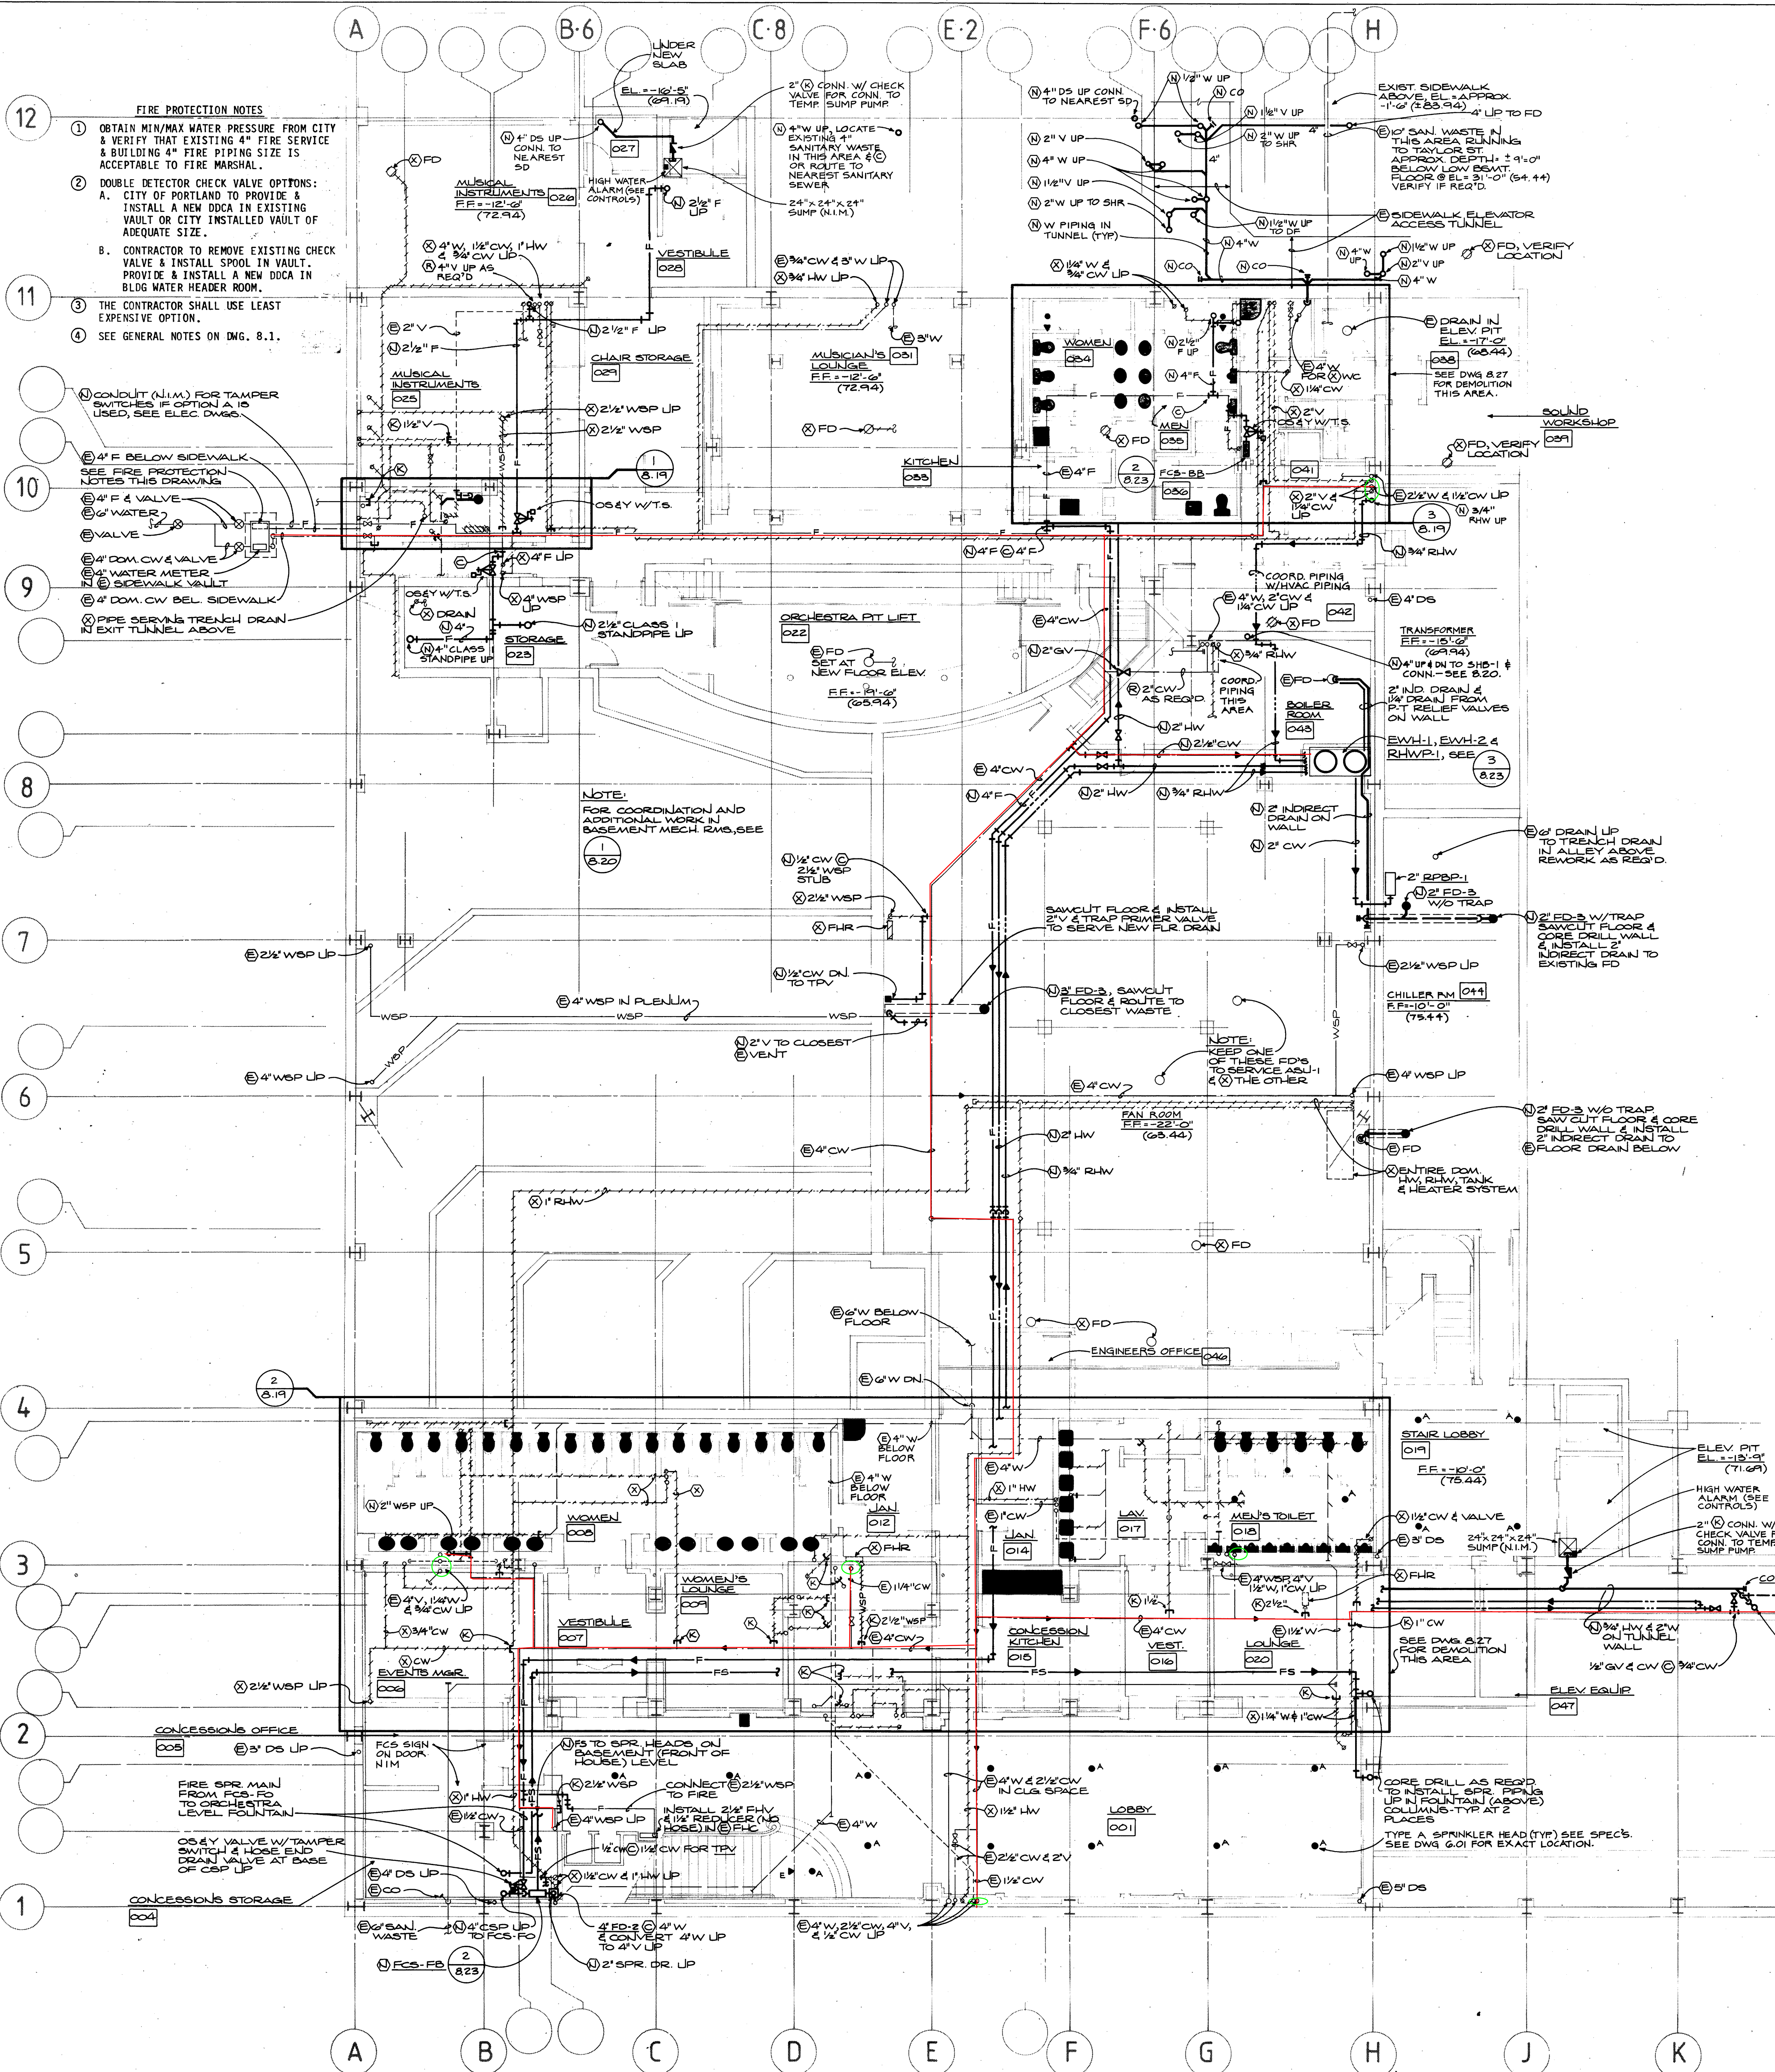

### PLUMBING FIXTURE SCHEDULE

SYM.	FIXTURE	MIN. ROUGH-IN SIZES (INCHES)					REMARKS/DESCRIPTION
		W	V	TRAP	CW	HW	
WC-1	WATER CLOSET	4	2	INT	1-1/4	-	WALL HUNG, FLUSH VALVE, STD. HT.
WC-2	WATER CLOSET	4	2	INT	1-1/4	-	WALL HUNG, FLUSH VALVE, HANDICAP HT.
WC-3	WATER CLOSET	4	2	INT	3/4	-	FLOOR STANDING, FLUSH TANK, STD. HT.
WC-4	WATER CLOSET	4	2	INT	3/4	-	FLOOR STANDING, FLUSH TANK, HANDICAP HT.
U-1	URINAL	2	1-1/2	INT	1	-	WALL HUNG, STALL TYPE, FLUSH VALVE, SIPHON JET, STD. HT.
U-2	URINAL	2	1-1/2	INT	1-1/4	-	WALL HUNG, FLUSH VALVE, SIPHON JET, HANDICAP HT.
U-3	URINAL	2	1-1/2	INT	1	-	WALL HUNG, STALL TYPE, FLUSH VALVE, WASHOUT, STD. HT.
L-1	LAVATORY	1-1/2	1-1/4	1-1/4	1/2	1/2	WALL HUNG, METERING FAUCET
L-2	LAVATORY	1-1/2	1-1/4	1-1/4	1/2	1/2	WALL HUNG, SINGLE LEVER, *HDCP W/INSULATED TRAP & HW
L-3	LAVATORY	1-1/2	1-1/4	1-1/4	1/2	1/2	UNDER CNTR MTD, OVAL, METERING FAUCET
L-4	LAVATORY	1-1/2	1-1/4	1-1/4	1/2	1/2	UNDER CNTR, SINGLE LEVER, INSULATED TRAP & HW, HANDICAP
L-5	LAVATORY	1-1/2	1-1/4	1-1/4	1/2	1/2	CNTR TOP, OVAL, RIM MTD, SINGLE LEVER, *HDCP W/INSULATED TRAP & HW
L-6	LAVATORY	1-1/2	1-1/4	1-1/4	1/2	1/2	SEE REMKS
S-1	SINK	2	1-1/2	1-1/2	1/2	1/2	COUNTER TOP, ST. STL SINGLE COMP, SINGLE LEVER, SINGLE SPOUT
S-2	SINK	2	1-1/2	1-1/2	1/2	1/2	SCULLERY TYPE ST. STL, 3-COMP, 2 SWING SPOUT FAUCETS
SS-1	SERVICE SINK	3	2	3	1/2	1/2	WALL HUNG, TRAP STD MTD, ENAMEL CAST IRON
MS-1	MOP SINK	3	2	3	1/2	1/2	FLOOR SET, ENAMEL CAST IRON
SHR-1	SHOWER	2	1-1/2	2	1/2	1/2	THERMOSTATIC/PRESS. BAL. VALVE, ARM, HEAD
SHR-2	SHOWER	2	1-1/2	2	1/2	1/2	THERMOSTATIC/PRESS. BAL. VALVE, SLIDE ROD, HAND HELD SPRAY, HDCP
DF-1	DRINKING FOUNTAIN	1-1/2	1-1/4	1-1/4	1/2	-	NON-REFRIGERATED, WALL MTD, HANDICAP
DF-2	DRINKING FOUNTAIN	1-1/2	1-1/4	1-1/4	1/2	-	NON-REFRIGERATED, WALL MTD, HANDICAP
EXDF-1	EXISTING DRINKING FOUNTAIN	1-1/2	1-1/4	AS REQD.	1/2	-	MODIFY EXISTING TERRA COTTA FOUNTAIN. DETAILS TO FOLLOW.
FD-1	FLOOR DRAIN	SEE DMGS	-	-	-	-	6" ROUND NICKEL BRONZE GRATE
FD-2	FLOOR DRAIN	SEE DMGS	-	-	-	-	ROUND HINGED GRATE
FD-3	FLOOR DRAIN	SEE DMGS	-	-	-	-	8" ROUND CAST IRON GRATE
SHD-1	SHOWER DRAIN	2	1-1/2	2	-	-	5" ROUND NICKEL BRONZE GRATE

### MISC. EQUIPMENT SCHEDULE

ITEM	DESCRIPTION
EW-1 & EW-2	119 GAL. STORAGE TANK, 18 KW, 105 GPH REC @ 70 DEG TEMP RISE SET @ 110 DEG F MAX OUTLET WATER. BASIS OF DESIGN: A.D. SMITH DSE-120.
RHPW-1	INLINE TYPE, 1", 10 GPH @ 15 FT. HD., 1/6 HP, 120V, 1 PHASE. BASIS OF DESIGN: BELL & GOSSETT SERIES PR.
RPP-1	REDUCED PRESSURE TYPE, 2", MAX PRESS LOSS 10 PSI @ 120 GPM. BASIS OF DESIGN: FERCO 2" 825V W/AGD.
DCA-1	DOUBLE CHECK TYPE, 4", MAX PRESS LOSS: 4 PSI @ 180 GPM. BASIS OF DESIGN: FERCO 4" 805.
GPR-1	3899 CFH, 2 PSI INLET, 5" TO 9" W.C. DUT, 2" SIZE. BASIS OF DESIGN: FISHER SERIES S200.
GPR-2	1245 CFH, 2 PSI INLET, 5" TO 9" W.C. DUT, 1-1/2" SIZE. BASIS OF DESIGN: FISHER SERIES S200.

# Portland Center for the Performing Arts

The City of Portland  
 Honorable Mildred A. Schwab;  
 Commissioner in Charge  
 Ronald K. Ragen; Chairman  
 Performing Arts Center  
 Committee

Broome, Oringdolph, O Toole, Rudolf & Associates, P.C.  
 ELS Design Group  
 Barton Myers  
 Theatre Projects, Inc.  
 R. Lawrence Kirkegaard & Associates  
 Interface Engineering, Inc.  
 C.W. Timmer & Associates  
 CH2M Hill  
 Project Address:  
 733 N.W. 20th Avenue  
 Portland, Oregon 97209  
 (503) 226-1575




## BASEMENT PLAN PLBG. & F.P.

Job No. \_\_\_\_\_ Date JULY 13, 1988  
 Set No. \_\_\_\_\_ Sheet No. \_\_\_\_\_

# Portland Center for the Performing Arts


The City of Portland  
 Honorable Mildred A. Schwab;  
 Commissioner in Charge  
 Ronald K. Ragen; Chairman  
 Performing Arts Center  
 Committee

Broome, Oringulph, O Toole, Rudolf & Associates, P.C.  
 ELS Design Group  
 Barton Myers  
 Theatre Projects, Inc.  
 R. Lawrence Kirkgaard & Associates  
 Interface Engineering, Inc.  
 C.W. Timmer & Associates  
 CH2M Hill  
 Project Address:  
 733 N.W. 20th Avenue  
 Portland, Oregon 97209  
 (503) 226-1575

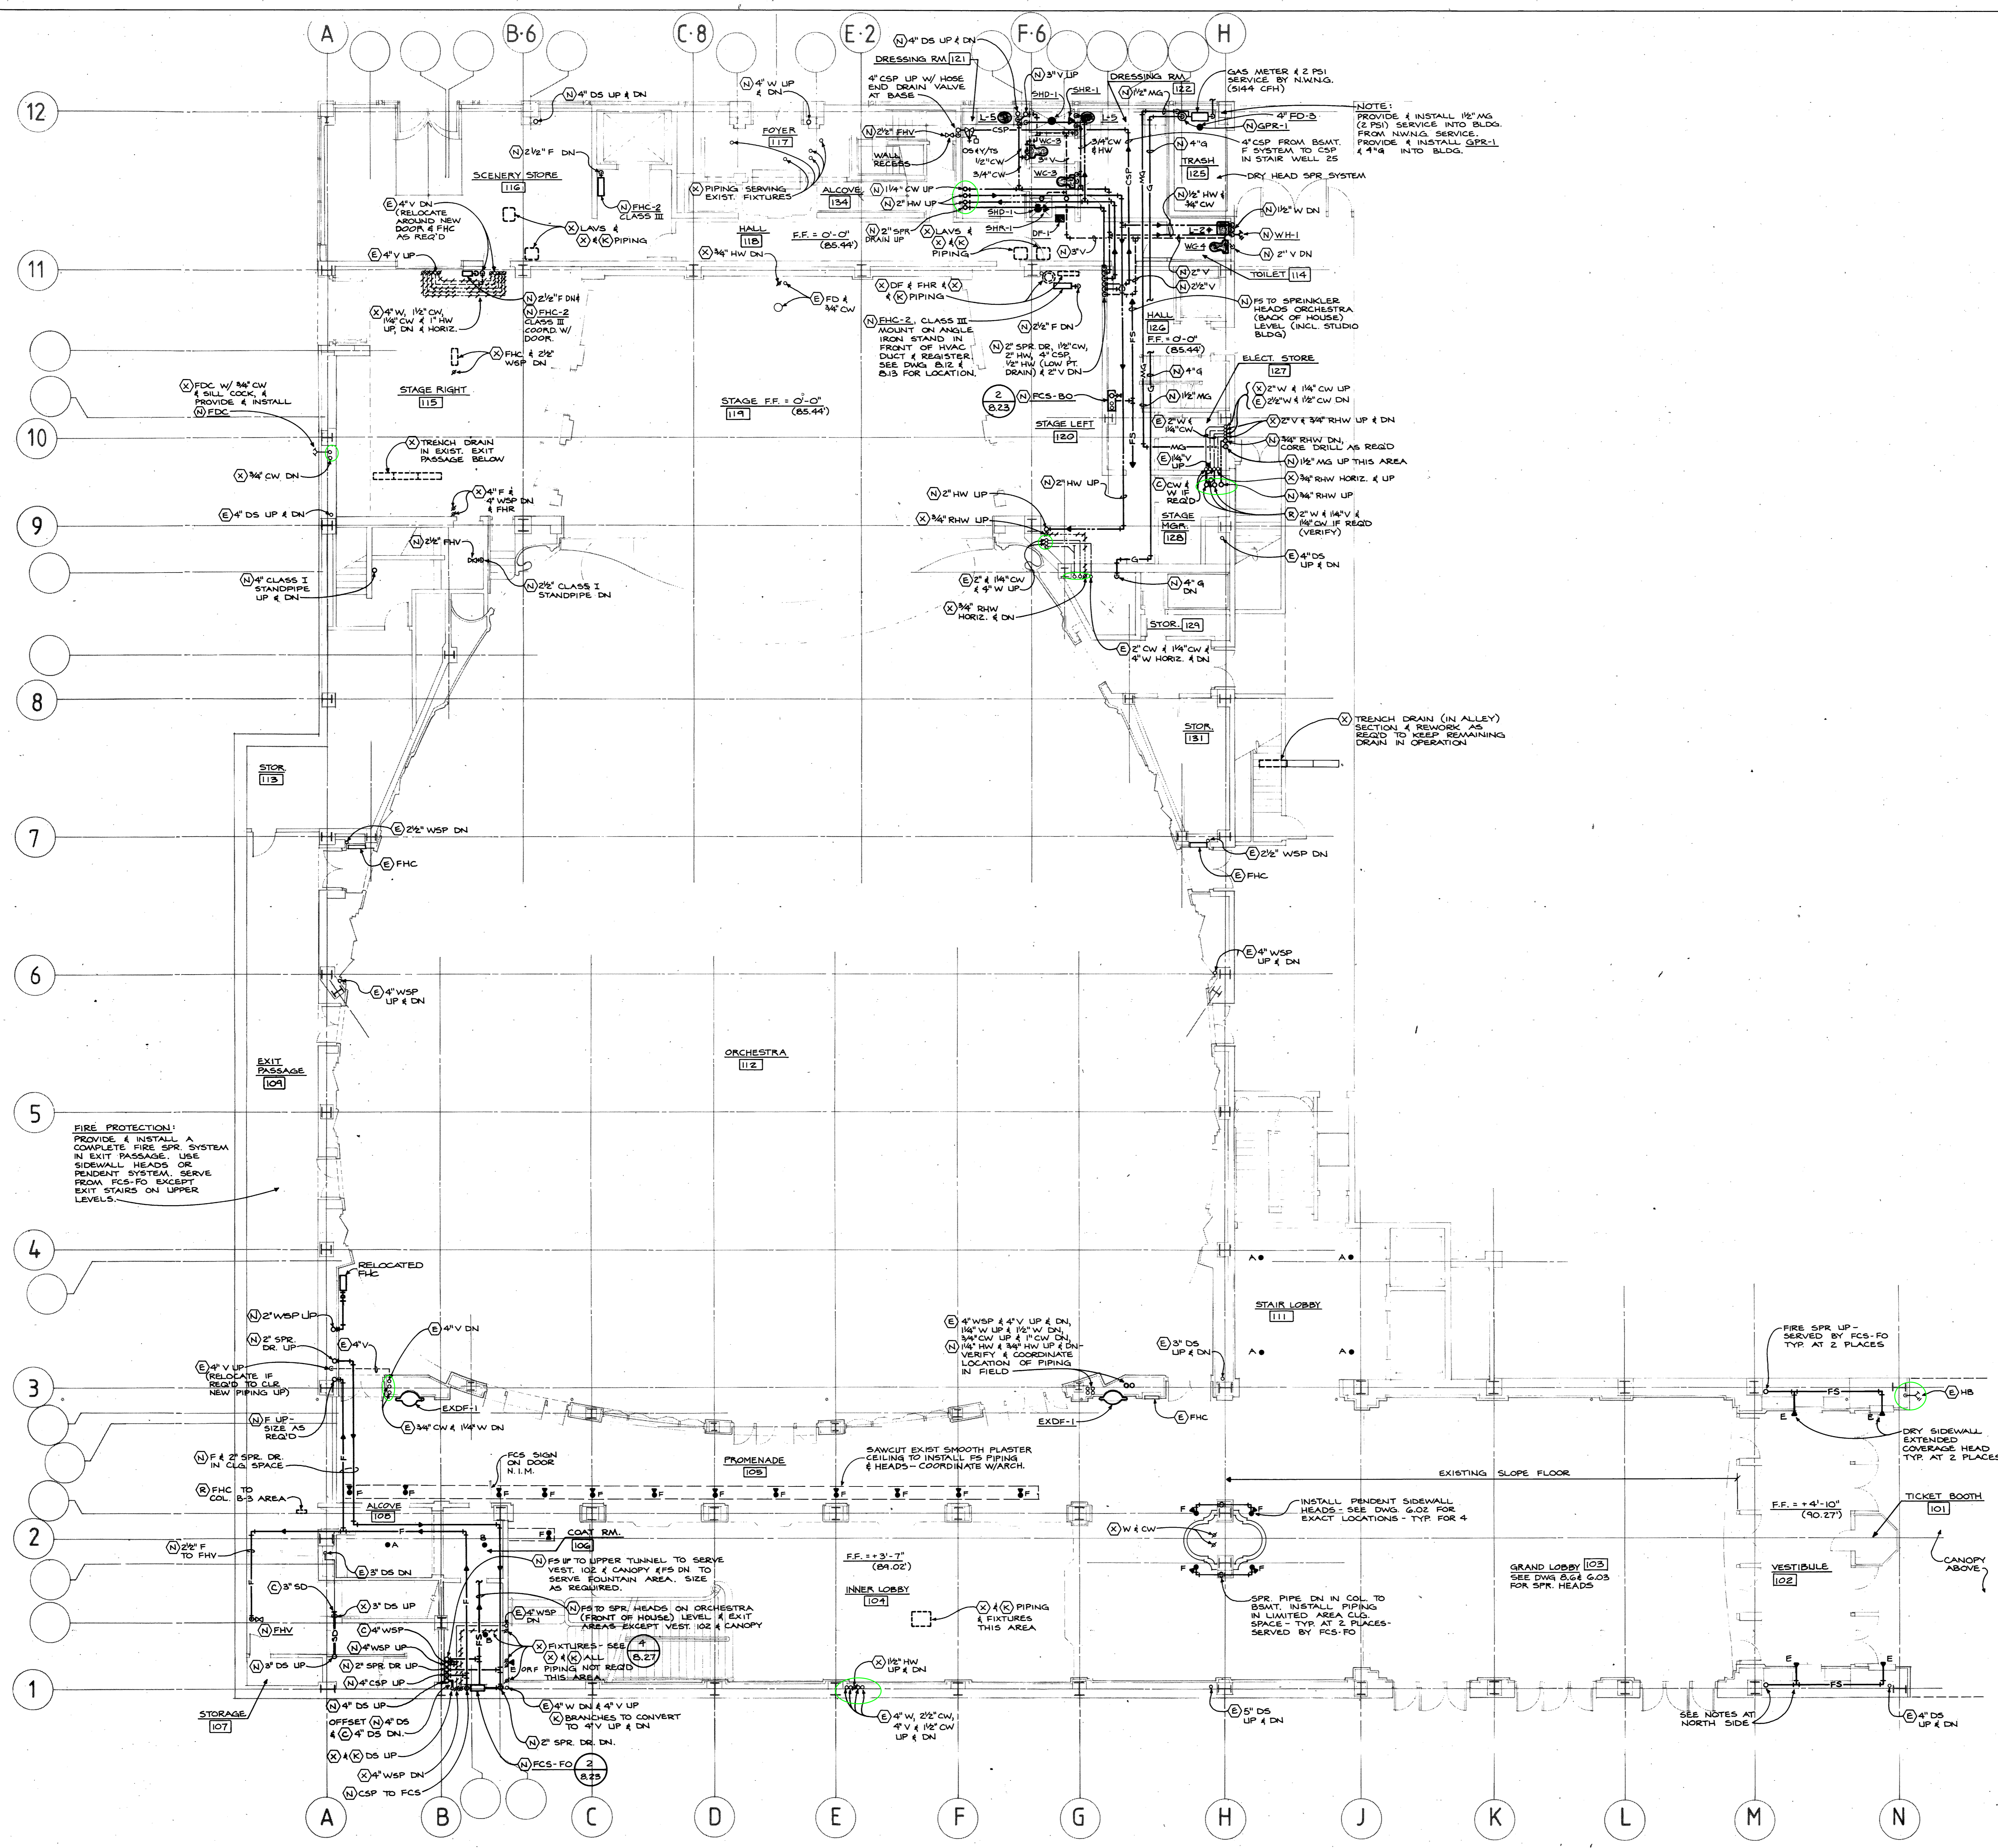

## ORCHESTRA PLAN PLBG. & F.P.

Job No.	Date
Set No.	Sheet No.
8.3	

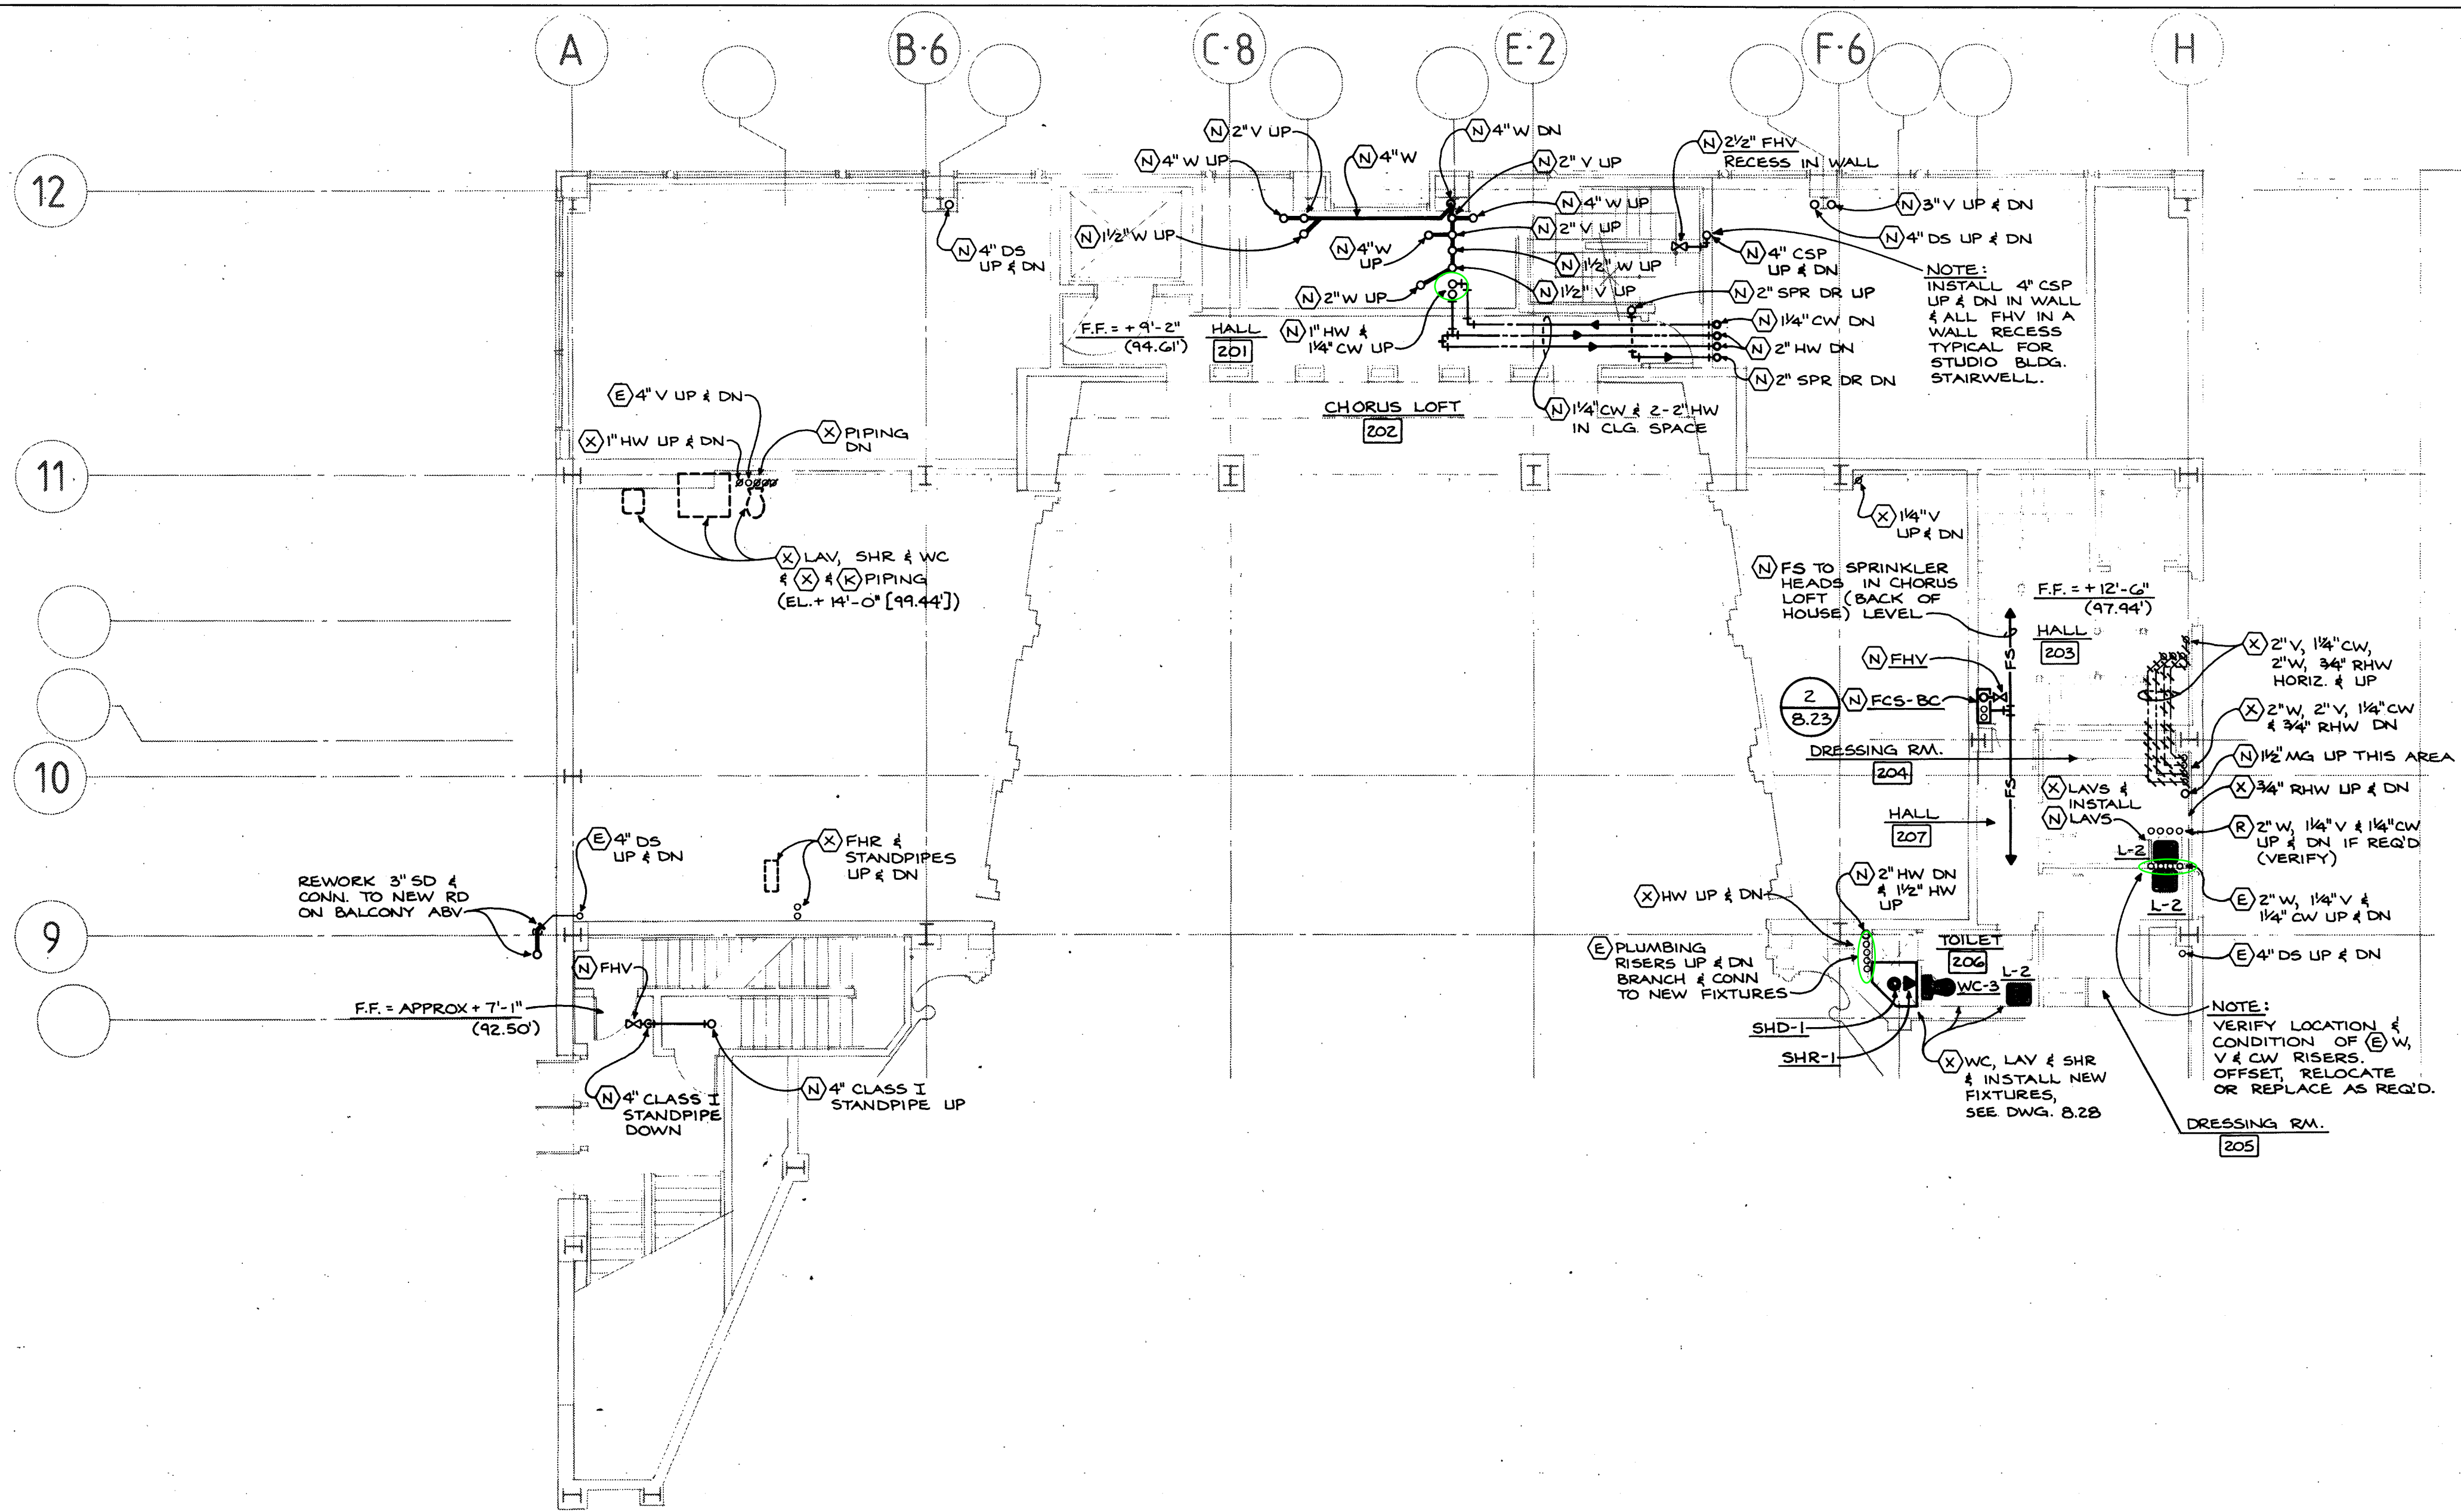

# Portland Center for the Performing Arts

The City of Portland  
 Honorable Mildred A. Schwab;  
 Commissioner in Charge  
 Ronald K. Ragen; Chairman  
 Performing Arts Center  
 Committee

Broome, Oringdolph, O Toole, Rudolf & Associates, P.C.  
 ELS Design Group  
 Barton Myers  
 Theatre Projects, Inc.  
 R. Lawrence Kirkegaard & Associates  
 Interface Engineering, Inc.  
 C.W. Timmer & Associates  
 CH2M Hill  
 Project Address:  
 733 N.W. 20th Avenue  
 Portland, Oregon 97209  
 (503) 224-1575



1693-20



## CHORUS LOFT PLAN PLBG. & F.P.

Job No.	Date JULY 13, 1983
Set No.	Sheet No. <b>8.4</b>
4.03	
3.01.04	

# Portland Center for the Performing Arts

The City of Portland  
Honorable Mildred A. Schwab,  
Commissioner in Charge  
Ronald K. Ragen; Chairman  
Performing Arts Center  
Committee

Broome, Oringdolph, O'Toole, Rudolf & Associates, P.C.  
E.L.S. Design Group  
Barton Myers  
Theatre Projects, Inc.  
R. Lawrence Kirkegaard & Associates  
Interface Engineering, Inc.  
C.W. Timmer & Associates  
CH2M Hill  
Project Address:  
733 N.W. 20th Avenue  
Portland, Oregon 97209  
(503) 226-1515

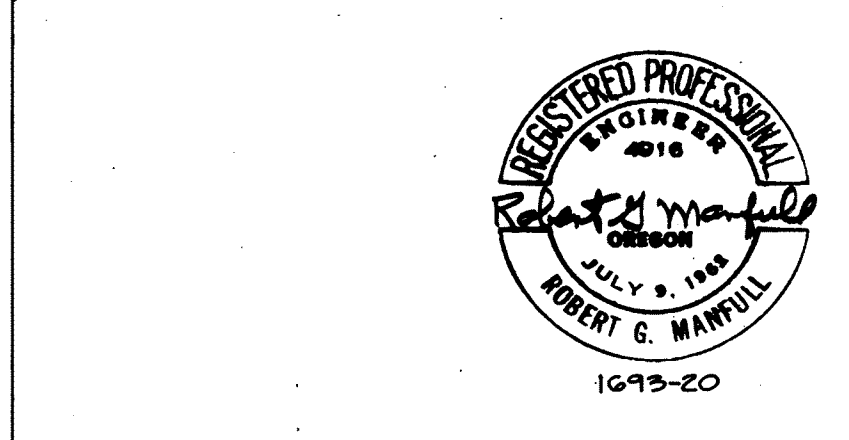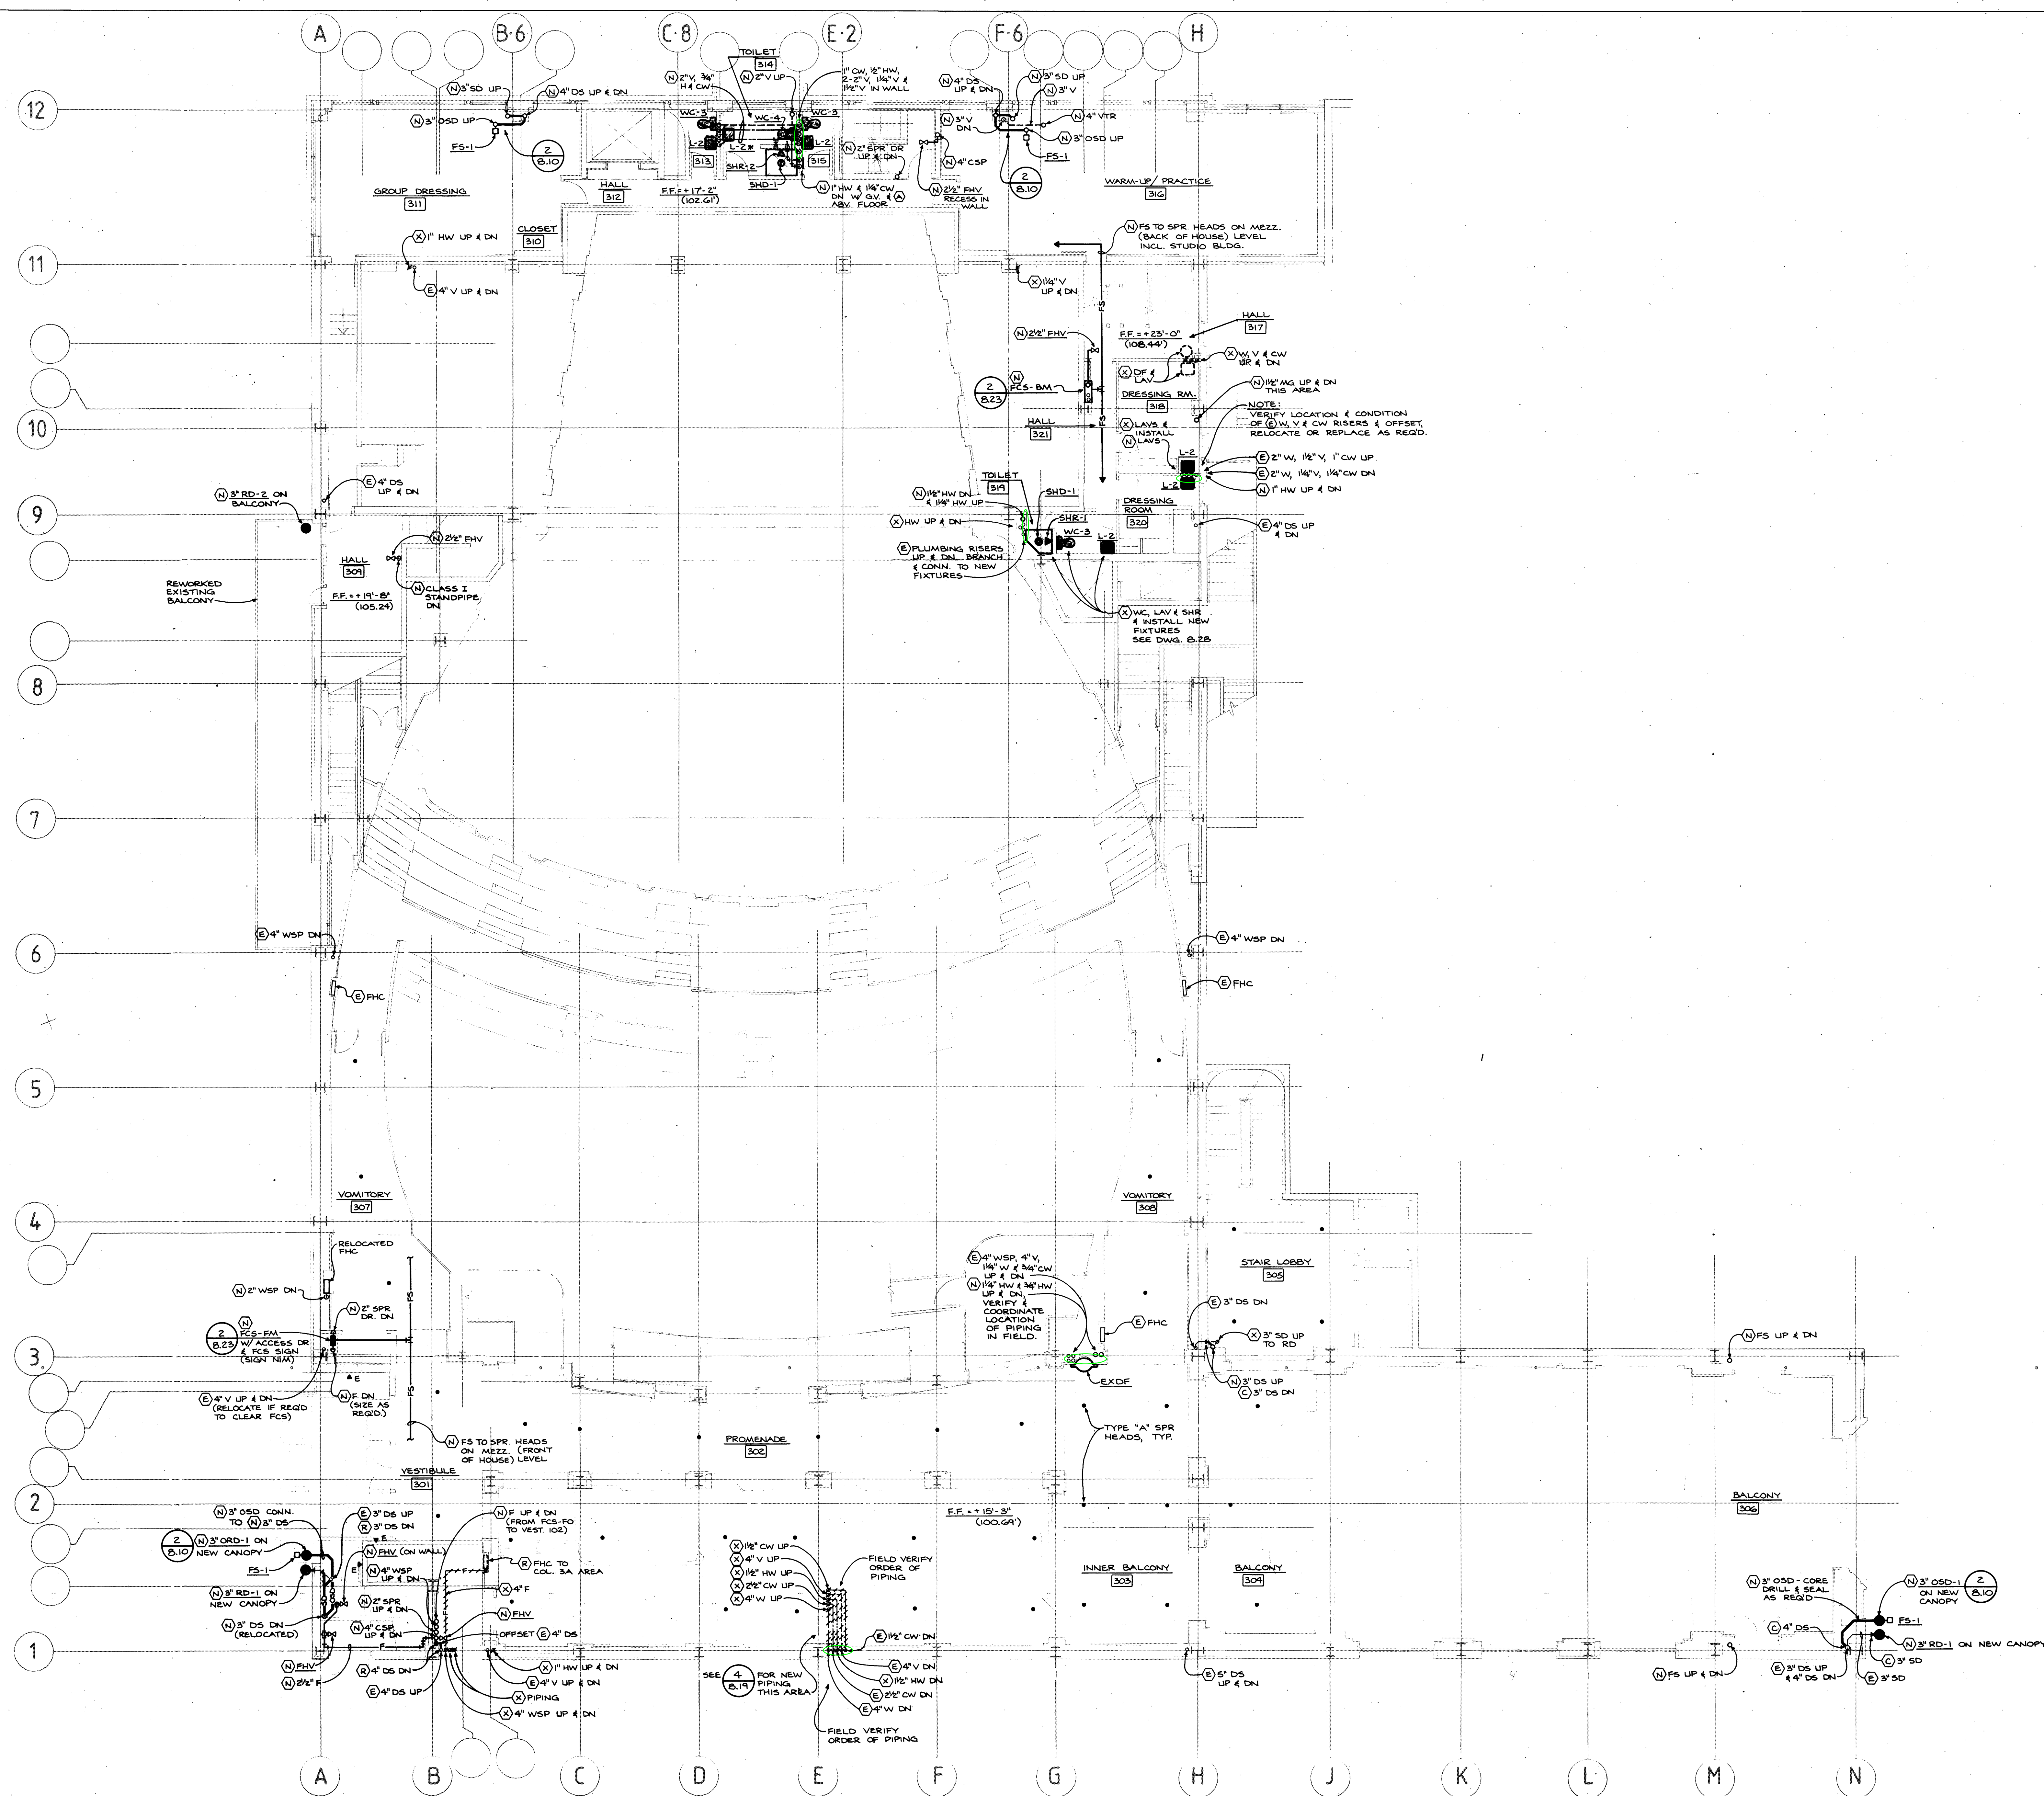

### MEZZANINE PLAN PLBG. & F.P.

Job No.	Date
Set No.	Sheet No.
<b>8.5</b>	

# Portland Center for the Performing Arts

The City of Portland

Honorable Mildred A. Schwab,  
Commissioner in Charge


Ronald K. Ragen, Chairman  
Performing Arts Center  
Committee

Broome, Oringdolph, O'Toole, Rudolf & Associates, P.C.  
ELS Design Group  
Baron Myers

Theatre Projects, Inc.  
R. Lawrence Kirkegaard & Associates

Interface Engineering, Inc.  
C.W. Timmer & Associates  
CH2M Hill

Project Address:  
733 N.W. 20th Avenue  
Portland, Oregon 97209  
(503) 226-1575

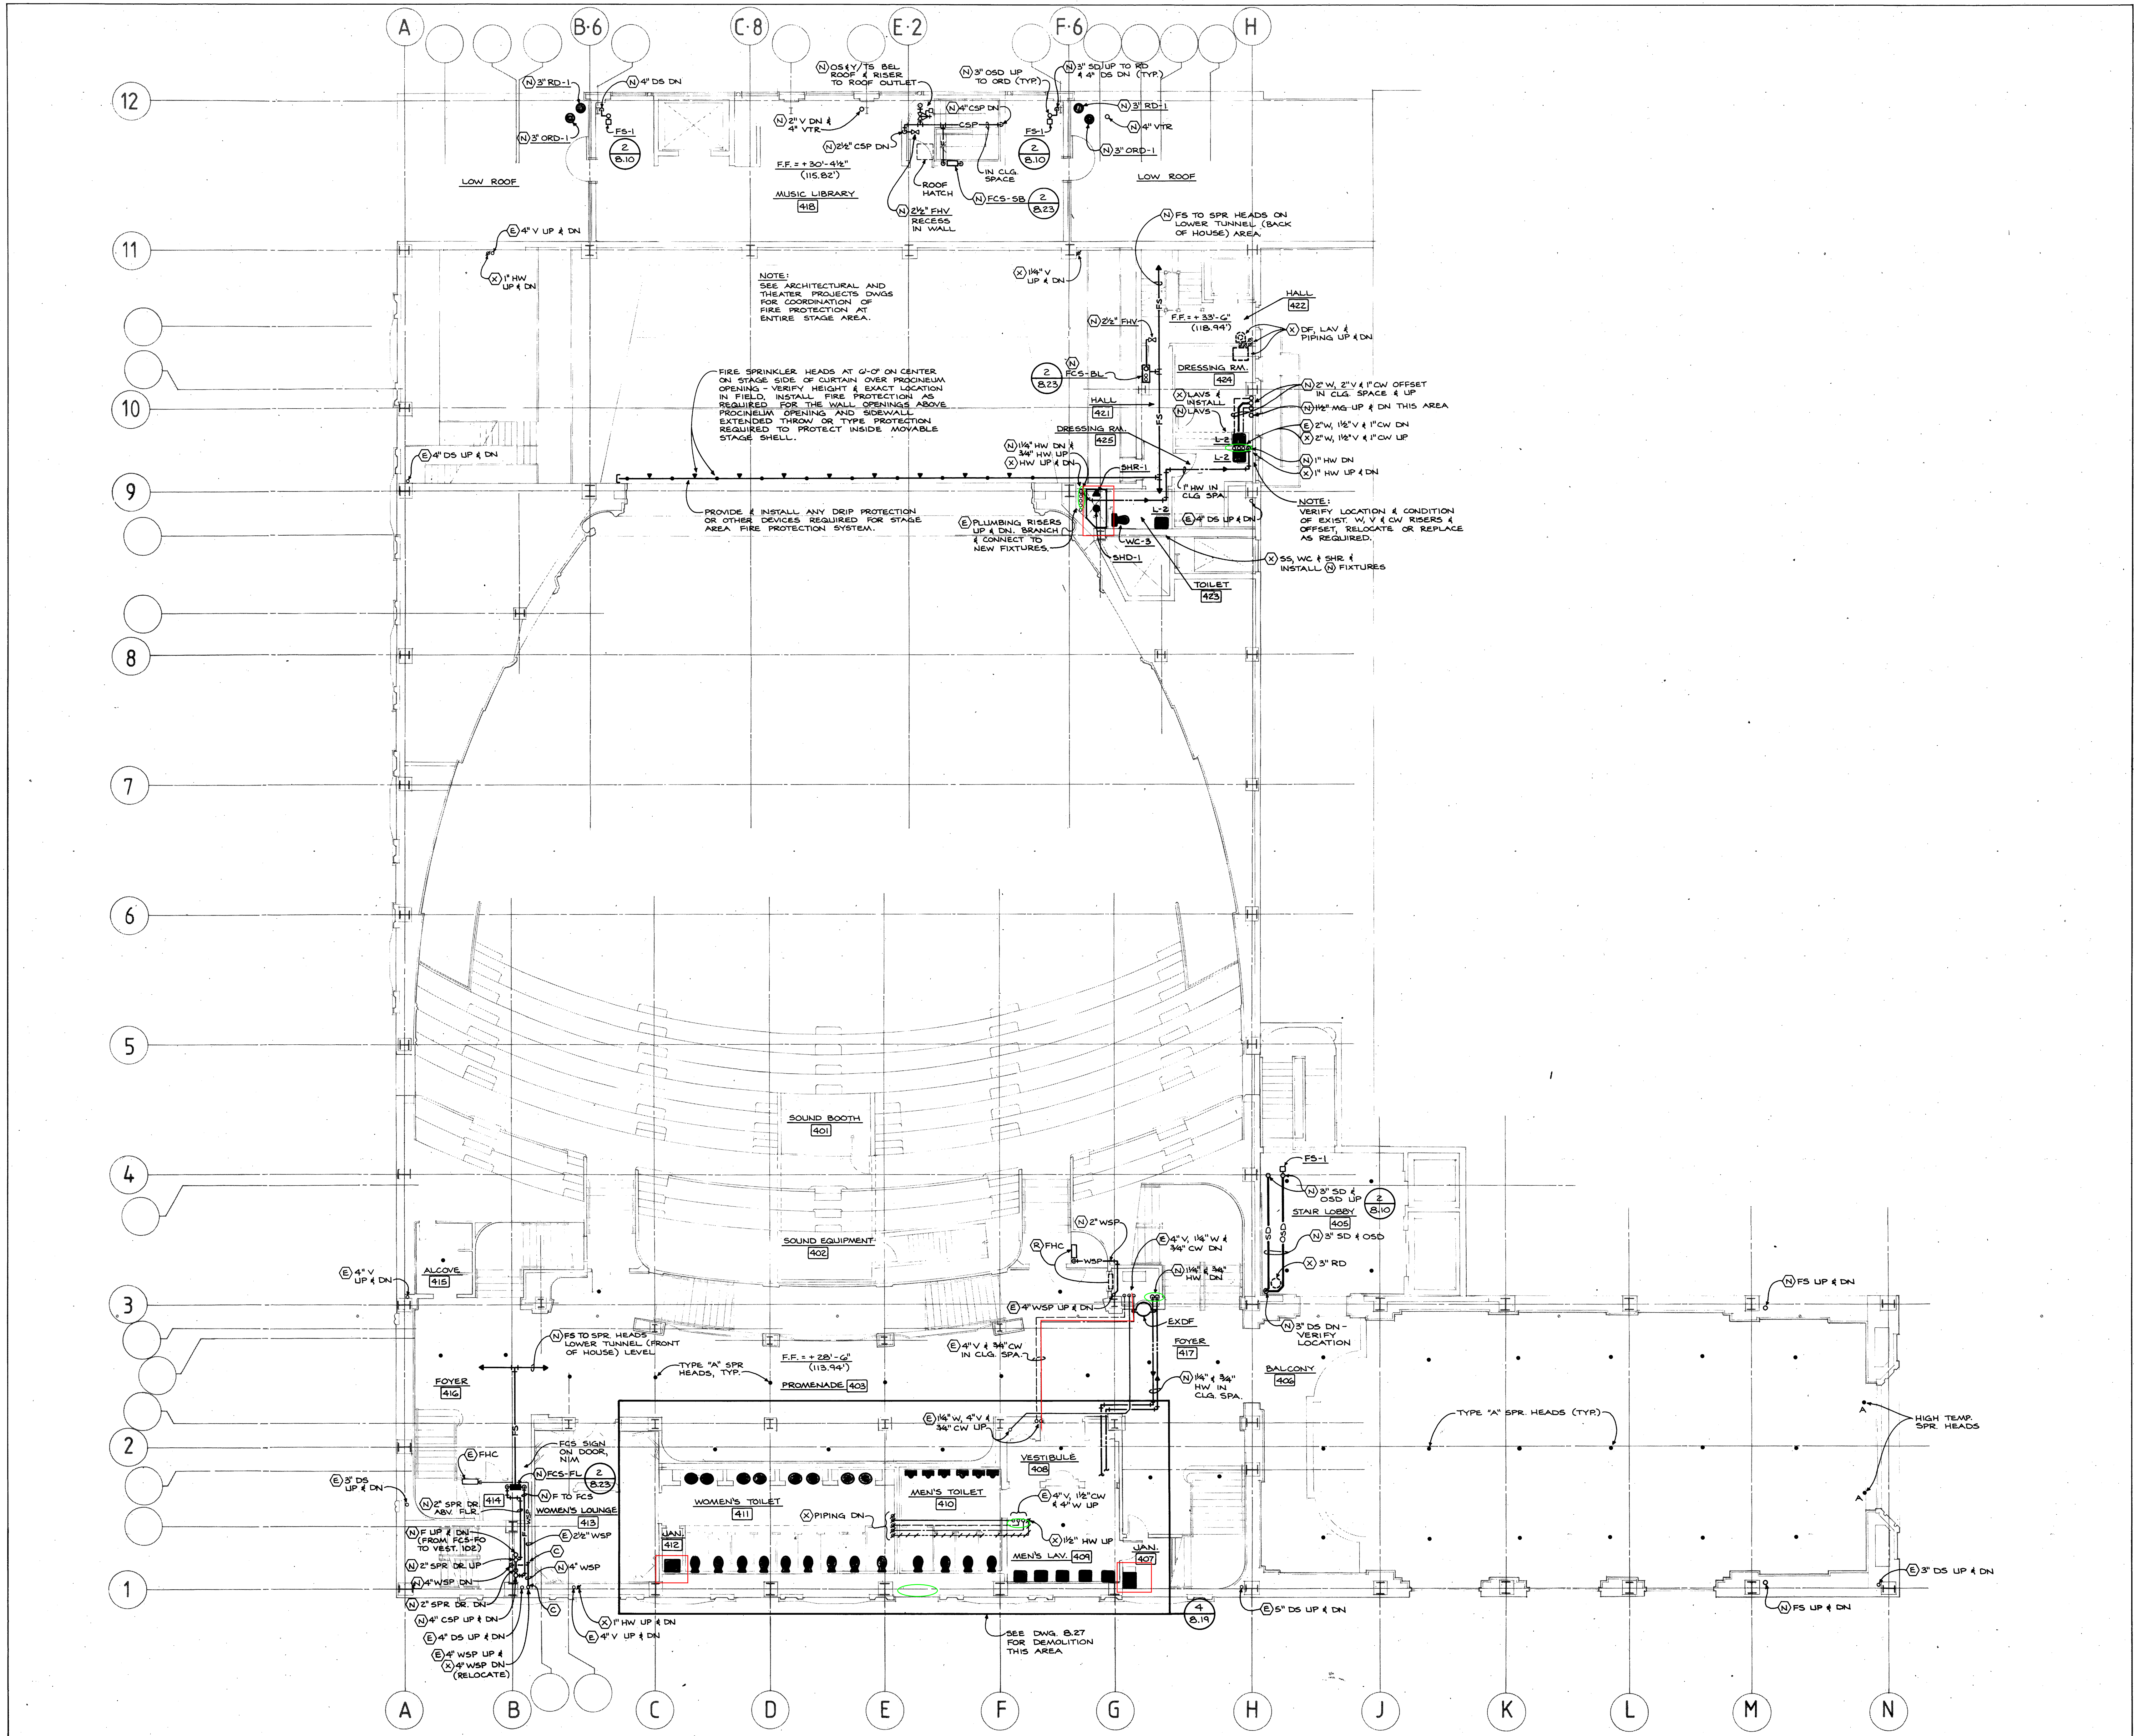

## LOWER TUNNEL PLAN PLBG. & F.P.

Job No.	Date
Set No.	Sheet No.
8.6	

# Portland Center for the Performing Arts

The City of Portland

Honorable Mildred A. Schwab;  
Commissioner in Charge  
Ronald K. Ragen; Chairman  
Performing Arts Center  
Committee


Broome, Oringdolph, O'Toole, Rudolf & Associates, P.C.

ELS Design Group  
Barton Myers

Theatre Projects, Inc.  
R. Lawrence Kirkegaard & Associates

Interface Engineering, Inc.  
C.W. Timmer & Associates  
CH2M Hill

Project Address:  
733 N.W. 20th Avenue  
Portland, Oregon 97209  
(503) 226-1575

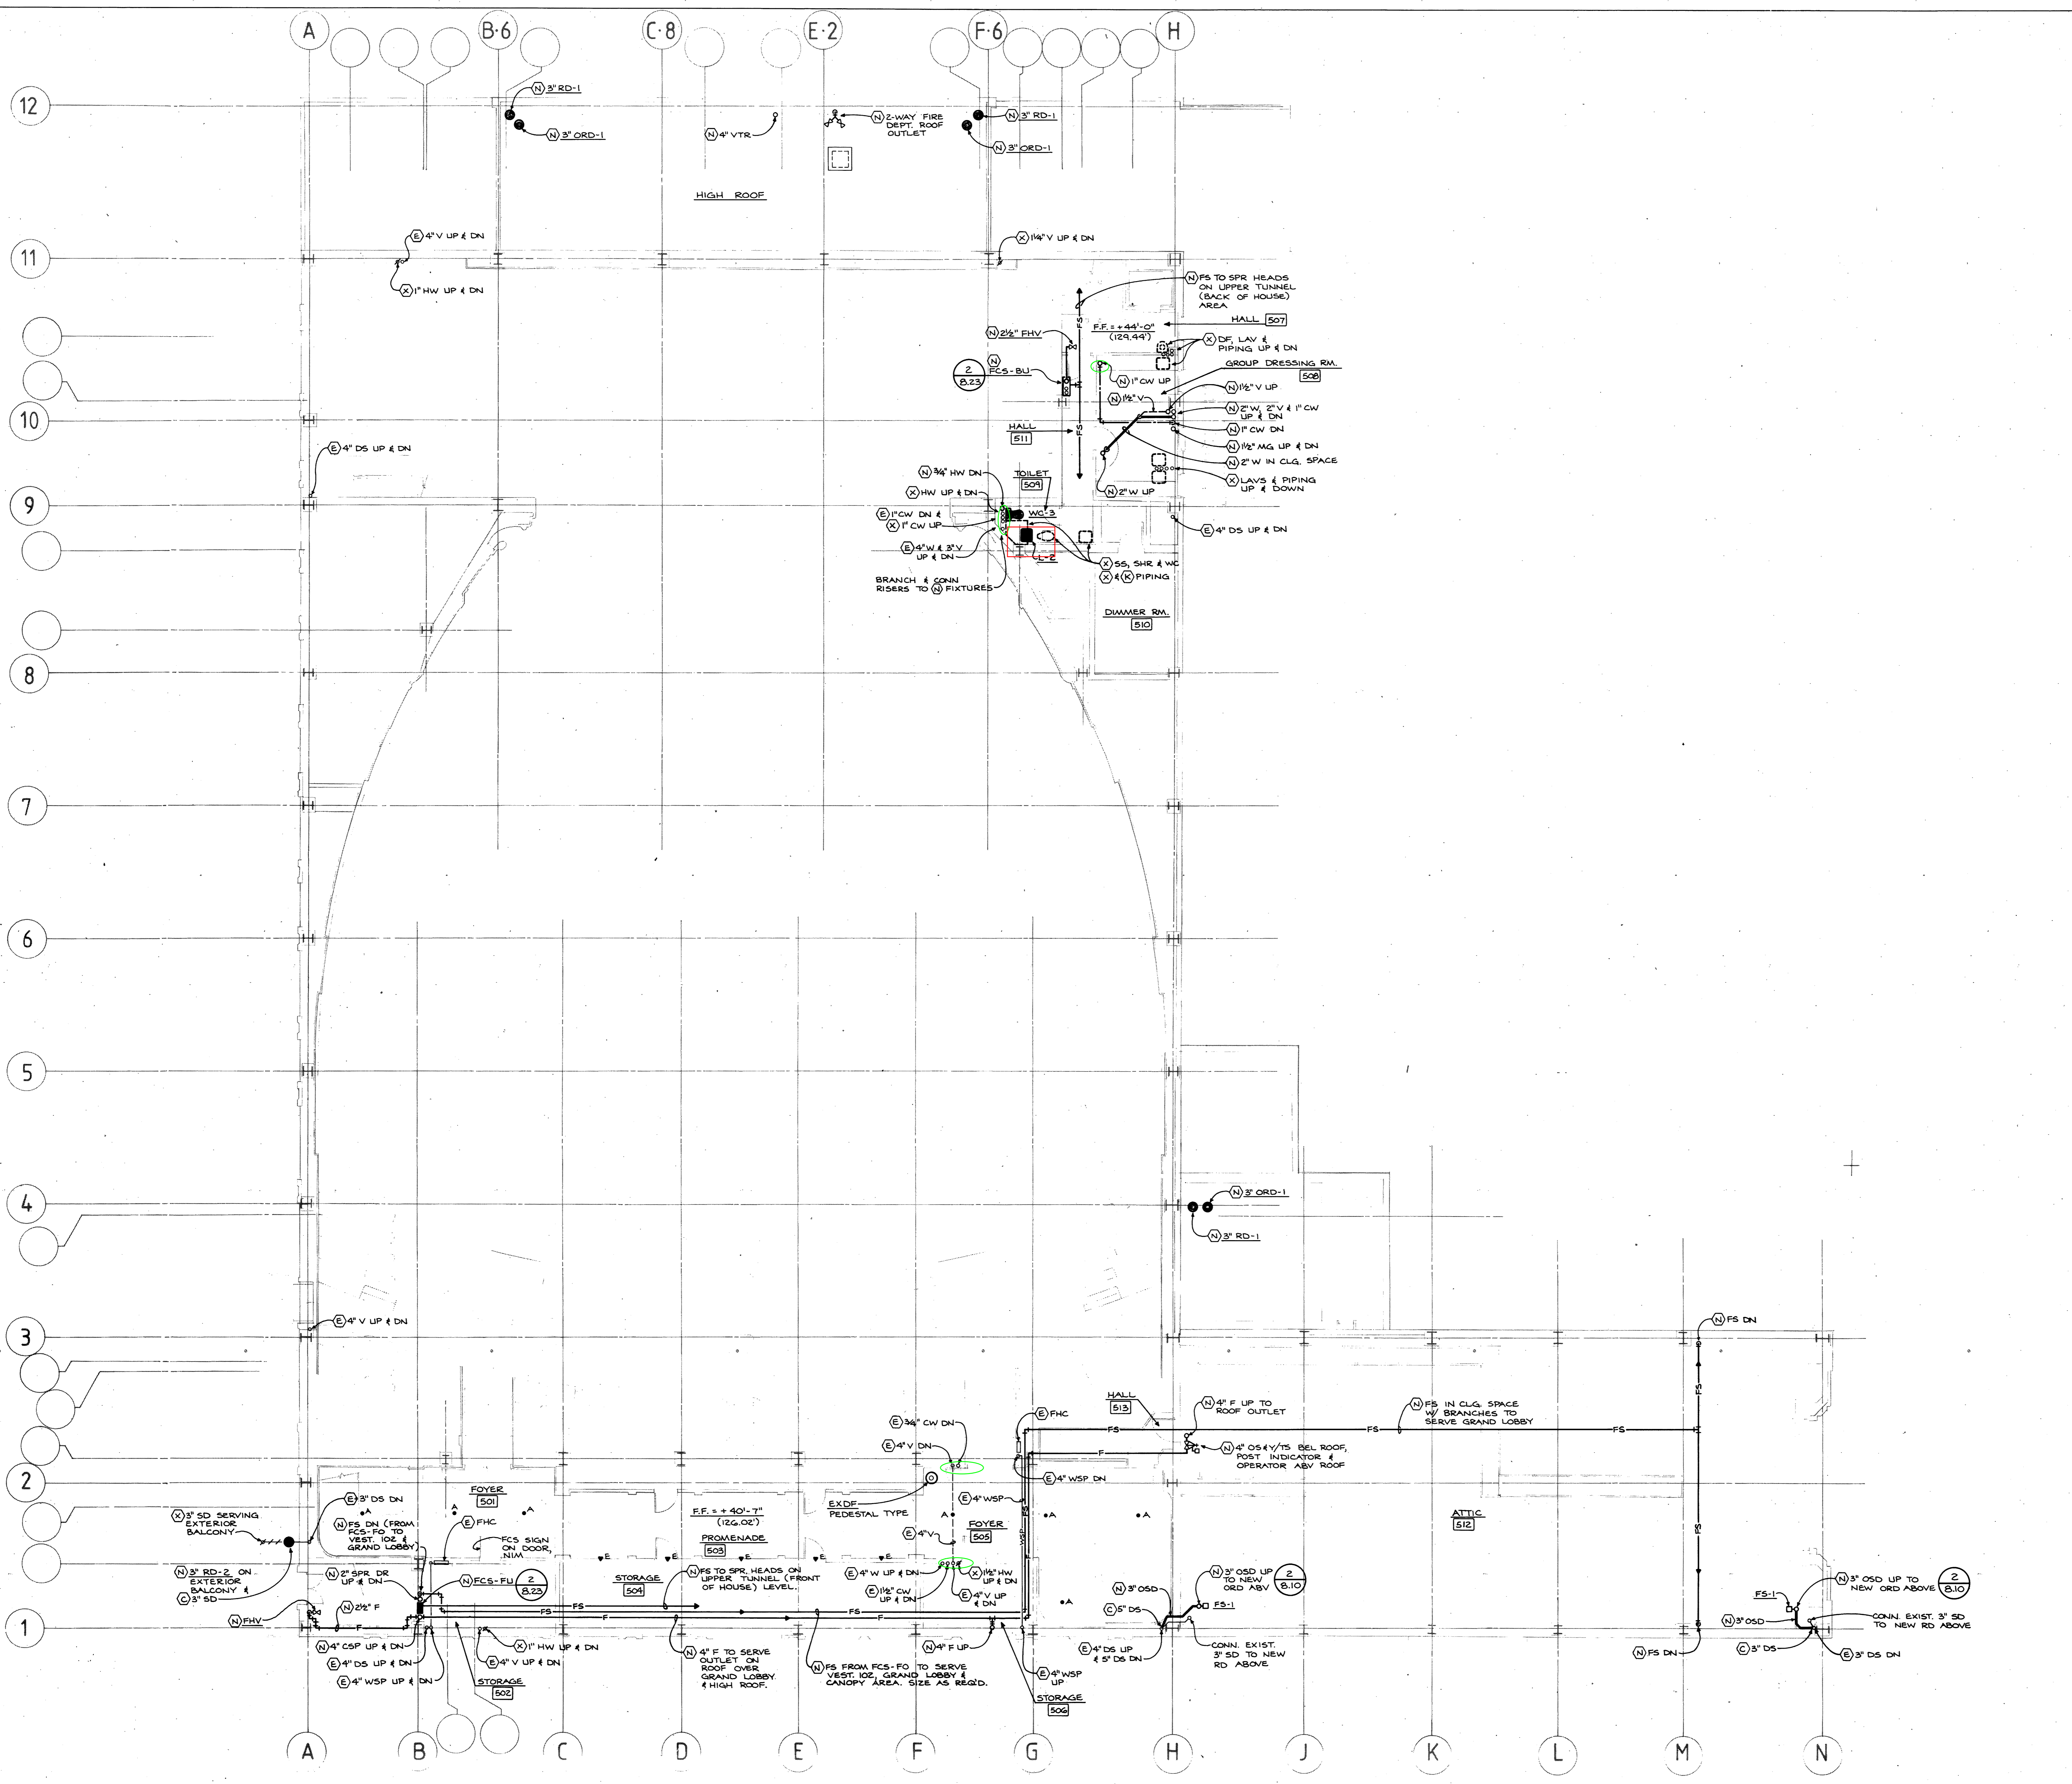

## UPPER TUNNEL PLAN PLBG. & F.P.

Job No.	Date
Set No.	Sheet No.

8.7




# Portland Center for the Performing Arts

The City of Portland


Honorable Mildred A. Schwab;  
Commissioner in Charge  
Ronald K. Ragen; Chairman  
Performing Arts Center  
Committee

Broome, Oringdolph, O'Toole, Rudolf & Associates, P.C.  
ELS Design Group  
Barton Myers  
Theatre Projects, Inc.  
R. Lawrence Kirkegaard & Associates  
Interface Engineering, Inc.  
C.W. Timmer & Associates  
CH2M Hill  
Project Address:  
733 N.W. 20th Avenue  
Portland, Oregon 97209  
(503) 226-1575

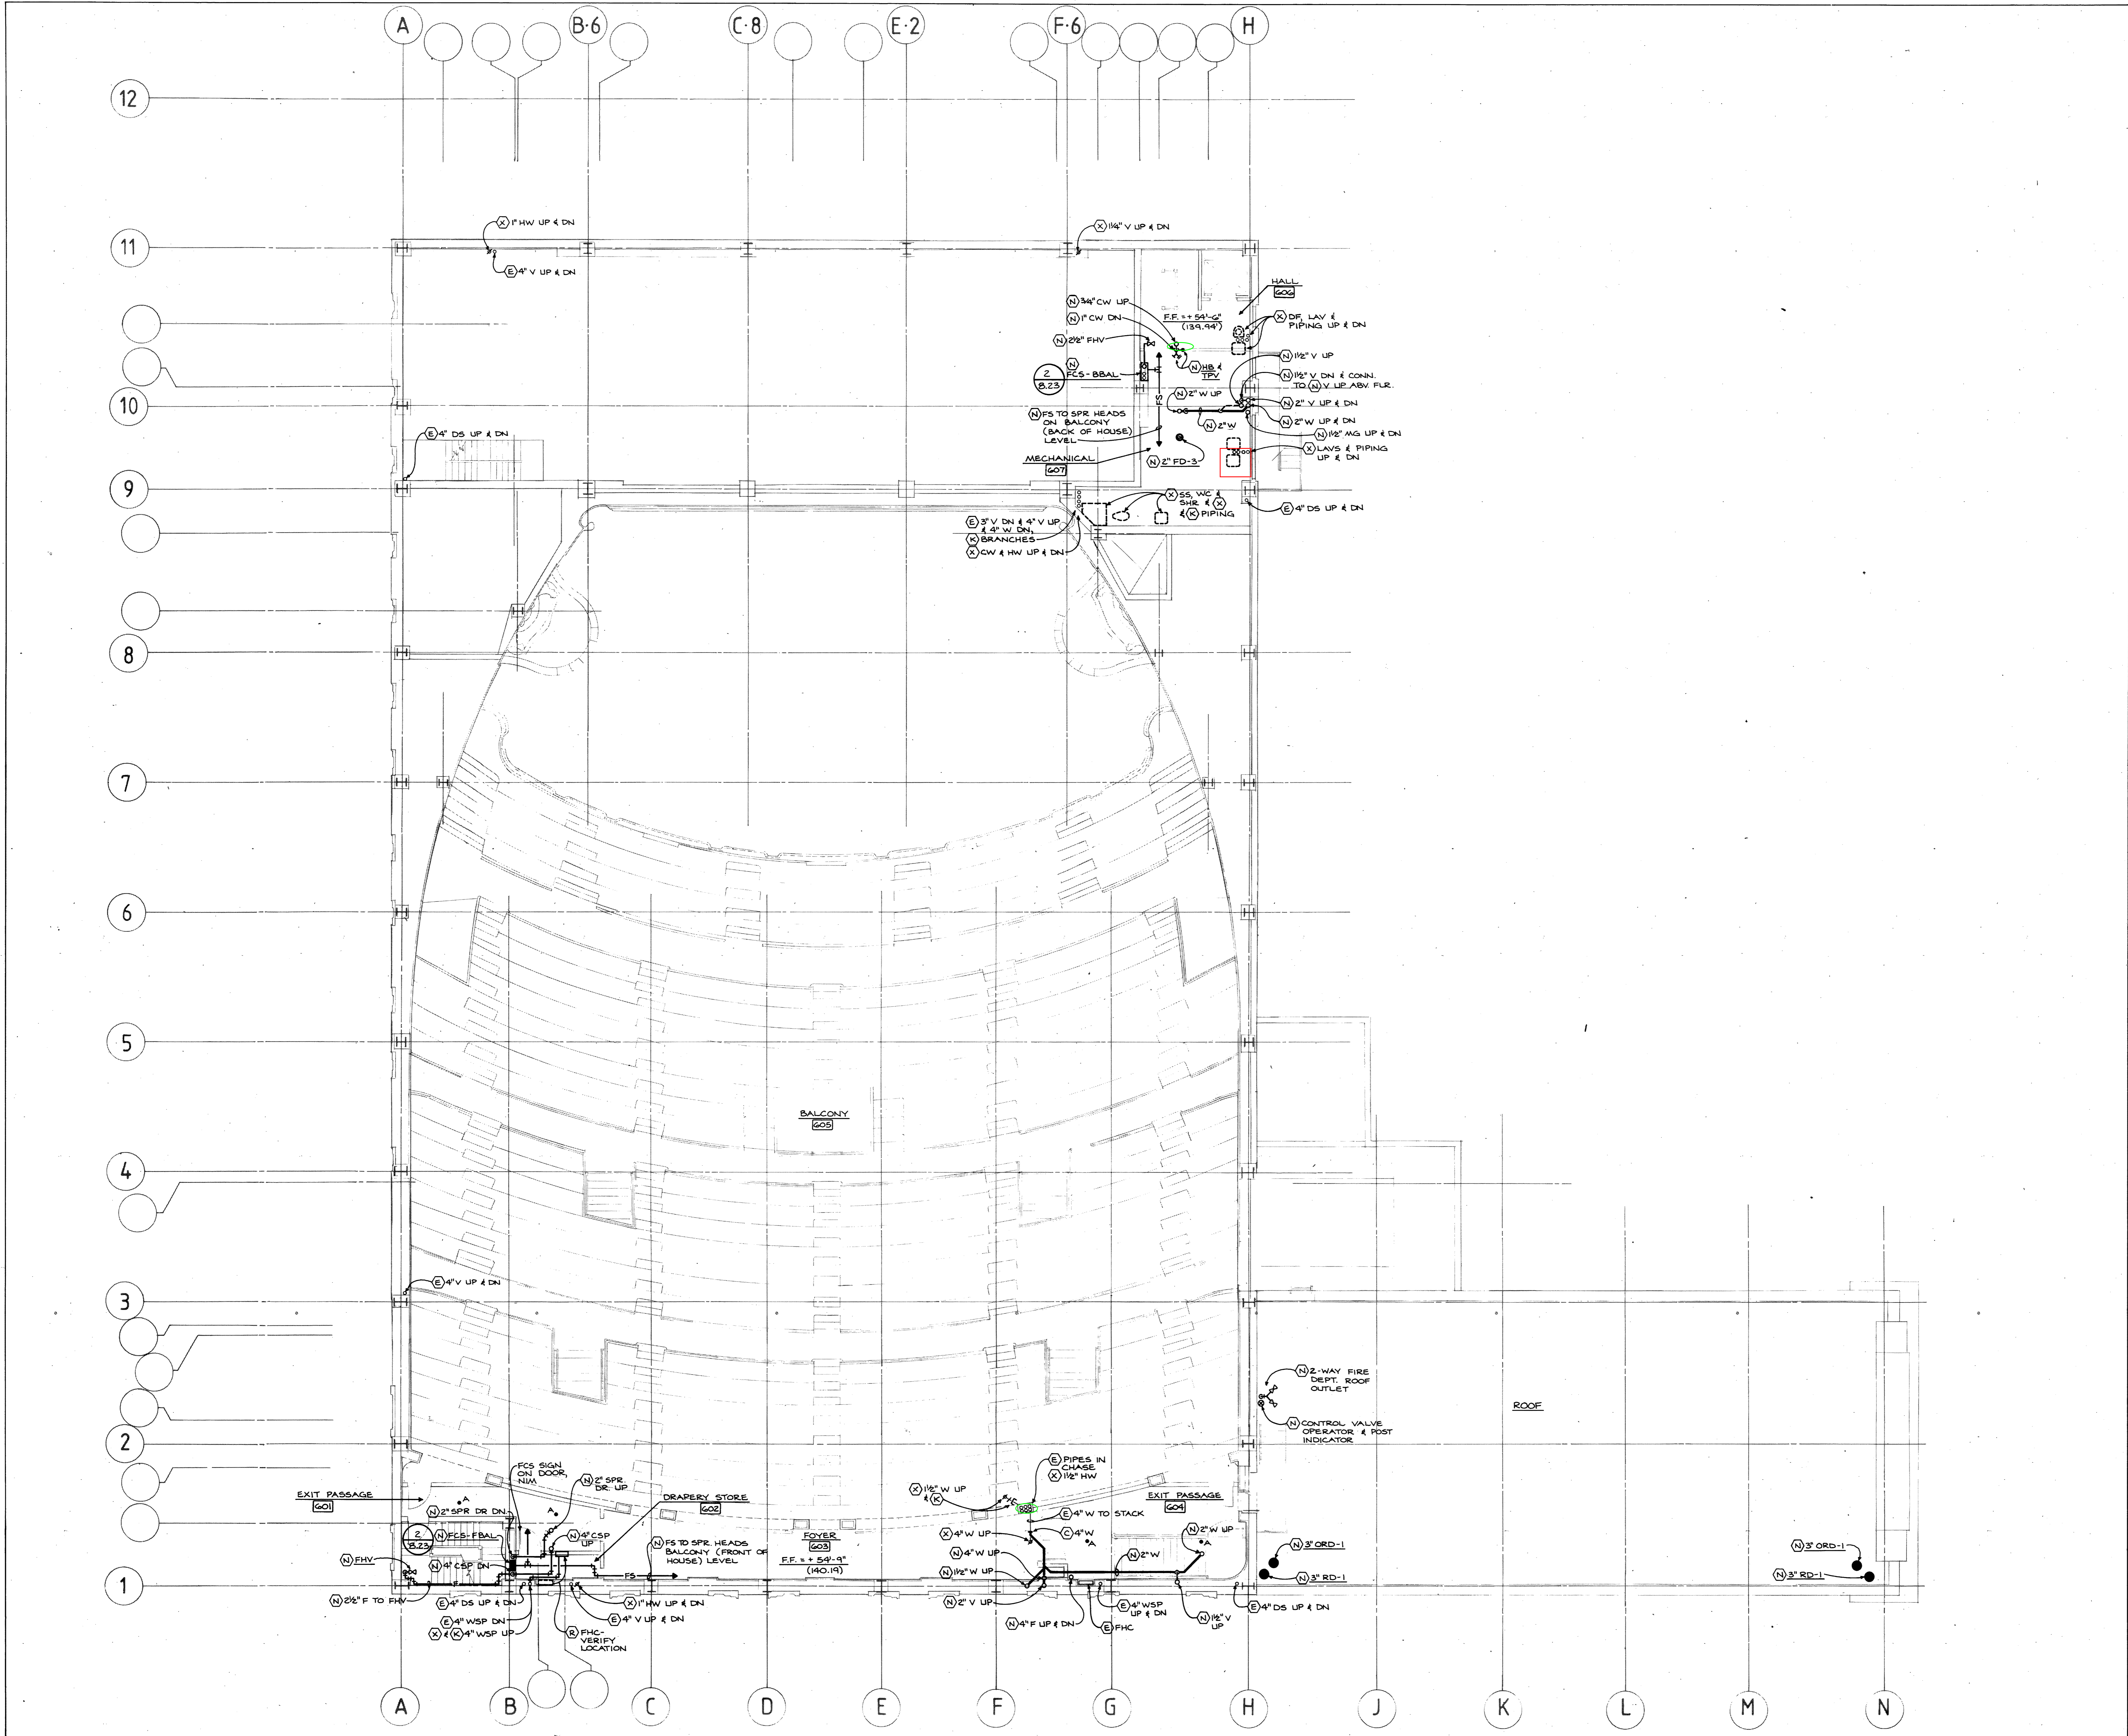

### BALCONY PLAN PLBG. & F.P.

Job No.	Date
Set No.	Sheet No.
<b>8.8</b>	
4.07	
8.8.83	

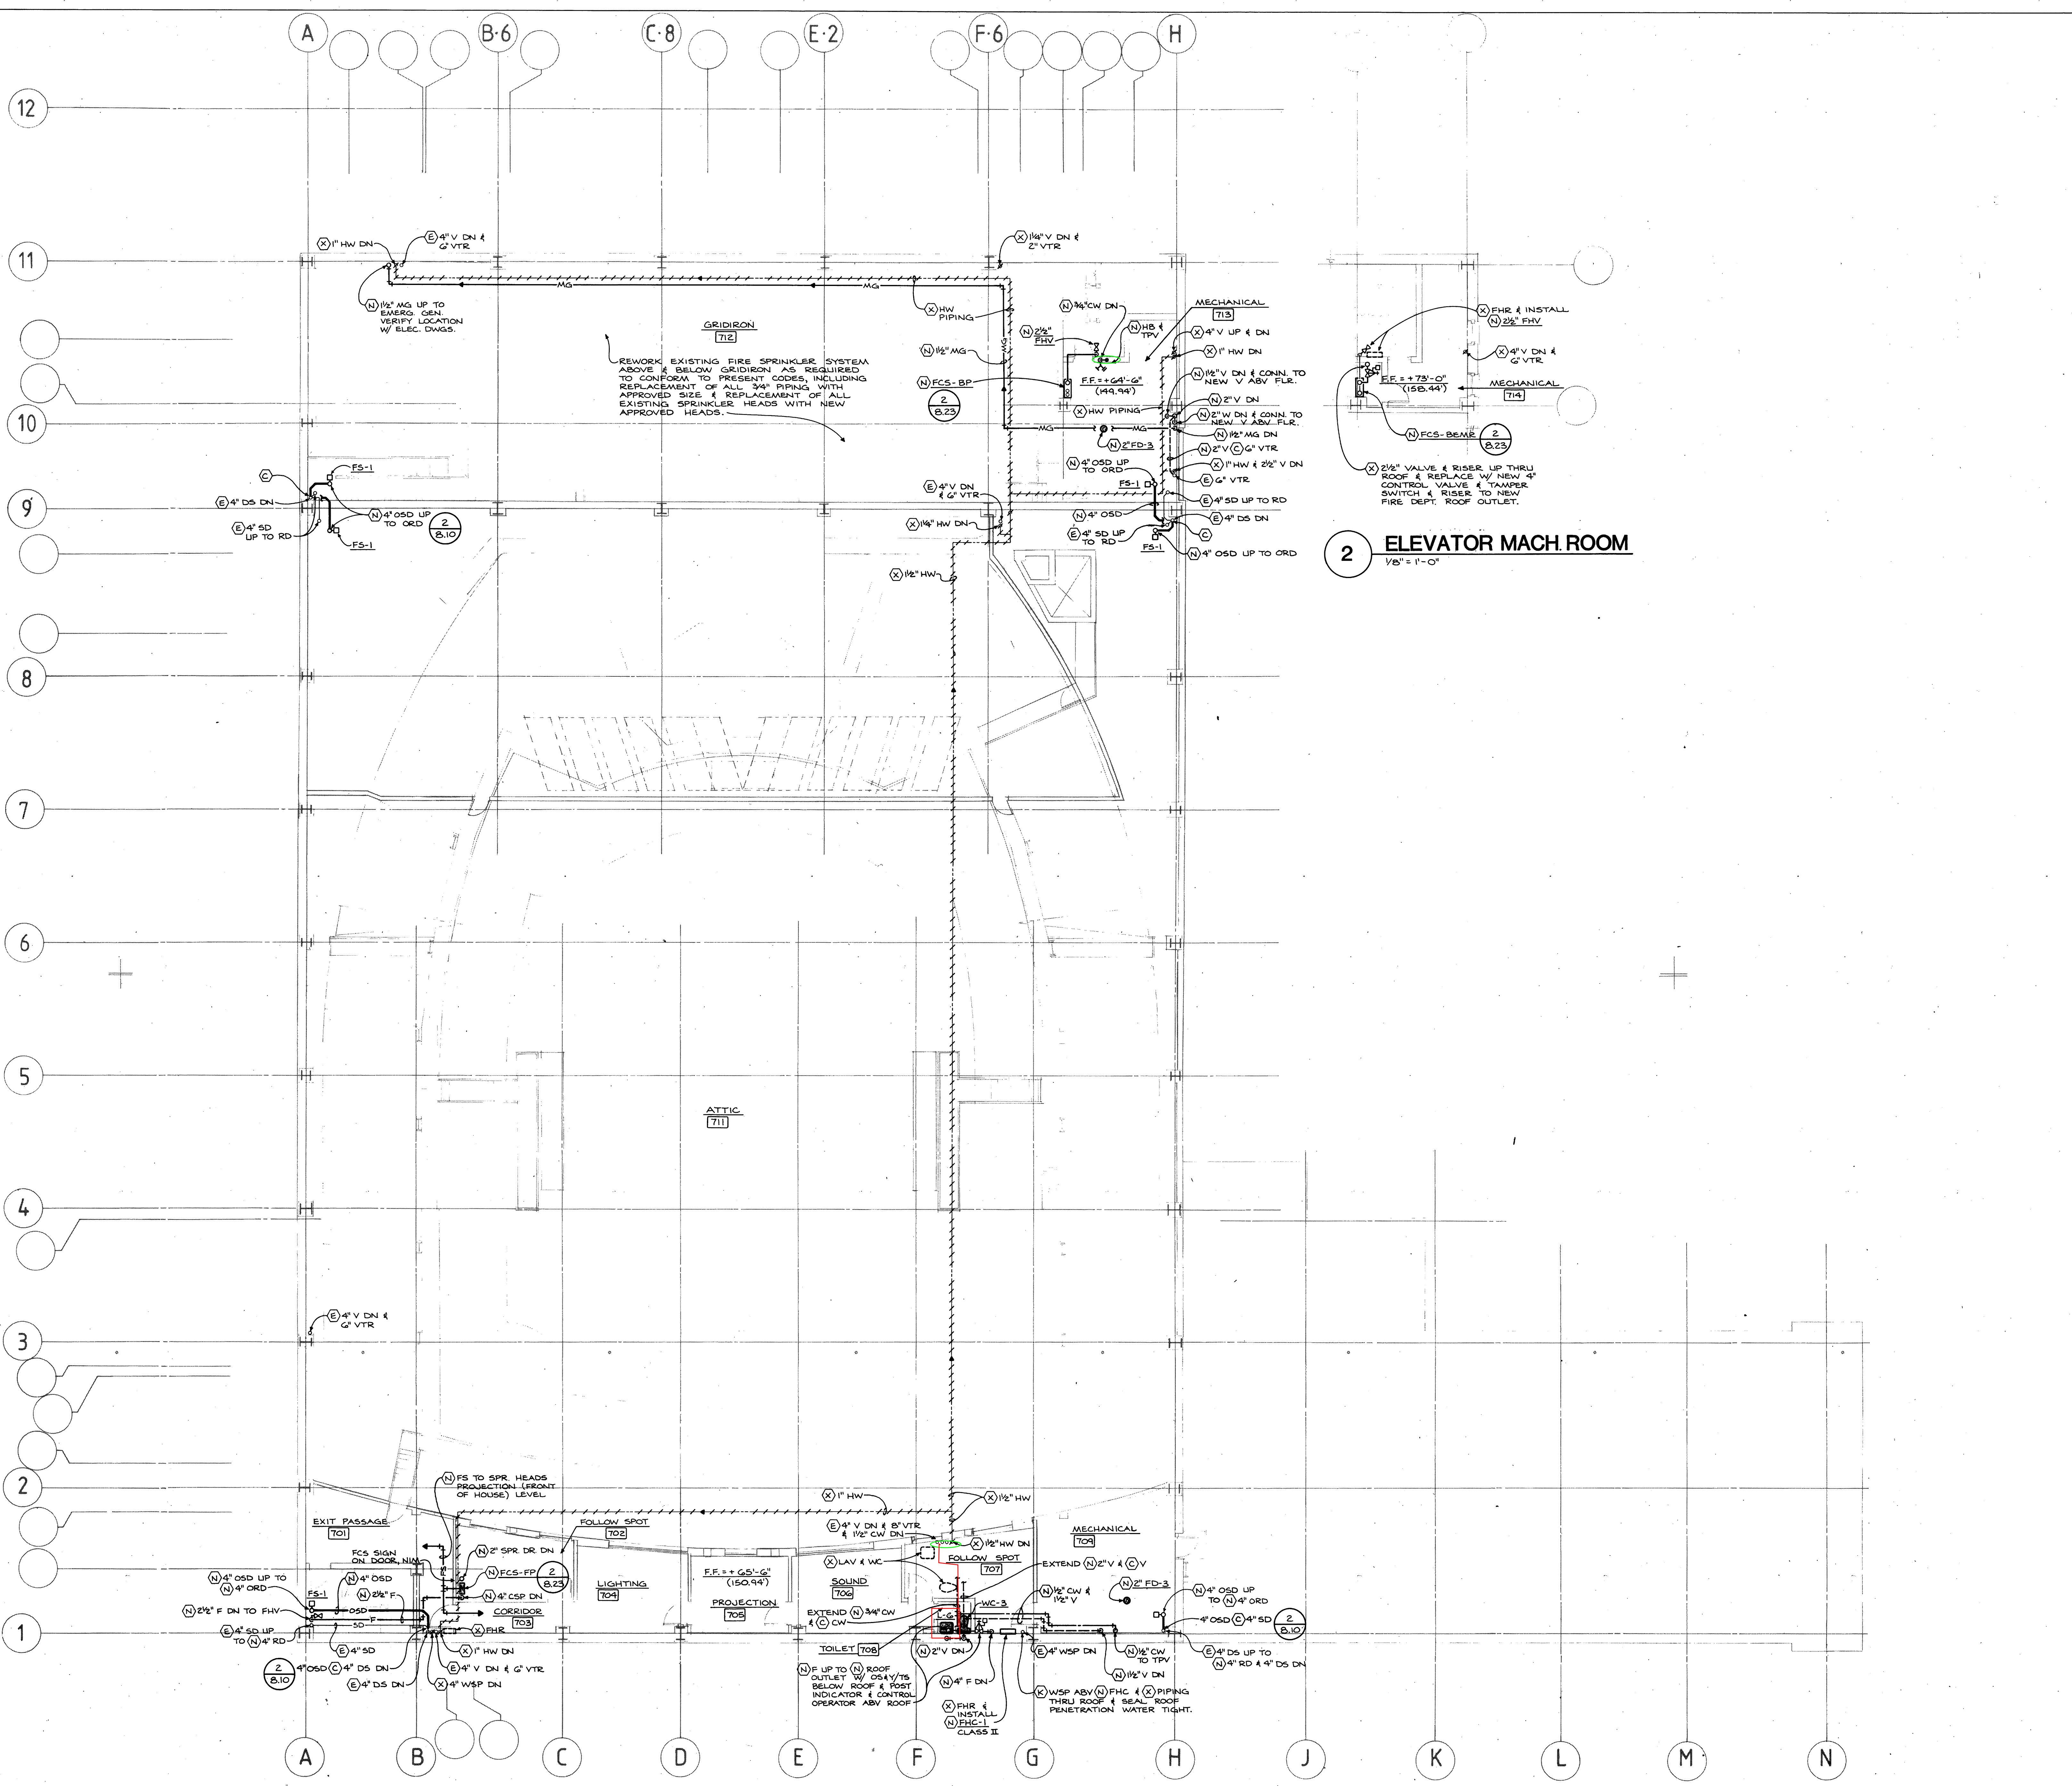

# Portland Center for the Performing Arts



The City of Portland  
 Honorable Mildred A. Schwab;  
 Commissioner in Charge  
 Ronald K. Ragen; Chairman  
 Performing Arts Center  
 Committee

Broome, Oringdalph, O'Toole, Rudolf & Associates, P.C.  
 ELS Design Group  
 Barton Myers  
 Theatre Projects, Inc.  
 R. Lawrence Kirkegaard & Associates  
 Interface Engineering, Inc.  
 C.W. Timmer & Associates  
 CH2M Hill  
 Project Address:  
 733 N.W. 20th Avenue  
 Portland, Oregon 97209  
 (503) 226-1575



## PROJECTION LEVEL PLAN PLBG. & F.P.

Job No.	Date
Set No.	Sheet No.
<b>8.9</b>	

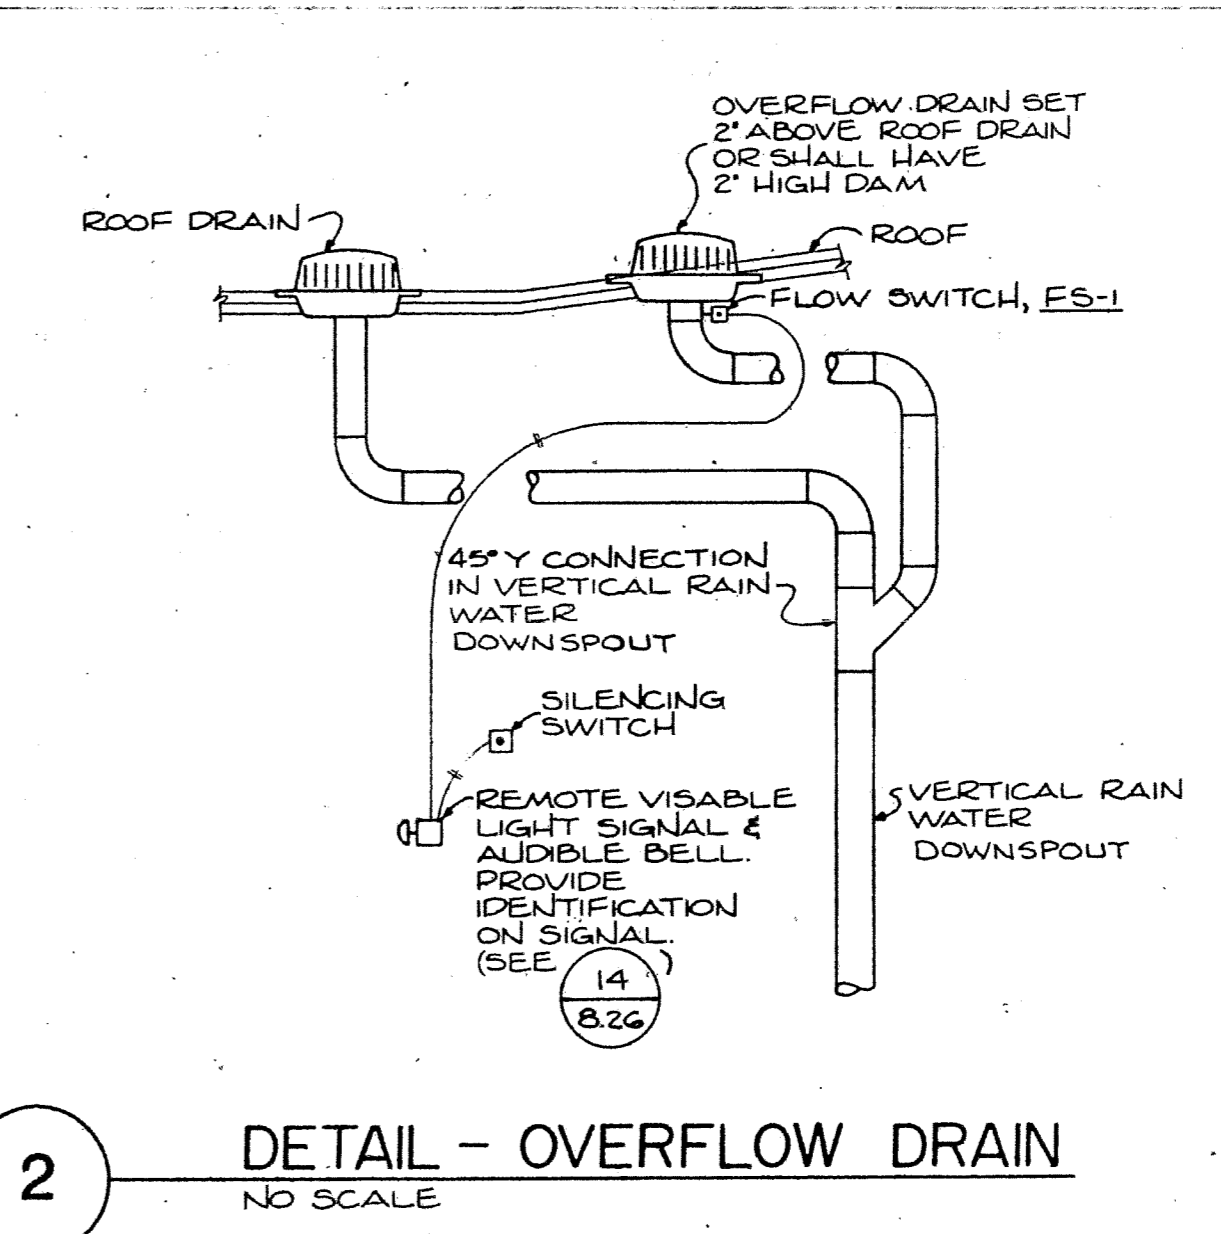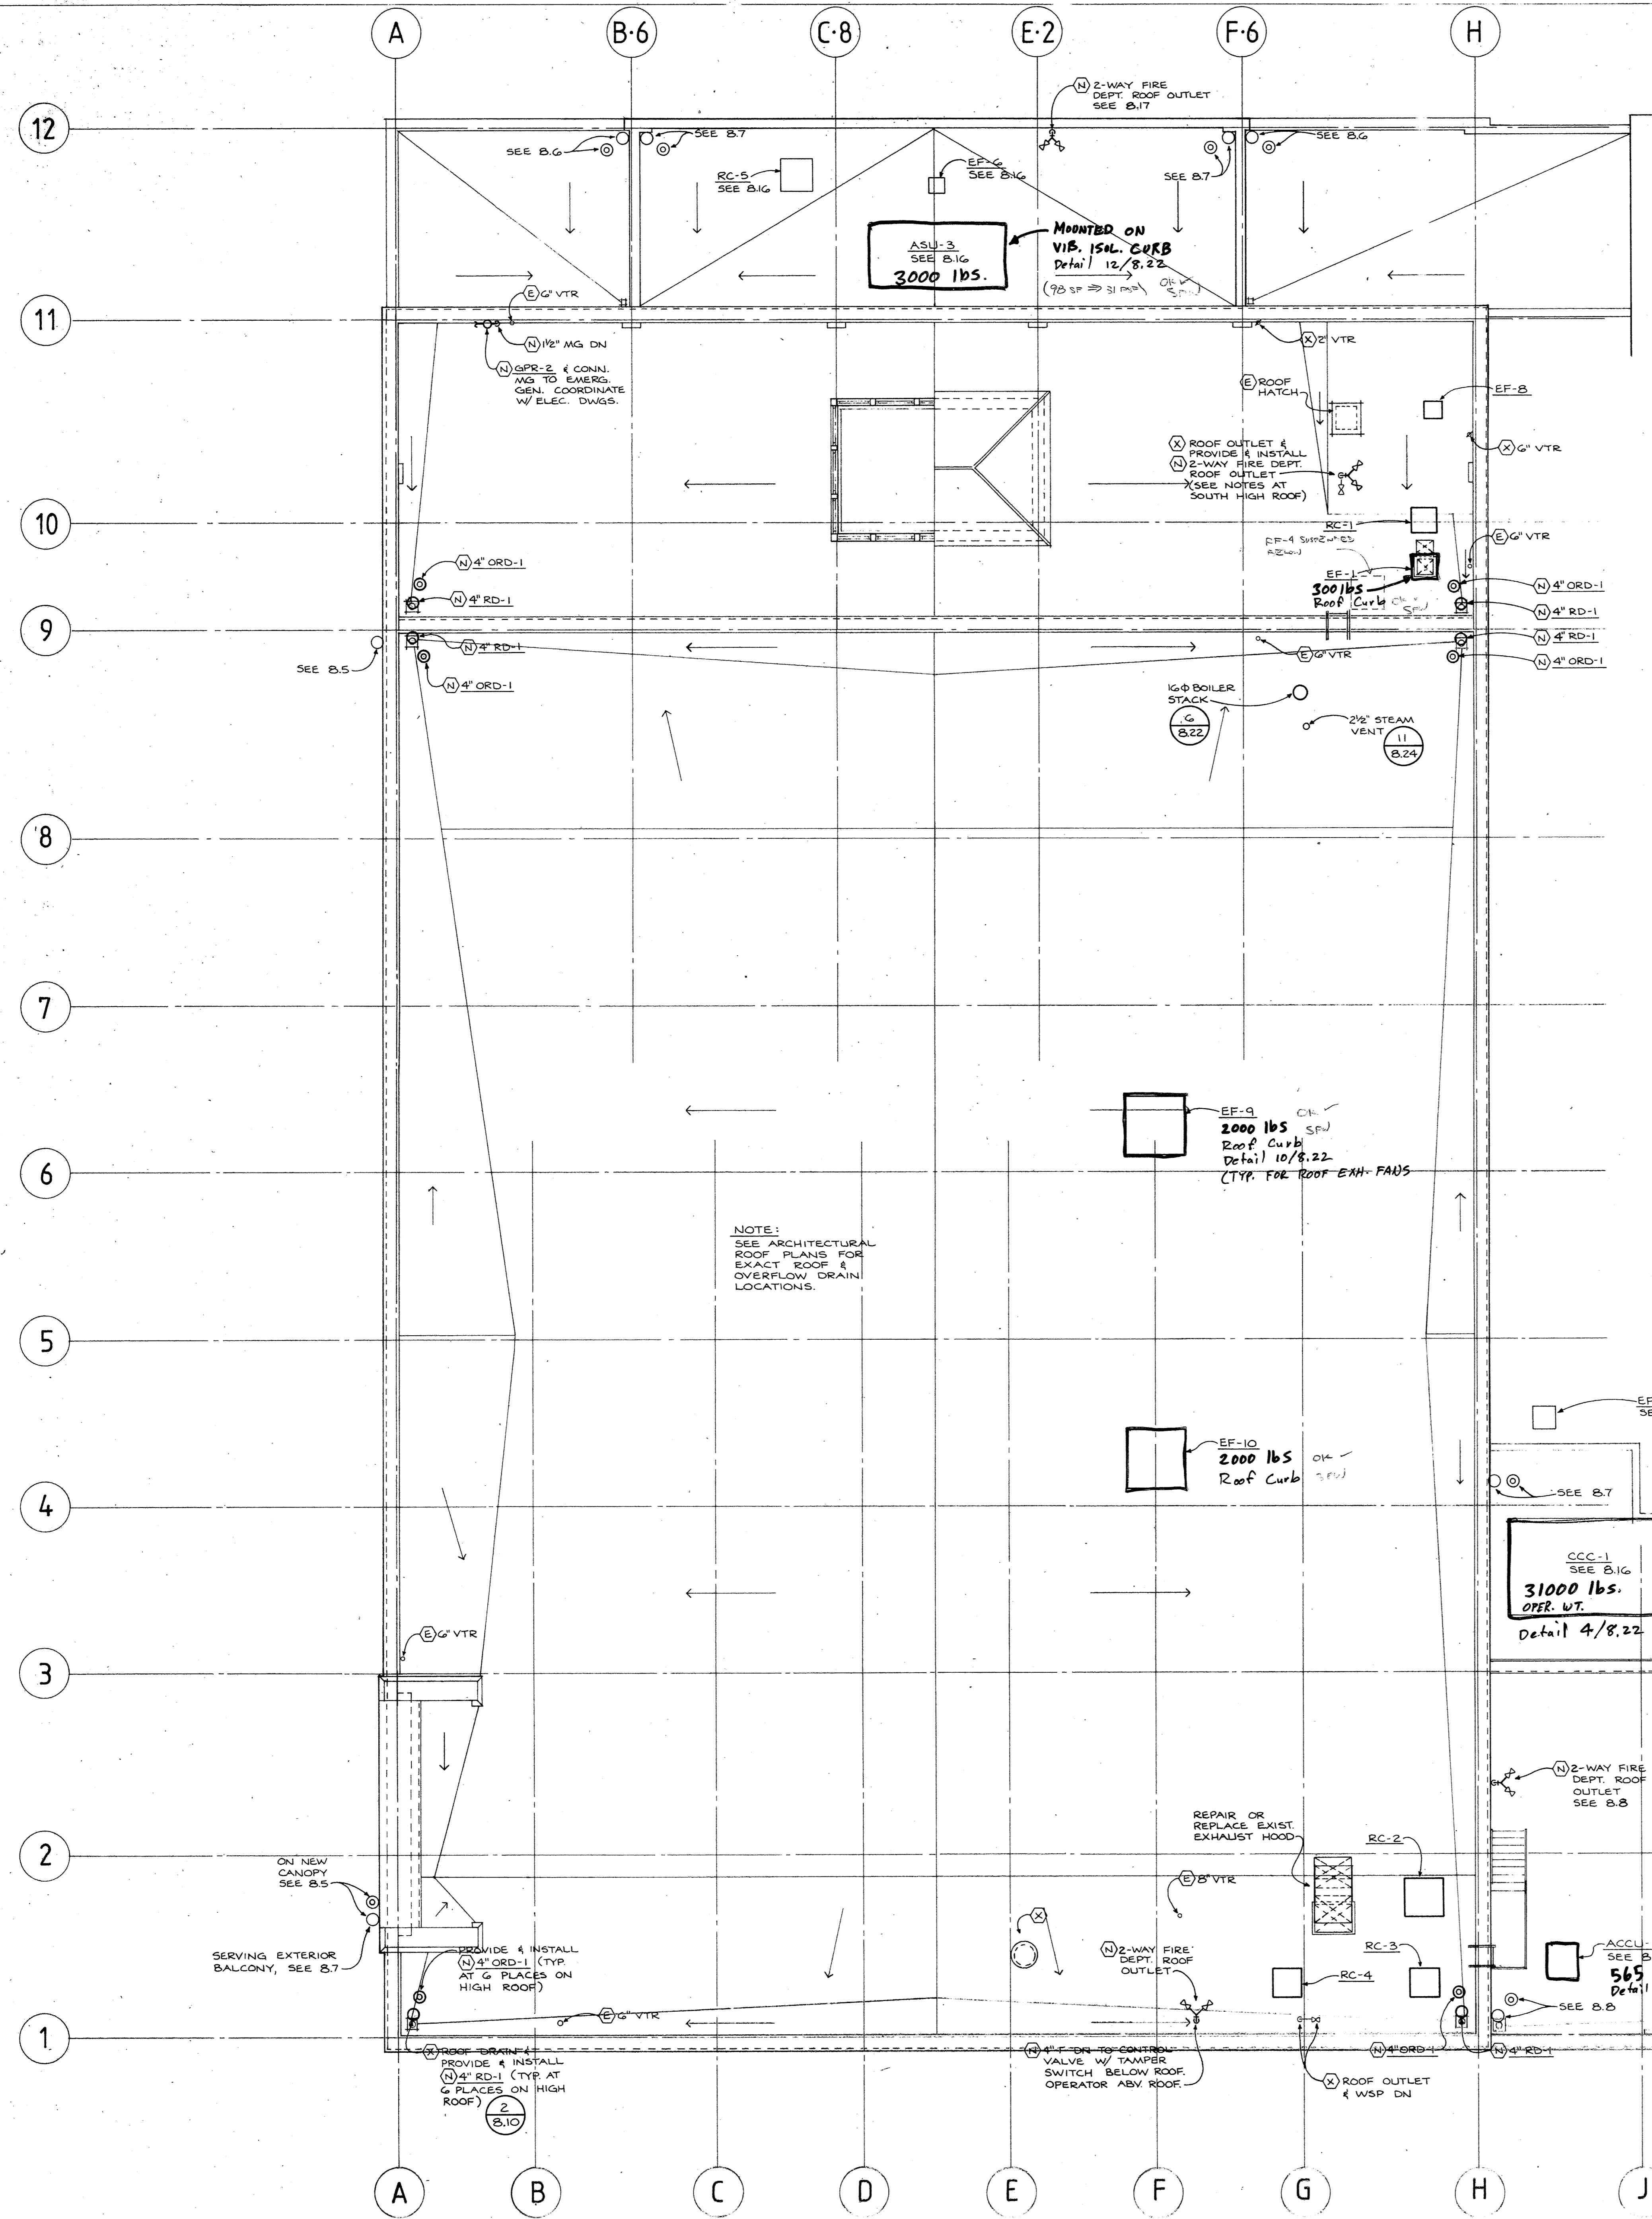

NOTES:  
SEE ARCHITECTURAL  
ROOF PLANS FOR  
EXACT ROOF &  
OVERFLOW DRAIN  
LOCATIONS.


REVIEWED FOR CONSTRUCTION BY  
ORIGINAL MECHANICAL DESIGNER  
SEE NEW MECHANICAL CALCULATIONS  
SPW = LJE 1-26-84  
CH2M Hill, Inc.

1693-20


**Portland Performing Arts Center**  
**ROOF PLAN**  
**MECHANICAL**

8.10


ROOF PLAN

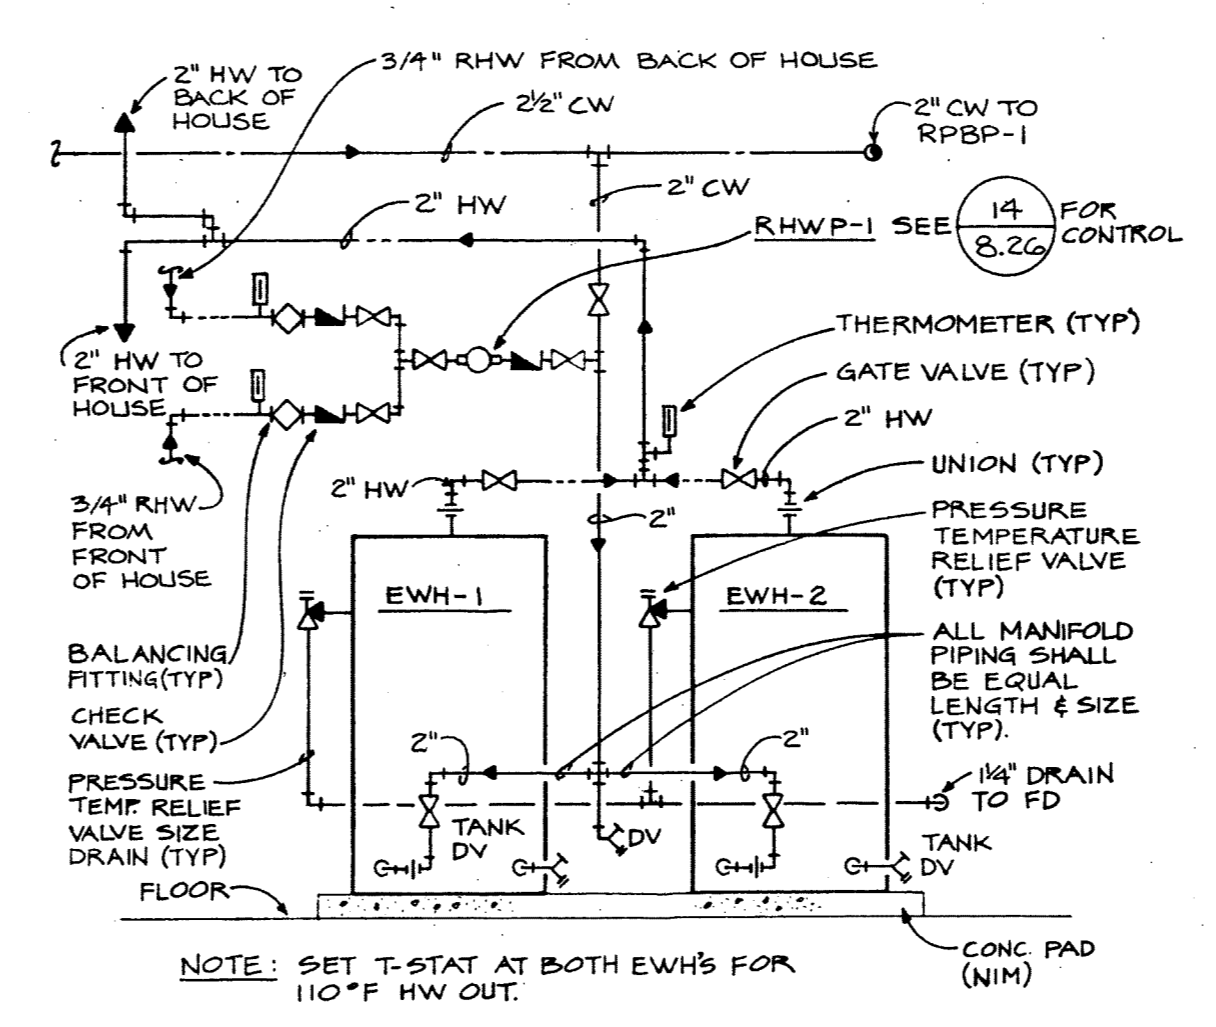

3 DETAIL - MANIFOLDED ELECTRIC WATER HEATER - EWH-1 & EWH-2  
NO SCALE

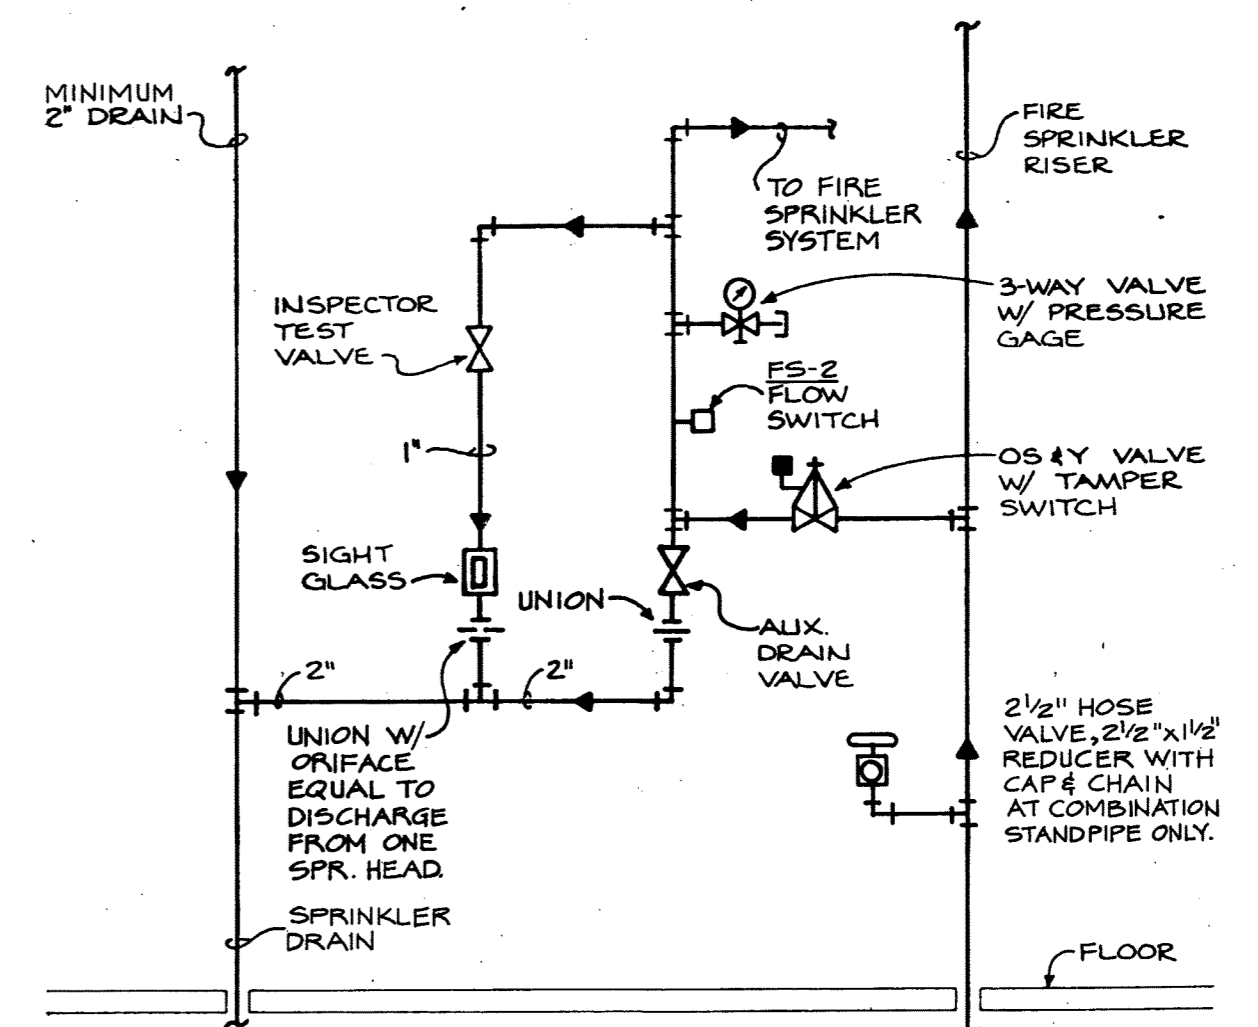

2 DETAIL - FLOOR CONTROL STATION  
NO SCALE

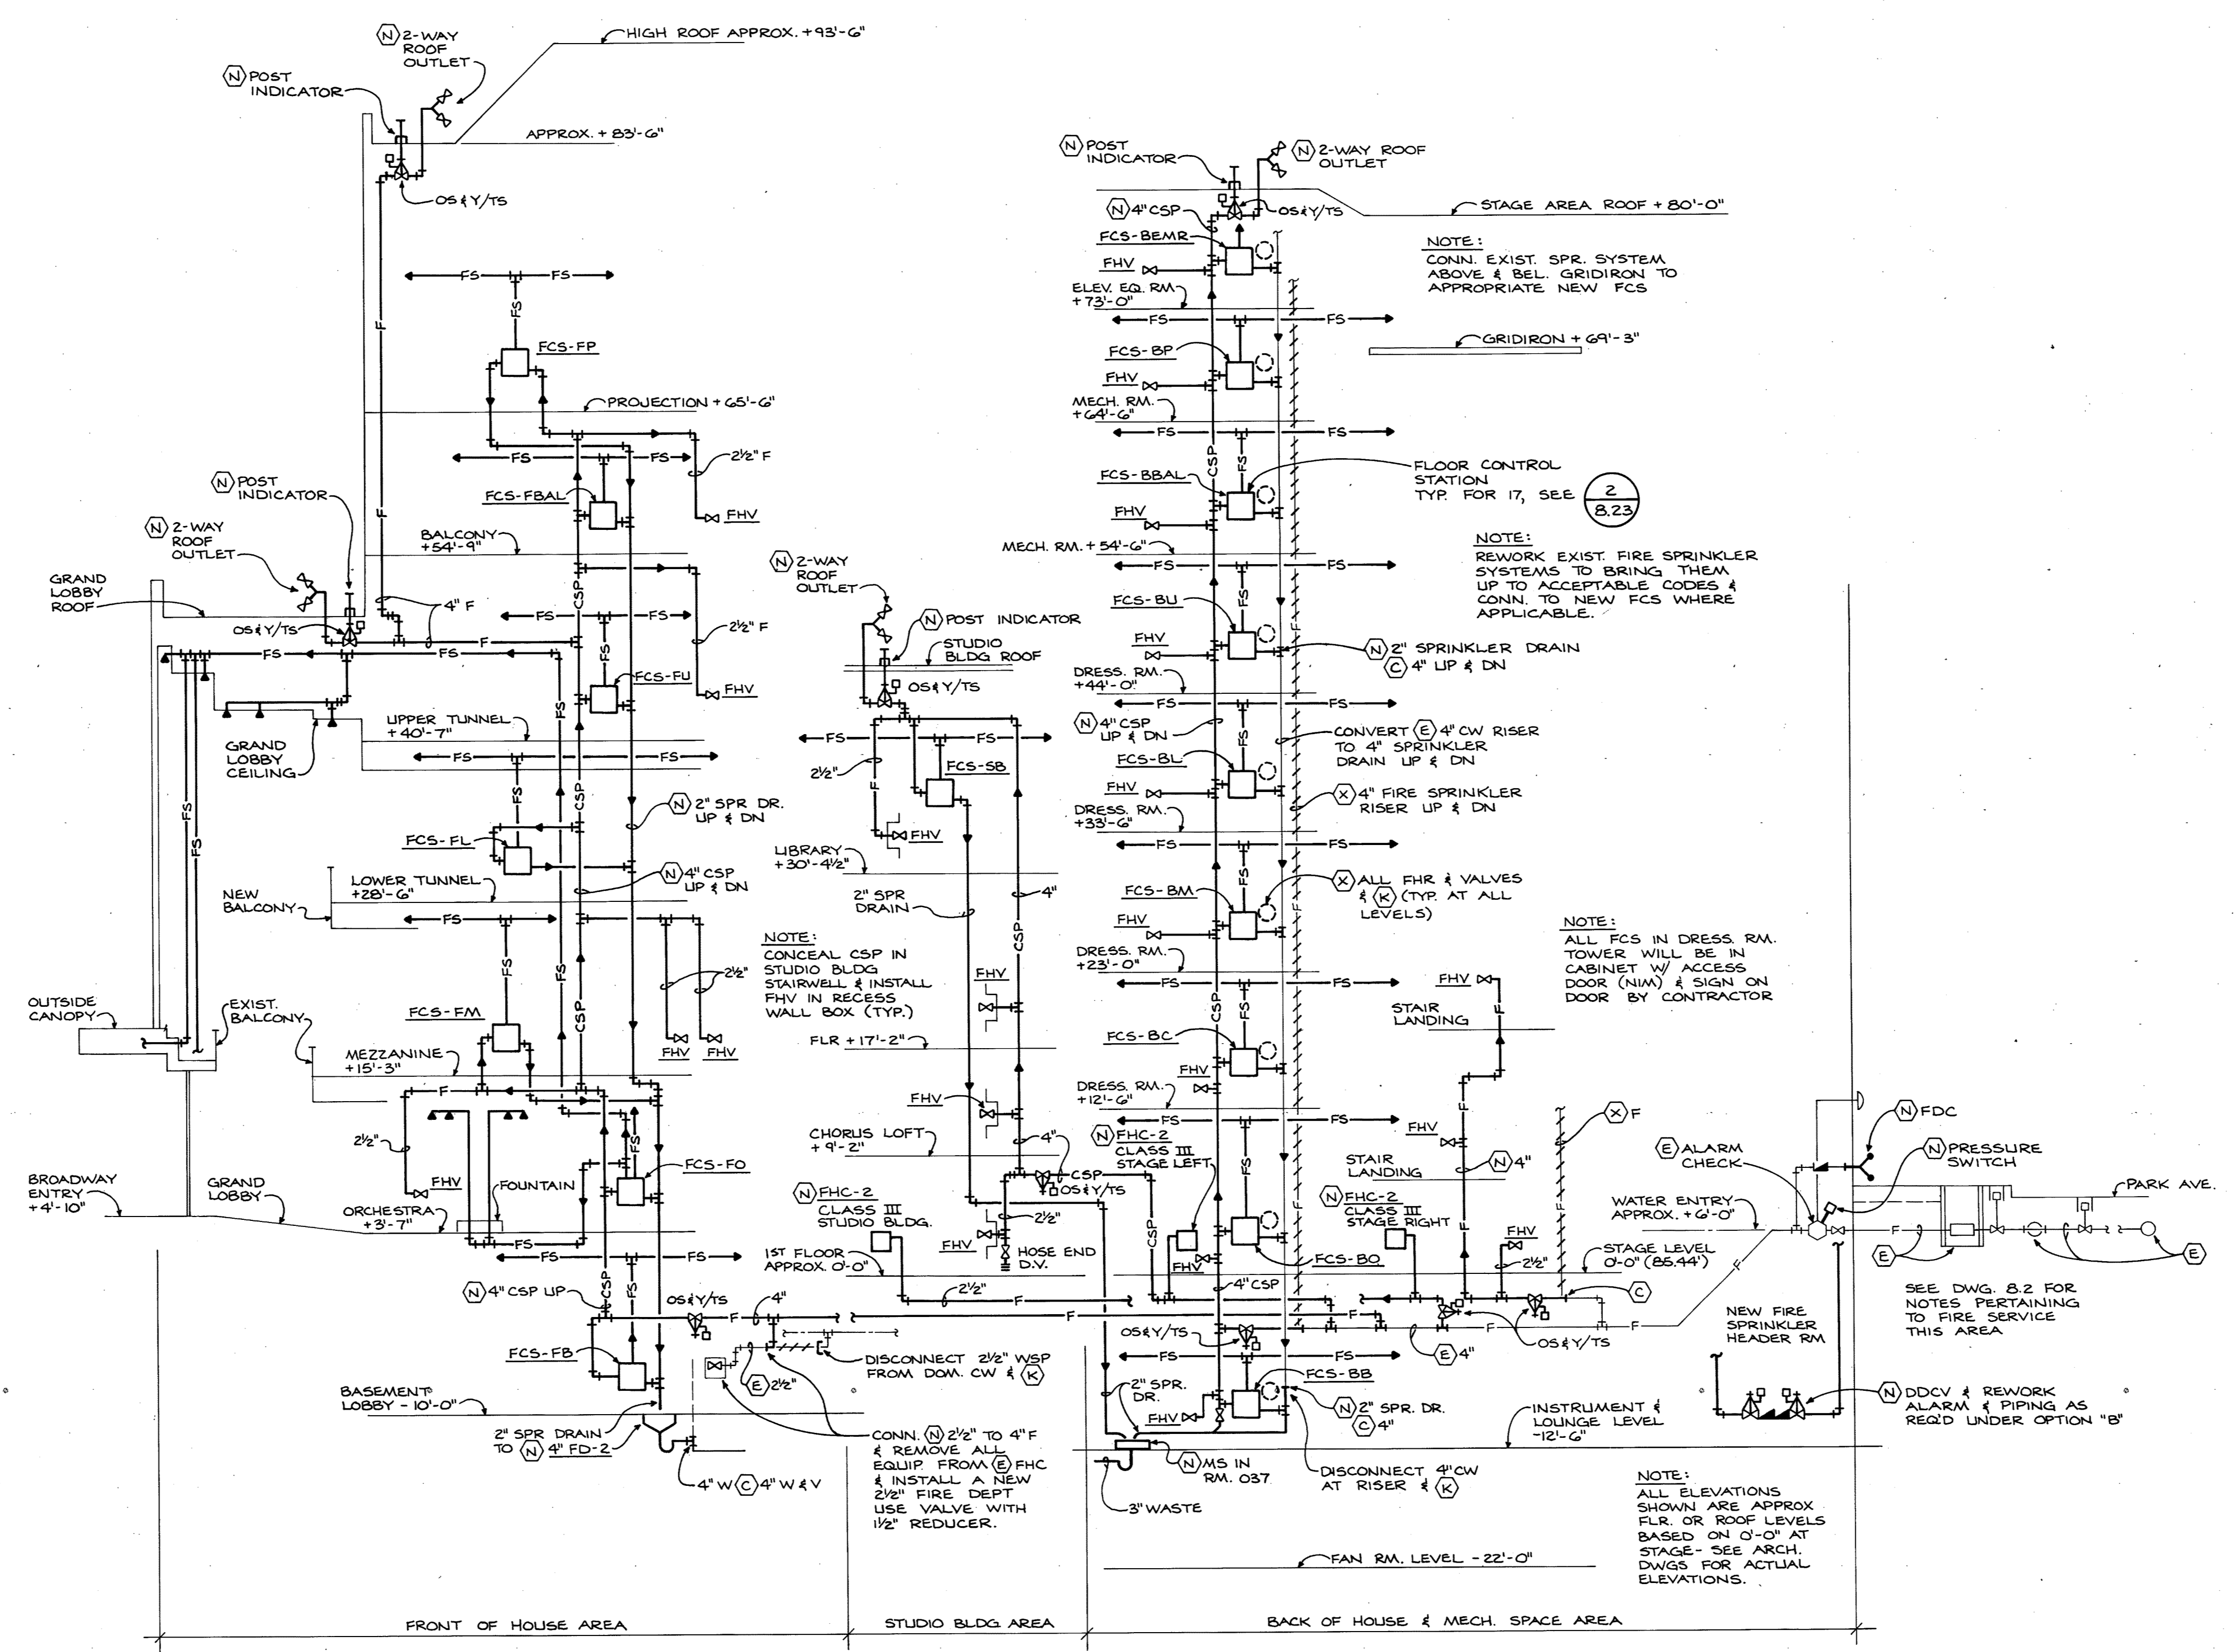

1 FIRE PROTECTION PIPING DIAGRAM  
NO SCALE

# Portland Center for the Performing Arts

The City of Portland  
Honorable Mildred A. Schwab;  
Commissioner in Charge  
Ronald K. Ragen; Chairman  
Performing Arts Center  
Committee

Broome, Oringdolph, O'Toole, Rudolf & Associates, P.C.  
ELS Design Group  
Baron Myers  
Theatre Projects, Inc.  
R. Lawrence Kirkegaard & Associates  
Interface Engineering, Inc.  
C.W. Timmer & Associates  
CH2M Hill  
Project Address:  
733 N.W. 20th Avenue  
Portland, Oregon 97209  
(503) 226-1575



## DIAGRAMS & DETAILS PLBG. & F.P.

Job No.	Date
Set No.	Sheet No.
8.23	


### LEGEND

### GENERAL NOTES


HWS	HWS	HEATING WATER SUPPLY
HWR	HWR	HEATING WATER RETURN
CWS	CWS	CHILLED WATER SUPPLY
CWR	CWR	CHILLED WATER RETURN
CLW	CLW	CONDENSER LEAVING WATER
CRW	CRW	CONDENSER RETURN WATER
RRV	RRV	REFRIGERANT RELIEF VENT
RL	RL	REFRIGERANT LIQUID
RS	RS	REFRIGERANT SUCTION
RHG	RHG	REFRIGERANT HOT GAS
DOS	DOS	DIESEL OIL SUPPLY
DOR	DOR	DIESEL OIL RETURN
CD	CD	CONDENSATE DRAIN
W	W	SANITARY SOIL OR WASTE ABOVE FLOOR
D	D	SANITARY SOIL OR WASTE BELOW GRADE OR FLOOR
SD	SD	INDIRECT WASTE OR DRAIN ABOVE FLOOR
SD	SD	STORM DRAIN ABOVE FLOOR
SD	SD	STORM DRAIN BELOW GRADE OR FLOOR
V	V	VENT
CM	CM	COLD WATER
PCM	PCM	PROCESS COLD WATER
HW	HW	HOT WATER
HMTM	HMTM	HOT WATER TEMPERATURE MAINTAINED
F	F	FIRE PROTECTION (WET)
FS	FS	FIRE SPRINKLER PIPE (FROM FCS)
CSP	CSP	COMBINATION STANDPIPE
WSP	WSP	WET STANDPIPE
MG	MG	NATURAL GAS (MEDIUM PRESSURE - 2 PSI)
G	G	NATURAL GAS (LOW PRESSURE - 11" W.C.)
V(G)	V(G)	VENT (GAS)
A	A	COMPRESSED AIR
HT	HT	HEAT TAPE
TPL	TPL	TRAP PRIMER LINE
ARW	ARW	ACID RESISTING WASTE
ARV	ARV	ACID RESISTING VENT
IRW	IRW	IRRIGATION WATER

DS&Y	OUTSIDE SCREW AND YOKE VALVE
GV	GATE VALVE
BLV	GLOBE VALVE
BV	BALL VALVE
GC	GAS COCK
CKV	CHECK VALVE
BWV	BACKWATER VALVE
BFV	BUTTERFLY VALVE
BAL	BALANCING FITTING
FCV	FLOW CONTROL VALVE
MV	TWO-WAY MOTORIZED VALVE
MV	THREE-WAY MOTORIZED VALVE
MV	MOTORIZED BUTTERFLY VALVE
PRV	PRESSURE REDUCING VALVE
RV	PRESSURE RELIEF VALVE
PTRV	PRESSURE TEMPERATURE RELIEF VALVE
	COMPRESSED AIR OUTLET
WH	WALL HYDRANT
DV	HOSE END DRAIN VALVE
HB	HOSE BIBB
AV	AIR VENT
WHA	WATER HAMMER ARRESTOR
TPV	TRAP PRIMER VALVE
STR	STRAINER WITH HOSE END DRAIN VALVE

	UNION, FLANGE
	PIPE REDUCER
	SPRINKLER HEAD - UPRIGHT/PENDENT & SIDEMALL
	SPRINKLER HEAD - DRY PENDENT, 45° DRY PENDENT
	PRESSURE GAGE WITH GAGE COCK
	GAGE COCK
	THERMOMETER
FS	FLOW SWITCH
	IMMERSION THERMOSTAT
	PITCHED DOWN
PTT	PRESSURE TEMPERATURE TAP
	DIRECTION OF FLOW
	VALVE IN RISER
	CAP OR PLUG
CTG	CLEANOUT TO GRADE
FCO	FLOOR CLEANOUT
WCO	WALL CLEANOUT
CO	CLEANOUT PLUG
TS	TAMPER SWITCH
	SQUARE FEET

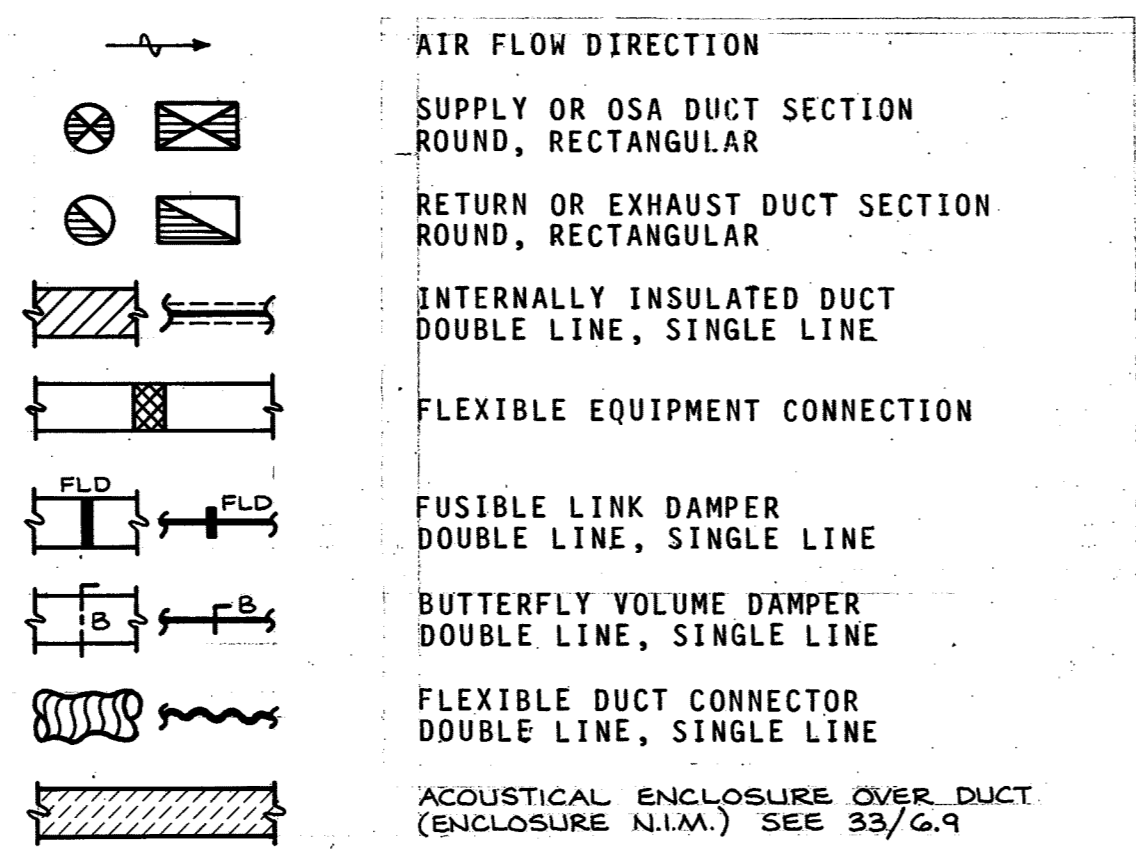

HWB	HEATING WATER BOILER
WCU	WATER CHILLER UNIT
HWP	HEATING WATER PUMP
CWP	CHILLED WATER PUMP
CDP	CONDENSER WATER PUMP
CT	COOLING TOWER
ACCU	AIR COOLED CONDENSING UNIT
ASU	AIR SUPPLY UNIT
MZU	MULTIZONE UNIT
SF	SUPPLY FAN
RF	RETURN FAN
EF	EXHAUST FAN
REF	ROOF EXHAUST FAN
CUH	CABINET UNIT HEATER
UH	UNIT HEATER
TU	TERMINAL UNIT
BHC	BOOSTER HEATING COIL
EHC	ELECTRIC HEATING COIL
HC	HEATING COIL
CC	COOLING COIL
OSA	OUTSIDE AIR
AUD	AUTOMATIC DAMPER
OAD	OUTSIDE AIR DAMPER
RAD	RETURN AIR DAMPER
EAD	EXHAUST AIR DAMPER
SMD	SMOKE DAMPER
SPS	STATIC PRESSURE SENSOR
Ø	ROUND DUCT DIAMETER, INCHES
32x14	RECTANGULAR DUCT SIZE, INCHES
CS	CEILING SUPPLY DIFFUSER
CR	CEILING RETURN GRILLE
CE	CEILING EXHAUST GRILLE
HS	HIGH SUPPLY GRILLE
HR	HIGH RETURN GRILLE
HE	HIGH EXHAUST GRILLE
LR	LOW RETURN GRILLE
LDS	LINEAR DUCT SUPPLY
LDR	LINEAR DUCT RETURN
DDCU	DIRECT DIGITAL CONTROL UNIT
FCP	FAN CONTROL PANEL
MCC	MOTOR CONTROL CENTER (SEE ELECT.)
TP	ROOM THERMOSTAT
	TRANSFER PUMP (DIESEL OIL)

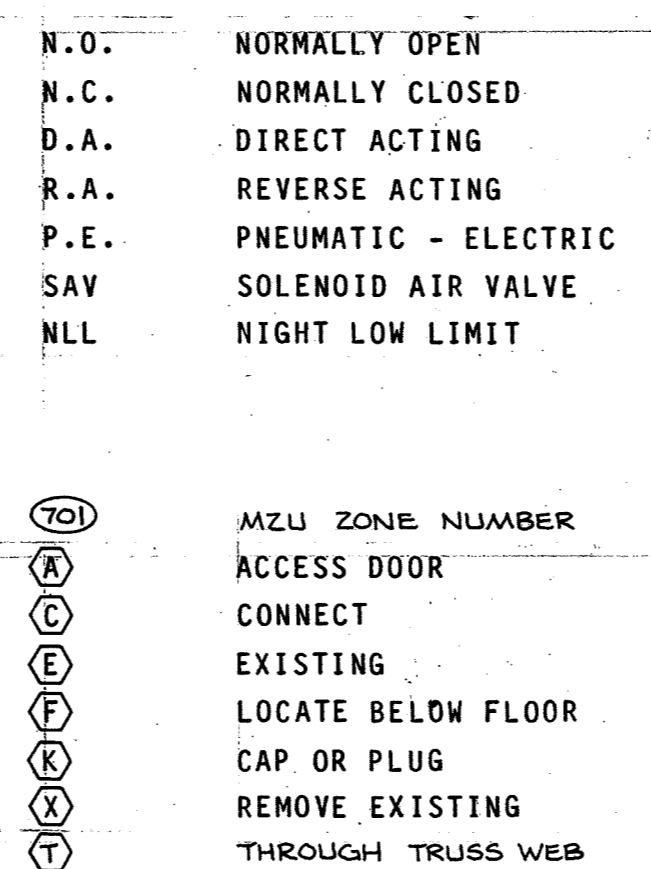

N.O.	NORMALLY OPEN
N.C.	NORMALLY CLOSED
D.A.	DIRECT ACTING
R.A.	REVERSE ACTING
P.E.	PNEUMATIC - ELECTRIC
SAV	SOLENOID AIR VALVE
NLL	NIGHT LOW LIMIT
(70)	MZU ZONE NUMBER
(A)	ACCESS DOOR
(C)	CONNECT
(E)	EXISTING
(F)	LOCATE BELOW FLOOR
(P)	CAP OR PLUG
(X)	REMOVE EXISTING
(T)	THROUGH TRUSS WEB

WC	WATER CLOSET
U	URINAL
L	LAVATORY
S	SINK
SS	SERVICE SINK
MS	MOP SINK
SHR	SHOWER
DF	DRINKING FOUNTAIN
EWH	ELECTRIC WATER HEATER
RPBP	REDUCED PRESSURE BACKFLOW PREVENTER
DCA	DOUBLE CHECK VALVE ASSEMBLY
DDCVA	DOUBLE DETECTOR CHECK VALVE ASSEMBLY
FHC	FIRE HOSE CABINET
FCS	FLOOR CONTROL STATION
FDC	FIRE DEPARTMENT CONNECTION
FH	FIRE HYDRANT
FHV	FIRE HOSE VALVE
HDR	HEADER
CB	CATCH BASIN
AD	AREA DRAIN
FS	FLOOR SINK
FD	FLOOR DRAIN
SHD	SHOWER DRAIN
DS	DOWNSPOUT
RD	ROOF DRAIN
ORD	OVERFLOW ROOF DRAIN
VTR	VENT THROUGH ROOF
MH	MANHOLE
CIP	CAST IRON PIPE
CSP	CONCRETE SEWER PIPE
CONC	CONCRETE
TC	TOP OF CURB
I.E.	INVERT ELEVATION
EL	ELEVATION
R1&C	ROUGH-IN AND CONNECT
NIM	NOT IN MECHANICAL SPECIFIED UNDER ANOTHER DIVISION
SOV	SHUT-OFF VALVE (GATE UNLESS OTHERWISE NOTED)
ASR	AUTOMATIC SPRINKLER RISER
ASD	AUTOMATIC SPRINKLER DRAIN
AGD	AIR GAP DRAIN

1. THE CONTRACTOR SHALL RECORD ALL INVERT ELEVATIONS, PIPE SIZES, LOCATIONS, AND ANY OTHER DEVIATIONS FROM CONTRACT DRAWINGS, ON AS-BUILT DRAWINGS.
2. ALL END OF WASTE PIPING RUN LAVATORIES, SINKS, AND DRINKING FOUNTAINS SHALL HAVE A WALL CLEANOUT BELOW FIXTURE.
3. REFER TO ARCHITECTURAL DOCUMENTS FOR EXACT LOCATION AND HEIGHT OF ALL PLUMBING FIXTURES. COORDINATE WITH ALL OTHER TRADES.
4. PROVIDE & INSTALL SHUTOFF VALVES ON ALL BRANCH WATER PIPING SERVING FIXTURES AND/OR GROUPS OF FIXTURES OR EQUIPMENT. INSTALL IN LIFTOUT CEILING WHERE POSSIBLE. BEHIND CEILING OR WALL ACCESS PANELS WHERE LIFTOUT CEILING IS NOT AVAILABLE OR AS INDICATED ON THE DRAWINGS. COORDINATE WITH ARCHITECTURAL AND ALL OTHER TRADES.
5. BECAUSE OF THE SMALL SCALE OF THE DRAWINGS, IT IS NOT POSSIBLE TO INDICATE ALL OFFSETS, FITTINGS, VALVES, AND ACCESSORIES WHICH MAY BE REQUIRED. THE CONTRACTOR SHALL CAREFULLY INVESTIGATE THE CONDITIONS SURROUNDING THE INSTALLATION OF HIS WORK AND SHALL FURNISH THE NECESSARY FITTINGS, VALVES, TRAPS, ETC., WHICH MAY BE REQUIRED TO COMPLETE THE INSTALLATION IN A SATISFACTORY AND CODE APPROVED MANNER.
6. WHERE BRANCH PIPE SIZE IS NOT SHOWN ON DRAWINGS, REFER TO PLUMBING FIXTURE ROUGH-IN SCHEDULE FOR REQUIRED PIPE SIZE.
7. ALL FIRE SPRINKLER HEADS HAVE NOT BEEN SHOWN OR SCHEDULED. IT IS THE RESPONSIBILITY OF THE CONTRACTOR TO LOCATE AND INSTALL A COMPLETE FIRE SPRINKLER SYSTEM IN ALL PORTIONS OF THE BUILDING EXCEPT AS SPECIFICALLY NOTED.
8. SEE ARCHITECTURAL REFLECTED CEILING PLANS FOR EXACT LOCATIONS OF PIPE AND DUCTS IN EXPOSED AREAS WITHOUT CEILINGS; ALSO FOR EXACT LOCATIONS OF SPRINKLER HEADS.
9. FOR LOCATIONS OF EXPANSION JOINTS IN GENERAL CONSTRUCTION WORK, SEE ARCHITECTURAL DRAWINGS.
10. THE LOCATIONS OF THE PLUMBING, MECHANICAL, AND FIRE PROTECTION PIPING, EQUIPMENT, DUCTS, AND FIRE SPRINKLER HEADS IS TO BE STRICTLY CONTROLLED IN MANY AREAS. THE ARCHITECTURAL REFLECTED CEILING PLANS AND THE MECHANICAL DRAWINGS INDICATE THE LOCATION OF MANY OF THESE ITEMS AND ANY DEVIATION FROM THESE DRAWINGS MUST BE APPROVED BY THE ARCHITECT PRIOR TO INSTALLATION.

# Portland Center for the Performing Arts

### The City of Portland

Honorable Mildred A. Schwab  
Commissioner in Charge  
Ronald K. Ragen  
Chairman  
Performing Arts Center Committee

### Architects

Broome, Oringulph, O'Toole, Rudolf & Associates pc  
ELS Design Group  
Barton Myers  
Project Address  
733 N.W. 20th Avenue  
Portland, Oregon 97209  
(503) 226-1575

### Consultants

Theatre Projects Inc.  
Theatre Consultants  
R. Lawrence Kirkegaard & Associates  
Acoustician  
CH2M Hill  
Structural Engineers  
C.W. Timmer Associates  
Mechanical Engineers  
Interface Engineering Inc.  
Electrical Engineers



Target	Revision Item	Revision Date
△	Addendum #1	10/29/84
△	Addendum #2	11/06/84
△	Addendum #3	11/13/84
△	Addendum #5	11/21/84
△	Proposal Request #1	03/01/85
△	Proposal Request #2	03/01/85
△	Proposal Request #3	03/01/85
△	Proposal Request #4	03/01/85
△	Proposal Request #5	03/08/85
△	Proposal Request #6	03/01/85
△	Proposal Request #7	03/01/85
△	Proposal Request #8	03/01/85
△	Proposal Request #9	03/01/85
△	Proposal Request #10	03/01/85
△	Proposal Request #11	03/01/85
△	Proposal Request #12	03/01/85
△	Proposal Request #13	03/01/85
△	Proposal Request #14	03/01/85
△	Clarification Items	03/01/85
△	Miscellaneous Items	03/01/85

### Revisions

### New Theatre Building

### LEGEND & NOTES MECHANICAL

Date OCT. 12, 1984

Scale NONE

Drawing No. 8.0

C.W. Timmer Associates Inc.  
Consulting Engineers  
1644 - 20

The City of Portland

Honorable Mildred A. Schwab  
Commissioner in Charge  
Ronald K. Ragen  
Chairman  
Performing Arts Center Committee

Architects  
Broome, Oringdolph, O'Toole, Rudolf & Associates pc  
E.L.S. Design Group  
Barton Myers

Project Address  
733 N.W. 20th Avenue  
Portland, Oregon 97209  
(503) 226-1575

Consultants  
Theatre Projects Inc.  
Theatre Consultants  
R. Lawrence Kirkegaard & Associates  
Acoustician  
CH2M Hill  
Structural Engineers  
C.W. Timmer Associates  
Mechanical Engineers  
Interface Engineering Inc.  
Electrical Engineers



Target	Revision Item	Revision Date
▲	Addendum #1	10/29/84
▲	Addendum #2	11/06/84
▲	Addendum #3	11/13/84
▲	Addendum #4	11/21/84
▲	Addendum #5	03/01/85
▲	Proposal Request #1	03/01/85
▲	Proposal Request #2	03/01/85
▲	Proposal Request #3	03/01/85
▲	Proposal Request #4	03/01/85
▲	Proposal Request #5	03/01/85
▲	Proposal Request #6	03/01/85
▲	Proposal Request #7	03/01/85
▲	Proposal Request #8	03/01/85
▲	Proposal Request #9	03/01/85
▲	Proposal Request #10	03/01/85
▲	Proposal Request #11	03/01/85
▲	Proposal Request #12	03/01/85
▲	Proposal Request #13	03/01/85
▲	Proposal Request #14	03/01/85
▲	Clarification Items	03/01/85
▲	Miscellaneous Items	03/01/85
▲	CLARIFICATION P.P. & L. VAULT	10/01/85
▲	MISC. ITEMS	10/17/85

Revisions

New Theatre Building


## SITE PLAN MECHANICAL

Date OCT. 12, 1984

Scale 1" = 10'-0"

Drawing No. 8.1

C.W. Timmer Associates Inc.  
Consulting Engineers 1649-20

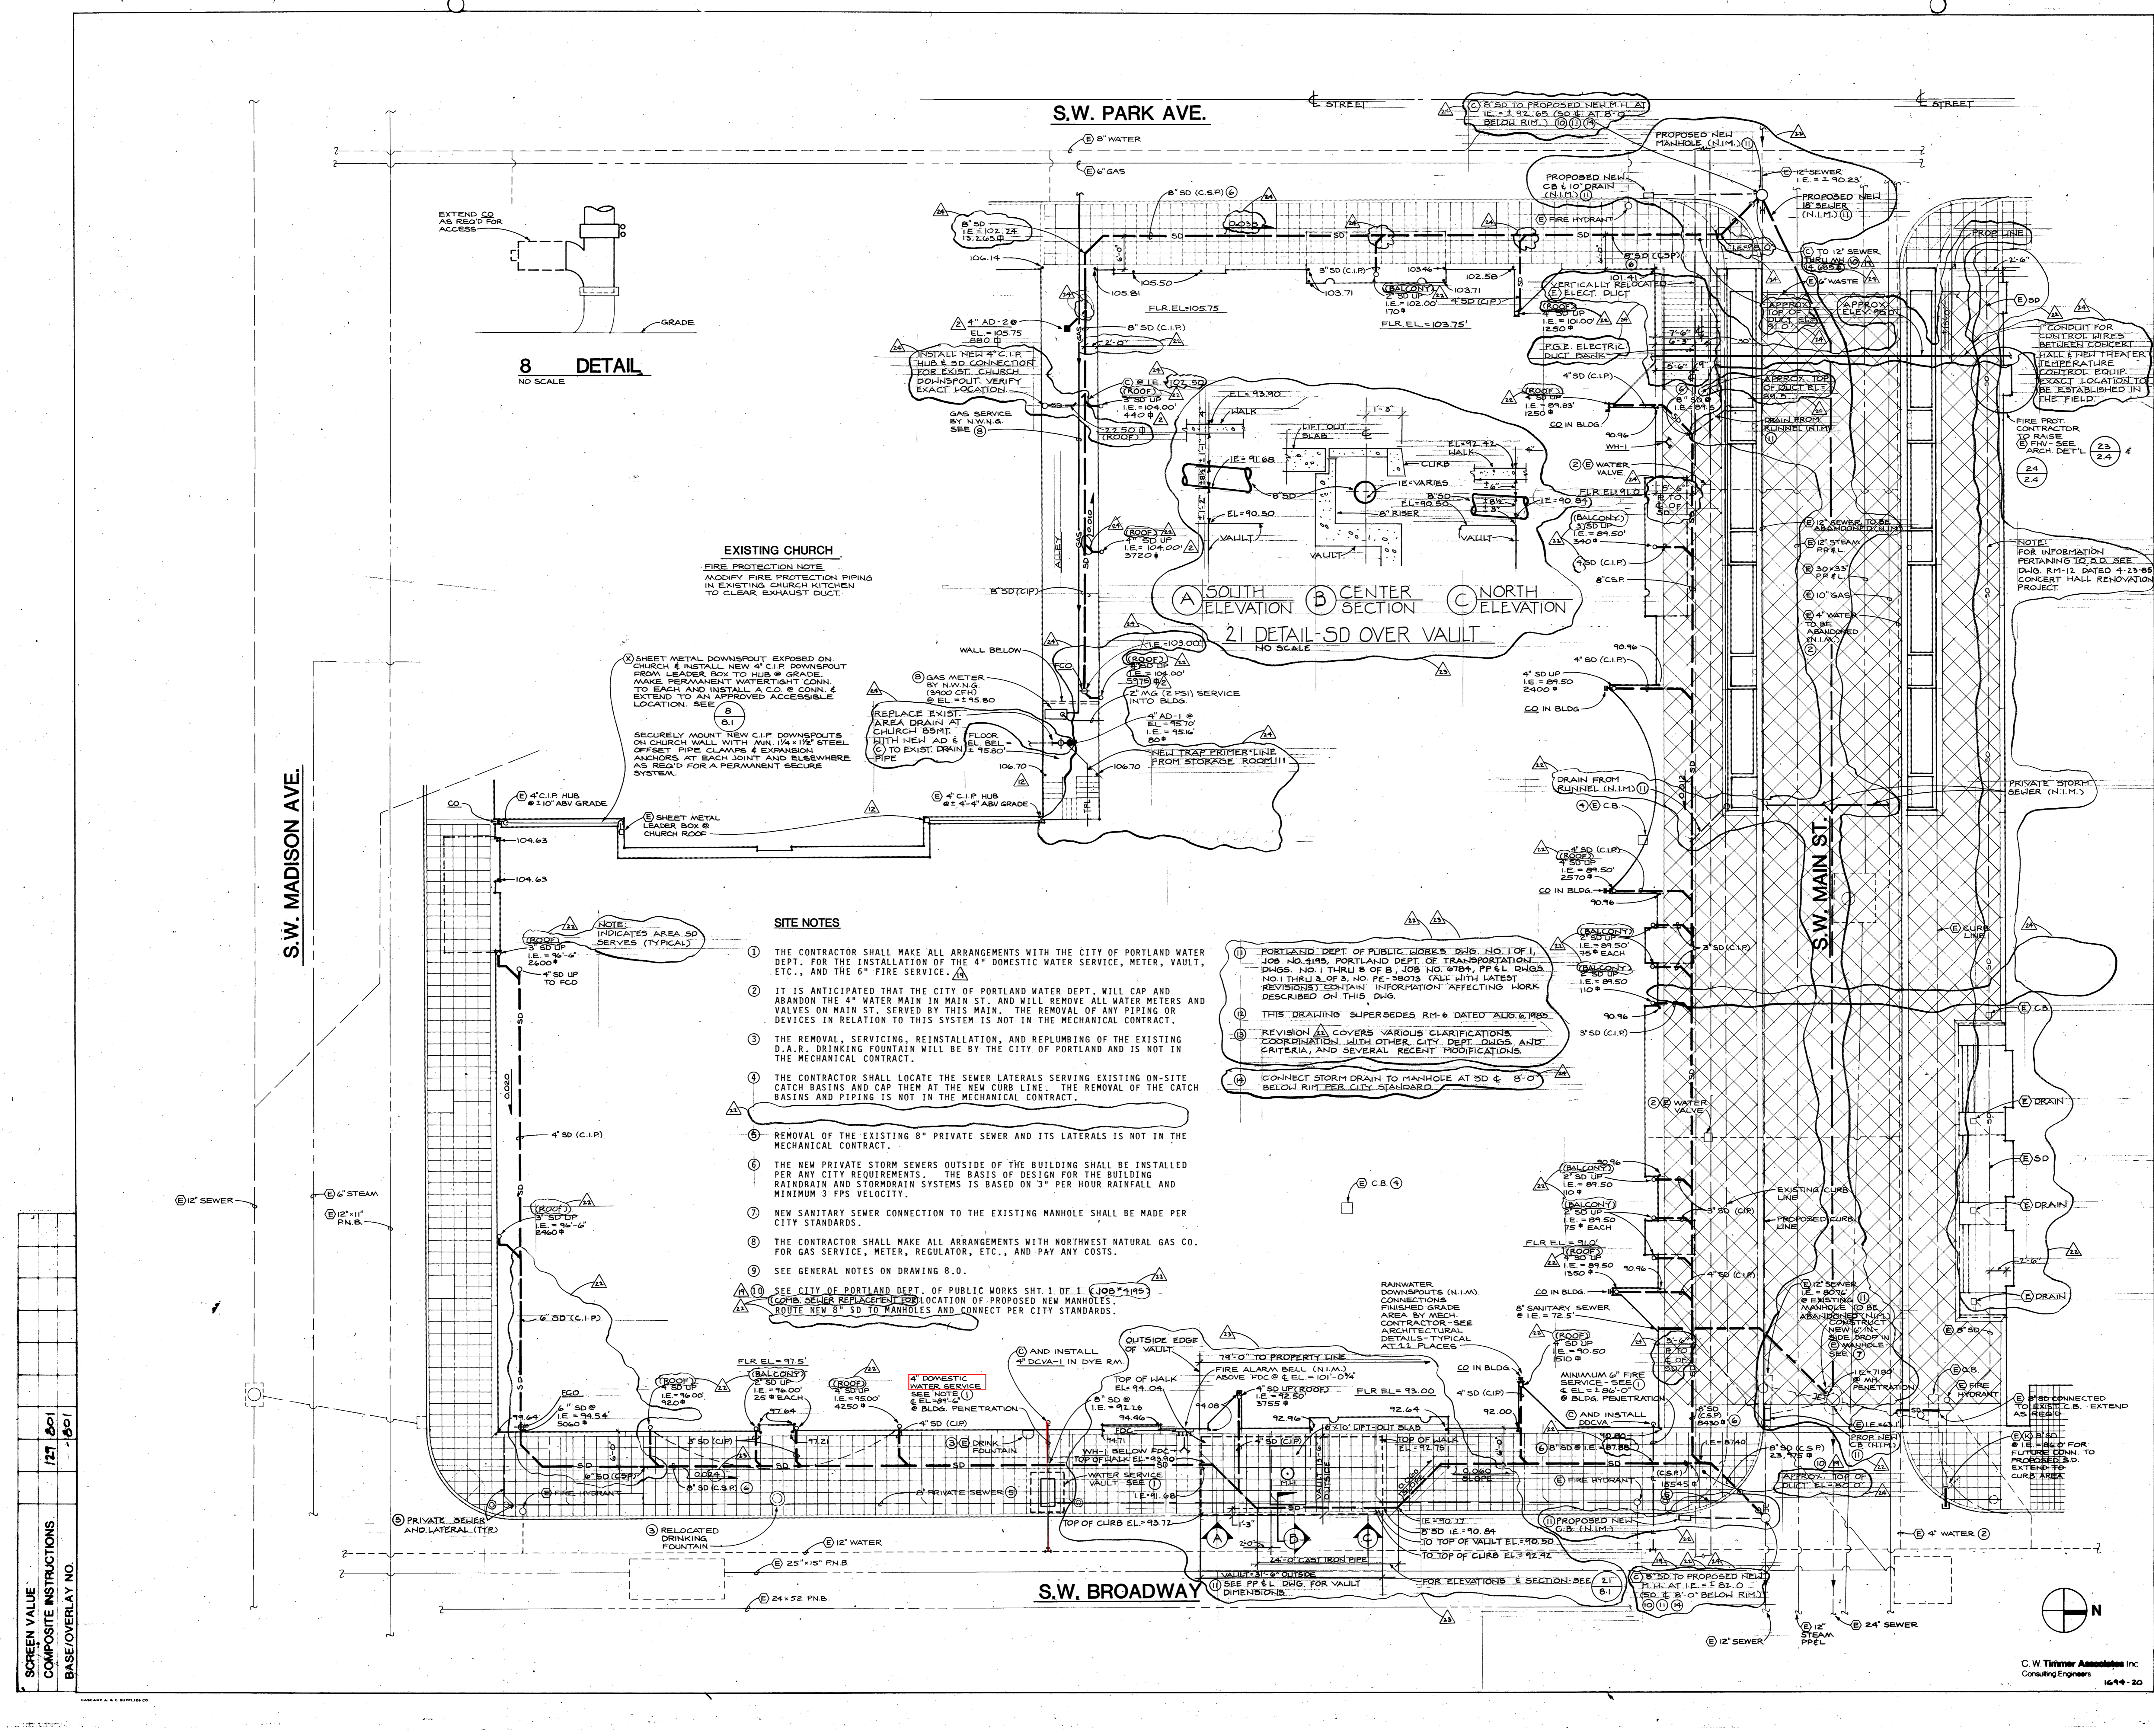

SCREEN VALUE  
COMPOSITE INSTRUCTIONS  
BASE/OVERLAY NO.

# Portland Center for the Performing Arts

The City of Portland

Honorable Mildred A. Schwab  
Commissioner in Charge  
Ronald K. Ragen  
Chairman  
Performing Arts Center Committee

Architects  
Broome, Oringdolph, O'Toole, Rudolf & Associates pc  
ELS Design Group  
Barton Myers  
Project Address  
733 N.W. 20th Avenue  
Portland, Oregon 97209  
(503) 226-1575

Consultants  
Theatre Projects Inc.  
Theatre Consultants  
R. Lawrence Kirkegaard & Associates  
Acoustician  
CH2M Hill  
Structural Engineers  
C.W. Timmer Associates  
Mechanical Engineers  
Interface Engineering Inc.  
Electrical Engineers



Target	Revision Item	Revision Date
▲	Addendum #1	10/29/84
▲	Addendum #2	11/06/84
▲	Addendum #4	11/13/84
▲	Addendum #5	11/23/84
▲	Proposal Request #1	03/01/85
▲	Proposal Request #2	03/01/85
▲	Proposal Request #3	03/01/85
▲	Proposal Request #4	03/01/85
▲	Proposal Request #5	03/08/85
▲	Proposal Request #6	03/01/85
▲	Proposal Request #7	03/01/85
▲	Proposal Request #8	03/01/85
▲	Proposal Request #9	03/01/85
▲	Proposal Request #10	03/01/85
▲	Proposal Request #11	03/01/85
▲	Proposal Request #12	03/01/85
▲	Proposal Request #13	03/01/85
▲	Proposal Request #14	03/01/85
▲	Clarification Items	03/01/85
▲	Miscellaneous Items	03/01/85


Revisions

New Theatre Building

## PLAN LEVEL 70'-0" PLUMBING & FIRE PROTECTION

Date OCT. 12, 1984  
Scale 1/8" = 1'-0"  
Drawing No. 8.2

C.W. Timmer Associates Inc.  
Consulting Engineers  
10-94-20

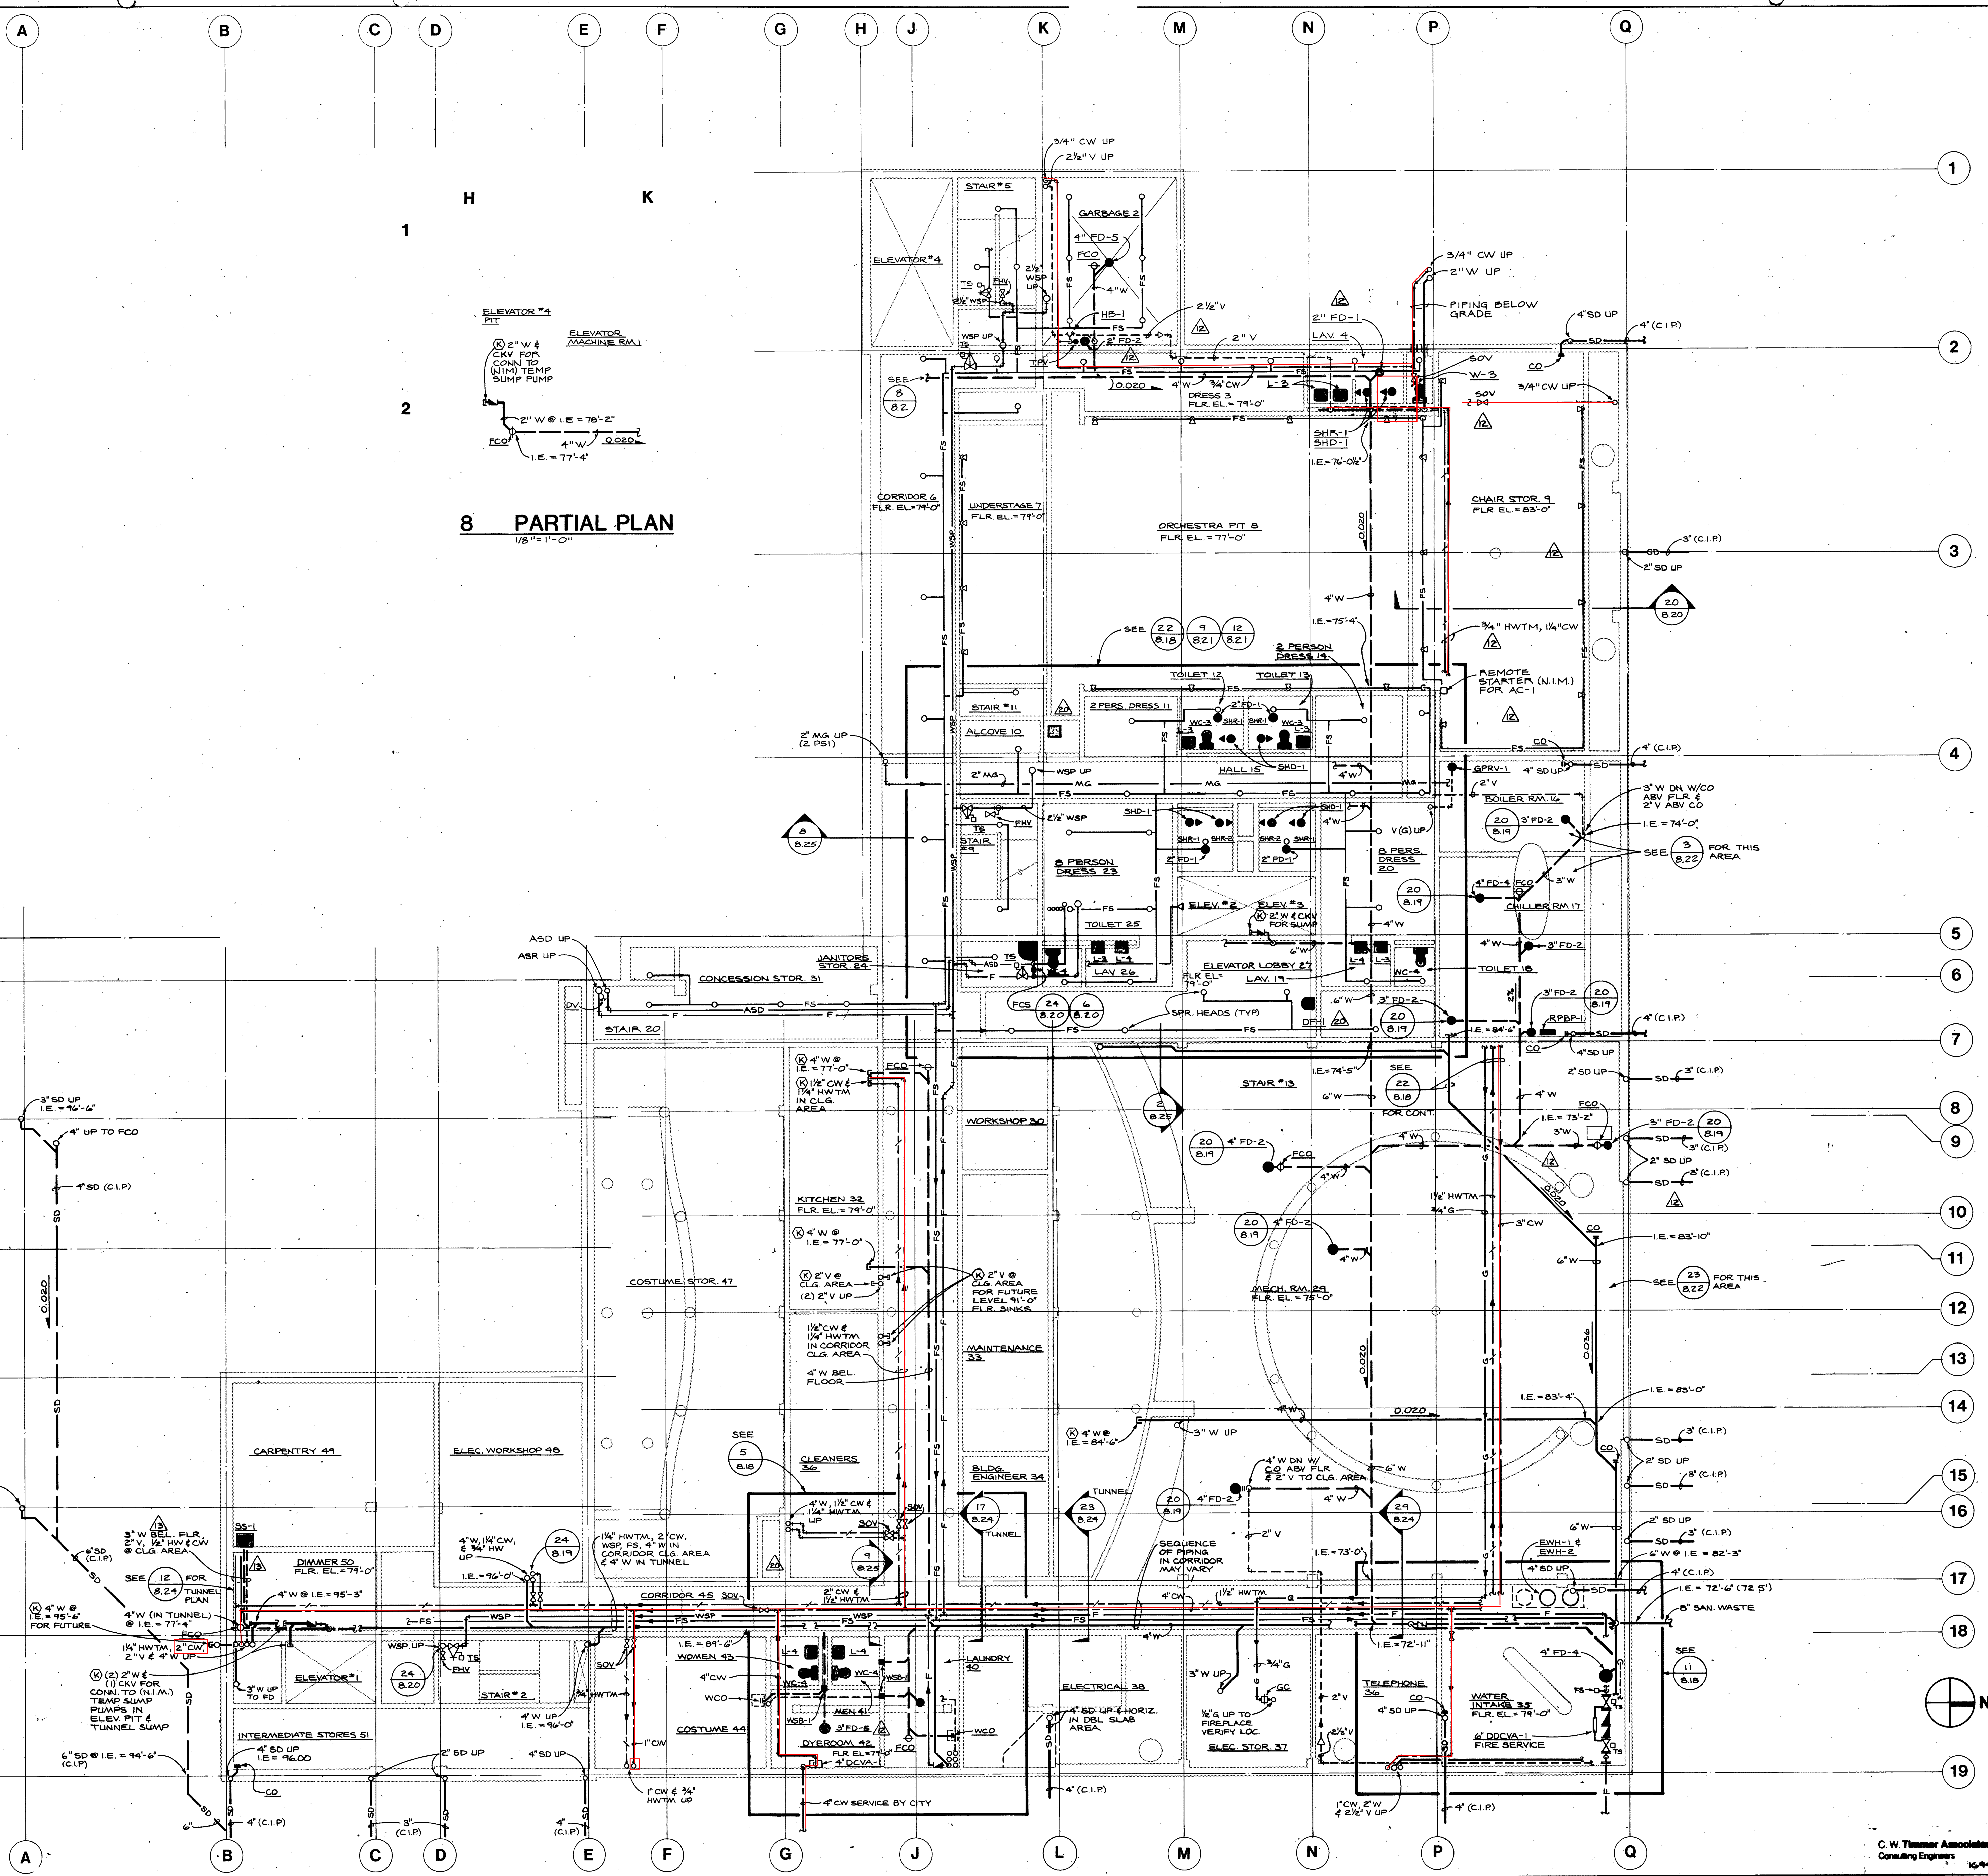

8 PARTIAL PLAN  
1/8" = 1'-0"

# Portland Center for the Performing Arts

The City of Portland

Honorable Mildred A. Schwab  
Commissioner in Charge  
Ronald K. Ragen  
Chairman  
Performing Arts Center Committee

Architects  
Broome, Oringdolph, O'Toole, Rudolf & Associates pc  
ELS Design Group  
Barton Myers

Project Address  
733 N.W. 20th Avenue  
Portland, Oregon 97209  
(503) 226-1575

Consultants  
Theatre Projects Inc.  
Theatre Consultants  
R. Lawrence Kirkegaard & Associates  
Acoustician  
CH2M Hill  
Structural Engineers  
C.W. Timmer Associates  
Mechanical Engineers  
Interface Engineering Inc.  
Electrical Engineers



Target	Revision Item	Revision Date
▲	Addendum #1	10/29/84
▲	Addendum #2	11/06/84
▲	Addendum #4	11/13/84
▲	Addendum #5	11/21/84
▲	Proposal Request #1	03/01/85
▲	Proposal Request #2	03/01/85
▲	Proposal Request #3	03/01/85
▲	Proposal Request #4	03/01/85
▲	Proposal Request #5	03/01/85
▲	Proposal Request #6	03/01/85
▲	Proposal Request #7	03/01/85
▲	Proposal Request #8	03/01/85
▲	Proposal Request #9	03/01/85
▲	Proposal Request #10	03/01/85
▲	Proposal Request #11	03/01/85
▲	Proposal Request #12	03/01/85
▲	Proposal Request #13	03/01/85
▲	Proposal Request #14	03/01/85
▲	Clarification Items	03/01/85
▲	Miscellaneous Items	03/01/85


Revisions

New Theatre Building

## PLAN LEVEL 01'-0" / 07'-6" PLUMBING & FIRE PROTECTION

Date OCT. 12, 1984  
Scale 1/8" = 1'-0"  
Drawing No. 8.3

C.W. Timmer Associates Inc.  
Consulting Engineers 1044-80

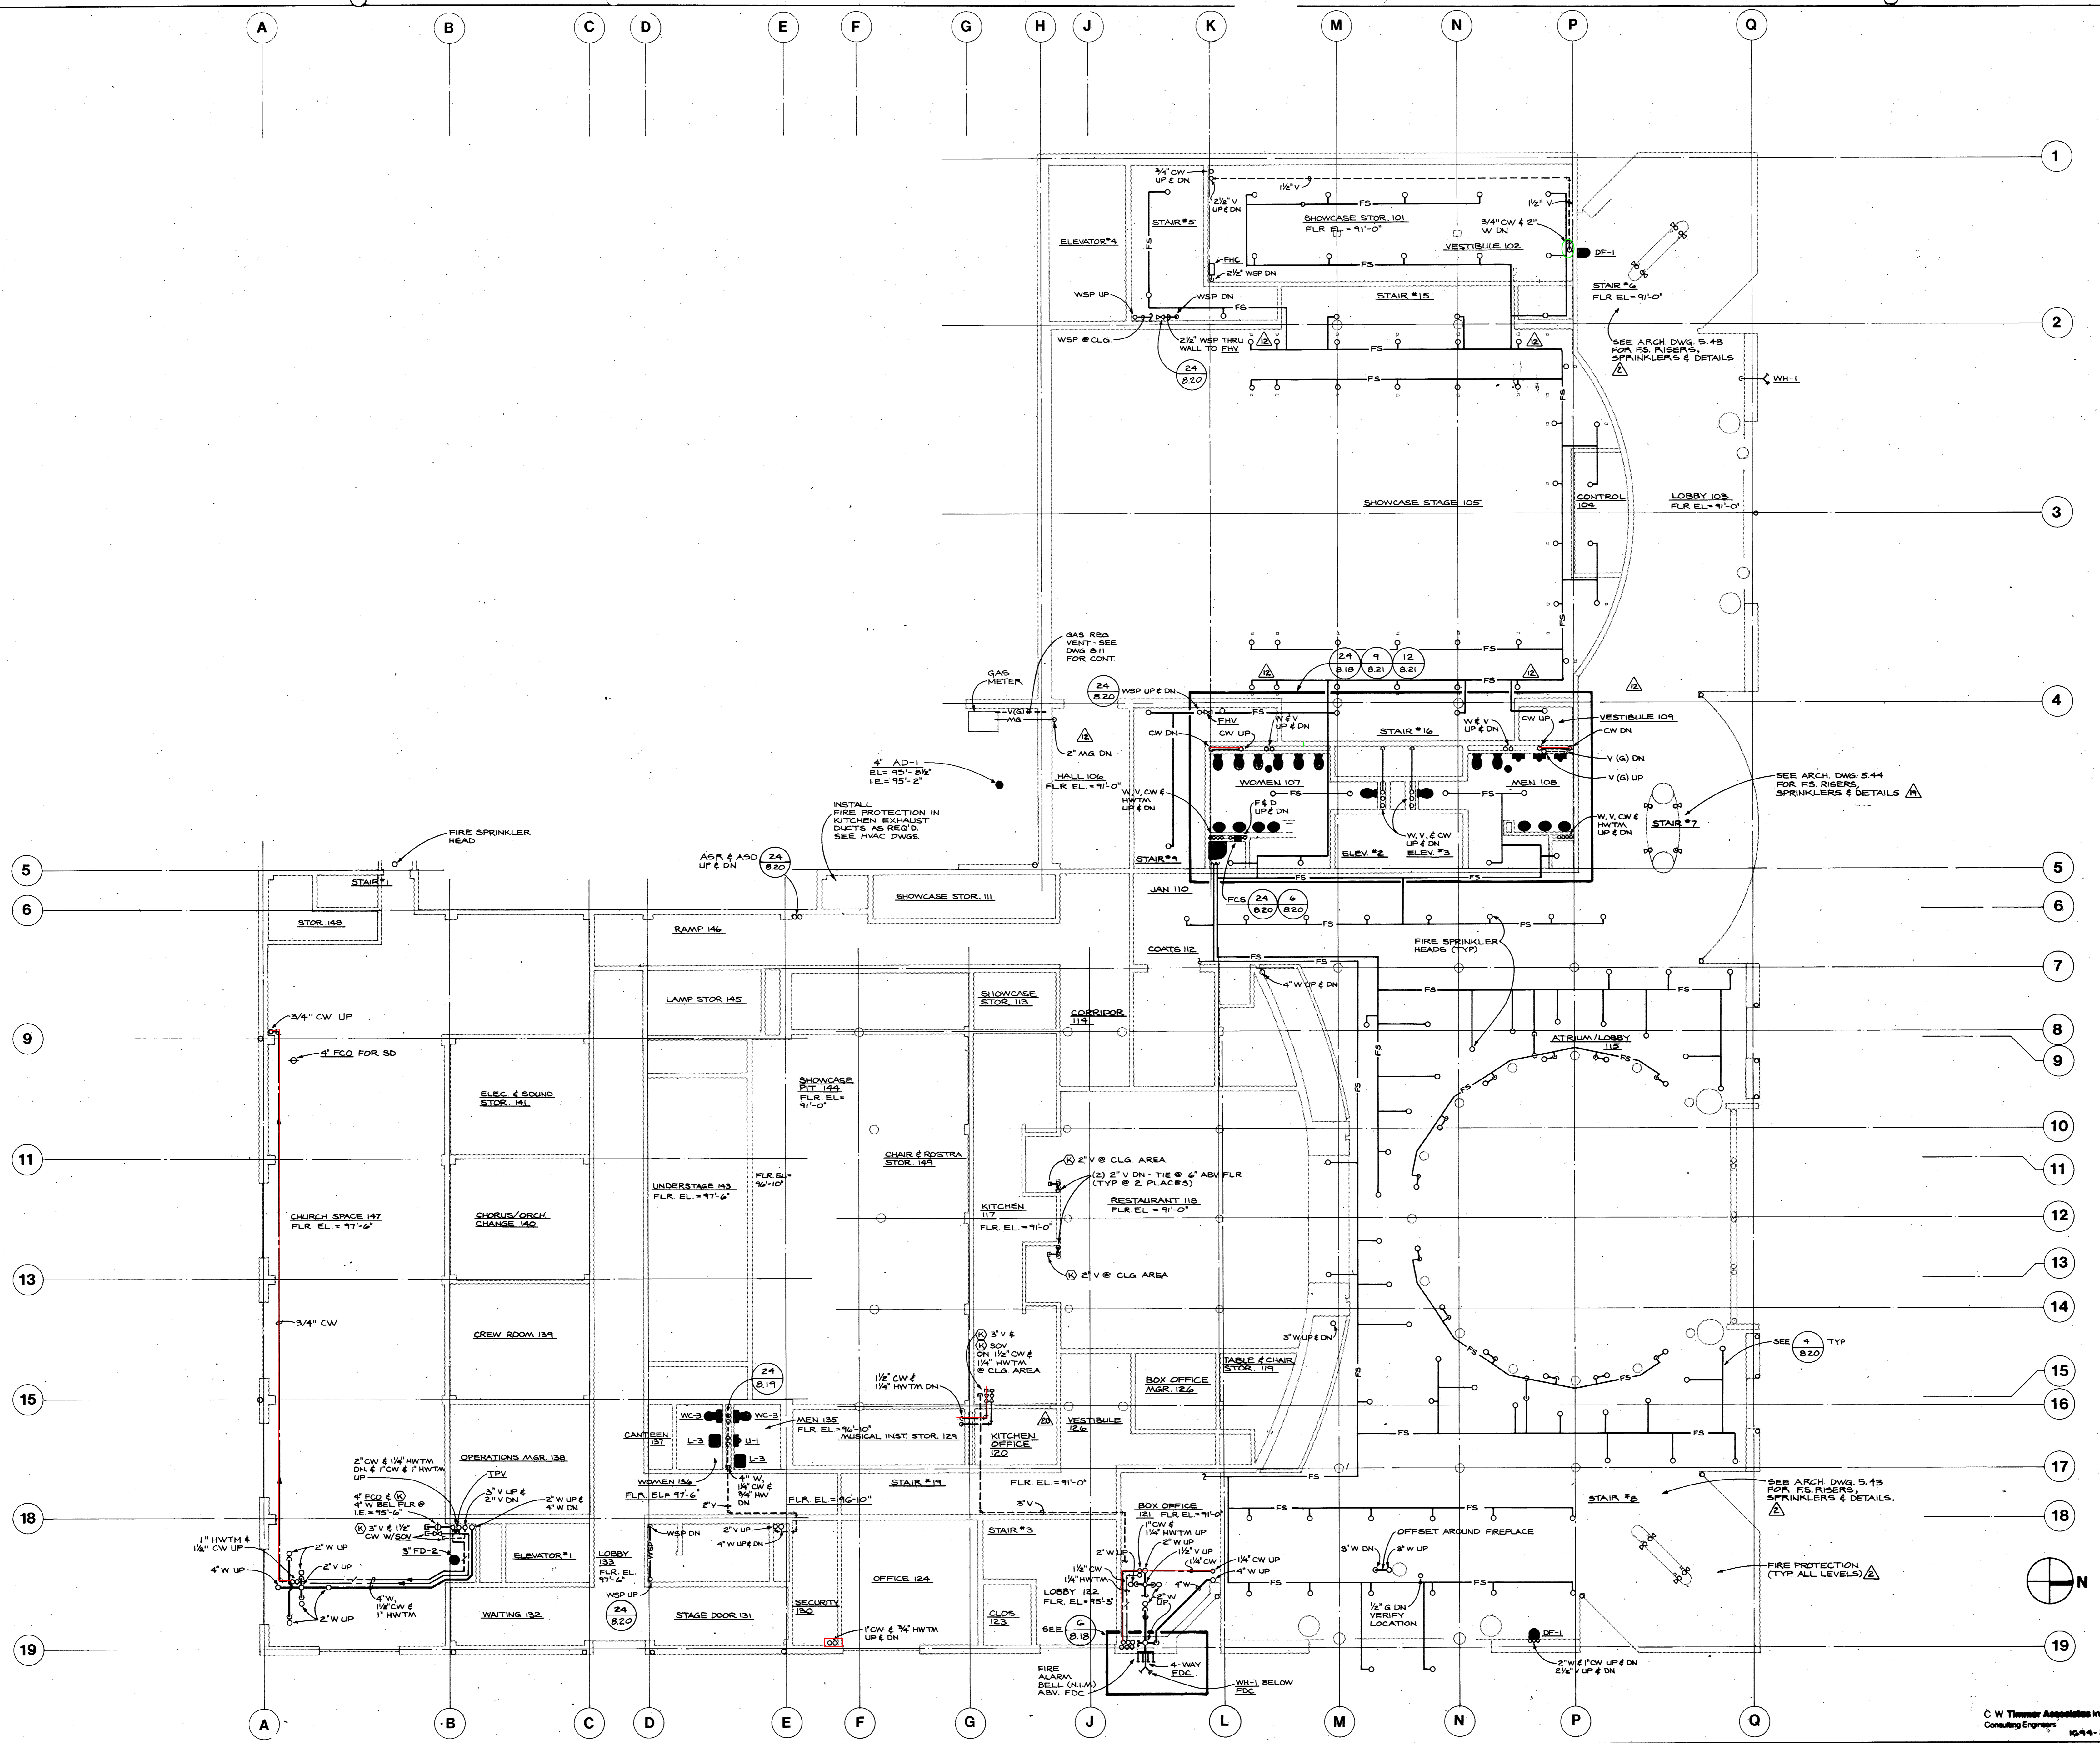





# Portland Center for the Performing Arts

The City of Portland

Honorable Mildred A. Schwab  
Commissioner in Charge  
Ronald K. Ragen  
Chairman  
Performing Arts Center Committee

Architects  
Broome, Oringdolph, O'Toole, Rudolf & Associates pc  
E.L.S. Design Group  
Barton Myers  
Project Address  
733 N.W. 20th Avenue  
Portland, Oregon 97209  
(503) 226-1575

Consultants  
Theatre Projects Inc.  
Theatre Consultants  
R. Lawrence Kirkegaard & Associates  
Acoustician  
CH2M Hill  
Structural Engineers  
C.W. Timmer Associates  
Mechanical Engineers  
Interface Engineering Inc.  
Electrical Engineers



Target	Revision Item	Revision Date
▲	Addendum #1	10/29/84
▲	Addendum #2	11/06/84
▲	Addendum #4	11/13/84
▲	Addendum #5	11/21/84
▲	Proposal Request #1	03/01/85
▲	Proposal Request #2	03/01/85
▲	Proposal Request #3	03/01/85
▲	Proposal Request #4	03/01/85
▲	Proposal Request #5	03/01/85
▲	Proposal Request #6	03/01/85
▲	Proposal Request #7	03/01/85
▲	Proposal Request #8	03/01/85
▲	Proposal Request #9	03/01/85
▲	Proposal Request #10	03/01/85
▲	Proposal Request #11	03/01/85
▲	Proposal Request #12	03/01/85
▲	Proposal Request #13	03/01/85
▲	Proposal Request #14	03/01/85
▲	Clarification Items	03/01/85
▲	Miscellaneous Items	03/01/85


Revisions

New Theatre Building

## PLAN LEVEL 107'-0"/108'-0" PLUMBING & FIRE PROTECTION

Date OCT 12, 1984  
Scale 1/8" = 1'-0"  
Drawing No. 8.5

C. W. Timmer Associates Inc.  
Consulting Engineers  
1644-20

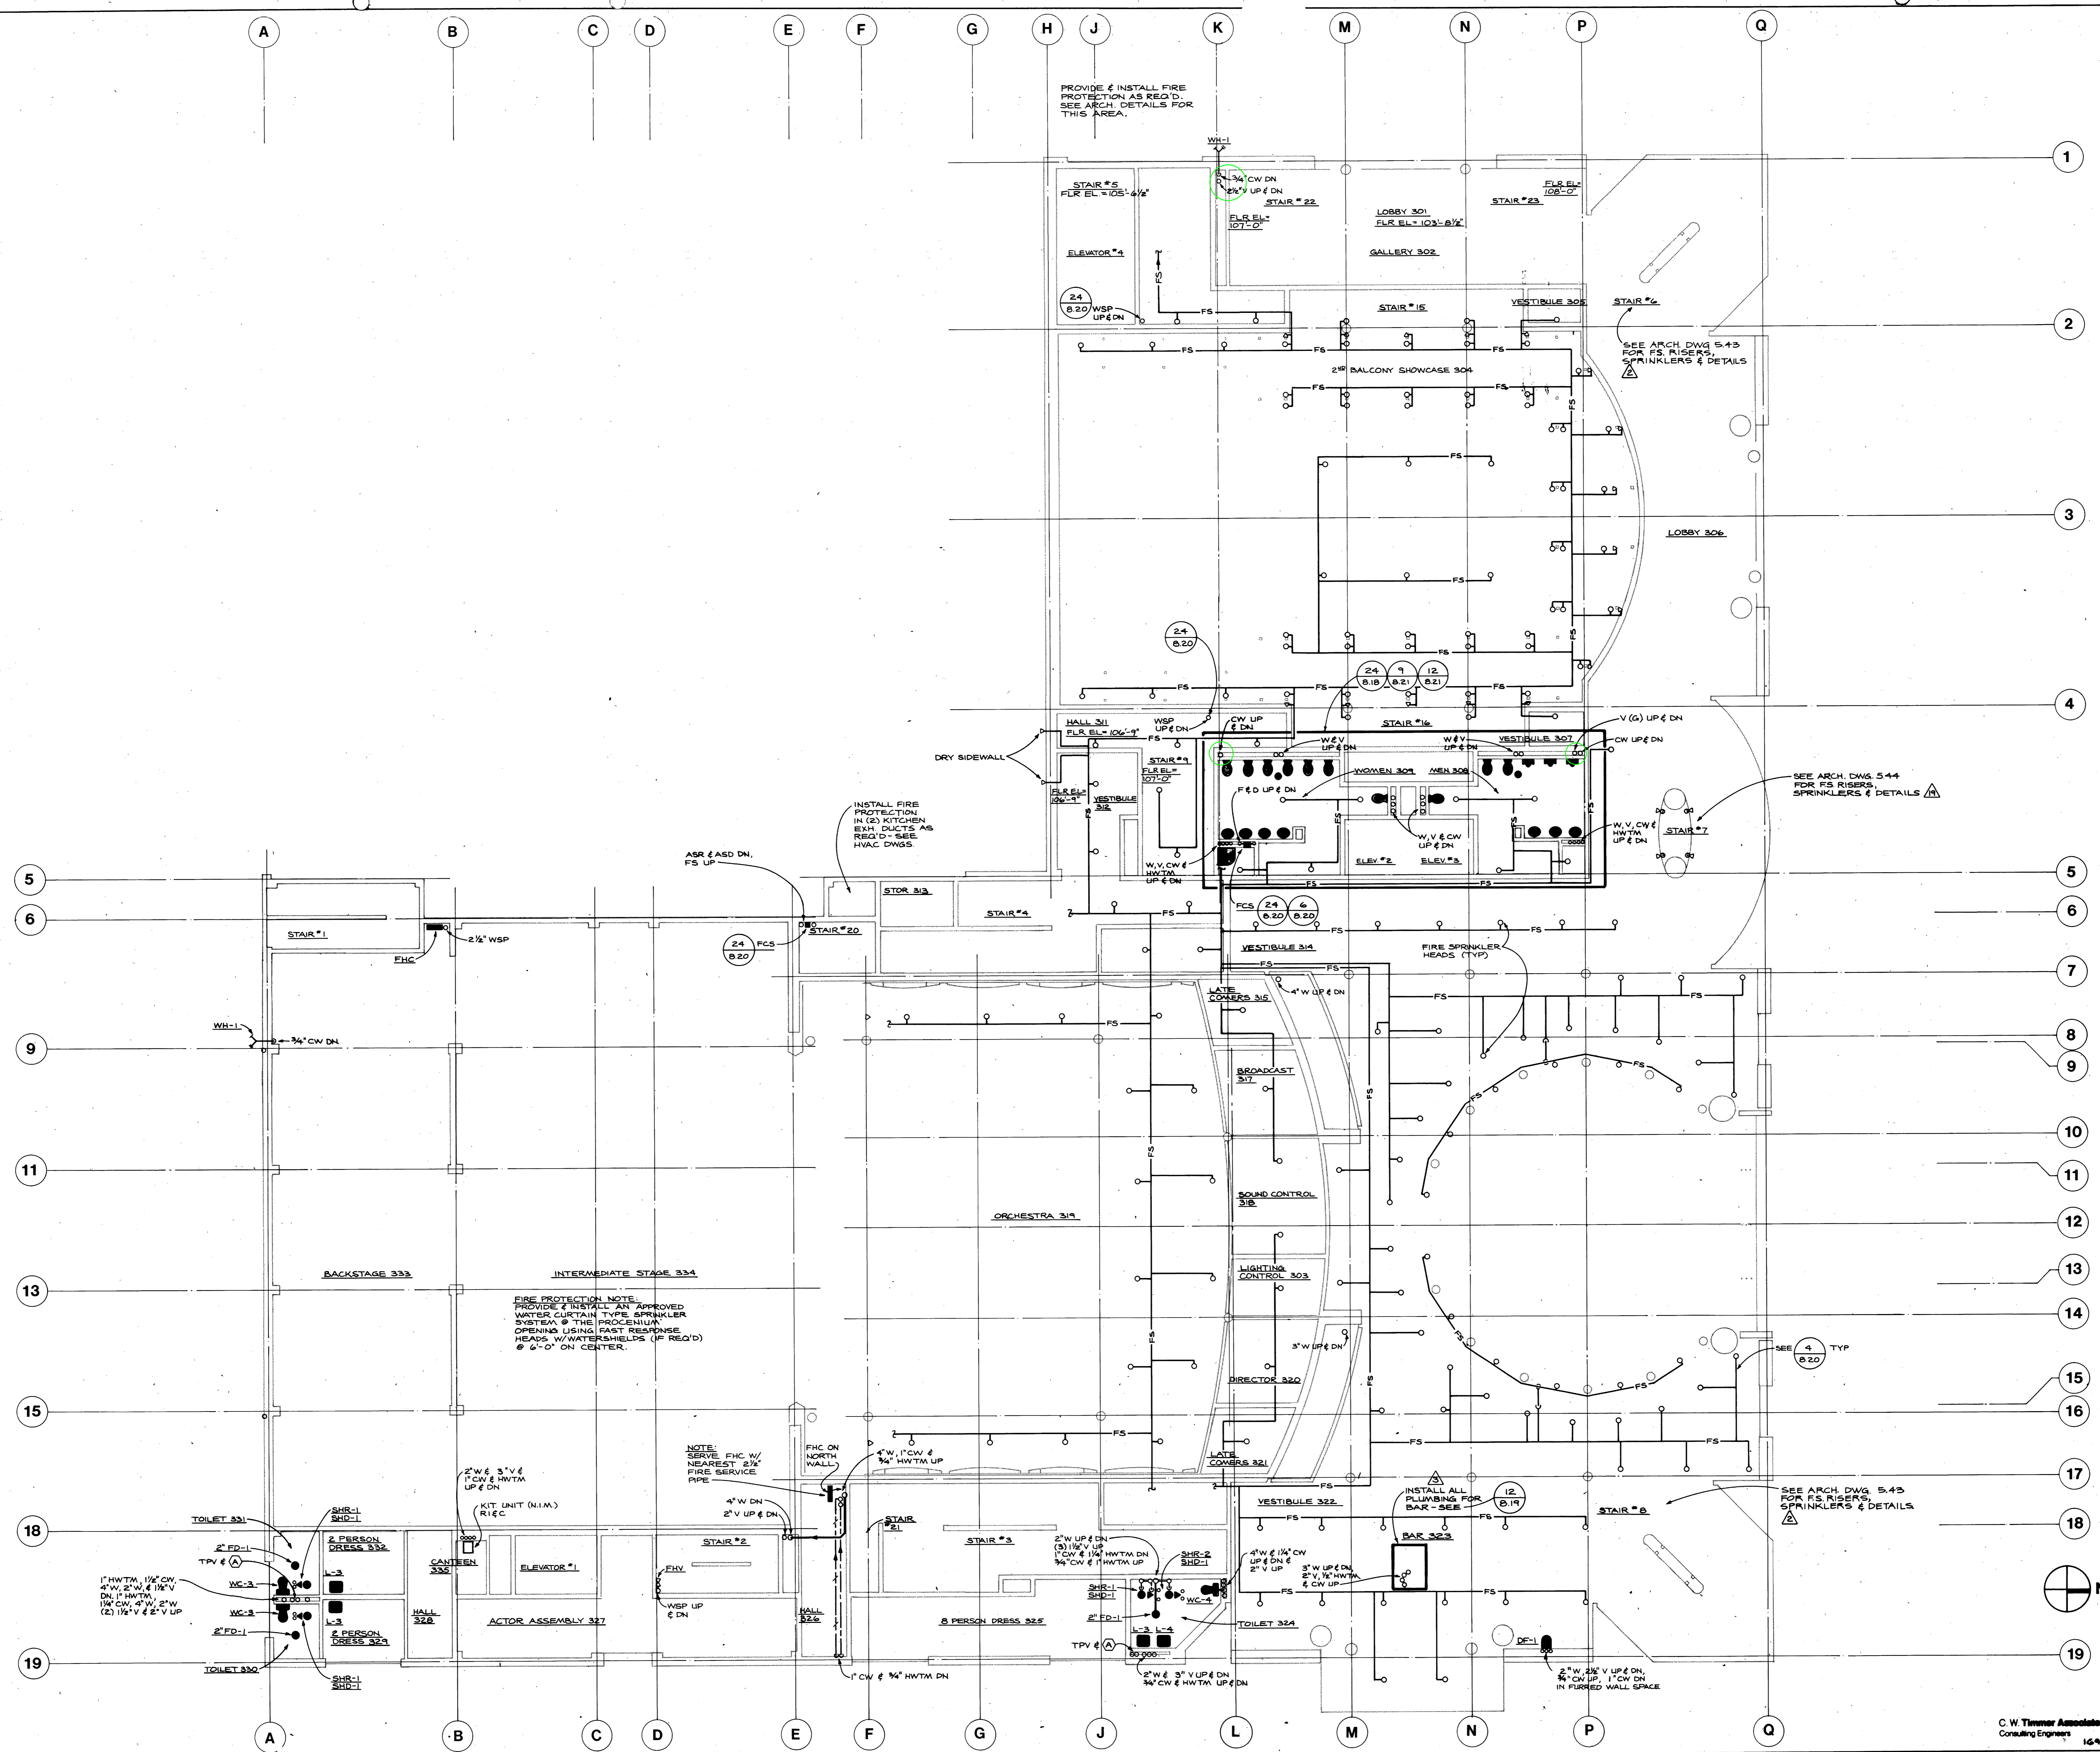

# Portland Center for the Performing Arts

The City of Portland

Honorable Mildred A. Schwab  
Commissioner in Charge  
Ronald K. Ragen  
Chairman  
Performing Arts Center Committee

Architects  
Broome, Oringdolph, O'Toole, Rudolf & Associates pc  
ELS Design Group  
Barton Myers

Project Address  
733 N.W. 20th Avenue  
Portland, Oregon 97209  
(503) 226-1575

Consultants  
Theatre Projects Inc.  
Theatre Consultants  
R. Lawrence Kirkegaard & Associates  
Acoustician  
CH2M Hill  
Structural Engineers  
C.W. Timmer Associates  
Mechanical Engineers  
Interface Engineering Inc.  
Electrical Engineers



Target	Revision Item	Revision Date
△	Addendum #1	10/23/84
△	Addendum #2	11/06/84
△	Addendum #4	11/13/84
△	Addendum #5	11/21/84
△	Proposal Request #1	03/01/85
△	Proposal Request #2	03/01/85
△	Proposal Request #3	03/01/85
△	Proposal Request #4	03/01/85
△	Proposal Request #5	03/08/85
△	Proposal Request #6	03/01/85
△	Proposal Request #7	03/01/85
△	Proposal Request #8	03/01/85
△	Proposal Request #9	03/01/85
△	Proposal Request #10	03/01/85
△	Proposal Request #11	03/01/85
△	Proposal Request #12	03/01/85
△	Proposal Request #13	03/01/85
△	Proposal Request #14	03/01/85
△	Clarification Items	03/01/85
△	Miscellaneous Items	03/01/85


Revisions

New Theatre Building

## PLAN LEVEL 115'-0"/118'-0" PLUMBING & FIRE PROTECTION

Date OCT 12, 1984  
Scale 1/8" = 1'-0"  
Drawing No. 8.6

C.W. Timmer Associates Inc.  
Consulting Engineers 1699 - 20

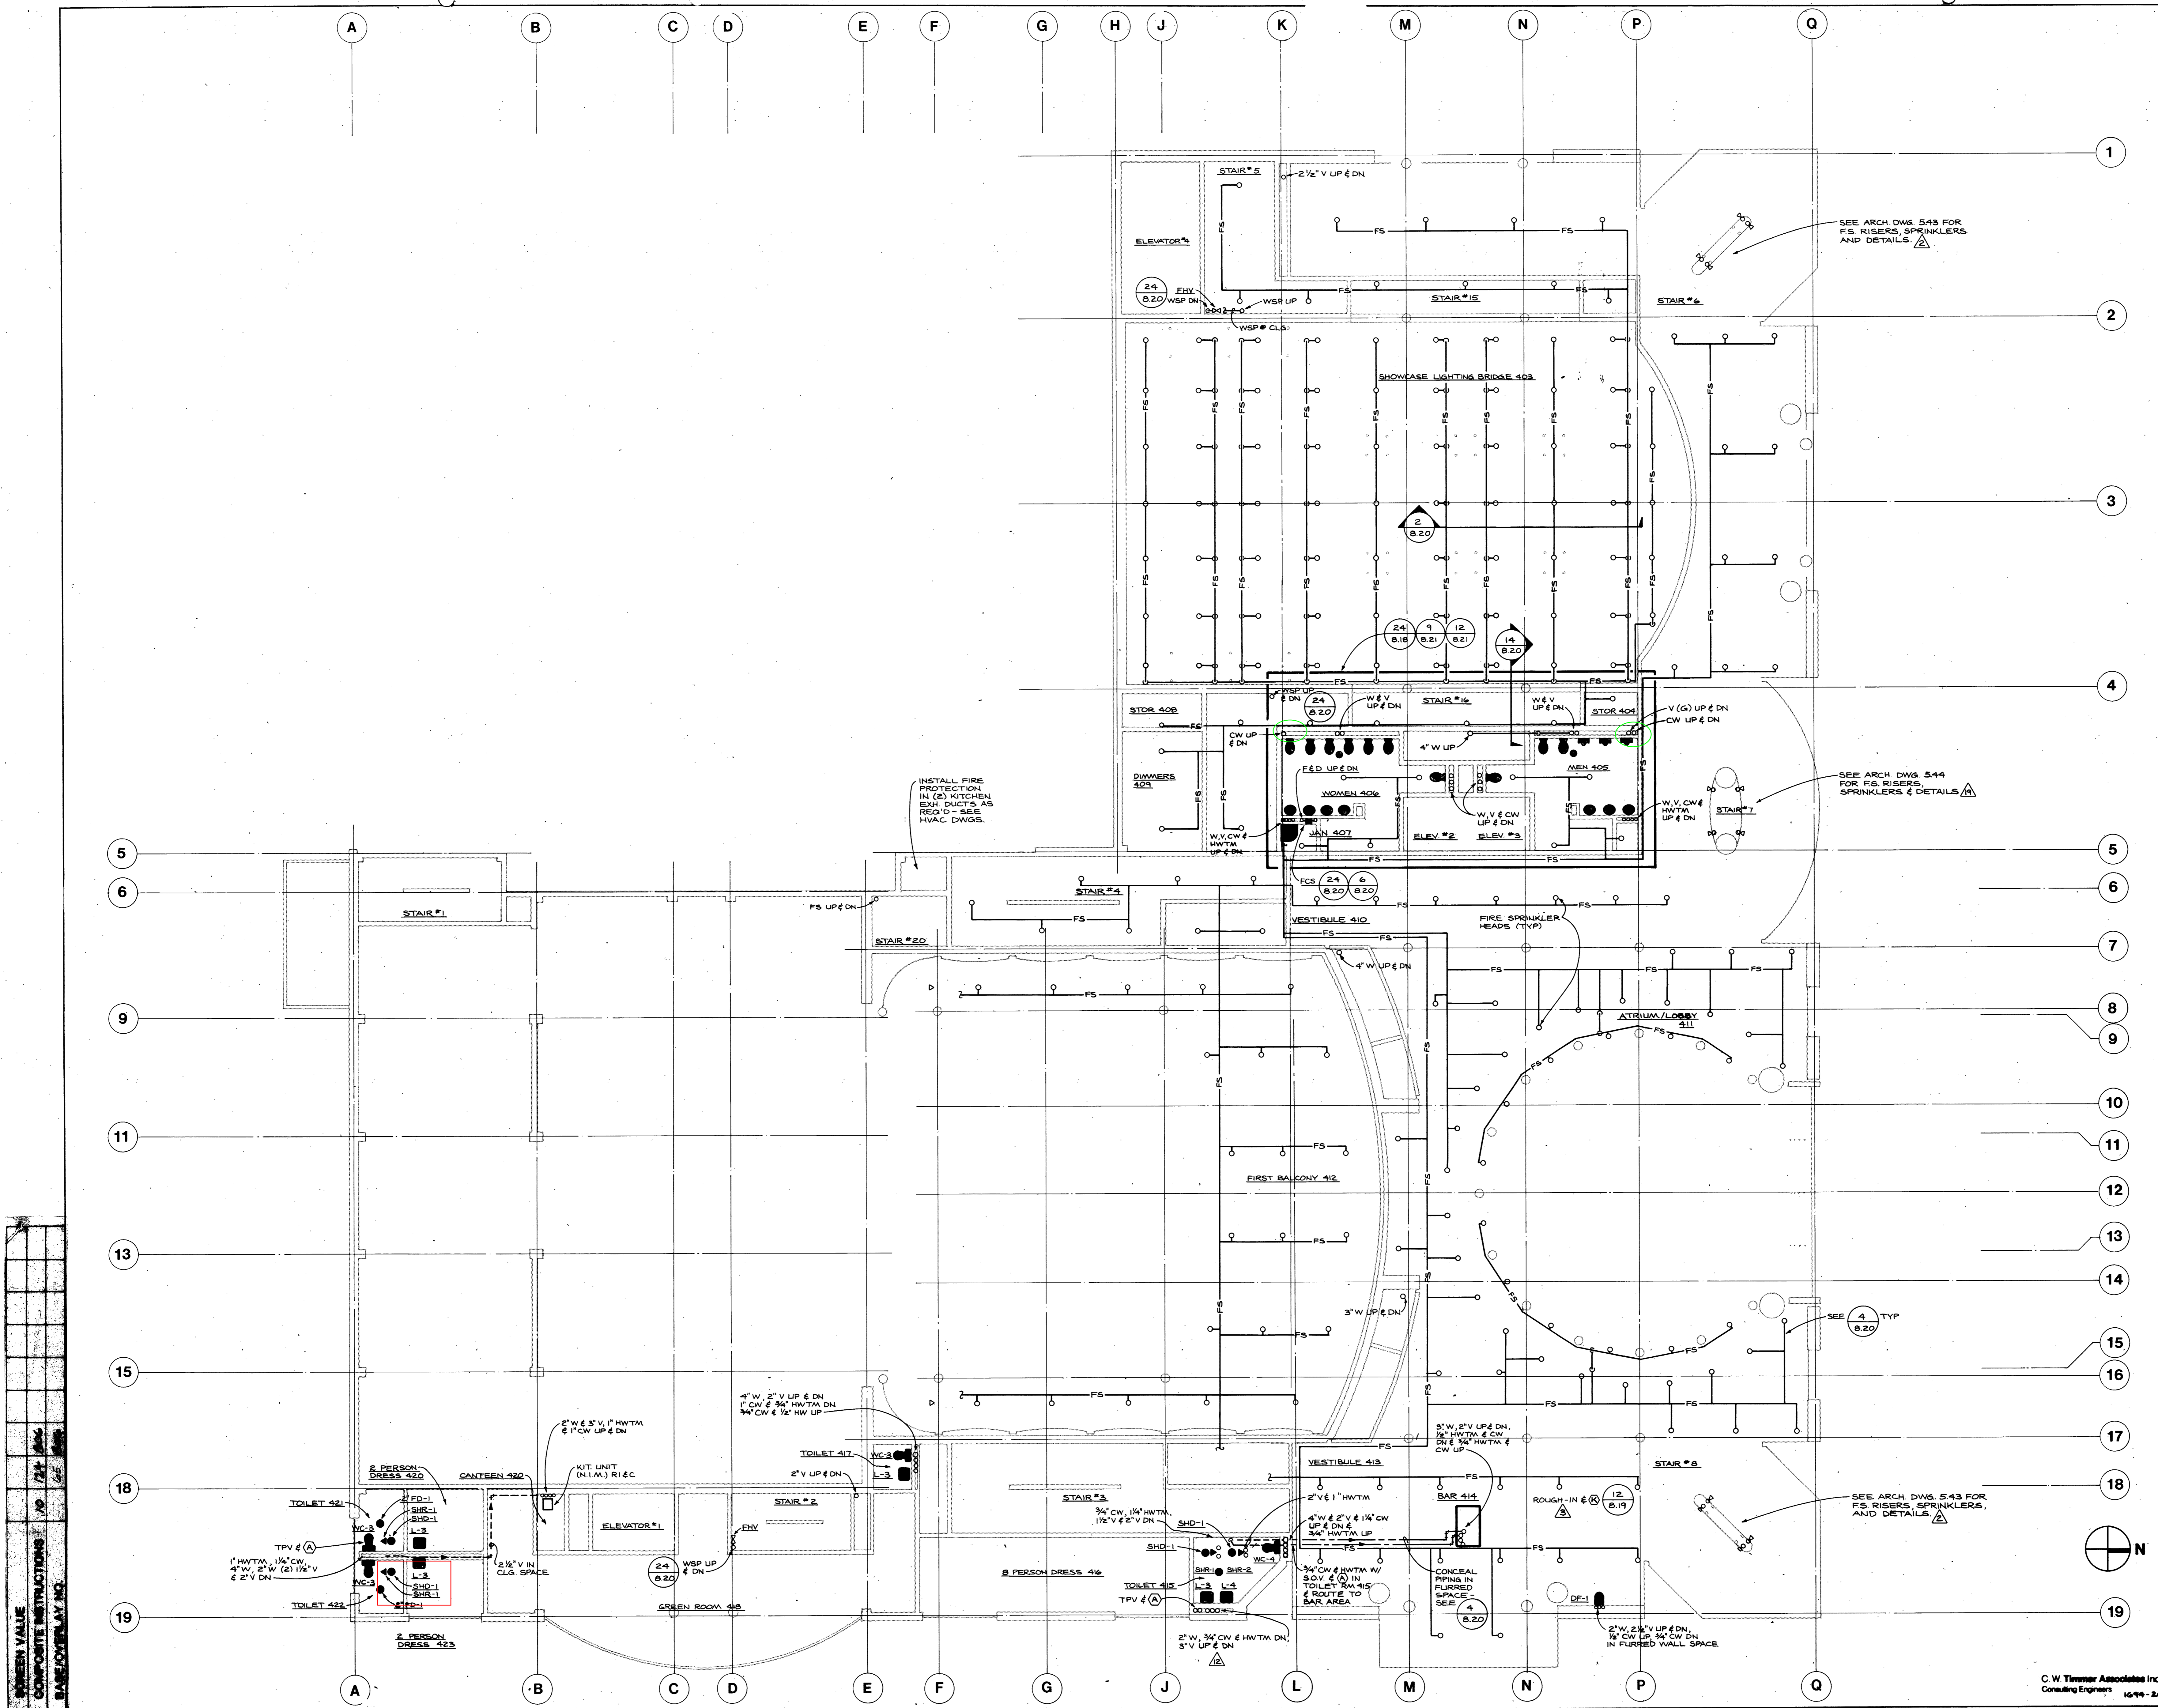

GREEN VALUE  
 COMPOSITE INSTRUCTIONS TO 1/1 800  
 BASE/COVERLAY NO.

# Portland Center for the Performing Arts

The City of Portland

Honorable Mildred A. Schwab  
Commissioner in Charge  
Ronald K. Ragen  
Chairman  
Performing Arts Center Committee

Architects  
Broome, Oringdolph, O'Toole, Rudolf & Associates pc  
ELS Design Group  
Barton Myers

Project Address  
733 N.W. 20th Avenue  
Portland, Oregon 97209  
(503) 226-1575

Consultants  
Theatre Projects Inc.  
Theatre Consultants  
R. Lawrence Kirkegaard & Associates  
Acoustician  
CH2M Hill  
Structural Engineers  
C.W. Timmer Associates  
Mechanical Engineers  
Interface Engineering Inc.  
Electrical Engineers



Target	Revision Item	Revision Date
▲	Addendum #1	10/29/84
▲	Addendum #2	11/06/84
▲	Addendum #4	11/13/84
▲	Addendum #5	11/21/84
▲	Proposal Request #1	03/01/85
▲	Proposal Request #2	03/01/85
▲	Proposal Request #3	03/01/85
▲	Proposal Request #4	03/01/85
▲	Proposal Request #5	03/01/85
▲	Proposal Request #6	03/01/85
▲	Proposal Request #7	03/01/85
▲	Proposal Request #8	03/01/85
▲	Proposal Request #9	03/01/85
▲	Proposal Request #10	03/01/85
▲	Proposal Request #11	03/01/85
▲	Proposal Request #12	03/01/85
▲	Proposal Request #13	03/01/85
▲	Proposal Request #14	03/01/85
▲	Clarification Items	03/01/85
▲	Miscellaneous Items	03/01/85


Revisions

New Theatre Building

**PLAN LEVEL 129'-0"**  
**PLUMBING & FIRE PROTECTION**

Date OCT 12, 1984  
Scale 1/8" = 1'-0"  
Drawing No. 8.7

C.W. Timmer Associates Inc.  
Consulting Engineers 1694 - 20

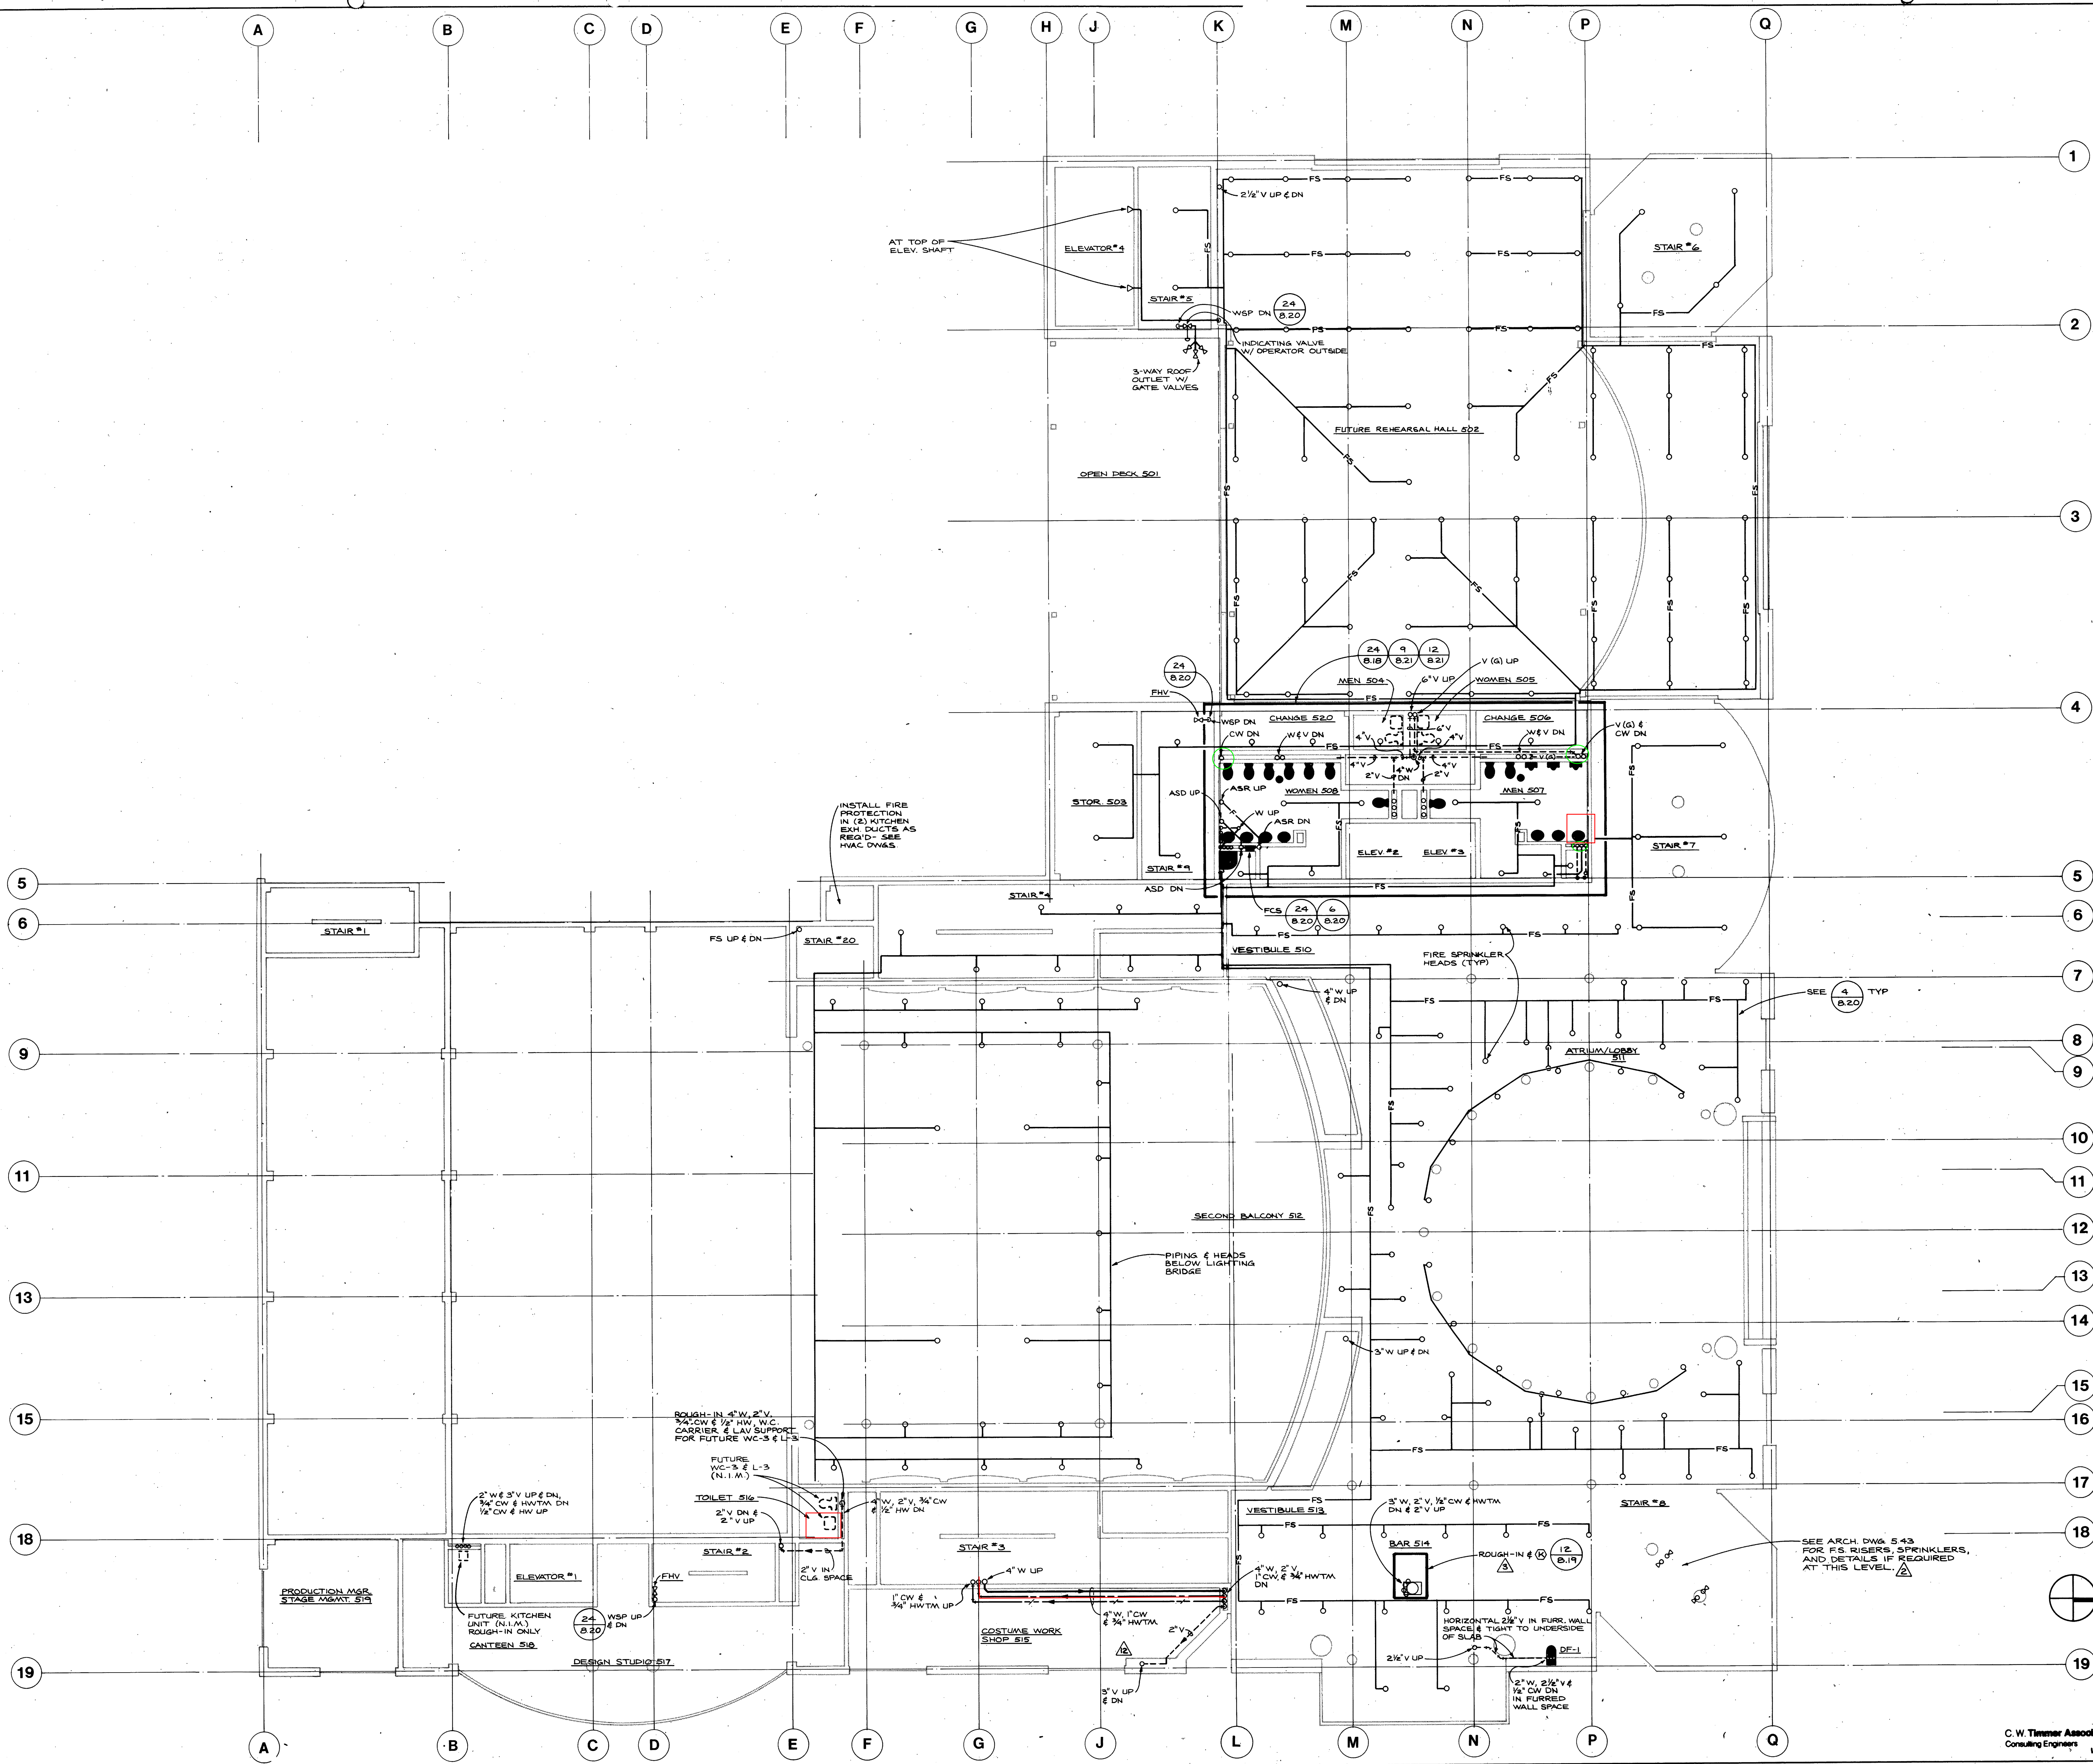

SCREEN VALUE  
 COMPLETE INSTRUCTIONS 10/12/85  
 CONSULTING ENGINEER AT NO. 1694

# Portland Center for the Performing Arts

The City of Portland

Honorable Mildred A. Schwab  
Commissioner in Charge  
Ronald K. Ragen  
Chairman  
Performing Arts Center Committee

Architects  
Broome, Oringdolph, O'Toole, Rudolf & Associates pc  
ELS Design Group  
Barton Myers

Project Address  
733 N.W. 20th Avenue  
Portland, Oregon 97209  
(503) 226-1575

Consultants  
Theatre Projects Inc.  
Theatre Consultants  
R. Lawrence Kirkegaard & Associates  
Acoustician  
CH2M Hill  
Structural Engineers  
C. W. Timmer Associates  
Mechanical Engineers  
Interface Engineering Inc.  
Electrical Engineers



Target	Revision Item	Revision Date
△	Addendum #1	10/29/84
△	Addendum #2	11/06/84
△	Addendum #4	11/13/84
△	Addendum #5	11/21/84
△	Proposal Request #1	03/01/85
△	Proposal Request #2	03/01/85
△	Proposal Request #3	03/01/85
△	Proposal Request #4	03/01/85
△	Proposal Request #5	03/01/85
△	Proposal Request #6	03/01/85
△	Proposal Request #7	03/01/85
△	Proposal Request #8	03/01/85
△	Proposal Request #9	03/01/85
△	Proposal Request #10	03/01/85
△	Proposal Request #11	03/01/85
△	Proposal Request #12	03/01/85
△	Proposal Request #13	03/01/85
△	Proposal Request #14	03/01/85
△	Clarifications on Items	03/01/85
△	Miscellaneous Items	03/01/85


Revisions

New Theatre Building

PLAN LEVEL 141'-0"  
PLUMBING &  
FIRE PROTECTION

Date OCT 12, 1984  
Scale 1/8" = 1'-0"  
Drawing No. 8.8

C. W. Timmer Associates Inc.  
Consulting Engineers 1644-20

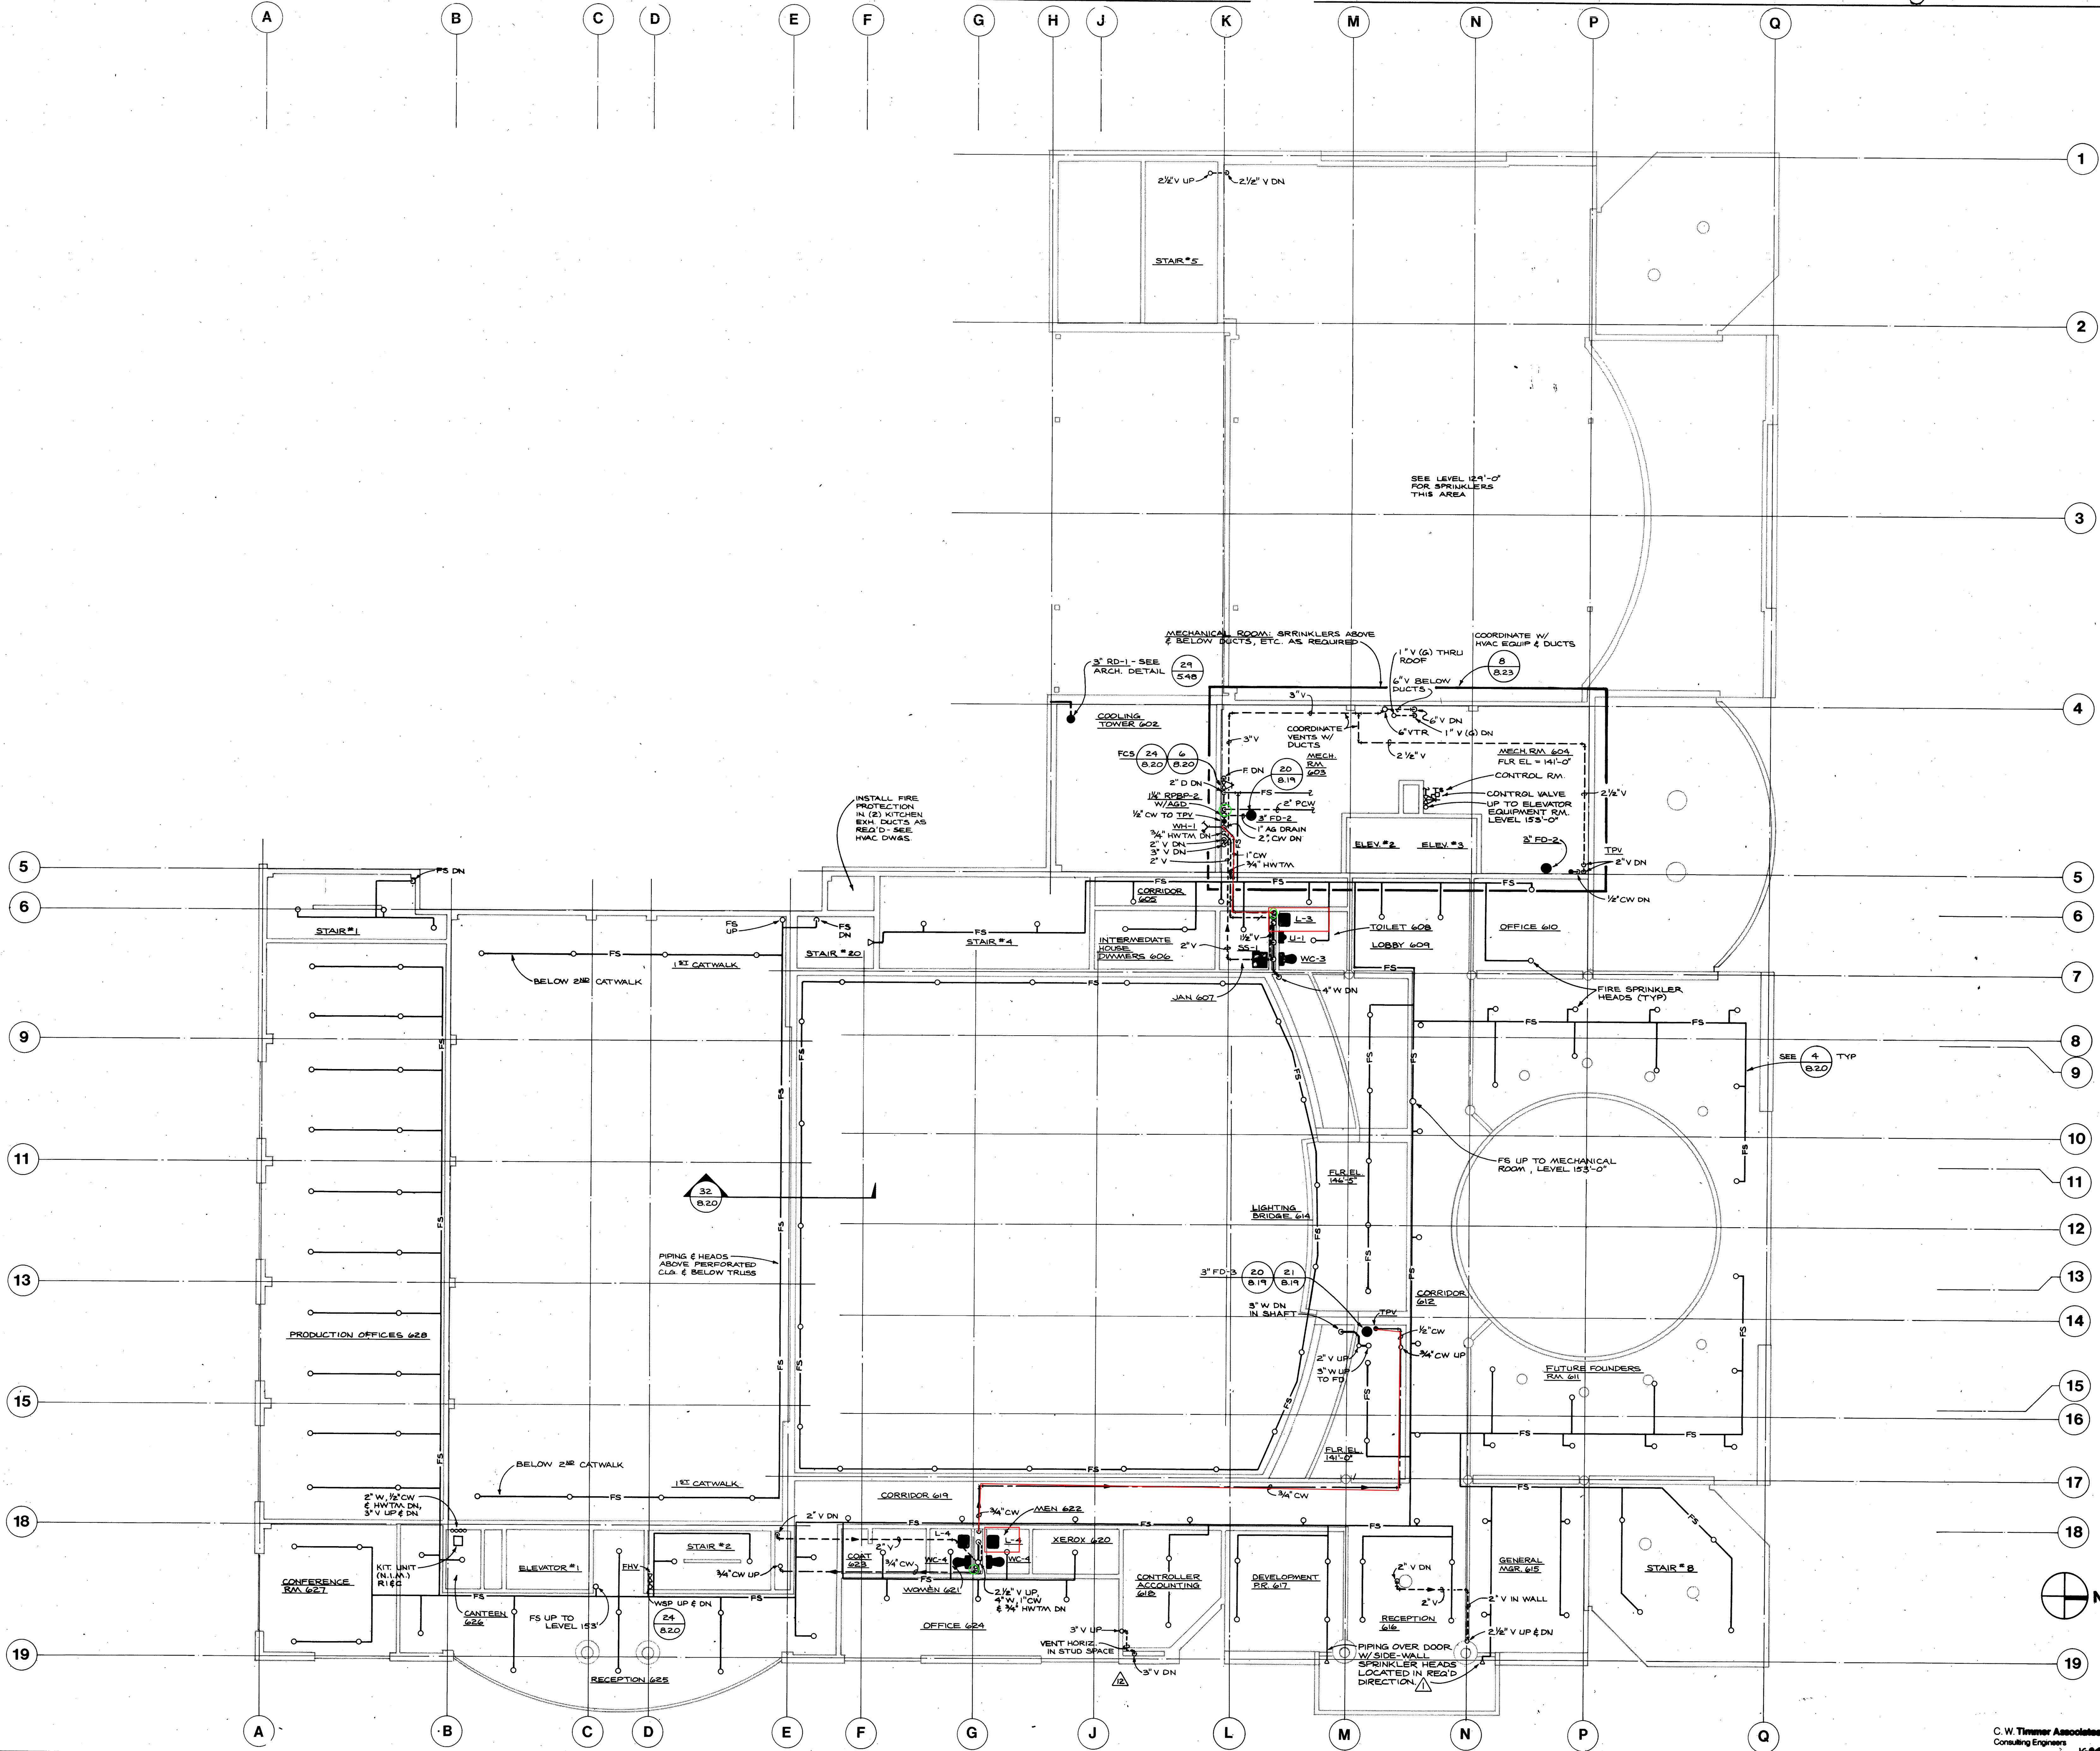

COMPPOSITE INSTRUCTIONS  
 BASE/OVERLAY NO.

# Portland Center for the Performing Arts

The City of Portland


Honorable Mildred A. Schwab  
Commissioner in Charge  
Ronald K. Ragen  
Chairman  
Performing Arts Center Committee

Architects  
Broome, Oringdolph, O'Toole, Rudolf & Associates pc  
ELS Design Group  
Barton Myers  
Project Address  
733 N.W. 20th Avenue  
Portland, Oregon 97209  
(503) 226-1575

Consultants  
Theatre Projects Inc.  
Theatre Consultants  
R. Lawrence Kirkegaard & Associates  
Acoustician  
CH2M Hill  
Structural Engineers  
C. W. Timmer Associates  
Mechanical Engineers  
Interface Engineering Inc.  
Electrical Engineers



Target	Revision Item	Revision Date
▲	Addendum #1	10/25/84
▲	Addendum #2	11/06/84
▲	Addendum #3	11/13/84
▲	Addendum #4	11/21/84
▲	Addendum #5	03/01/85
▲	Proposal Request #1	03/01/85
▲	Proposal Request #2	03/01/85
▲	Proposal Request #3	03/01/85
▲	Proposal Request #4	03/01/85
▲	Proposal Request #5	03/08/85
▲	Proposal Request #6	03/01/85
▲	Proposal Request #7	03/01/85
▲	Proposal Request #8	03/01/85
▲	Proposal Request #9	03/01/85
▲	Proposal Request #10	03/01/85
▲	Proposal Request #11	03/01/85
▲	Proposal Request #12	03/01/85
▲	Proposal Request #13	03/01/85
▲	Proposal Request #14	03/01/85
▲	Clarification Items	03/01/85
▲	Miscellaneous Items	03/01/85

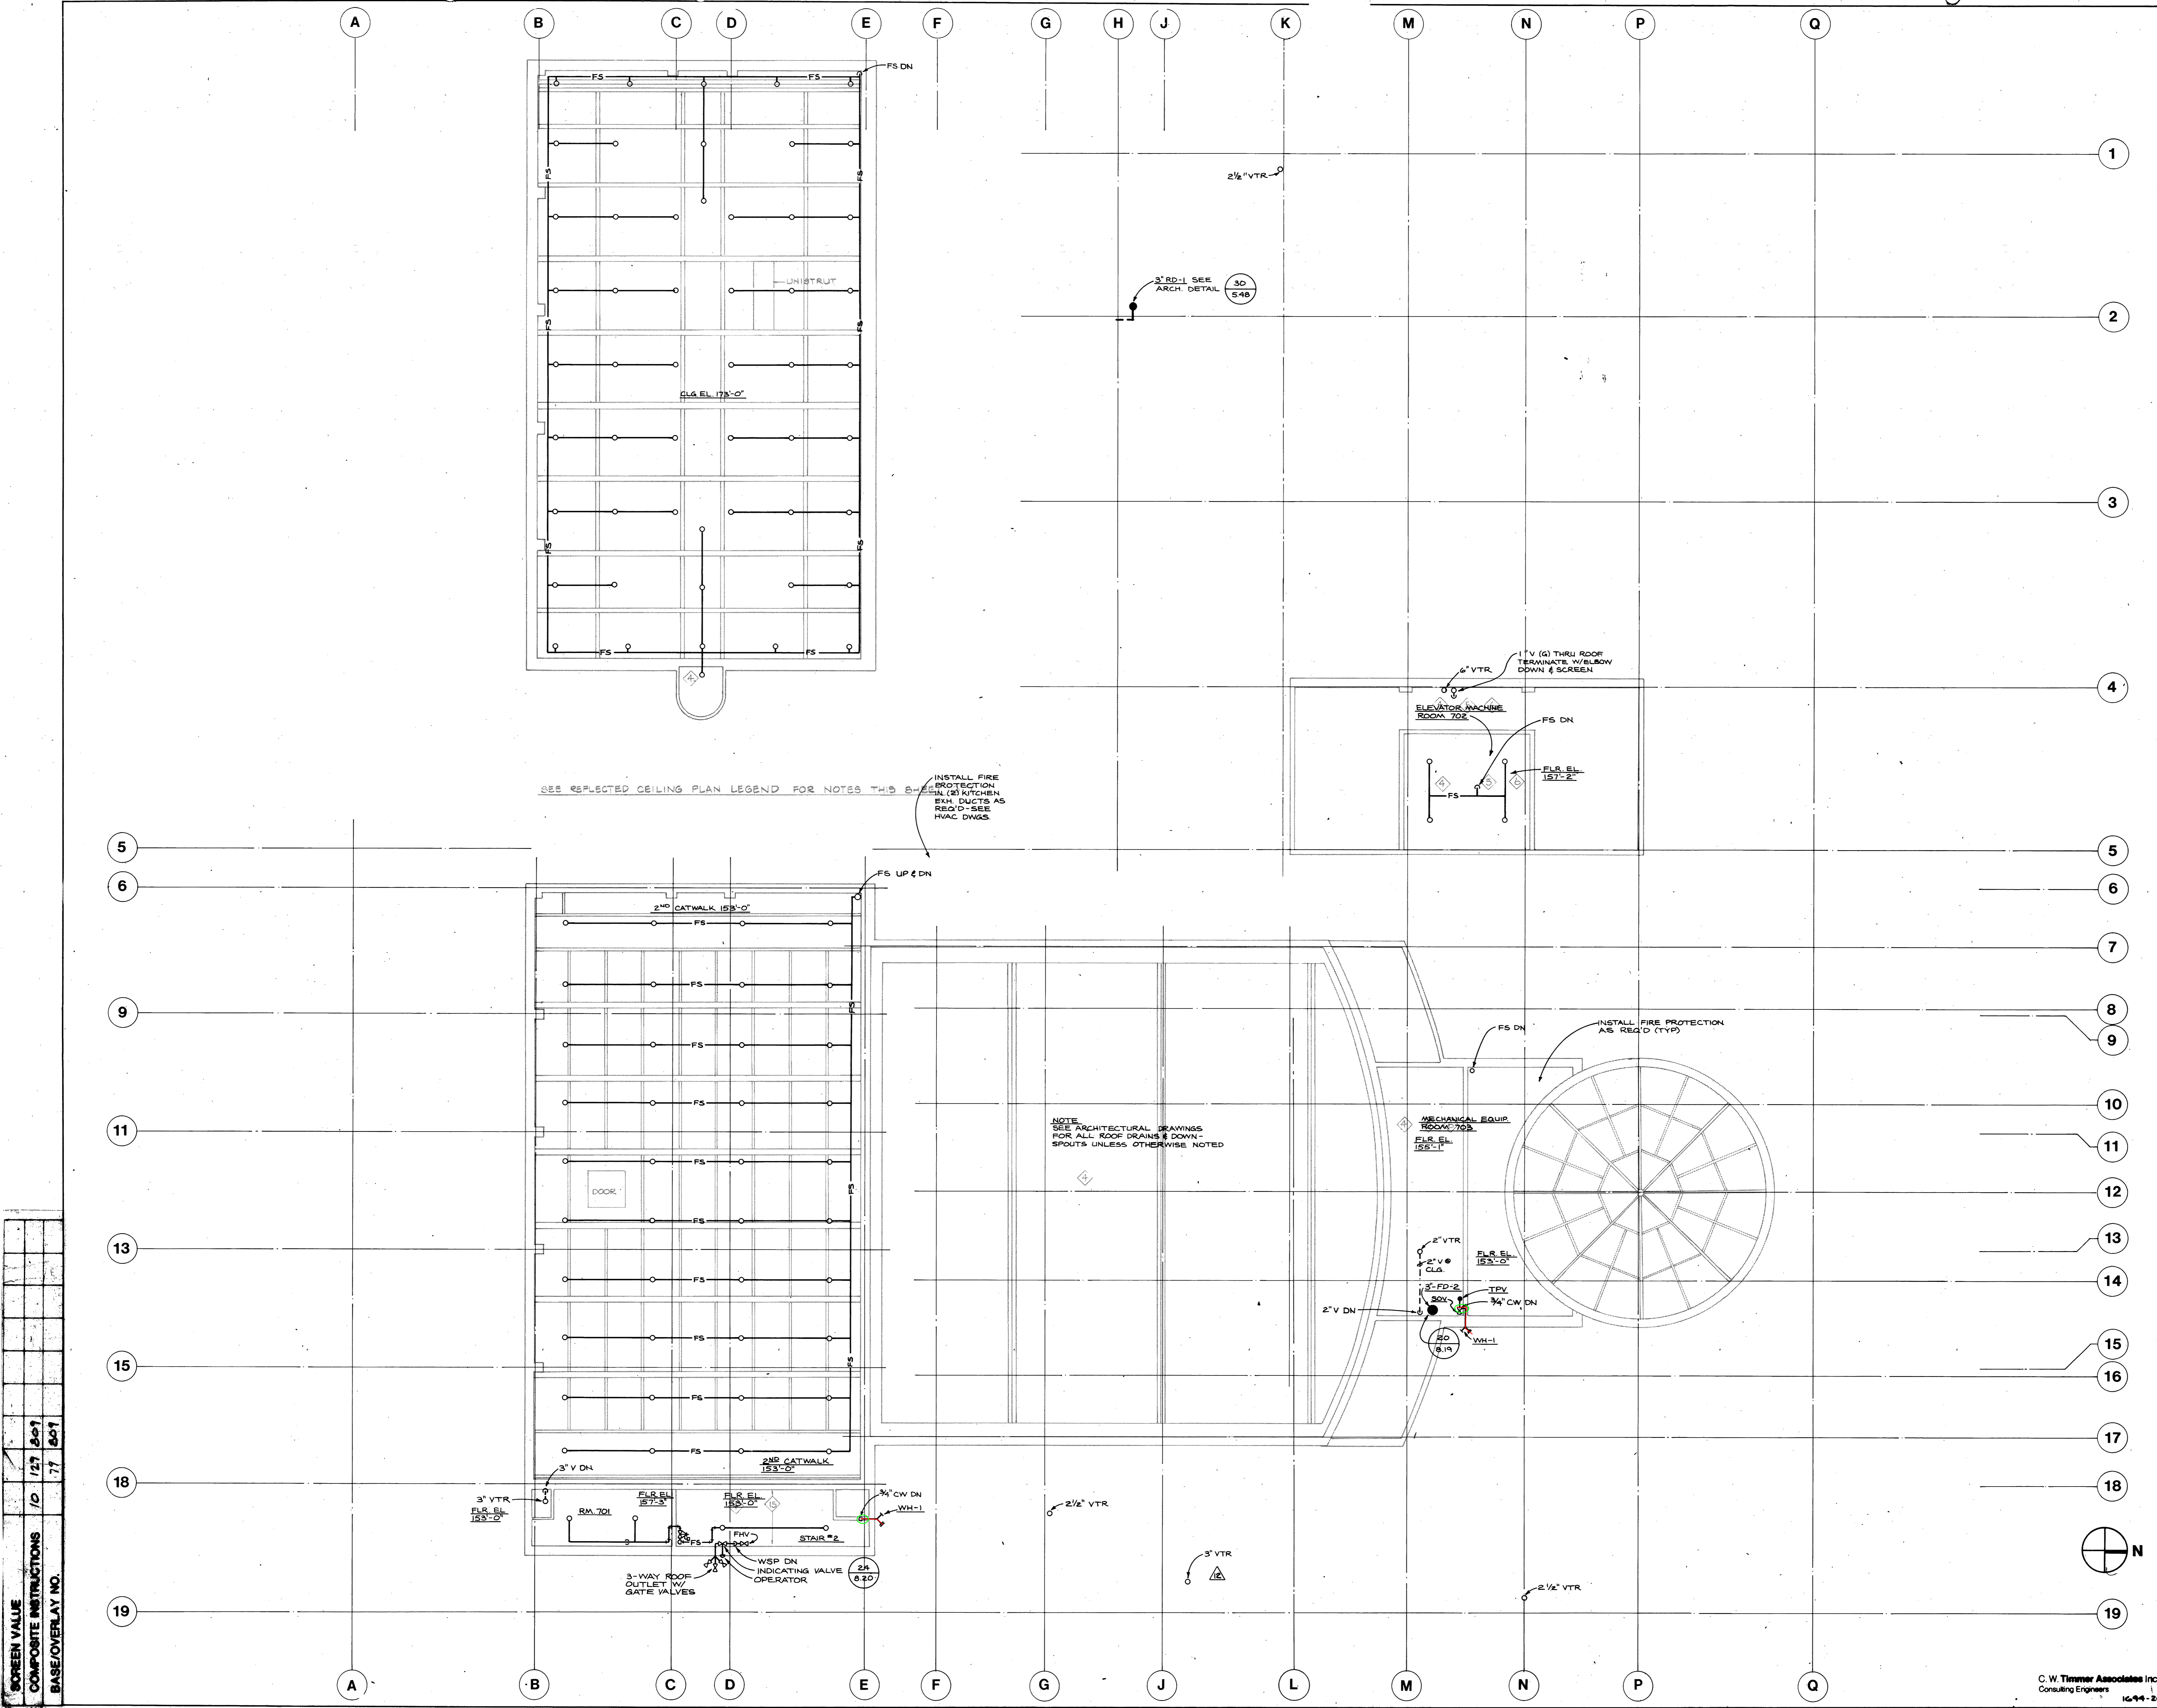

SCREEN VALUE	1/0	1/27	8/07
COMPOSITE INSTRUCTIONS	1/0	1/27	8/07
BASE/OVERLAY NO.	17	8/07	


Revisions

New Theatre Building

## PLAN LEVEL 153'-0"/173'-0" PLUMBING & FIRE PROTECTION


Date OCT 12, 1984  
Scale 1/8" = 1'-0"  
Drawing No. 8.9

C. W. Timmer Associates Inc.  
Consulting Engineers 16-44-20

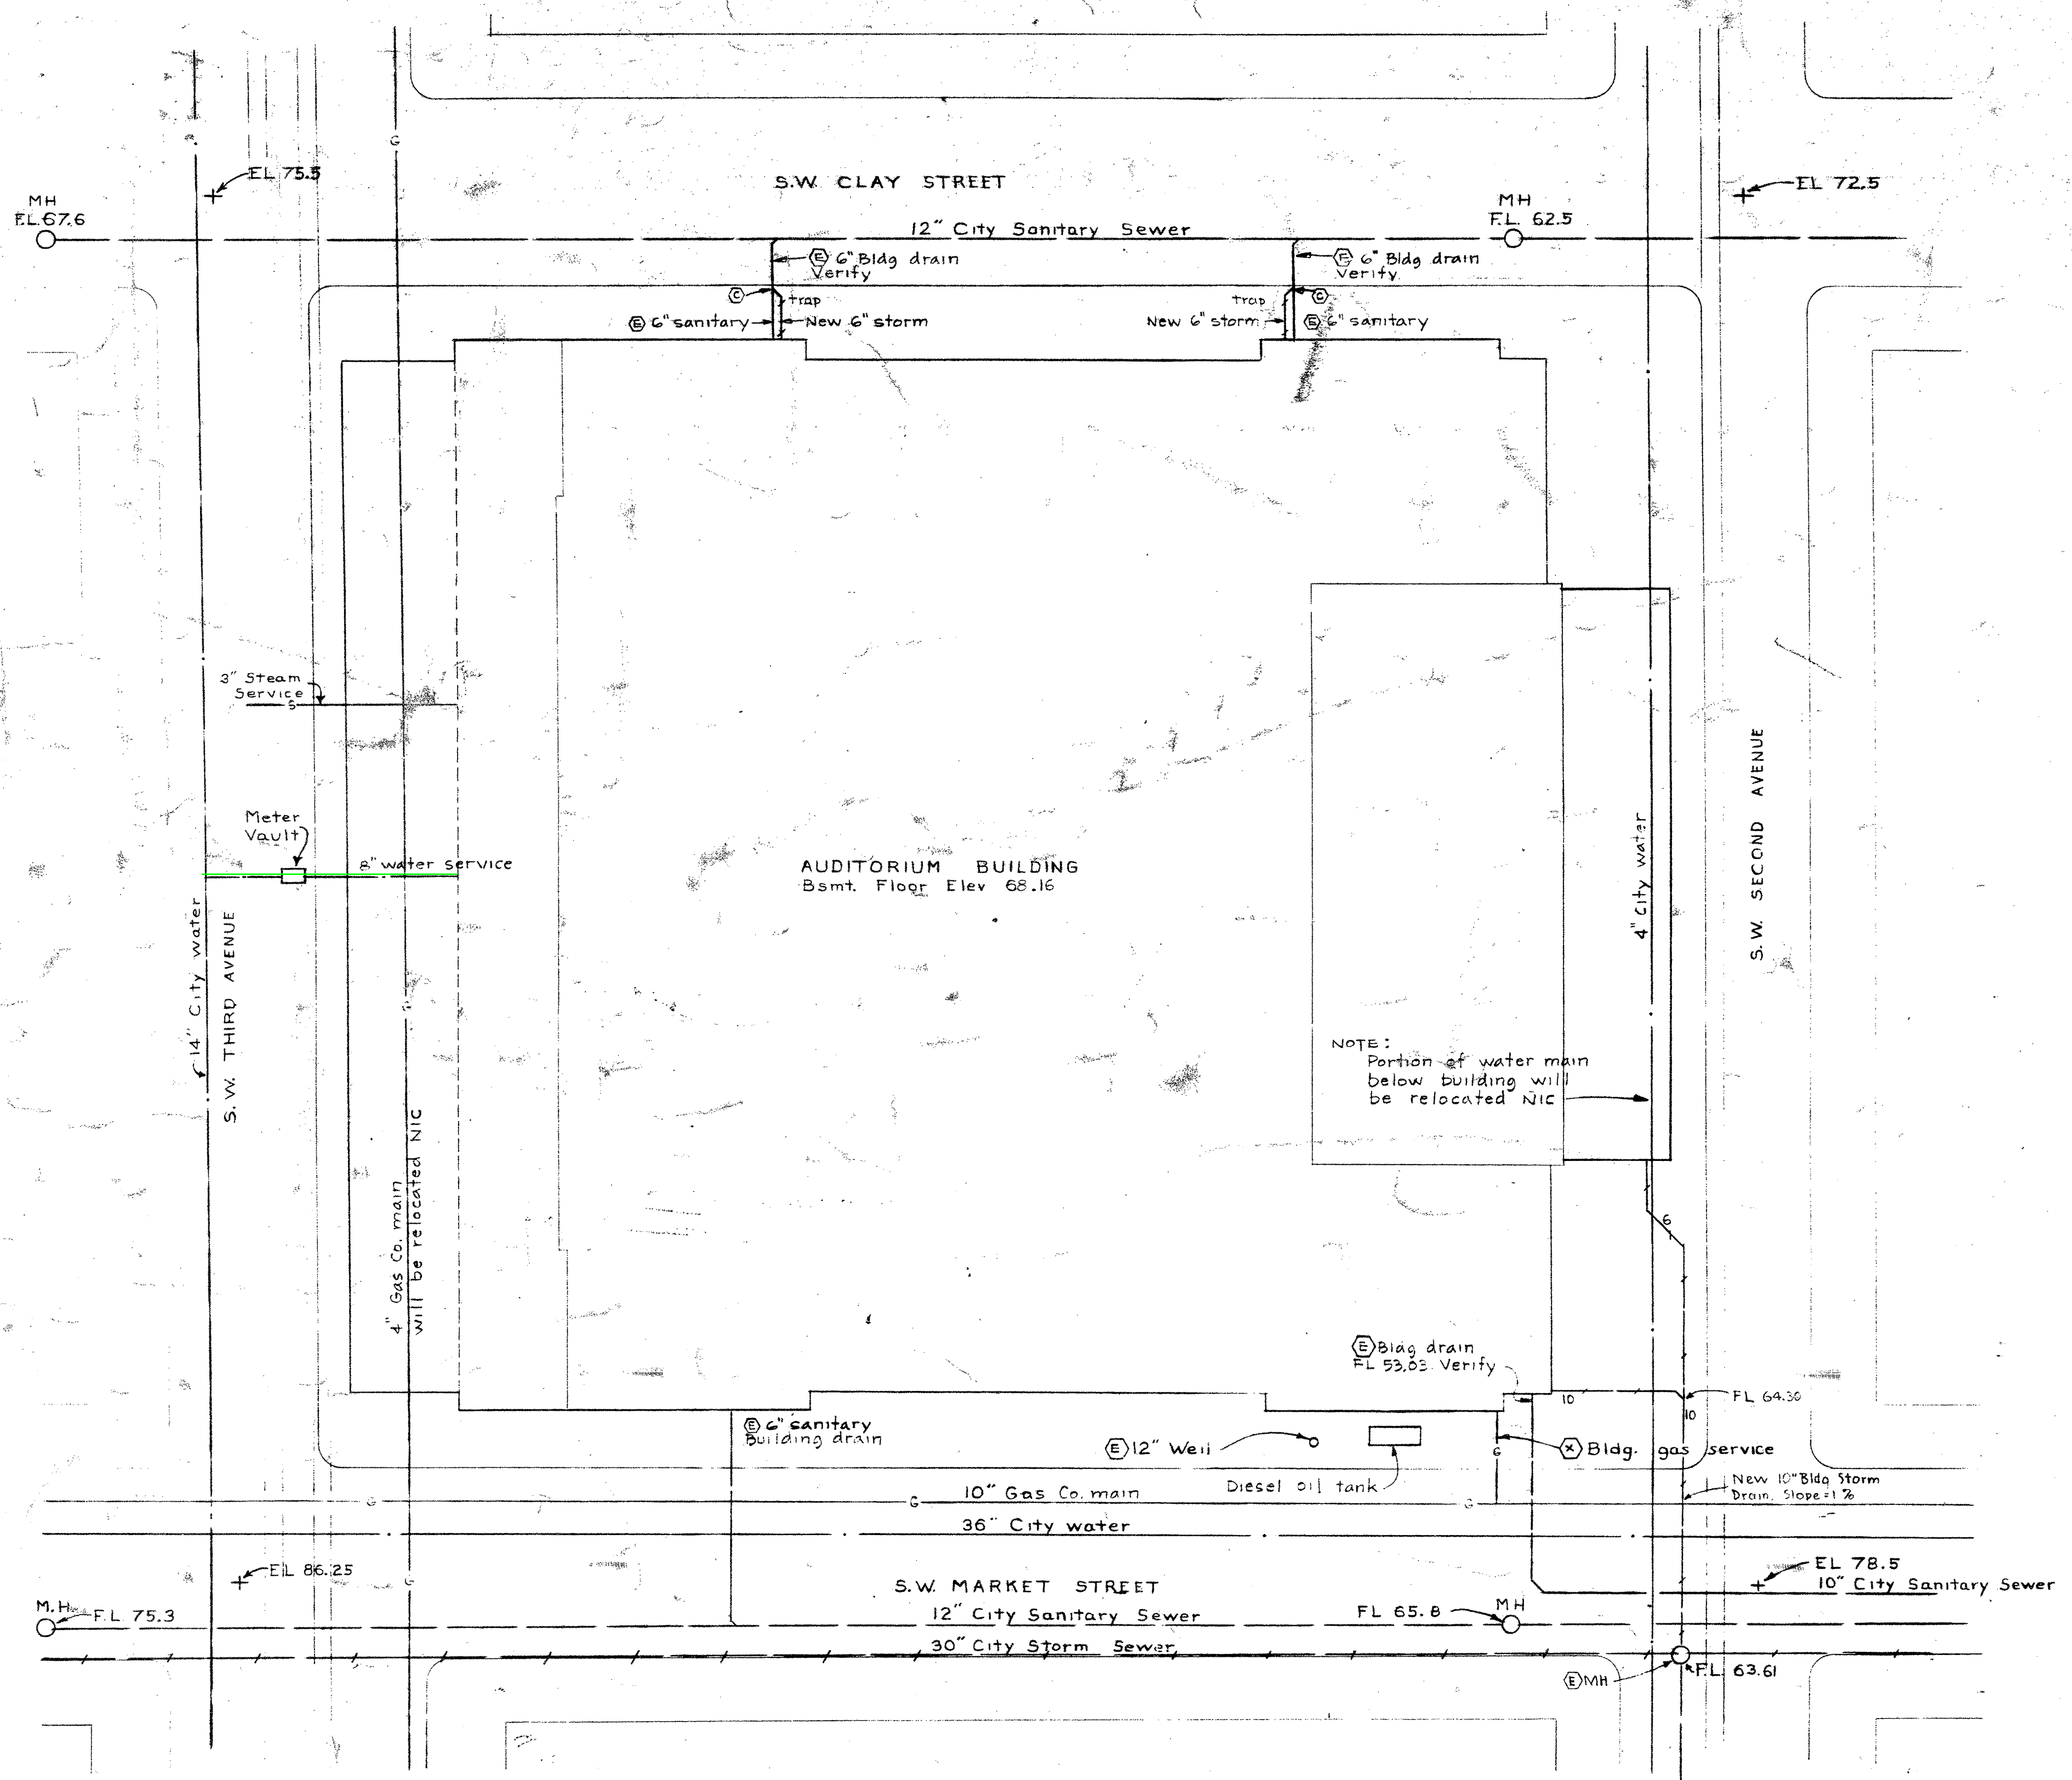

**PLOT PLAN**

1" = 20' Approx.  
 Notes: All elevations are approximate. Verify

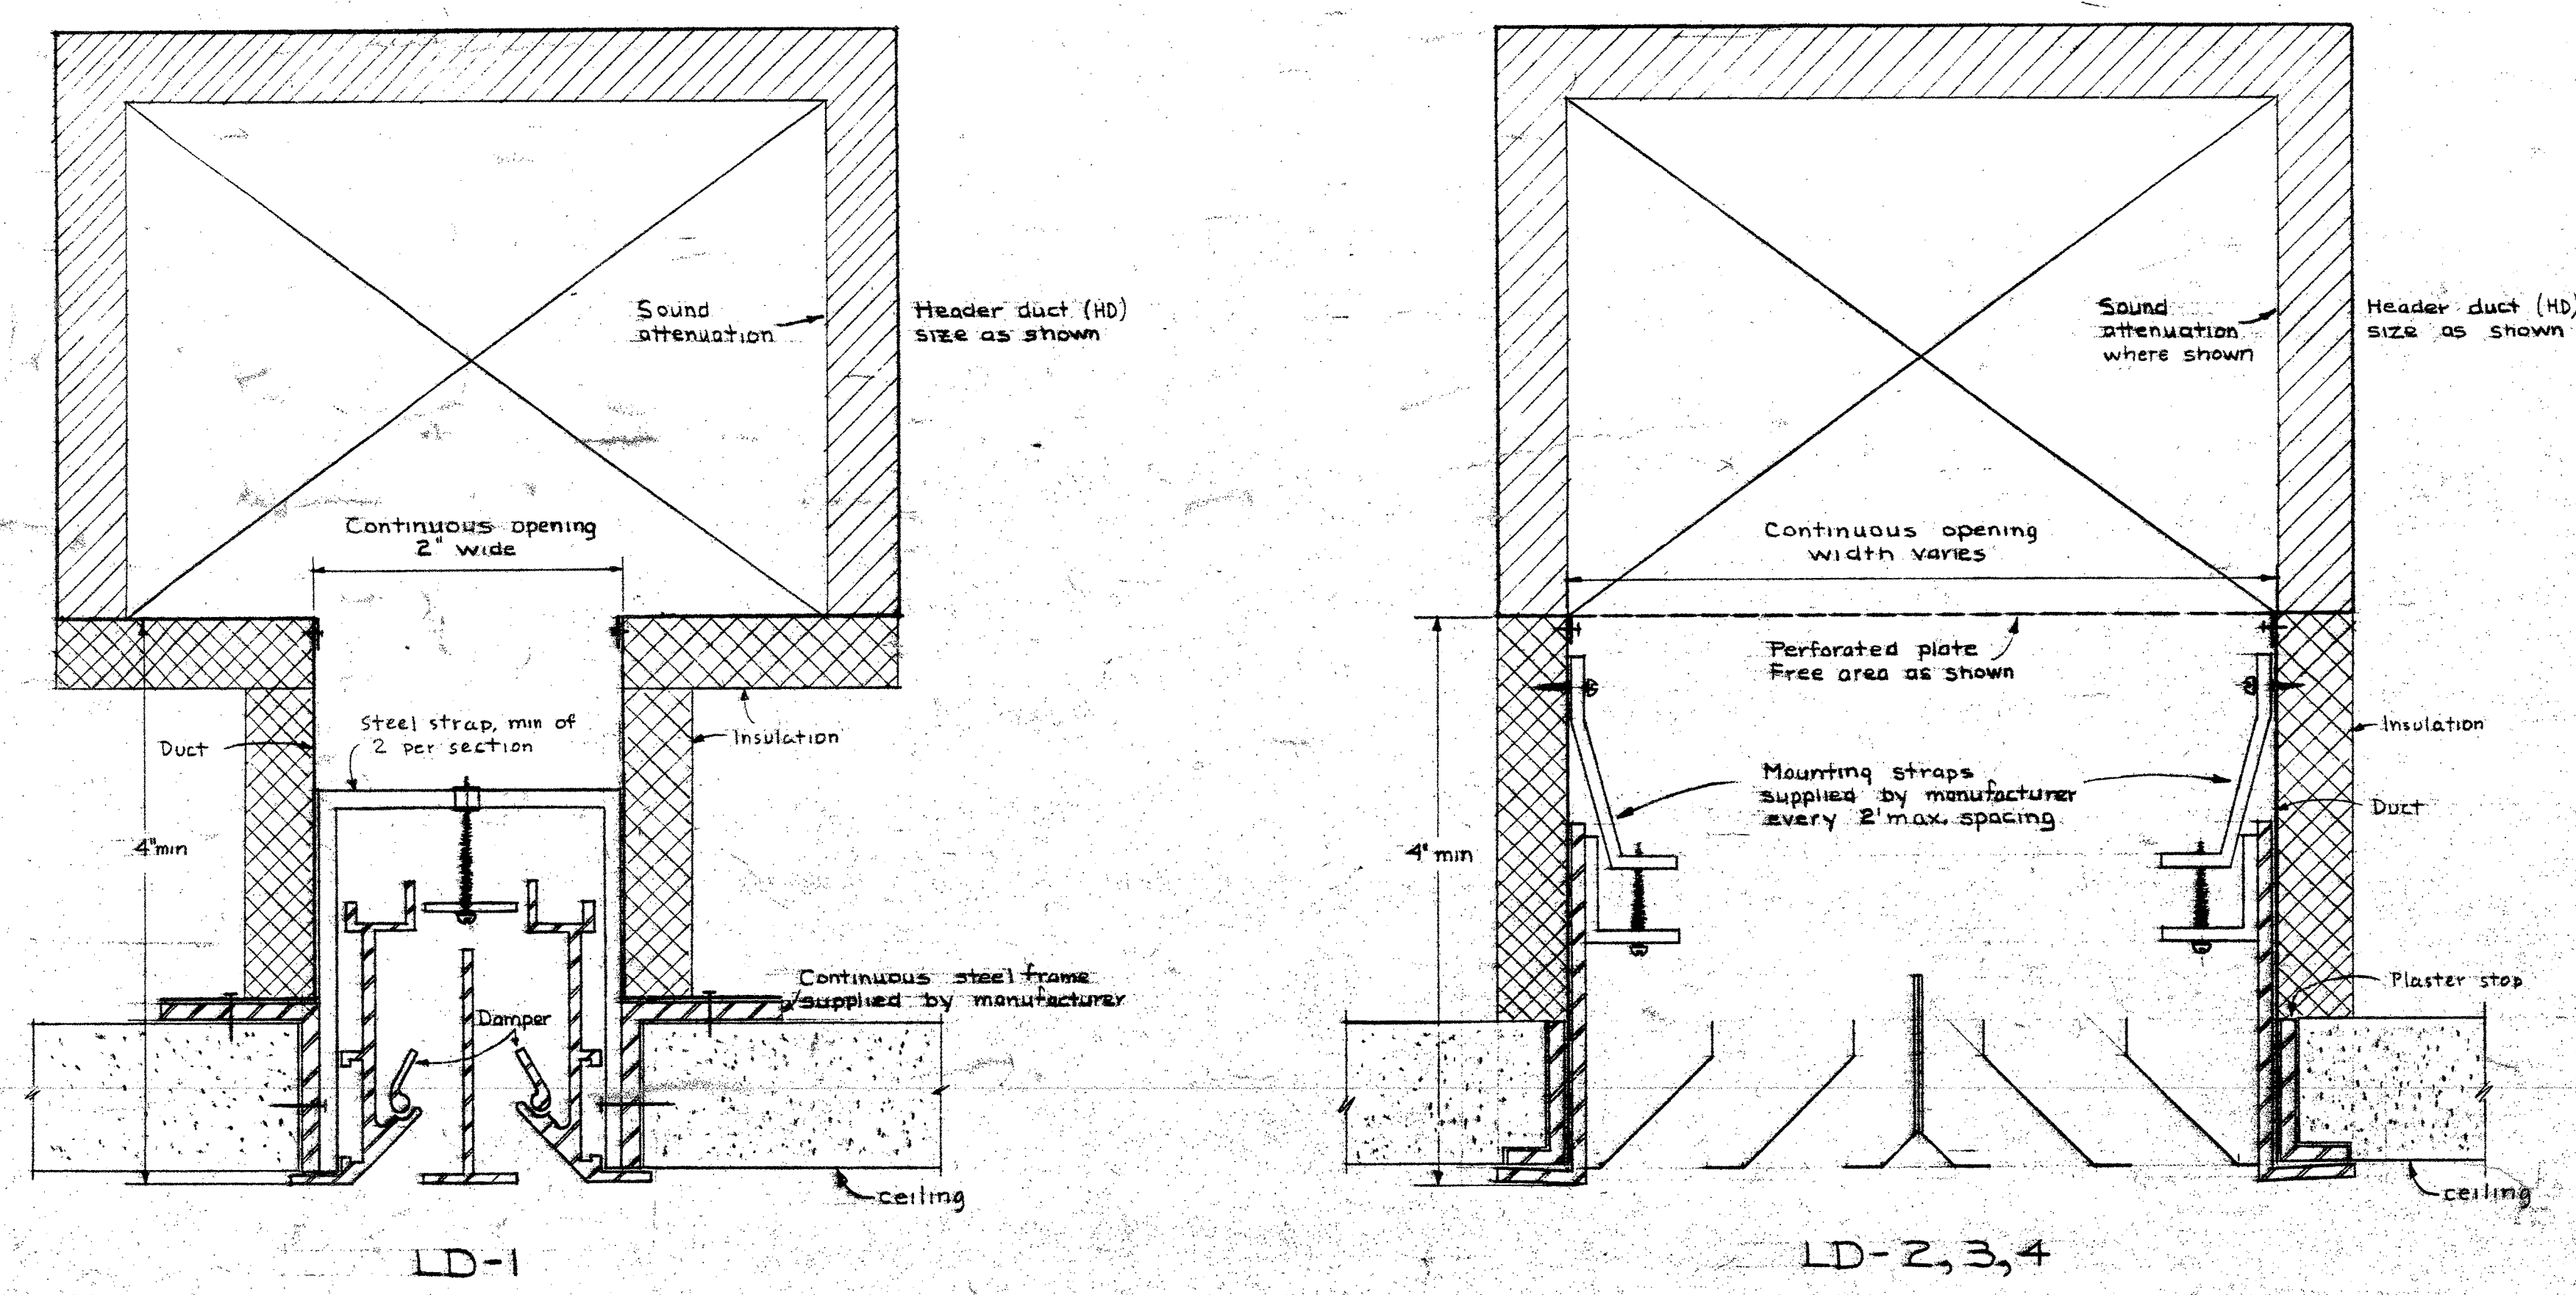

**TYPICAL LINEAR DIFFUSER MOUNTING DETAILS**  
 No Scale

**MECHANICAL DRAWING SYMBOLS**

— S —	Steam	200	Air volume, cfm
— R —	Condensate return	LD-2	Linear diffuser
— C —	Cooling supply	14%FP	Perforated plate, 14% free area
— CR —	Cooling return	S	Splitter damper
— HS —	Heating supply	B	Butterfly damper
— HR —	Heating return	OAD	Outside air automatic damper
— WS —	Well water supply	EAD	Exhaust air automatic damper
— WR —	Well water return	RAD	Return air automatic damper
— CW —	Cold water	IVD	Inlet vane damper
— HW —	Hot water recirculated	MD	Mixing damper
— HW —	Hot water	SP	Static pressure damper
— SPR —	Sprinkler supply	SP	Riser number - heating & cooling pipes
— WSP —	Wet standpipe	⊗	Existing removed or abandoned, as applicable
— W —	Waste, soil, drainage	⊙	Below floor
— RD —	Roof drain	⊕	Existing to remain
— V —	Plumbing vent	⊖	Between joists
— G —	Gas	⊗	Rough-in
— G —	Gate valve	⊙	Air supply zone number
— C —	Check valve	⊕	Room number
— A —	Adjusting valve	⊖	Column line number
— AV —	Automatic valve	AAV	Automatic air vent valve
— U —	Union	SAV	Semi-automatic air vent valve
— G —	Globe valve	SU	Supply air unit
— CO —	Cleanout	EF	Exhaust fan
— FS —	Pitch down	FC-2	Fan-coil unit
— FS —	Flow measuring station	BH	Entry heater
— DP —	Drain pan piping	HP	Heating pump
— R —	Relief valve	BD	Blank-off top of diffuser
— V —	Drain valve	FD	Floor drain
— TSS —	Sprinkler heads; pendant, upright	WH	Wall hydrant
— TSS —	Tube service space	HC	Heating coil
— TSS —	Thermometer	CC	Cooling coil
— P —	Pipe capped	ASV	Automatic sequencing valve
— O —	Offset in duct; see details Drwg M-3	PRV	Pressure reducing valve
— S —	Supply or intake duct	BT	Bucket trap
— R —	Return or exhaust duct	FT	Float and thermostatic trap
— S —	Sound attenuated duct	CP	Ceiling plenum supply
— S —	Wall supply grille	MH	Manhole
— F —	Wall return grille at floor	EL	Elevation
— F —	Wall return grille at ceiling	FL	Flow-line elevation
— FC —	Wall return grille at floor and ceiling	VTR	Vent through roof
— R40 —	Ceiling diffuser, Agitair pattern no.	DD	Deflection damper
— R —	Ceiling return grille	MCC	Motor control center NIM
— FLD —	Fire sub duct	NIM	Not in mechanical work
— DSP —	Dry standpipe	FHC	Fire hose cabinet
— CD —	Canopy drain	HD	Header duct
— A —	Access door	IM	Ice machine (NIM)
— T —	Thermostat	CM	Coffee machine (NIM)
— G —	Pressure gage	ST	Sound trap
		DEC	Duct encased in concrete; see detail Drwg M-6
		BB	Special baseboard return grille; see specifications



**MECHANICAL**  
**PLOT PLAN AND DETAILS**

**B. MARCUS PRITECA**  
 ARCHITECT

**PAUL VENKLAUS & ASSOCIATES**  
 ARCHITECTURAL CONSULTANTS

**COOPER & ROSE ASSOCIATES
 STRUCTURAL ENGINEERS**

**J. DONALD KROEGER & ASSOCIATES**  
 MECHANICAL ENGINEERS

**GRANT KELLEY & ASSOCIATES**  
 ELECTRICAL ENGINEERS

**LILA COLWELL A.L.D.**  
 MECHANICAL CONSULTANT


**REBUILDING OF**  
**PORTLAND CIVIC AUDITORIUM**  
 3 W. THIRD AVENUE & CLAY STREET  
 702  
 CITY OF PORTLAND OREGON

**STANTON, BOLES, HARDY & BURGESS**  
 ARCHITECTS  
 208 S. W. STARR ST., PORTLAND 4, OREGON  
 PHONE NO. 5329  
 TELETYPE 34 1955


**M-1**




FLOOR PLAN - LOWER BASEMENT LEVEL  
1/8" = 1'-0"

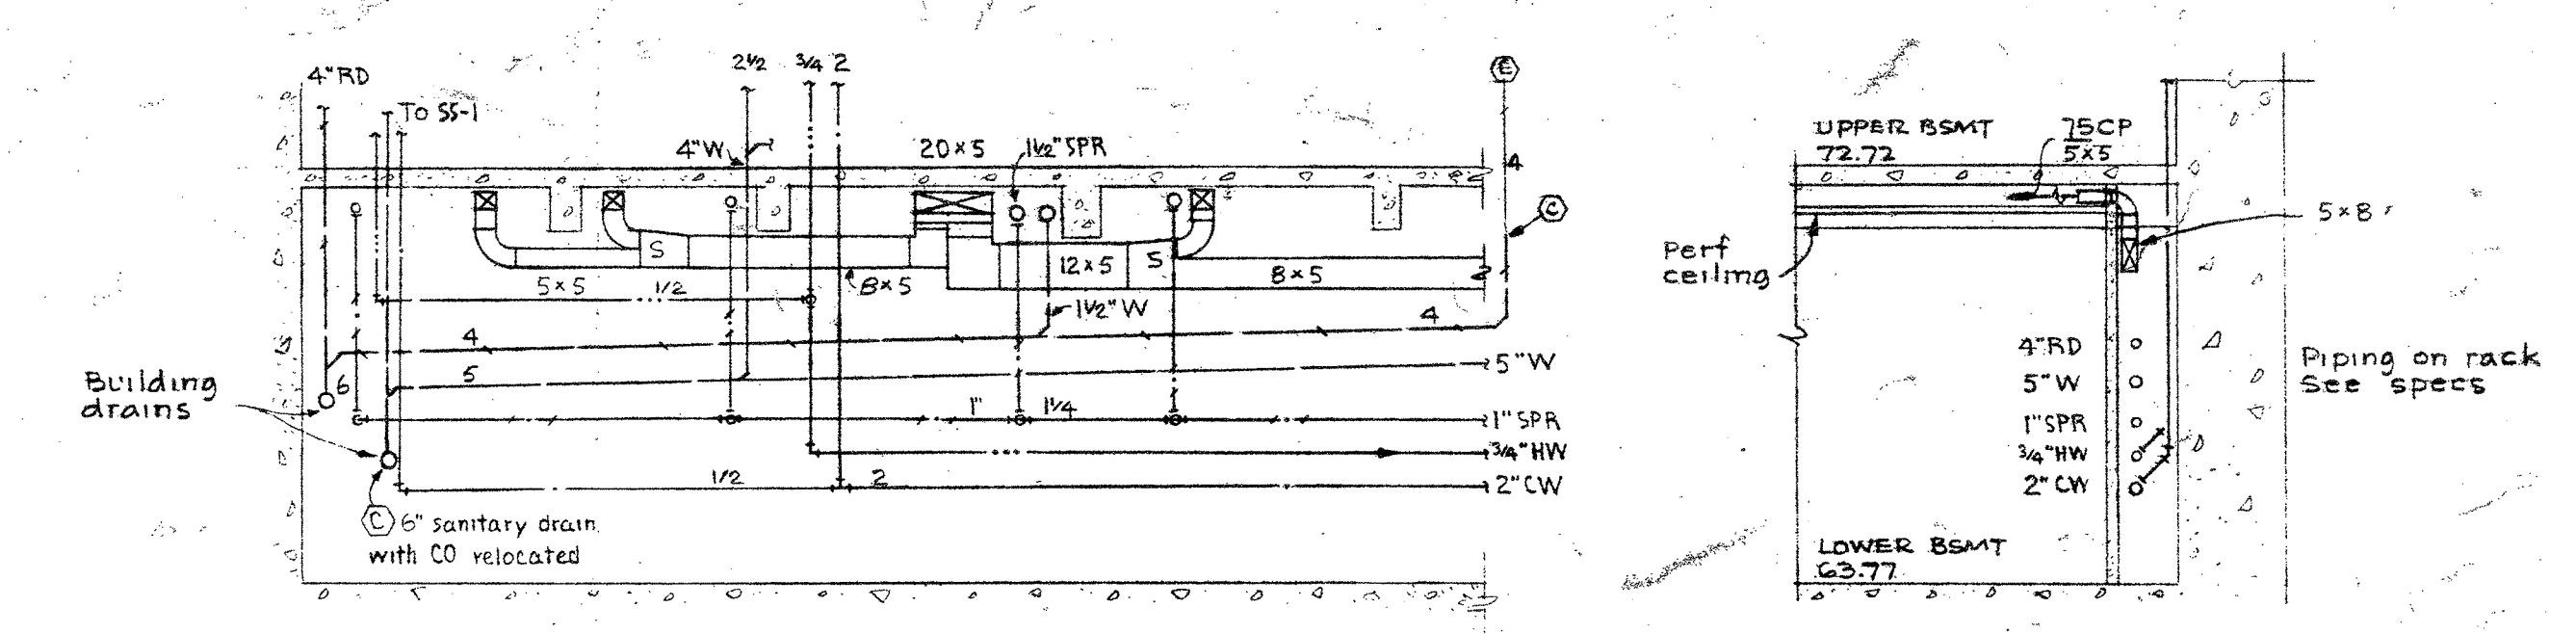


SECTION A-M2  
DETAILS OF PIPING AT WALL IN ROOM 107  
1/4" = 1'-0"

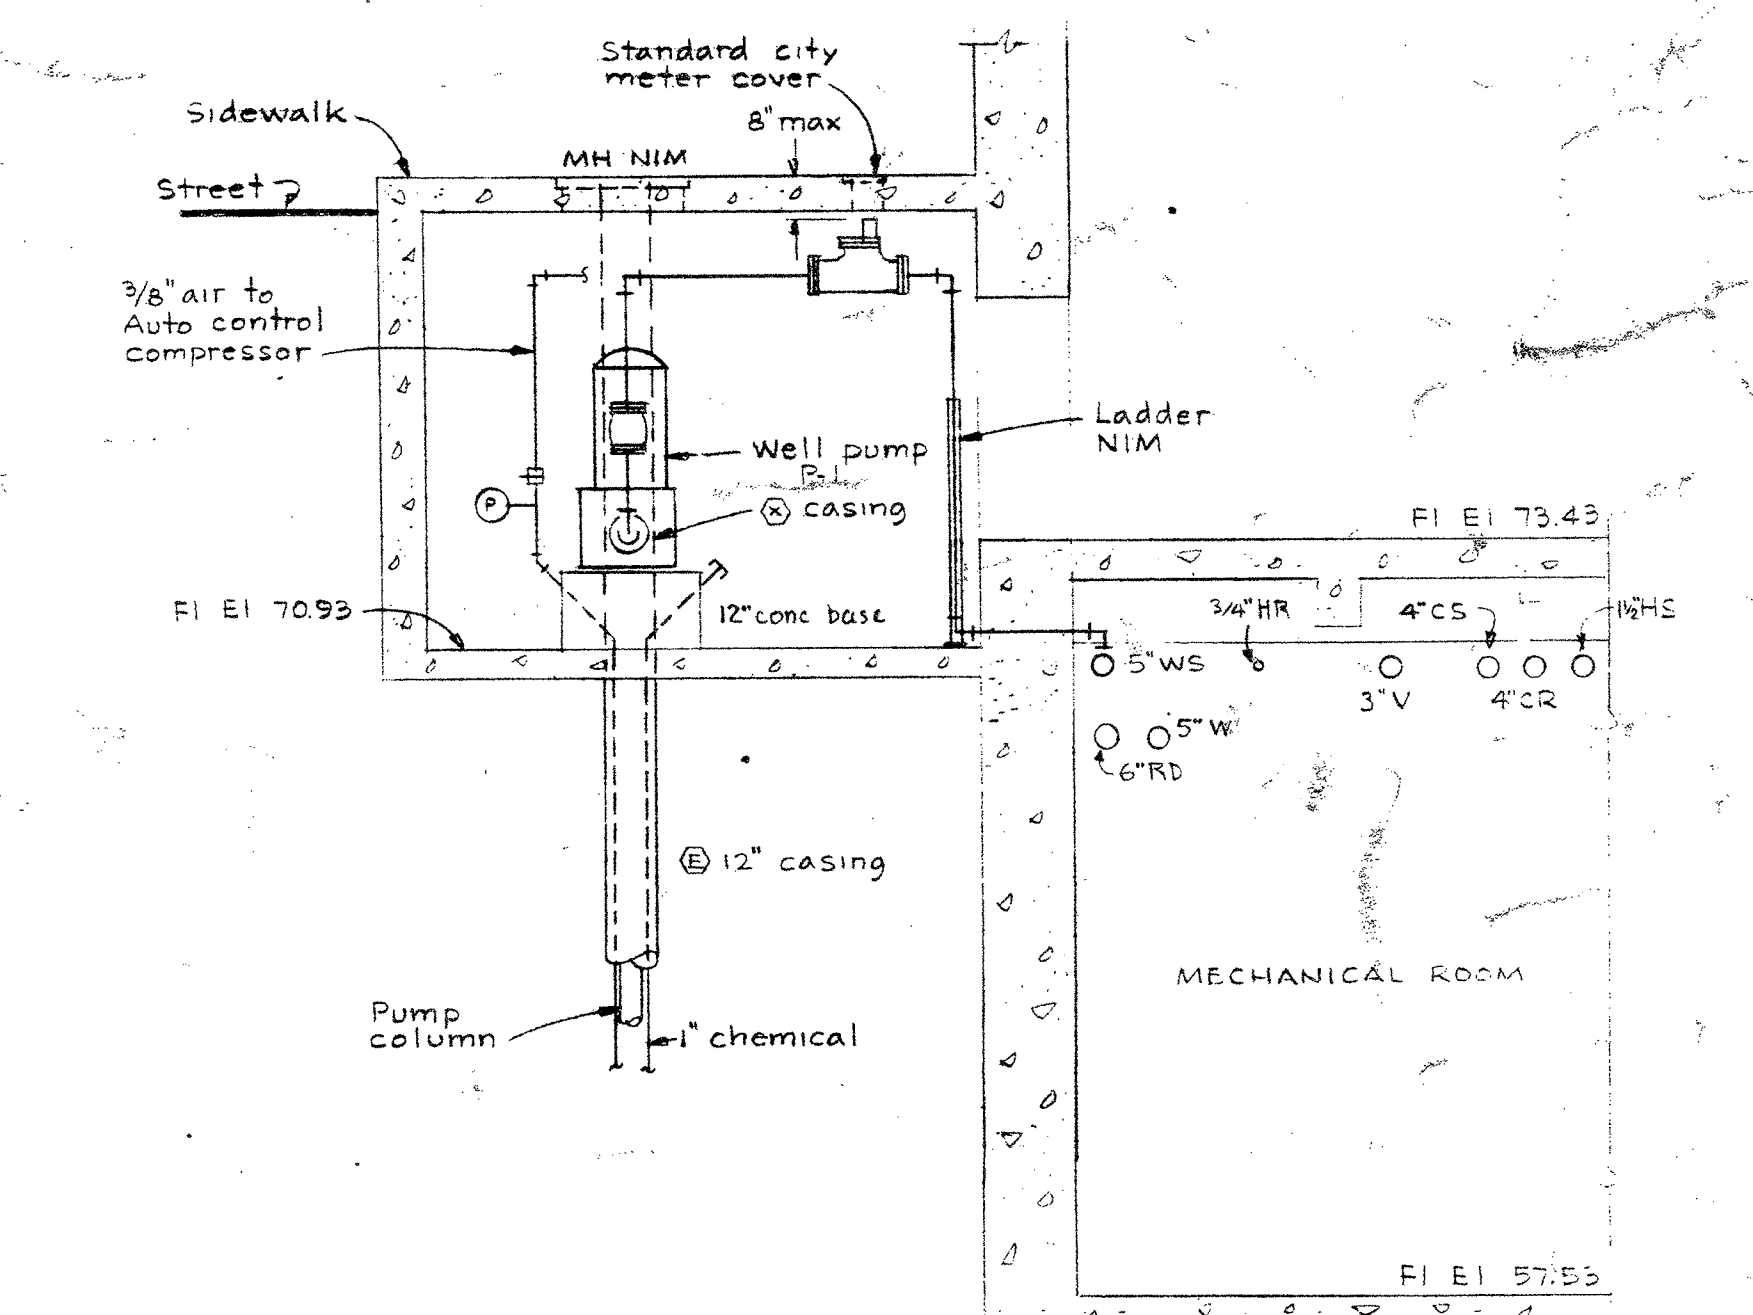


SECTION B-M2  
1/2" = 1'-0"

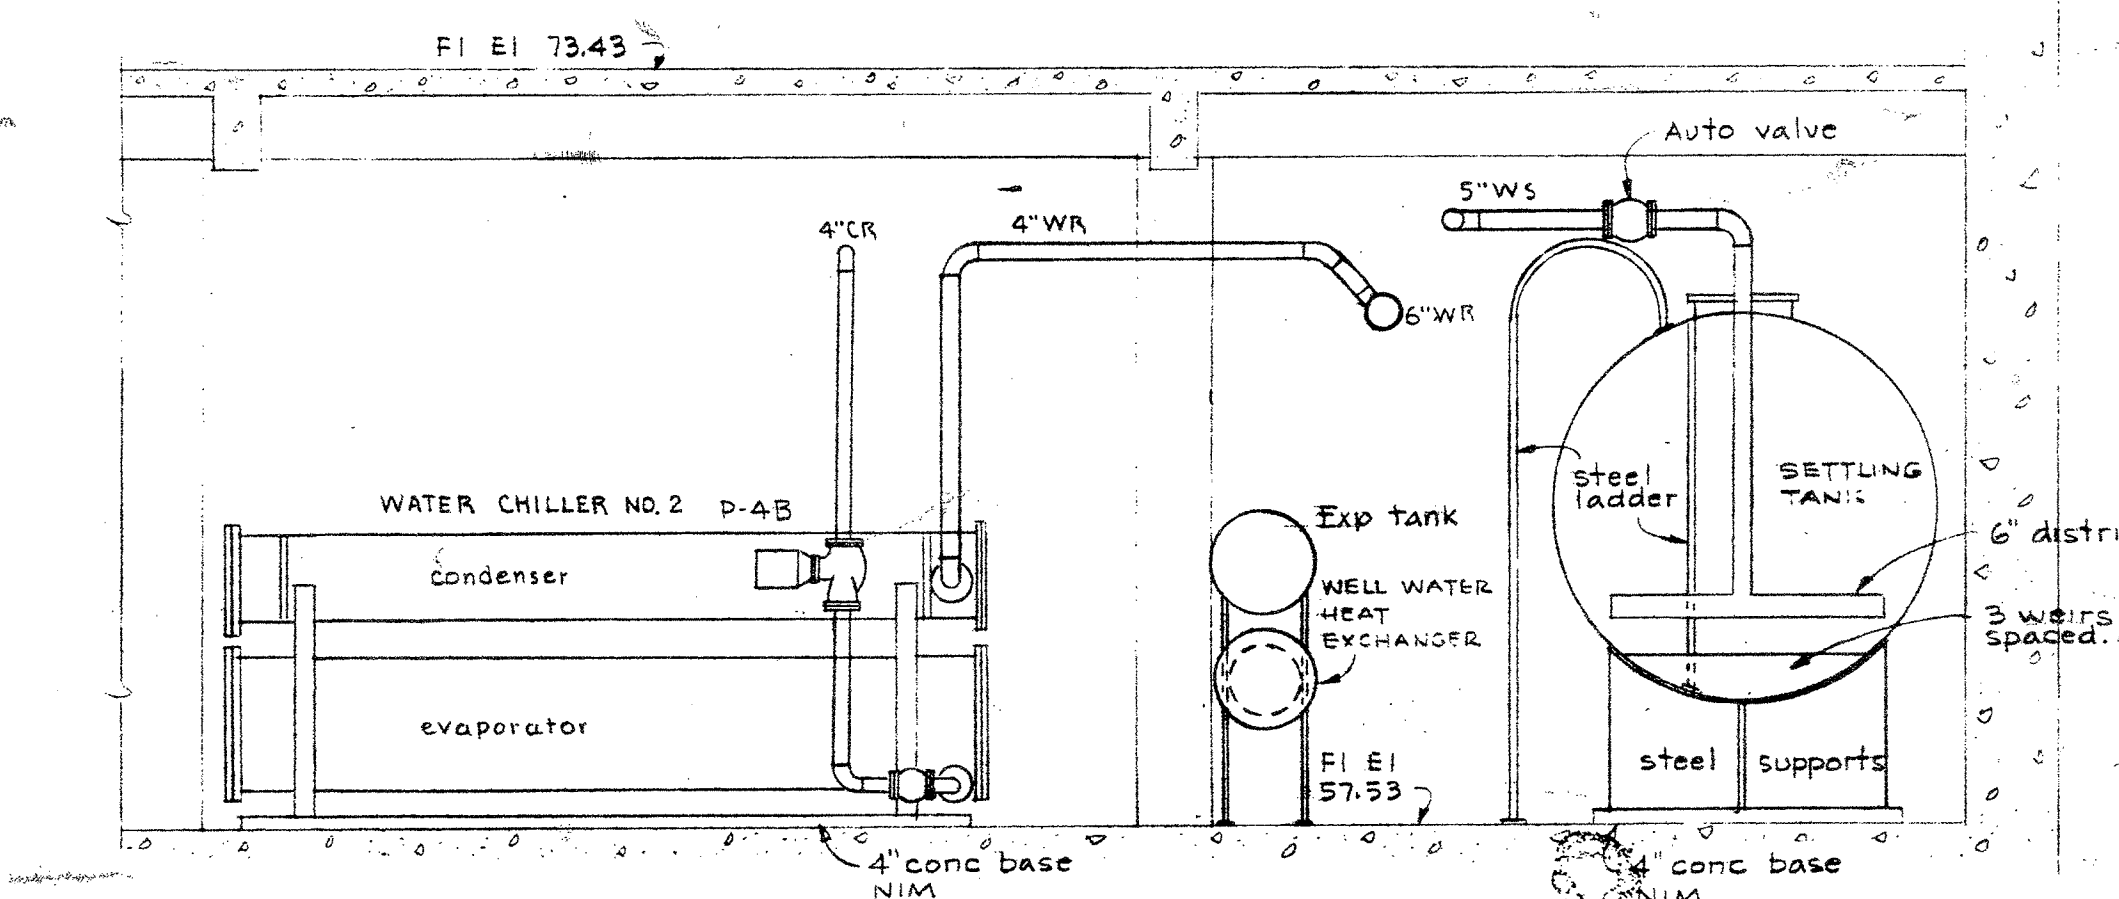

SECTION C-M2  
1/2" = 1'-0"

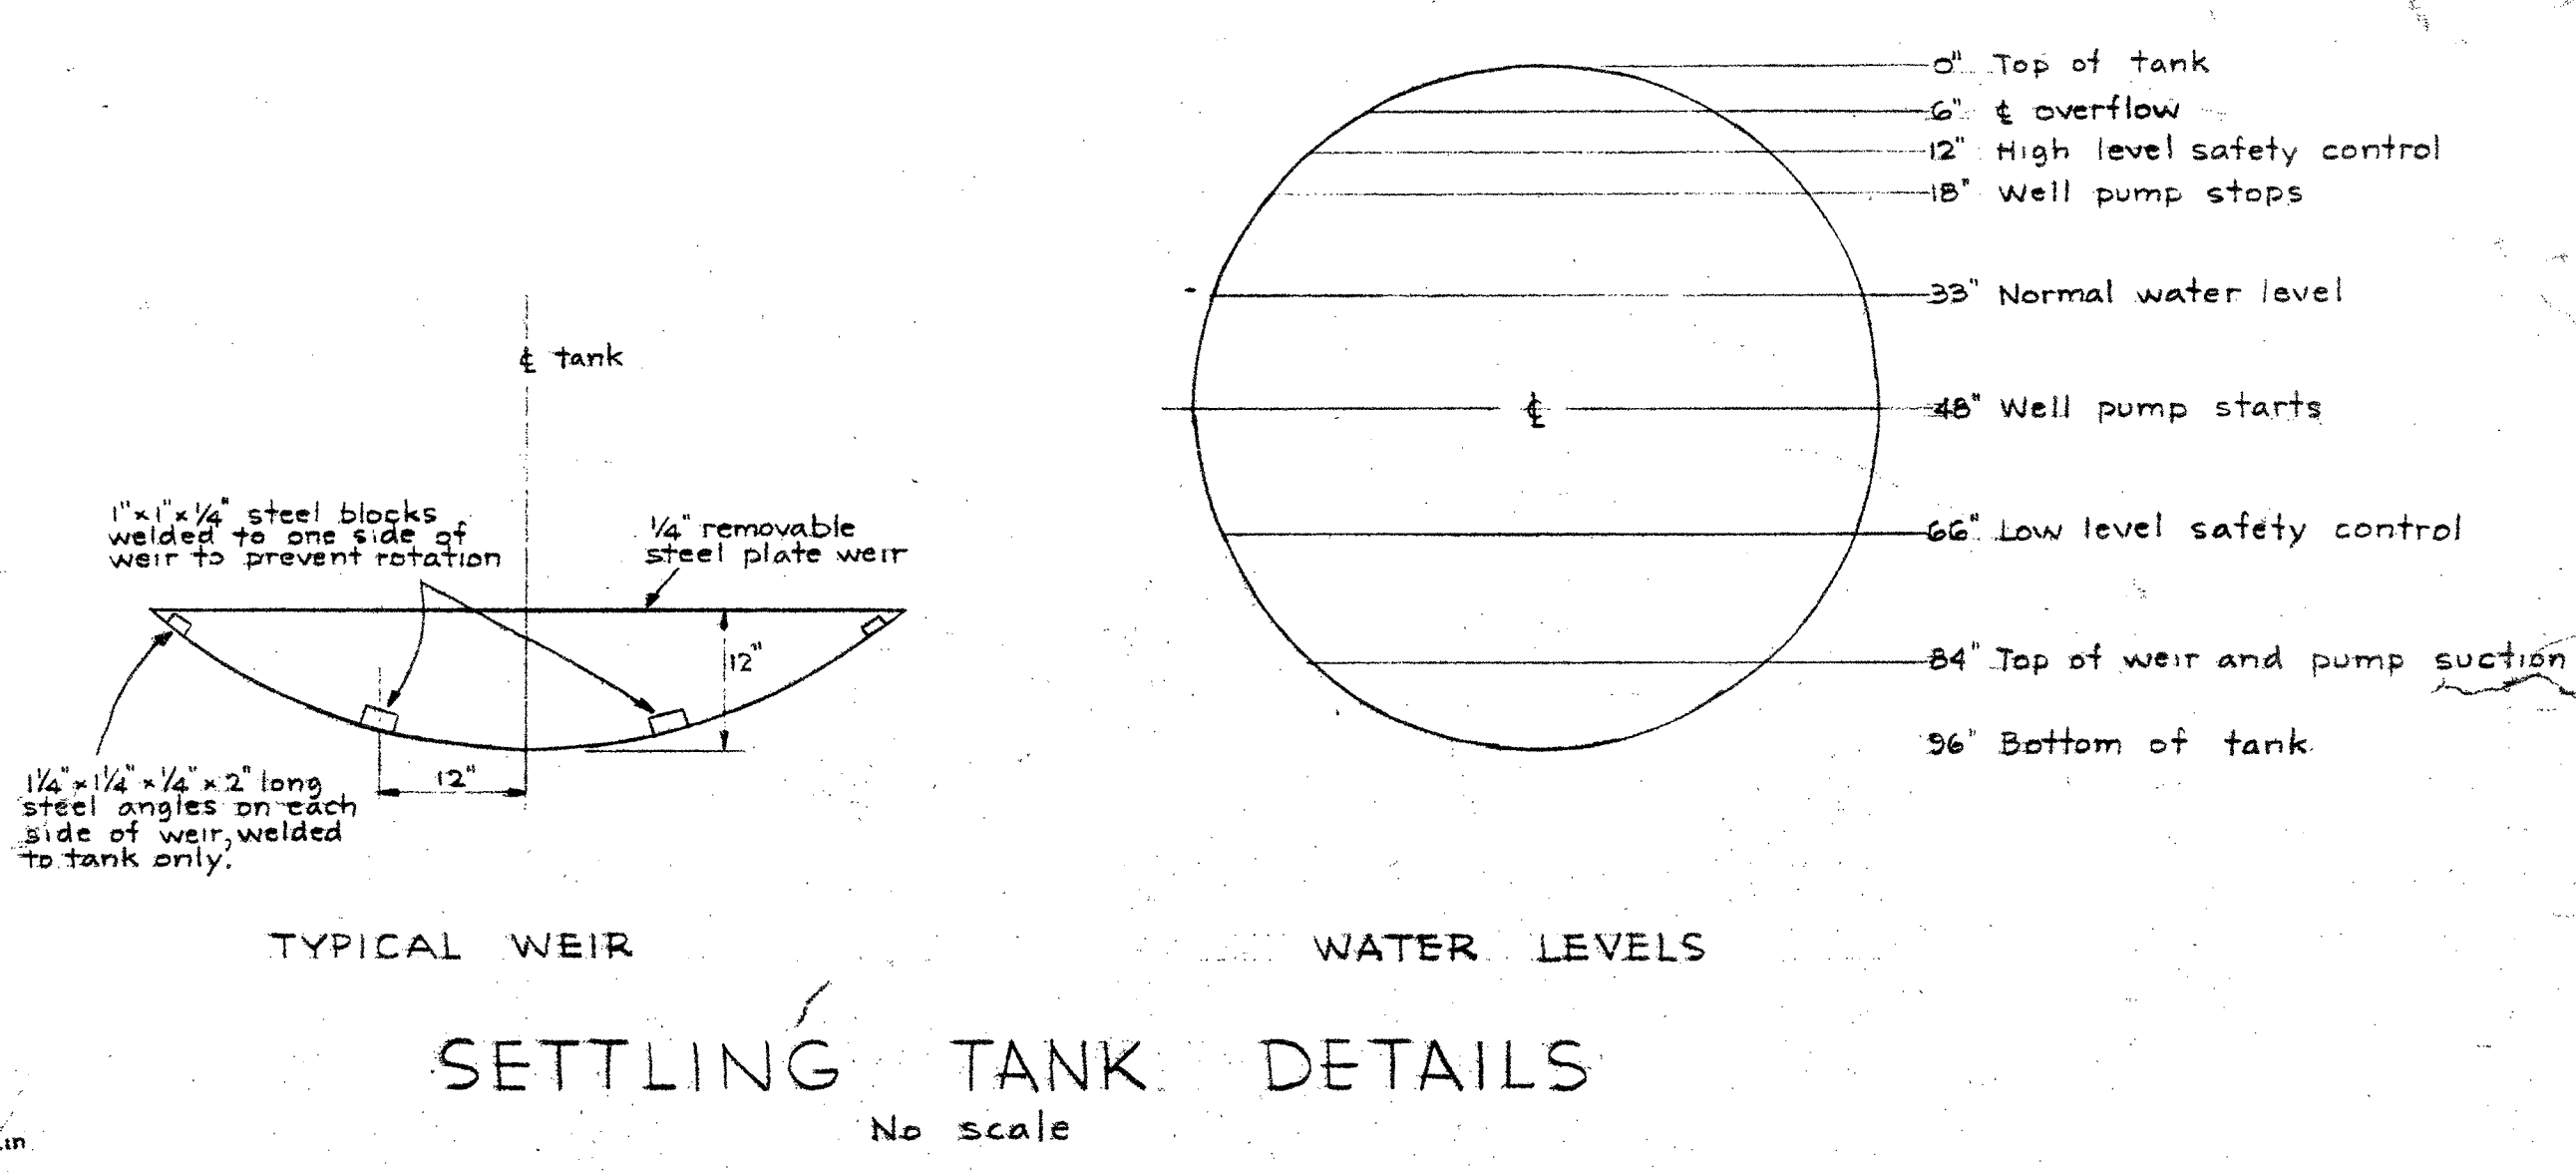

TYPICAL WEIR  
WATER LEVELS  
SETTLING TANK DETAILS  
No scale

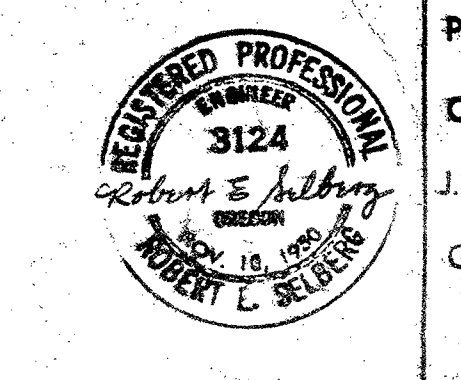

**MECHANICAL LOWER BASEMENT FLOOR PLAN AND DETAILS**

**B. MARCUS PRITECA ARCHITECT**  
THEATER CONSULTANT

**PAUL VENEKLAEN & ASSOCIATES**  
ACOUSTICAL CONSULTANTS

**COOPER & ROSE & ASSOCIATES**  
STRUCTURAL ENGINEERS

**J. DONALD KROEBER & ASSOCIATES**  
MECHANICAL ENGINEERS

**GRANT KELLEY & ASSOCIATES**  
ELECTRICAL ENGINEERS

**LITA COLWELL A.I.D.**  
INTERIOR CONSULTANT


**REBUILDING OF PORTLAND CIVIC AUDITORIUM**  
2 W. THIRD AVENUE & CLAY STREET  
FOR CITY OF PORTLAND OREGON

**STANTON, BOLES, MAGUIRE & CHURCH ARCHITECTS**  
208 S. W. STARK ST., PORTLAND 4, OREGON  
COMM. NO. 6323 DRAWN  
DATE: MAY 24 1966 CHECKED


DRAWING **M-2**






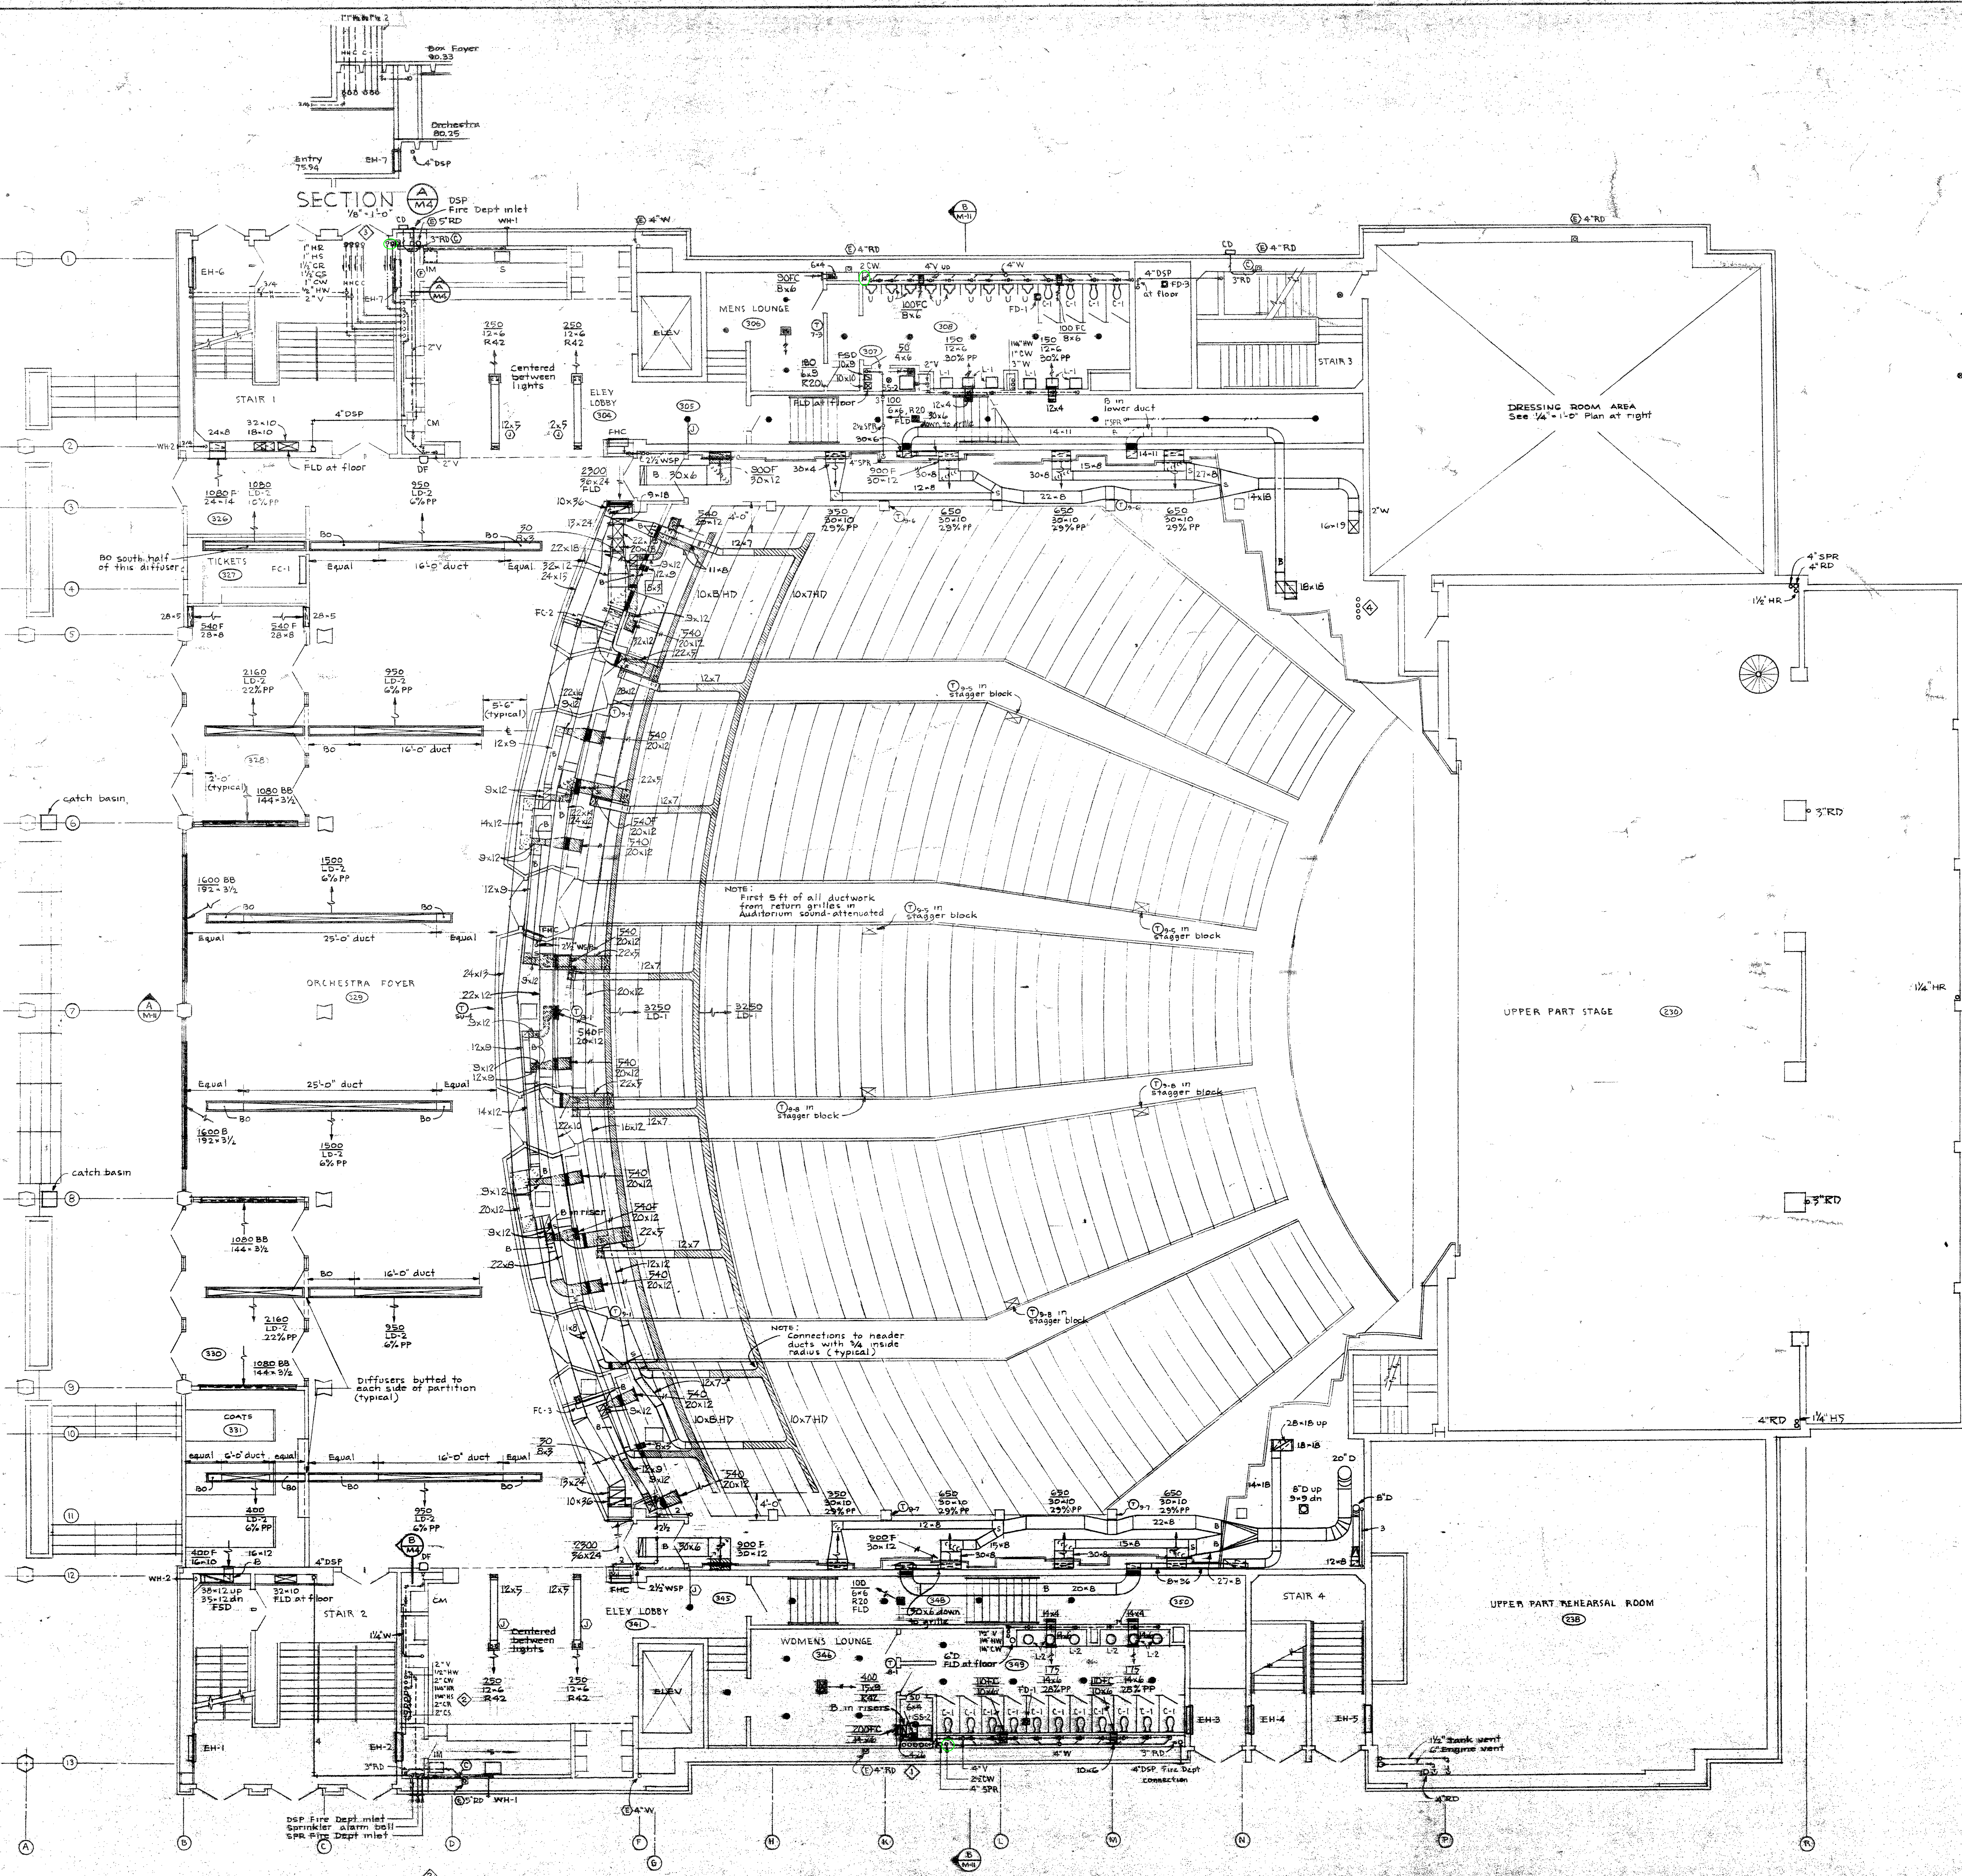

FLOOR PLAN - ORCHESTRA LEVEL  
1/8" = 1'-0"

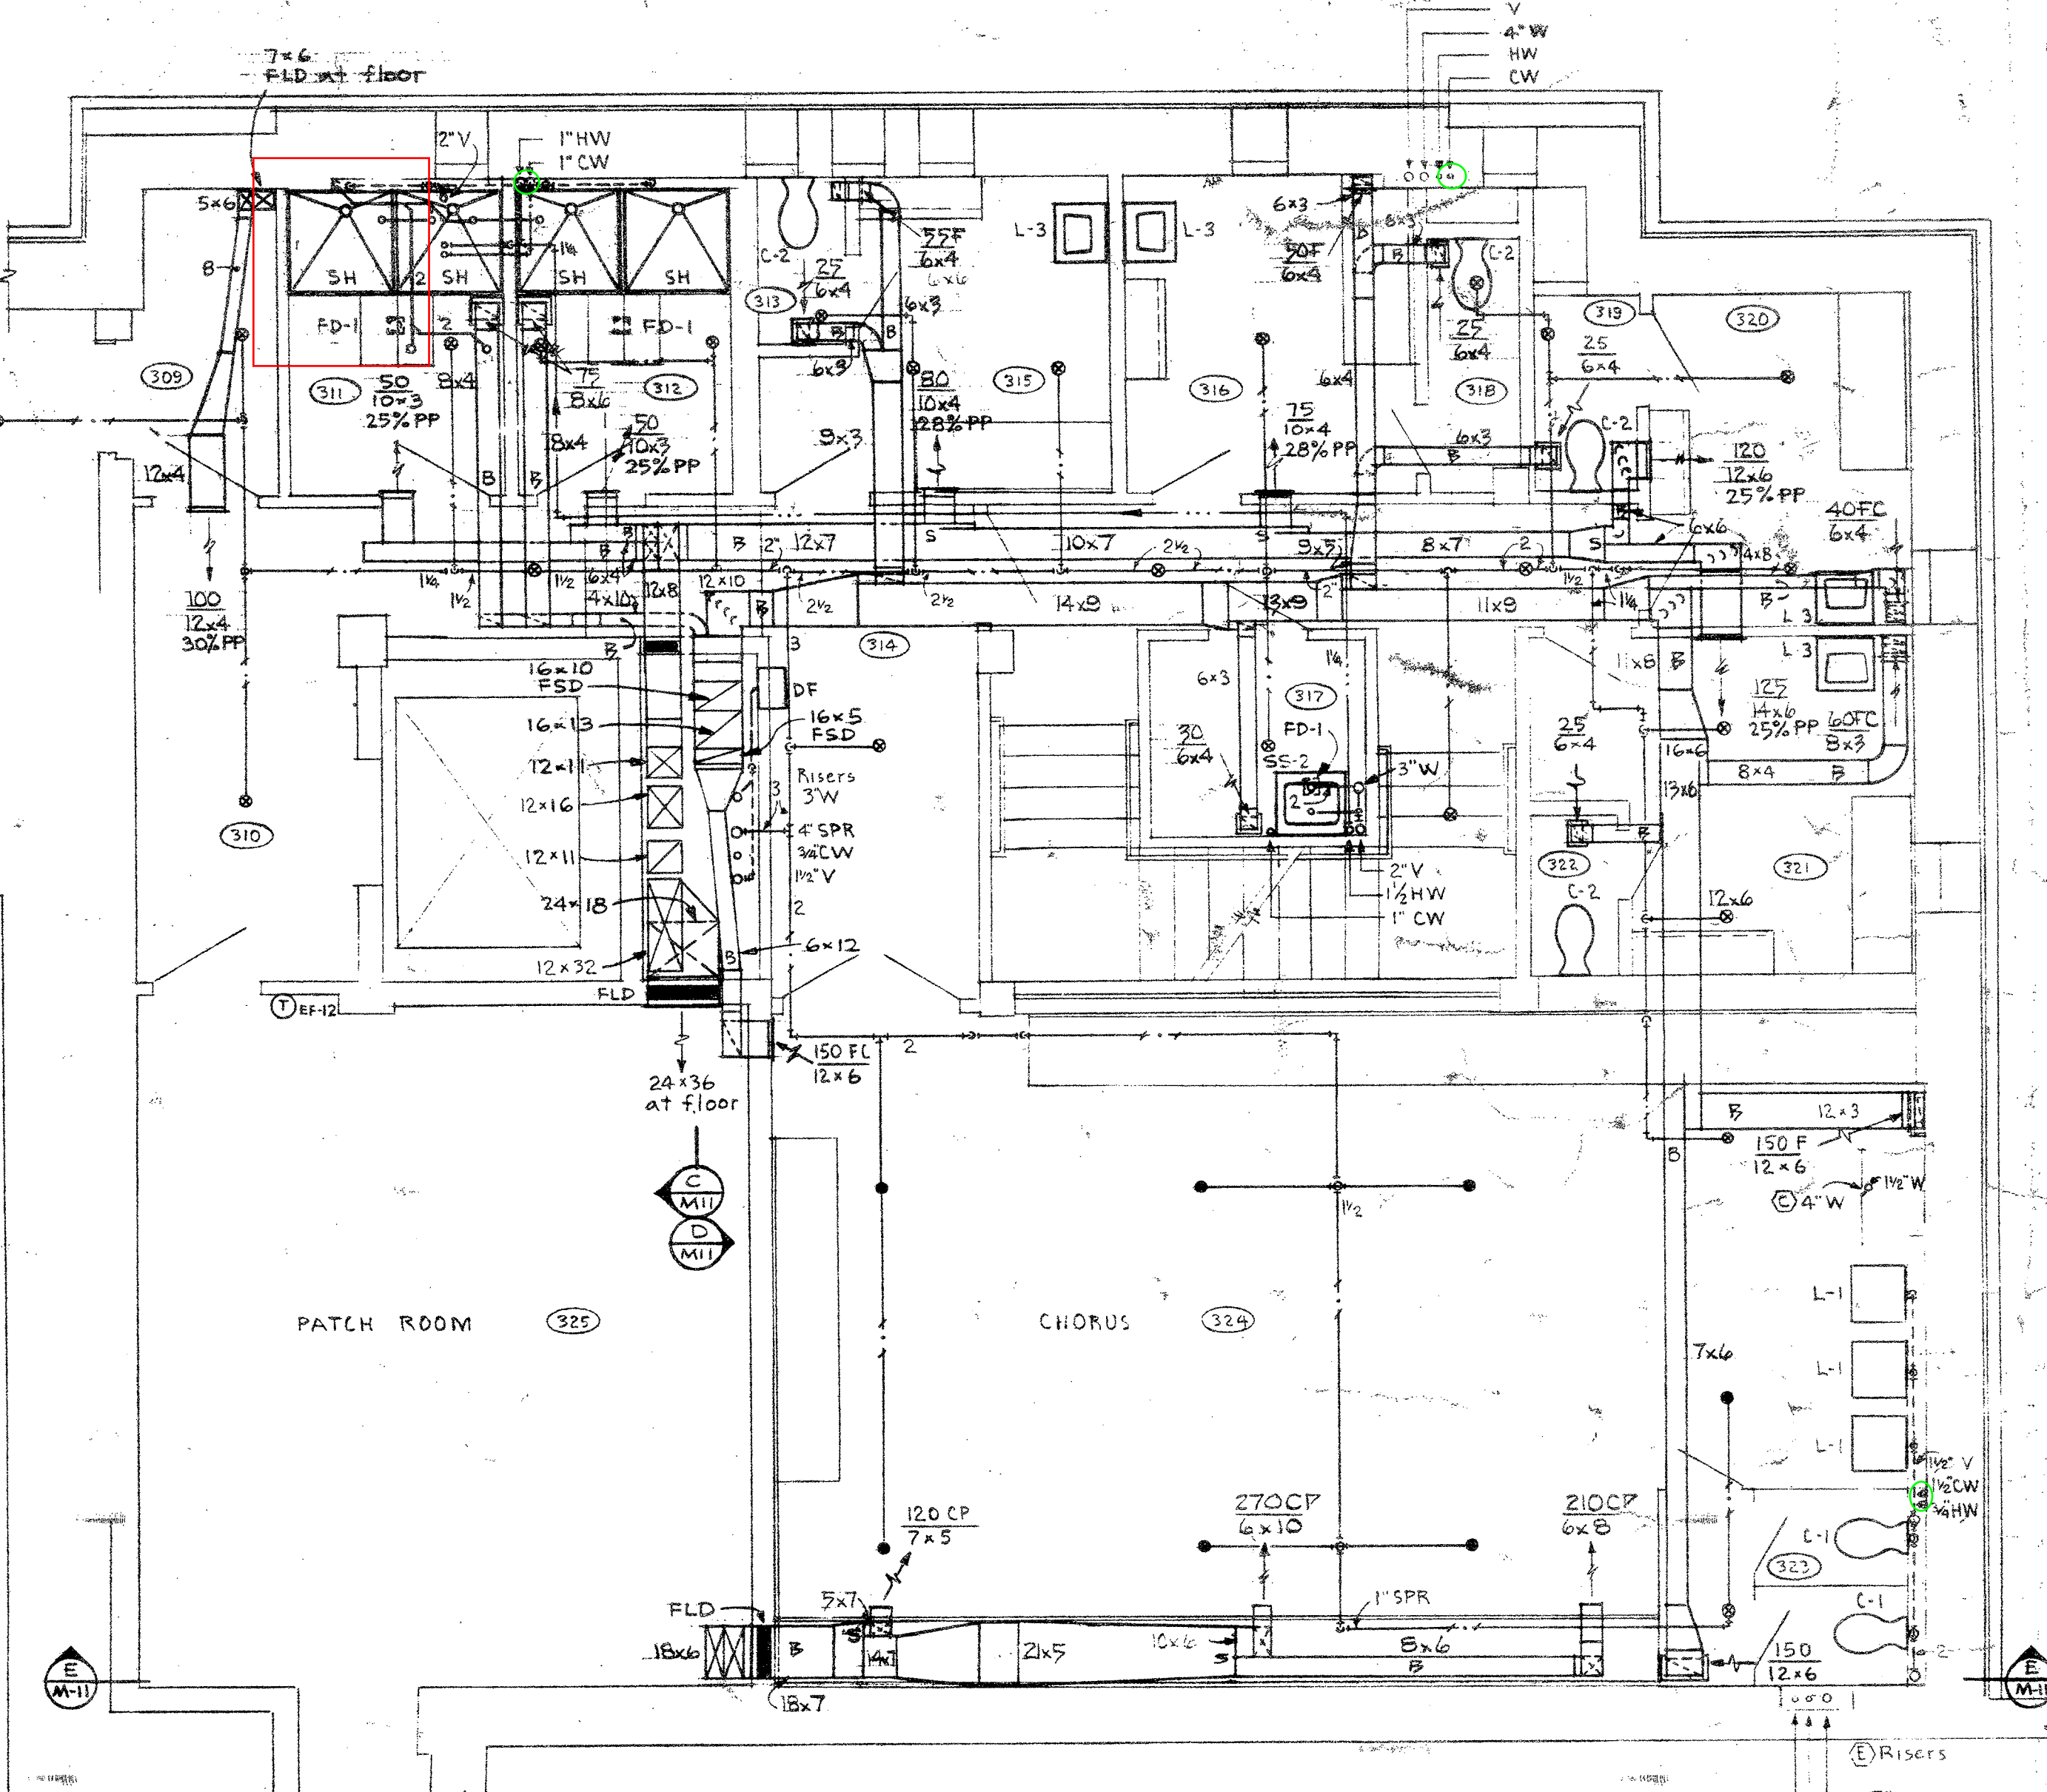

FLOOR PLAN - DRESSING ROOM AREA  
ORCHESTRA LEVEL  
1/4" = 1'-0"

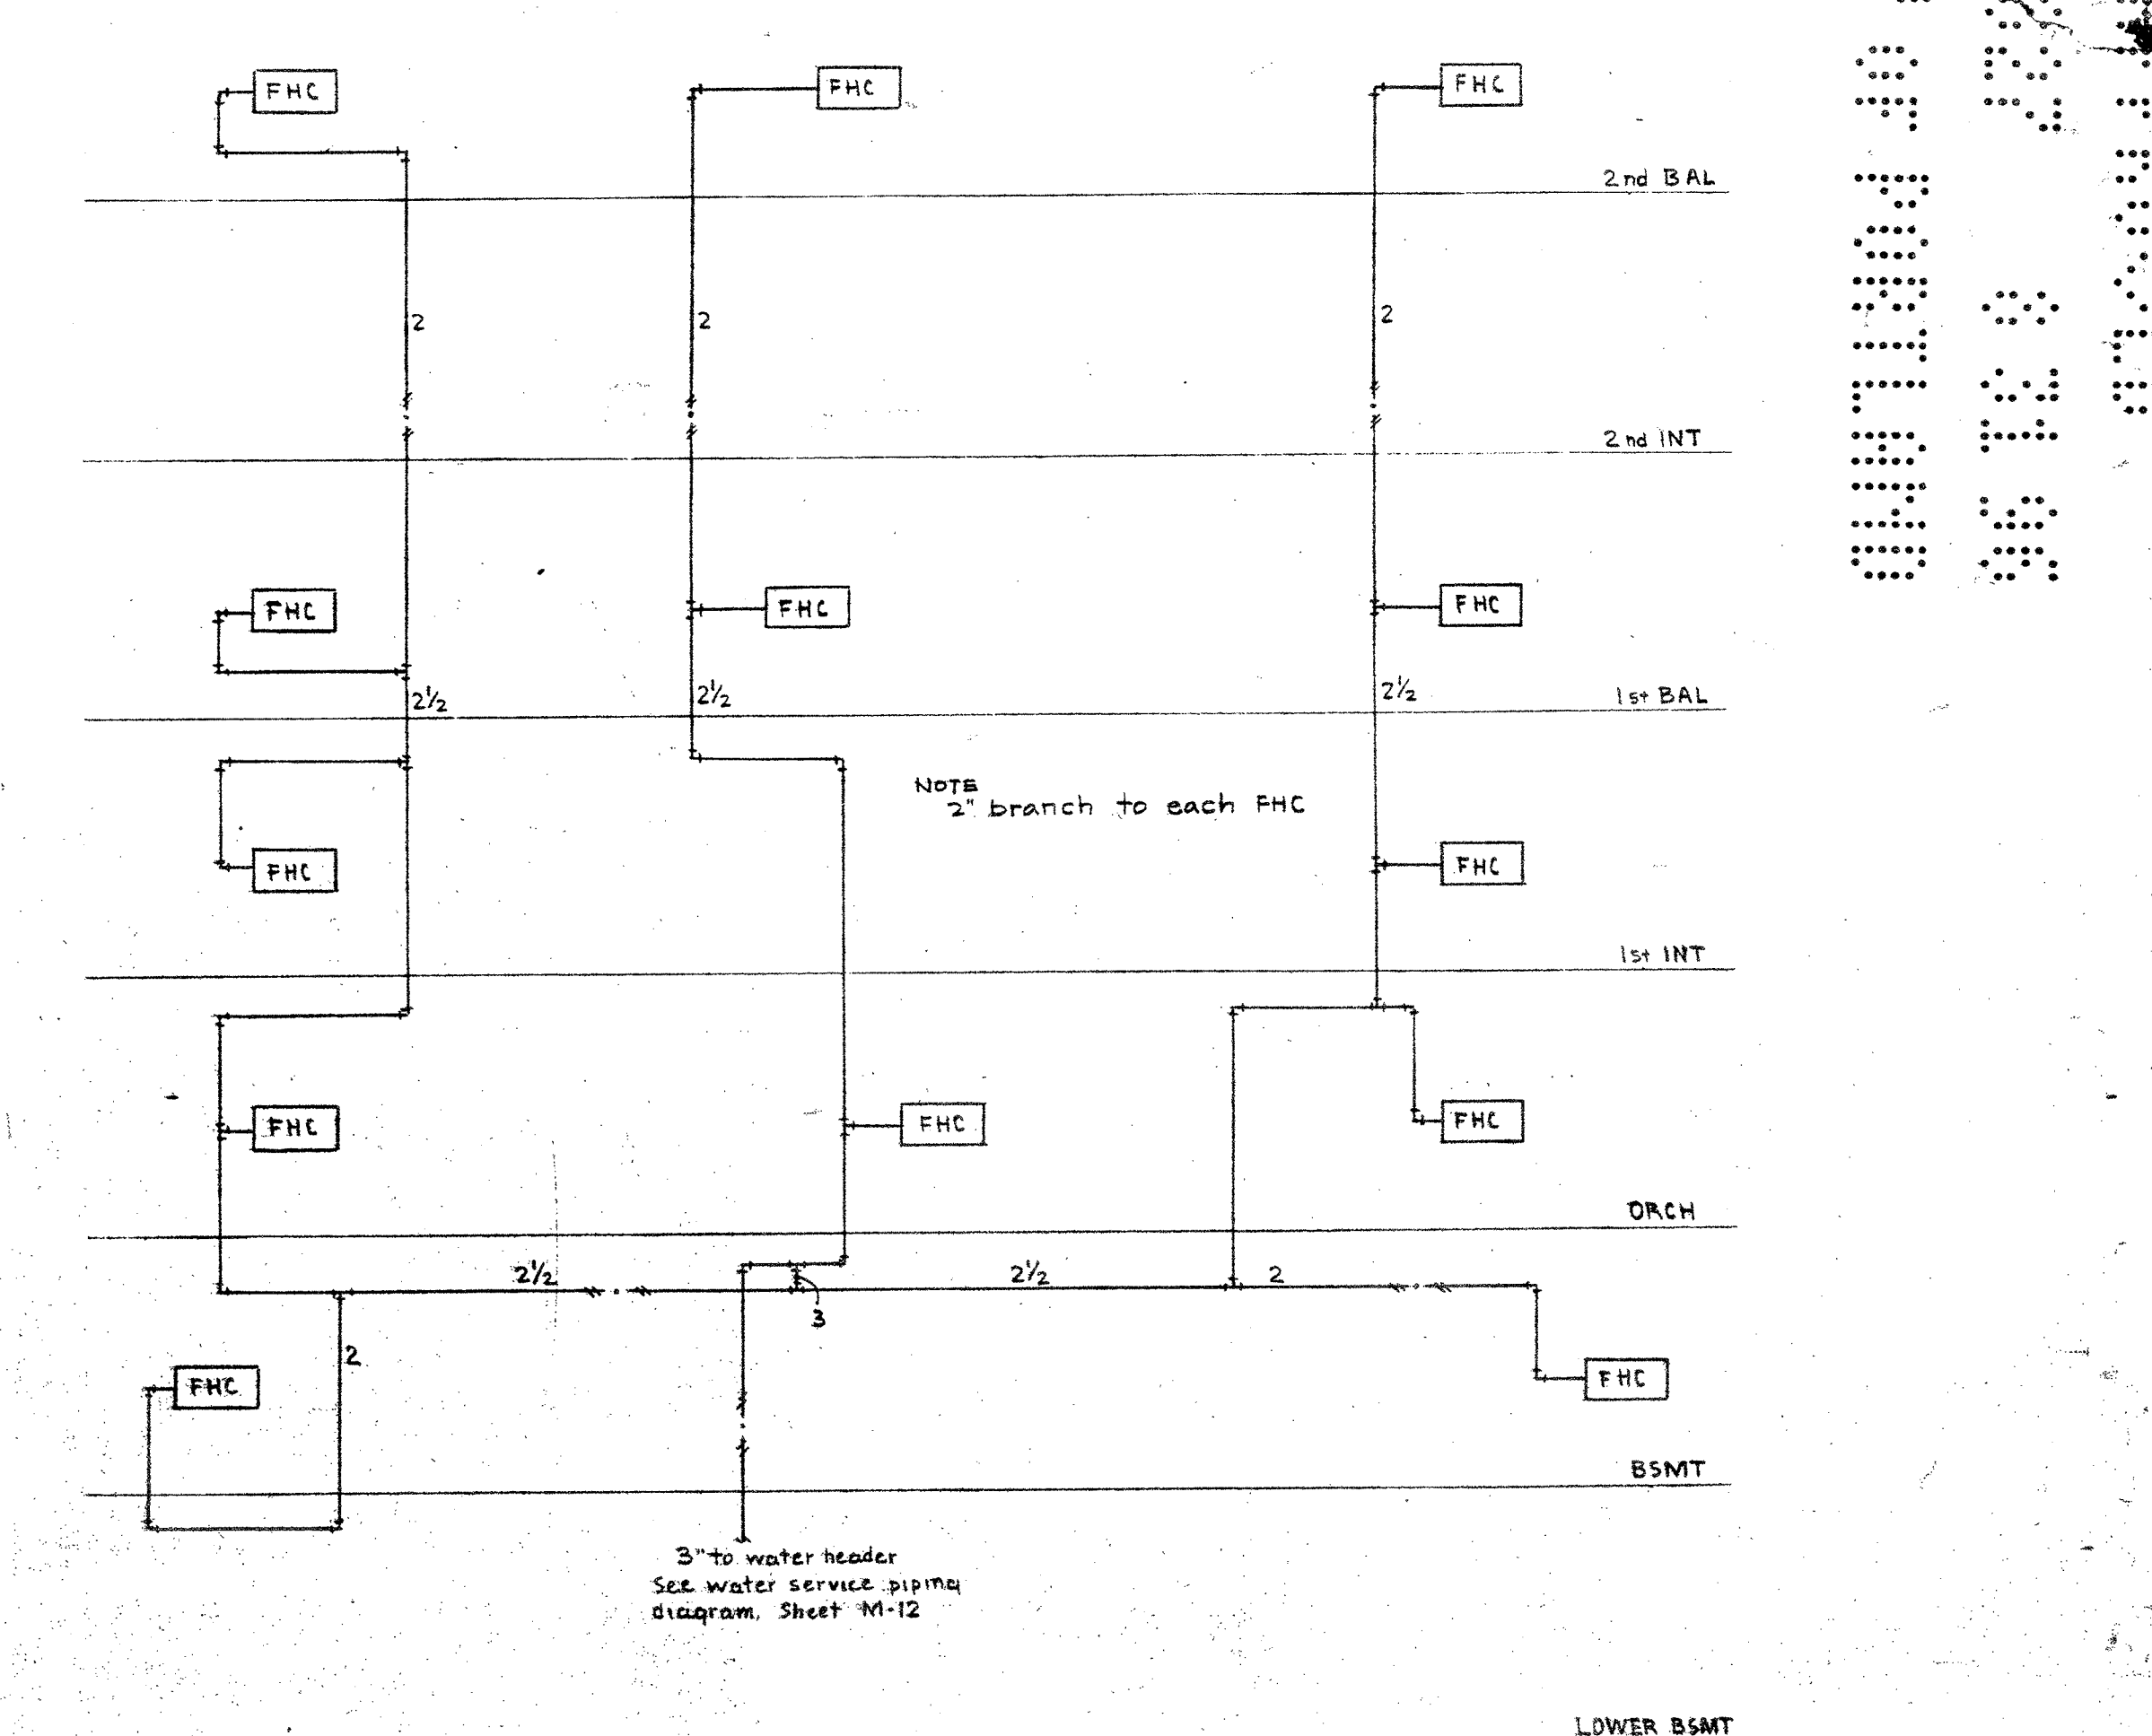

WET STANDPIPE DIAGRAM  
No scale



SECTION B-B  
1/8" = 1'-0"

**MECHANICAL ORCHESTRA LEVEL FLOOR PLAN AND DETAILS**

**REBUILDING OF PORTLAND CIVIC AUDITORIUM**  
S. W. THIRD AVENUE & CLAY STREET  
FOR THE CITY OF PORTLAND OREGON

**ARCHITECTS:** STANTON, BOLES, MADUIRE & CHURCH  
208 S. W. STARK ST., PORTLAND 4, OREGON  
COMM. NO. 6323  
DATE: MAY 24 1966

**MECHANICAL ENGINEERS:** GRANT KELLEY & ASSOCIATES  
1114 COLWELL AID.  
PORTLAND CONSULTANT


**STRUCTURAL ENGINEERS:** COPPER & ROSE & ASSOCIATES  
1 DONALD KROEGER & ASSOCIATES

**ACoustICAL CONSULTANTS:** PAUL VENEKASEN & ASSOCIATES


**THEATER CONSULTANT:** B. MARCUS PRITECA

**DRAWING M-4**


DATE: MAY 24 1966

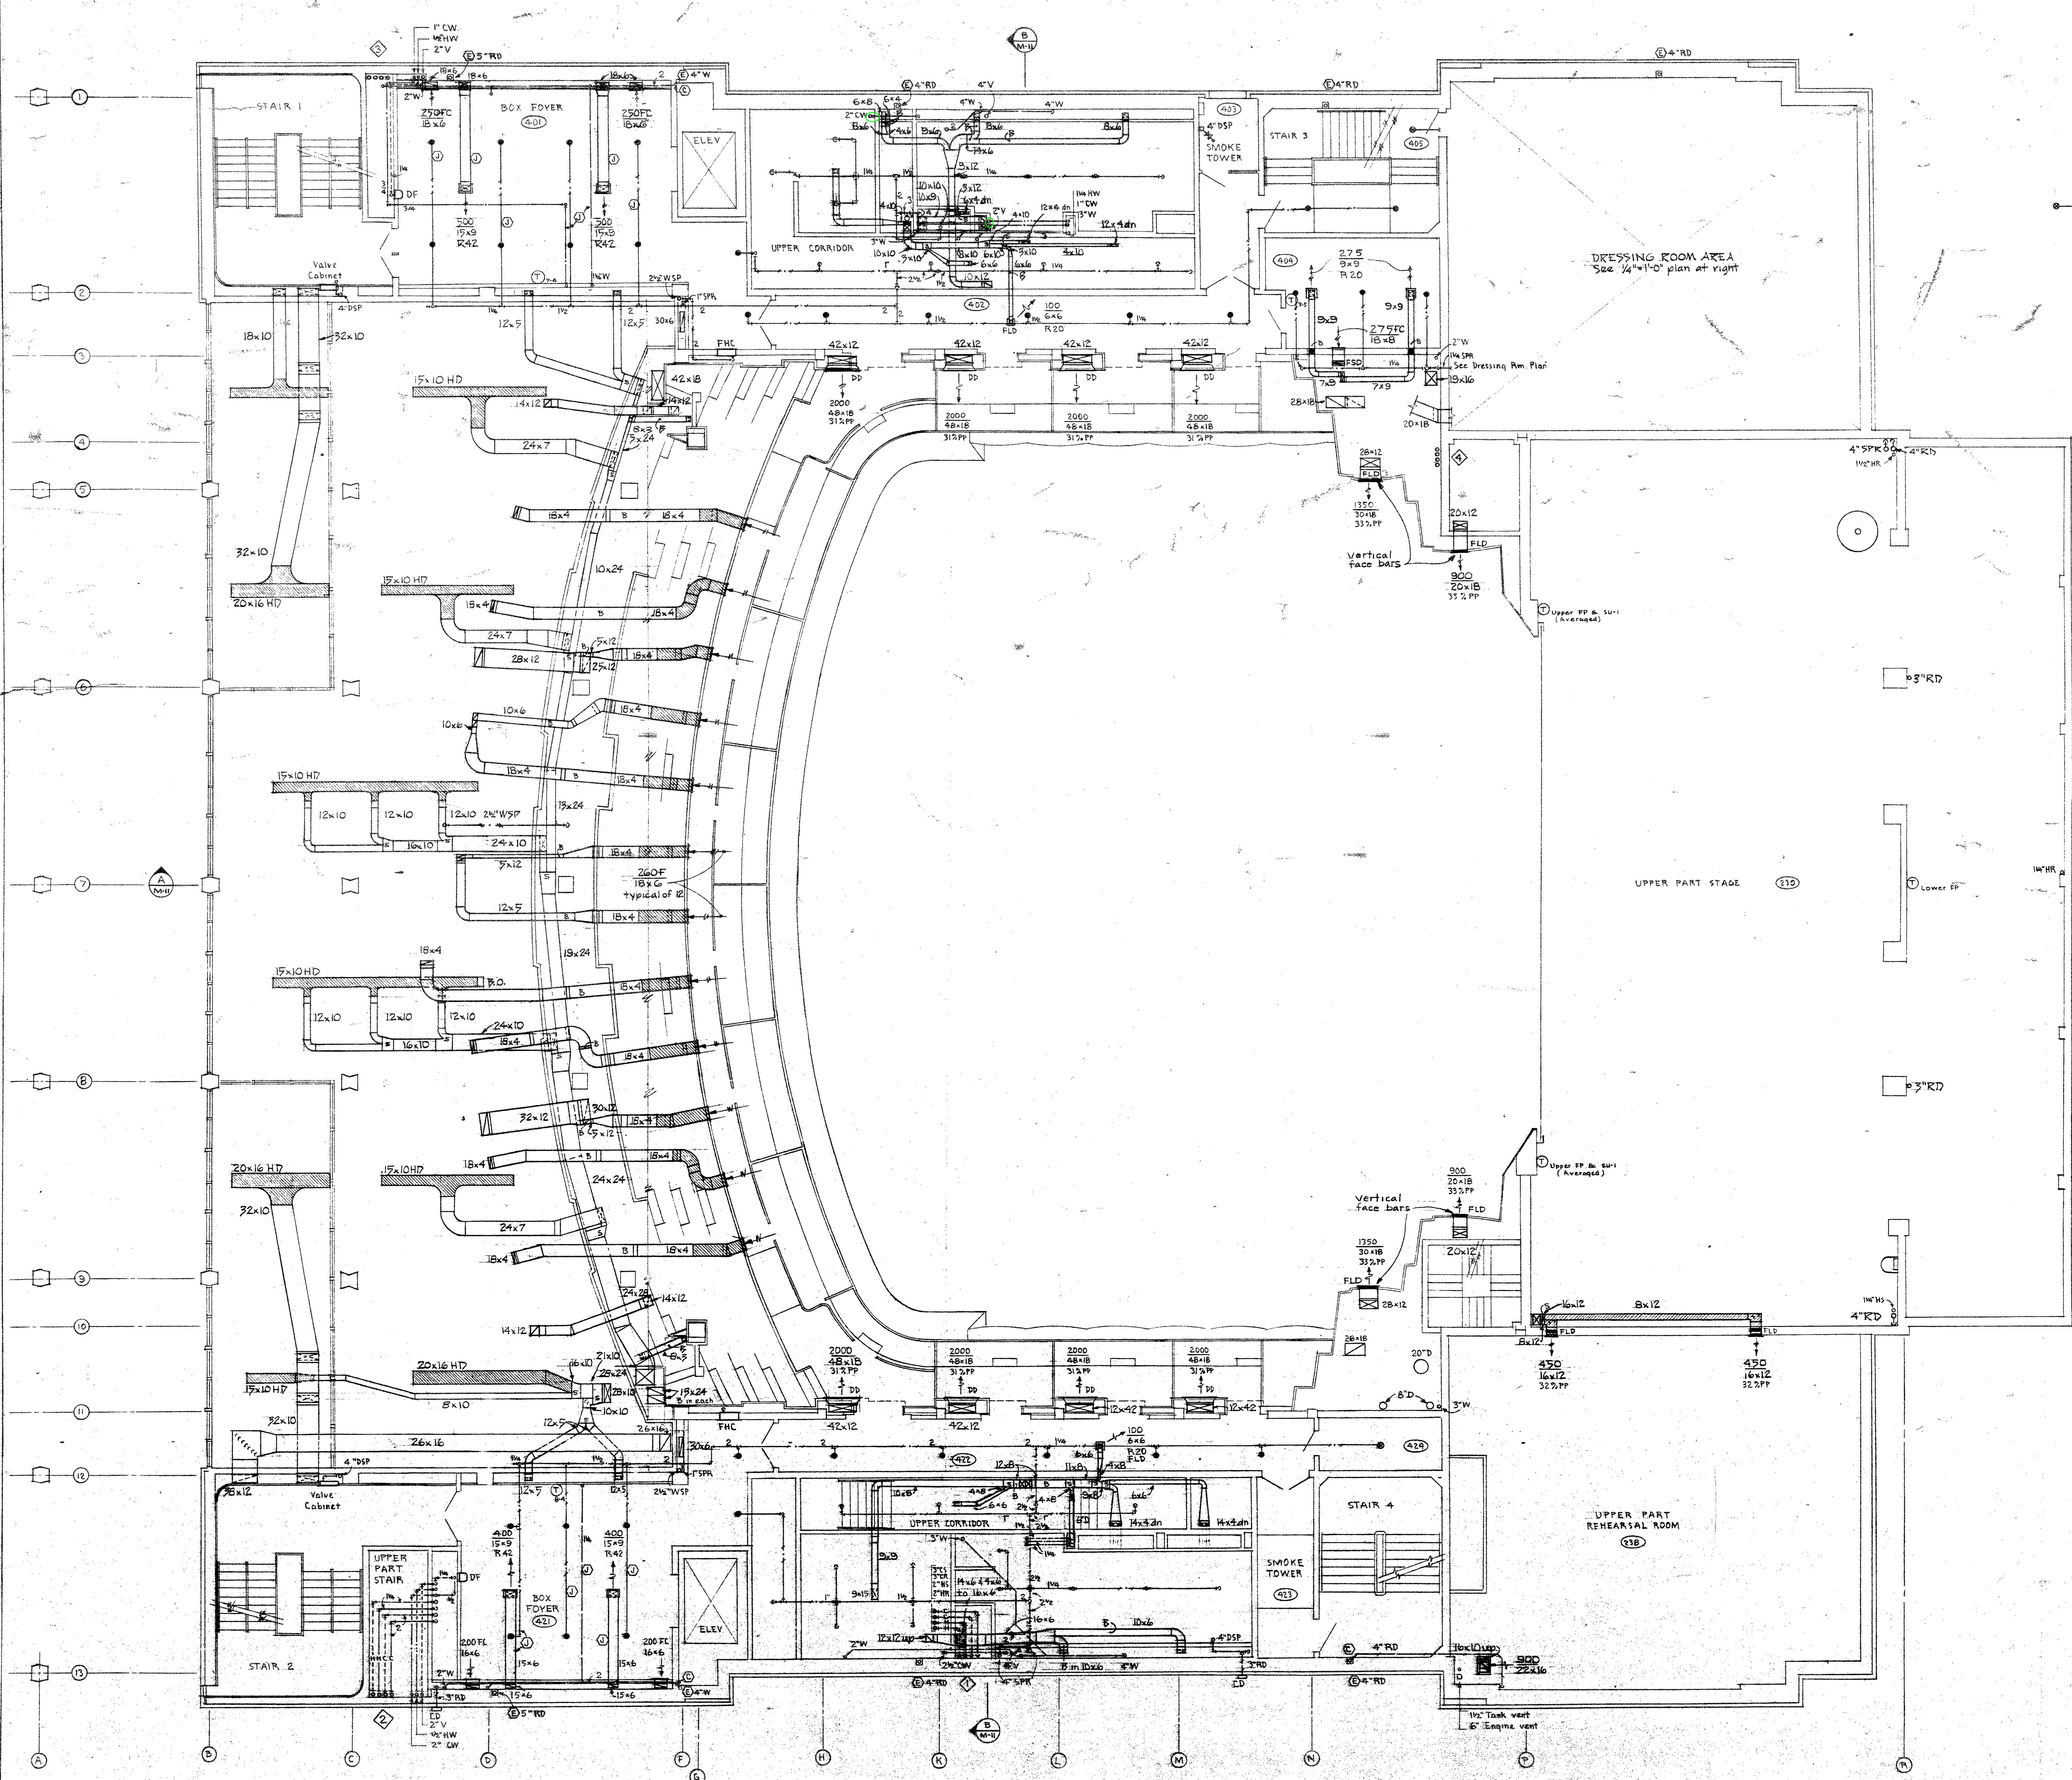



FLOOR PLAN - INTERMEDIATE LEVEL NO. 1  
1/8" = 1'-0"

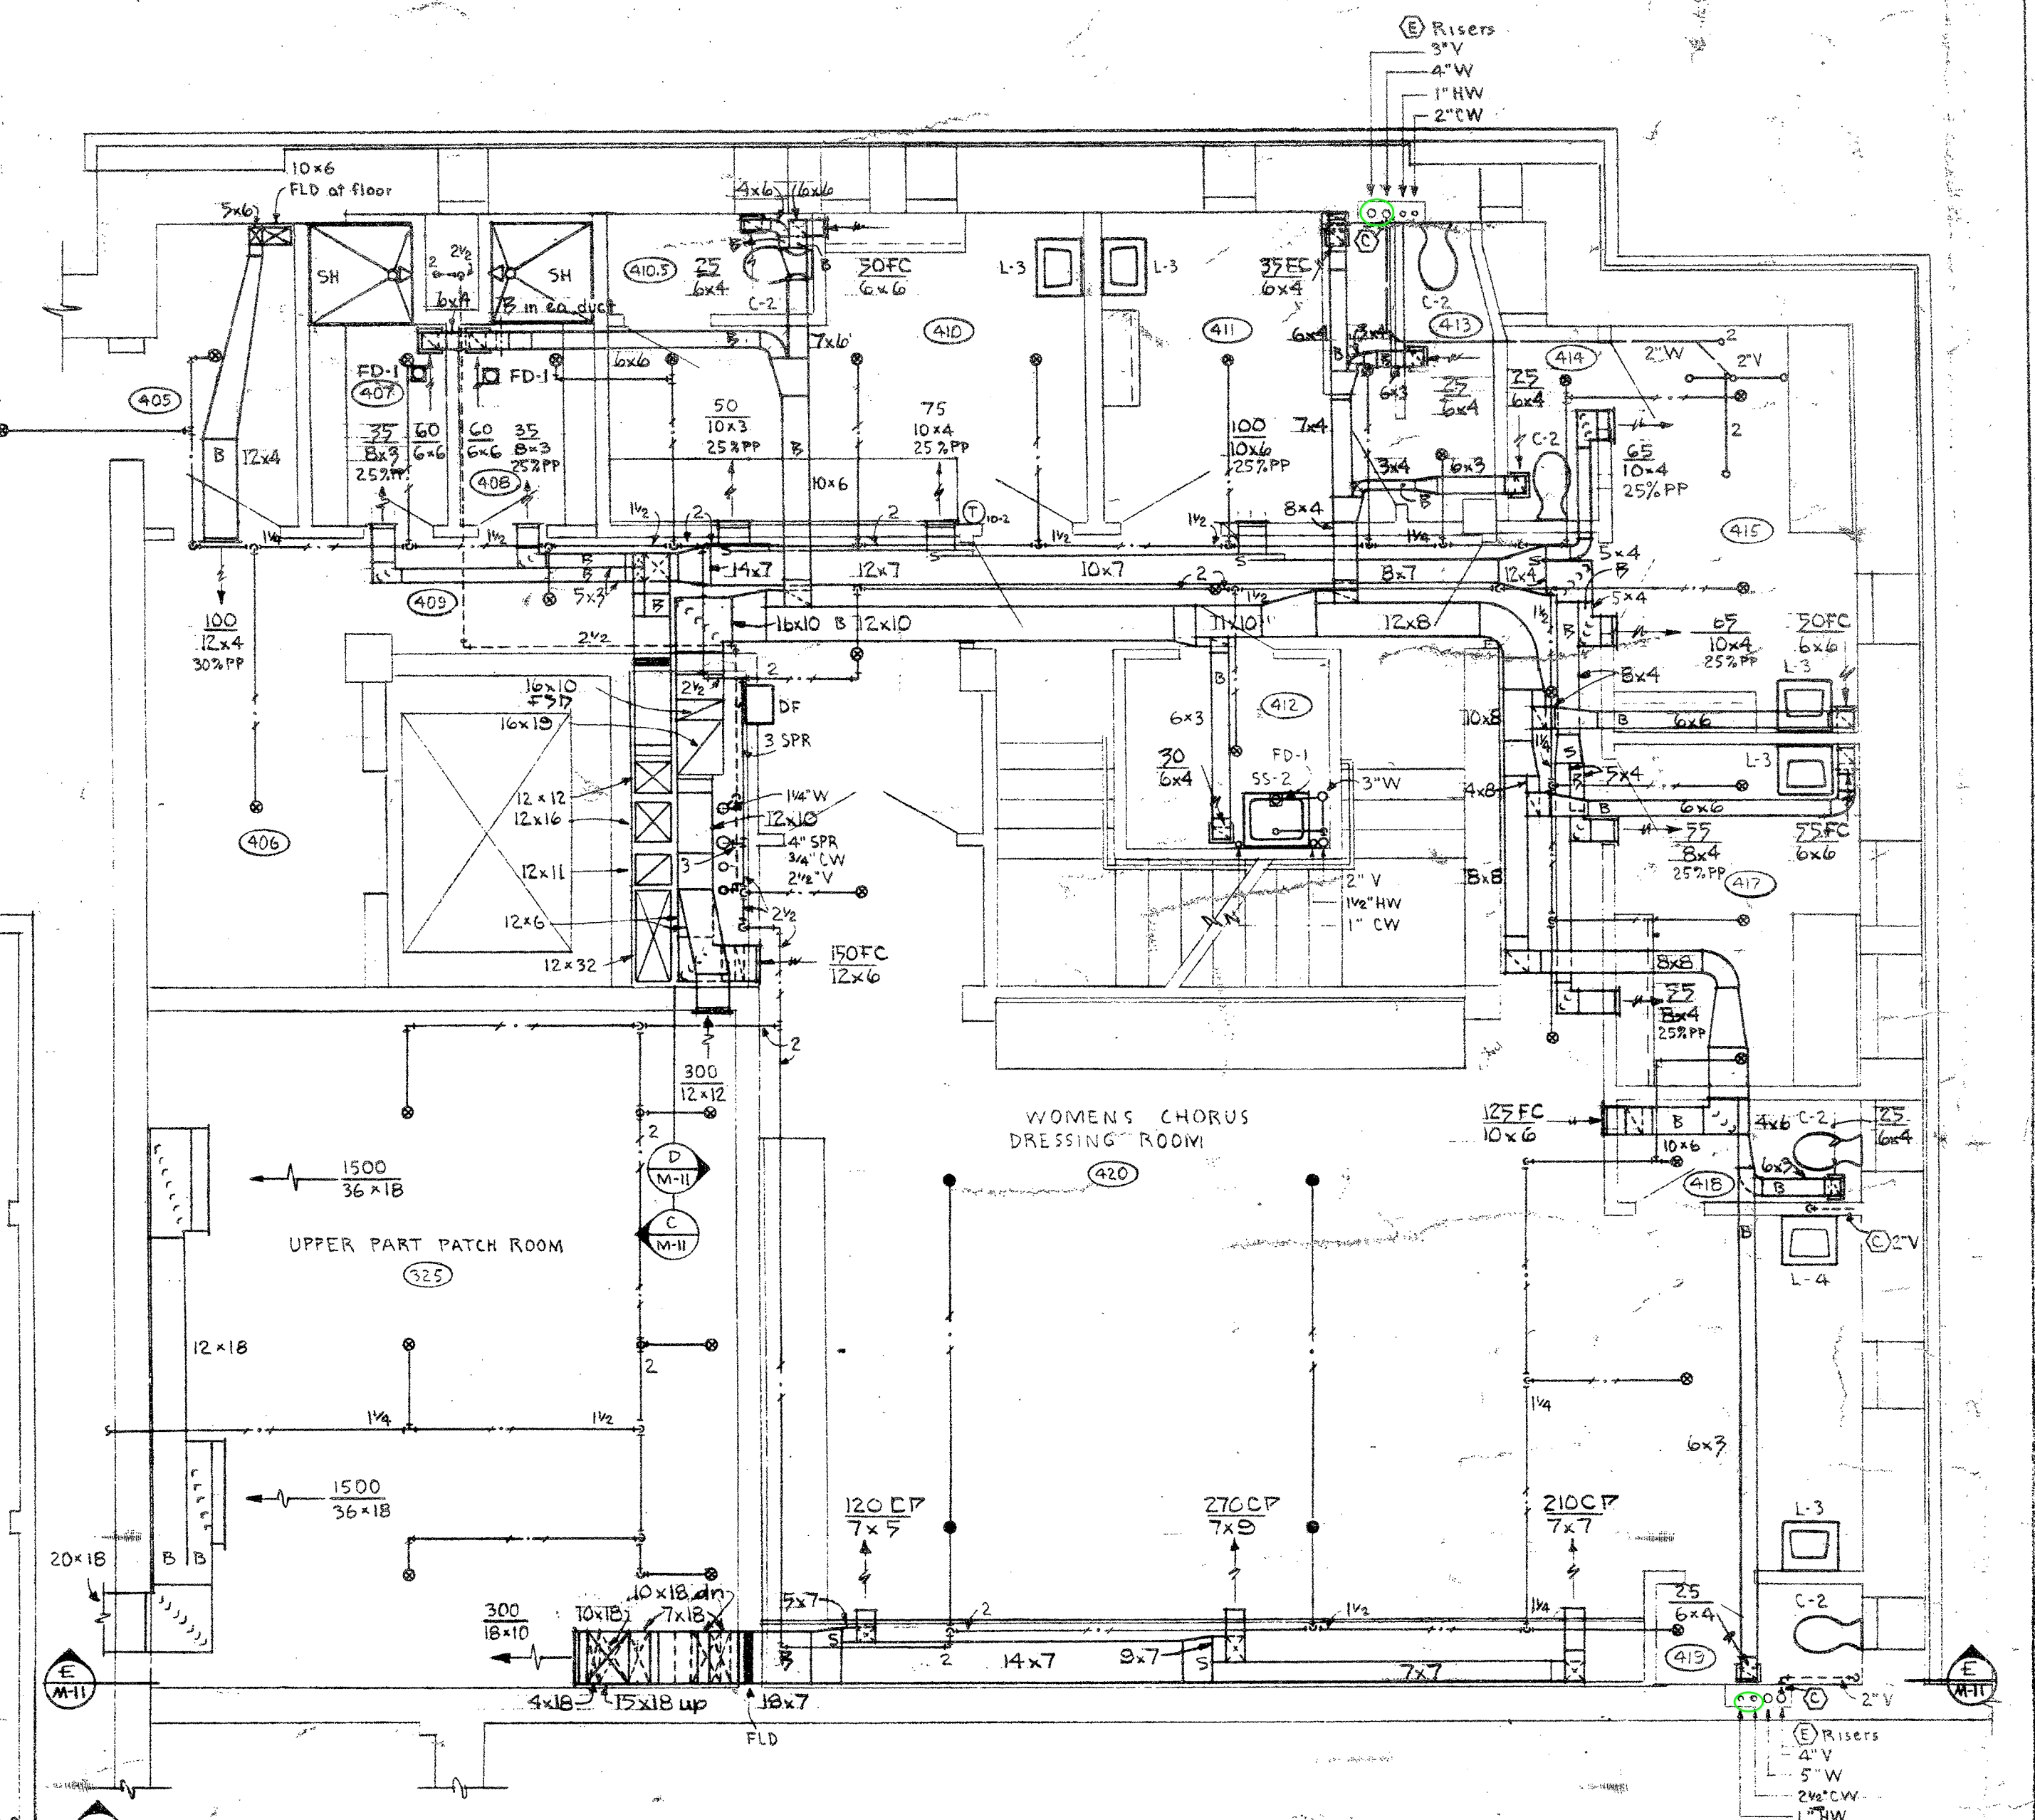

FLOOR PLAN - DRESSING ROOM AREA  
INTERMEDIATE LEVEL NO. 1  
1/4" = 1'-0"

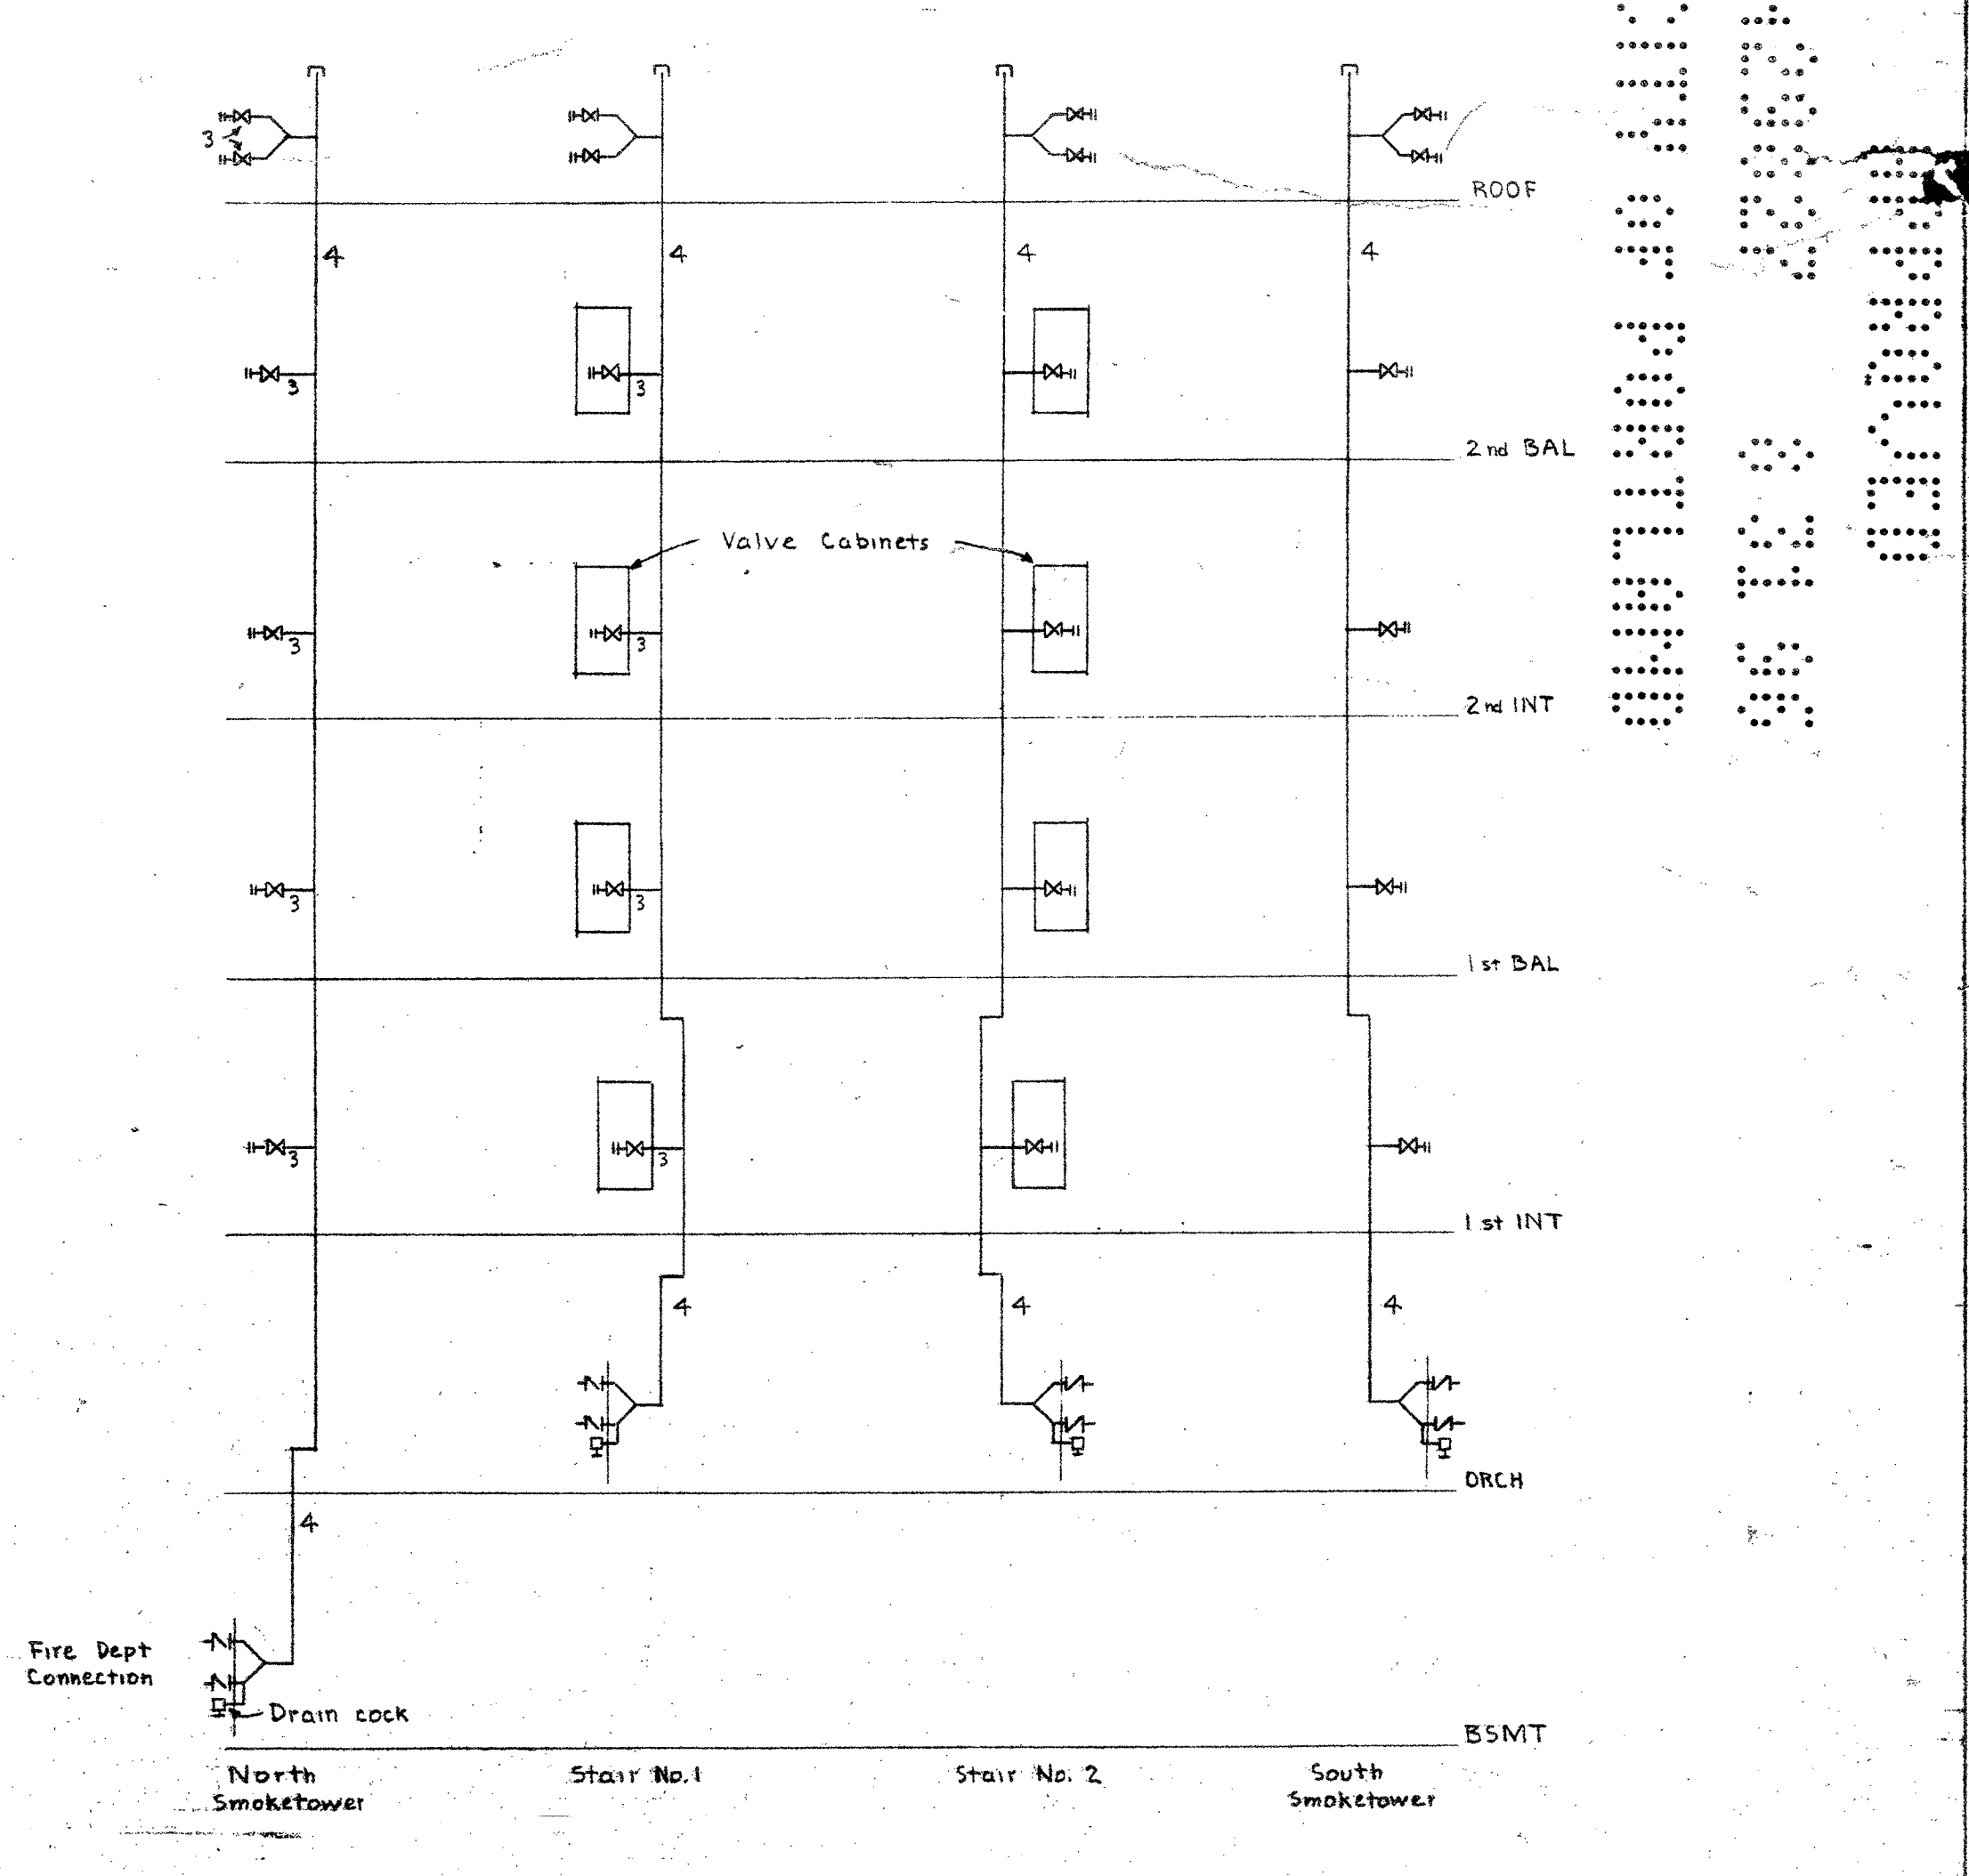

DRY STANDPIPE DIAGRAM  
No scale

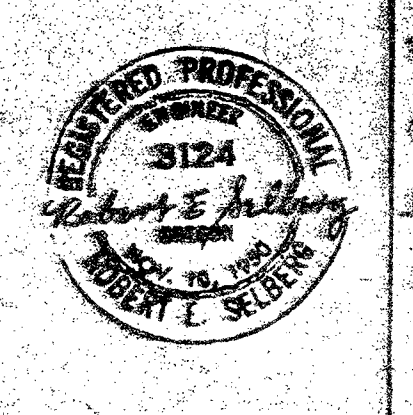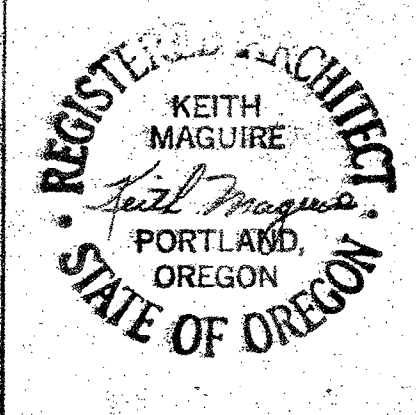







**MECHANICAL INTERMEDIATE LEVEL NO. 1 PLAN AND DETAILS**

**1 MARCUS PRITECA**  
ARCHITECT  
REGISTERED ARCHITECT  
3124  
3124  
3124

**REBUILDING OF PORTLAND CIVIC AUDITORIUM**  
3 W. THIRD AVENUE & CLAY STREET  
FOR  
CITY OF PORTLAND, OREGON

**STANTON, BOLES, MAGUIRE & CHURCH ARCHITECTS**  
208 S. W. STARK ST., PORTLAND 4, OREGON  
COMM. NO. 6323  
DATE: MAY 24 1966

**DRAWING M-5**  
CHECKED

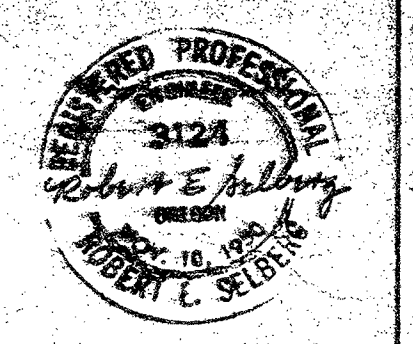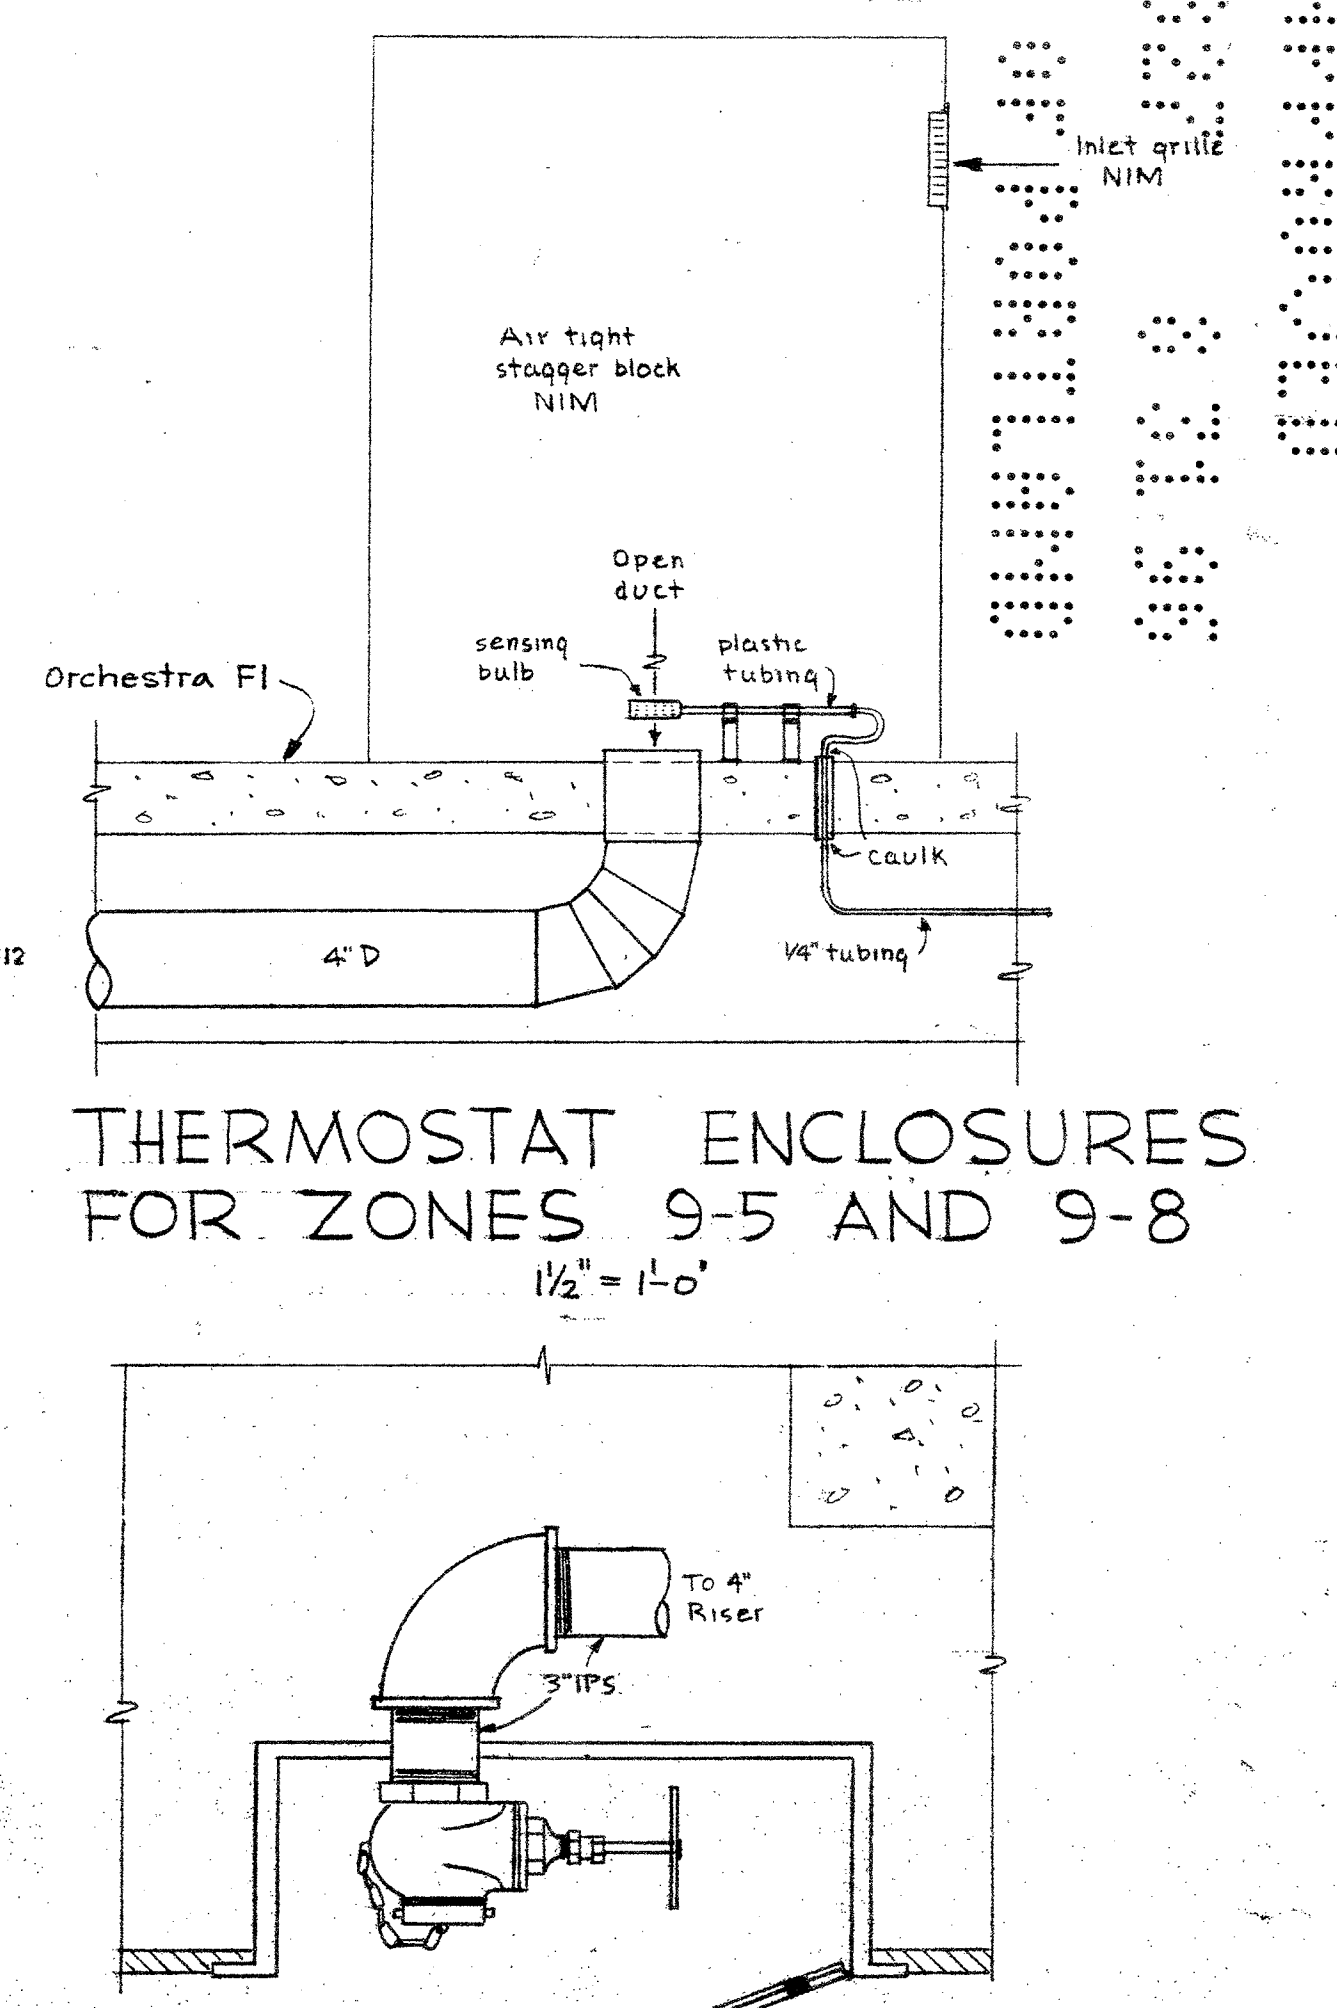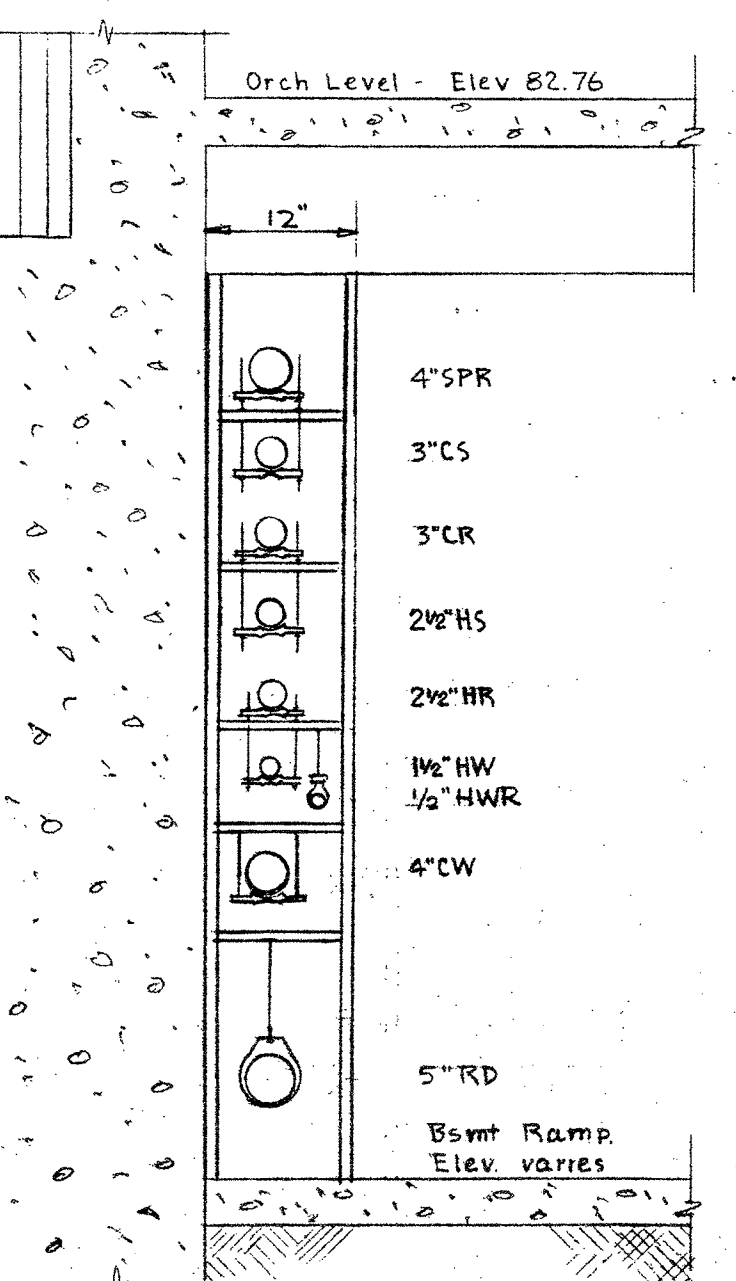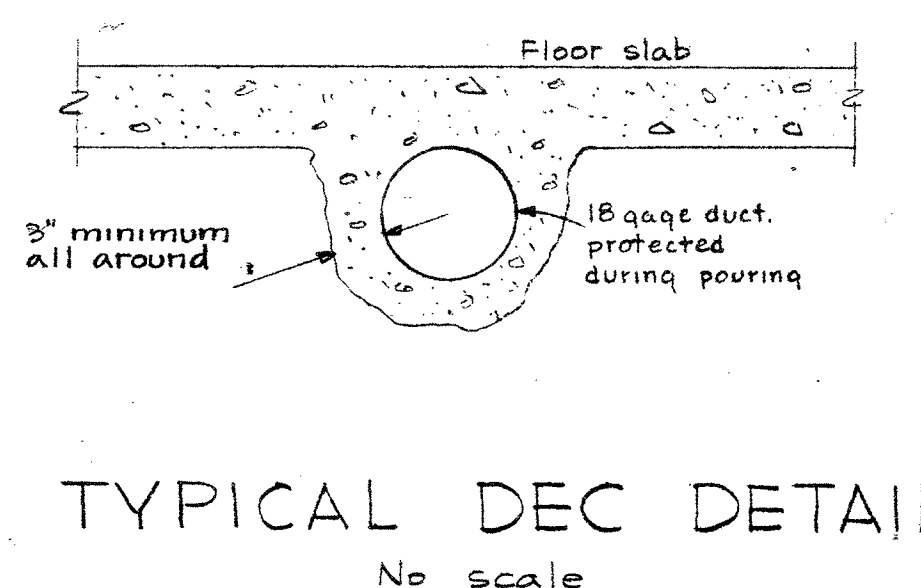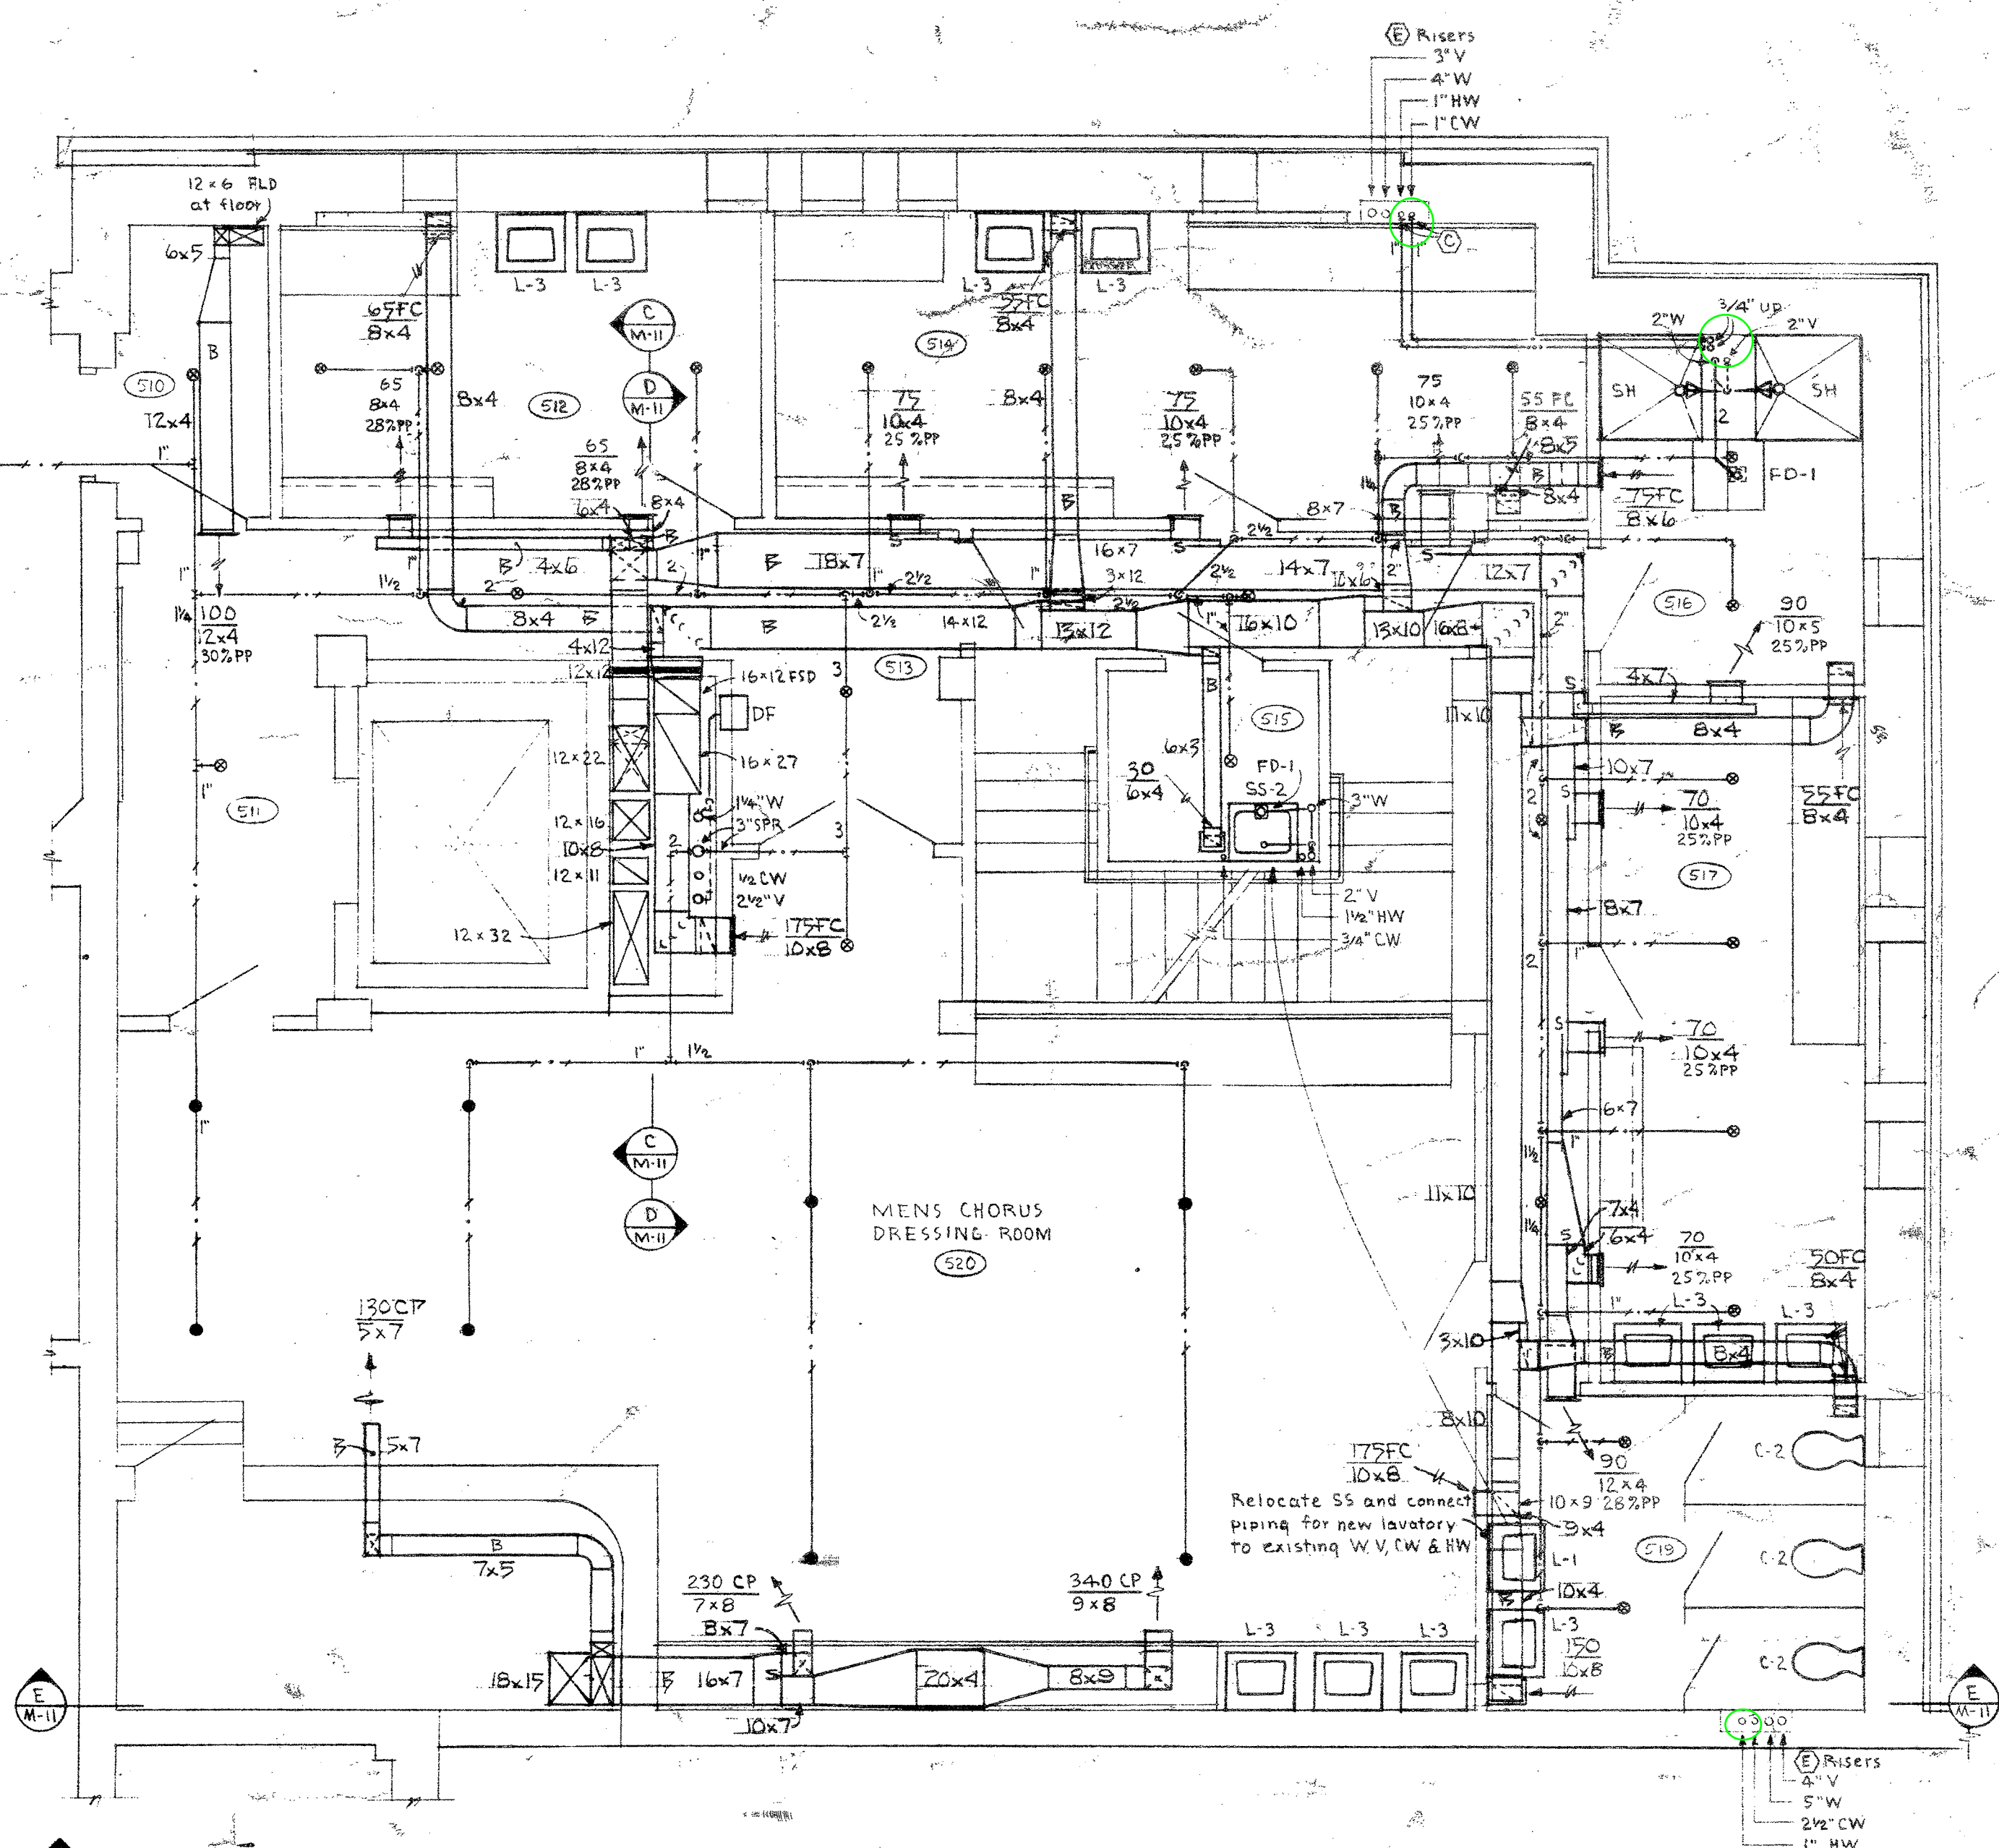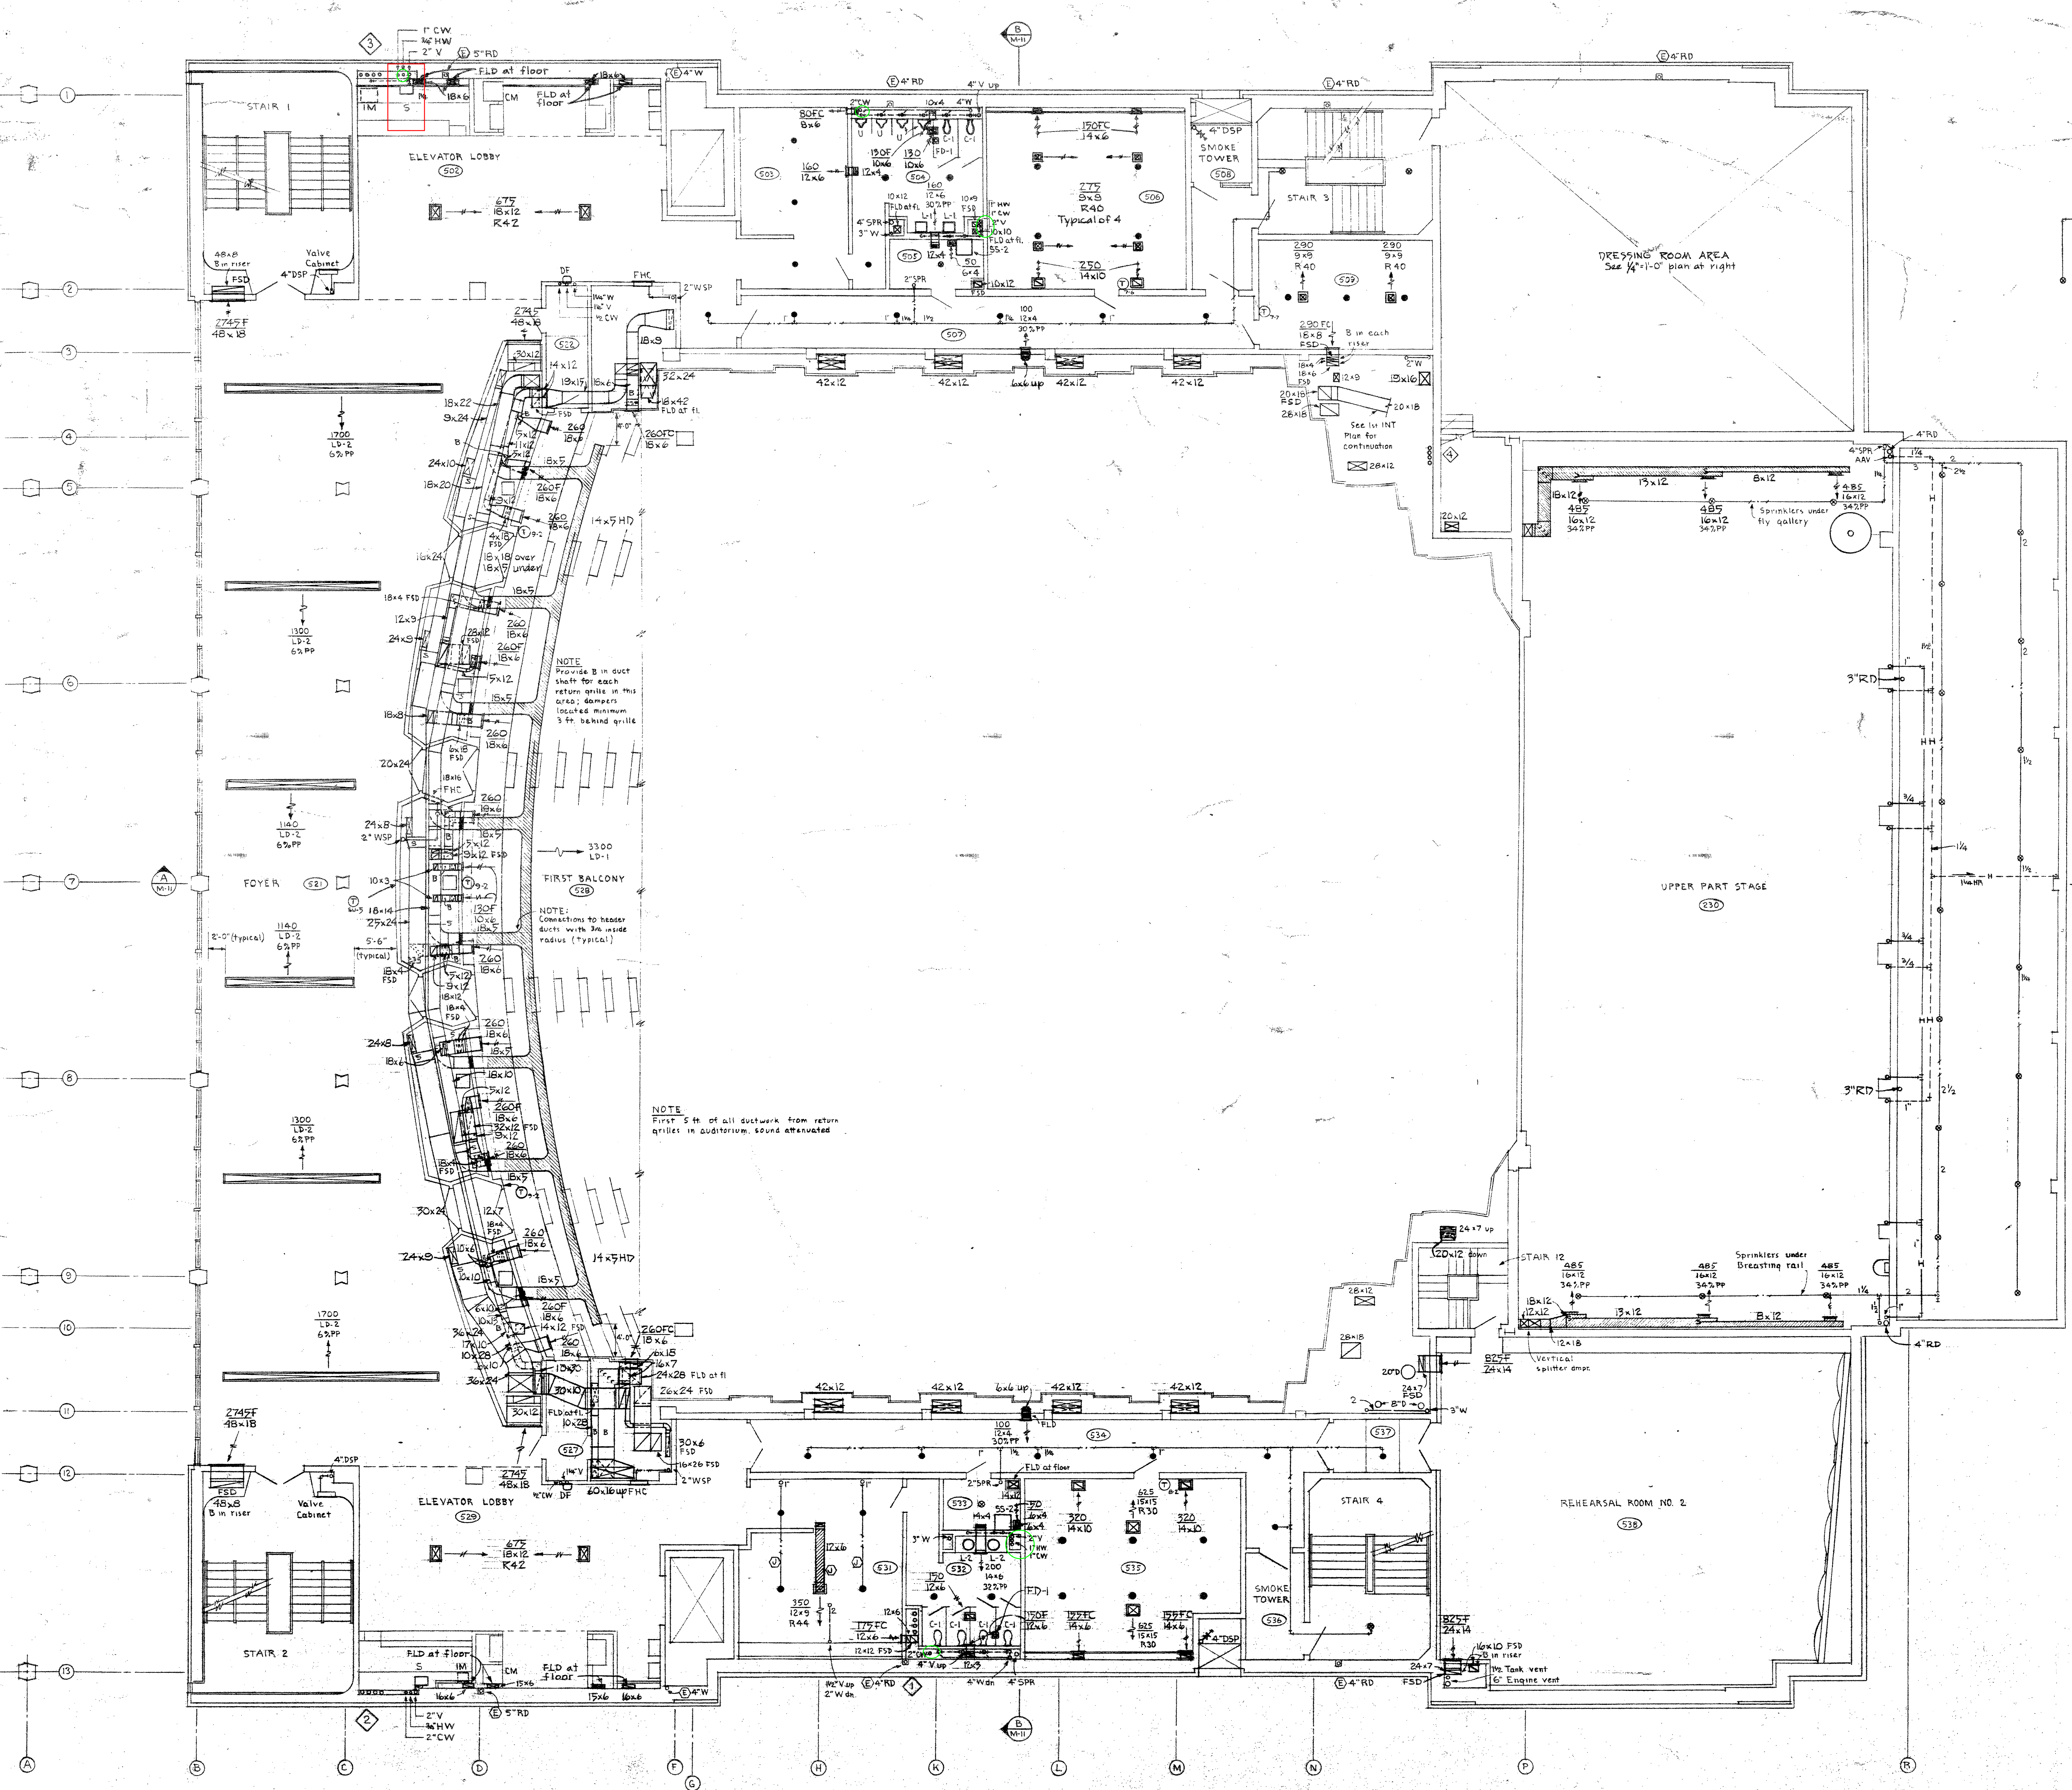


**MECHANICAL FIRST BALCONY FLOOR PLAN AND DETAILS**

B. MARCUS PRITECA ARCHITECT  
THEATER CONSULTANT  
PAUL VENEKIDEN & ASSOCIATES ARCHITECTURAL CONSULTANTS  
CODPER & ROSE & ASSOCIATES STRUCTURAL ENGINEERS  
J. DONALD KROEGER & ASSOCIATES MECHANICAL ENGINEERS  
GRANT KELLEY & ASSOCIATES ELECTRICAL ENGINEERS  
LILA COLWELL A.I.D. INTERIOR CONSULTANT


**REBUILDING OF PORTLAND CIVIC AUDITORIUM**  
S. W. THIRD AVENUE & CLAY STREET  
FOR CITY OF PORTLAND, OREGON

STANTON, BOLES, MAGUIRE & CHURCH ARCHITECTS  
208 S. W. STARK ST., PORTLAND 4, OREGON  
COMM. NO. 6323  
DATE: MAY 24, 1966


DRAWING M-6  
DRAWN  
CHECKED

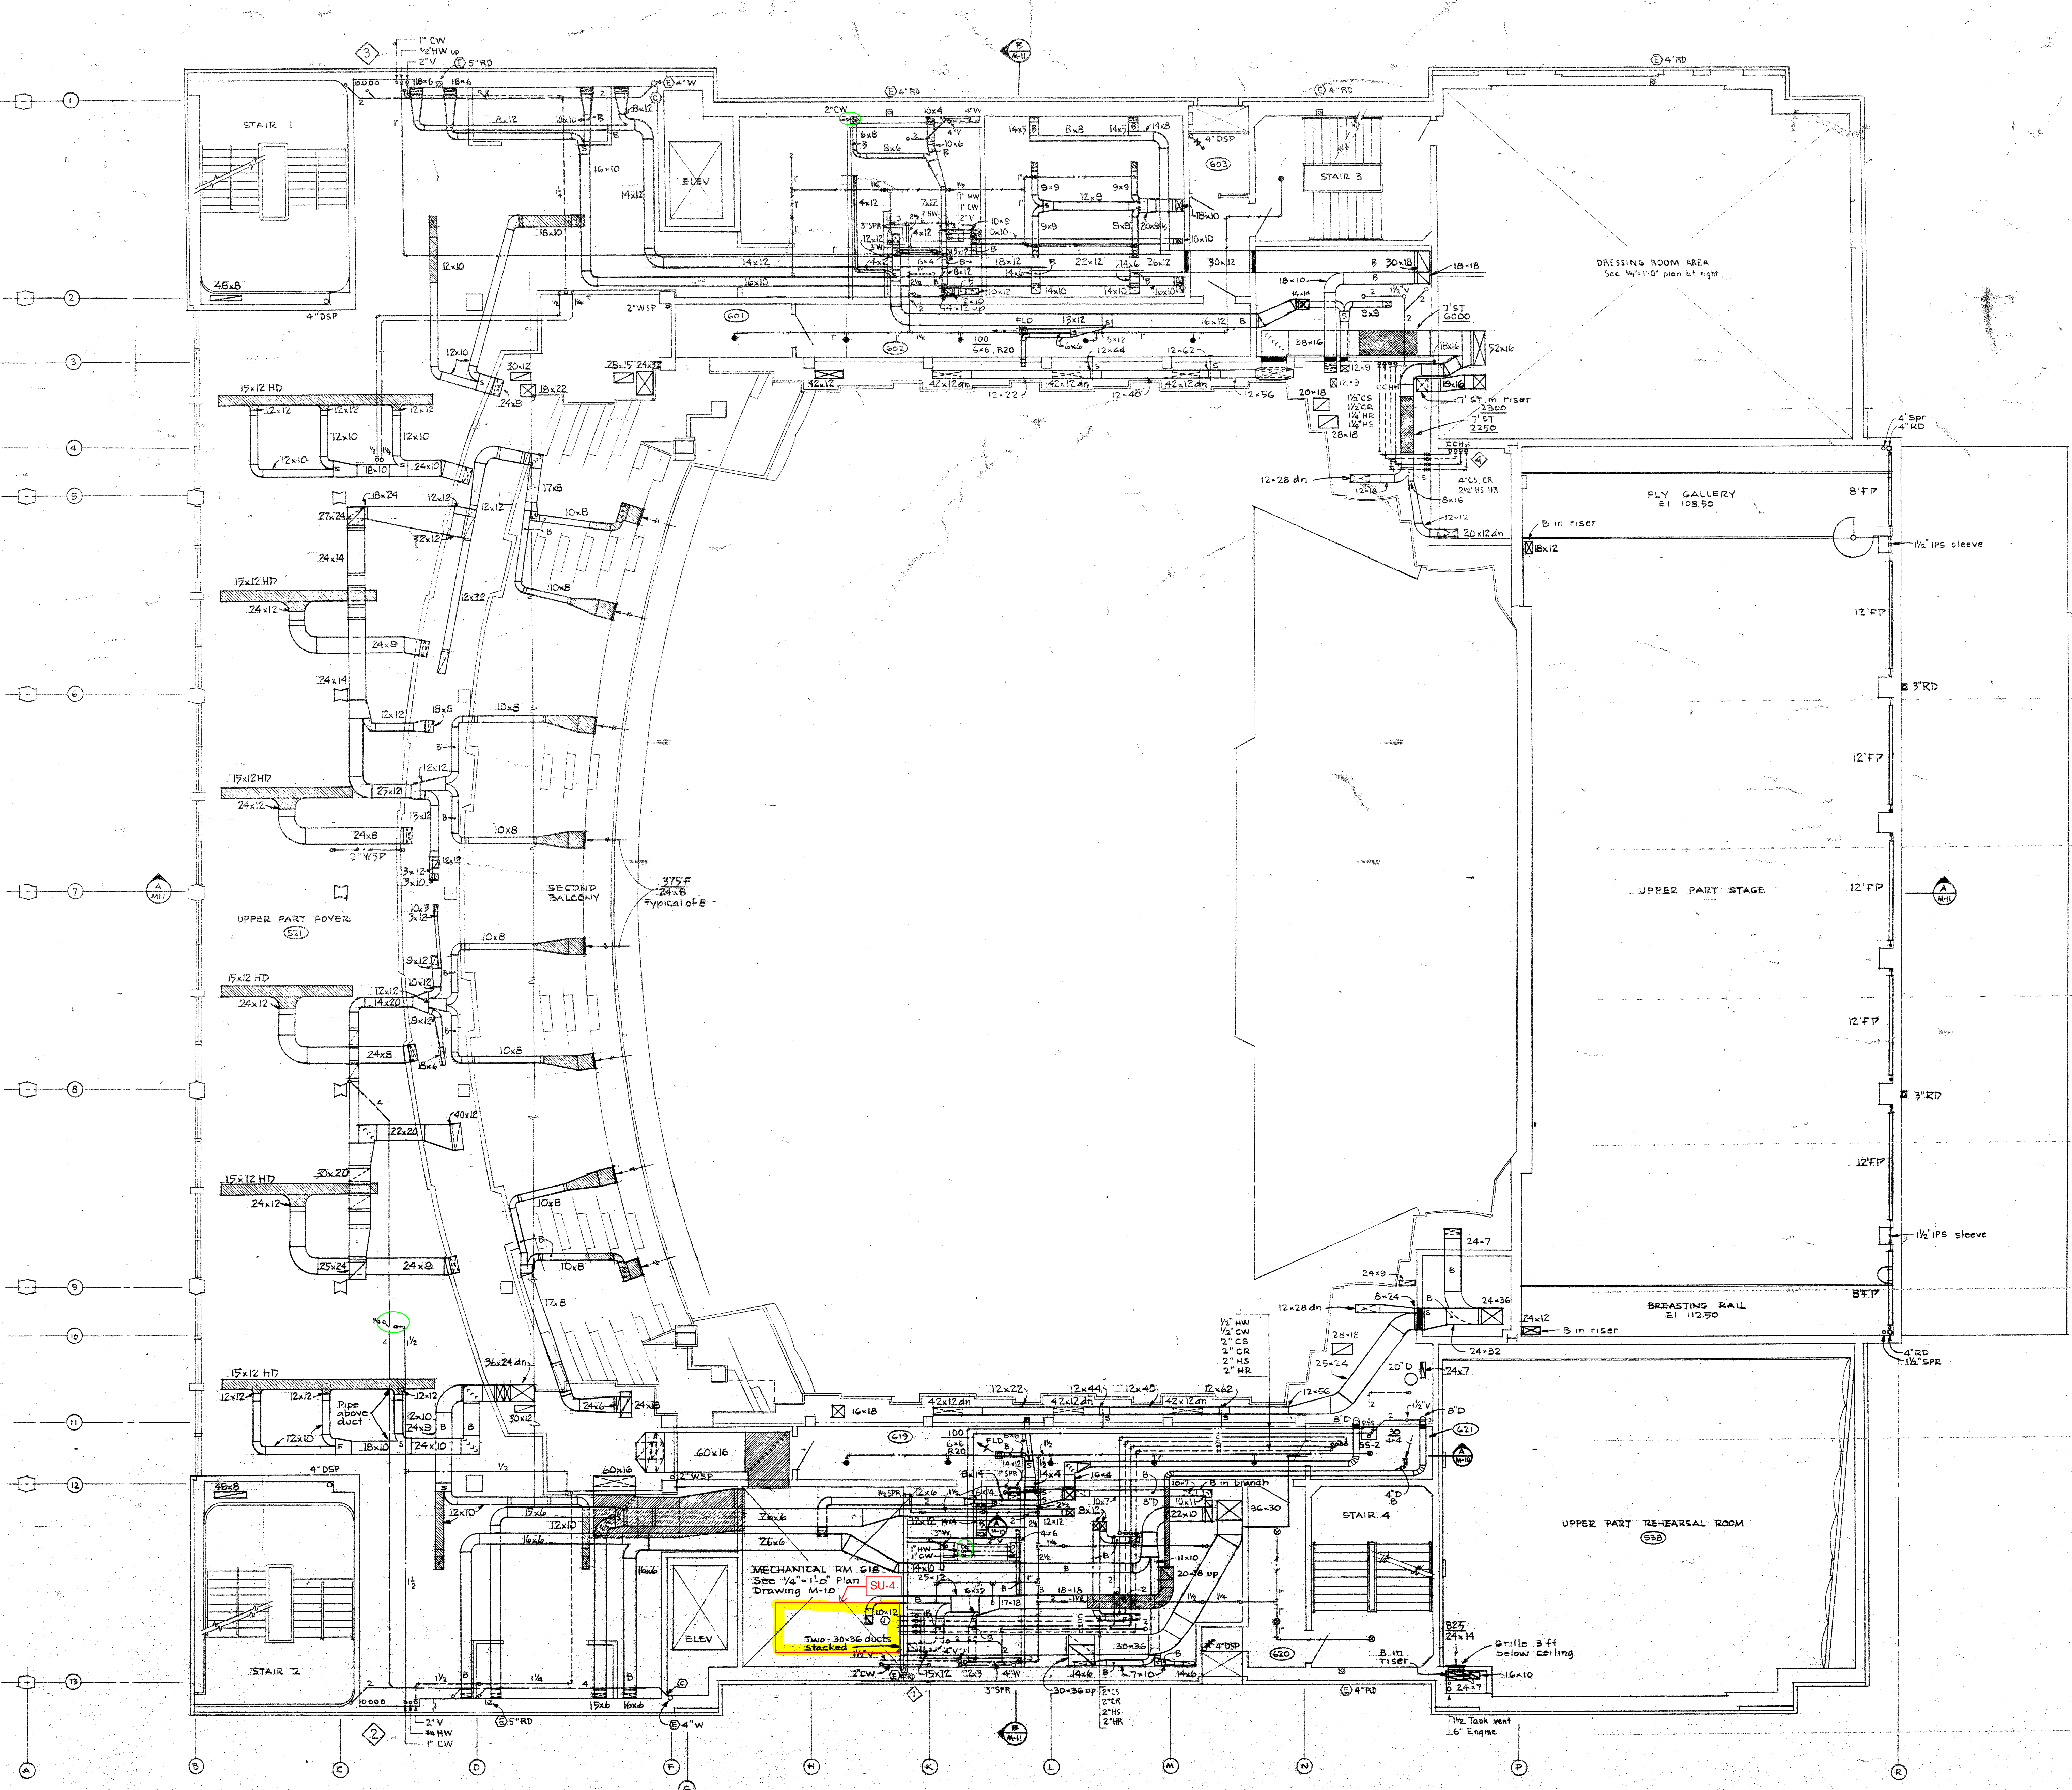


FLOOR PLAN - INTERMEDIATE LEVEL NO. 2  
 1/8" = 1'-0"

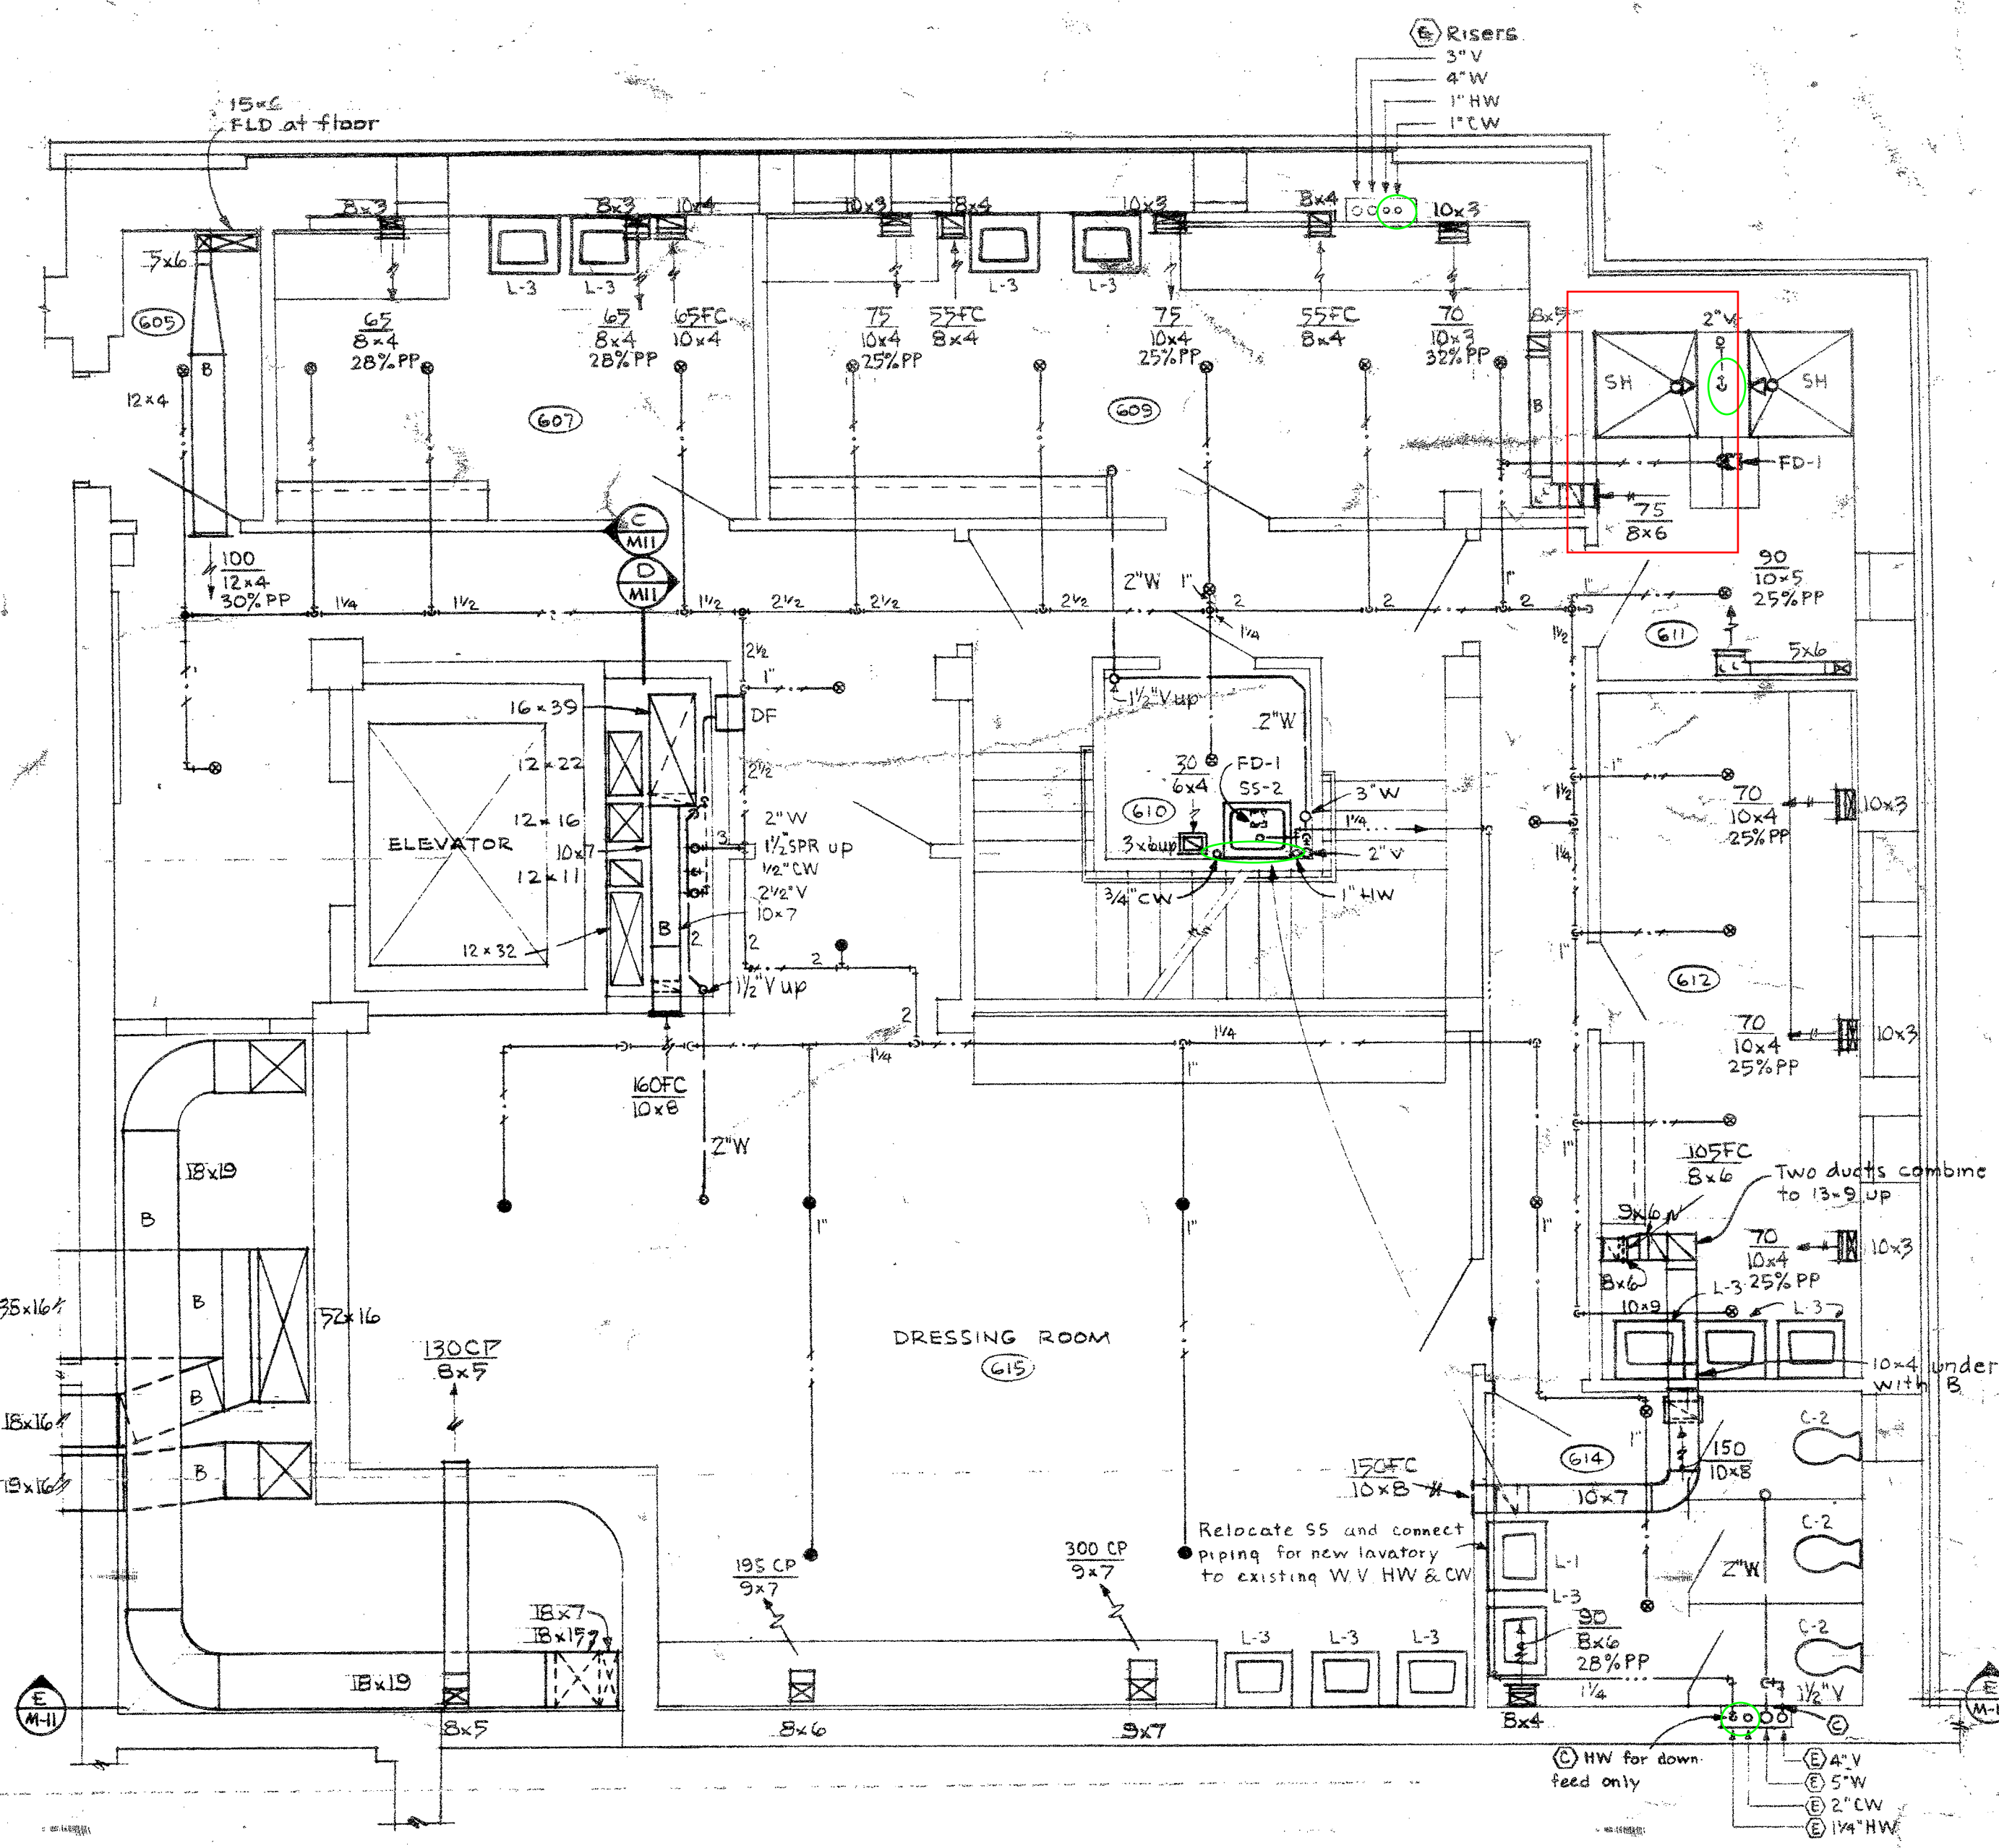

FLOOR PLAN - DRESSING ROOM AREA  
 INTERMEDIATE LEVEL NO. 2  
 1/4" = 1'-0"

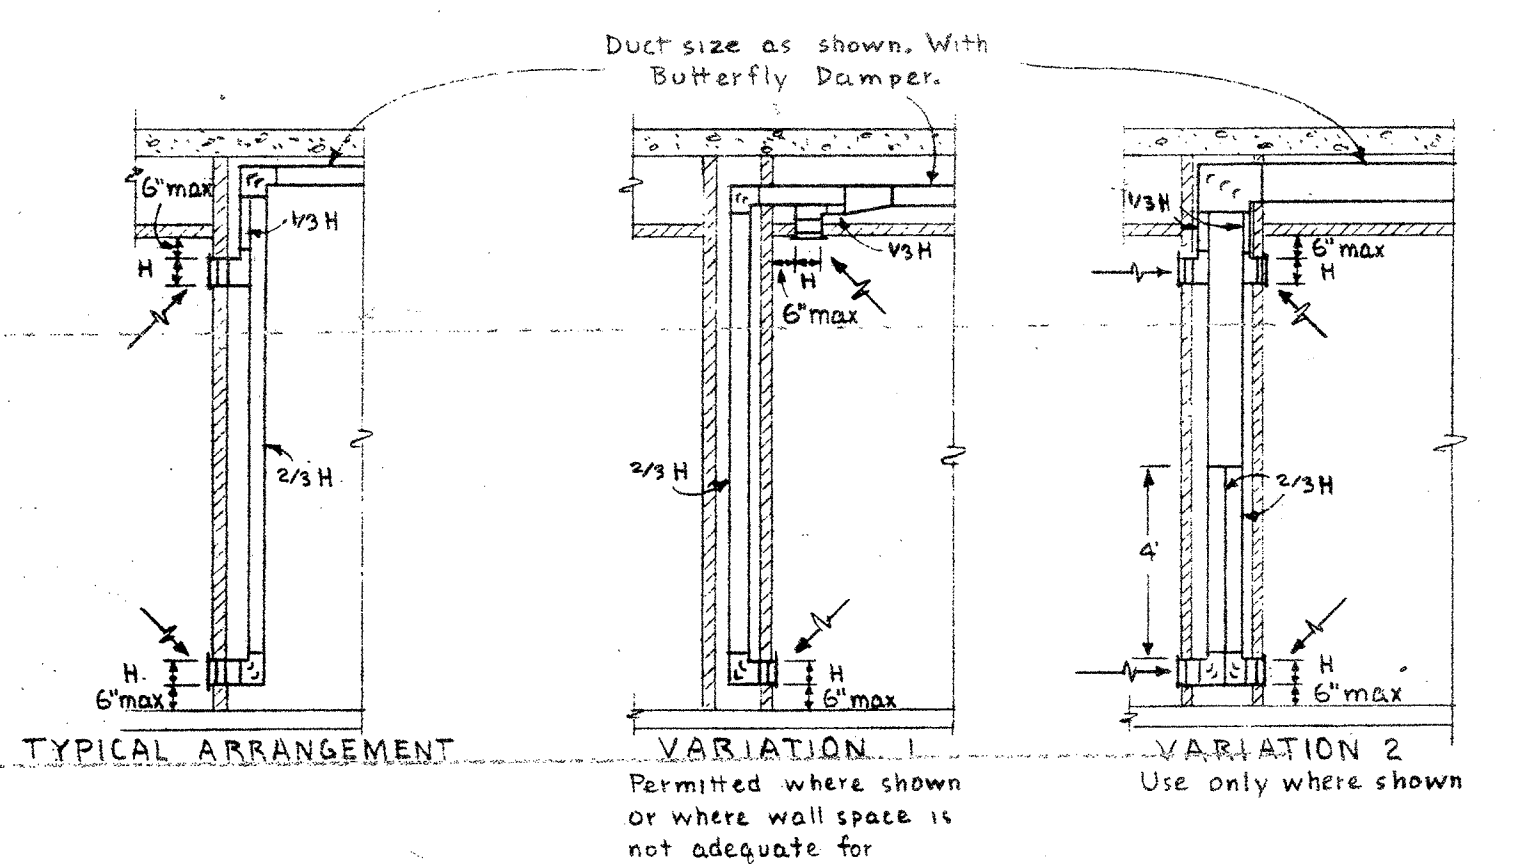


TYPICAL FC RETURN GRILLE DETAILS  
 No scale  
 Note: All FC grilles with integral key-operated backblade damper.


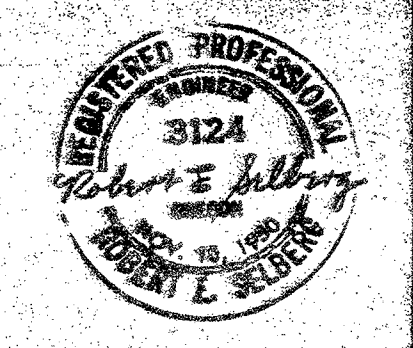


**MECHANICAL INTERMEDIATE LEVEL NO. 2 PLAN AND DETAILS**


<p><b>B. MARCUS PRITECA</b>          ARCHITECT          THEATER CONSULTANT</p> <p><b>PAUL VENEKLIAN &amp; ASSOCIATES</b>          ACoustICAL CONSULTANTS</p> <p><b>COOPER &amp; ROUSE &amp; ASSOCIATES</b>          STRUCTURAL ENGINEERS</p> <p><b>J. DONALD KROEGER &amp; ASSOCIATES</b>          MECHANICAL ENGINEERS</p> <p><b>GRANT KELLEY &amp; ASSOCIATES</b>          ELECTRICAL ENGINEERS</p> <p><b>LILA COLWELL A.I.D.</b>          INTERIOR CONSULTANT</p>	<p><b>REBUILDING OF PORTLAND CIVIC AUDITORIUM</b>          3 W. THIRD AVENUE &amp; CLAY STREET          FOR          CITY OF PORTLAND, OREGON</p> <p><b>STANTON, BOLES, MADURE &amp; CHURCH ARCHITECTS</b>          208 S. W. STARK ST., PORTLAND 4, OREGON          DRAWN BY: M-7          DATE: MAY 24 1966</p>
--	---

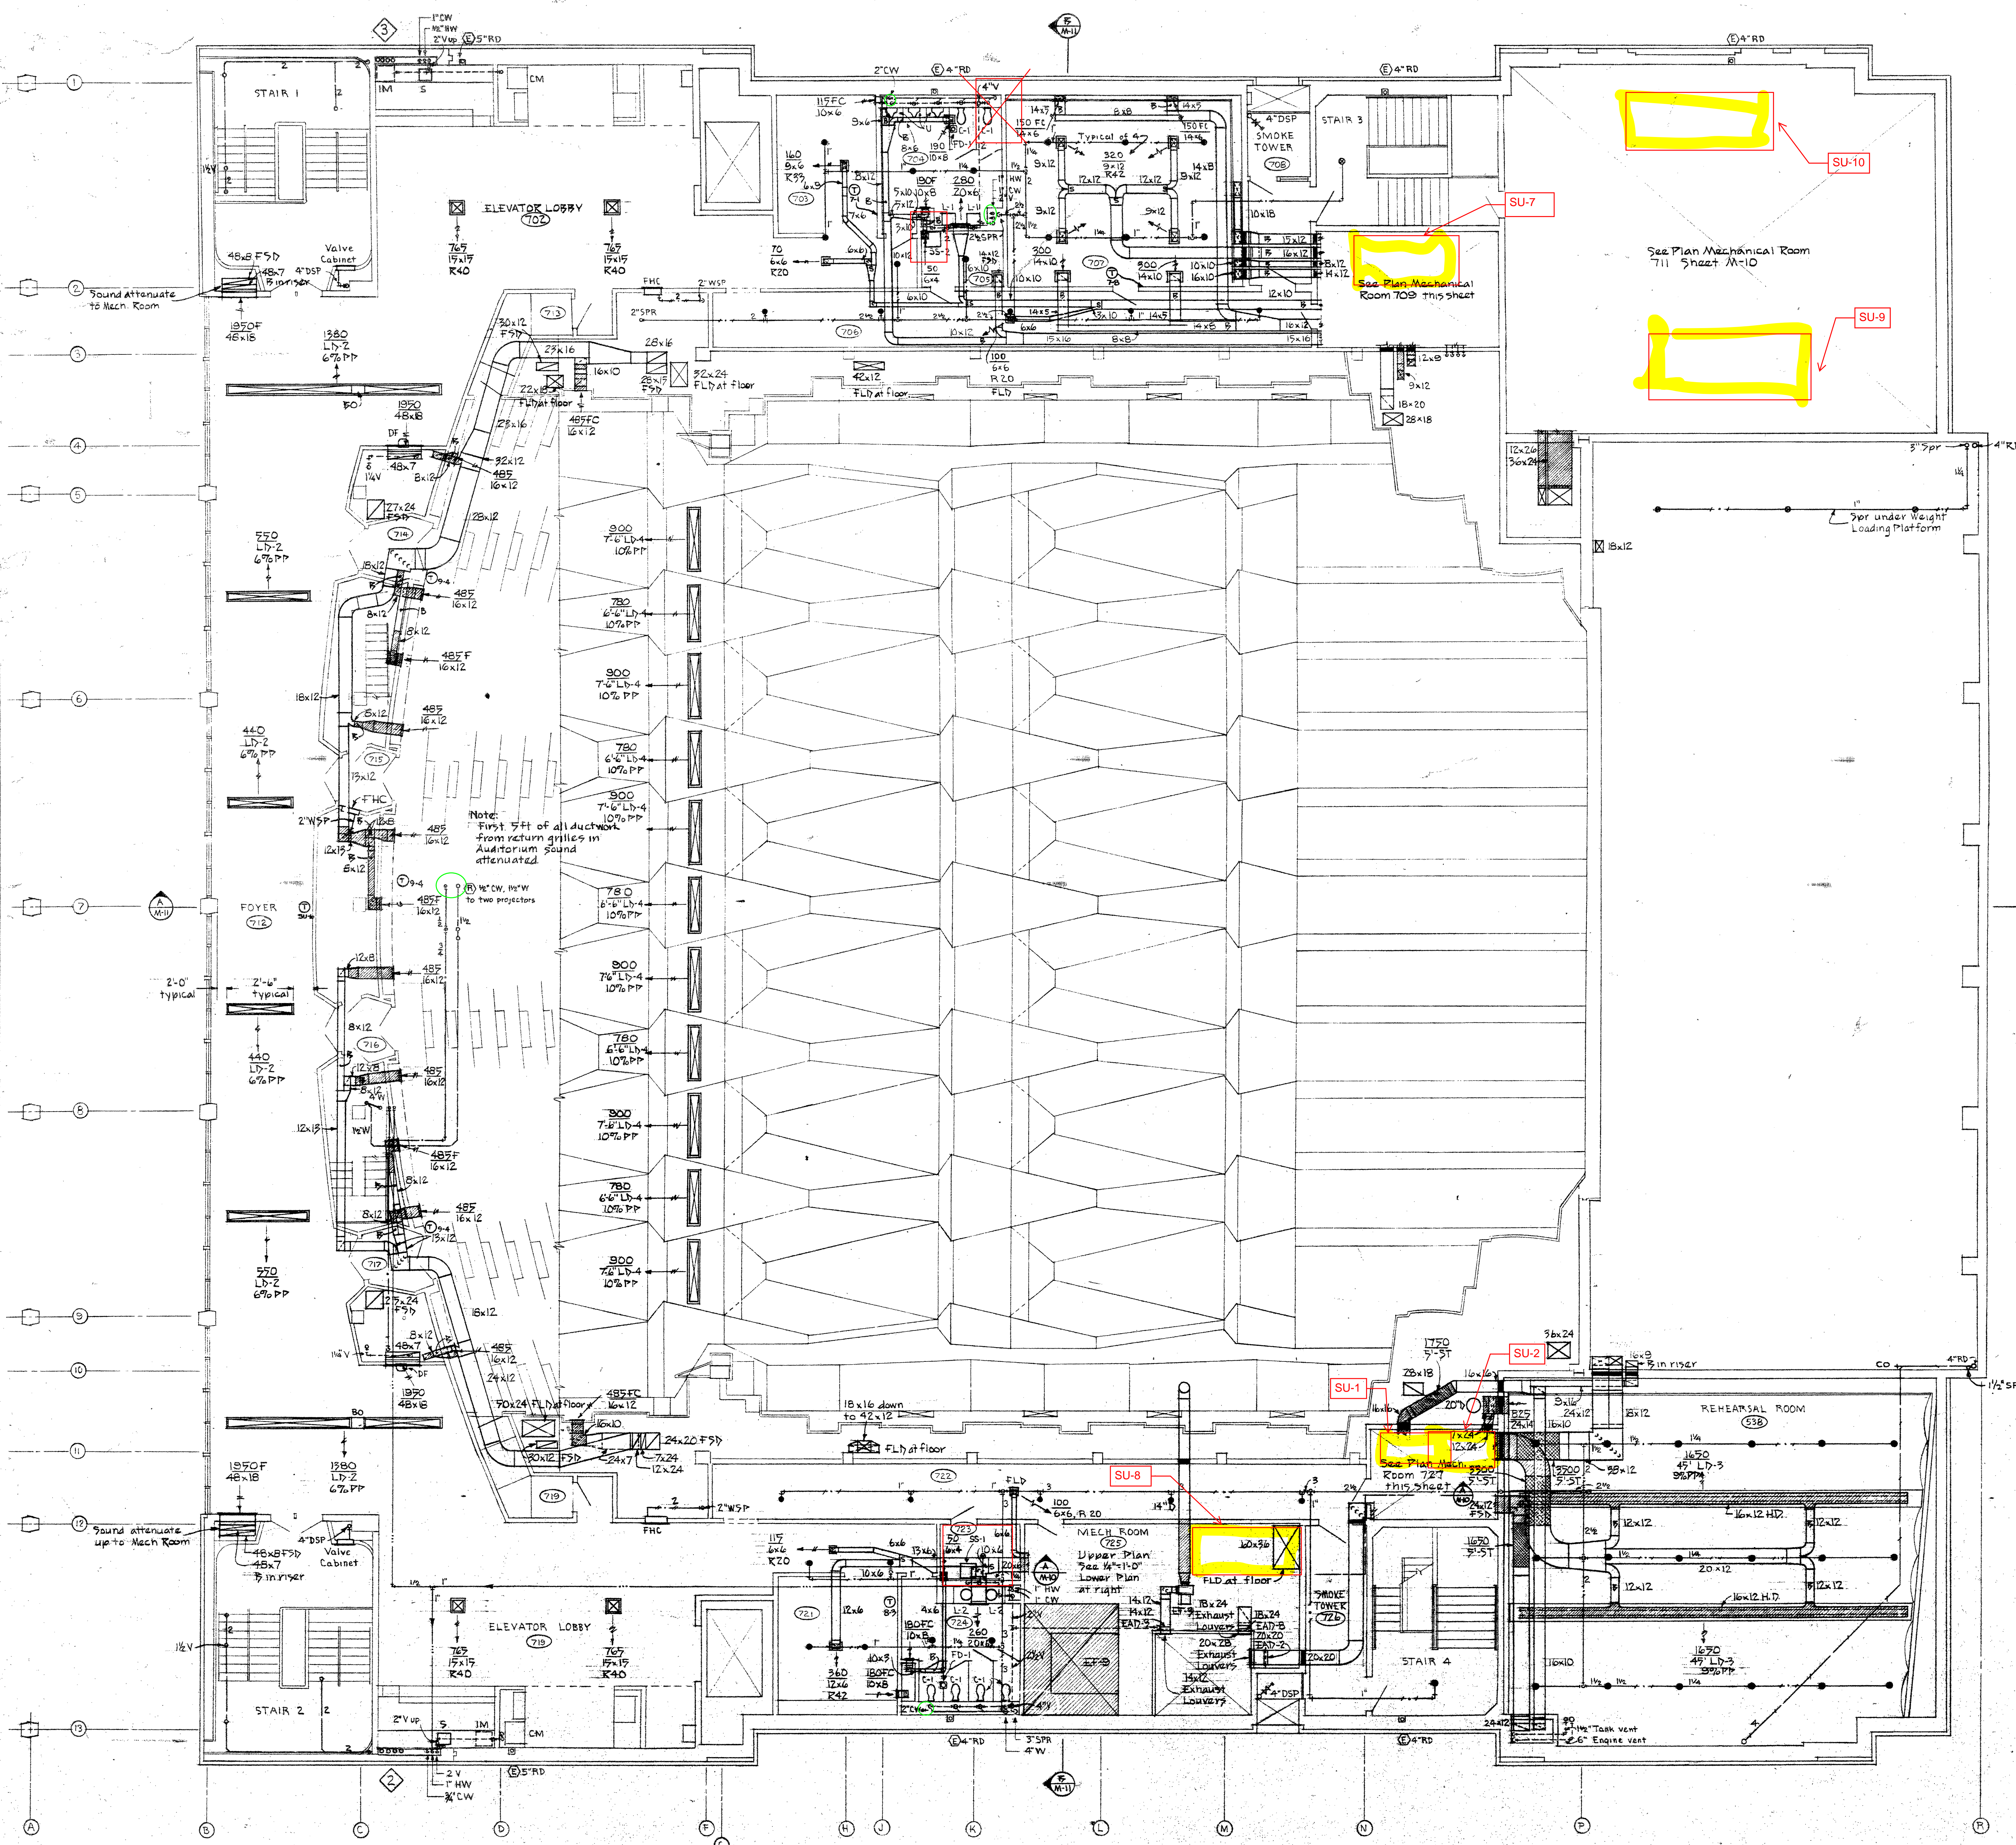


FLOOR PLAN - SECOND BALCONY LEVEL  
1/8"=1'-0"

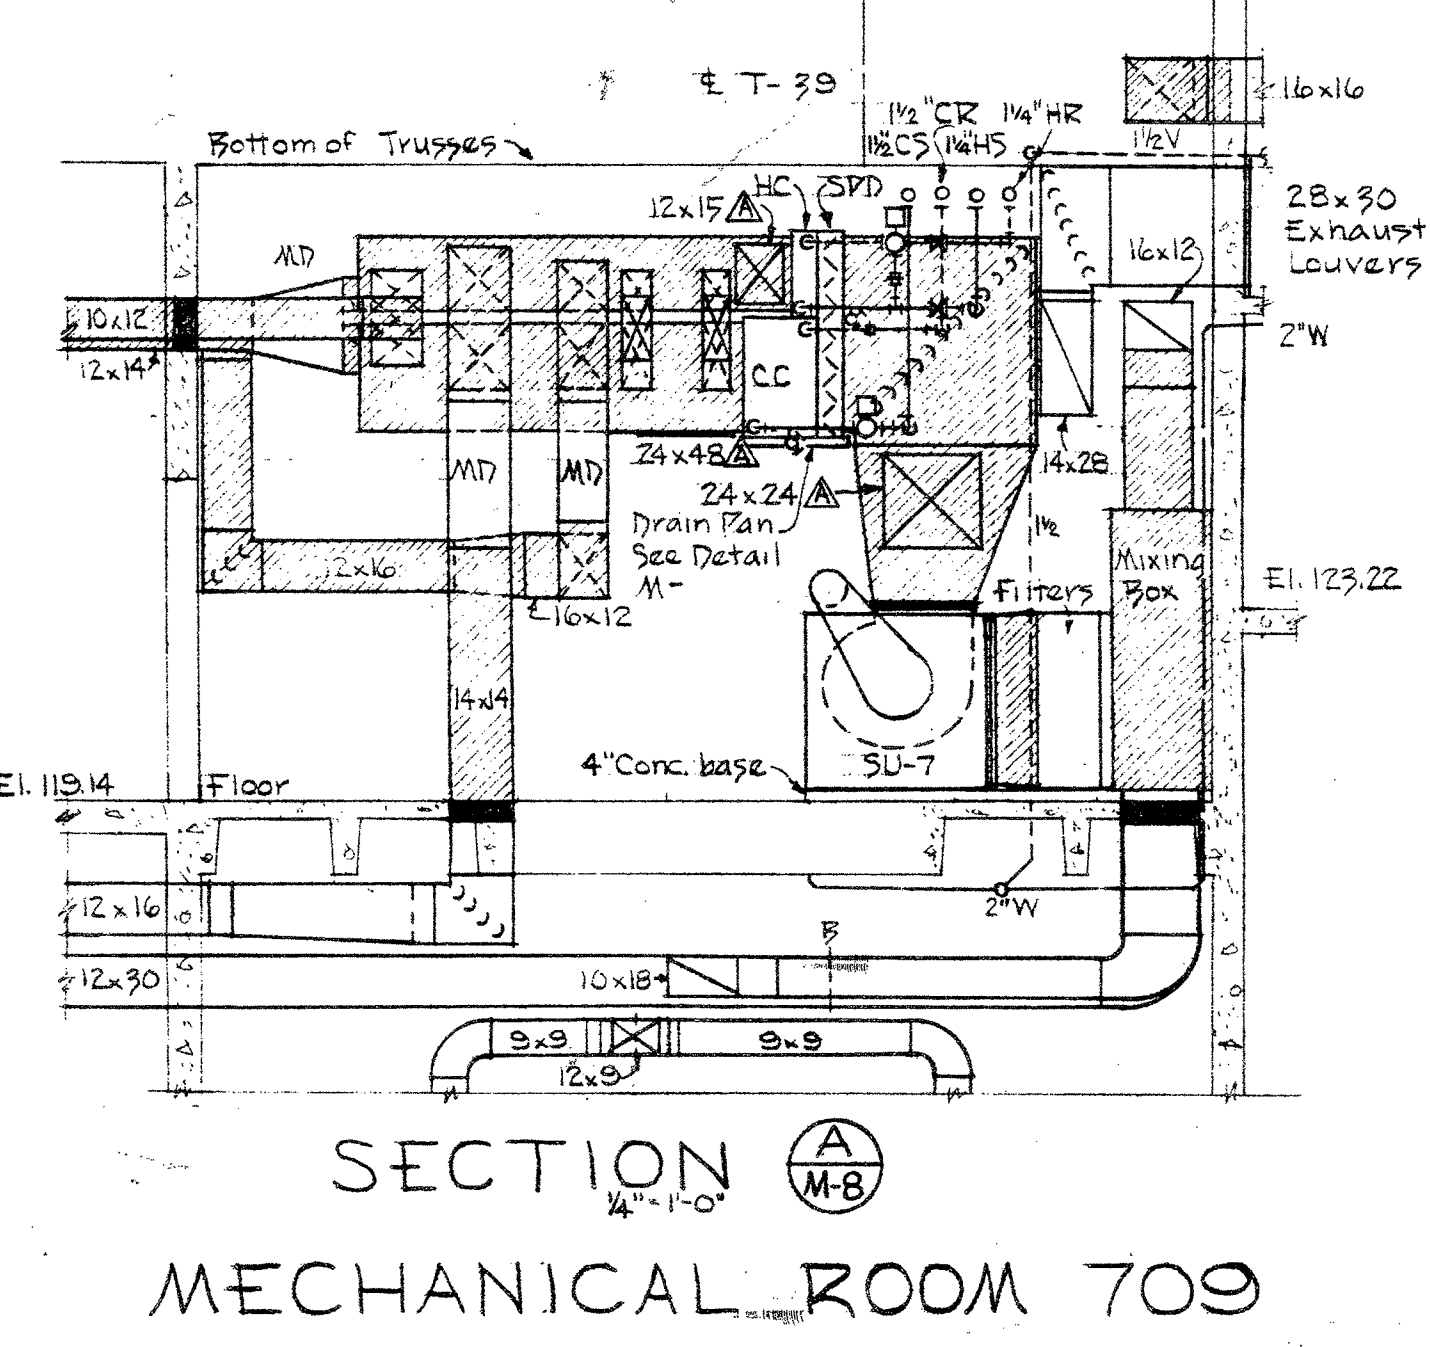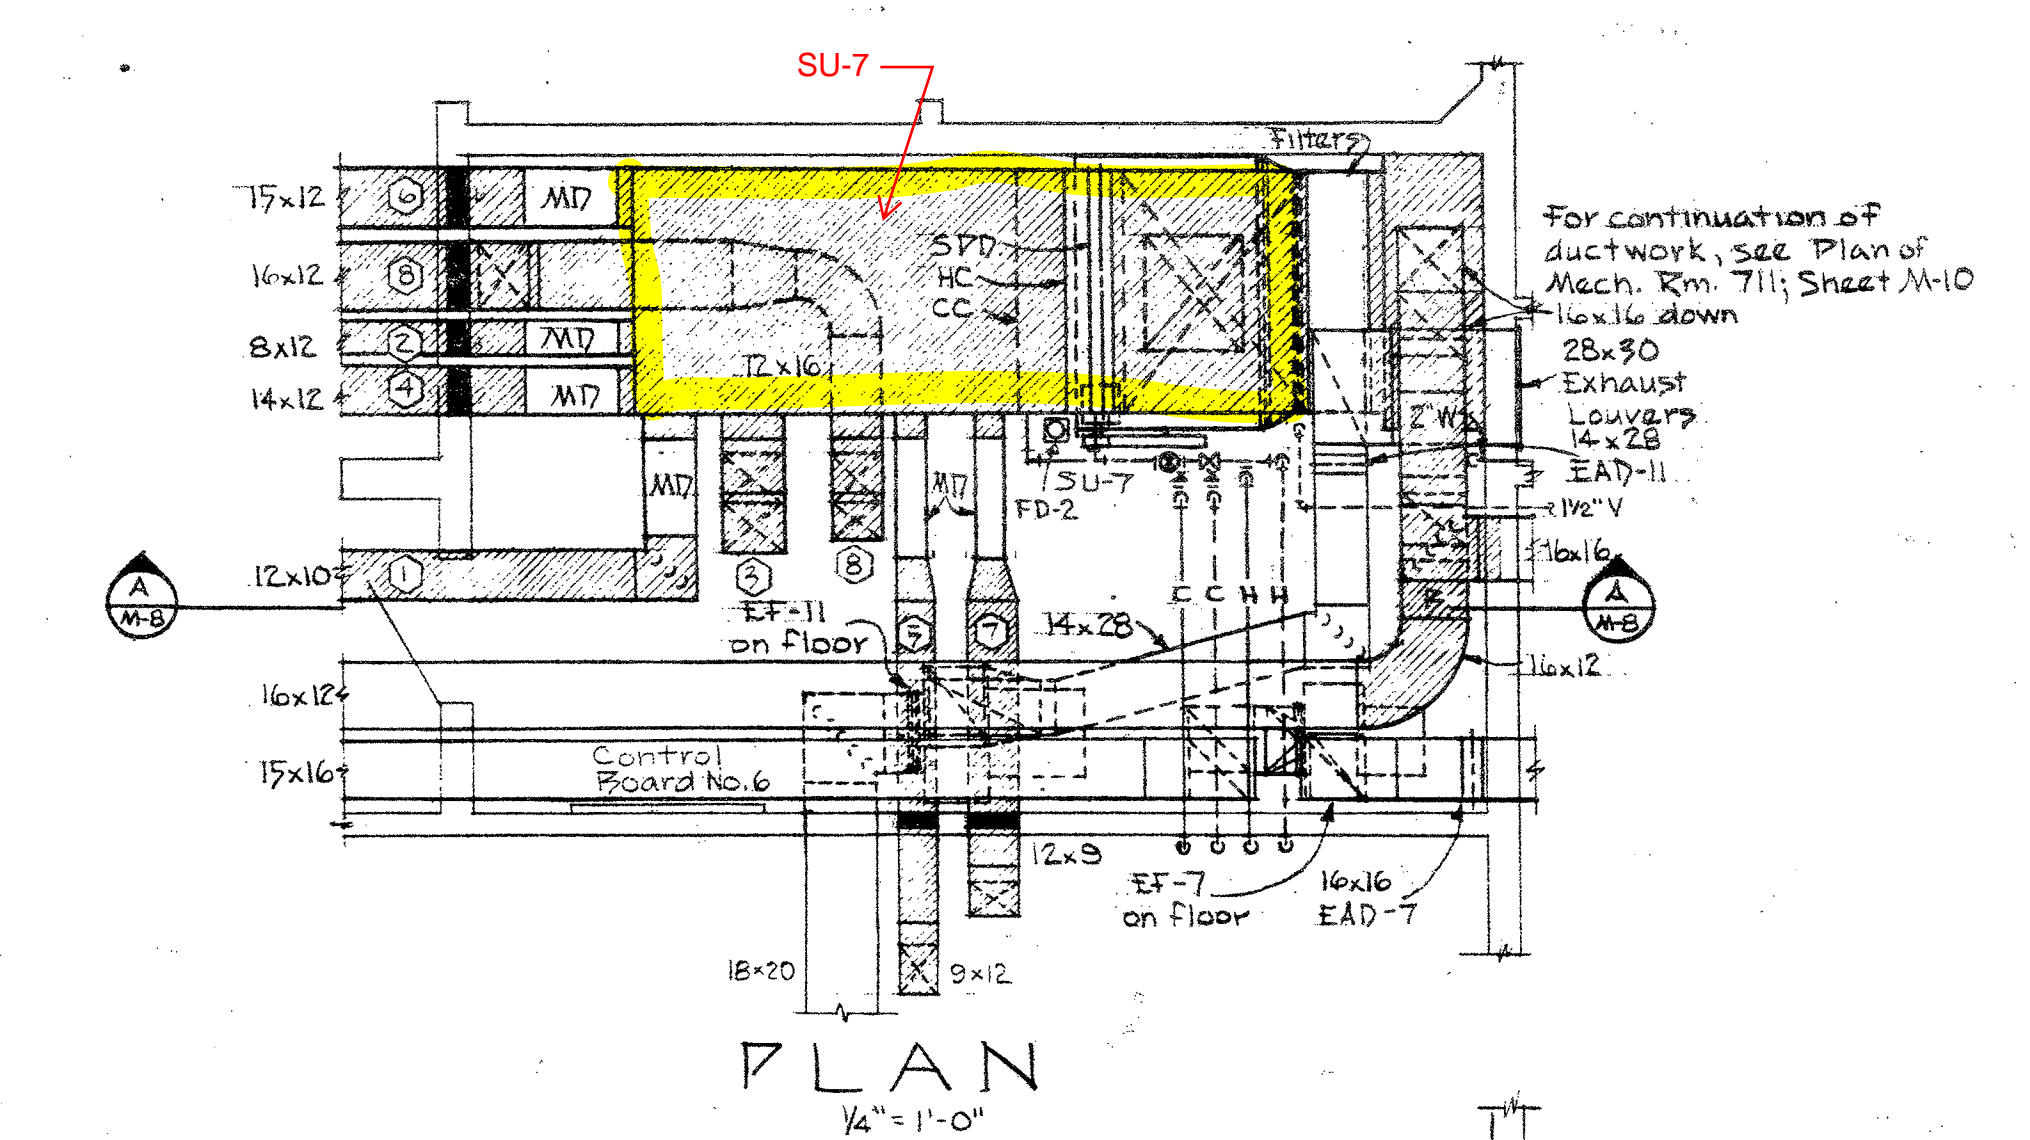


SECTION A-B  
MECHANICAL ROOM 709  
1/4"=1'-0"

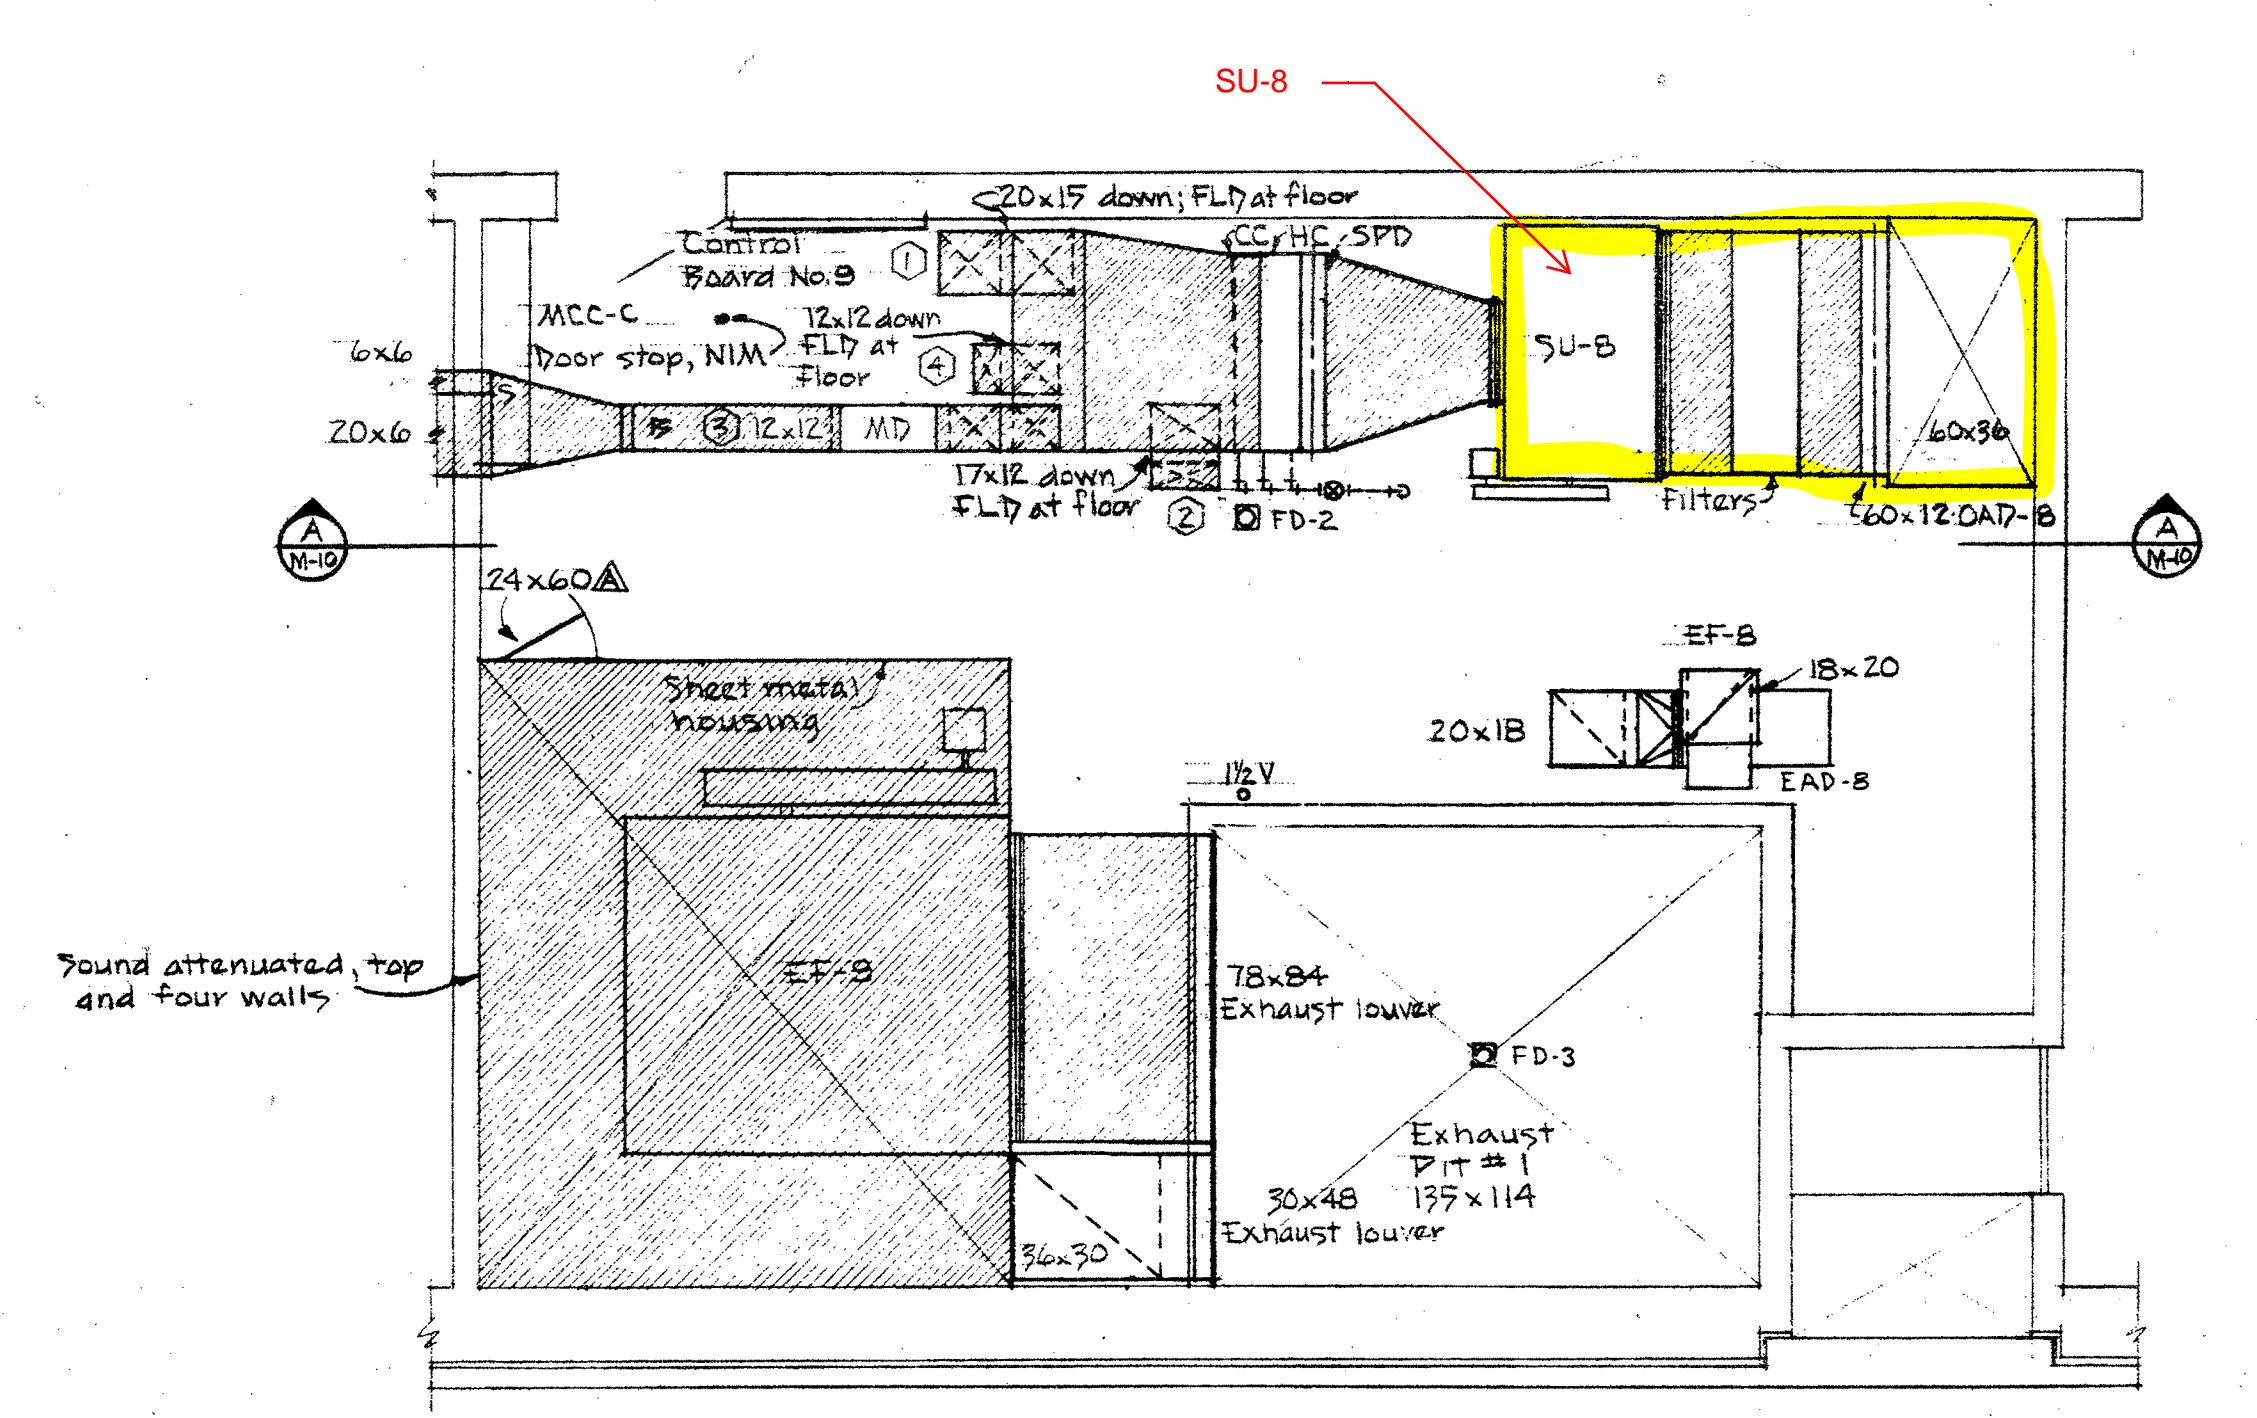

LOWER PLAN  
MECHANICAL ROOM 725  
1/4"=1'-0"

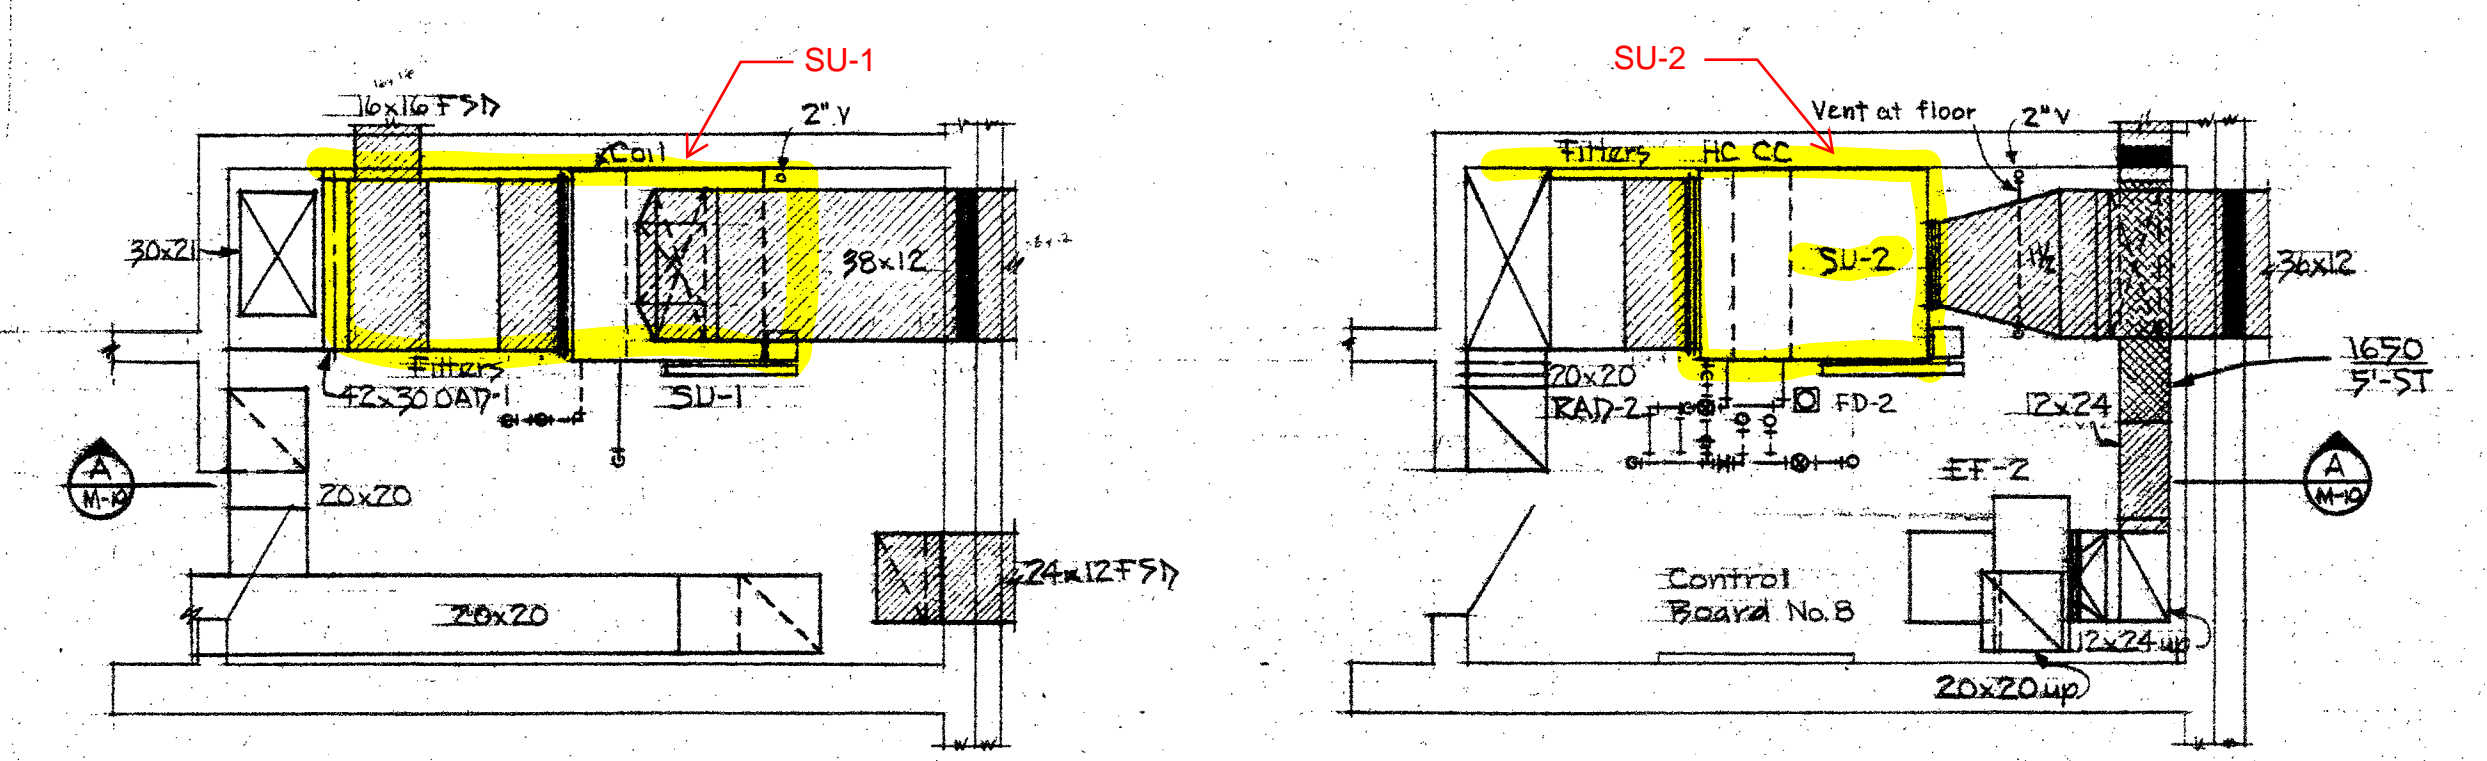

UPPER PLAN  
LOWER PLAN  
MECHANICAL ROOM 727  
1/4"=1'-0"

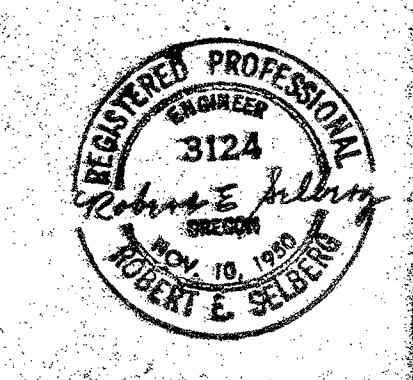

**MECHANICAL SECOND BALCONY FLOOR PLAN AND DETAILS**



BY: MARCUS PRITCA ARCHITECT  
THEATER CONSULTANT  
PAUL VONBACH & ASSOCIATES ACoustical CONSULTANTS  
COOPER & ROSE & ASSOCIATES STRUCTURAL ENGINEERS  
J. DONALD KROEBER & ASSOCIATES MECHANICAL ENGINEERS  
GRANT KELLEY & ASSOCIATES ELECTRICAL ENGINEERS  
LILA COLWELL A.I.D. INTERIOR CONSULTANT

**REBUILDING OF PORTLAND CIVIC AUDITORIUM**  
3 W. THIRD AVENUE & CLAY STREET  
CITY OF PORTLAND OREGON


DRAWING: STANTON, BOLES, MAGUIRE & CHURCH ARCHITECTS  
200 S. W. STARK ST., PORTLAND, OREGON  
EDMMS NO. 6325  
DATE: MAY 24 1966

**M-8**


CHECKED

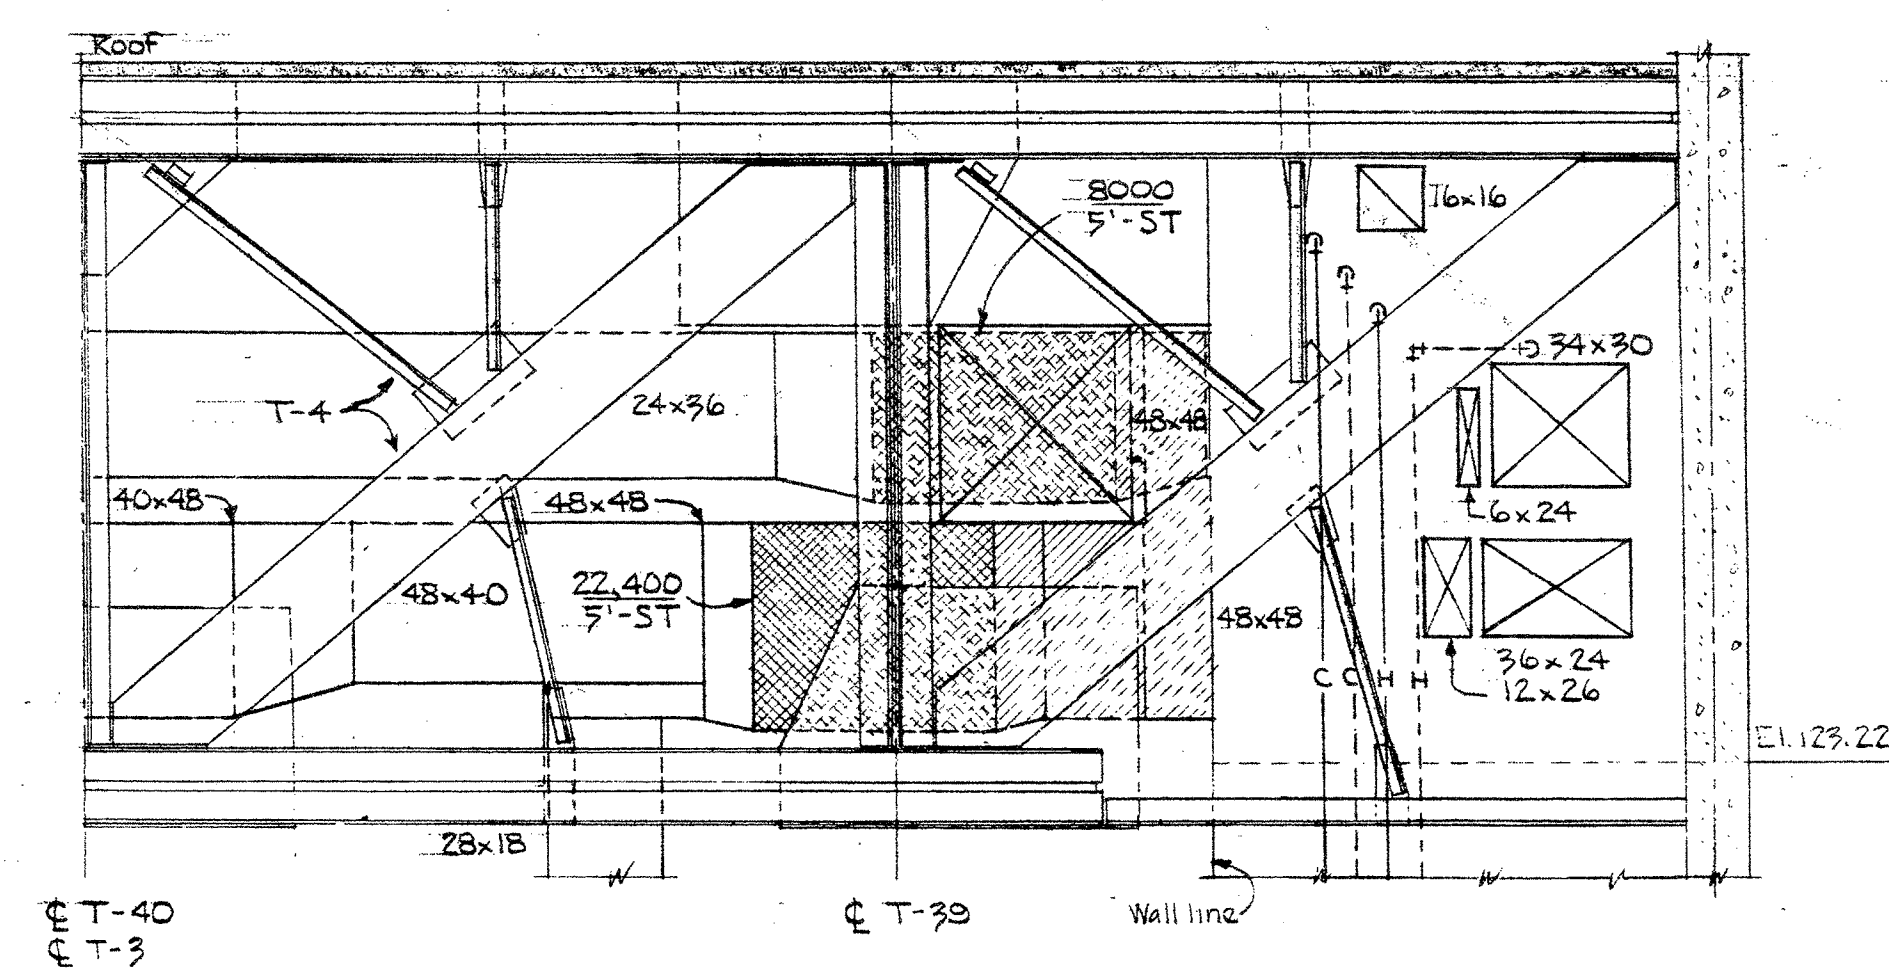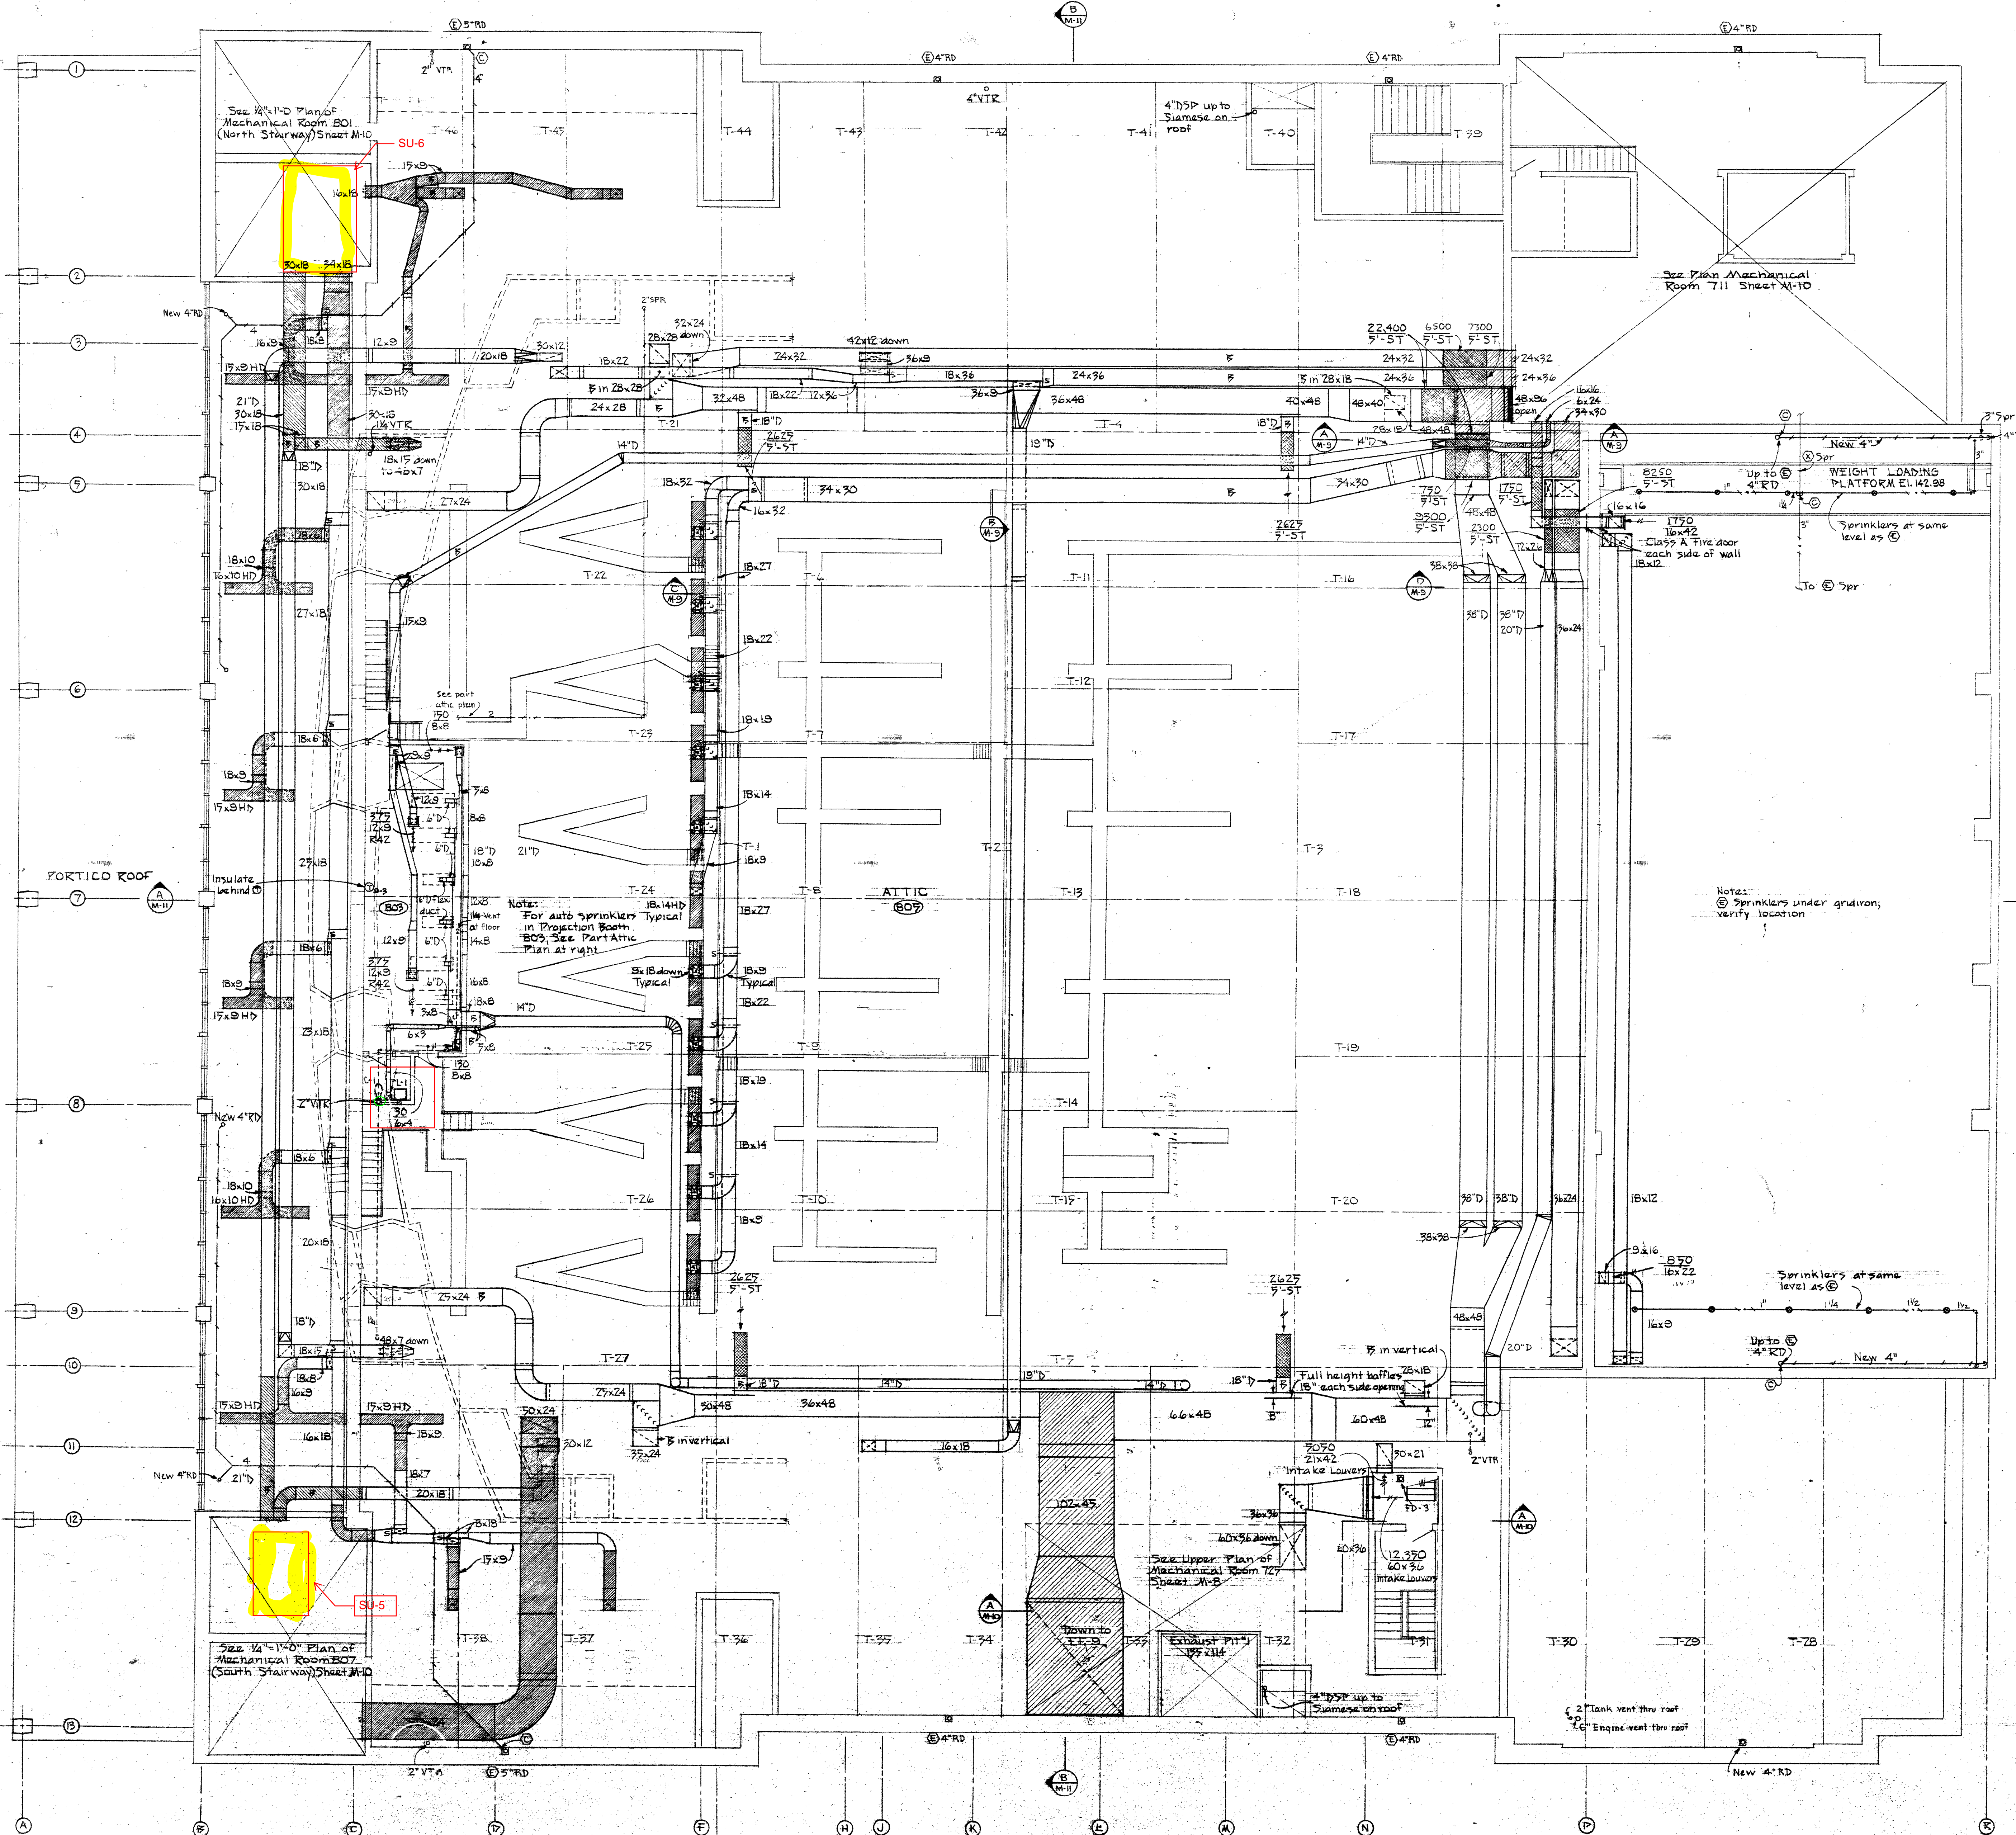


SECTION A  
1/4" = 1'-0"

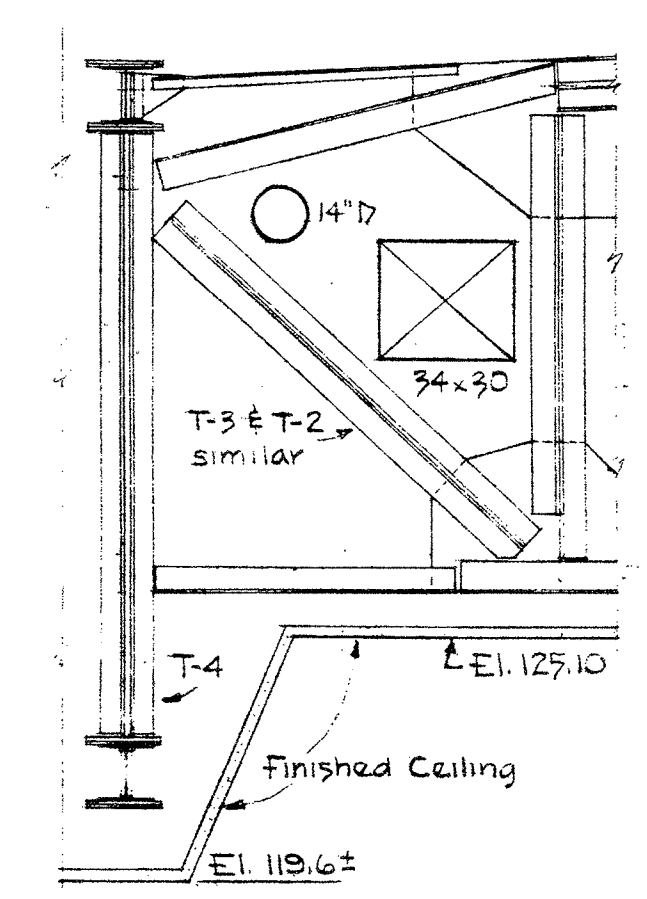


SECTION B  
1/4" = 1'-0"

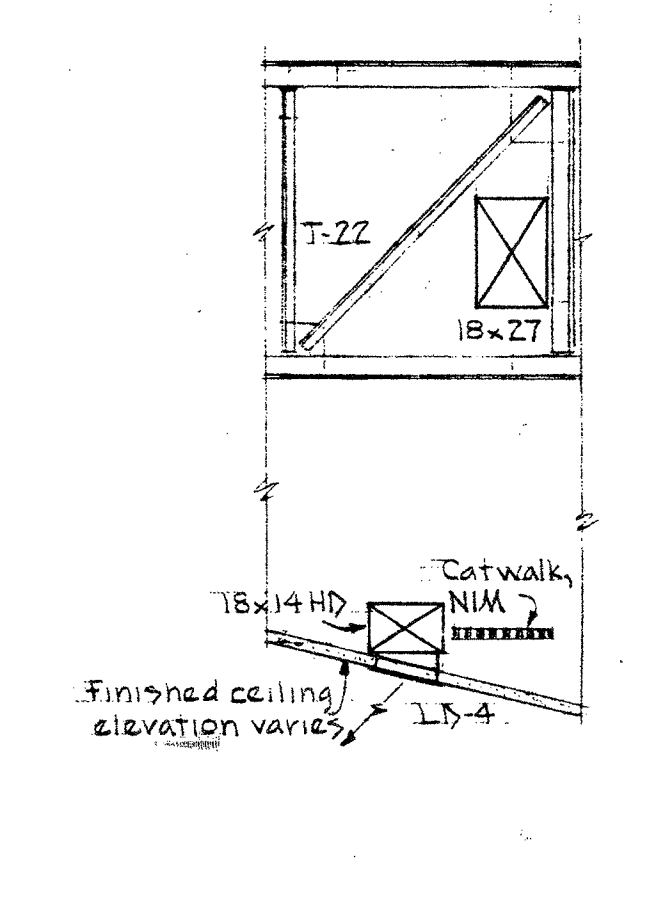


SECTION C  
1/4" = 1'-0"

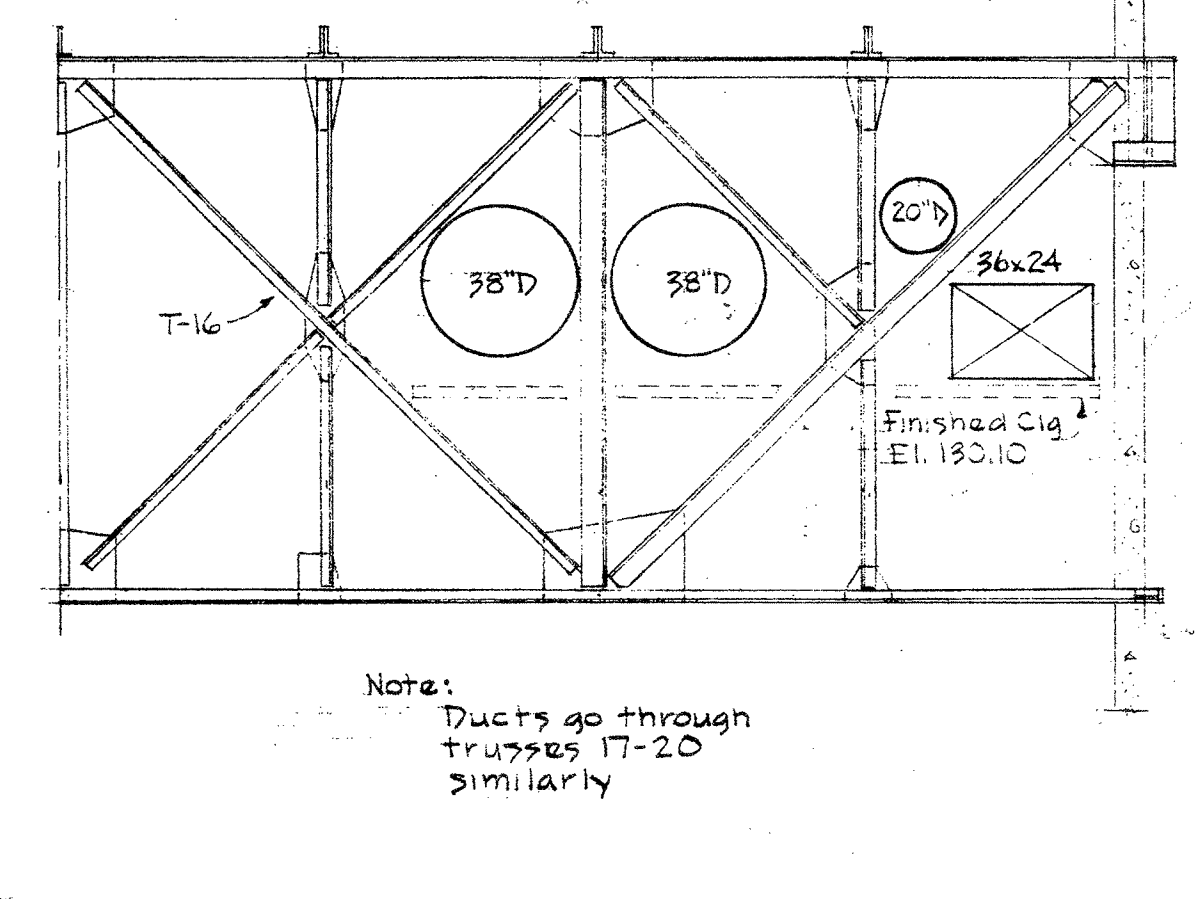


SECTION D  
1/4" = 1'-0"

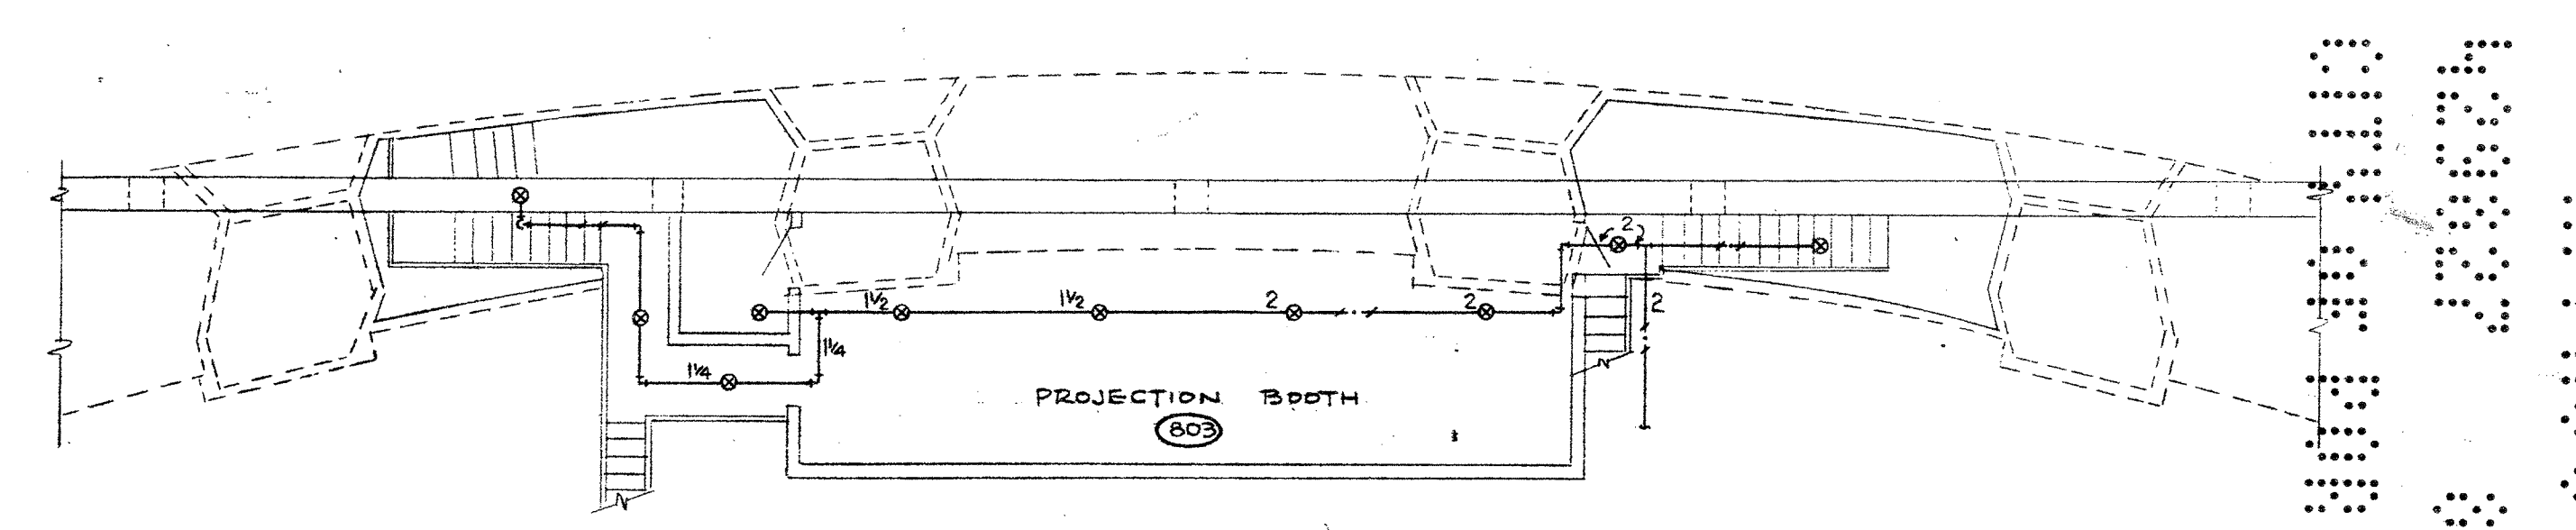


PART ATTIC PLAN - SPRINKLERS IN PROJECTION BOOTH  
1/8" = 1'-0"

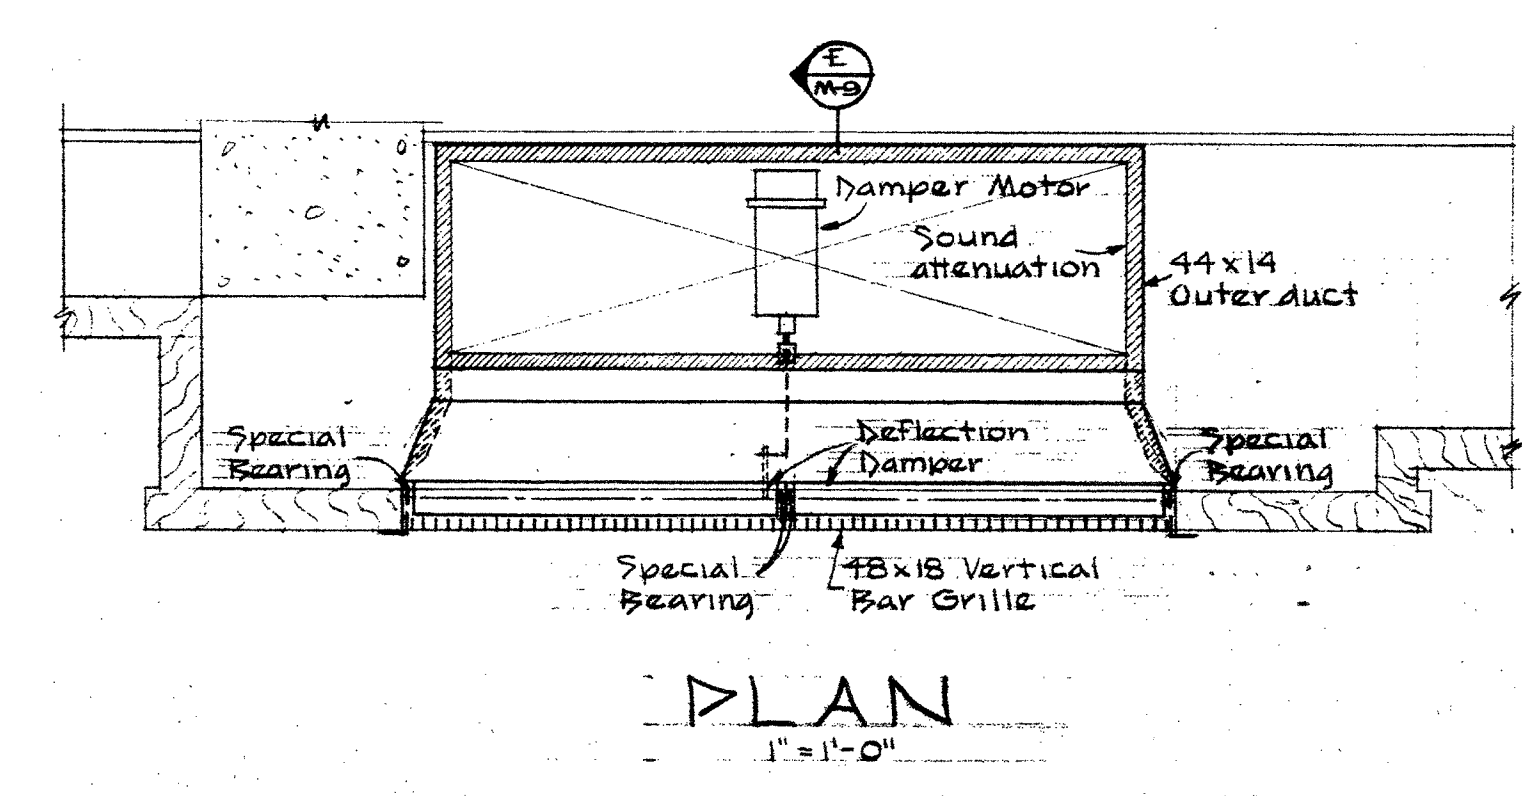

PLAN  
1" = 1'-0"

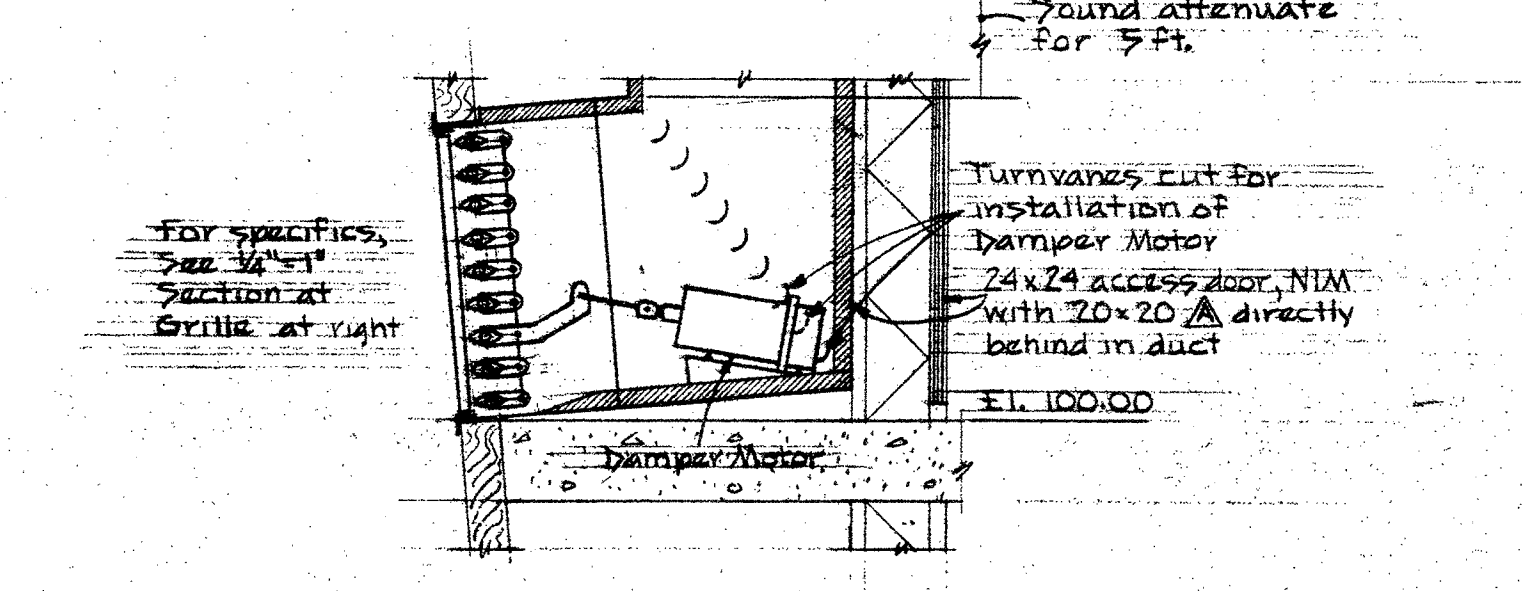

SECTION E  
1" = 1'-0"

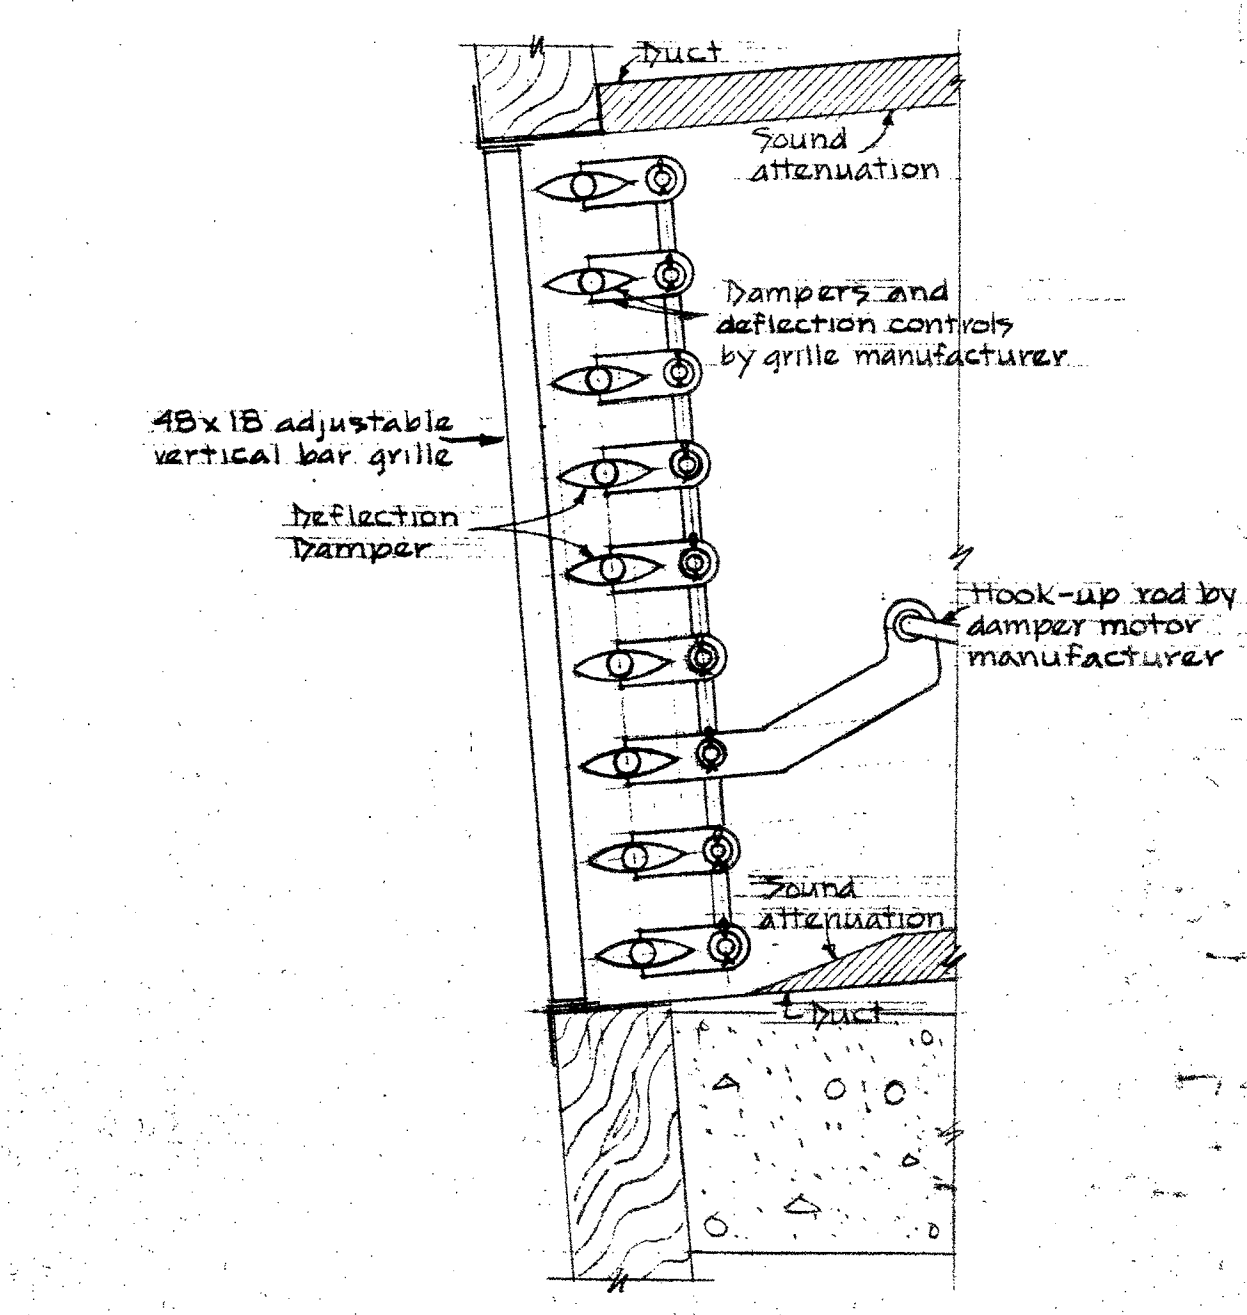

SECTION AT GRILLE  
1/4" = 1"

DETAILS OF TYPICAL HIGH SIDEWALL SUPPLY GRILLES IN AUDITORIUM WITH DD

ATTIC PLAN  
1/8" = 1'-0"

MECHANICAL ATTIC PLAN AND DETAILS

**B MARCUS PRITECA**  
ARCHITECT

**PAUL WENGLASSEN & ASSOCIATES**  
ACOUSTICAL CONSULTANTS

**COOPER & ROSE & ASSOCIATES**  
STRUCTURAL ENGINEERS

**J. DONALD KROEBER & ASSOCIATES**  
MECHANICAL ENGINEERS

**GRANT KELLEY & ASSOCIATES**  
ELECTRICAL ENGINEERS


**LILA COLWELL A.I.D.**  
INTERIOR CONSULTANT










**REBUILDING OF PORTLAND CIVIC AUDITORIUM**  
S. W. THIRD AVENUE & CLAY STREET  
FOR  
CITY OF PORTLAND OREGON

**DRAWING M-9**

**STANTON, BOLES, MAGUIRE & CHURCH**  
ARCHITECTS  
208 S. W. STARK ST., PORTLAND 4, OREGON  
COMM. NO. 6323  
DATE: MAY 24 1956

DRAWN  
CHECKED

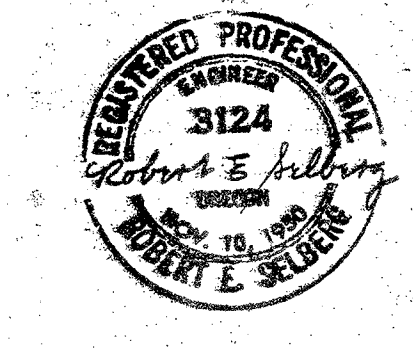

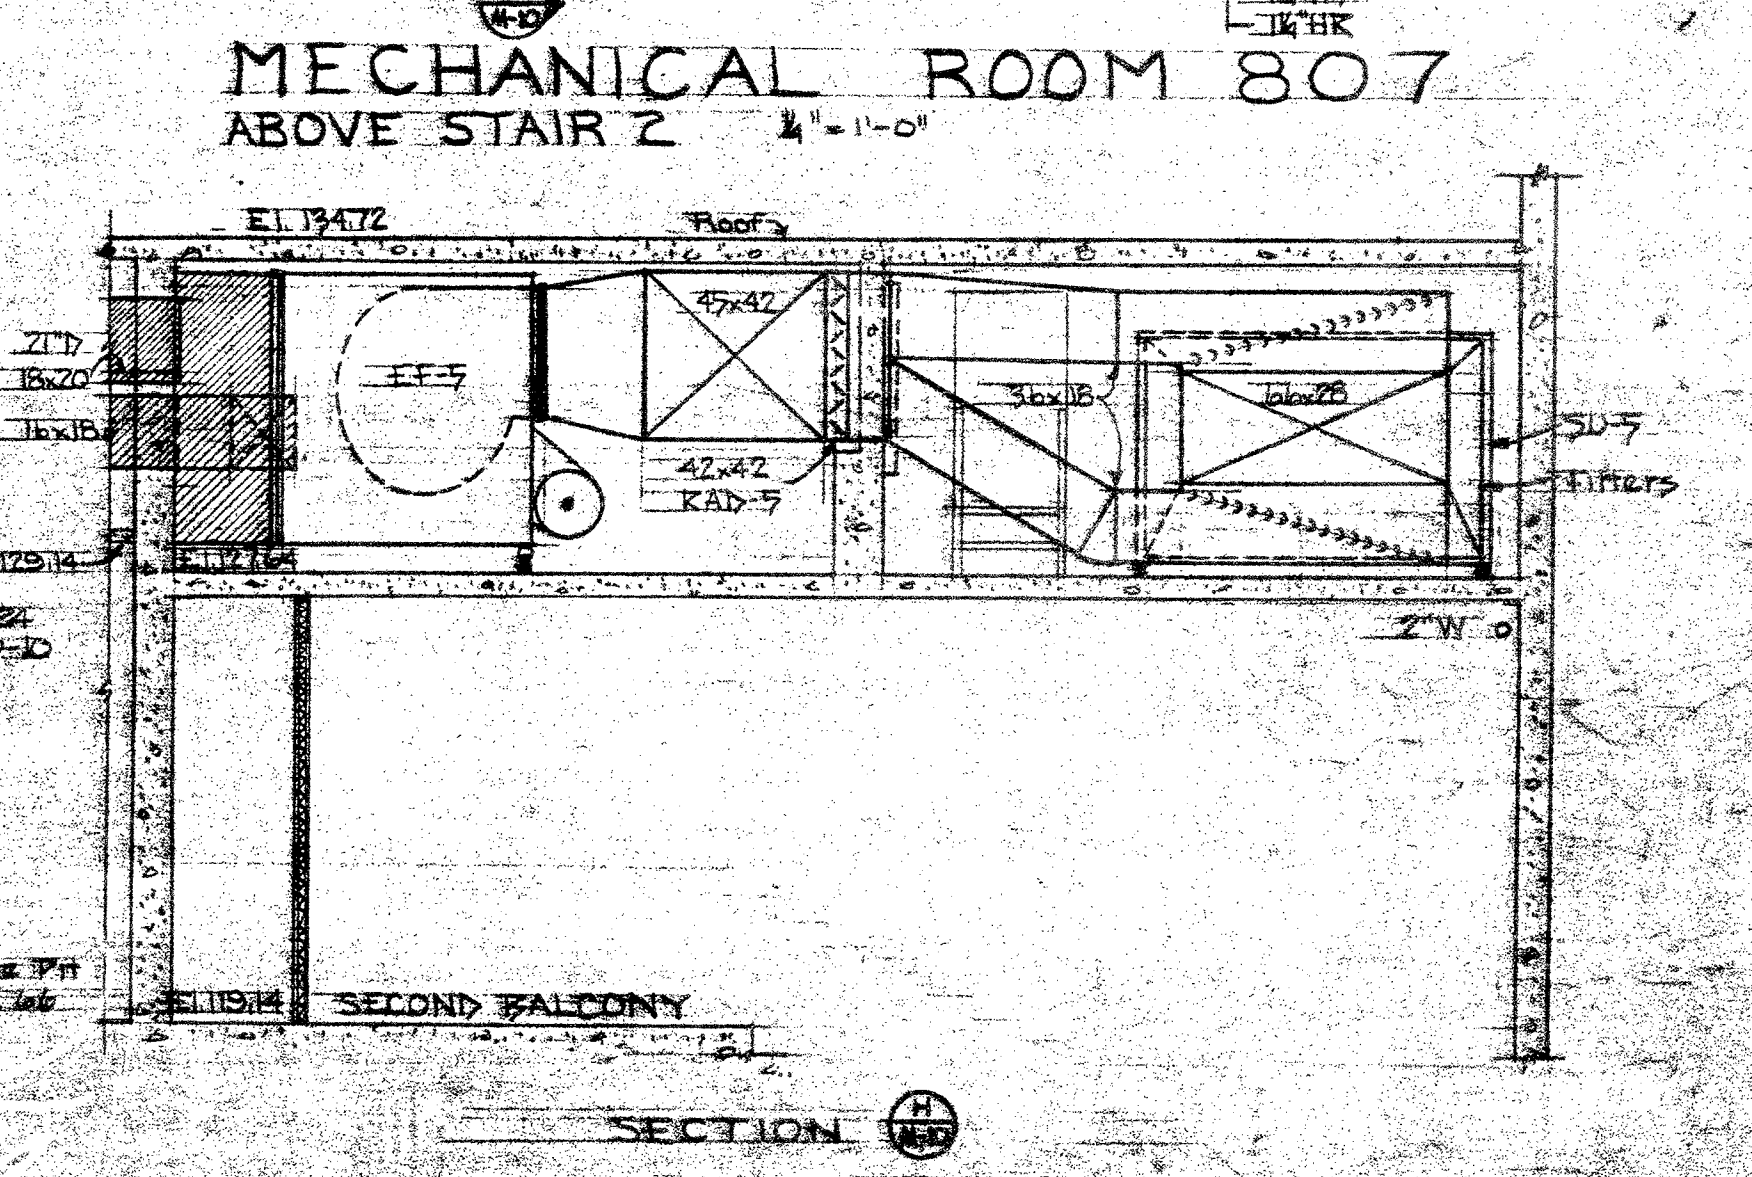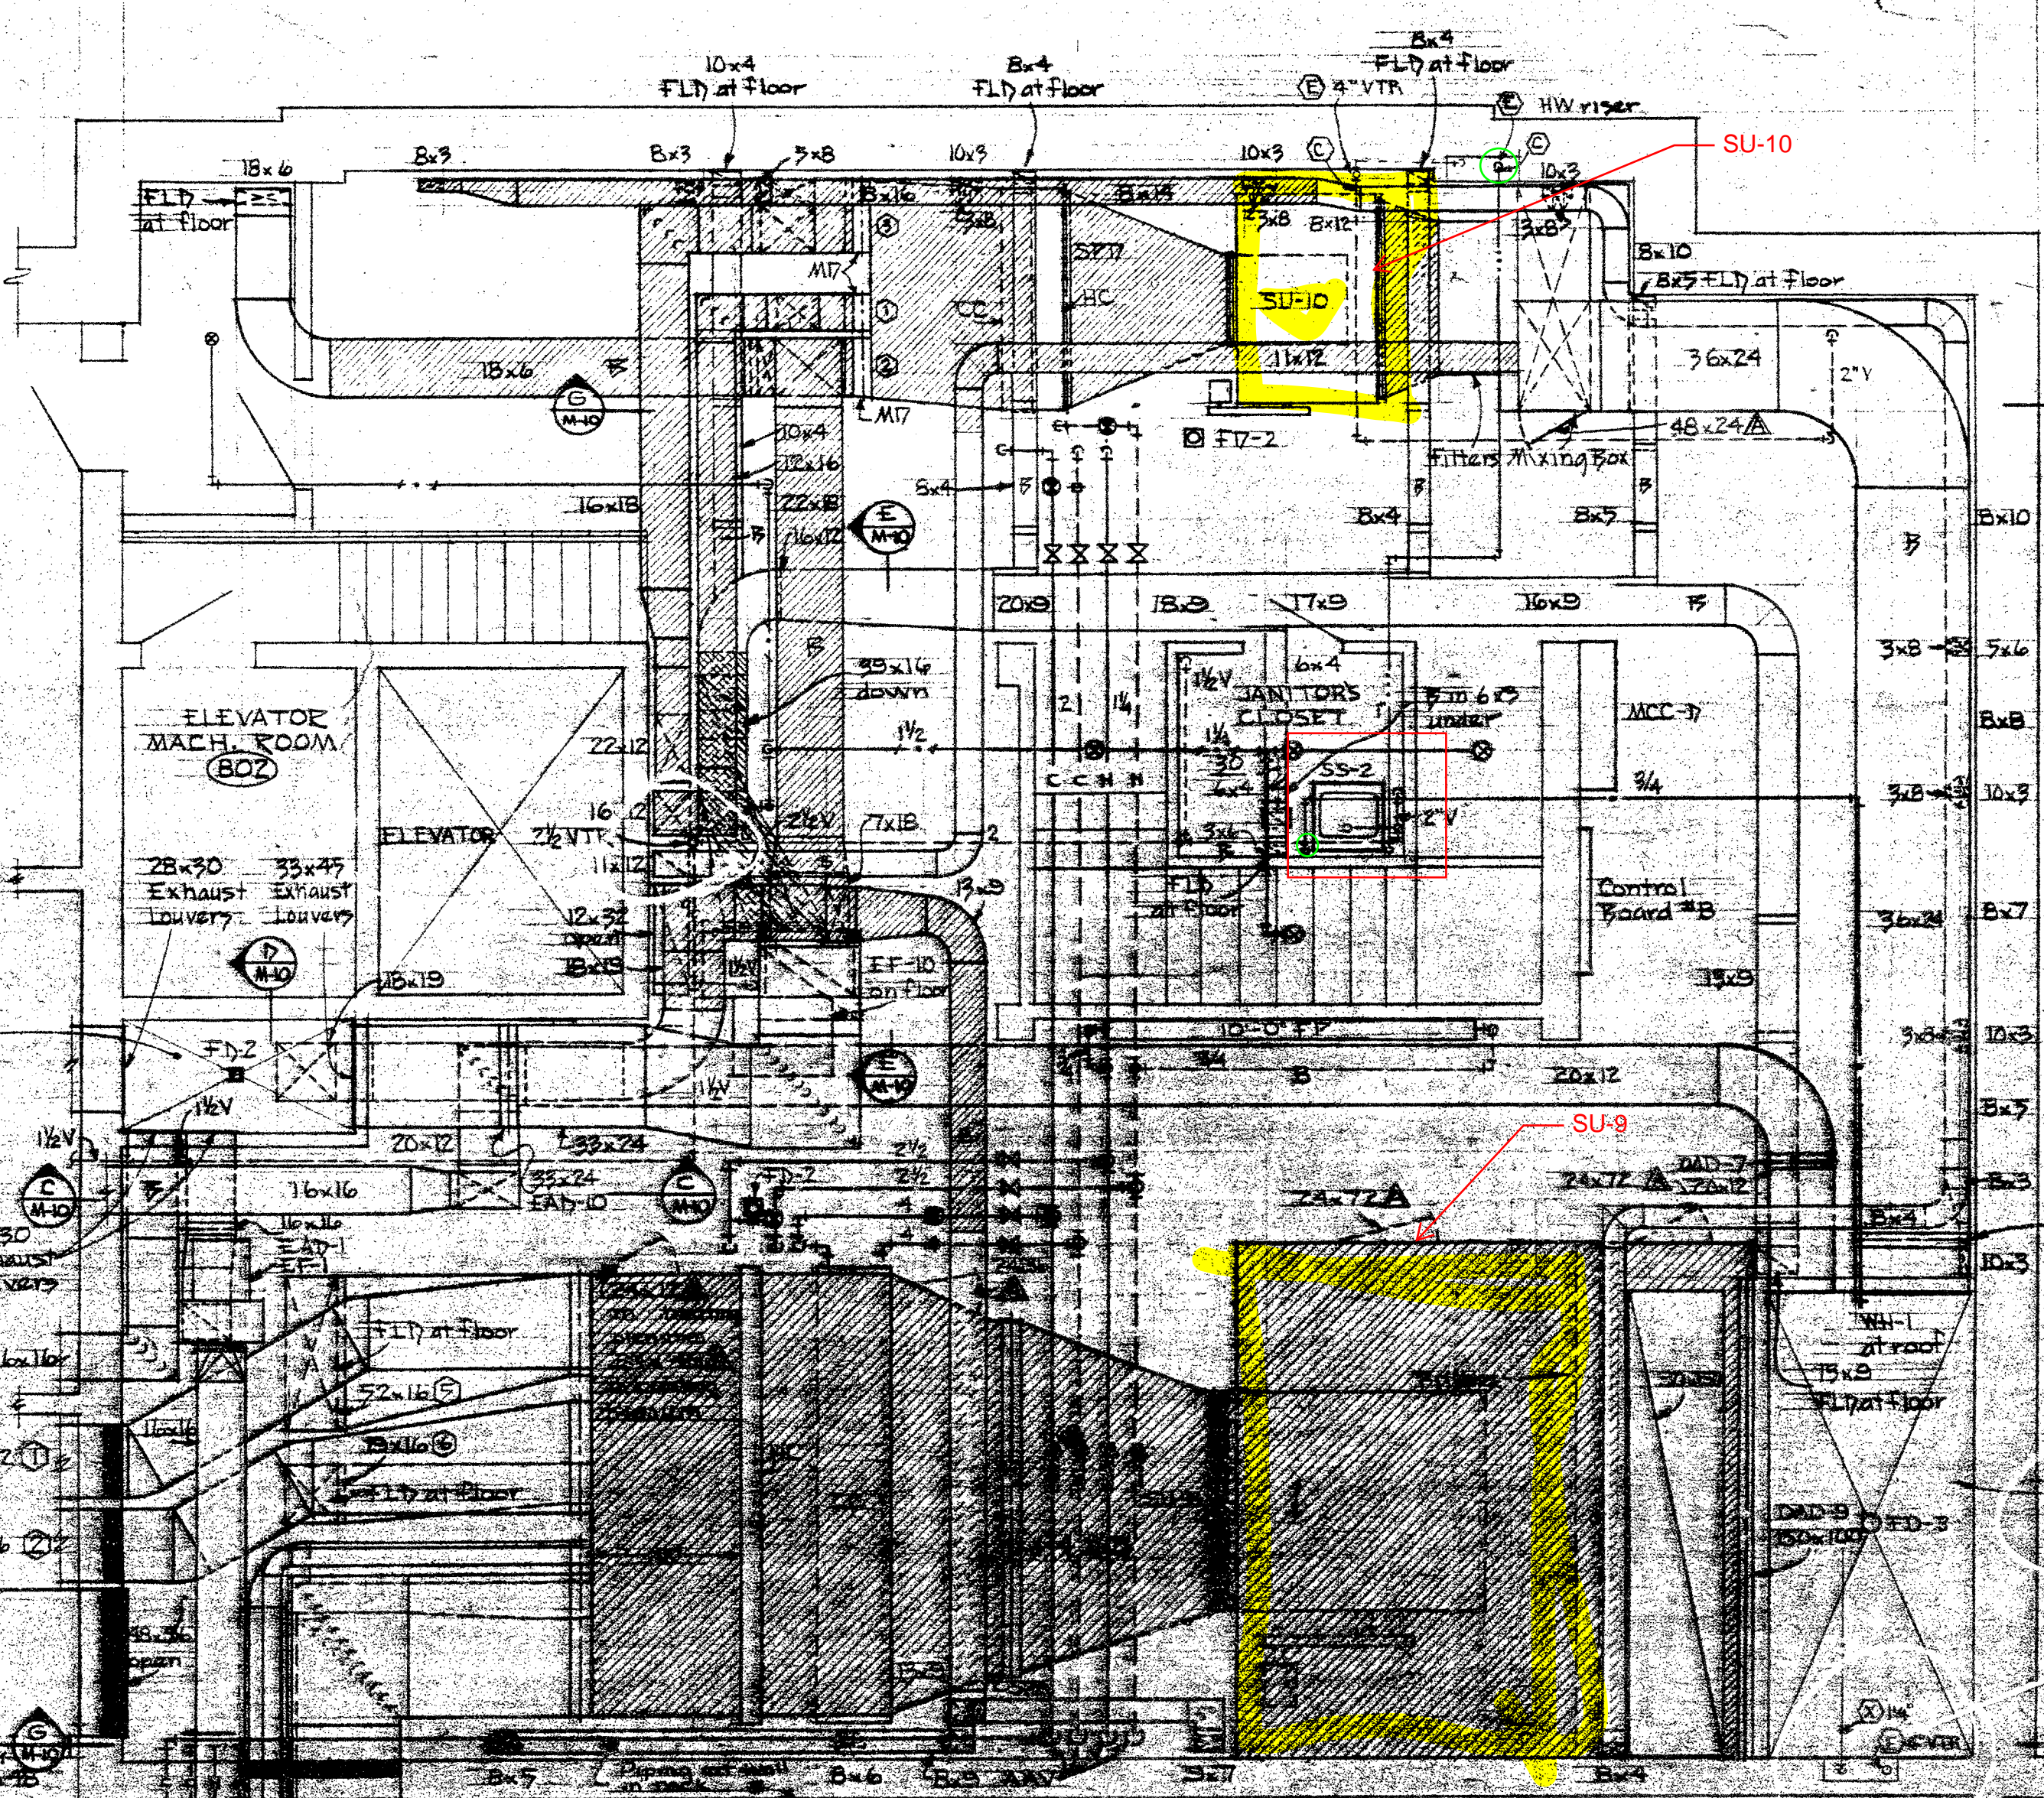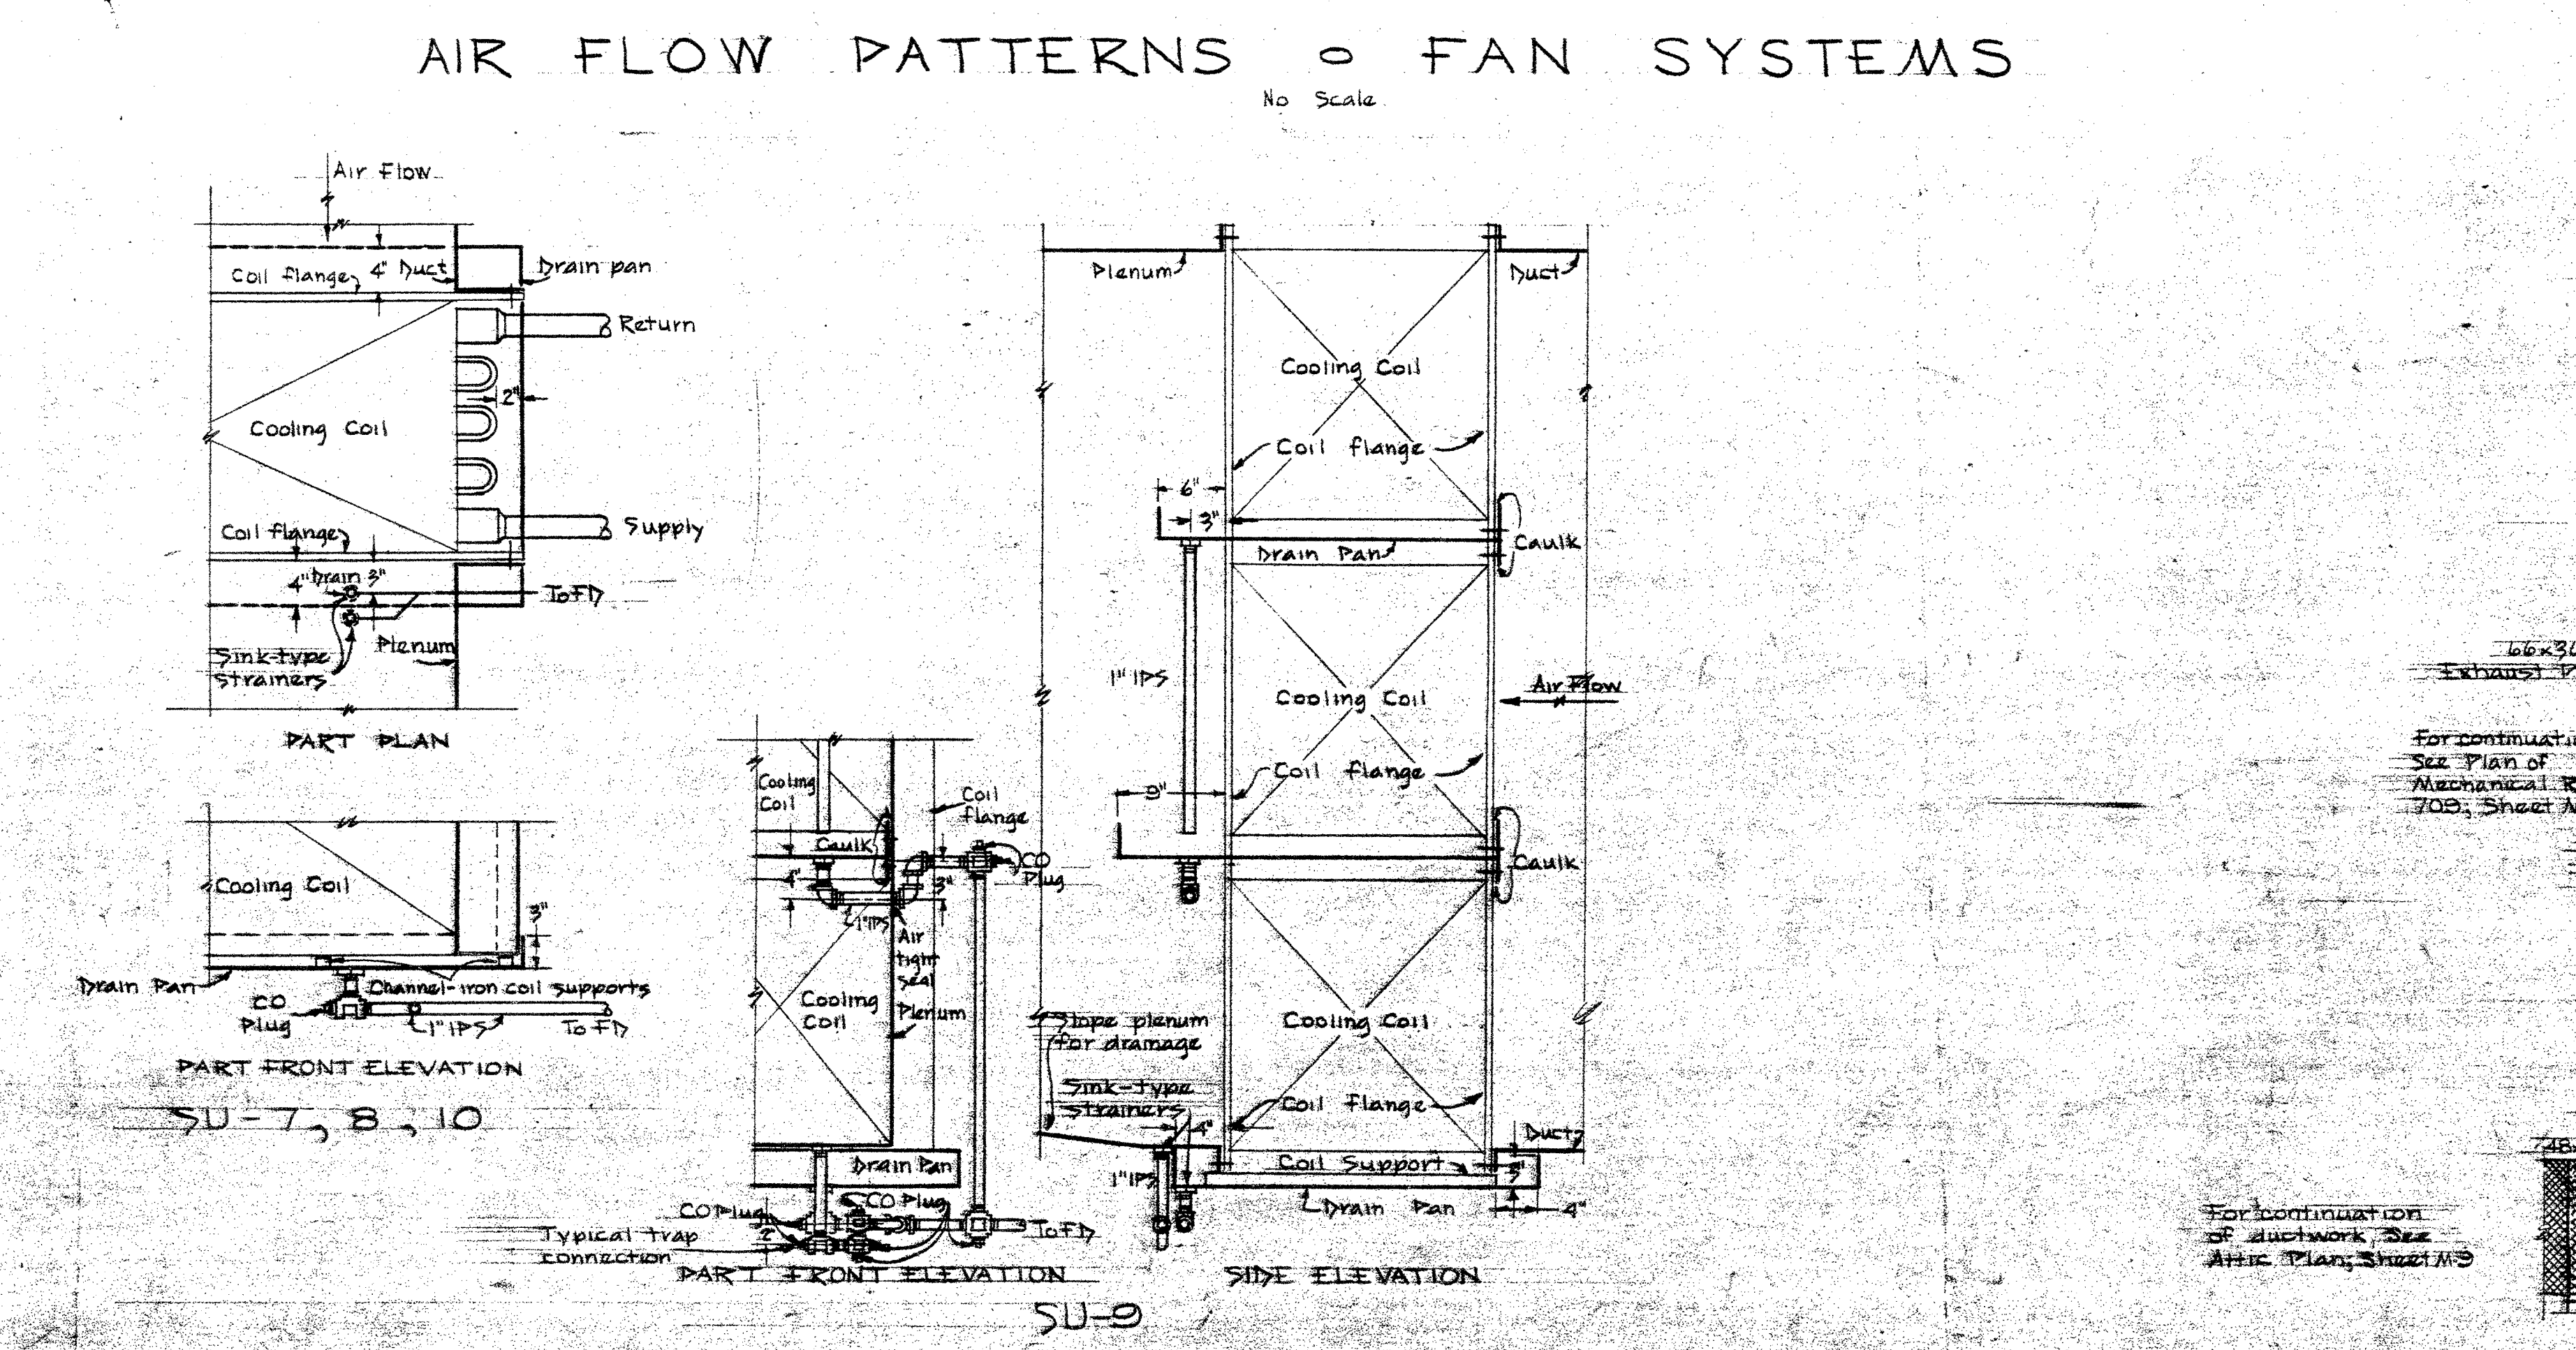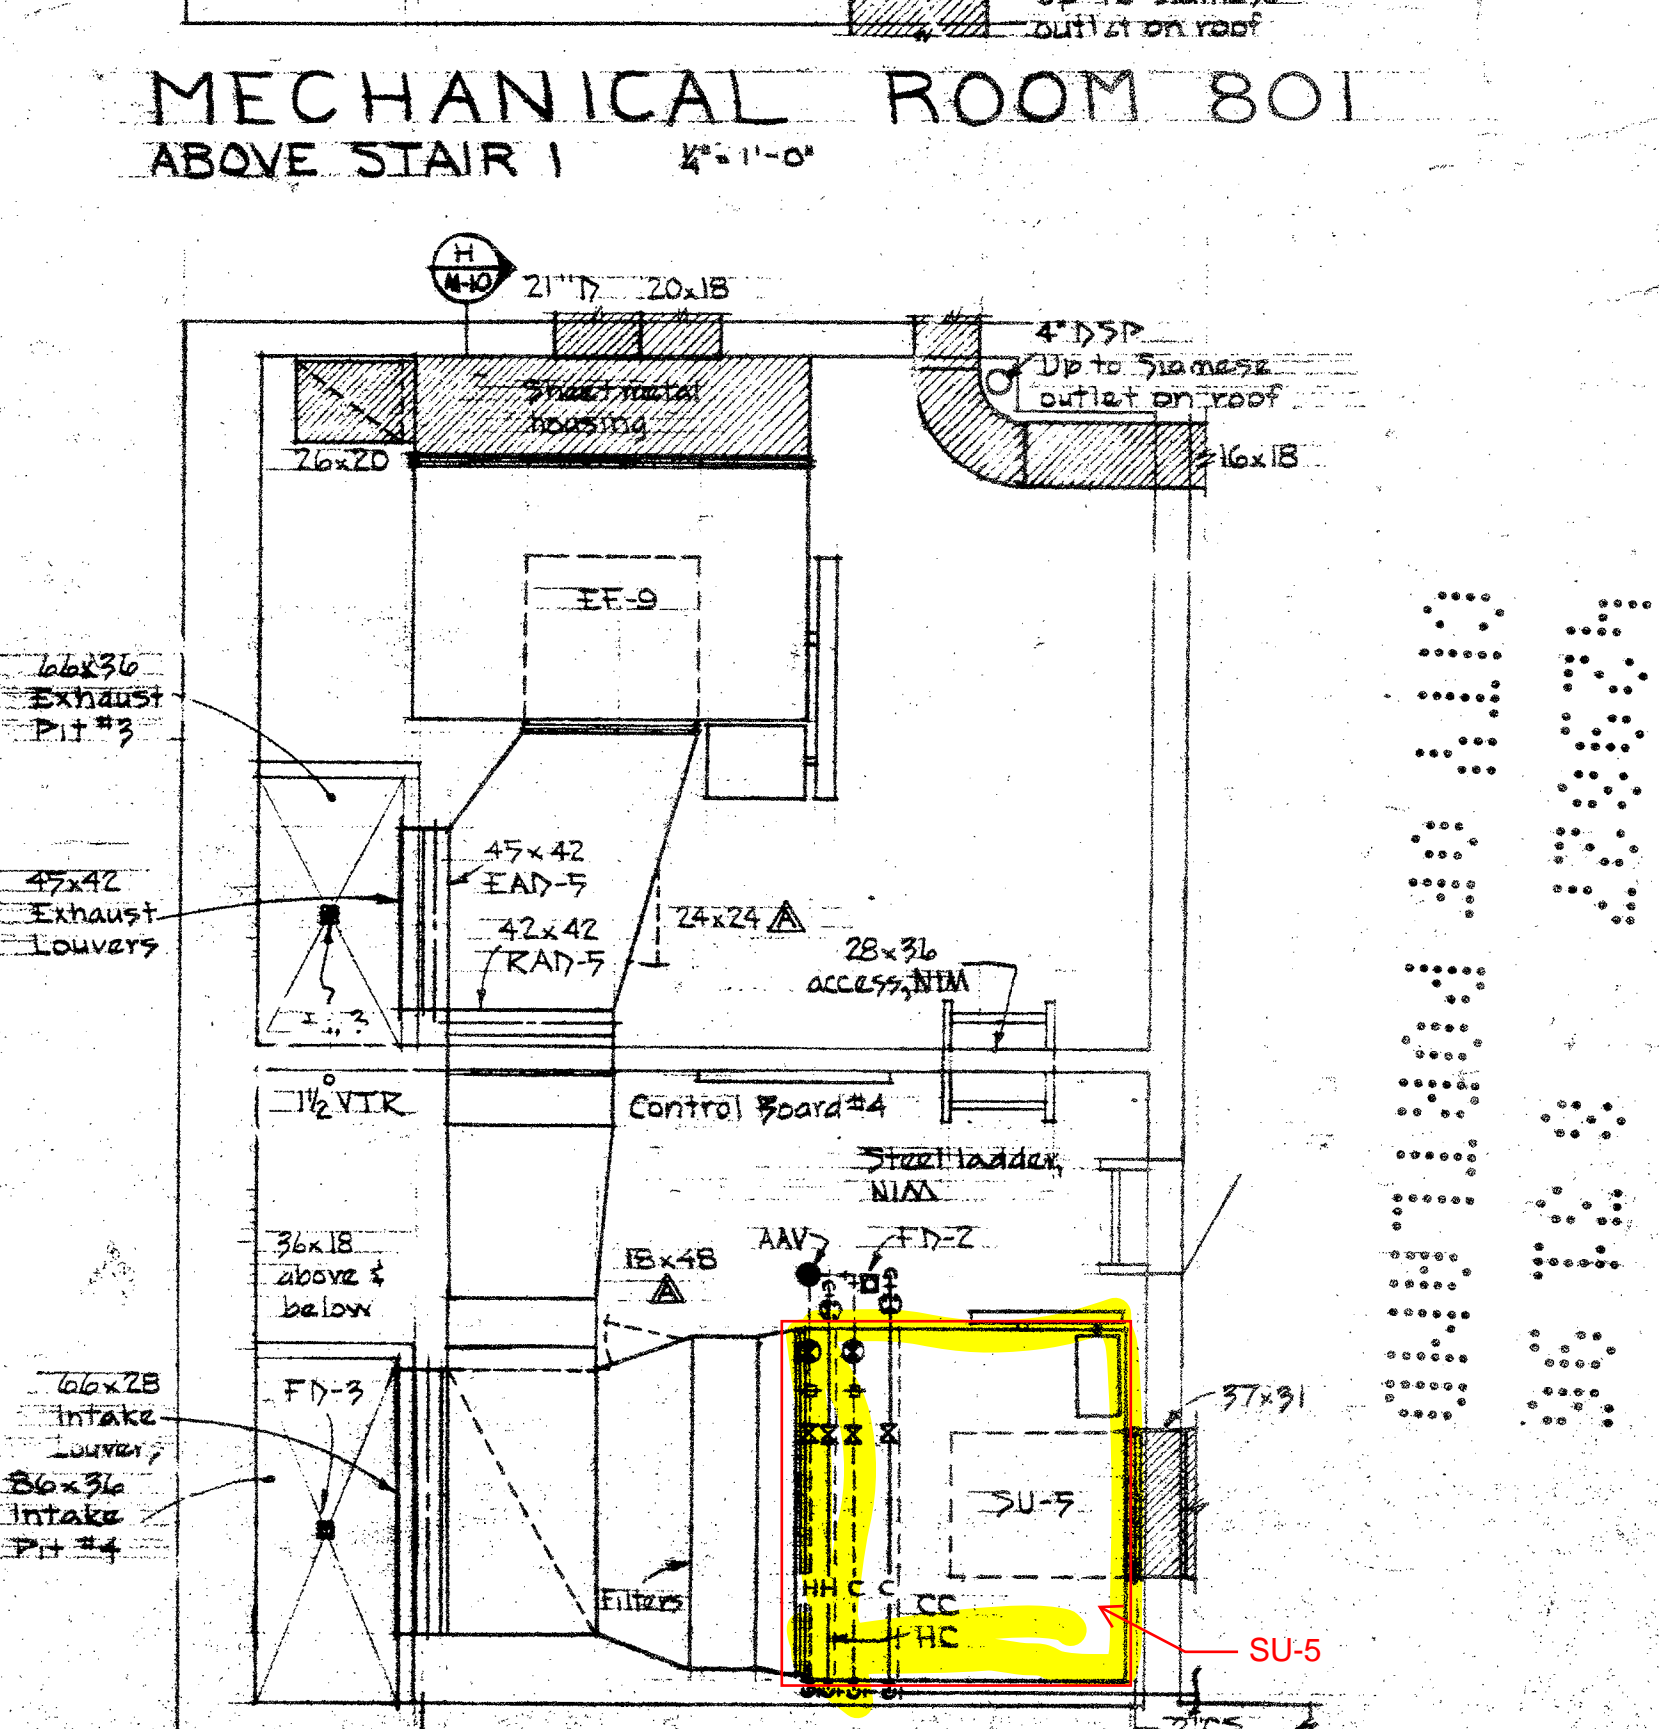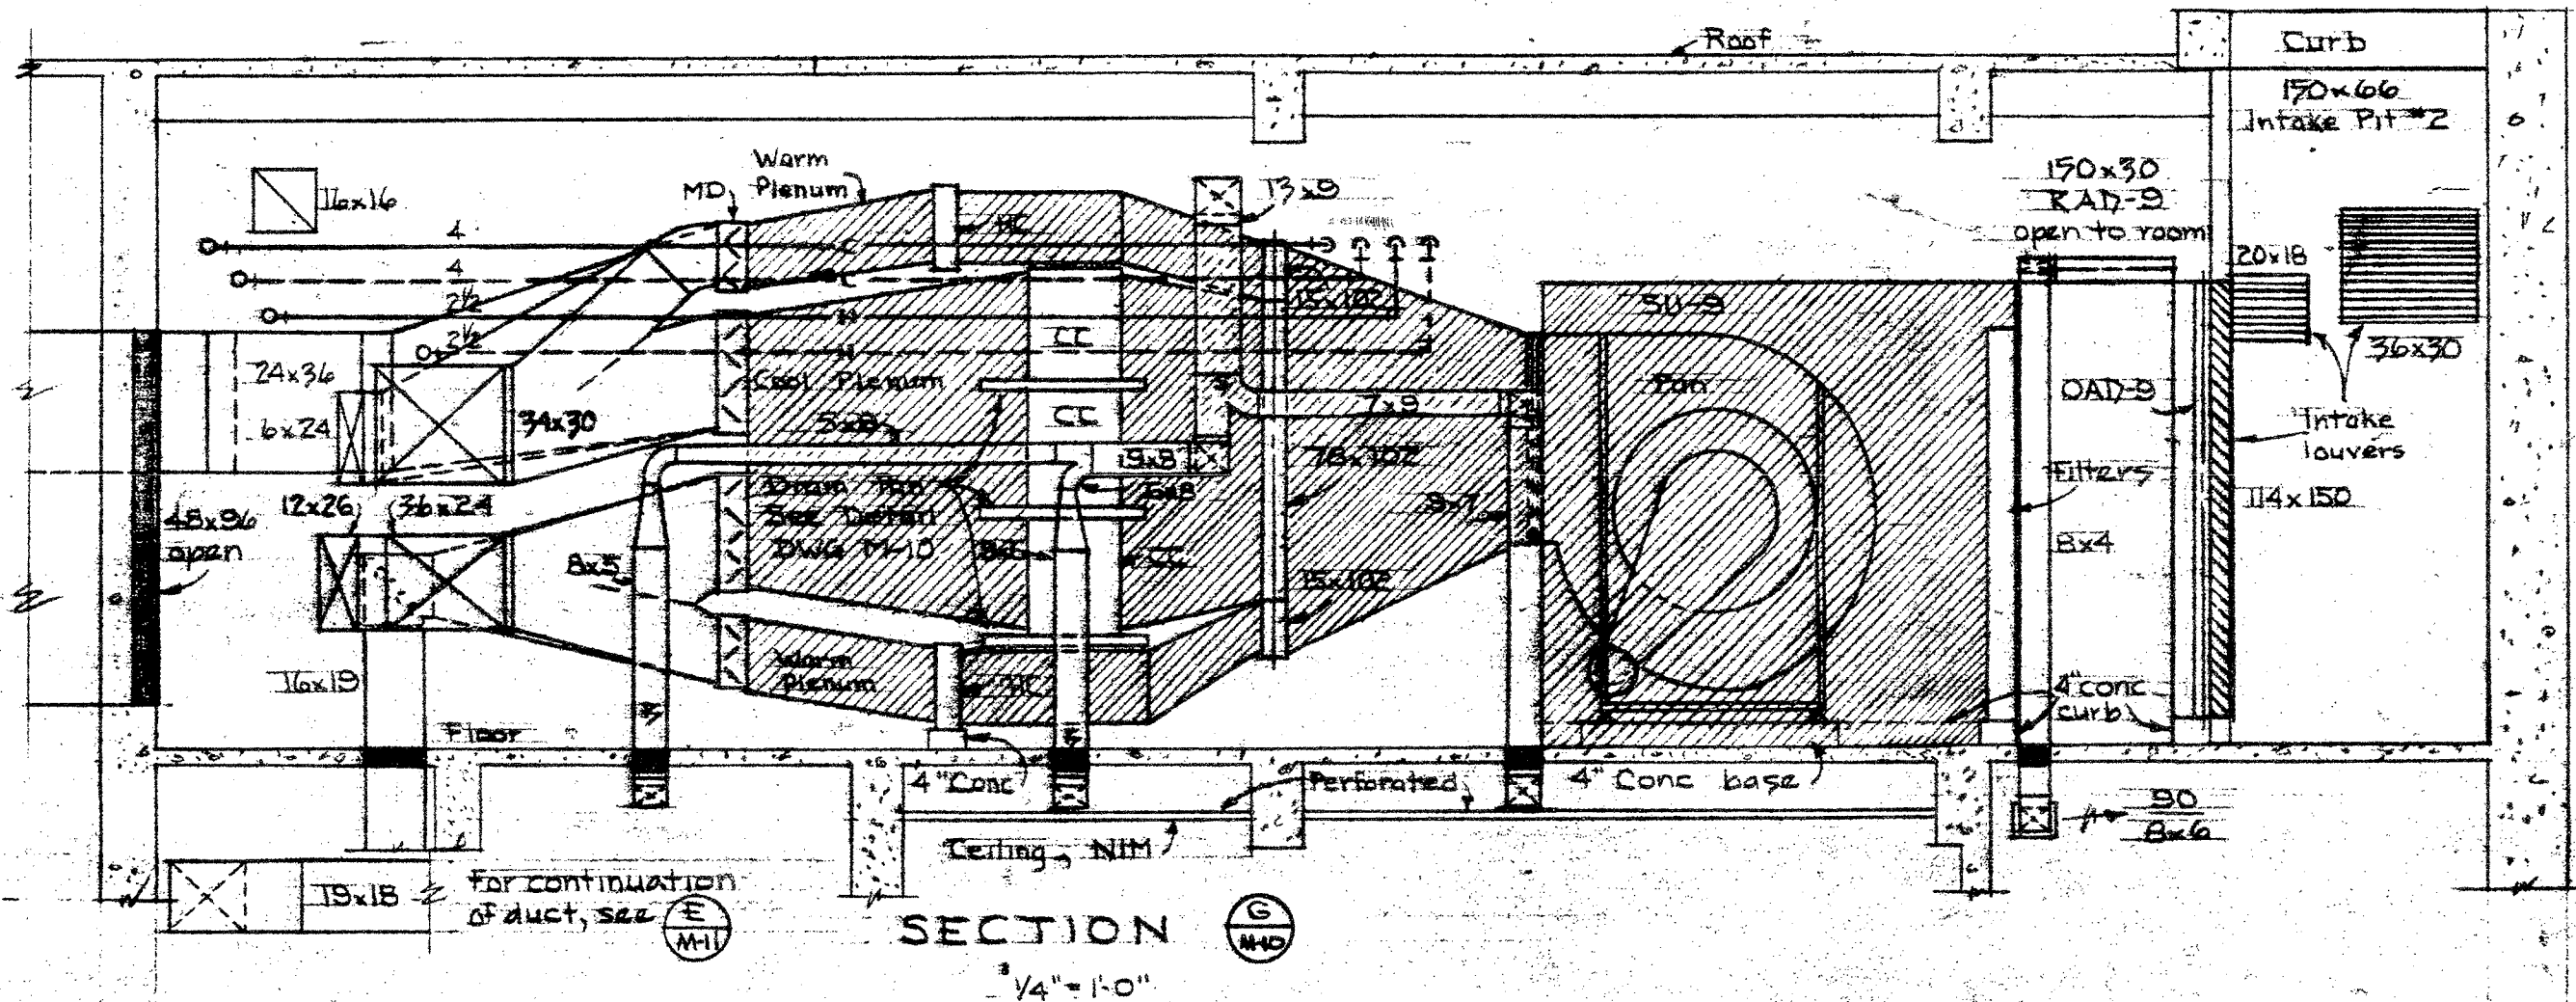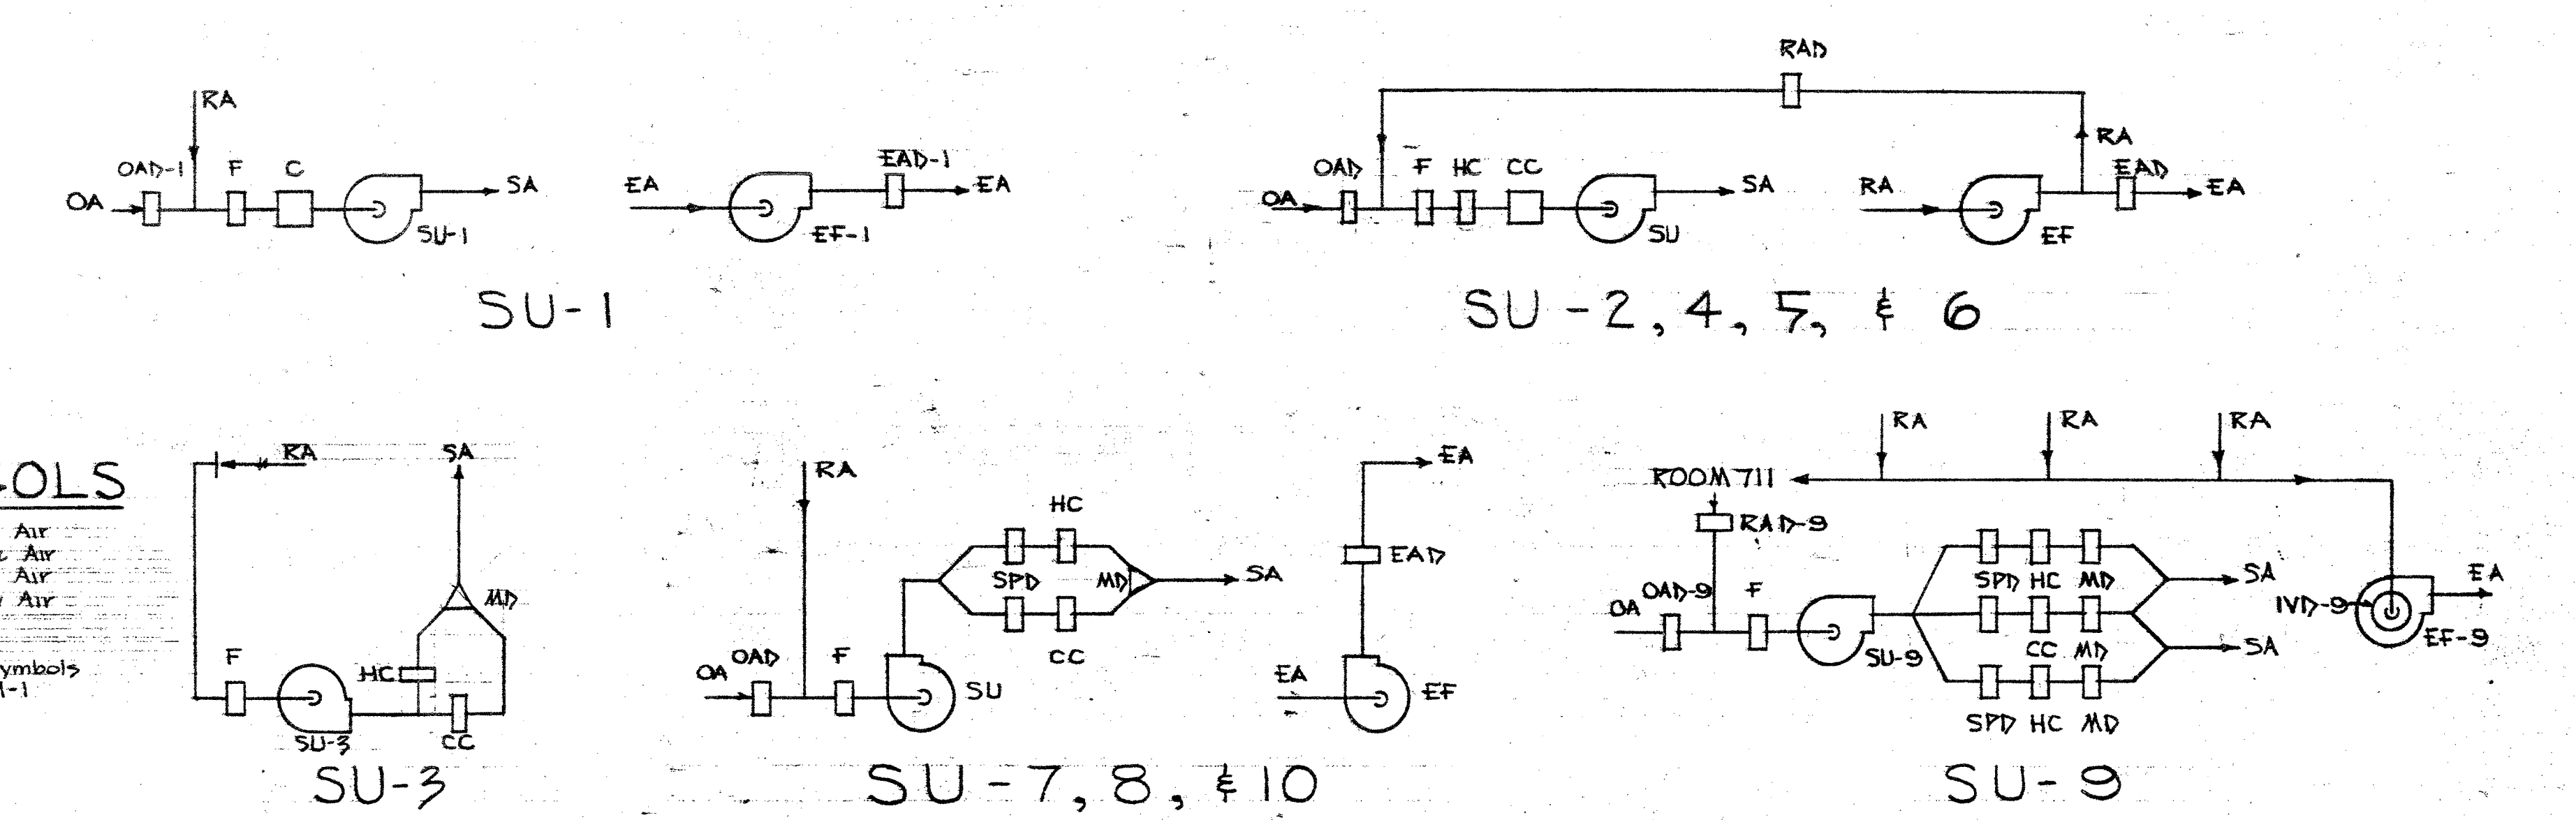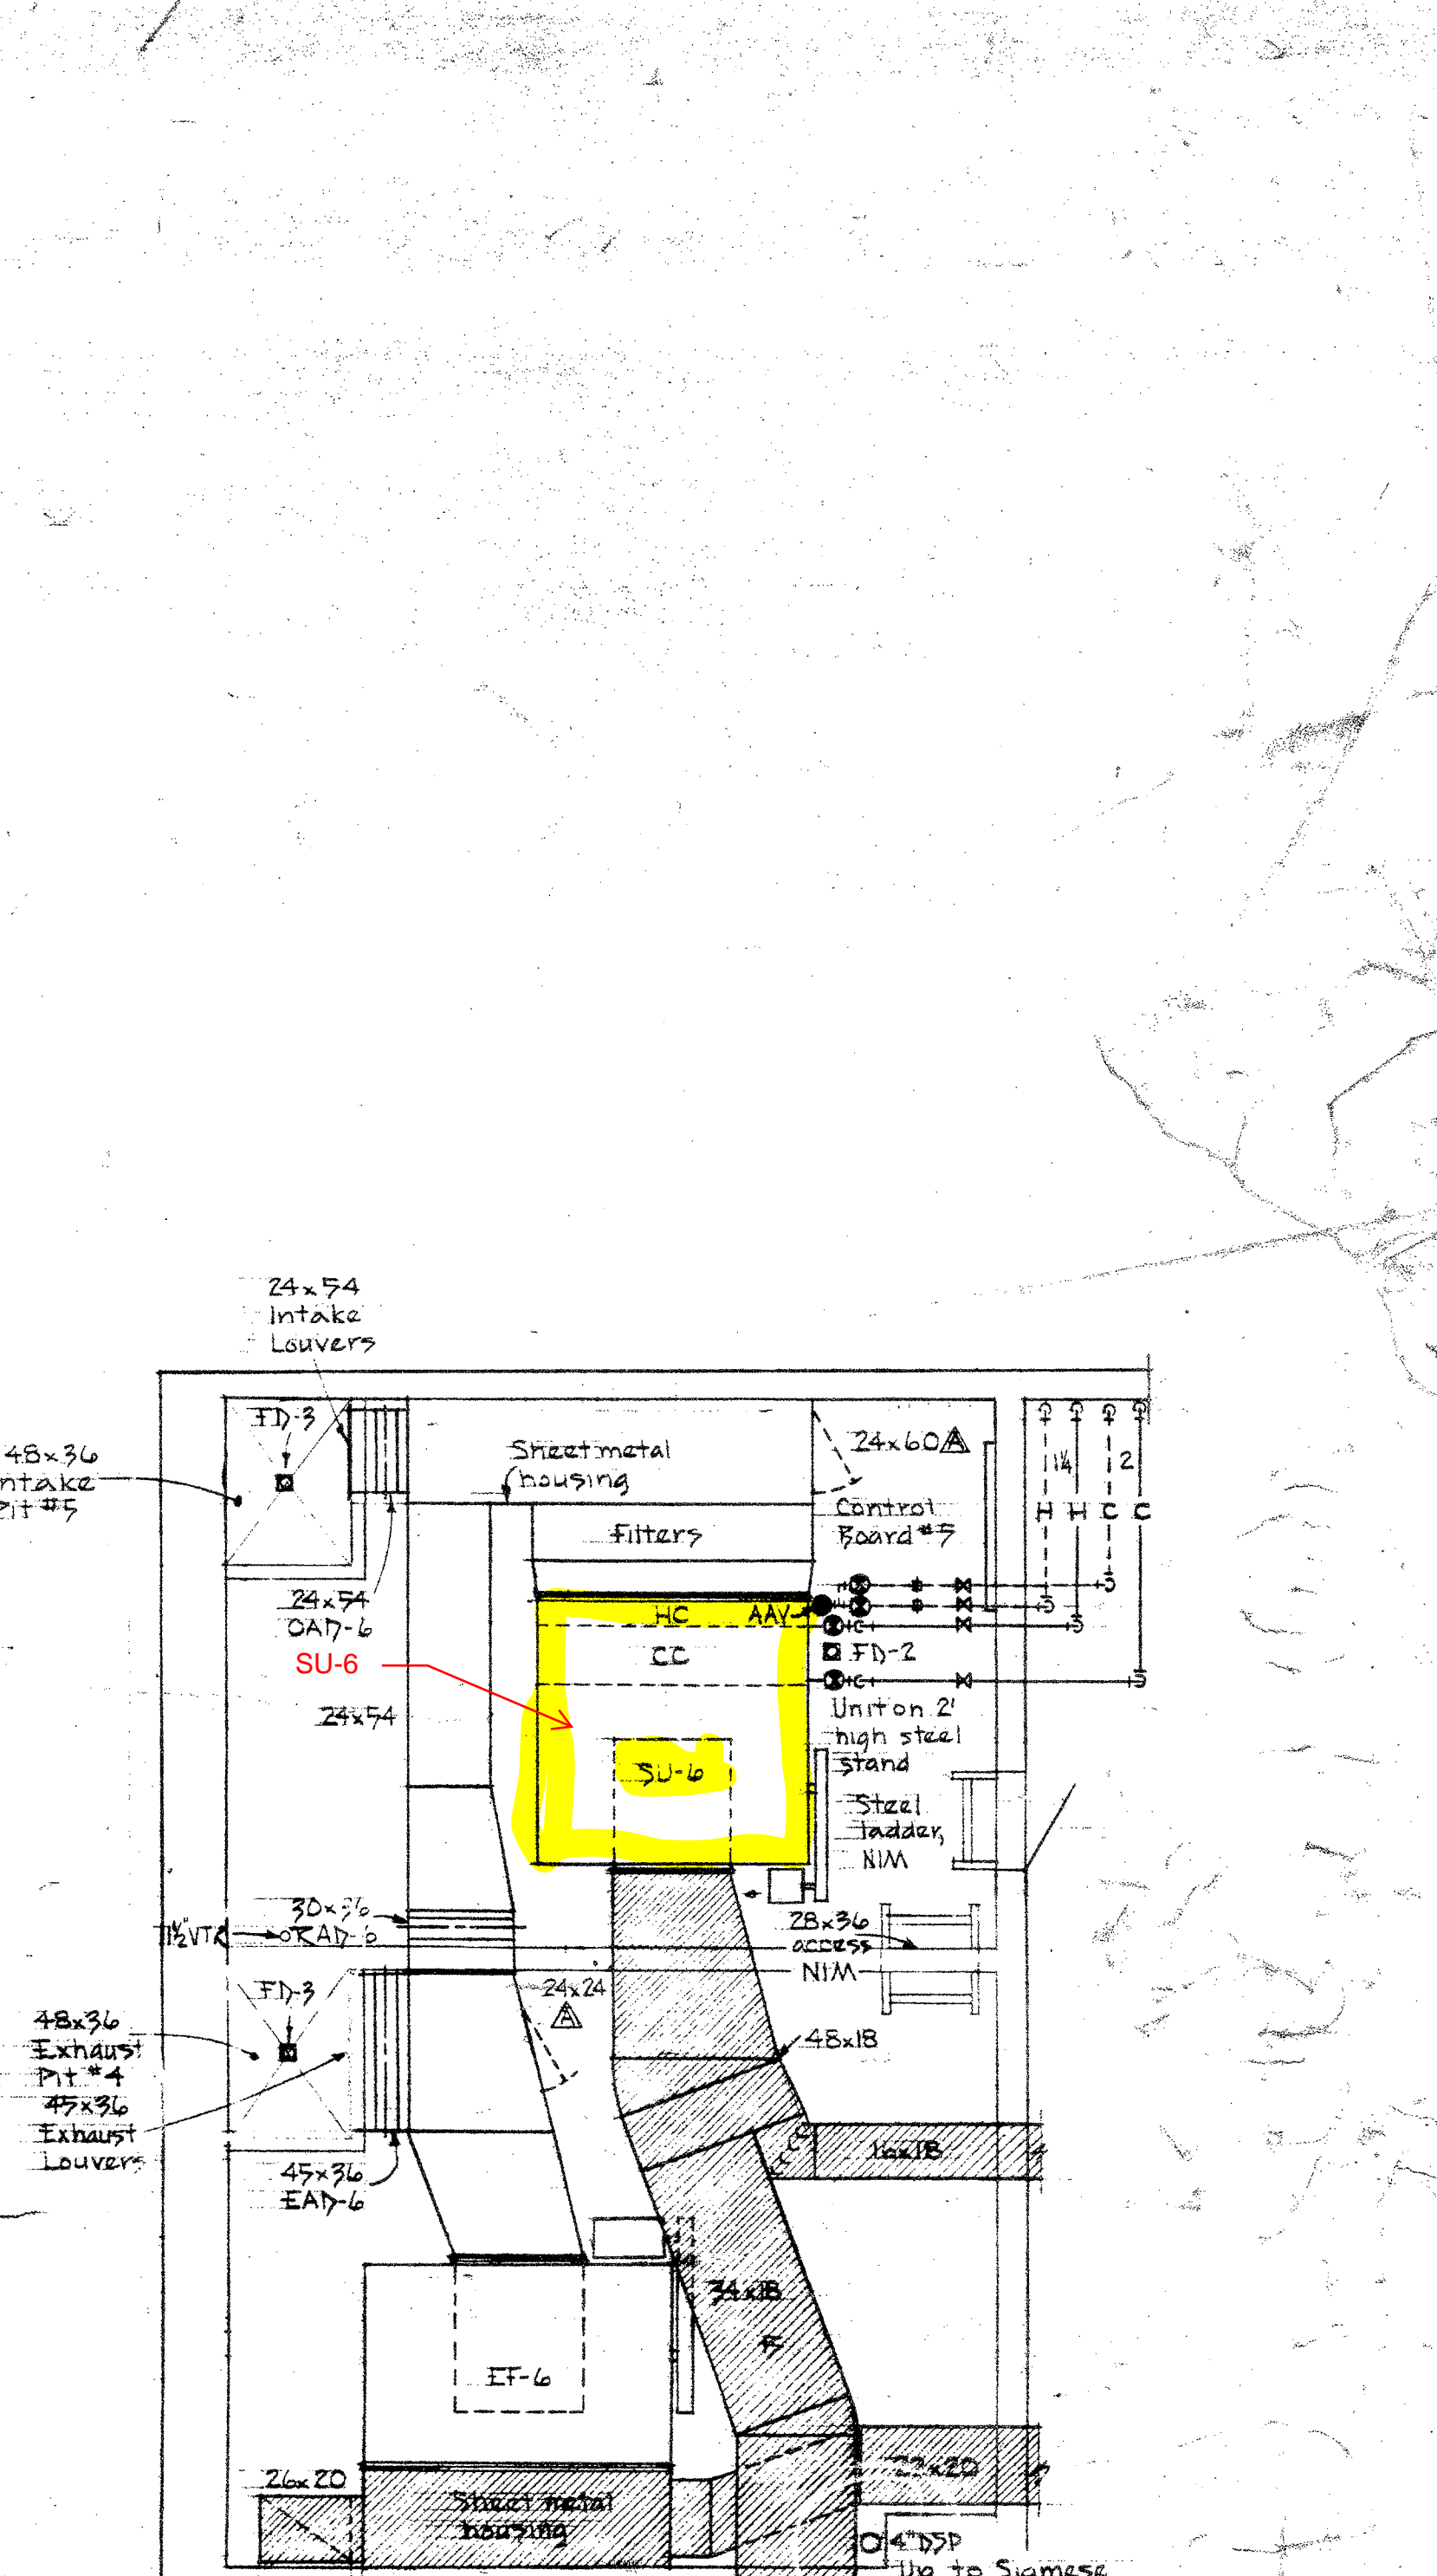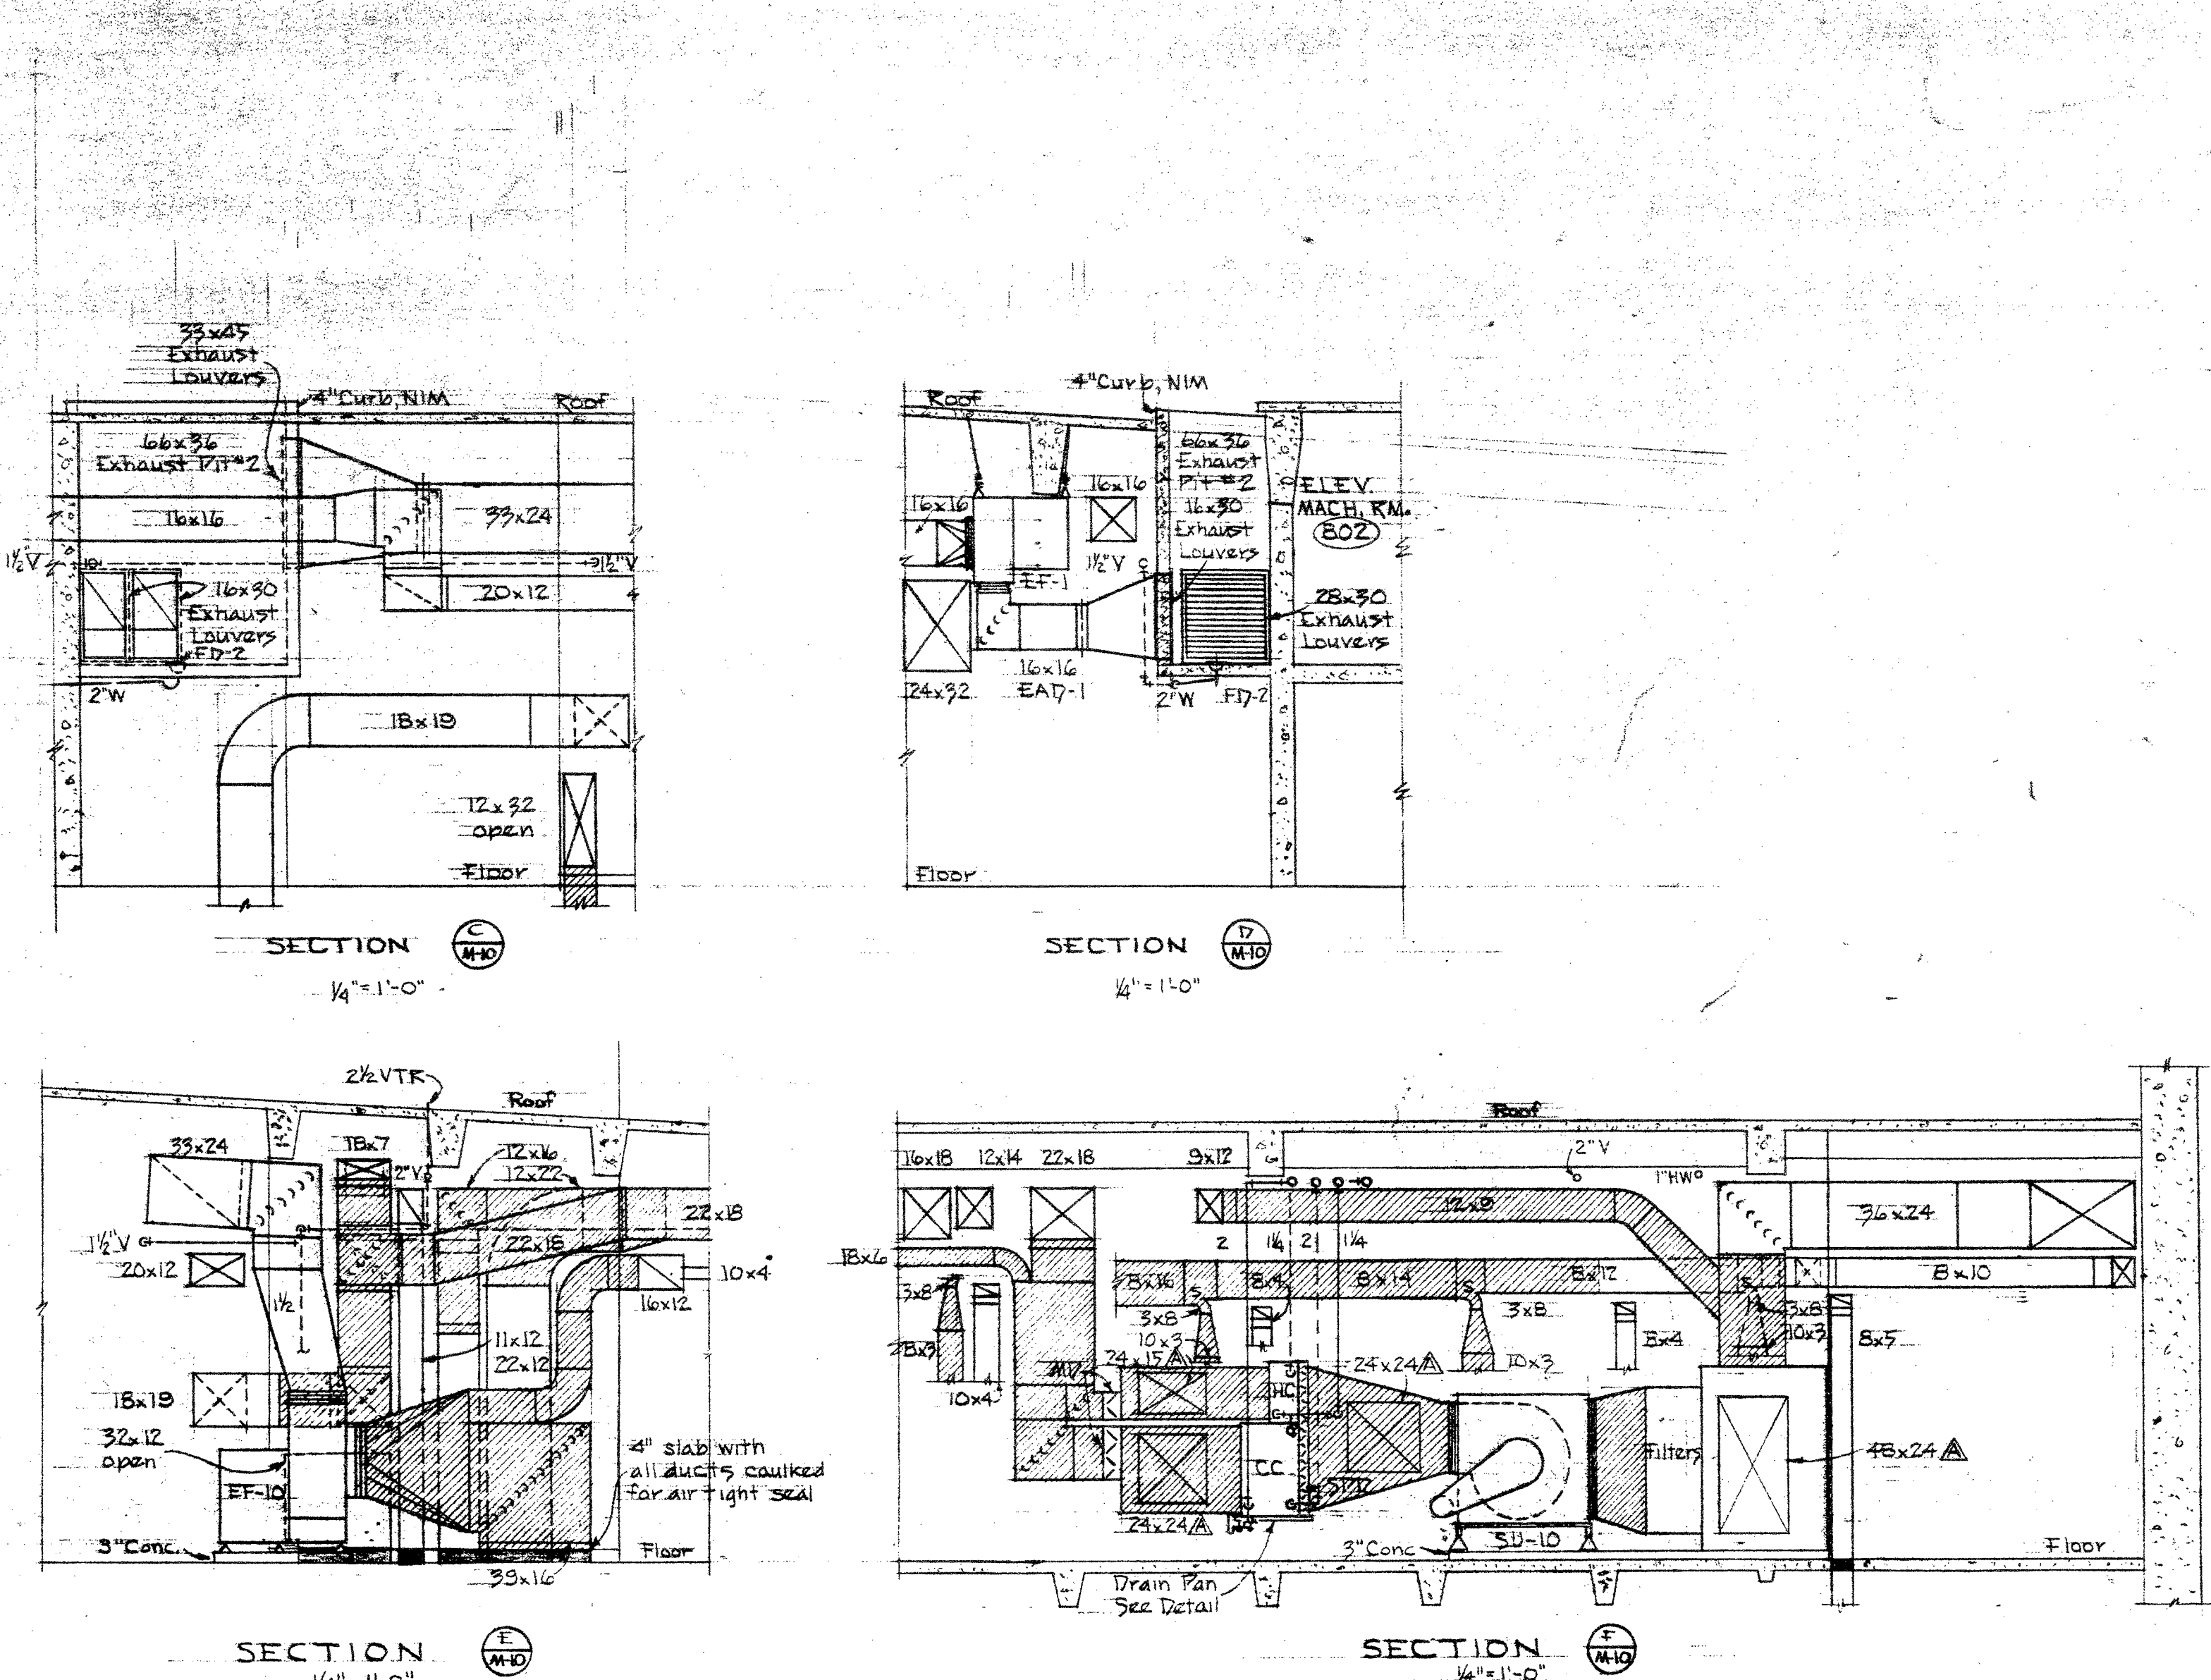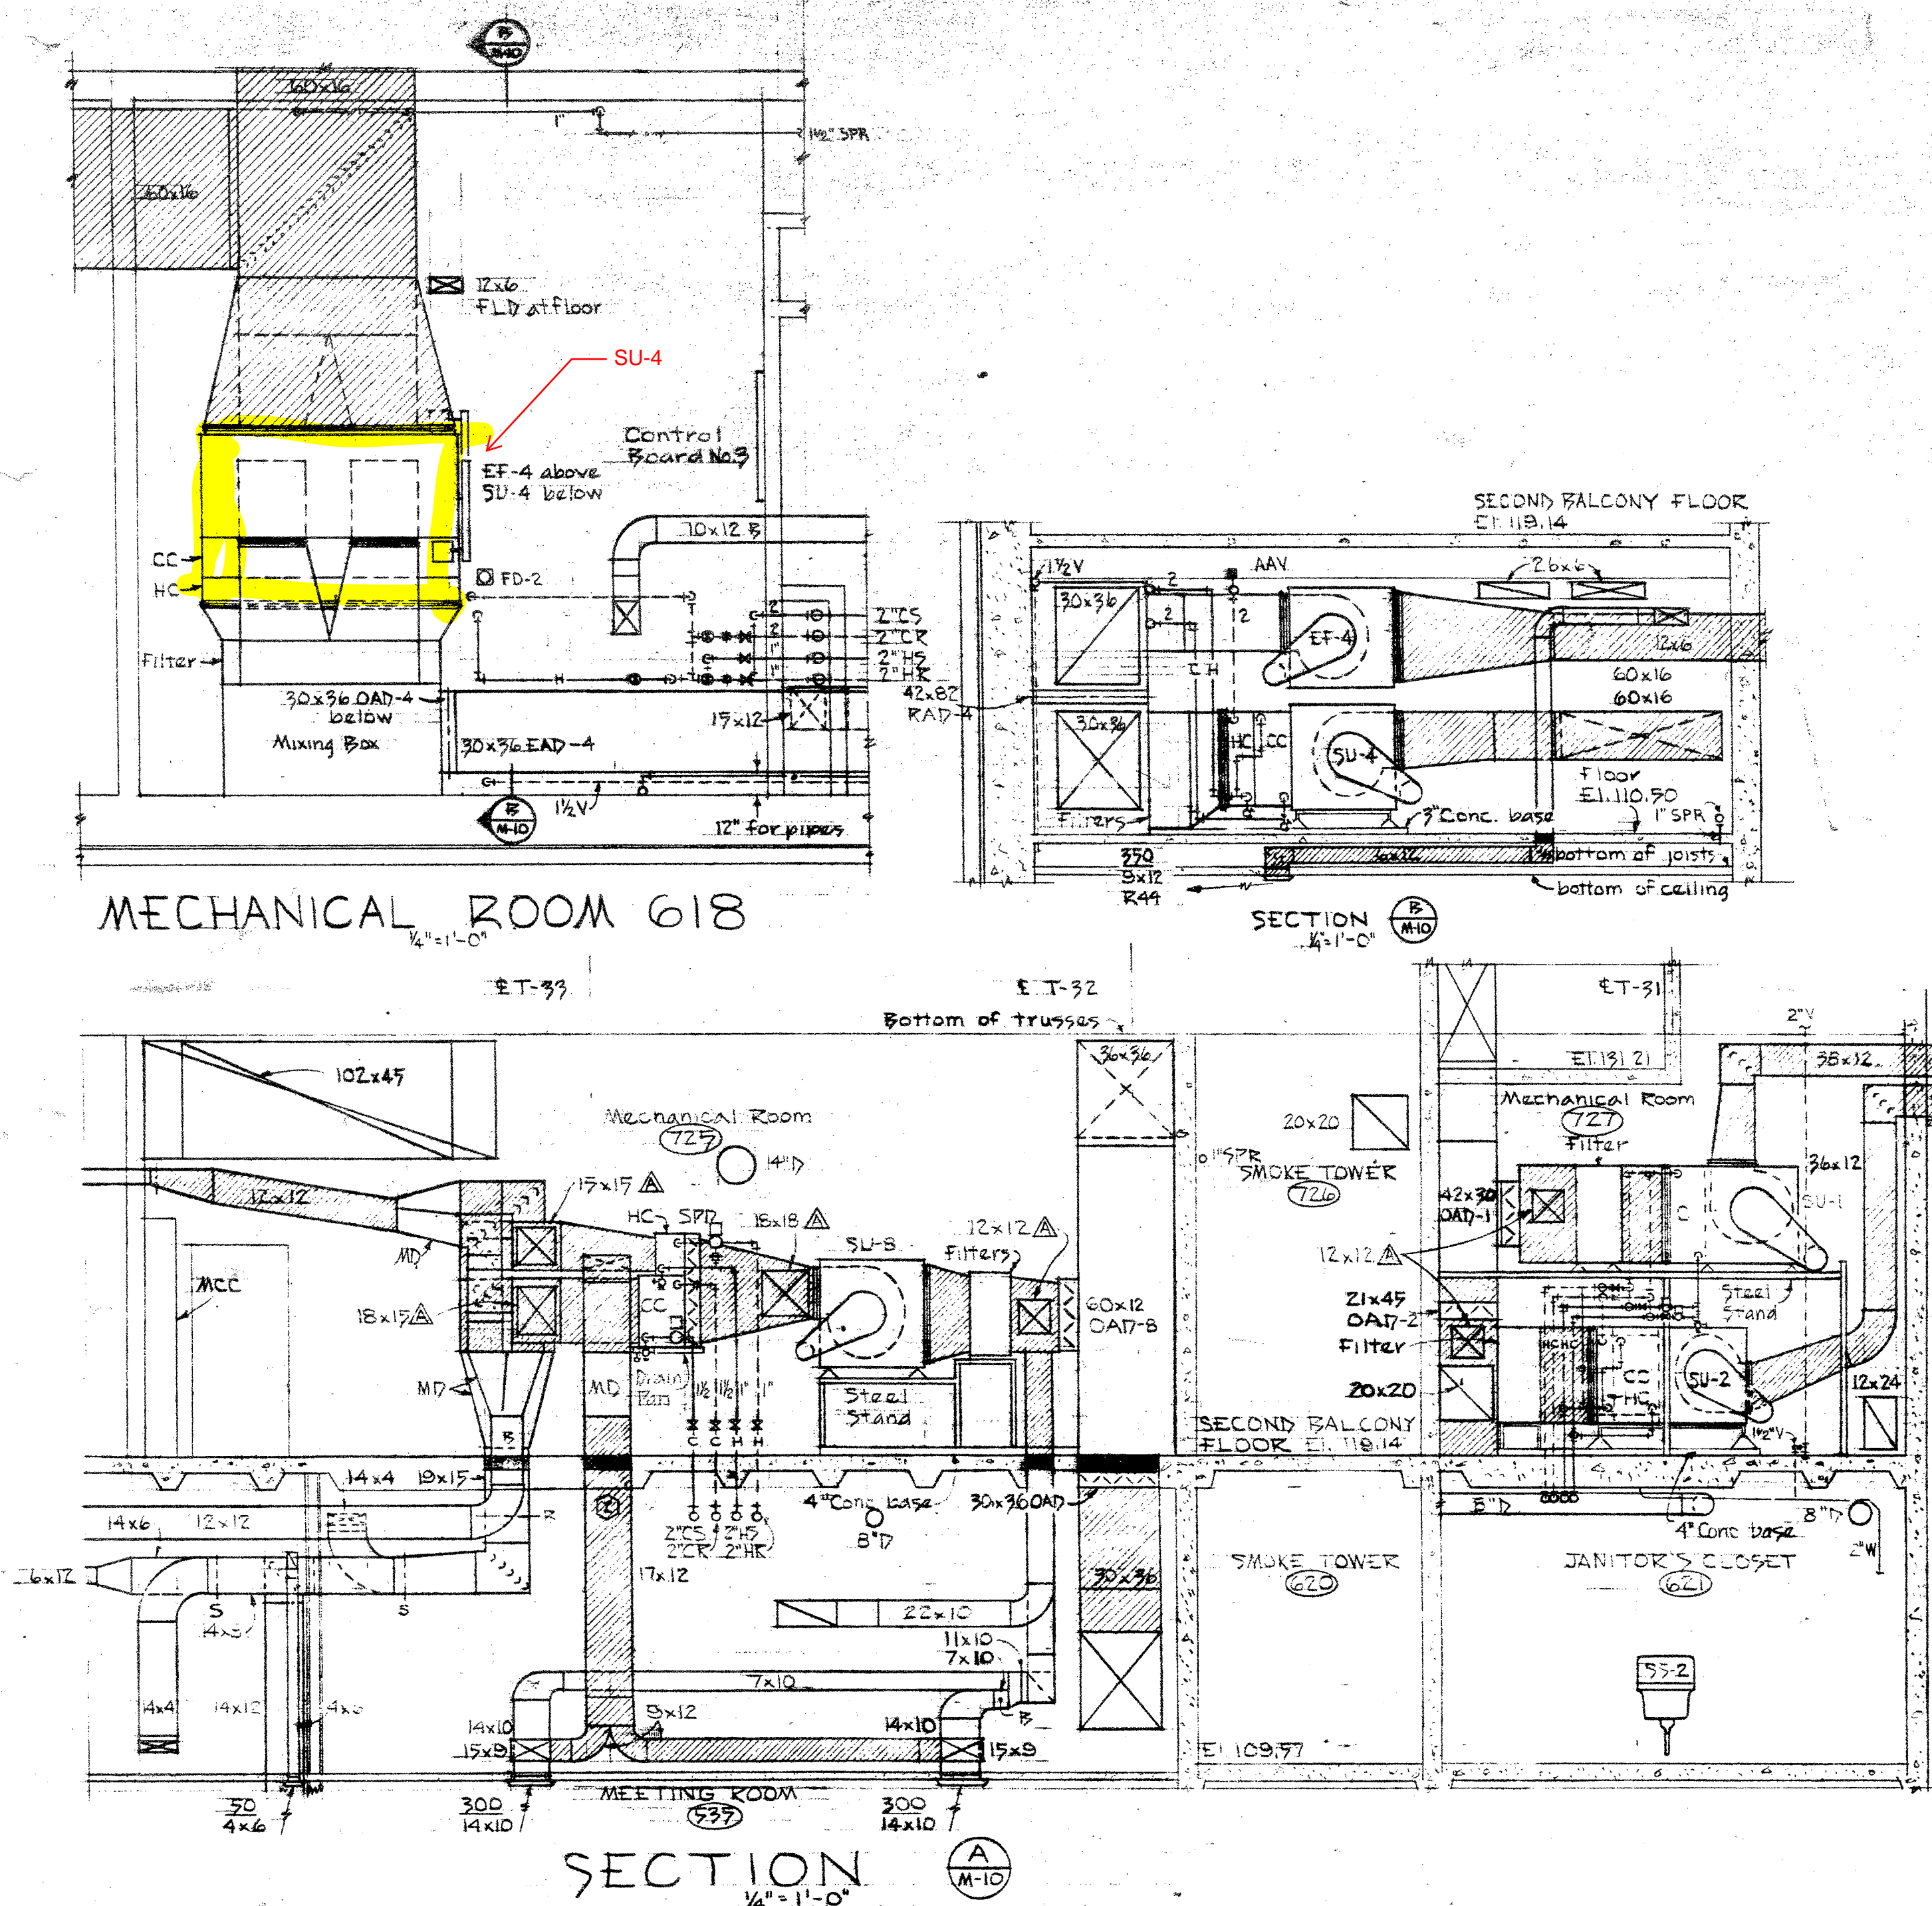

**MECHANICAL ROOM DETAILS**

**REBUILDING OF PORTLAND CIVIC AUDITORIUM**  
 100 N. THIRD AVENUE & CLAY STREET  
 CITY OF PORTLAND, OREGON

**ARCHITECTS**  
 RICHARD H. HARTFORD & ASSOCIATES  
 100 N. THIRD AVENUE & CLAY STREET  
 PORTLAND, OREGON



**MECHANICAL ENGINEERS**  
 RICHARD H. HARTFORD & ASSOCIATES  
 100 N. THIRD AVENUE & CLAY STREET  
 PORTLAND, OREGON

**MECHANICAL ENGINEERS**  
 RICHARD H. HARTFORD & ASSOCIATES  
 100 N. THIRD AVENUE & CLAY STREET  
 PORTLAND, OREGON




**MECHANICAL ENGINEERS**  
 RICHARD H. HARTFORD & ASSOCIATES  
 100 N. THIRD AVENUE & CLAY STREET  
 PORTLAND, OREGON





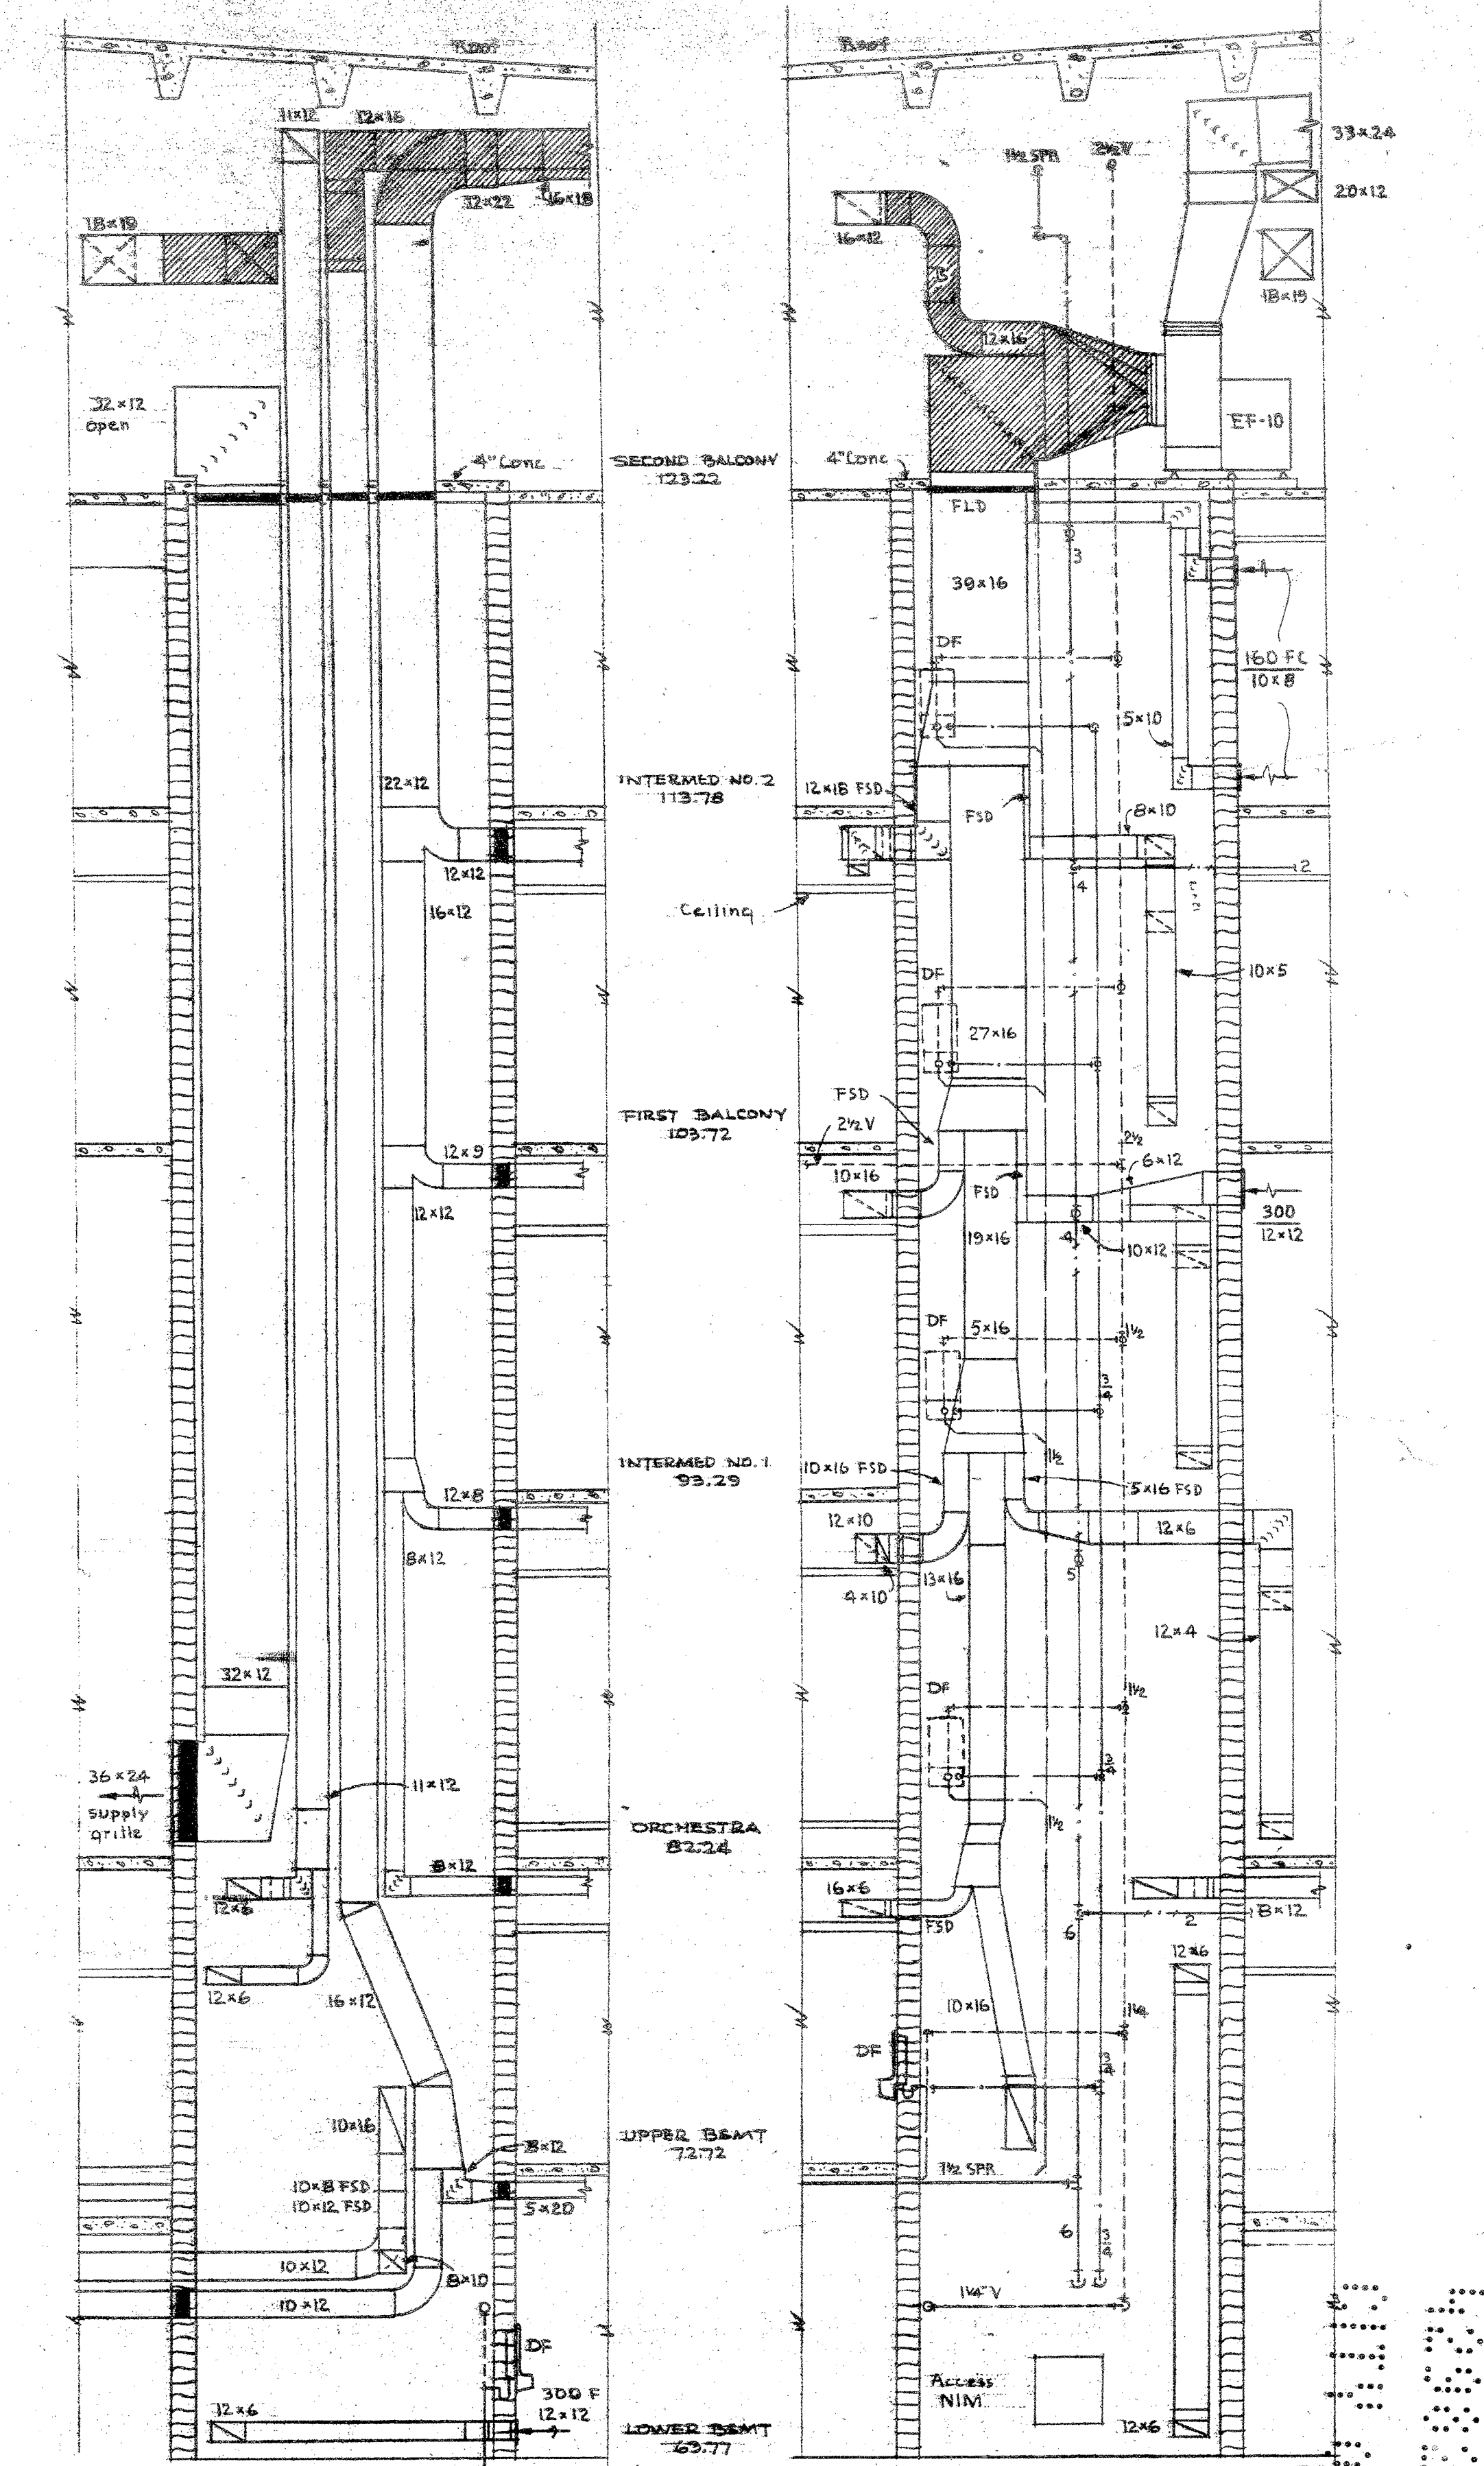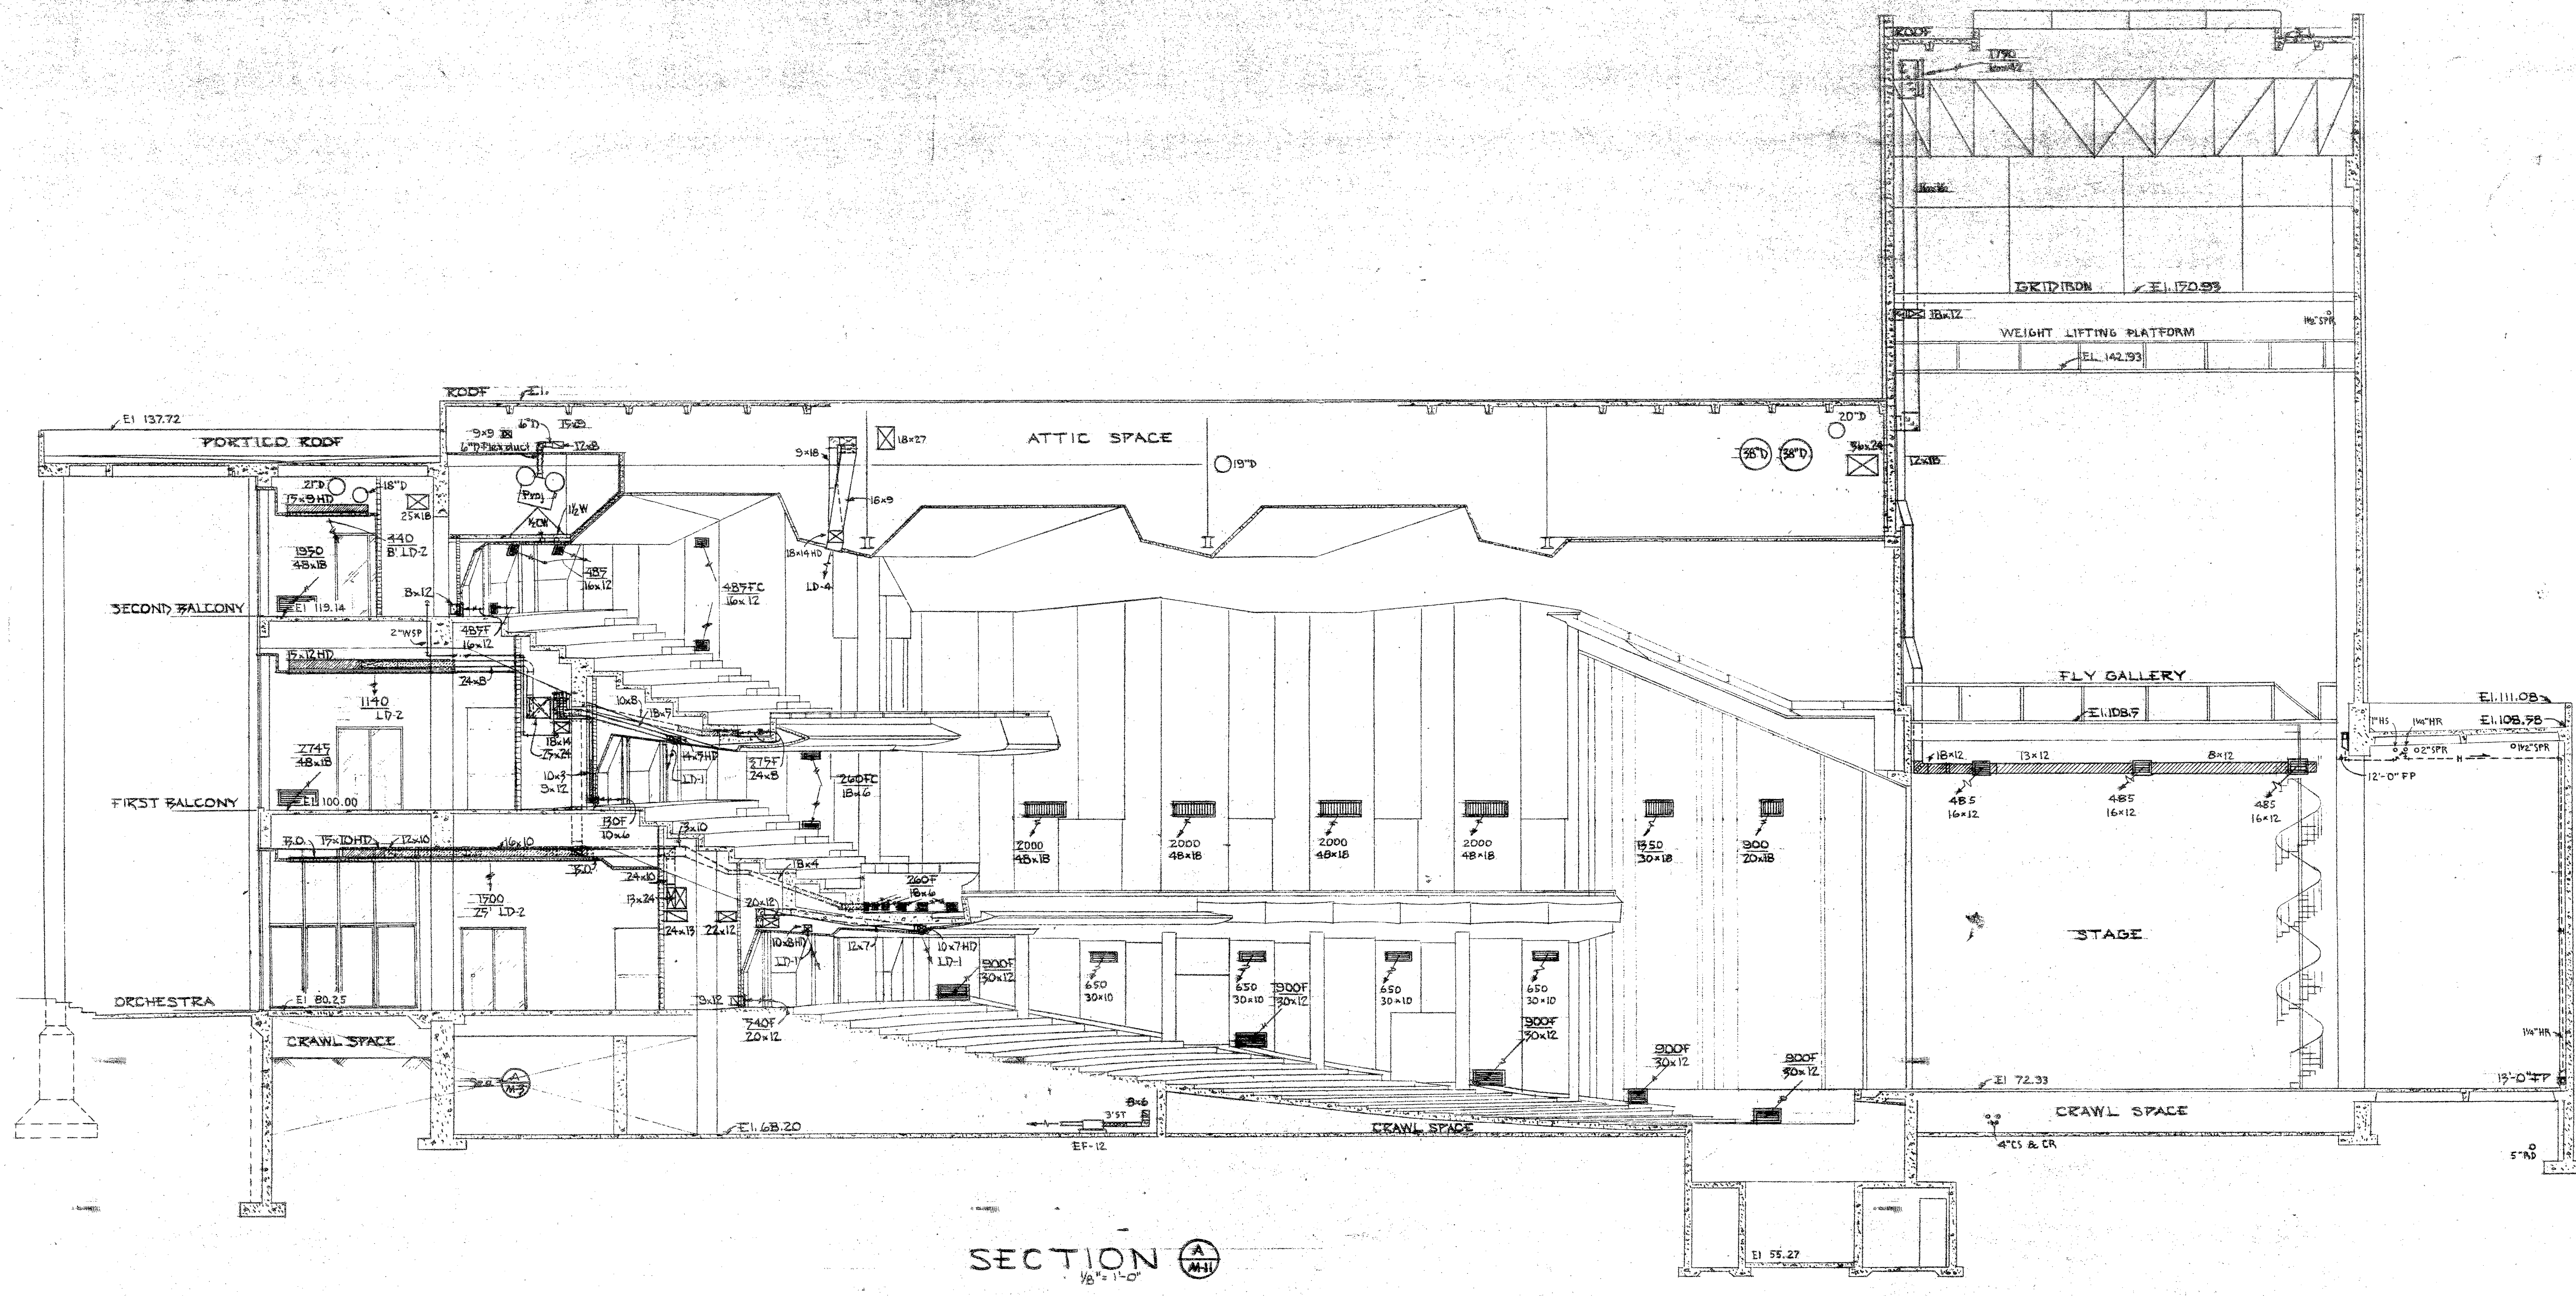

DUCT SHAFT DETAILS - DRESSING ROOM AREA  
1/4" = 1'-0"

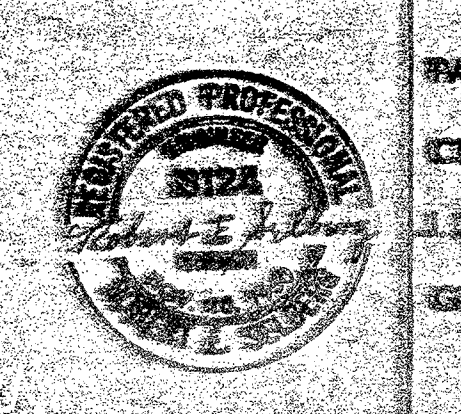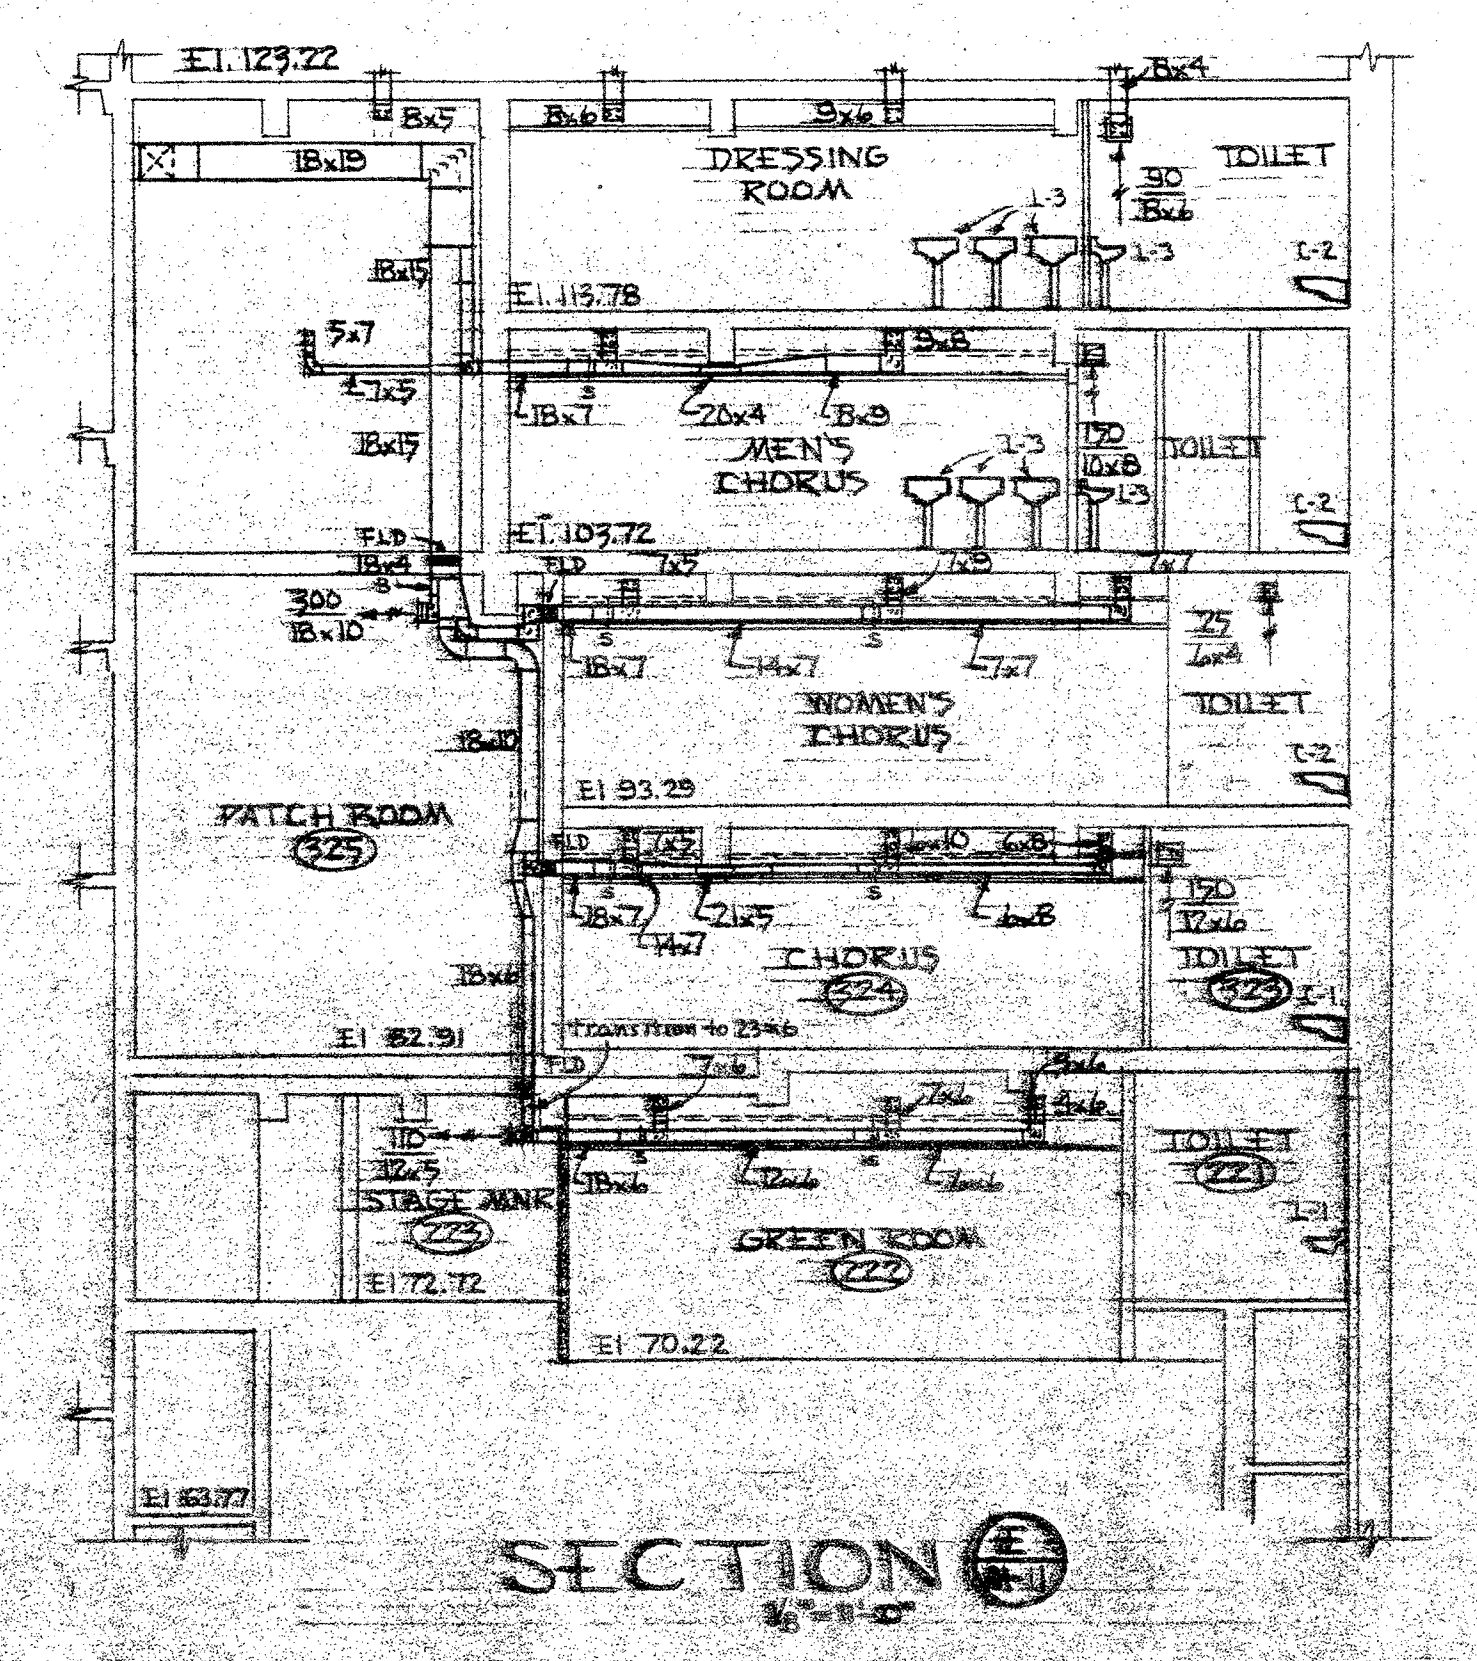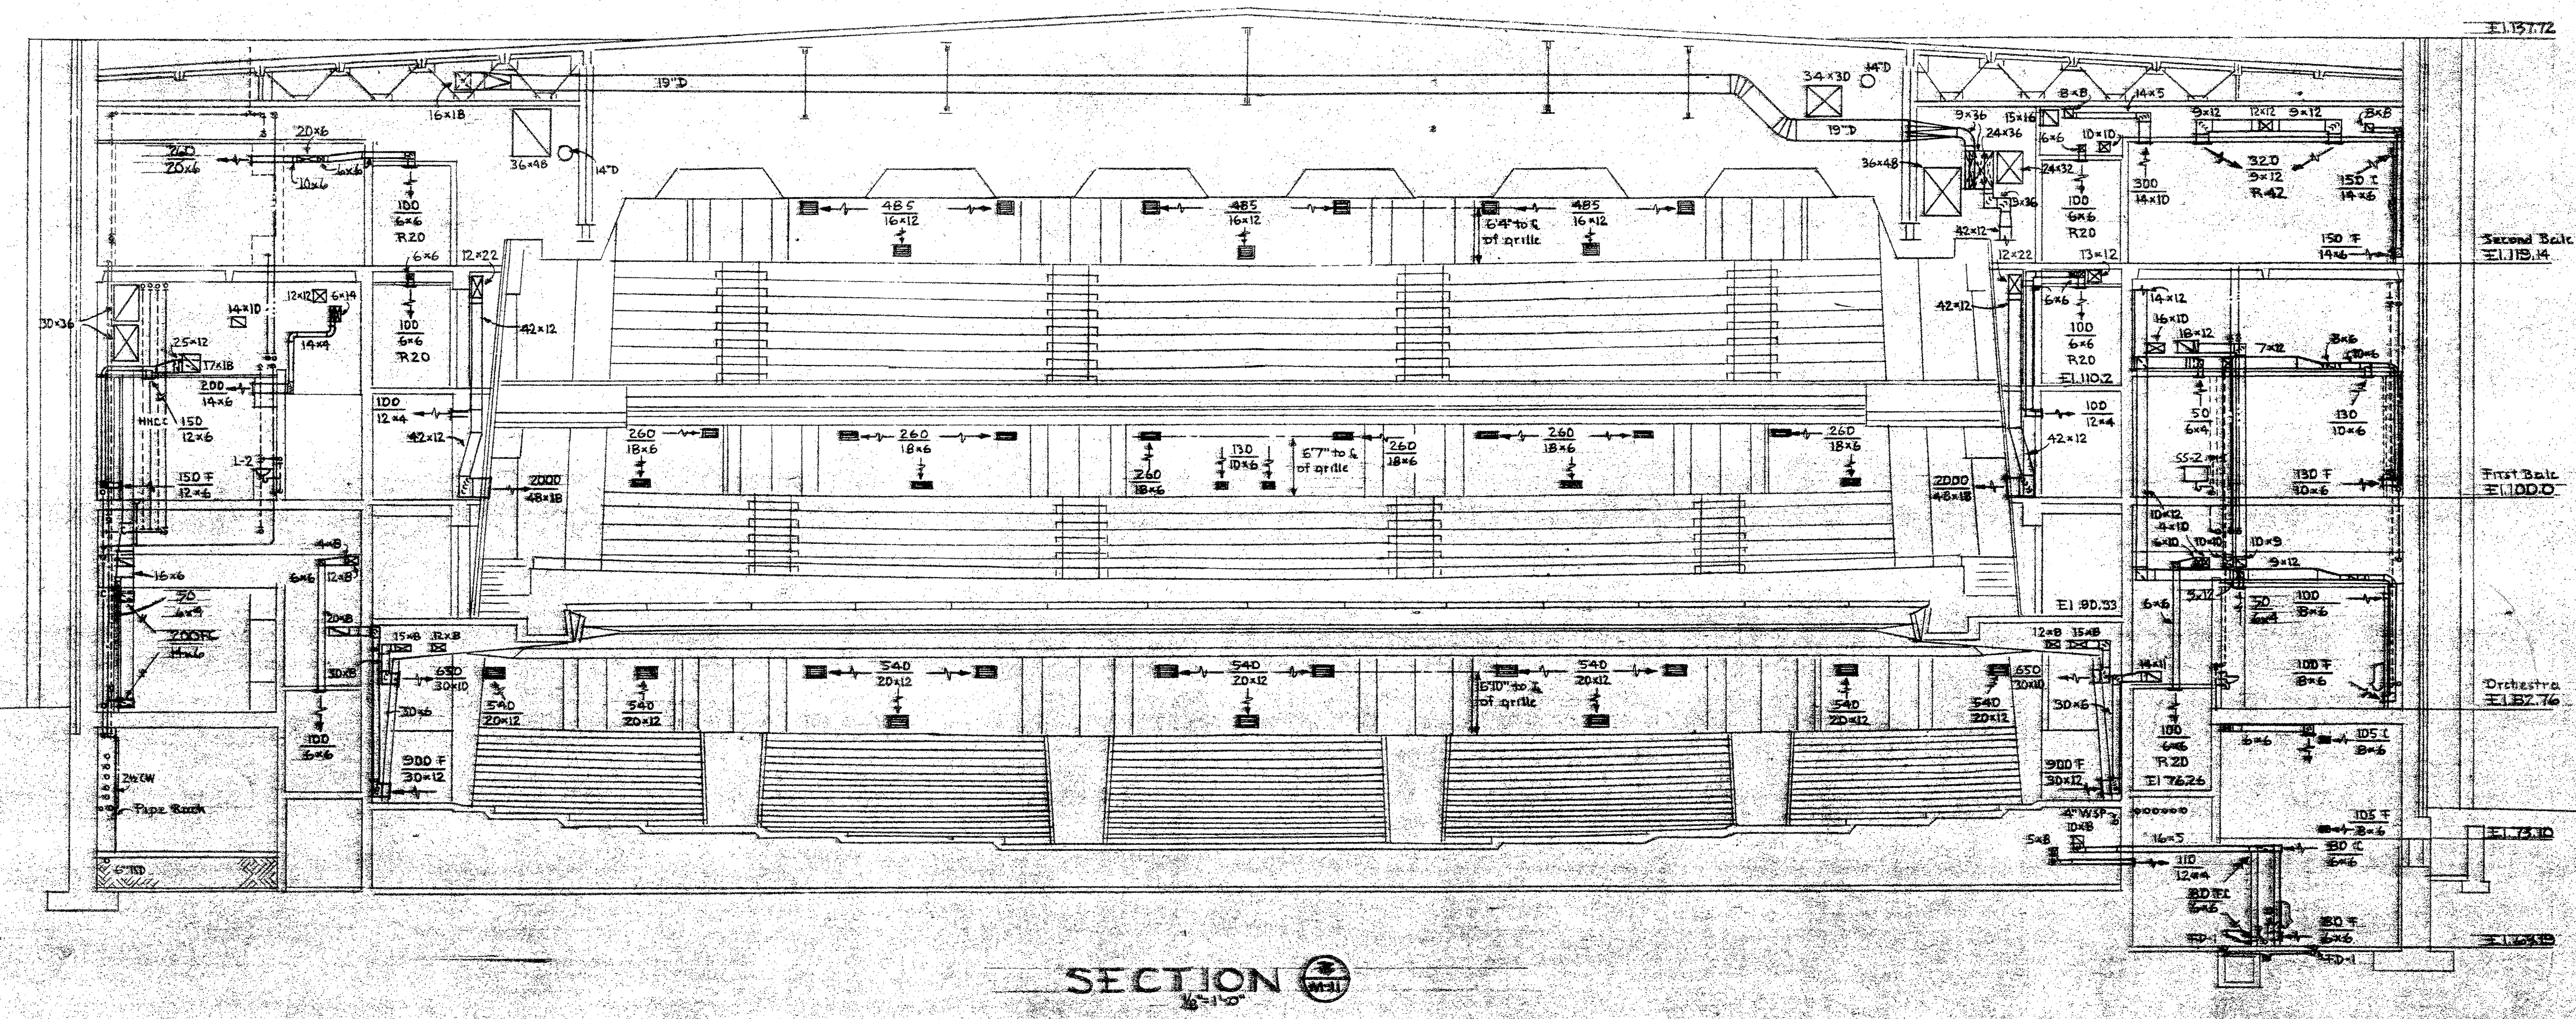


**MECHANICAL BUILDING SECTIONS AND DETAILS**

**REBUILDING OF PORTLAND CIVIC AUDITORIUM**  
 3 W. THIRD AVENUE & CLAY STREET  
 PORTLAND, OREGON  
 CITY OF PORTLAND RECORDS

**ARCHITECTS**  
 STANIOR, BILES, MAGUIRE & CHURCH  
 308 S. W. STARK ST., PORTLAND 4, OREGON  
 PHONE 2-6329

**REGISTERED PROFESSIONAL ENGINEERS**  
 M.H.I.

**REGISTERED ARCHITECT**  
 KEITH MAGUIRE  
 STATE OF OREGON

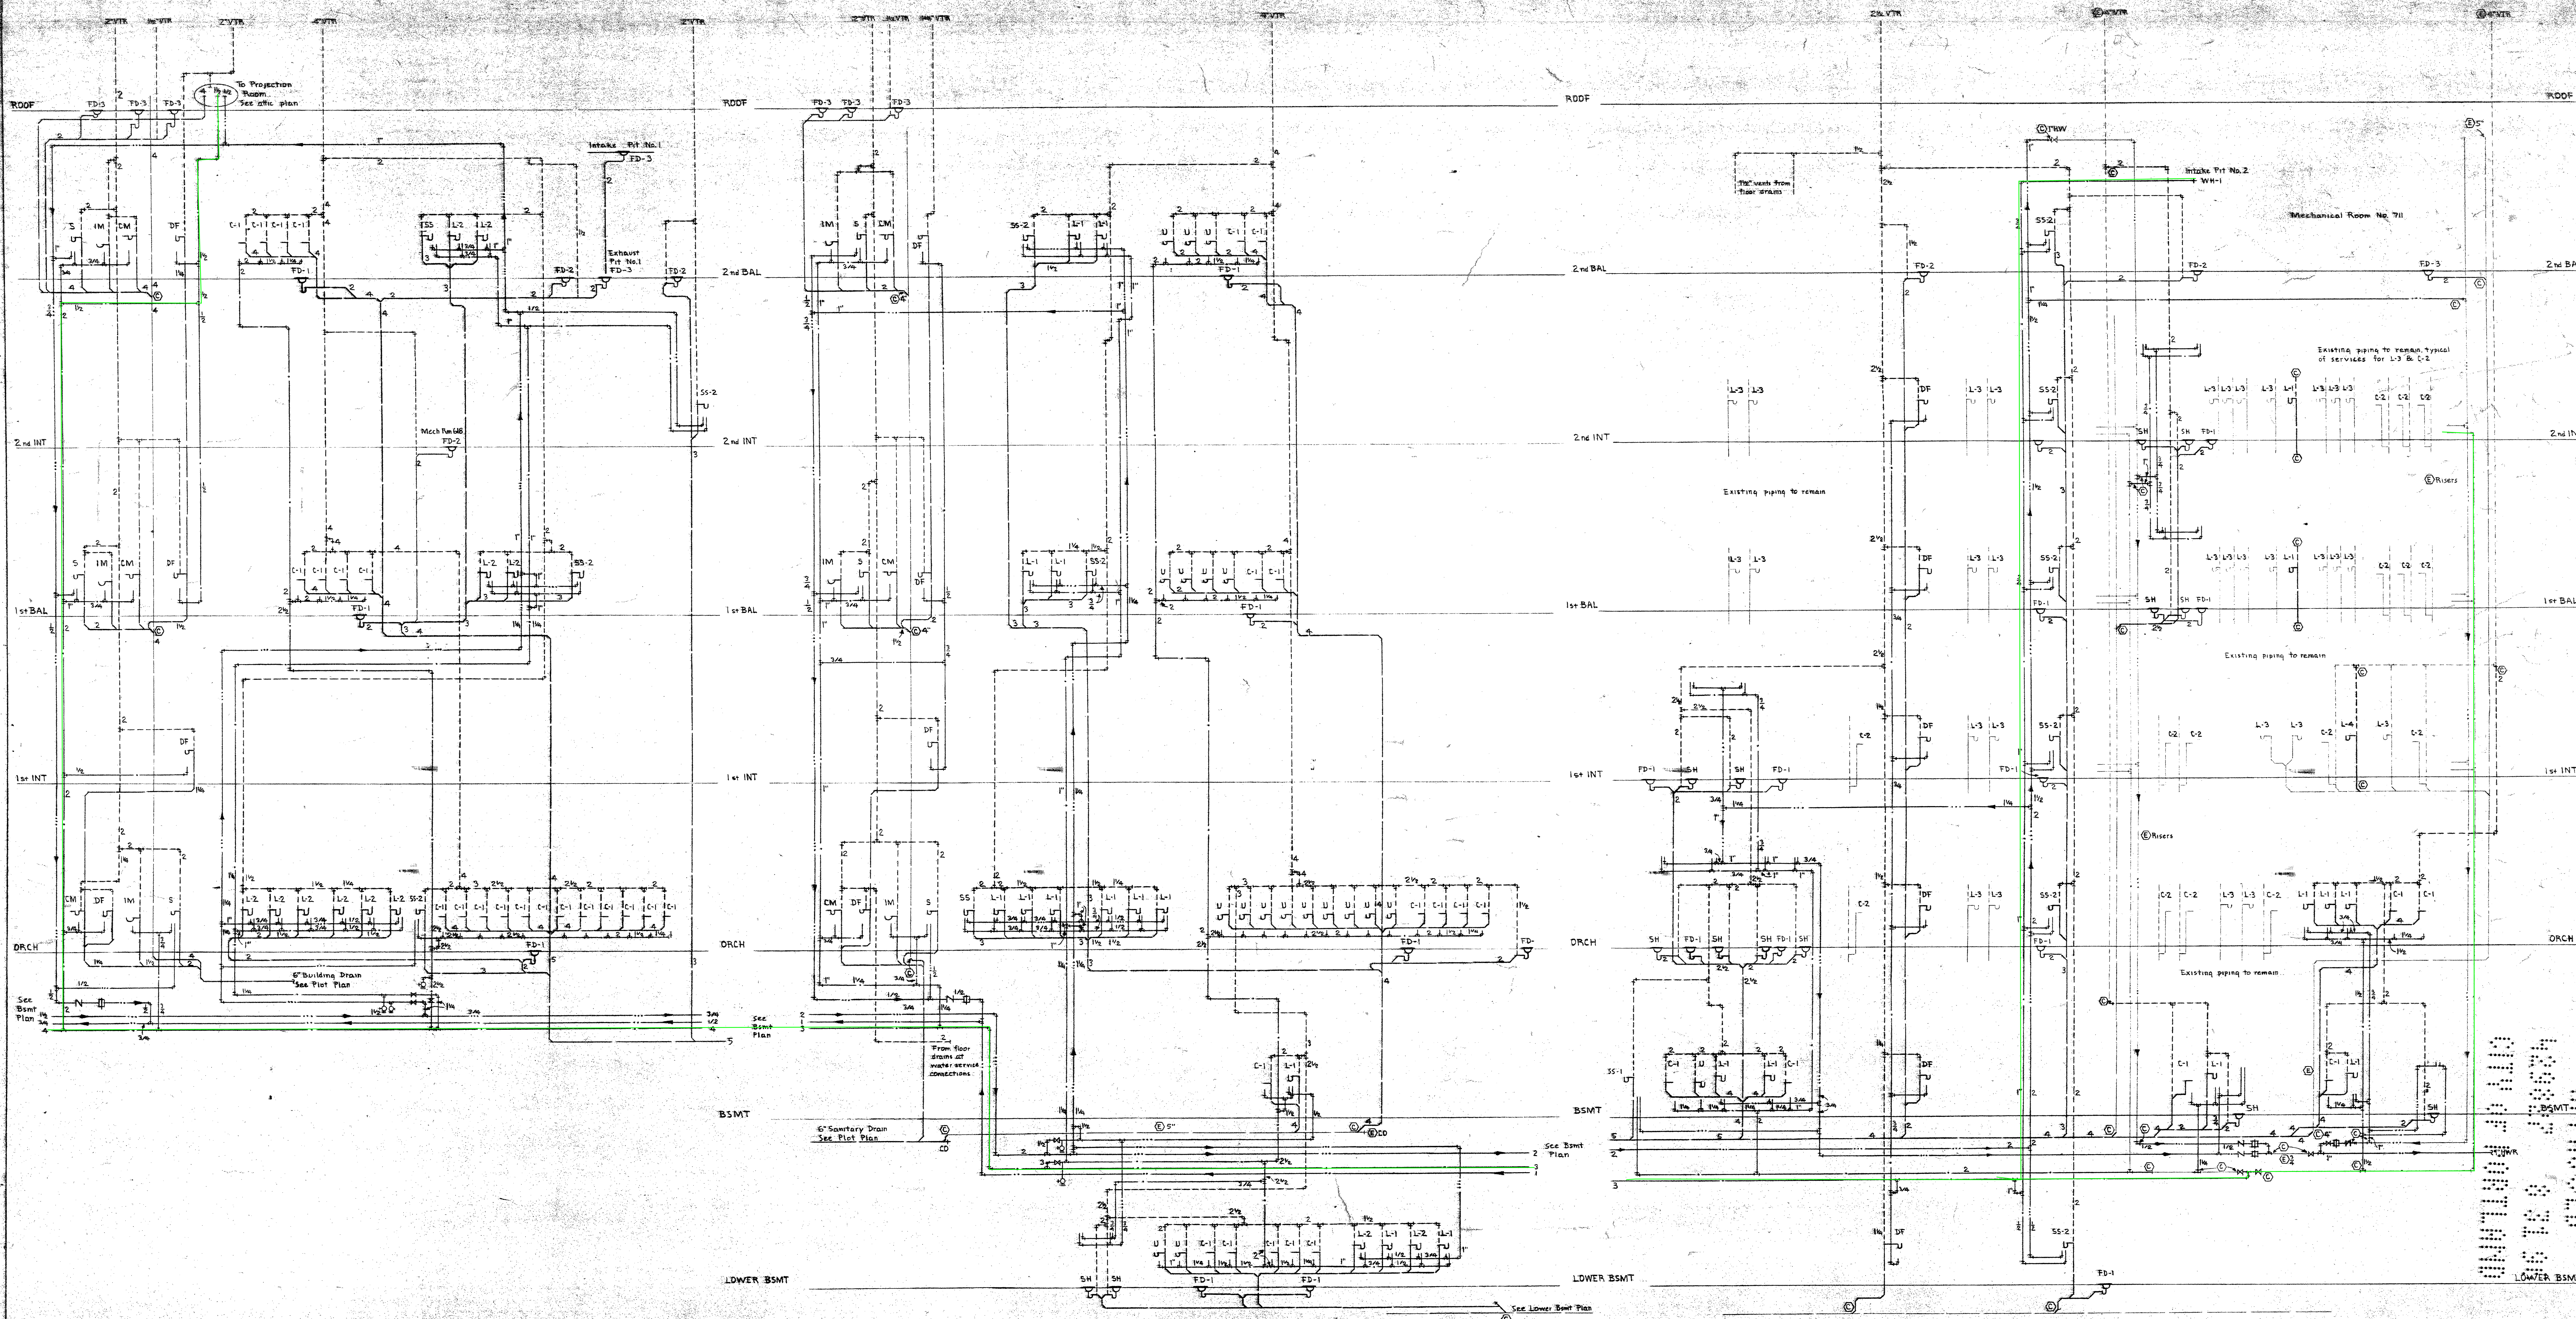


SOUTH SIDE

NORTH SIDE

DRESSING ROOM AREA

PART PLUMBING RISER DIAGRAMS


No scale

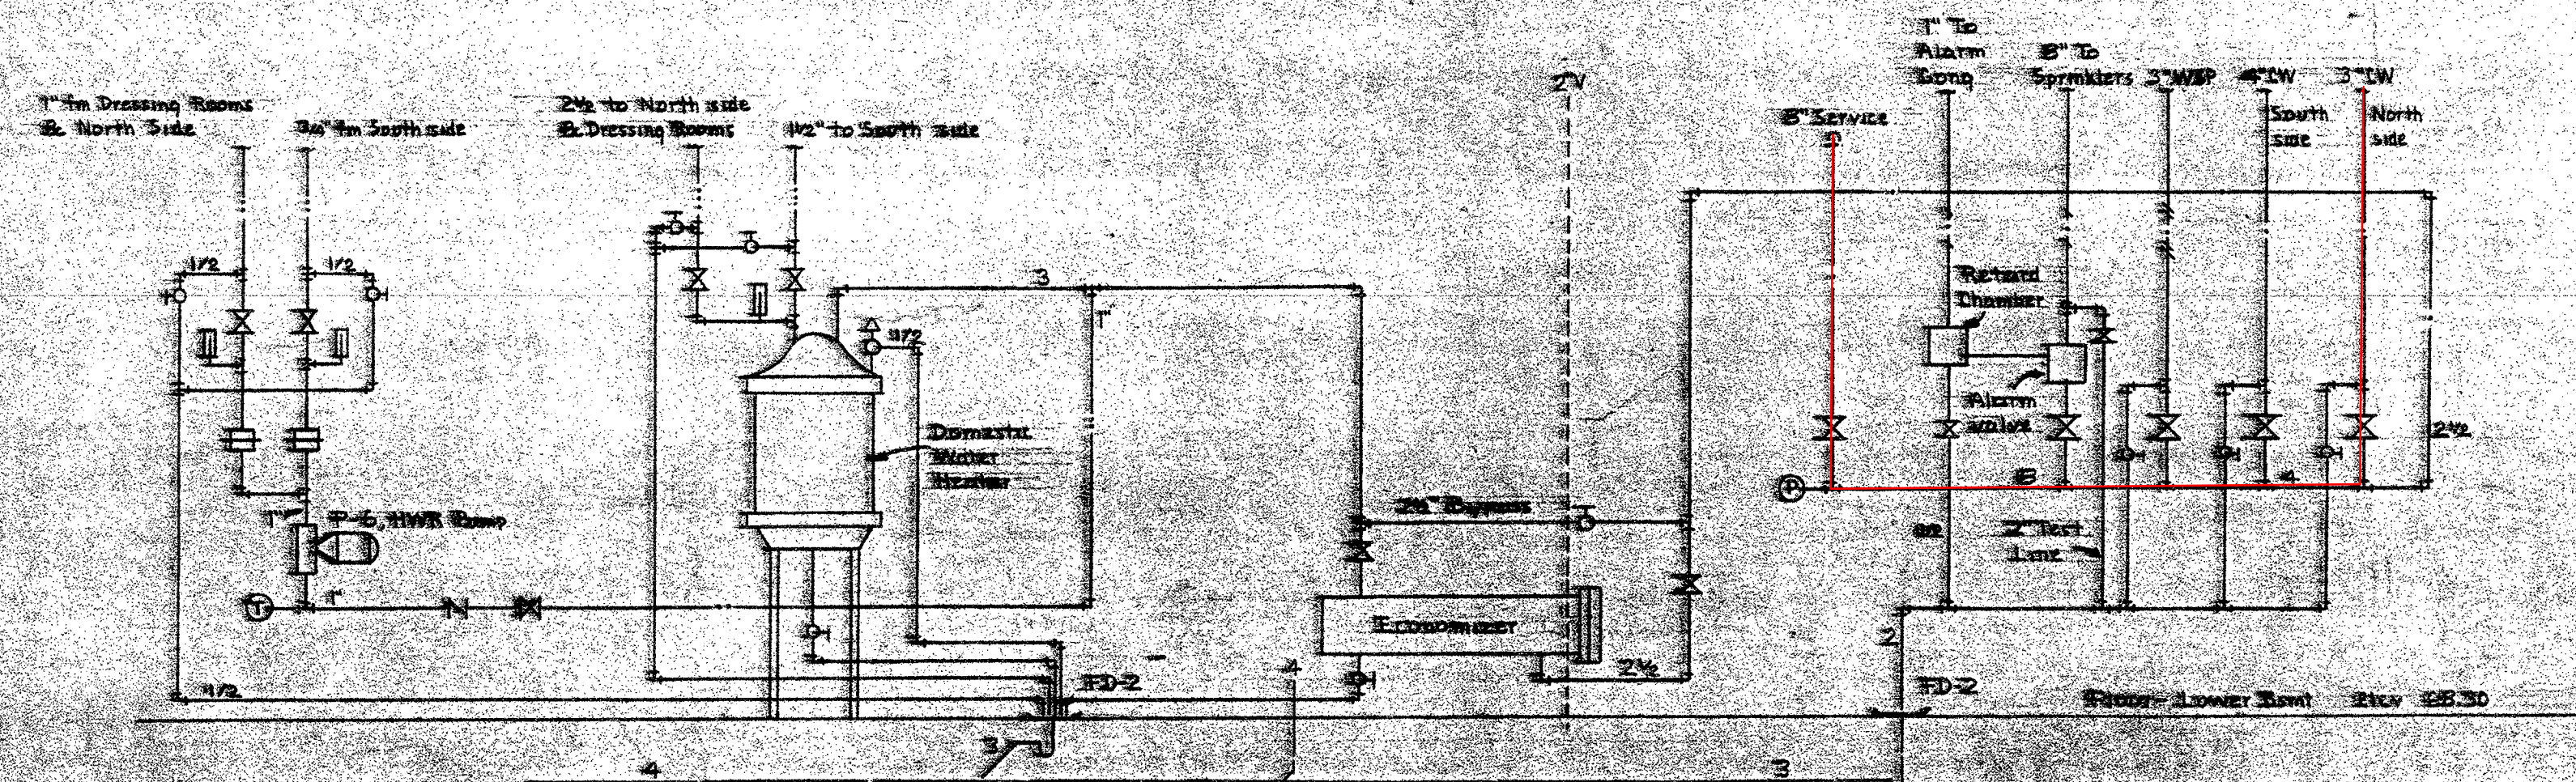

PIPING DIAGRAM - WATER SERVICE CONNECTIONS


No Scale

Note: See Floor Plan of Room 278, Drawings M-2 & M-3

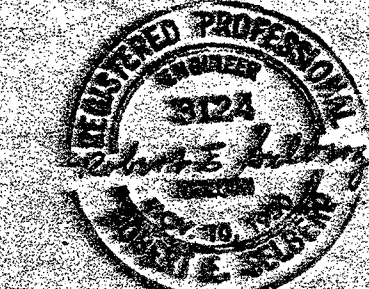


MECHANICAL PLUMBING PIPING DIAGRAMS

<p>B. MARCUS PRITECA REGISTERED ARCHITECT REGISTERED MECHANICAL ENGINEER REGISTERED ELECTRICAL ENGINEER REGISTERED PLUMBING ENGINEER REGISTERED CIVIL ENGINEER REGISTERED SANITARY ENGINEER REGISTERED CHEMICAL ENGINEER REGISTERED METALLURGICAL ENGINEER REGISTERED AERONAUTICAL ENGINEER REGISTERED AGRICULTURAL ENGINEER REGISTERED INDUSTRIAL ENGINEER REGISTERED MINING ENGINEER REGISTERED NUCLEAR ENGINEER REGISTERED PETROLEUM ENGINEER REGISTERED SURVEYING ENGINEER REGISTERED TRANSPORTATION ENGINEER REGISTERED WATER RESOURCES ENGINEER REGISTERED WASTE ENGINEER REGISTERED WIND ENGINEER</p>	<p>REBUILDING OF <b>PORTLAND CIVIC AUDITORIUM</b> S. W. THIRD AVENUE &amp; CLAY STREET PORTLAND, OREGON CITY OF PORTLAND, OREGON</p>
<p>COOPER &amp; ROSE &amp; ASSOCIATES STRUCTURAL ENGINEERS J. DONALD KROBBER &amp; ASSOCIATES MECHANICAL ENGINEERS GARY KECLEY &amp; ASSOCIATES ELECTRICAL ENGINEERS ALVA EDWELL, A.B.D. REGISTERED CONSULTANT</p>	<p>STANTON, BOLES, MAGUIRE &amp; CHURCH ARCHITECTS 208 S. W. STARK ST., PORTLAND 4, OREGON PHONE: 523-5323 DRAWN: M-12 DATE: MAY 24 1955</p>


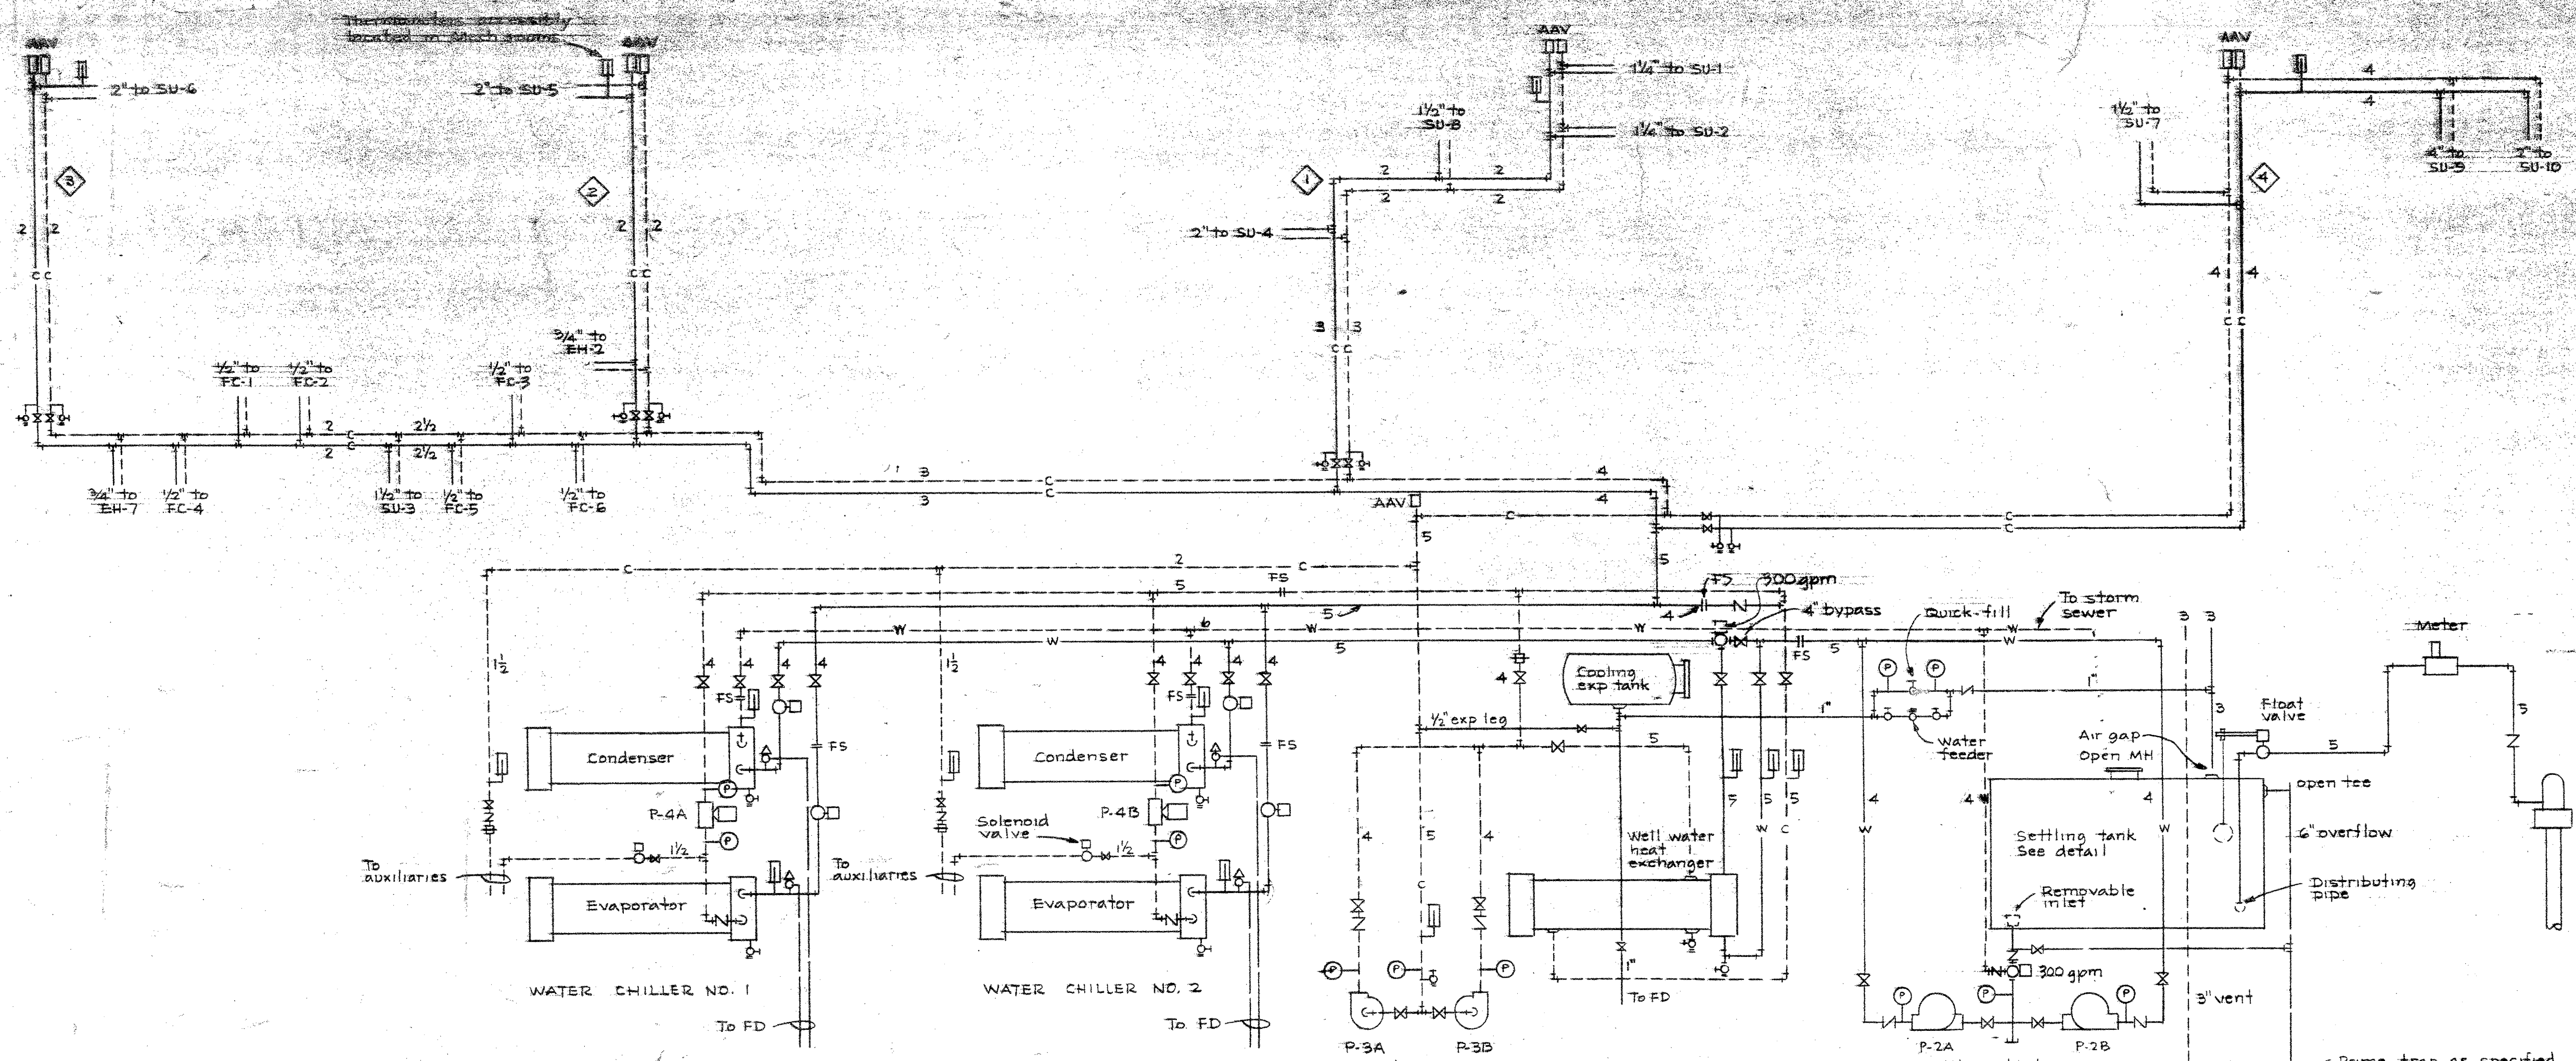


**COOLING SYSTEM PIPING DIAGRAM**  
No Scale  
Notes: Pipe sizes shown for branch piping to equipment are for both supply and return.






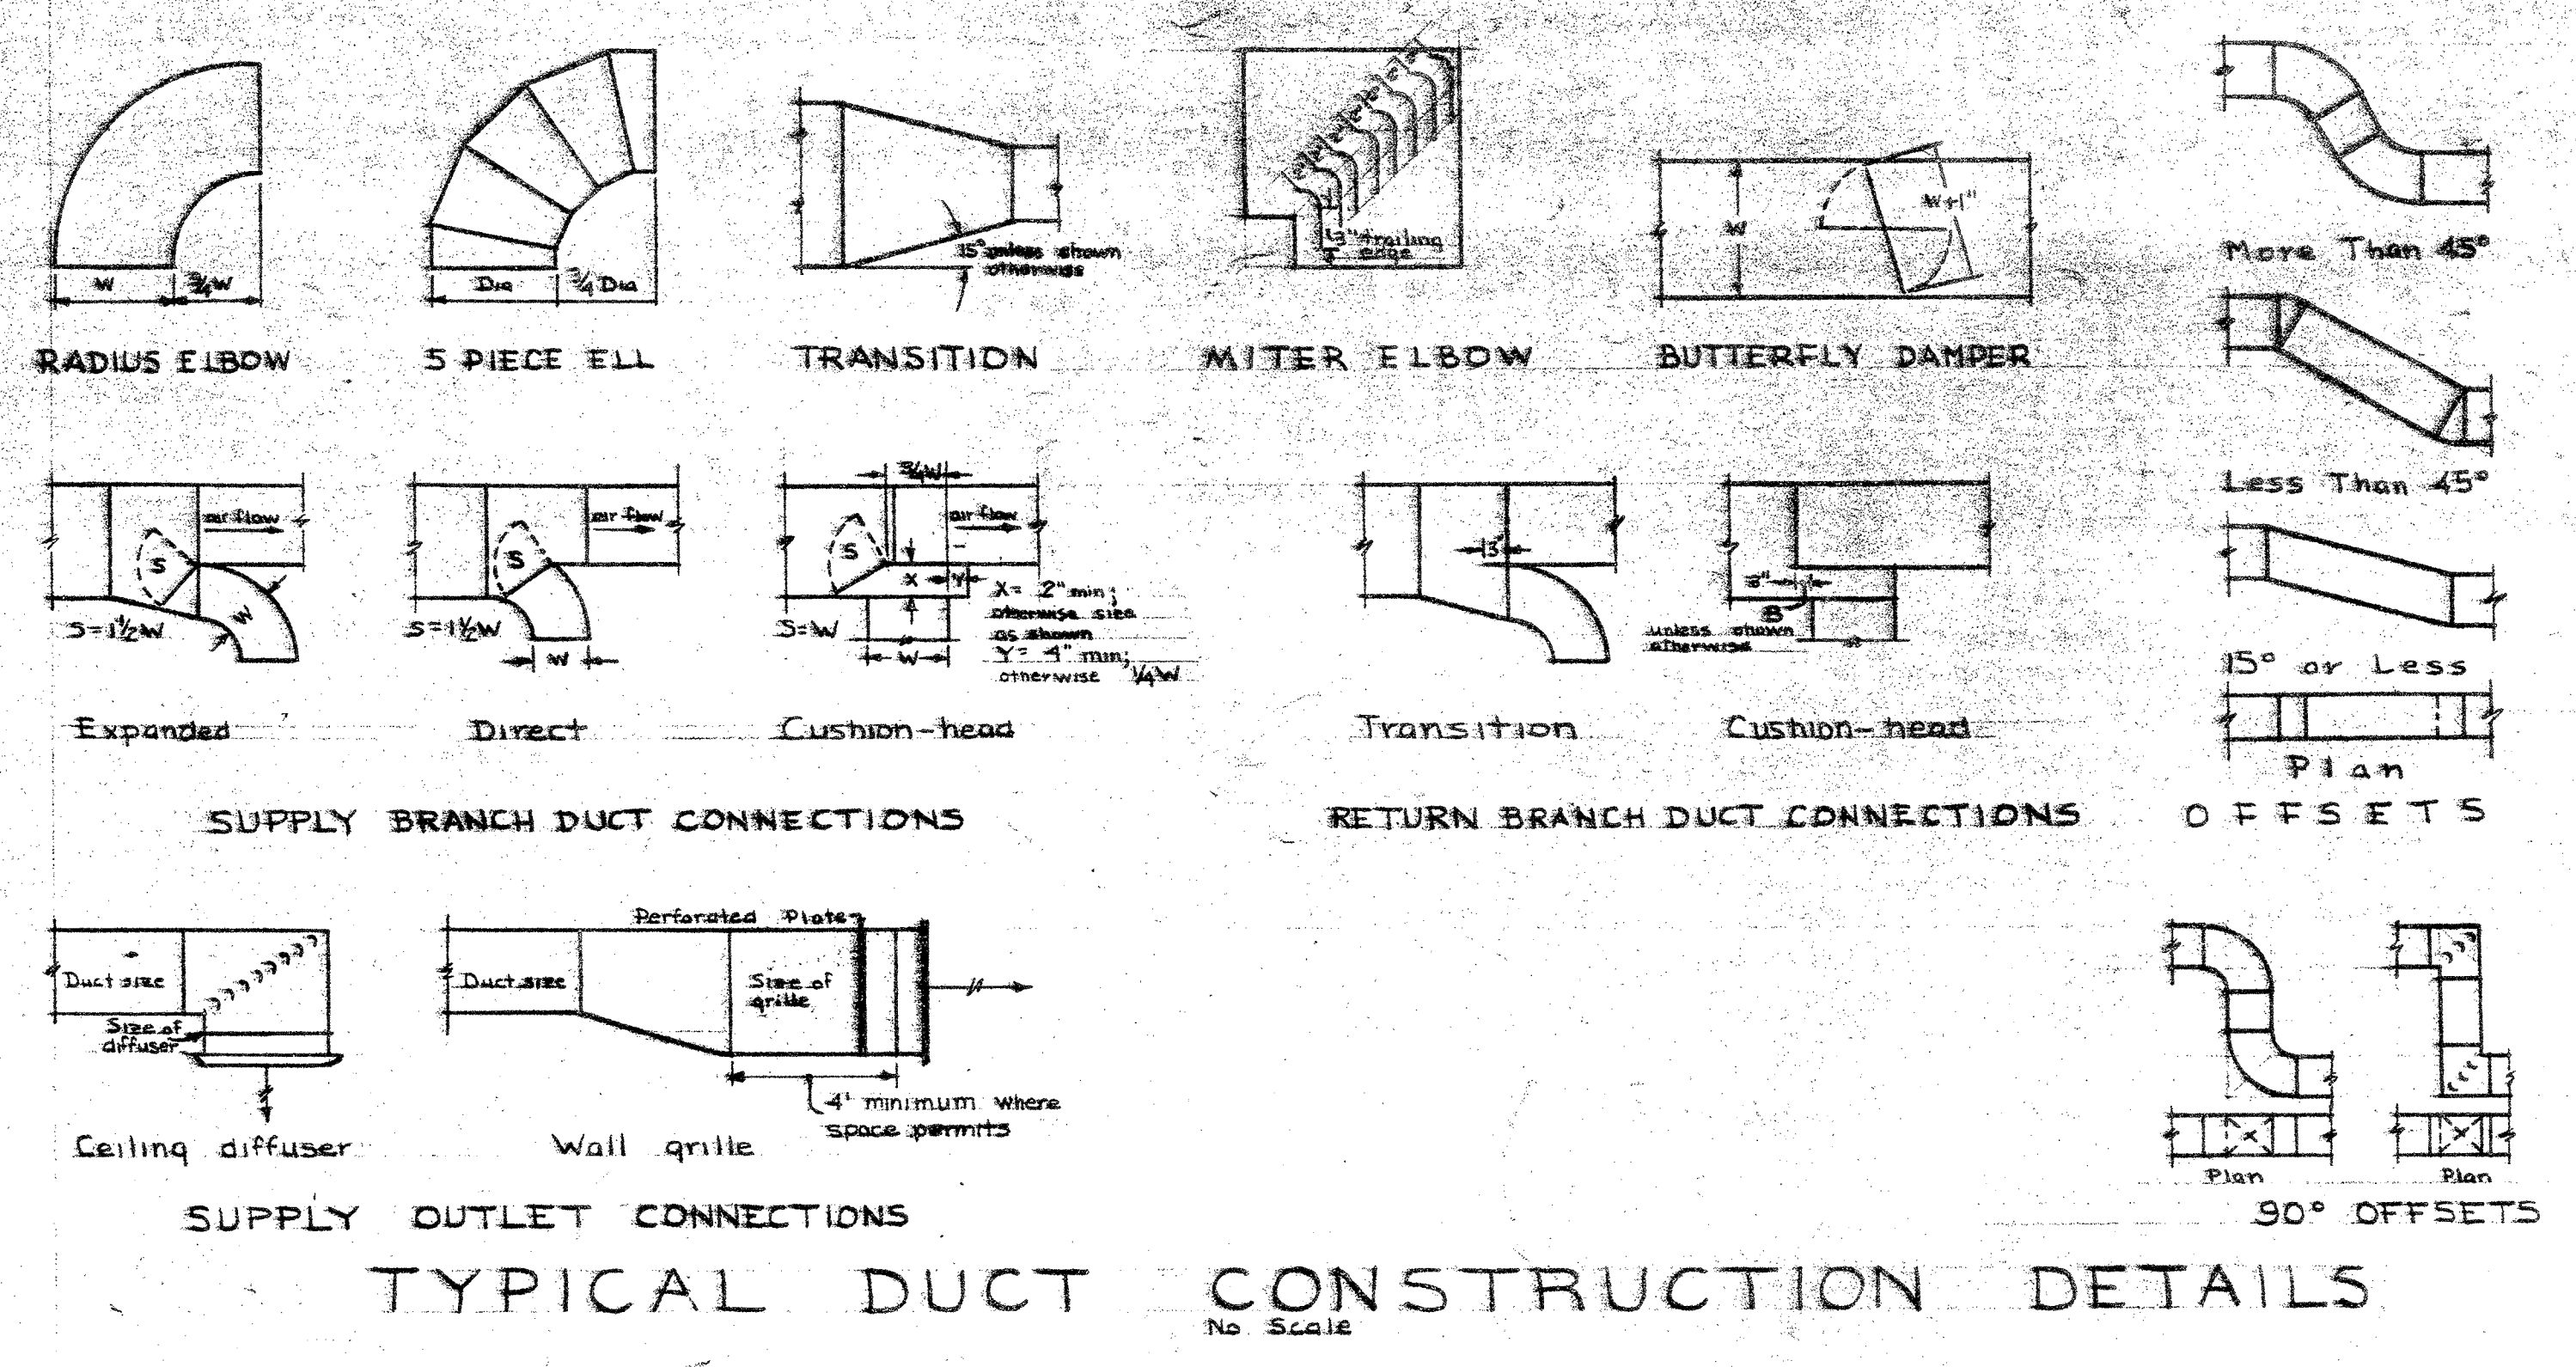


**MIXING DAMPER SCHEDULE**

UNIT ZONE	CFM	Damper Width	Dimensions (inches)		Length	TYPE	Room Thermostat Location
			X (Warm)	Y (Cool)	L		
<b>SU-7</b>							
1	610	14	12	12	22	C	705
2	700	14	14	14	22	C	1,202
3	1000	16	16	16	22	C	306
4	1000	16	16	16	22	C	40
5	750	14	14	14	22	C	424
6	1100	17	14	14	22	C	506
7	780	14	14	14	22	C	508
8	1200	18	18	18	22	C	705
<b>SU-8</b>							
1	1860	22	17	14	22	C	346
2	1250	18	14	14	22	C	535
3	720	14	14	14	22	C	721
4	800	14	14	14	22	C	421
<b>SU-9</b>							
1	4700	32	18	32		A	340
2	7500	38	18	32		A	525
3	750	18	18	26		A	829
4	3750	24	18	32		A	7, E, 9
5	8250	34	18	32		A	340
6	2500	17	18	32		A	540
7	8250	34	18	32		A	540
8	2500	17	18	32		A	540
<b>SU-10</b>							
1	1350	14	12	16		B	107
2	2075	21	17	20		B	410
3	1900	20	17	20		B	212

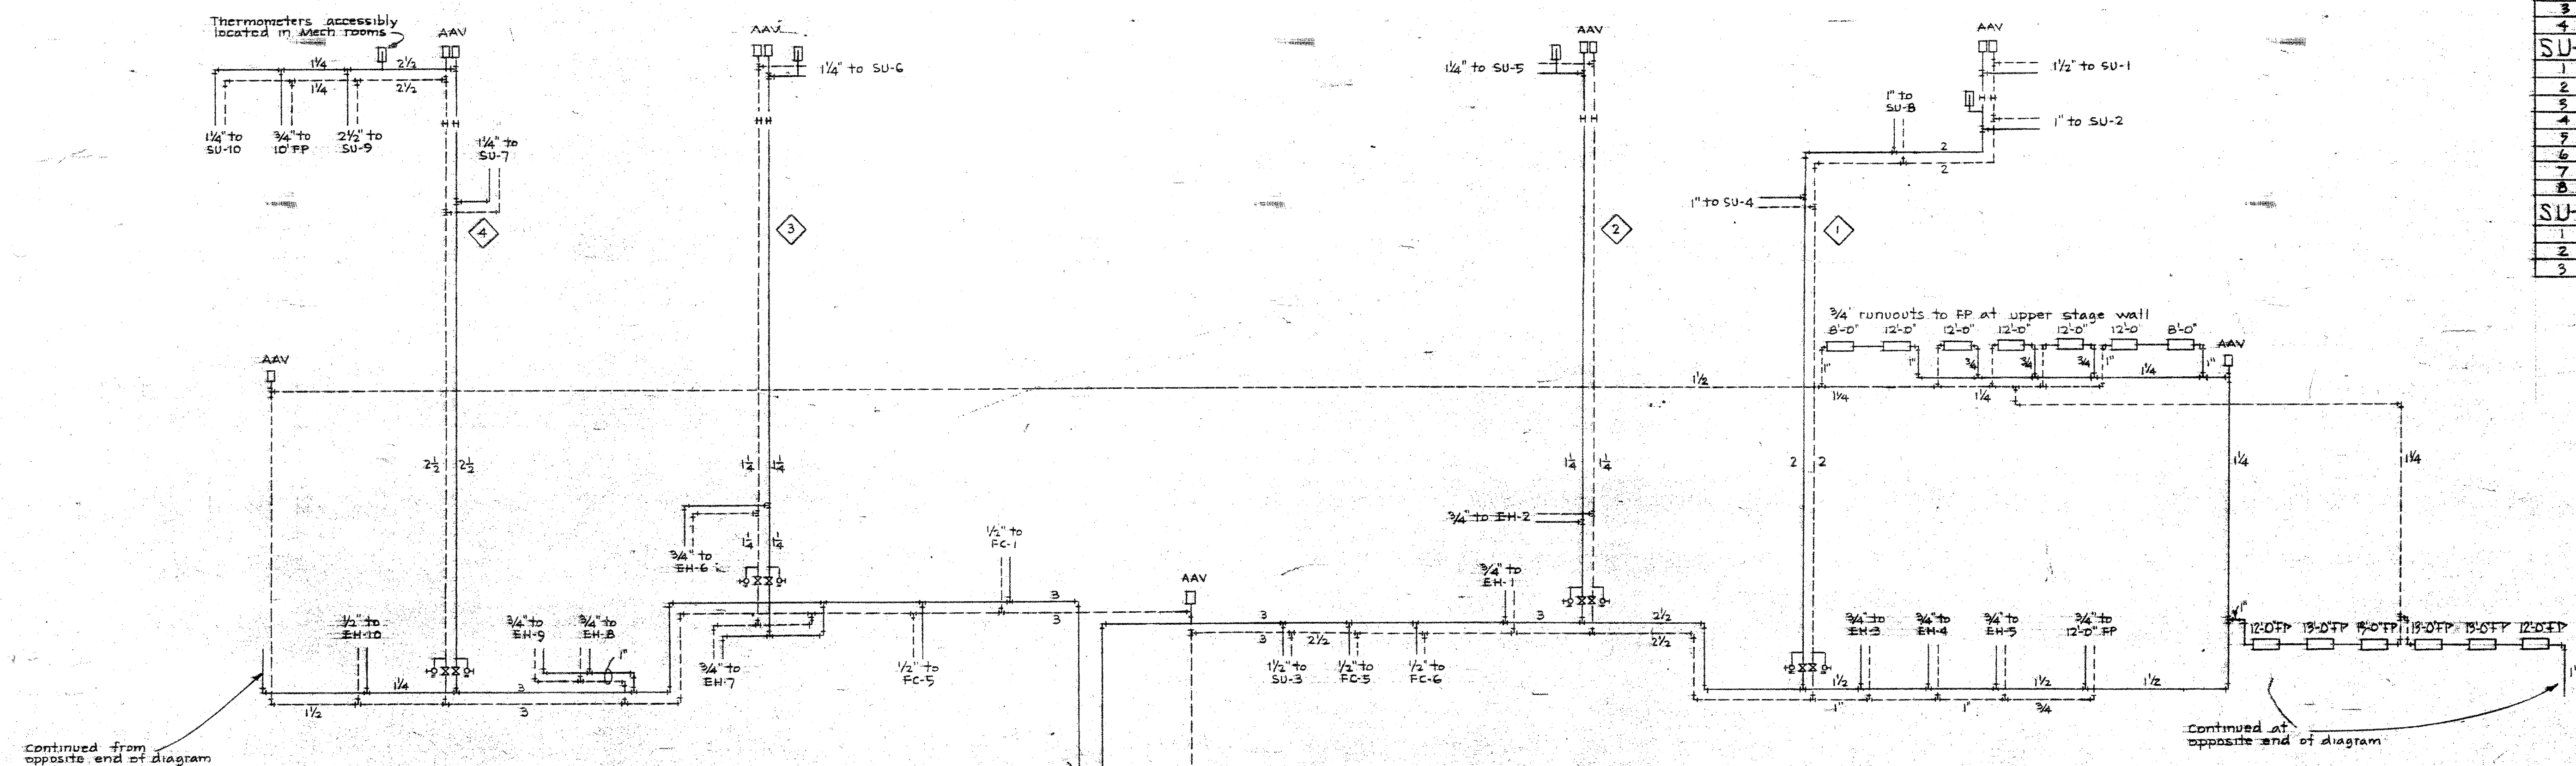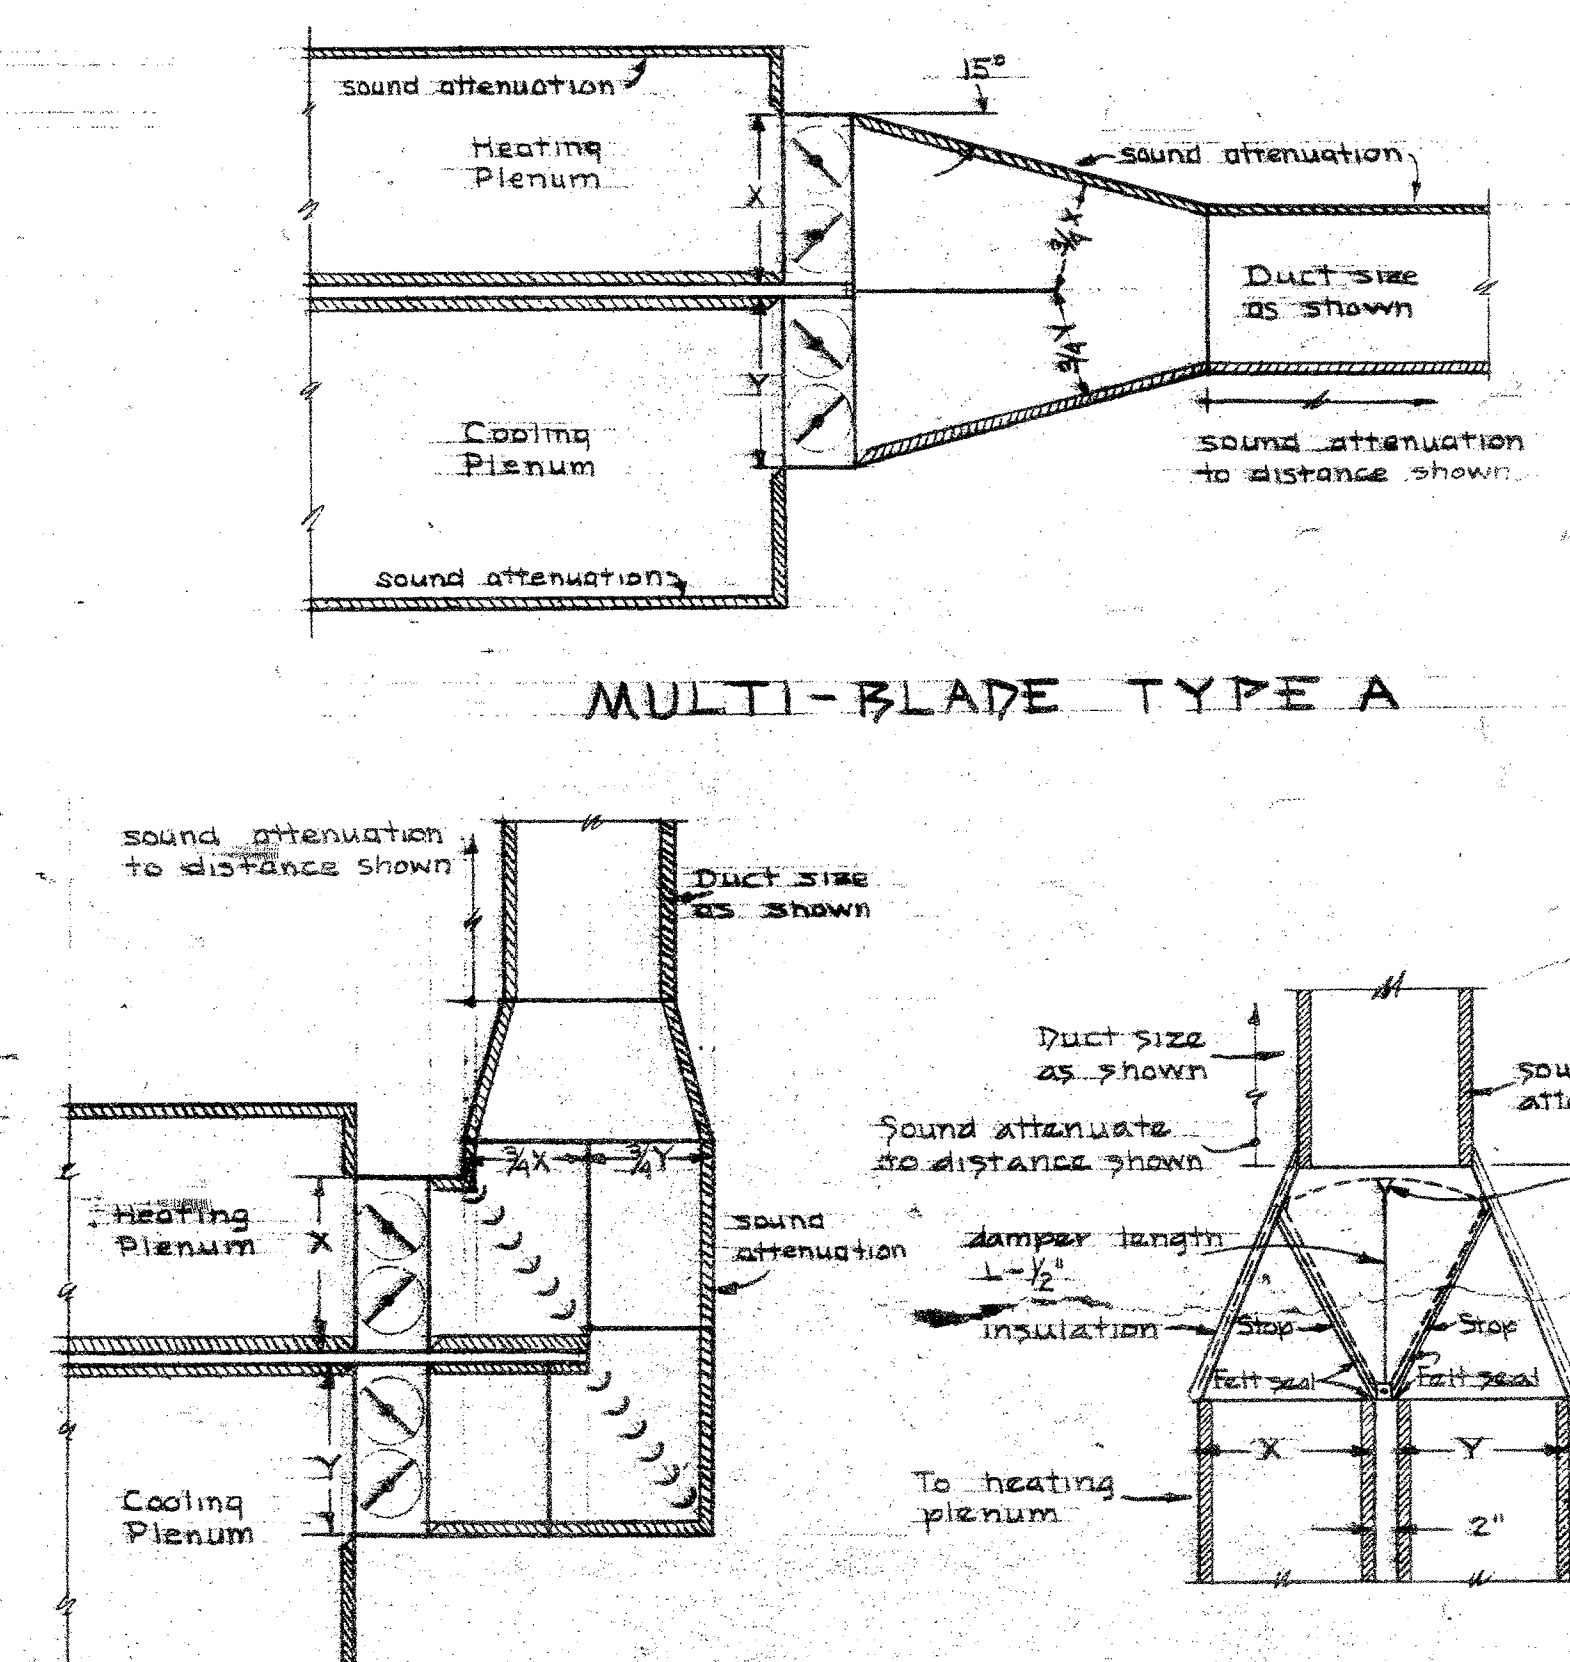

**HEATING SYSTEM PIPING DIAGRAM**  
No Scale  
Notes: Pipe sizes shown for branch piping to equipment are for both supply and return.

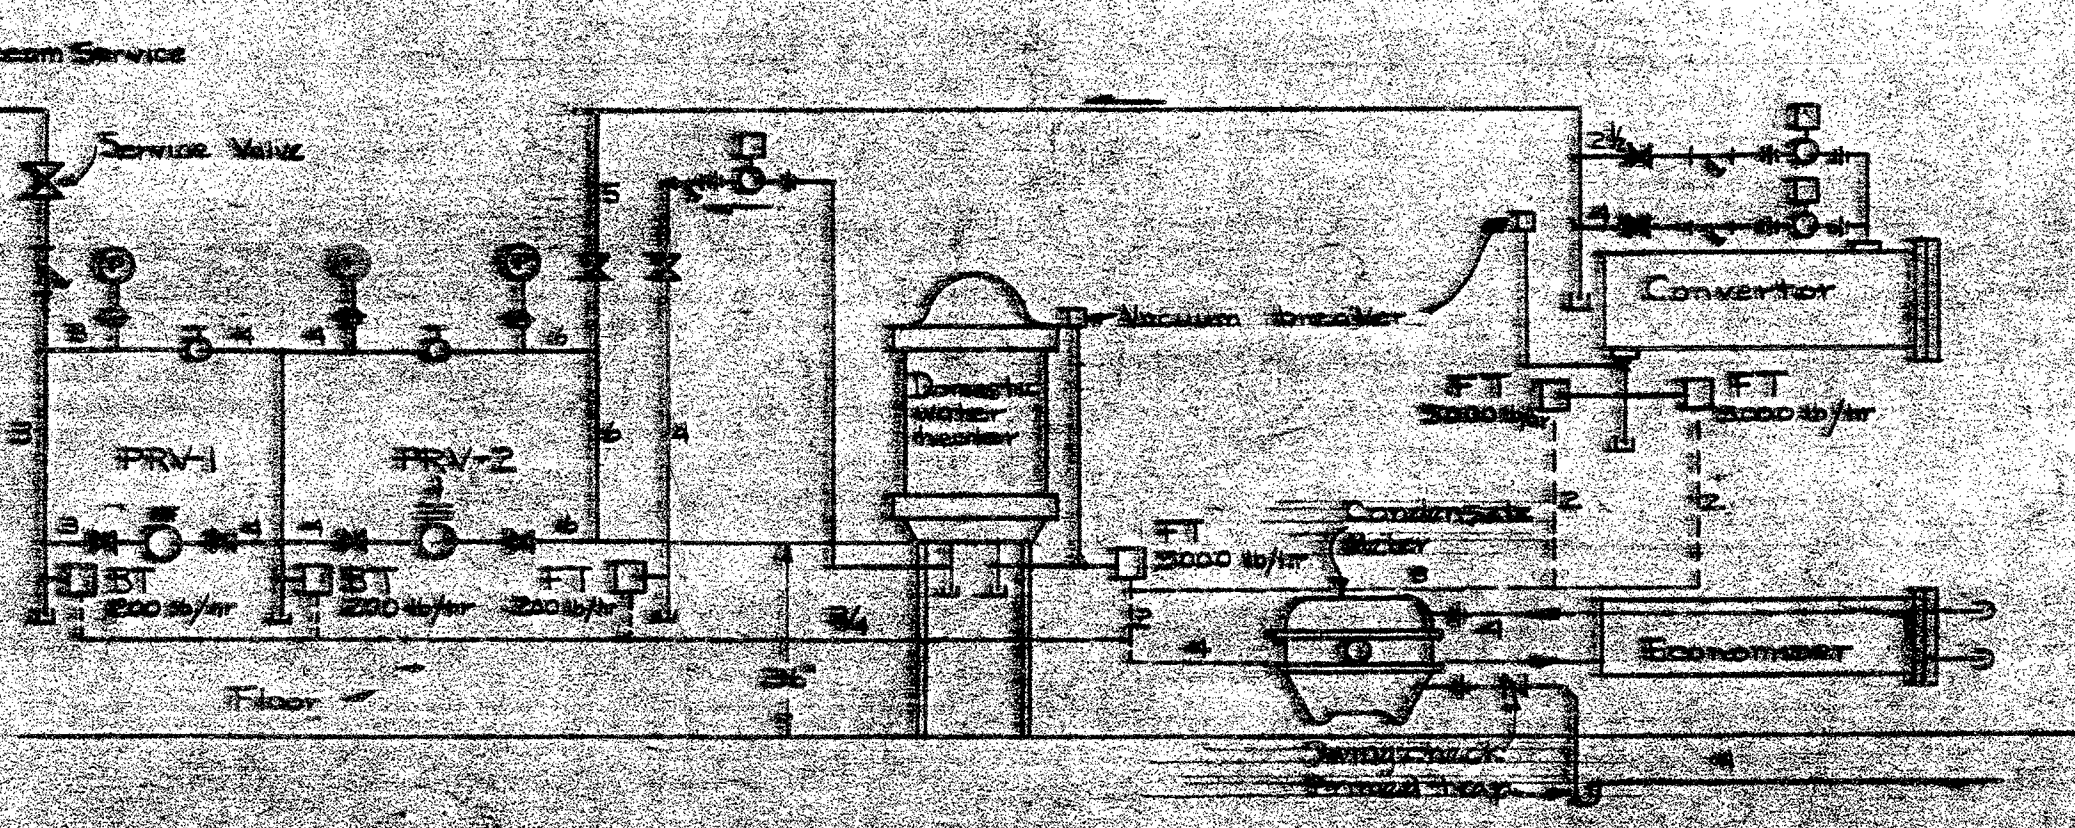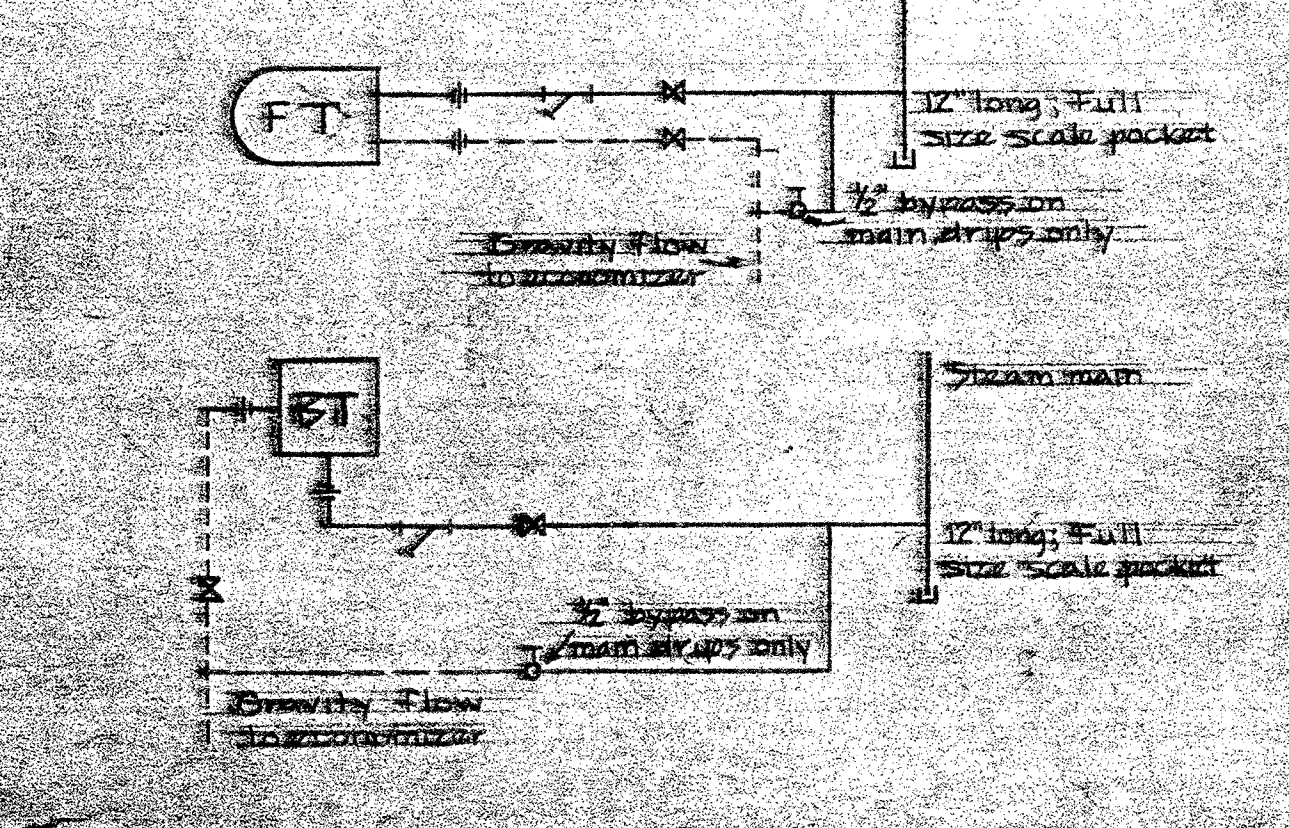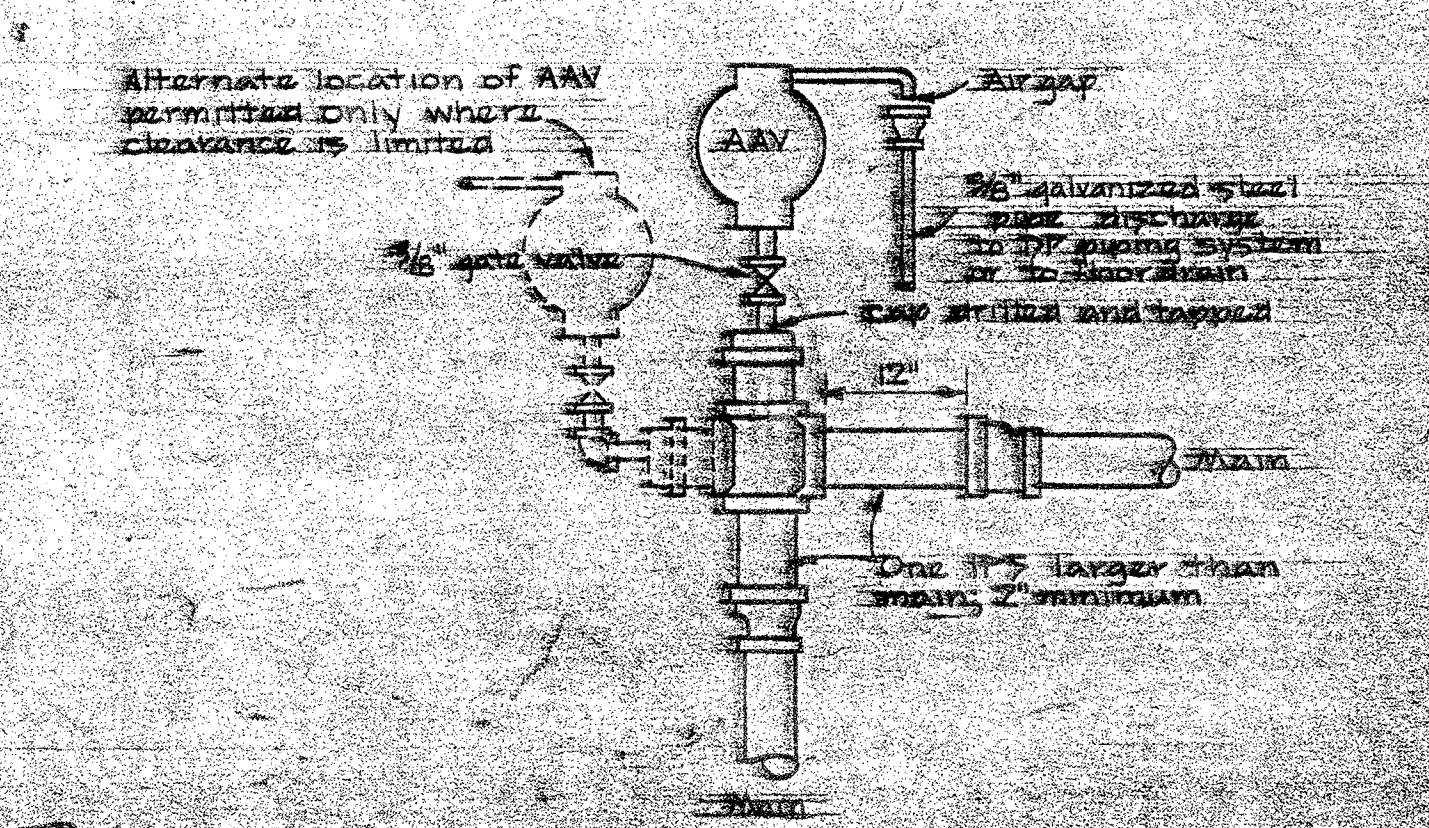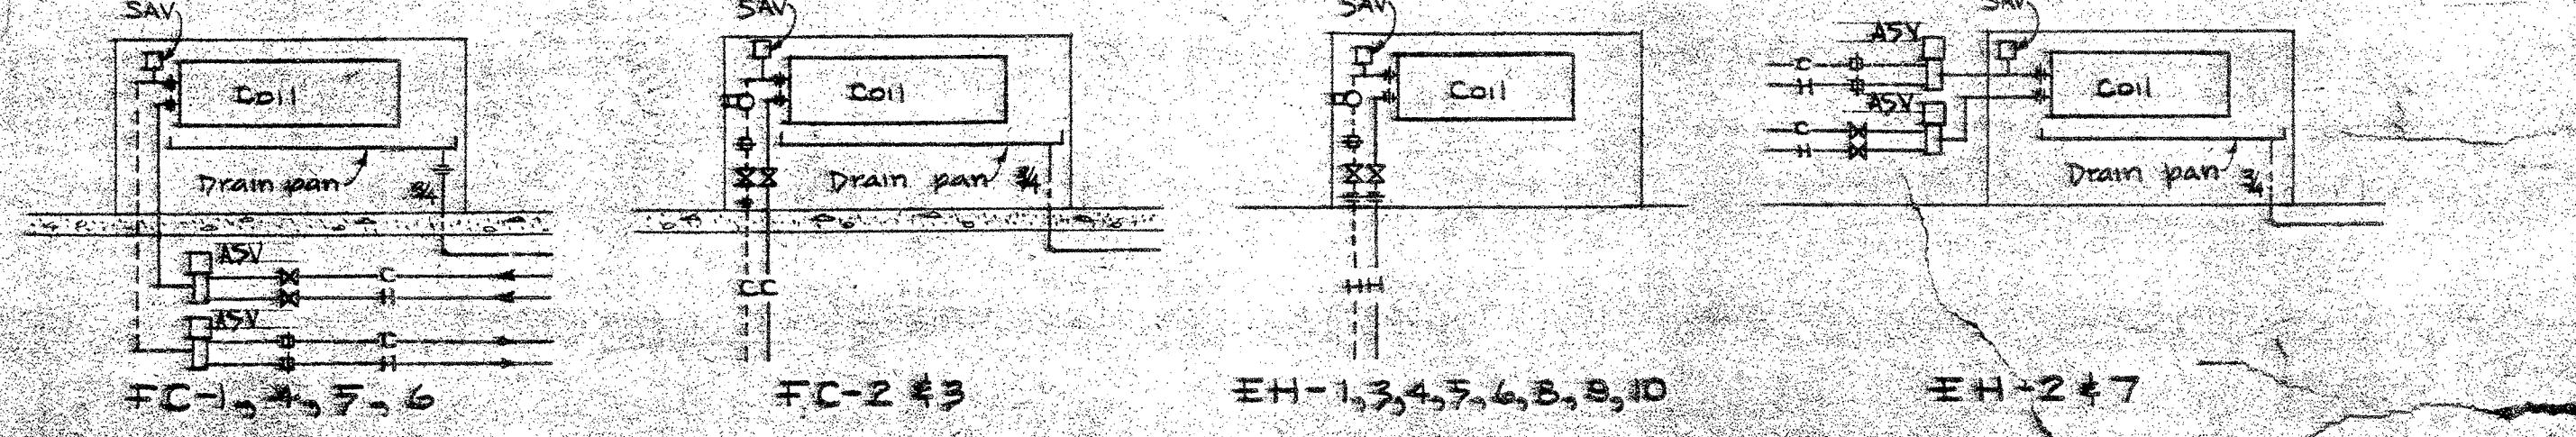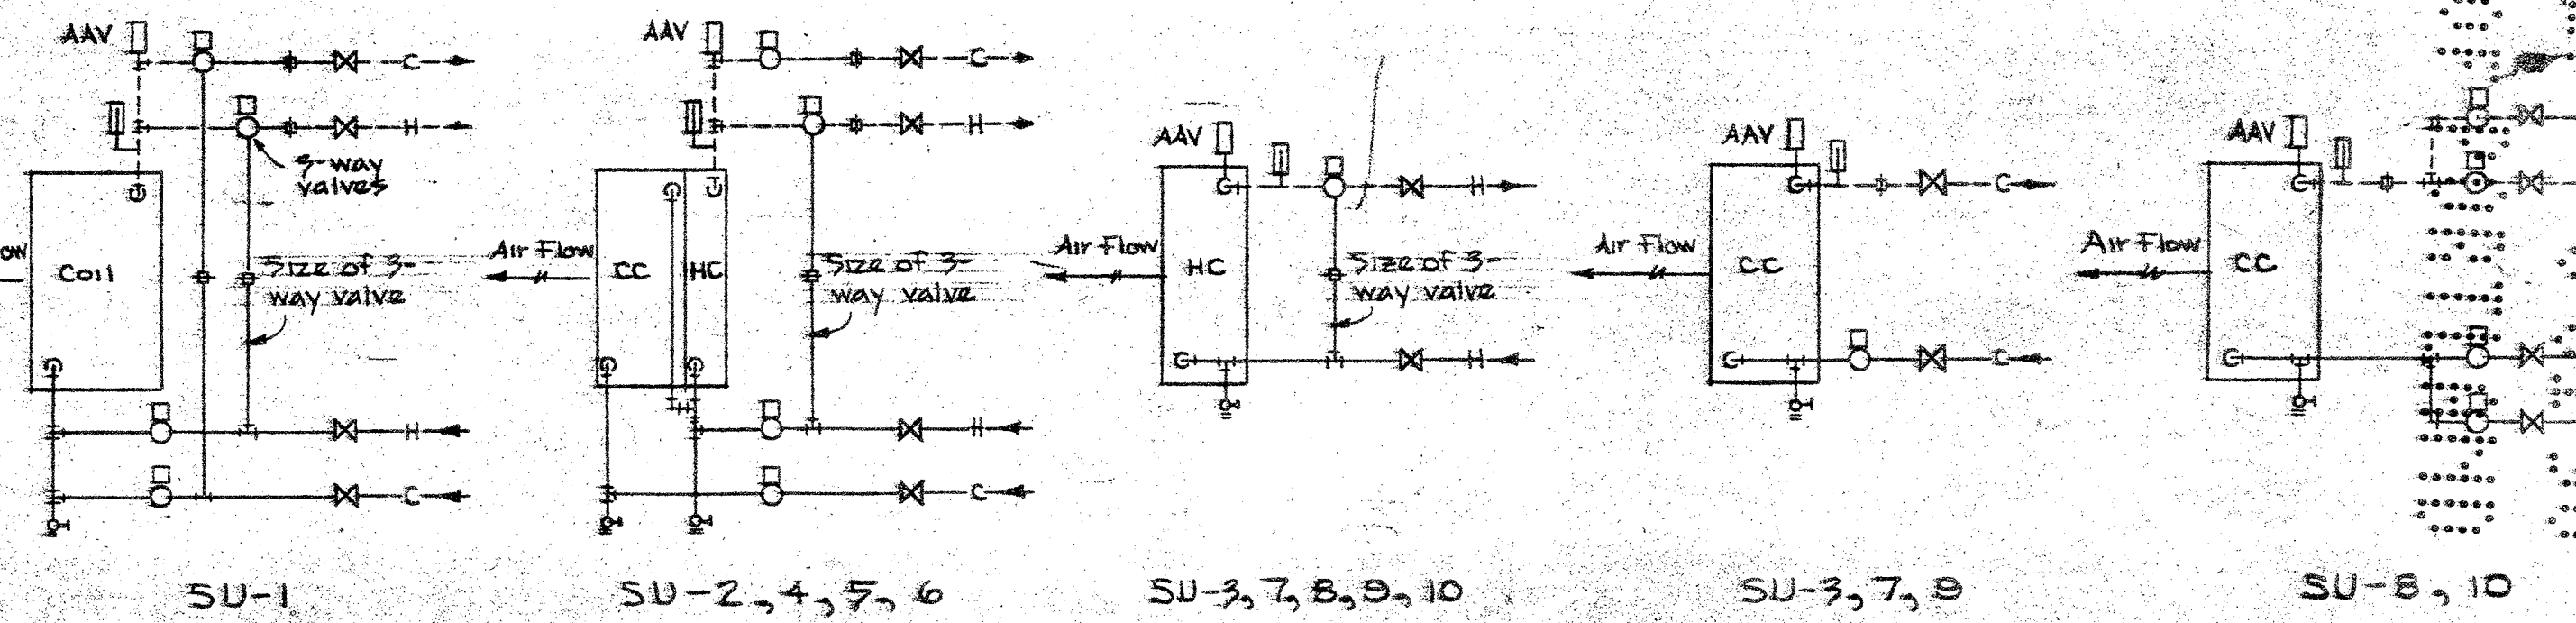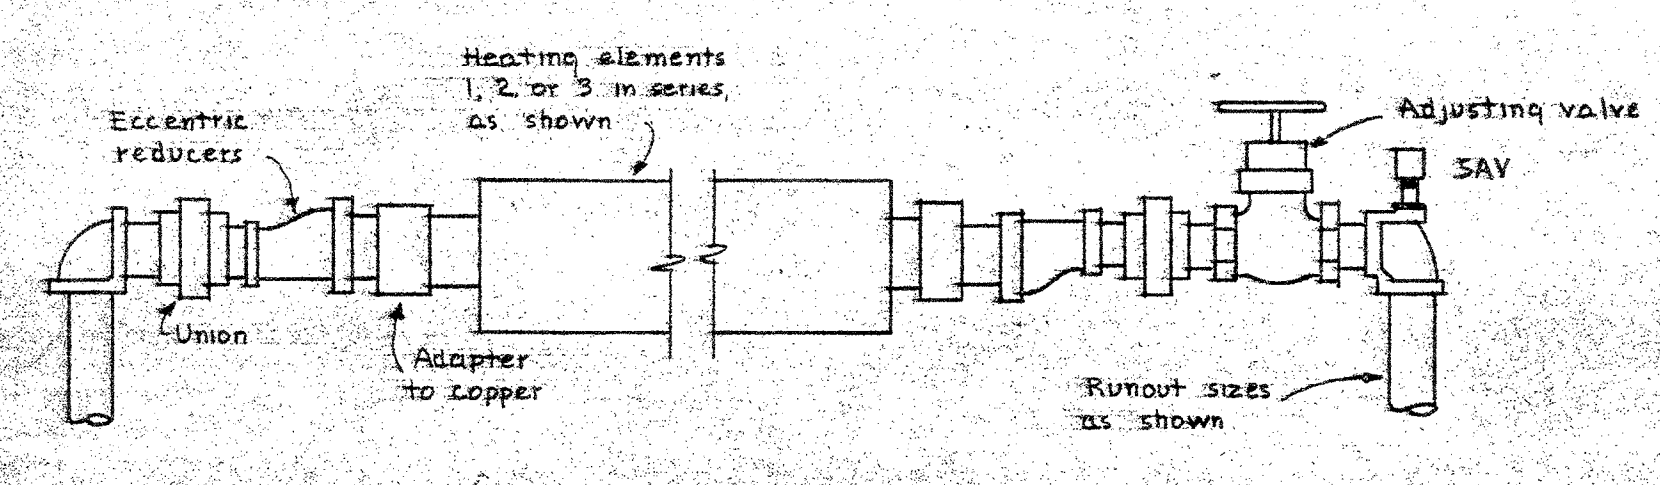


**MECHANICAL HEATING AND COOLING PIPING DIAGRAMS & DUCT DETAILS**

**B. MARCUS FREIDA ARCHITECT**  
MARCUS FREIDA & ASSOCIATES  
MECHANICAL ENGINEERS  
1000 BROADWAY, NEW YORK, N.Y. 10018


**REBUILDING OF PORTLAND CIVIC AUDITORIUM**  
100 BROAD AVENUE, 4TH FLOOR  
PORTLAND, OREGON 97208

**STANTON BOLES MARSH & BROWN ARCHITECTS**  
300 S.W. STARK ST., PORTLAND, OREGON 97208  
503-241-1111

DATE: MAY 24, 1988

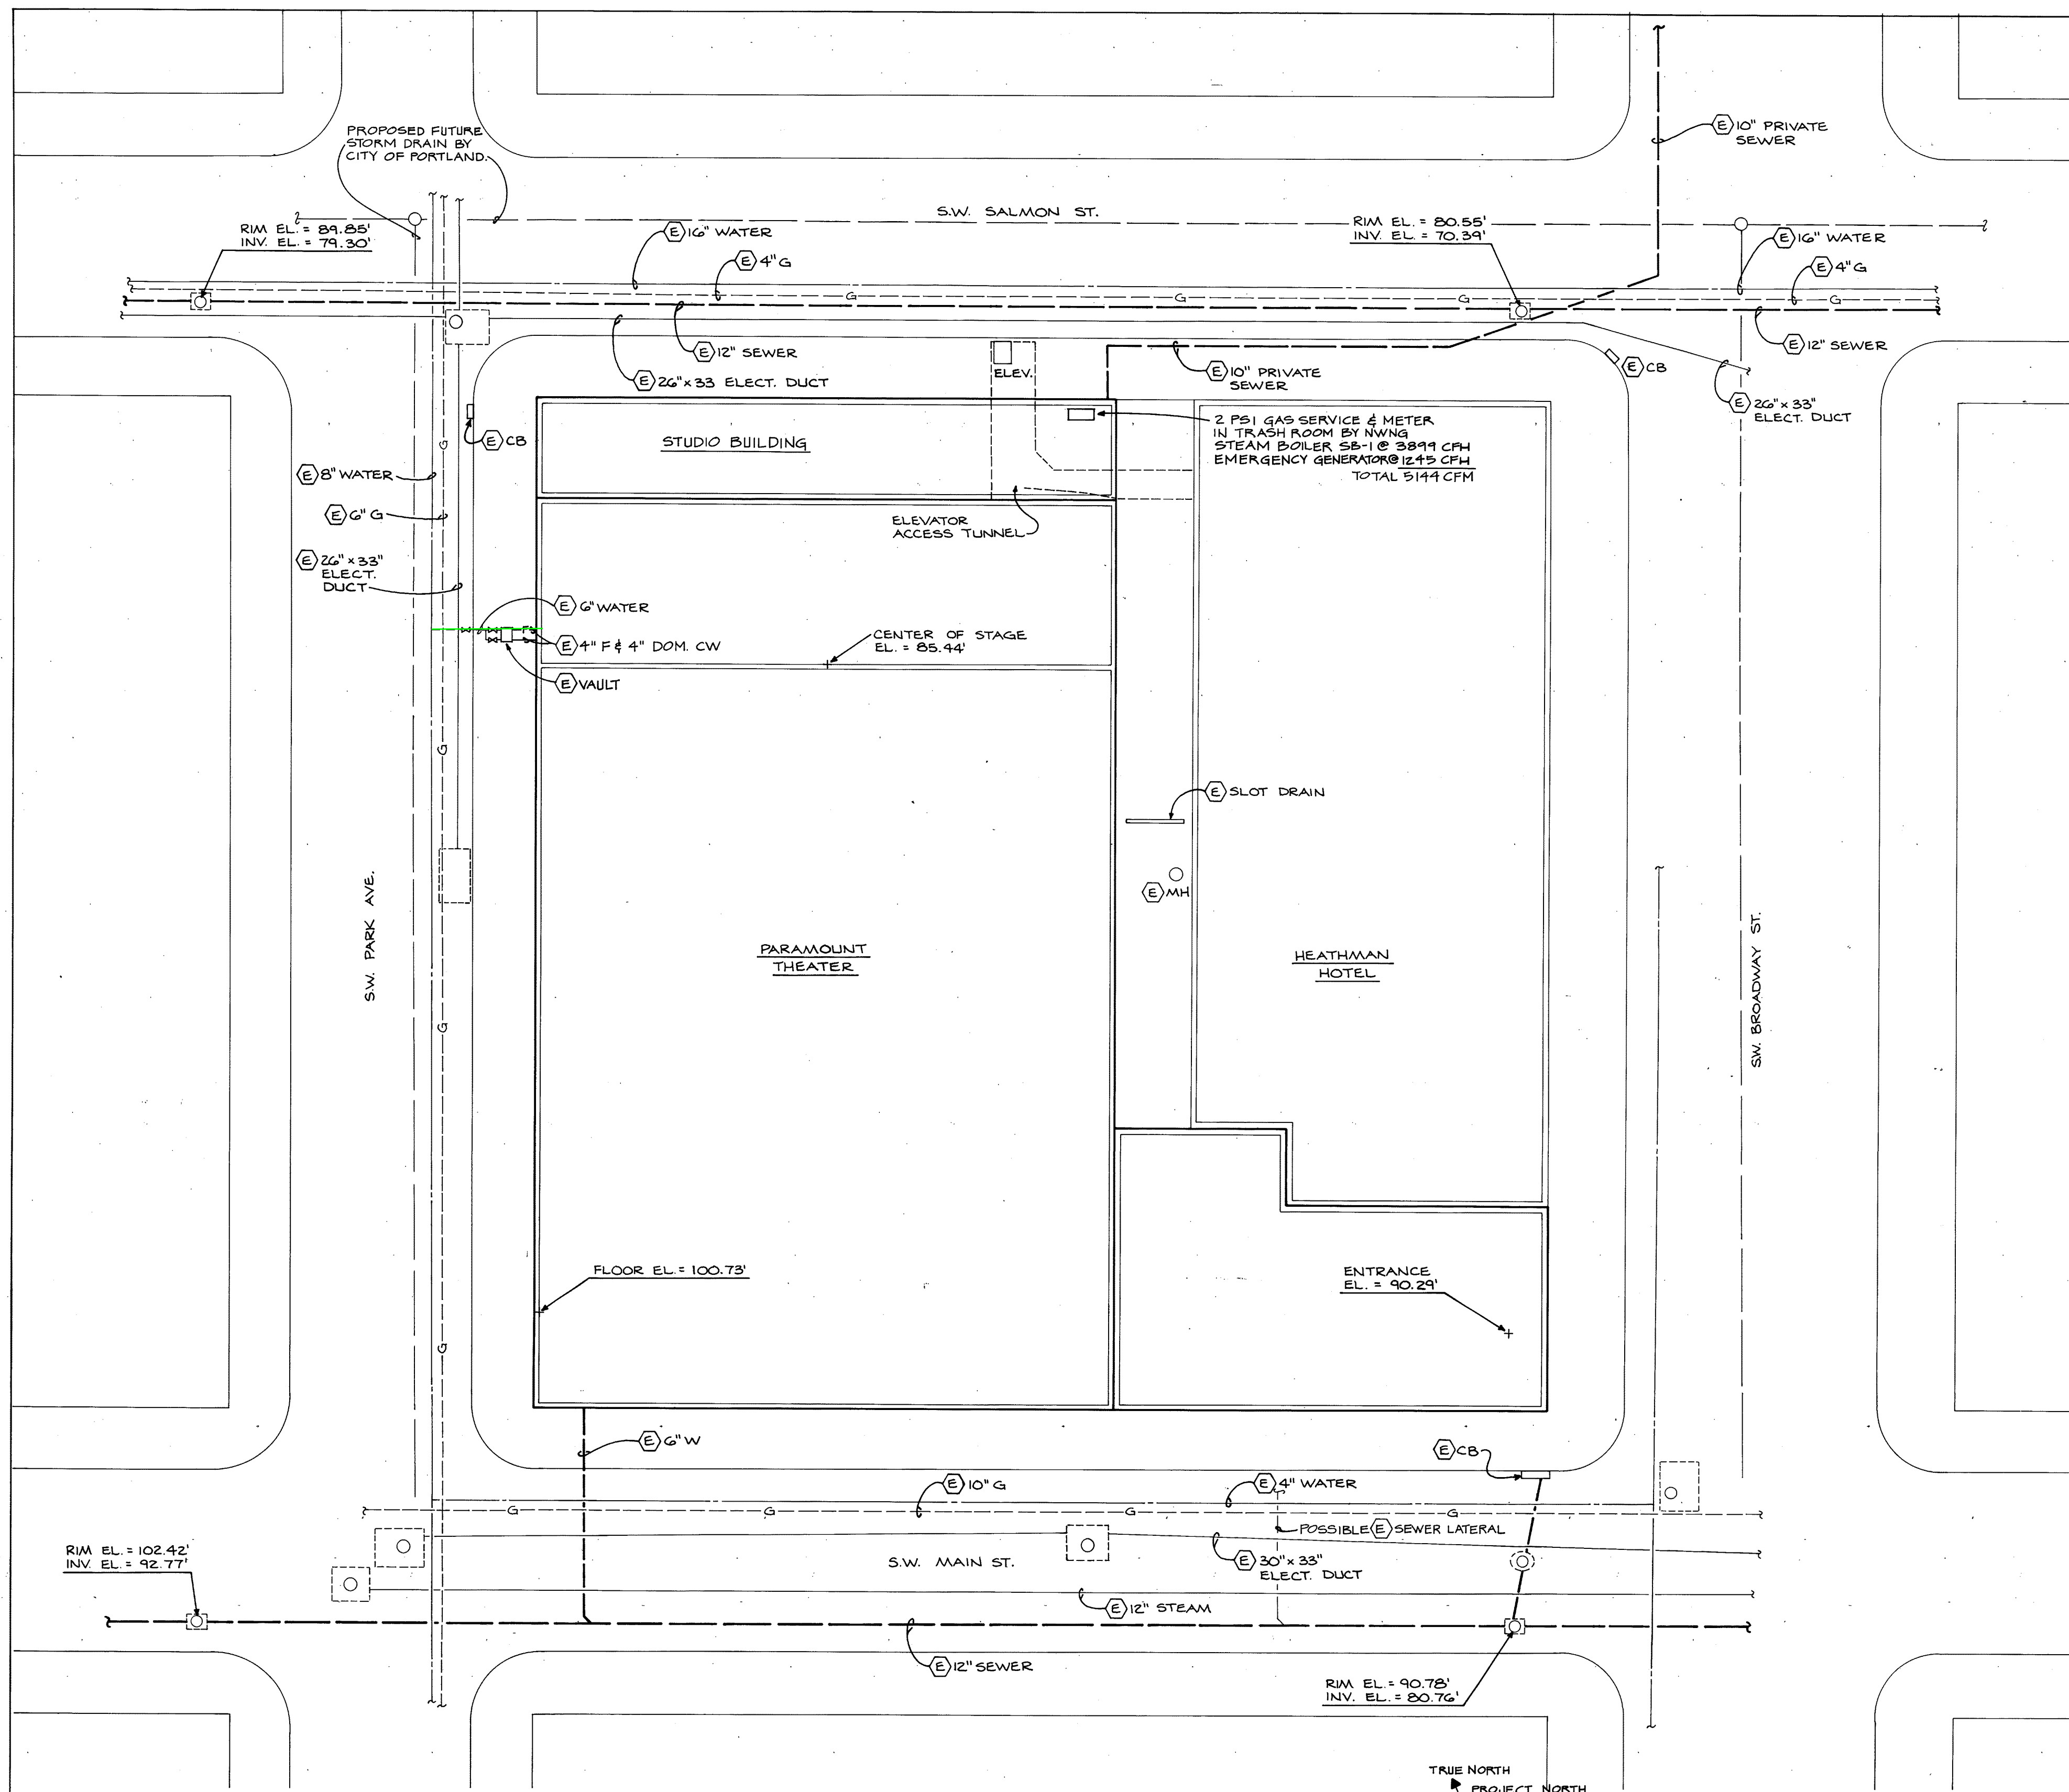

**MECHANICAL SITE PLAN**  
1"=20'-0"

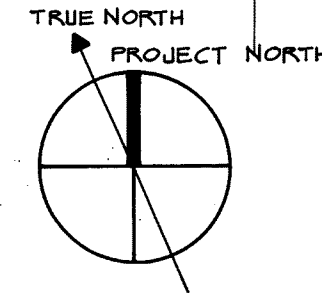

**GENERAL NOTES**

- INFORMATION PERTAINING TO EXISTING HVAC EQUIPMENT, FIRE PROTECTION, AND PLUMBING PIPING, FIXTURES, ITEMS, ETC., SHOWN ON THESE DRAWINGS HAS BEEN TAKEN FROM C.W. & GEO. L. RAPP DRAWINGS DATED JAN. 29, 1927, AND SEVERAL SUPPLEMENT DRAWINGS, ALSO SOME FIELD INVESTIGATION.
- THESE DRAWINGS DO NOT INDICATE ACCURATE PIPE ROUTING IN ALL AREAS. SOME CONCEALED DUCT AND PIPING RUNS & OTHER NON-VISIBLE ITEMS HAVE BEEN SHOWN IN AN ASSUMED LOCATION BUT NOT VERIFIED. THE CONTRACTOR WILL BE RESPONSIBLE FOR FIELD LOCATING ALL POINTS OF CONNECTION.
- PRIOR TO INSTALLATION OF ANY NEW PIPING, CONTRACTOR SHALL EXPOSE ALL POINTS OF CONNECTION AND VERIFY EXACT SIZE, LOCATION, CONDITION, ELEVATION, & TYPE OF MATERIAL. HE SHALL DETERMINE THAT THE EXISTING PIPE IS THE CORRECT SIZE & THAT THE ELEVATION IS LOW ENOUGH TO ACHIEVE THE REQUIRED SLOPE BEFORE NEW PIPING IS CONNECTED; IF NOT, HE SHALL NOTIFY ARCHITECT AND NOT PROCEED WITH INSTALLATION UNTIL INSTRUCTED TO DO SO. SEE SPECIFICATIONS FOR PIPE TESTS AND CLEANING.
- ALL EXISTING DUCTS AND PIPING WHICH ARE NO LONGER REQUIRED AND WHICH INTERFERE WITH CONSTRUCTION OR WILL BE EXPOSED SHALL BE REMOVED AND BE DISPOSED OF AS DIRECTED BY THE OWNER. IF IT IS CONCEALED AND/OR DOES NOT INTERFERE WITH CONSTRUCTION, IT MAY BE CAPPED AND ABANDONED IN PLACE. SEE SPECIFICATIONS. CAP ALL PIPING AS CLOSE TO MAIN AS POSSIBLE TO ELIMINATE DEAD END RUNS. LIMIT ALL NEW & EXISTING CAPPED DEAD END RUNS TO 2'-0" MAXIMUM FOR ALL SERVICES EXCEPT INACCESSIBLE BELOW GRADE WASTE PIPING.
- ALL EXISTING MECHANICAL EQUIPMENT, FIRE PROTECTION ITEMS, PLUMBING FIXTURES, & APPURTENANCES WHICH ARE REMOVED AND NOT RELOCATED SHALL BE TURNED OVER TO THE OWNER. SEE SPECIFICATIONS & NOTE 9.
- ALL EXISTING MECHANICAL EQUIPMENT, PLUMBING, AND FIRE PROTECTION ITEMS & APPURTENANCES WHICH ARE TO BE RELOCATED UNDER THIS CONTRACT SHALL BE COMPLETELY CLEANED AND INSPECTED. IF REPAIR IS REQUIRED TO PUT THEM IN A SATISFACTORY WORKING CONDITION, NOTIFY OWNER BEFORE REINSTALLING.
- ALL INVERT ELEVATIONS, PIPE SIZES, LOCATIONS, AND DEVIATIONS FROM CONTRACT DRAWINGS, INCLUDING EXISTING, SHALL BE RECORDED ON AS-BUILT DRAWINGS.
- ALL END OF PIPING RUN LAVATORIES, SINKS, AND DRINKING FOUNTAINS SHALL HAVE A WALL CLEANOUT BELOW FIXTURE.
- REMOVE EXISTING FIXTURES, EQUIPMENT, AND ALL LOCAL RELATED PIPING, FITTINGS, AND APPURTENANCES WHERE INDICATED AND AS REQUIRED. CAP ALL SERVICE PIPING IN A CONCEALED LOCATION. SEE NOTE 4.
- REFER TO ARCHITECTURAL DOCUMENTS FOR EXACT LOCATION AND HEIGHT OF ALL PLUMBING FIXTURES. COORDINATE WITH ALL OTHER TRADES.
- PRIOR TO DISCONNECTING, REMOVING, OR CAPPING ANY EXISTING SERVICES, VERIFY THAT THEY DO NOT SERVE ANY EXISTING FIXTURES OR EQUIPMENT. IF THEY DO, LEAVE SYSTEM INTACT OR WHERE POSSIBLE AND/OR TO SIMPLIFY OR CLEAN UP SYSTEM, CONNECT TO CLOSEST NEW SERVICES. RECORD ON AS-BUILT DRAWINGS.
- PROVIDE & INSTALL SHUTOFF VALVES ON ALL BRANCH WATER PIPING SERVING FIXTURES AND/OR GROUPS OF FIXTURES OR EQUIPMENT. INSTALL IN LIFTOUT CEILING WHERE POSSIBLE, BEHIND CEILING OR WALL ACCESS PANELS WHERE LIFTOUT CEILING IS NOT AVAILABLE OR AS INDICATED ON THE DRAWINGS. COORDINATE WITH ARCHITECTURAL AND ALL OTHER TRADES.
- BECAUSE OF THE SMALL SCALE OF THE DRAWINGS, IT IS NOT POSSIBLE TO INDICATE ALL OFFSETS, FITTINGS, VALVES, AND ACCESSORIES WHICH MAY BE REQUIRED. THE CONTRACTOR SHALL CAREFULLY INVESTIGATE THE CONDITIONS SURROUNDING THE INSTALLATION OF HIS WORK AND SHALL FURNISH THE NECESSARY FITTINGS, VALVES, TRAPS, ETC., WHICH MAY BE REQUIRED TO COMPLETE THE INSTALLATION IN A SATISFACTORY AND CODE APPROVED MANNER.
- WHERE BRANCH PIPE SIZE IS NOT SHOWN ON DRAWINGS, REFER TO FIXTURE ROUGH-IN SCHEDULE FOR REQUIRED PIPE SIZE.
- IF ANY EXISTING RISERS OR SERVICE PIPING STILL REQUIRED TO REMAIN IN SERVICE AND WHICH INTERFERES WITH NEW CONSTRUCTION IS ENCOUNTERED DURING REMODEL WORK, THE CONTRACTOR SHALL RELOCATE TO THE NEAREST ACCEPTABLE LOCATION AND RECONNECT.
- ALL ORIGINAL INSULATION IS ASSUMED TO BE ASBESTOS TYPE. SEE SPECIFICATIONS FOR SPECIAL CONDITIONS SURROUNDING ITS HANDLING.
- THE RECORD DRAWINGS DO NOT INDICATE THE RAIN DRAIN/STORM DRAIN ROUTING FROM BASEMENT RISER LOCATIONS TO OUTSIDE OF BUILDING. THE CONTRACTOR SHALL FIELD INVESTIGATE AND WHERE POSSIBLE, DETERMINE WHERE RAIN DRAINS EXIT BUILDING AND RECORD ON AS-BUILT DRAWINGS. IF IT IS FOUND THAT ANY RAIN DRAINS CONNECT TO SANITARY SEWER EITHER WITHIN OR OUTSIDE BUILDING, HE SHALL REPORT THIS INFORMATION TO THE ARCHITECT AND ENGINEER.
- A NEW CODE APPROVED VALVE, RACK, HOSE, NOZZLE, AND APPURTENANCES SHALL BE INSTALLED IN ALL EXISTING FIRE HOSE CABINETS TO BE RELOCATED OR TO REMAIN.
- ALL FIRE SPRINKLER HEADS HAVE NOT BEEN SHOWN OR SCHEDULED. IT IS THE RESPONSIBILITY OF THE CONTRACTOR TO LOCATE AND INSTALL A COMPLETE FIRE SPRINKLER SYSTEM IN ALL PORTIONS OF THE BUILDING EXCEPT AUDITORIUM AND OTHER AREAS THE FIRE MARSHAL HAS EXEMPTED.
- ALL FIRE PROTECTION WITHIN THE BUILDING WHICH IS SERVED BY THE DOMESTIC WATER SERVICE INCLUDING REWORKING EXISTING FIRE HOSE CABINETS SHALL BE THE RESPONSIBILITY OF THE PLUMBING CONTRACTOR.
- WHERE NEW OR RELOCATED DIFFUSERS OR GRILLES ARE SHOWN, REFER TO ARCHITECTURAL CEILING PLANS & ELEVATIONS FOR THEIR EXACT LOCATION.
- ALL ELEVATIONS SHOWN ON THESE DRAWINGS MAY BE APPROXIMATE, SEE ARCHITECTURAL DRAWING FOR ACTUAL ELEVATIONS.

**LEGEND**

LPS	LPS	LOW PRESSURE STEAM SUPPLY	HX	HEAT EXCHANGER
LPR	LPR	LOW PRESSURE CONDENSATE RETURN	SHB	STEAM HEATING BOILER
HWS	HWS	HEATING WATER SUPPLY	ET	EXPANSION TANK
HWR	HWR	HEATING WATER RETURN	WCU	WATER CHILLER UNIT
CWS	CWS	CHILLED WATER SUPPLY	HWP	HEATING WATER PUMP
CMR	CMR	CHILLED WATER RETURN	CWP	CHILLED WATER PUMP
CLW	CLW	CONDENSER LEAVING WATER	CDP	CONDENSER WATER PUMP
CRW	CRW	CONDENSER RETURN WATER	CCC	CLOSED CIRCUIT COOLER
RRV	RRV	REFRIGERANT RELIEF VENT	ACCU	AIR COOLED CONDENSING UNIT
RL	RL	REFRIGERANT LIQUID	ASU	AIR SUPPLY UNIT
RS	RS	REFRIGERANT SUCTIION	ACU	AIR CONDITIONING UNIT
CD	CD	CONDENSATE DRAIN	SF	SUPPLY FAN
W	W	SANITARY SOIL OR WASTE ABOVE FLOOR	RF	RETURN FAN
M	M	SANITARY SOIL OR WASTE BELOW FLOOR OR GRADE	EF	EXHAUST FAN
SD	SD	STORM DRAIN ABOVE FLOOR	REF	ROOF EXHAUST FAN
SD	SD	STORM DRAIN BELOW FLOOR OR GRADE	RC	RELIEF CAP
OSD	OSD	OVERFLOW STORM DRAIN ABOVE FLOOR	RDR	STEAM RADIATOR
V	V	VENT	CV	CONNECTOR
CM	CM	COLD WATER	CUH	CABINET UNIT HEATER
PCW	PCW	PROCESS COLD WATER	UH	UNIT HEATER
HW	HW	HOT WATER	BHC	BOOSTER HEATING COIL
RHW	RHW	RECIRCULATED HOT WATER	HC	HEATING COIL
F	F	FIRE PROTECTION (WET)	CC	COOLING COIL
FS	FS	FIRE PROTECTION (SPRINKLER FROM FCS)	OSA	OUTSIDE AIR
DP	DP	FIRE PROTECTION (DRY)	AUD	AUTOMATIC DAMPER
WSP	WSP	WET STANDPIPE (CLASS II FROM DOMESTIC WATER)	OAD	OUTSIDE AIR DAMPER
CSP	CSP	COMBINATION STANDPIPE	RAD	RETURN AIR DAMPER
MG	MG	NATURAL GAS (MEDIUM PRESSURE - 2 PSI)	EAD	EXHAUST AIR DAMPER
G	G	NATURAL GAS (LOW PRESSURE - 11" W.C.)	SMD	SMOKE DAMPER
V(G)	V(G)	VENT (GAS)	6Φ	ROUND DUCT DIAMETER, INCHES
		REMOVE EXISTING PIPING OR ABANDON IN PLACE	32x14	RECTANGULAR DUCT SIZE, INCHES
OS&Y	OS&Y	OUTSIDE SCREW AND YOKE VALVE	CS	CEILING SUPPLY DIFFUSER
OS&Y/TS	OS&Y/TS	OS&Y VALVE WITH TAMPER SWITCH	CR	CEILING RETURN GRILLE
GV	GV	GATE VALVE	CE	CEILING EXHAUST GRILLE
GLV	GLV	GLOBE VALVE	HS	HIGH SUPPLY GRILLE
BV	BV	BALL VALVE	HR	HIGH RETURN GRILLE
GC	GC	GAS COCK	HE	HIGH EXHAUST GRILLE
CKV	CKV	CHECK VALVE	LS	LOW SUPPLY GRILLE
BVF	BVF	BUTTERFLY VALVE	LR	LOW RETURN GRILLE
BAL	BAL	BALANCING FITTING	LCS	LINEAR CEILING SUPPLY DIFFUSER
FCV	FCV	FLOW CONTROL VALVE	WG	WALL GRILLE
MV	MV	TWO-WAY MOTORIZED VALVE	SMB	STARTER MOUNTING BOARD (SEE ELECT.)
MV	MV	THREE-WAY MOTORIZED VALVE	DDCU	DIRECT DIGITAL CONTROL UNIT
MV	MV	MOTORIZED BUTTERFLY VALVE	MCC	MOTOR CONTROL CENTER (SEE ELECT.)
PRV	PRV	PRESSURE REDUCING VALVE	Ⓡ	ROOM THERMOSTAT OR SENSOR
RV	RV	PRESSURE RELIEF VALVE	Ⓢ	ZONE AIR DUCT
WH	WH	WALL HYDRANT	N.O.	NORMALLY OPEN
DV	DV	HOSE END DRAIN VALVE	N.C.	NORMALLY CLOSED
HB	HB	HOSE BIBB	D.A.	DIRECT ACTING
AV	AV	AIR VENT	R.A.	REVERSE ACTING
VB	VB	VACUUM BREAKER	P.E.	PNEUMATIC - ELECTRIC
WHA	WHA	WATER HAMMER ARRESTOR (SIZE C)	SAV	SOLENOID AIR VALVE
STR	STR	STRAINER WITH HOSE END DRAIN VALVE	NLL	NIGHT LOW LIMIT
		PIPE ANCHOR	WC	WATER CLOSET
		FLEXIBLE CONNECTOR	U	URINAL
		UNION, FLANGE	L	LAVATORY
		PIPE REDUCER	S	SINK
		SPRINKLER HEAD - UPRIGHT, PENDENT, RECESSED & FLUSH	SS	SERVICE SINK
		SPRINKLER HEAD - SIDEWALL & PENDENT SIDEWALL	MS	MOP SINK
		PRESSURE GAGE WITH GAGE COCK	SHR	SHOWER
		GAGE COCK	DF	DRINKING FOUNTAIN
		THERMOMETER	EW	ELECTRIC WATER HEATER
FS	FS	FLOW SWITCH	RHP	RECIRCULATING HOT WATER PUMP
		IMMERSION THERMOSTAT	RPBP	REDUCED PRESSURE BACKFLOW PREVENTER
		PITCHED DOWN	DCA	DOUBLE CHECK VALVE ASSEMBLY
PTT	PTT	PRESSURE TEMPERATURE TAP	DDCA	DOUBLE DETECTOR CHECK VALVE ASSEMBLY
		DIRECTION OF FLOW	FCS	FLOOR CONTROL STATION (FIRE SPRINKLER)
		VALVE IN RISER	FHC	FIRE HOSE CABINET
		CAP OR PLUG	FHR	FIRE HOSE REEL
CTG	CTG	CLEANOUT TO GRADE	FHV	FIRE HOSE VALVE
FCO	FCO	FLOOR CLEANOUT	FDC	FIRE DEPARTMENT CONNECTION
WCO	WCO	WALL CLEANOUT	FD	FLOOR DRAIN
CO	CO	CLEANOUT	SHD	SHOWER DRAIN
TPV	TPV	TRAP PRIMER VALVE	DS	DOWNSPOUT
GPR	GPR	GAS PRESSURE	RD	ROOF DRAIN
		AIR FLOW DIRECTION	ORD	OVERFLOW ROOF DRAIN
		SUPPLY OR OSA DUCT SECTION ROUND, RECTANGULAR	VTR	VENT THROUGH ROOF
		RETURN OR EXHAUST DUCT SECTION ROUND, RECTANGULAR	CIP	CAST IRON PIPE
		INTERNALLY INSULATED DUCT DOUBLE LINE, SINGLE LINE	I.E.	INVERT ELEVATION
		FLEXIBLE EQUIPMENT CONNECTION	EL	ELEVATION
FLD	FLD	FUSIBLE LINK DAMPER DOUBLE LINE, SINGLE LINE	FF	FINISHED FLOOR
		BUTTERFLY VOLUME DAMPER DOUBLE LINE, SINGLE LINE		
		DUCT LAGGING DOUBLE LINE	NIM	NOT IN MECHANICAL - ANOTHER DIVISION SPECIFIED UNDER ANOTHER DIVISION
			Ⓐ	ACCESS DOOR
			Ⓑ	CONNECT TO EXISTING
			Ⓒ	EXISTING TO REMAIN
			Ⓓ	CAP OR PLUG
			Ⓔ	NEW
			Ⓛ	RELOCATE EXISTING THROUGH TRUSS WEB
			Ⓜ	LOCATE IN WALL SPACE
			Ⓝ	REMOVE EXISTING
			■	NEW PLUMBING FIXTURE
			□	REMOVE EXISTING FIXTURE, EQUIPMENT OR ITEM.

# Portland Center for the Performing Arts



The City of Portland  
Honorable Mildred A. Schwab,  
Commissioner in Charge  
Ronald K. Ragen: Chairman  
Performing Arts Center  
Committee

Broome, Oringdolph, O'Toole, Rudolf & Associates, P.C.  
ELS Design Group  
Barton Myers  
Theatre Projects, Inc.  
R. Lawrence Kirkegaard & Associates  
Interface Engineering, Inc.  
C.W. Timmer & Associates  
CH2M Hill  
Project Address:  
733 N.W. 20th Avenue  
Portland, Oregon 97209  
(503) 226-1575

**SITE PLAN AND LEGEND**


Job No.	Date
Set No.	Sheet No.
8.1	



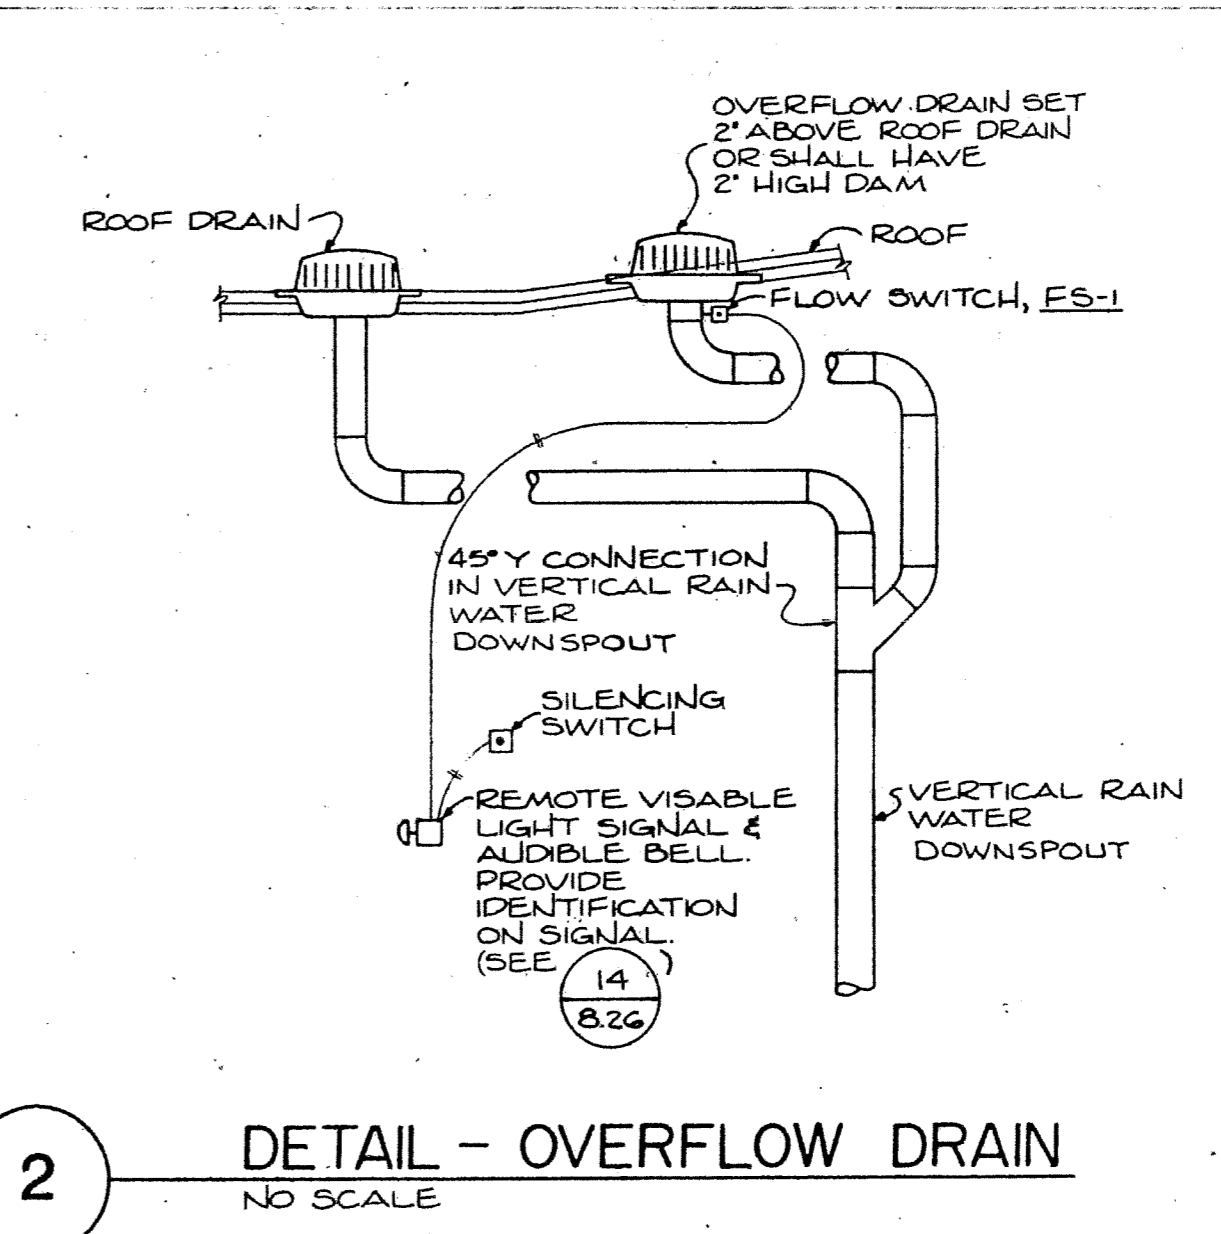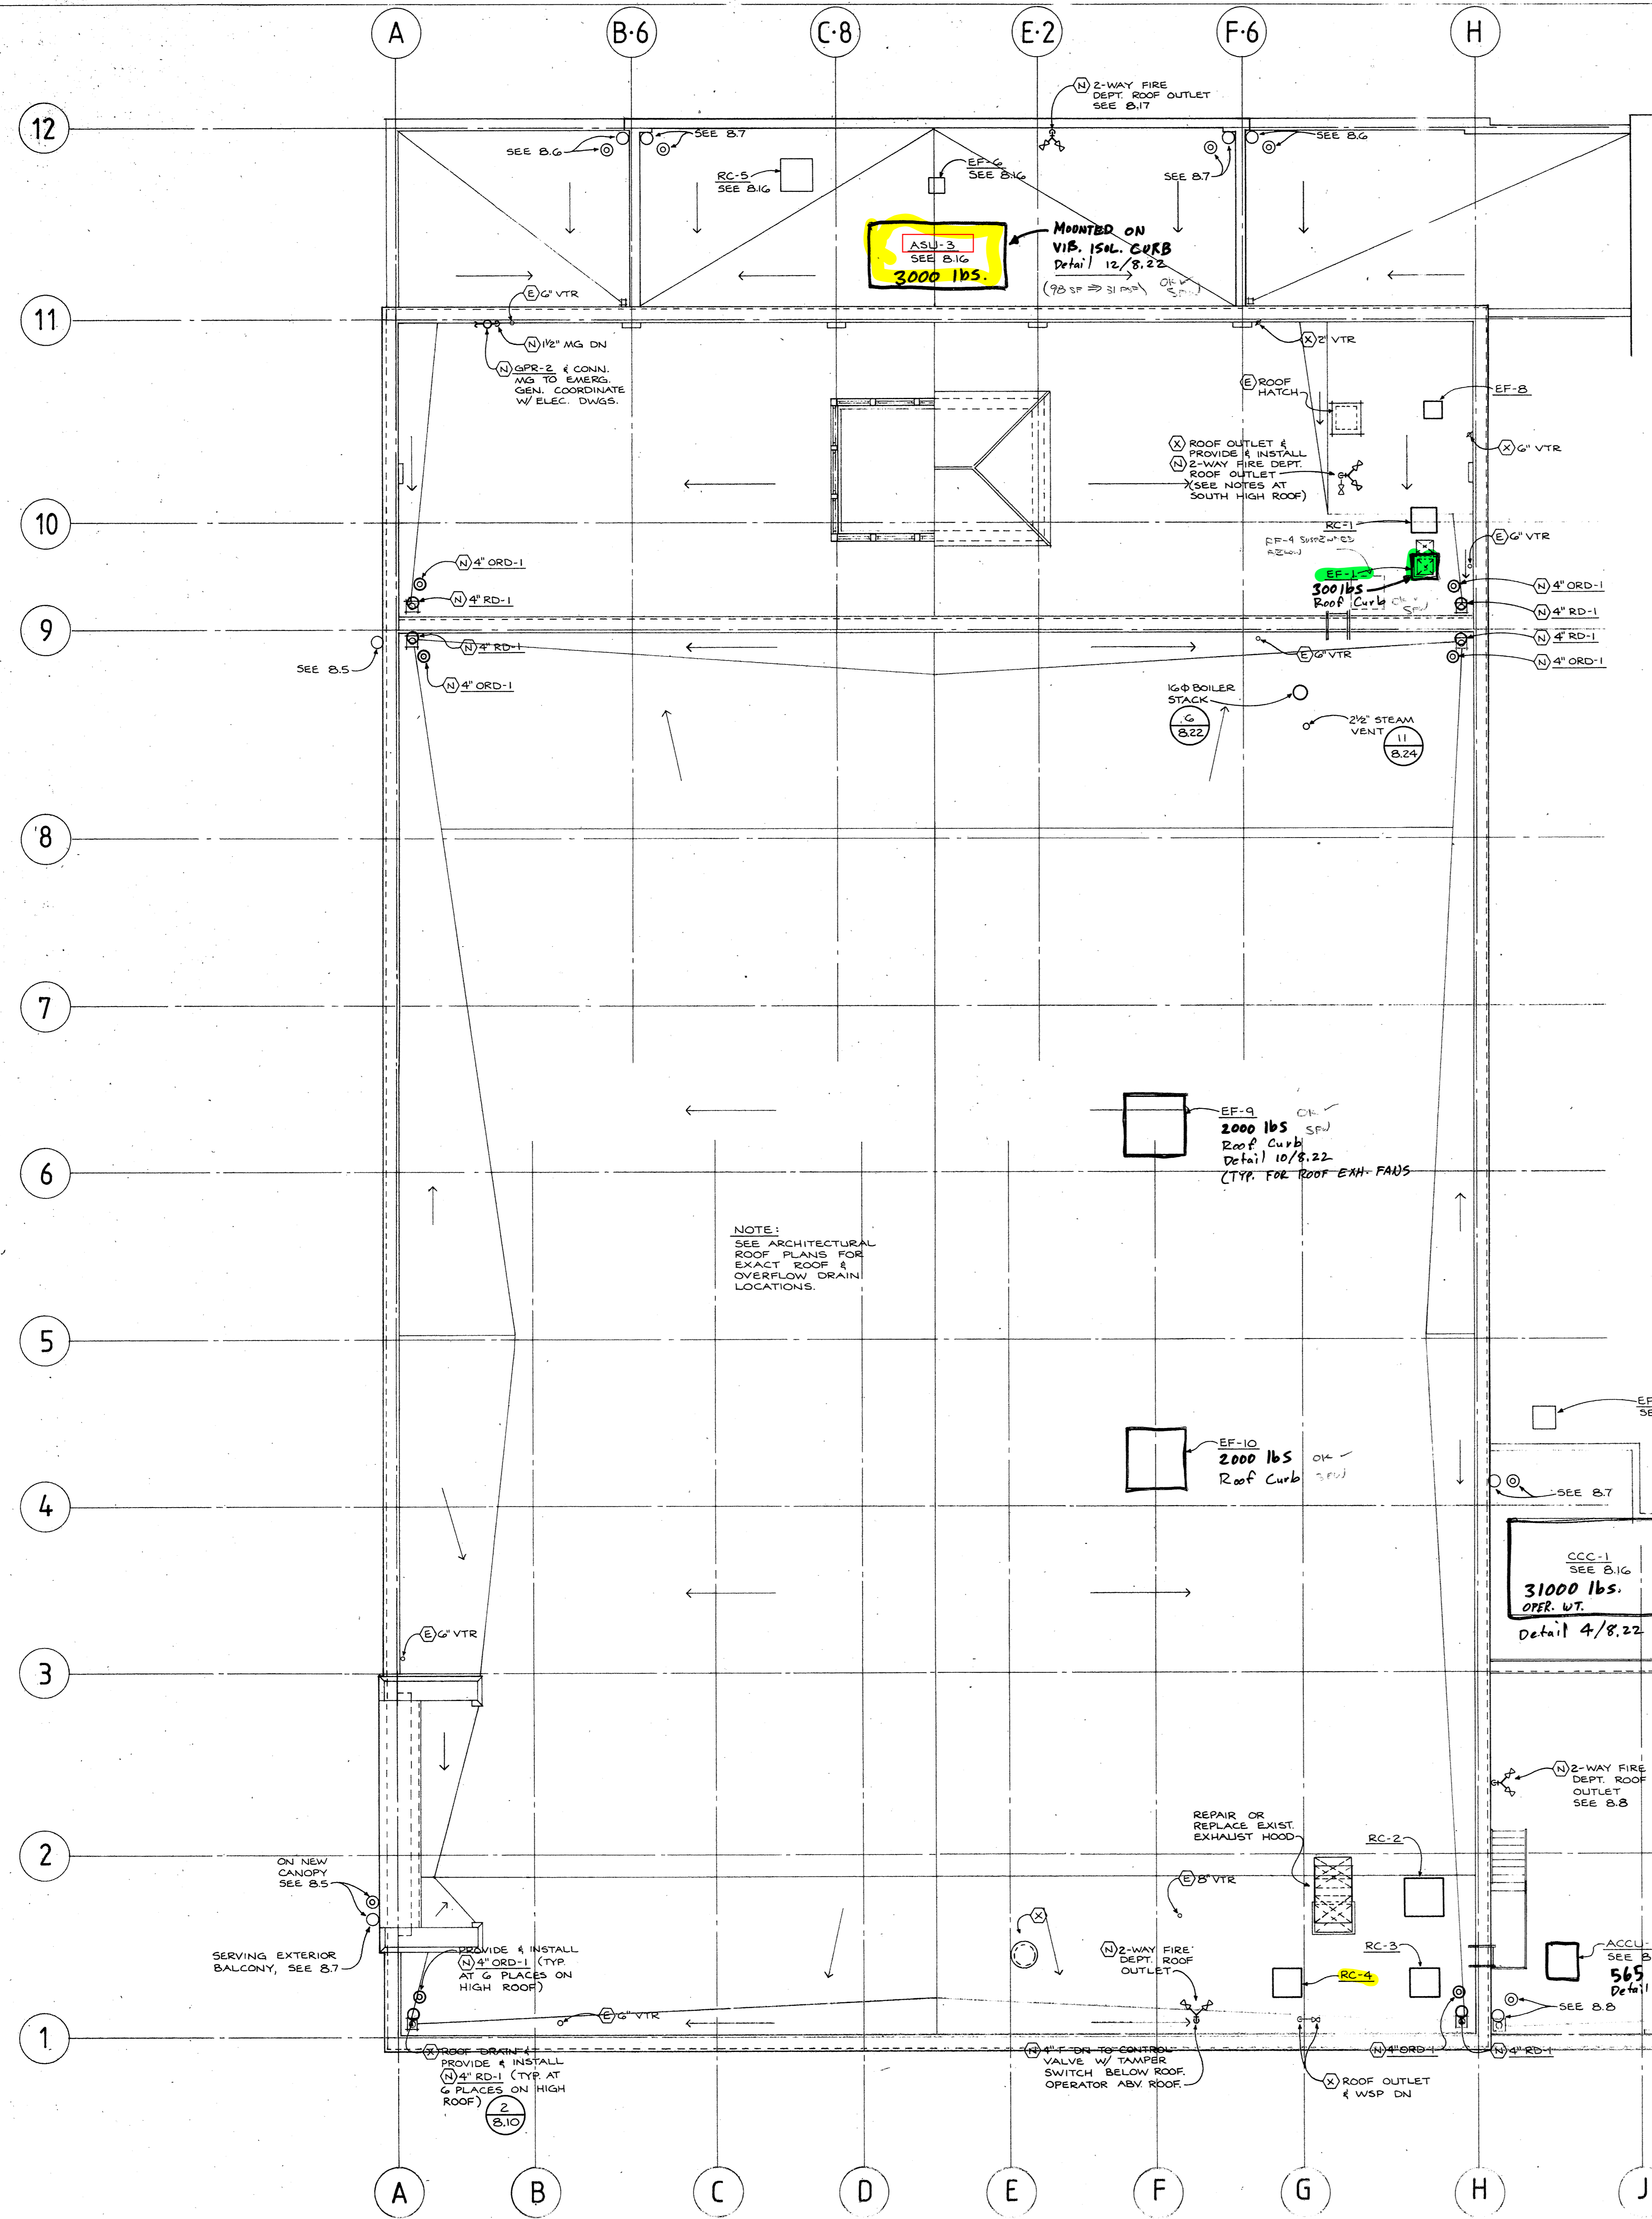

2 DETAIL - OVERFLOW DRAIN  
NO SCALE

REVIEWED FOR CONSTRUCTION BY ORIGINAL MECHANICAL DESIGNER SET NEW MECHANICAL CALCULATIONS SDW = LTE 1-26-84 CH2M Hill, Inc.

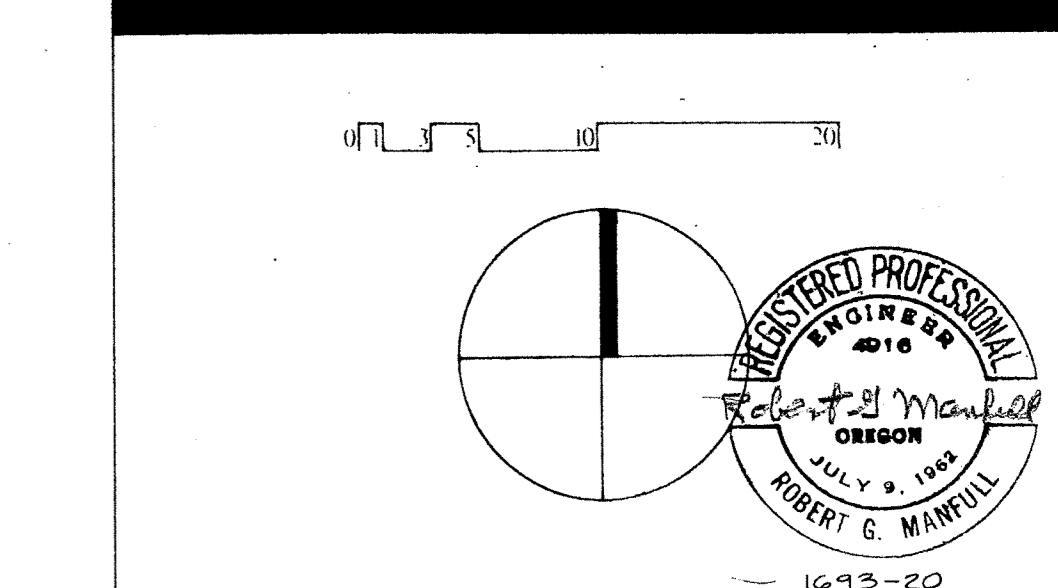

Portland Performing Arts Center  
ROOF PLAN  
MECHANICAL

Broomer, Oringulph, O'Loire, Rudolf & Associates, P.C.  
E.L.S. Design Group  
Barlow Myers  
Theatre Projects Inc.  
R. Lawrence Kirkgaard & Associates  
Interface Engineering, Inc.  
C.W. Timmer & Associates  
CH2M Hill



8.10

ROOF PLAN

# Portland Center for the Performing Arts

The City of Portland  
Honorable Mildred A. Schwab;  
Commissioner in Charge  
Ronald K. Ragen; Chairman  
Performing Arts Center  
Committee

Broome, Oringdolph, O Toole, Rudolf & Associates, P.C.  
ELS Design Group  
Barton Myers  
Theatre Projects, Inc.  
R. Lawrence Kirkegaard & Associates  
Interface Engineering, Inc.  
C.W. Timmer & Associates  
CH2M Hill  
Project Address:  
733 N.W. 20th Avenue  
Portland, Oregon 97209  
(503) 226-1575

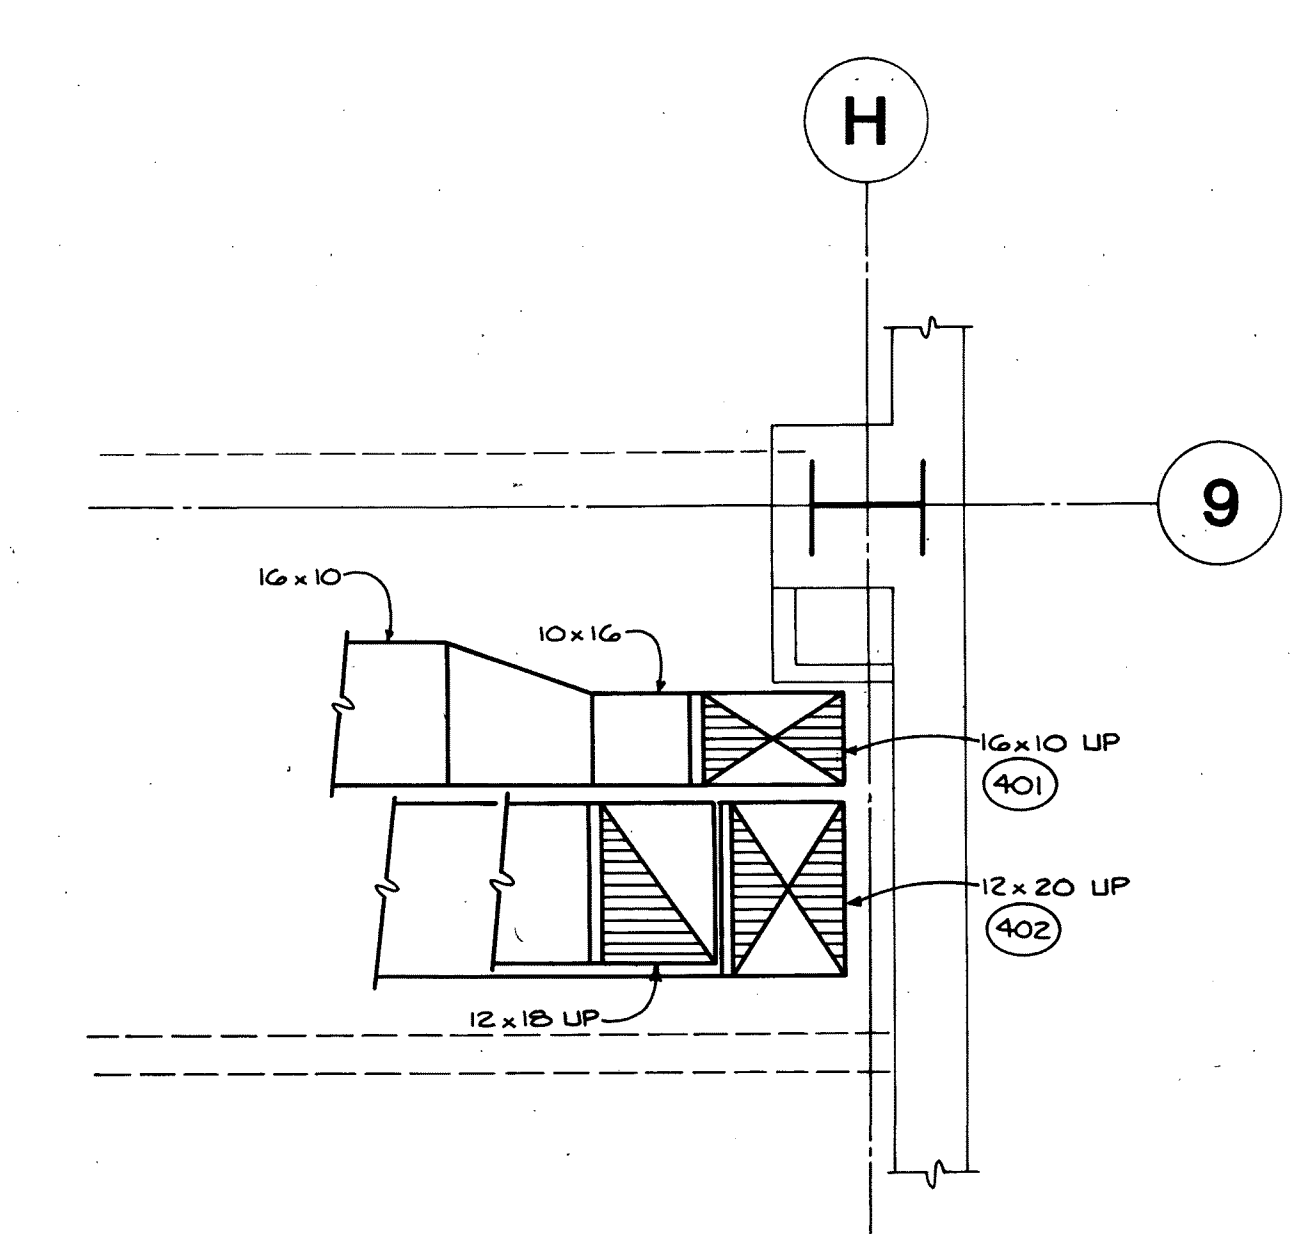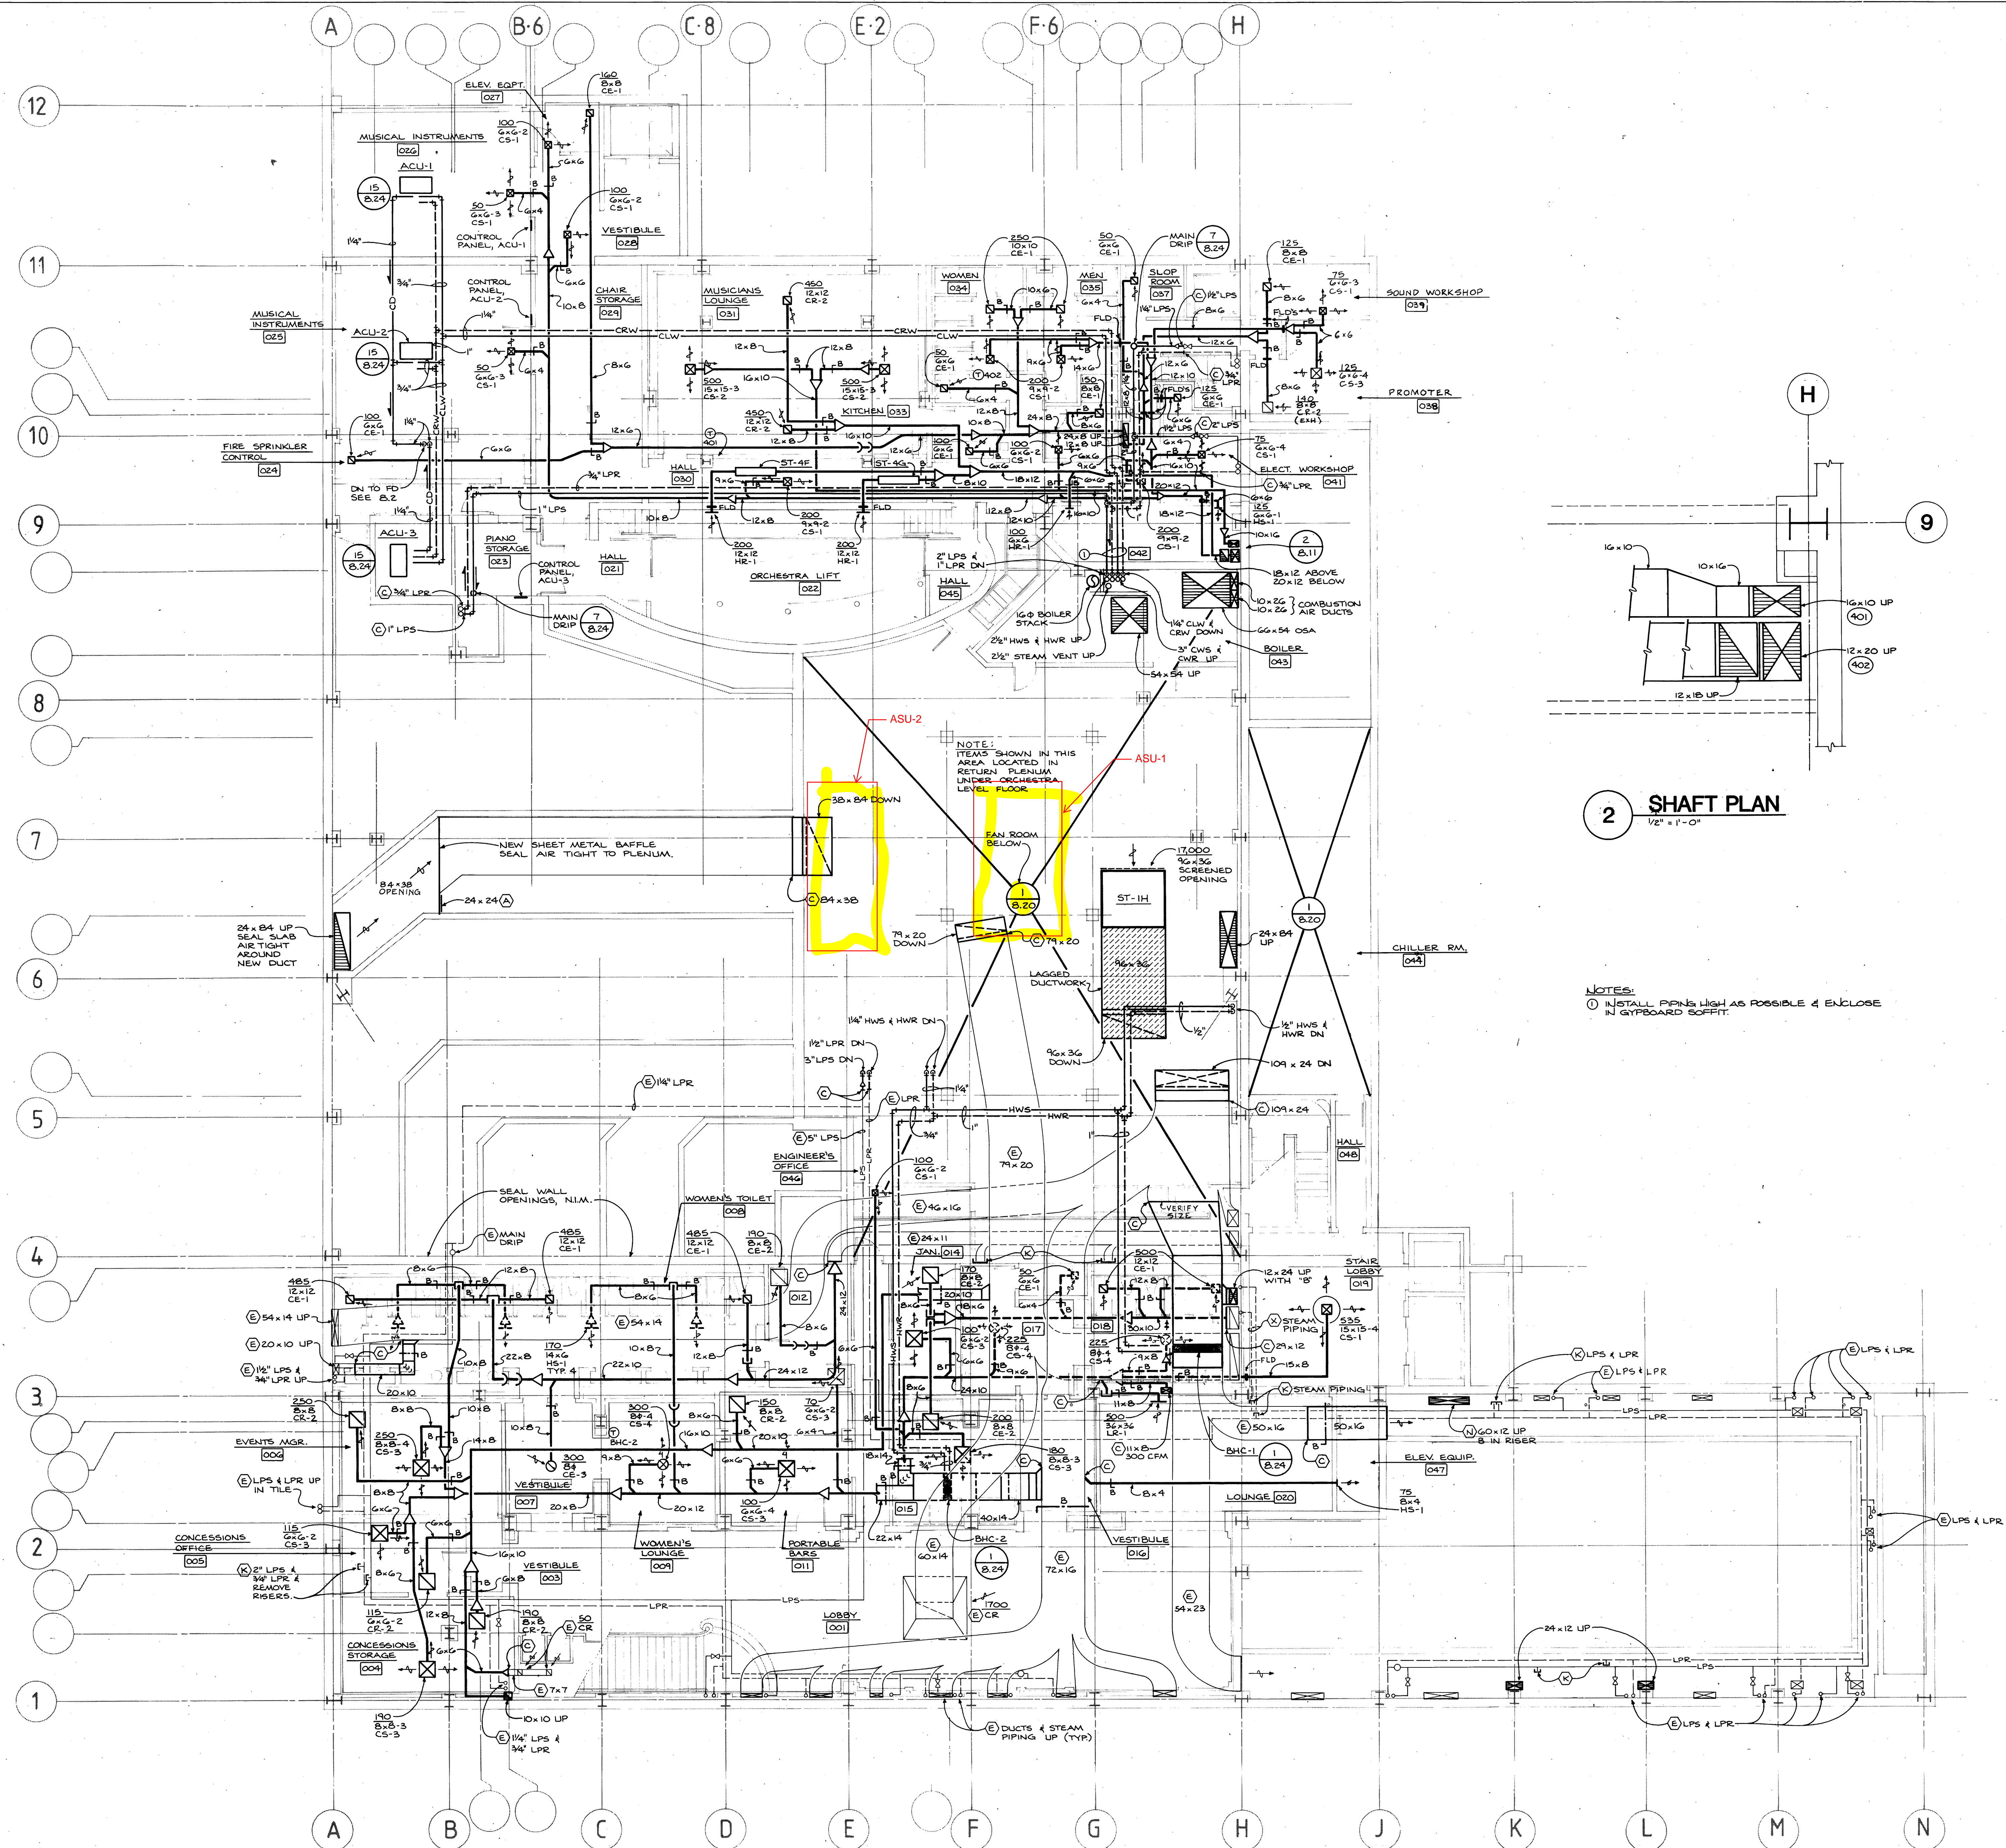


2 SHAFT PLAN  
1/2" = 1'-0"

NOTES:  
1. INSTALL PIPING AS HIGH AS POSSIBLE & ENCLOSE IN GYPSUM SOFFIT.

## BASEMENT PLAN - HVAC

Job No.	Date
Set No.	Sheet No.
8.11	



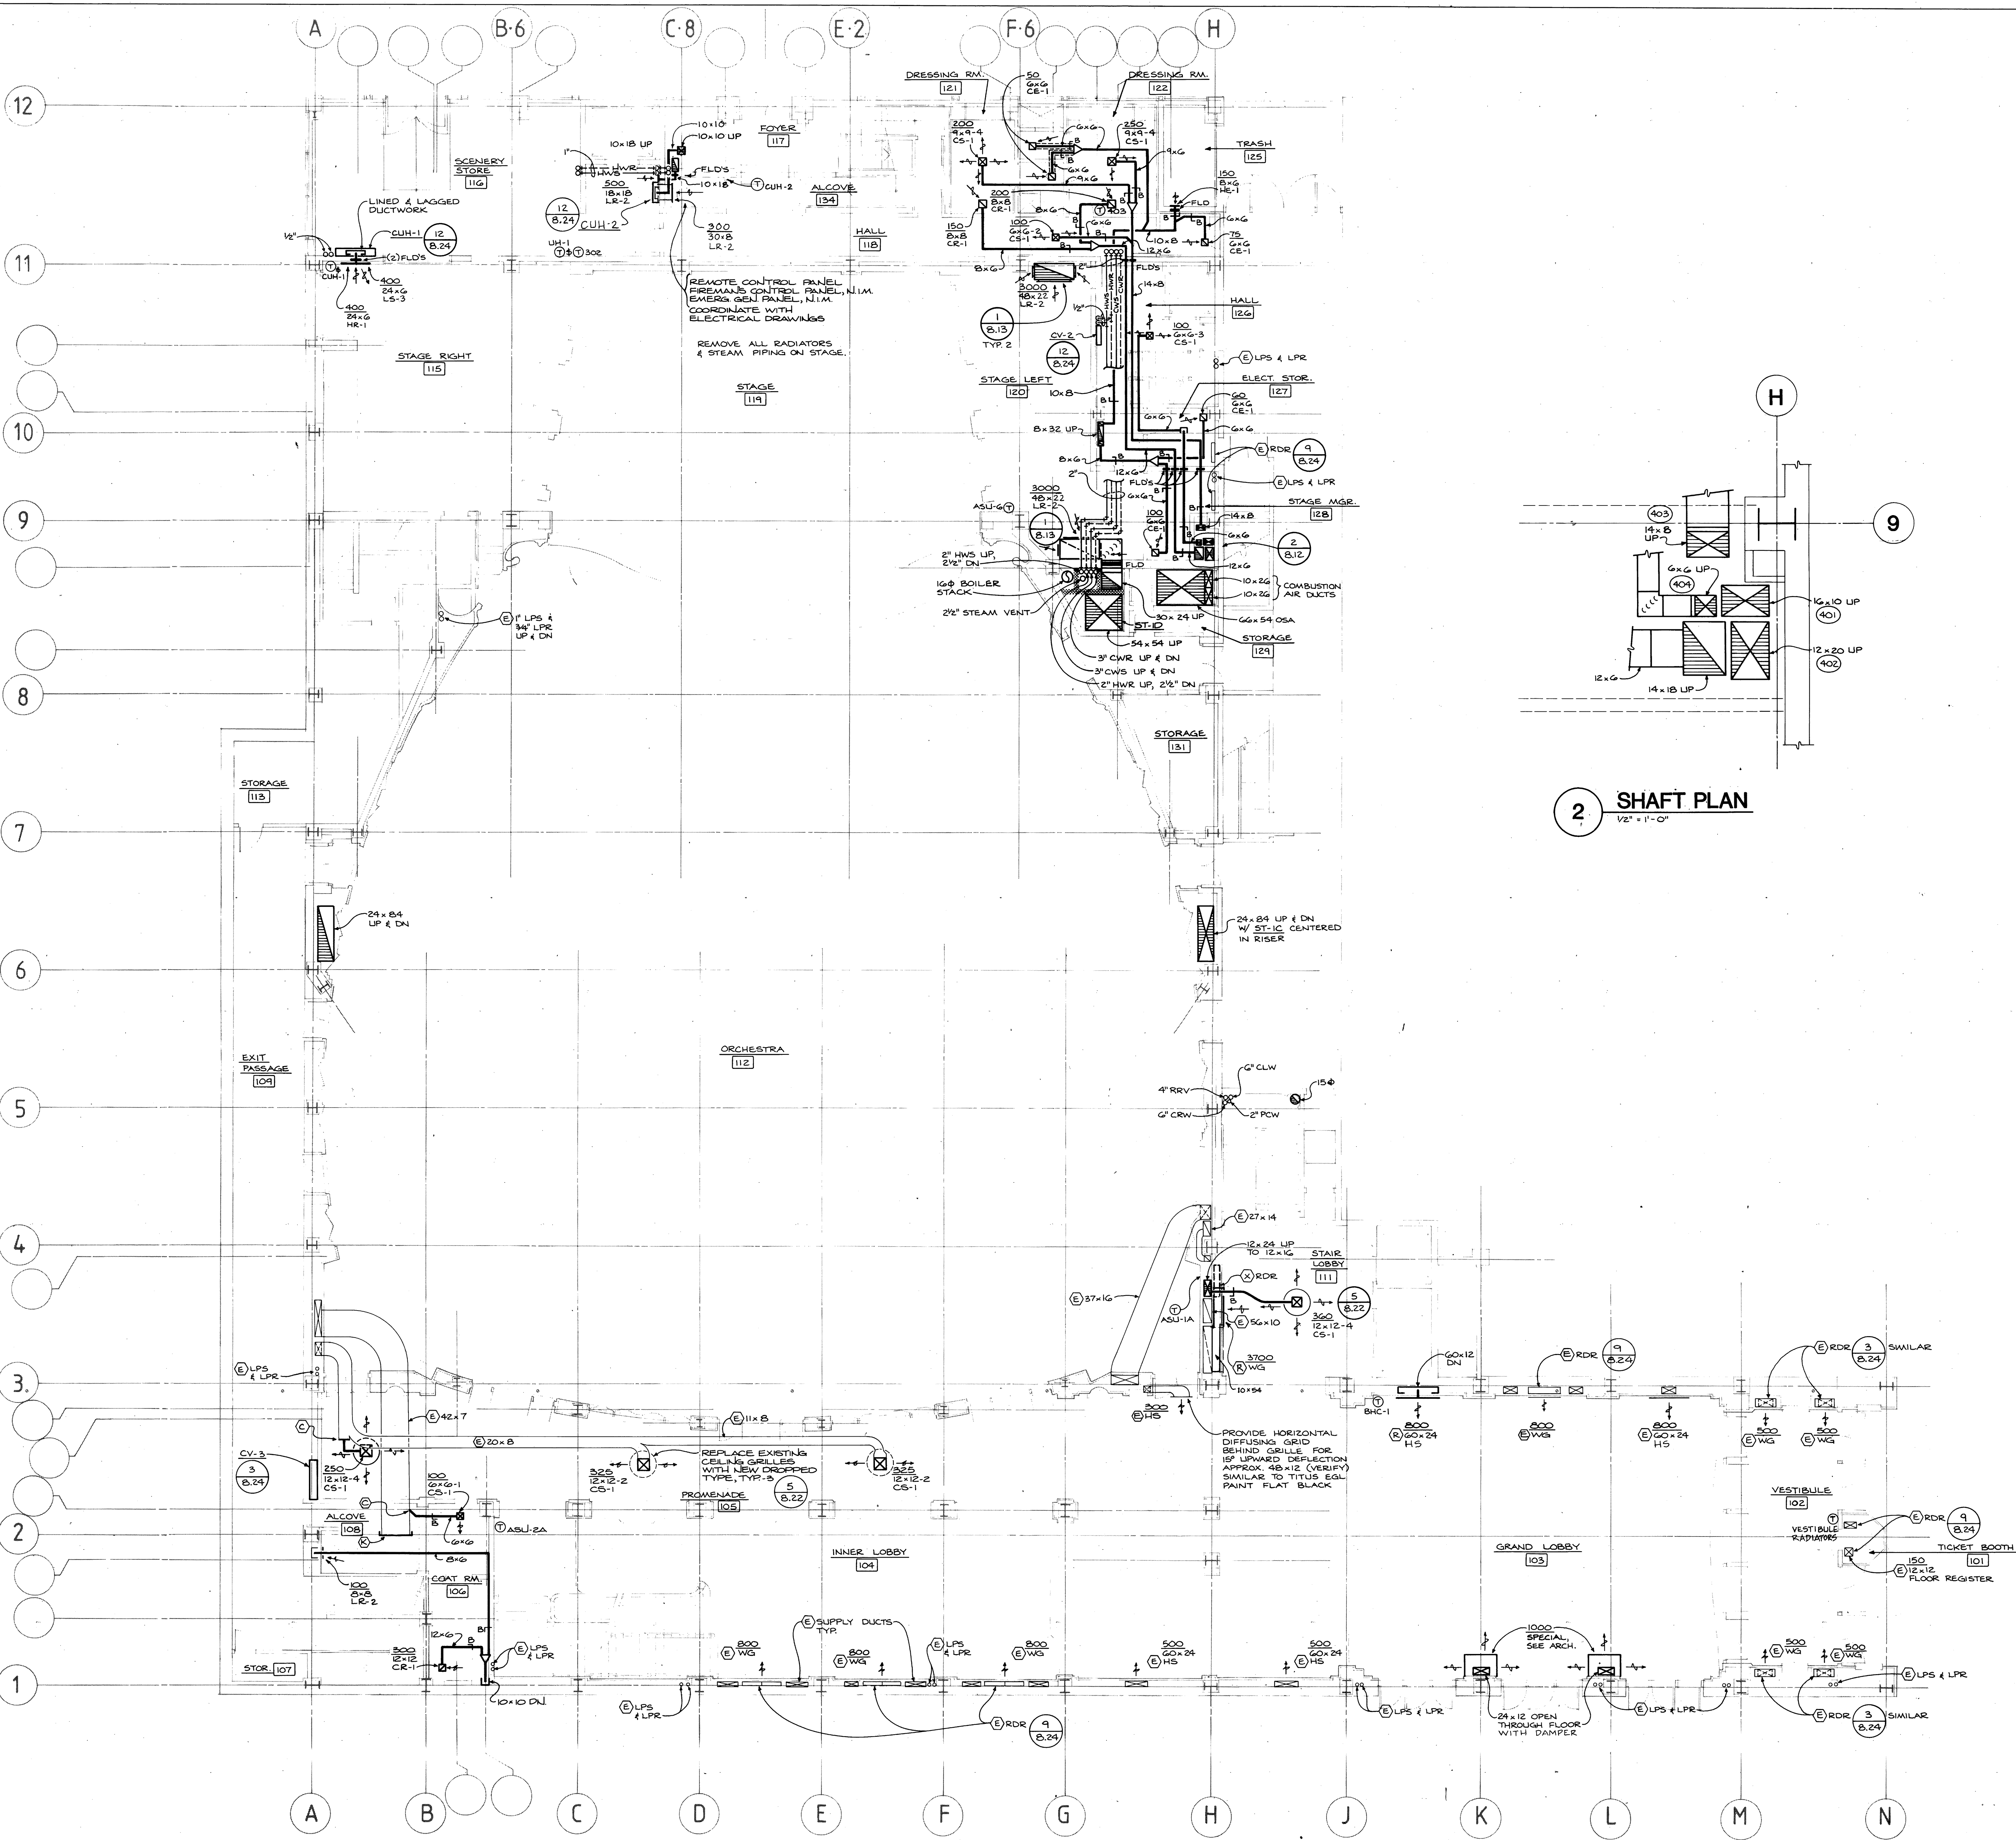

**2 SHAFT PLAN**  
1/2" = 1'-0"

# Portland Center for the Performing Arts

The City of Portland  
 Honorable Mildred A. Schwab;  
 Commissioner in Charge  
 Ronald K. Ragen; Chairman  
 Performing Arts Center  
 Committee

Broome, Oringdolph, O'Toole, Rudolf & Associates, P.C.  
 ELS Design Group  
 Barton Myers  
 Theatre Projects, Inc.  
 R. Lawrence Kirkgaard & Associates  
 Interface Engineering, Inc.  
 C.W. Timmer & Associates  
 CH2M Hill  
 Project Address:  
 733 N.W. 20th Avenue  
 Portland, Oregon 97209  
 (503) 226-1575



## ORCHESTRA PLAN HVAC



Job No. \_\_\_\_\_ Date JULY 18, 1985  
 Set No. \_\_\_\_\_ Sheet No. \_\_\_\_\_

8.12


# Portland Center for the Performing Arts

The City of Portland  
 Honorable Mildred A. Schwab;  
 Commissioner in Charge  
 Ronald K. Ragen; Chairman  
 Performing Arts Center  
 Committee


Broome, Oringdolph, O'Toole, Rudolf & Associates, P.C.  
 ELS Design Group  
 Barton Myers  
 Theatre Projects, Inc.  
 R. Lawrence Kirkegaard & Associates  
 Interface Engineering, Inc.  
 C.W. Timmer & Associates  
 CH2M Hill  
 Project Address:  
 733 N.W. 20th Avenue  
 Portland, Oregon 97209  
 (503) 226-1575

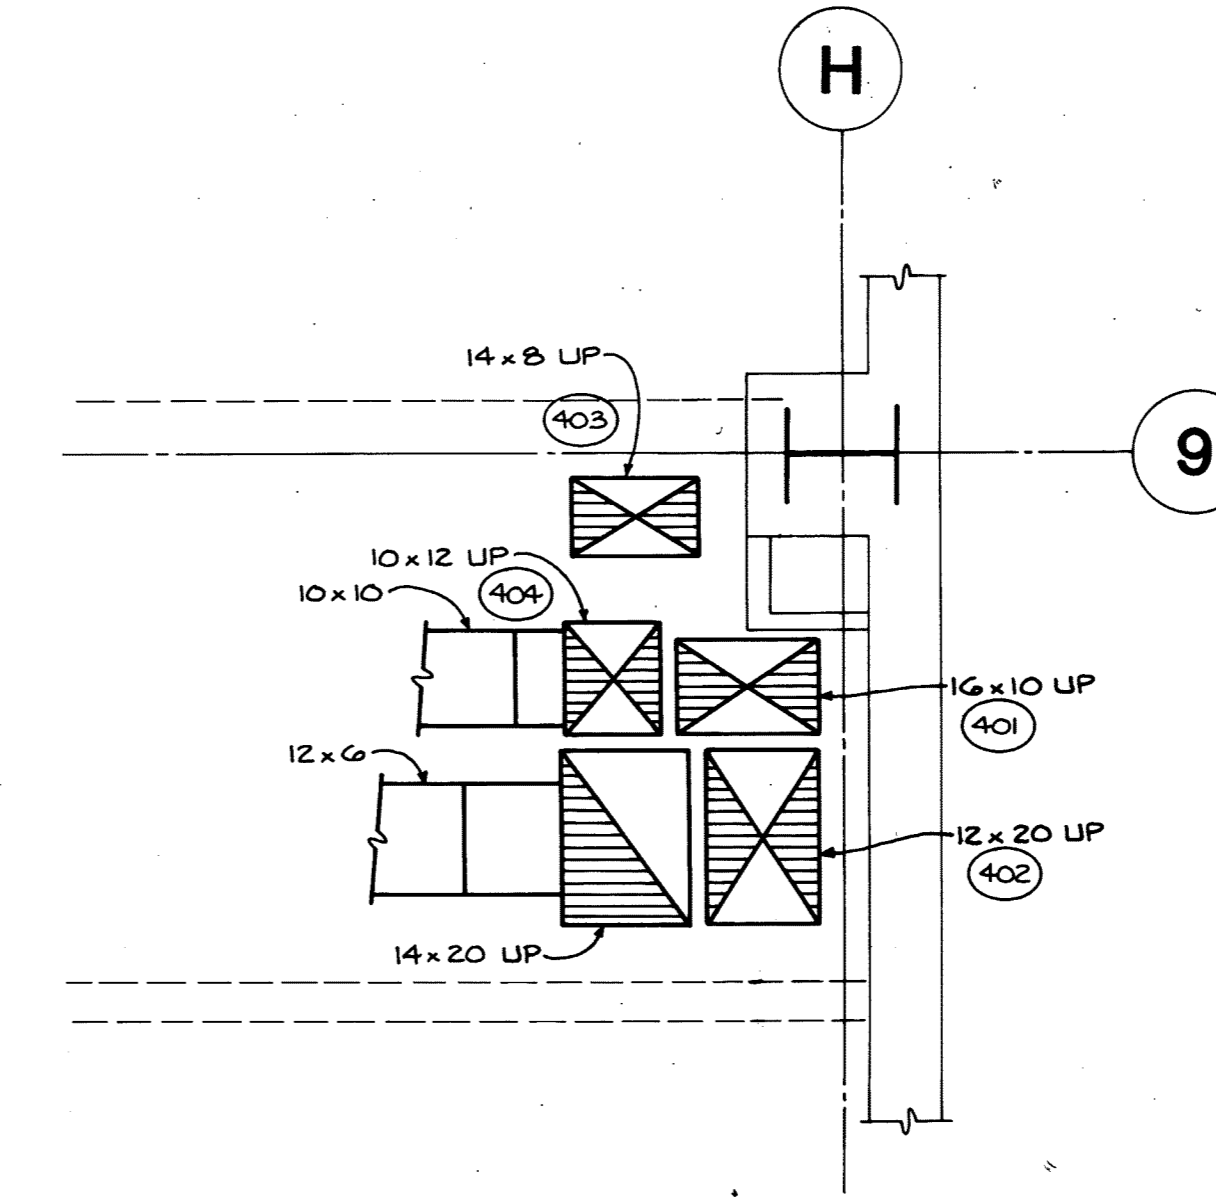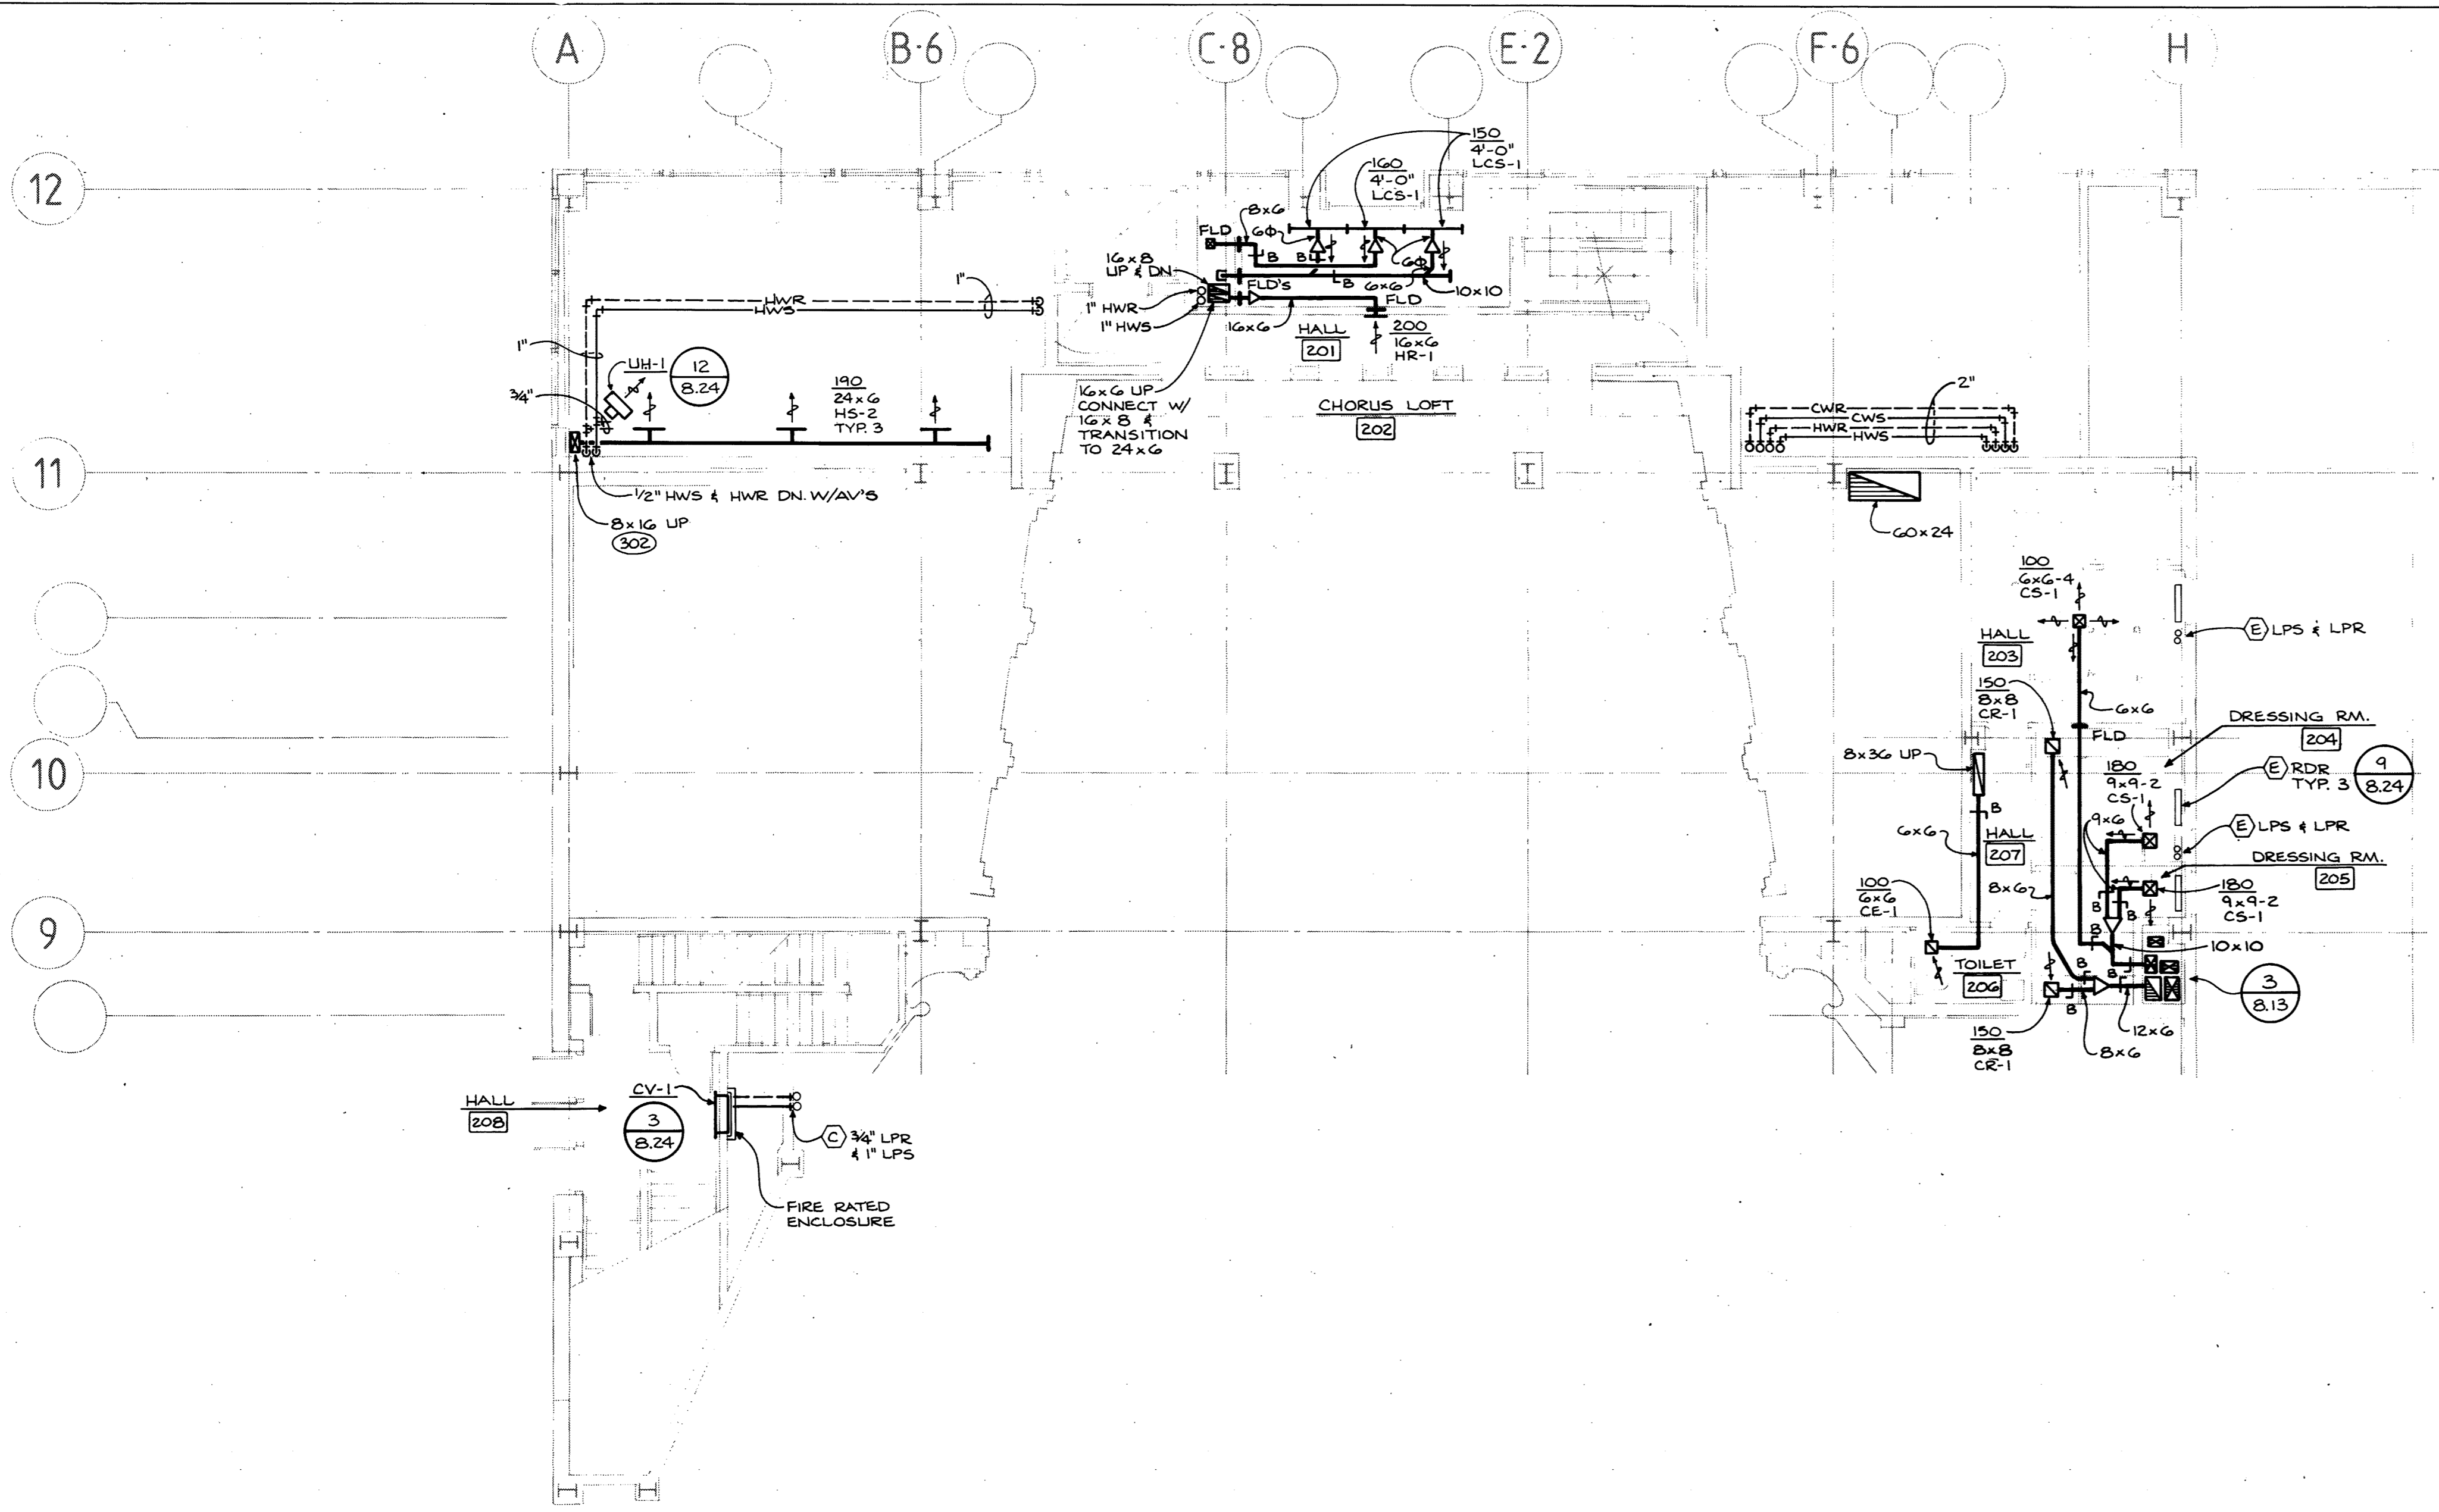


**3** SHAFT PLAN  
 1/2" = 1'-0"

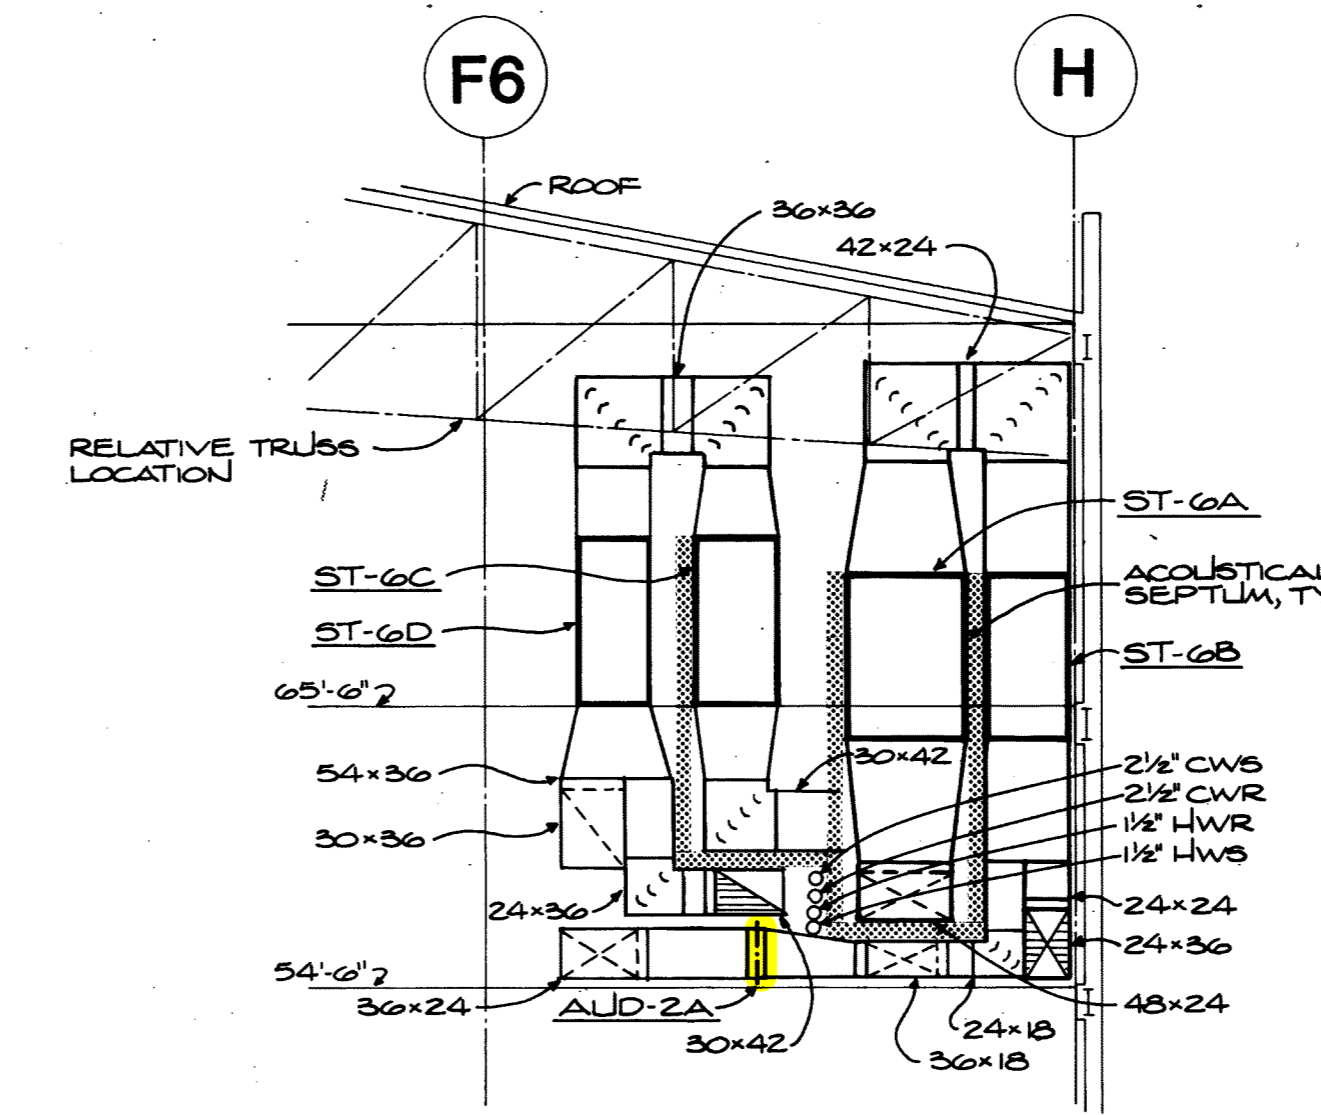


**2** SECTION - ASU-6 DUCTWORK  
 1/8" = 1'-0"

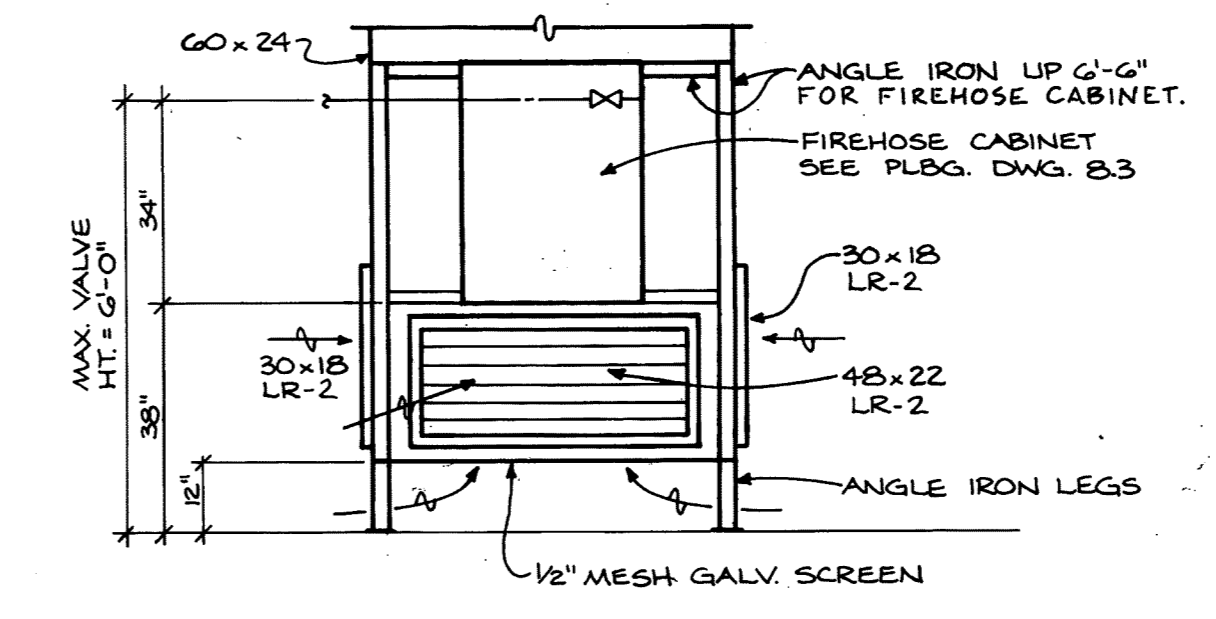


**1** DETAIL - STAGE LOW RETURN  
 NO SCALE

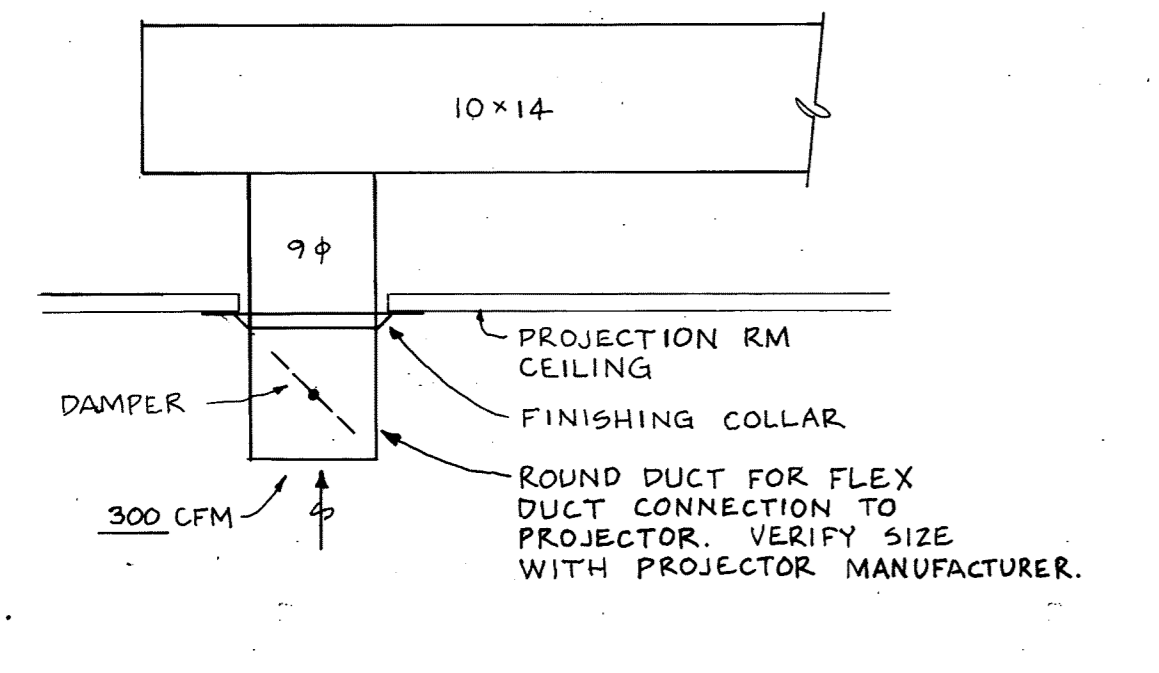

**7** DETAIL-PROJ. ROOM EXHAUST  
 NO SCALE

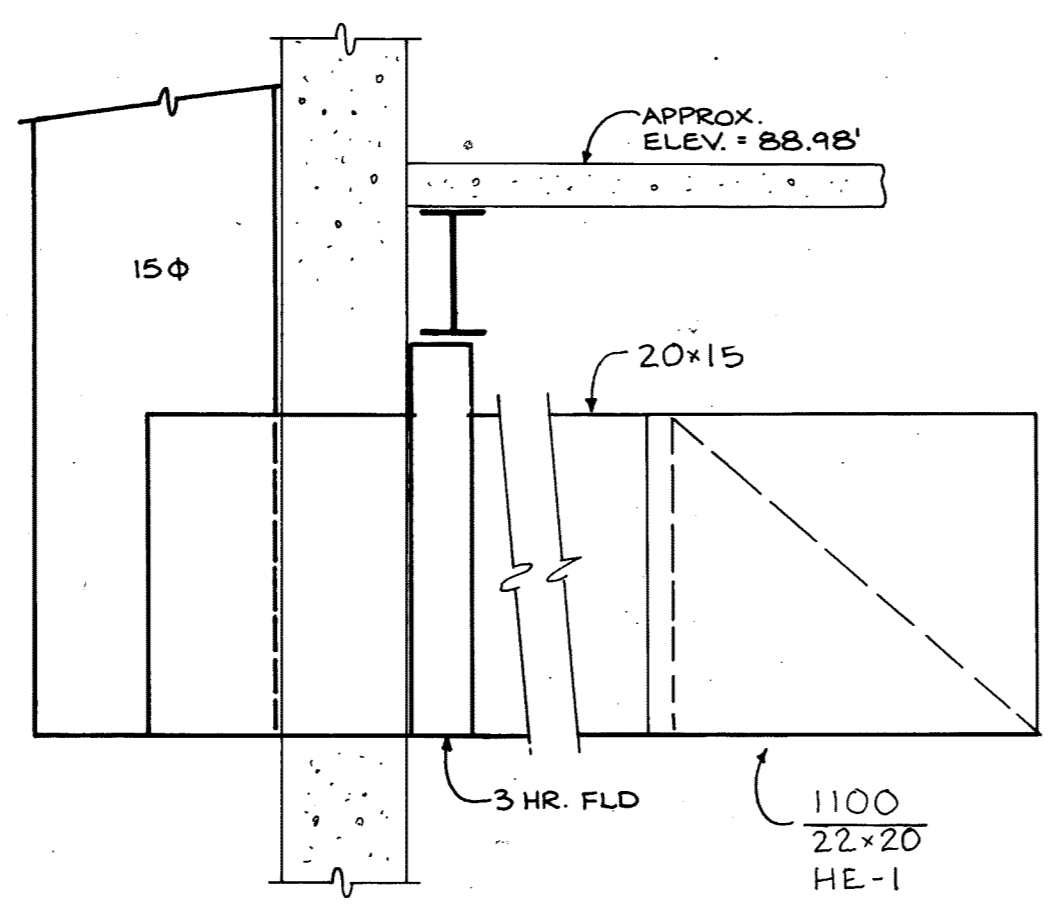


**6** SECTION  
 1" = 1'-0"

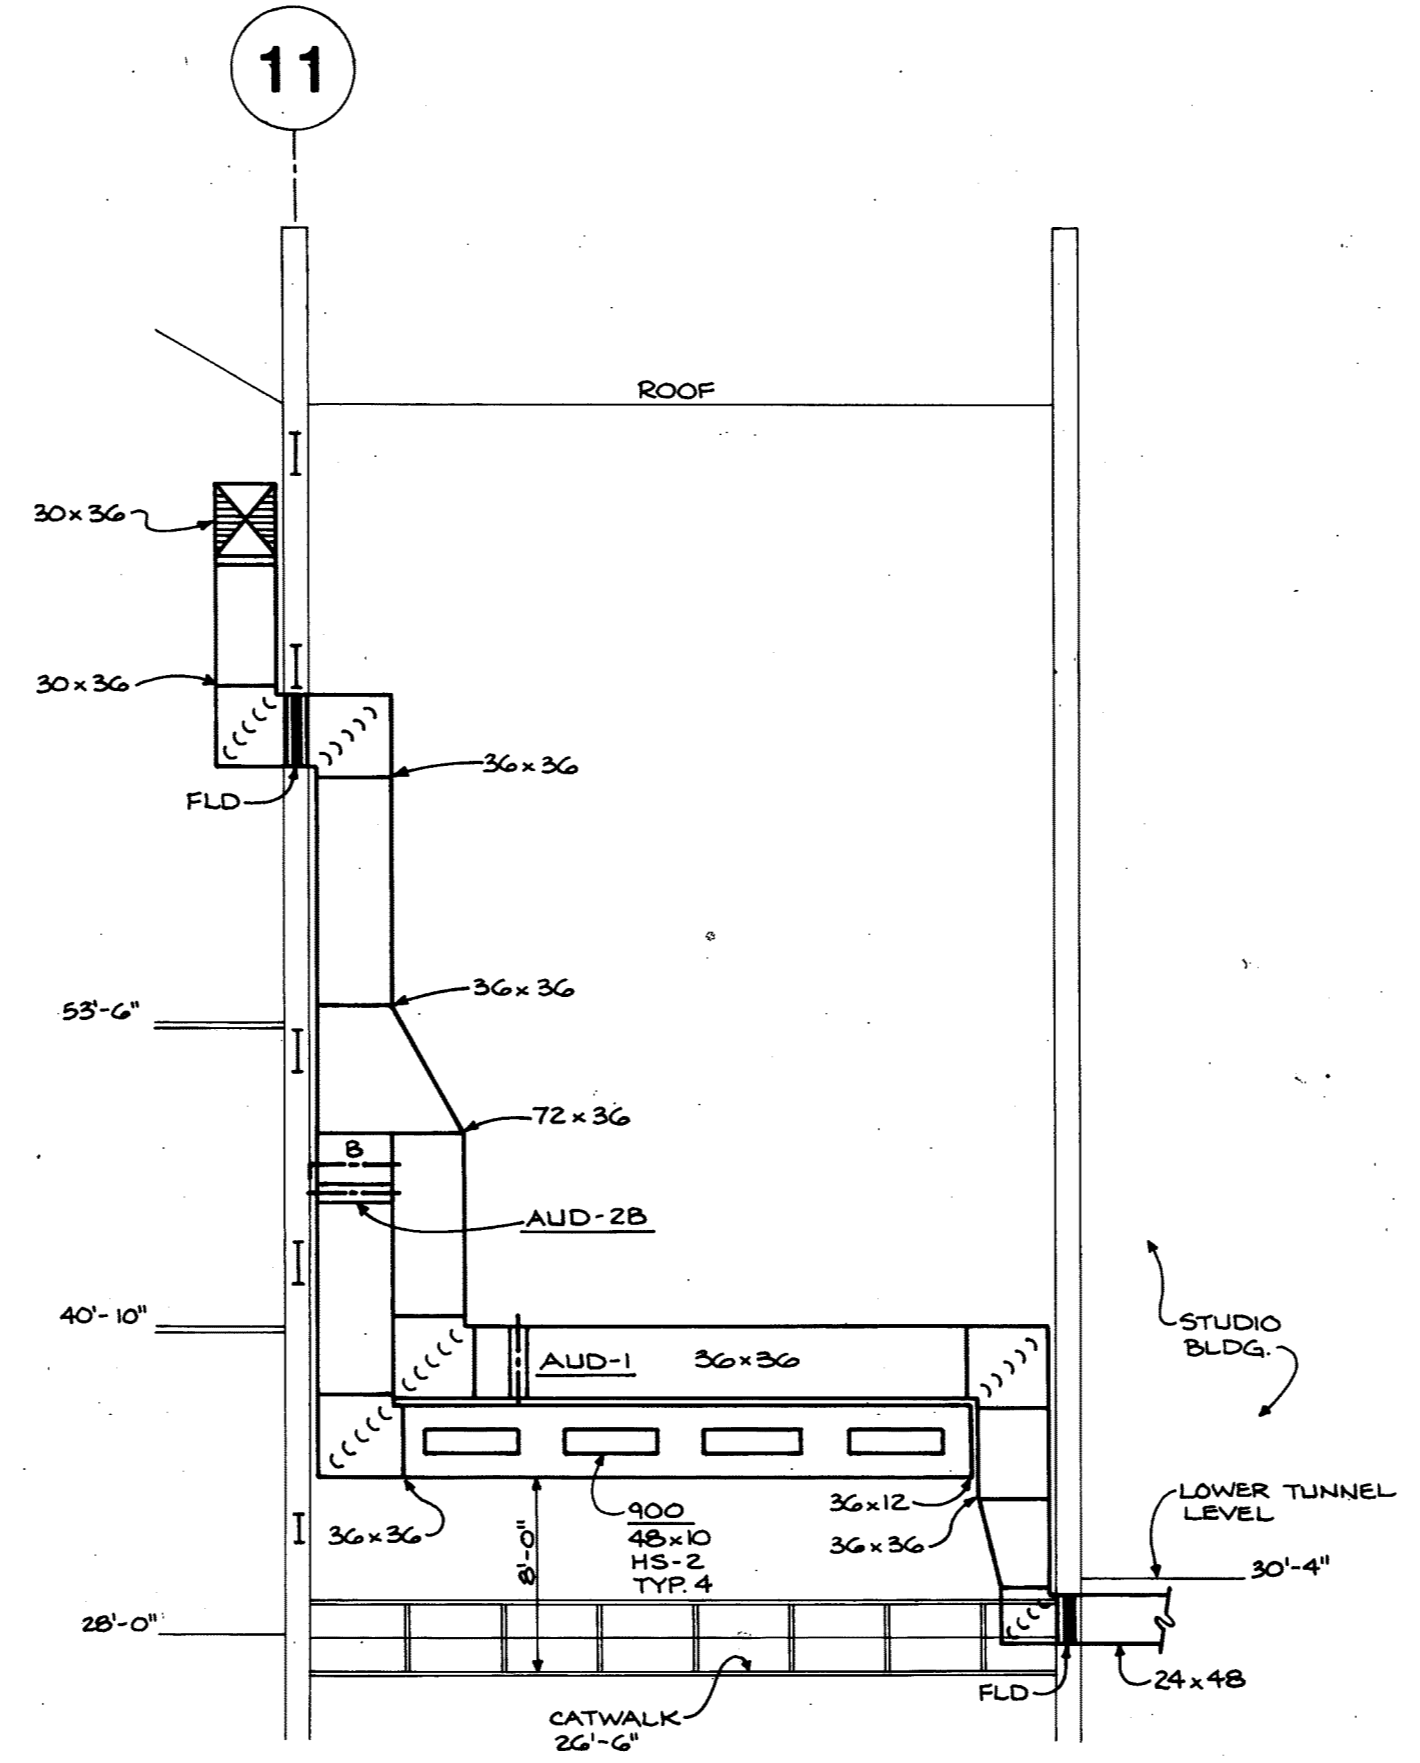


**4** SECTION - STAGE SUPPLY  
 1/8" = 1'-0"

## CHORUS LOFT PLAN HVAC


Job No.	Date
Set No.	Sheet No.
<b>8.13</b>	

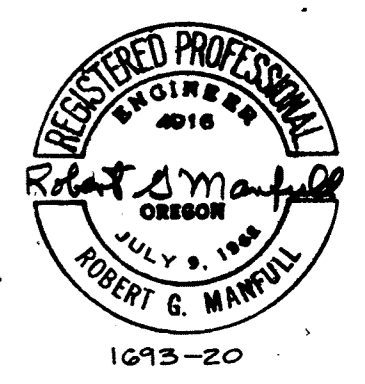



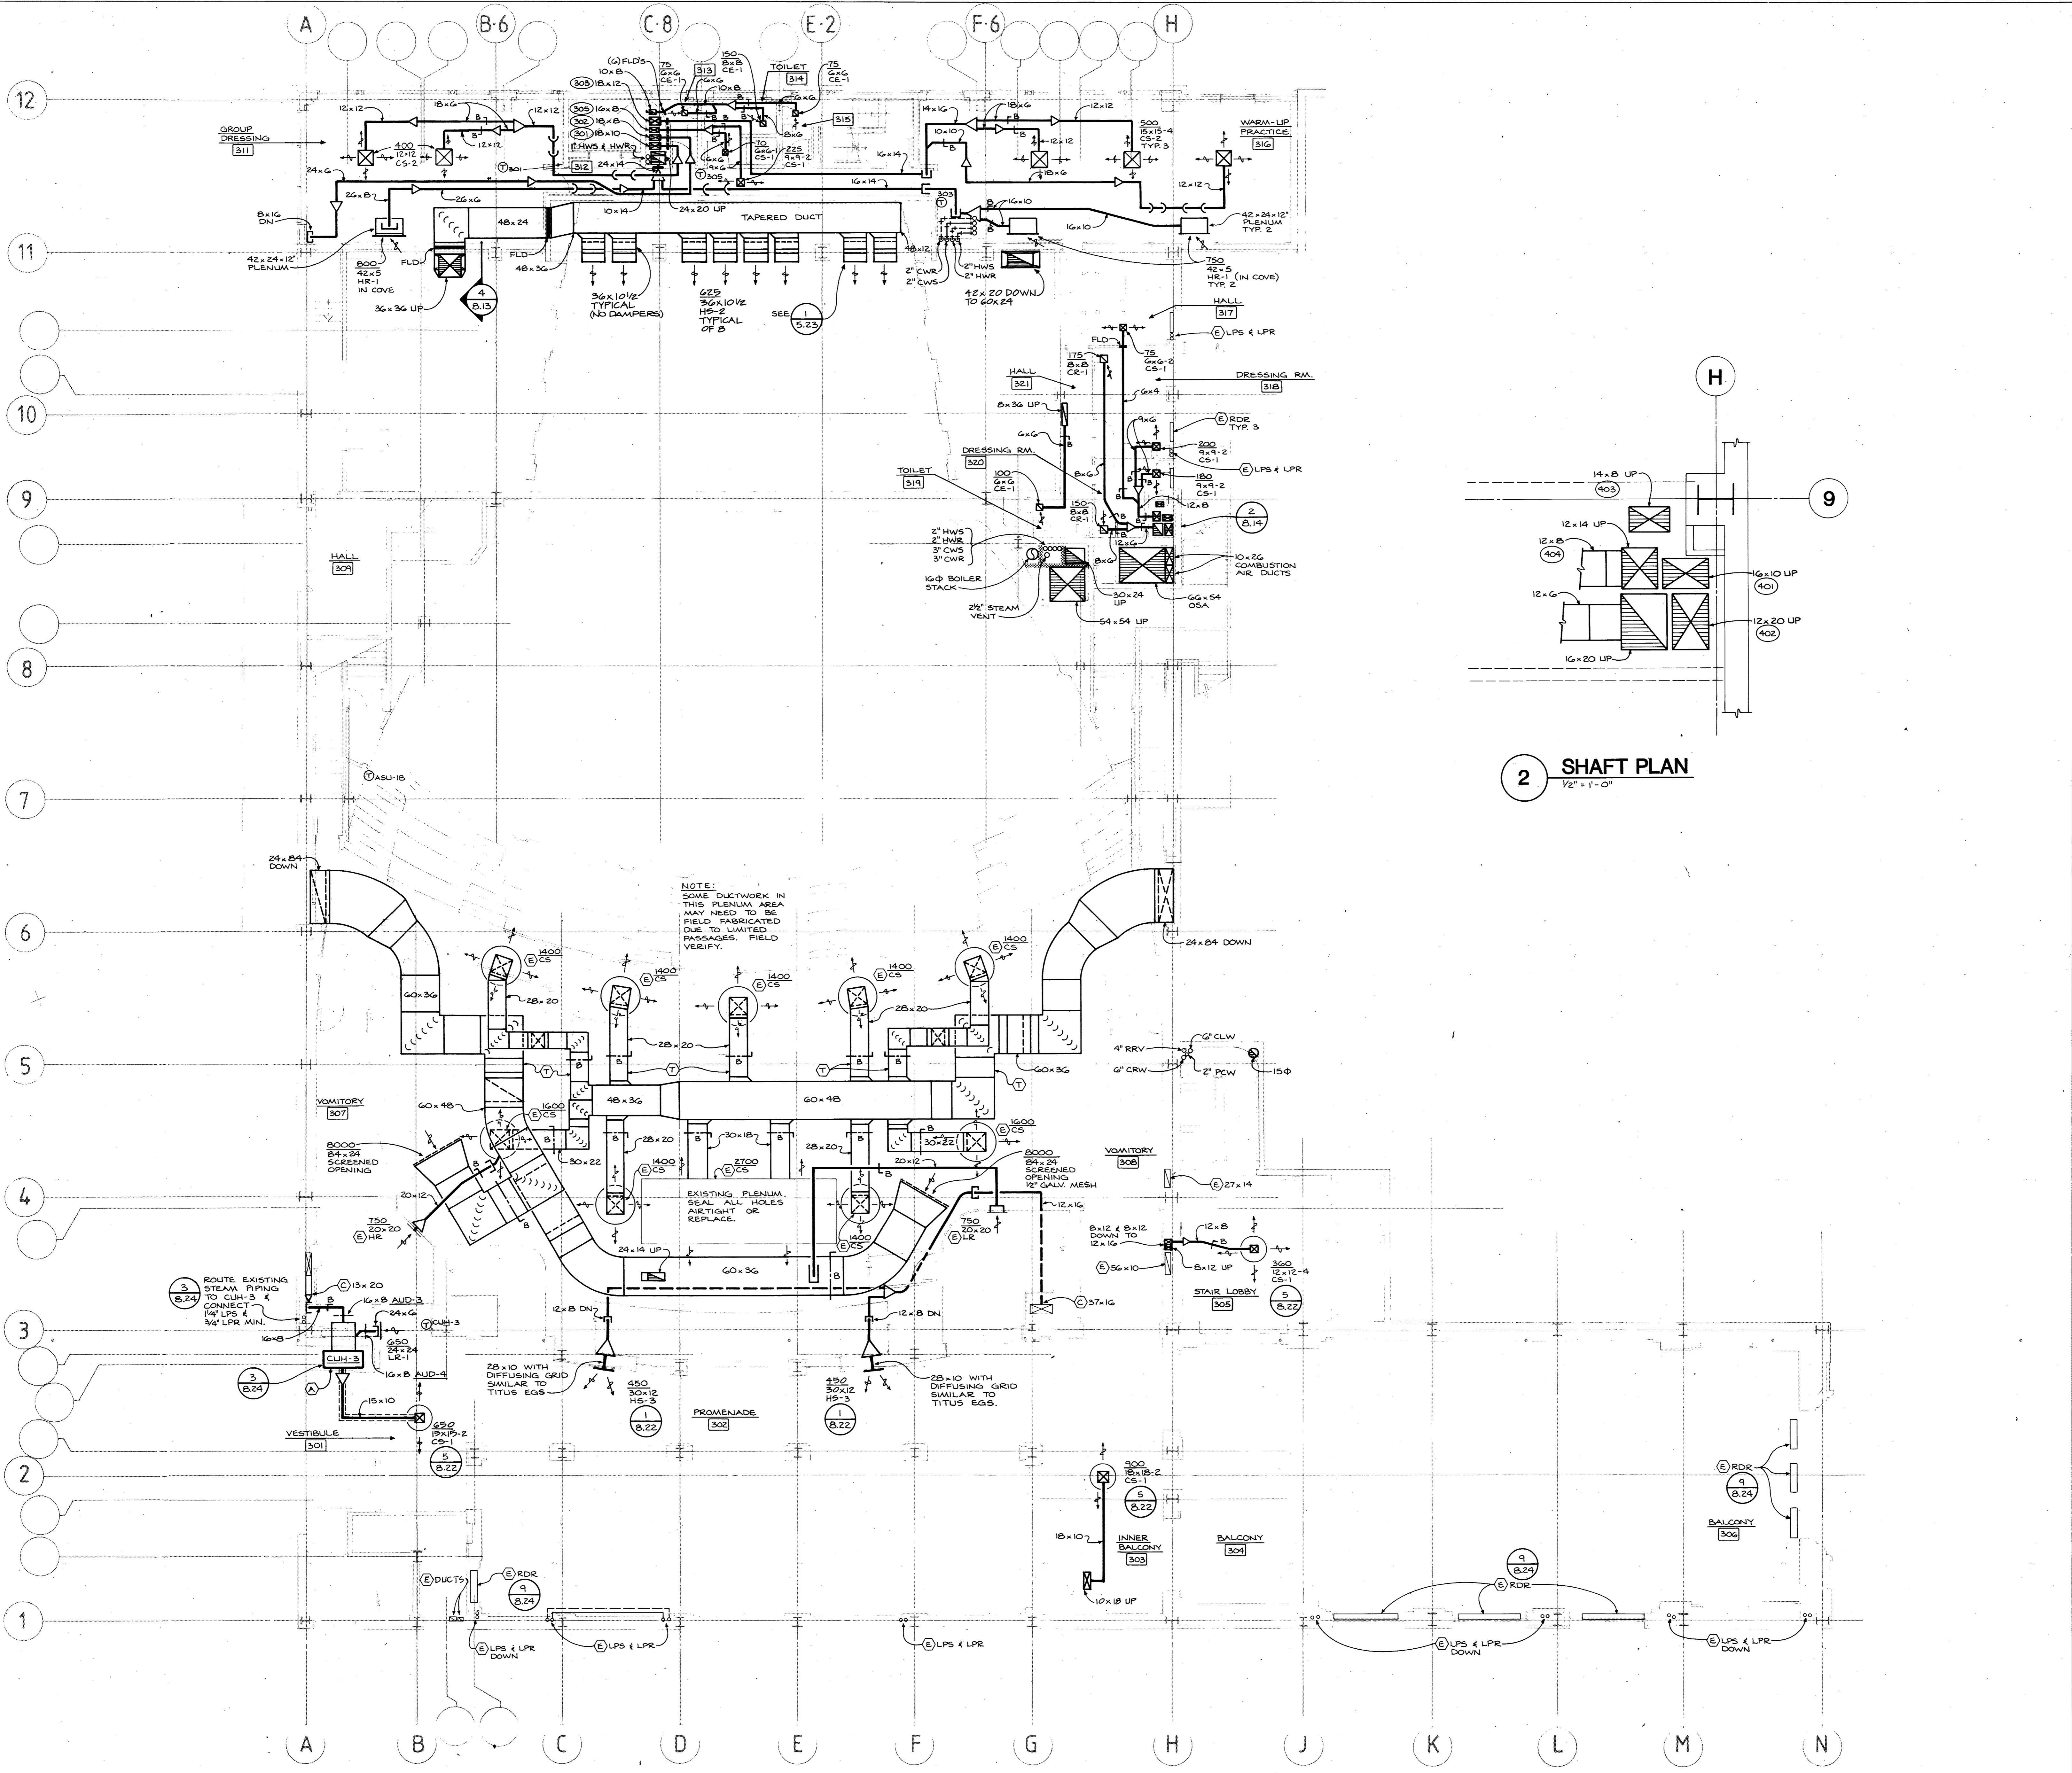

2 SHAFT PLAN  
1/2" = 1'-0"

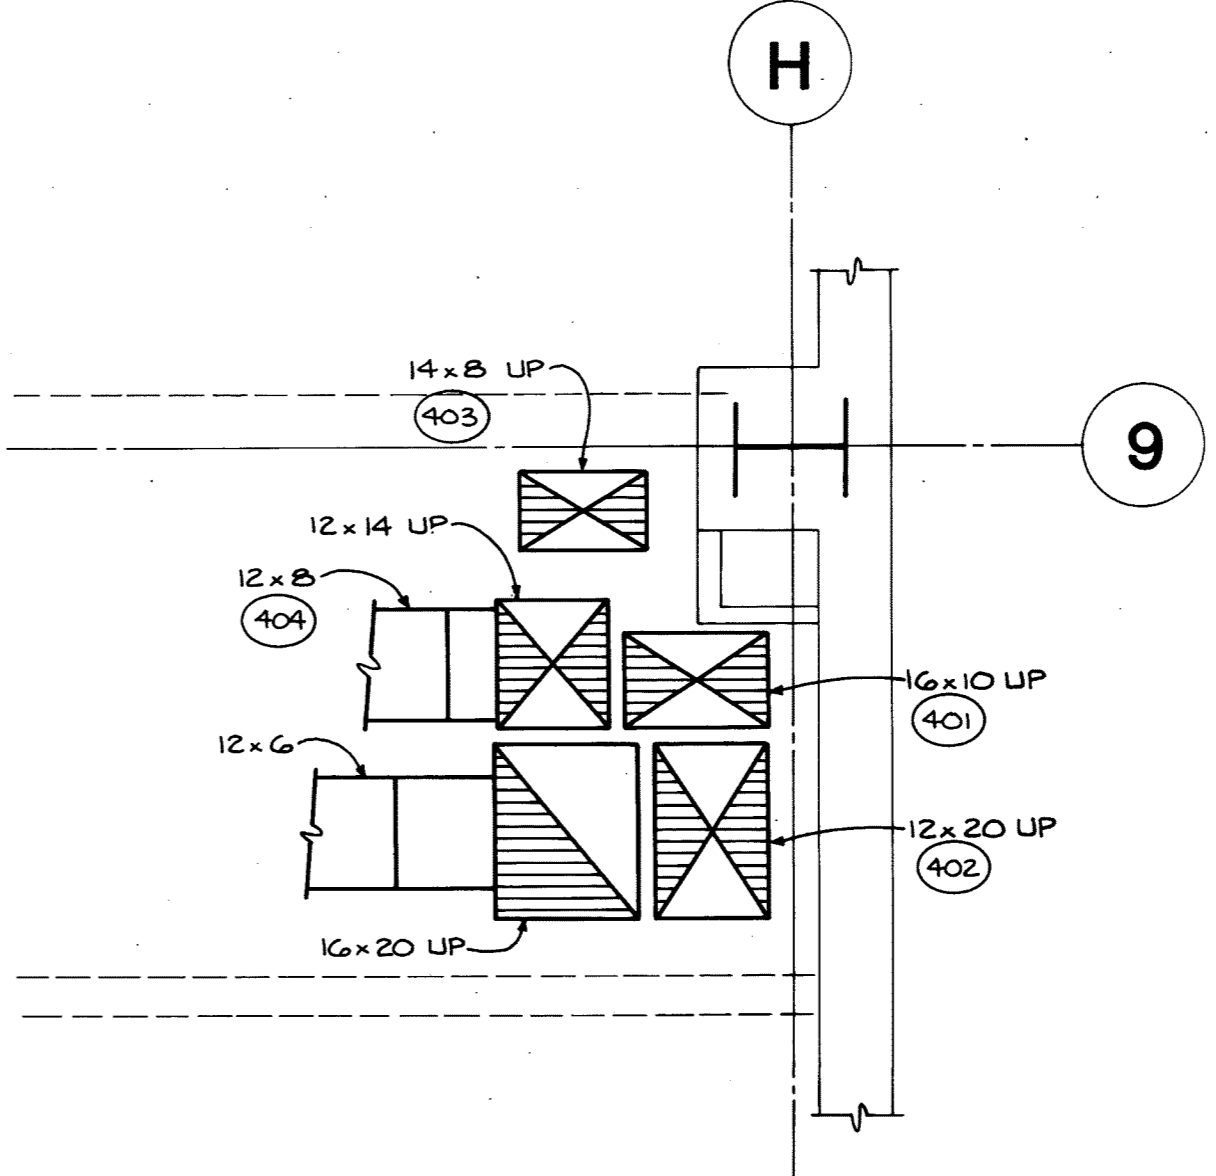

# Portland Center for the Performing Arts

The City of Portland  
 Honorable Mildred A. Schwab;  
 Commissioner in Charge  
 Ronald K. Ragen; Chairman  
 Performing Arts Center  
 Committee

Broome, Oringdolph, O Toole, Rudolf & Associates, P.C.  
 ELS Design Group  
 Barton Myers  
 Theatre Projects, Inc.  
 R. Lawrence Kirkegaard & Associates  
 Interface Engineering, Inc.  
 C.W. Timmer & Associates  
 CH2M Hill  
 Project Address:  
 733 N.W. 20th Avenue  
 Portland, Oregon 97209  
 (503) 226-1575





## MEZZANINE PLAN - HVAC

Job No.	Date
Set No.	Sheet No.
8.14	


# Portland Center for the Performing Arts

The City of Portland  
Honorable Mildred A. Schwab;  
Commissioner in Charge  
Ronald K. Ragen; Chairman  
Performing Arts Center  
Committee


Broome, Oringdolph, O Toole, Rudolf & Associates, P.C.  
ELS Design Group  
Barton Myers  
Theatre Projects, Inc.  
R. Lawrence Kirkegaard & Associates  
Interface Engineering, Inc.  
C.W. Timmer & Associates  
CH2M Hill  
Project Address:  
733 N.W. 20th Avenue  
Portland, Oregon 97209  
(503) 226-1575

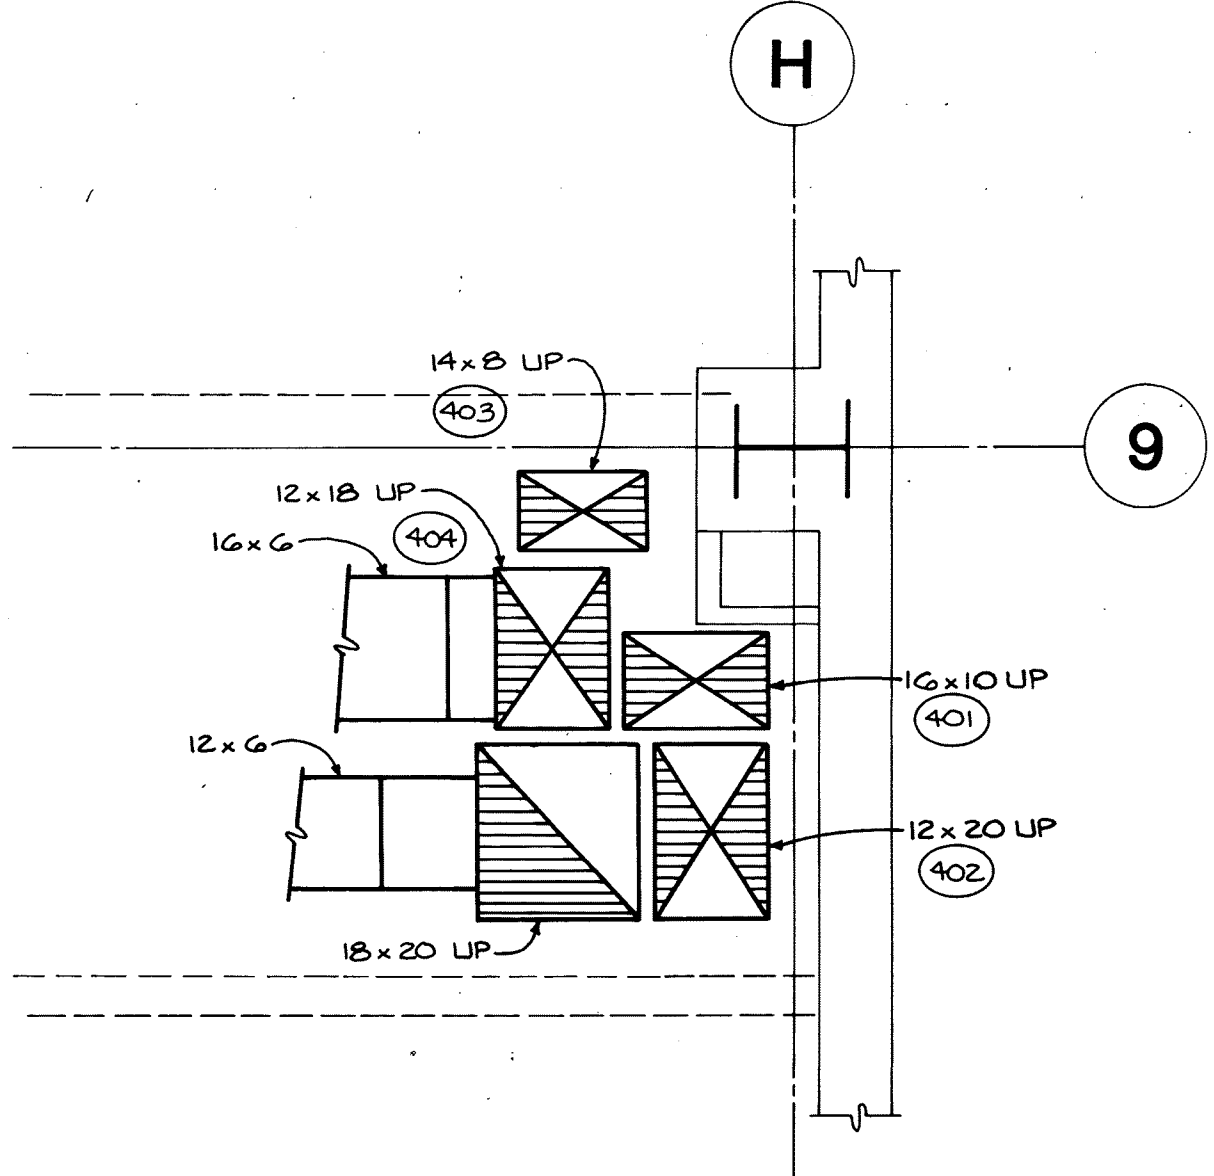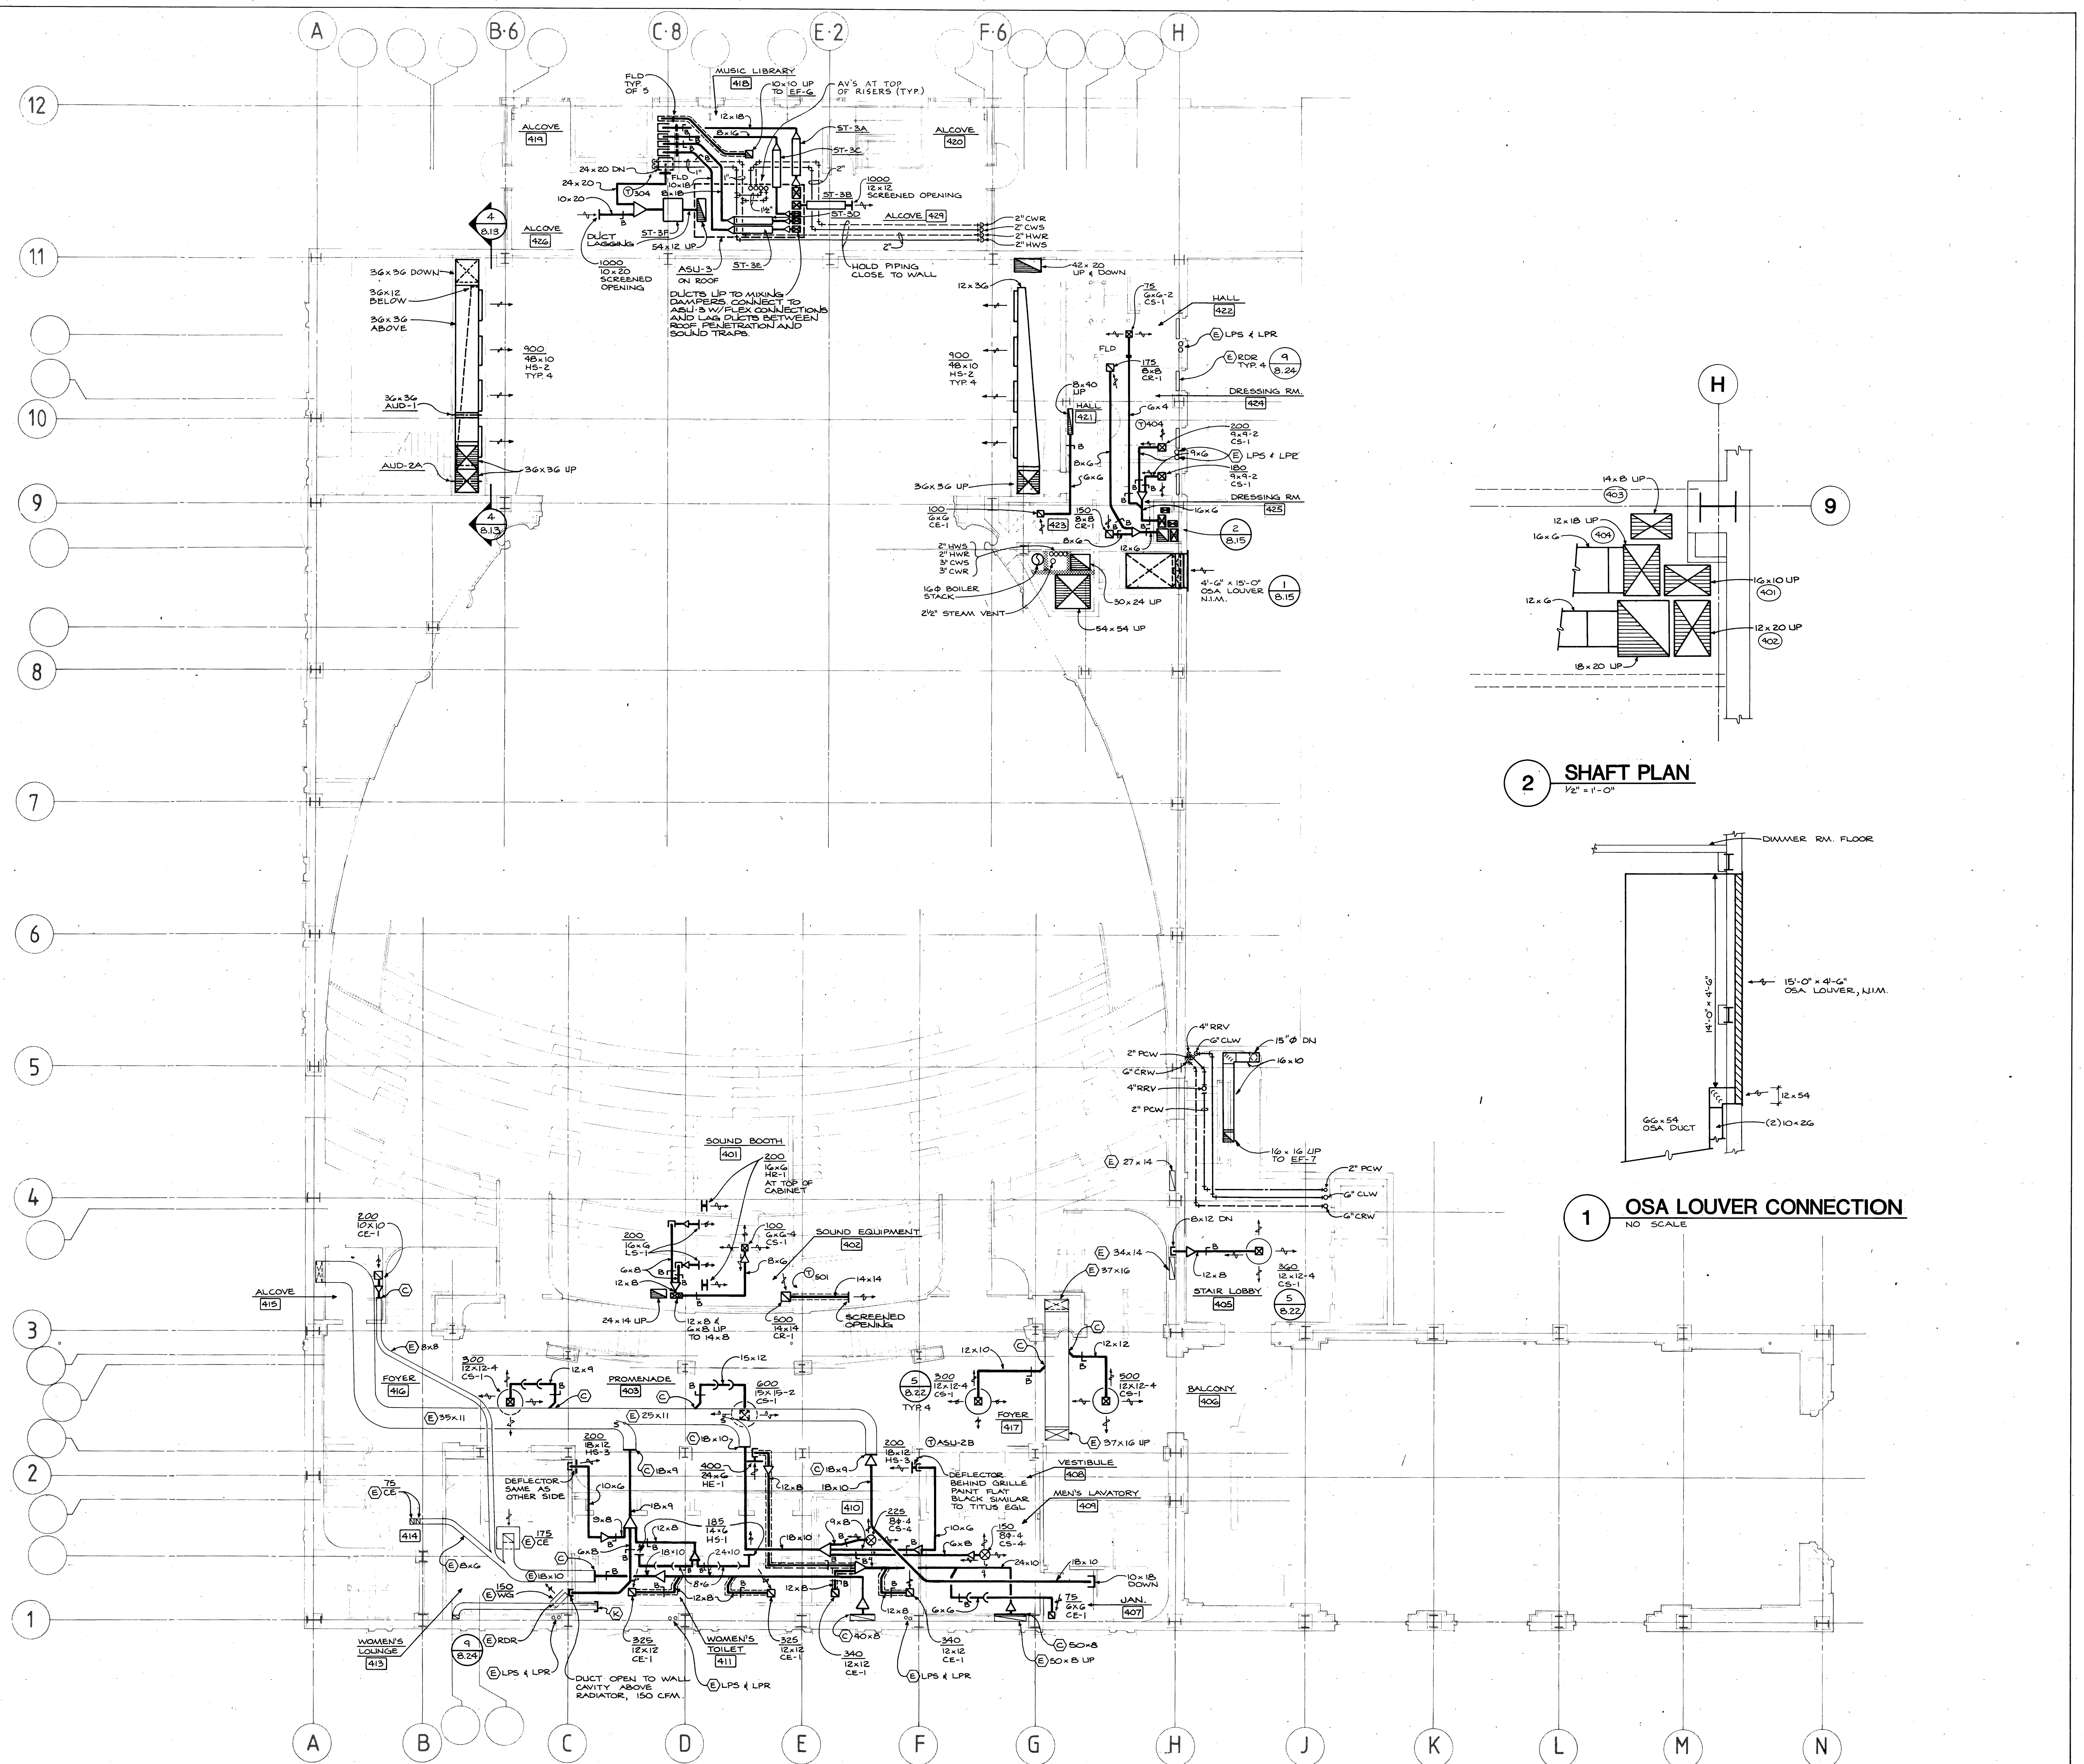

2 SHAFT PLAN  
1/2" = 1'-0"

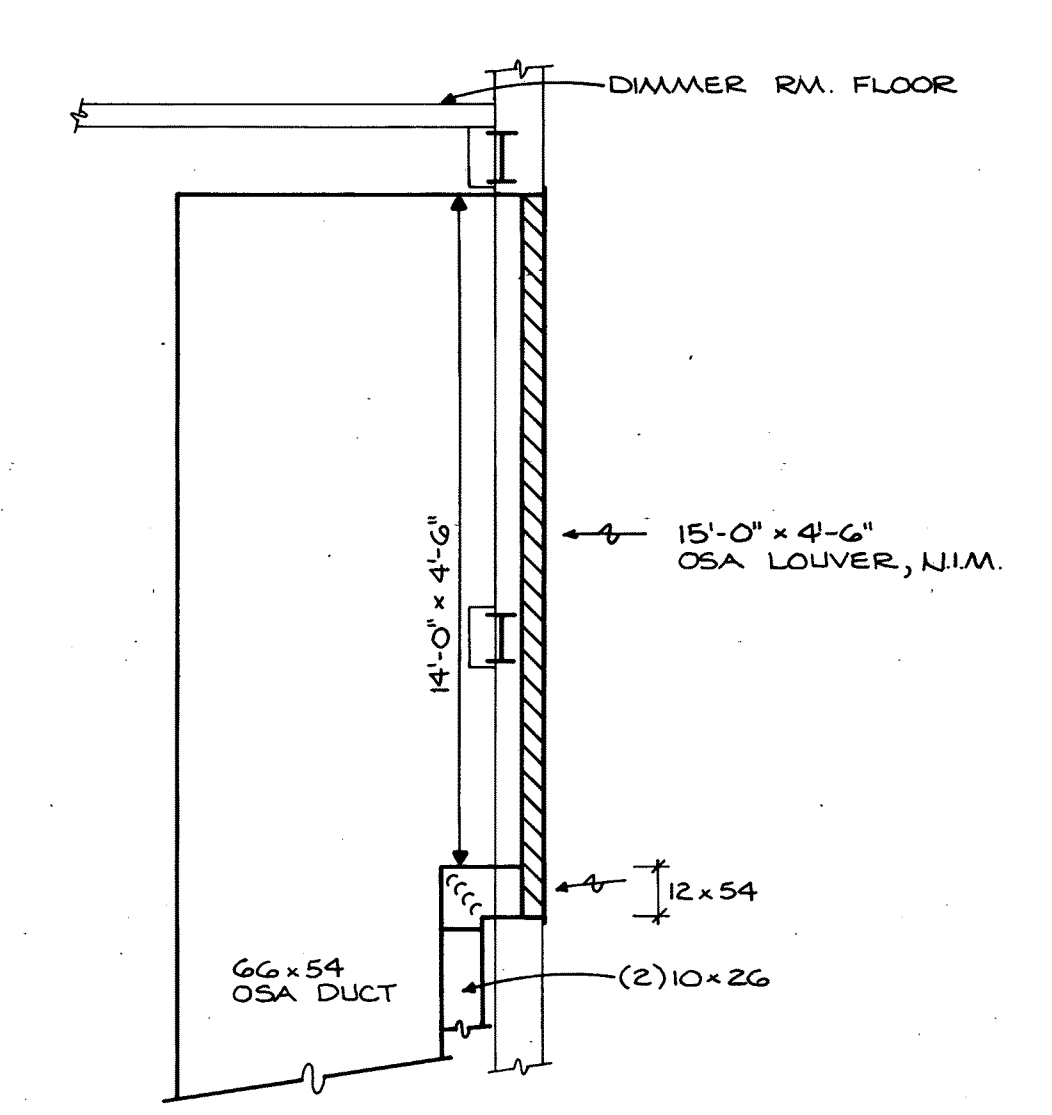

1 OSA LOUVER CONNECTION  
NO SCALE

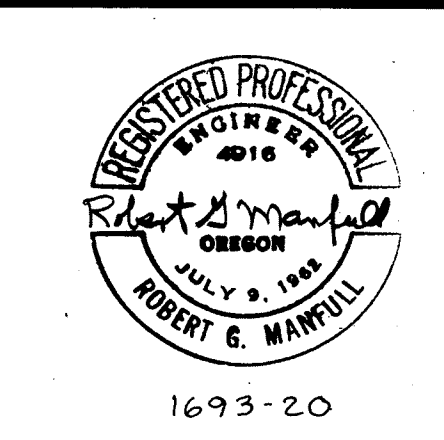



## LOWER TUNNEL PLAN HVAC

Job No.	Date
Set No.	JULY 18, 1988
	Sheet No.
	8.15


# Portland Center for the Performing Arts

The City of Portland  
Honorable Mildred A. Schwab,  
Commissioner in Charge  
Ronald K. Ragen, Chairman  
Performing Arts Center  
Committee

Broome, Oringdolph, O'Toole, Rudolf & Associates, P.C.  
E.L.S. Design Group  
Baron Myers  
Theatre Projects, Inc.  
R. Lawrence Kirkegaard & Associates  
Interface Engineering, Inc.  
C.W. Timmer & Associates  
CH2M Hill  
Project Address:  
733 N.W. 20th Avenue  
Portland, Oregon 97209  
(503) 226-1575

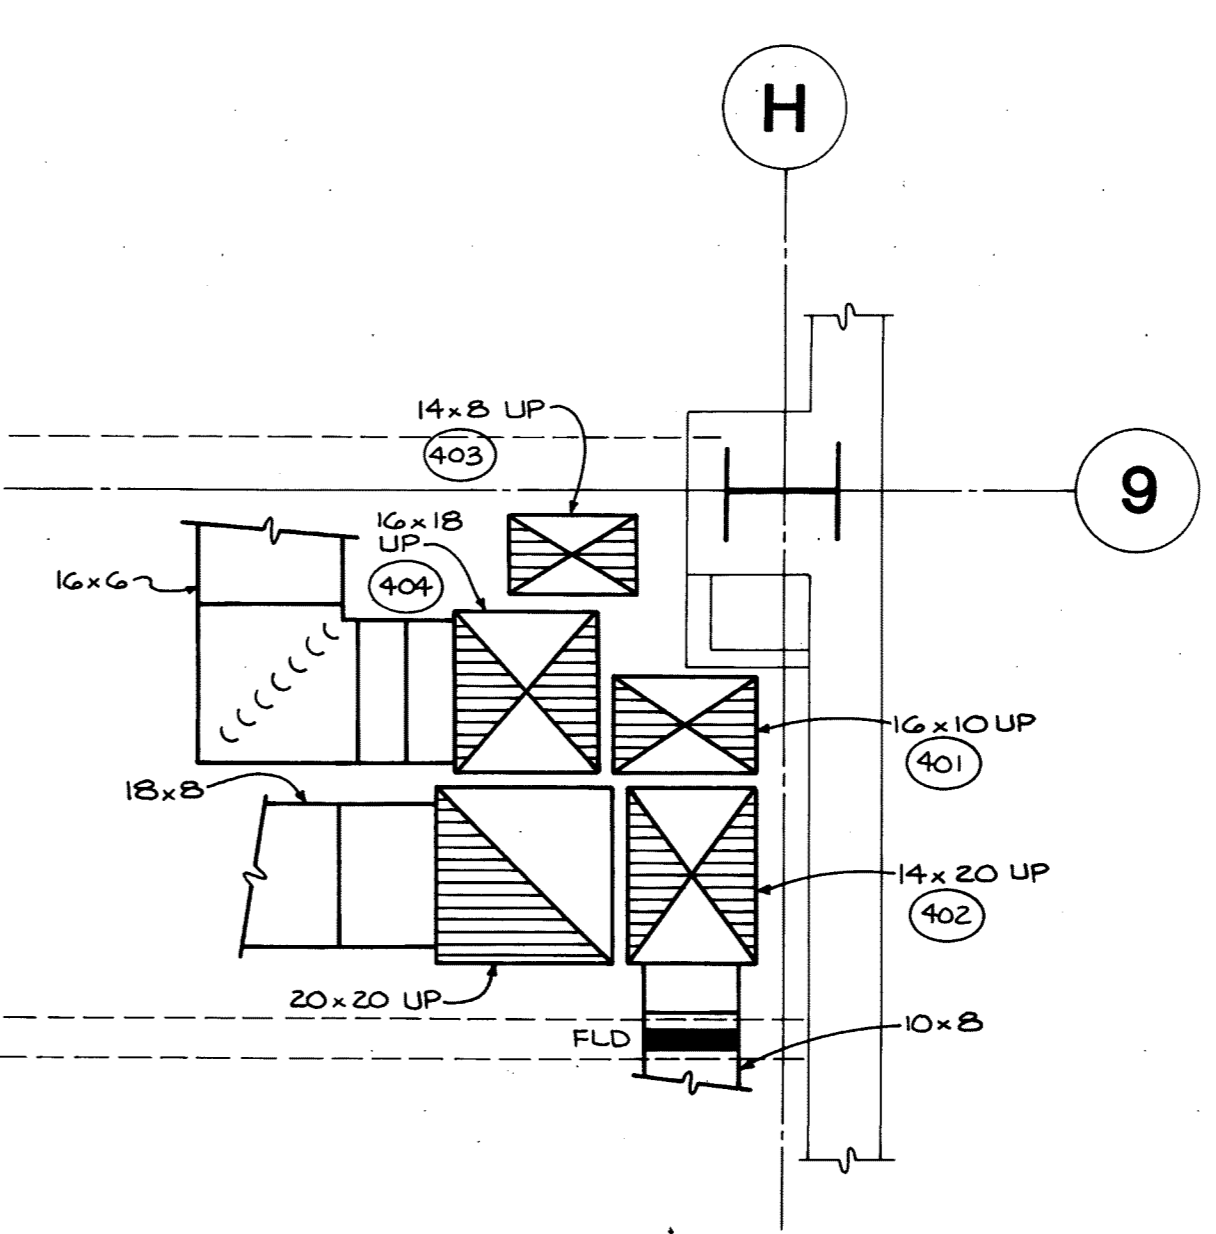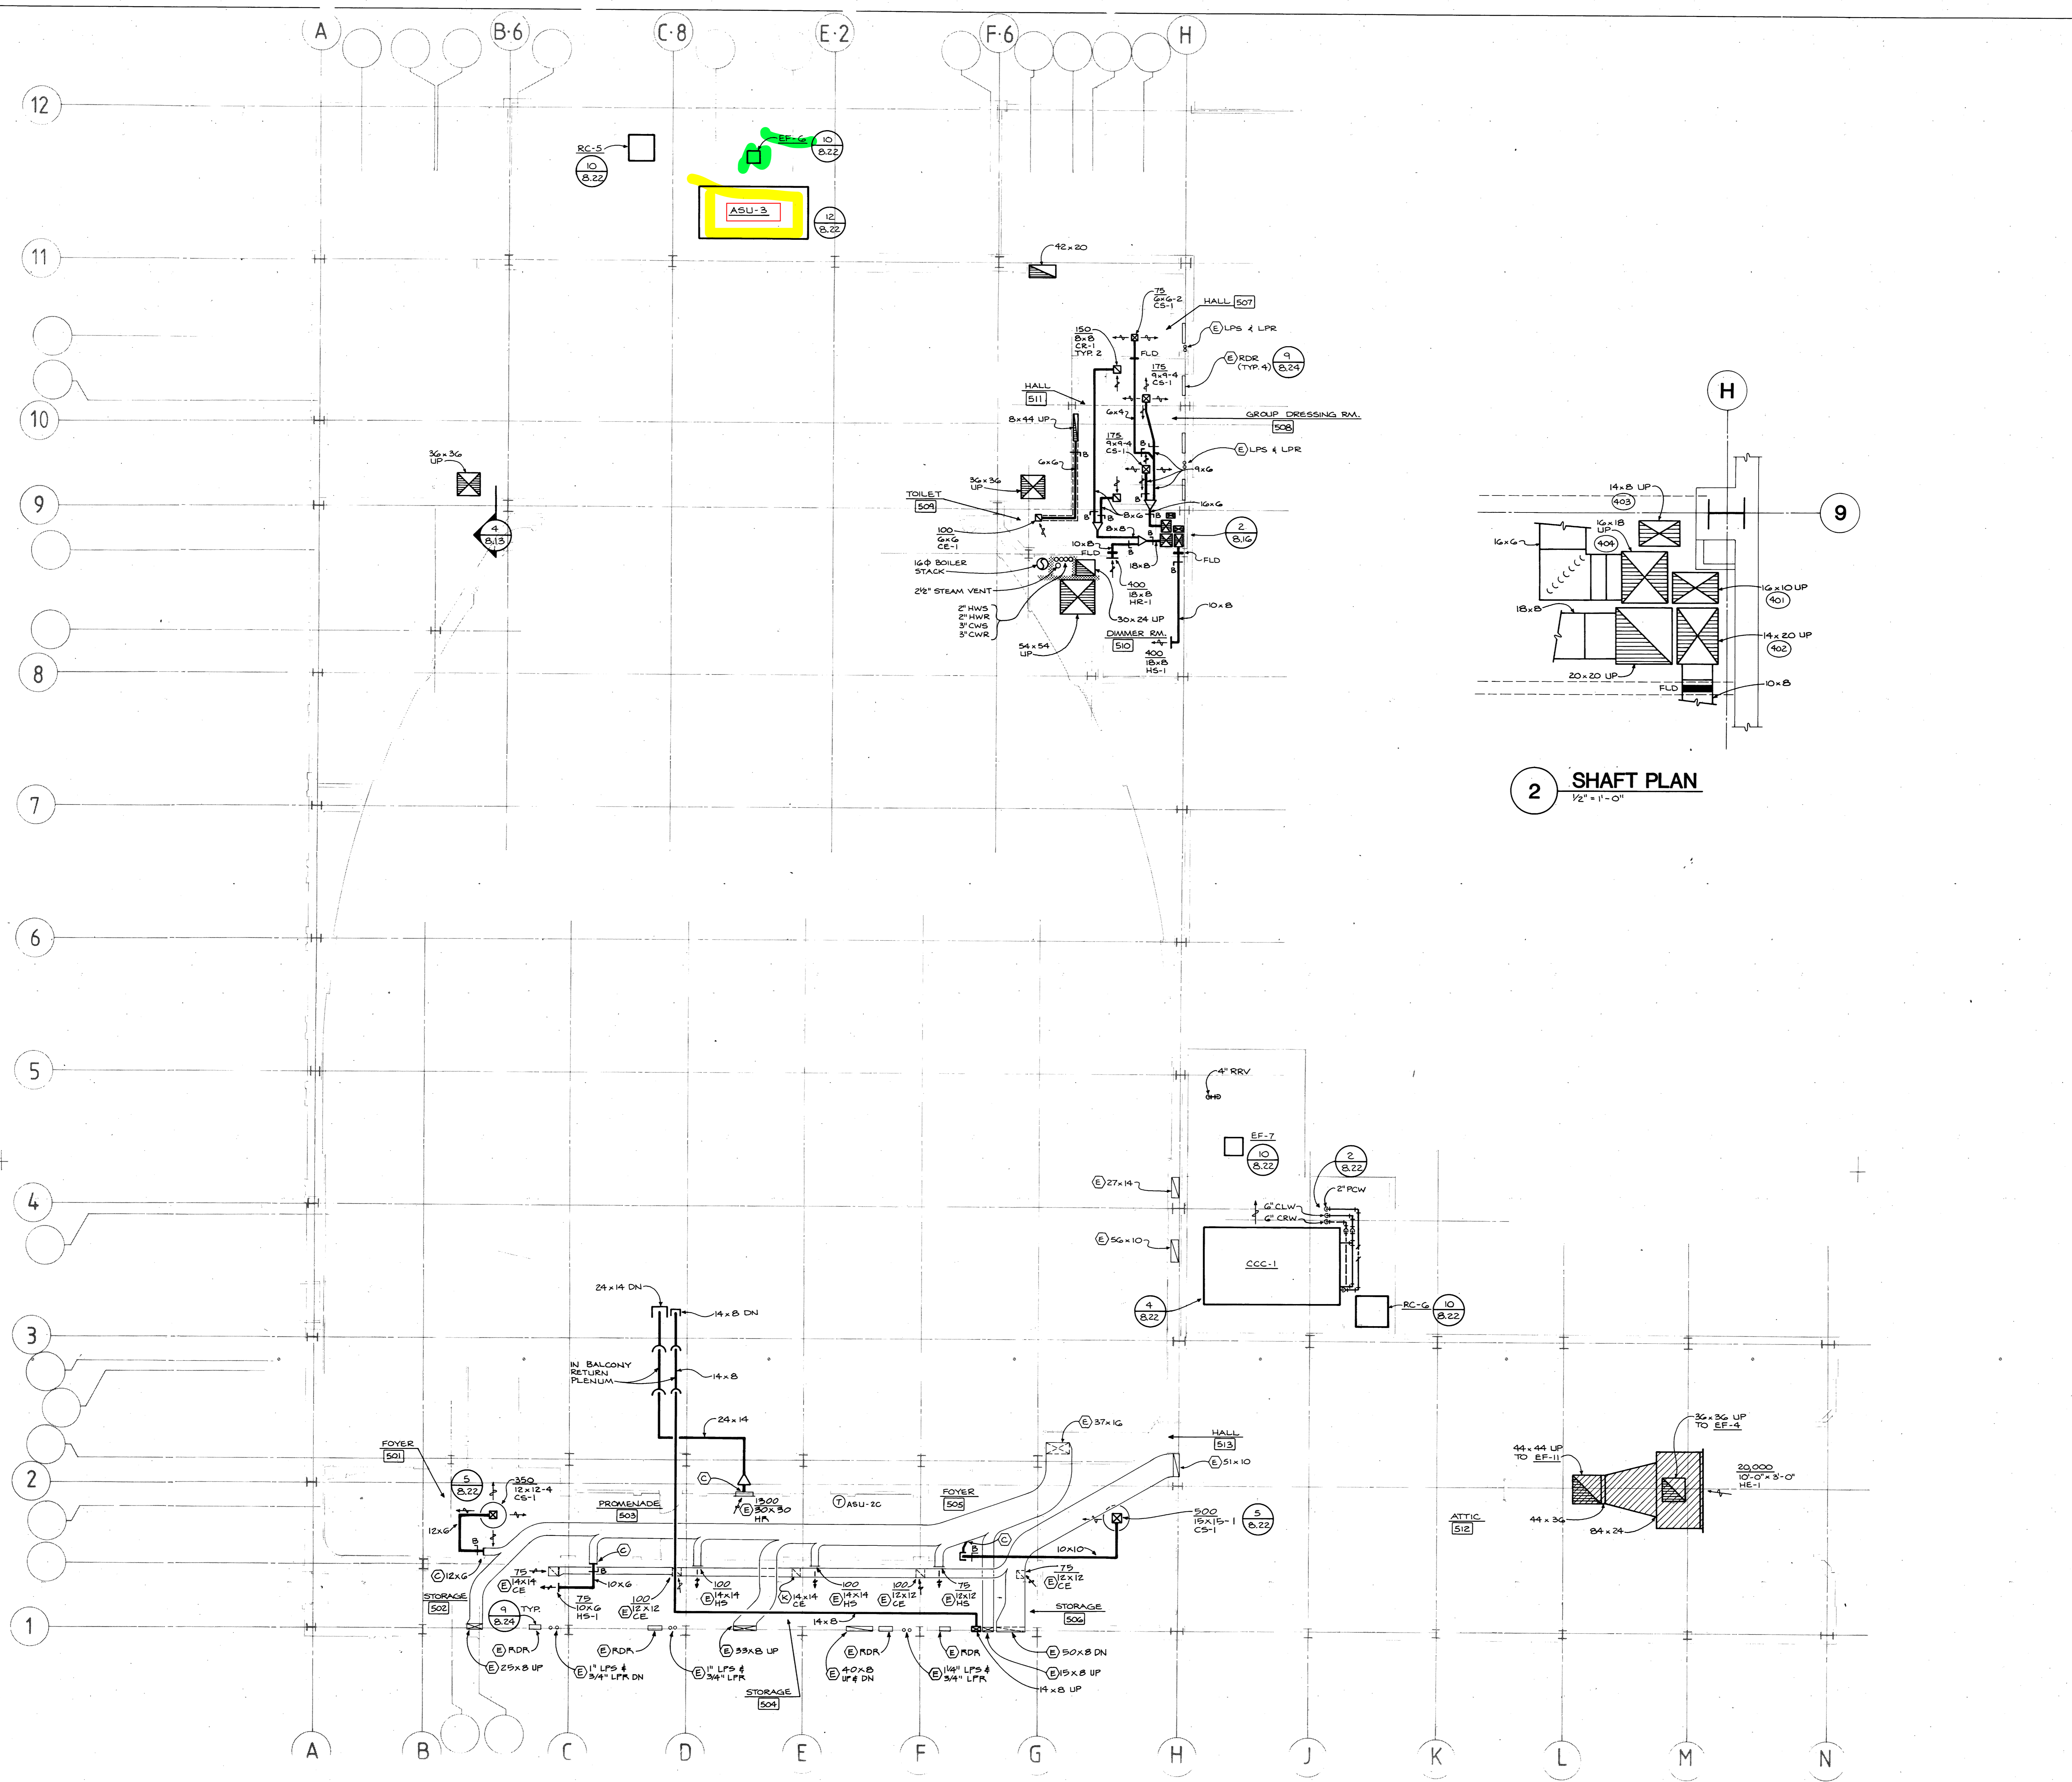

2 SHAFT PLAN  
1/2" = 1'-0"

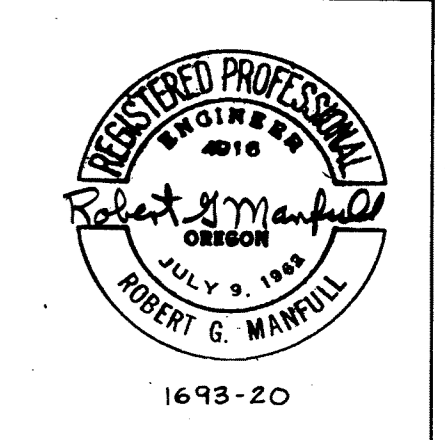

## UPPER TUNNEL PLAN HVAC

Job No.	Date
Set No.	Sheet No.
<b>8.16</b>	

# Portland Center for the Performing Arts

The City of Portland

Honorable Mildred A. Schwab,  
Commissioner in Charge



Ronald K. Ragen; Chairman  
Performing Arts Center  
Committee

Broome, Oringduiph, O Toole, Rudolf & Associates, P.C.  
ELS Design Group  
Barton Myers


Theatre Projects, Inc.  
R. Lawrence Kirkegaard & Associates

Interface Engineering, Inc.  
C.W. Timmer & Associates  
CH2M Hill

Project Address:  
733 N.W. 20th Avenue  
Portland, Oregon 97209  
(503) 226-1575

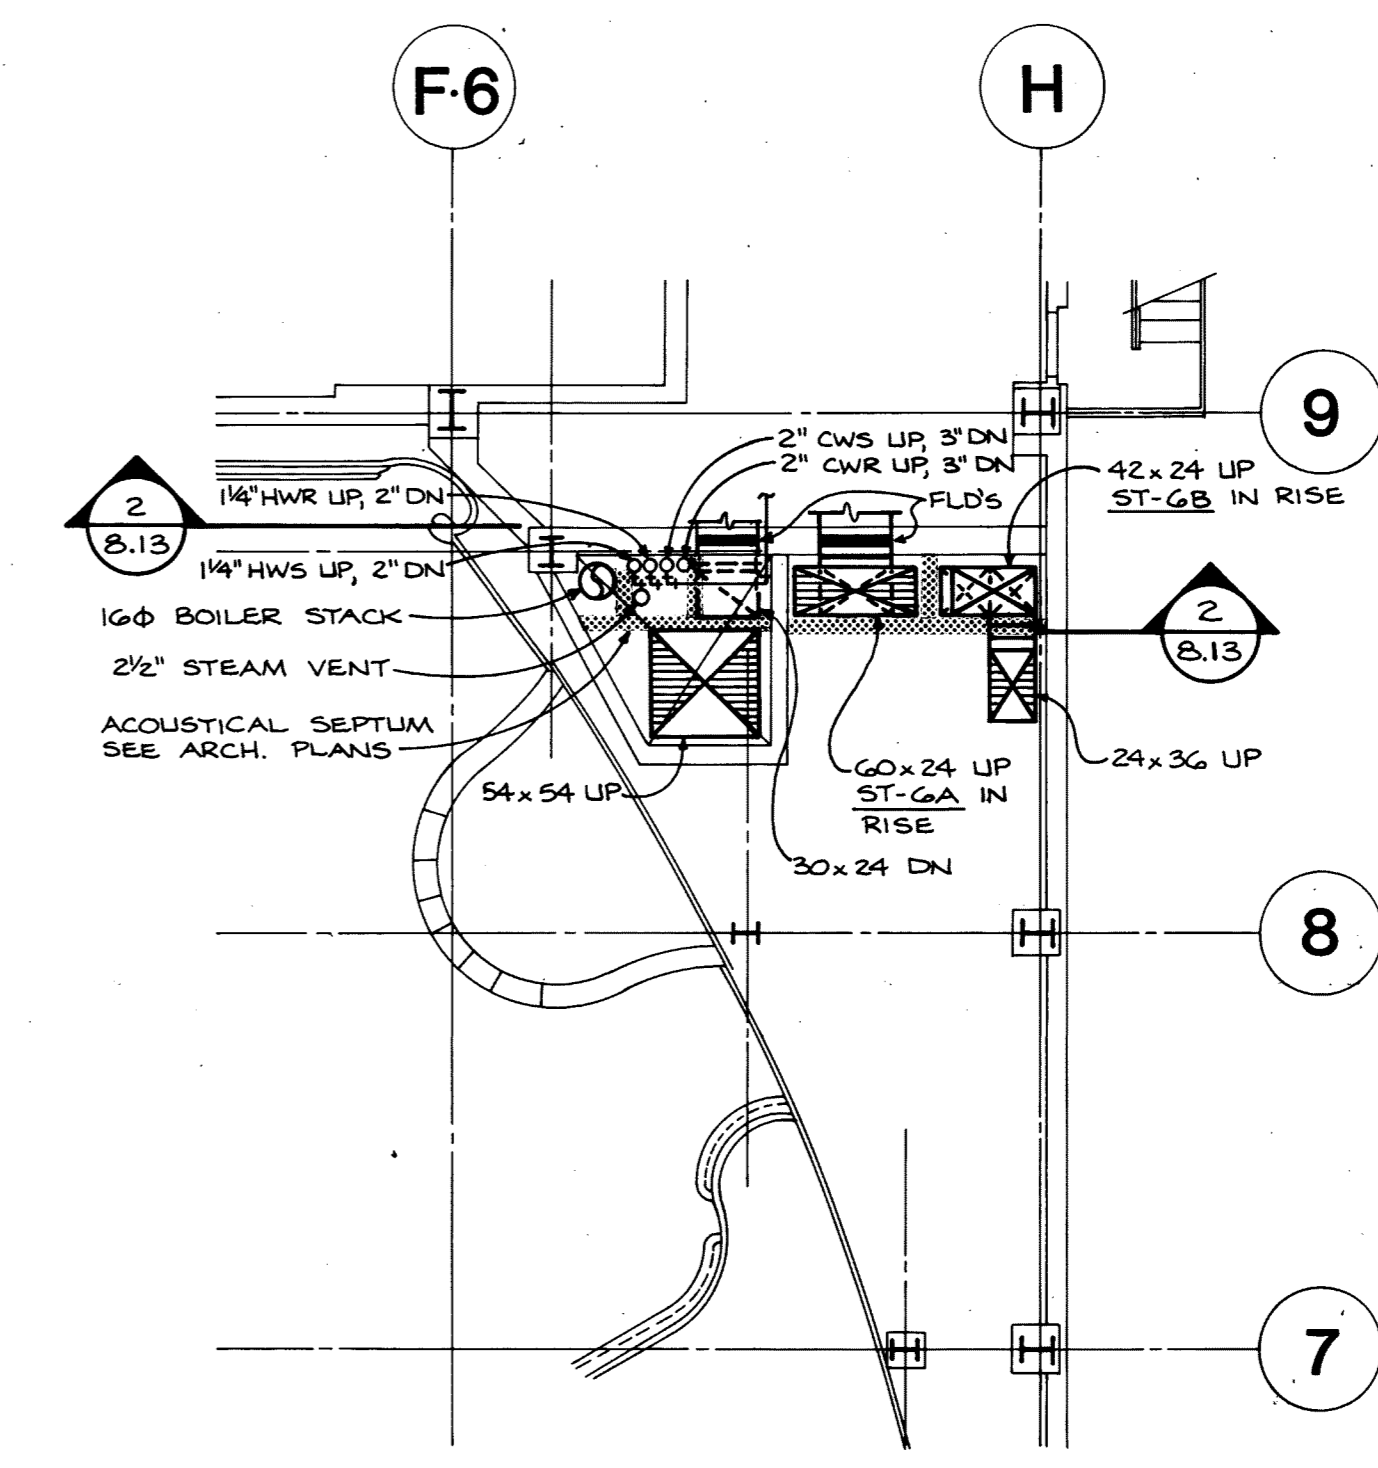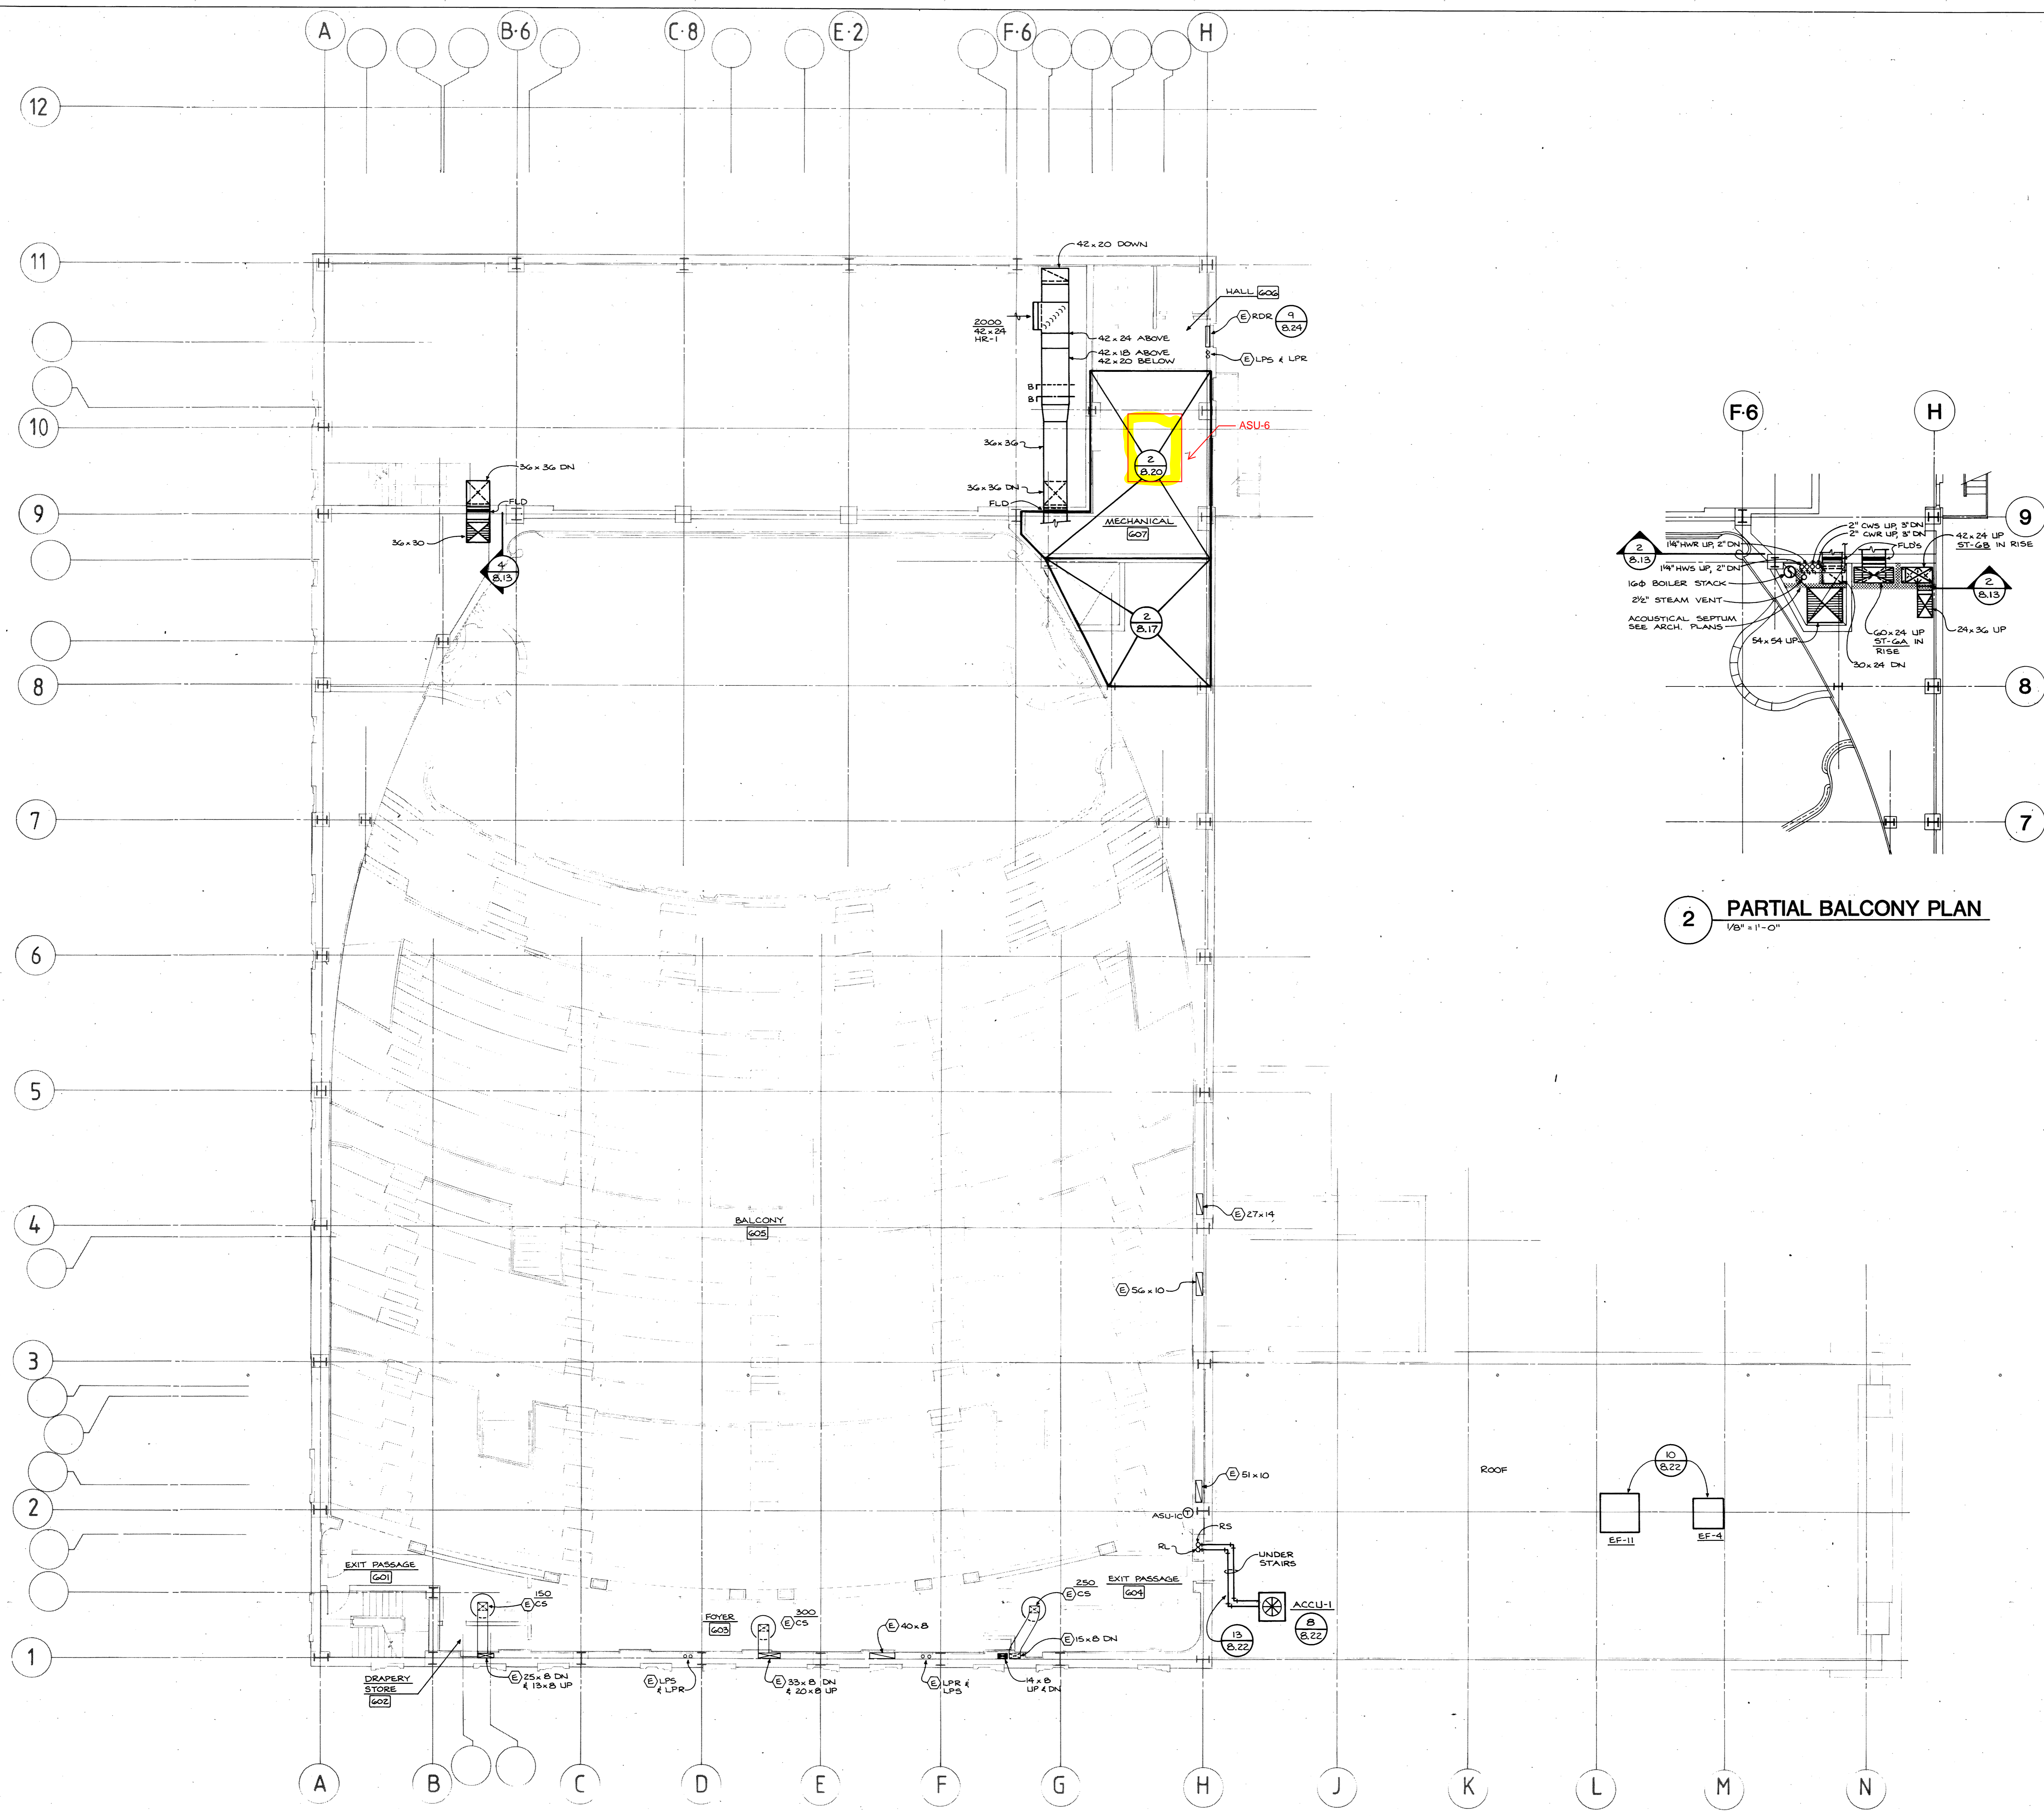

**2 PARTIAL BALCONY PLAN**  
1/8" = 1'-0"

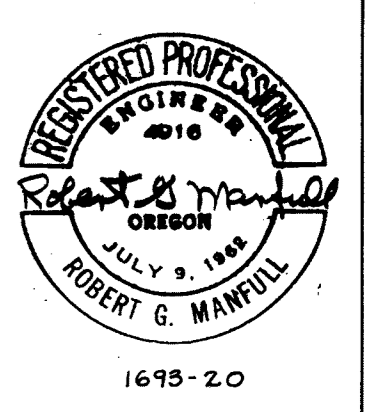


## BALCONY PLAN - HVAC

Job No.	Date
Set No.	Sheet No.
<b>8.17</b>	
4.07	
5.0.83	


# Portland Center for the Performing Arts

The City of Portland  
 Honorable Mildred A. Schwab;  
 Commissioner in Charge  
 Ronald K. Ragen; Chairman  
 Performing Arts Center  
 Committee

Broome, Oringdolph, O'Toole, Rudolf & Associates, P.C.  
 ELS Design Group  
 Barton Myers  
 Theatre Projects, Inc.  
 R. Lawrence Kirkgaard & Associates  
 Interface Engineering, Inc.  
 C.W. Timmer & Associates  
 CH2M Hill  
 Project Address:  
 733 N.W. 20th Avenue  
 Portland, Oregon 97209  
 (503) 226-1575

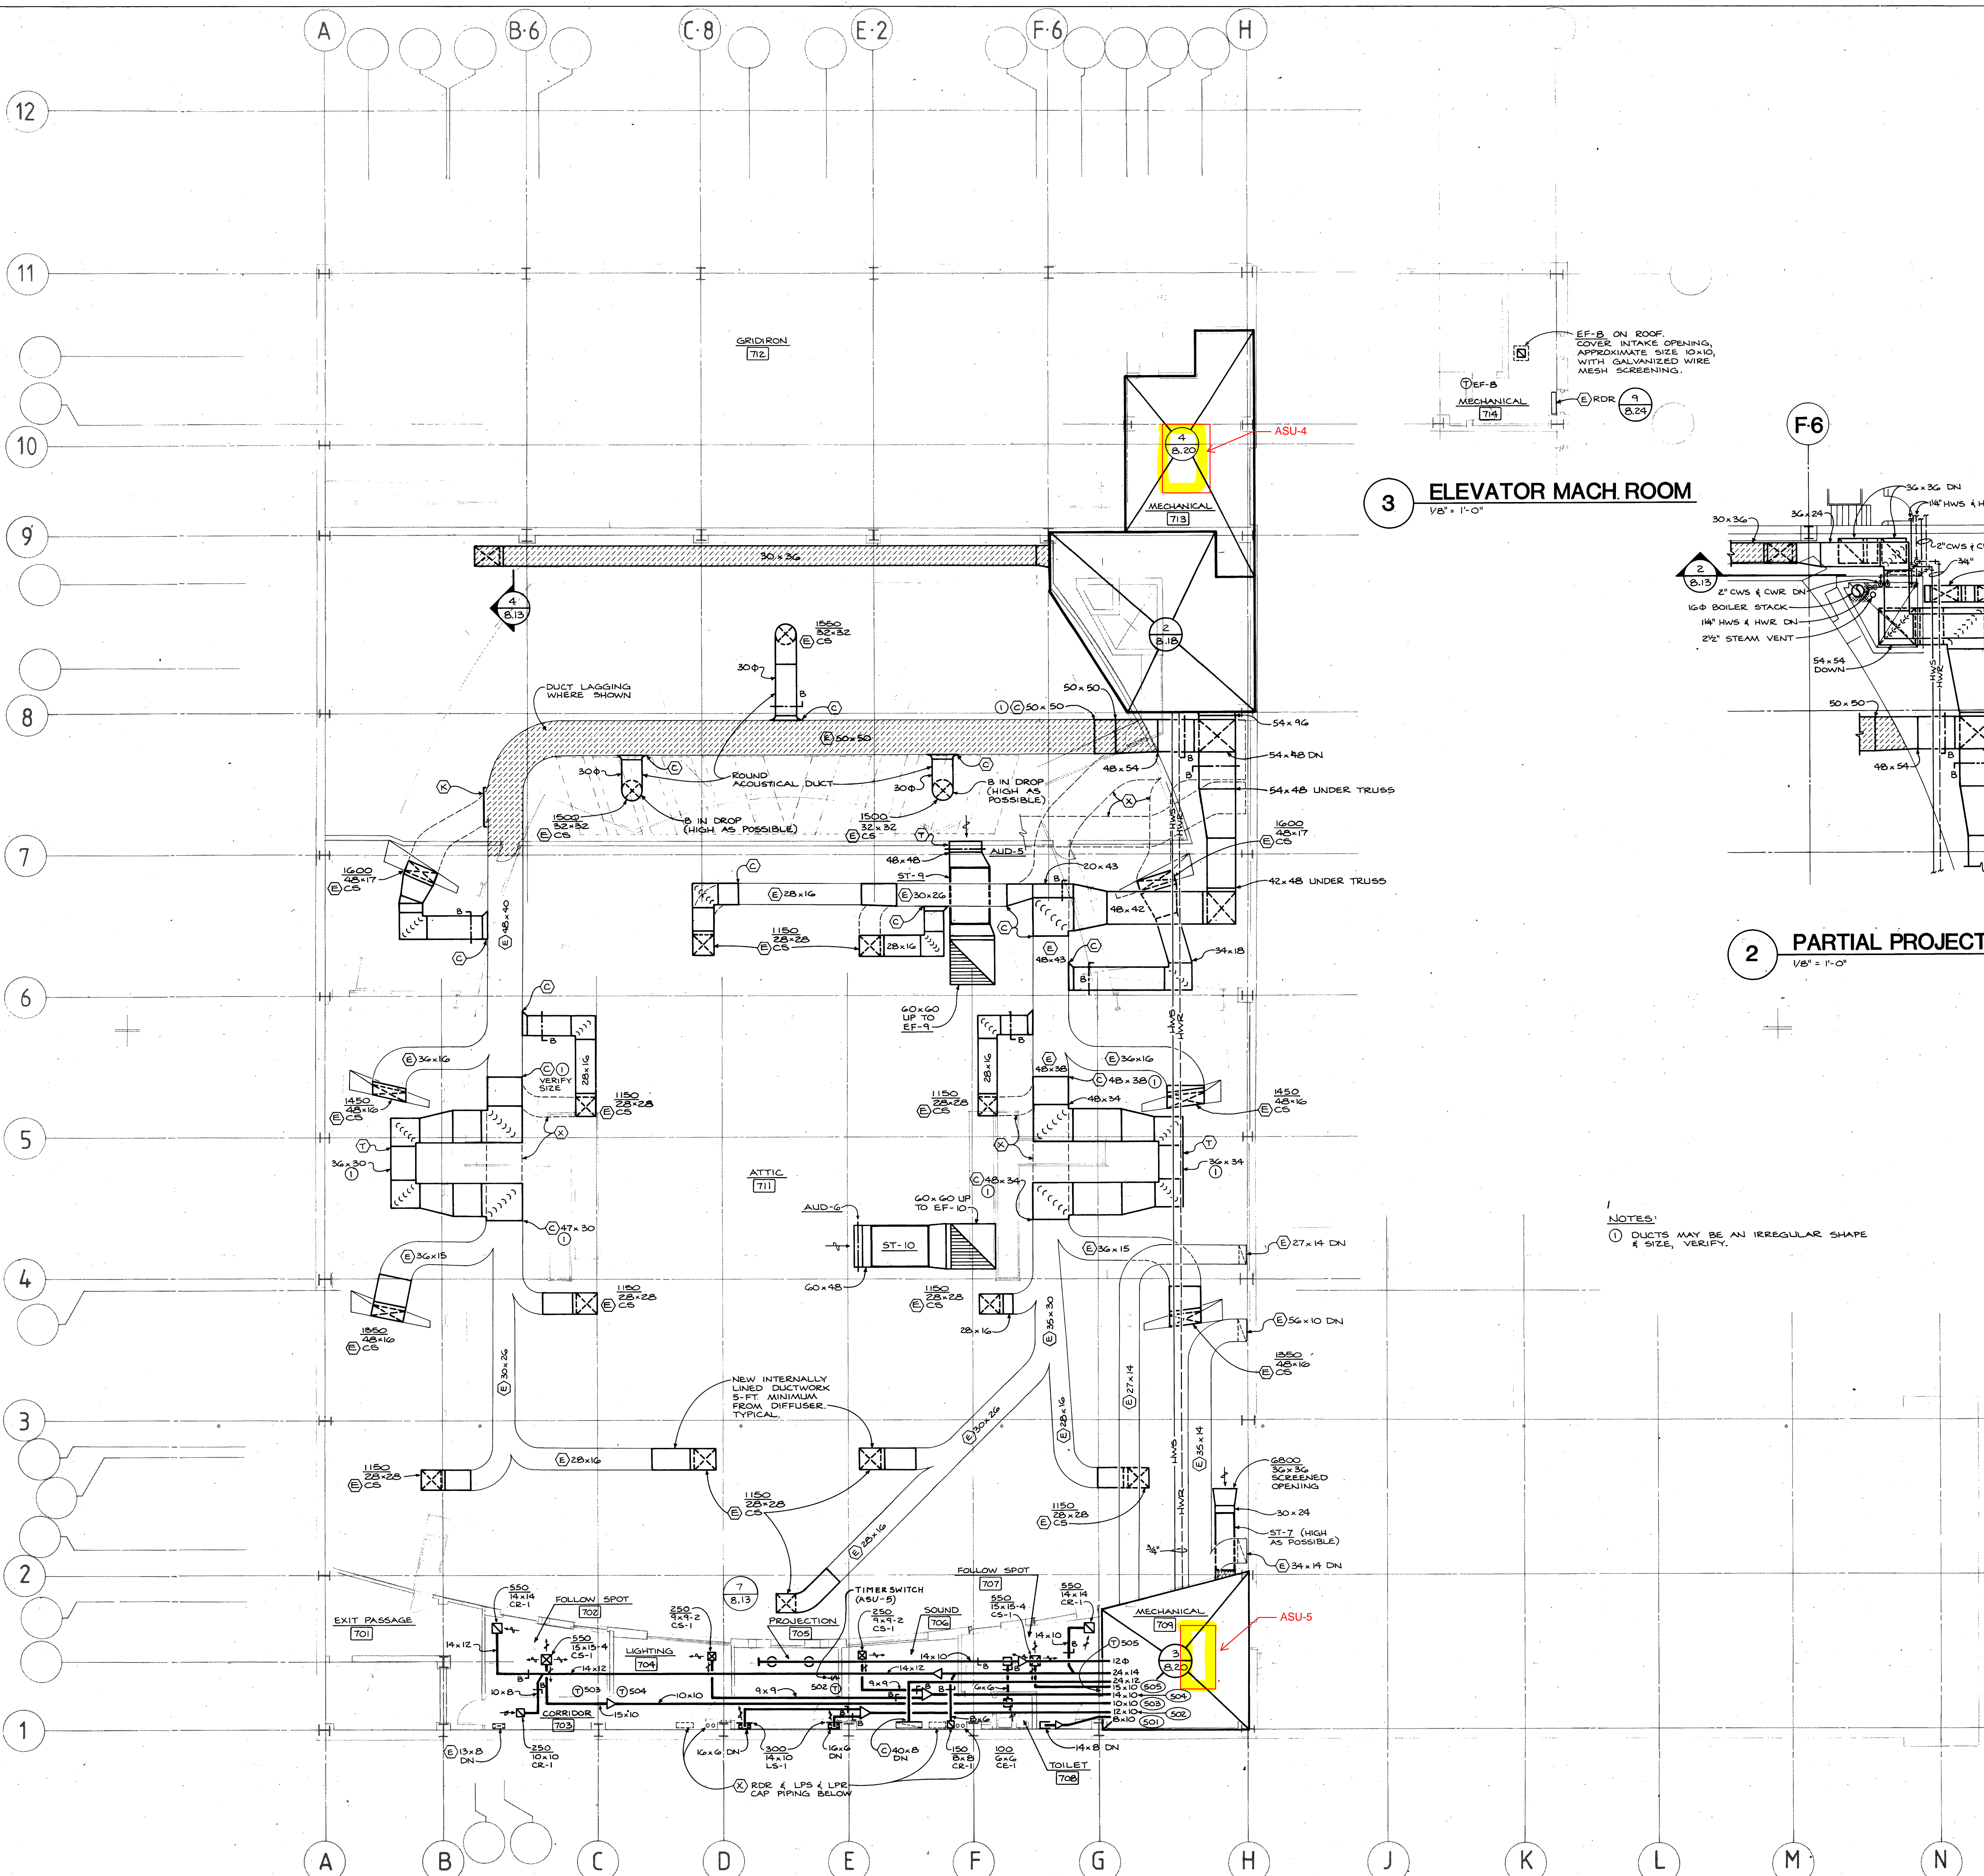

**3 ELEVATOR MACH. ROOM**  
 1/8" = 1'-0"

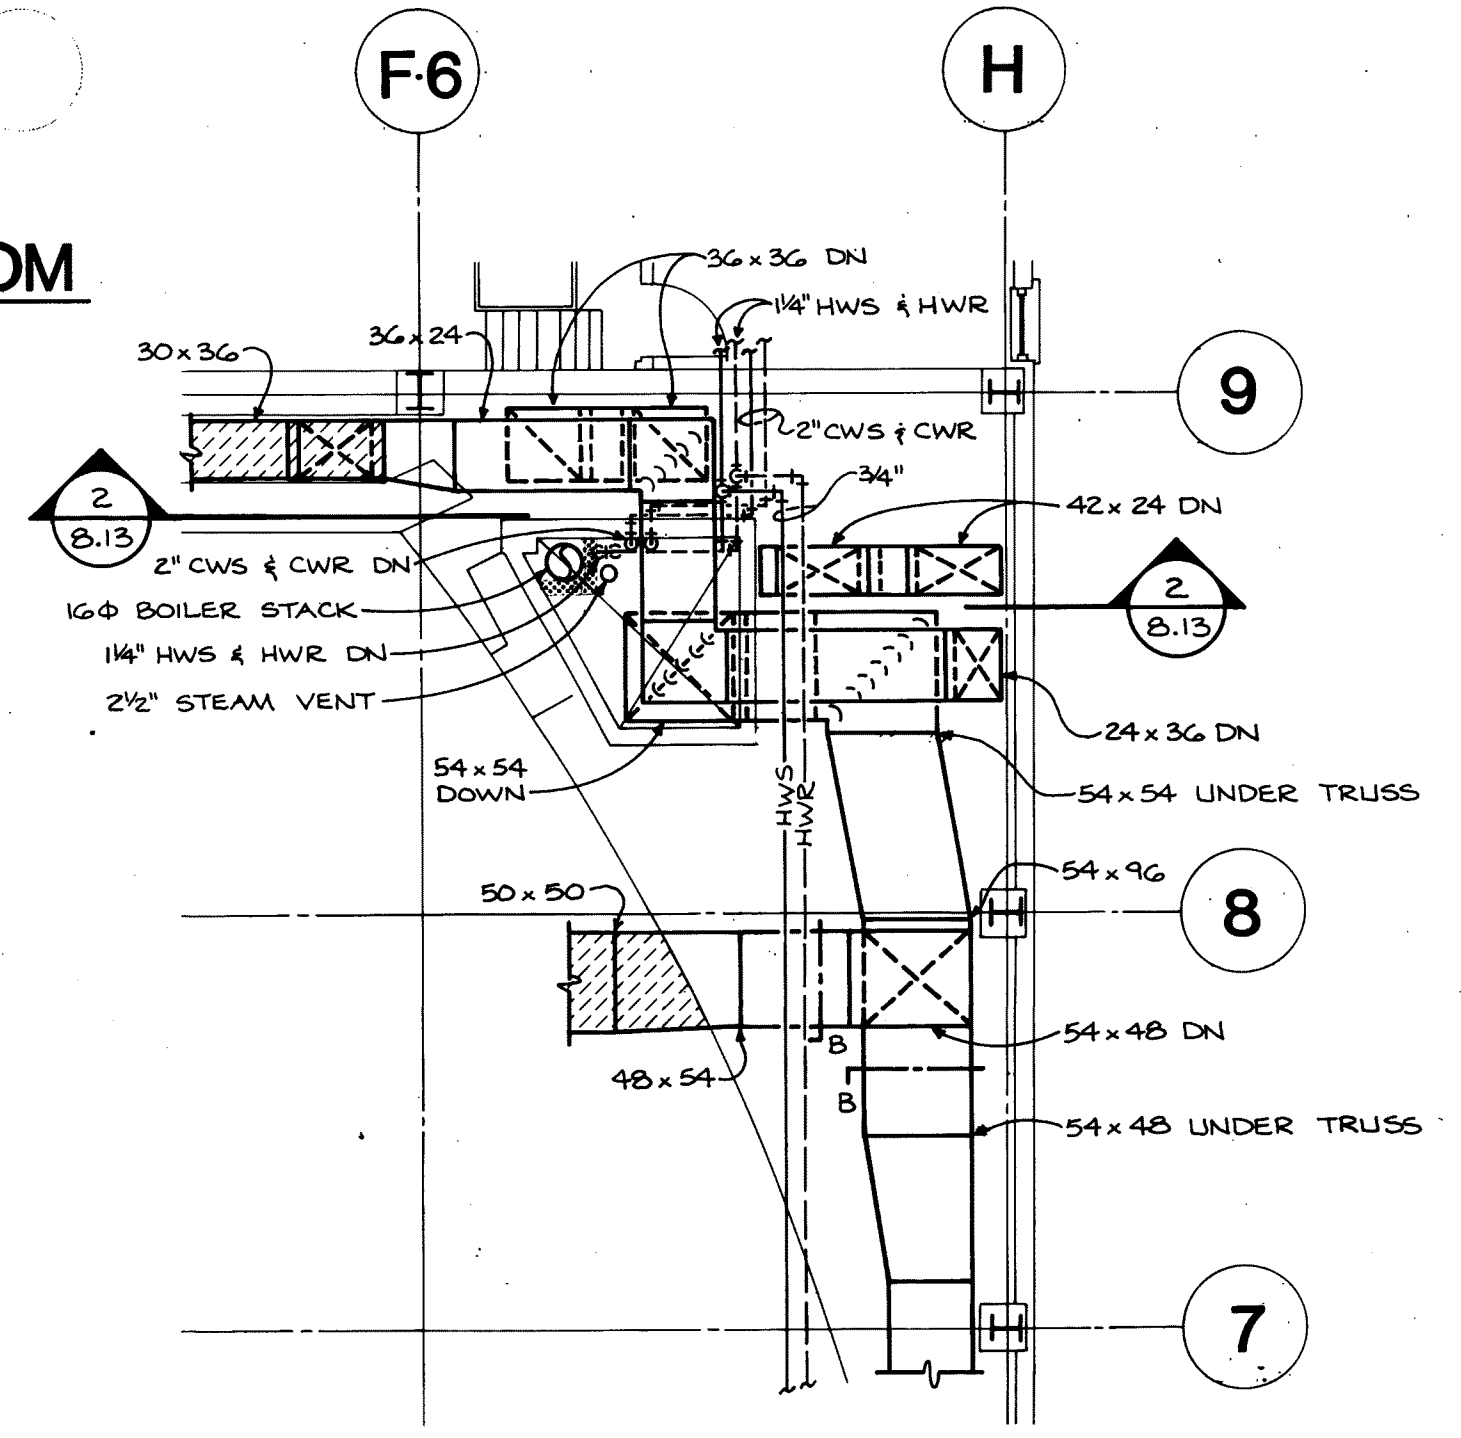


**2 PARTIAL PROJECTION PLAN**  
 1/8" = 1'-0"

NOTES:  
 ① DUCTS MAY BE AN IRREGULAR SHAPE & SIZE, VERIFY.


## PROJECTION LEVEL PLAN HVAC

Job No.	Date
Set No.	Sheet No.
<b>8.18</b>	




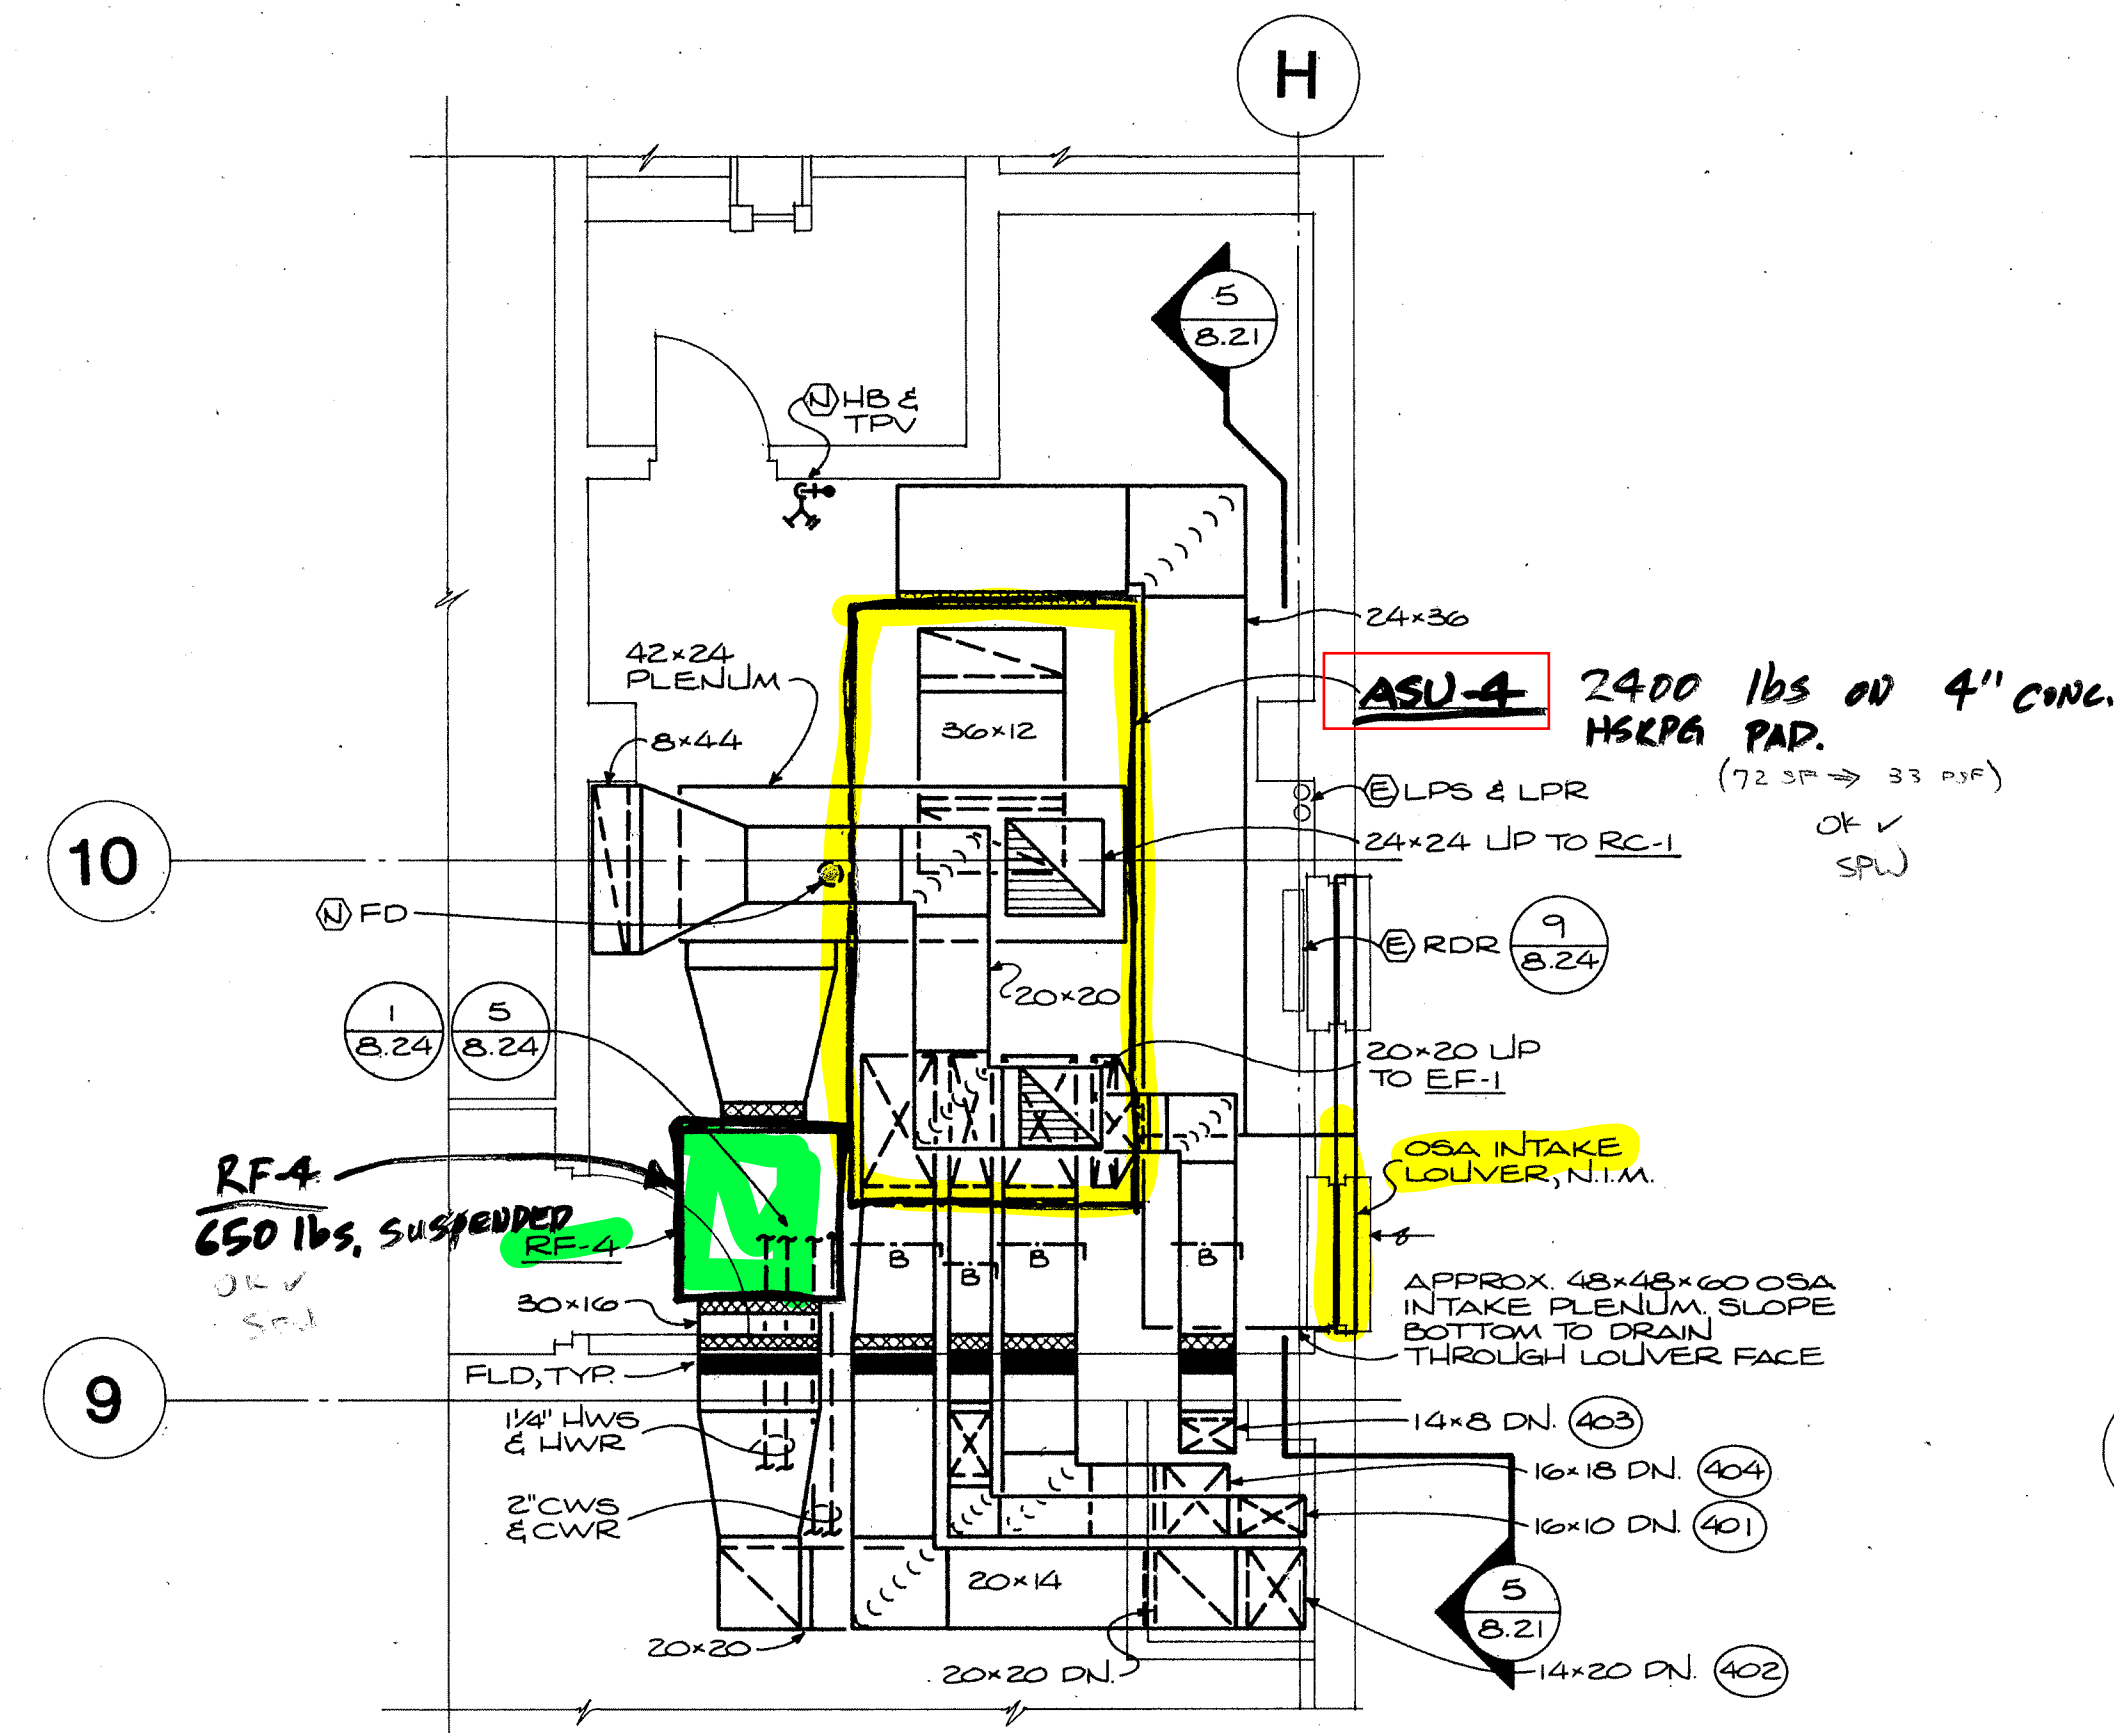


4 MECH. ROOM 713 PLAN  
1/4"=1'-0"

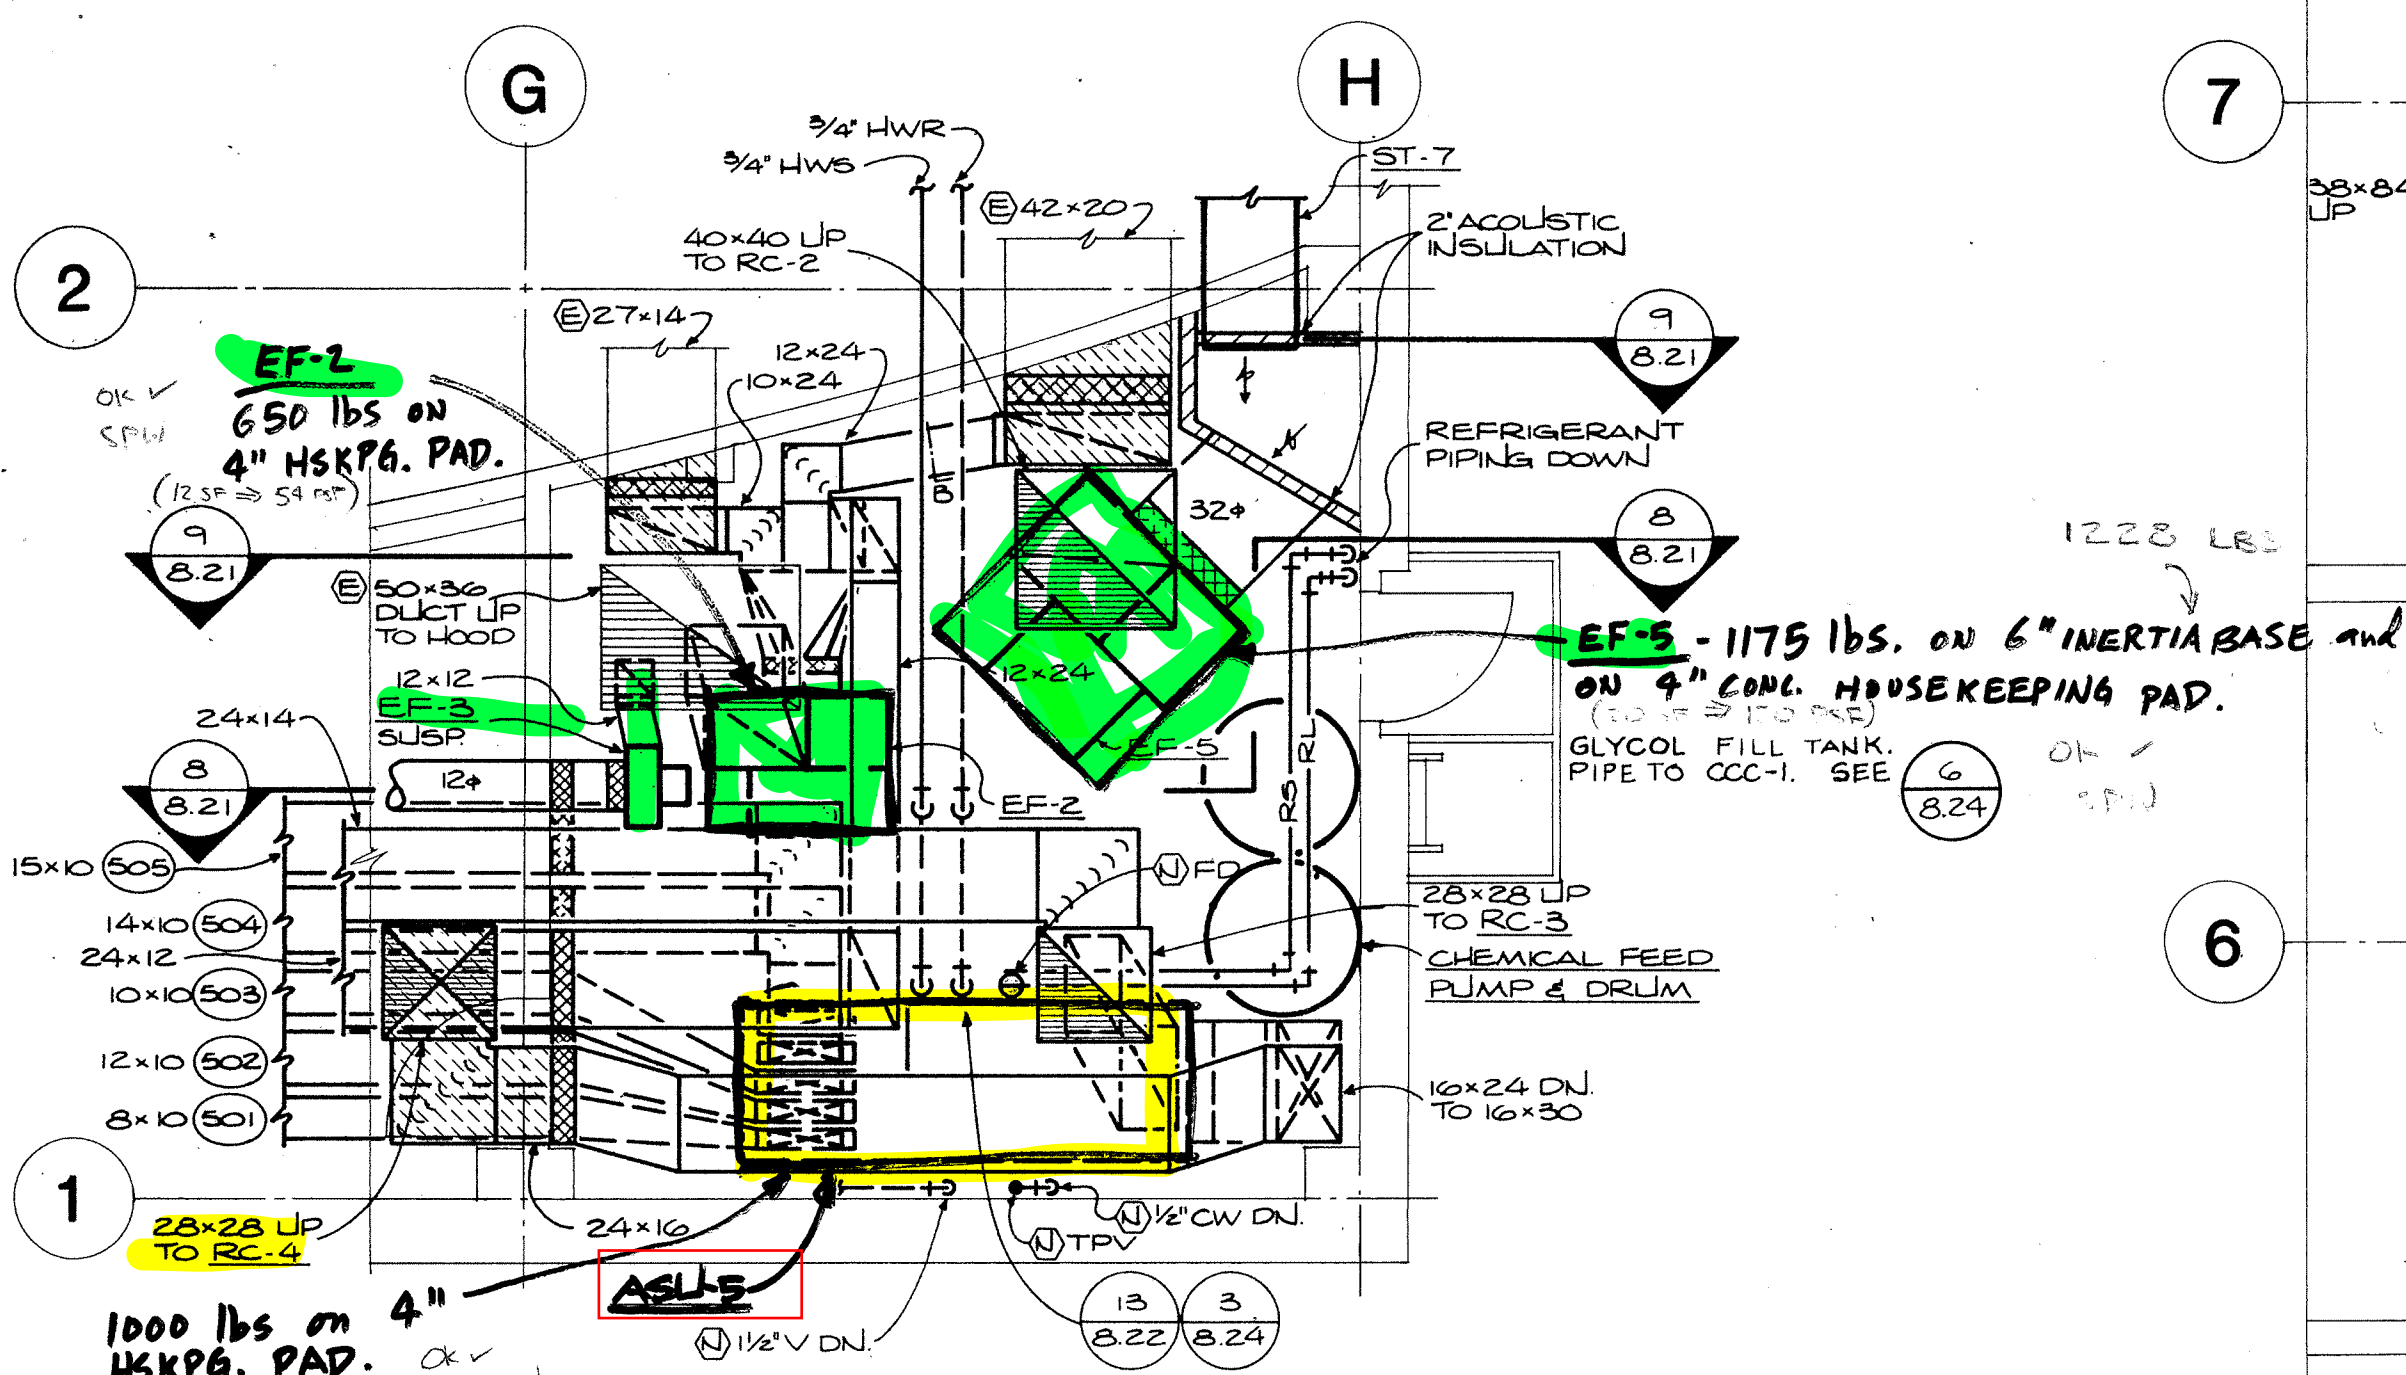

3 MECH. ROOM 709 PLAN  
1/4"=1'-0"

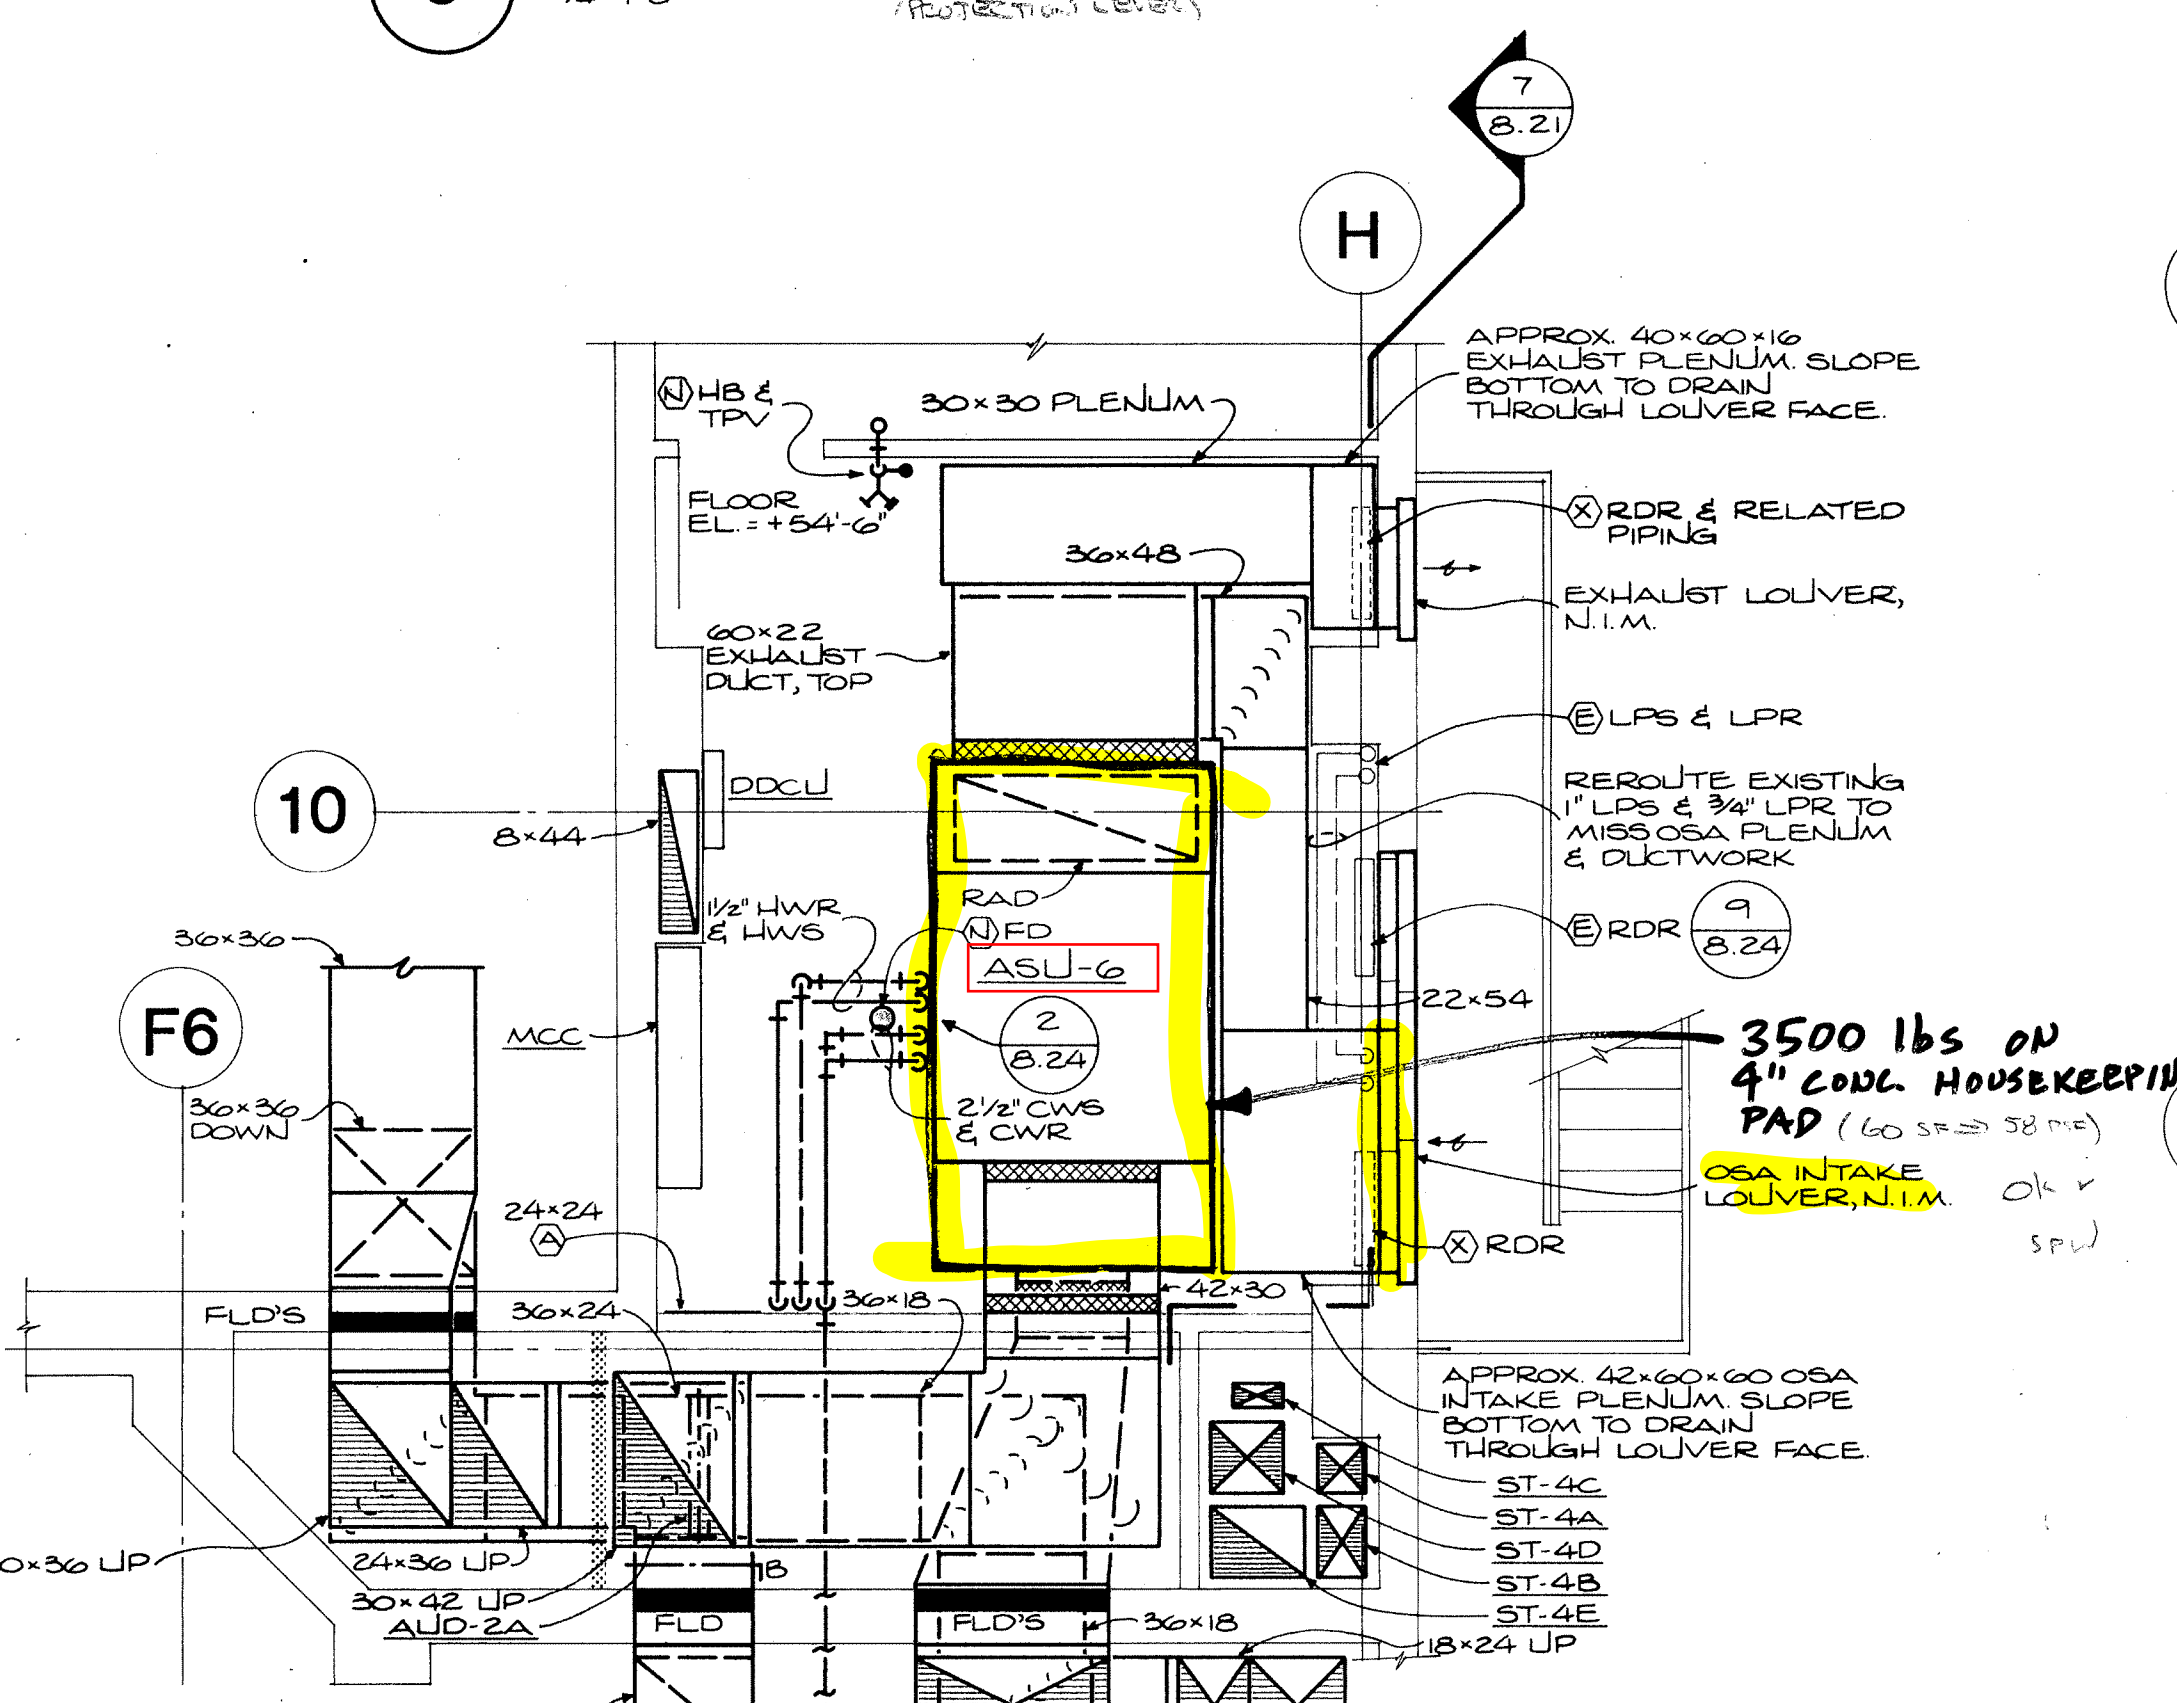


2 MECH. ROOM 607 PLAN  
1/4"=1'-0"

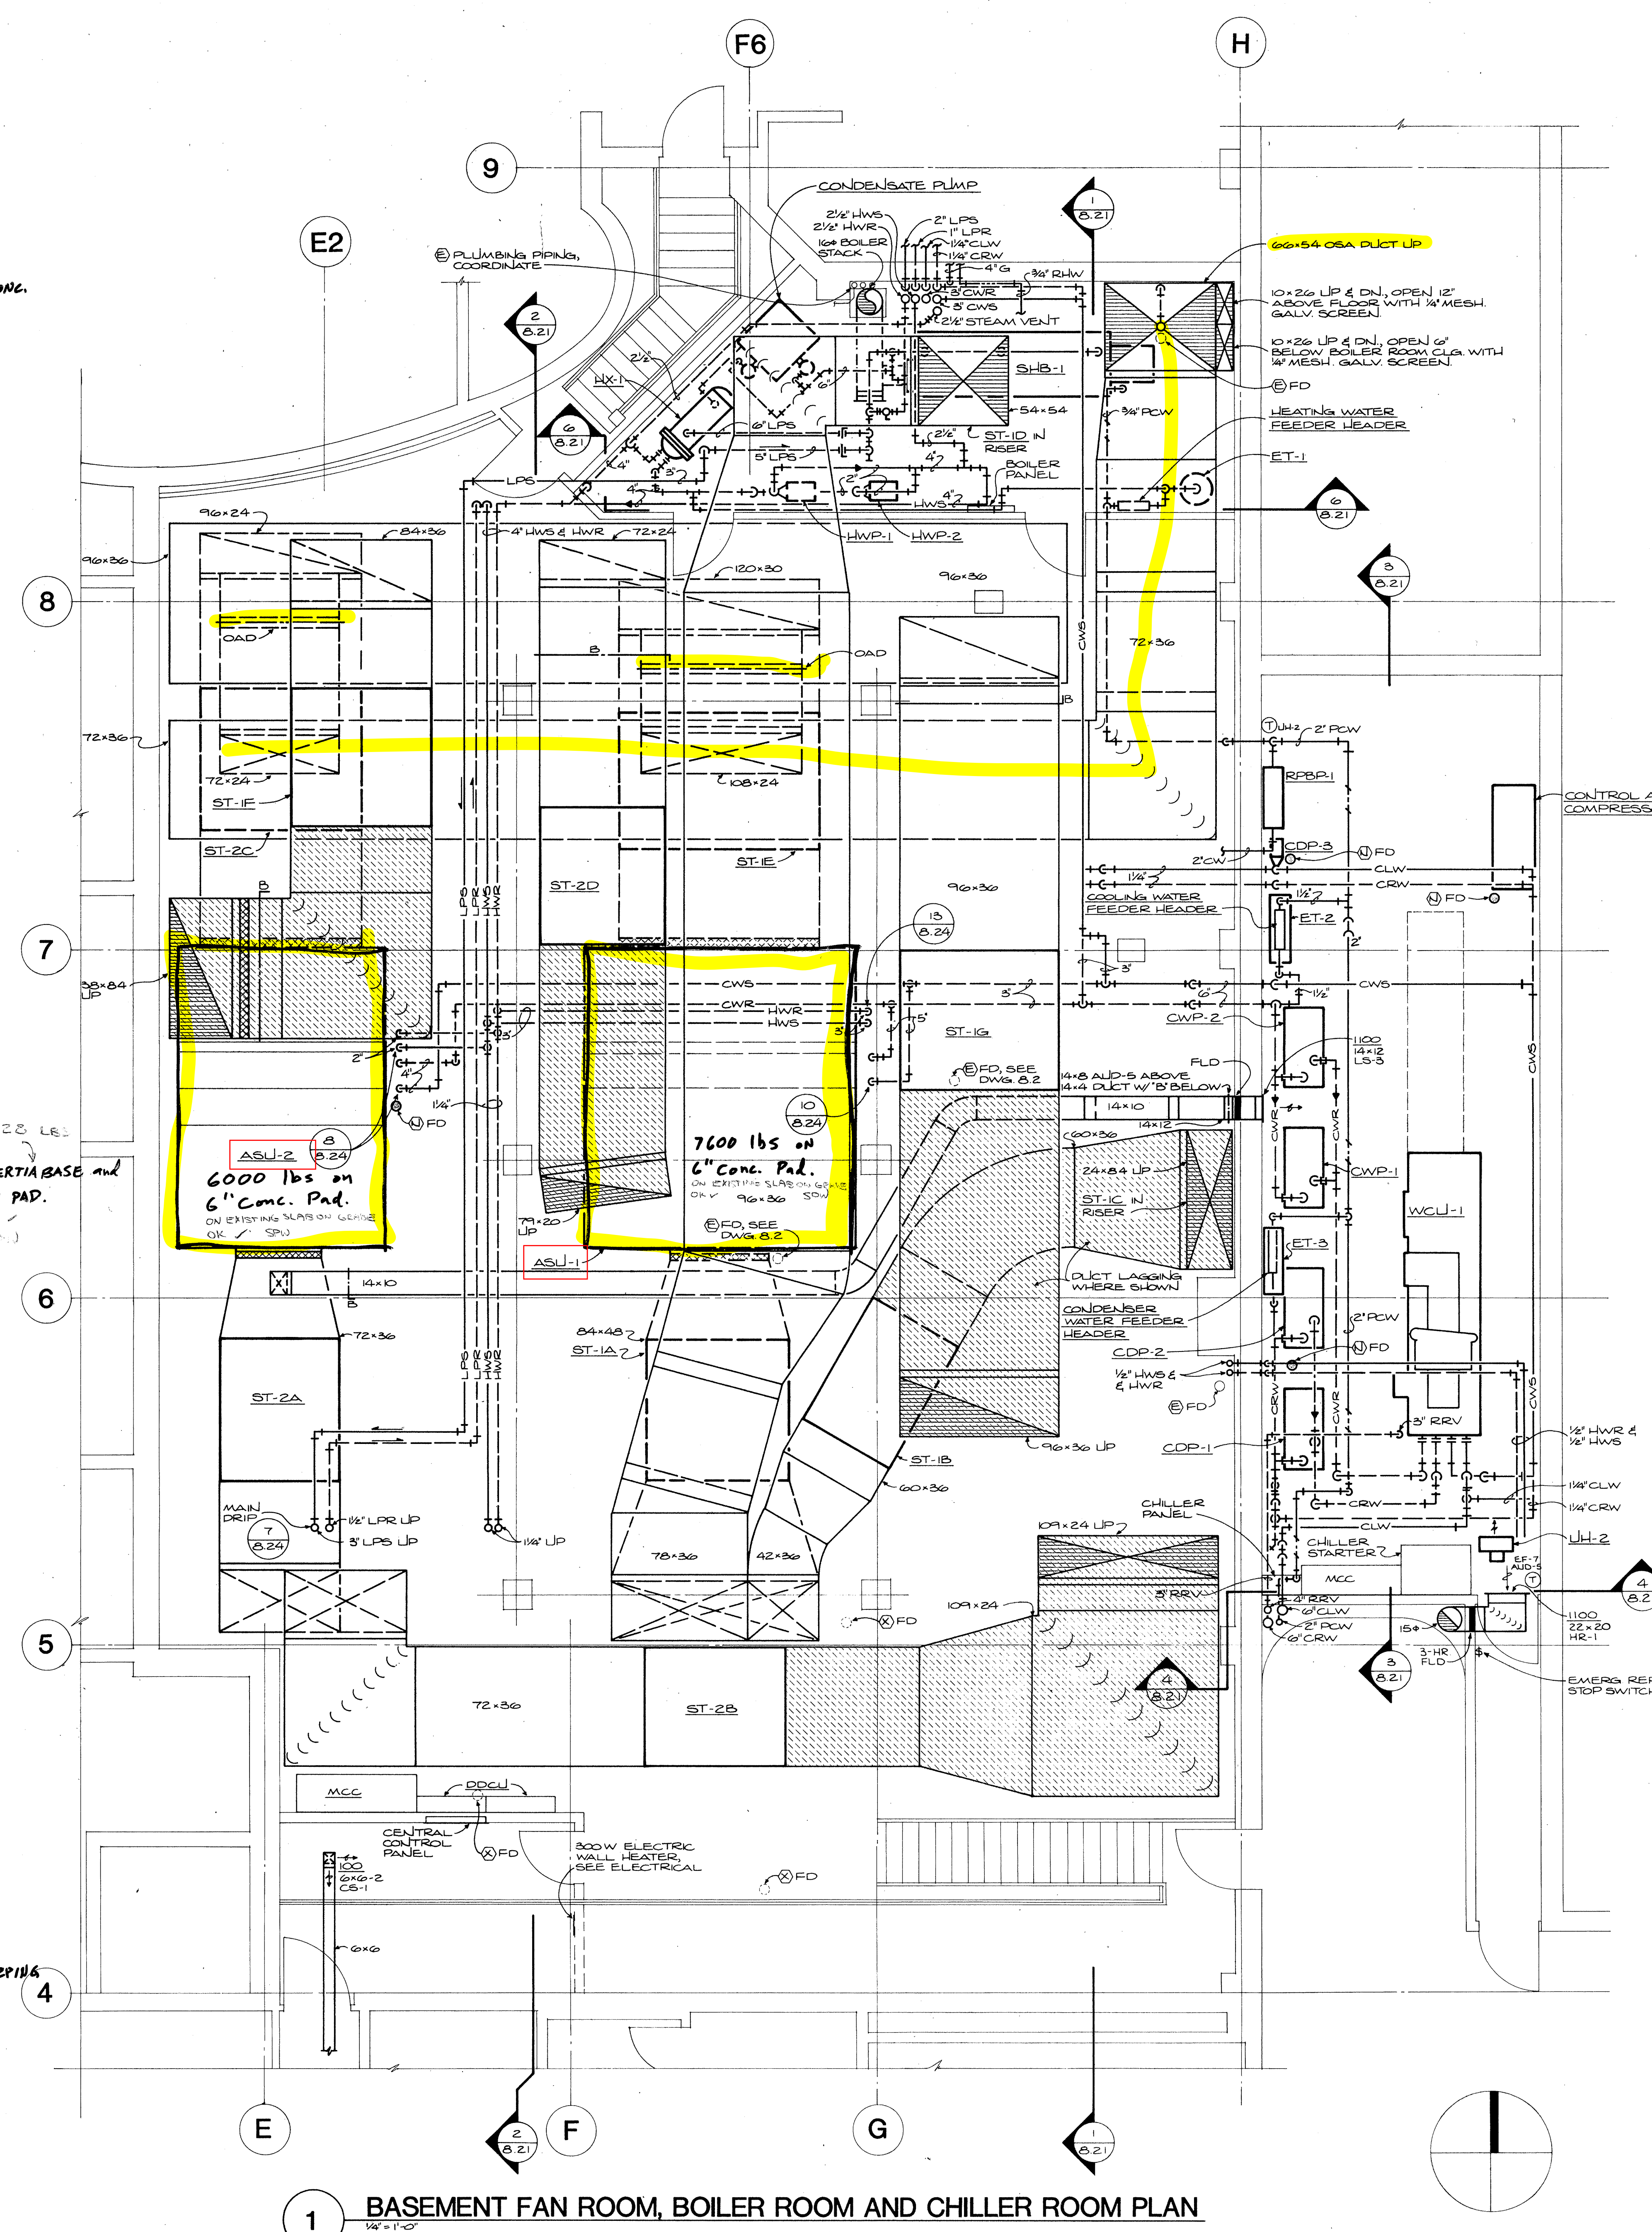

1 BASEMENT FAN ROOM, BOILER ROOM AND CHILLER ROOM PLAN  
1/4"=1'-0"

REVIEWED FOR COMPLIANCE WITH  
ORIGINAL MECHANICAL DATA.  
SEE NEW STRUCTURAL DRAWINGS  
SPW FOR LTB 1-7-63  
CH2M HILL, INC.

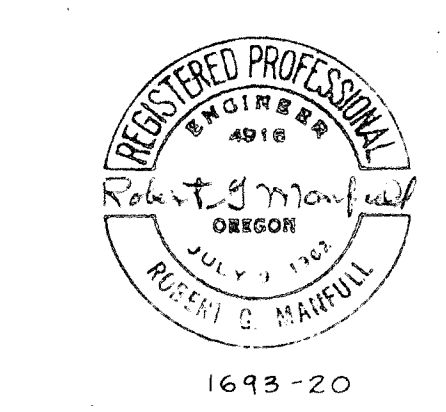


MECHANICAL ROOM  
PLANS


# Portland Center for the Performing Arts

The City of Portland  
Honorable Mildred A. Schwab;  
Commissioner in Charge  
Ronald K. Ragen; Chairman  
Performing Arts Center  
Committee


Broome, Oringdolph, O Toole, Rudolf & Associates, P.C.  
ELS Design Group  
Barton Myers  
Theatre Projects, Inc.  
R. Lawrence Kirkgaard & Associates  
Interface Engineering, Inc.  
C.W. Timmer & Associates  
CH2M Hill  
Project Address:  
733 N.W. 20th Avenue  
Portland, Oregon 97209  
(503) 226-1575

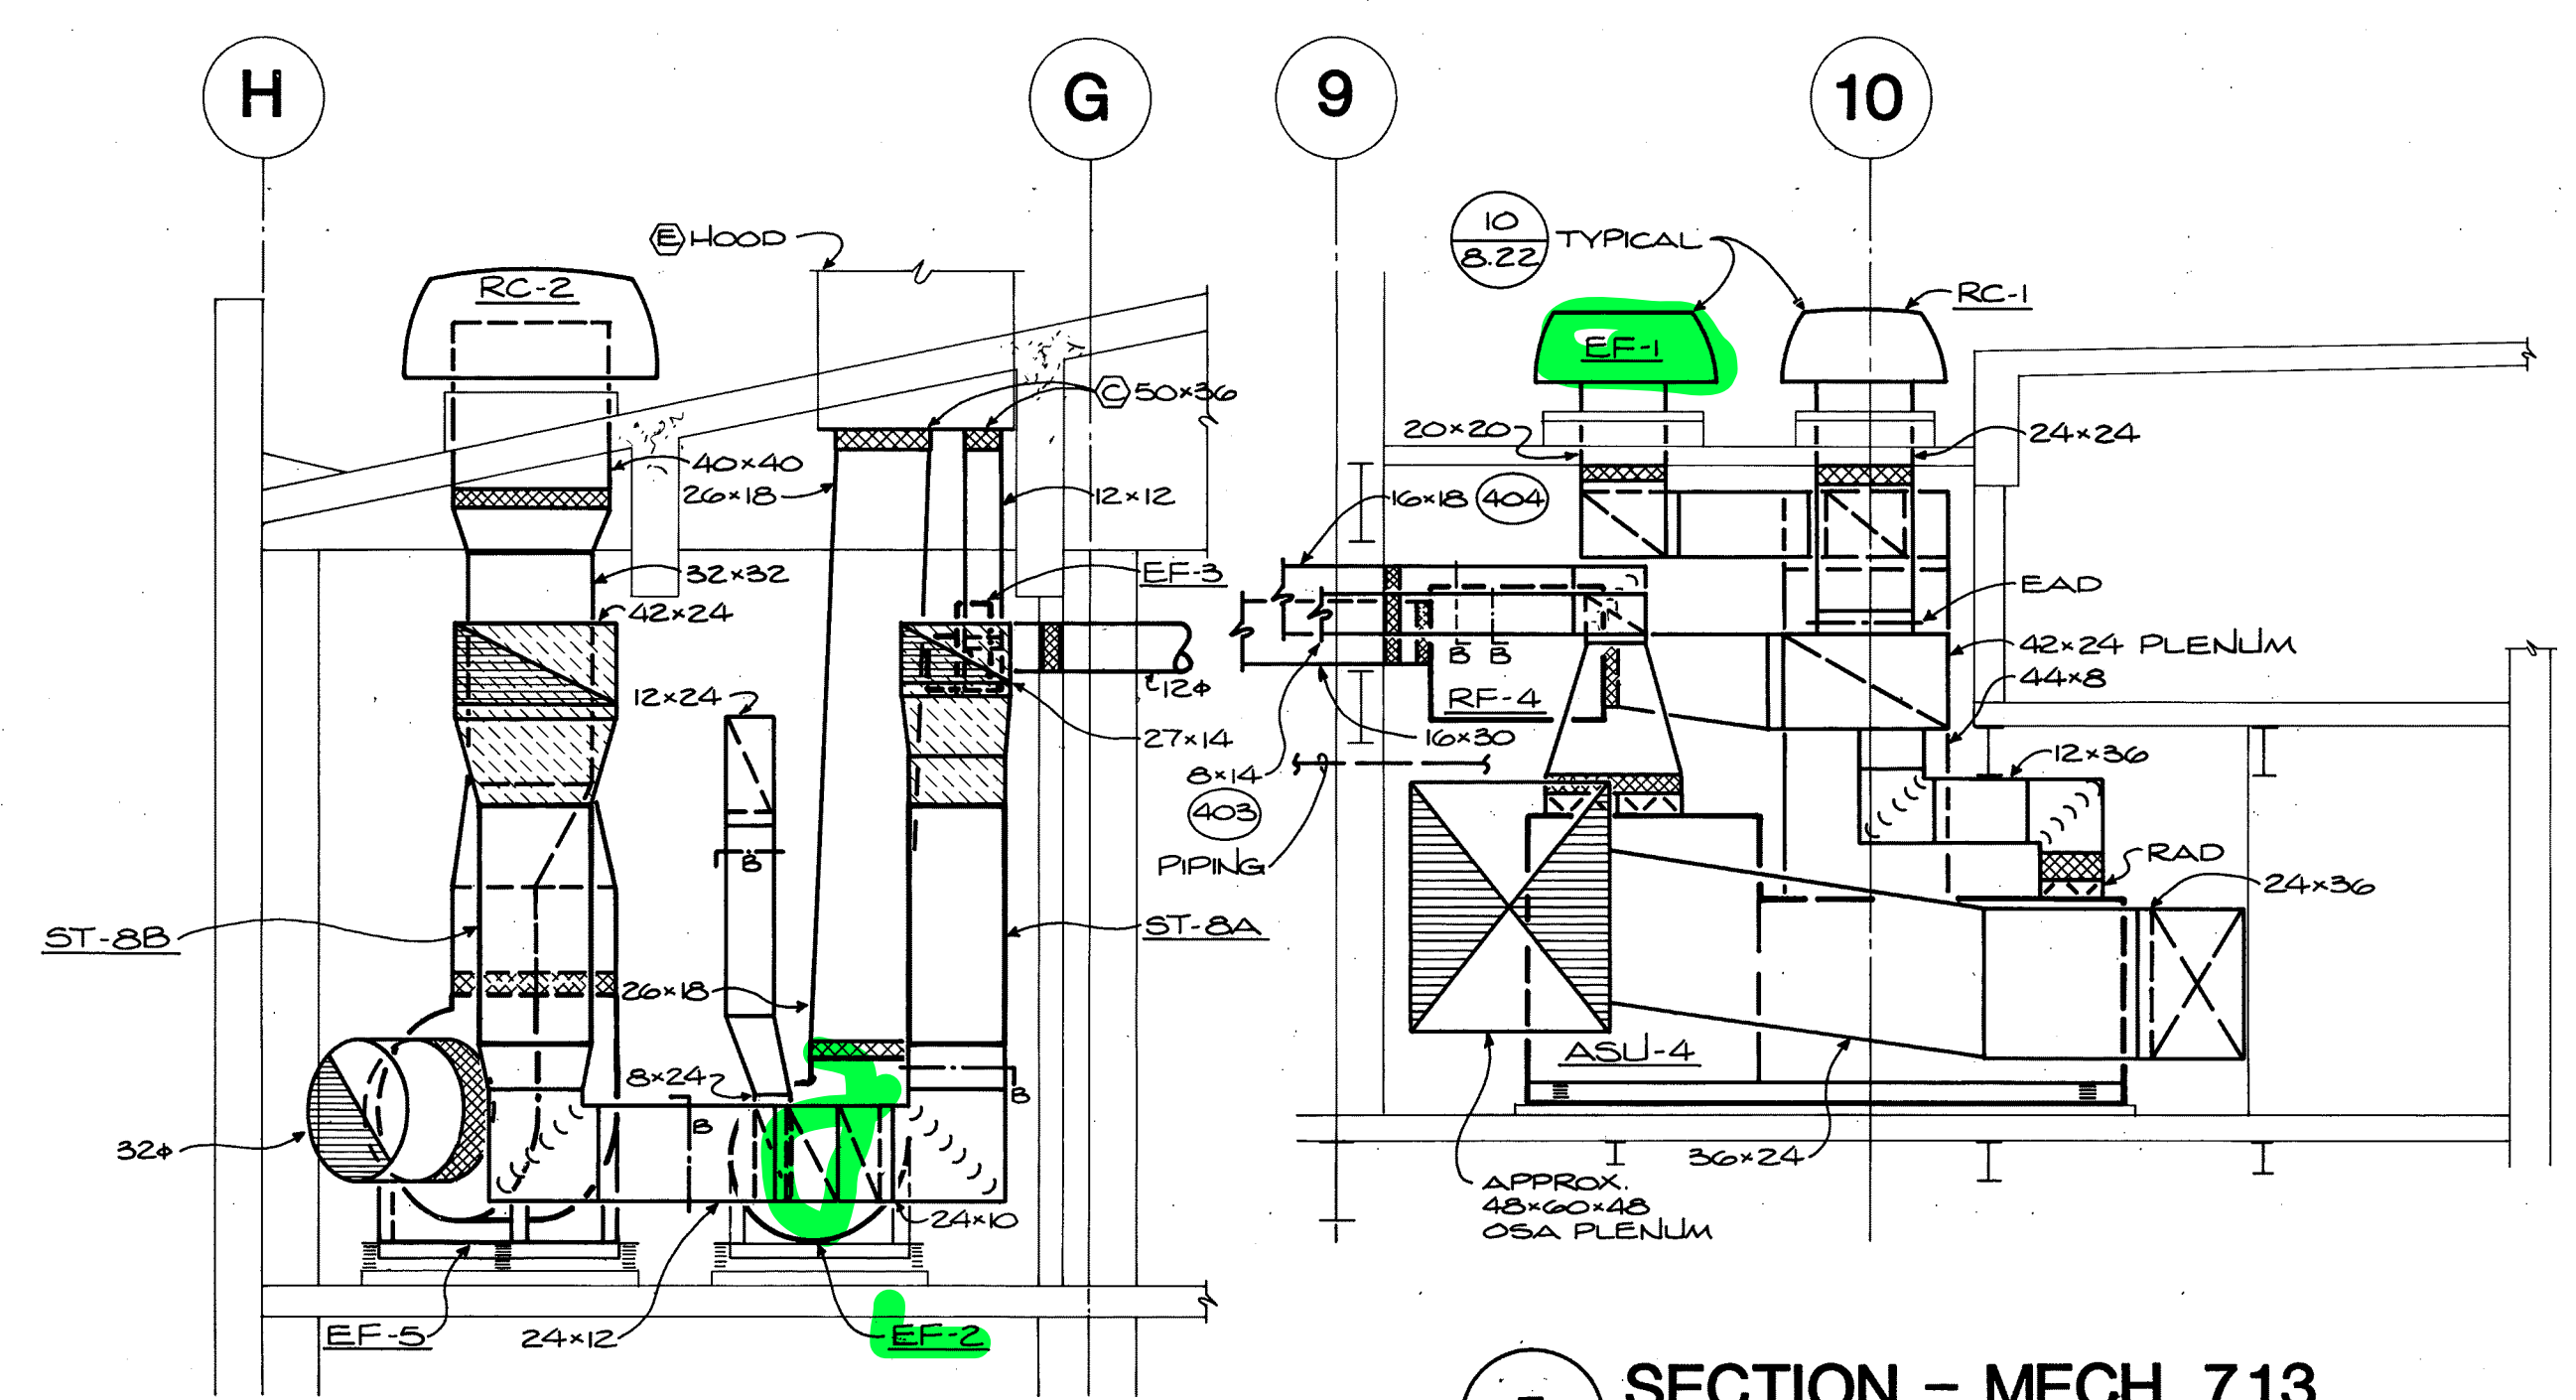


5 SECTION - MECH. 713  
1/4"=1'-0"

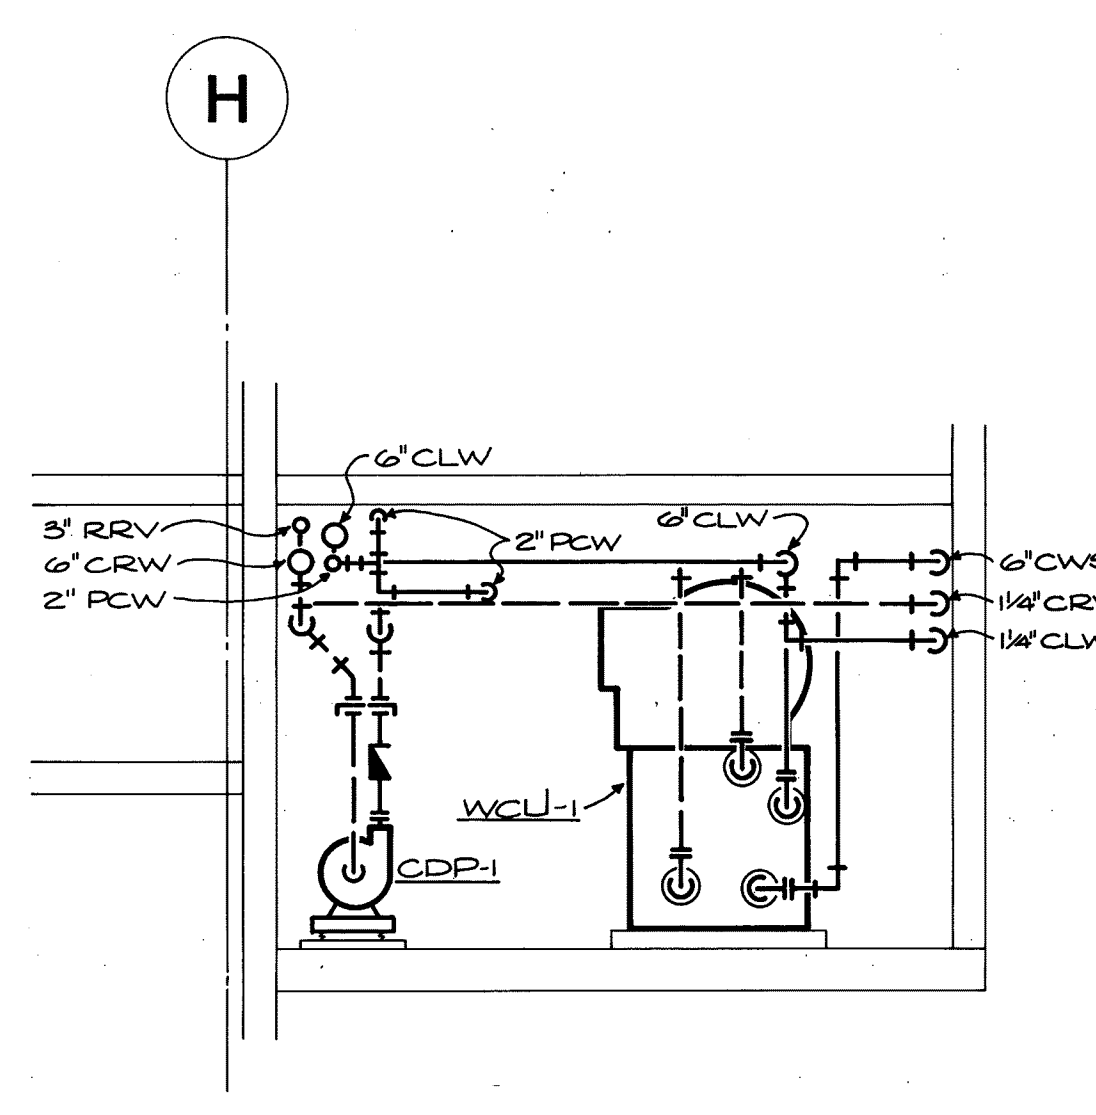


4 SECTION - CHILLER ROOM  
1/4"=1'-0"

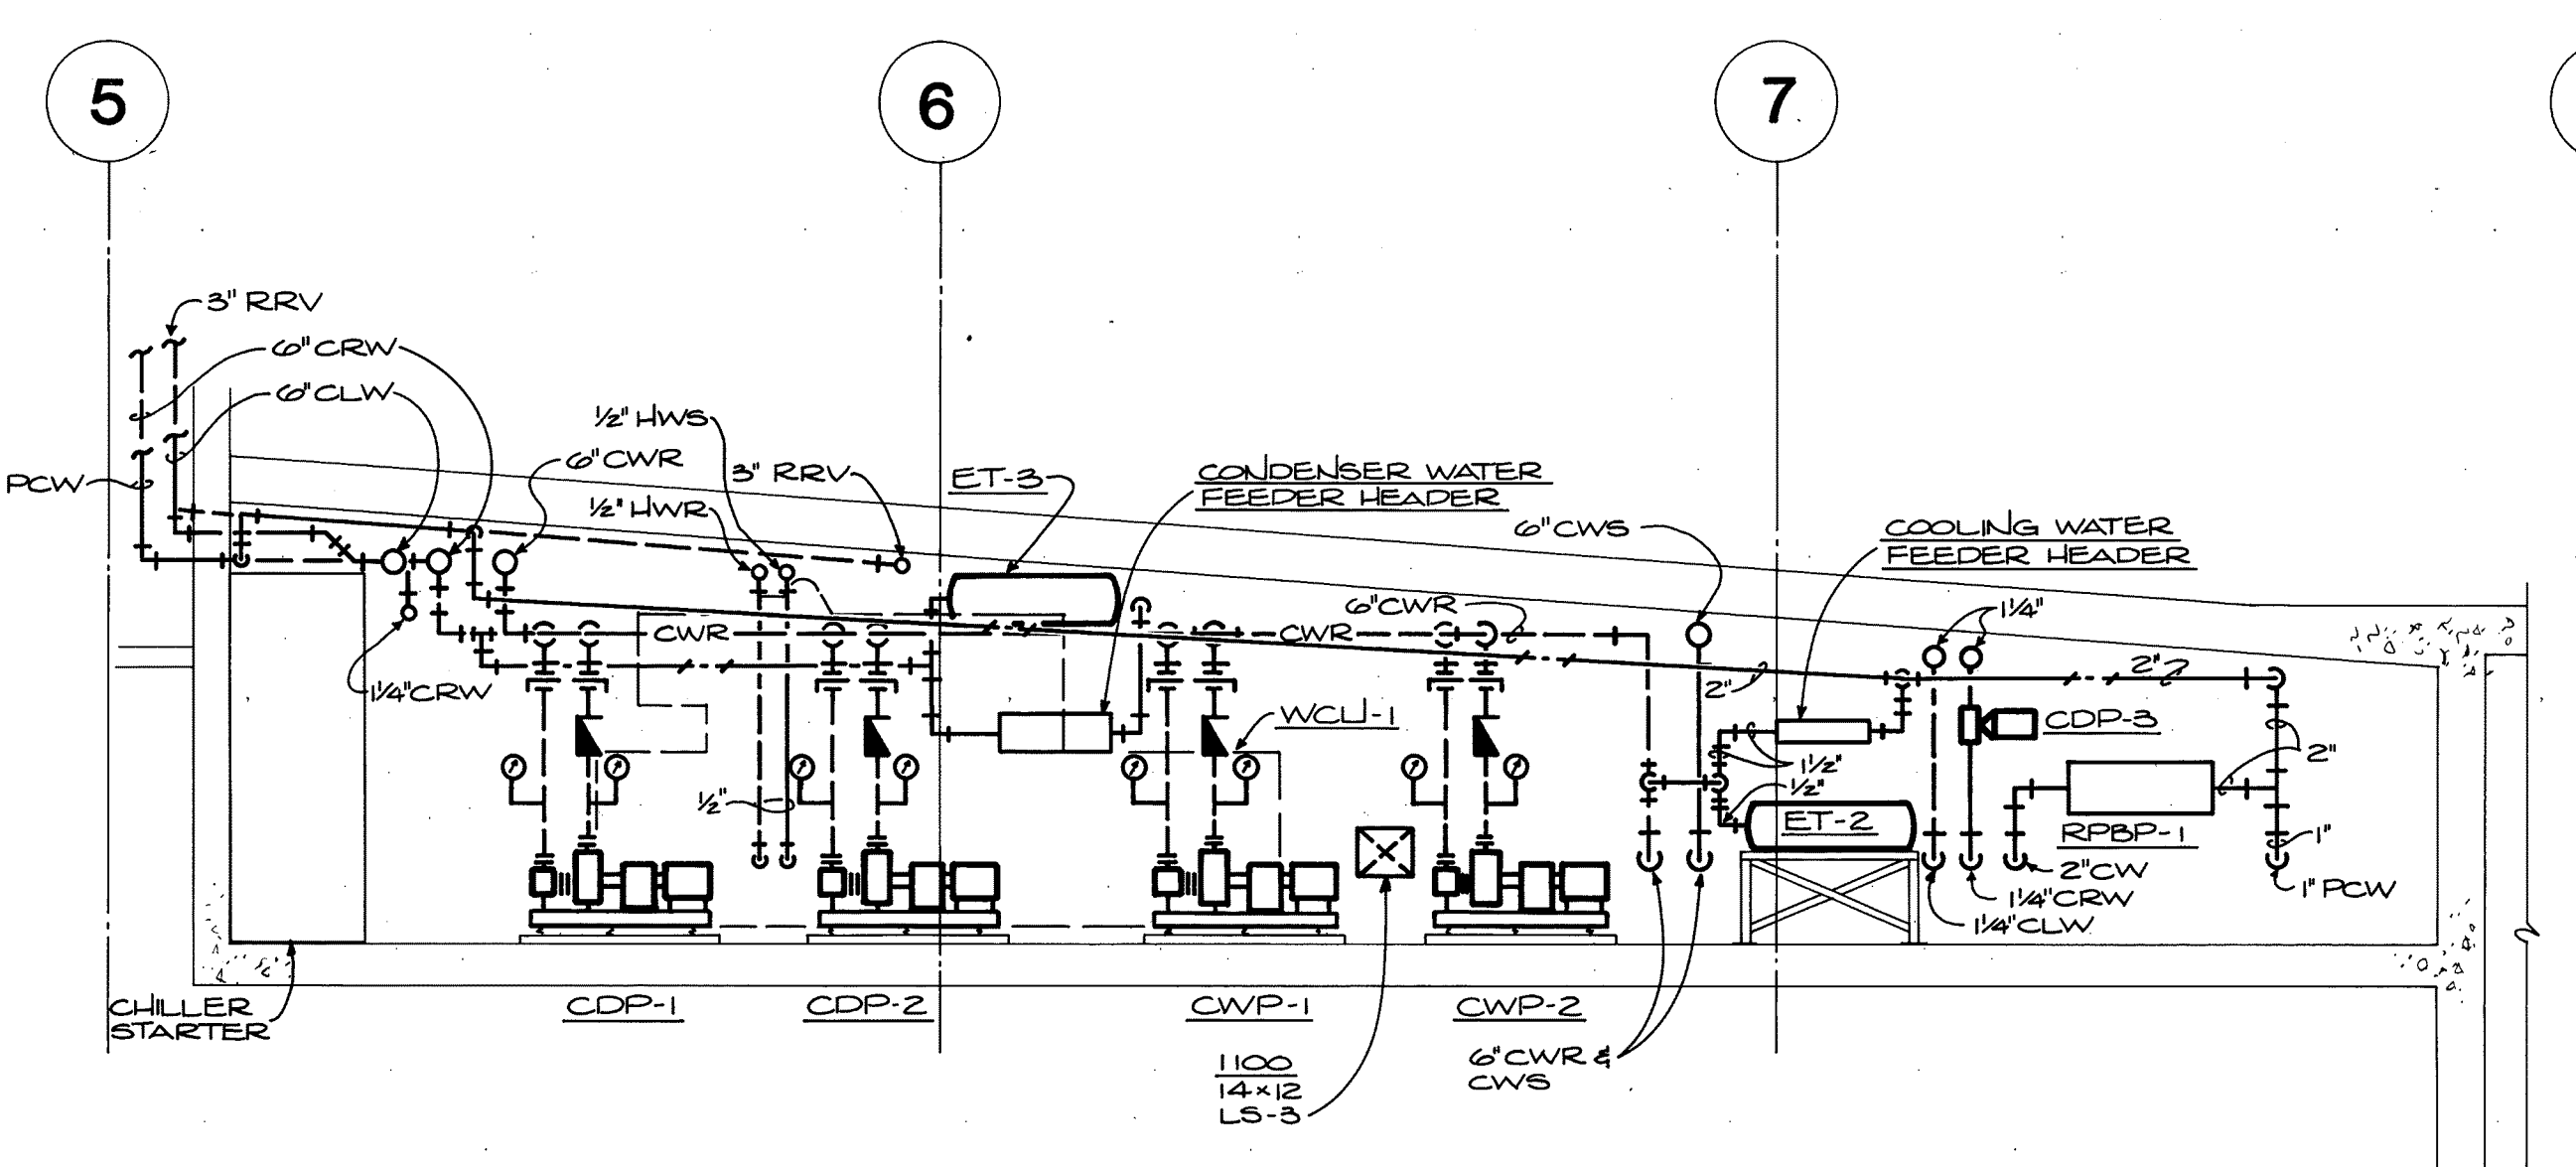


3 SECTION - CHILLER ROOM  
1/4"=1'-0"

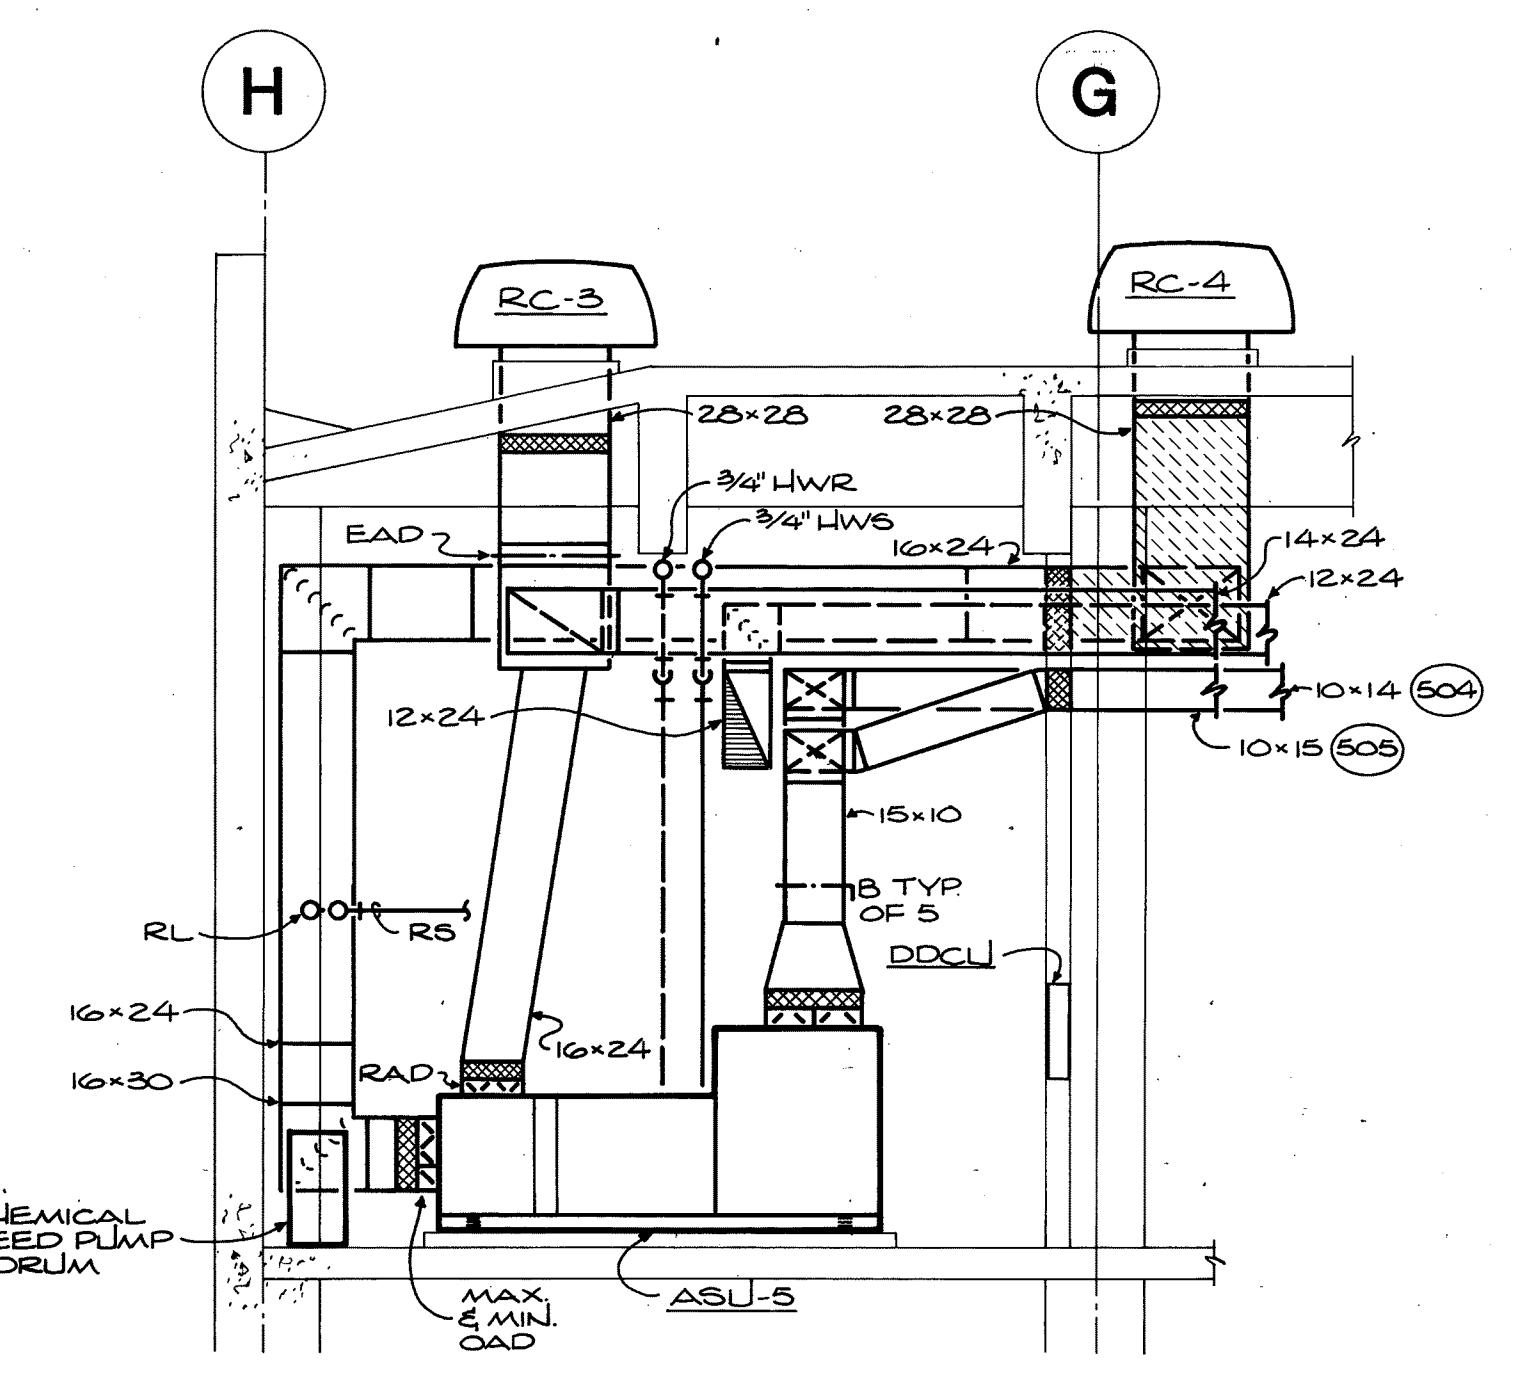


8 SECTION - MECH. 709  
1/4"=1'-0"

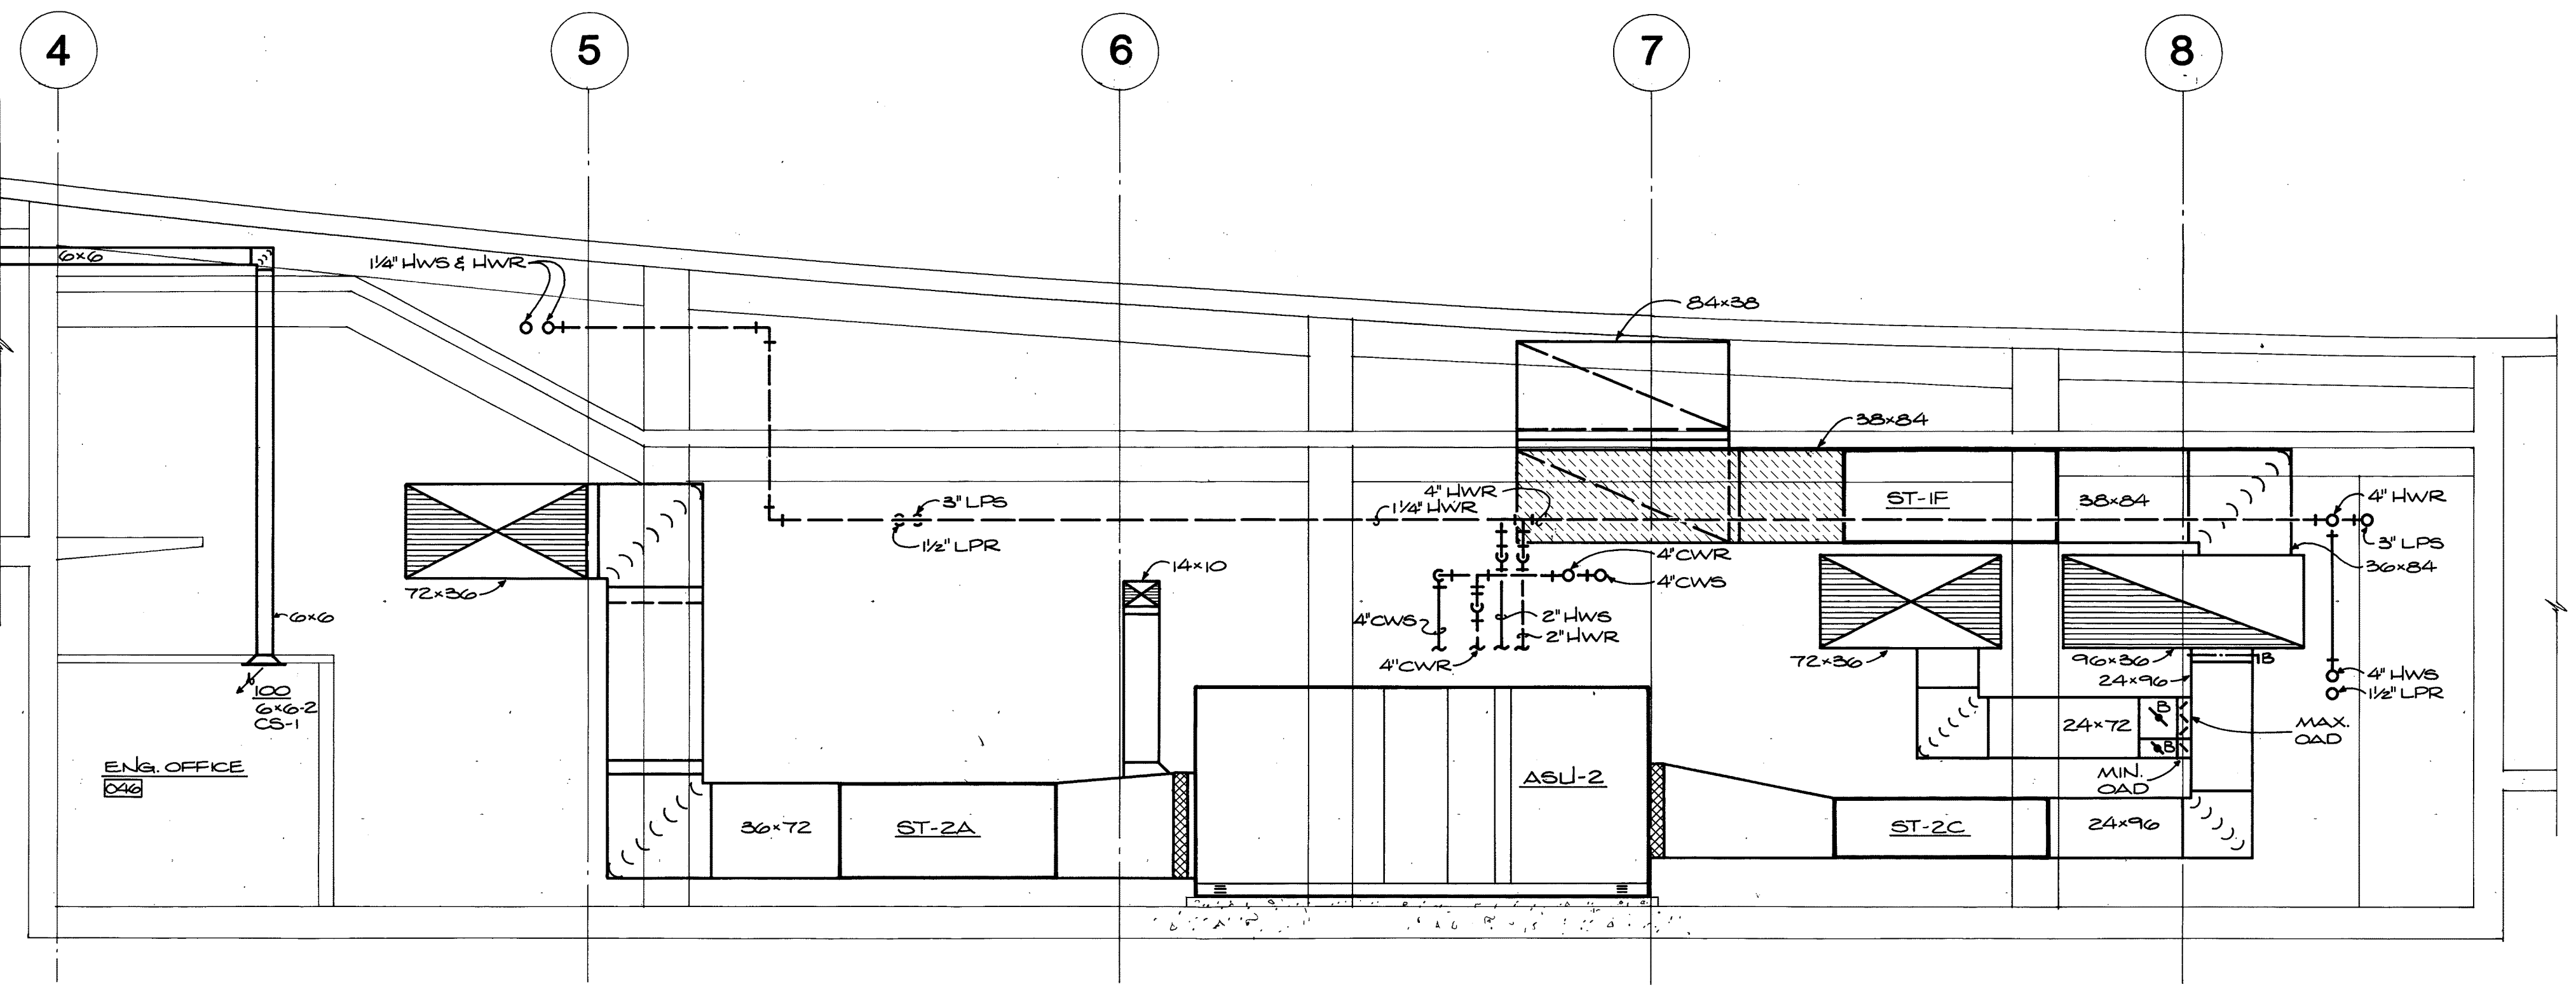


2 SECTION - BASEMENT FAN ROOM  
1/4"=1'-0"

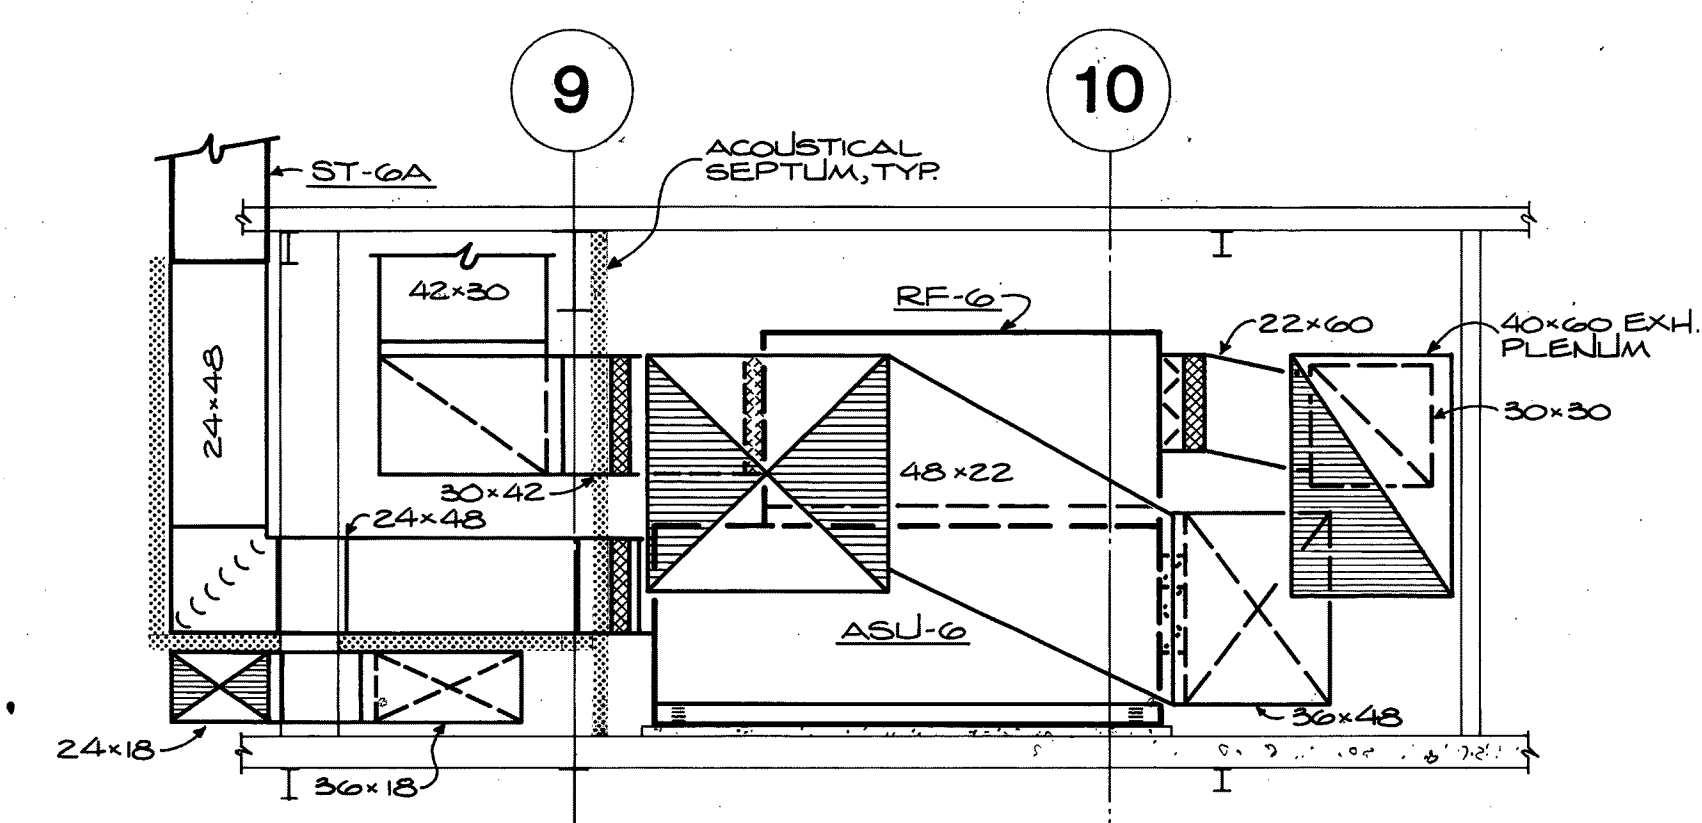


7 SECTION - MECH. 608  
1/4"=1'-0"

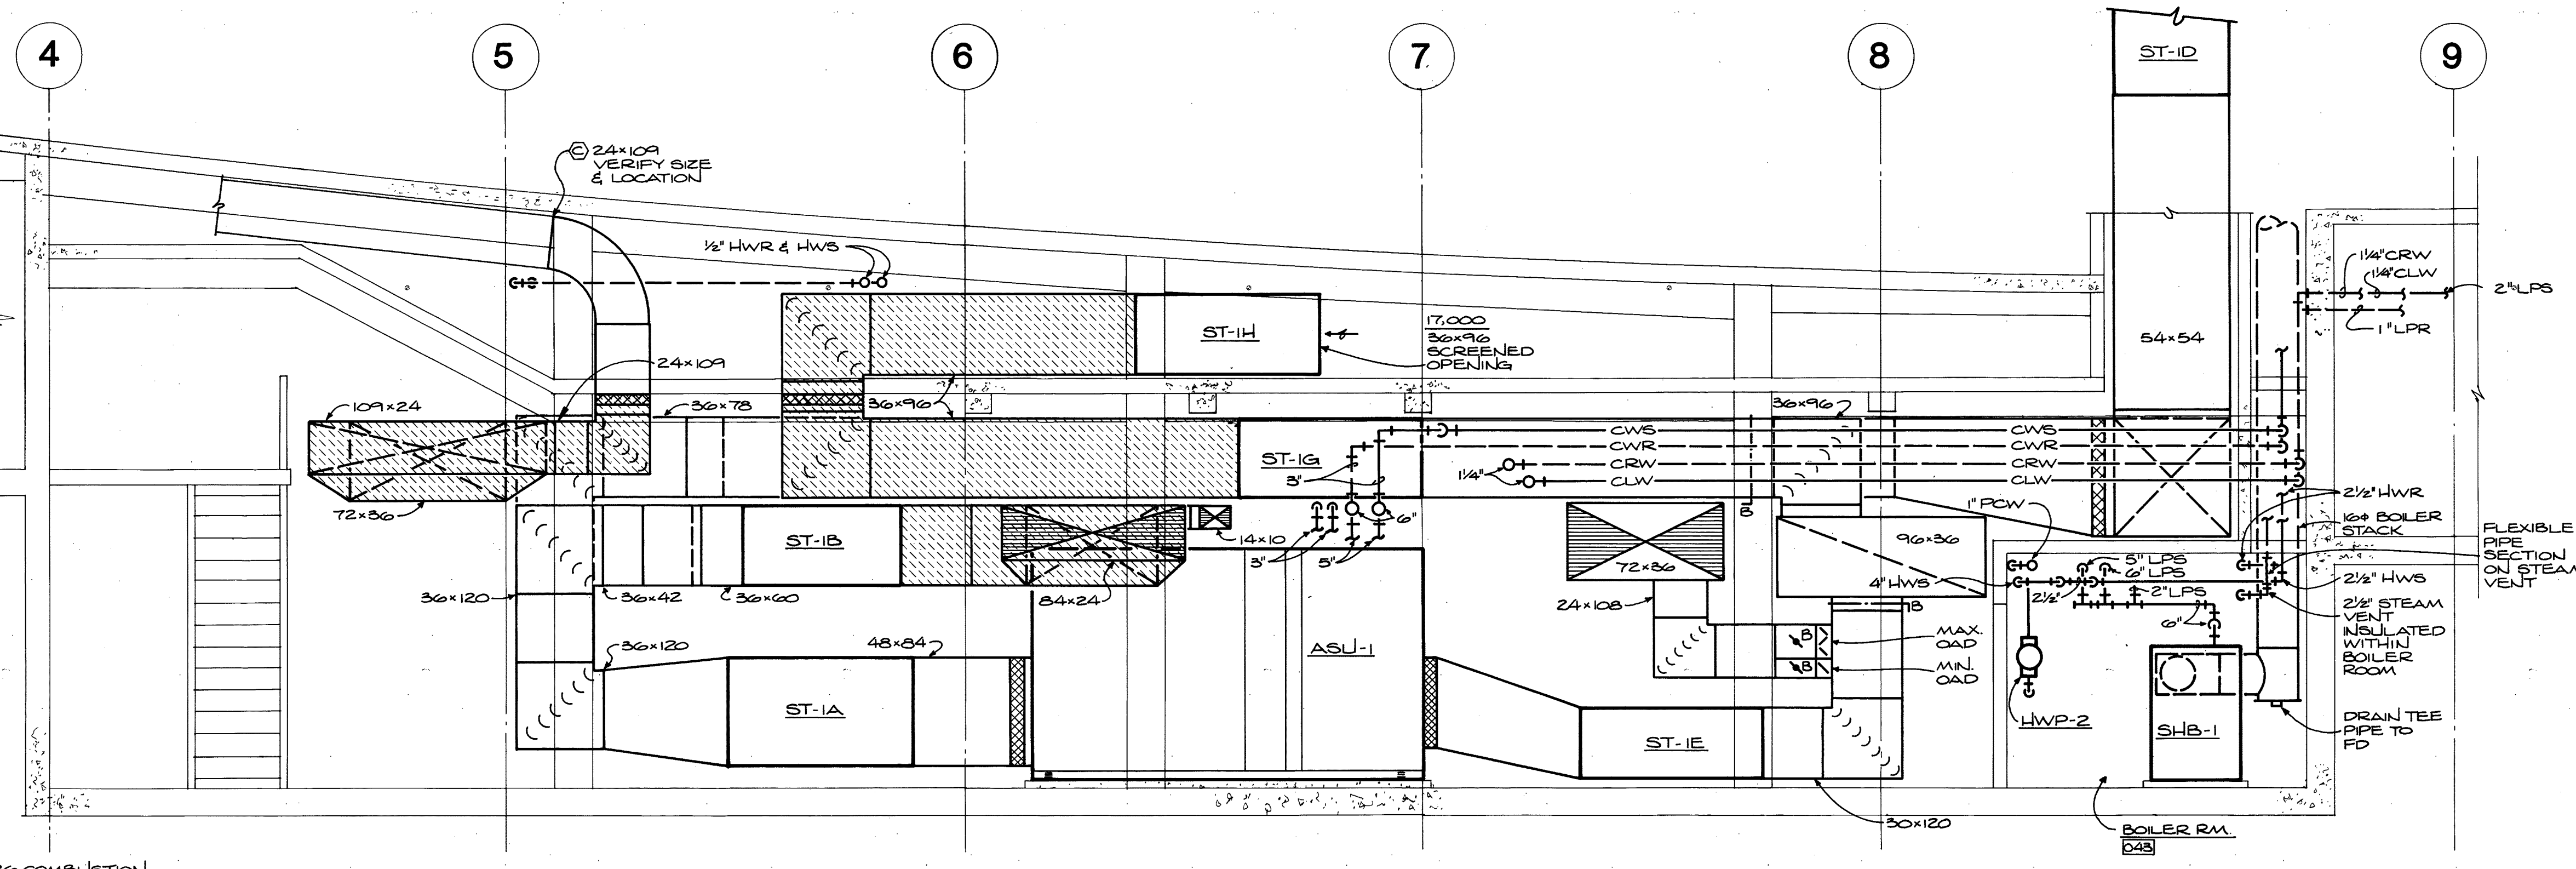

1 SECTION - BASEMENT FAN ROOM  
1/4"=1'-0"

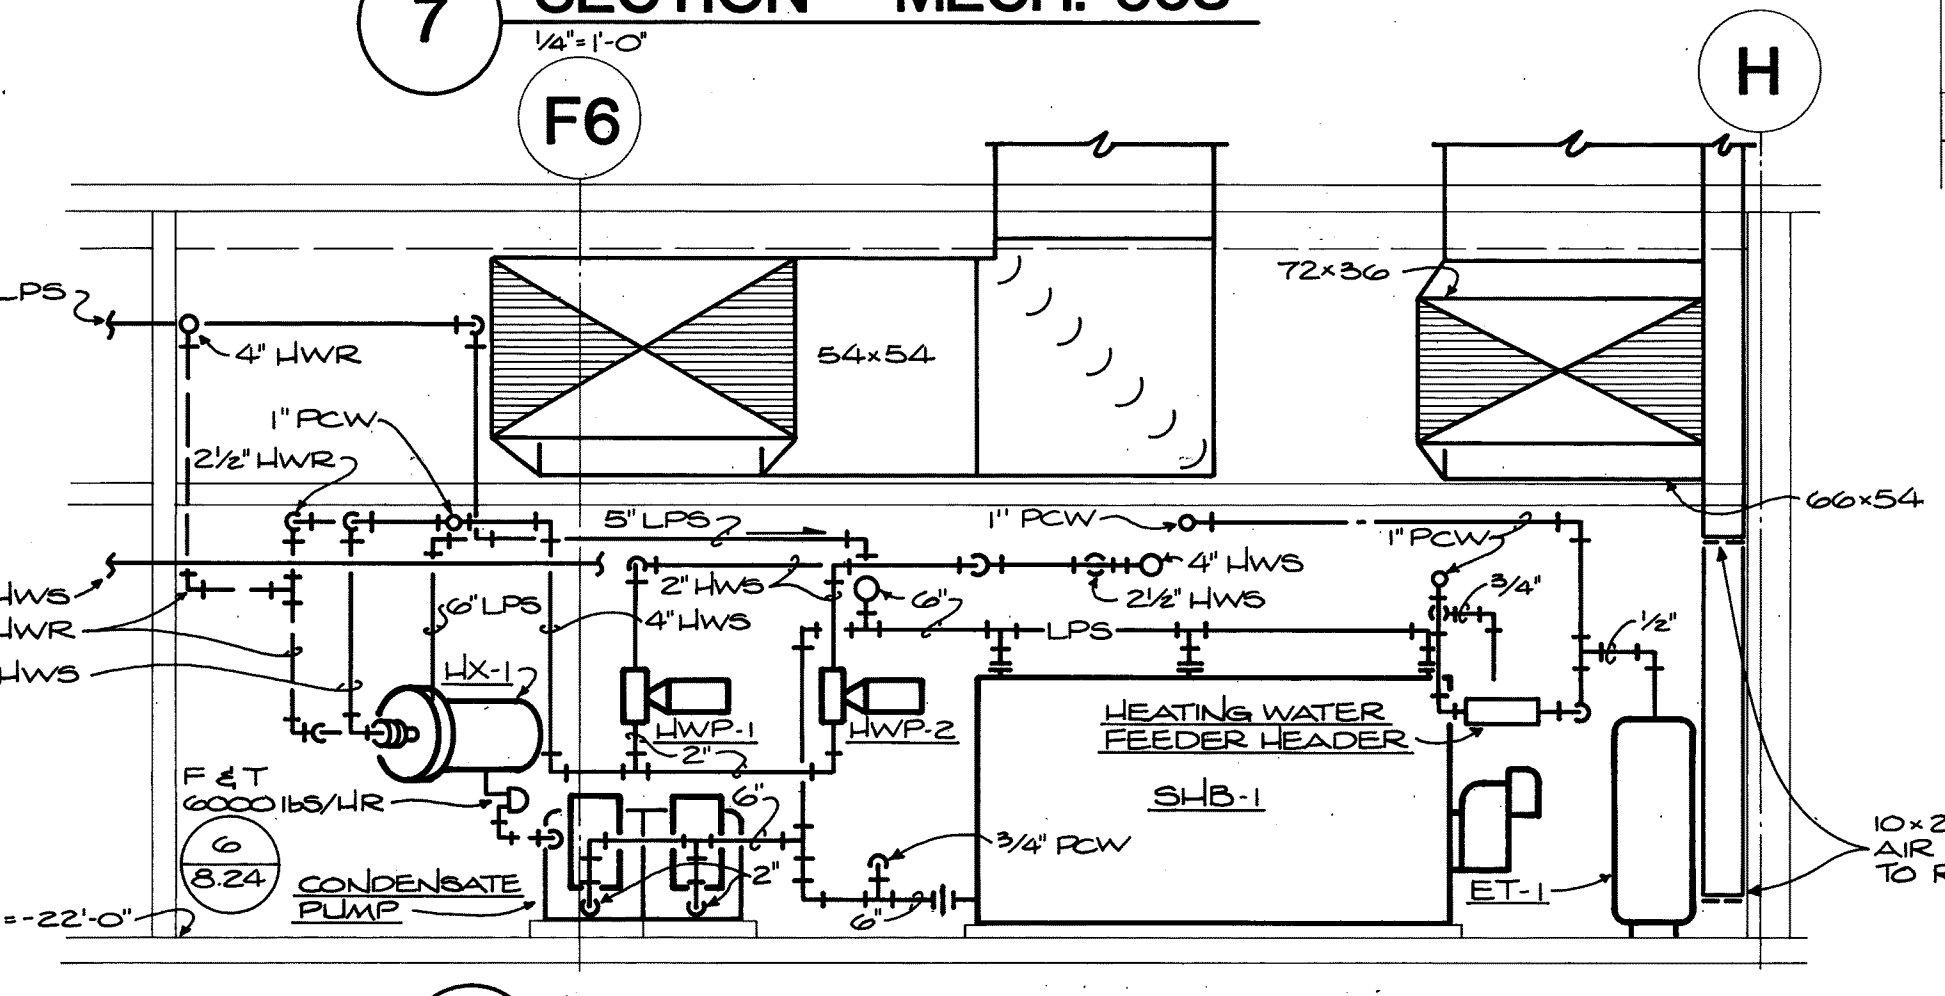

6 SECTION - BOILER ROOM  
1/4"=1'-0"

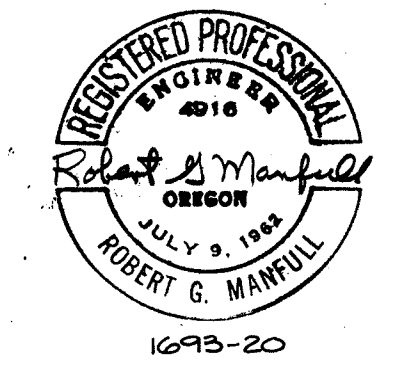

## MECHANICAL ROOM SECTIONS


Job No. \_\_\_\_\_ Date JULY 18, 1983  
Set No. \_\_\_\_\_ Sheet No. \_\_\_\_\_

8.21

# Portland Center for the Performing Arts


The City of Portland  
Honorable Mildred A. Schwab;  
Commissioner in Charge  
Ronald K. Ragen; Chairman  
Performing Arts Center  
Committee

Broome, Oringduh, O Toole, Rudolf & Associates, P.C.  
ELS Design Group  
Barton Myers  
Theatre Projects, Inc.  
R. Lawrence Kirkgaard & Associates  
Interface Engineering, Inc.  
C.W. Timmer & Associates  
CH2M Hill  
Project Address:  
733 N.W. 20th Avenue  
Portland, Oregon 97209  
(503) 226-1575

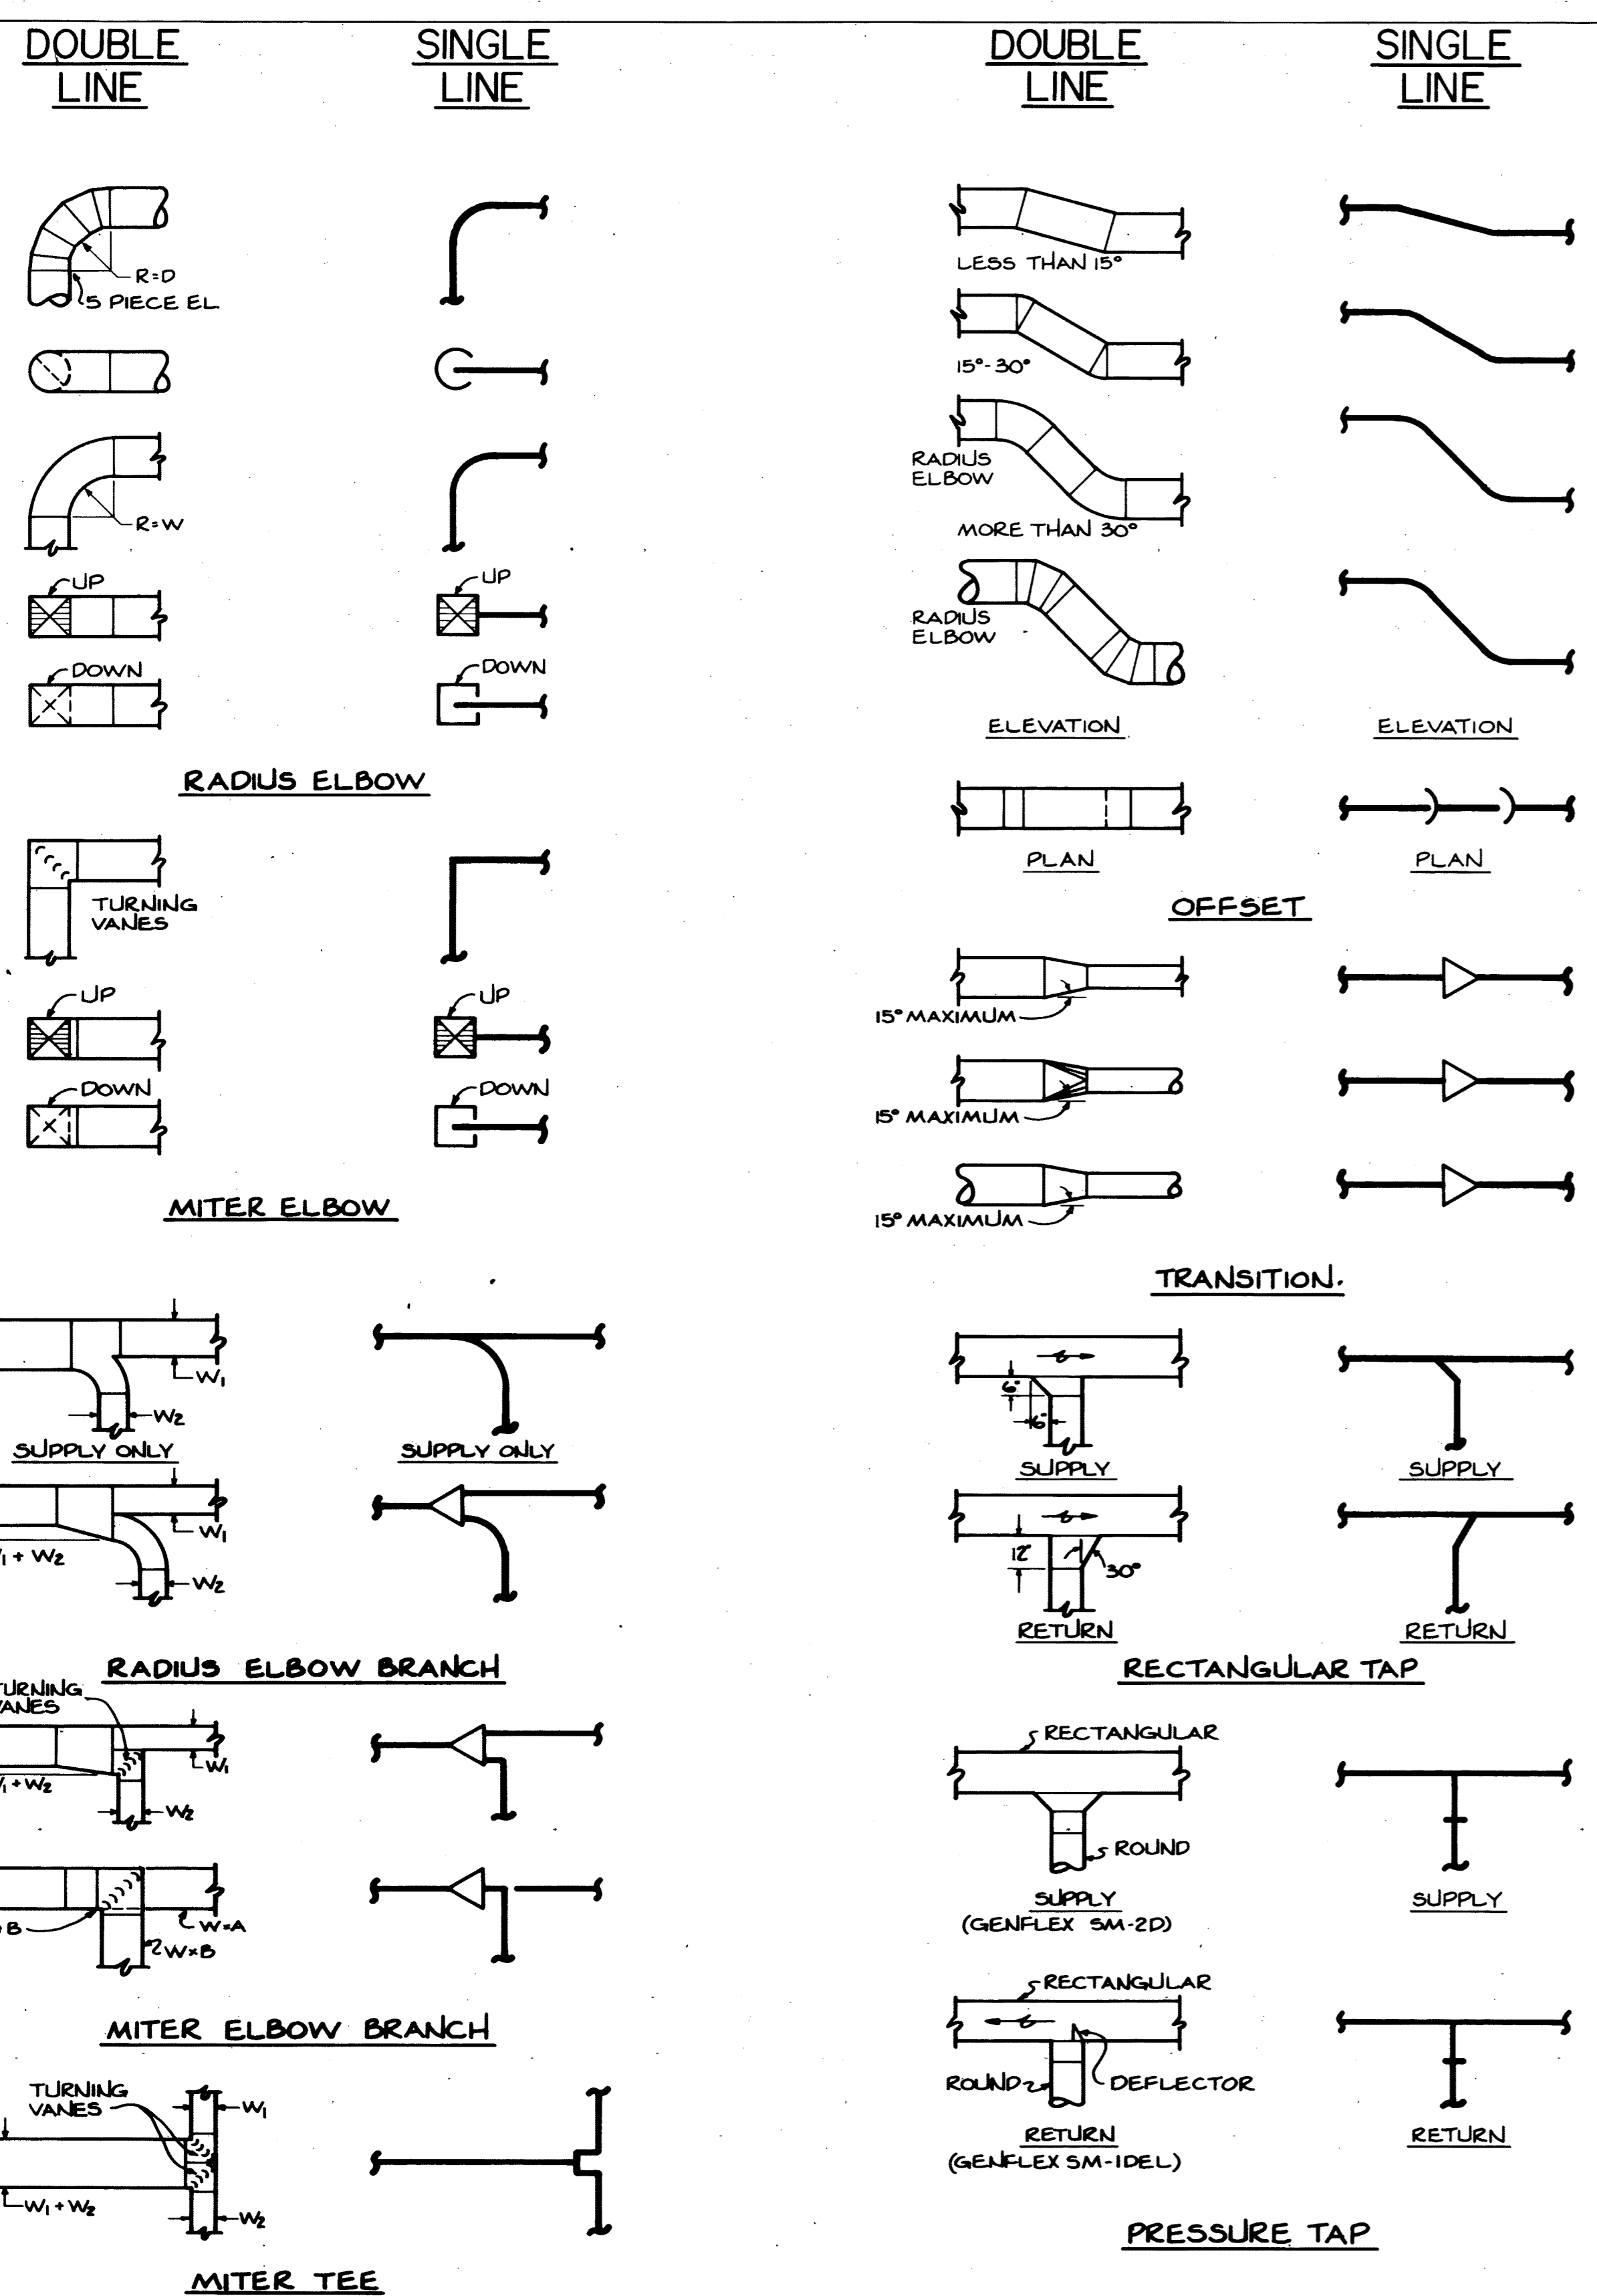


14 DETAILS - DUCT FITTINGS  
NO SCALE

- NOTES:  
1. ADJUSTING DAMPER REQUIRED FOR EACH LOW PRESSURE SUPPLY AND RETURN BRANCH  
2. 52x14 - FIRST DIMENSION IS THE SIDE SEEN IN SECTION THE SECOND DIMENSION IS THE HORIZONTAL SIDE

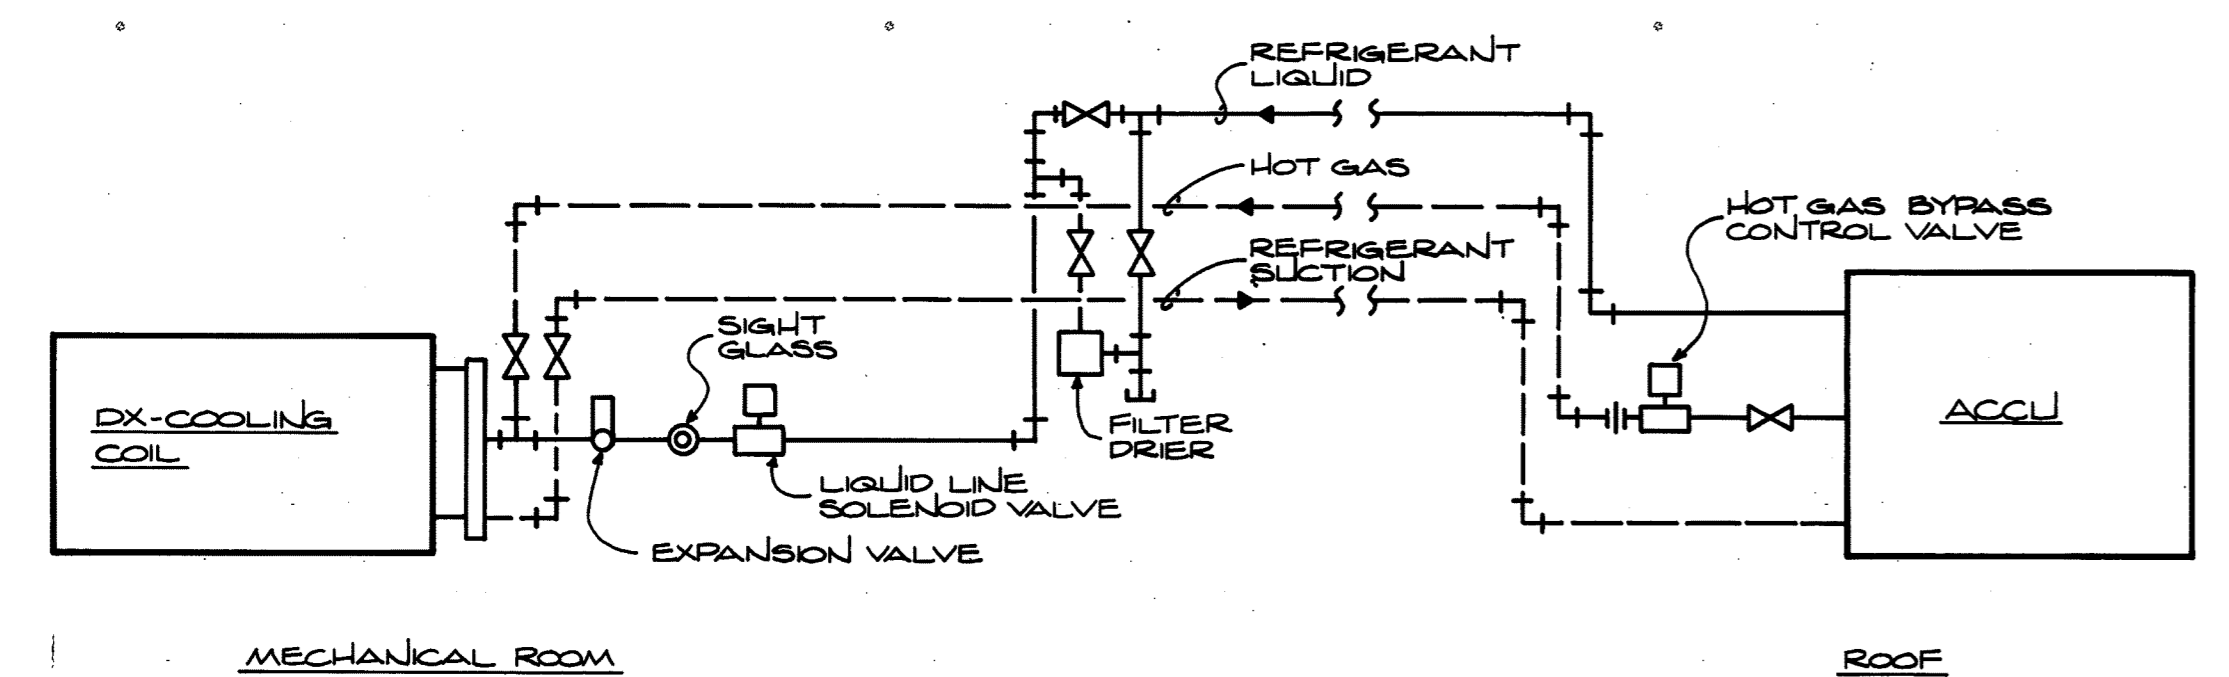


13 REFRIGERANT PIPING DIAGRAM  
NO SCALE


- NOTES:  
1. TRAP & PITCH PIPING AS REQUIRED FOR ACTUAL RELATIVE POSITIONS OF COMPRESSORS & COILS.  
2. PIPING SLEEVED & SEALED THROUGH ROOF OR WALL.  
3. ALL VALVES OF REFRIGERANT TYPE.  
4. ISOLATING VALVES AT ACCU ARE NOT SHOWN.

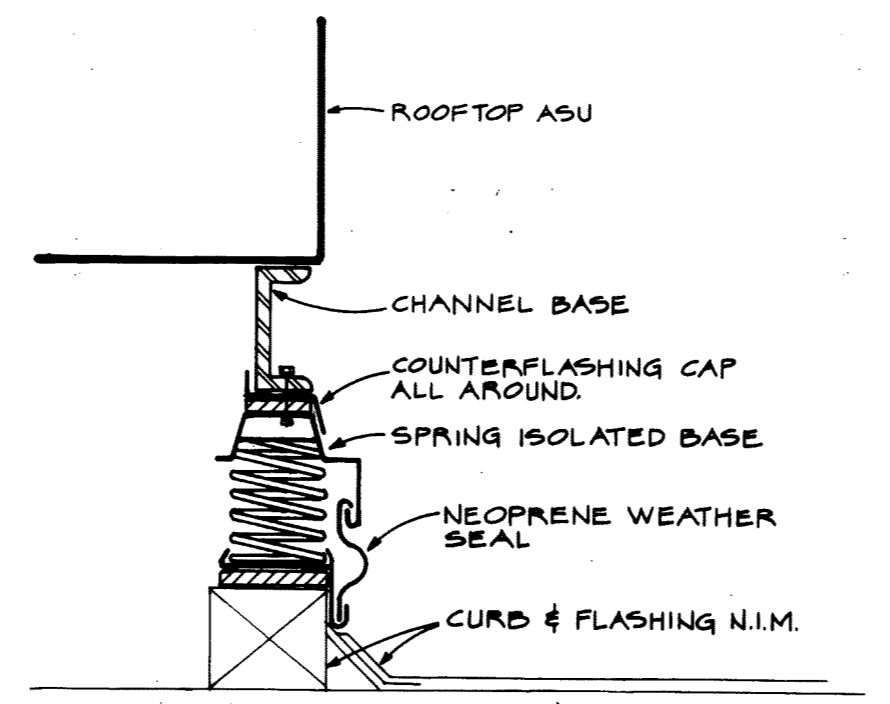



12 DETAIL - ROOFTOP ASU MOUNTING  
NO SCALE

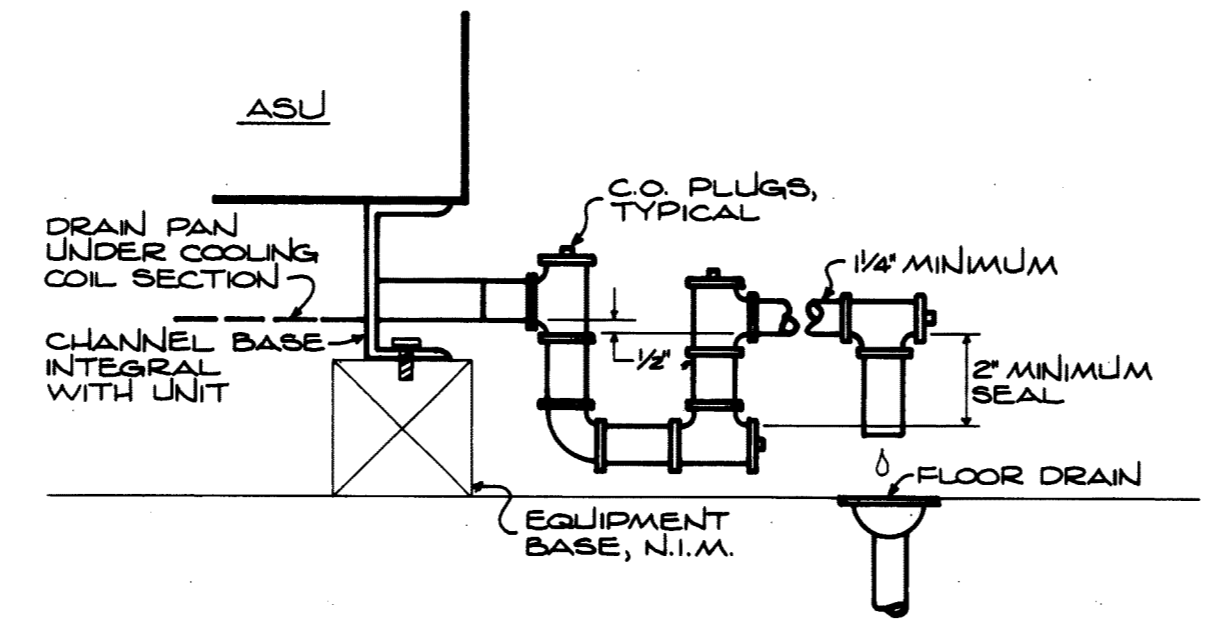


11 DETAIL - CONDENSATE TRAP  
NO SCALE

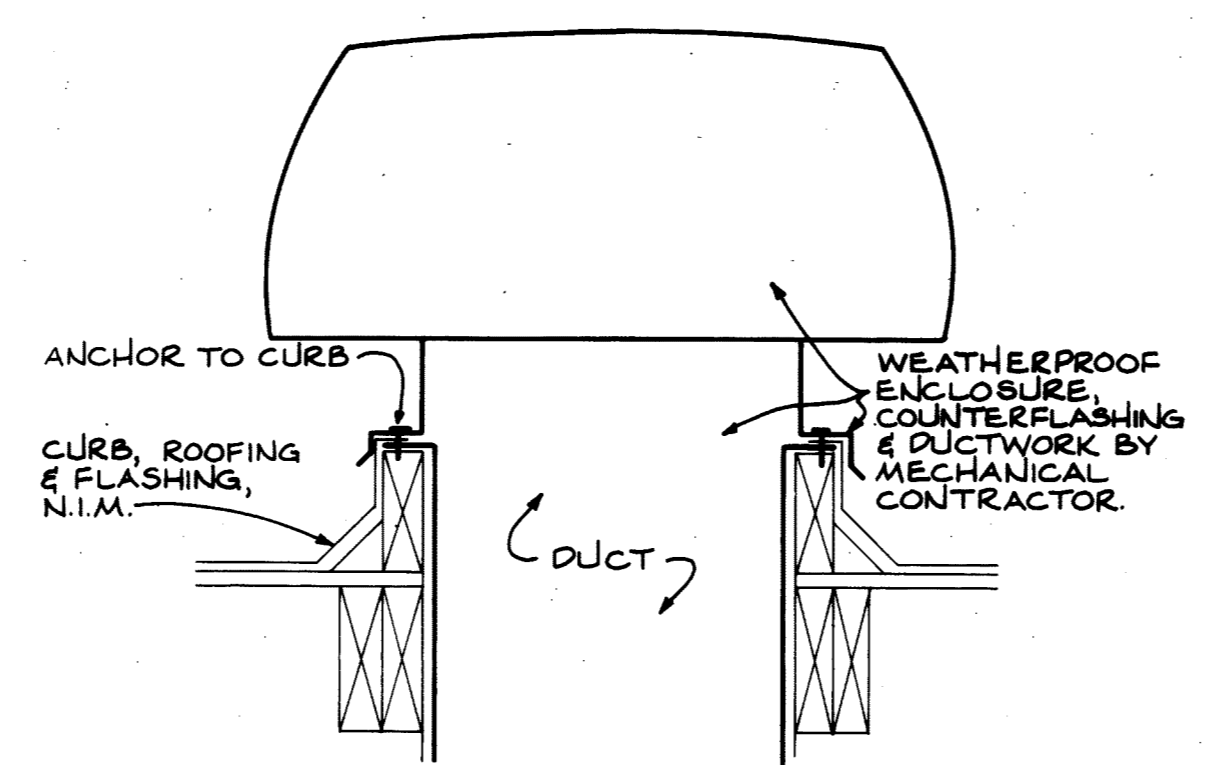


10 DETAIL - EF & RC ROOF PENETRATION  
NO SCALE

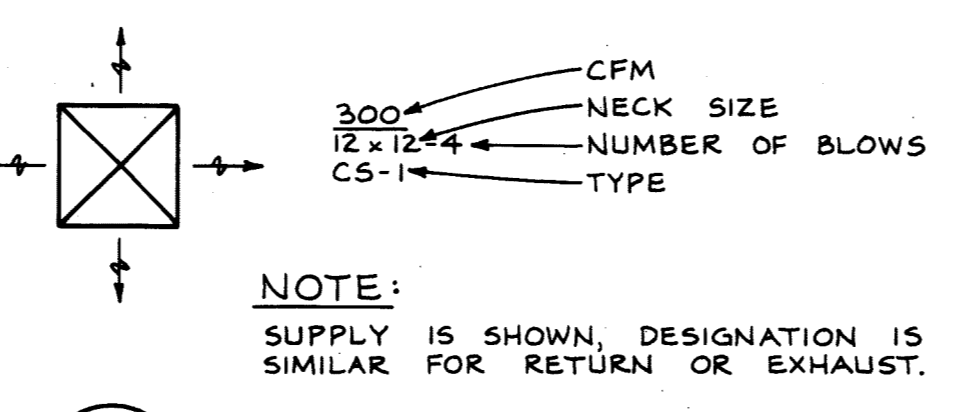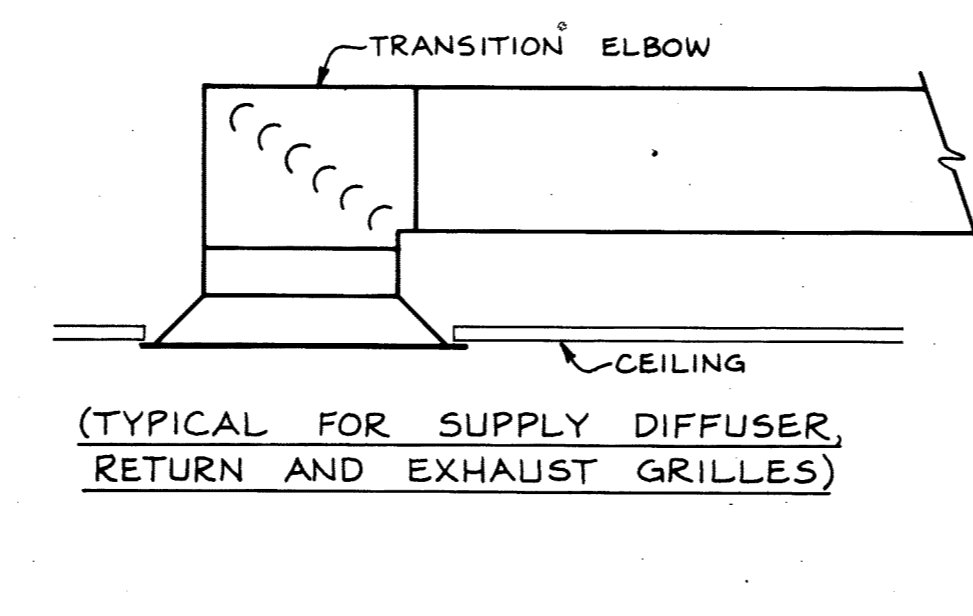


9 DETAIL - CEILING OUTLET  
NO SCALE

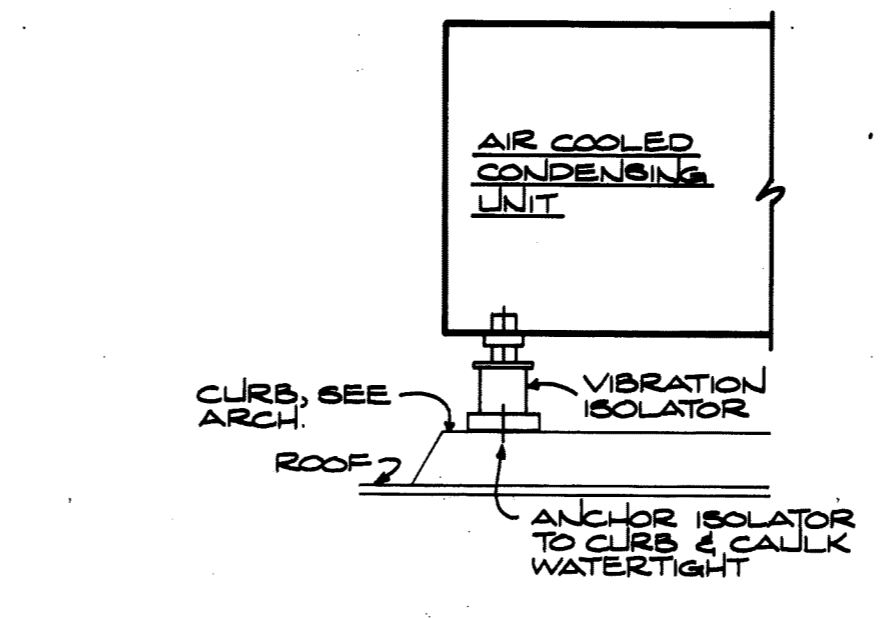


8 DETAIL - ACCU MOUNTING  
NO SCALE

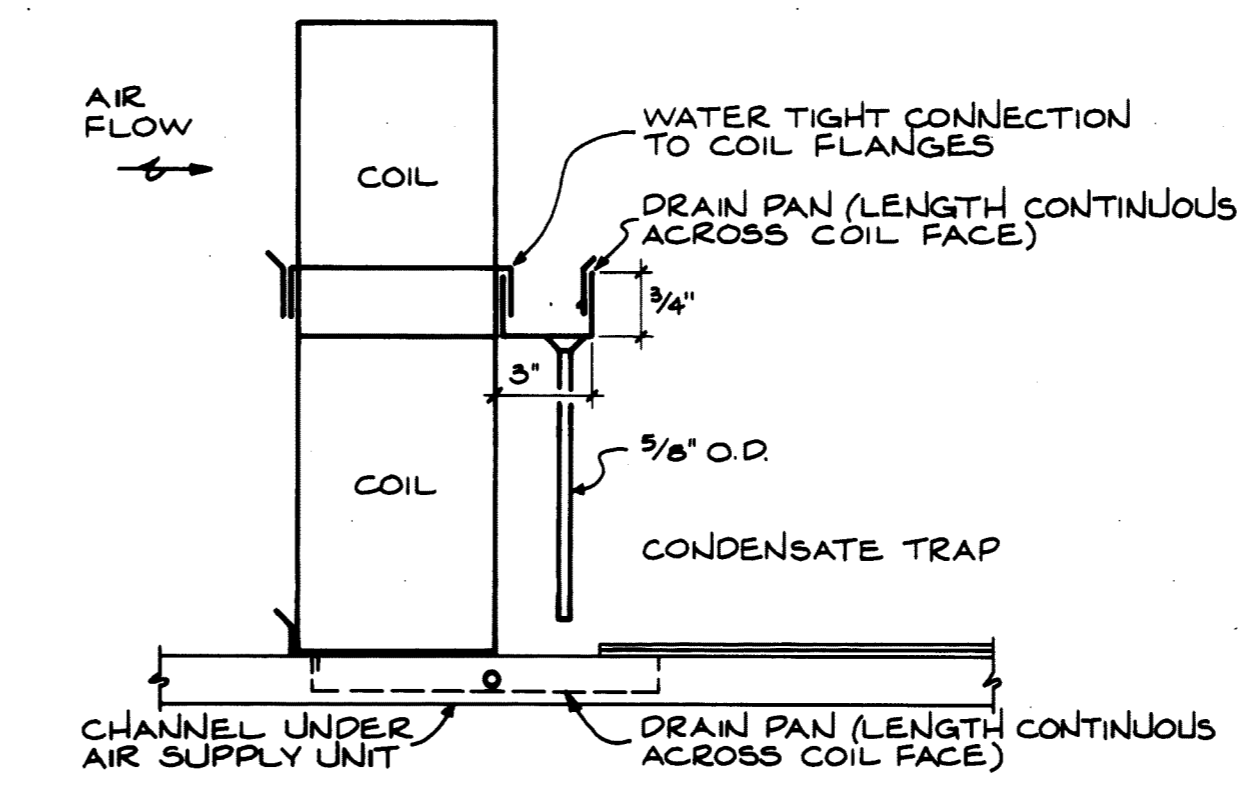


7 DETAIL - COOLING COIL DRAIN PAN  
NO SCALE

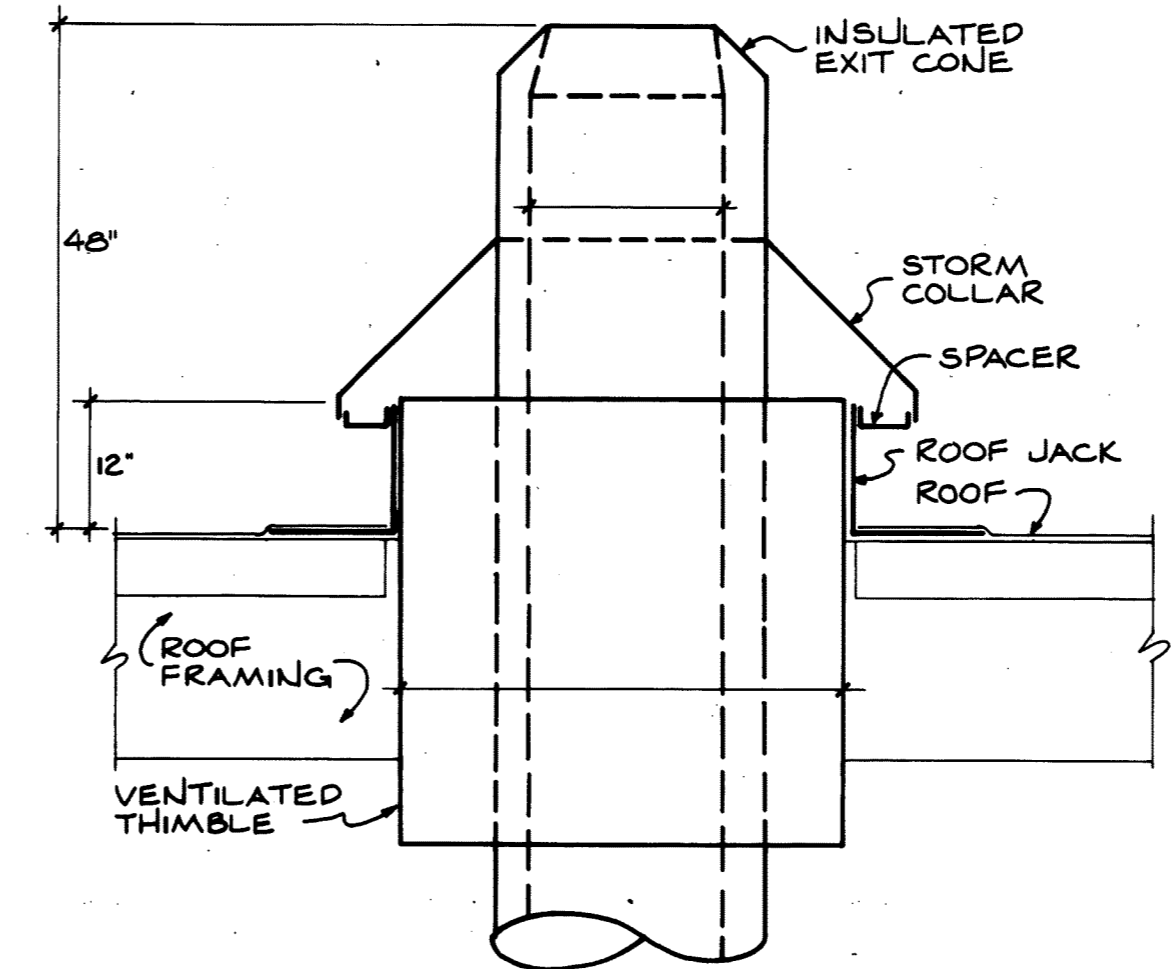


6 DETAIL - BOILER STACK ROOF PENETRATION  
NO SCALE

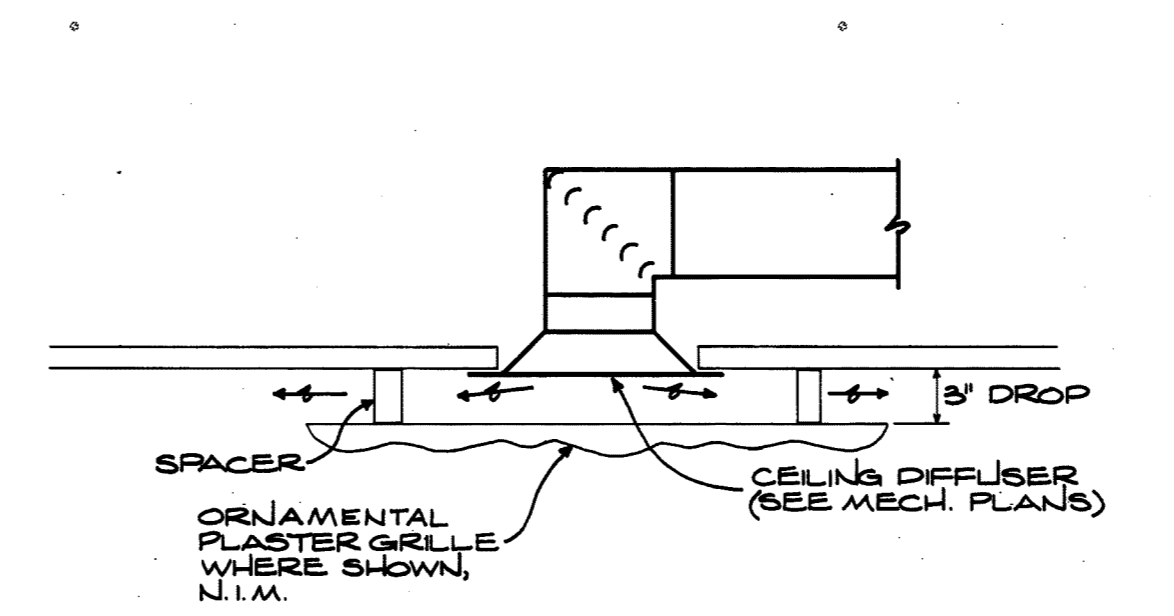


5 DETAIL - ORNAMENTAL CEILING GRILLE  
NO SCALE

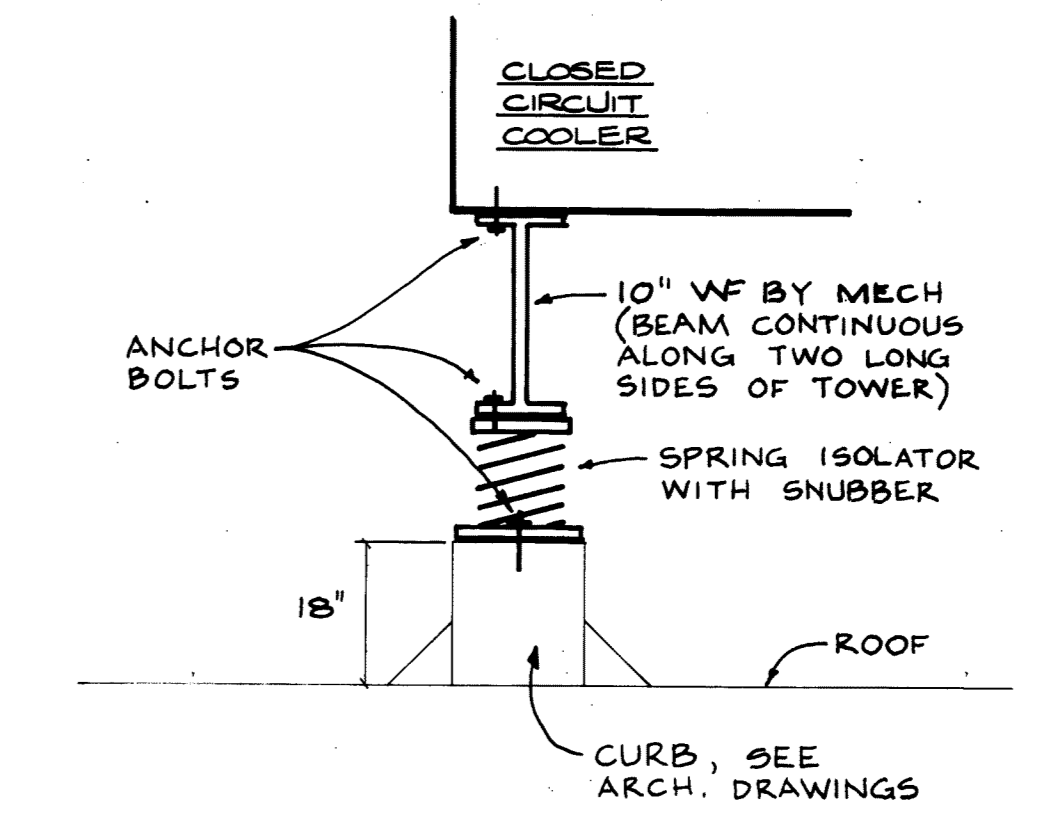


4 DETAIL - CCC SUPPORT  
NO SCALE

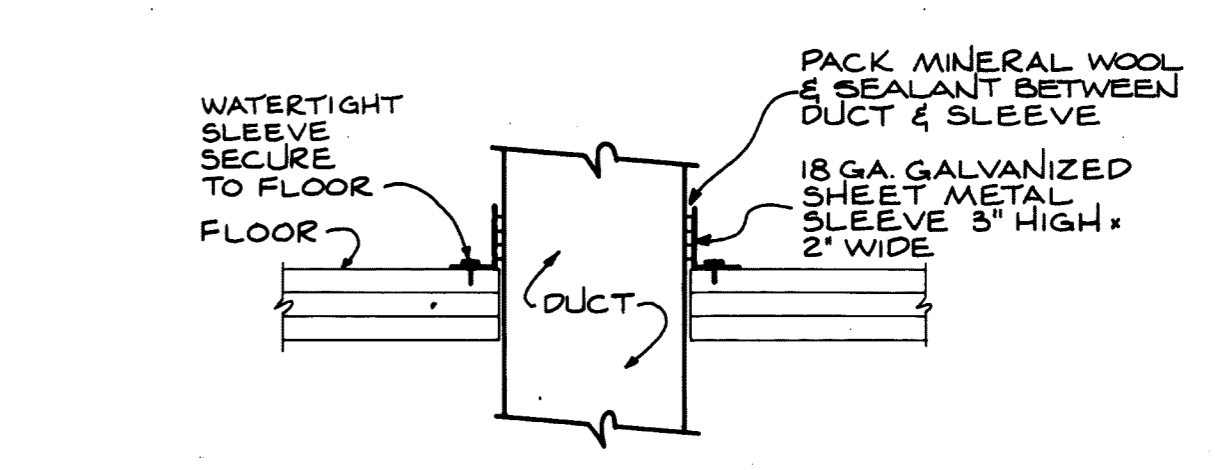

3 DETAIL - DUCT SLEEVE  
NO SCALE

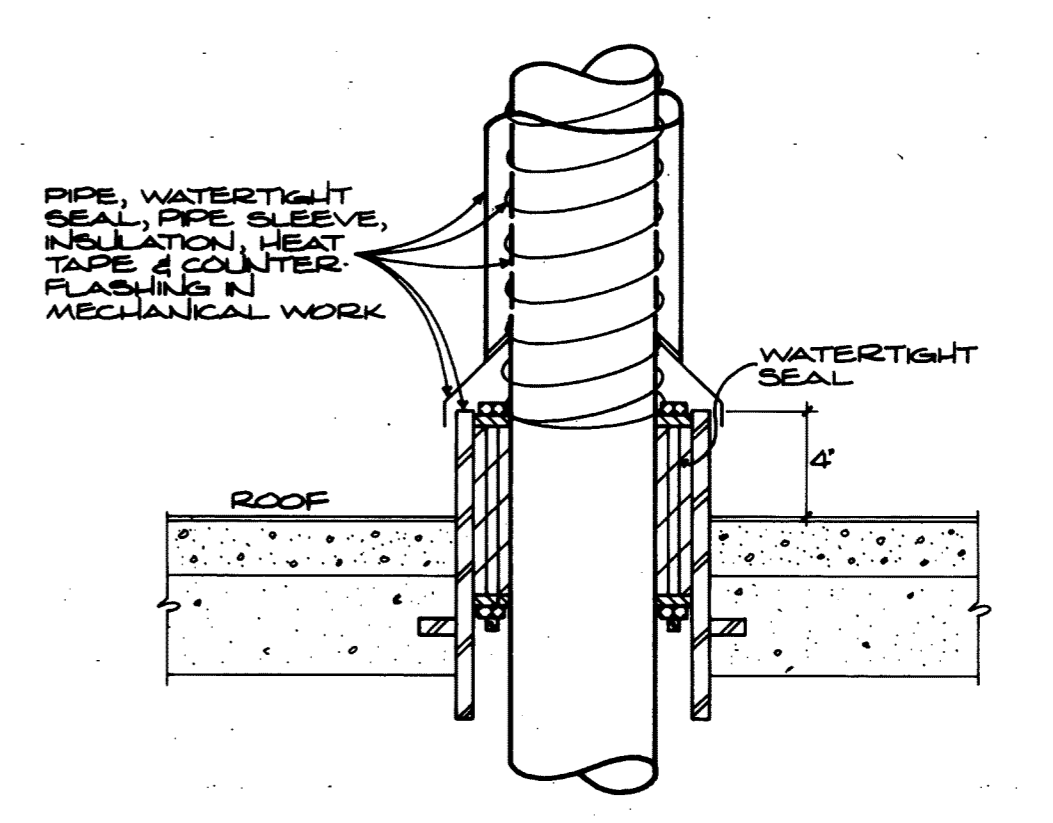

2 DETAIL - PIPE PENETRATION THROUGH ROOF  
NO SCALE

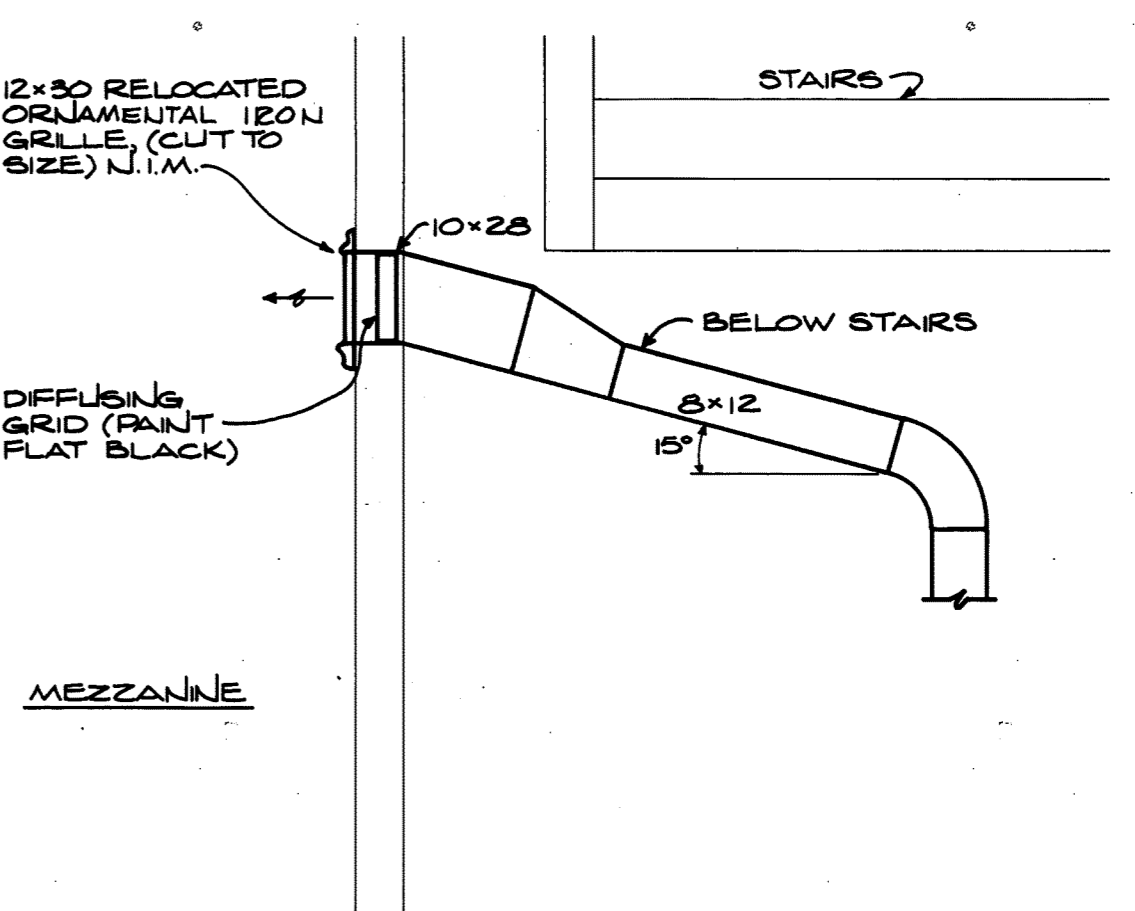

1 DETAIL - HS-3 AT MEZZ  
NO SCALE

## DETAILS - HVAC

Job No.	Date
Set No.	JULY 18, 1983
	Sheet No.
	8.22






**LEGEND**

**GENERAL NOTES**

1. THE CONTRACTOR SHALL RECORD ALL INVERT ELEVATIONS, PIPE SIZES, LOCATIONS, AND ANY OTHER DEVIATIONS FROM CONTRACT DRAWINGS, ON AS-BUILT DRAWINGS.
2. ALL END OF WASTE PIPING RUN LAVATORIES, SINKS, AND DRINKING FOUNTAINS SHALL HAVE A WALL CLEANOUT BELOW FIXTURE.
3. REFER TO ARCHITECTURAL DOCUMENTS FOR EXACT LOCATION AND HEIGHT OF ALL PLUMBING FIXTURES. COORDINATE WITH ALL OTHER TRADES.
4. PROVIDE & INSTALL SHUTOFF VALVES ON ALL BRANCH WATER PIPING SERVING FIXTURES AND/OR GROUPS OF FIXTURES OR EQUIPMENT. INSTALL IN LIFTOUT CEILING WHERE POSSIBLE. BEHIND CEILING OR WALL ACCESS PANELS WHERE LIFTOUT CEILING IS NOT AVAILABLE OR AS INDICATED ON THE DRAWINGS. COORDINATE WITH ARCHITECTURAL AND ALL OTHER TRADES.
5. BECAUSE OF THE SMALL SCALE OF THE DRAWINGS, IT IS NOT POSSIBLE TO INDICATE ALL OFFSETS, FITTINGS, VALVES, AND ACCESSORIES WHICH MAY BE REQUIRED. THE CONTRACTOR SHALL CAREFULLY INVESTIGATE THE CONDITIONS SURROUNDING THE INSTALLATION OF HIS WORK AND SHALL FURNISH THE NECESSARY FITTINGS, VALVES, TRAPS, ETC., WHICH MAY BE REQUIRED TO COMPLETE THE INSTALLATION IN A SATISFACTORY AND CODE APPROVED MANNER.
6. WHERE BRANCH PIPE SIZE IS NOT SHOWN ON DRAWINGS, REFER TO PLUMBING FIXTURE ROUGH-IN SCHEDULE FOR REQUIRED PIPE SIZE.
7. ALL FIRE SPRINKLER HEADS HAVE NOT BEEN SHOWN OR SCHEDULED. IT IS THE RESPONSIBILITY OF THE CONTRACTOR TO LOCATE AND INSTALL A COMPLETE FIRE SPRINKLER SYSTEM IN ALL PORTIONS OF THE BUILDING EXCEPT AS SPECIFICALLY NOTED.
8. SEE ARCHITECTURAL REFLECTED CEILING PLANS FOR EXACT LOCATIONS OF PIPE AND DUCTS IN EXPOSED AREAS WITHOUT CEILINGS; ALSO FOR EXACT LOCATIONS OF SPRINKLER HEADS.
9. FOR LOCATIONS OF EXPANSION JOINTS IN GENERAL CONSTRUCTION WORK, SEE ARCHITECTURAL DRAWINGS.
10. THE LOCATIONS OF THE PLUMBING, MECHANICAL, AND FIRE PROTECTION PIPING, EQUIPMENT, DUCTS, AND FIRE SPRINKLER HEADS IS TO BE STRICTLY CONTROLLED IN MANY AREAS. THE ARCHITECTURAL REFLECTED CEILING PLANS AND THE MECHANICAL DRAWINGS INDICATE THE LOCATION OF MANY OF THESE ITEMS AND ANY DEVIATION FROM THESE DRAWINGS MUST BE APPROVED BY THE ARCHITECT PRIOR TO INSTALLATION.

HWS	HWS	HEATING WATER SUPPLY
HWR	HWR	HEATING WATER RETURN
CWS	CWS	CHILLED WATER SUPPLY
CWR	CWR	CHILLED WATER RETURN
CLW	CLW	CONDENSER LEAVING WATER
CRW	CRW	CONDENSER RETURN WATER
RRV	RRV	REFRIGERANT RELIEF VENT
RL	RL	REFRIGERANT LIQUID
RS	RS	REFRIGERANT SUCTION
RHG	RHG	REFRIGERANT HOT GAS
DOS	DOS	DIESEL OIL SUPPLY
DOR	DOR	DIESEL OIL RETURN
CD	CD	CONDENSATE DRAIN
W	W	SANITARY SOIL OR WASTE ABOVE FLOOR
W	W	SANITARY SOIL OR WASTE BELOW GRADE OR FLOOR
D	D	INDIRECT WASTE OR DRAIN ABOVE FLOOR
SD	SD	STORM DRAIN ABOVE FLOOR
SD	SD	STORM DRAIN BELOW GRADE OR FLOOR
V	V	VENT
CM	CM	COLD WATER
PCM	PCM	PROCESS COLD WATER
HW	HW	HOT WATER
HMTM	HMTM	HOT WATER TEMPERATURE MAINTAINED
F	F	FIRE PROTECTION (WET)
FS	FS	FIRE SPRINKLER PIPE (FROM FCS)
CSP	CSP	COMBINATION STANDPIPE
WSP	WSP	WET STANDPIPE
MG	MG	NATURAL GAS (MEDIUM PRESSURE - 2 PSI)
G	G	NATURAL GAS (LOW PRESSURE - 11" W.C.)
V(G)	V(G)	VENT (GAS)
A	A	COMPRESSED AIR
HT	HT	HEAT TAPE
TPL	TPL	TRAP PRIMER LINE
ARW	ARW	ACID RESISTING WASTE
ARV	ARV	ACID RESISTING VENT
IRW	IRW	IRRIGATION WATER

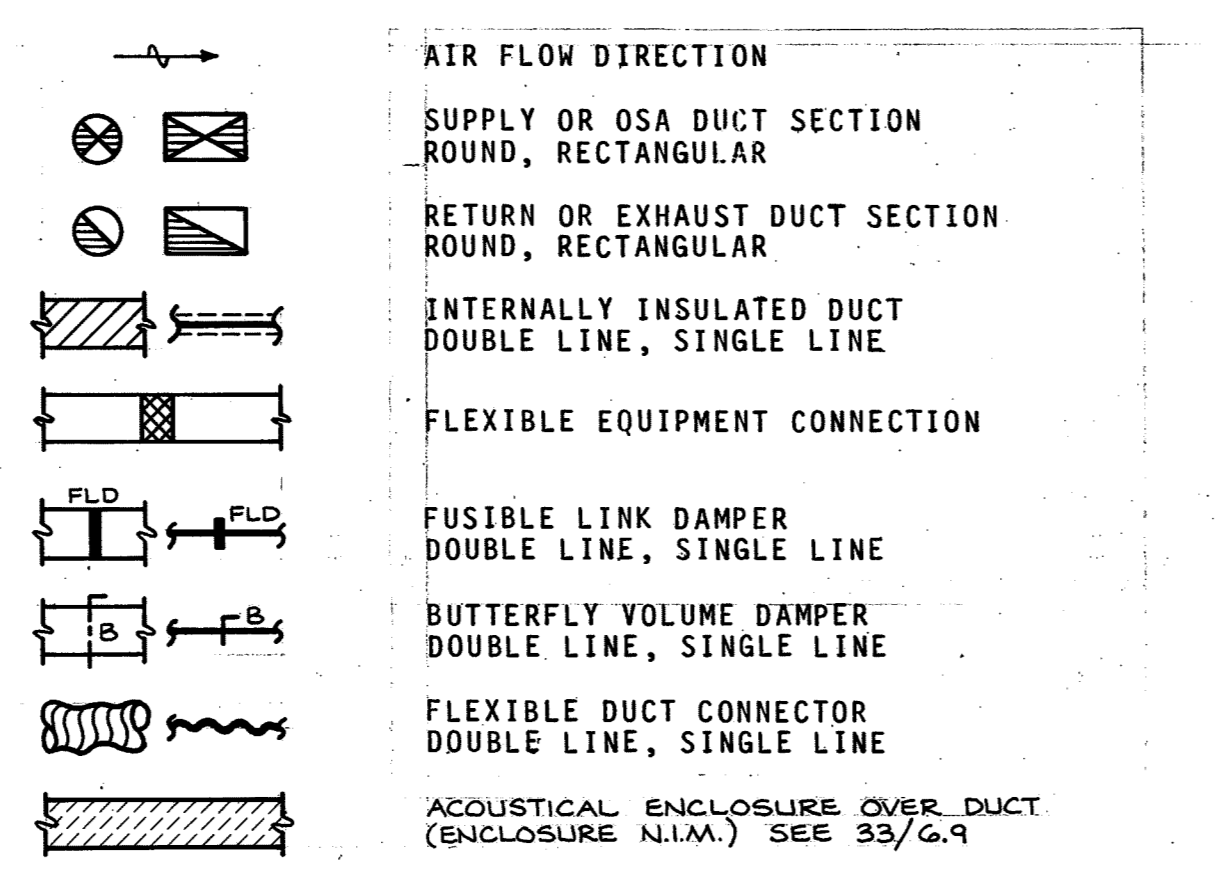

N.O.	NORMALLY OPEN
N.C.	NORMALLY CLOSED
D.A.	DIRECT ACTING
R.A.	REVERSE ACTING
P.E.	PNEUMATIC - ELECTRIC
SAV	SOLENOID AIR VALVE
NLL	NIGHT LOW LIMIT
(70)	MZU ZONE NUMBER
(A)	ACCESS DOOR
(C)	CONNECT
(E)	EXISTING
(F)	LOCATE BELOW FLOOR
(P)	CAP OR PLUG
(R)	REMOVE EXISTING
(T)	THROUGH TRUSS WEB

HWB	HEATING WATER BOILER
WCU	WATER CHILLER UNIT
HWP	HEATING WATER PUMP
CWP	CHILLED WATER PUMP
CDP	CONDENSER WATER PUMP
CT	COOLING TOWER
ACCU	AIR COOLED CONDENSING UNIT
ASU	AIR SUPPLY UNIT
MZU	MULTIZONE UNIT
SF	SUPPLY FAN
RF	RETURN FAN
EF	EXHAUST FAN
REF	ROOF EXHAUST FAN
CUH	CABINET UNIT HEATER
UH	UNIT HEATER
TU	TERMINAL UNIT
BHC	BOOSTER HEATING COIL
EHC	ELECTRIC HEATING COIL
HC	HEATING COIL
CC	COOLING COIL
OSA	OUTSIDE AIR
AUD	AUTOMATIC DAMPER
OAD	OUTSIDE AIR DAMPER
RAD	RETURN AIR DAMPER
EAD	EXHAUST AIR DAMPER
SMD	SMOKE DAMPER
SPS	STATIC PRESSURE SENSOR
Ø	ROUND DUCT DIAMETER, INCHES
32x14	RECTANGULAR DUCT SIZE, INCHES
CS	CEILING SUPPLY DIFFUSER
CR	CEILING RETURN GRILLE
CE	CEILING EXHAUST GRILLE
HS	HIGH SUPPLY GRILLE
HR	HIGH RETURN GRILLE
HE	HIGH EXHAUST GRILLE
LR	LOW RETURN GRILLE
LDS	LINEAR DUCT SUPPLY
LDR	LINEAR DUCT RETURN
DDCU	DIRECT DIGITAL CONTROL UNIT
FCP	FAN CONTROL PANEL
HCC	MOTOR CONTROL CENTER (SEE ELECT.)
Ⓢ	ROOM THERMOSTAT
TP	TRANSFER PUMP (DIESEL OIL)

DS&Y	OUTSIDE SCREW AND YOKE VALVE
GV	GATE VALVE
GLV	GLOBE VALVE
BV	BALL VALVE
GC	GAS COCK
CKV	CHECK VALVE
BWV	BACKWATER VALVE
BFV	BUTTERFLY VALVE
BAL	BALANCING FITTING
FCV	FLOW CONTROL VALVE
MV	TWO-WAY MOTORIZED VALVE
MV	THREE-WAY MOTORIZED VALVE
MV	MOTORIZED BUTTERFLY VALVE
PRV	PRESSURE REDUCING VALVE
RV	PRESSURE RELIEF VALVE
PTRV	PRESSURE TEMPERATURE RELIEF VALVE
CAO	COMPRESSED AIR OUTLET
WH	WALL HYDRANT
DV	HOSE END DRAIN VALVE
HB	HOSE BIBB
AV	AIR VENT
WHA	WATER HAMMER ARRESTOR
TPV	TRAP PRIMER VALVE
STR	STRAINER WITH HOSE END DRAIN VALVE
U	UNION, FLANGE
R	PIPE REDUCER
U	SPRINKLER HEAD - UPRIGHT/PENDENT & SIDEWALL
D	SPRINKLER HEAD - DRY PENDENT, 45° DRY PENDENT
G	PRESSURE GAGE WITH GAGE COCK
G	GAGE COCK
T	THERMOMETER
FS	FLOW SWITCH
IT	IMMERSION THERMOSTAT
P	PITCHED DOWN
PTT	PRESSURE TEMPERATURE TAP
D	DIRECTION OF FLOW
V	VALVE IN RISER
C	CAP OR PLUG
CTG	CLEANOUT TO GRADE
FCO	FLOOR CLEANOUT
WCO	WALL CLEANOUT
CO	CLEANOUT PLUG
TS	TAMPER SWITCH
S	SQUARE FEET

WC	WATER CLOSET
U	URINAL
L	LAVATORY
S	SINK
SS	SERVICE SINK
MS	MOP SINK
SHR	SHOWER
DF	DRINKING FOUNTAIN
EW	ELECTRIC WATER HEATER
RPBP	REDUCED PRESSURE BACKFLOW PREVENTER
DCA	DOUBLE CHECK VALVE ASSEMBLY
DDCVA	DOUBLE DETECTOR CHECK VALVE ASSEMBLY
FHC	FIRE HOSE CABINET
FCS	FLOOR CONTROL STATION
FDC	FIRE DEPARTMENT CONNECTION
FH	FIRE HYDRANT
FHV	FIRE HOSE VALVE
HDR	HEADER
CB	CATCH BASIN
AD	AREA DRAIN
FS	FLOOR SINK
FD	FLOOR DRAIN
SHD	SHOWER DRAIN
DS	DOWNSPOUT
RD	ROOF DRAIN
ORD	OVERFLOW ROOF DRAIN
VTR	VENT THROUGH ROOF
MH	MANHOLE
CIP	CAST IRON PIPE
CSP	CONCRETE SEWER PIPE
CONC	CONCRETE
TC	TOP OF CURB
I.E.	INVERT ELEVATION
EL	ELEVATION
R1&C	ROUGH-IN AND CONNECT
NIM	NOT IN MECHANICAL SPECIFIED UNDER ANOTHER DIVISION
SOV	SHUT-OFF VALVE (GATE UNLESS OTHERWISE NOTED)
ASR	AUTOMATIC SPRINKLER RISER
ASD	AUTOMATIC SPRINKLER DRAIN
AGD	AIR GAP DRAIN

**Portland Center for the Performing Arts**

**The City of Portland**

Honorable Mildred A. Schwab  
Commissioner in Charge  
Ronald K. Ragen  
Chairman  
Performing Arts Center Committee

Architects  
Broome, Oringdolph, O'Toole, Rudolf & Associates pc  
ELS Design Group  
Barton Myers

Project Address  
733 N.W. 20th Avenue  
Portland, Oregon 97209  
(503) 226-1575

Consultants  
Theatre Projects Inc.  
Theatre Consultants  
R. Lawrence Kirkegaard & Associates  
Acoustician  
CH2M Hill  
Structural Engineers  
C.W. Timmer Associates  
Mechanical Engineers  
Interface Engineering Inc.  
Electrical Engineers



Target	Revision Item	Revision Date
△	Addendum #1	10/29/84
△	Addendum #2	11/06/84
△	Addendum #3	11/13/84
△	Addendum #5	11/21/84
△	Proposal Request #1	03/01/85
△	Proposal Request #2	03/01/85
△	Proposal Request #3	03/01/85
△	Proposal Request #4	03/01/85
△	Proposal Request #5	03/08/85
△	Proposal Request #6	03/01/85
△	Proposal Request #7	03/01/85
△	Proposal Request #8	03/01/85
△	Proposal Request #9	03/01/85
△	Proposal Request #10	03/01/85
△	Proposal Request #11	03/01/85
△	Proposal Request #12	03/01/85
△	Proposal Request #13	03/01/85
△	Proposal Request #14	03/01/85
△	Clarification Items	03/01/85
△	Miscellaneous Items	03/01/85

Revisions

**New Theatre Building**

**LEGEND & NOTES MECHANICAL**

Date OCT. 12, 1984  
Scale NONE  
Drawing No. 8.0

C.W. Timmer Associates Inc.  
Consulting Engineers  
1644 - 20

# Portland Center for the Performing Arts

The City of Portland

Honorable Mildred A. Schwab  
Commissioner in Charge  
Ronald K. Ragen  
Chairman  
Performing Arts Center Committee

**Architects**  
Brooms, Oringdolph, O'Toole, Rudolf & Associates pc  
ELS Design Group  
Barton Myers  
Project Address  
733 N.W. 20th Avenue  
Portland, Oregon 97209  
(503) 226-1575

**Consultants**  
Theatre Projects Inc.  
Theatre Consultants  
R. Lawrence Kirkegaard & Associates  
Acoustician  
CH2M Hill  
Structural Engineers  
C. W. Timmer Associates  
Mechanical Engineers  
Interface Engineering Inc.  
Electrical Engineers



Target	Revision Item	Revision Date
▲	Addendum #1	10/23/84
▲	Addendum #2	11/06/84
▲	Addendum #4	11/13/84
▲	Addendum #5	11/21/84
▲	Proposal Request #1	03/01/85
▲	Proposal Request #2	03/01/85
▲	Proposal Request #3	03/01/85
▲	Proposal Request #4	03/01/85
▲	Proposal Request #5	03/06/85
▲	Proposal Request #6	03/01/85
▲	Proposal Request #7	03/01/85
▲	Proposal Request #8	03/01/85
▲	Proposal Request #9	03/01/85
▲	Proposal Request #10	03/01/85
▲	Proposal Request #11	03/01/85
▲	Proposal Request #12	03/01/85
▲	Proposal Request #13	03/01/85
▲	Proposal Request #14	03/01/85
▲	Clarification Items	03/01/85
▲	Miscellaneous Items	03/01/85

Revisions

New Theatre Building


PLAN LEVEL 79'-0"  
HVAC

Date OCT 12 1984  
Scale 1/8" = 1'-0"  
Drawing No. 8.10

C. W. Timmer Associates Inc.  
Consulting Engineers  
1644 - 20

## 8 PARTIAL PLAN - LEVEL 71'-6"

1/8" = 1'-0"

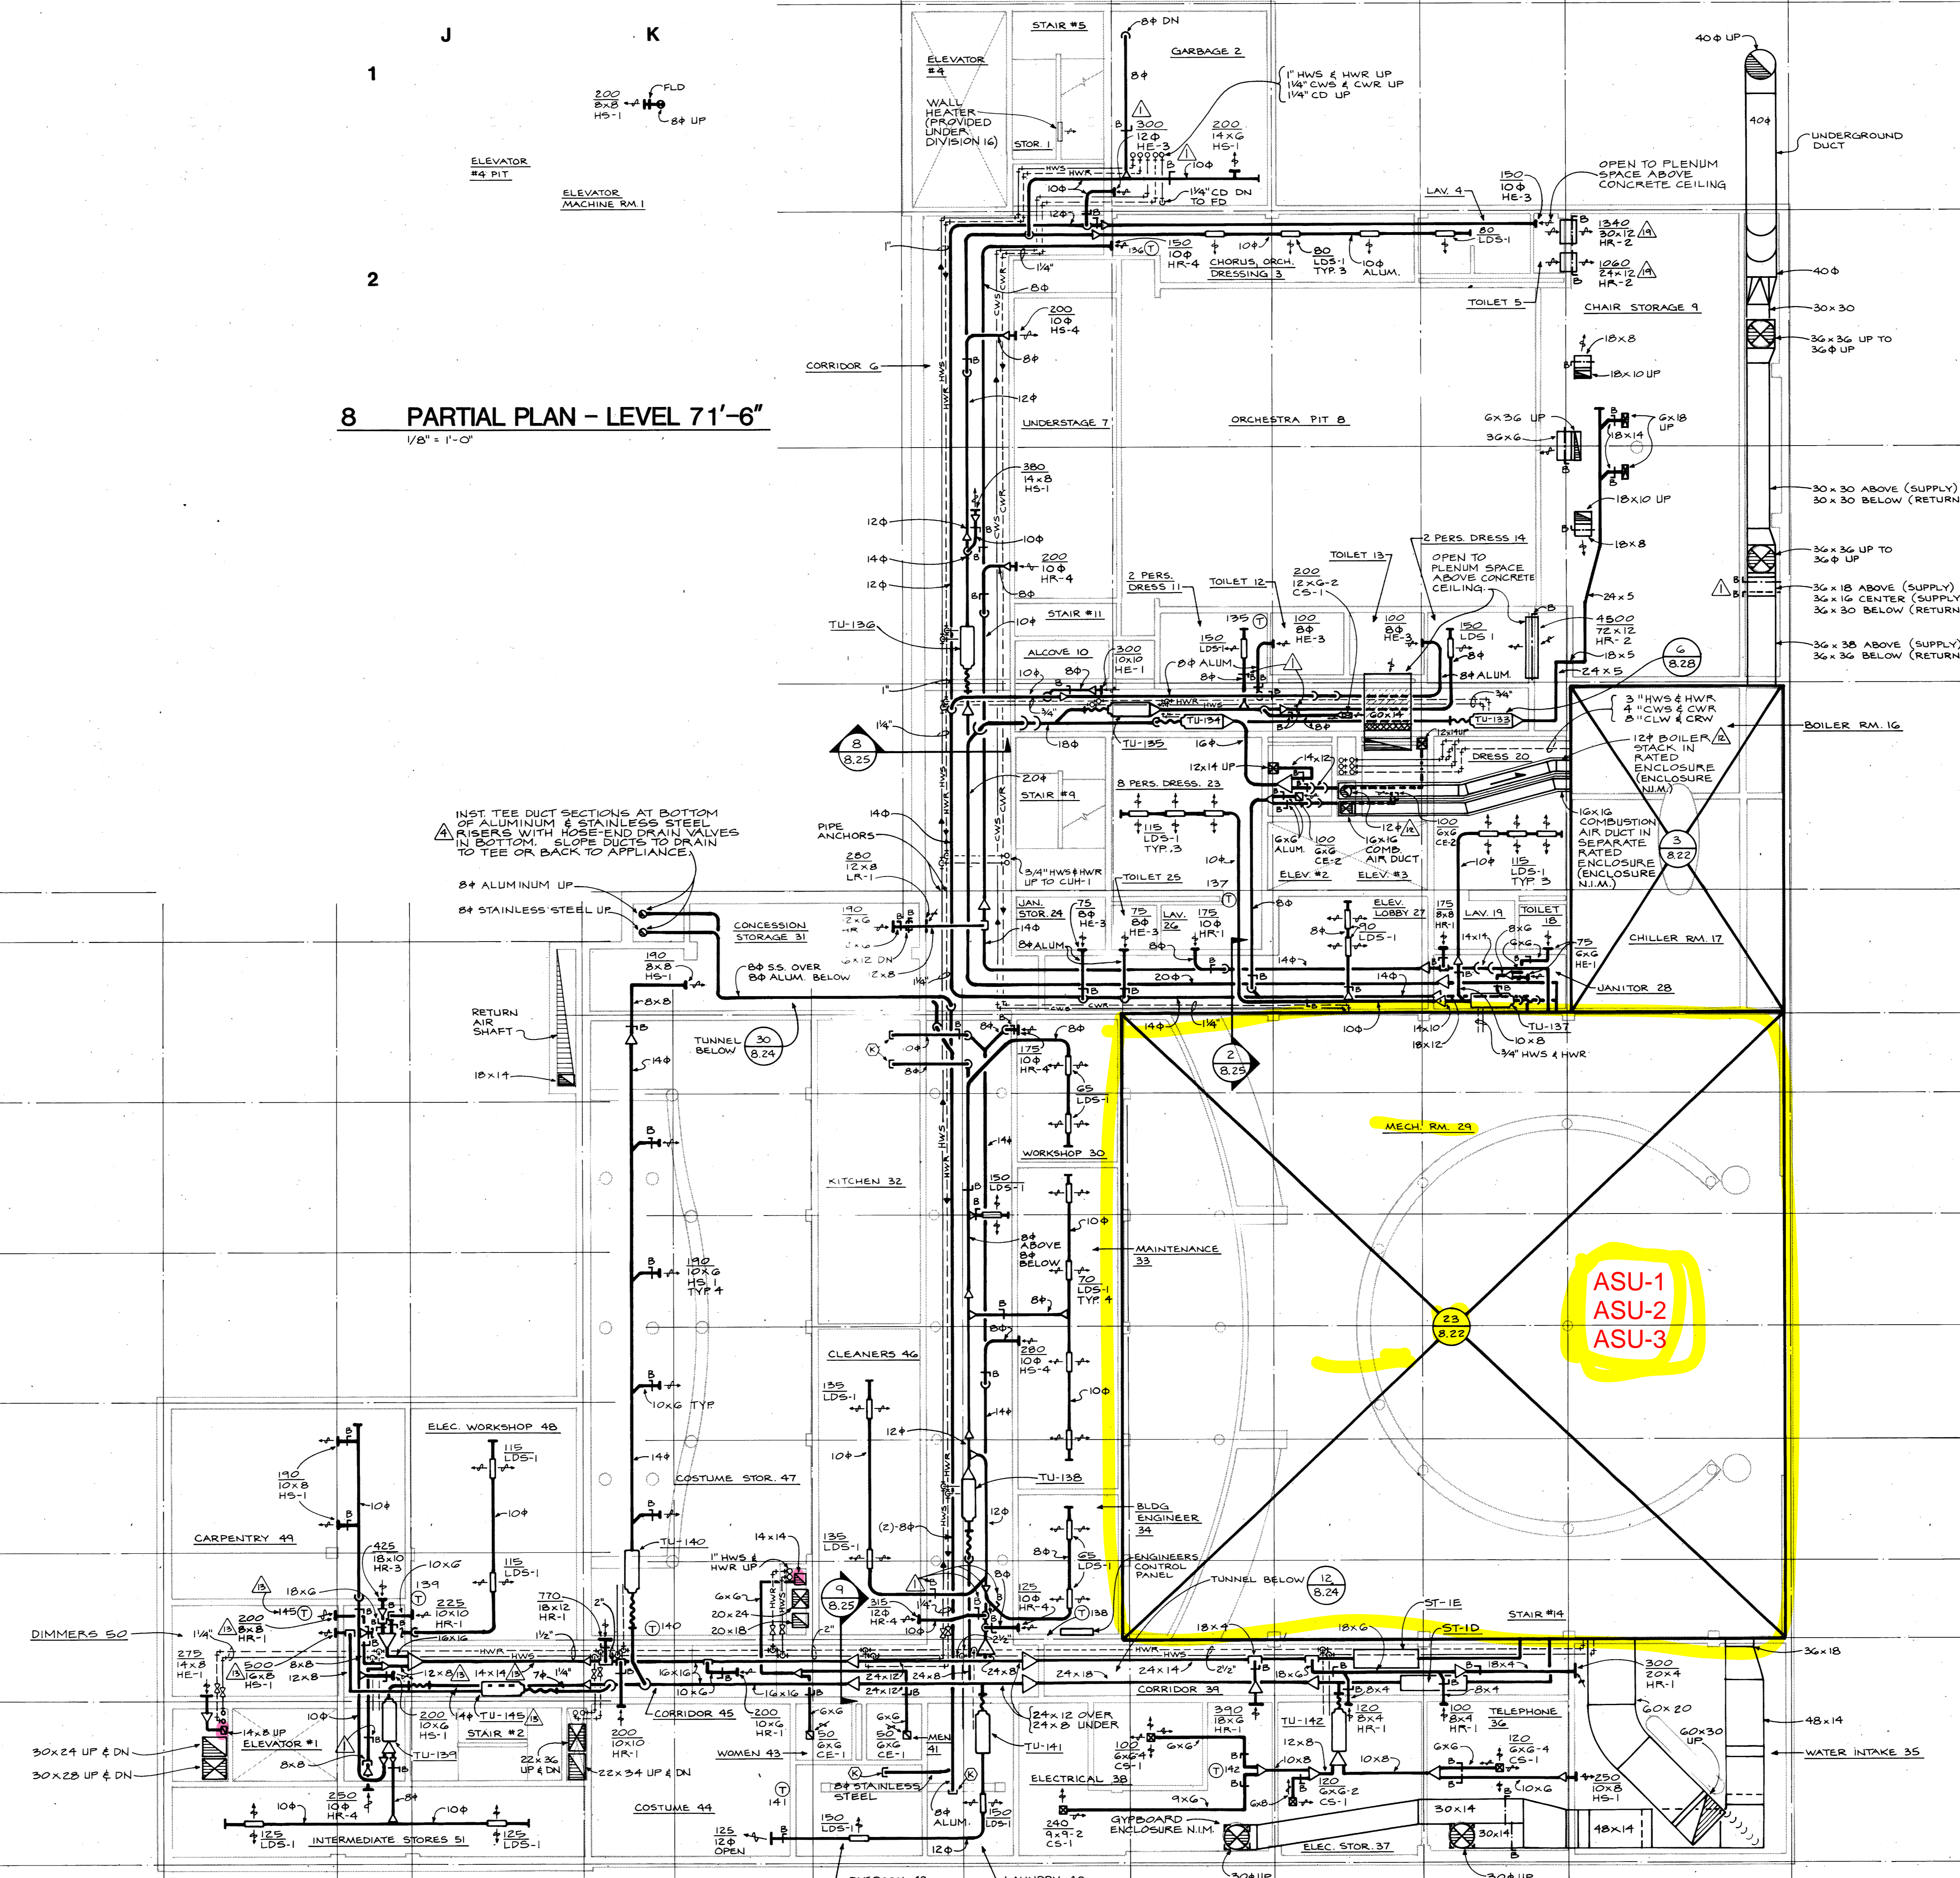

SCREEN VALUE	10	120	810
COMPOSITE INSTRUCTIONS	10	57	210
BASE/OVERLAY NO.			

# Portland Center for the Performing Arts

The City of Portland

Honorable Mildred A. Schwab  
Commissioner in Charge  
Ronald K. Ragen  
Chairman  
Performing Arts Center Committee

Architects  
Broome, Oringdolph, O'Toole, Rudolf & Associates pc  
ELS Design Group  
Barton Myers  
Project Address  
733 N.W. 20th Avenue  
Portland, Oregon 97209  
(503) 226-1575

Consultants  
Theatre Projects Inc.  
Theatre Consultants  
R. Lawrence Kirkegaard & Associates  
Acoustician  
CH2M Hill  
Structural Engineers  
C.W. Timmer Associates  
Mechanical Engineers  
Interface Engineering Inc.  
Electrical Engineers



Target	Revision Item	Revision Date
▲	Addendum #1	10/29/84
▲	Addendum #2	11/06/84
▲	Addendum #4	11/13/84
▲	Addendum #5	11/21/84
▲	Proposal Request #1	03/01/85
▲	Proposal Request #2	03/01/85
▲	Proposal Request #3	03/01/85
▲	Proposal Request #4	03/01/85
▲	Proposal Request #5	03/01/85
▲	Proposal Request #6	03/01/85
▲	Proposal Request #7	03/01/85
▲	Proposal Request #8	03/01/85
▲	Proposal Request #9	03/01/85
▲	Proposal Request #10	03/01/85
▲	Proposal Request #11	03/01/85
▲	Proposal Request #12	03/01/85
▲	Proposal Request #13	03/01/85
▲	Proposal Request #14	03/01/85
▲	Clarification Items	03/01/85
▲	Miscellaneous Items	03/01/85


Revisions

New Theatre Building

PLAN LEVEL 91'-0" / 97'-6"  
HVAC

Date - OCT 12, 1984  
Scale 1/8" = 1'-0"  
Drawing No. 8.11

C. W. Timmer Associates Inc.  
Consulting Engineers 1044-20

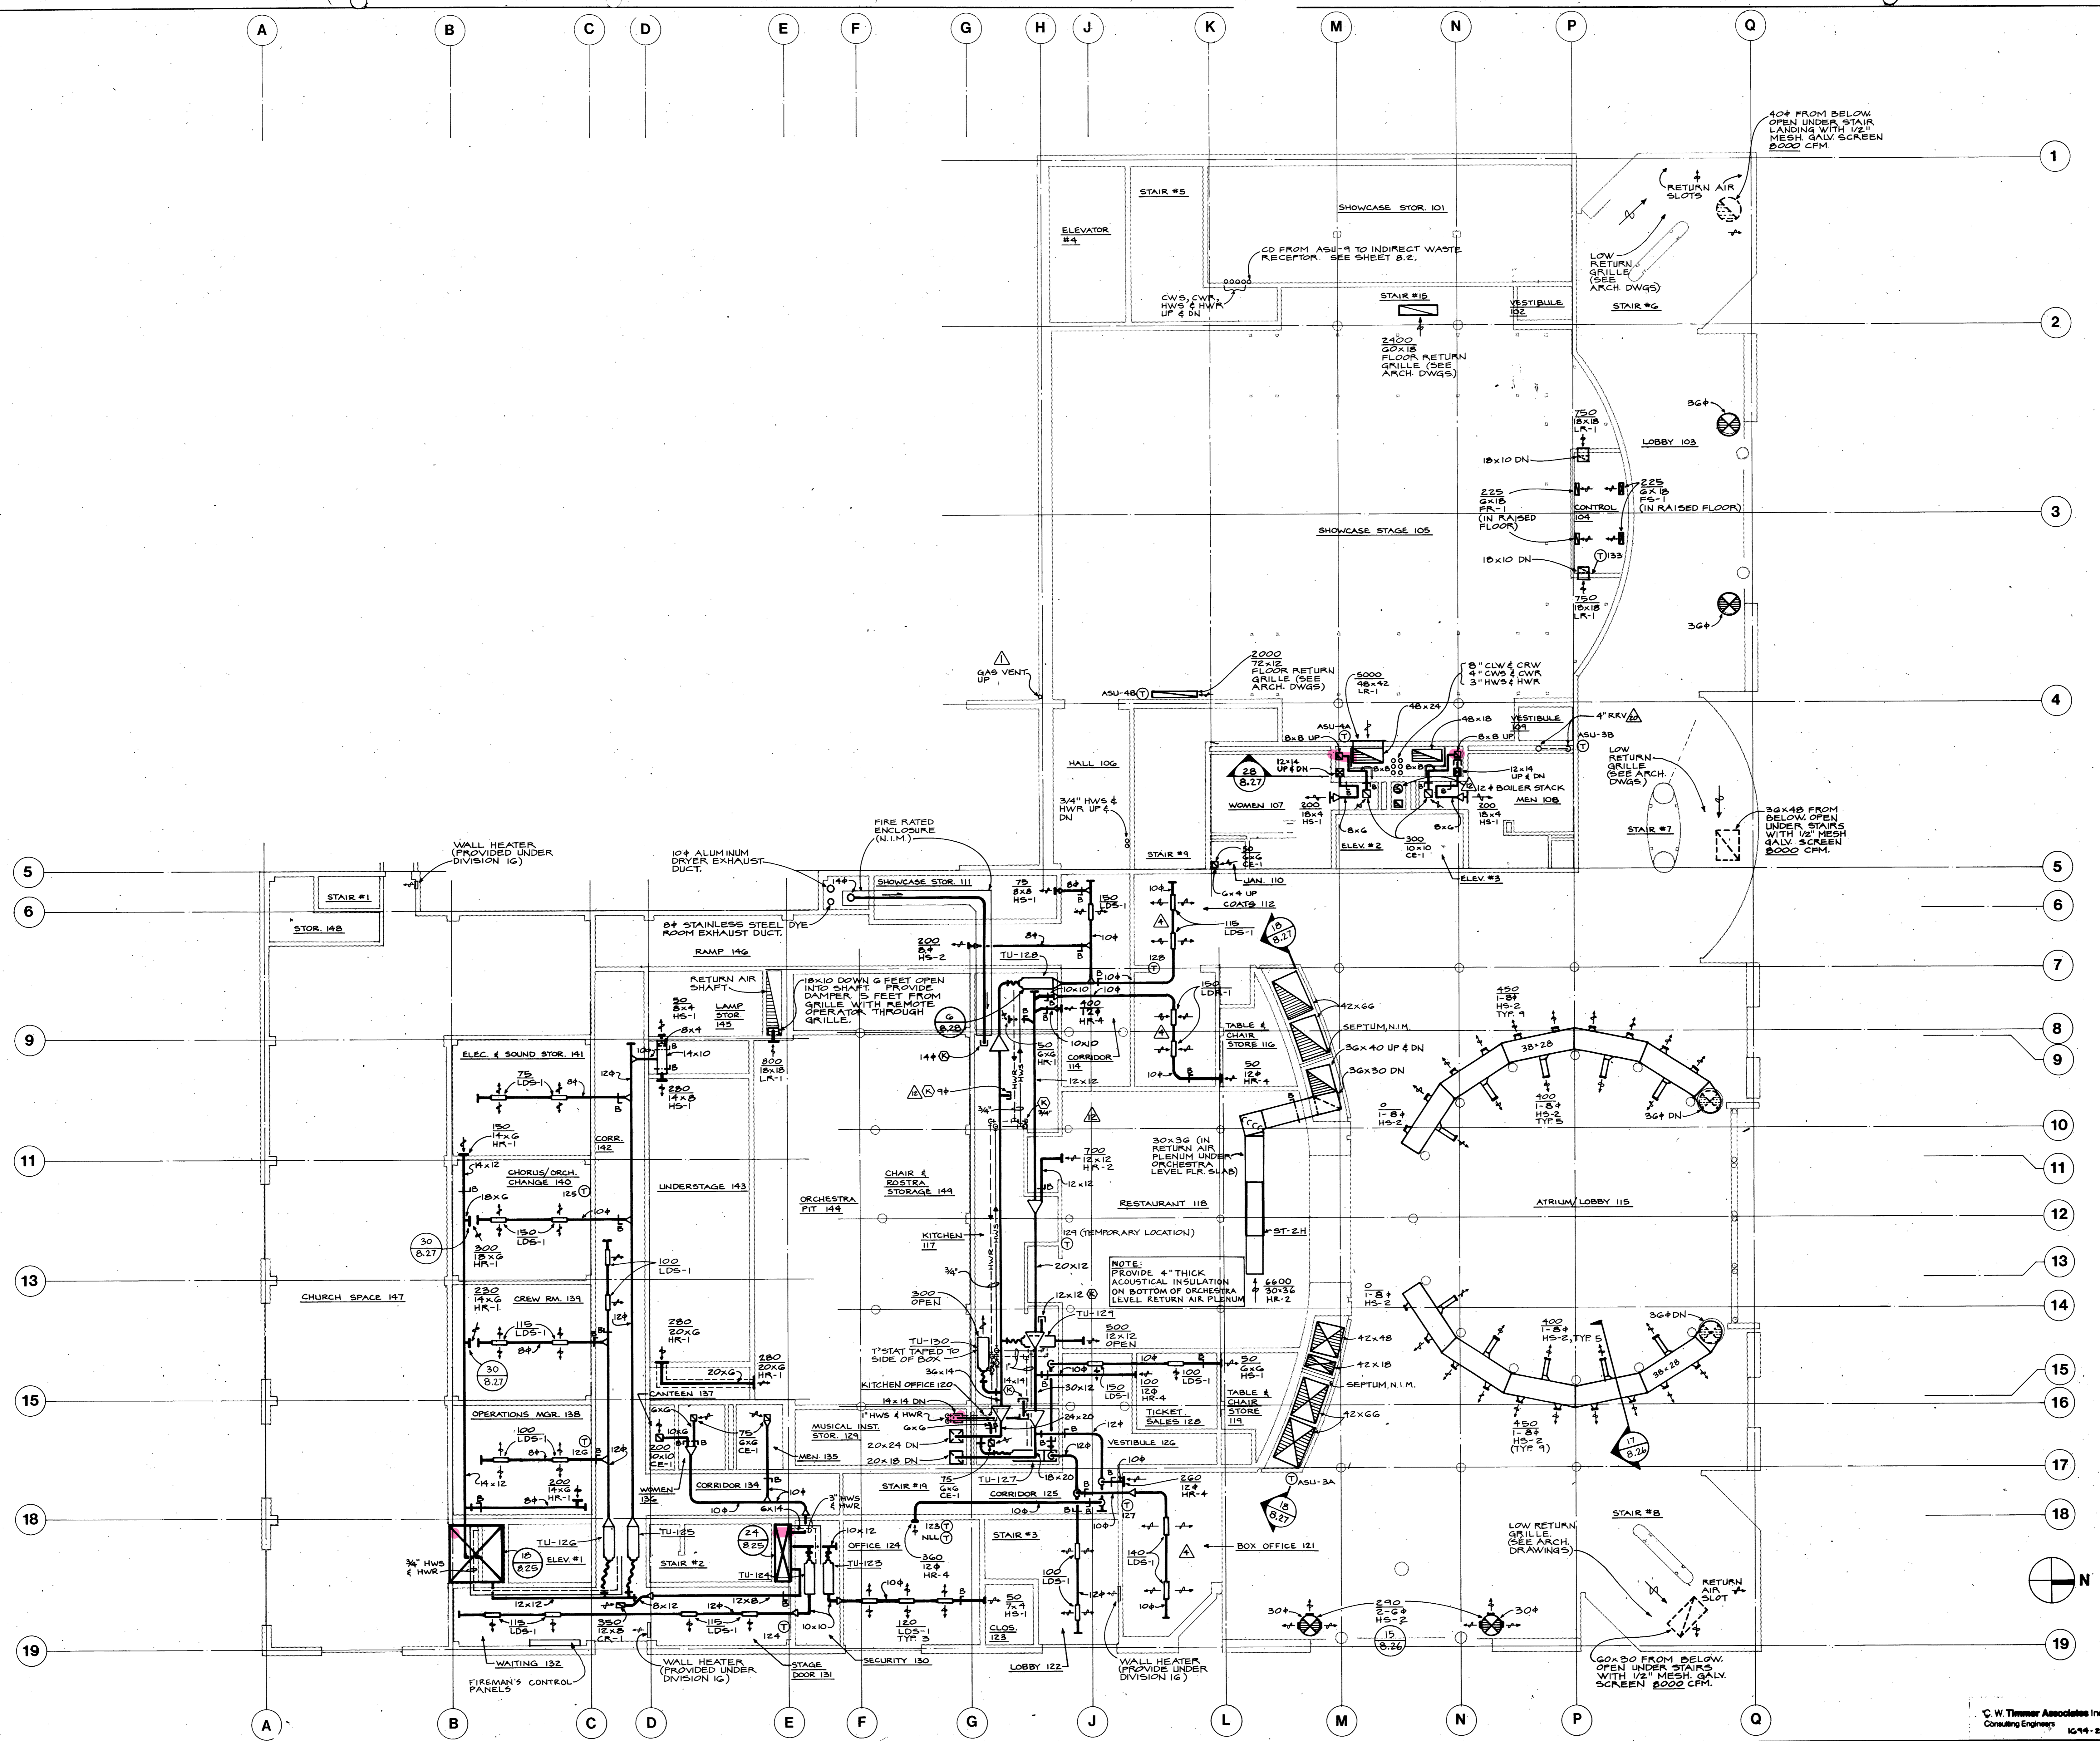

# Portland Center for the Performing Arts

The City of Portland

Honorable Mildred A. Schwab  
Commissioner in Charge  
Ronald K. Ragen  
Chairman  
Performing Arts Center Committee

Architects  
Broome, Oringduh, O'Toole, Rudolf & Associates pc  
E/S Design Group  
Barton Myers  
Project Address  
733 N.W. 20th Avenue  
Portland, Oregon 97209  
(503) 226-1575

Consultants  
Theatre Projects Inc.  
Theatre Consultants  
R. Lawrence Kirkegaard & Associates  
Acoustician  
CH2M Hill  
Structural Engineers  
C.W. Timmer Associates  
Mechanical Engineers  
Interface Engineering Inc.  
Electrical Engineers



Target	Revision Item	Revision Date
△	Addendum #1	10/29/84
△	Addendum #2	11/06/84
△	Addendum #4	11/13/84
△	Addendum #5	11/21/84
△	Proposal Request #1	03/01/85
△	Proposal Request #2	03/01/85
△	Proposal Request #3	03/01/85
△	Proposal Request #4	03/01/85
△	Proposal Request #5	03/08/85
△	Proposal Request #6	03/01/85
△	Proposal Request #7	03/01/85
△	Proposal Request #8	03/01/85
△	Proposal Request #9	03/01/85
△	Proposal Request #10	03/01/85
△	Proposal Request #11	03/01/85
△	Proposal Request #12	03/01/85
△	Proposal Request #13	03/01/85
△	Proposal Request #14	03/01/85
△	Clarification Items	03/01/85
△	Miscellaneous Items	03/01/85

Revisions

New Theatre Building


PLAN LEVEL 99'-0"  
HVAC

Date OCT. 12, 1984

Scale 1/8"=1'-0"

Drawing No. 68.12

C.W. Timmer Associates  
Mechanical Engineers

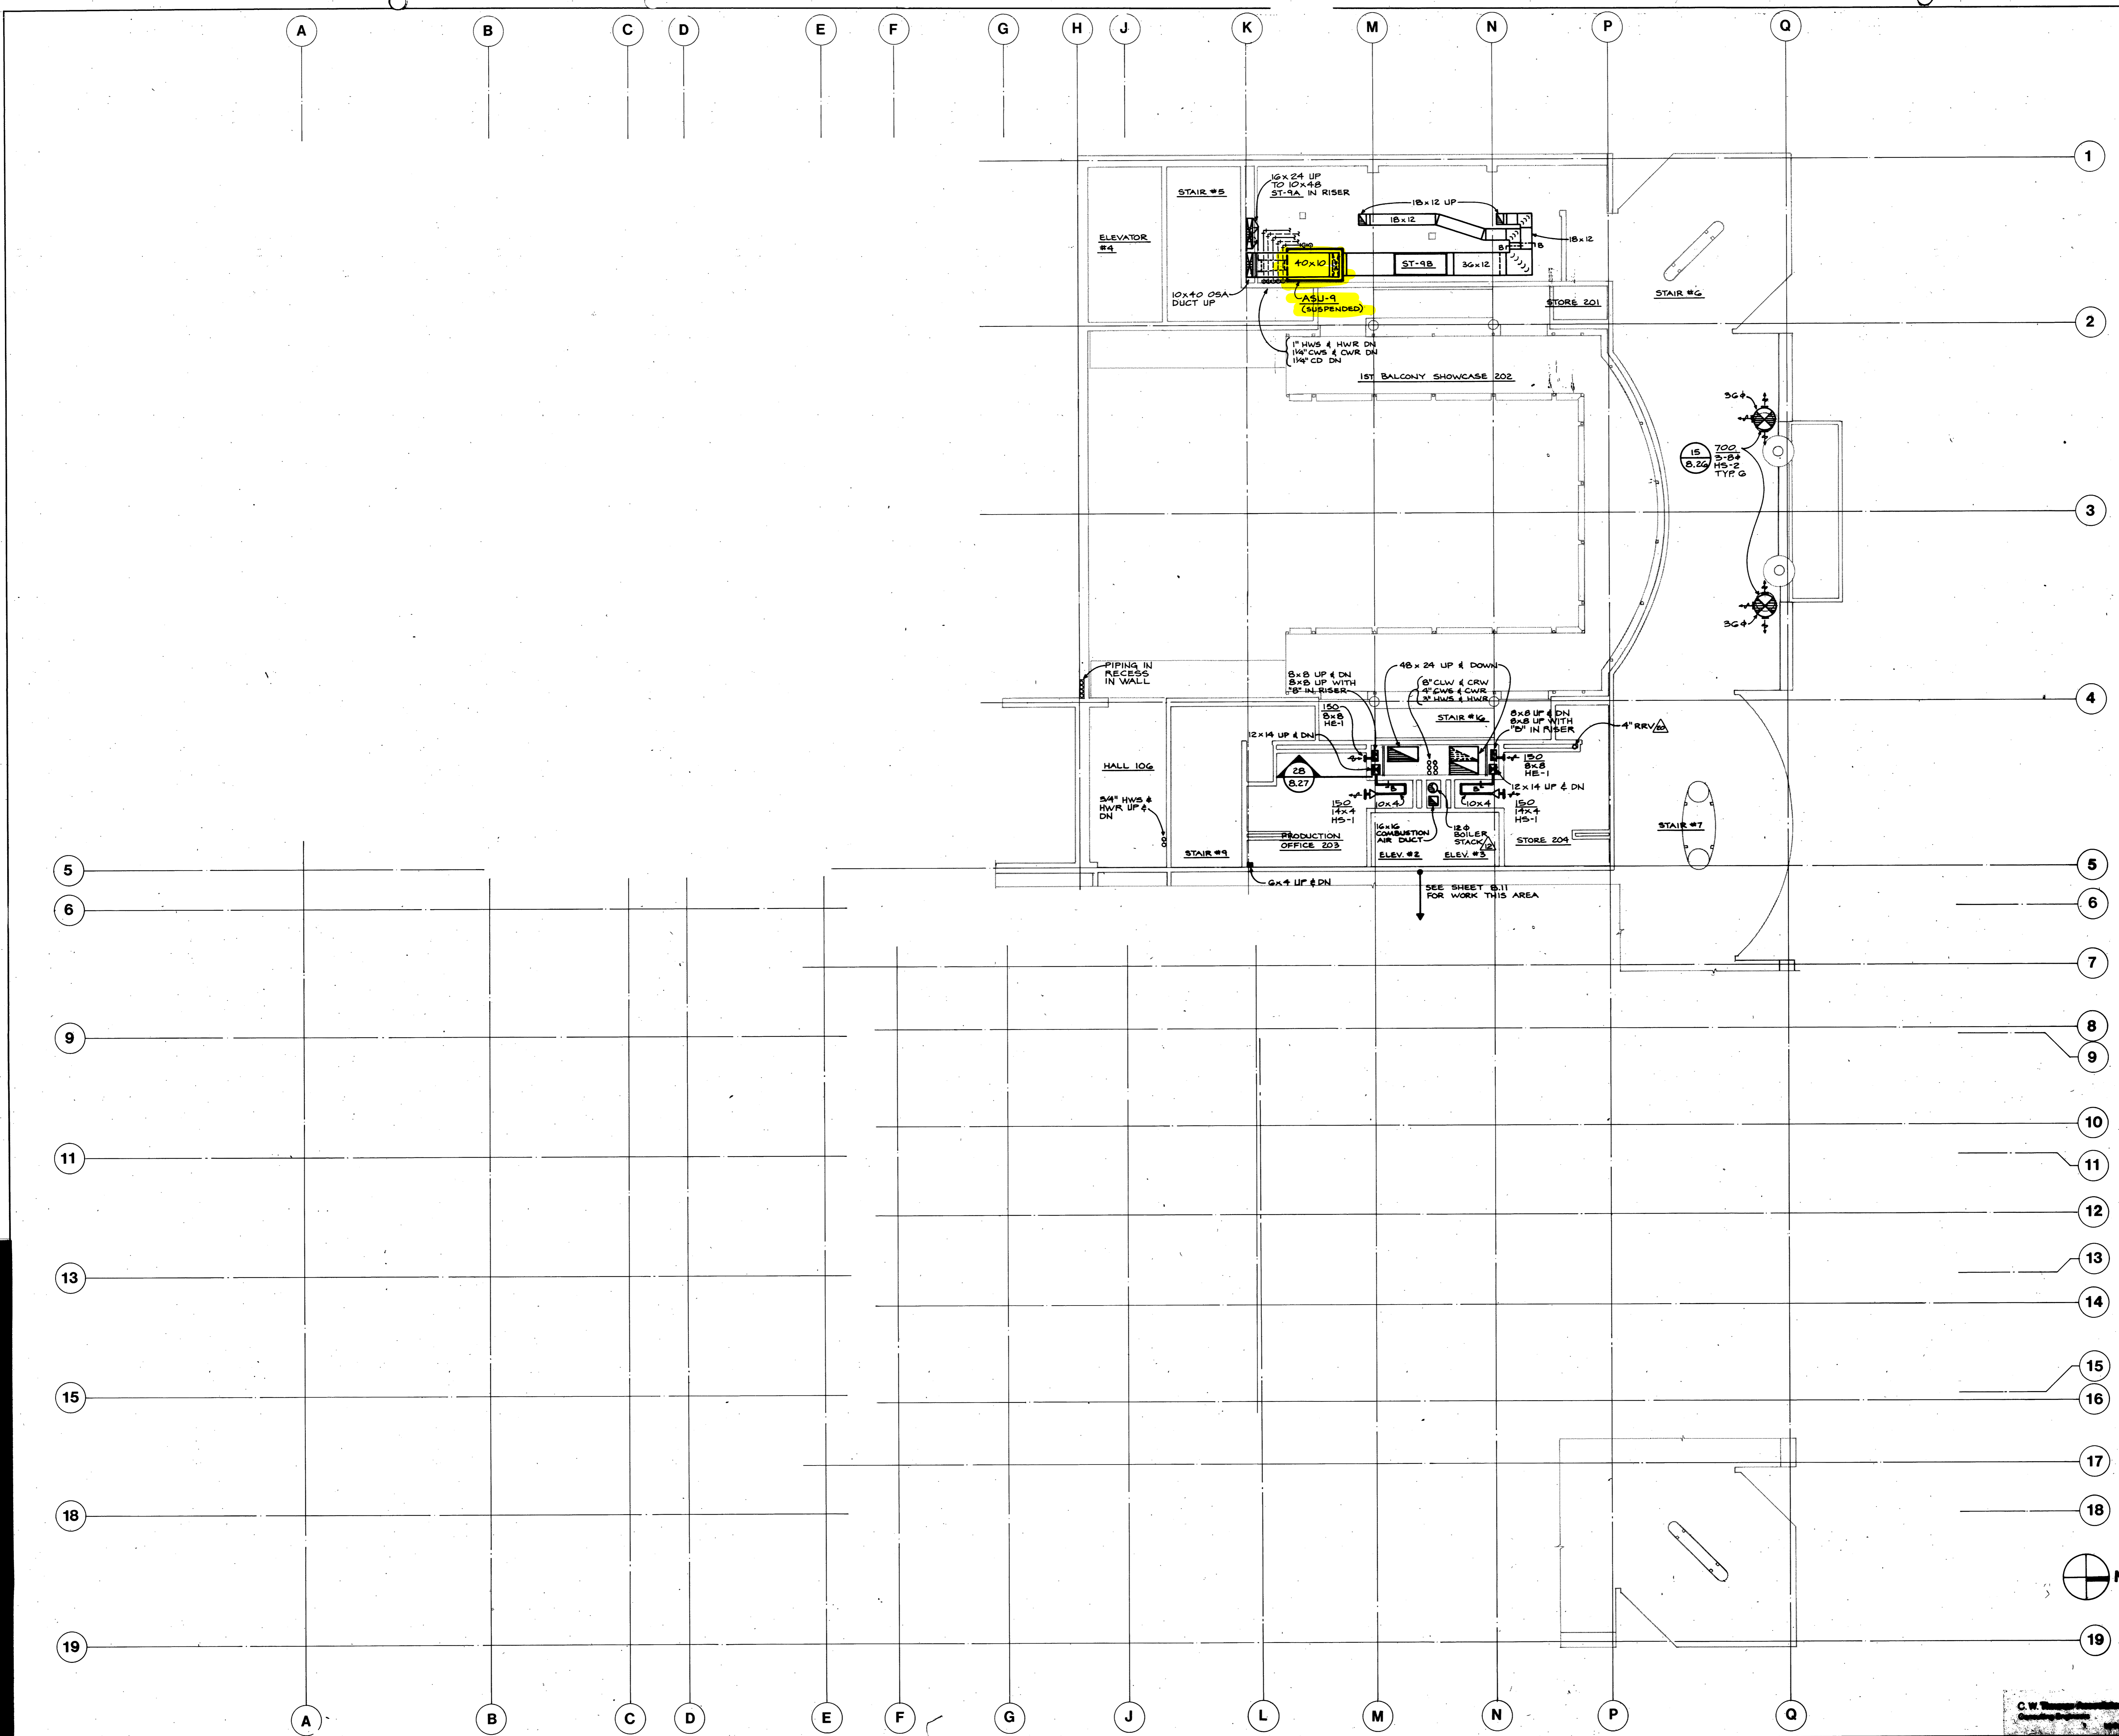

# Portland Center for the Performing Arts

The City of Portland

Honorable Mildred A. Schwab  
Commissioner in Charge  
Ronald K. Ragen  
Chairman  
Performing Arts Center Committee

Architects  
Broome, Oringdolph, O'Toole, Rudolf & Associates pc  
ELS Design Group  
Barton Myers

Project Address  
733 N.W. 20th Avenue  
Portland, Oregon 97209  
(503) 226-1575

Consultants  
Theatre Projects Inc.  
Theatre Consultants  
R. Lawrence Kirkegaard & Associates  
Acoustician  
CH2M Hill  
Structural Engineers  
C.W. Timmer Associates  
Mechanical Engineers  
Interface Engineering Inc.  
Electrical Engineers



Target	Revision Item	Revision Date
▲	Addendum #1	10/29/84
▲	Addendum #2	11/06/84
▲	Addendum #4	11/13/84
▲	Addendum #5	11/21/84
▲	Proposal Request #1	03/01/85
▲	Proposal Request #2	03/01/85
▲	Proposal Request #3	03/01/85
▲	Proposal Request #4	03/01/85
▲	Proposal Request #5	03/08/85
▲	Proposal Request #6	03/01/85
▲	Proposal Request #7	03/01/85
▲	Proposal Request #8	03/01/85
▲	Proposal Request #9	03/01/85
▲	Proposal Request #10	03/01/85
▲	Proposal Request #11	03/01/85
▲	Proposal Request #12	03/01/85
▲	Proposal Request #13	03/01/85
▲	Proposal Request #14	03/01/85
▲	Clarification Items	03/01/85
▲	Miscellaneous Items	03/01/85

Revisions

New Theatre Building

PLAN LEVEL 107'-0" / 108'-0"  
HVAC

Date: 10/23/83  
Scale: 1/8" = 1'-0"  
Drawing No. 8.13

C.W. Timmer Associates Inc.  
Consulting Engineers  
1644-20



NOTES  
 1 2-10" DUCTS UP & CONNECTED TO 10" MUSHROOMS UNDER SEATS  
 2 18" X 12" UP TO RETURN AIR FLENUM UNDER SEATING WITH 1/2" MESH GALV SCREEN

SCREEN VALUE  
 COMPOSITE INSTRUCTIONS  
 BASE/OVERLAY NO

# Portland Center for the Performing Arts

The City of Portland

Honorable Mildred A. Schwab  
Commissioner in Charge  
Ronald K. Ragen  
Chairman  
Performing Arts Center Committee

Architects  
Broome, Oringdolph, O'Toole, Rudolf & Associates pc  
ELS Design Group  
Barton Myers

Project Address  
733 N.W. 20th Avenue  
Portland, Oregon 97209  
(503) 226-1575

Consultants  
Theatre Projects Inc.  
Theatre Consultants  
R. Lawrence Kirkegaard & Associates  
Acoustician  
CH2M Hill  
Structural Engineers  
C. W. Timmer Associates  
Mechanical Engineers  
Interface Engineering Inc.  
Electrical Engineers



Target	Revision Item	Revision Date
▲	Addendum #1	10/29/84
▲	Addendum #2	11/06/84
▲	Addendum #4	11/13/84
▲	Addendum #5	11/21/84
▲	Proposal Request #1	03/01/85
▲	Proposal Request #2	03/01/85
▲	Proposal Request #3	03/01/85
▲	Proposal Request #4	03/01/85
▲	Proposal Request #5	03/01/85
▲	Proposal Request #6	03/01/85
▲	Proposal Request #7	03/01/85
▲	Proposal Request #8	03/01/85
▲	Proposal Request #9	03/01/85
▲	Proposal Request #10	03/01/85
▲	Proposal Request #11	03/01/85
▲	Proposal Request #12	03/01/85
▲	Proposal Request #13	03/01/85
▲	Proposal Request #14	03/01/85
▲	Clarification Items	03/01/85
▲	Miscellaneous Items	03/01/85


Revisions

New Theatre Building

PLAN LEVEL 115'-0" / 118'-6"  
HVAC

Date: 10/29/84  
Scale: 1/8" = 1'-0"  
Drawing No. 8.14

C. W. Timmer Associates Inc.  
Consulting Engineers  
10-44-20

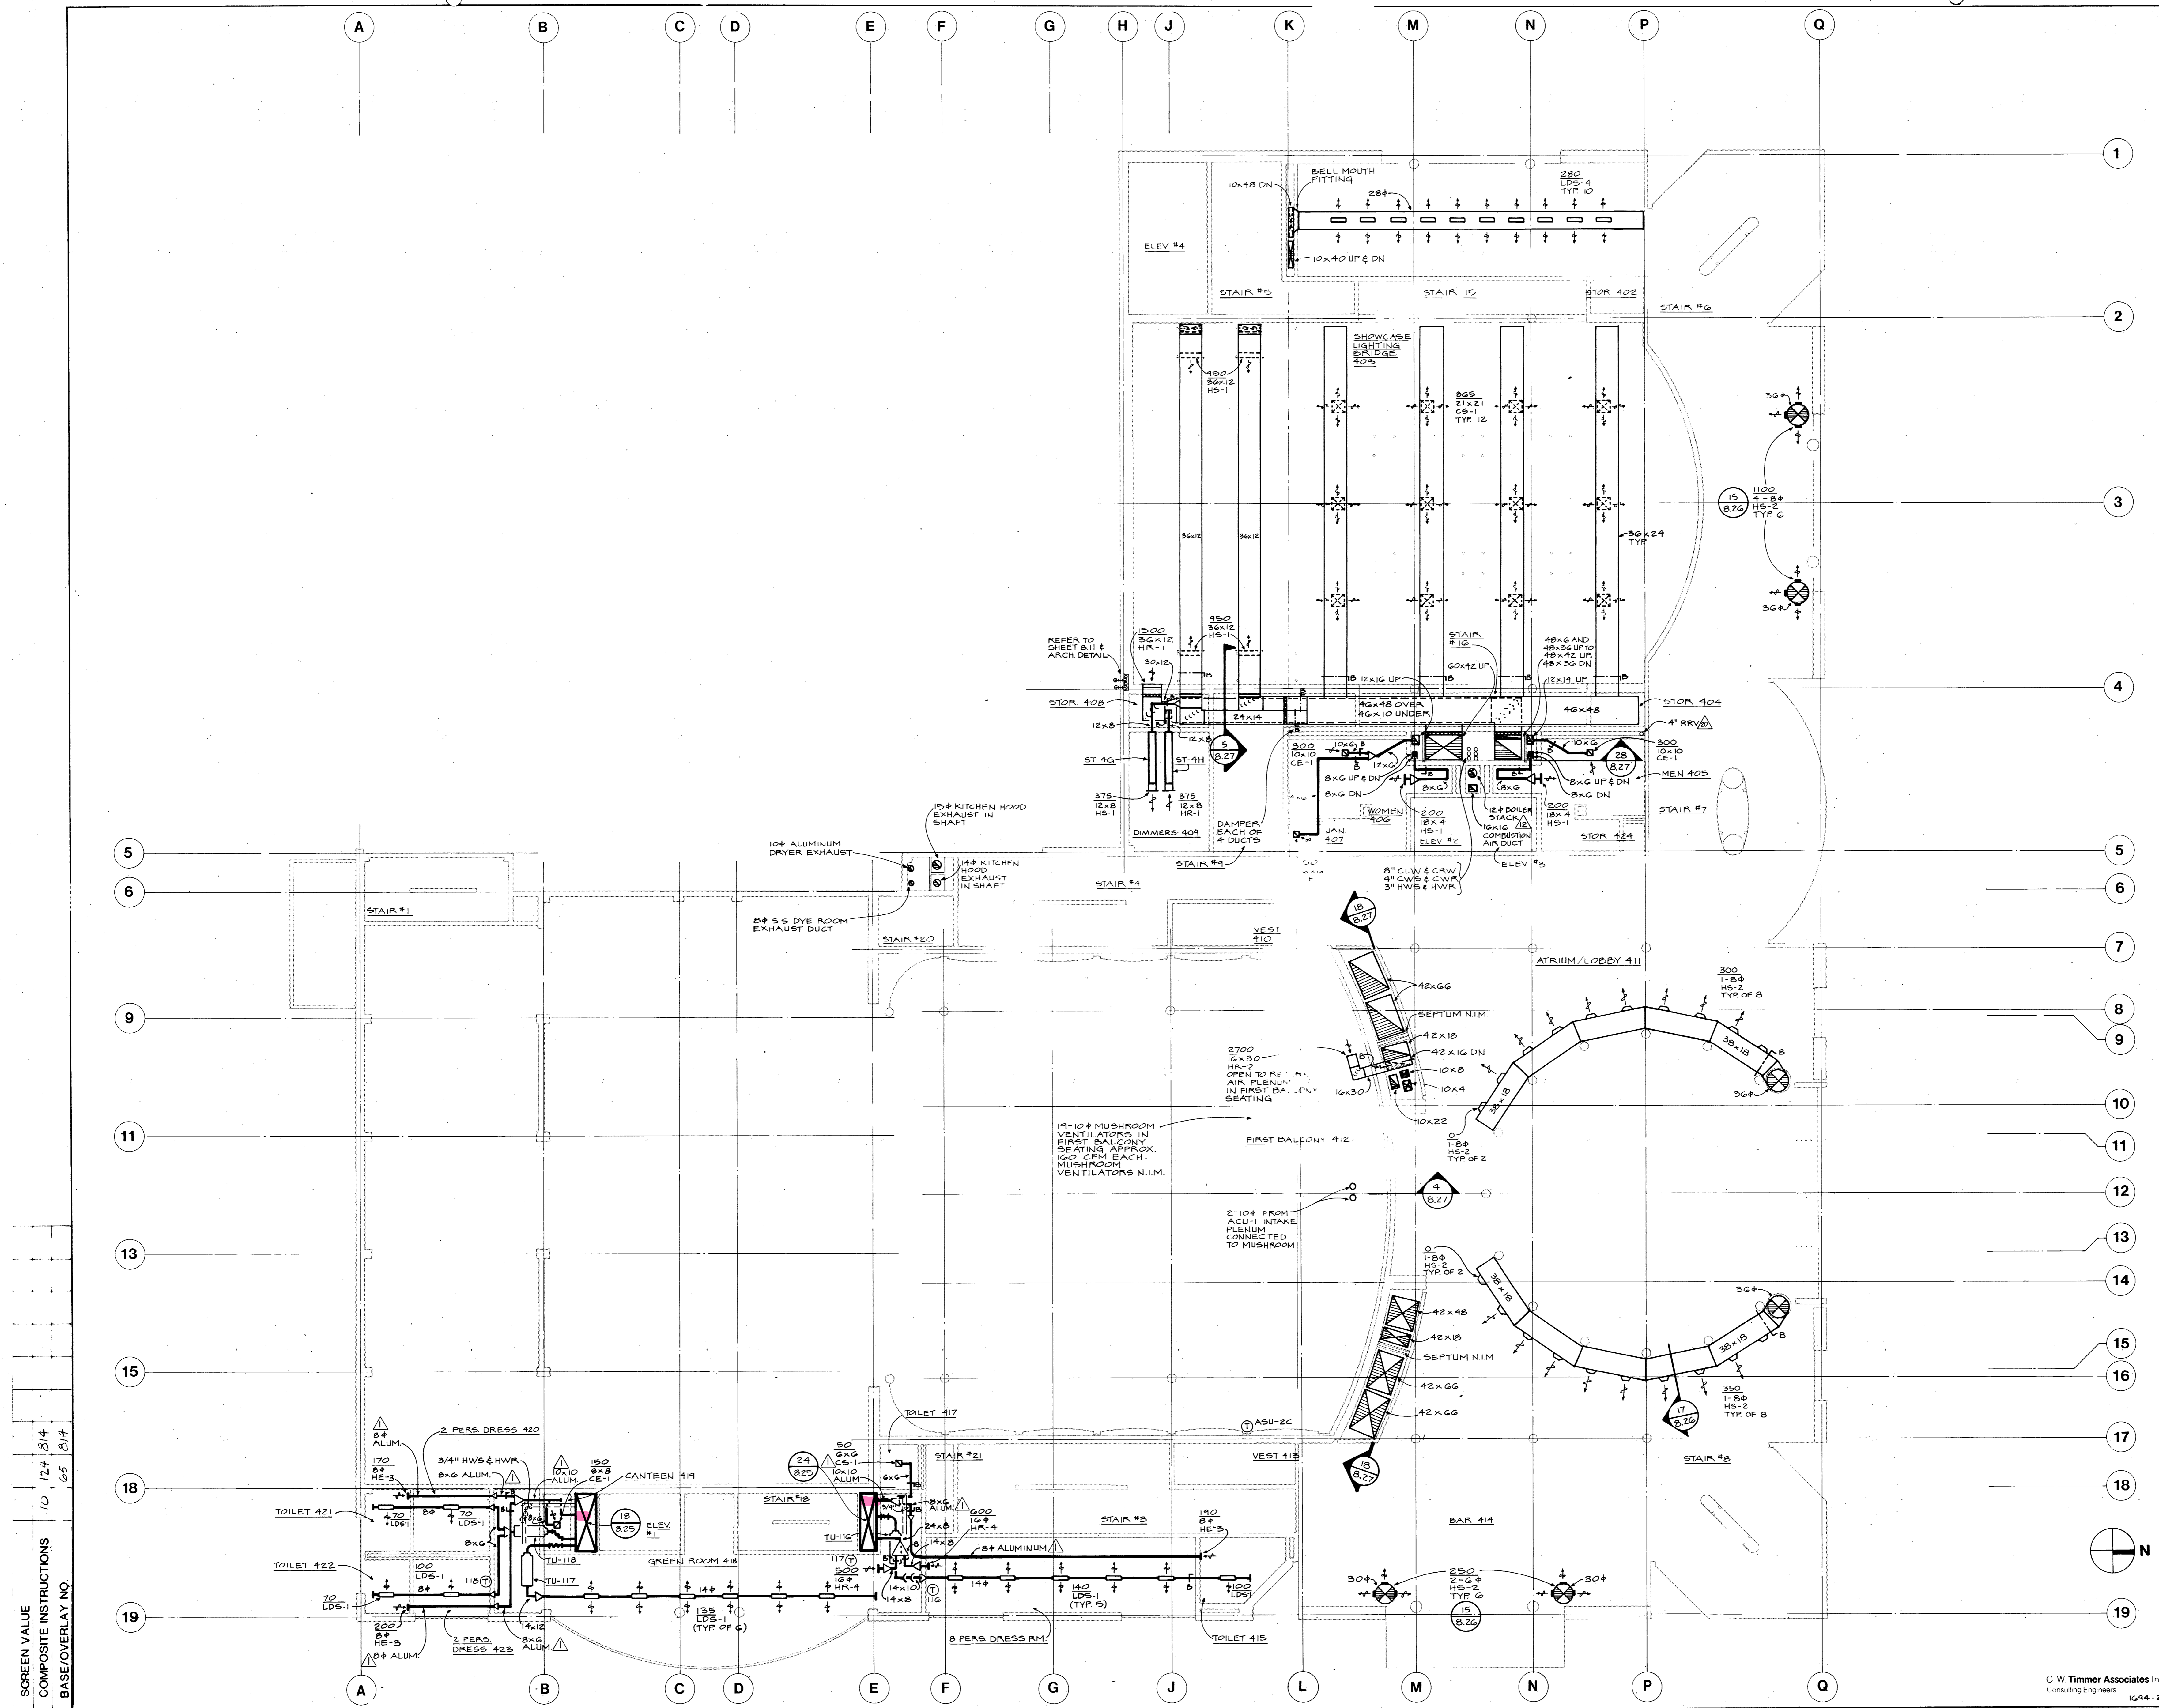

SCREEN VALUE  
COMPOSITE INSTRUCTIONS  
BASE/OVERLAY NO.

# Portland Center for the Performing Arts

The City of Portland

Honorable Mildred A. Schwab  
Commissioner in Charge  
Ronald K. Ragen  
Chairman  
Performing Arts Center Committee

Architects  
Broome, Oringdolph, O'Toole, Rudolf & Associates pc  
ELS Design Group  
Barton Myers

Project Address  
733 N.W. 20th Avenue  
Portland, Oregon 97209  
(503) 226-1575

Consultants  
Theatre Projects Inc.  
Theatre Consultants  
R. Lawrence Kirkegaard & Associates  
Acoustician  
CH2M Hill  
Structural Engineers  
C.W. Timmer Associates  
Mechanical Engineers  
Interface Engineering Inc.  
Electrical Engineers



Target	Revision Item	Revision Date
▲	Addendum #1	10/29/84
▲	Addendum #2	11/06/84
▲	Addendum #3	11/13/84
▲	Addendum #4	11/21/84
▲	Addendum #5	11/21/84
▲	Proposal Request #1	03/01/85
▲	Proposal Request #2	03/01/85
▲	Proposal Request #3	03/01/85
▲	Proposal Request #4	03/01/85
▲	Proposal Request #5	03/01/85
▲	Proposal Request #6	03/01/85
▲	Proposal Request #7	03/01/85
▲	Proposal Request #8	03/01/85
▲	Proposal Request #9	03/01/85
▲	Proposal Request #10	03/01/85
▲	Proposal Request #11	03/01/85
▲	Proposal Request #12	03/01/85
▲	Proposal Request #13	03/01/85
▲	Proposal Request #14	03/01/85
▲	Clarification Items	03/01/85
▲	Miscellaneous Items	03/01/85

Revisions

New Theatre Building


PLAN LEVEL 129'-0"  
HVAC

Date OCT 12, 1984

Scale 1/8" = 1'-0"

Drawing No. 8.15

C.W. Timmer Associates Inc.  
Consulting Engineers  
1614-20

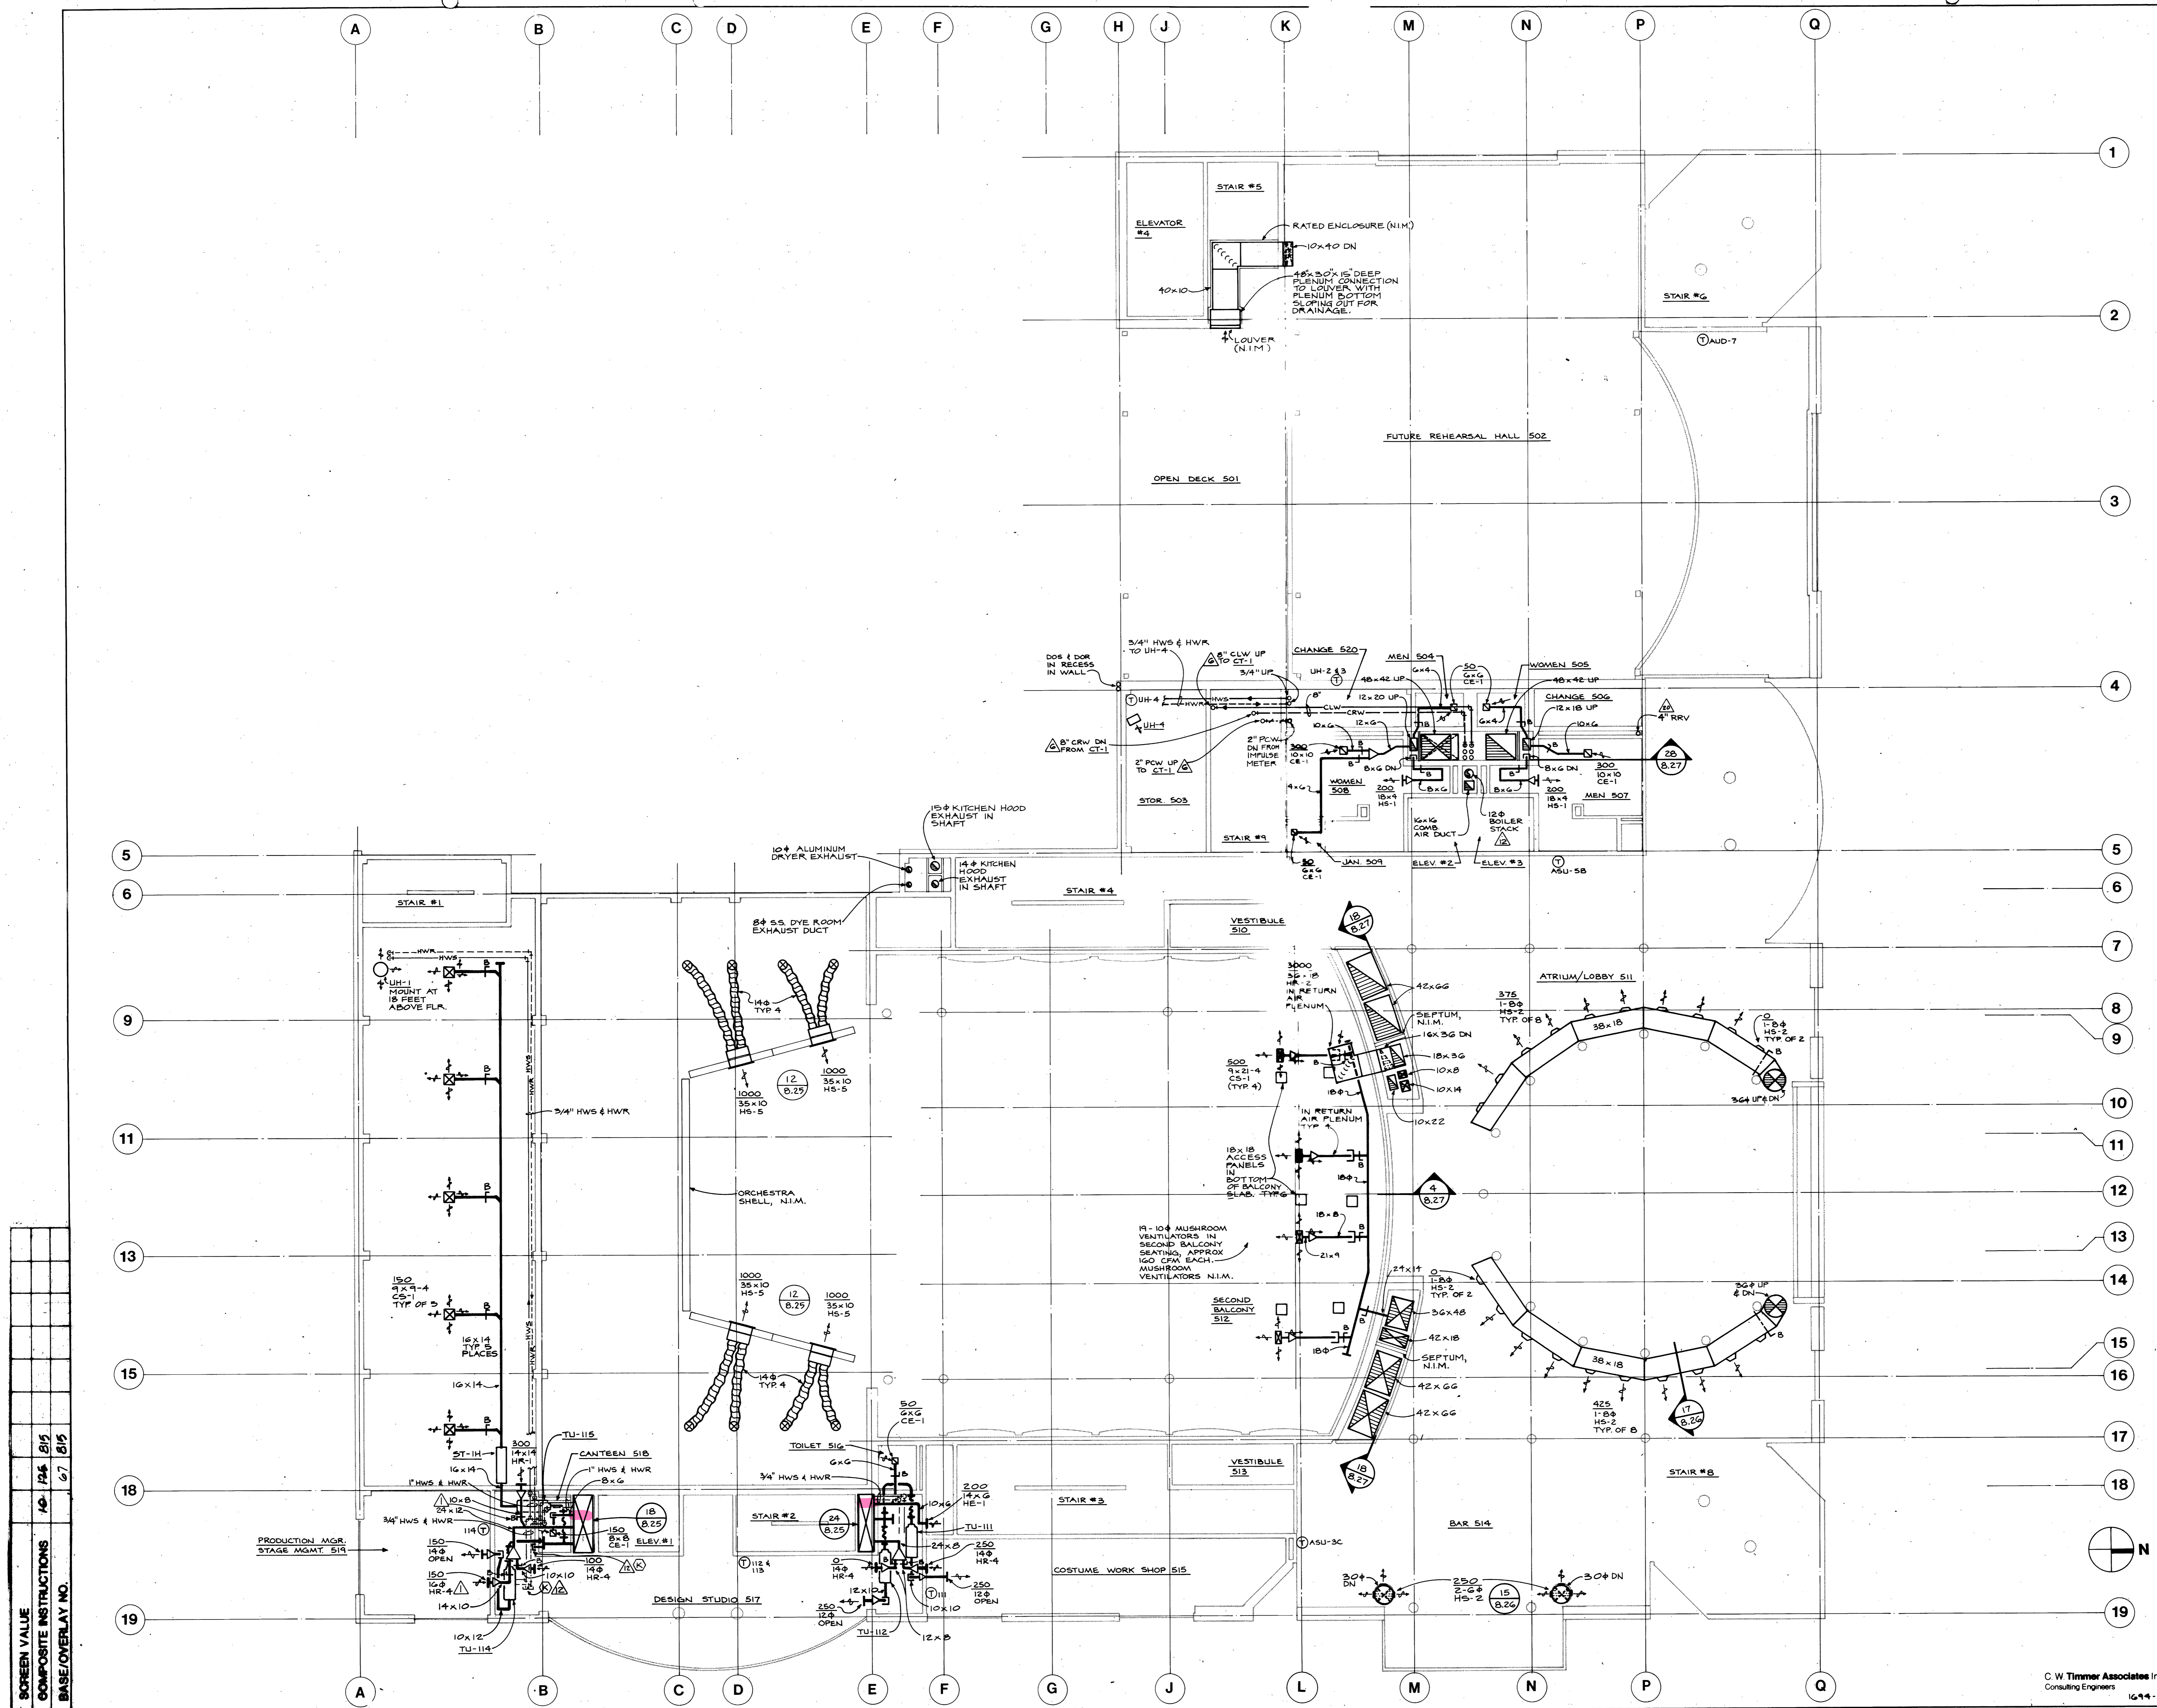

SCREEN VALUE	
COMPOSITE INSTRUCTIONS	146 126 1815
BASE/OVERLAY NO.	67 1815







The City of Portland

Honorable Mildred A. Schwab  
Commissioner in Charge  
Ronald K. Ragen  
Chairman  
Performing Arts Center Committee

Architects  
Broome, Oringdolph, O'Toole, Rudolf & Associates pc  
EIS Design Group  
Barton Myers

Project Address  
733 N.W. 20th Avenue  
Portland, Oregon 97209  
(503) 226-1575

Consultants  
Theatre Projects Inc.  
Theatre Consultants  
R. Lawrence Kirkegaard & Associates  
Acoustician  
CH2M Hill  
Structural Engineers  
C.W. Timmer Associates  
Mechanical Engineers  
Interface Engineering Inc.  
Electrical Engineers



Target	Revision Item	Revision Date
▲	Addendum #1	10/29/84
▲	Addendum #2	11/06/84
▲	Addendum #4	11/13/84
▲	Addendum #5	11/21/84
▲	Proposal Request #1	03/01/85
▲	Proposal Request #2	03/01/85
▲	Proposal Request #3	03/01/85
▲	Proposal Request #4	03/01/85
▲	Proposal Request #5	03/08/85
▲	Proposal Request #6	03/01/85
▲	Proposal Request #7	03/01/85
▲	Proposal Request #8	03/01/85
▲	Proposal Request #9	03/01/85
▲	Proposal Request #10	03/01/85
▲	Proposal Request #11	03/01/85
▲	Proposal Request #12	03/01/85
▲	Proposal Request #13	03/01/85
▲	Proposal Request #14	03/01/85
▲	Clarification Items	03/01/85
▲	Miscellaneous Items	03/01/85

Revisions

New Theatre Building


MECHANICAL RMS  
DETAILS

Date OCT. 12, 1984


Scale 1/4" = 1'-0"

Drawing No. 8.22


C.W. Timmer Associates Inc.  
Consulting Engineers  
1644 - 20

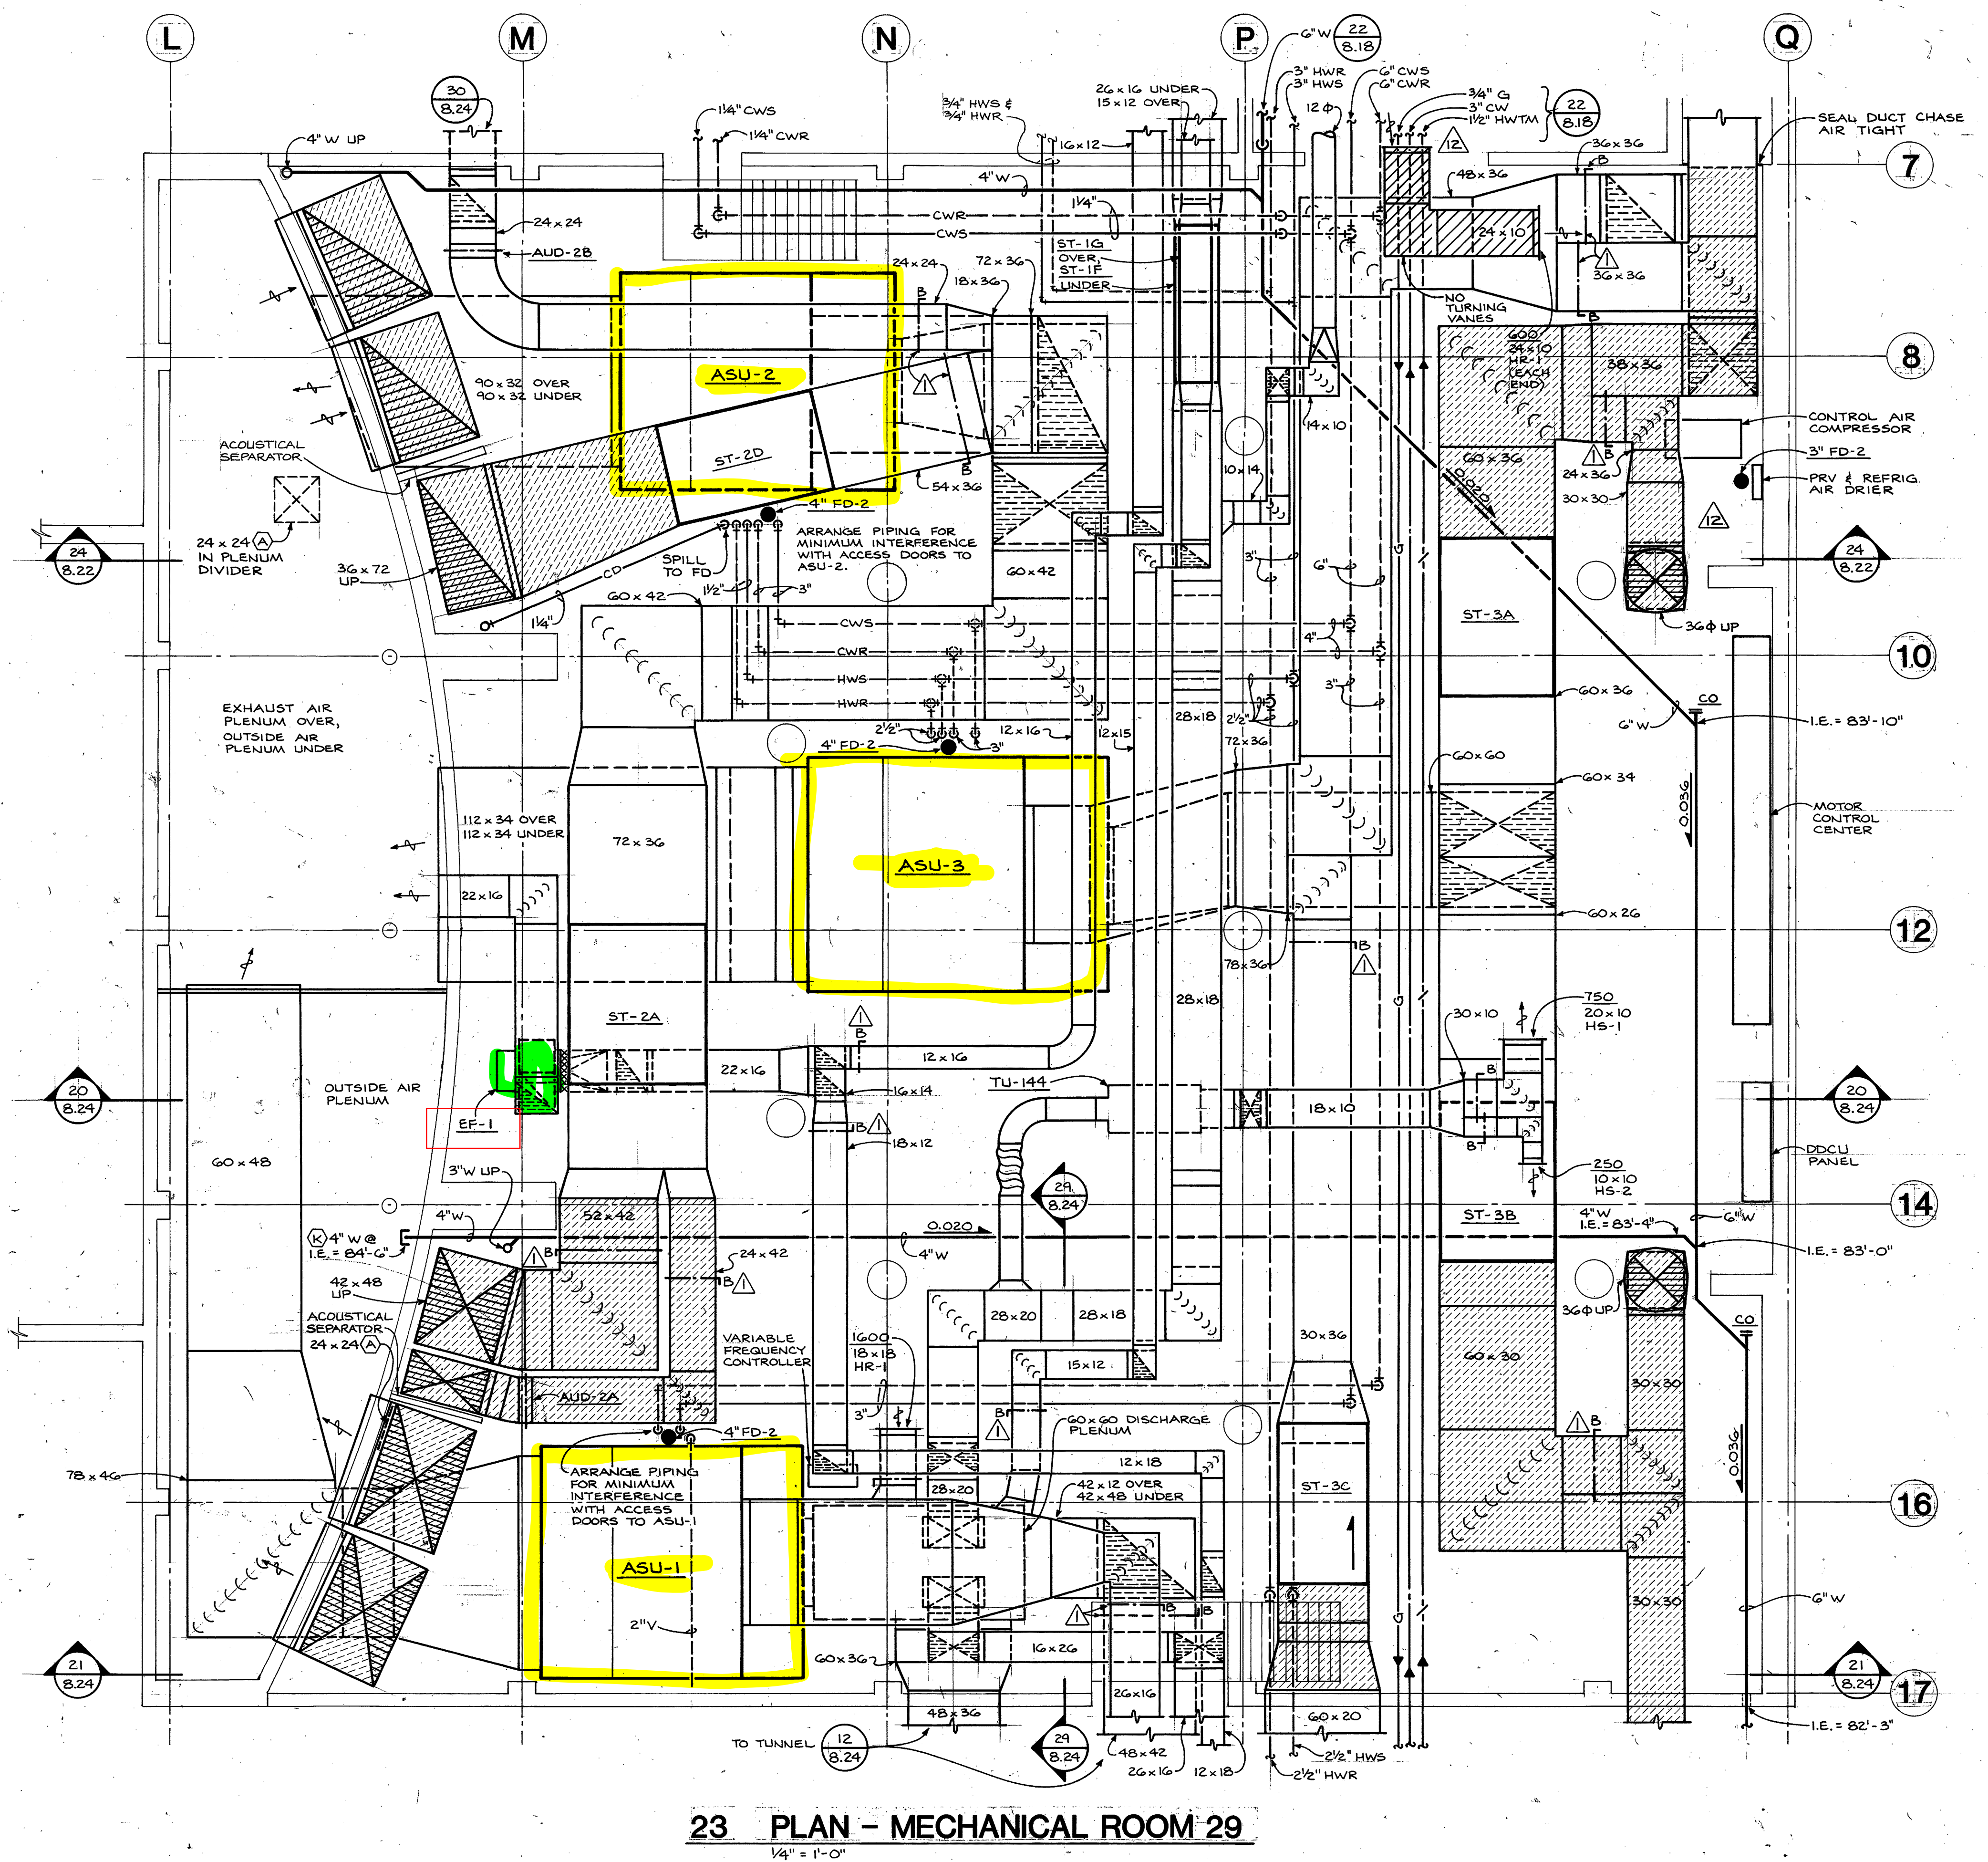


23 PLAN - MECHANICAL ROOM 29  
1/4" = 1'-0"

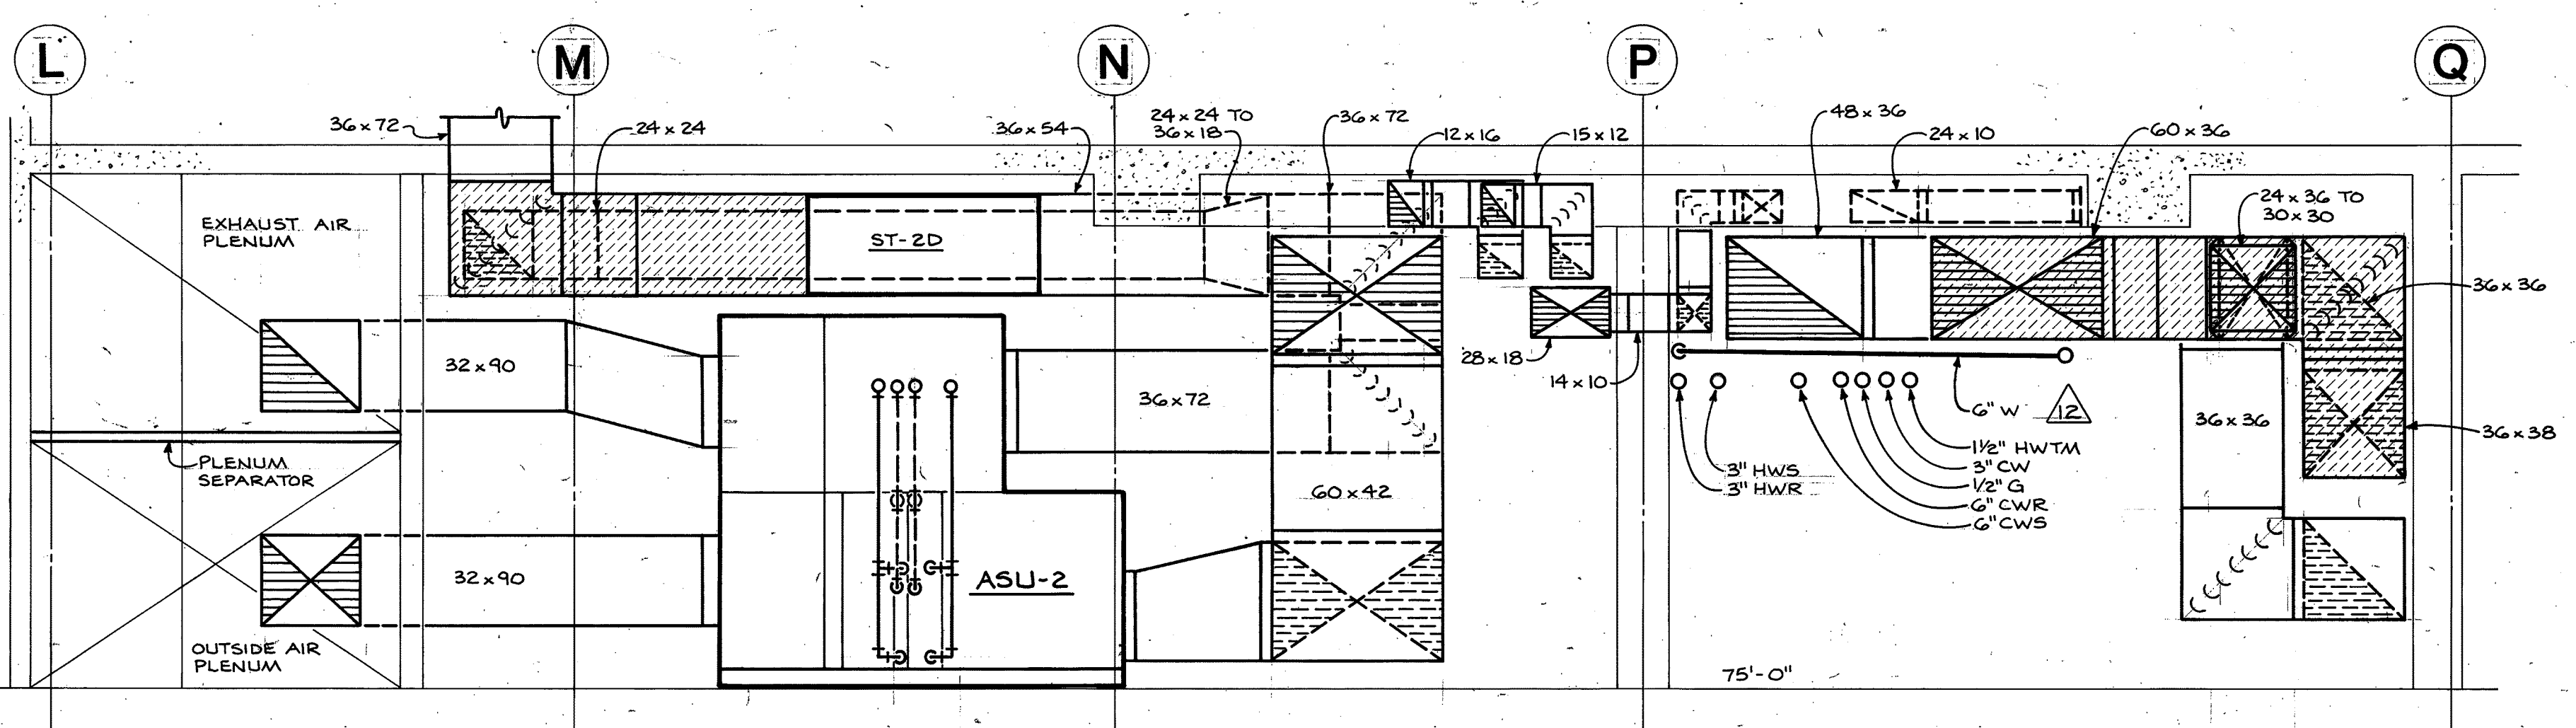


24 SECTION AT ASU-2  
1/4" = 1'-0"

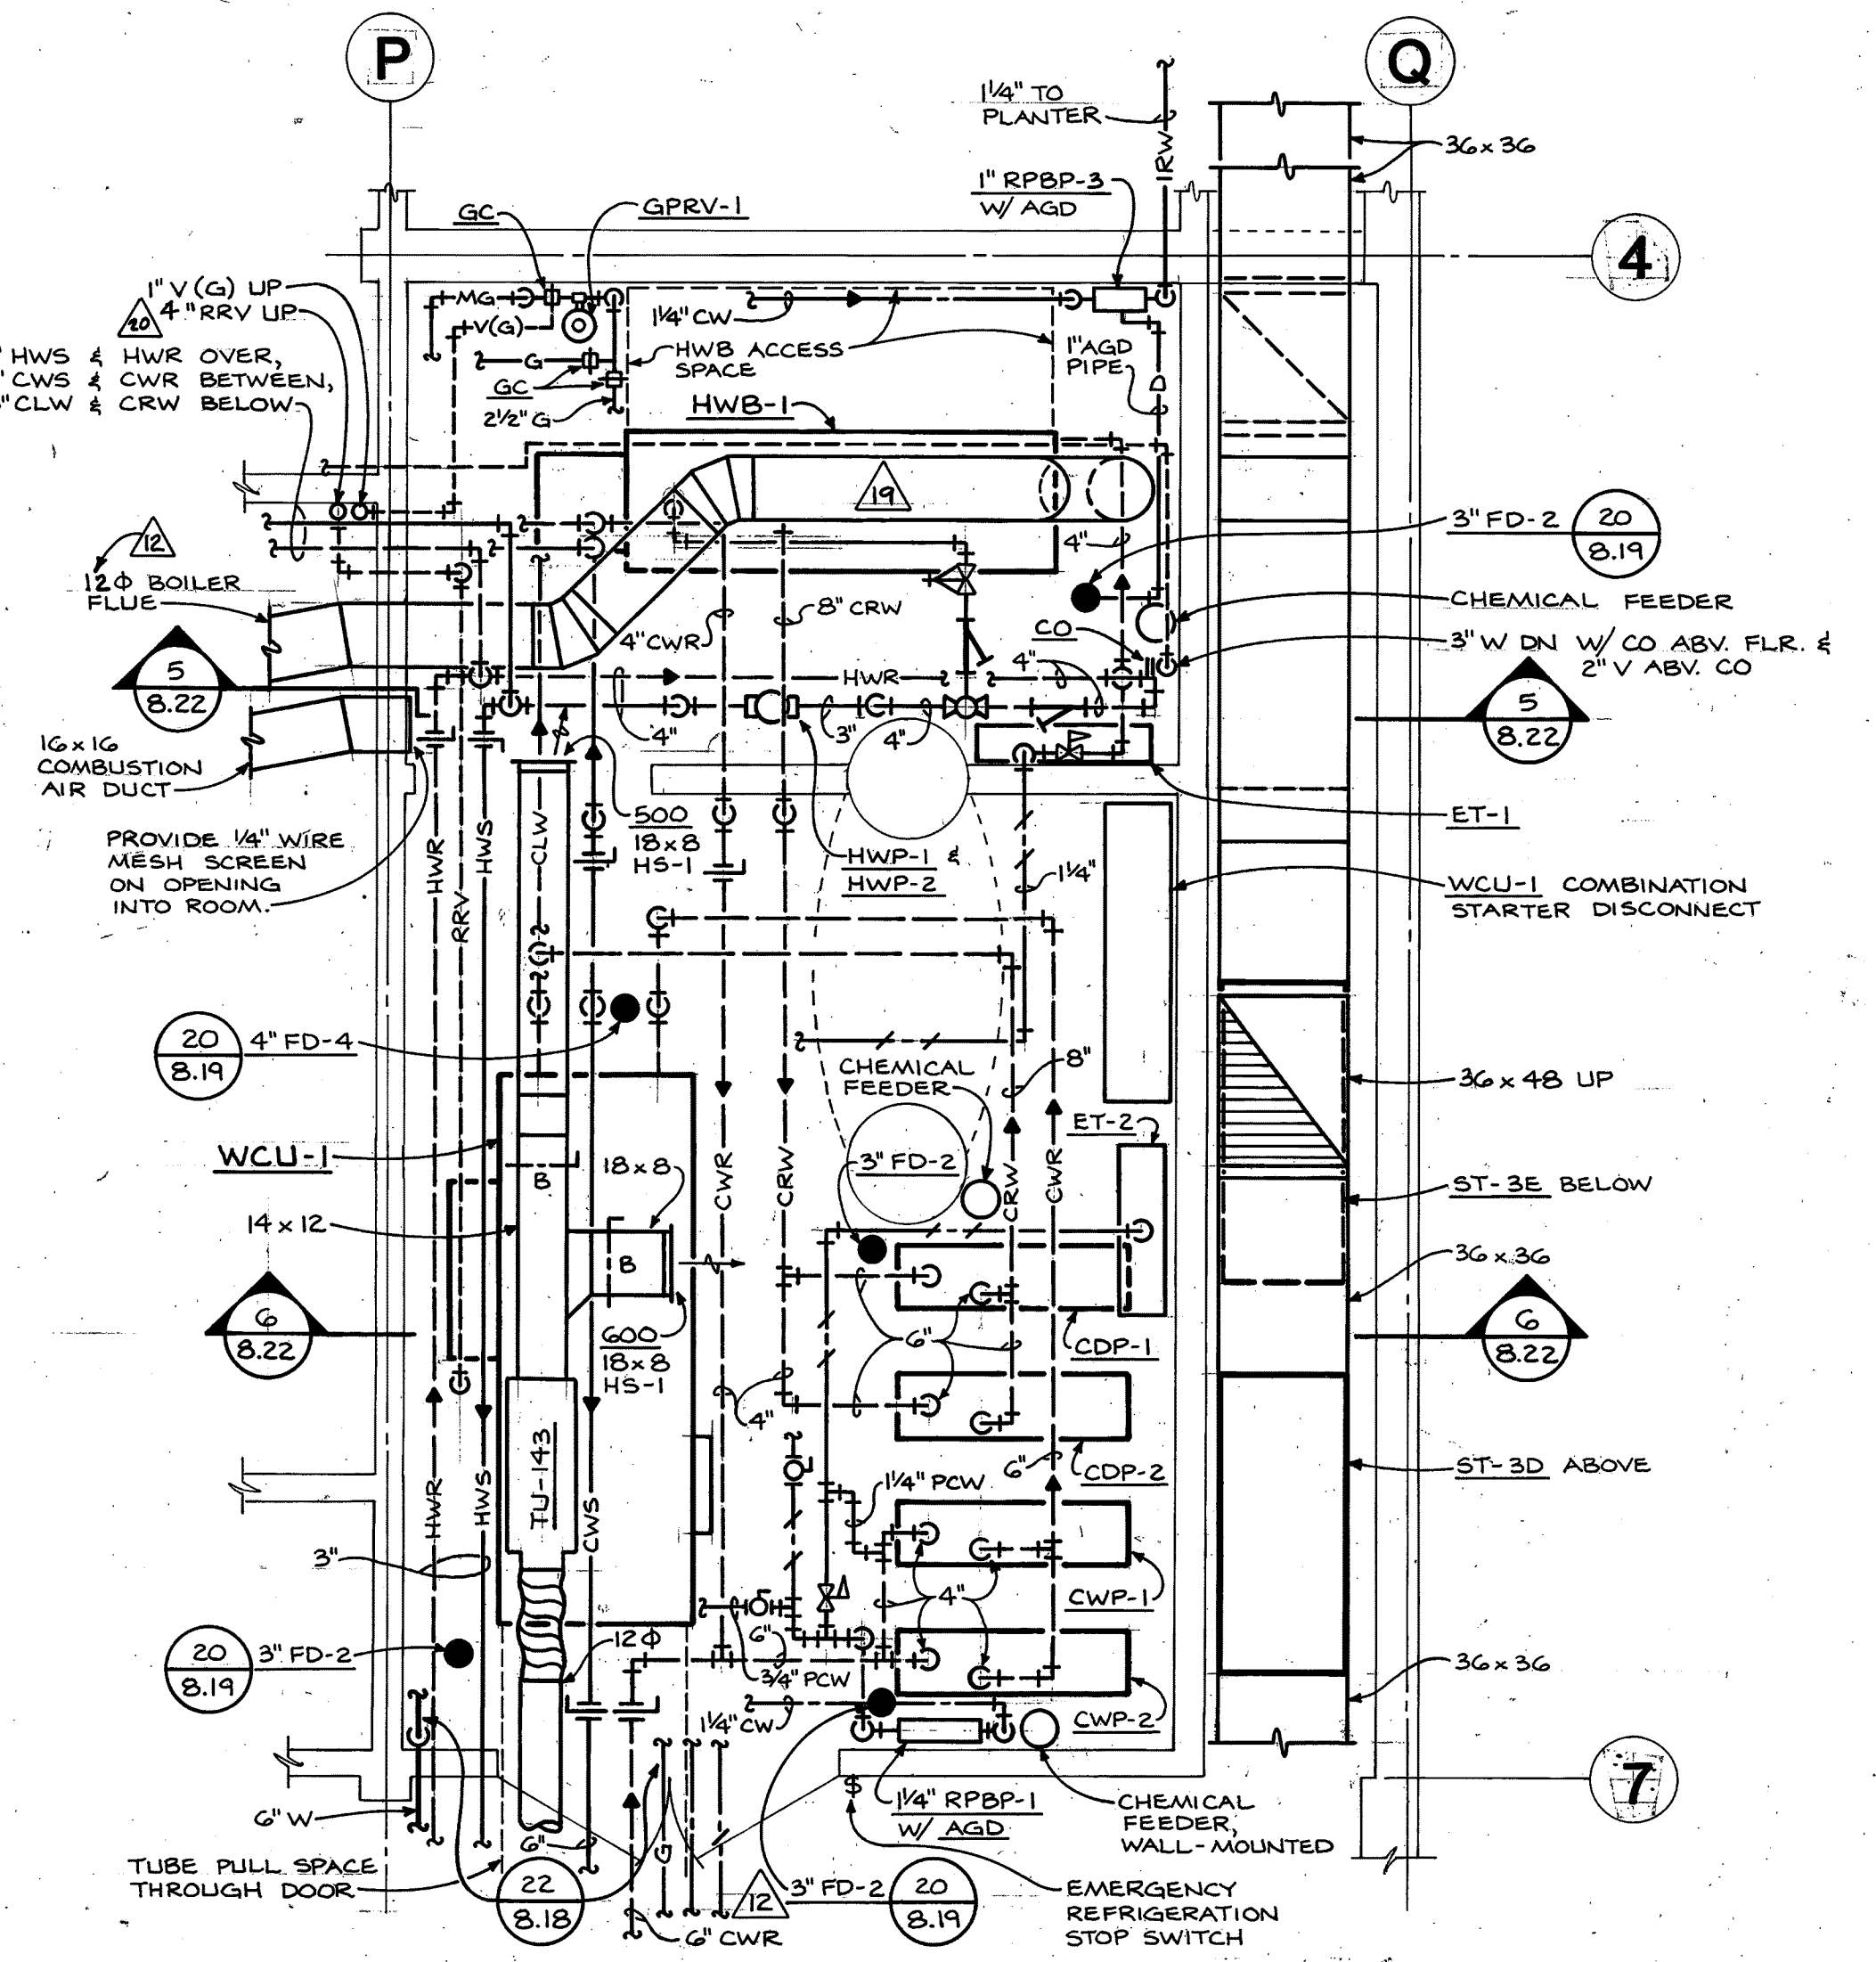

3 PLAN - BOILER/CHILLER ROOM  
1/4" = 1'-0"

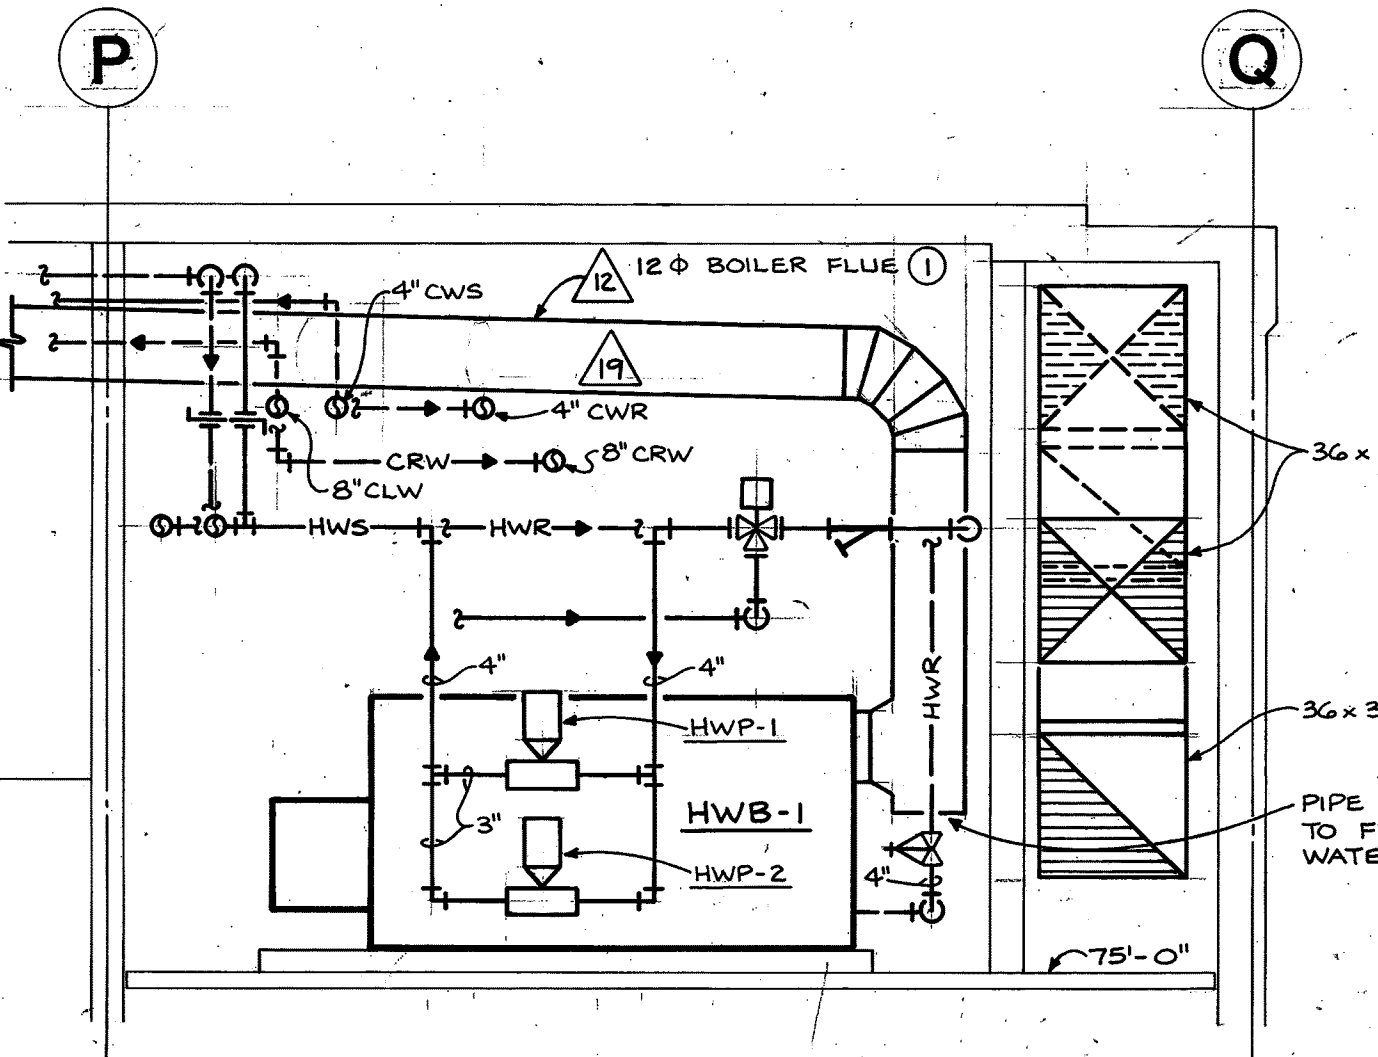

5 SECTION - BOILER ROOM  
1/4" = 1'-0"  
NOTES: 1) SLOPE BOILER FLUE MINIMUM 1/4" / FOOT.  
ROUTE IN SEPARATE RATED SHIRT PER CODE.  
HOLD AS TIGHT TO SLAB ABOVE AS POSSIBLE.

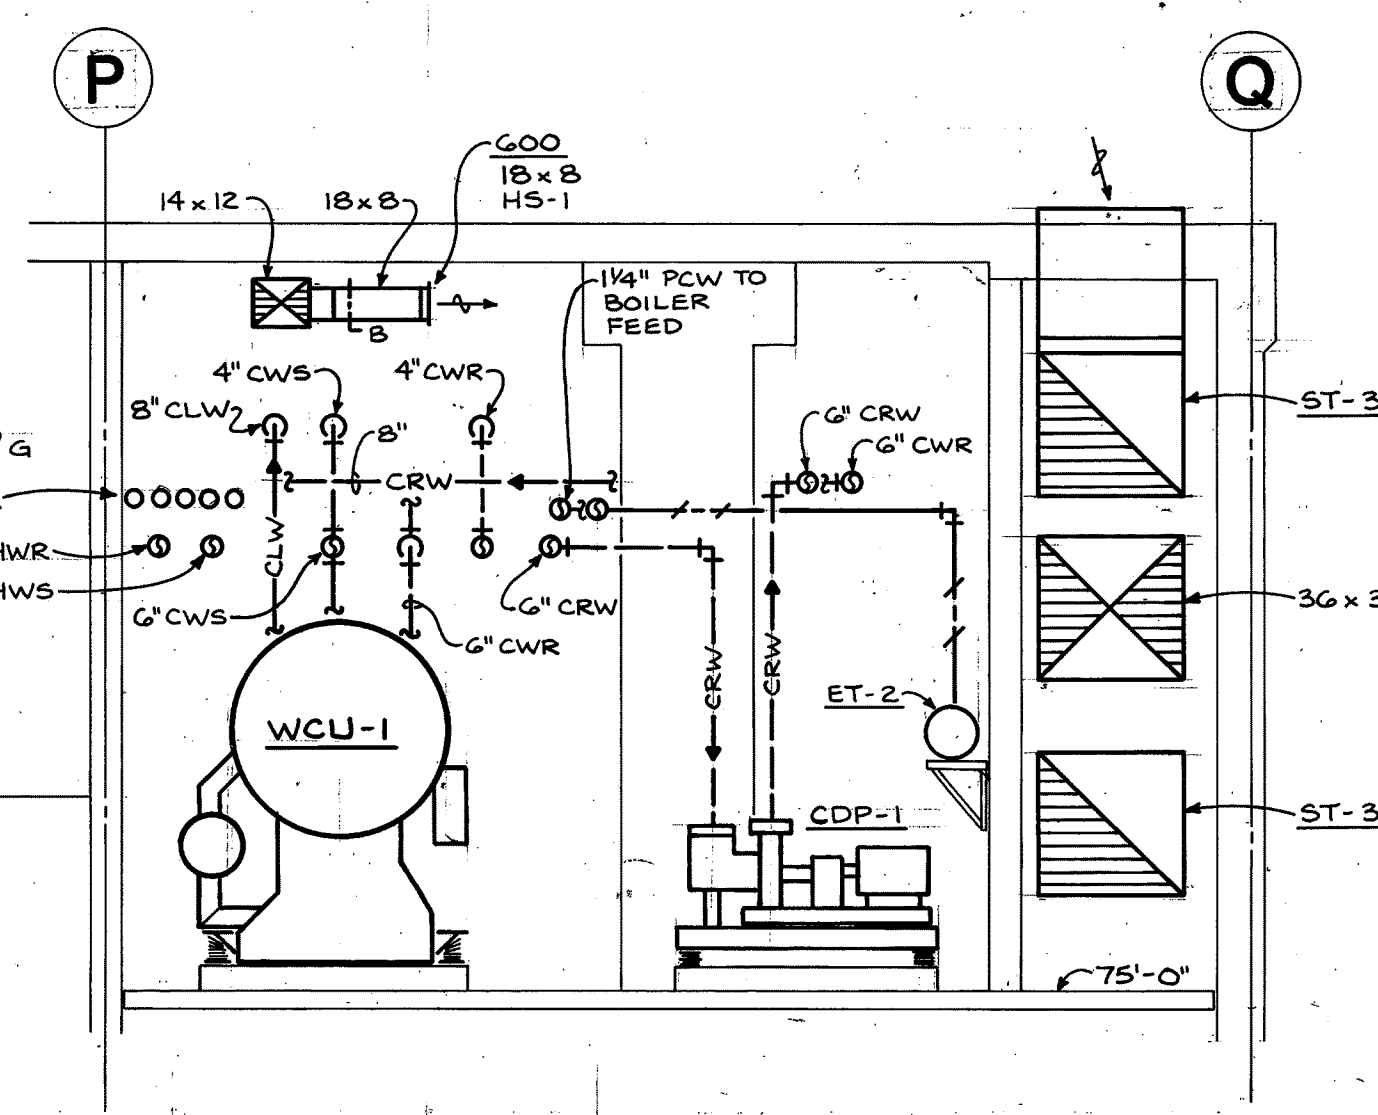


6 SECTION - CHILLER ROOM  
1/4" = 1'-0"

The City of Portland









Honorable Mildred A. Schwab  
Commissioner in Charge  
Ronald K. Ragen  
Chairman  
Performing Arts Center Committee

Architects  
Broome, Oringdolph, O'Toole, Rudolf & Associates pc  
ELS Design Group  
Barton Myers  
Project Address  
733 N.W. 20th Avenue  
Portland, Oregon 97209  
(503) 226-1575

Consultants  
Theatre Projects Inc.  
Theatre Consultants  
R. Lawrence Kirkegaard & Associates  
Acoustician  
CH2M Hill  
Structural Engineers  
C.W. Timmer Associates  
Mechanical Engineers  
Interface Engineering Inc.  
Electrical Engineers

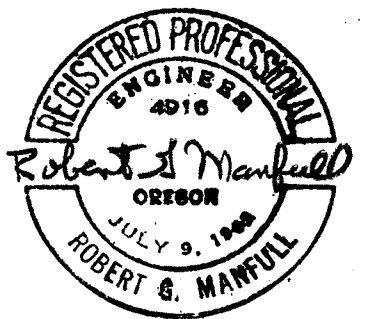

Target	Revision Item	Revision Date
▲	Addendum #1	10/29/84
▲	Addendum #2	11/06/84
▲	Addendum #4	11/13/84
▲	Addendum #5	11/21/84
▲	Proposal Request #1	03/01/85
▲	Proposal Request #2	03/01/85
▲	Proposal Request #3	03/01/85
▲	Proposal Request #4	03/01/85
▲	Proposal Request #5	03/08/85
▲	Proposal Request #6	03/01/85
▲	Proposal Request #7	03/01/85
▲	Proposal Request #8	03/01/85
▲	Proposal Request #9	03/01/85
▲	Proposal Request #10	03/01/85
▲	Proposal Request #11	03/01/85
▲	Proposal Request #12	03/01/85
▲	Proposal Request #13	03/01/85
▲	Proposal Request #14	03/01/85
▲	Clarification Items	03/01/85
▲	Miscellaneous Items	03/01/85

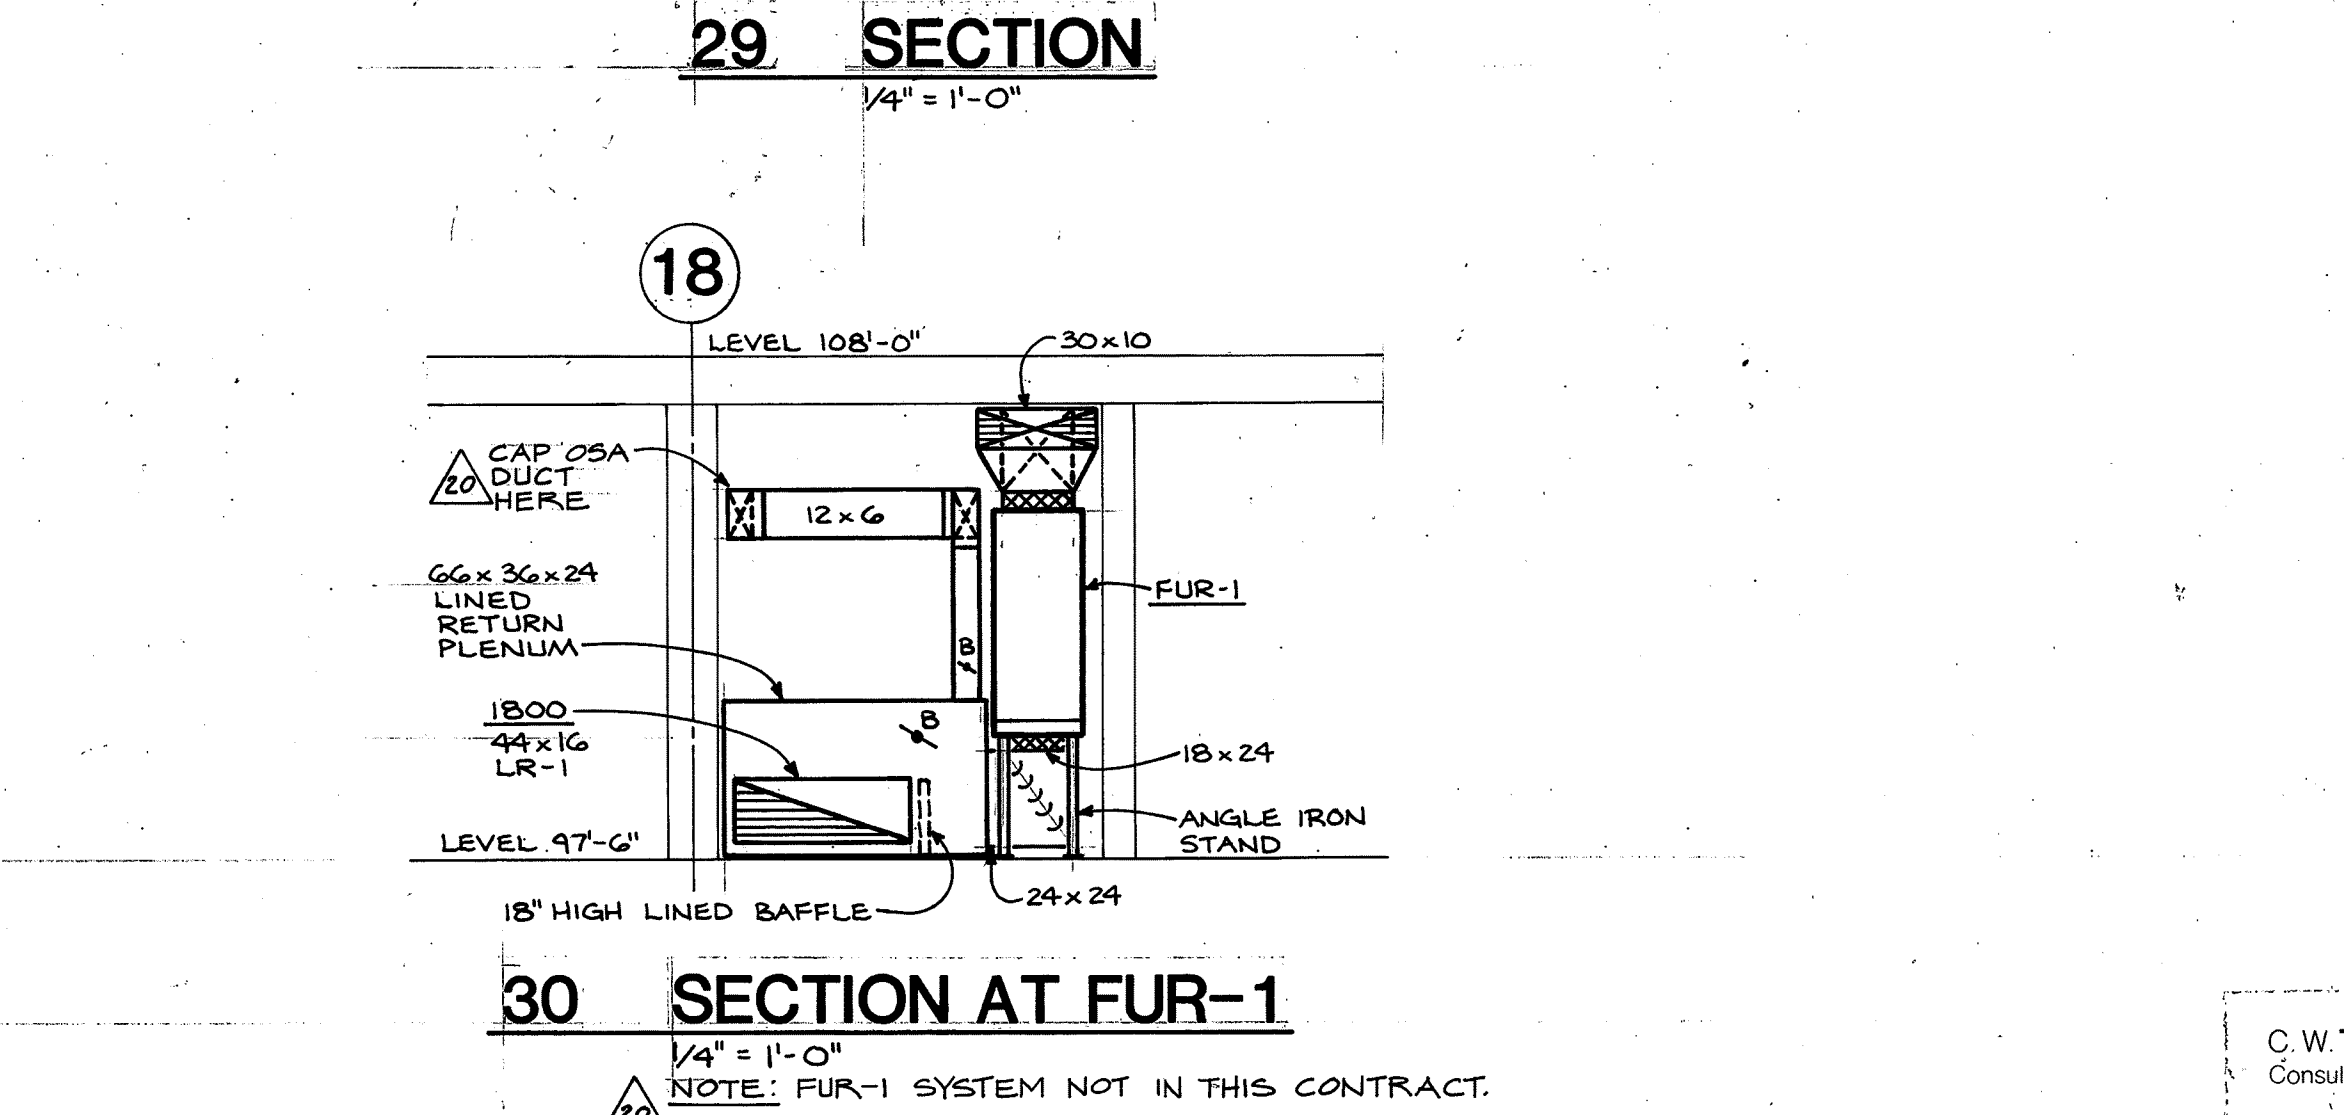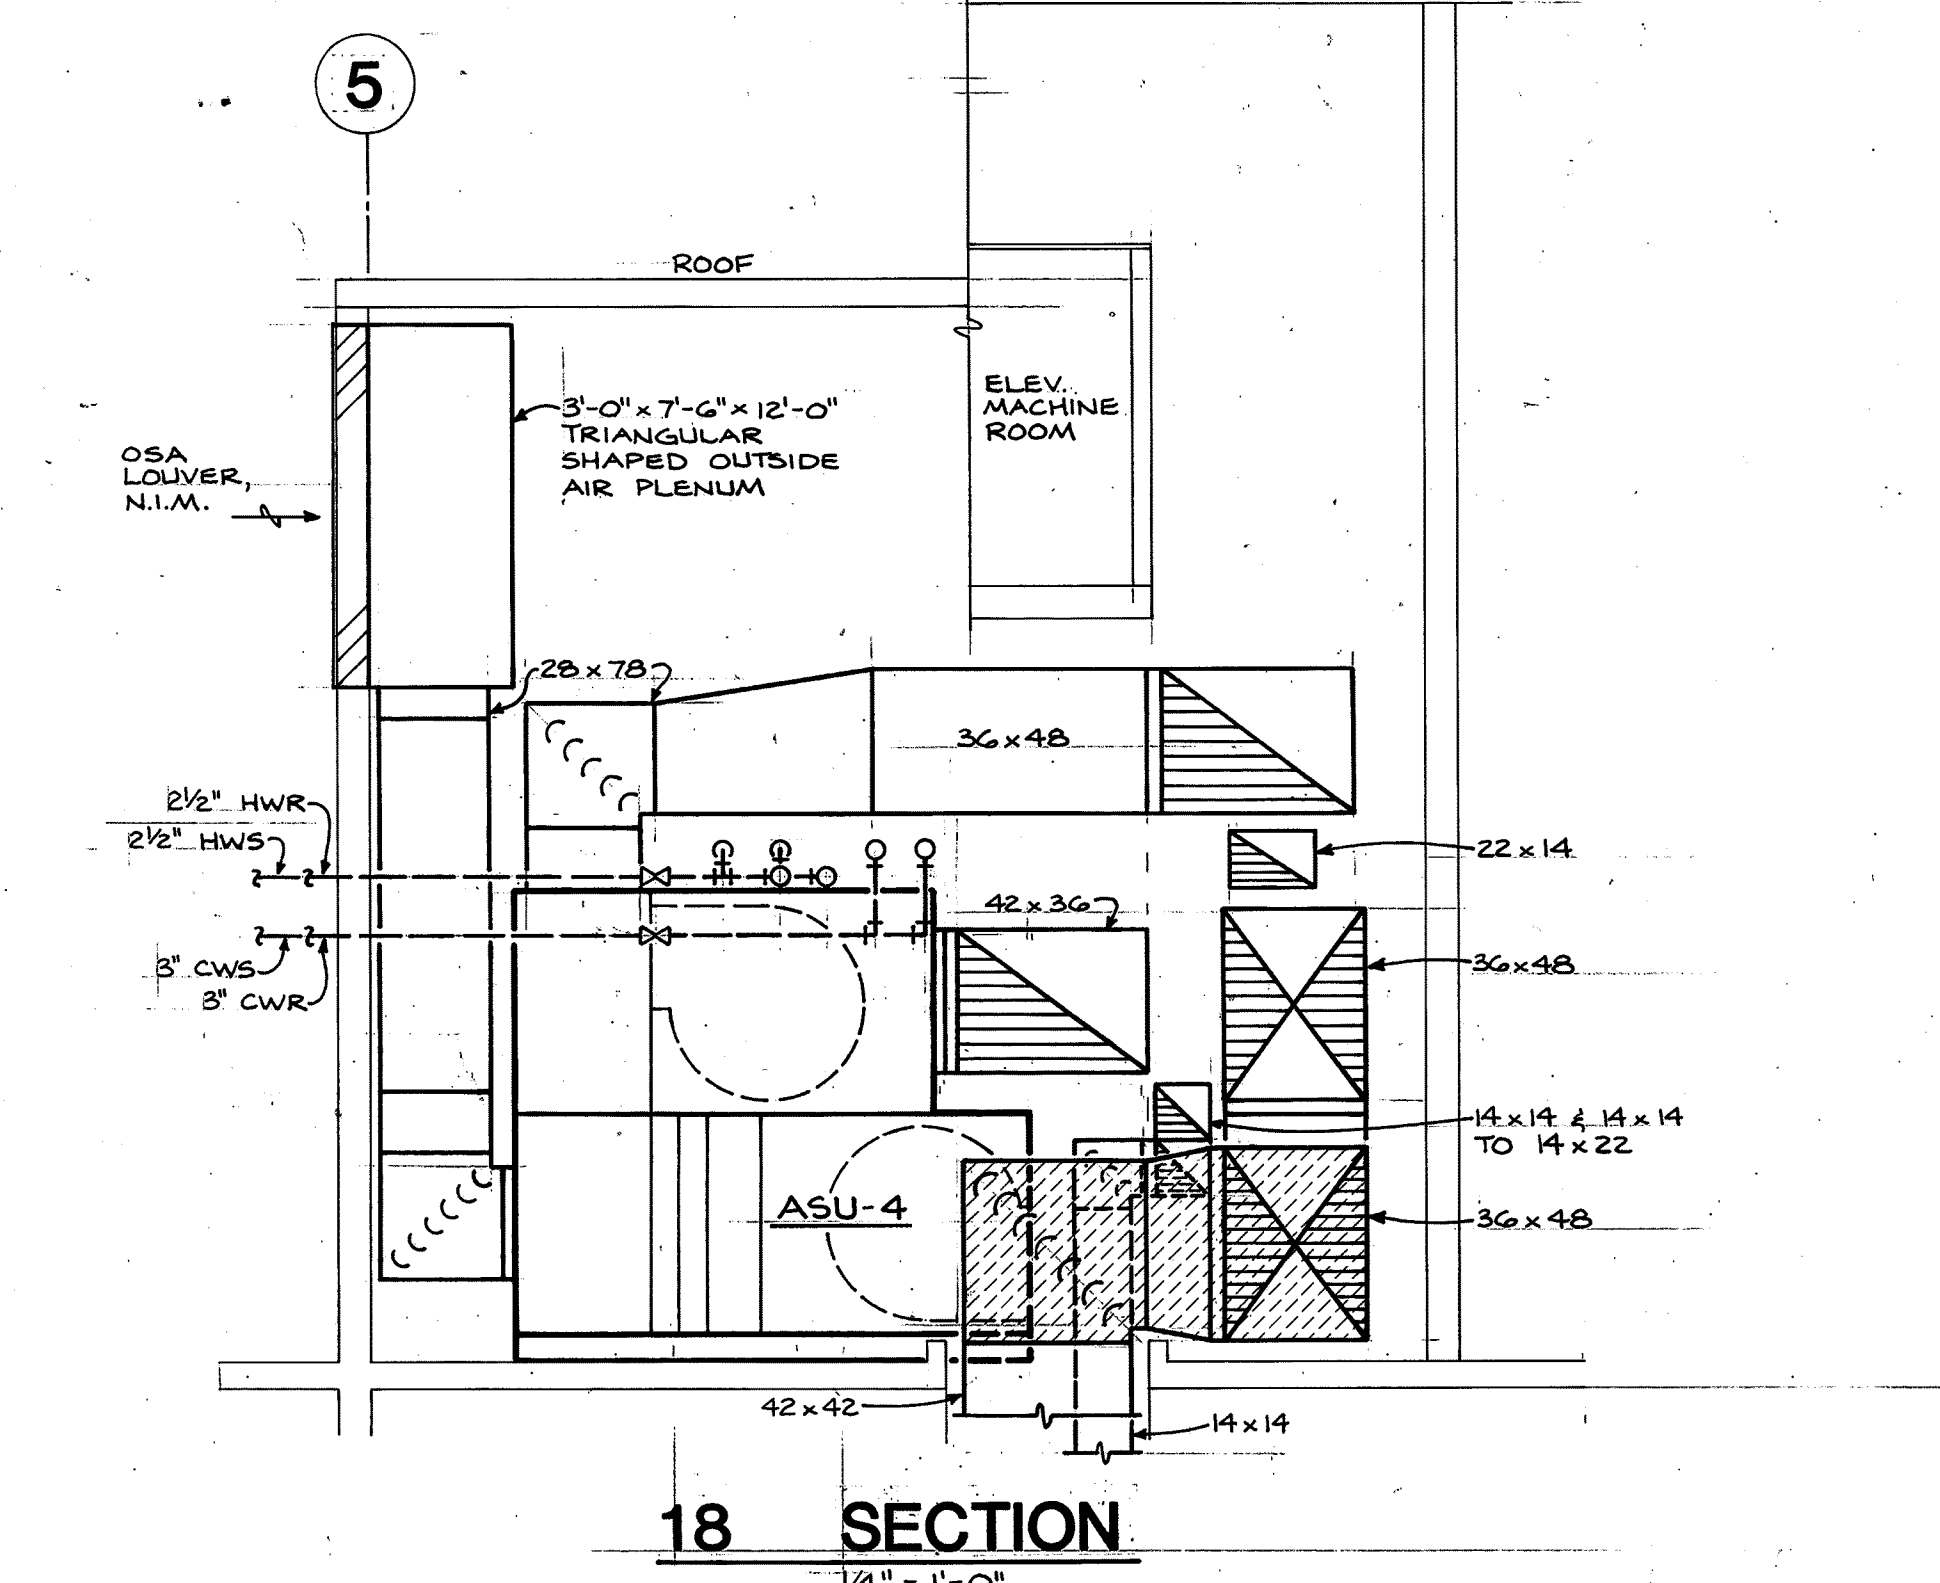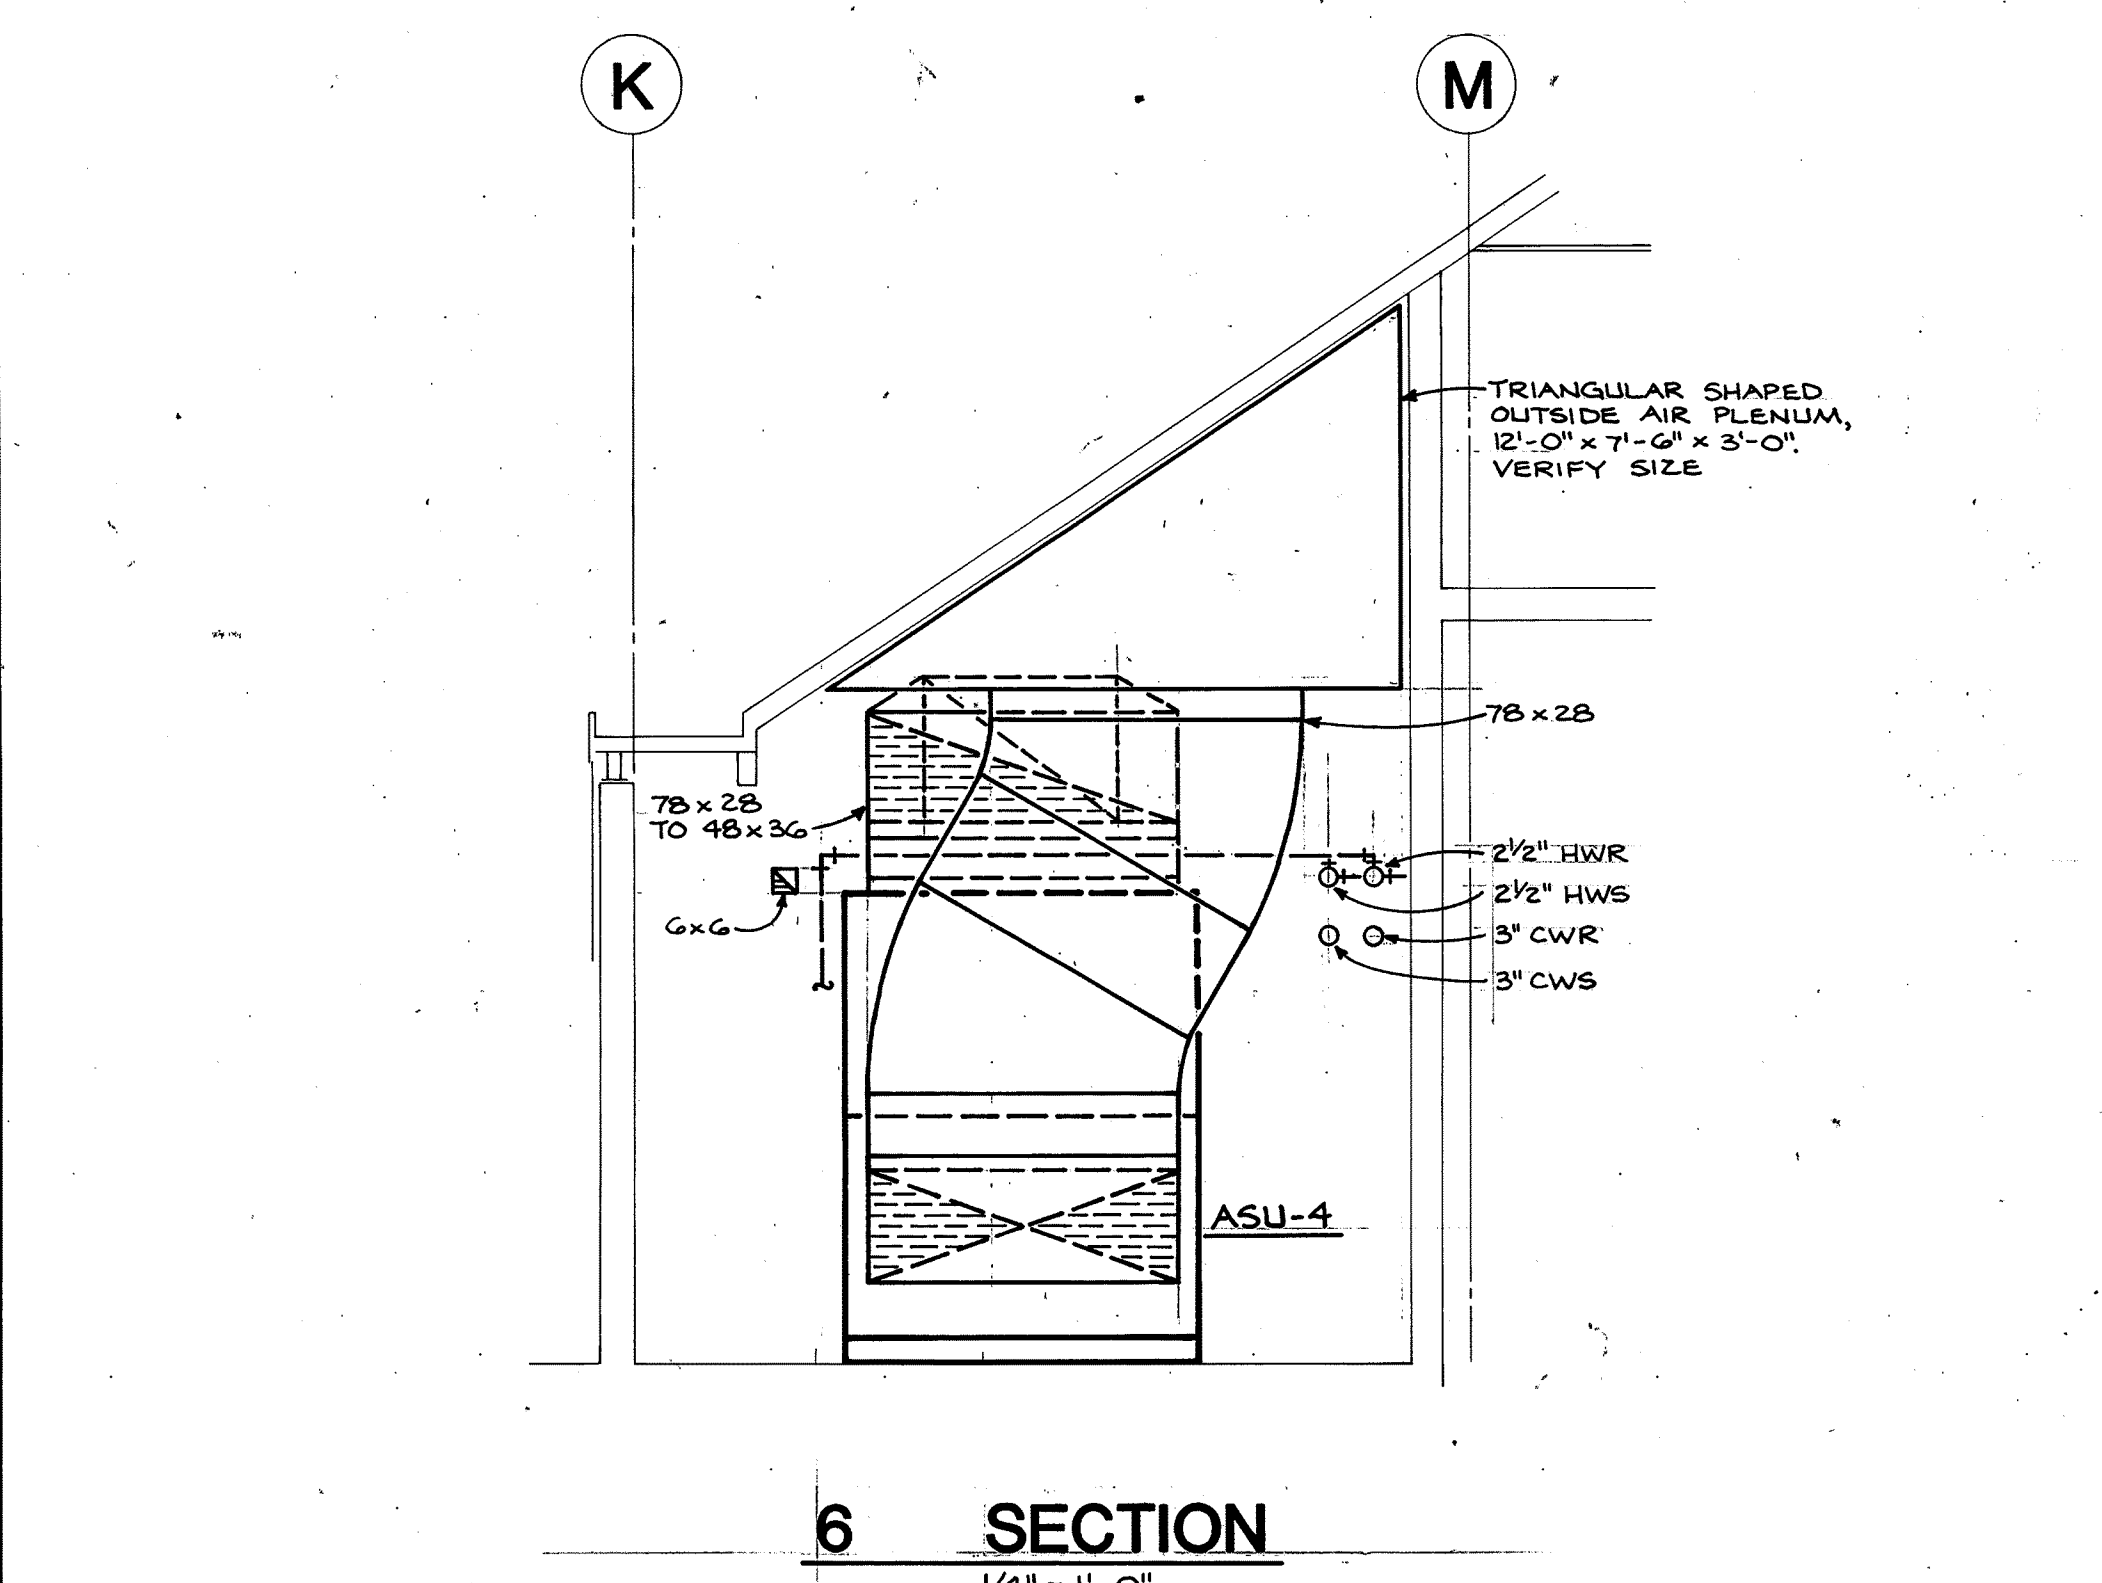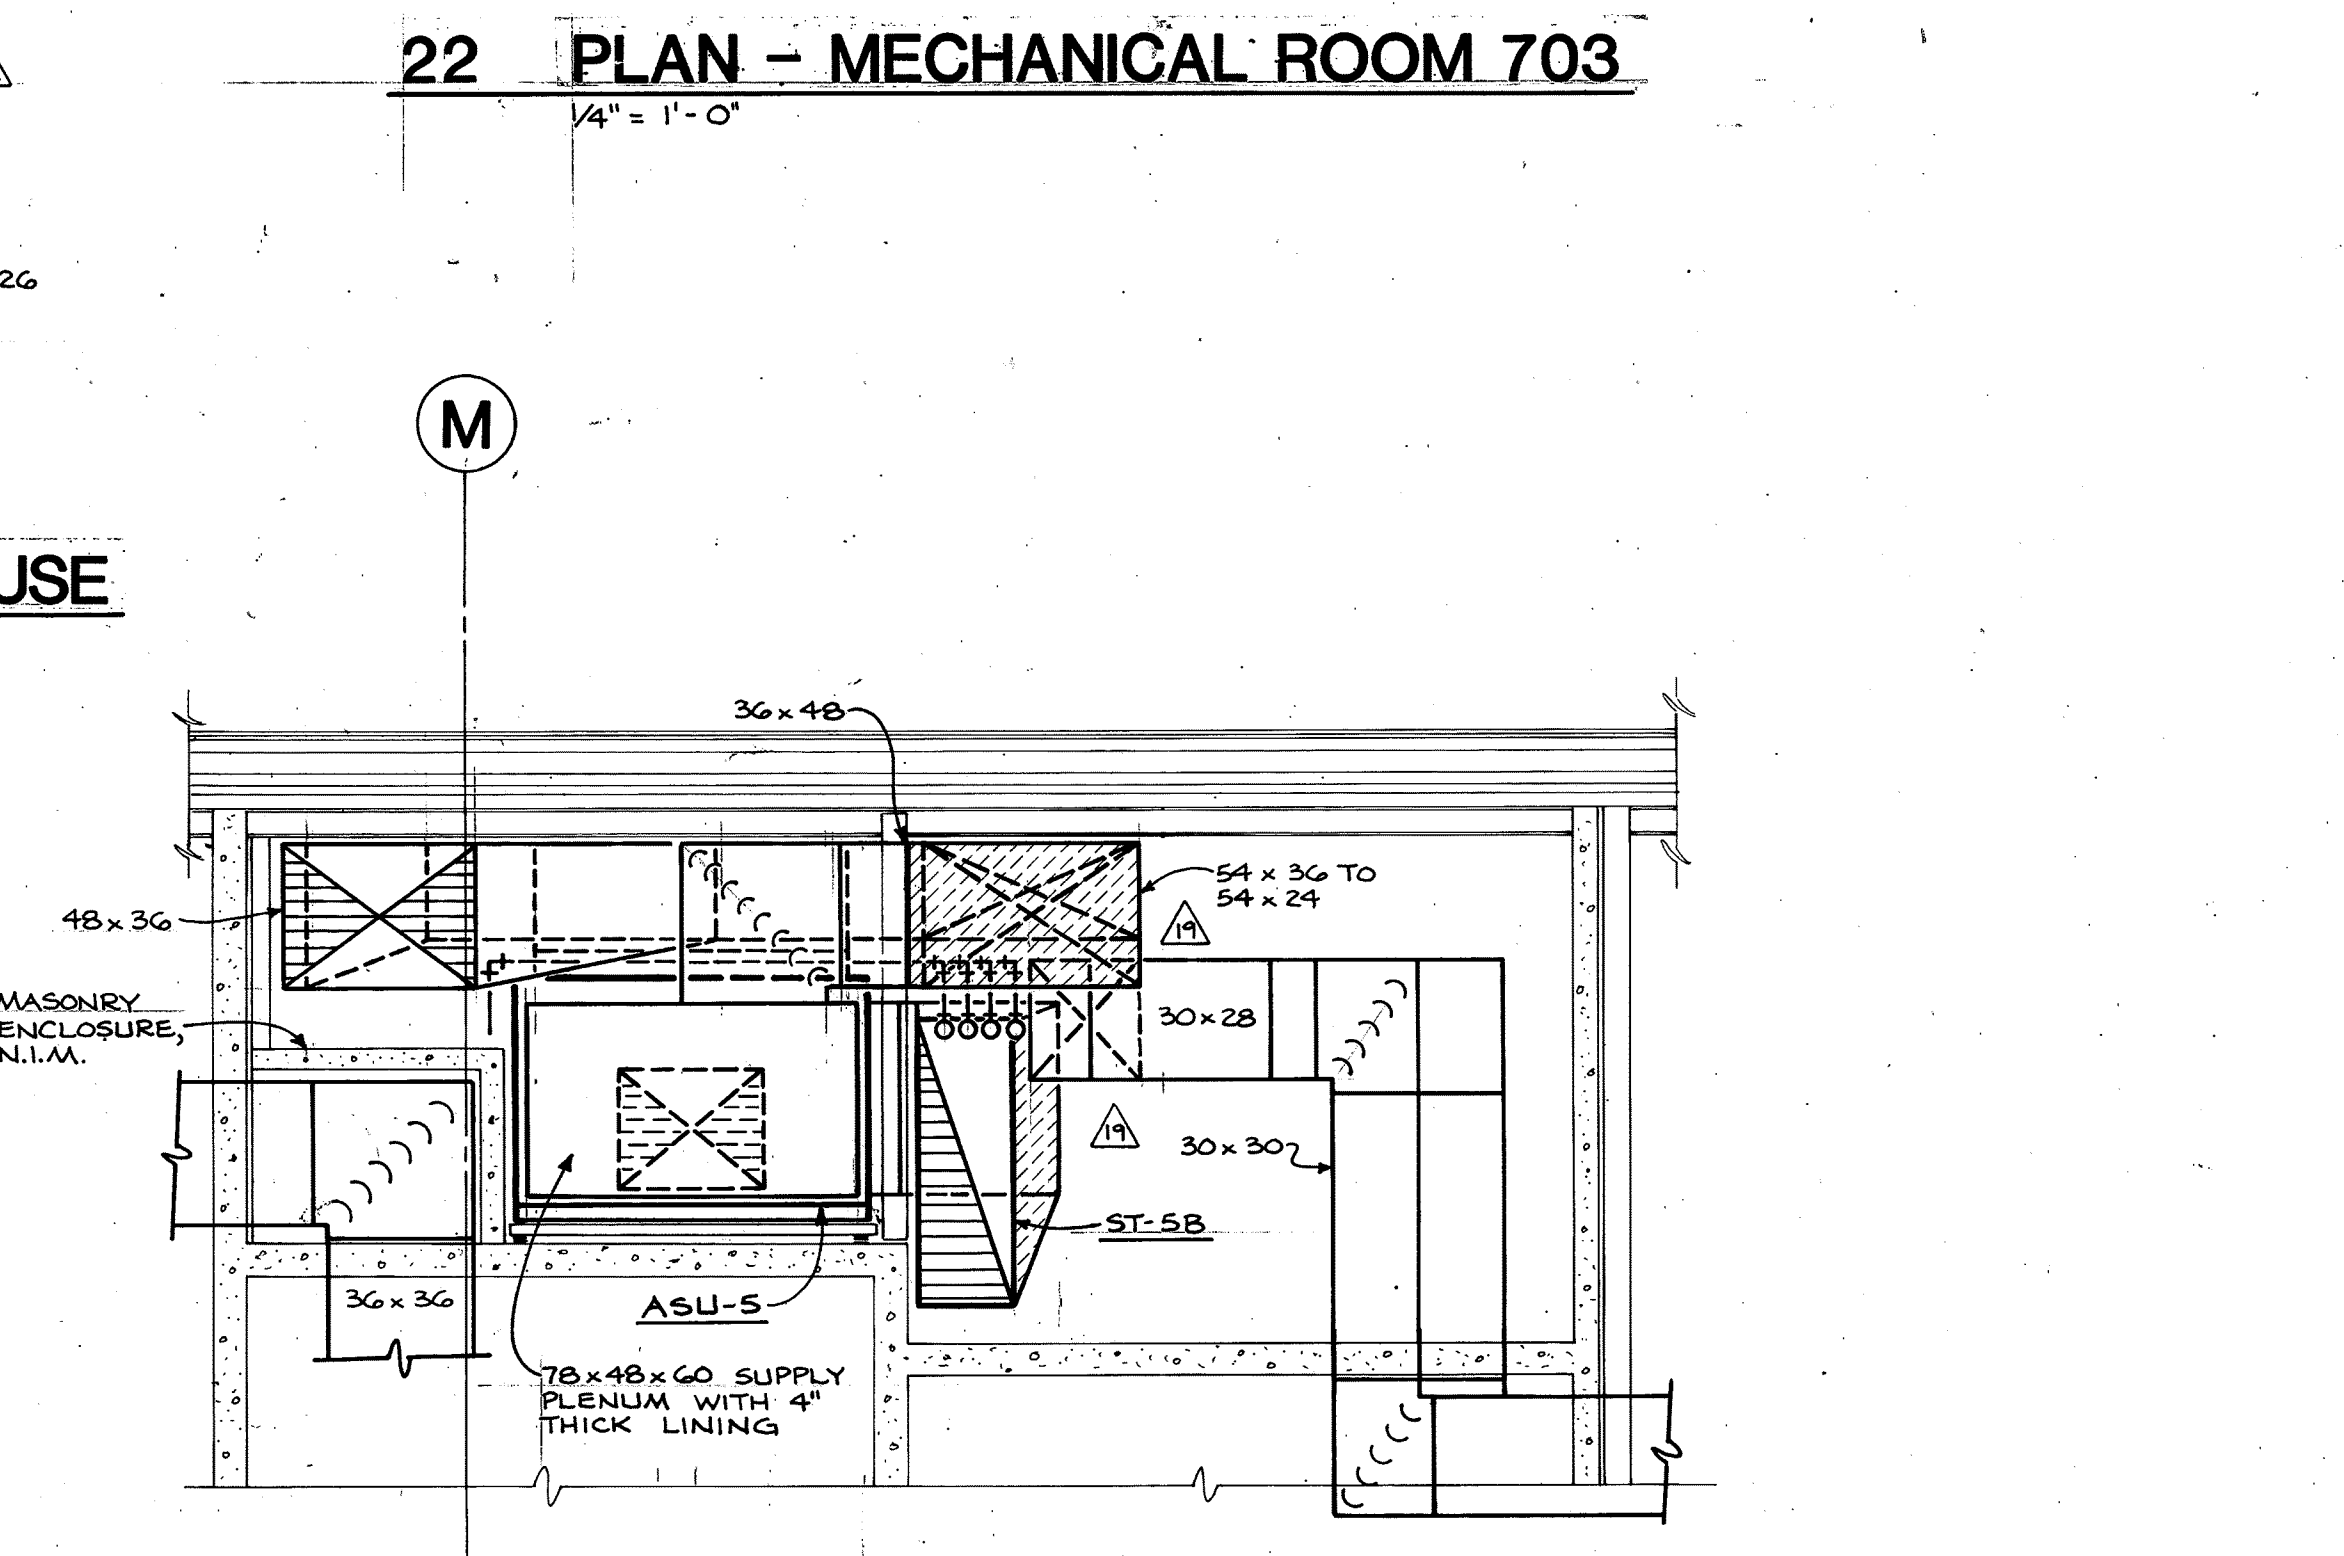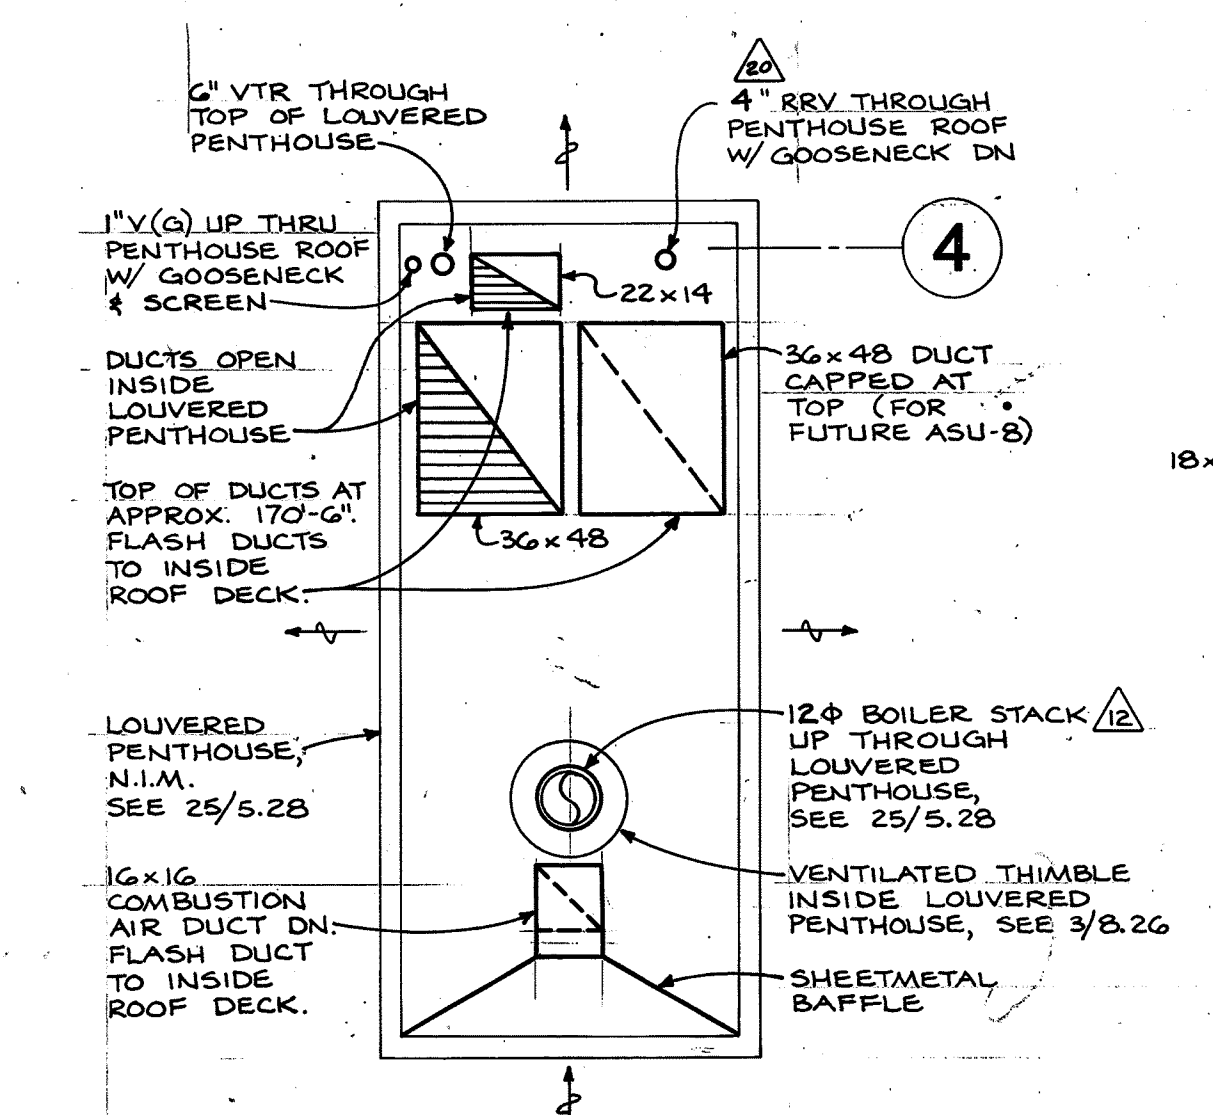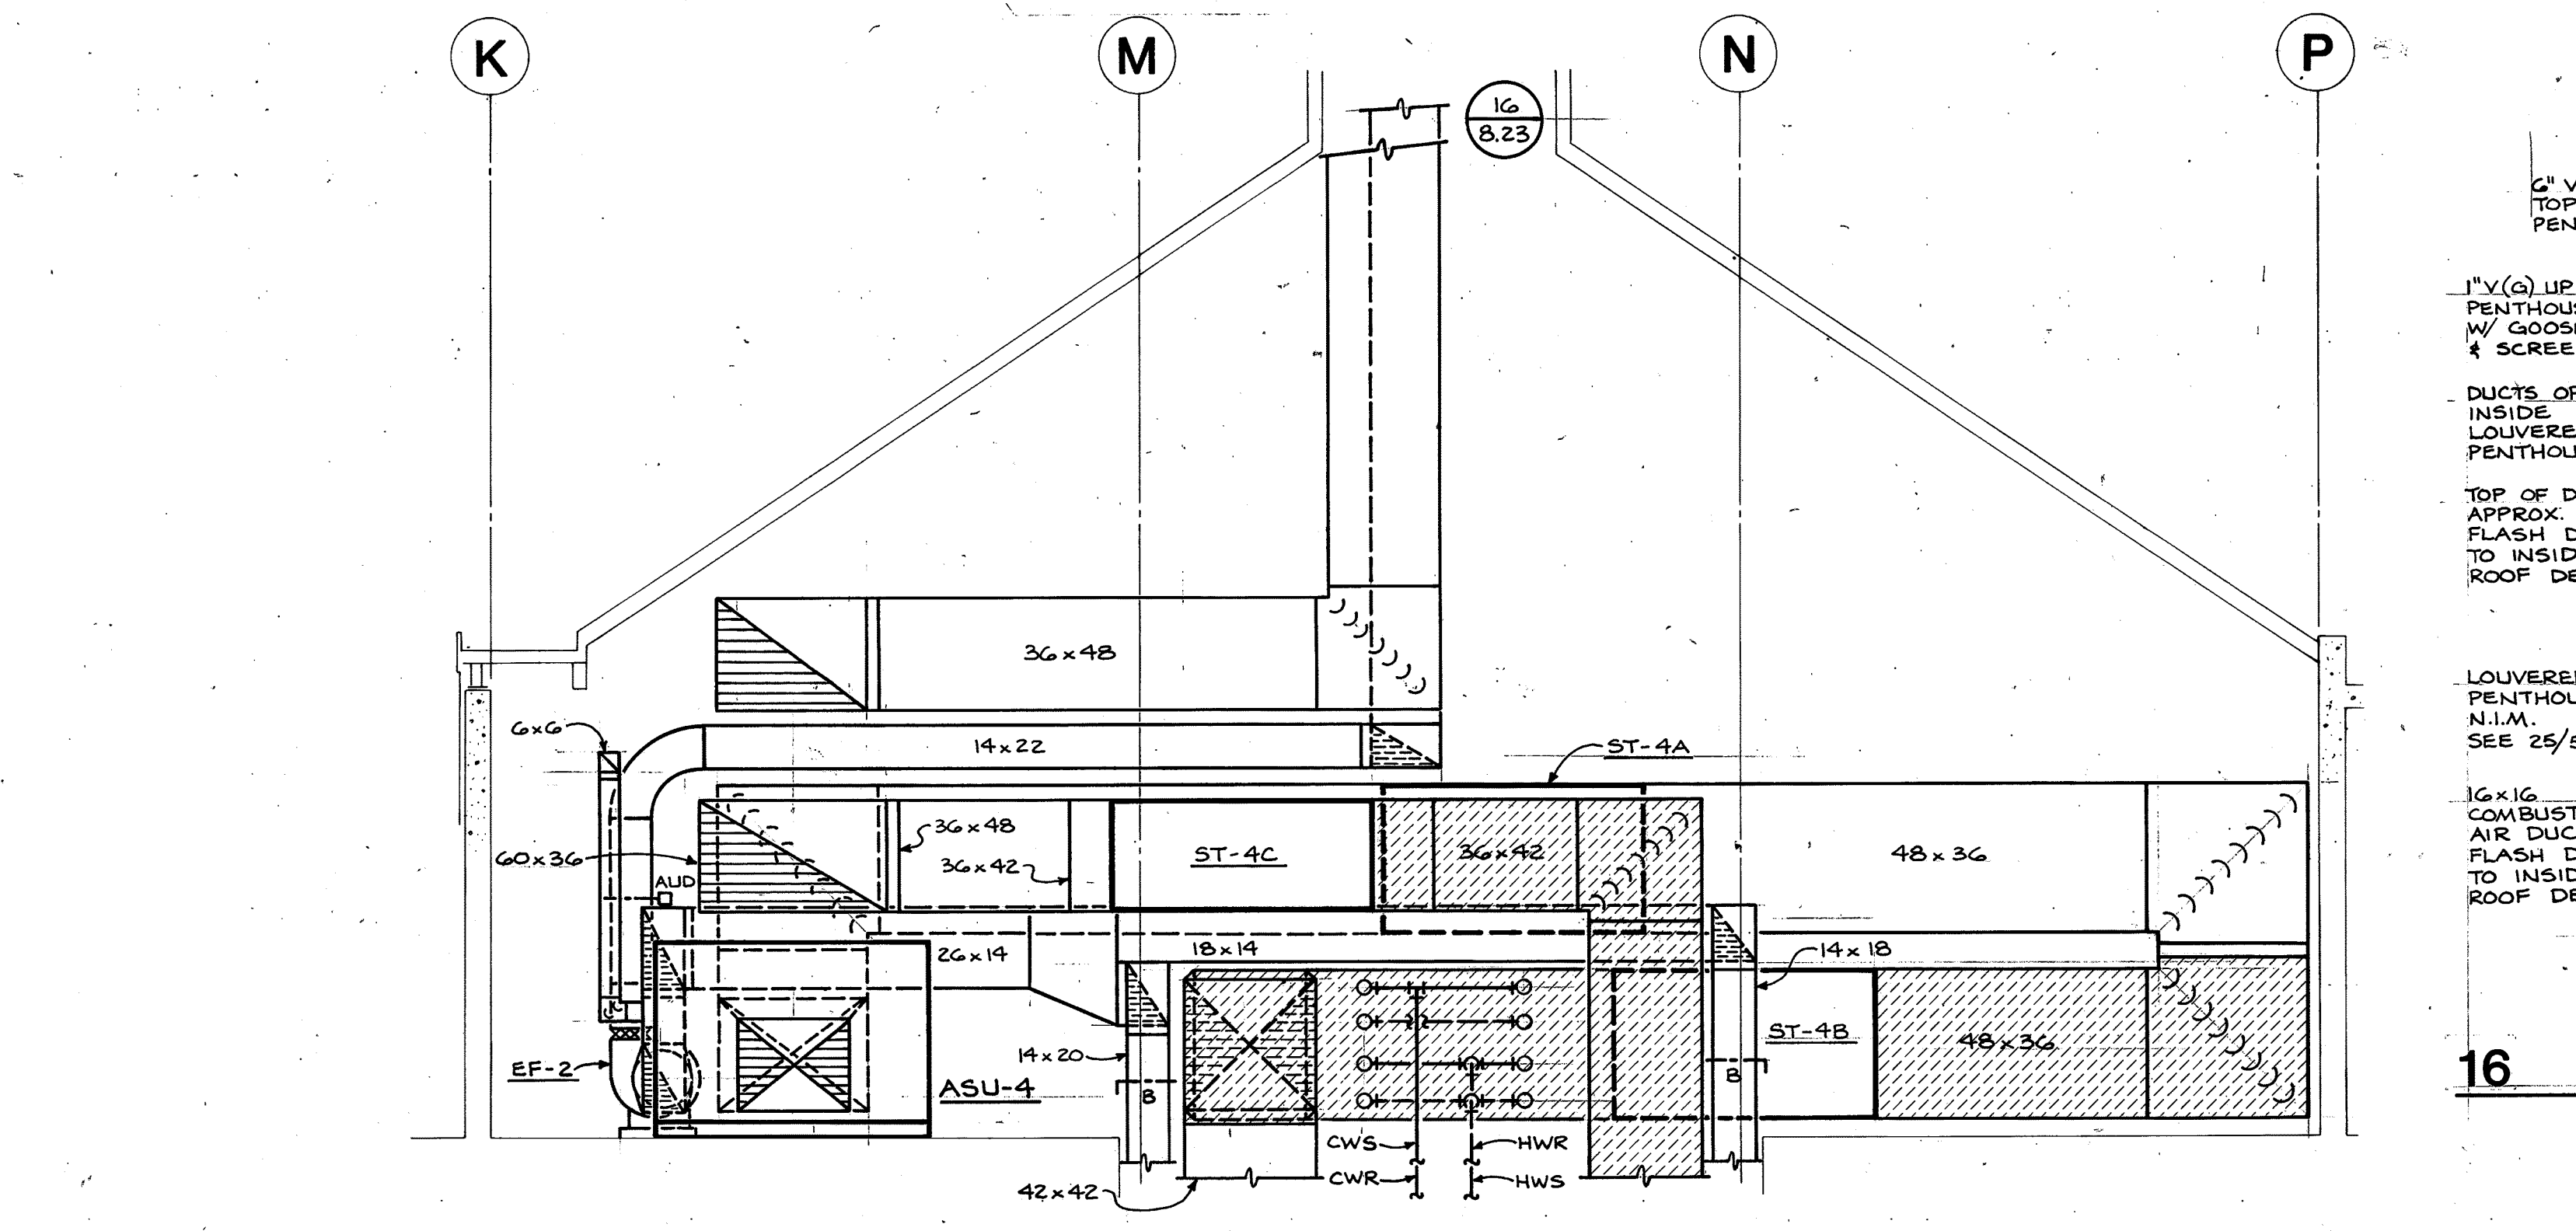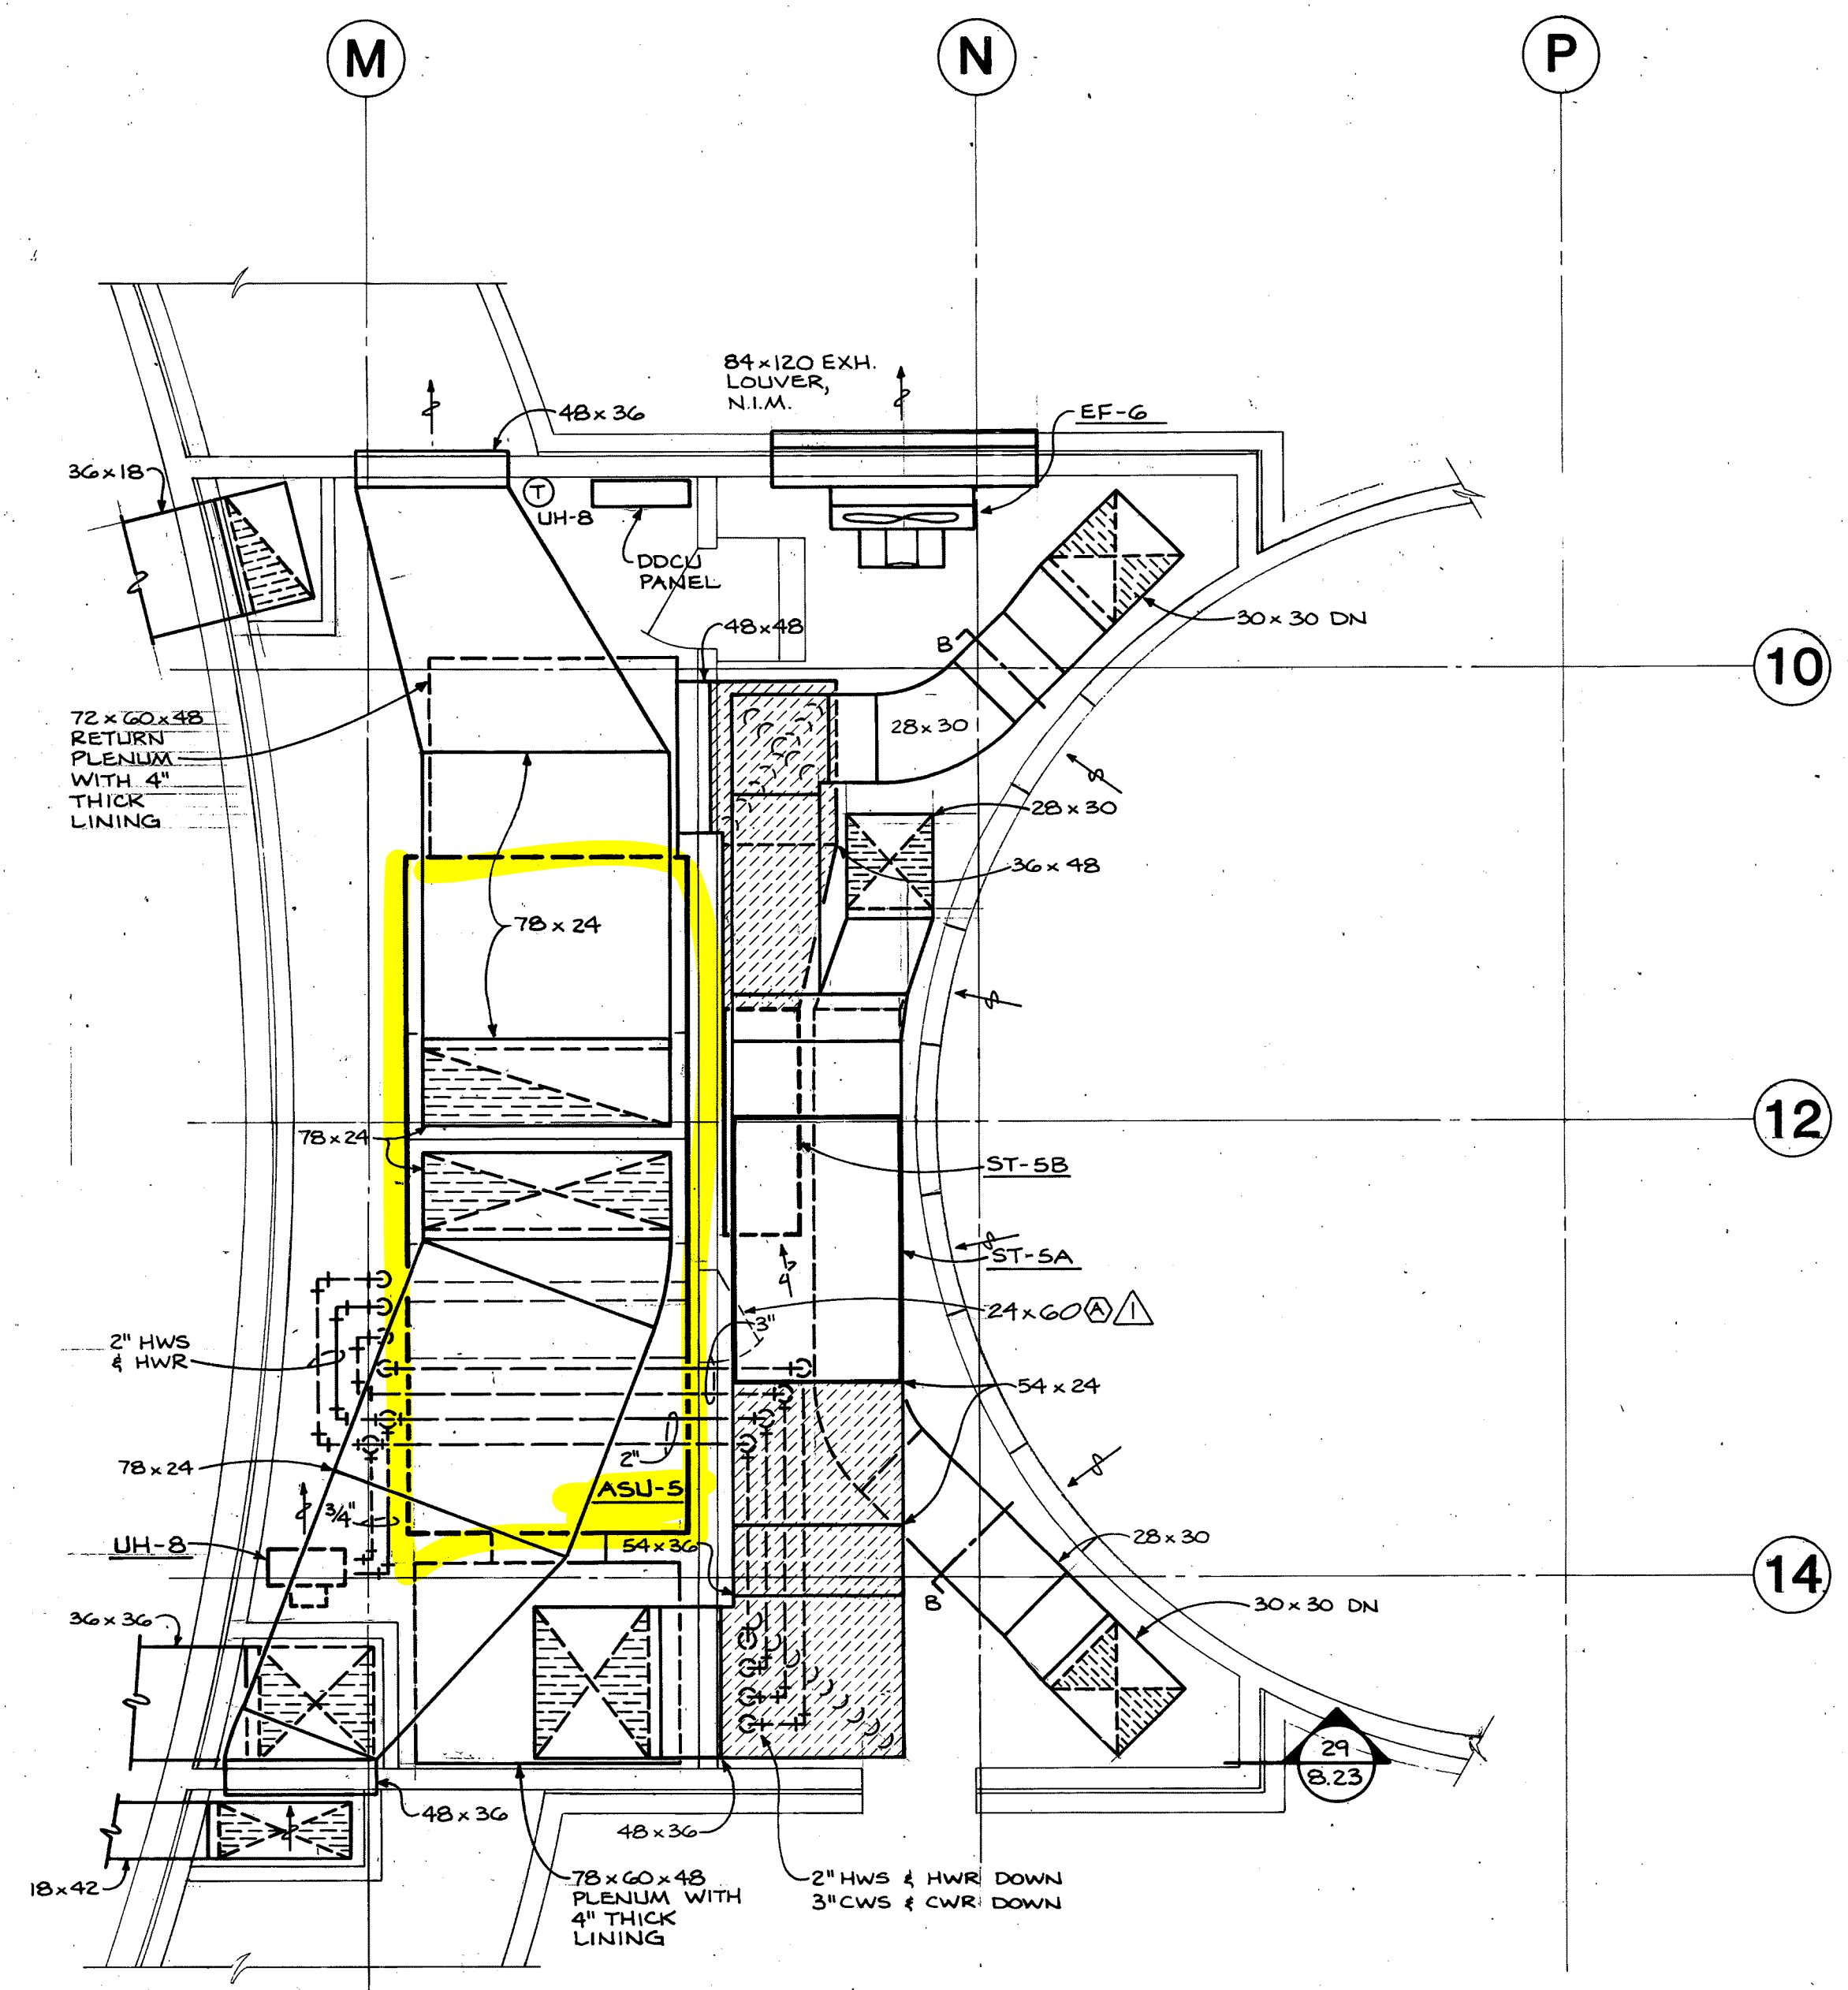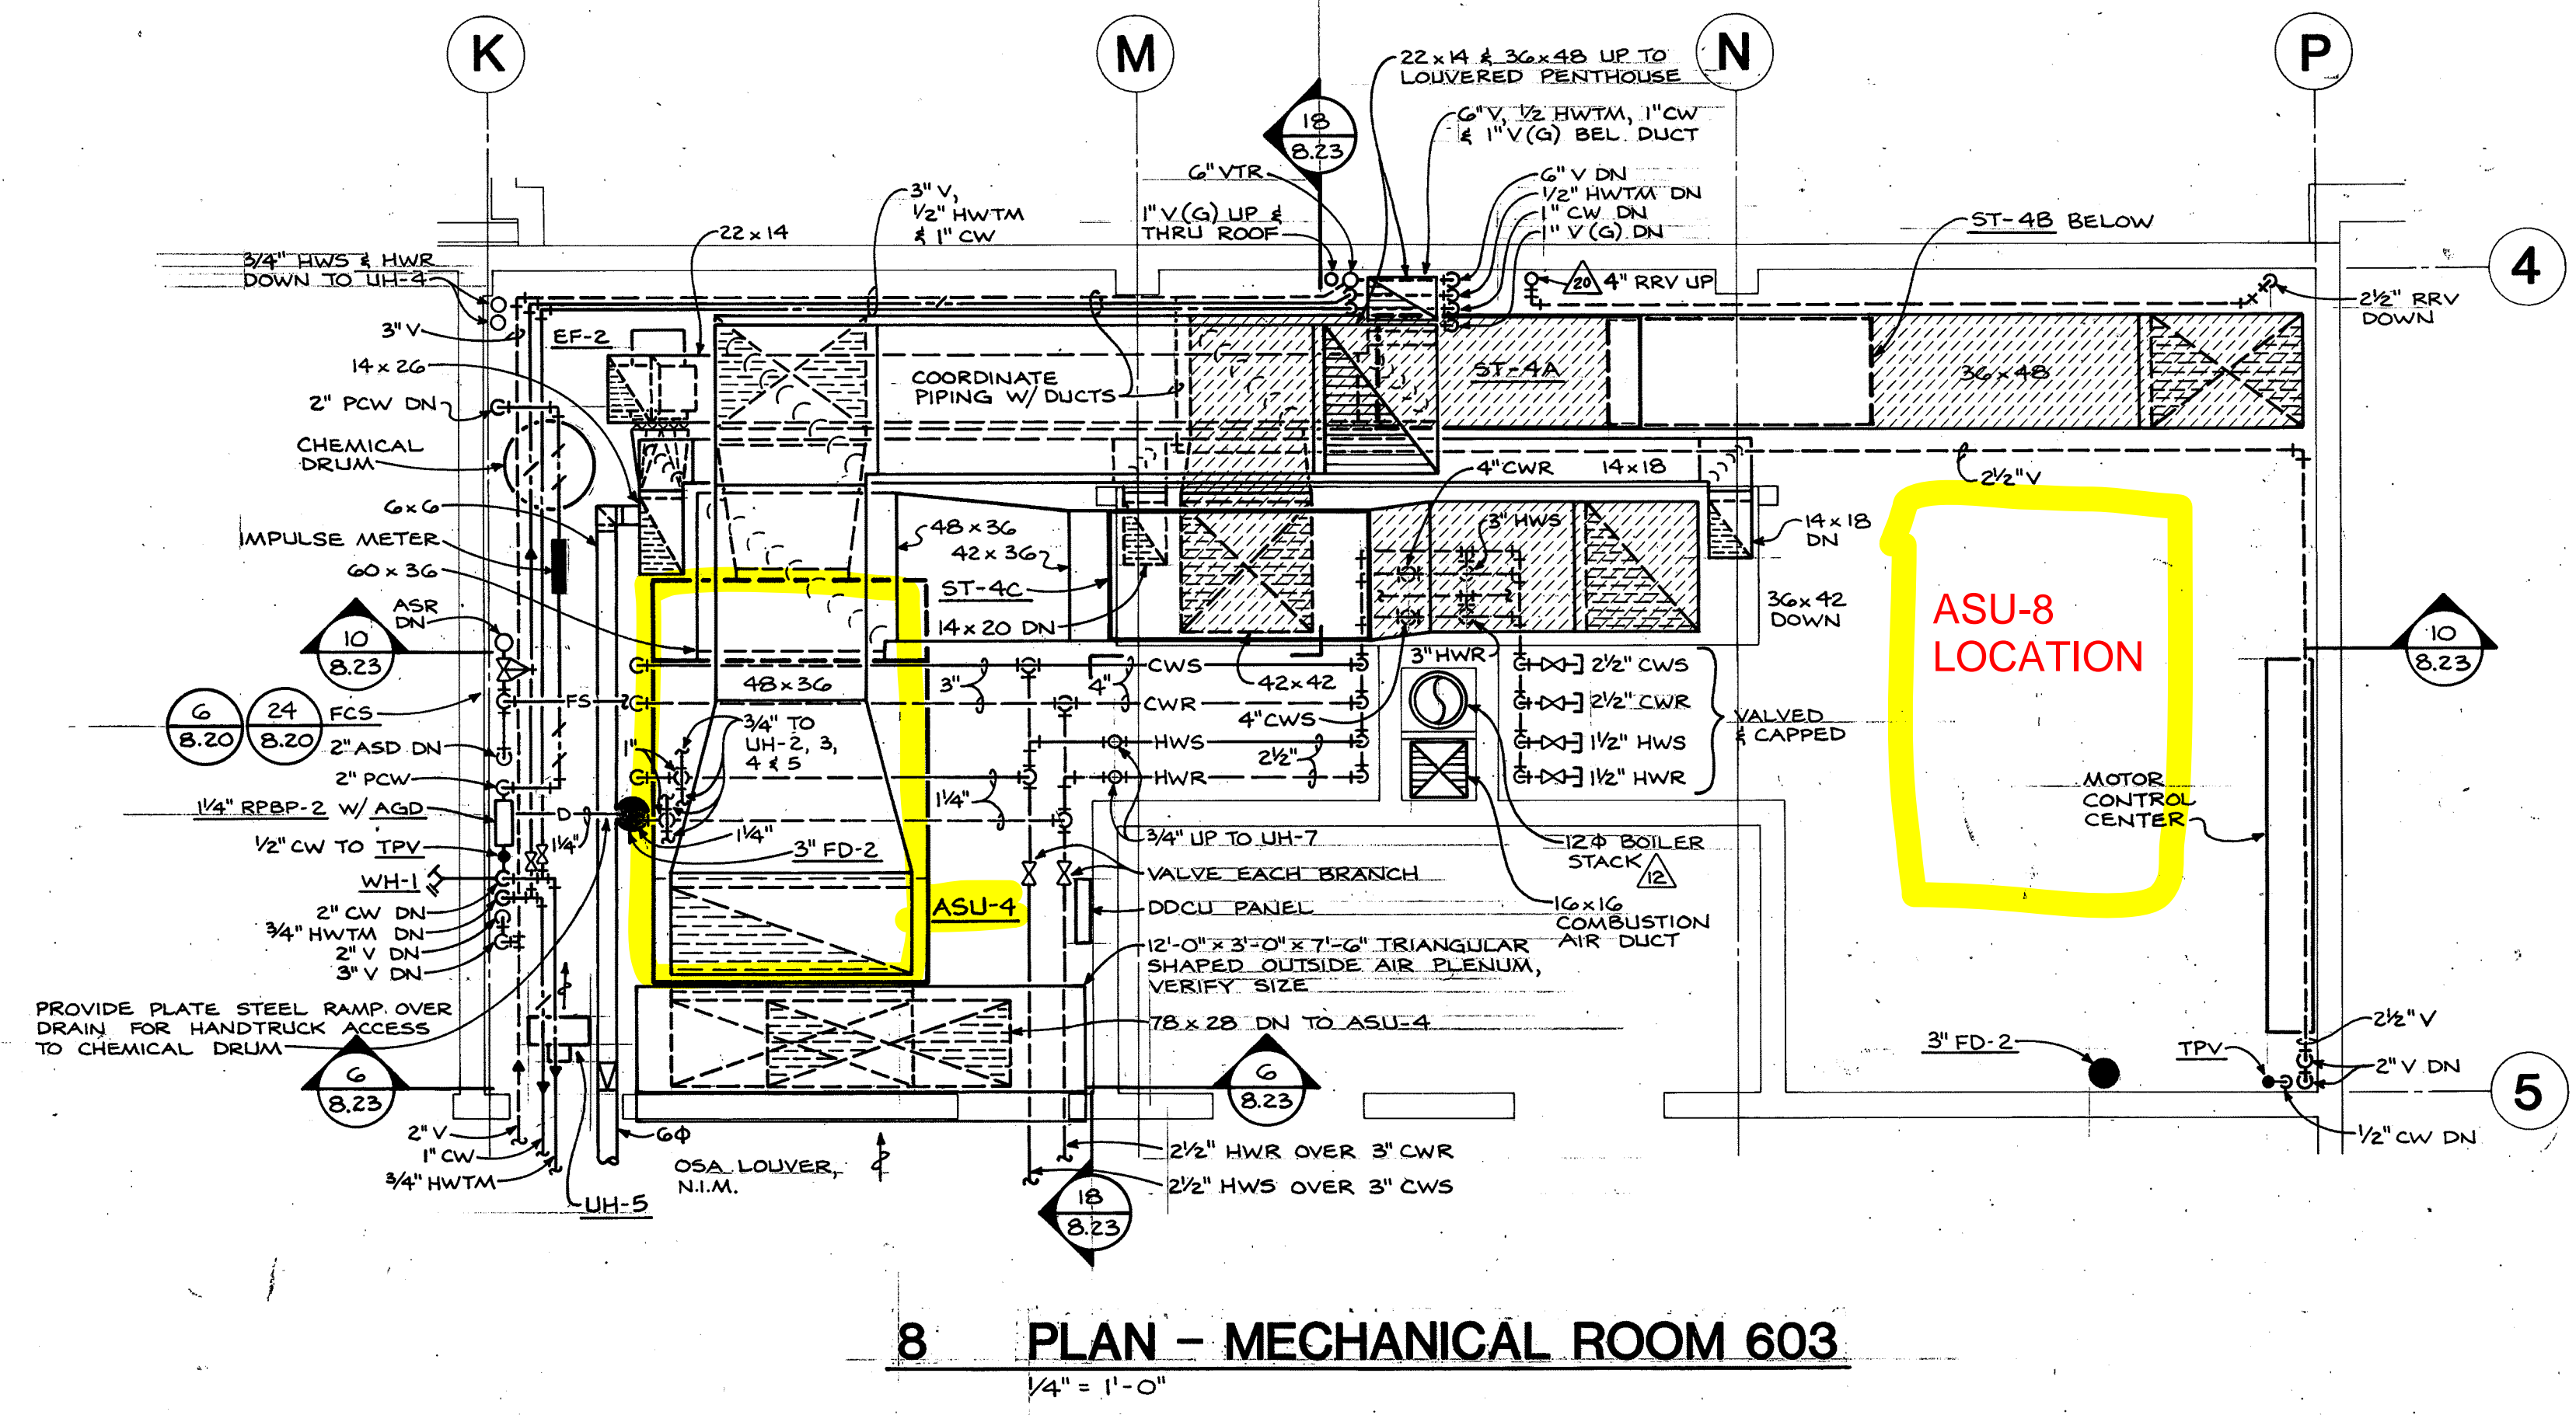


Revisions  
New Theatre Building

DETAILS  
MECHANICAL RMS


Date OCT. 12, 1984  
Scale 1/4" = 1'-0"  
Drawing No. 8.23

C. W. Timmer Associates Inc.  
Consulting Engineers  
1694-20

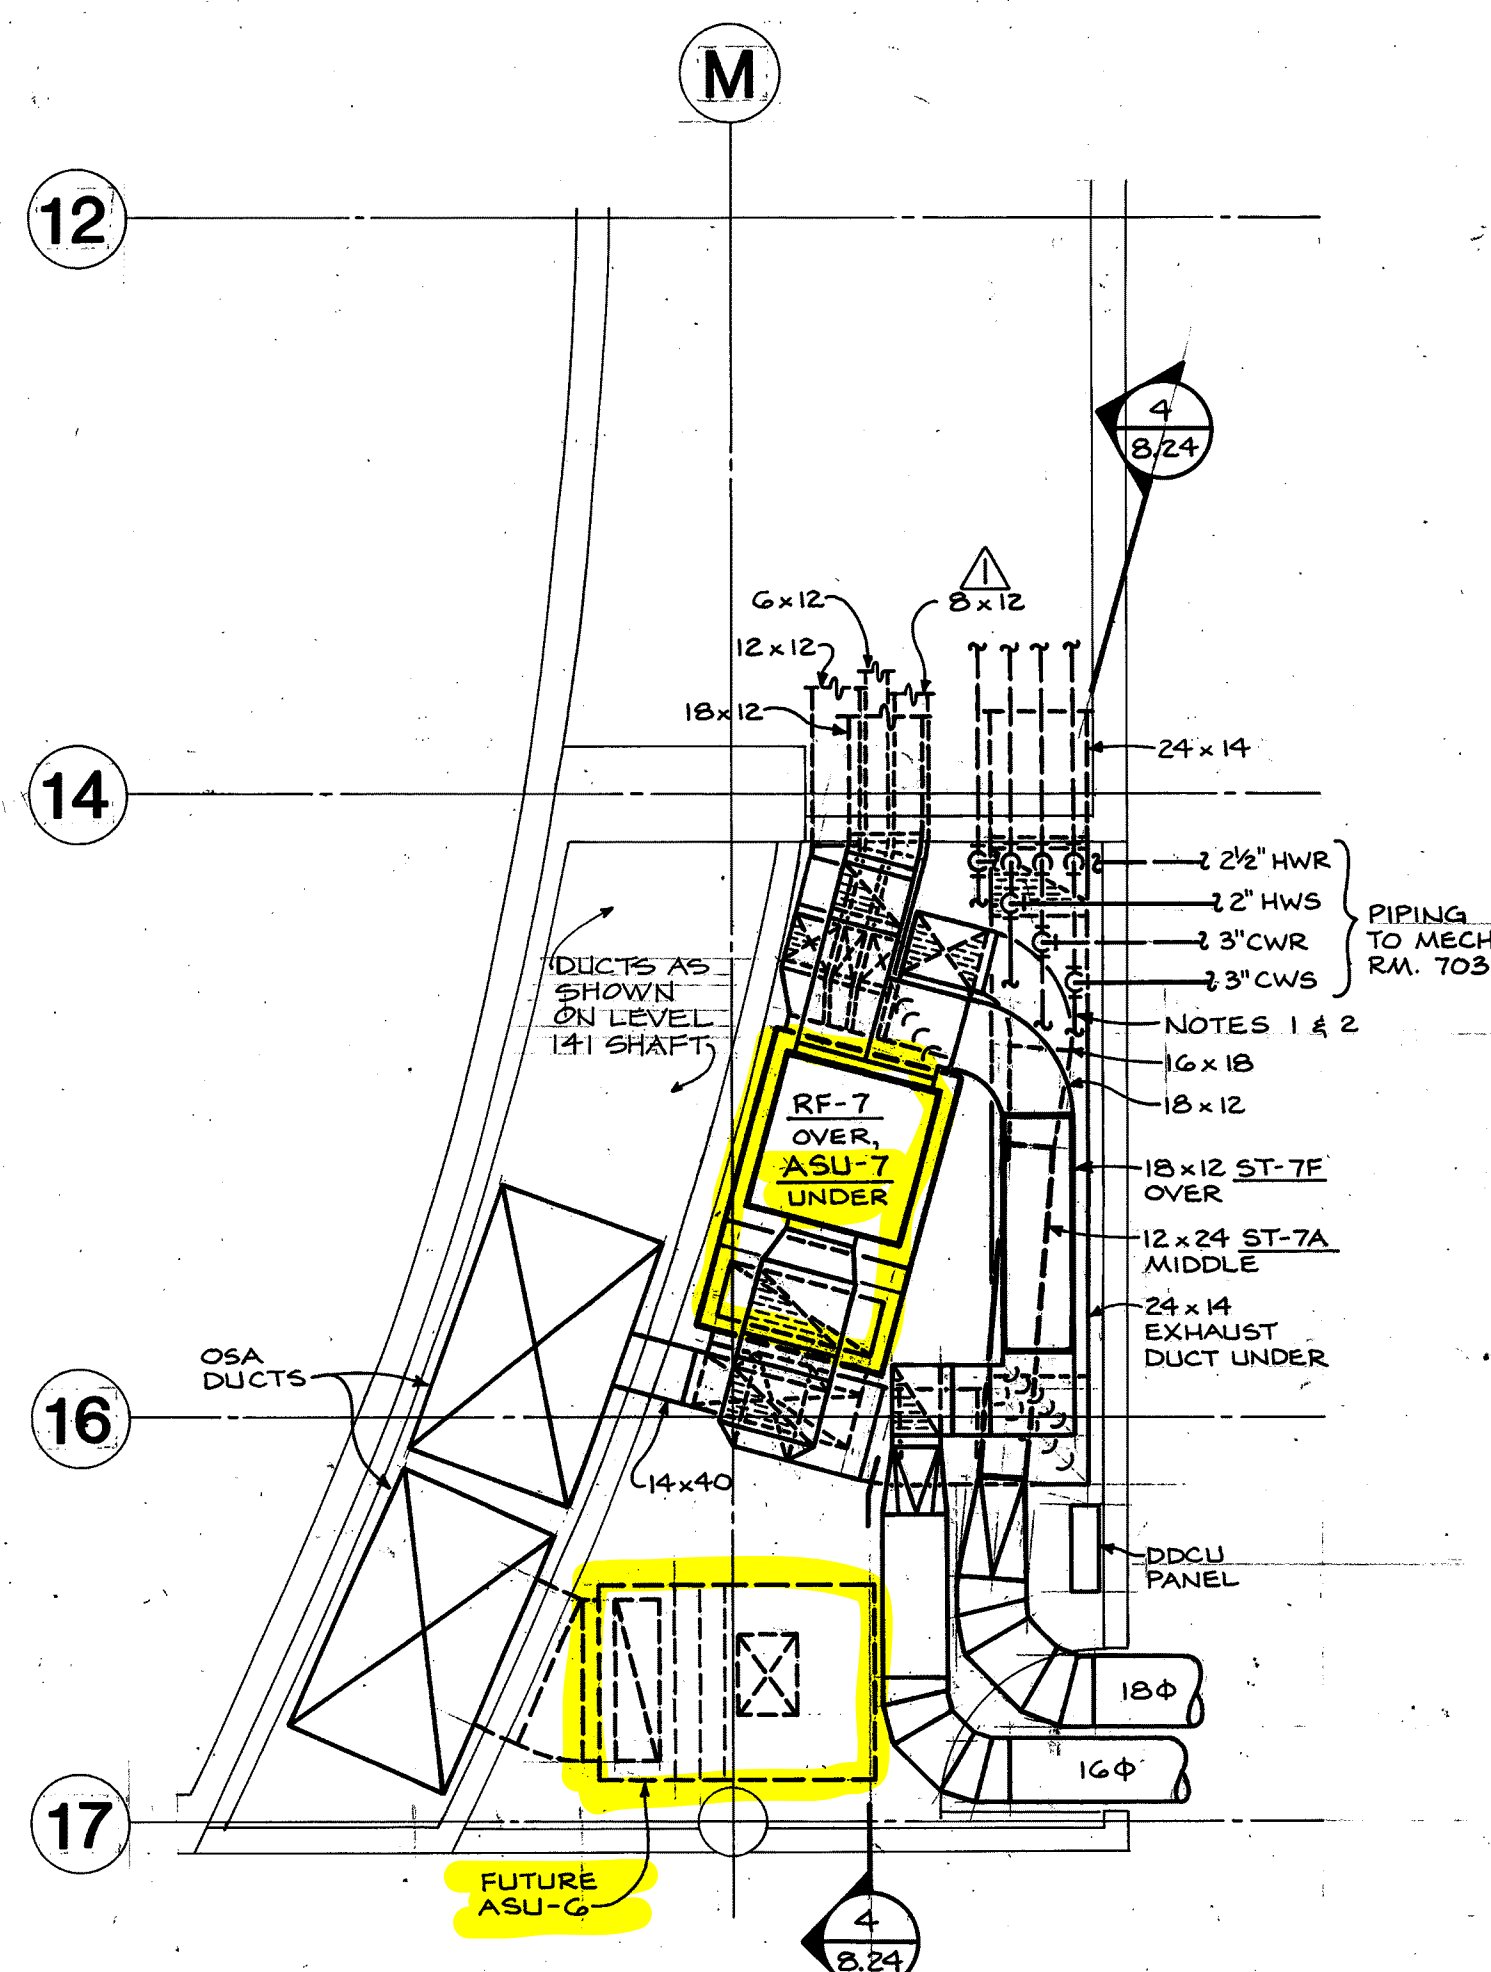


**3 PLAN - MECHANICAL ROOM 629**  
1/4" = 1'-0"


**NOTES:**  
1. 3/4" HWS & HWR. 3/4" BRANCH LINES TO ASU-7. 3/4" CAPPED BRANCH LINES TO FUTURE ASU-G.  
2. 2" CWS & CWR. 1/4" BRANCH LINES TO ASU-7. 1/4" CAPPED BRANCH LINES TO FUTURE ASU-G.

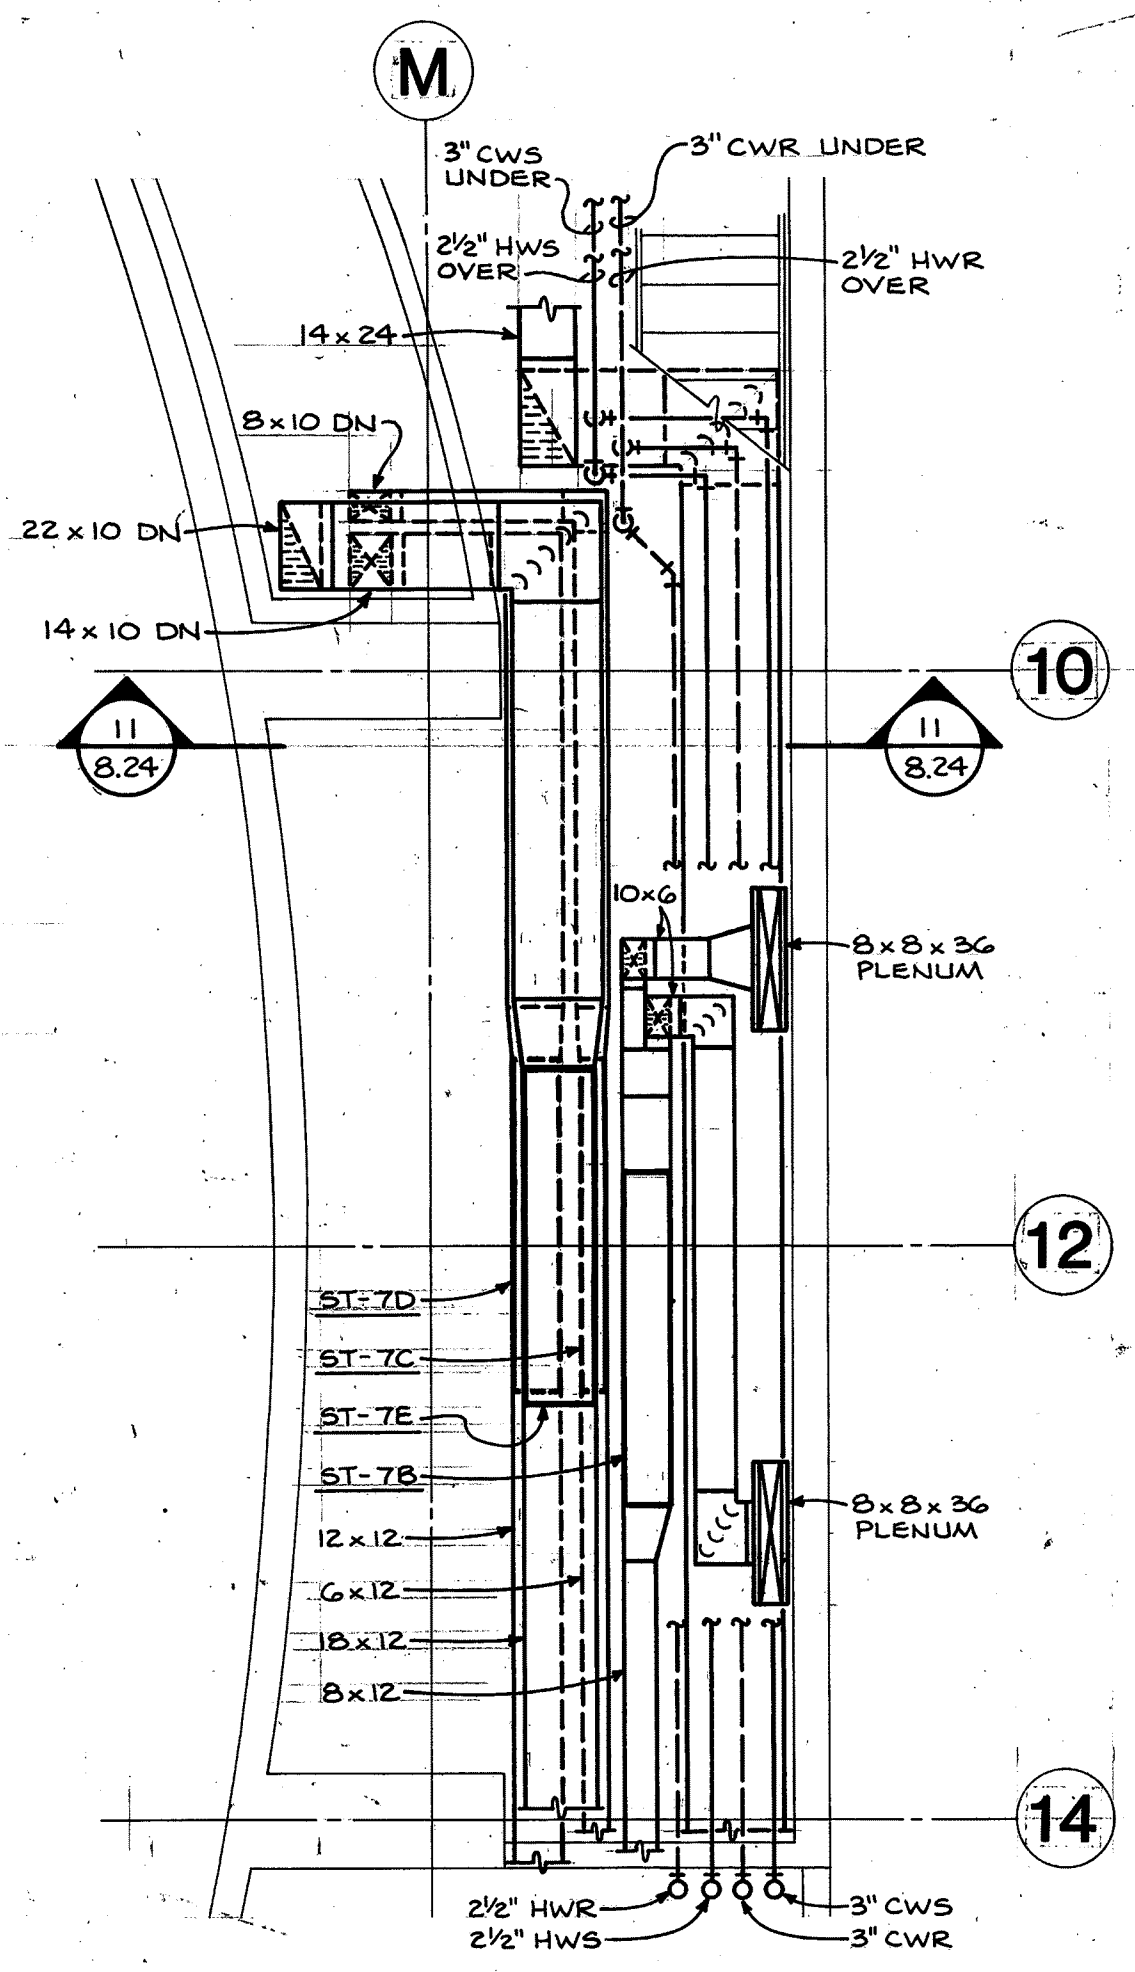


**9 PLAN - SPACE BELOW CONTROL ROOM 618**  
1/4" = 1'-0"

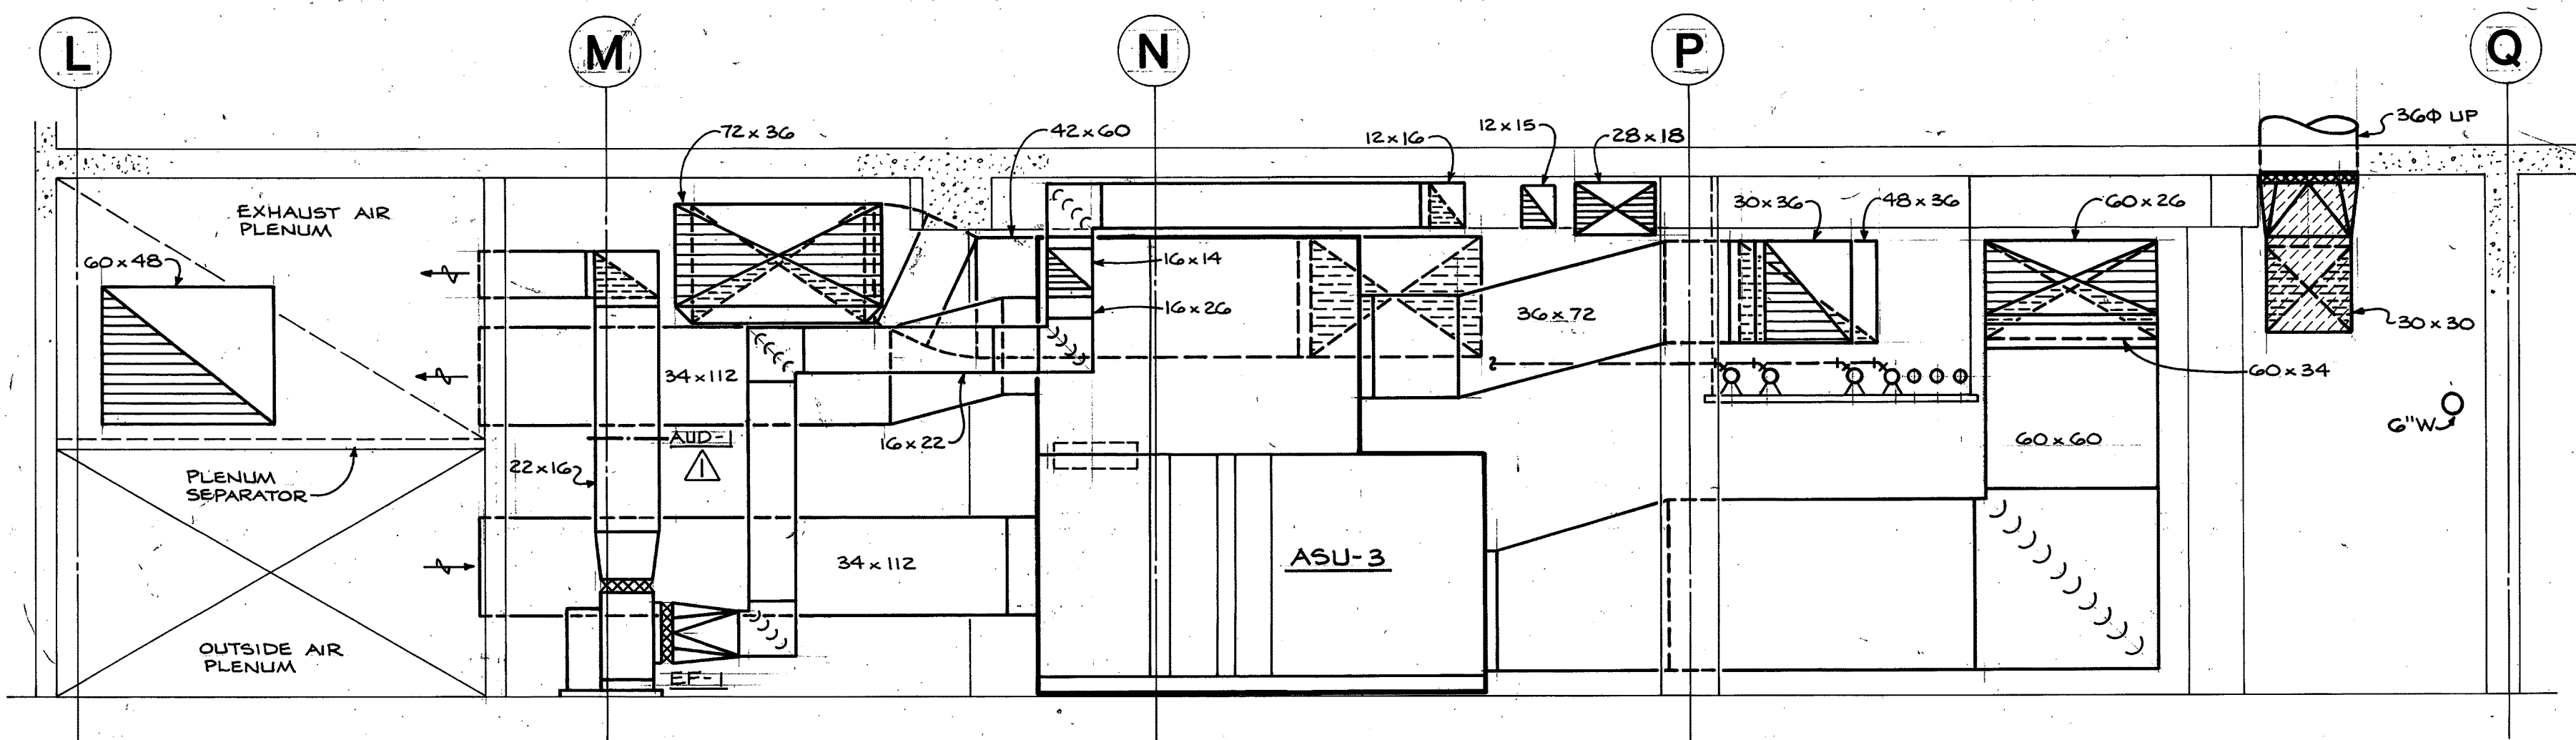

**20 SECTION AT ASU-3**  
1/4" = 1'-0"

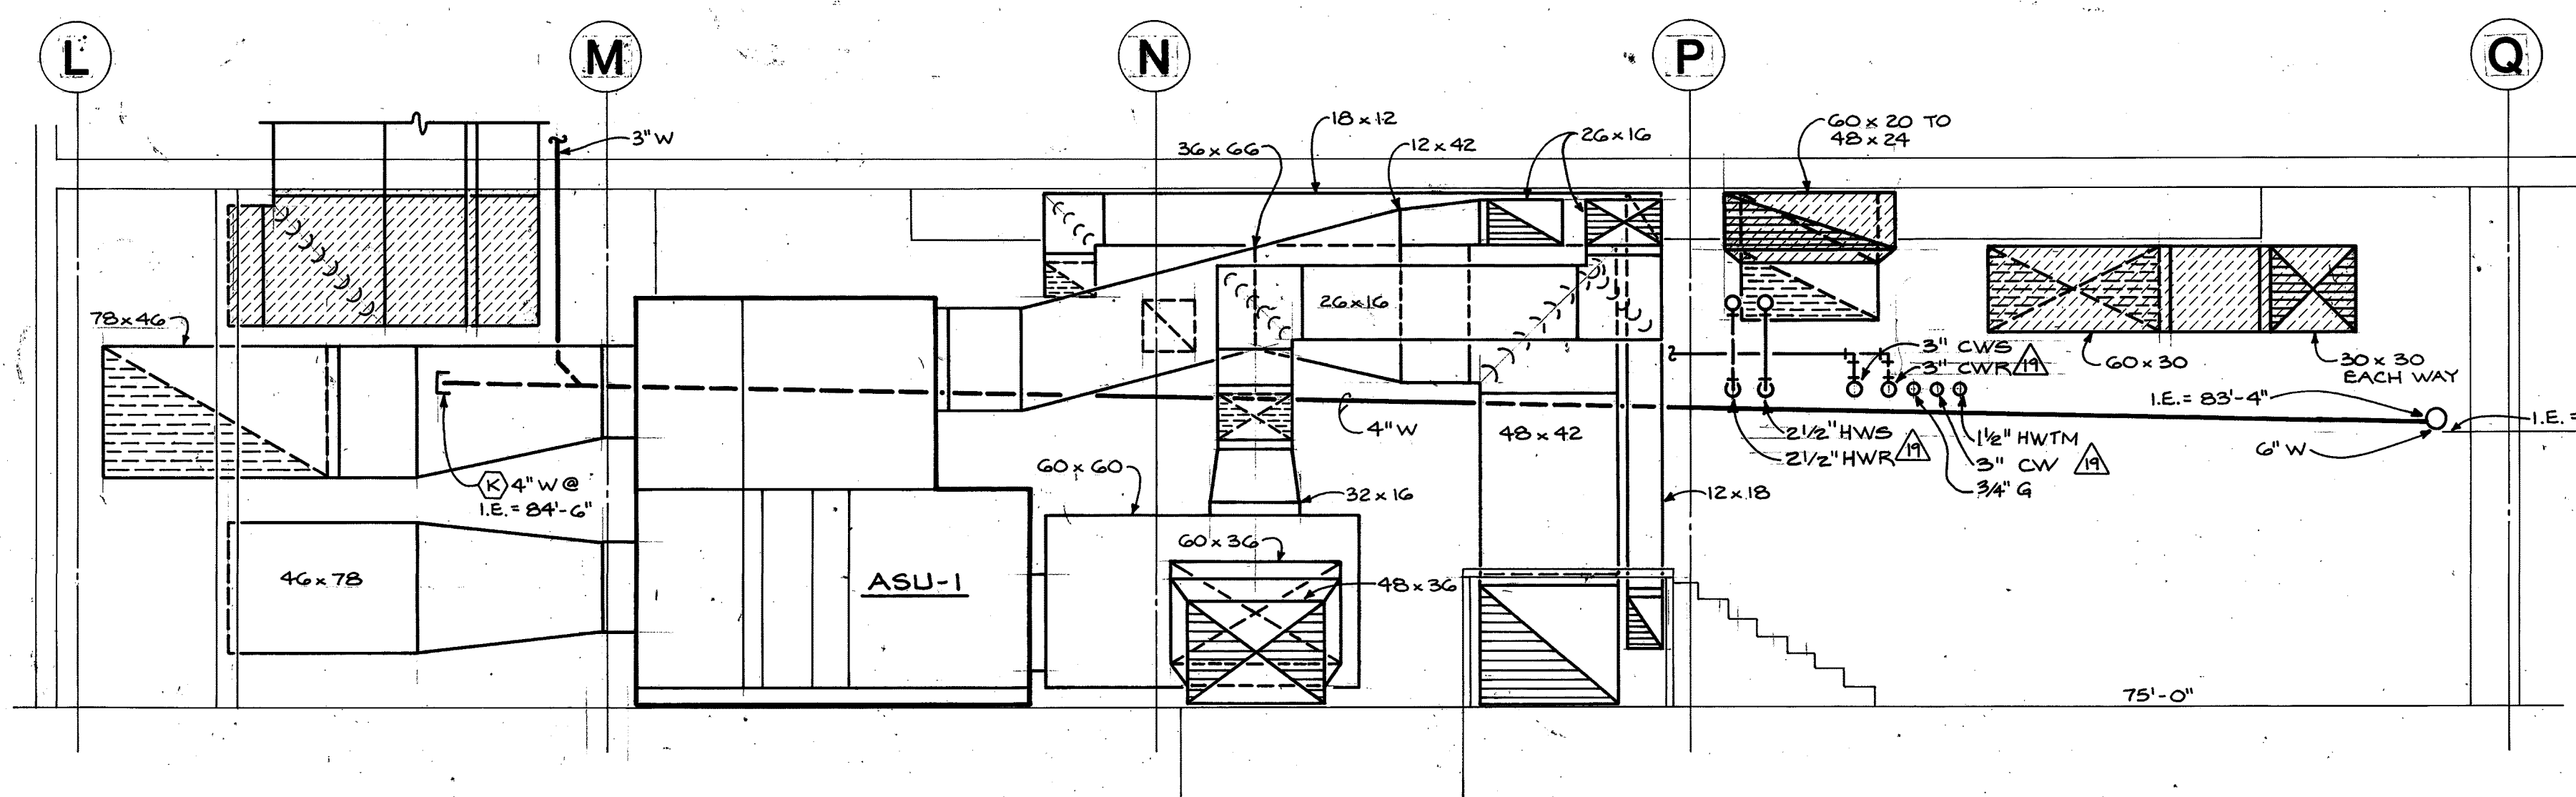


**21 SECTION AT ASU-1**  
1/4" = 1'-0"

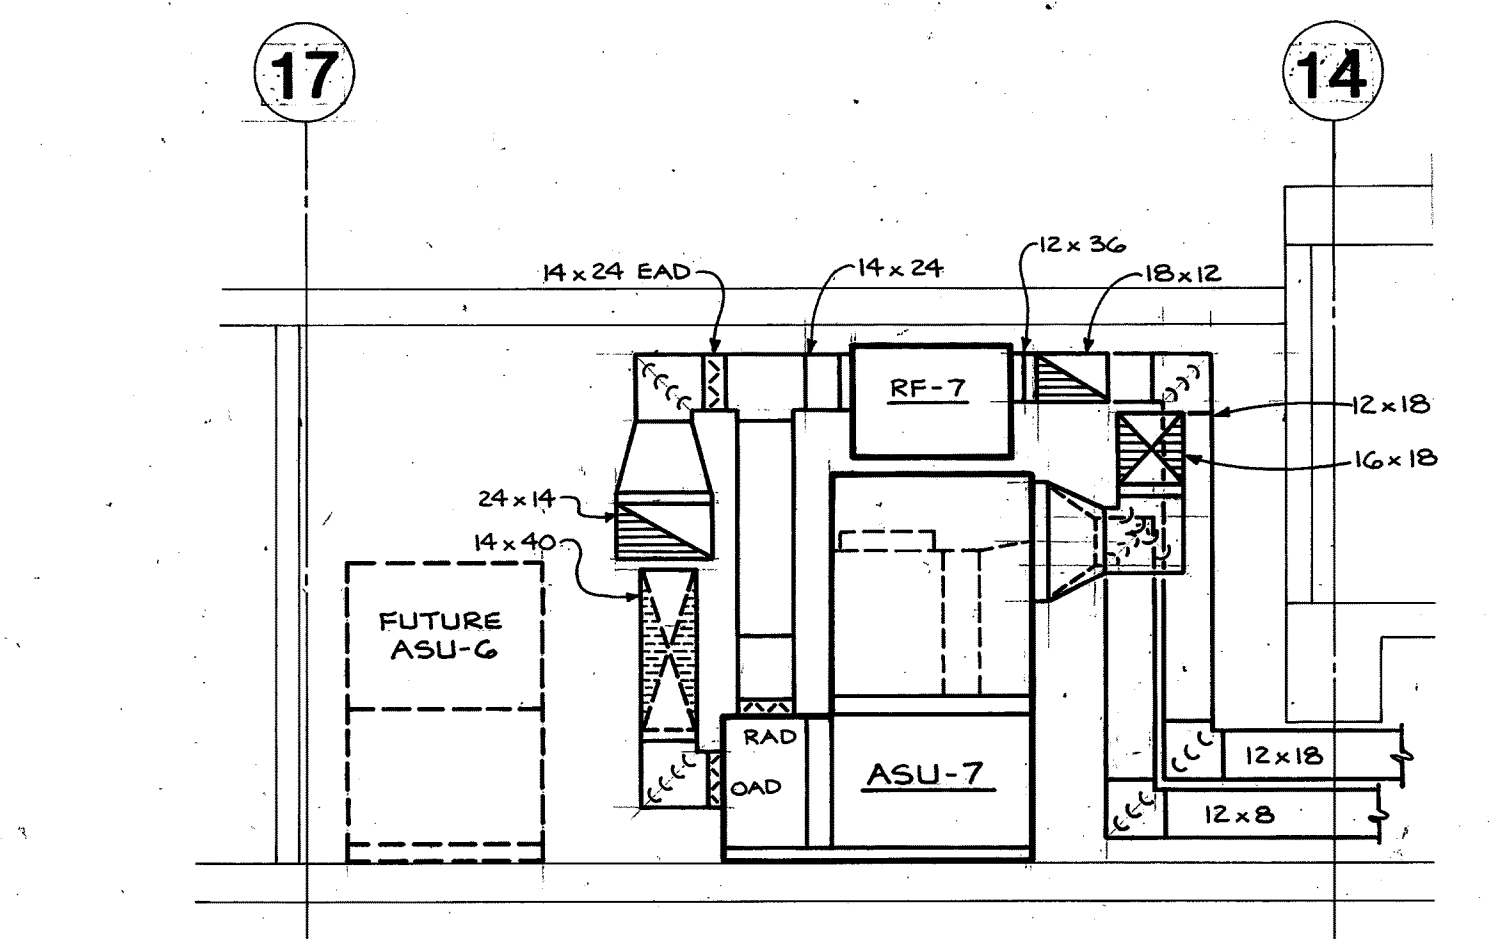


**4 SECTION**  
1/4" = 1'-0"

MZ DAMPER SCHEDULE				
ZONE	SERVES	AIR VOLUME	DAMPER SIZE	DUCT SIZE
(20)	141, MISC.	2000	20x14	18x16
(22)	PROJECTOR	500	6x14	8x12
(23)	CONTROL BOOTHS	340	4x14	6x12
(24)	SOUND	800	8x14	12x12


MZ, ASU-7 BASED ON PACE A-15 WITH 1/2" BETWEEN ZONES AT DAMPER SECTION.

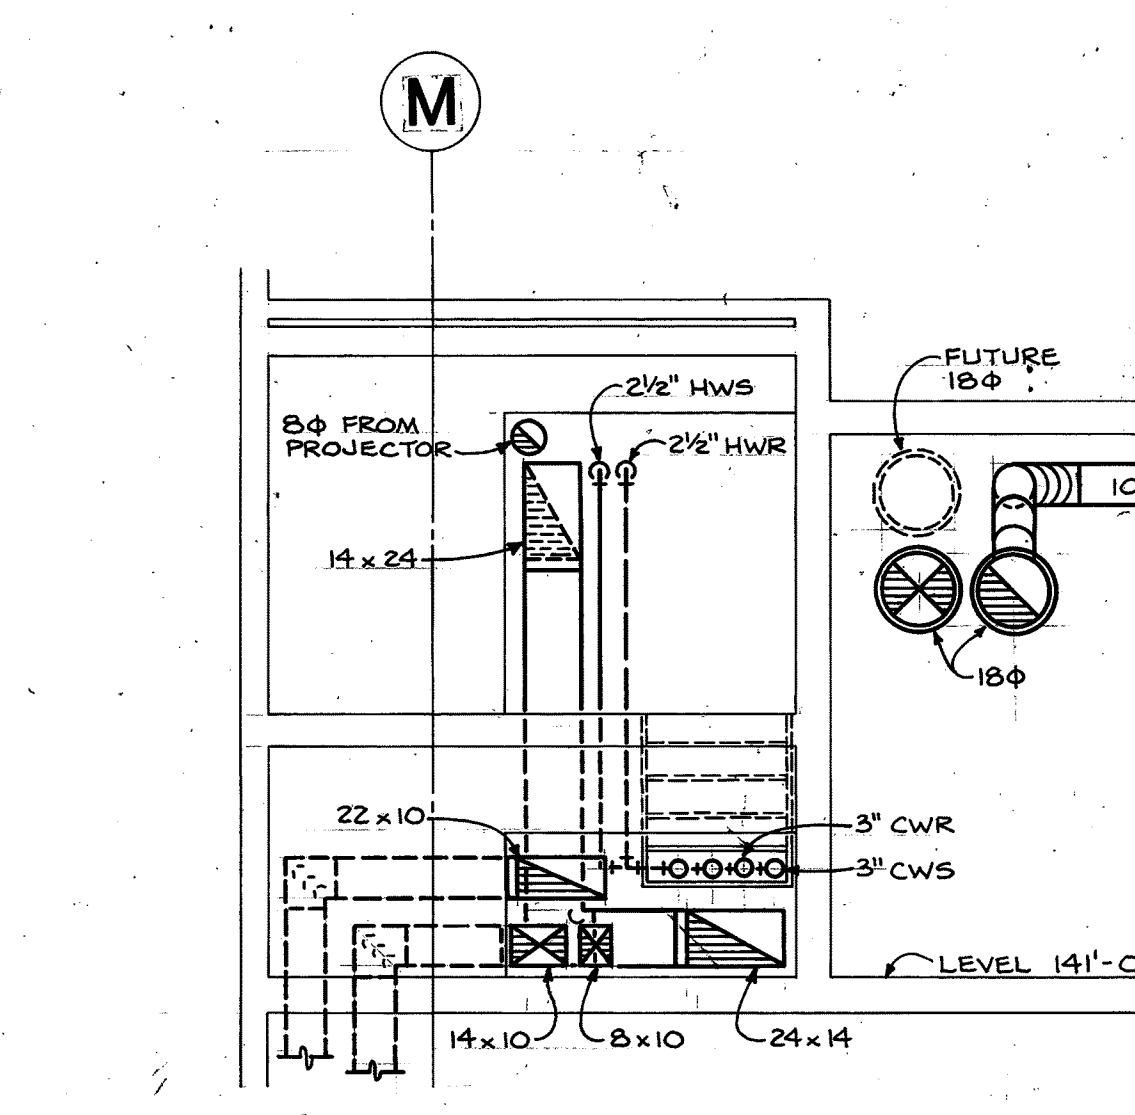


**11 SECTION**  
1/4" = 1'-0"

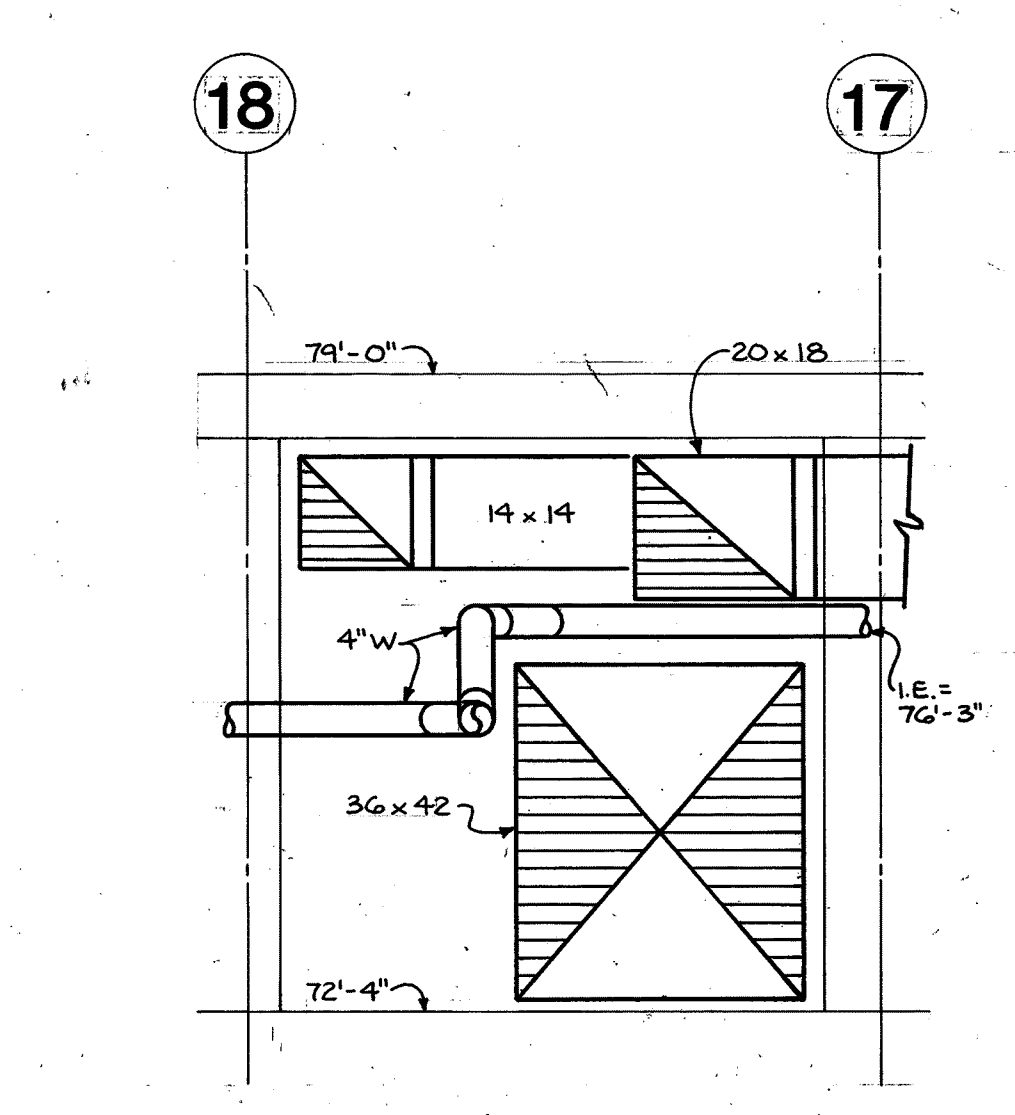


**17 SECTION - TUNNEL AT J**  
1/2" = 1'-0"

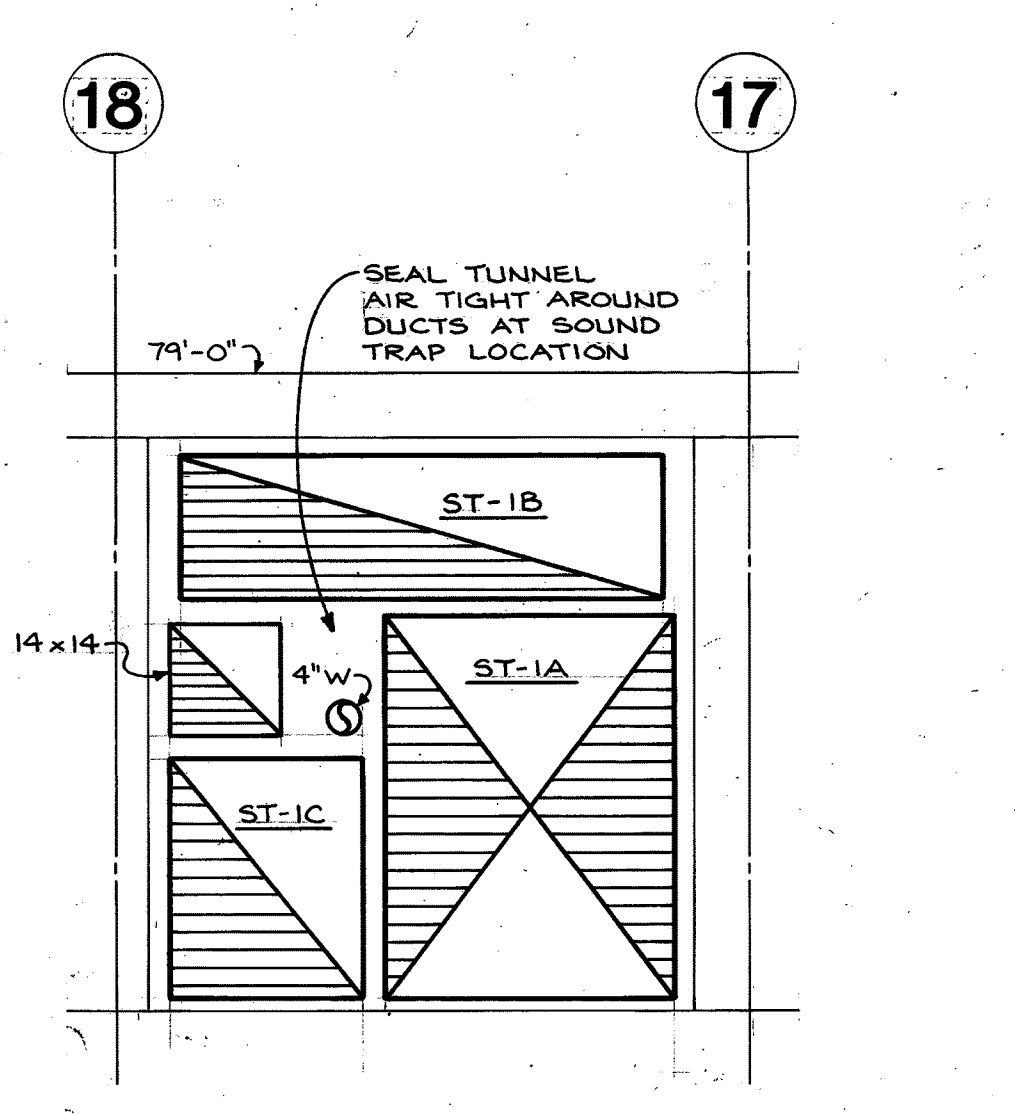


**23 SECTION - TUNNEL AT L**  
1/2" = 1'-0"

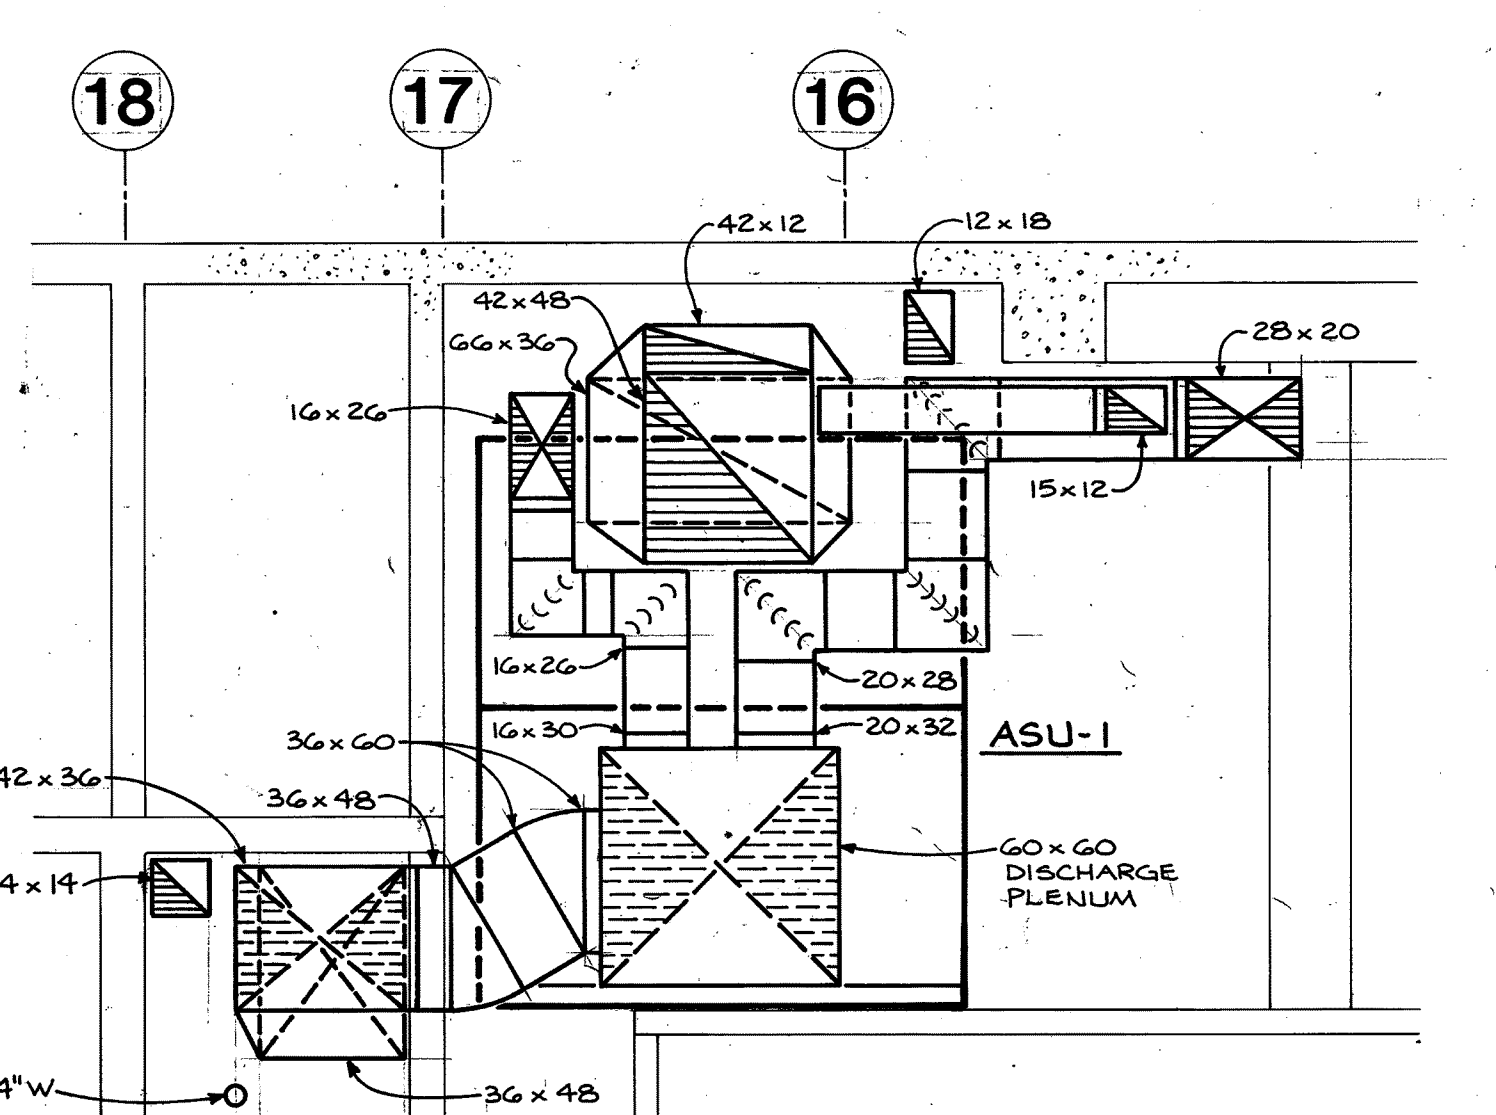

**29 SECTION**  
1/4" = 1'-0"

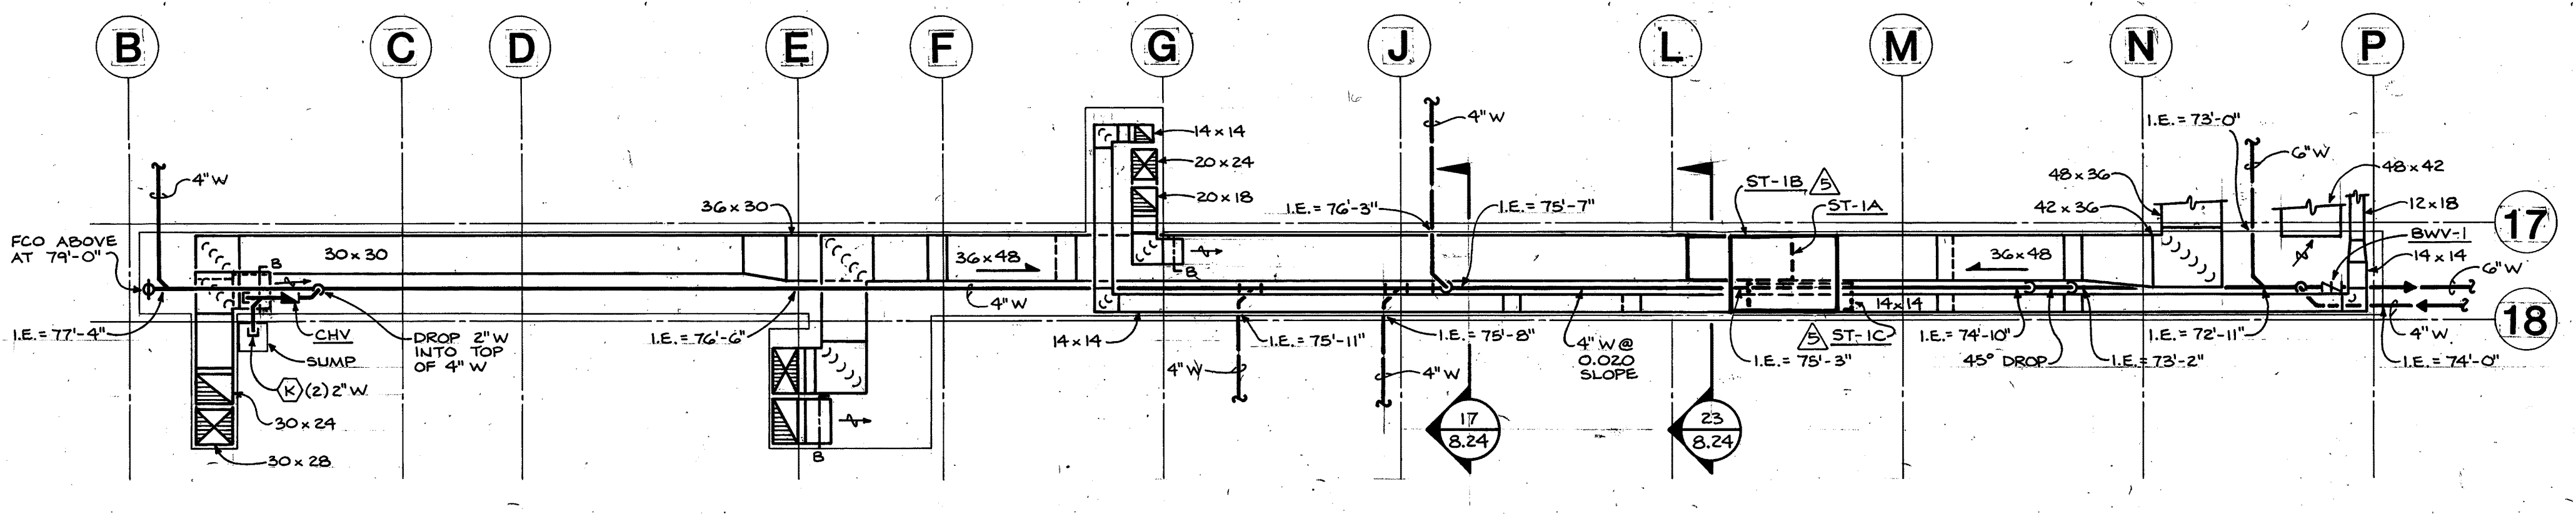

**12 TUNNEL PLAN**  
1/8" = 1'-0"

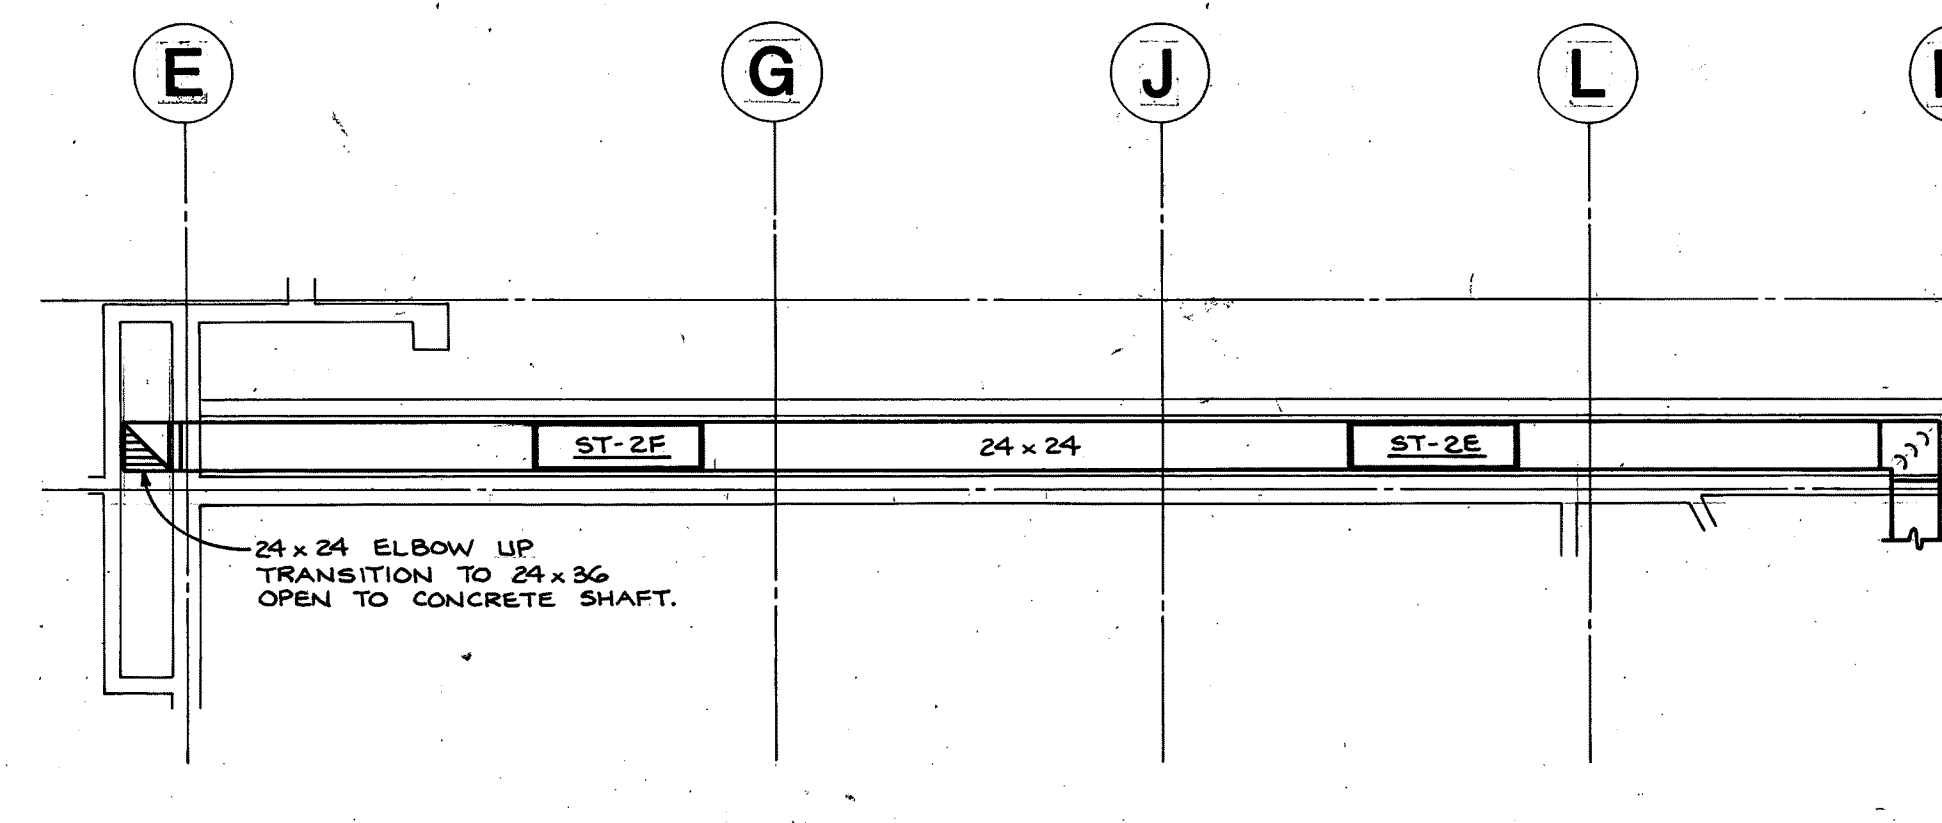

**30 TUNNEL PLAN**  
1/8" = 1'-0"

# Portland Center for the Performing Arts

The City of Portland

Honorable Mildred A. Schwab  
Commissioner in Charge  
Ronald K. Ragen  
Chairman  
Performing Arts Center Committee

Architects  
Broome, Oringdolph, O'Toole, Rudolf & Associates pc  
E/S Design Group  
Barton Myers

Project Address  
733 N.W. 20th Avenue  
Portland, Oregon 97209  
(503) 226-1575

Consultants  
Theatre Projects Inc.  
Theatre Consultants  
R. Lawrence Kirkegaard & Associates  
Acoustician  
CH2M Hill  
Structural Engineers  
C.W. Timmer Associates  
Mechanical Engineers  
Interface Engineering Inc.  
Electrical Engineers



Target	Revision Item	Revision Date
▲	Addendum #1	10/29/84
▲	Addendum #2	11/06/84
▲	Addendum #4	11/13/84
▲	Addendum #5	11/21/84
▲	Proposal Request #1	03/01/85
▲	Proposal Request #2	03/01/85
▲	Proposal Request #3	03/01/85
▲	Proposal Request #4	03/01/85
▲	Proposal Request #5	03/01/85
▲	Proposal Request #6	03/01/85
▲	Proposal Request #7	03/01/85
▲	Proposal Request #8	03/01/85
▲	Proposal Request #9	03/01/85
▲	Proposal Request #10	03/01/85
▲	Proposal Request #11	03/01/85
▲	Proposal Request #12	03/01/85
▲	Proposal Request #13	03/01/85
▲	Proposal Request #14	03/01/85
▲	Clarification Items	03/01/85
▲	Miscellaneous Items	03/01/85

Revisions

New Theatre Building

DETAILS  
MECHANICAL RMS

Date OCT. 12, 1984  
Scale AS SHOWN  
Drawing No. 8.24

C.W. Timmer Associates Inc.  
Consulting Engineers  
1644-20

The City of Portland  
 Honorable Mildred A. Schwab  
 Commissioner in Charge  
 Ronald K. Ragen  
 Chairman  
 Performing Arts Center Committee

Architects  
 Broome, Oringdolph, O'Toole, Rudolf & Associates pc  
 ELS Design Group  
 Barton Myers  
 Project Address  
 733 N.W. 20th Avenue  
 Portland, Oregon 97209  
 (503) 226-1575

Consultants  
 Theatre Projects Inc.  
 Theatre Consultants  
 R. Lawrence Kirkegaard & Associates  
 Acoustician  
 CH2M Hill  
 Structural Engineers  
 C.W. Timmer Associates  
 Mechanical Engineers  
 Interface Engineering Inc.  
 Electrical Engineers




Target	Revision Item	Revision Date
▲	Addendum #1	10/29/84
▲	Addendum #2	11/06/84
▲	Addendum #3	11/13/84
▲	Addendum #4	11/21/84
▲	Addendum #5	03/01/85
▲	Proposal Request #1	03/01/85
▲	Proposal Request #2	03/01/85
▲	Proposal Request #3	03/01/85
▲	Proposal Request #4	03/01/85
▲	Proposal Request #5	03/08/85
▲	Proposal Request #6	03/01/85
▲	Proposal Request #7	03/01/85
▲	Proposal Request #8	03/01/85
▲	Proposal Request #9	03/01/85
▲	Proposal Request #10	03/01/85
▲	Proposal Request #11	03/01/85
▲	Proposal Request #12	03/01/85
▲	Proposal Request #13	03/01/85
▲	Proposal Request #14	03/01/85
▲	Clarification Items	03/01/85
▲	Miscellaneous Items	03/01/85

Revisions  
**New Theatre Building**

**DETAILS  
 HVAC**


Date OCT. 12, 1984  
 Scale AS SHOWN  
 Drawing No. 8.25

C.W. Timmer Associates Inc.  
 Consulting Engineers  
 1644-20

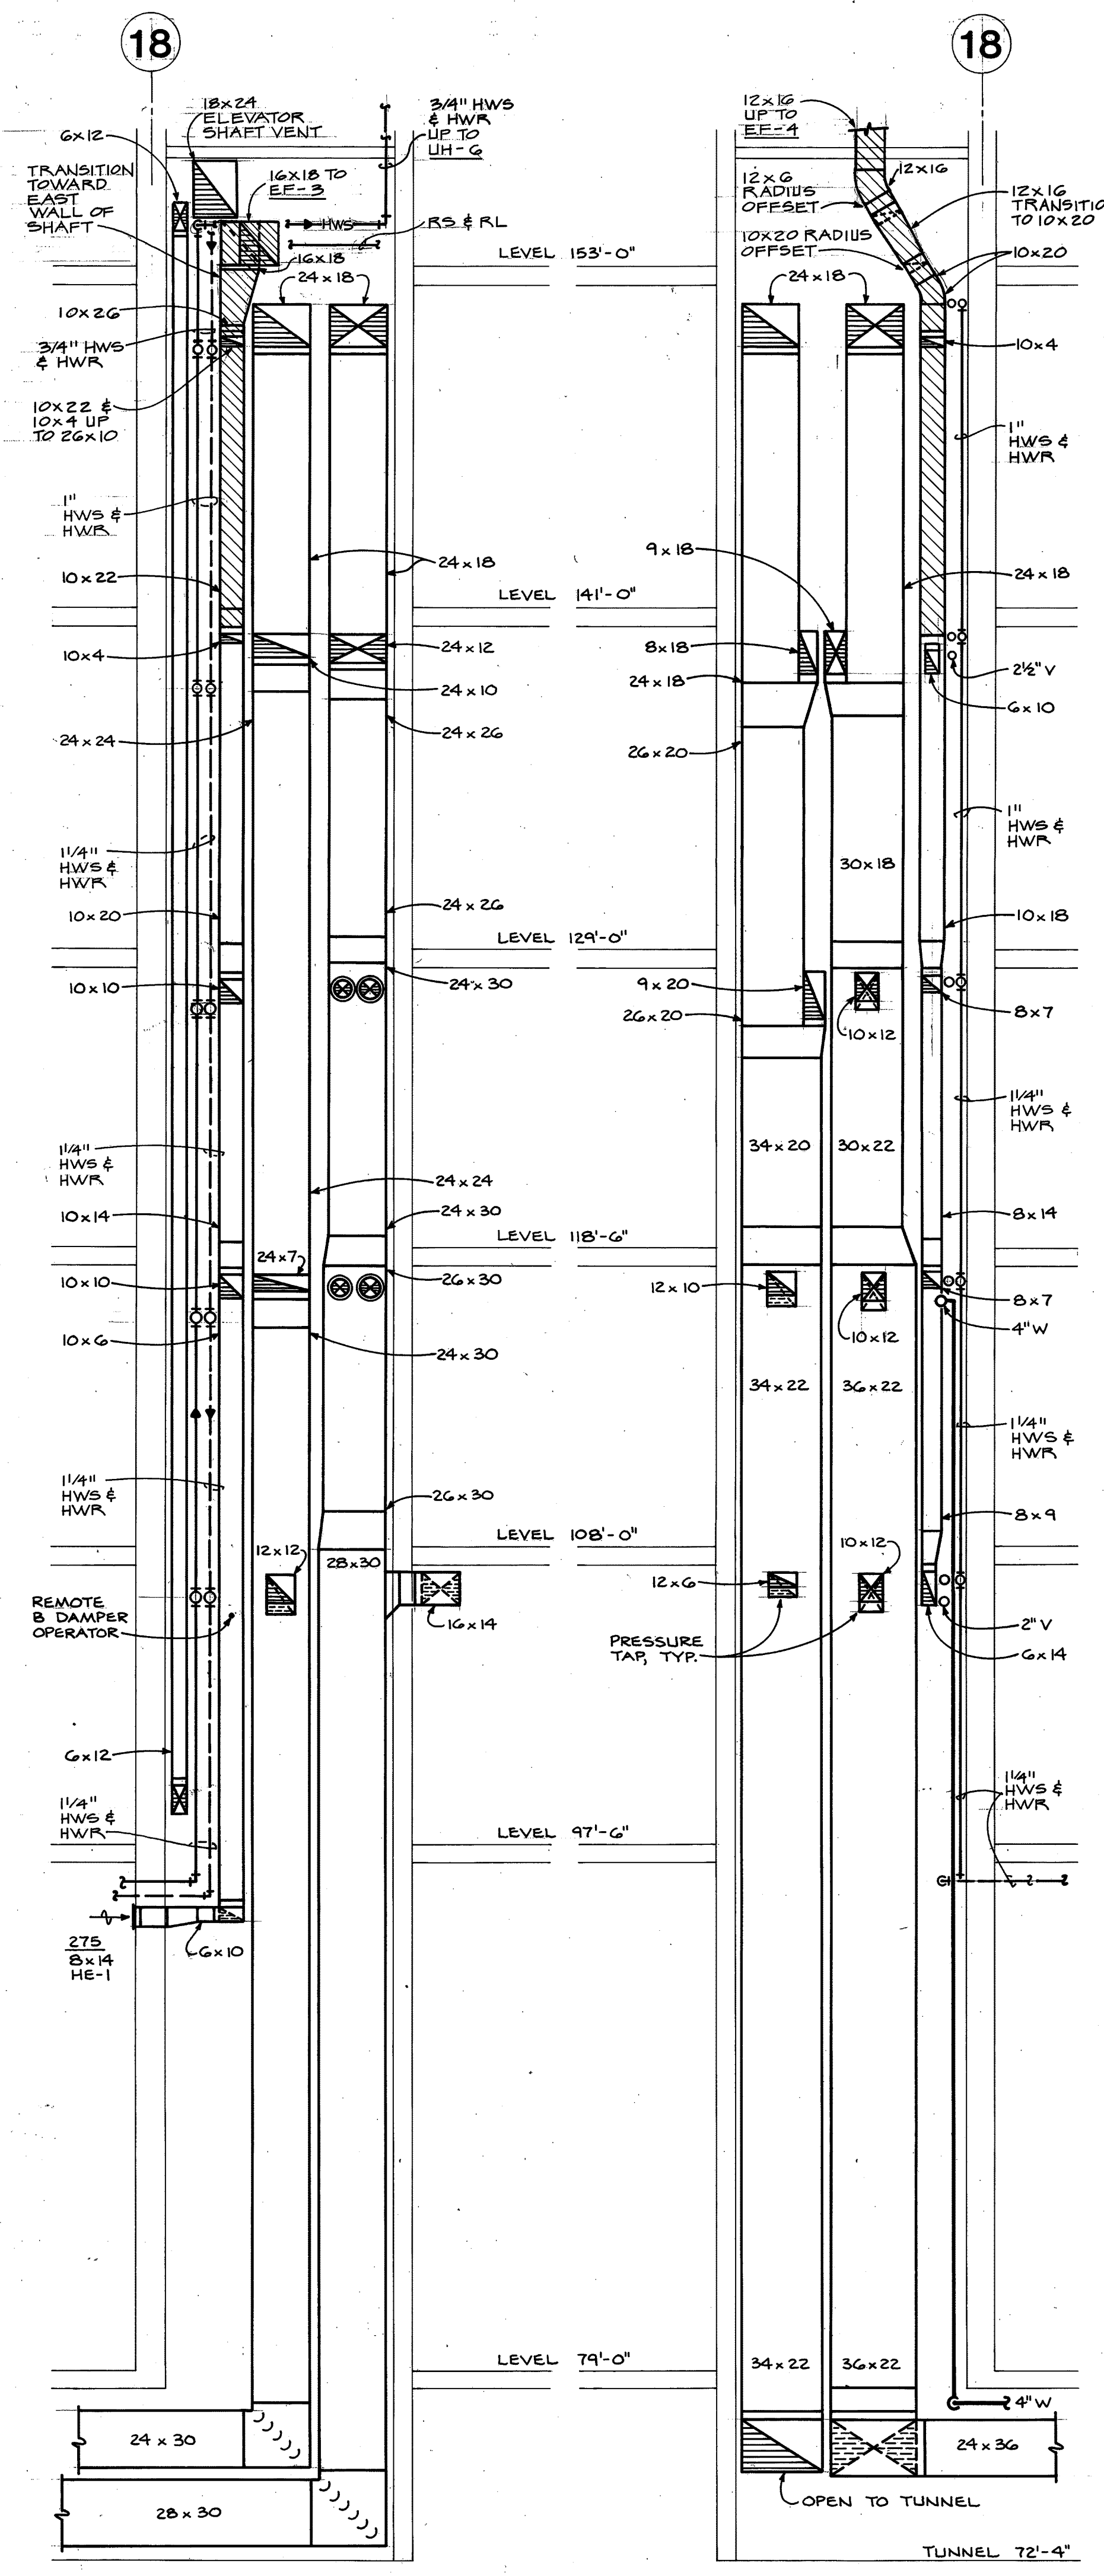


**30 SECTION AT  
 SHAFT B-18**  
 1/4" = 1'-0"


**36 SECTION AT  
 SHAFT E-18**  
 1/4" = 1'-0"

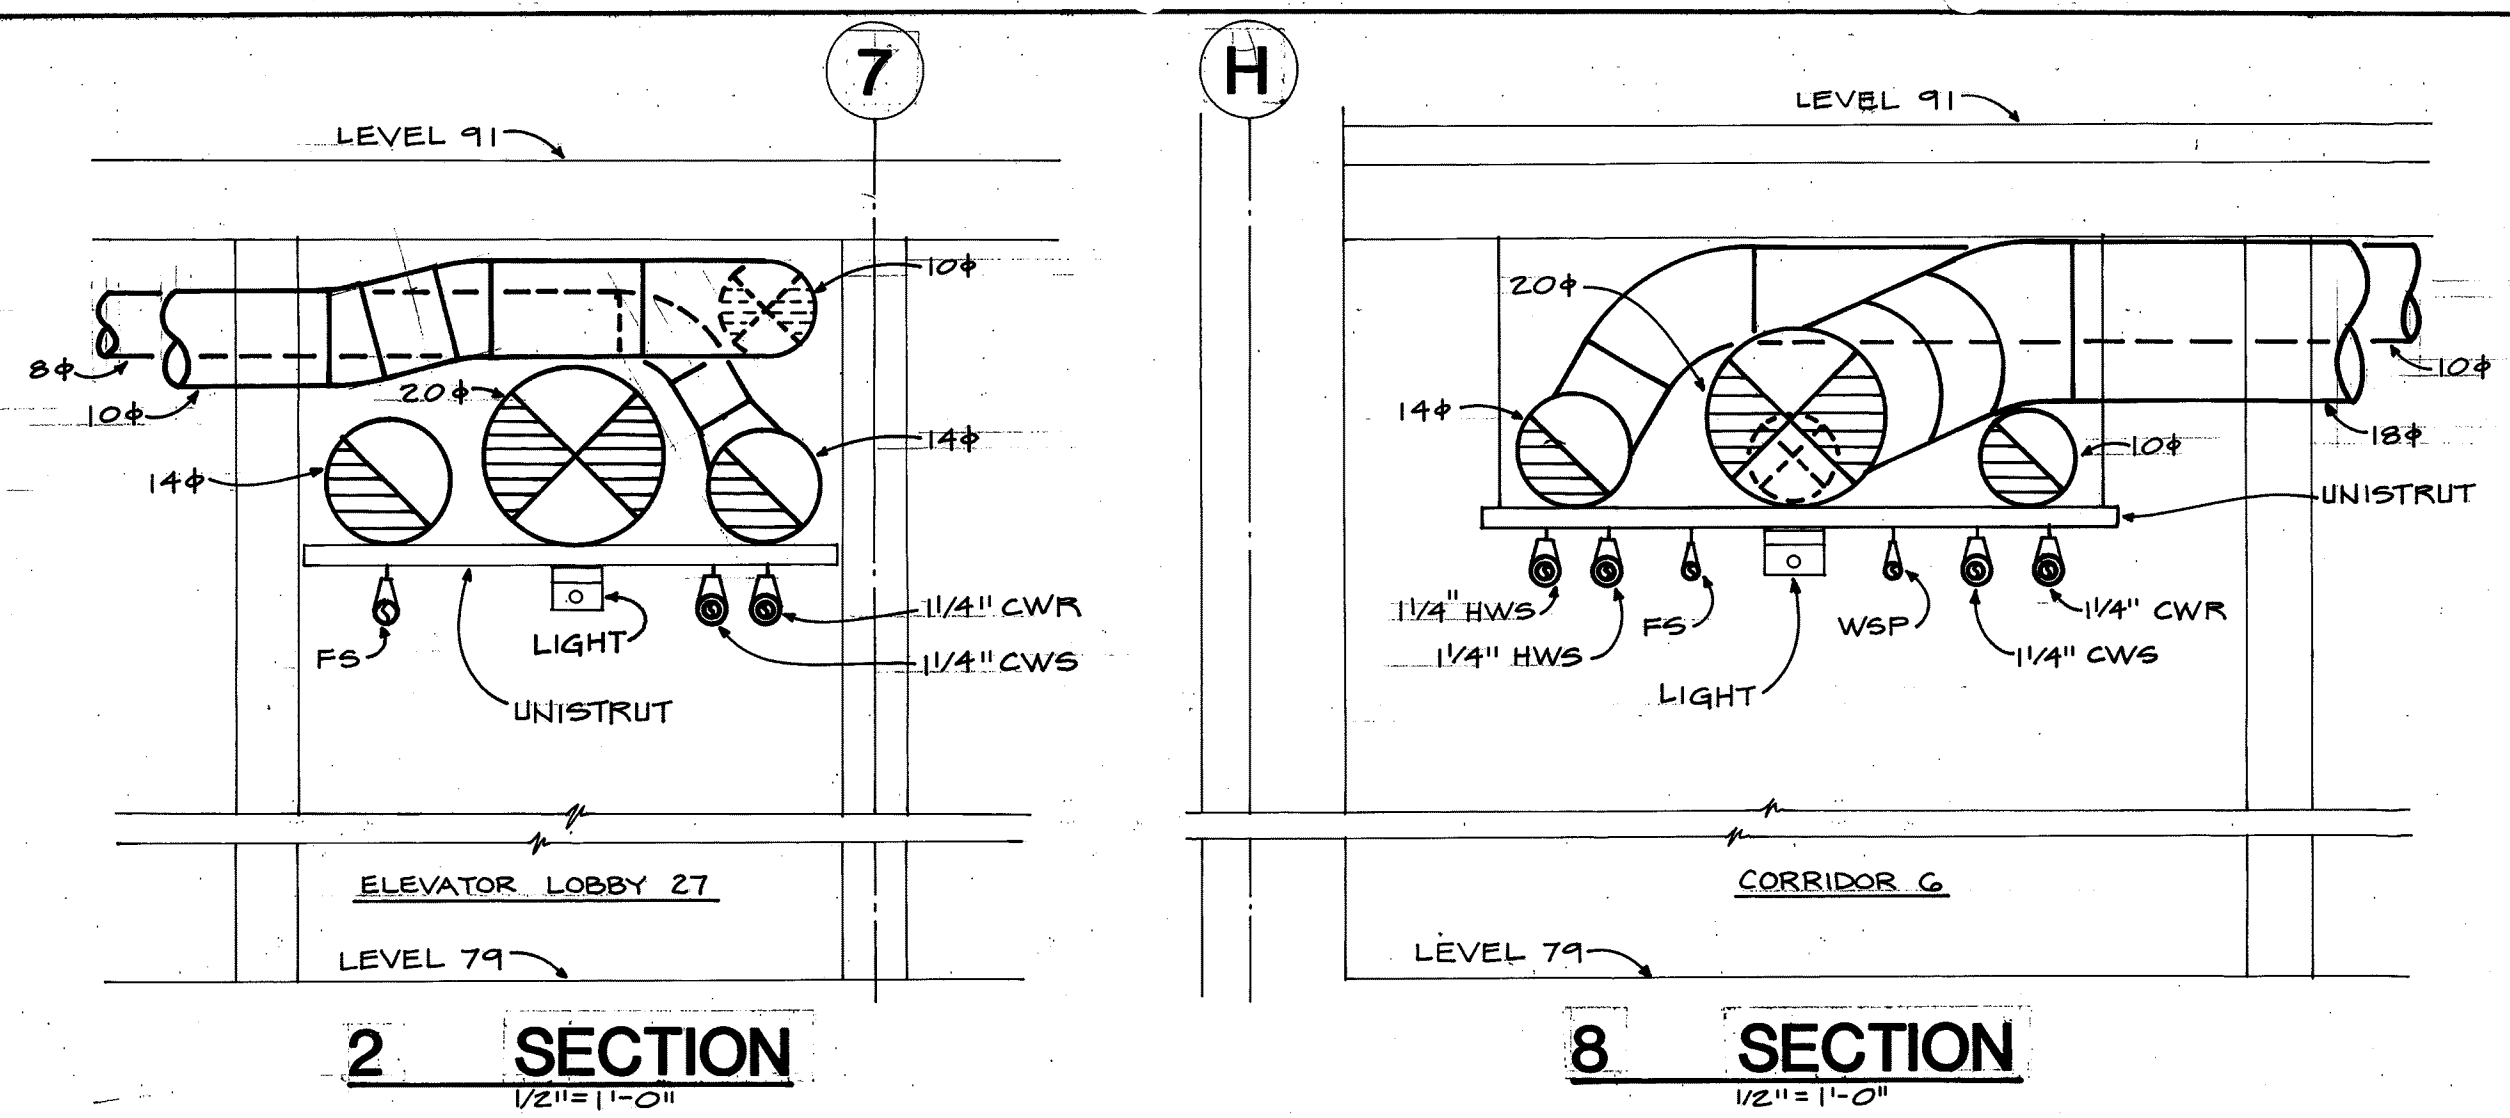


**2 SECTION**  
 1/2" = 1'-0"

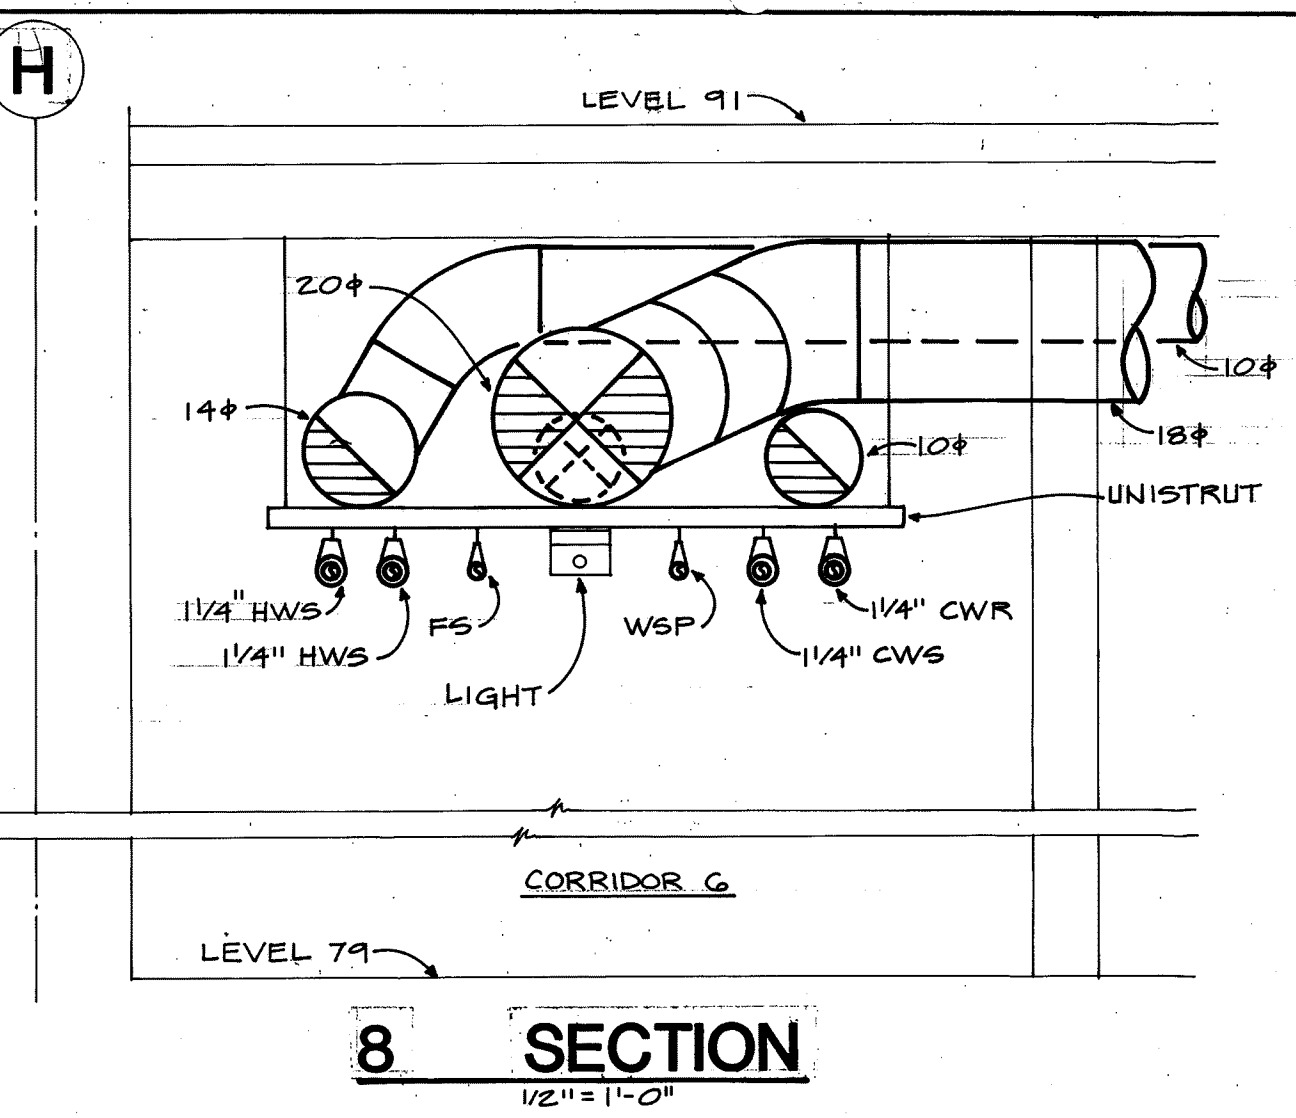


**8 SECTION**  
 1/2" = 1'-0"

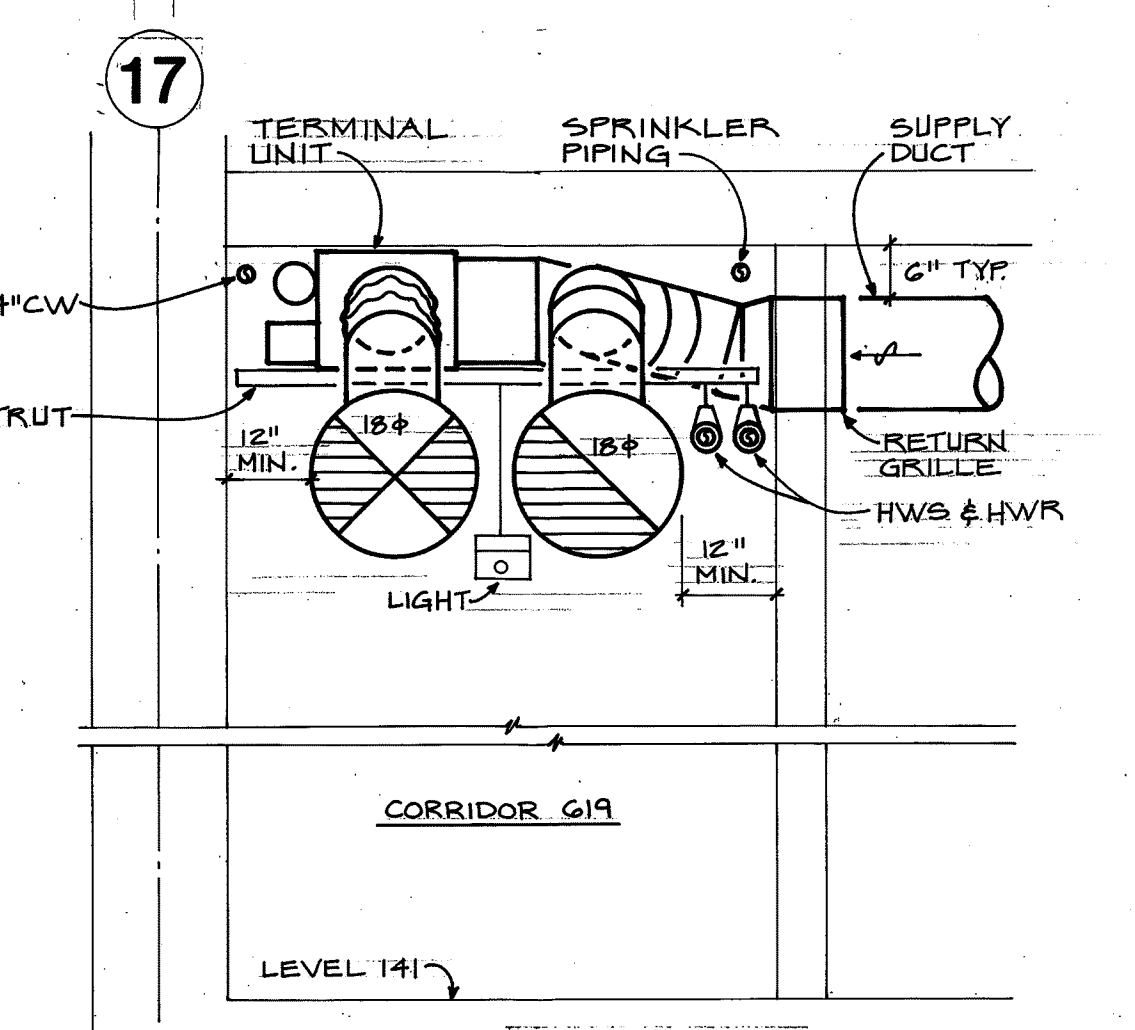


**3 SECTION**  
 1/2" = 1'-0"

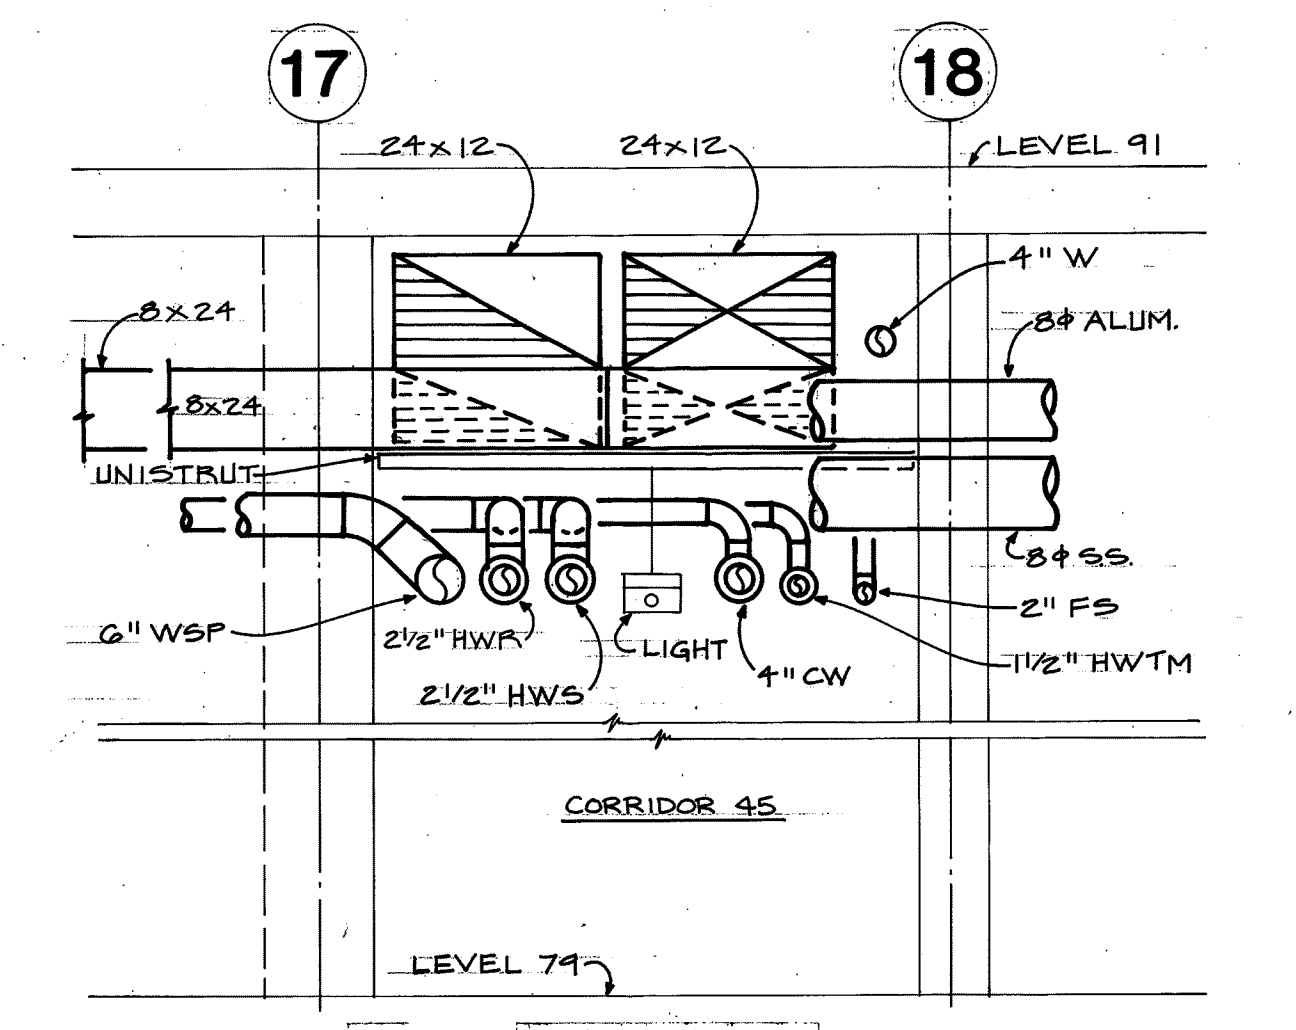


**9 SECTION**  
 1/2" = 1'-0"

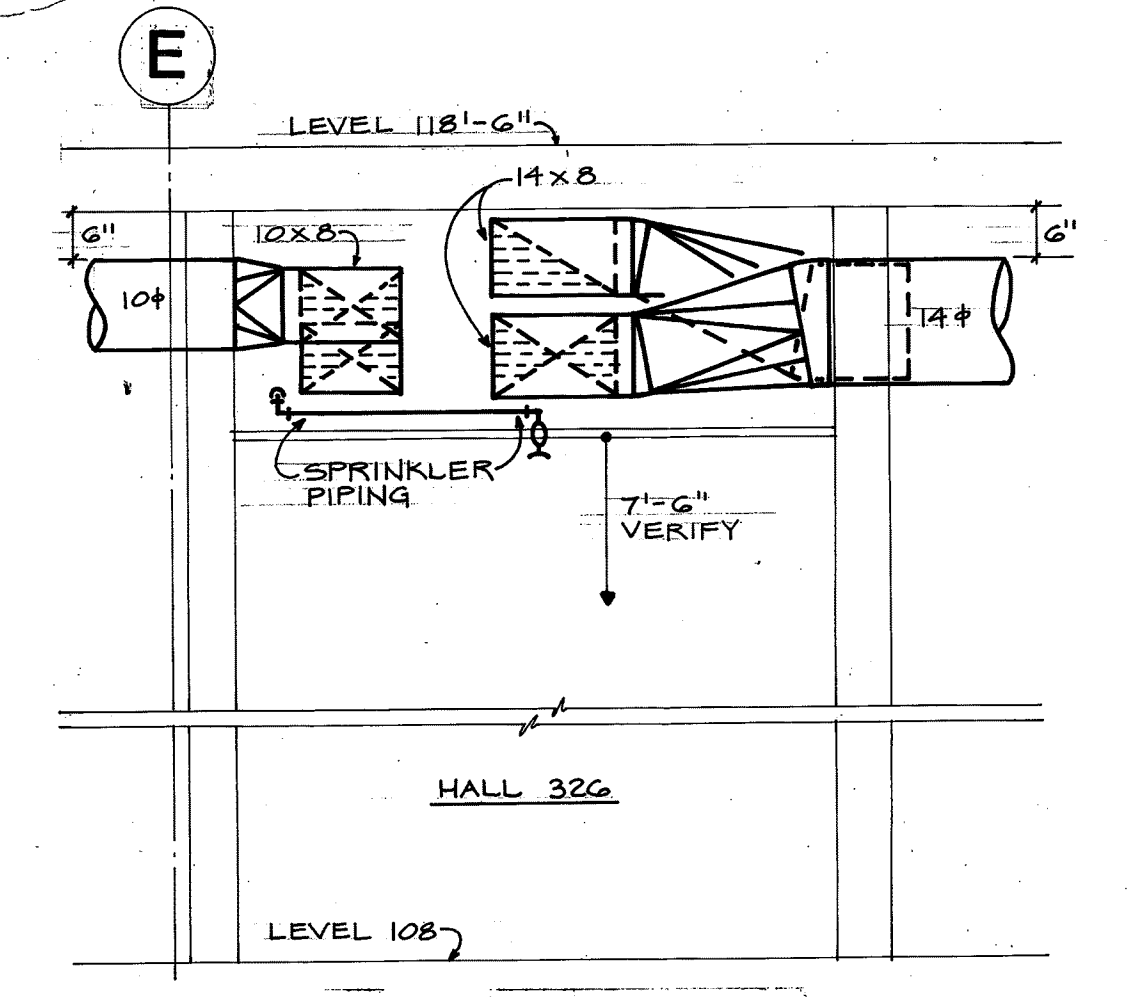


**5 SECTION**  
 1/2" = 1'-0"

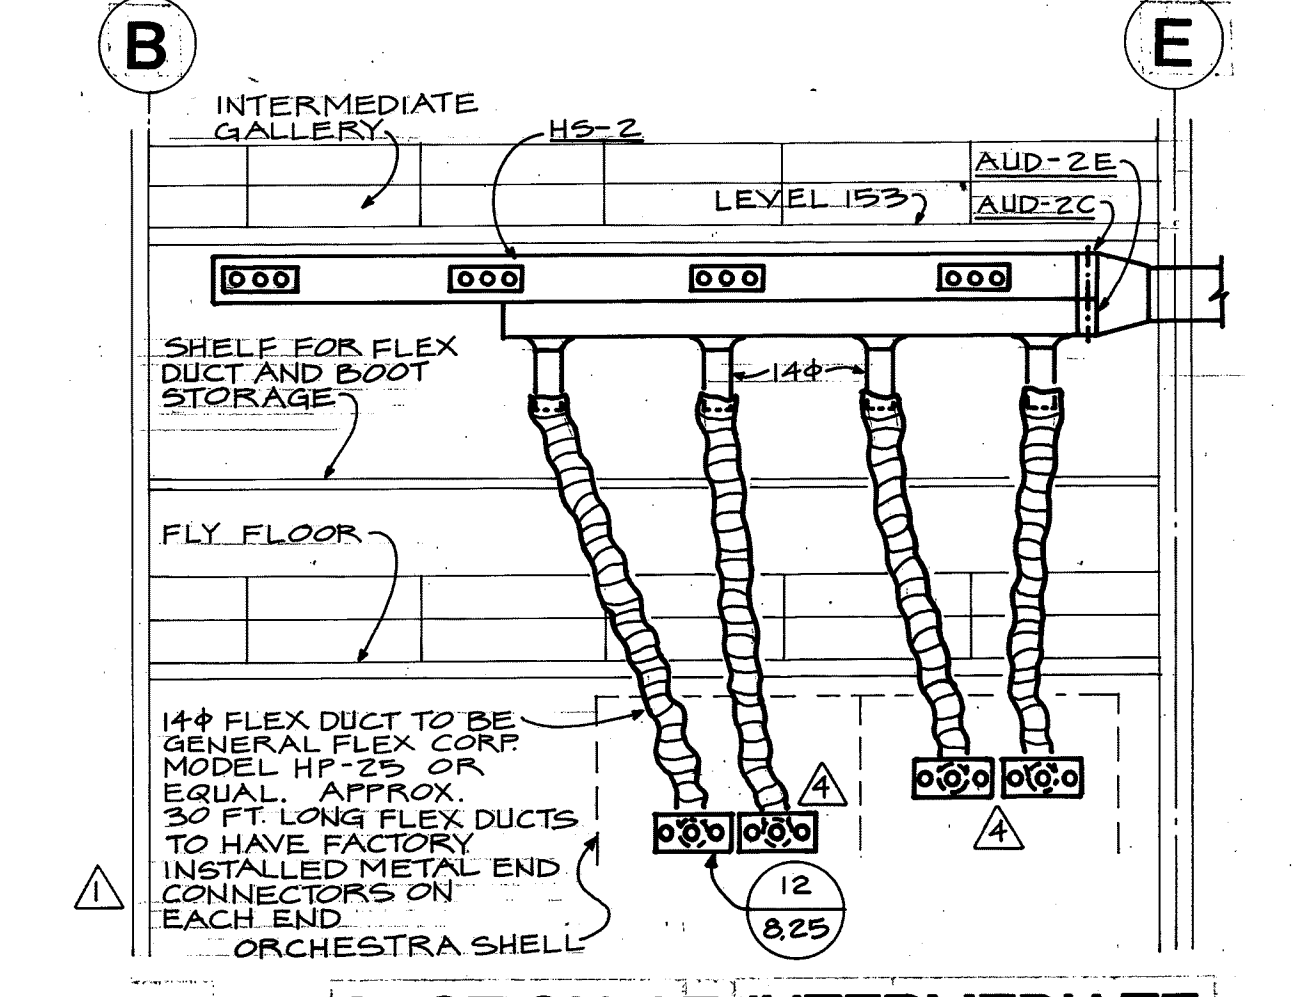


**11 SECTION AT INTERMEDIATE STAGE**  
 1/8" = 1'-0"

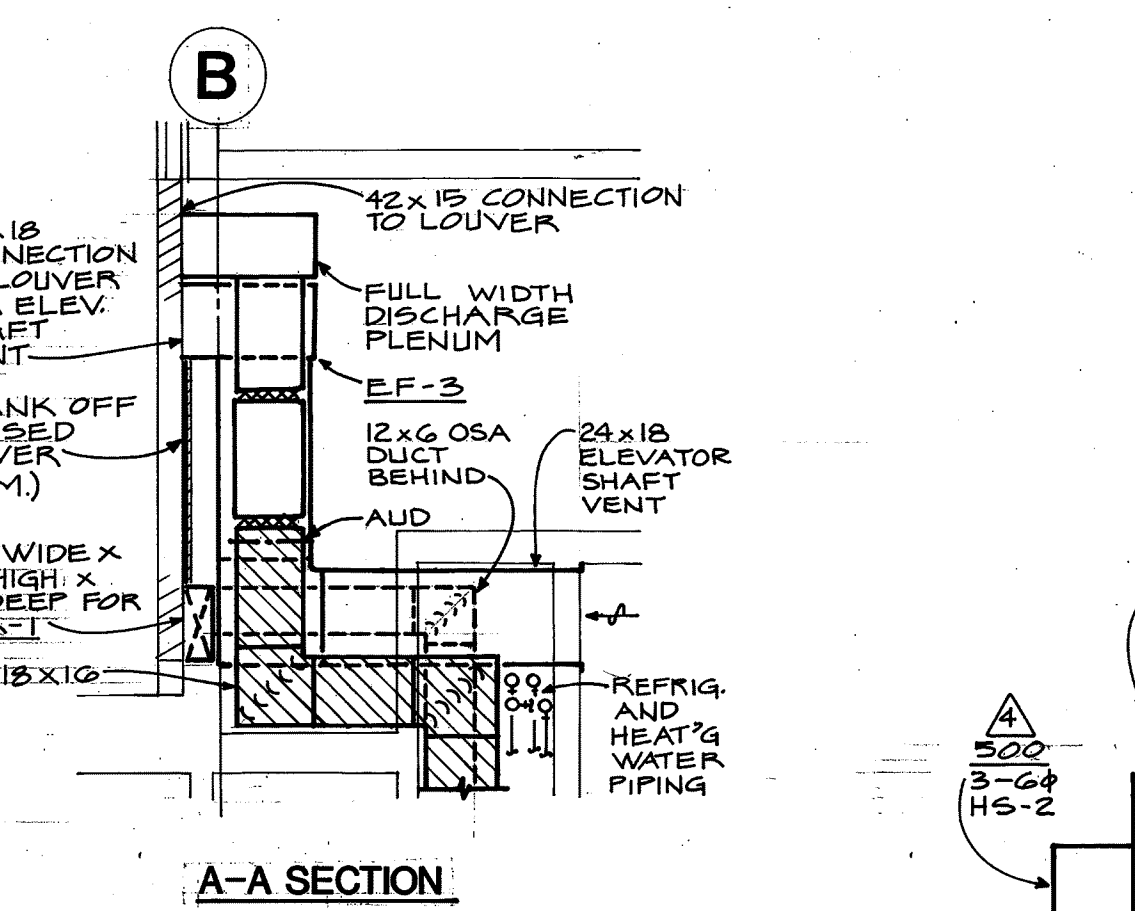


**A-A SECTION**

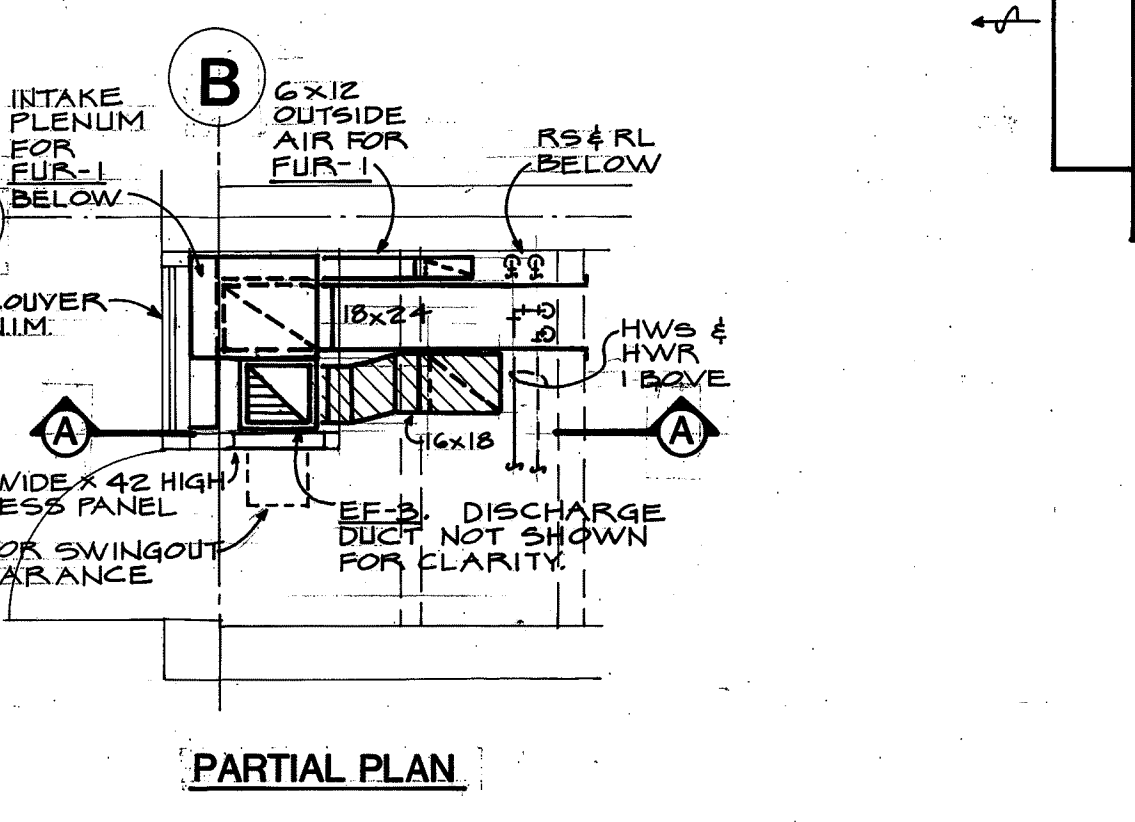

**6 DETAIL - ROOM 701**  
 1/4" = 1'-0"

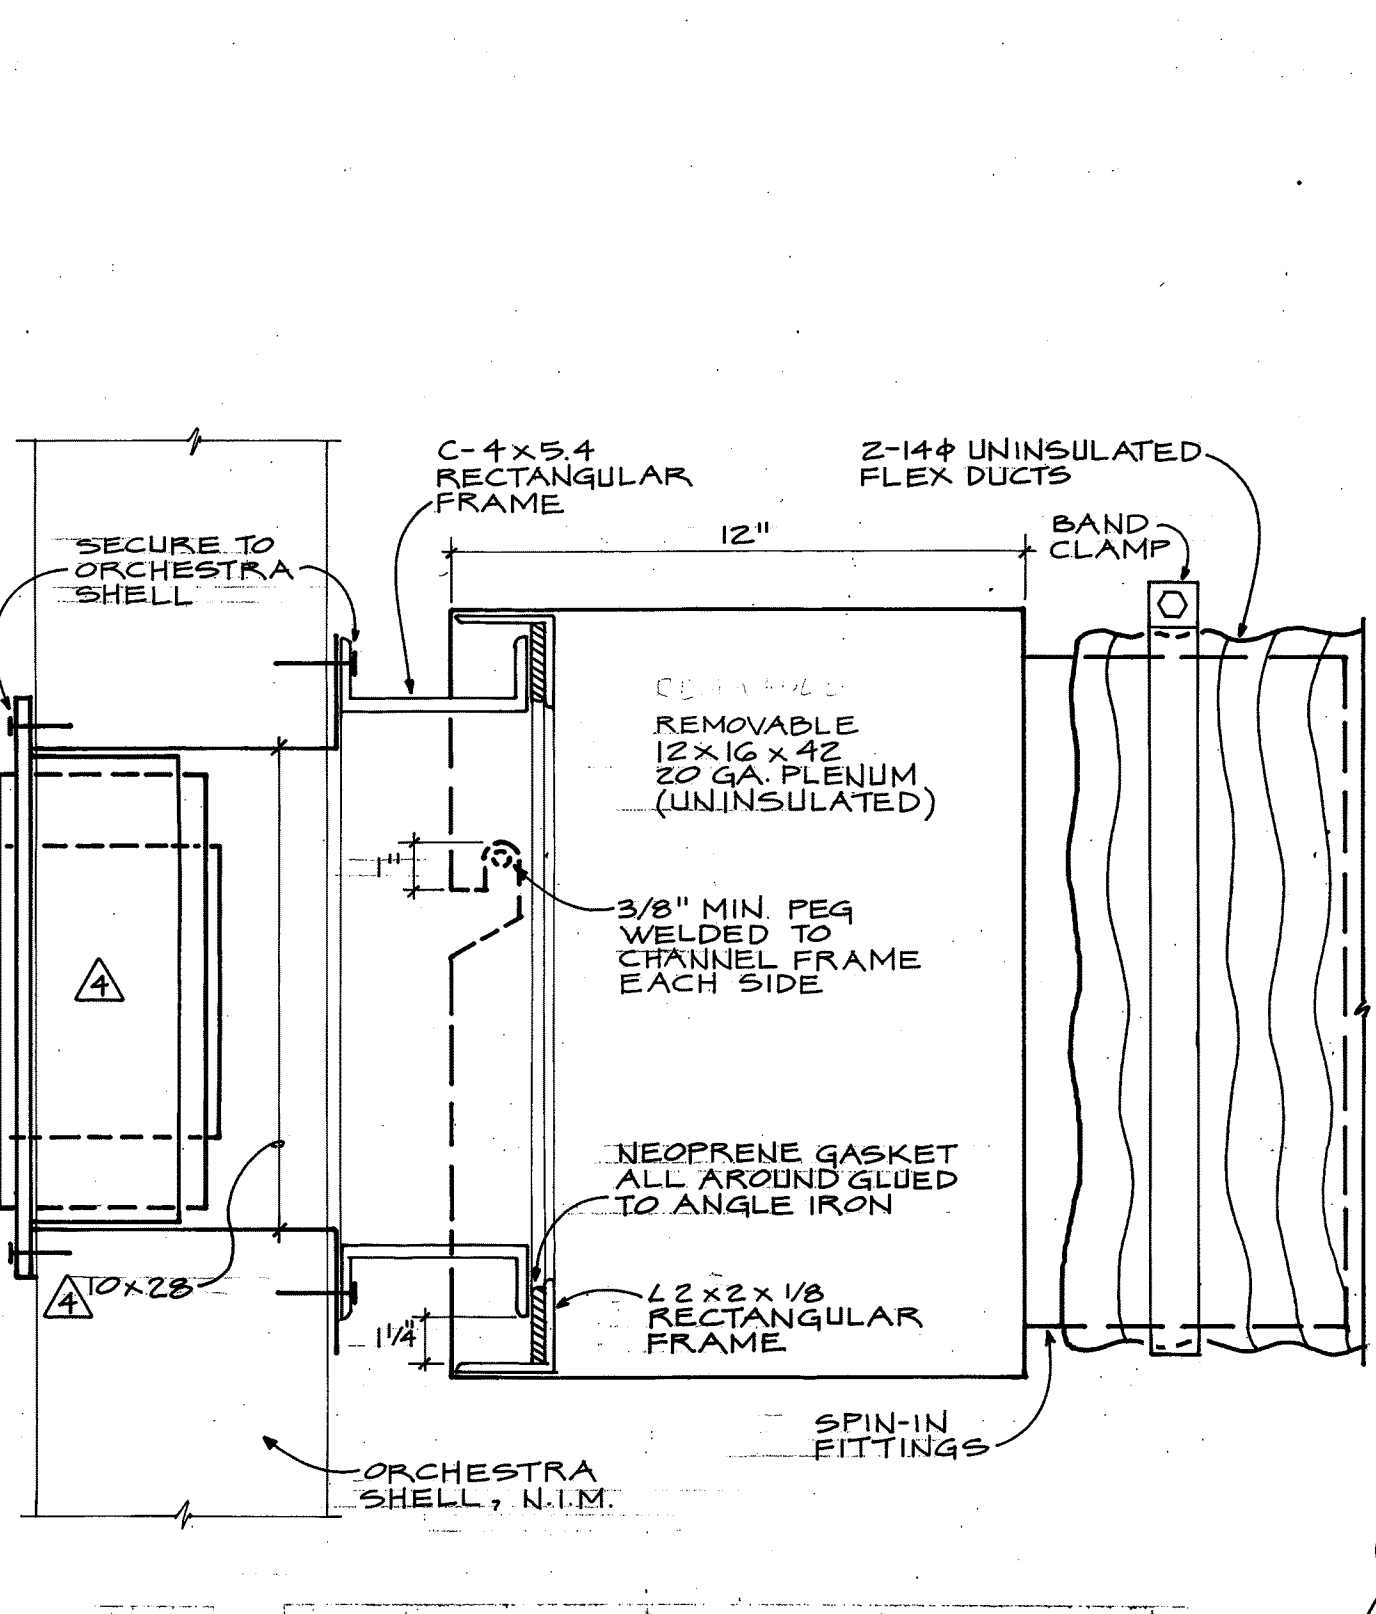


**12 DETAIL - REMOVABLE DUCT CONNECTION FOR HS-5**  
 NO SCALE  
 NOTE: SUBMIT SHOP DRAWINGS PRIOR TO FABRICATION

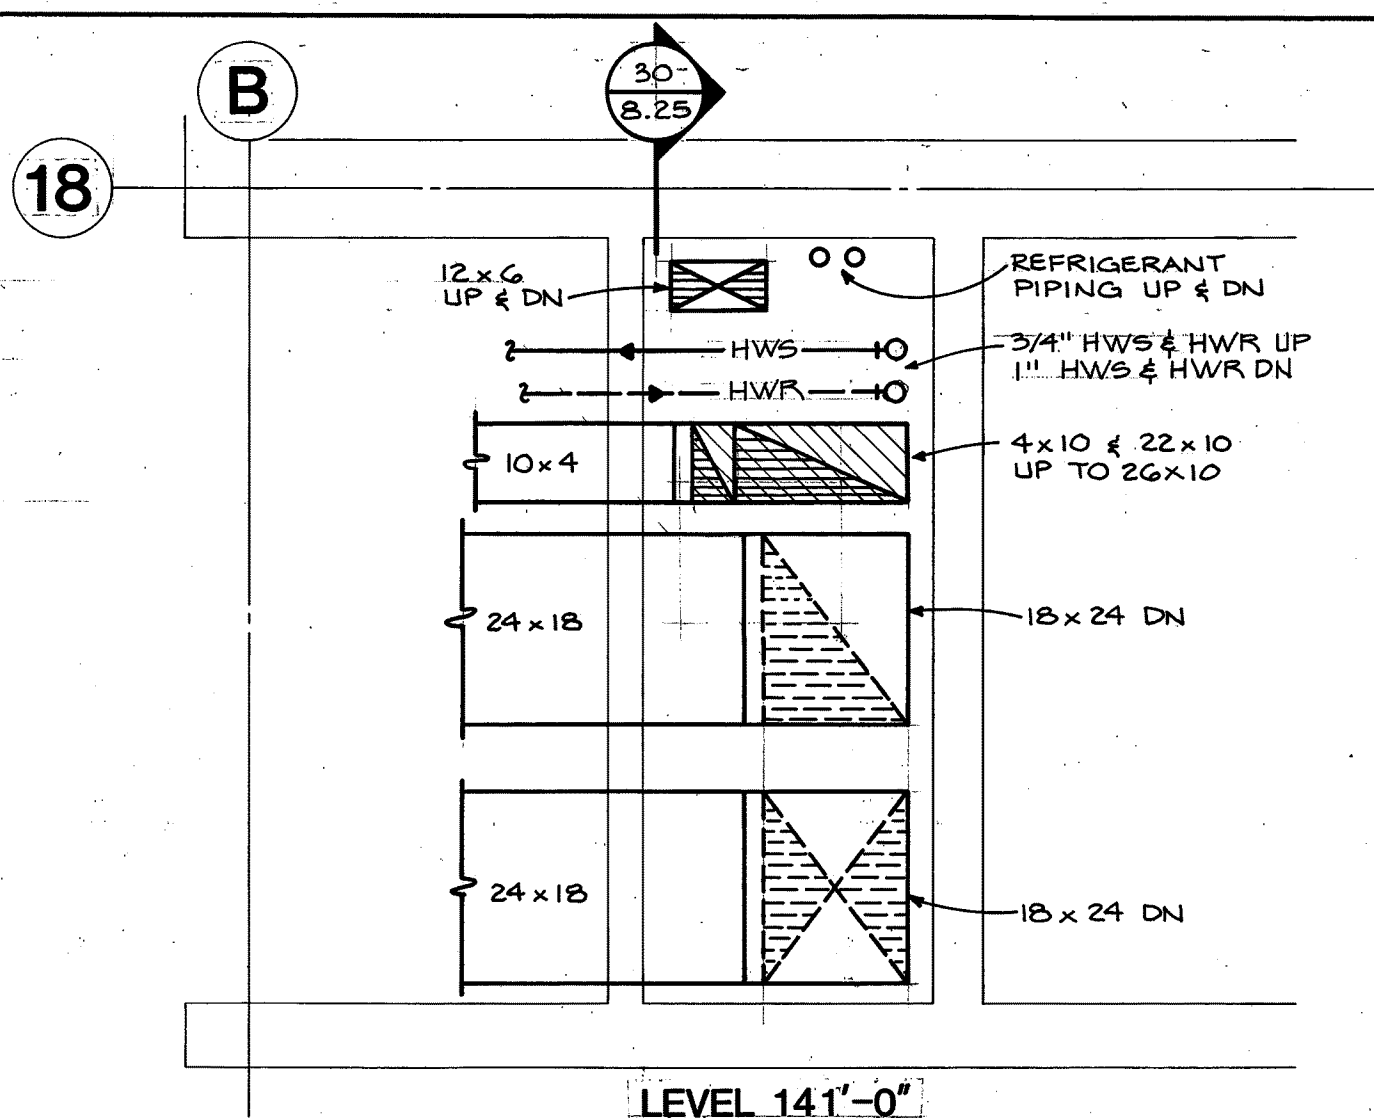


**LEVEL 141'-0"**

**LEVEL 129'-0"**

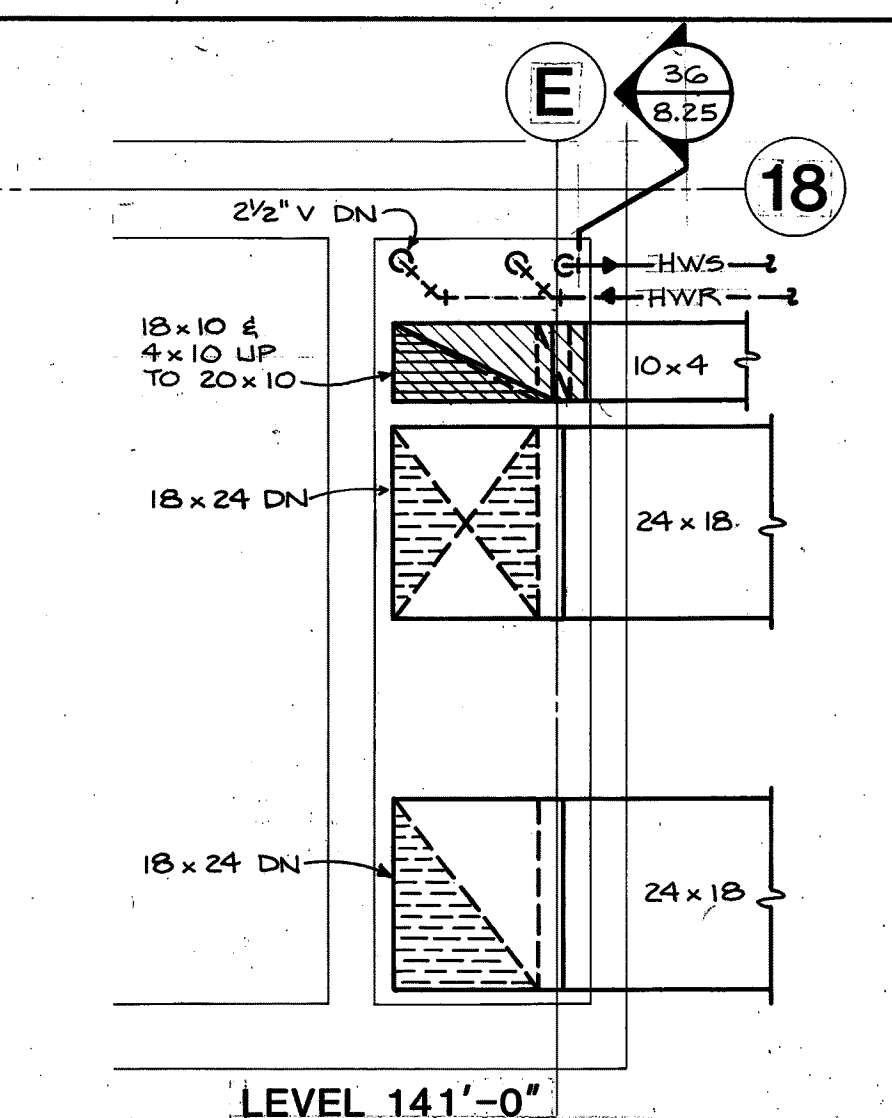


**LEVEL 141'-0"**


**LEVEL 129'-0"**

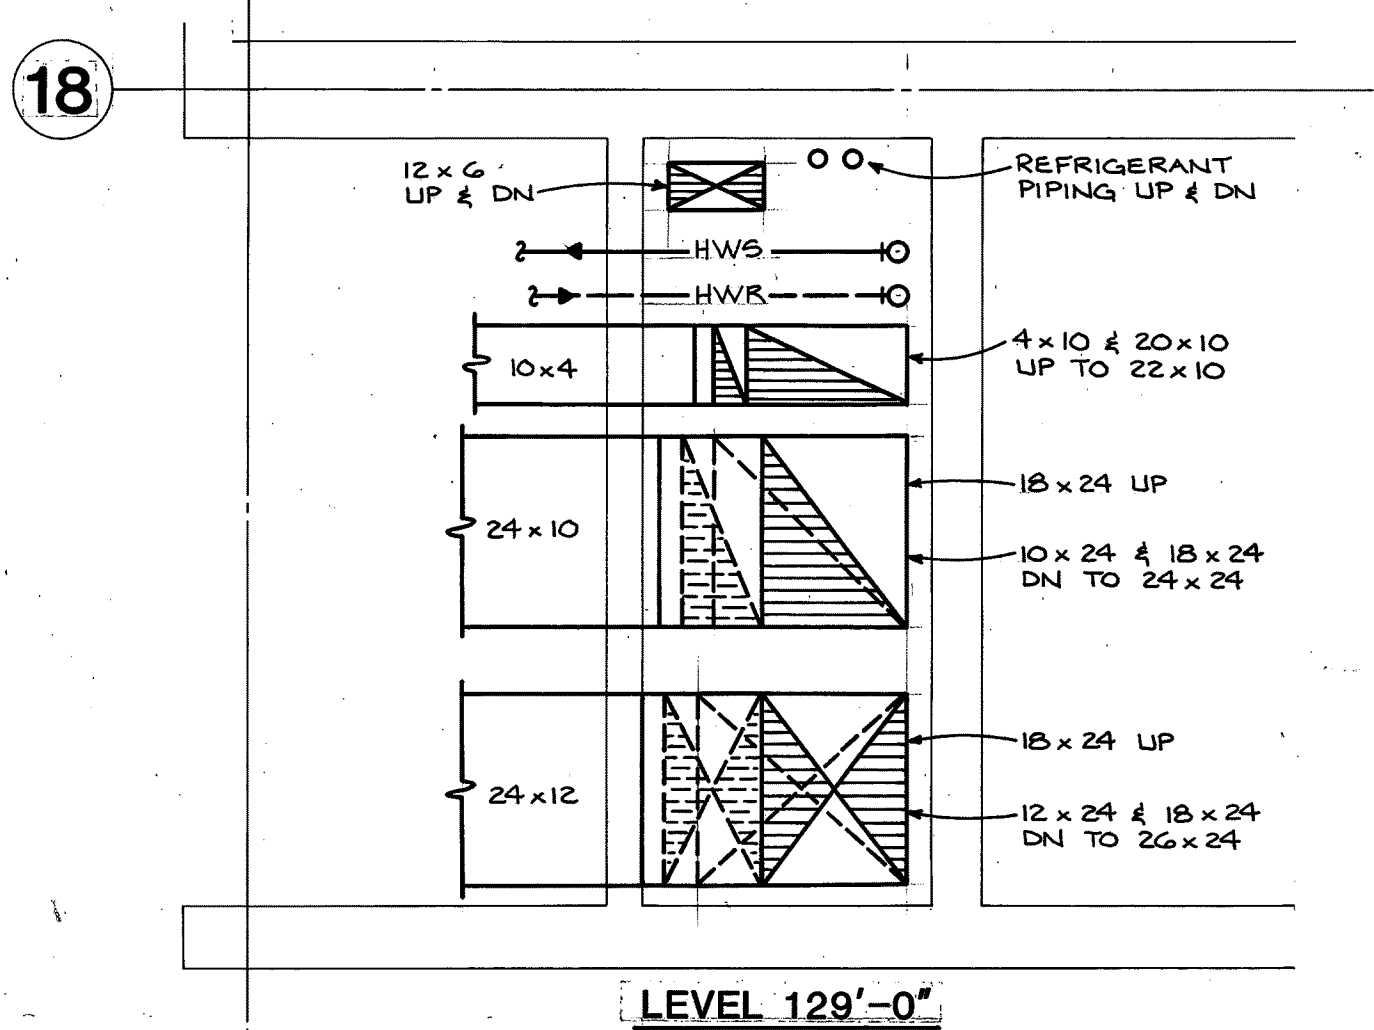

**LEVEL 118'-6"**

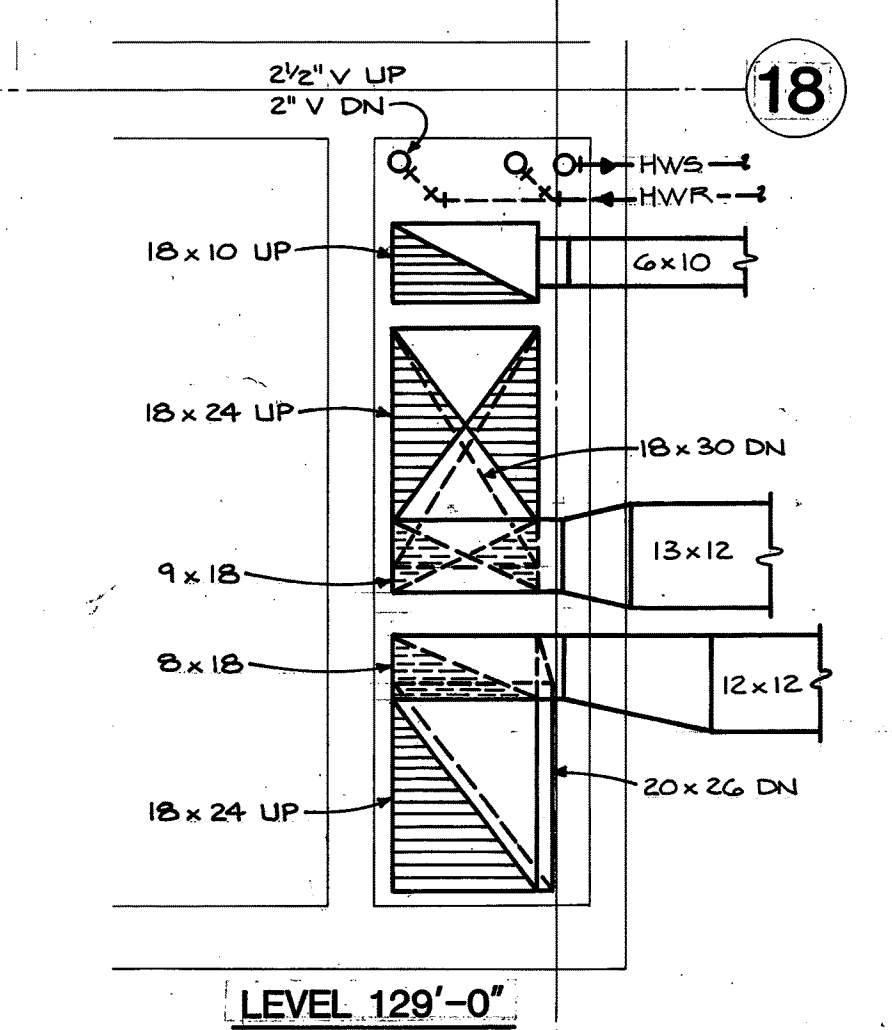


**LEVEL 118'-6"**

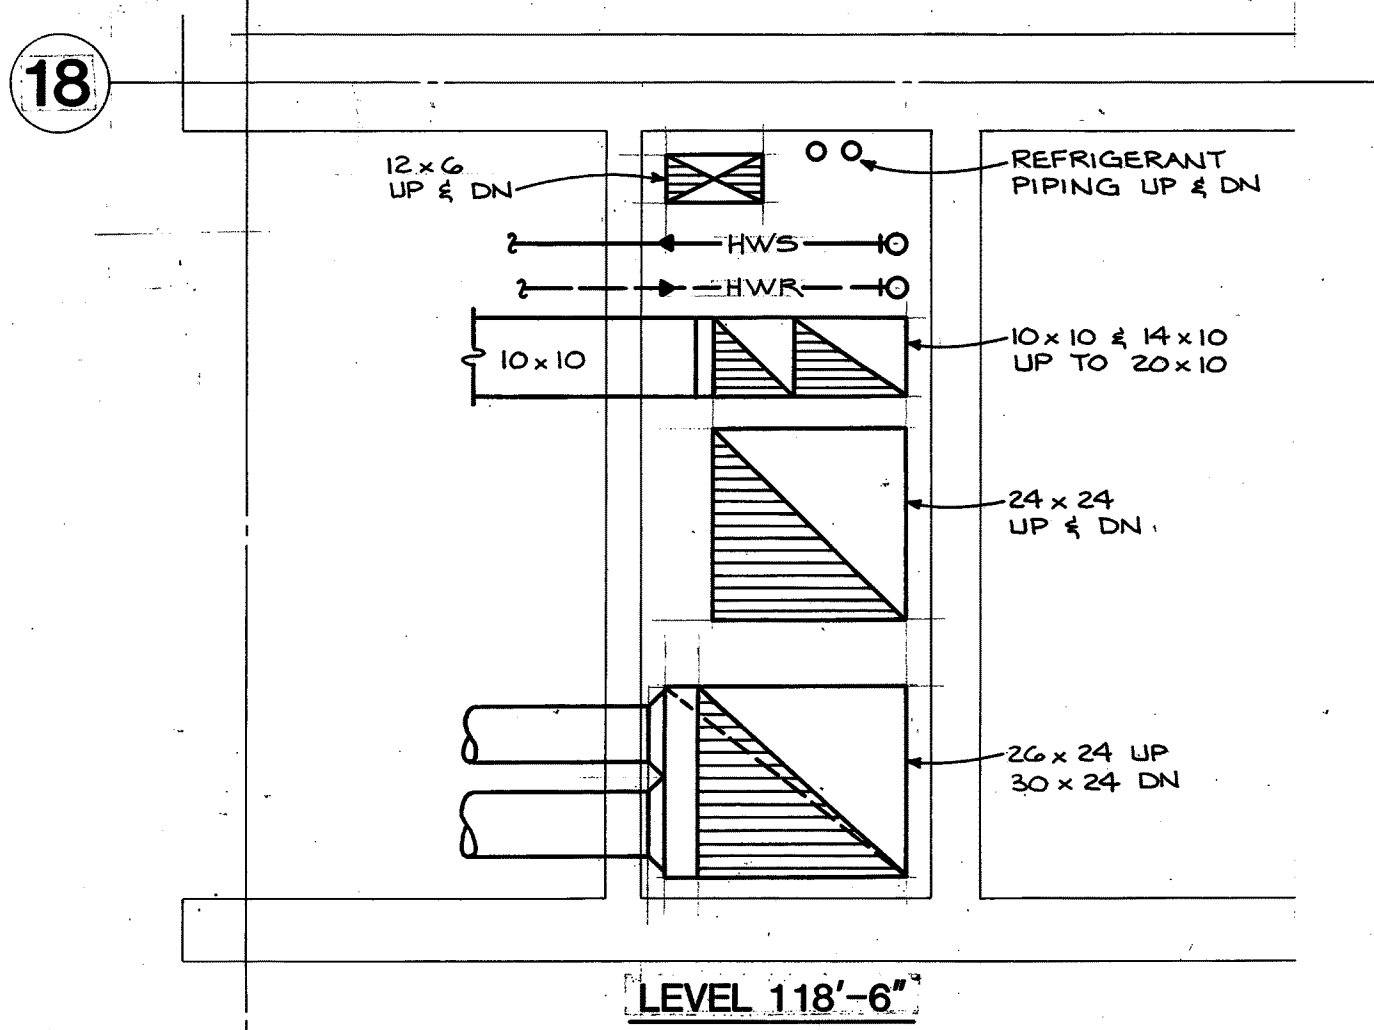


**LEVEL 108'-0"**

**LEVEL 97'-6"**

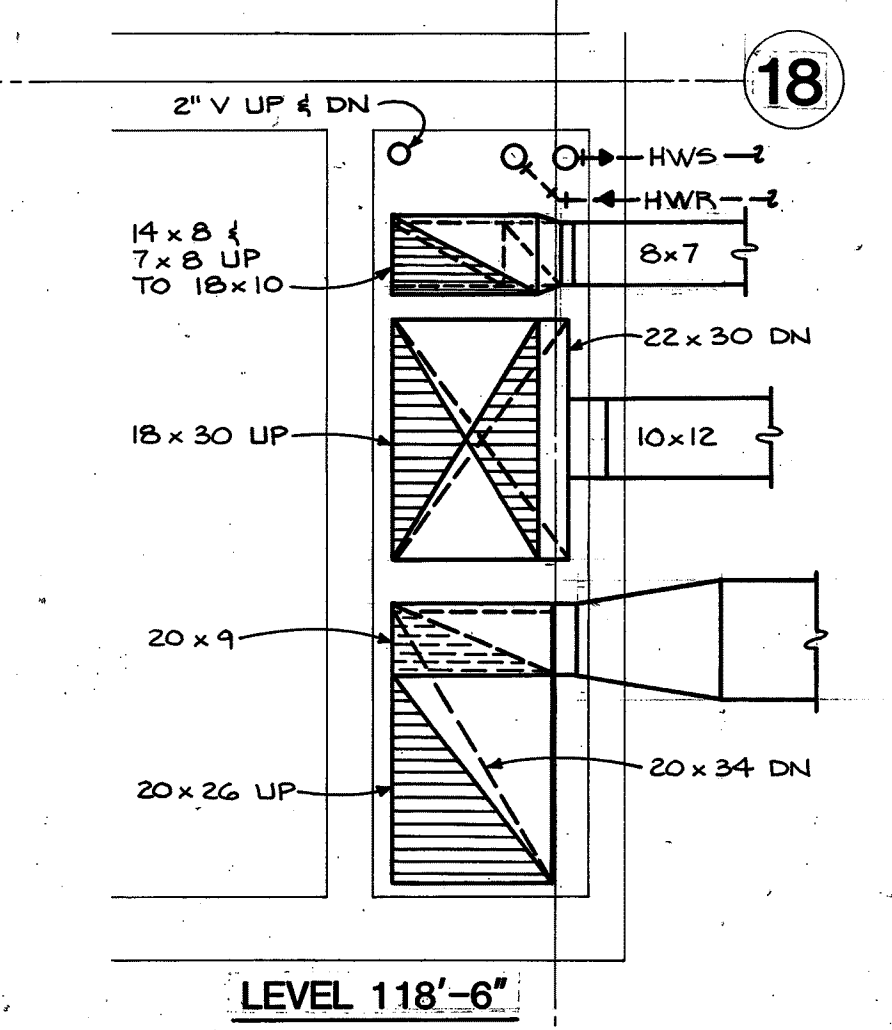


**LEVEL 108'-0"**


**LEVEL 97'-6"**

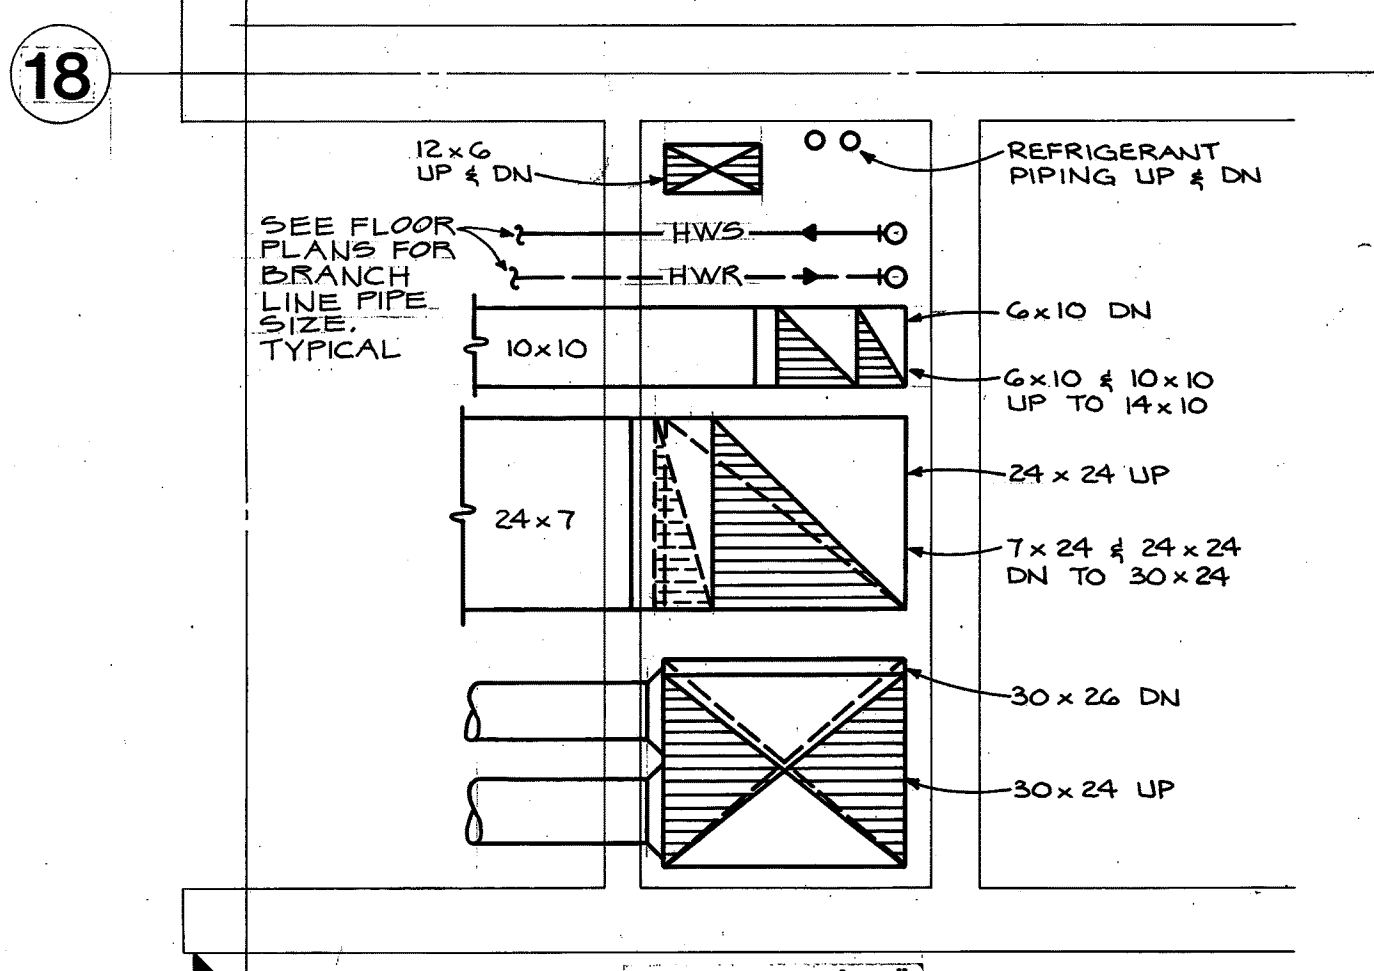


**LEVEL 79'-0"**

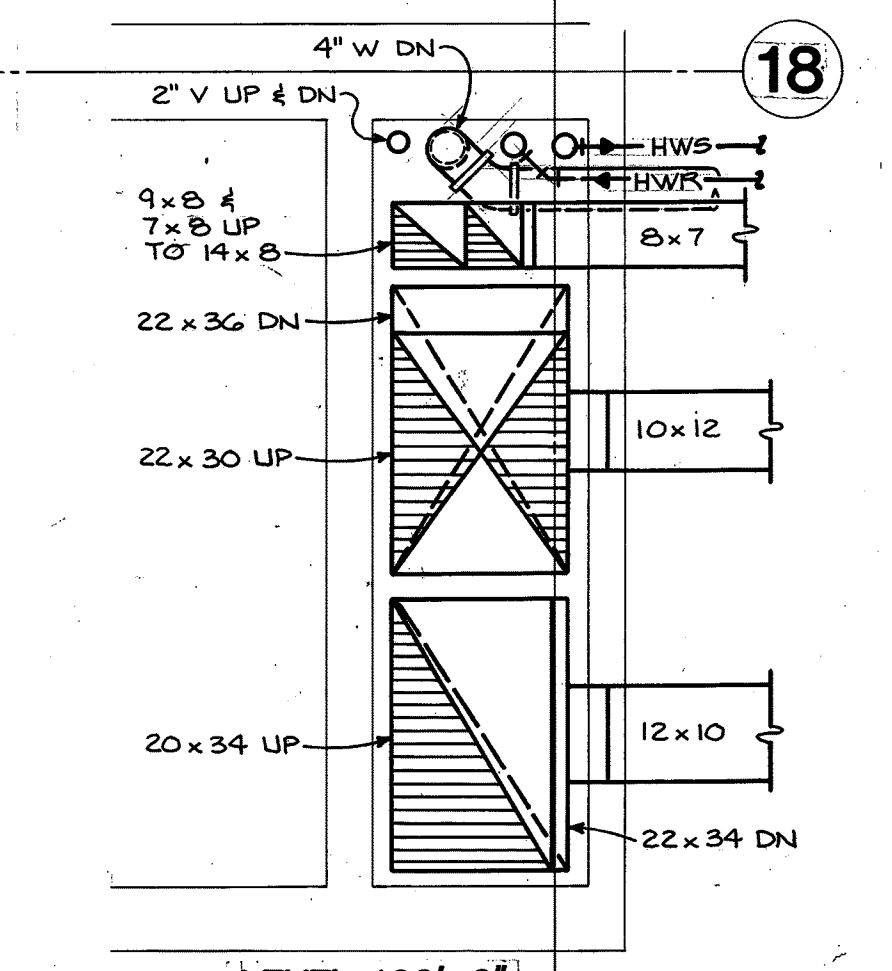


**LEVEL 79'-0"**

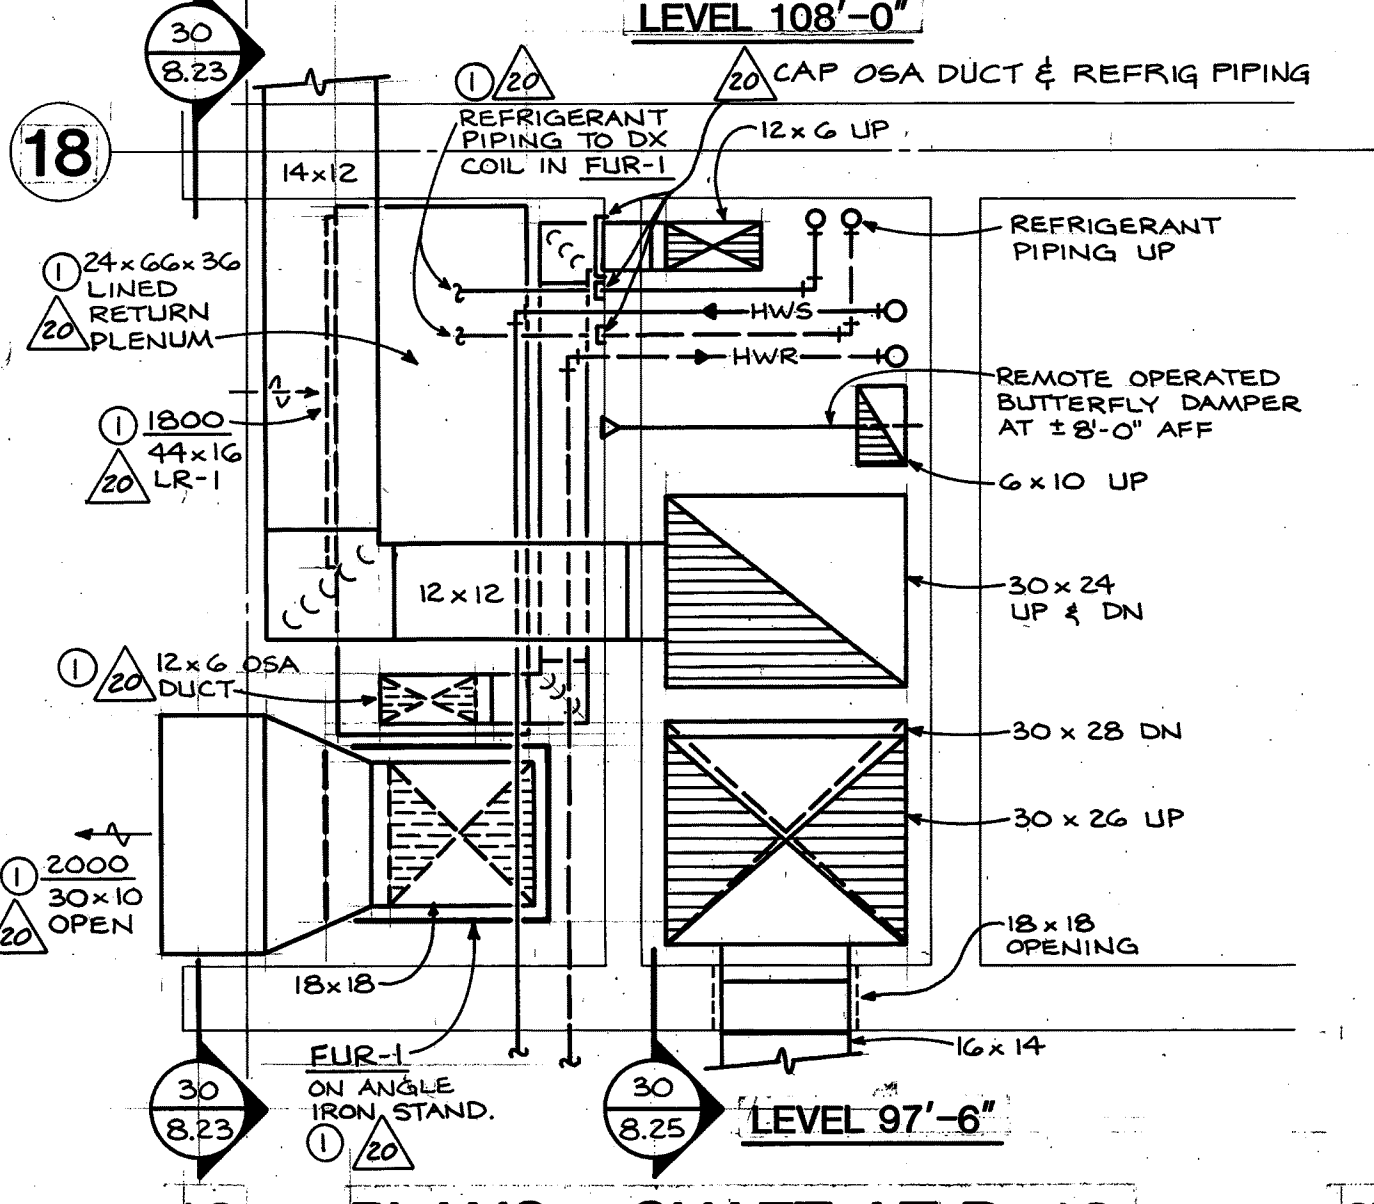


**TUNNEL 72'-4"**

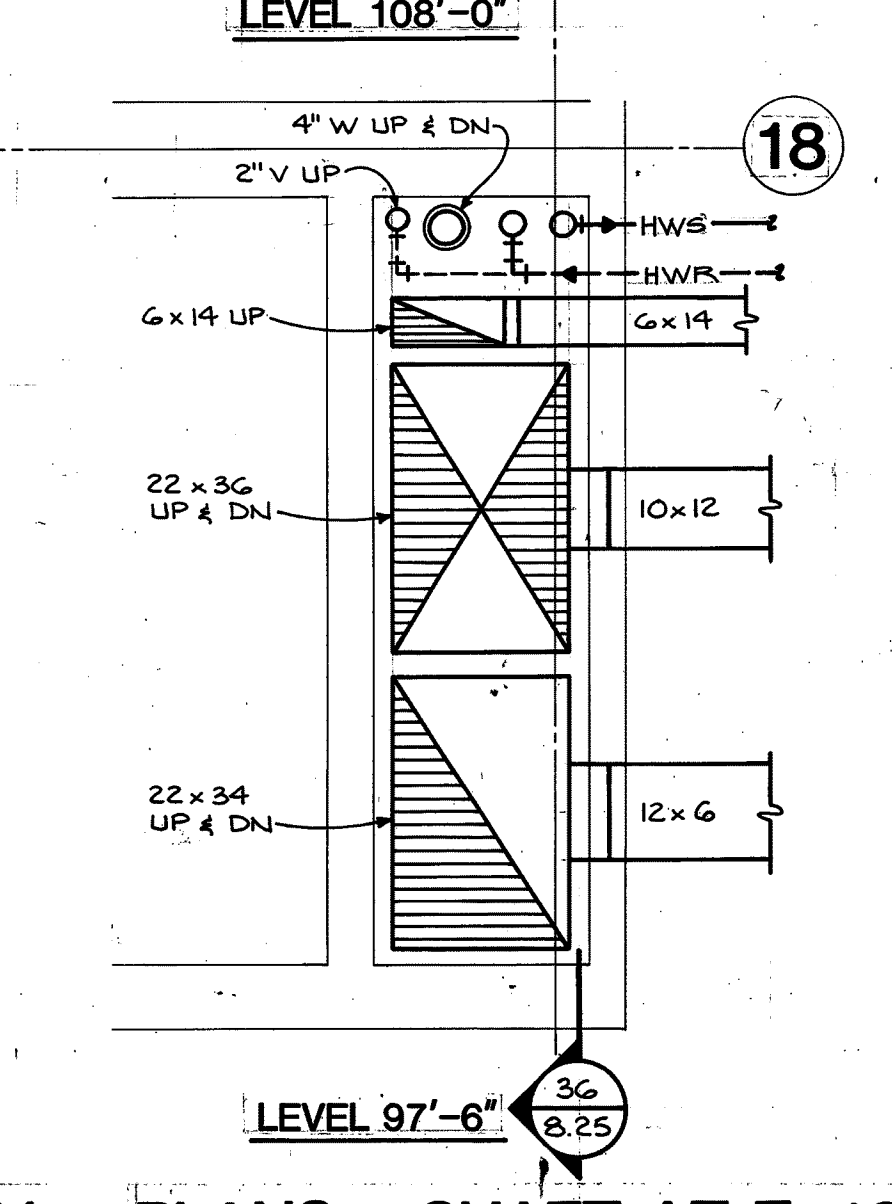


**TUNNEL 72'-4"**

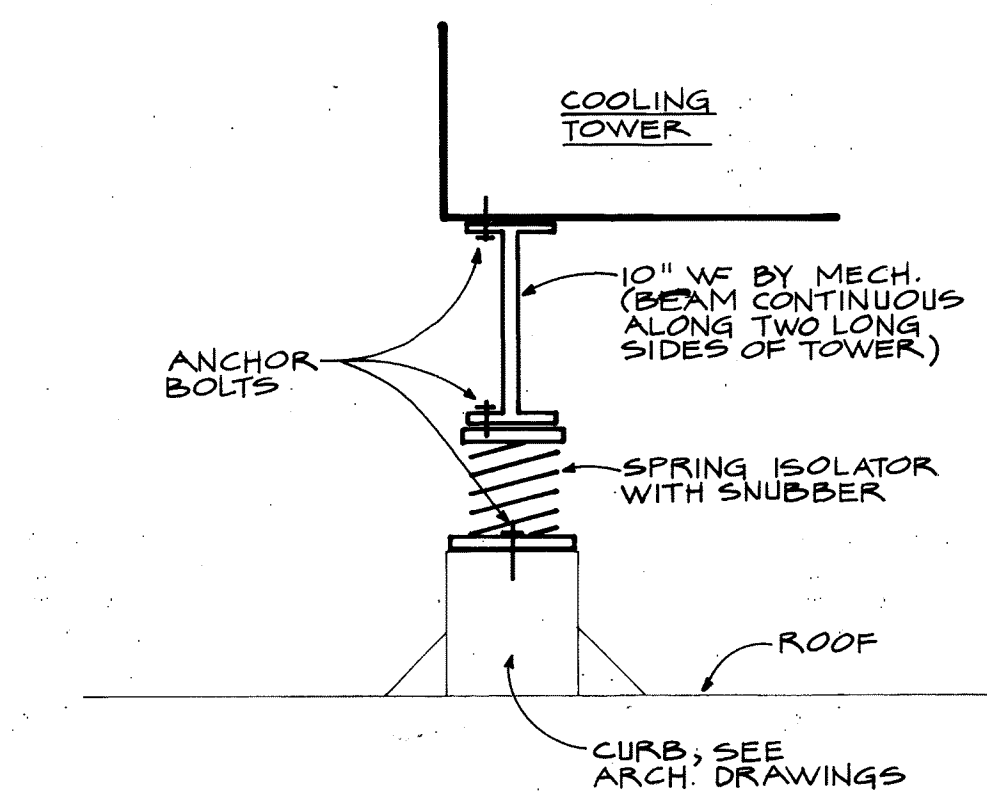


**2** **DETAIL - TOWER SUPPORT**  
NO SCALE

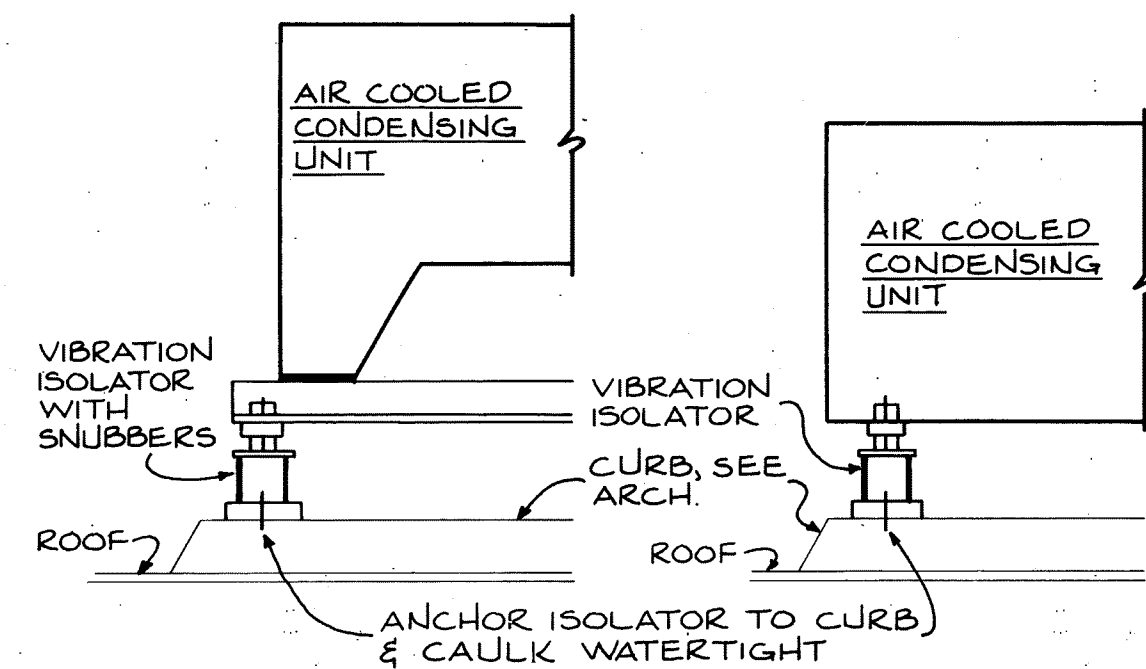


**8** **DETAIL - ACCU MOUNTING**  
NO SCALE

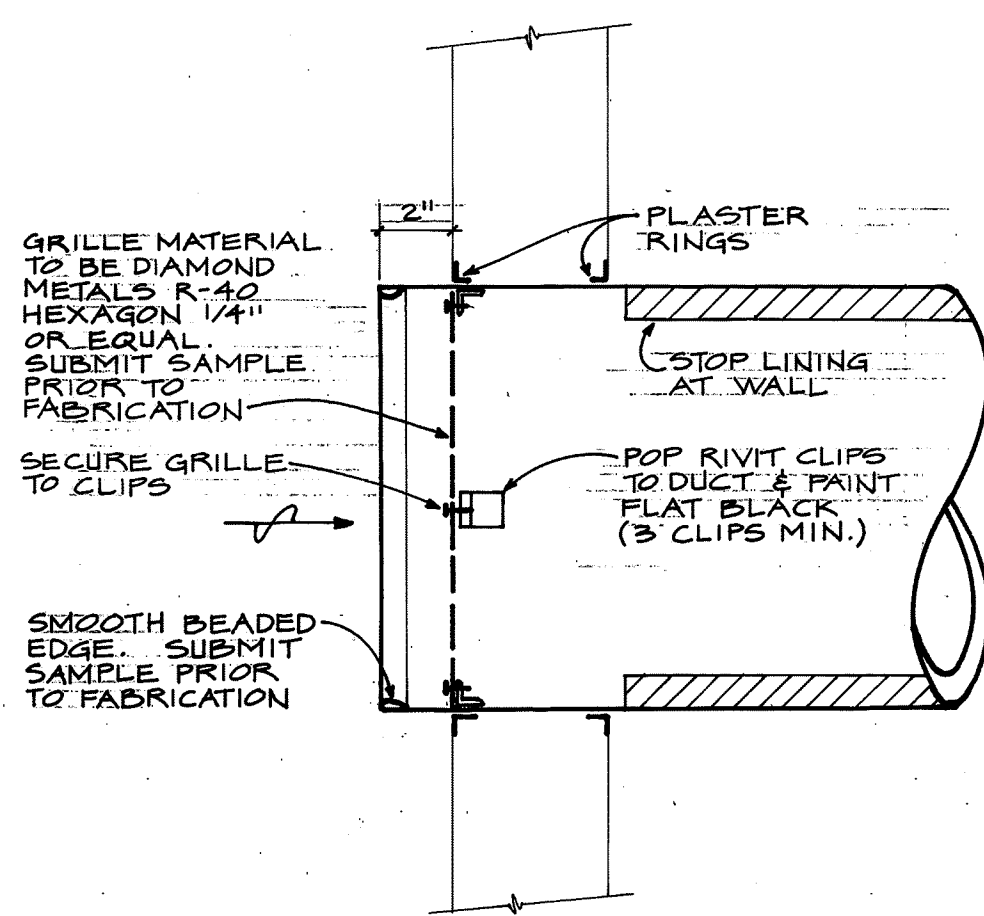


**14** **DETAIL - ROUND RETURN OR EXHAUST GRILLES**  
NO SCALE

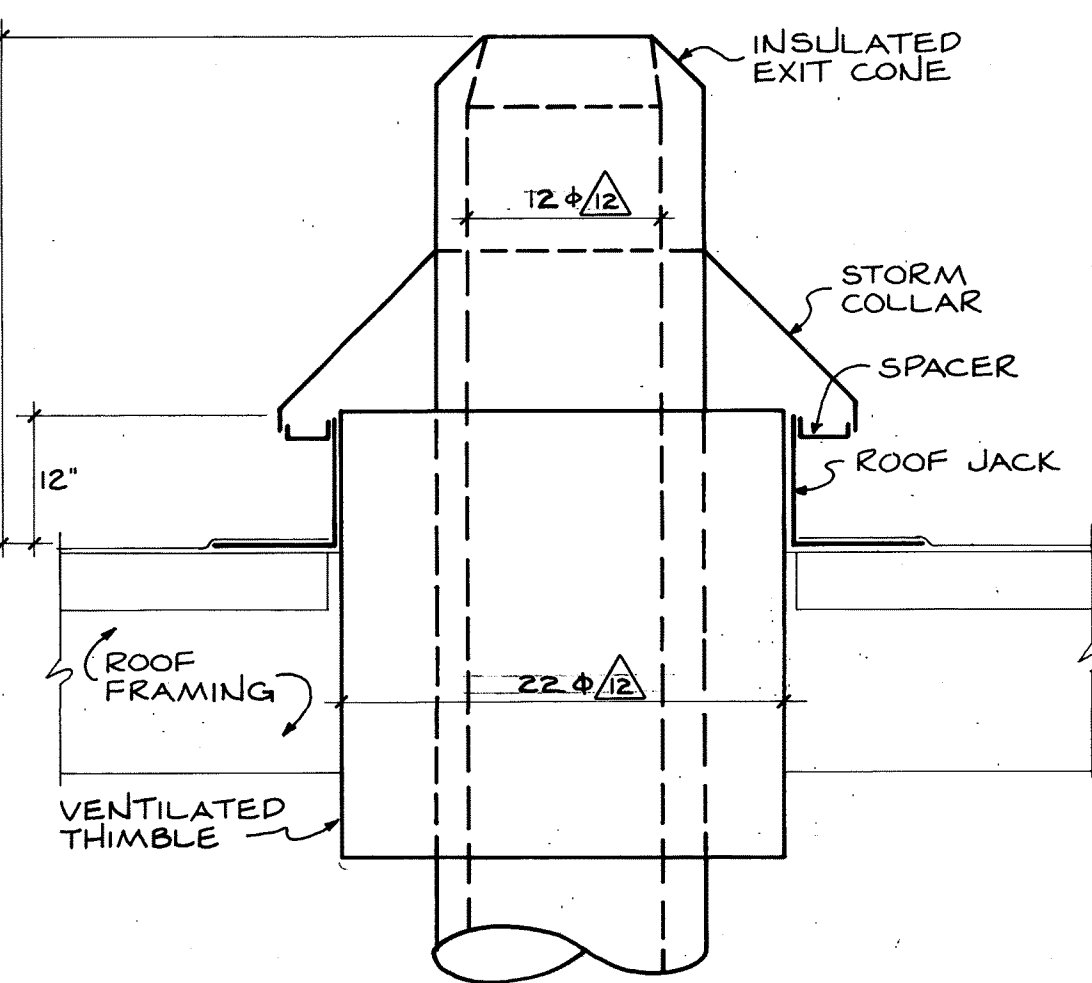


**3** **DETAIL - STACK THROUGH ROOF**  
NO SCALE

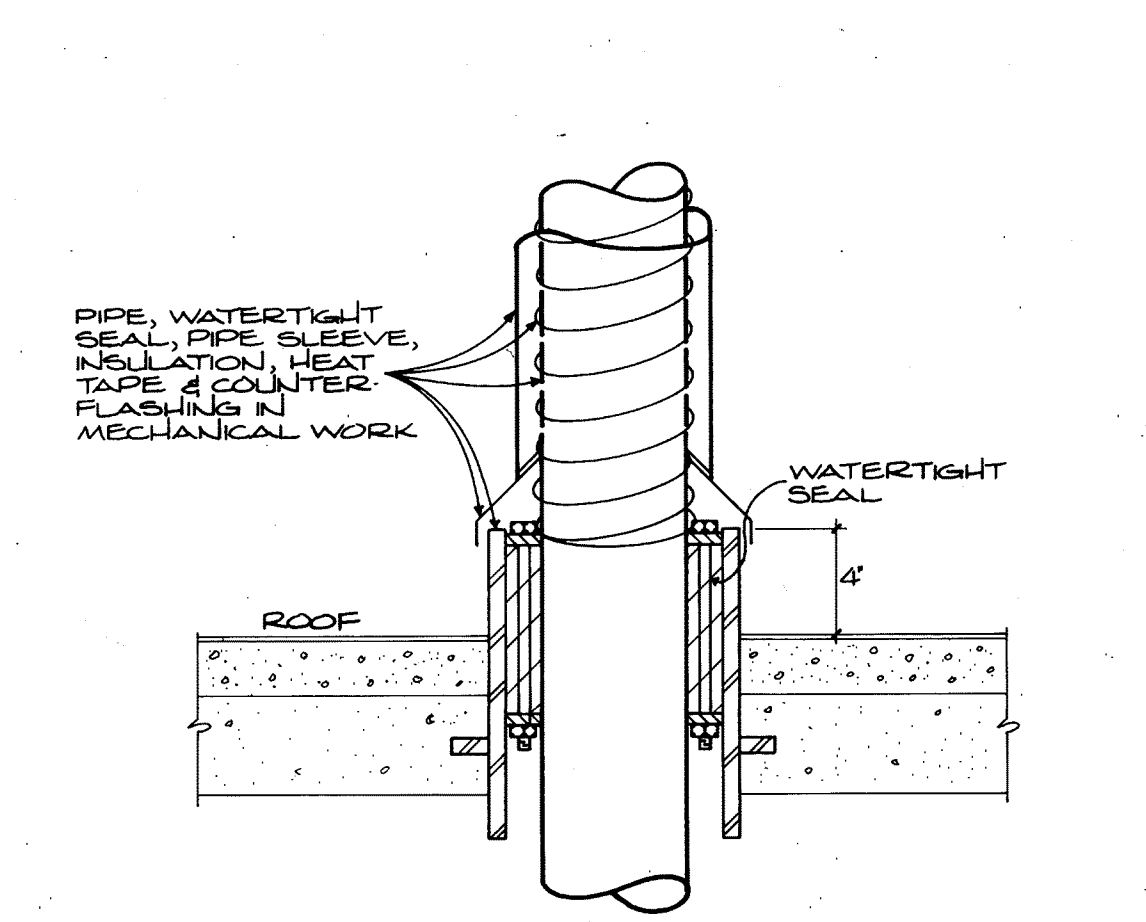


**9** **DETAIL - PIPE PENETRATION THROUGH ROOF**  
NO SCALE

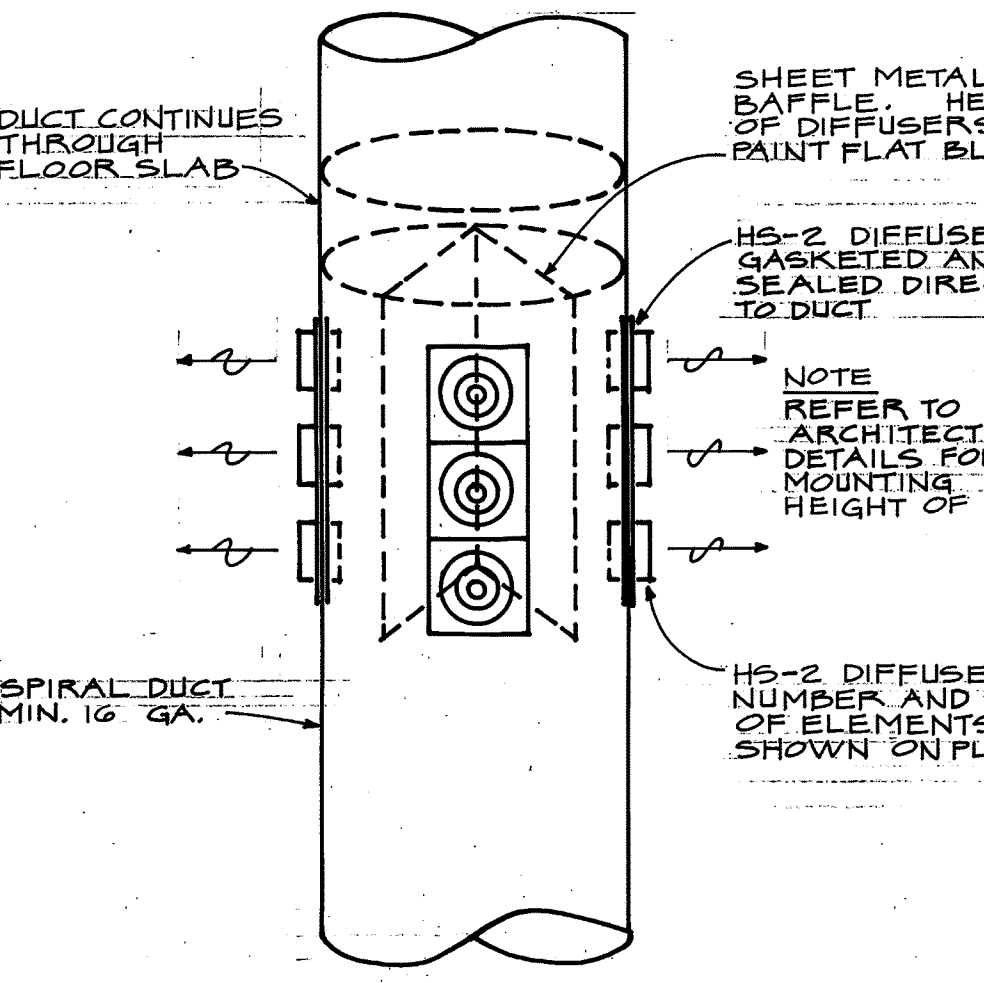


**15** **DETAIL - DUCT SUPPLY COLUMN**

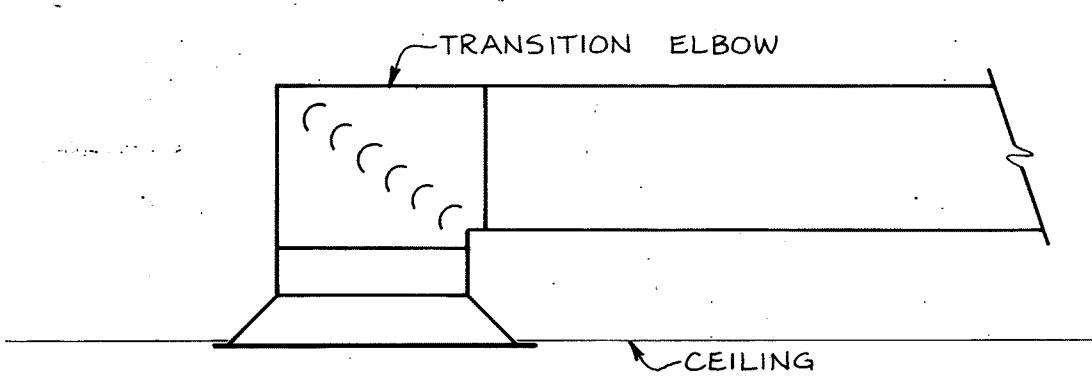


**5** **DETAIL - CEILING OUTLET**  
NO SCALE

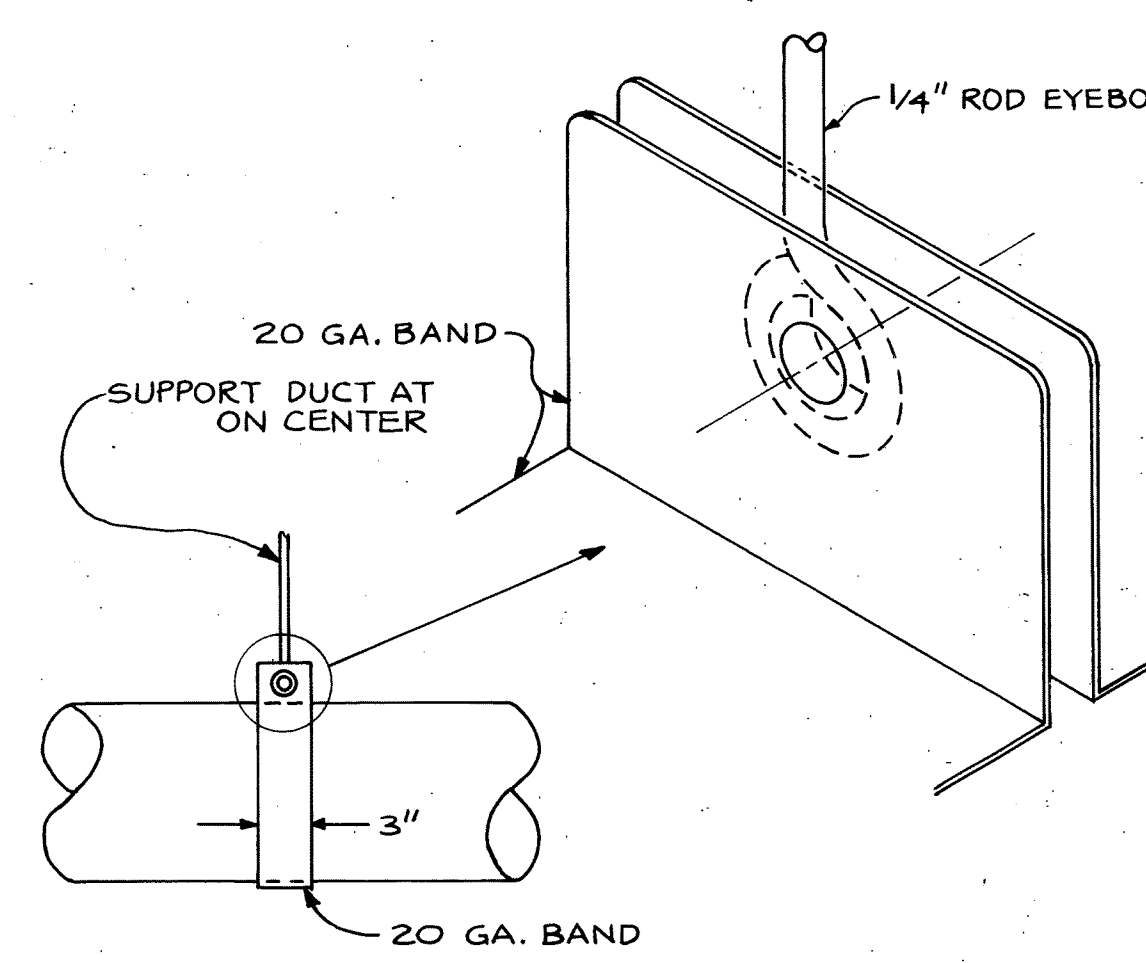


**11** **DETAIL - EXPOSED DUCT HANGER**  
NO SCALE

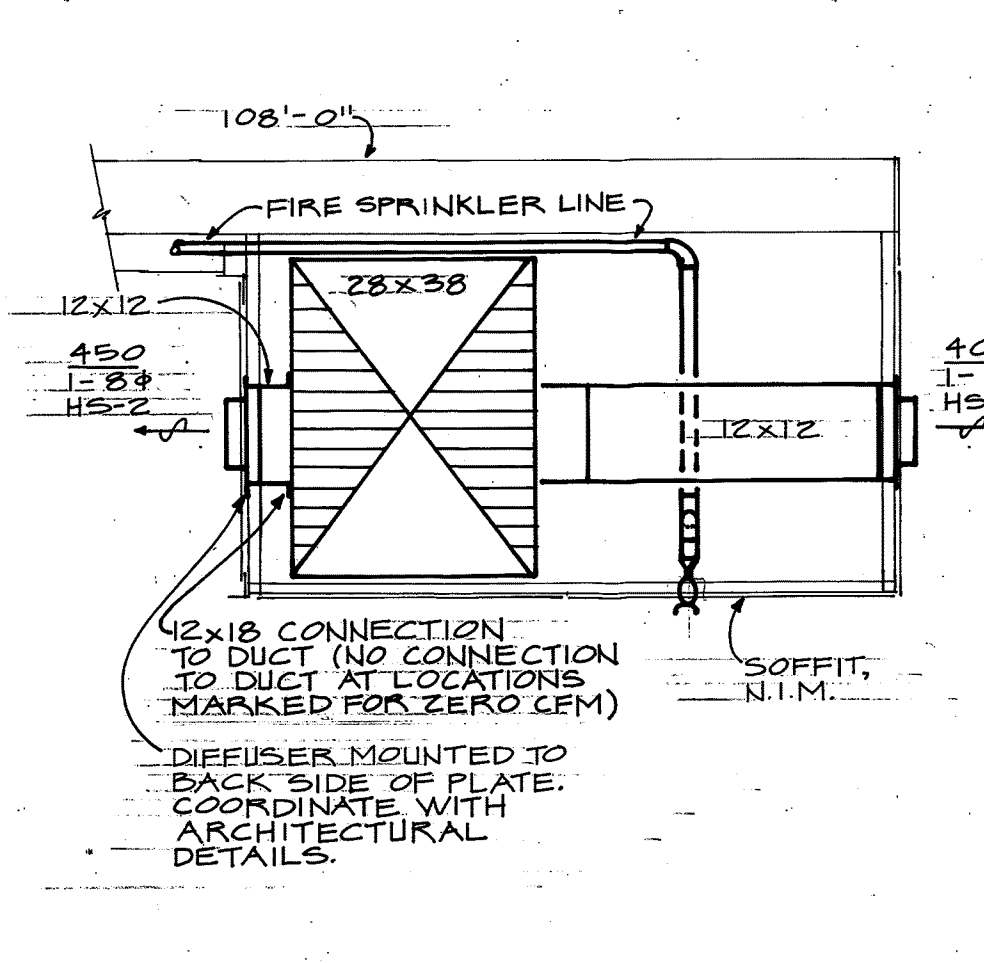


**17** **DETAIL - ATRIUM SOFFIT RING SUPPLY**  
1/2\"/>

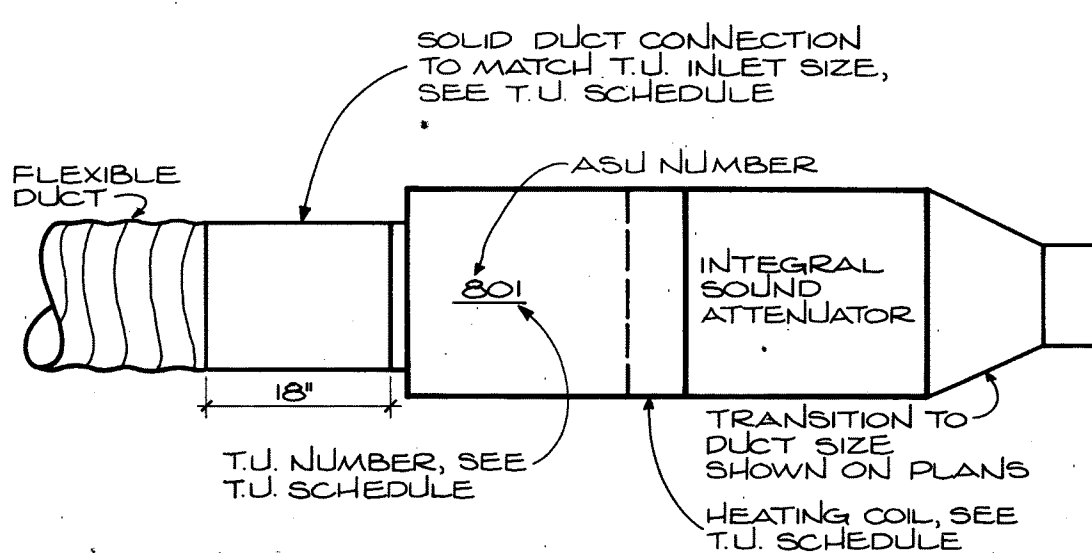

**6** **DETAIL - TERMINAL UNIT**  
NO SCALE

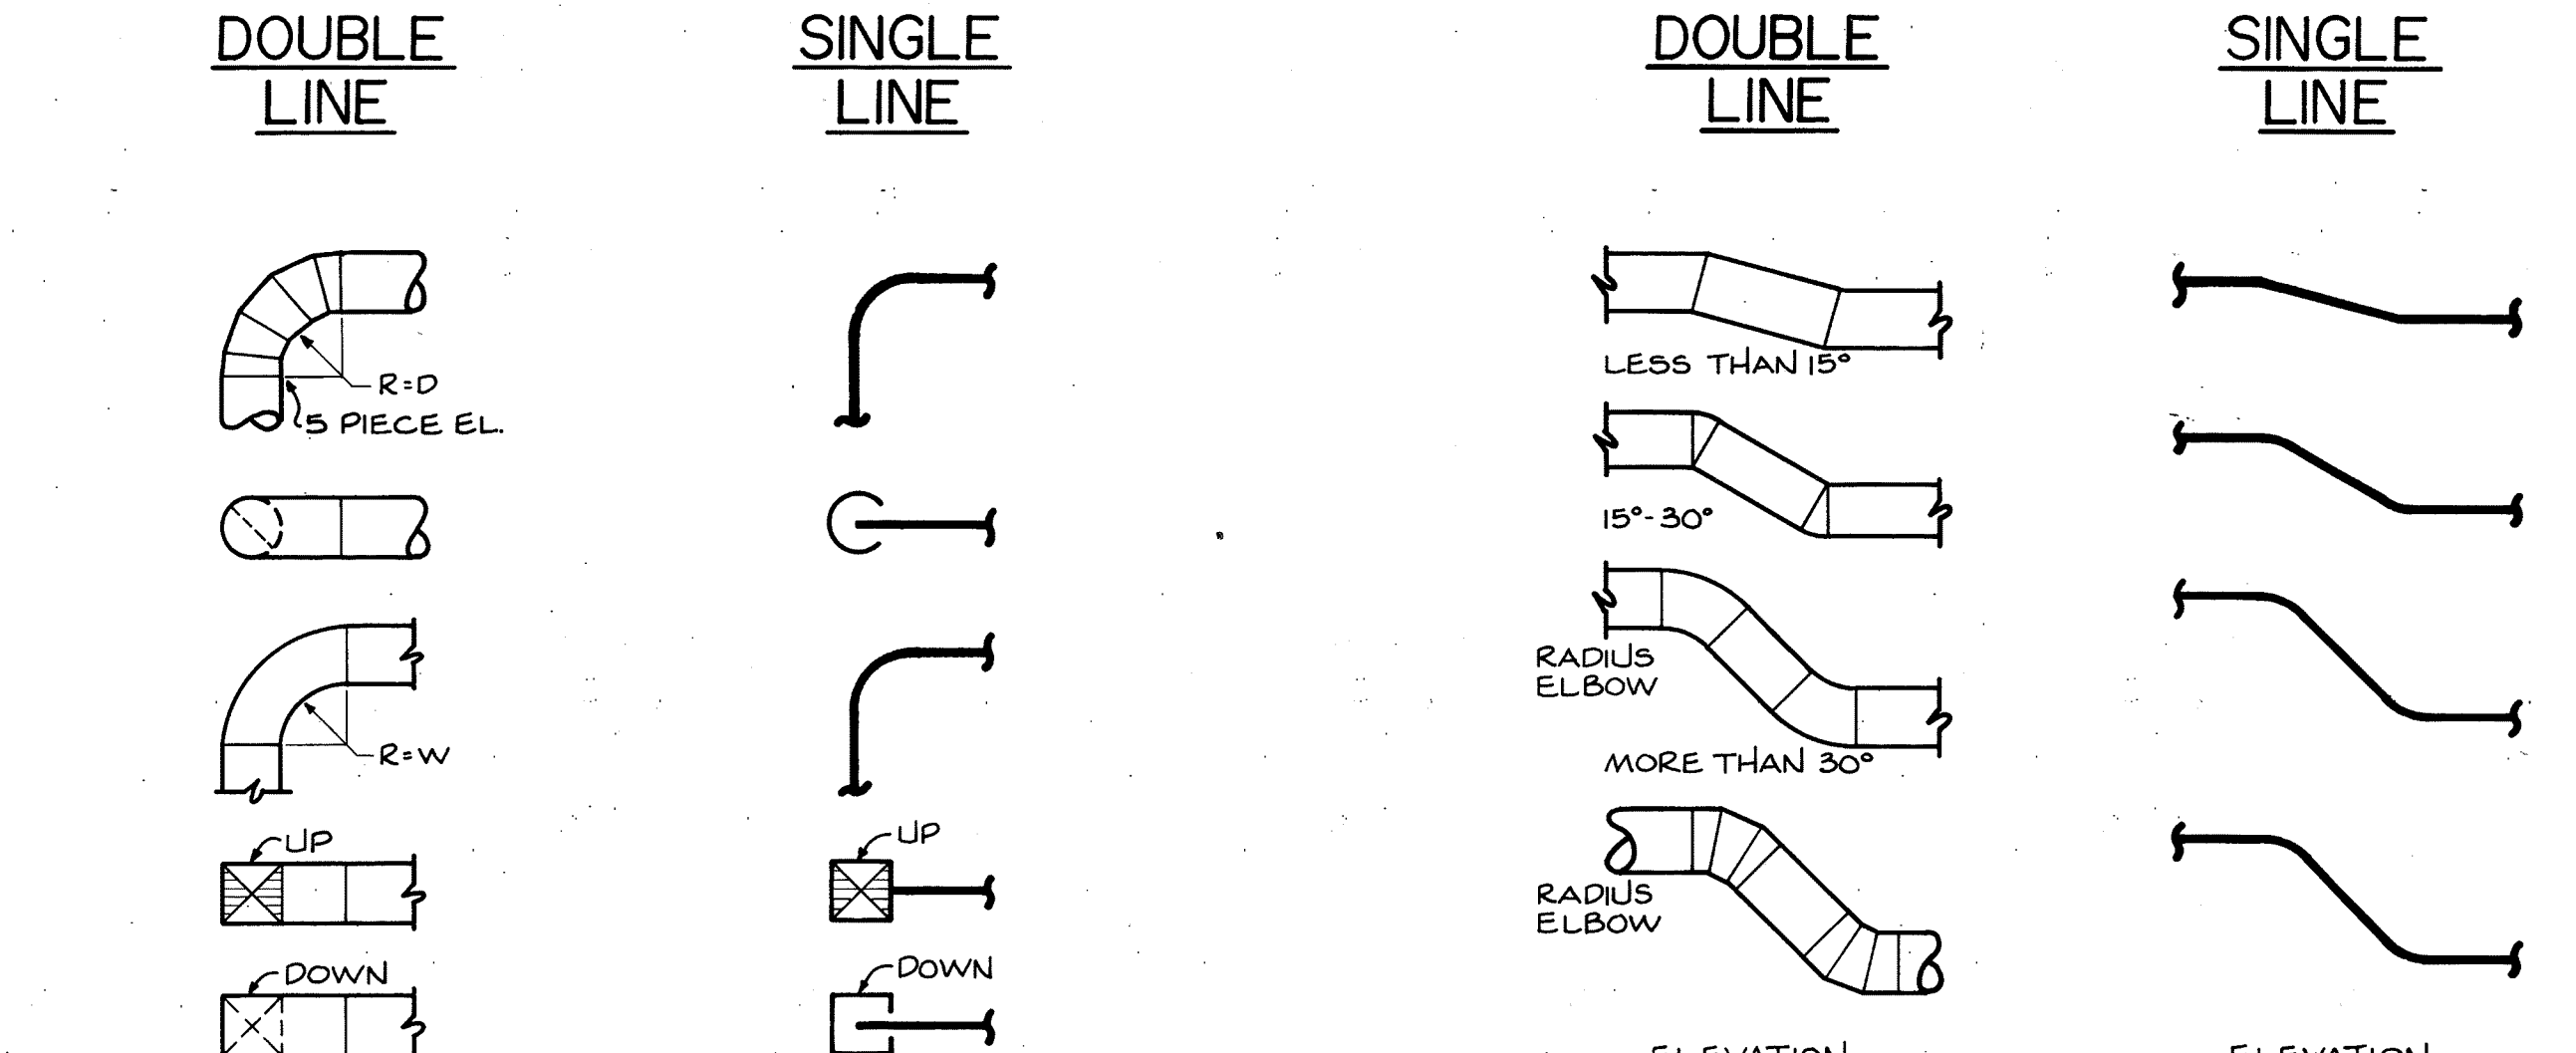

**30** **DETAILS - DUCT FITTINGS**

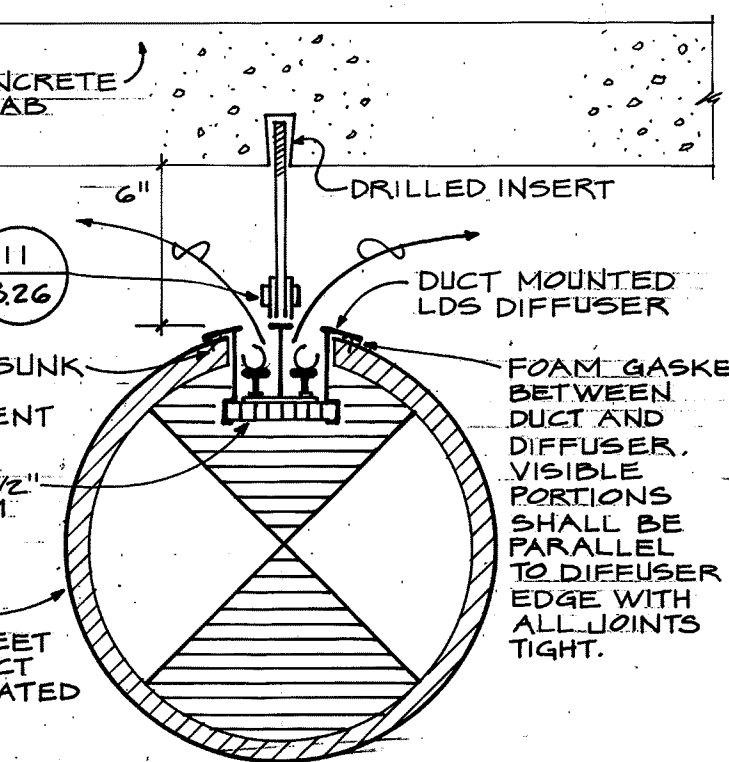

**24** **DETAIL - TYP. DUCT MTD. LDS**  
NO SCALE

NO SCALE  
NOTES:  
1. ADJUSTING DAMPER REQUIRED FOR EACH LOW PRESSURE SUPPLY, RETURN & EXH. BRANCH.  
2. 32 X 14 - FIRST DIMENSION IS THE SIDE SEEN. IN SECTION THE FIRST DIMENSION IS THE HORIZONTAL SIDE.

**Portland Center for the Performing Arts**

The City of Portland  
Honorable Mildred A. Schwab  
Commissioner in Charge  
Ronald K. Ragen  
Chairman  
Performing Arts Center Committee

Architects  
Broome, Oringduiph, O'Toole, Rudolf & Associates pc  
EIS Design Group  
Barton Myers  
Project Address  
733 N.W. 20th Avenue  
Portland, Oregon 97209  
(503) 226-1575  
Consultants  
Theatre Projects Inc.  
Theatre Consultants  
R. Lawrence Kirkegaard & Associates  
Acoustician  
CH2M Hill  
Structural Engineers  
C.W. Timmer Associates  
Mechanical Engineers  
Interface Engineering Inc.  
Electrical Engineers



Target	Revision Item	Revision Date
△	Addendum #1	10/29/84
△	Addendum #2	11/06/84
△	Addendum #3	11/13/84
△	Addendum #5	11/23/84
△	Proposal Request #1	03/01/85
△	Proposal Request #2	03/01/85
△	Proposal Request #3	03/01/85
△	Proposal Request #4	03/01/85
△	Proposal Request #5	03/01/85
△	Proposal Request #6	03/01/85
△	Proposal Request #7	03/01/85
△	Proposal Request #8	03/01/85
△	Proposal Request #9	03/01/85
△	Proposal Request #10	03/01/85
△	Proposal Request #11	03/01/85
△	Proposal Request #12	03/01/85
△	Proposal Request #13	03/01/85
△	Proposal Request #14	03/01/85
△	Clarification Items	03/01/85
△	Miscellaneous Items	03/01/85

Revisions  
**New Theatre Building**

**DETAILS HVAC**

Date: OCT. 12, 1984  
Scale: NONE  
Drawing No. **8.26**

C.W. Timmer Associates Inc.  
Consulting Engineers  
1644-20

The City of Portland

Honorable Mildred A. Schwab  
Commissioner in Charge  
Chairman  
Ronald K. Ragen  
Chairman  
Performing Arts Center Committee

Architects  
Broome, Oringdolph, O'Toole, Rudolf & Associates pc  
E/S Design Group  
Barton Myers  
Project Address  
733 N.W. 20th Avenue  
Portland, Oregon 97209  
(503) 226-1575

Consultants  
Theatre Projects Inc.  
Theatre Consultants  
R. Lawrence Kirkegaard & Associates  
Acoustician  
CH2M Hill  
Structural Engineers  
C.W. Timmer Associates  
Mechanical Engineers  
Interface Engineering Inc.  
Electrical Engineers



Target	Revision Item	Revision Date
▲	Addendum #1	10/29/84
▲	Addendum #2	11/06/84
▲	Addendum #4	11/13/84
▲	Addendum #5	11/21/84
▲	Proposal Request #1	03/01/85
▲	Proposal Request #2	03/01/85
▲	Proposal Request #3	03/01/85
▲	Proposal Request #4	03/01/85
▲	Proposal Request #5	03/01/85
▲	Proposal Request #6	03/01/85
▲	Proposal Request #7	03/01/85
▲	Proposal Request #8	03/01/85
▲	Proposal Request #9	03/01/85
▲	Proposal Request #10	03/01/85
▲	Proposal Request #11	03/01/85
▲	Proposal Request #12	03/01/85
▲	Proposal Request #13	03/01/85
▲	Proposal Request #14	03/01/85
▲	Clarification Items	03/01/85
▲	Miscellaneous Items	03/01/85

Revisions

New Theatre Building


DETAILS - HVAC

Date OCT. 12, 1984


Scale AS SHOWN

Drawing No. 8.27

C.W. Timmer Associates Inc.  
Consulting Engineers  
164420

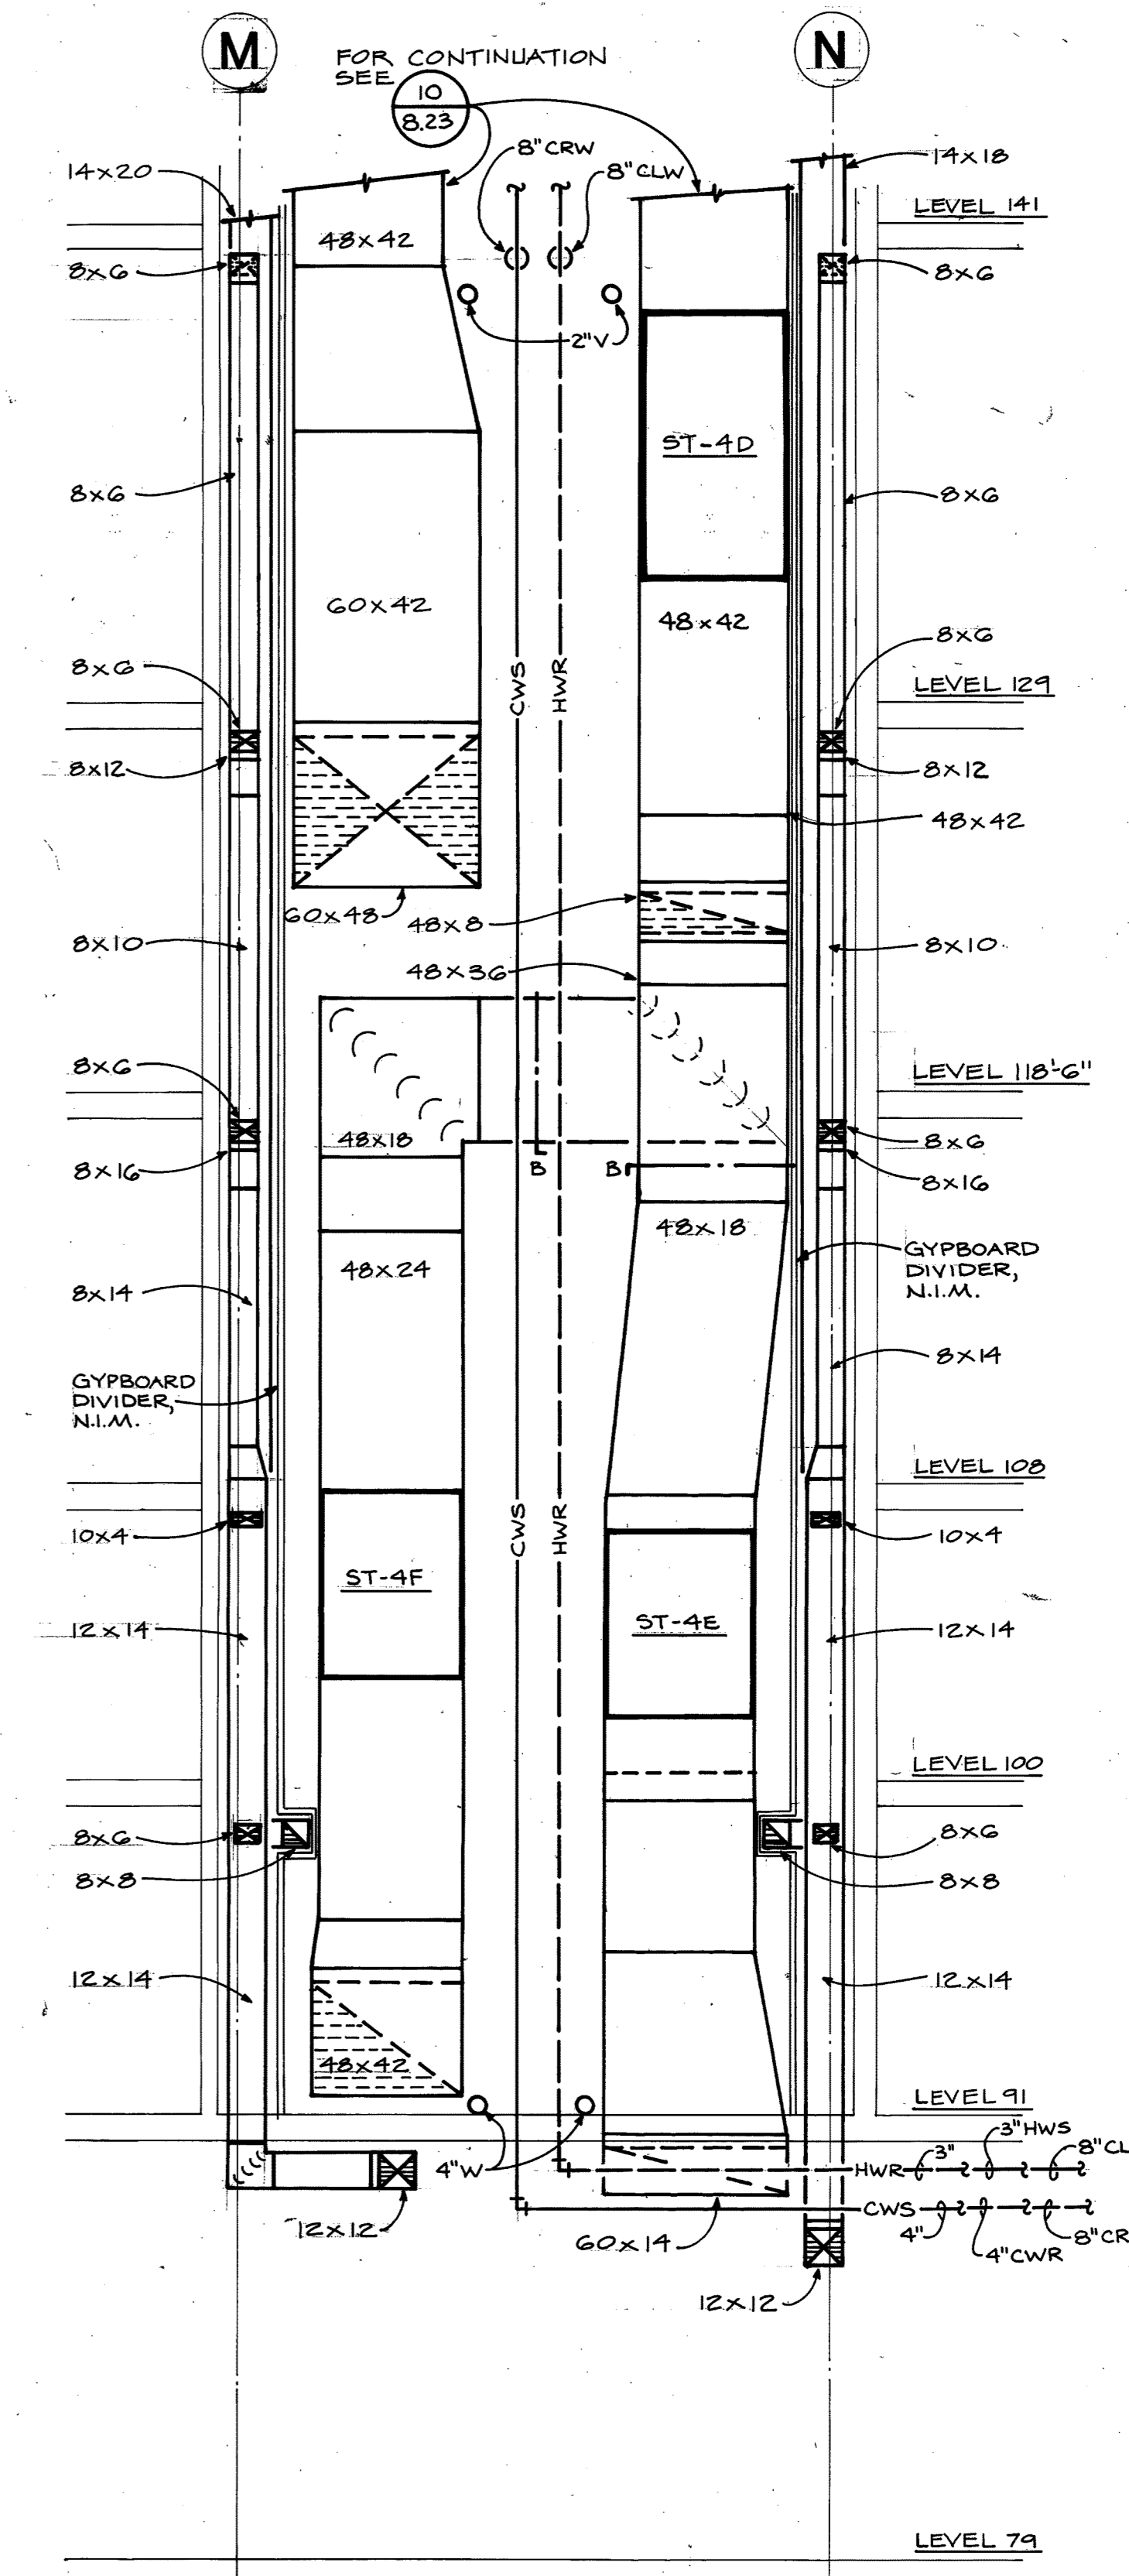


28 SECTION AT SHAFT M-N, & 4.5  
1/4" = 1'-0"

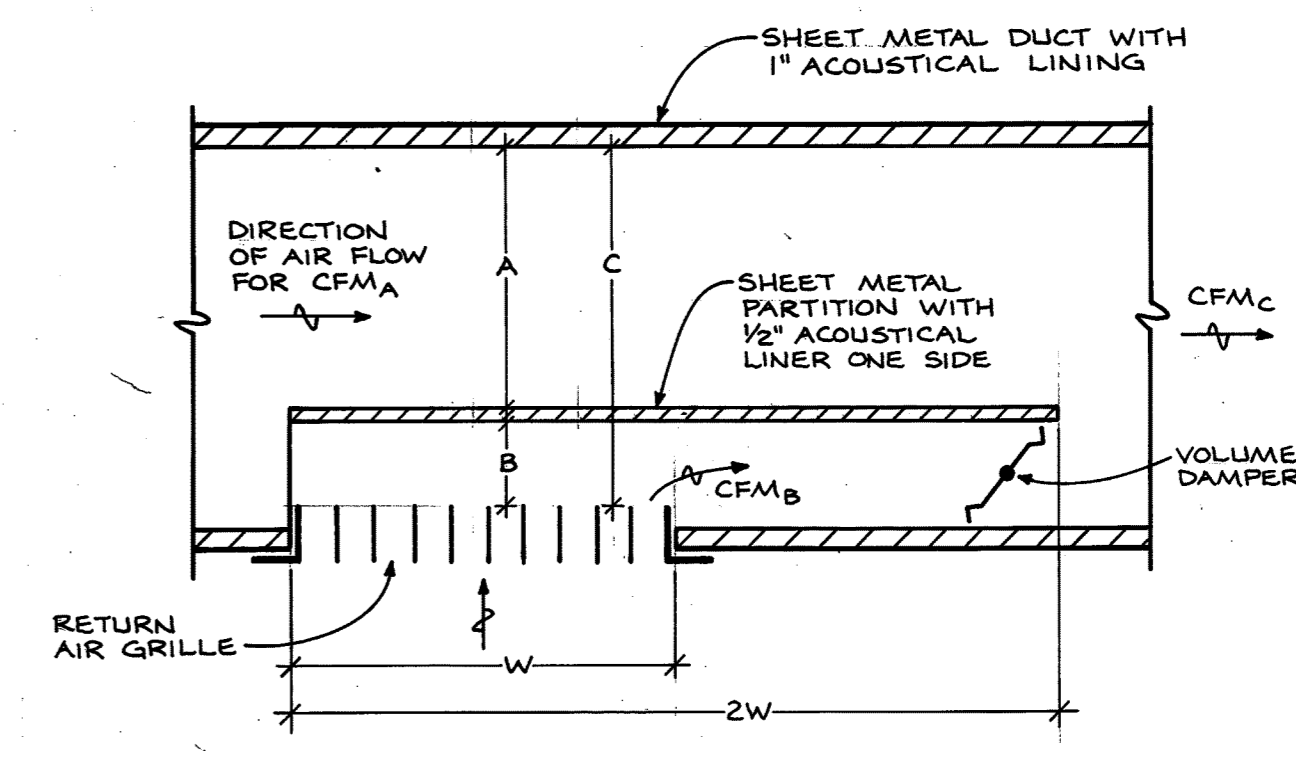


DIMENSIONAL RATIOS:  
 $A = (C - 1/2) \frac{CFM_A}{CFM_C}$   
 $B = (C - 1/2) \frac{CFM_B}{CFM_C}$   
 $C = A + B + 1/2$


30 DETAIL - RETURN AIR DAMPER  
NO SCALE

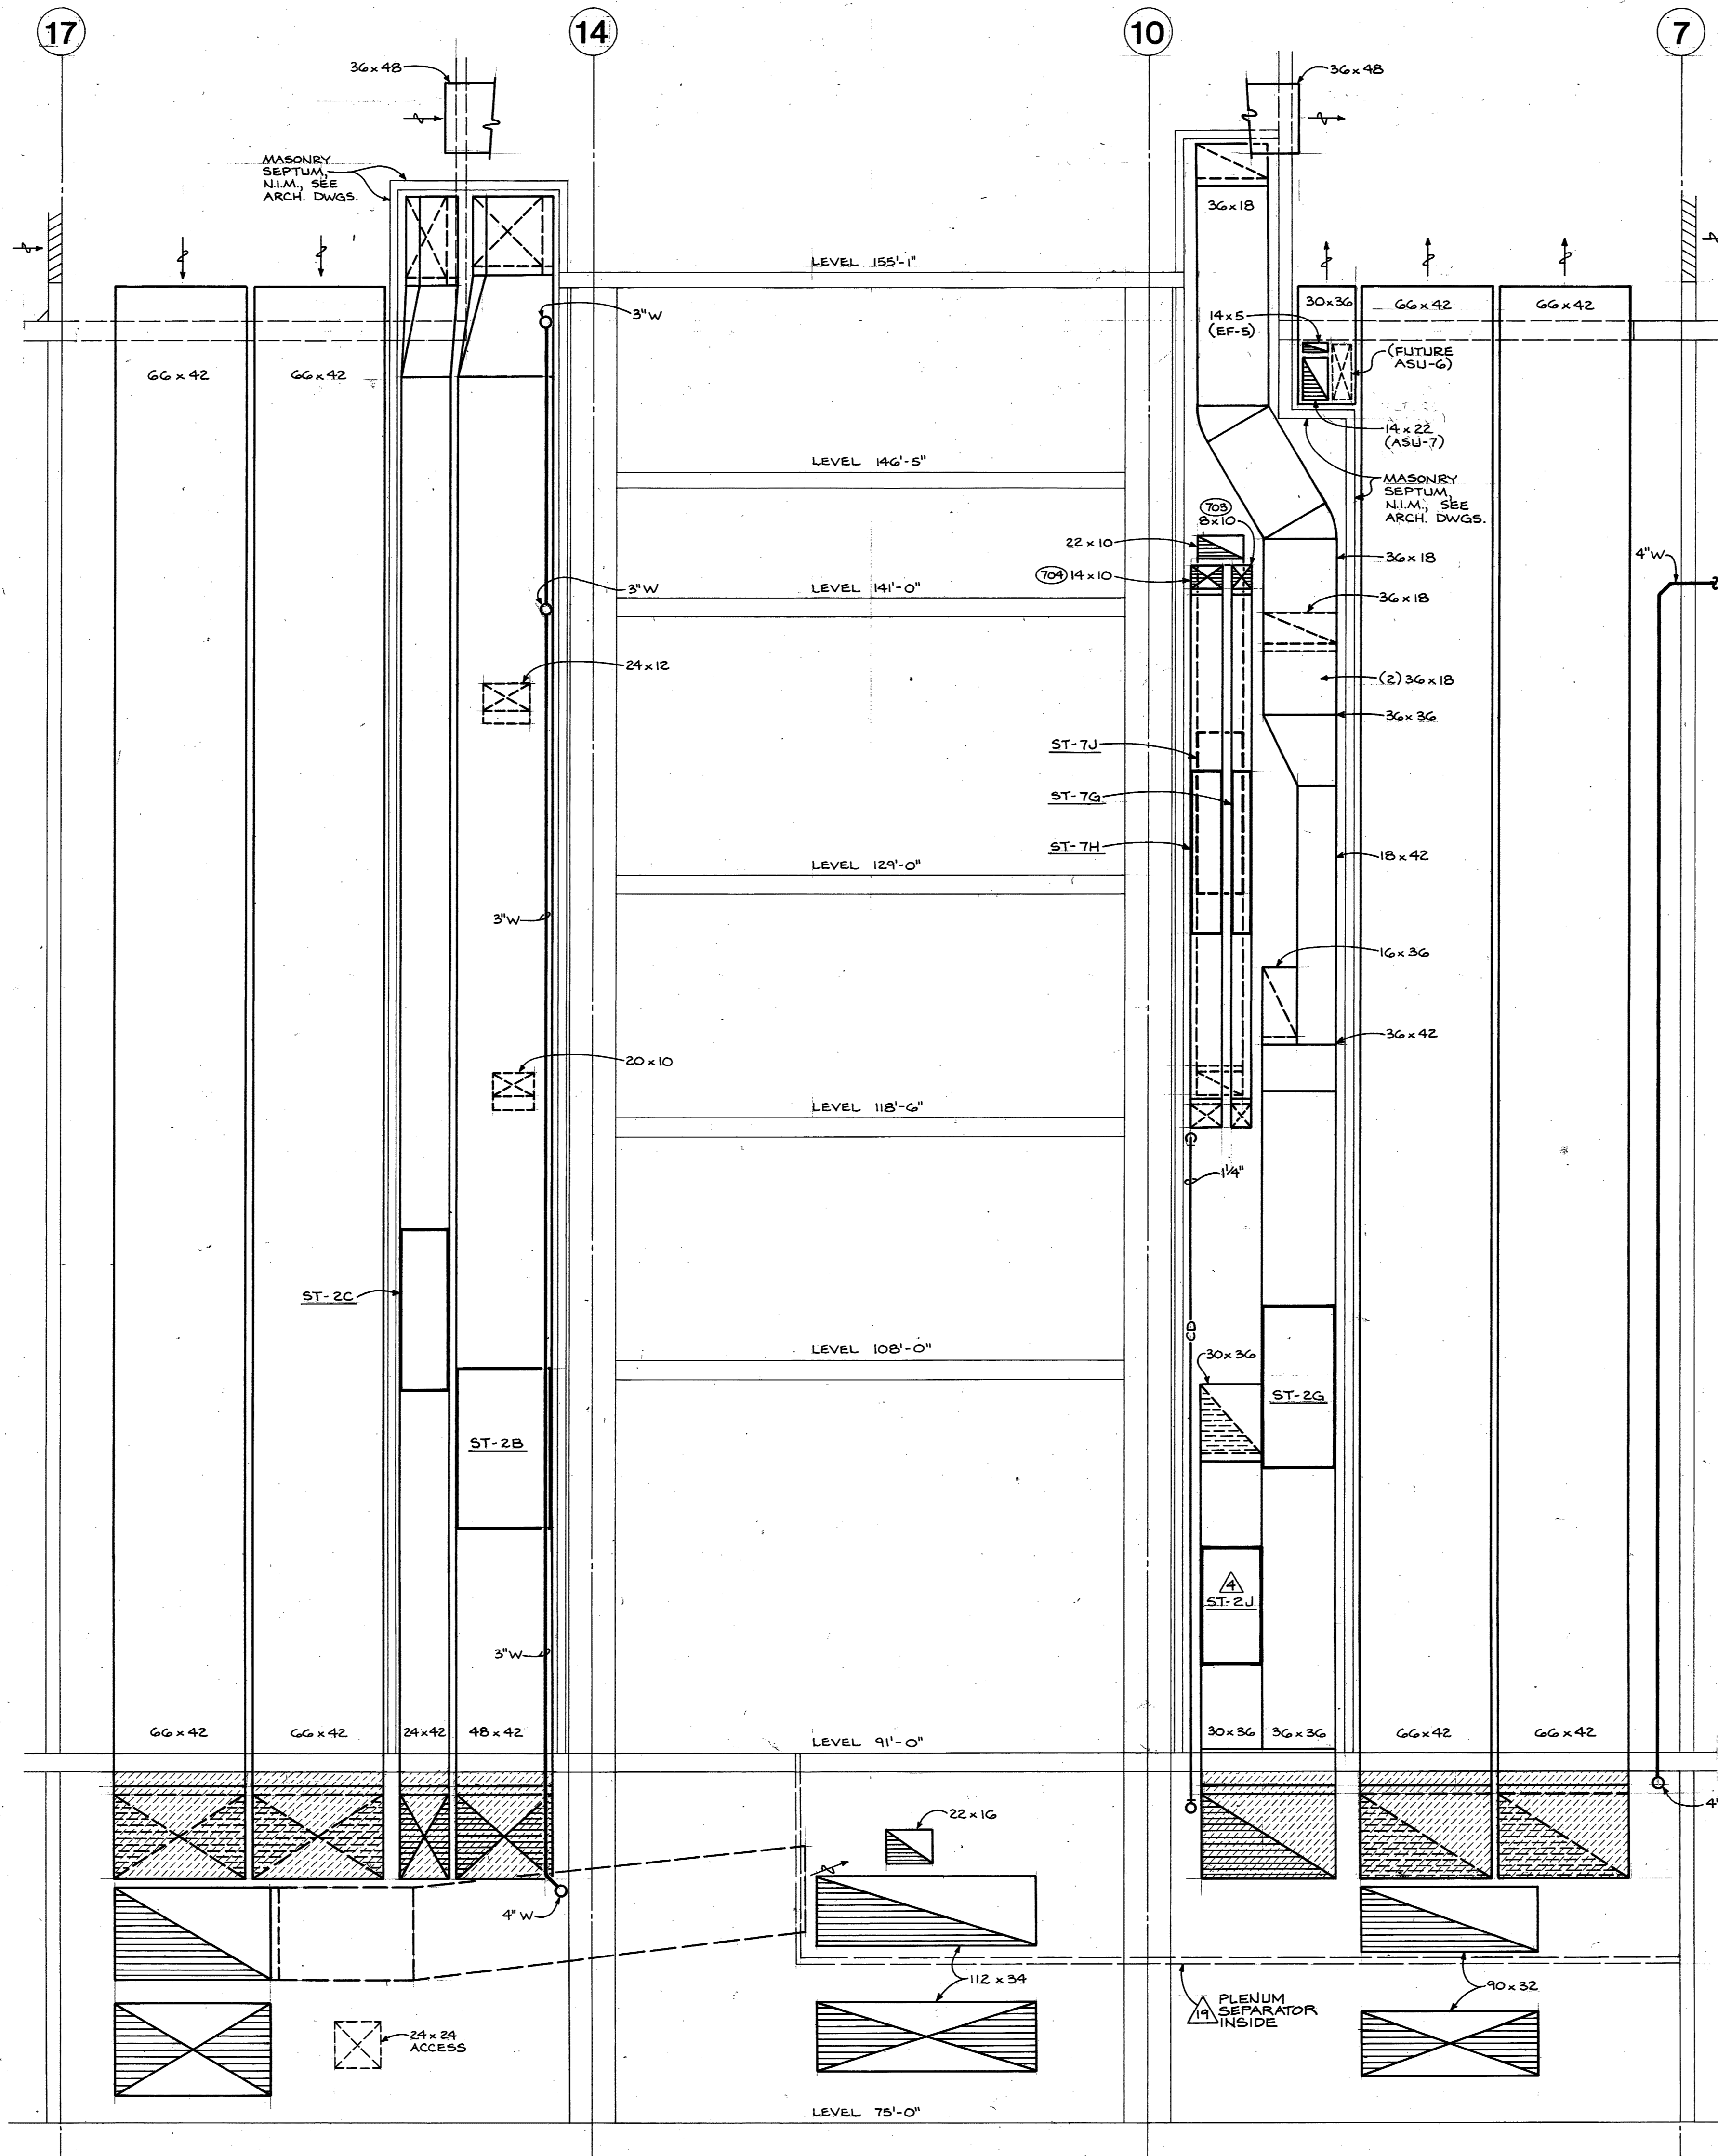


18 SECTION AT SHAFTS NEAR M  
1/4" = 1'-0"

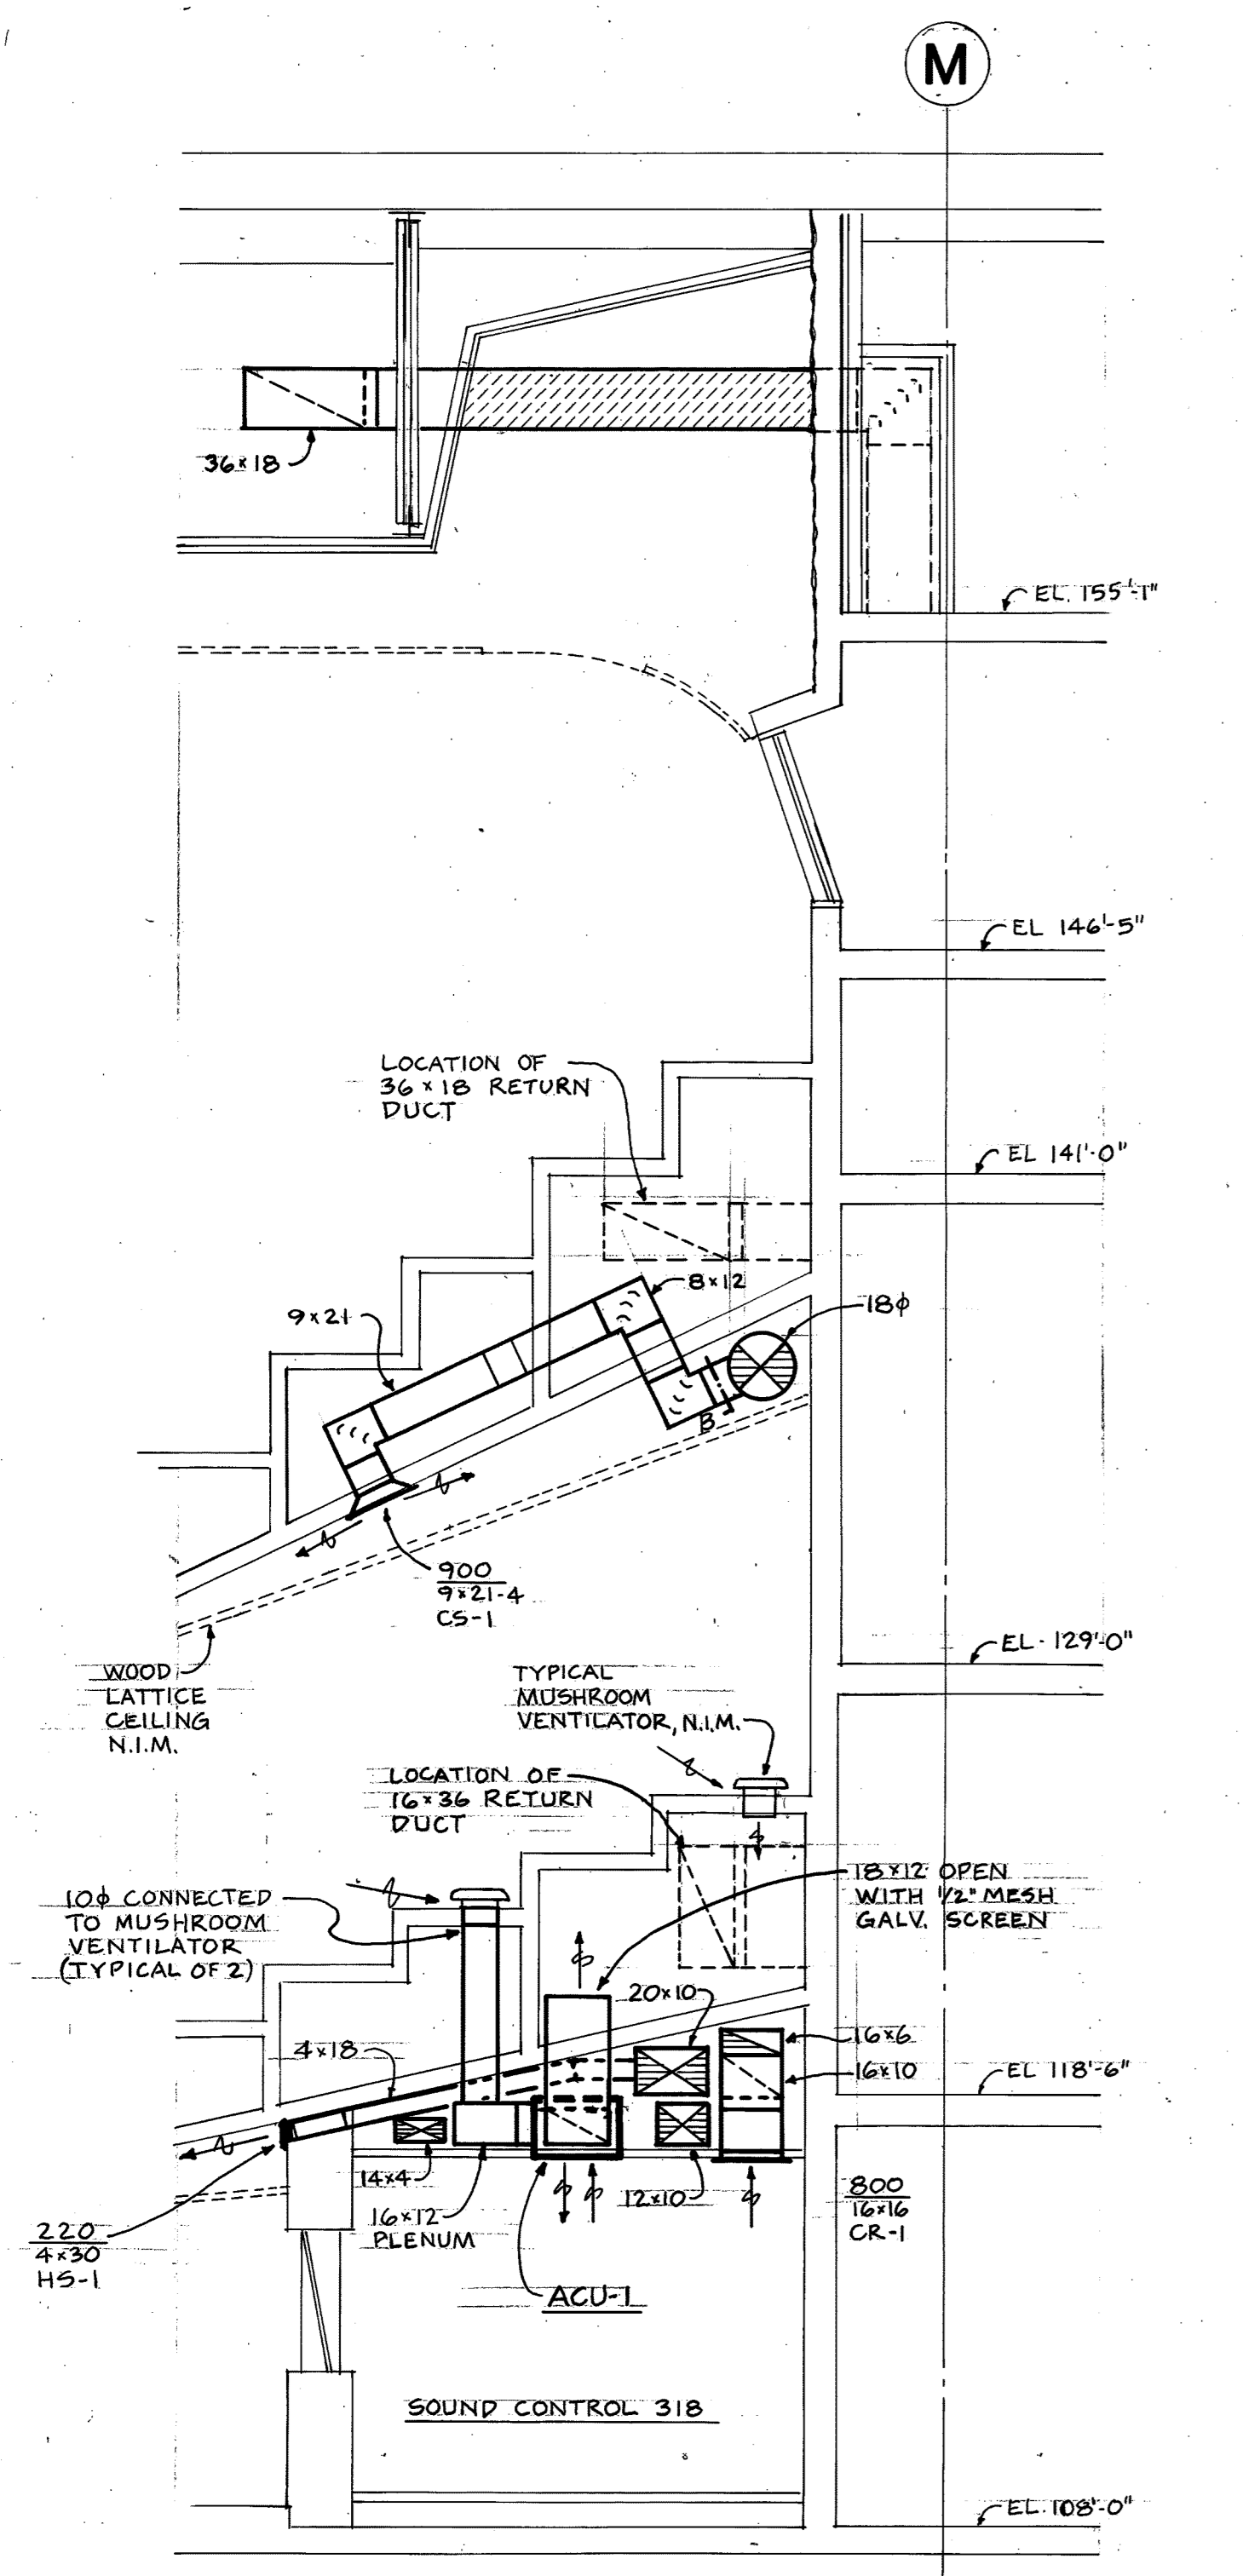

4 SECTION AT INTERMEDIATE BALCONIES  
1/4" = 1'-0"

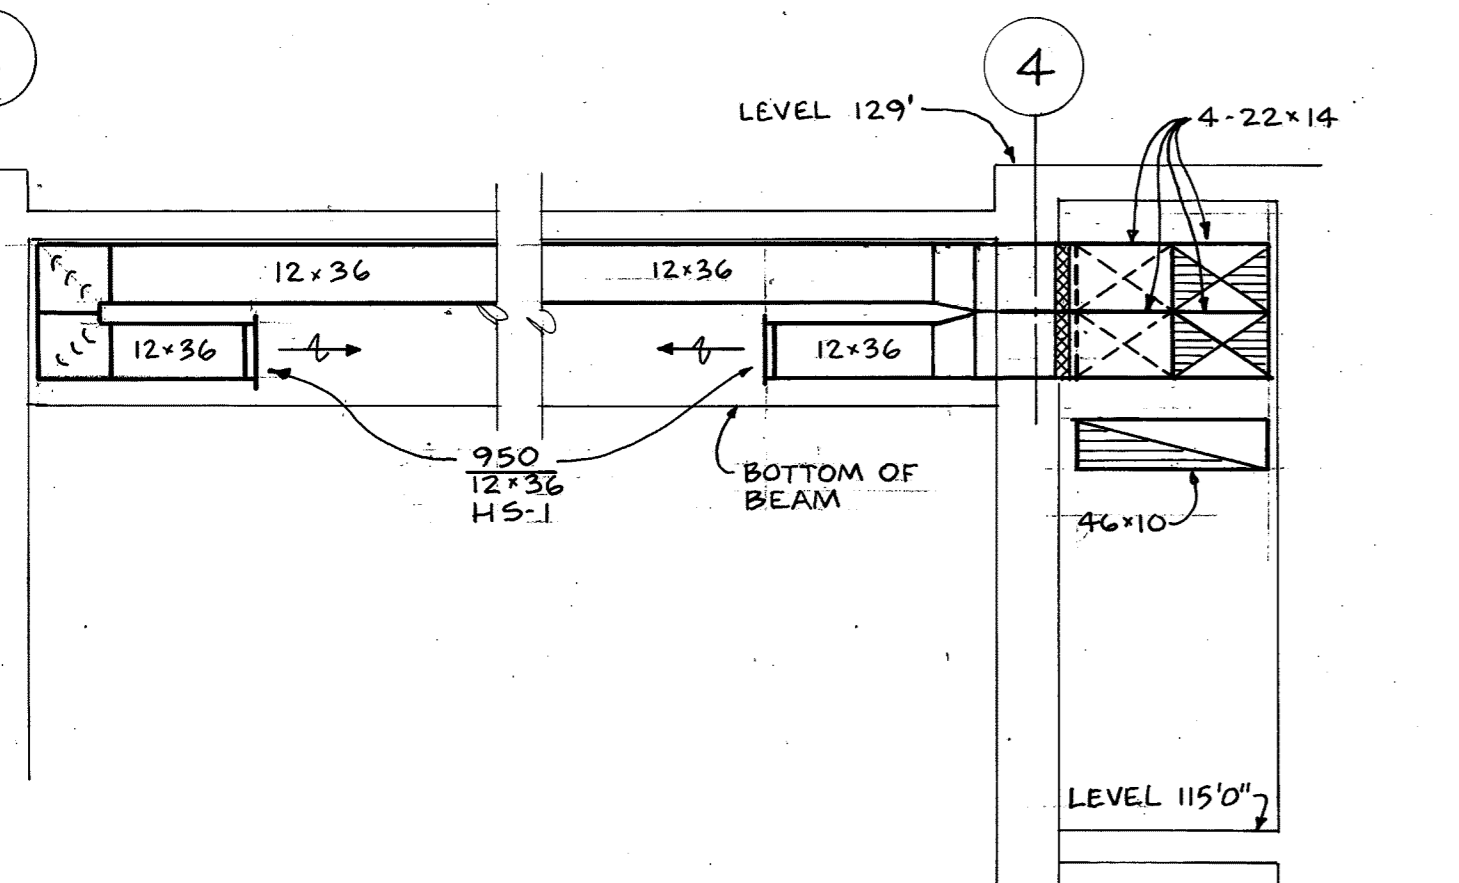


5 SECTION AT SHOWCASE STAGE  
1/4" = 1'-0"

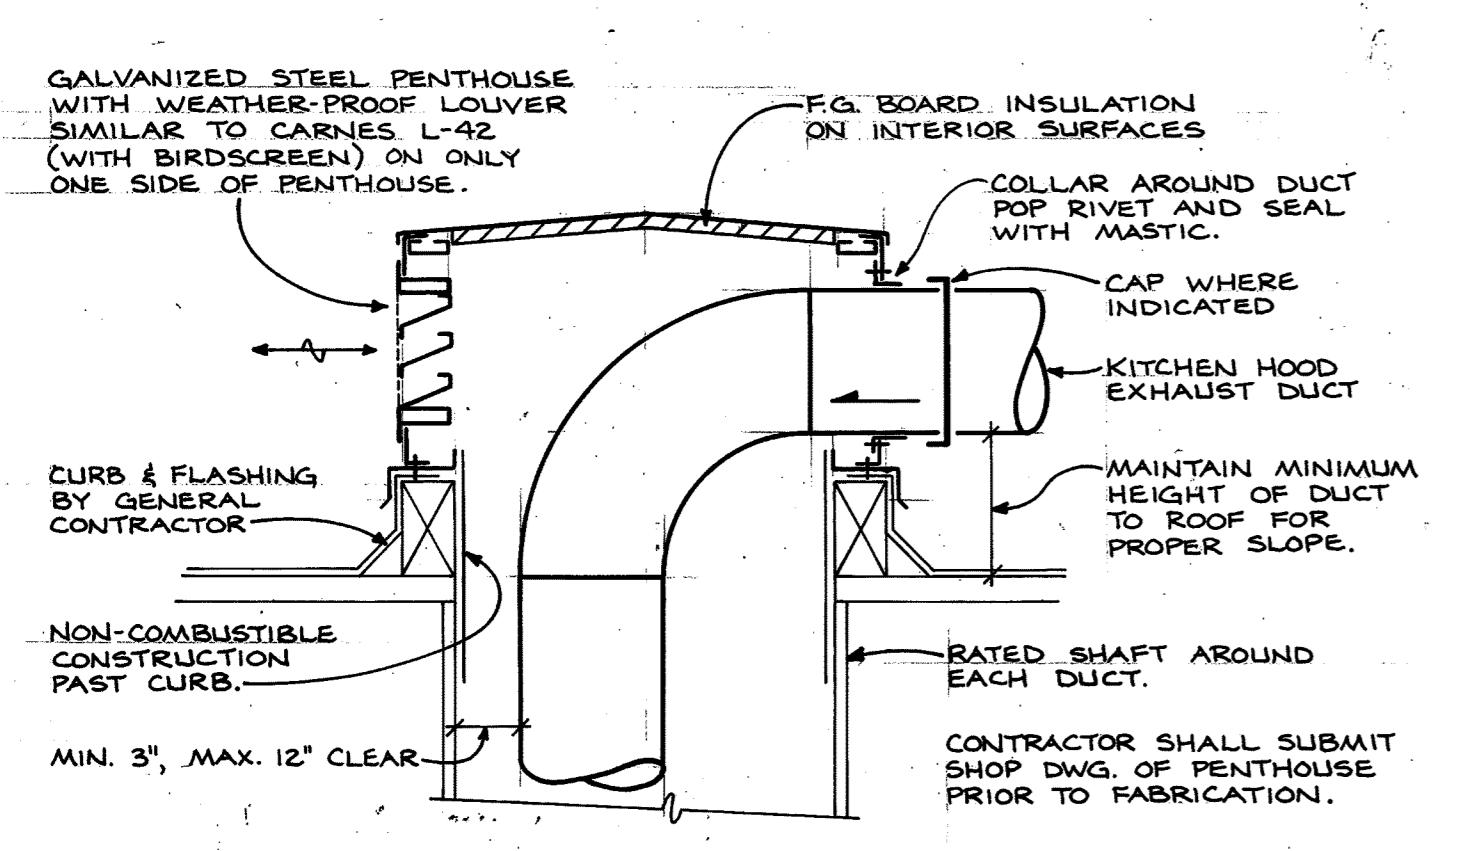


6 DETAIL - PENTHOUSE FOR VENTILATED SHAFT  
NO SCALE





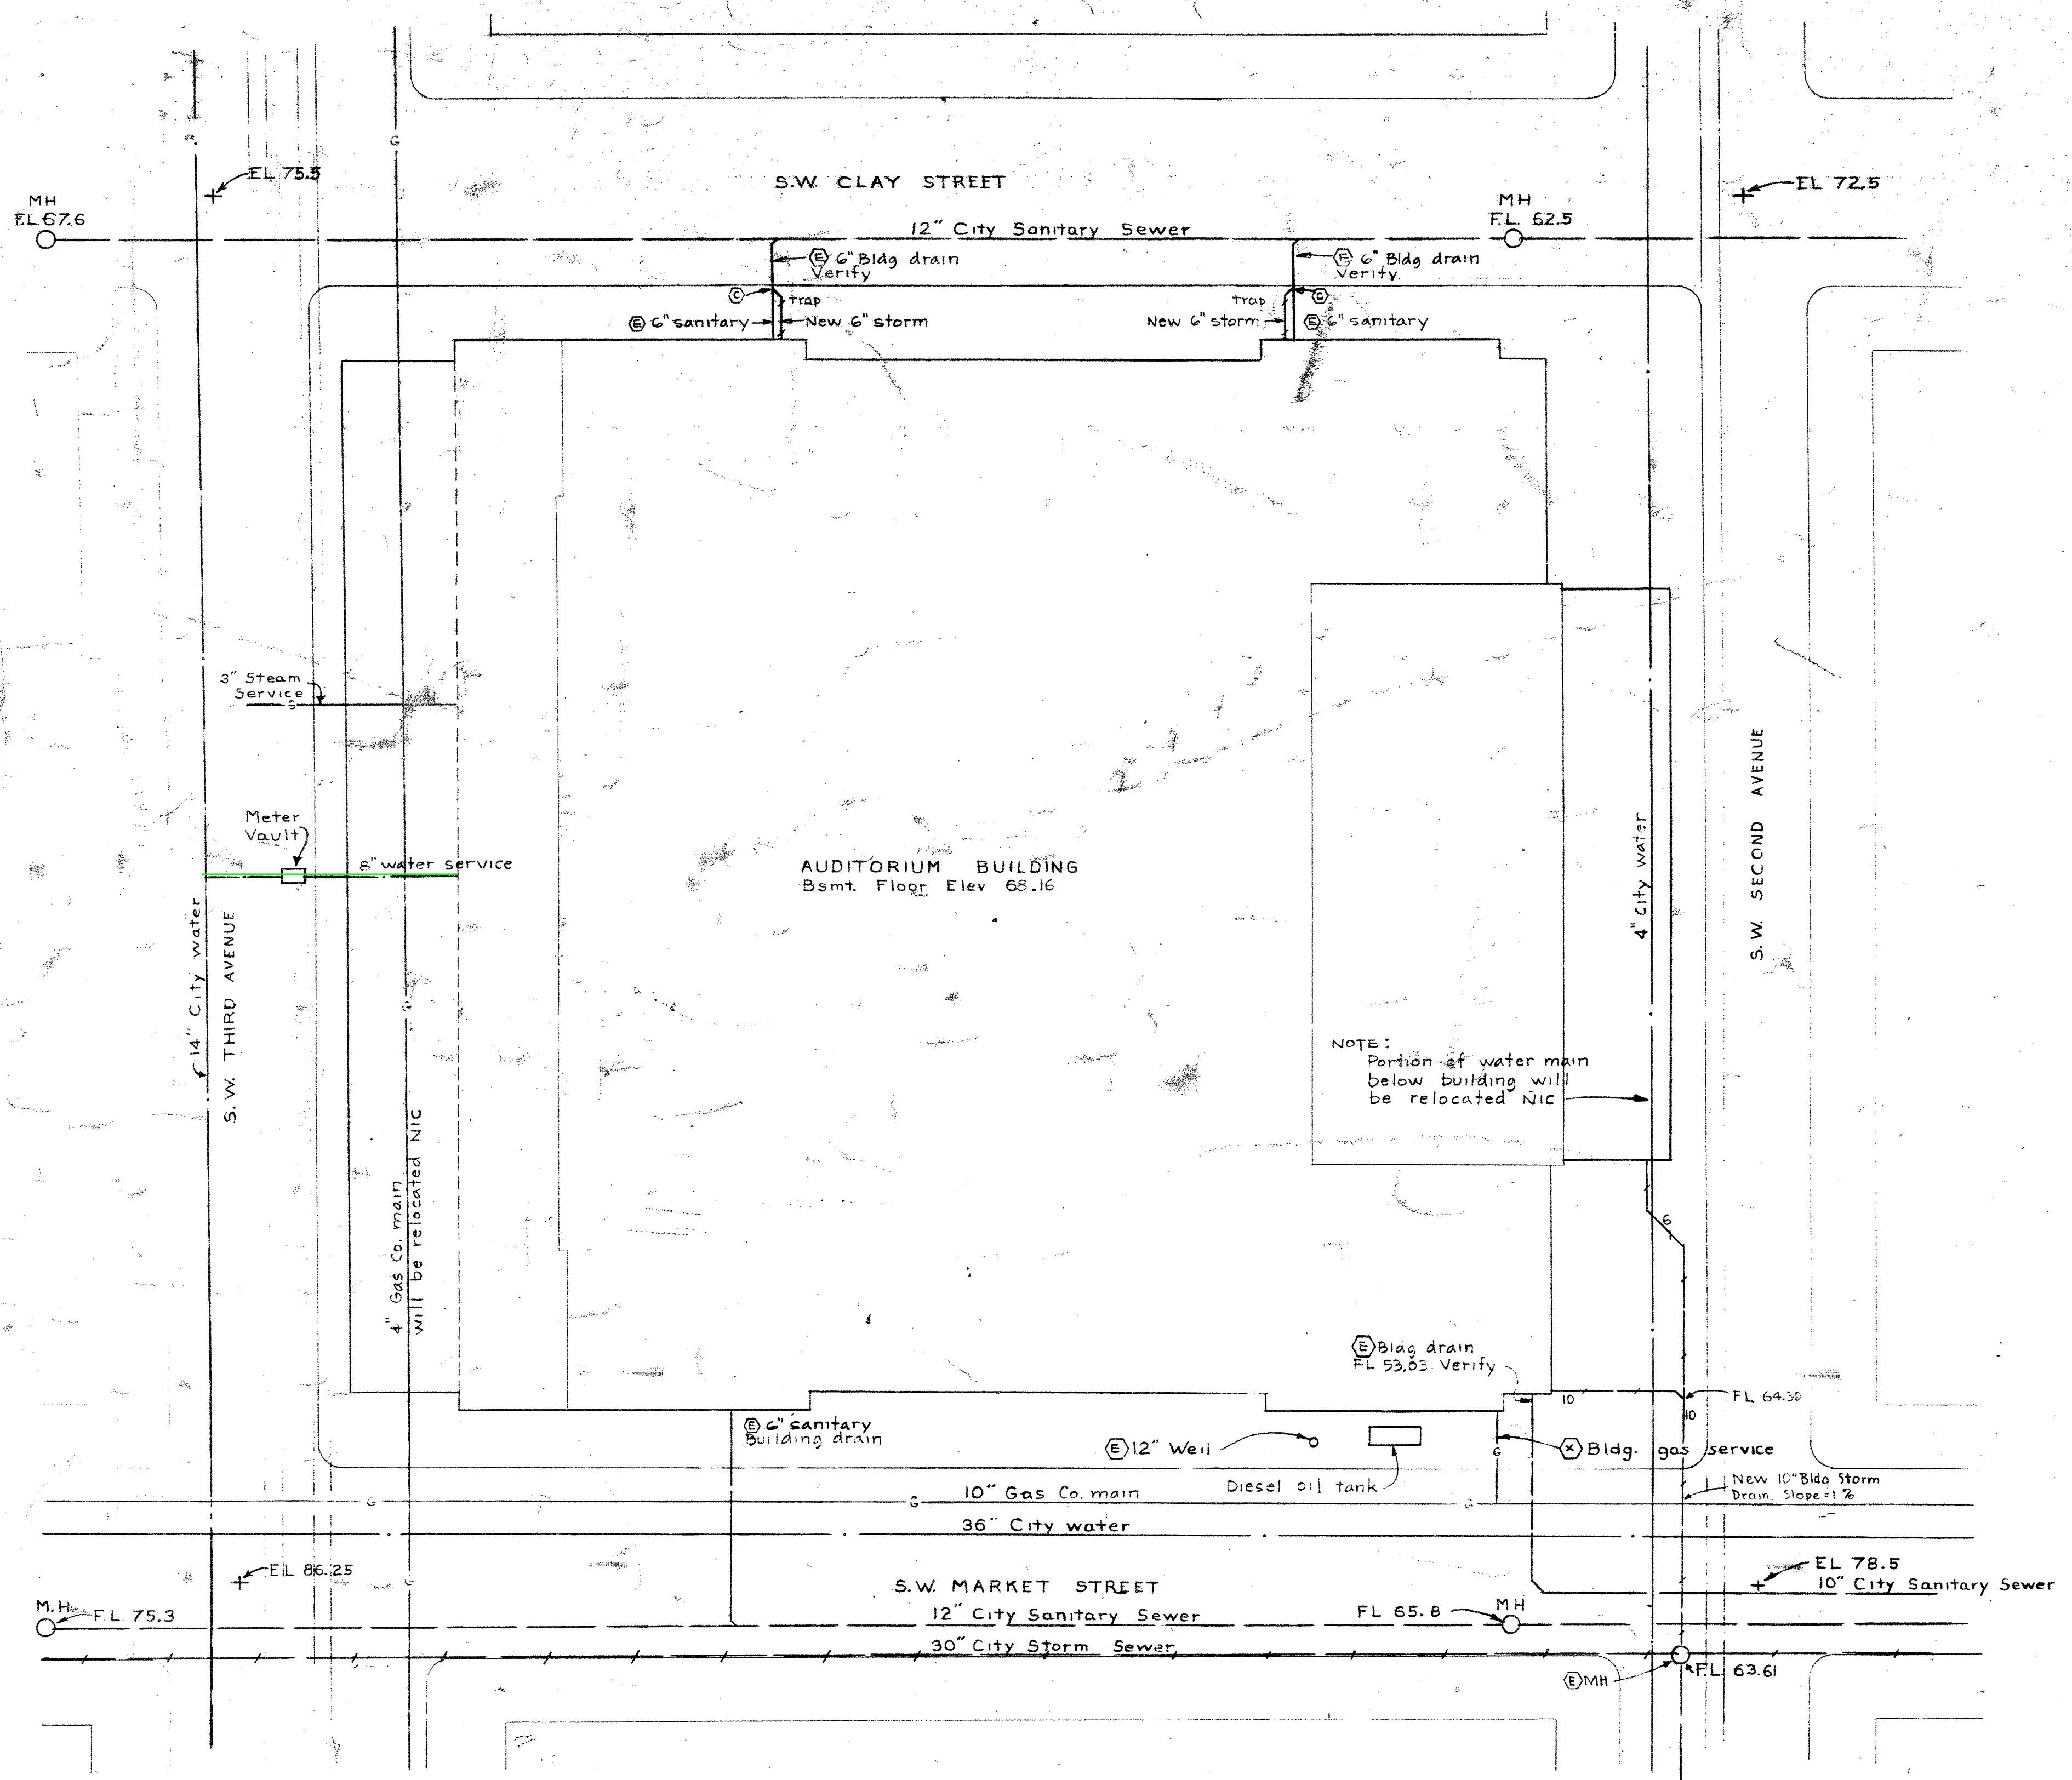


**PLOT PLAN**  
 1" = 20' Approx.  
 Notes: All elevations are approximate. Verify

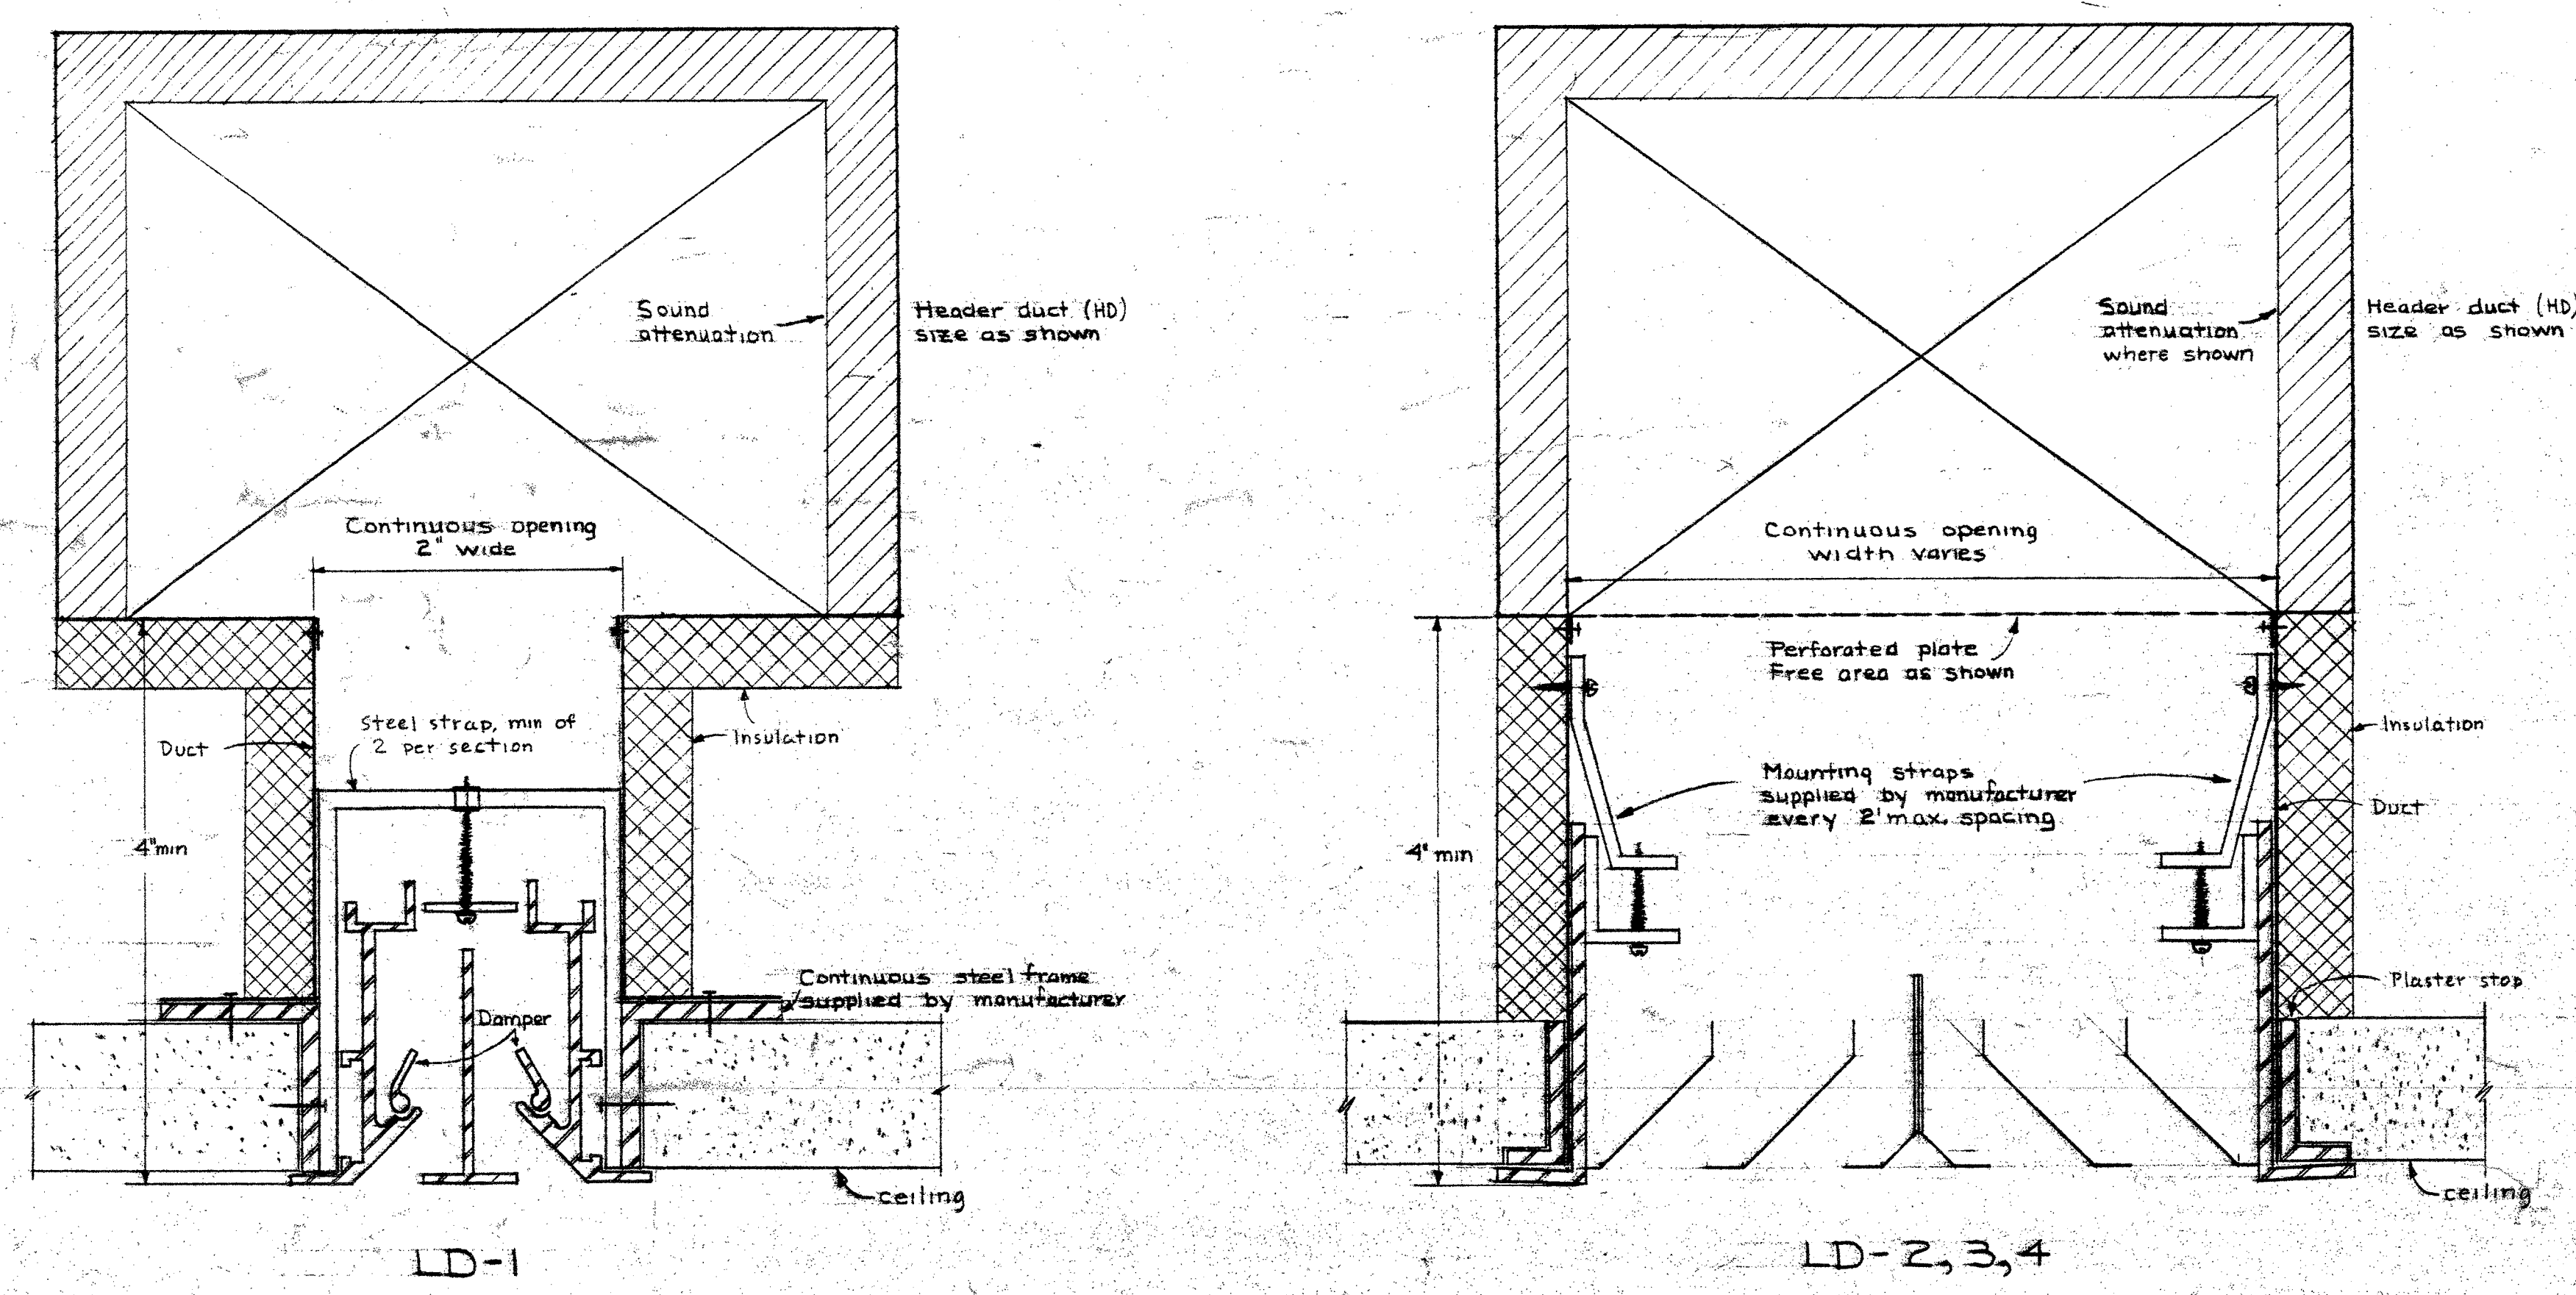

**TYPICAL LINEAR DIFFUSER MOUNTING DETAILS**  
 No Scale

**MECHANICAL DRAWING SYMBOLS**

— S —	Steam	200	Air volume, cfm
— R —	Condensate return	LD-2	Linear diffuser
— C —	Cooling supply	14%FP	Perforated plate, 14% free area
— CR —	Cooling return	S	Splitter damper
— HS —	Heating supply	B	Butterfly damper
— HR —	Heating return	OAD	Outside air automatic damper
— WS —	Well water supply	EAD	Exhaust air automatic damper
— WR —	Well water return	RAD	Return air automatic damper
— CW —	Cold water	IVD	Inlet vane damper
— HW —	Hot water recirculated	MD	Mixing damper
— HW —	Hot water	SP	Static pressure damper
— SPR —	Sprinkler supply	SP	Riser number - heating & cooling pipes
— WSP —	Wet standpipe	⊗	Existing removed or abandoned, as applicable
— W —	Waste, soil, drainage	⊙	Below floor
— RD —	Roof drain	⊕	Existing to remain
— V —	Plumbing vent	⊖	Between joists
— G —	Gas	⊗	Rough-in
— G —	Gate valve	⊙	Air supply zone number
— C —	Check valve	⊕	Room number
— A —	Adjusting valve	⊖	Column line number
— AV —	Automatic valve	AAV	Automatic air vent valve
— U —	Union	SAV	Semi-automatic air vent valve
— G —	Globe valve	SU	Supply air unit
— CO —	Cleanout	EF	Exhaust fan
— FS —	Pitch down	FC-2	Fan-coil unit
— FS —	Flow measuring station	BH	Entry heater
— DP —	Drain pan piping	HP	Heating pump
— R —	Relief valve	BD	Blank-off top of diffuser
— V —	Drain valve	FD	Floor drain
— TSS —	Sprinkler heads; pendant, upright	WH	Wall hydrant
— TSS —	Tube service space	HC	Heating coil
— T —	Thermometer	CC	Cooling coil
— P —	Pipe capped	ASV	Automatic sequencing valve
— O —	Offset in duct; see details Drwg M-3	PRV	Pressure reducing valve
— S —	Supply or intake duct	BT	Bucket trap
— R —	Return or exhaust duct	FT	Float and thermostatic trap
— S —	Sound attenuated duct	CP	Ceiling plenum supply
— S —	Wall supply grille	MH	Manhole
— S —	Wall return grille at floor	EL	Elevation
— S —	Wall return grille at ceiling	FL	Flow-line elevation
— S —	Wall return grille at floor and ceiling	VTR	Vent through roof
— S —	Ceiling diffuser, Agitair pattern no.	DD	Deflection damper
— S —	Ceiling return grille	MCC	Motor control center NIM
— S —	Fire damper	NIM	Not in mechanical work
— S —	Fire sub duct	FHC	Fire hose cabinet
— S —	Dry standpipe	HD	Header duct
— S —	Canopy drain	IM	Ice machine (NIM)
— S —	Access door	CM	Coffee machine (NIM)
— S —	Thermostat	ST	Sound trap
— S —	Pressure gage	DEC	Duct encased in concrete; see detail Drwg M-6
		BB	Special baseboard return grille; see specifications

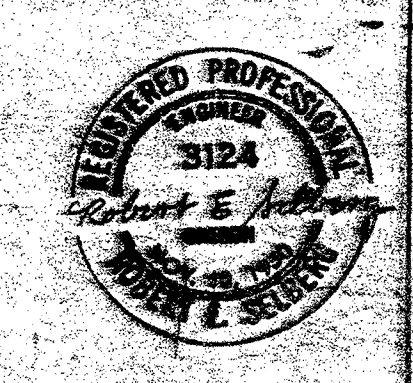

**MECHANICAL**  
**PLOT PLAN AND DETAILS**

**B. MARCUS BRITICA**  
 ARCHITECT  
 5124  
 200 S. W. THIRD AVENUE, PORTLAND 4, OREGON

**REBUILDING OF PORTLAND CIVIC AUDITORIUM**  
 3 W. THIRD AVENUE & CLAY STREET  
 702  
 CITY OF PORTLAND OREGON

**PAUL VEBGLASSEN & ASSOCIATES**  
 ARCHITECTS  
 702

**COOPER & ROSE ASSOCIATES**  
 MECHANICAL ENGINEERS  
 200 S. W. THIRD AVENUE, PORTLAND 4, OREGON


**J. DONALD KROEGER & ASSOCIATES**  
 MECHANICAL ENGINEERS  
 200 S. W. THIRD AVENUE, PORTLAND 4, OREGON

**GRANT KELLEY & ASSOCIATES**  
 ELECTRICAL ENGINEERS  
 200 S. W. THIRD AVENUE, PORTLAND 4, OREGON


**LILA COLWELL A.L.D.**  
 MECHANICAL ENGINEER

**STANTON, BOLES, HARDY & BURGESS**  
 ARCHITECTS  
 200 S. W. THIRD AVENUE, PORTLAND 4, OREGON  
 DRAWING NO. 1023  
 DATE: 12/14/55


**M-1**

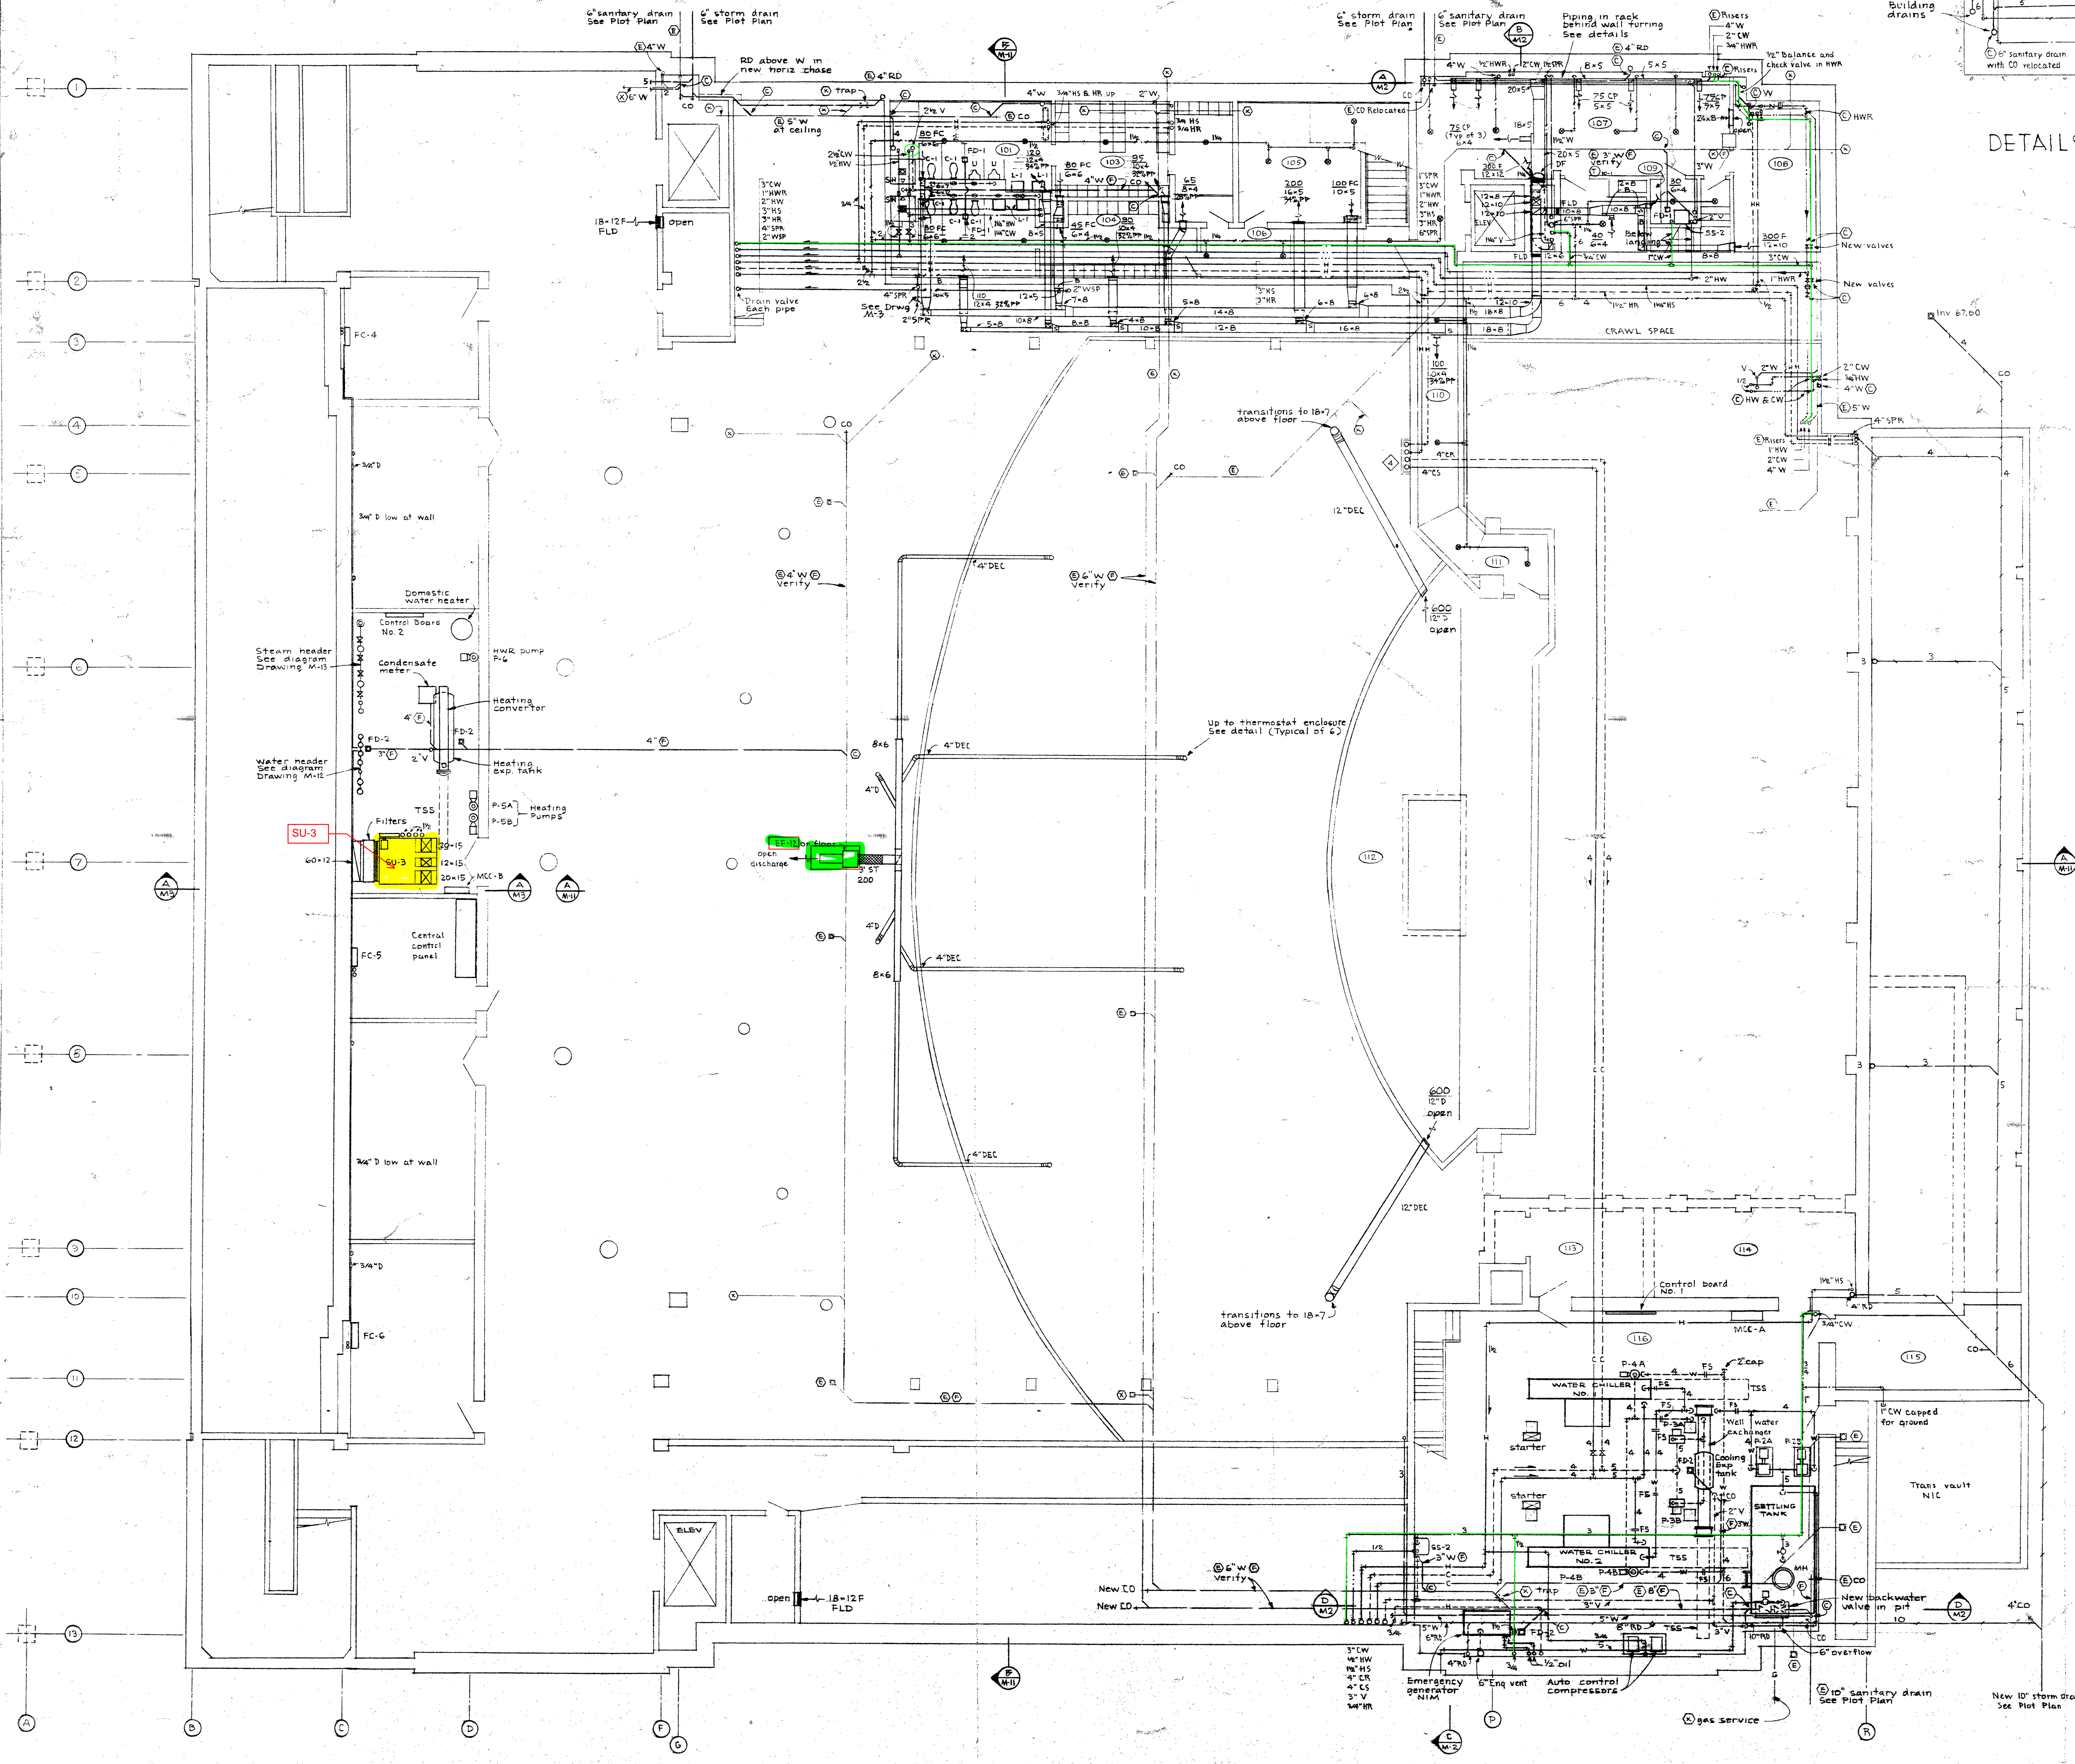


FLOOR PLAN - LOWER BASEMENT LEVEL  
1/8" = 1'-0"

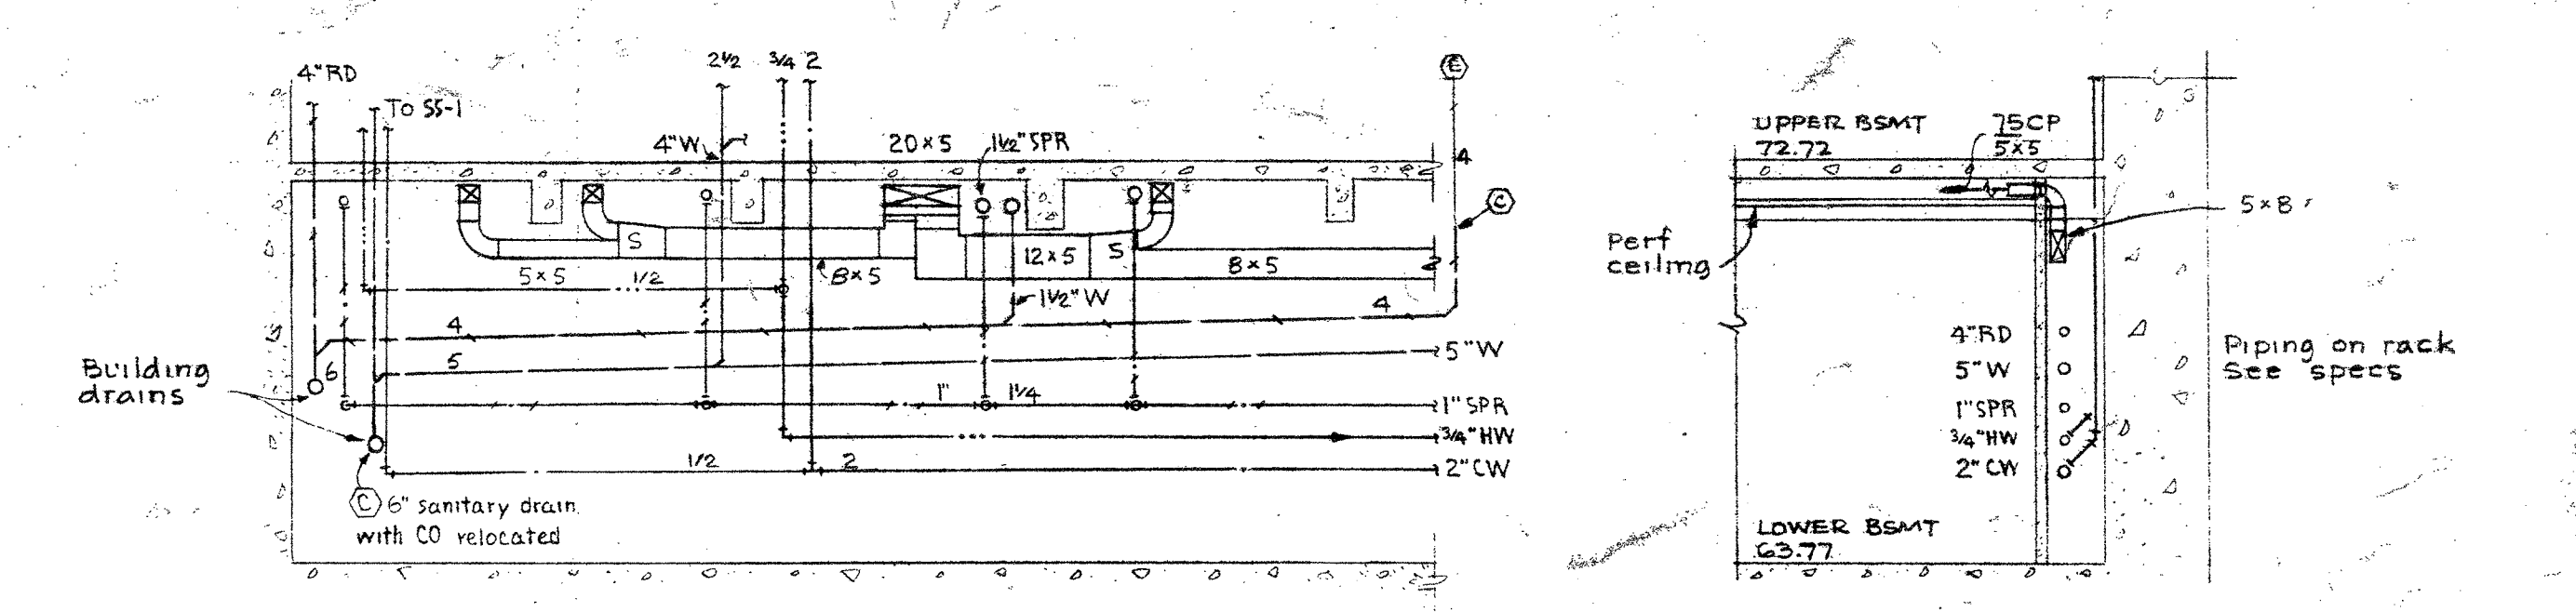


SECTION A-M2  
DETAILS OF PIPING AT WALL IN ROOM 107  
1/4" = 1'-0"

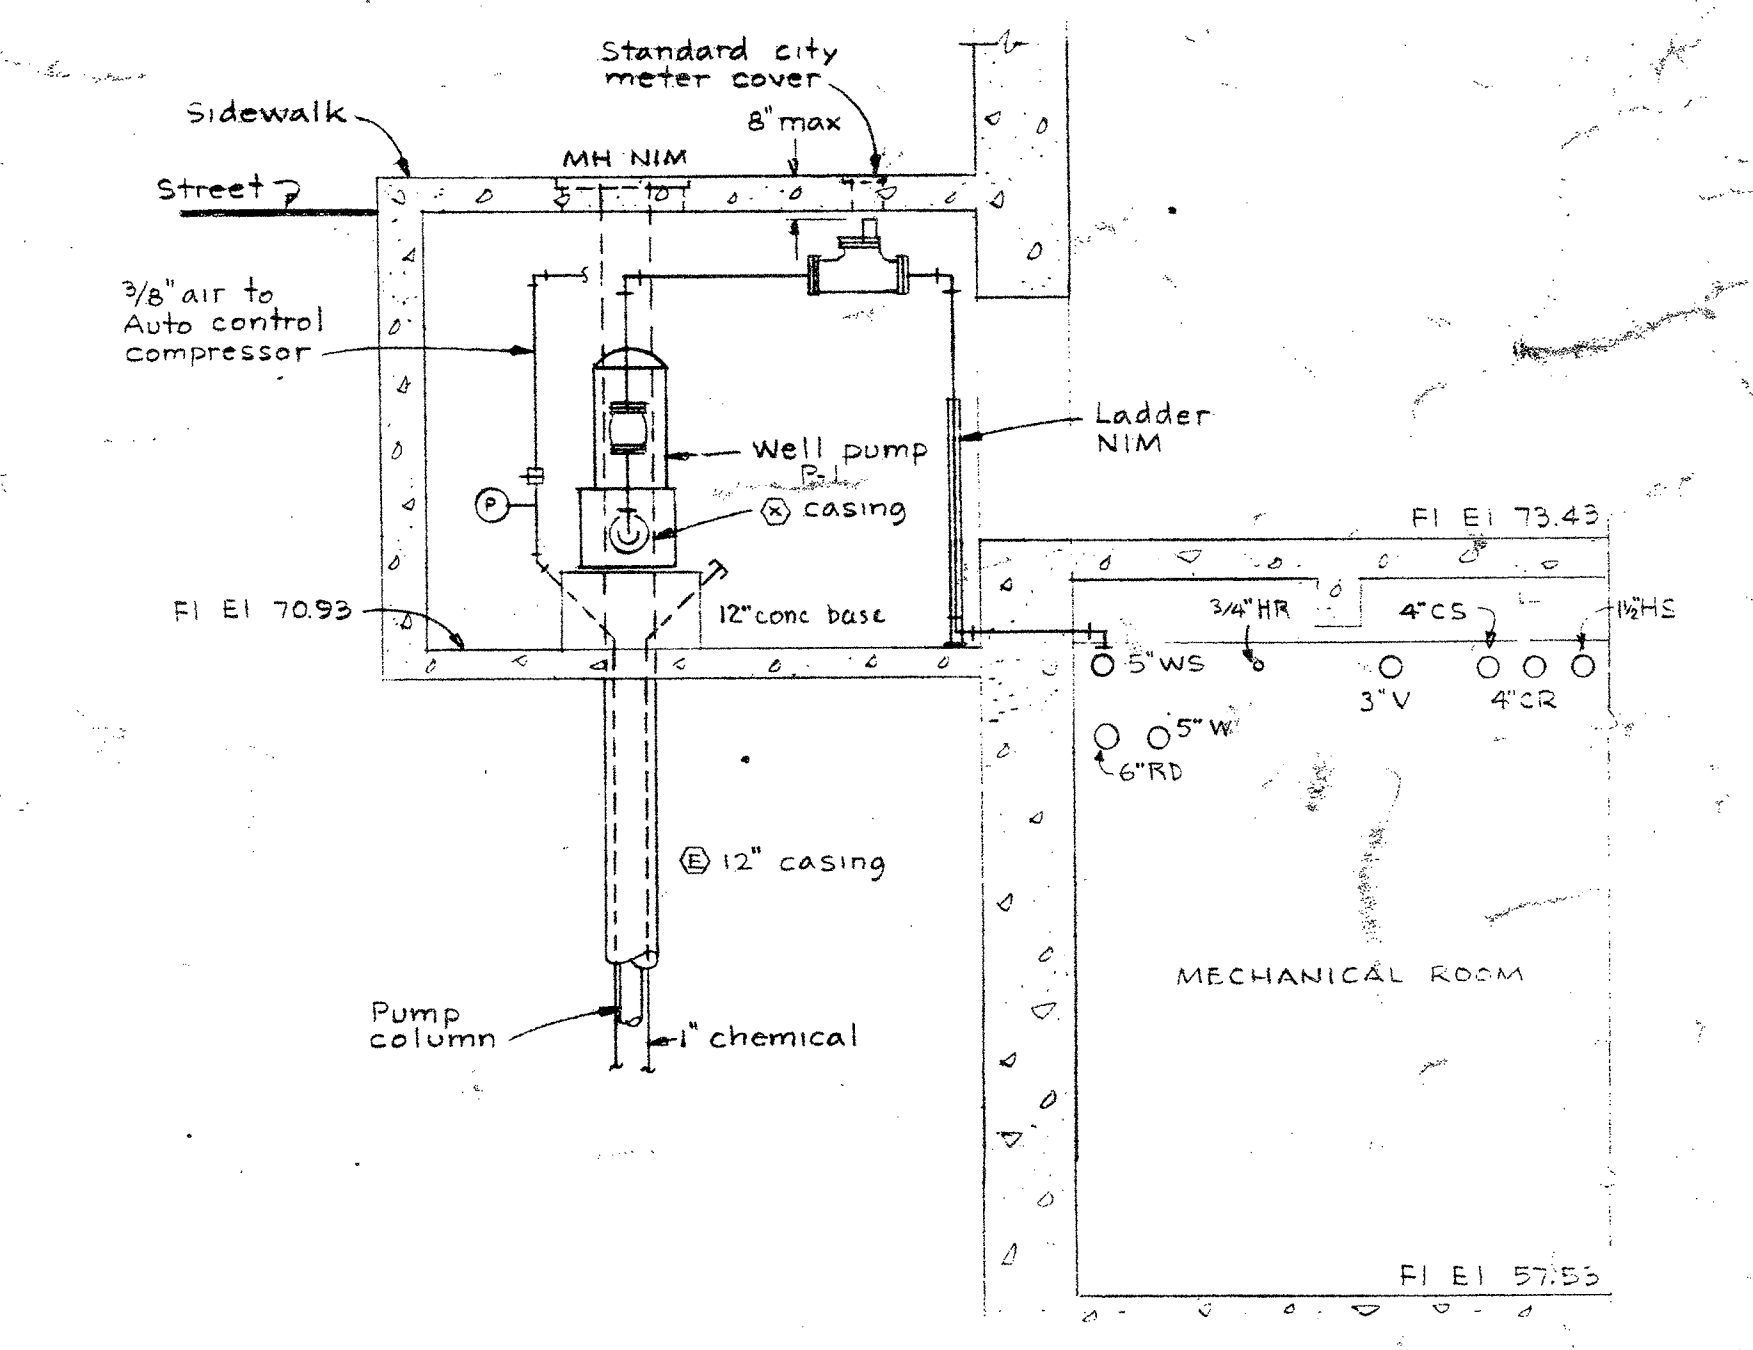



SECTION B-M2  
1/2" = 1'-0"

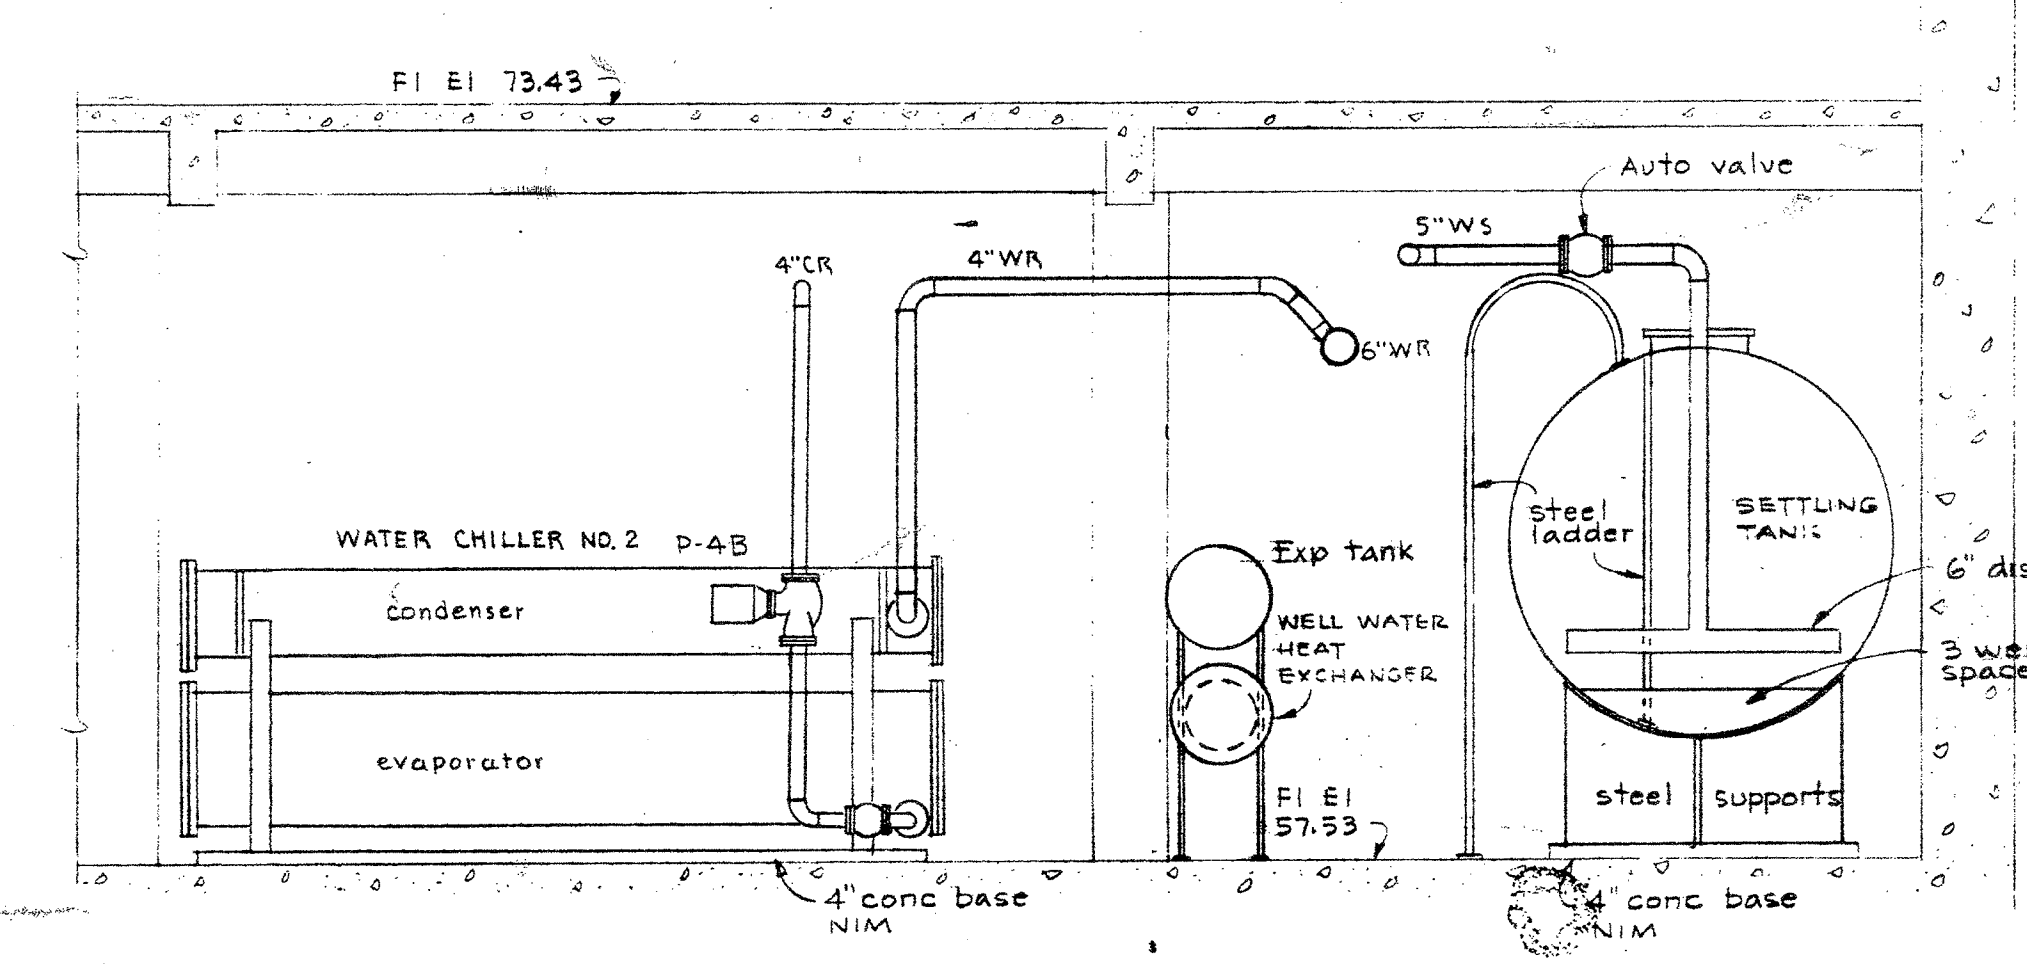

SECTION C-M2  
1/2" = 1'-0"

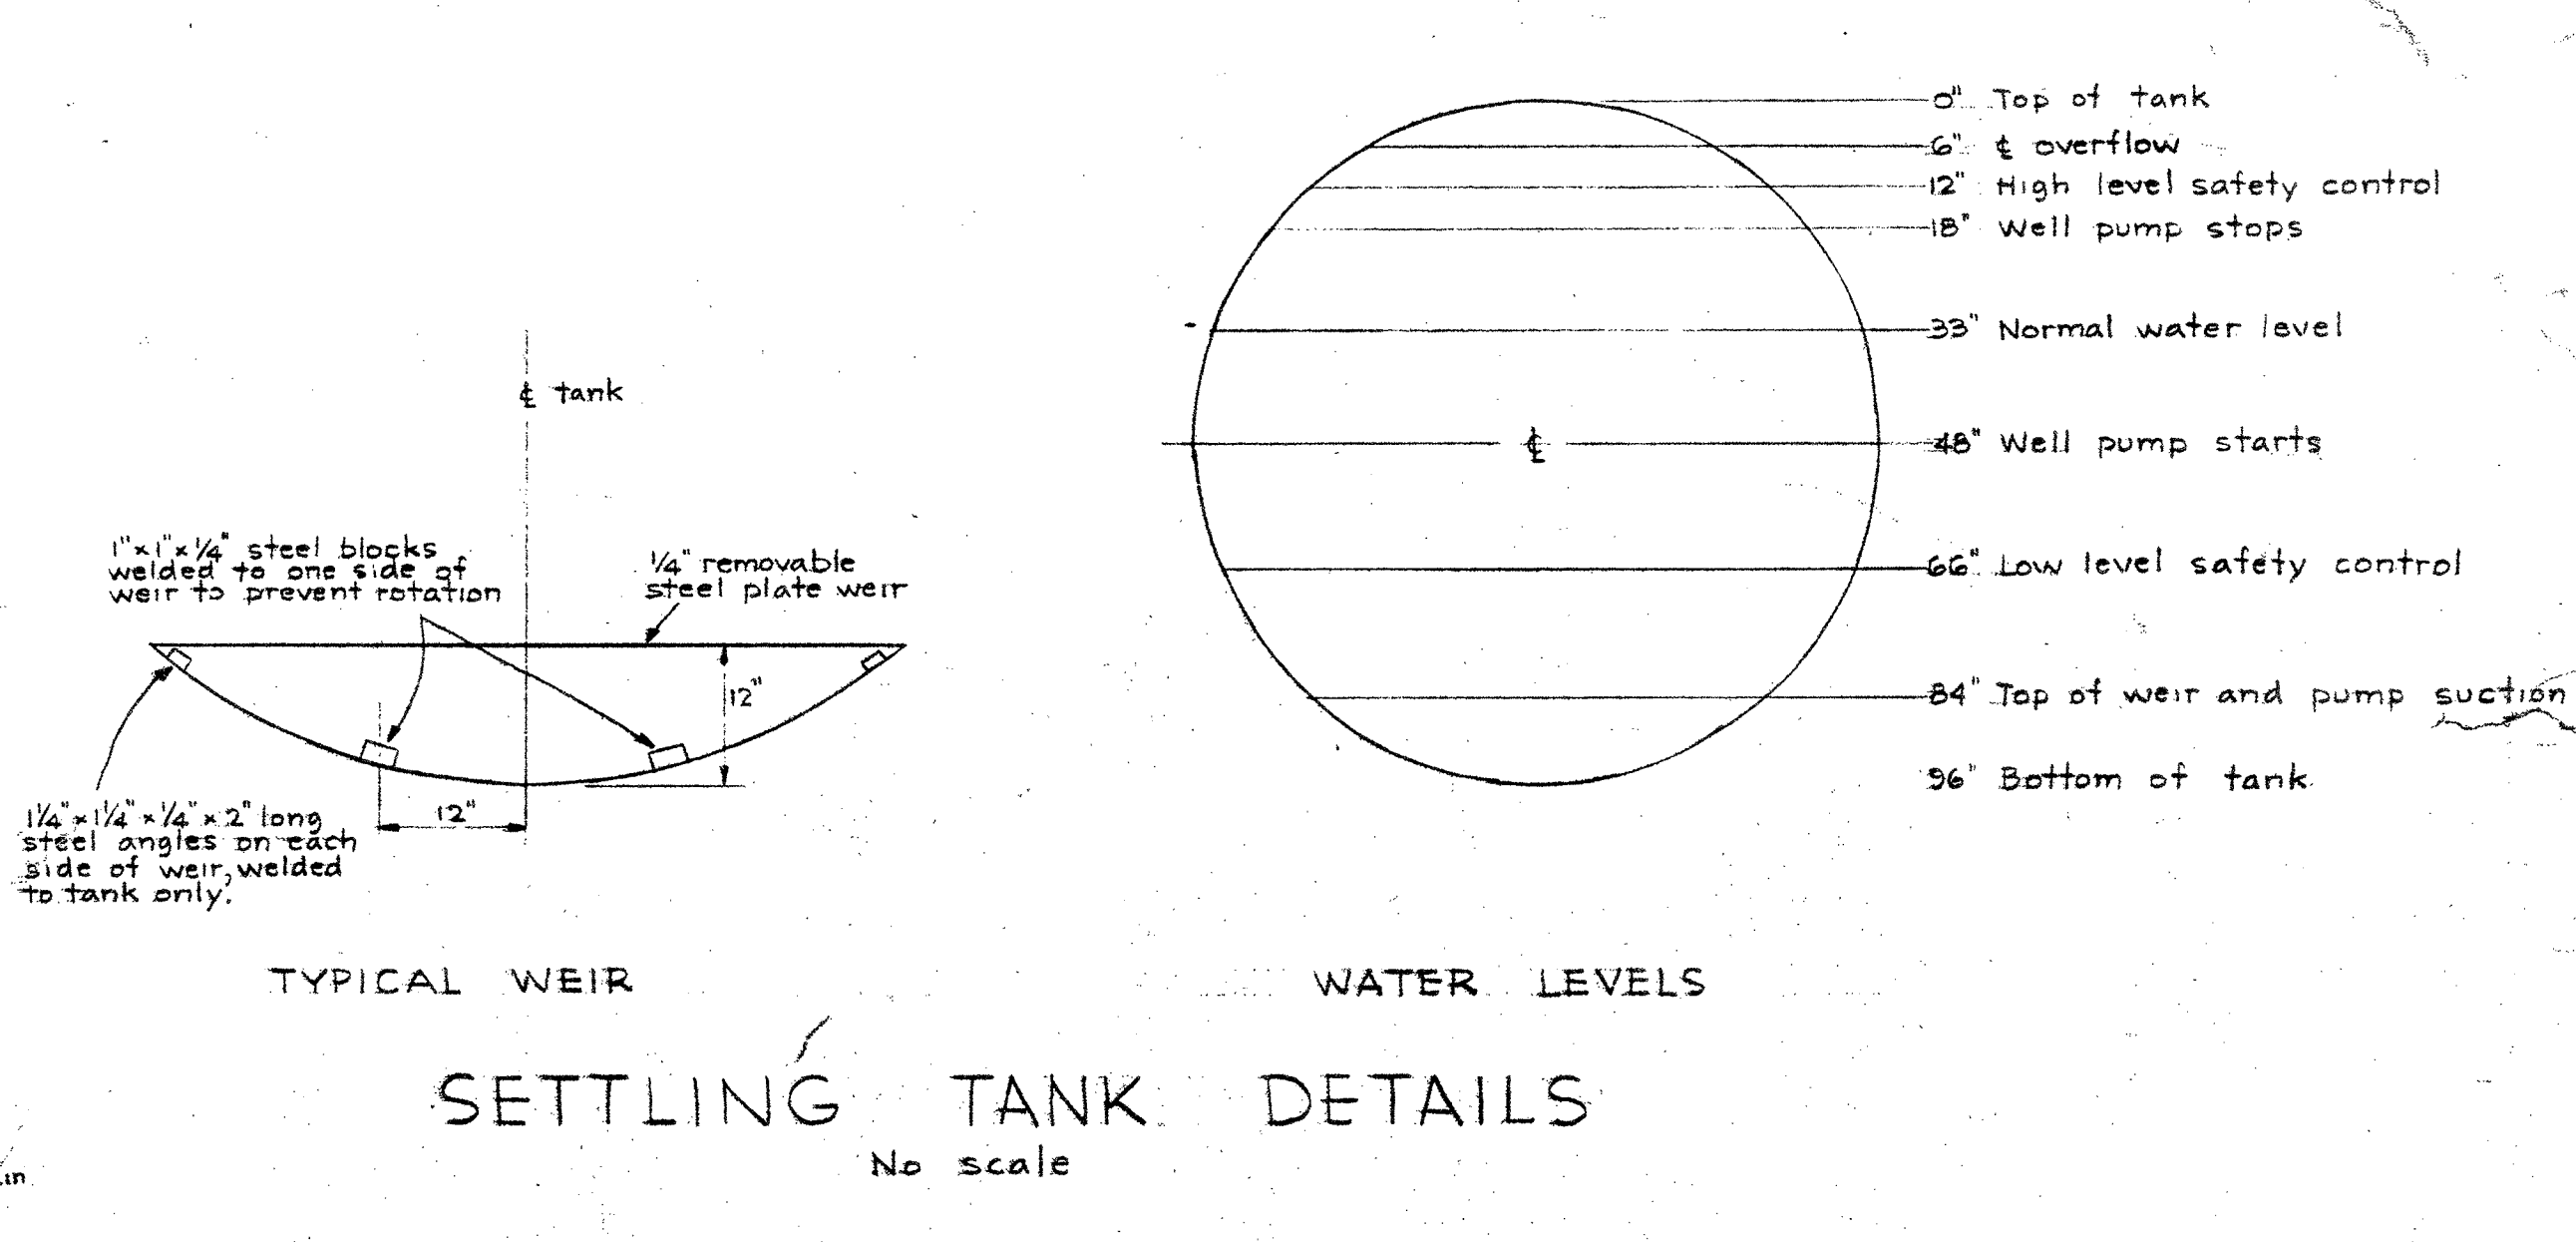

SETTLING TANK DETAILS  
No. Scale

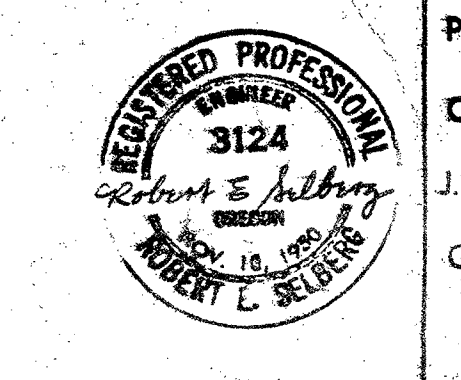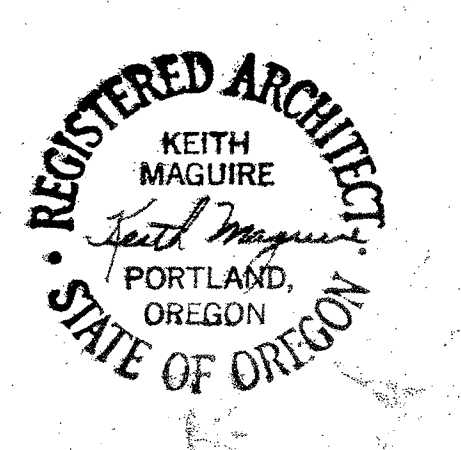

**MECHANICAL LOWER BASEMENT FLOOR PLAN AND DETAILS**

**B. MARCUS PRITCA**  
ARCHITECT  
THEATER CONSULTANT

**PAUL VENEKLAEN & ASSOCIATES**  
ACOUSTICAL CONSULTANTS

**COOPER & ROSE & ASSOCIATES**  
STRUCTURAL ENGINEERS

**J. DONALD KROEBER & ASSOCIATES**  
MECHANICAL ENGINEERS


**GRANT KELLEY & ASSOCIATES**  
ELECTRICAL ENGINEERS

**LITA COLWELL A.I.D.**  
INTERIOR CONSULTANT


**REBUILDING OF PORTLAND CIVIC AUDITORIUM**  
2 W. THIRD AVENUE & CLAY STREET  
FOR CITY OF PORTLAND OREGON

**DRAWING M-2**


**STANTON, BOLES, MAGUIRE & CHURCH**  
ARCHITECTS  
208 S. W. STARK ST., PORTLAND 4, OREGON  
COMM. NO. 6323  
DATE: MAY 24 1966

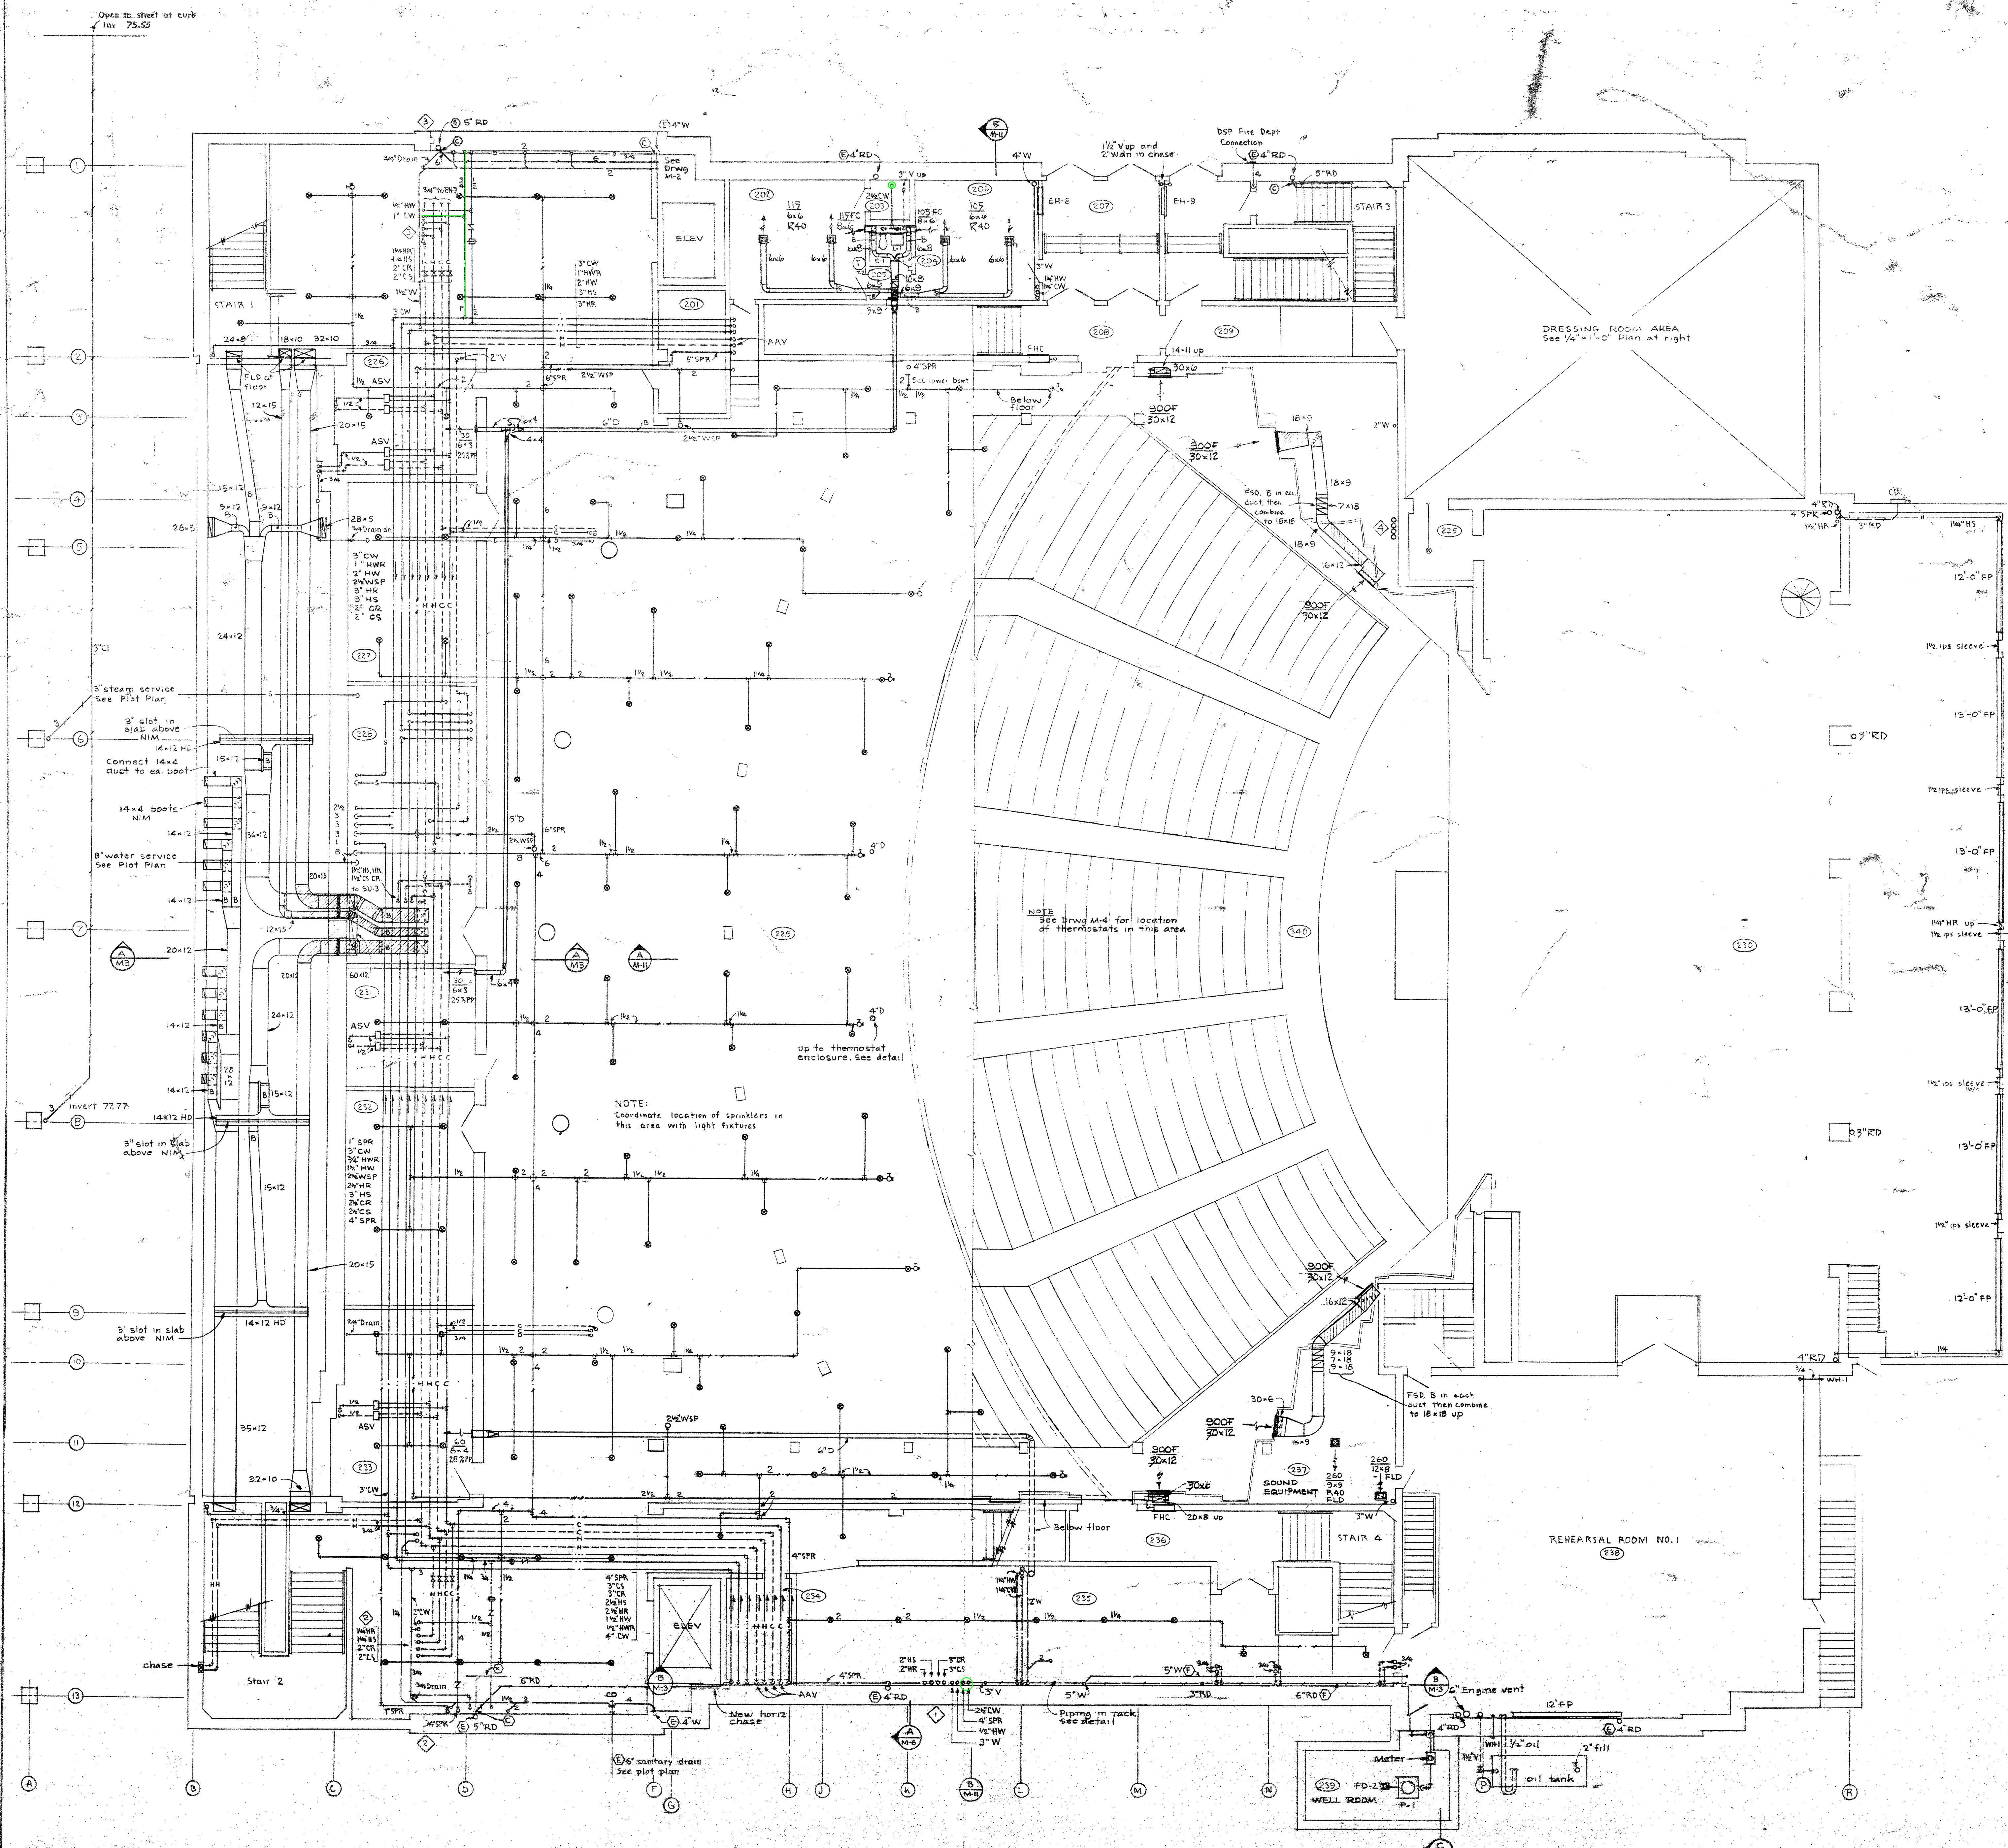


FLOOR PLAN - UPPER BASEMENT LEVEL  
1/8" = 1'-0"

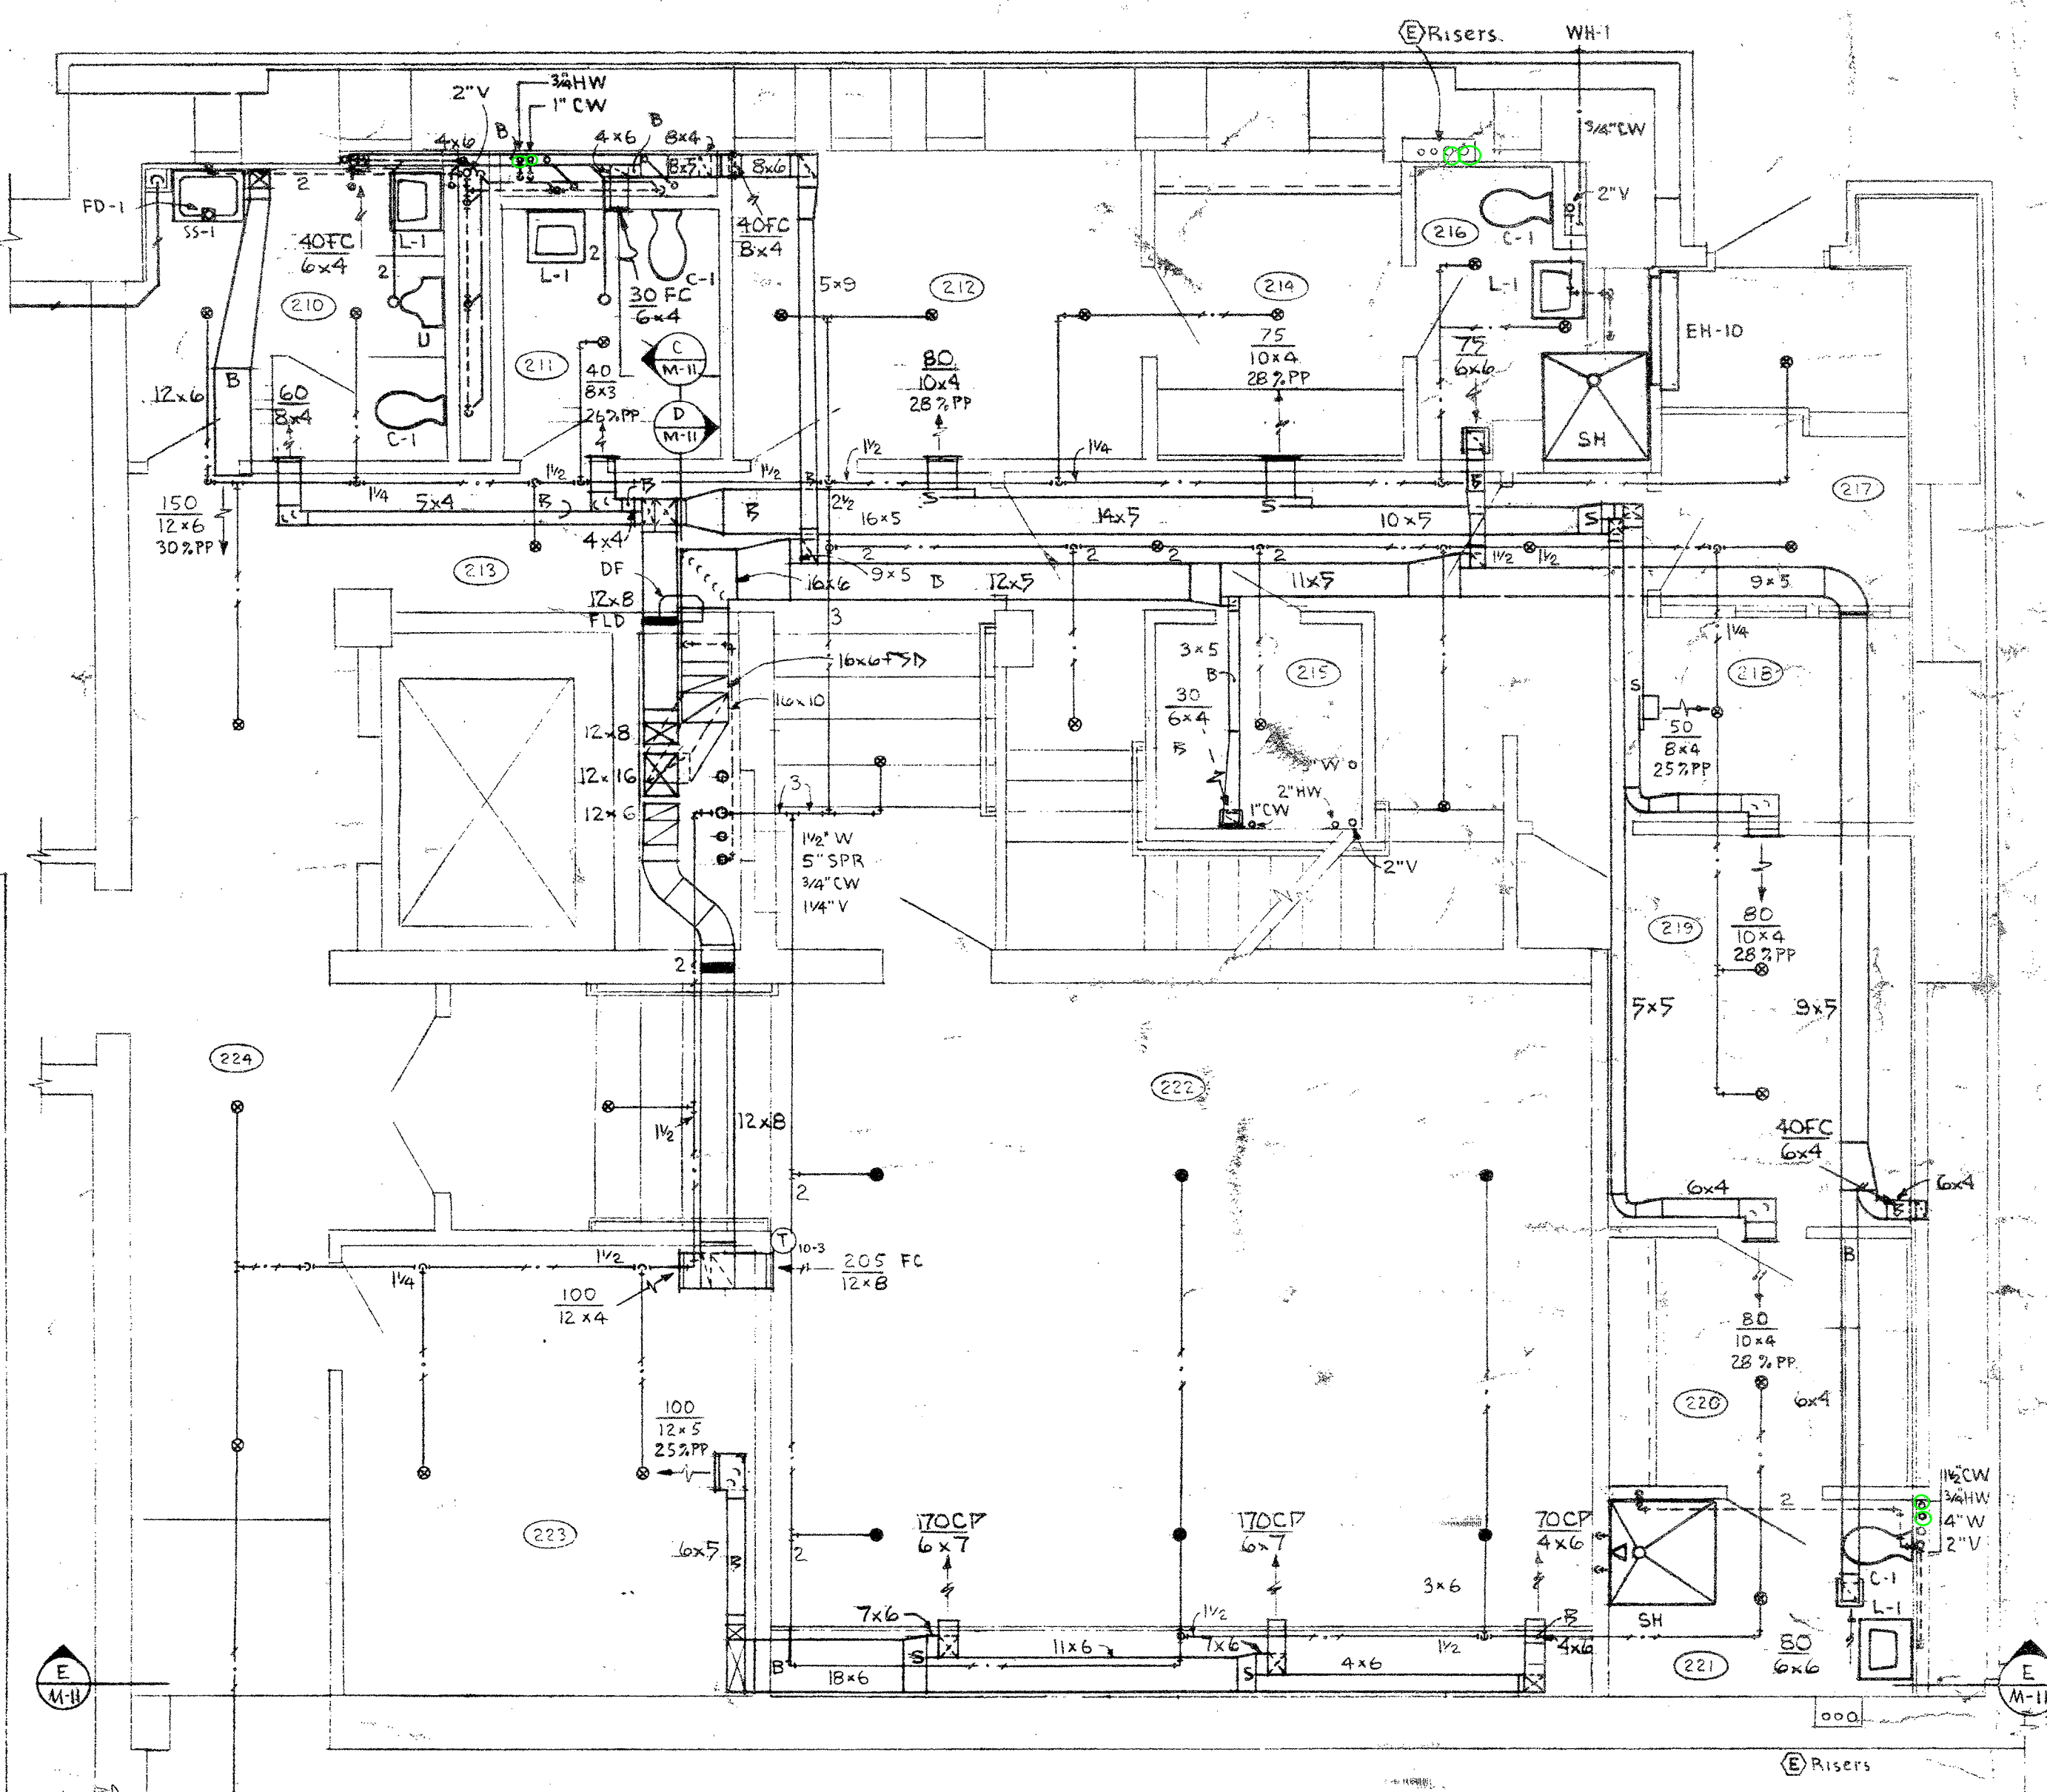


FLOOR PLAN - DRESSING ROOM AREA  
UPPER BASEMENT LEVEL  
1/4" = 1'-0"

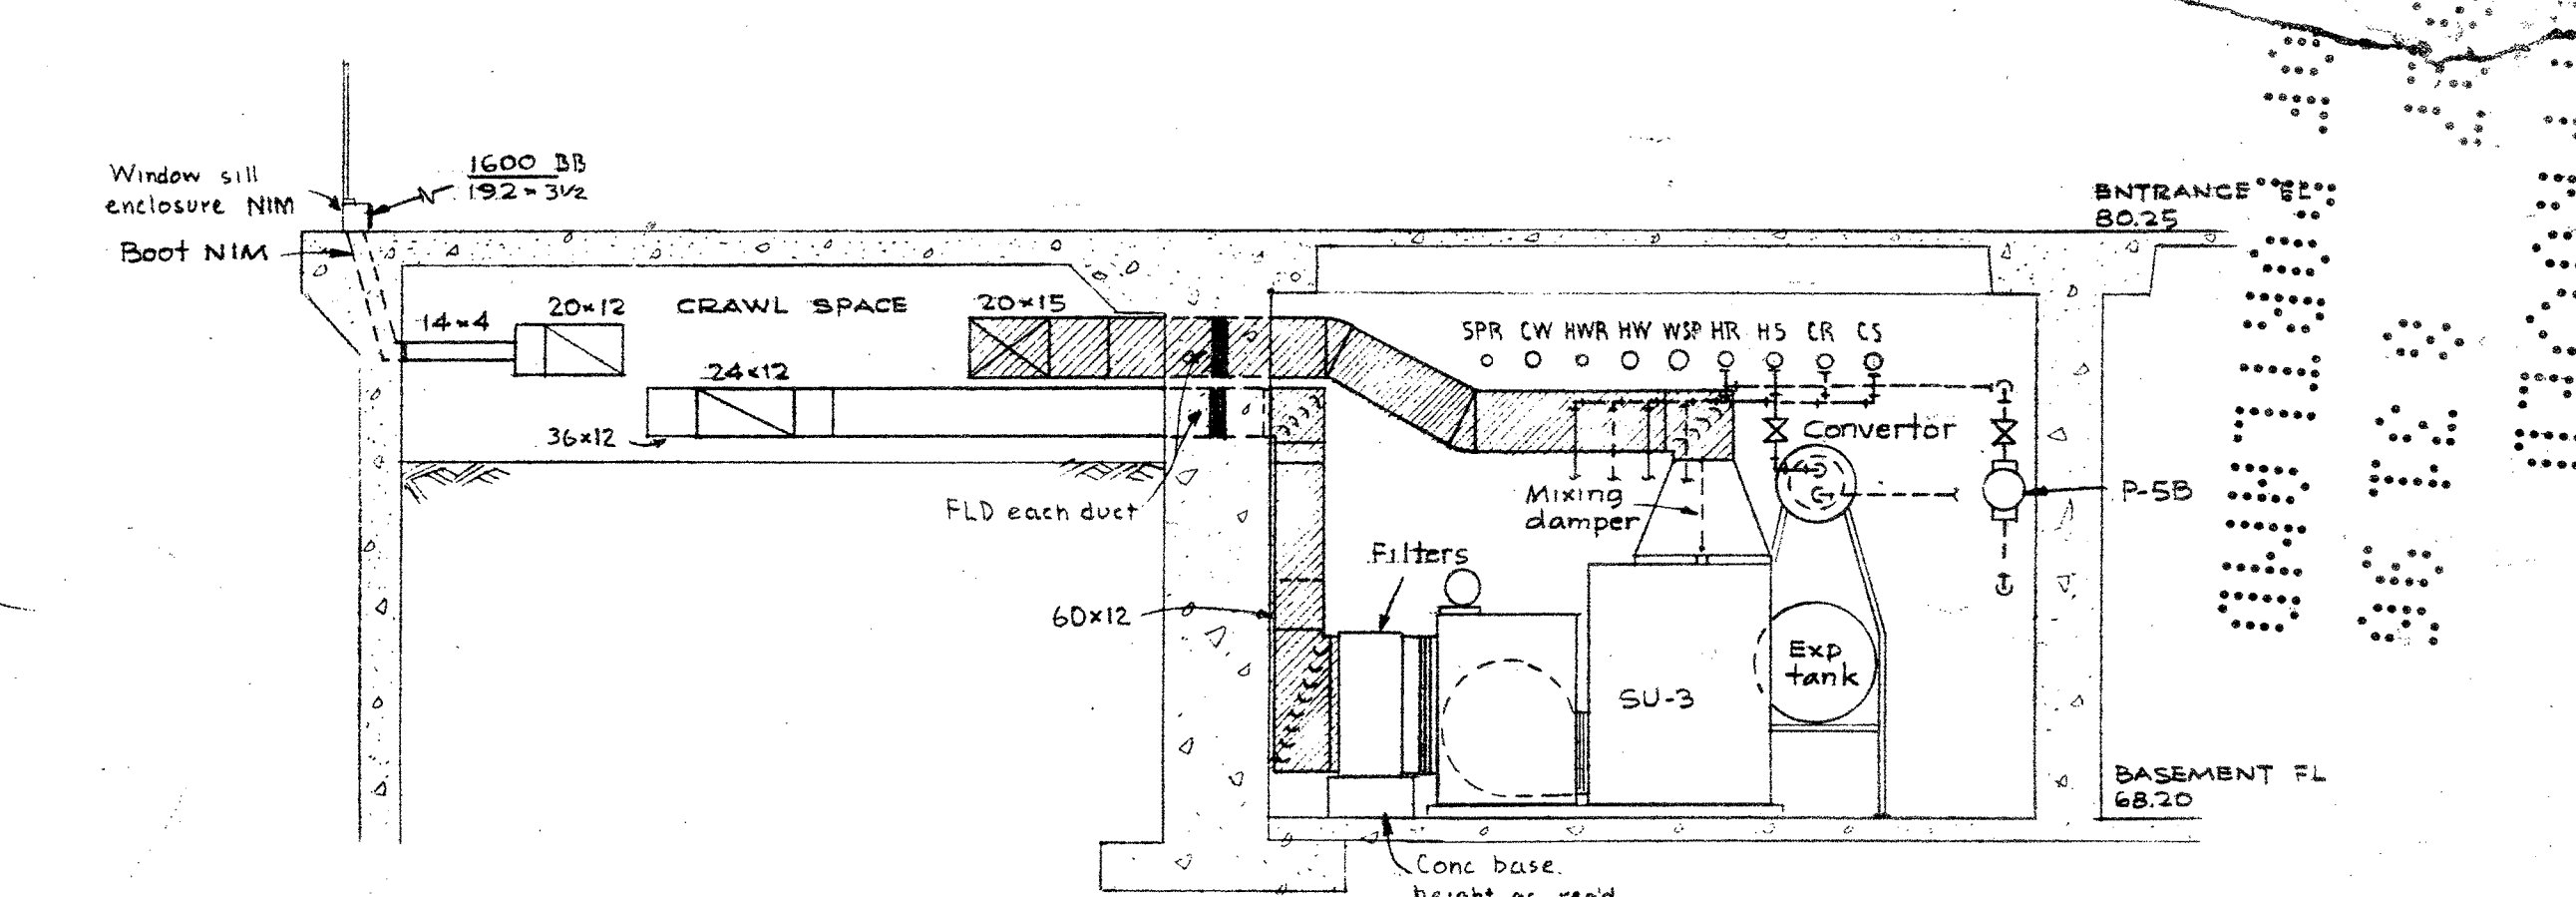

SECTION A-M  
1/4" = 1'-0"

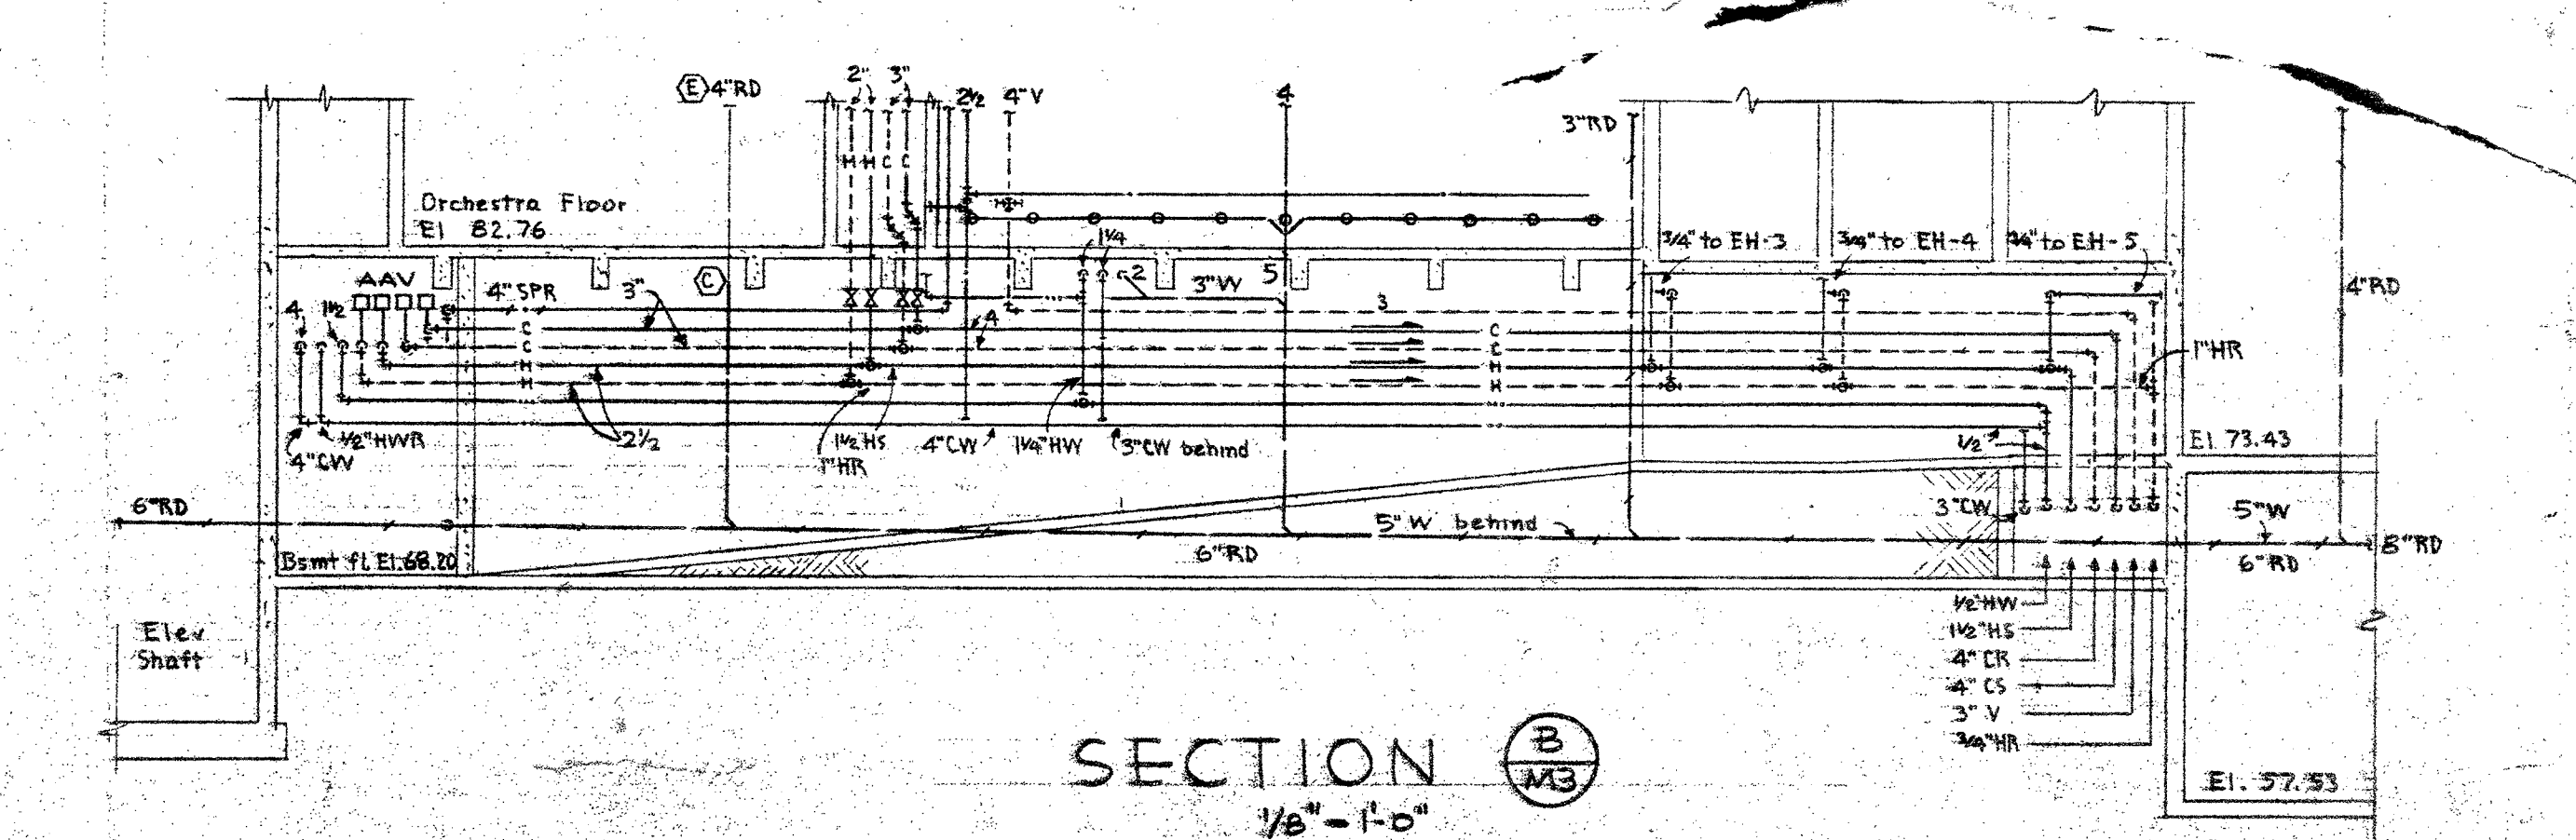

SECTION B-W  
3/8" = 1'-0"

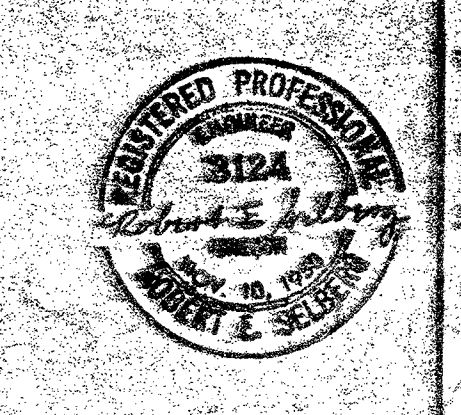

**MECHANICAL UPPER BASEMENT FLOOR PLAN AND DETAILS**





**REBUILDING OF PORTLAND CIVIC AUDITORIUM**  
 3 W. THIRD AVENUE & CLAY STREET  
 CITY OF PORTLAND OREGON

**ARCHITECT:** MARCUS PRITECA  
**THEATER CONSULTANT:** PAUL VENEKASSEN & ASSOCIATES  
**ACOUSTICAL CONSULTANTS:** COOPER & ROSE & ASSOCIATES  
**STRUCTURAL ENGINEERS:** J. DONALD KROEGER & ASSOCIATES  
**Mechanical Engineers:** GRANT KELLEY & ASSOCIATES  
**Electrical Engineers:** ILLA C. GILWELL & A.D.  
**INTERIOR CONSULTANT:**

**DRAWING:** STANTON, BOLES, MAGUIRE & CHURCH ARCHITECTS  
 208 S. W. STARK ST., PORTLAND 4, OREGON  
 COMM. NO. 8223  
 DATE: MAY 24 1966

**M-3**

CHECKED

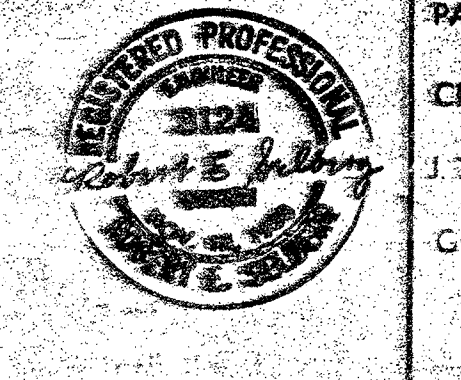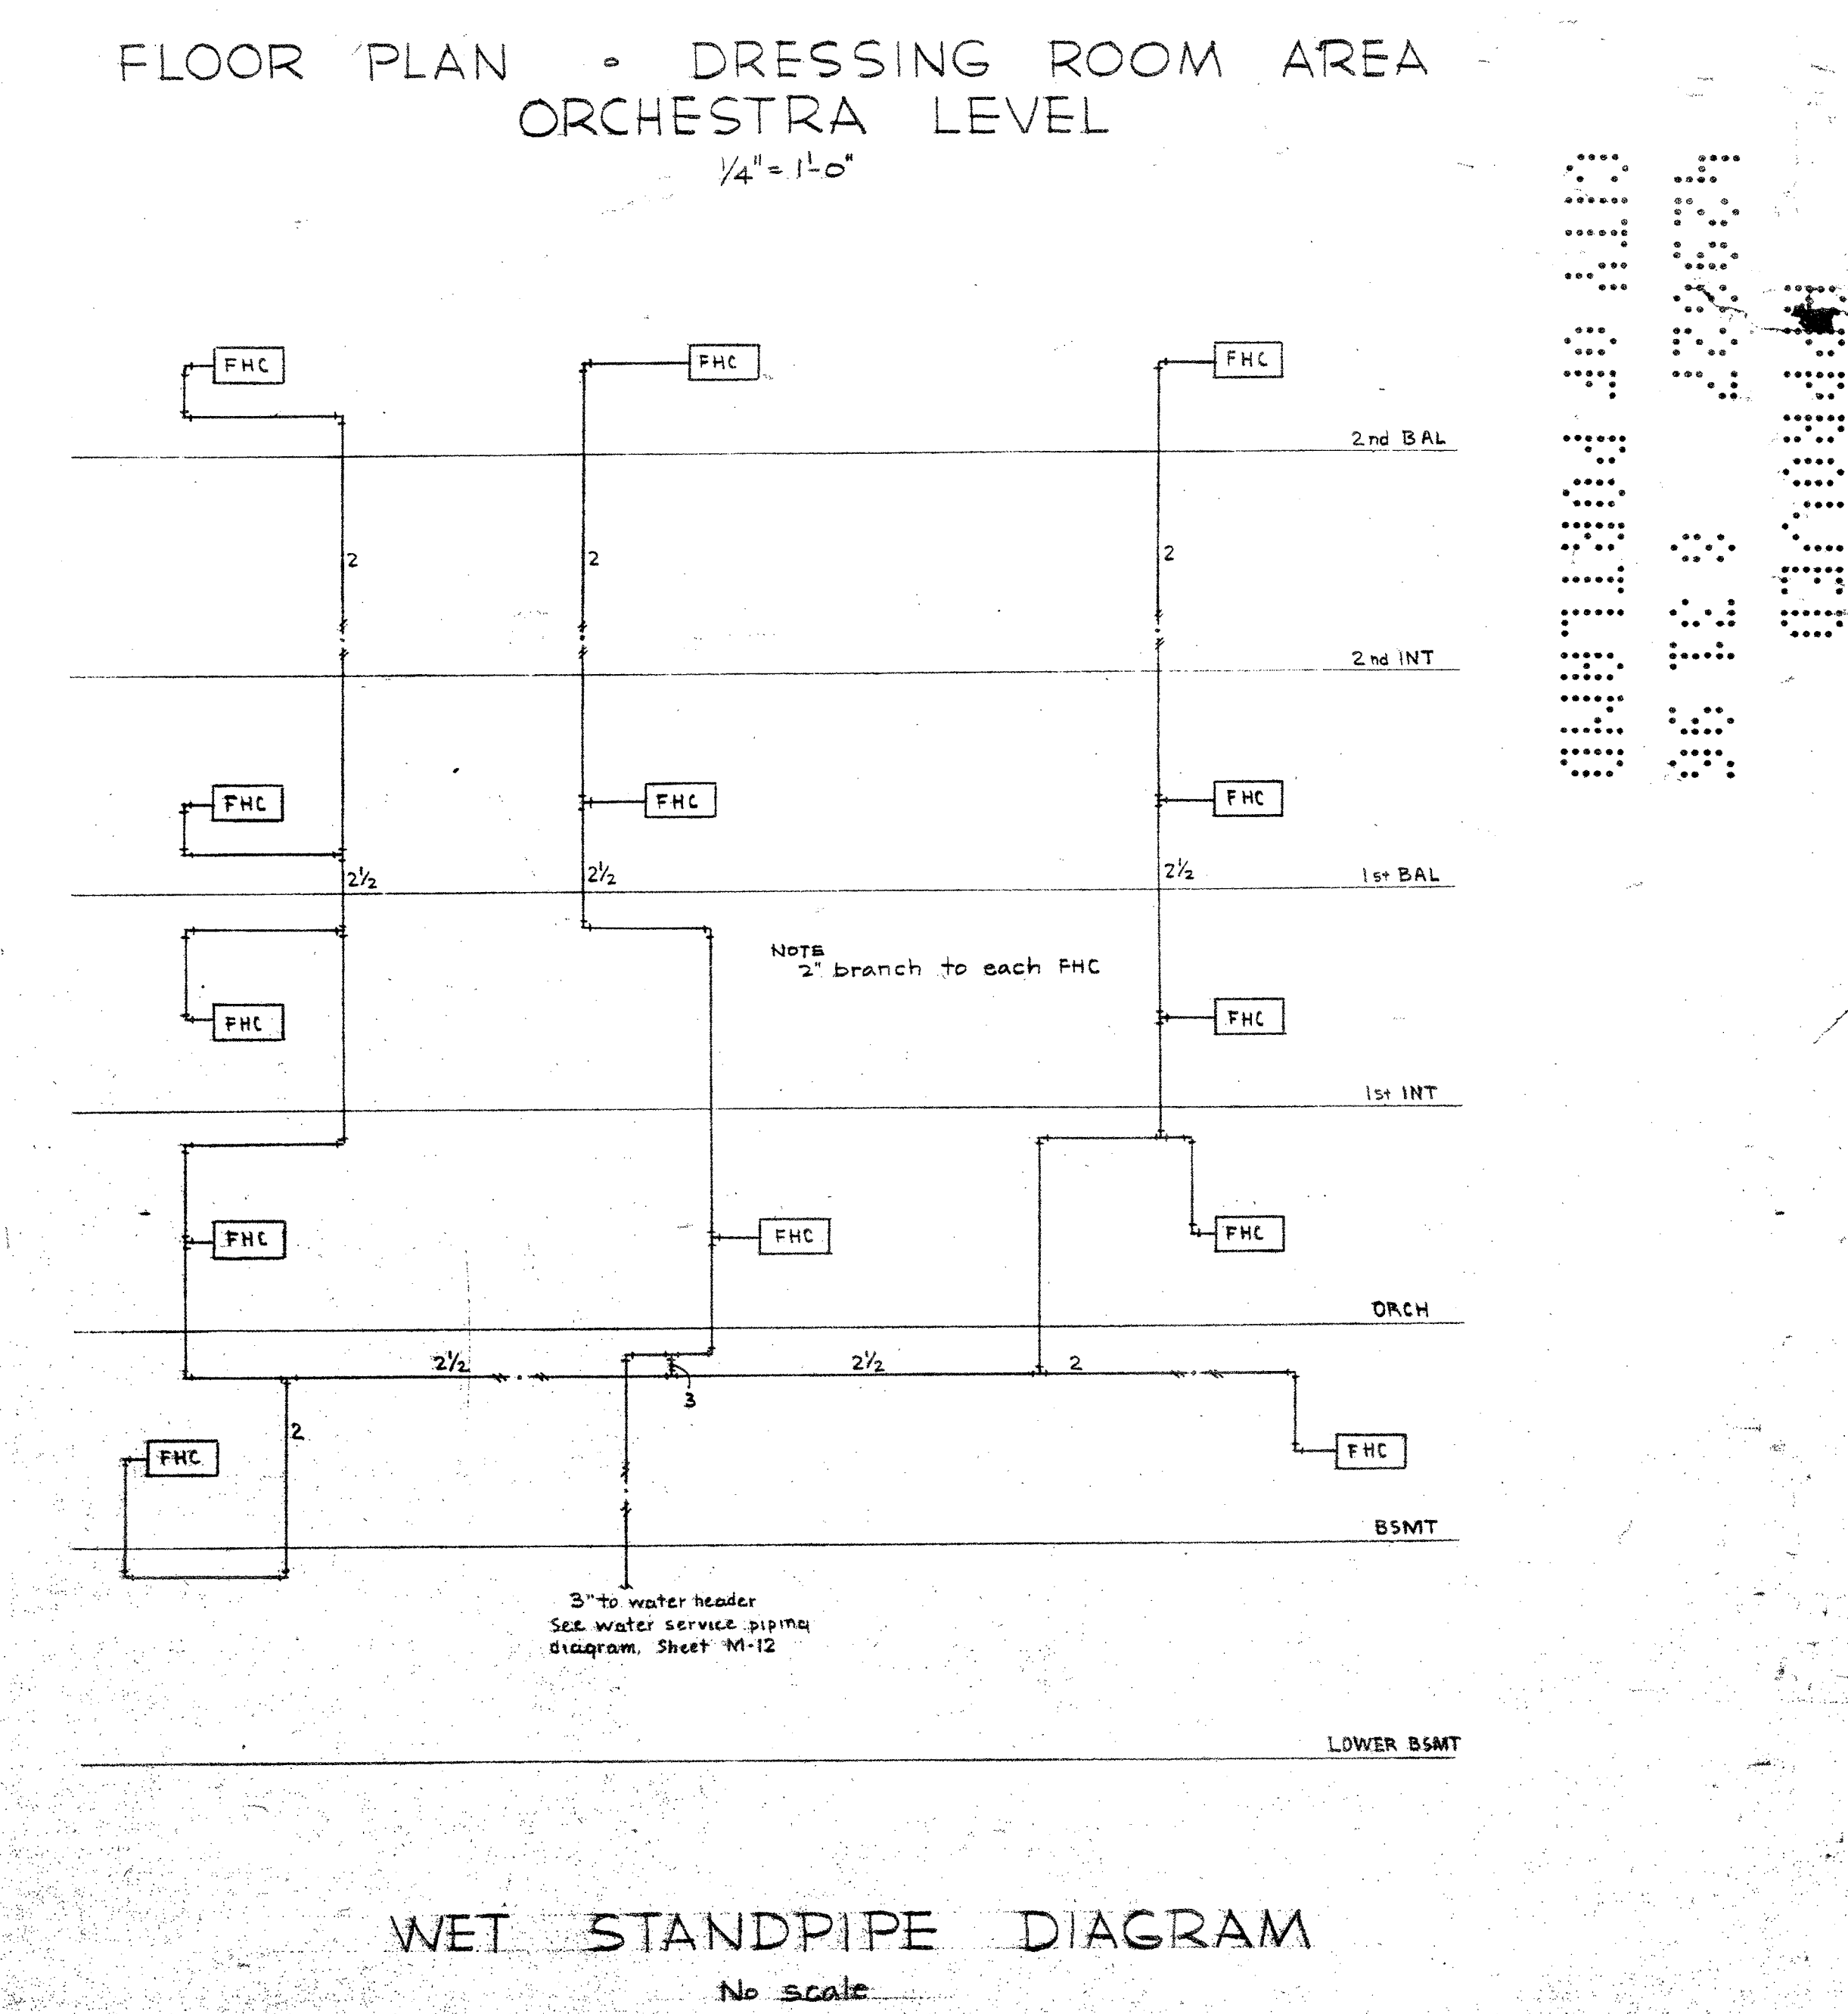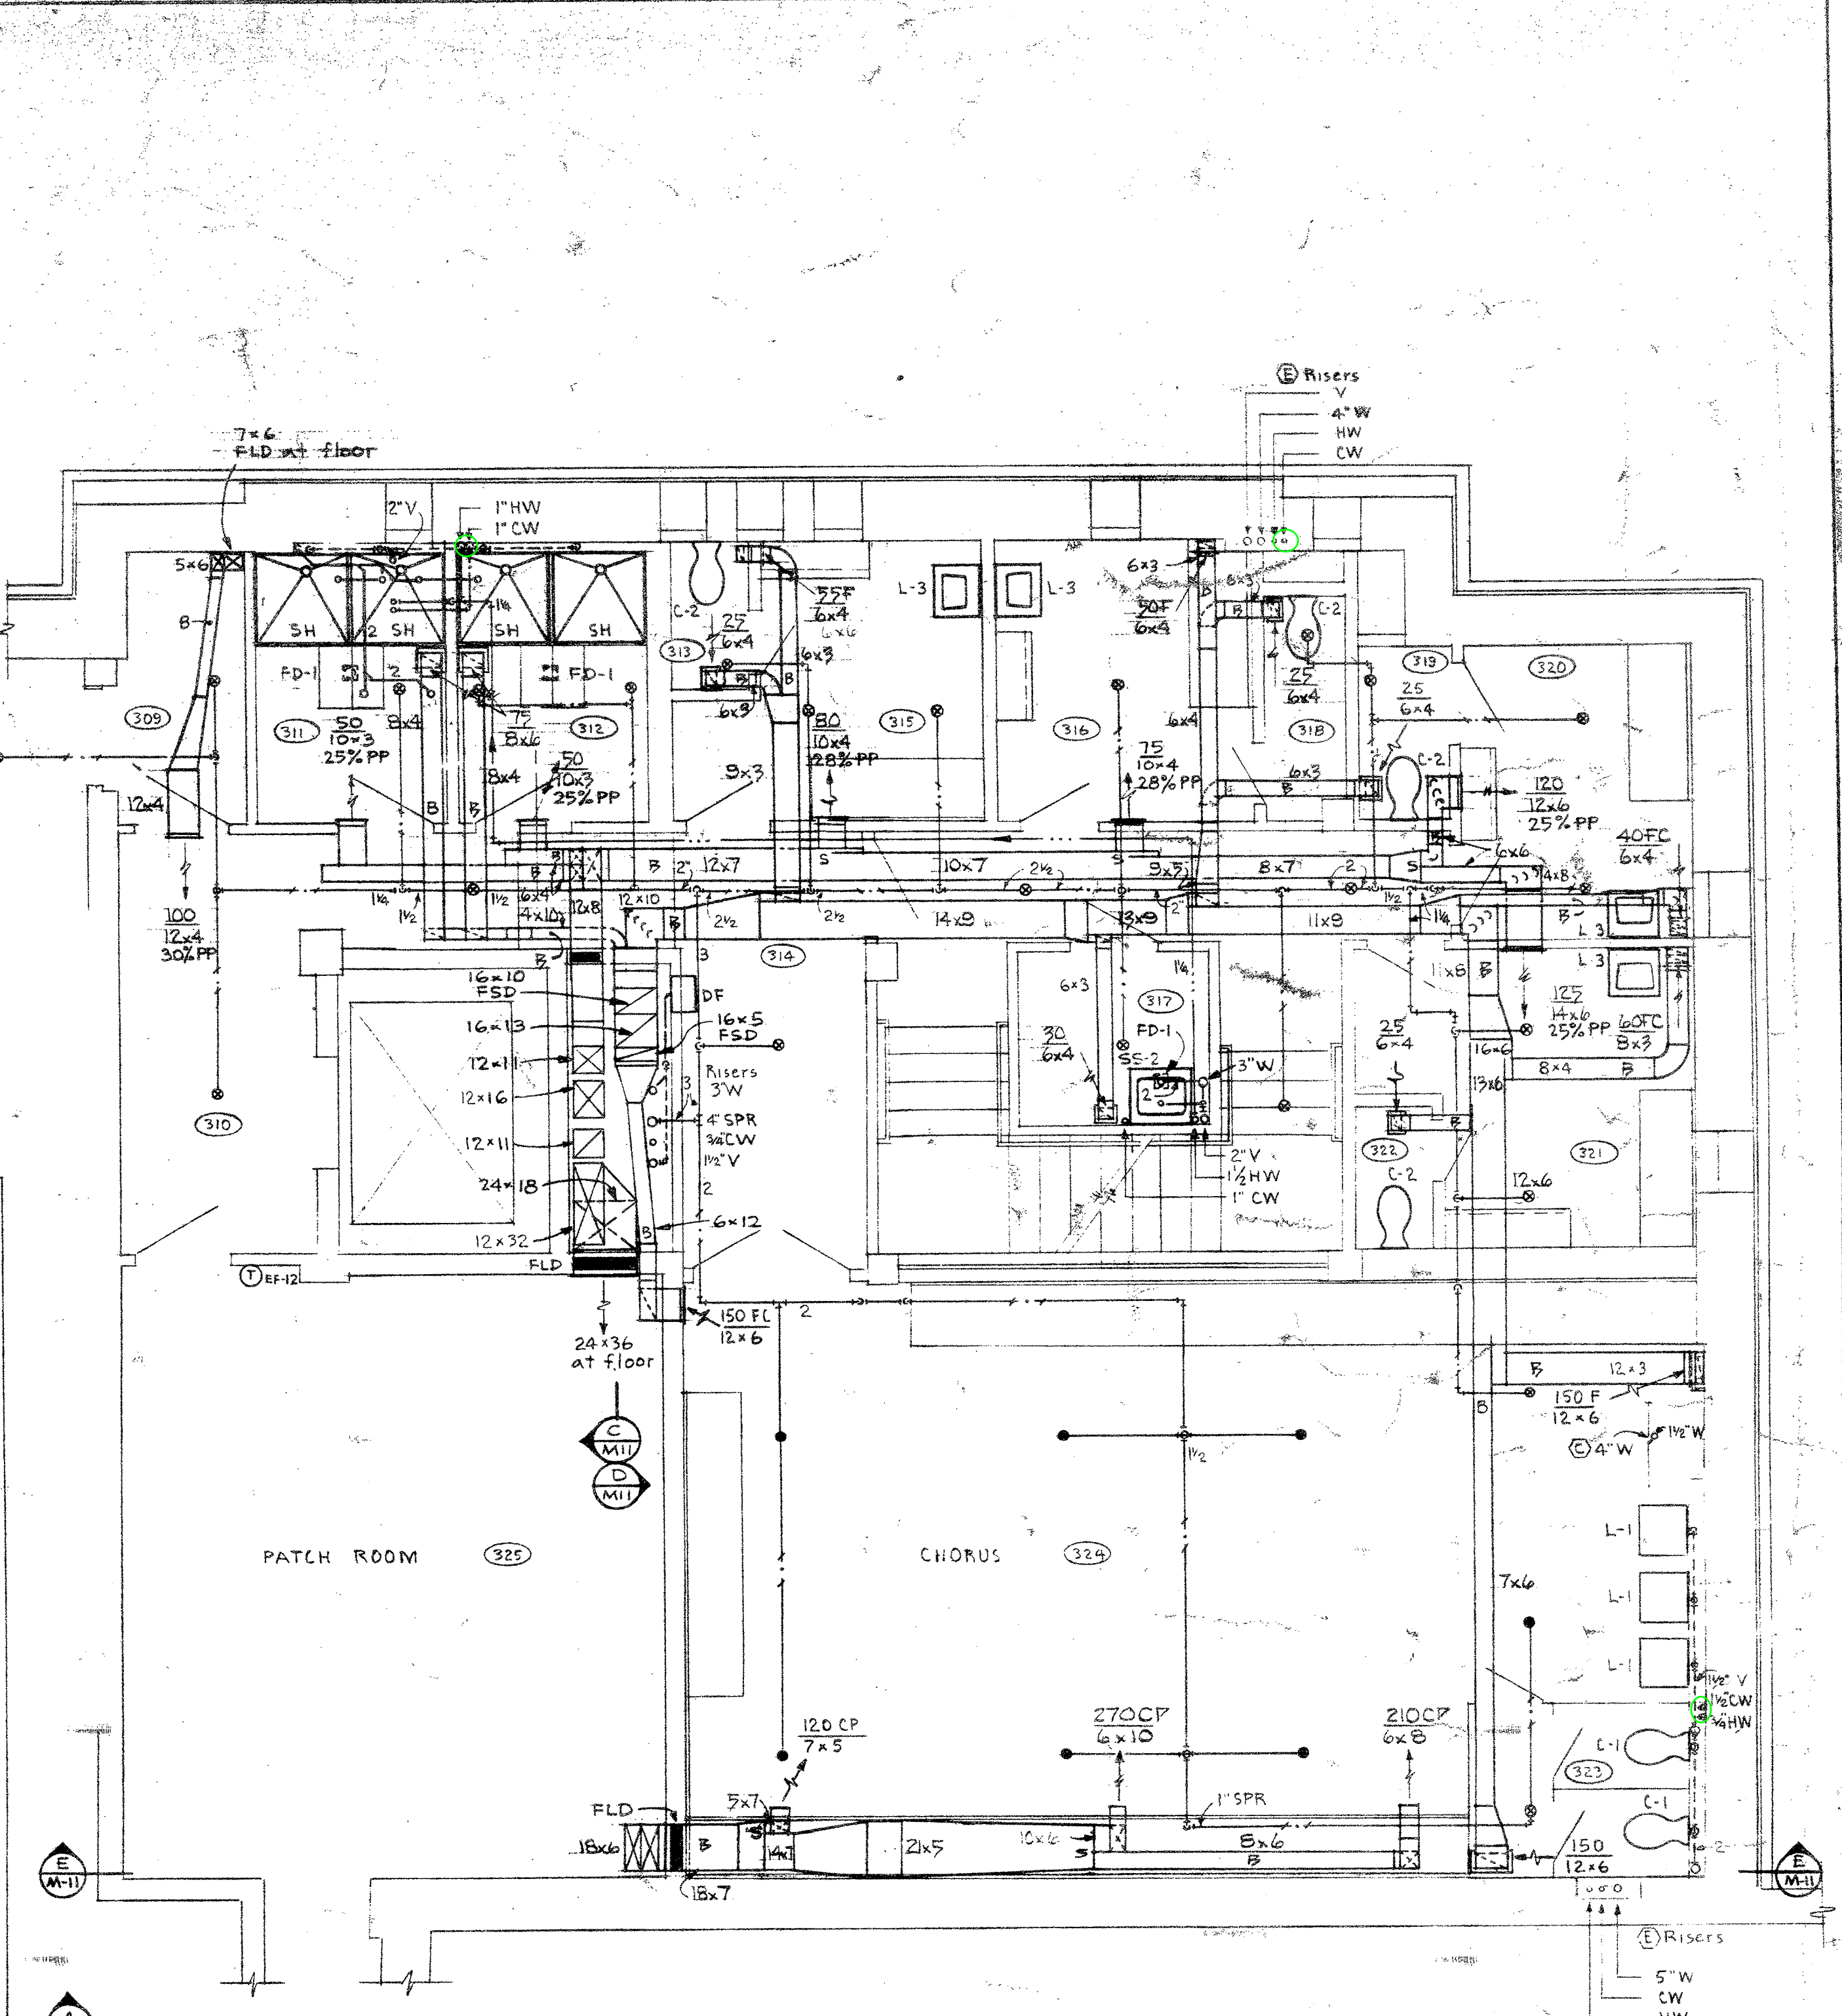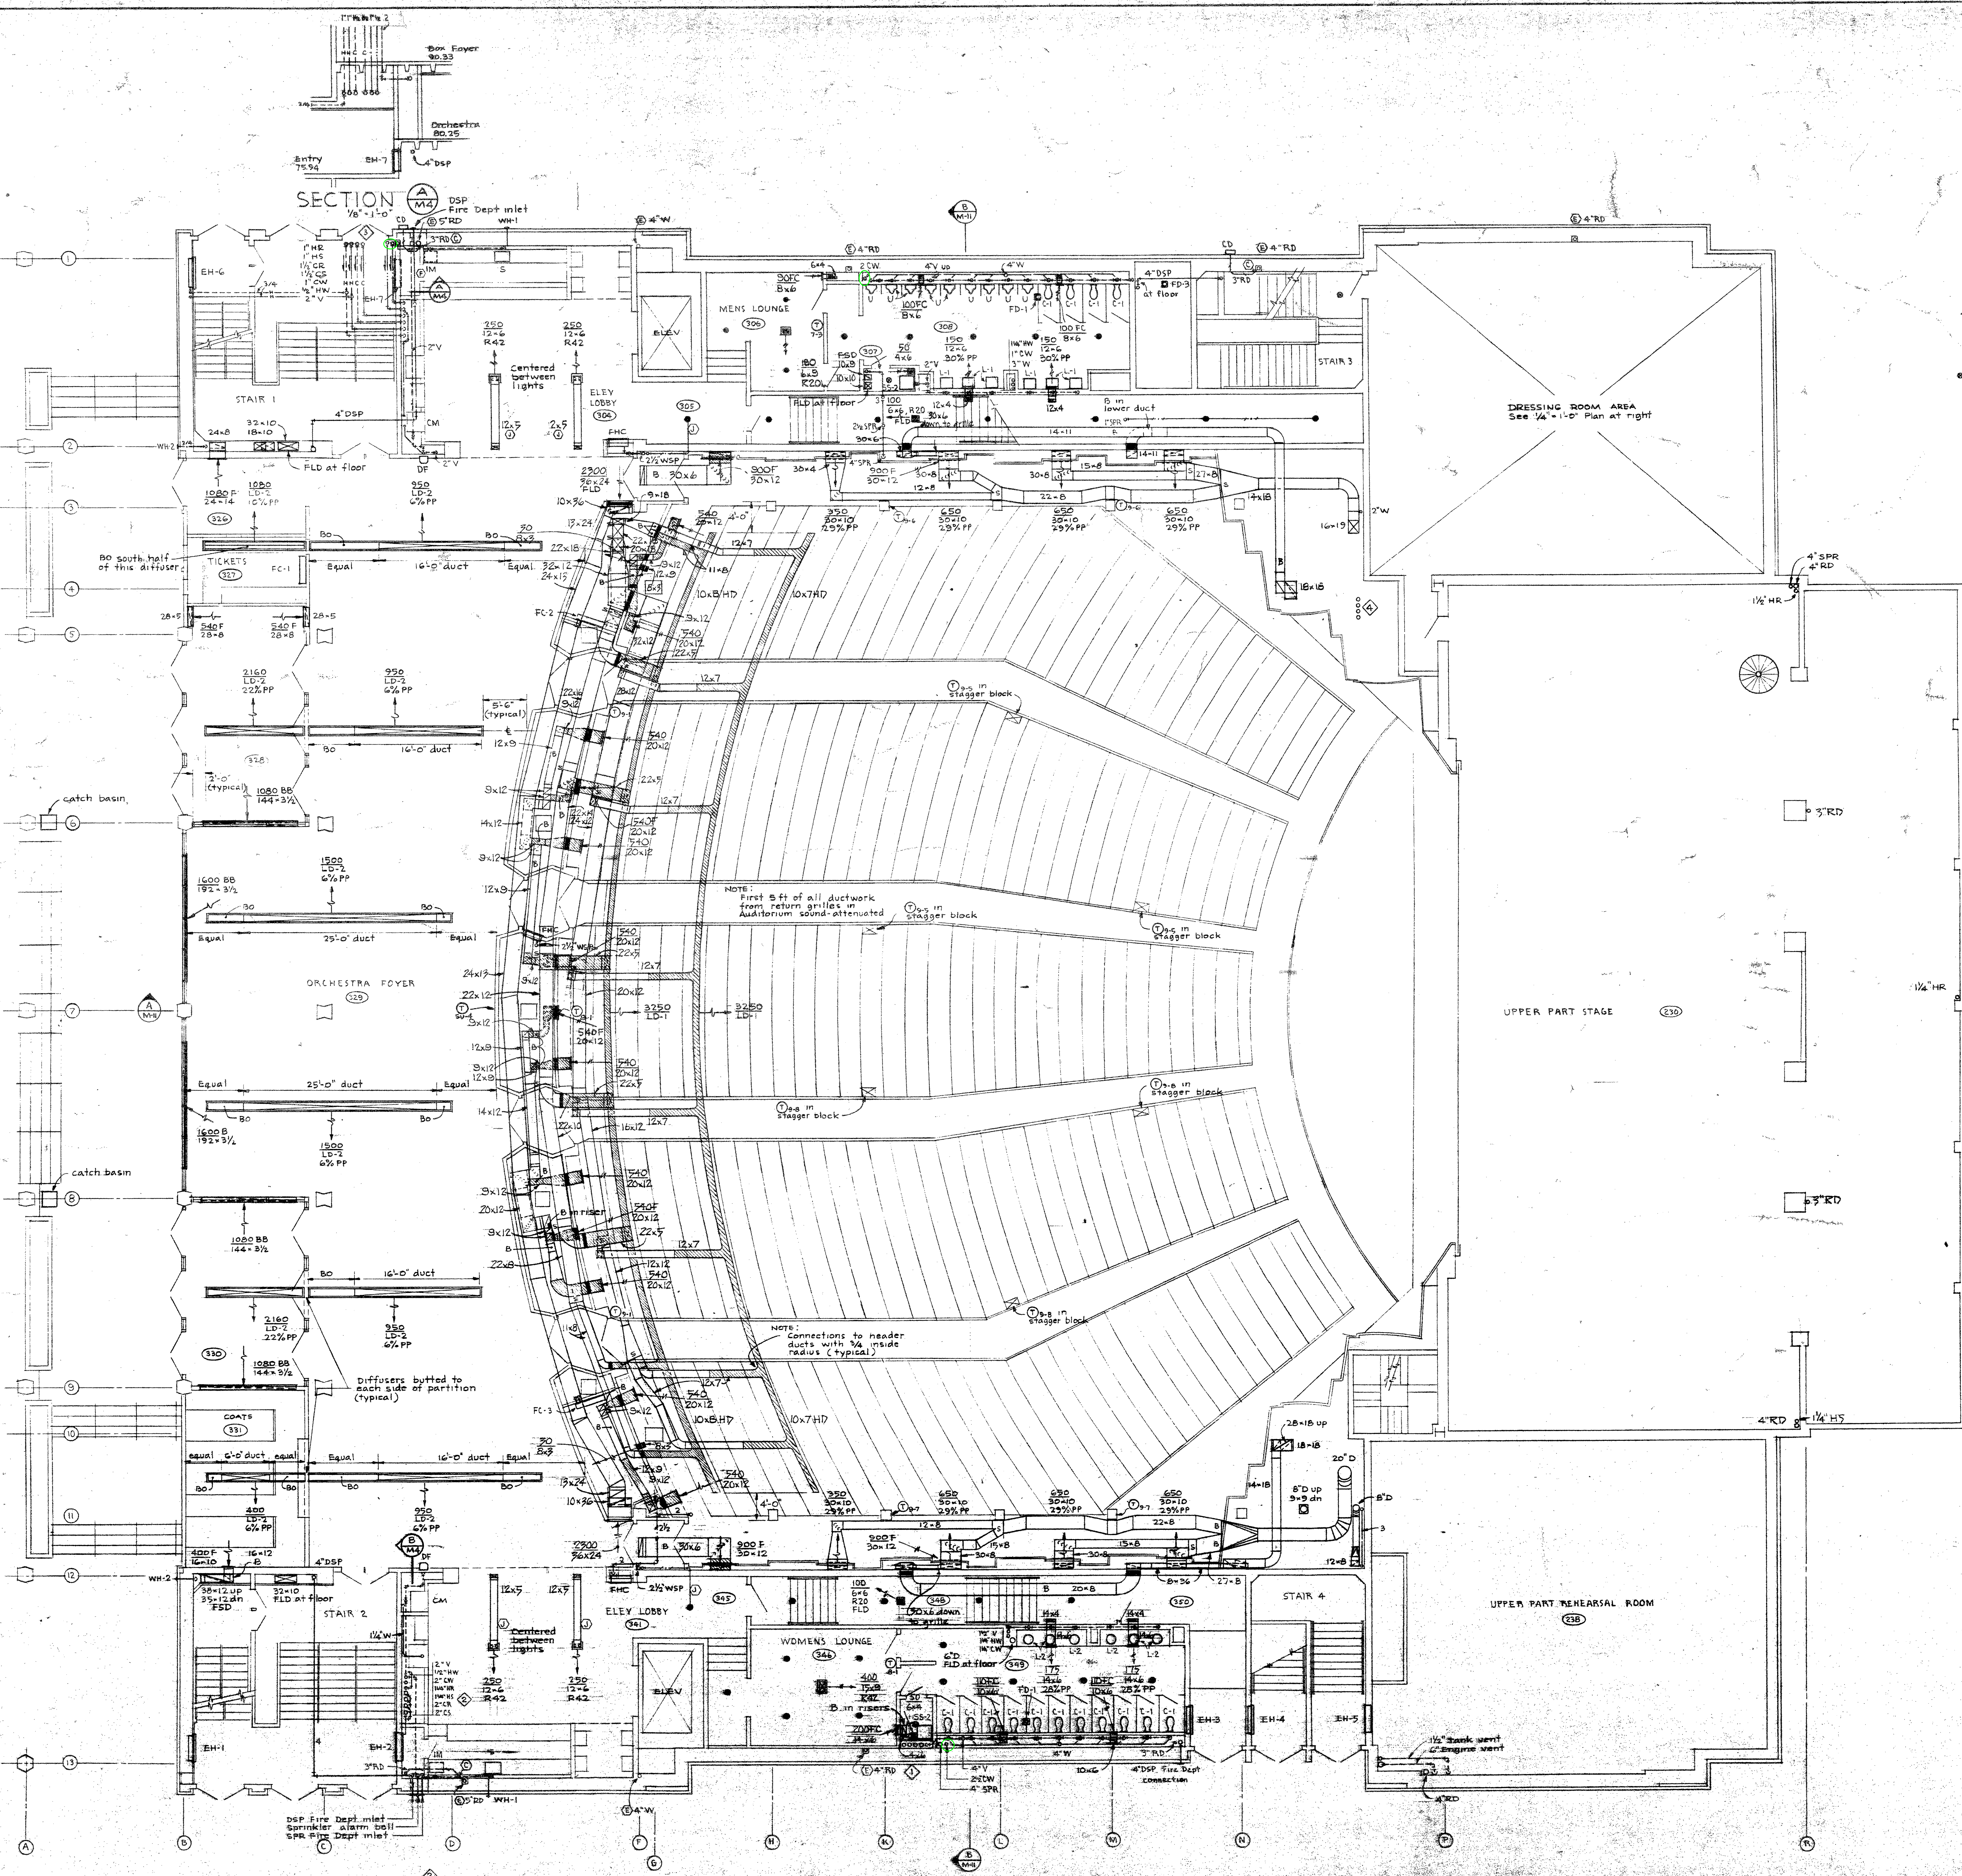

**MECHANICAL ORCHESTRA LEVEL FLOOR PLAN AND DETAILS**


**REBUILDING OF PORTLAND CIVIC AUDITORIUM**  
S. W. THIRD AVENUE & CLAY STREET  
FOR  
CITY OF PORTLAND OREGON

**ARCHITECTS**  
STANTON, BOLES, MAGUIRE & CHURCH  
208 S. W. STARK ST., PORTLAND 4, OREGON  
COMM. NO. 6323  
DATE: MAY 24 1966


**MECHANICAL ENGINEERS**  
B. MARCUS PRITCA  
TIBETER CONSULTANT  
PAUL VENEKASEN & ASSOCIATES  
CODDER & ROSE & ASSOCIATES  
J. DONALD KROEGER & ASSOCIATES  
GRANT KELLEY & ASSOCIATES  
LILA COLWELL A.I.D.

**DRAWING**  
M-4


**CHECKED**  
DRAWN

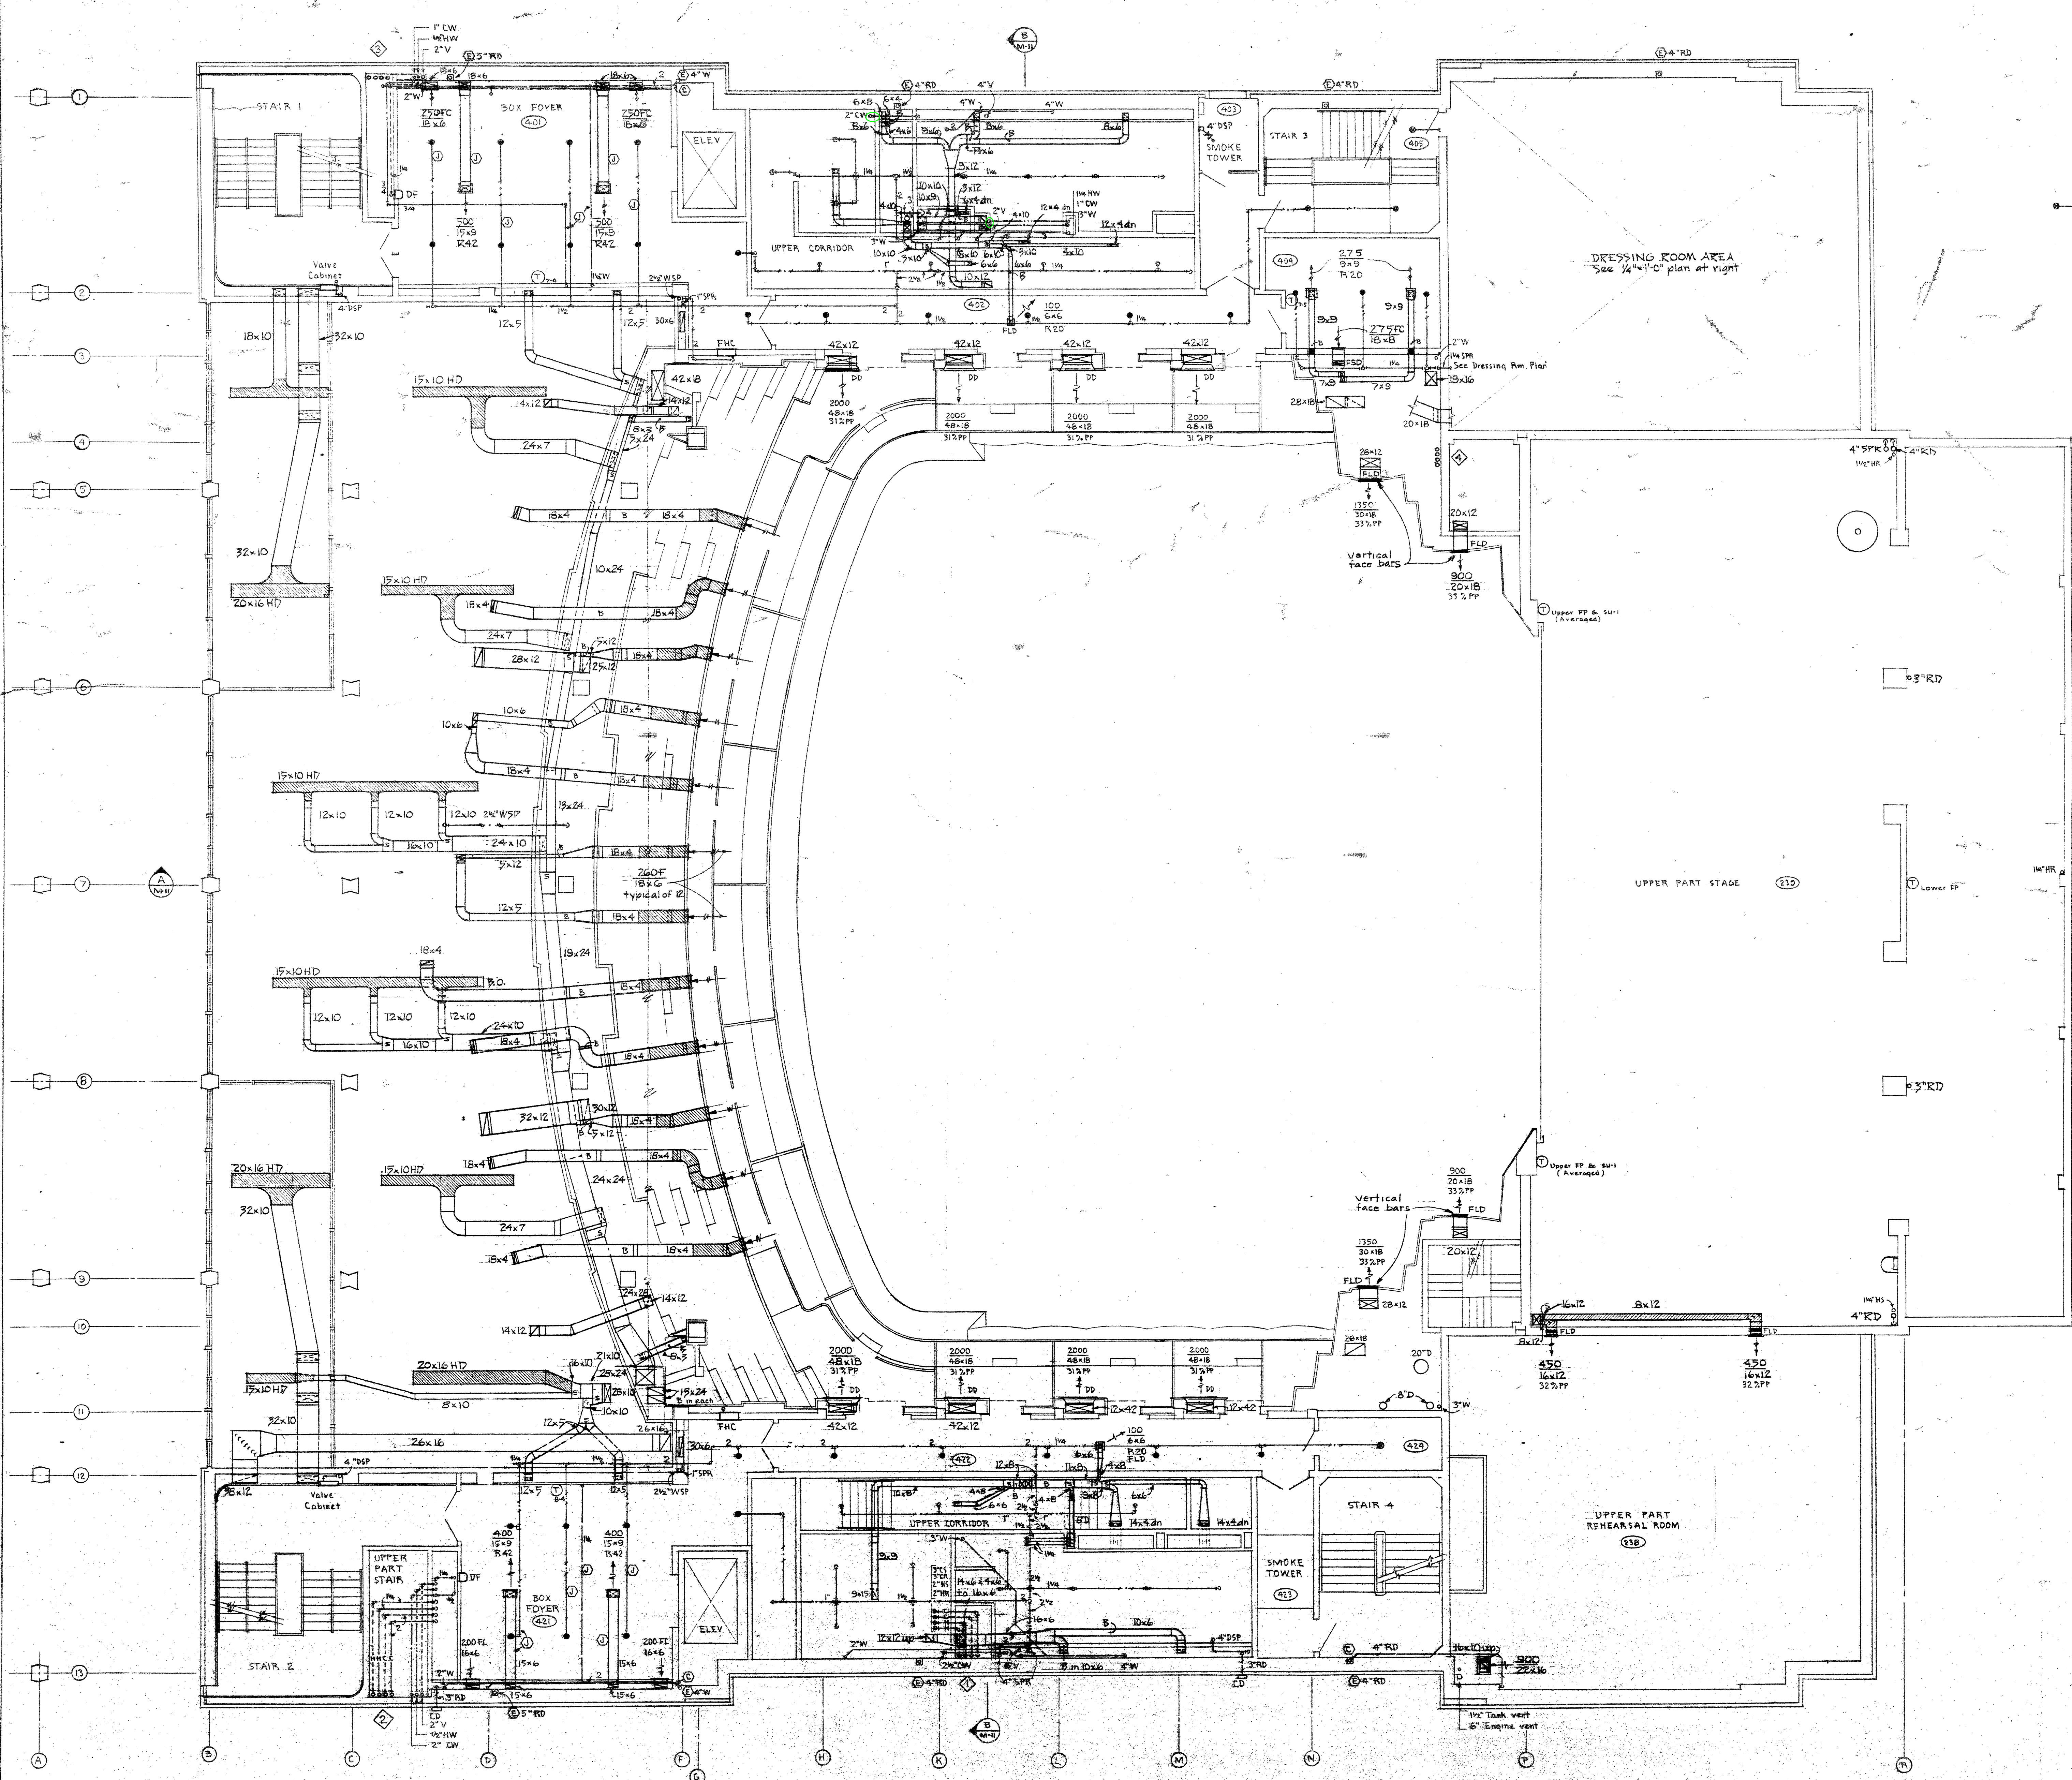



FLOOR PLAN - INTERMEDIATE LEVEL NO. 1  
1/8" = 1'-0"

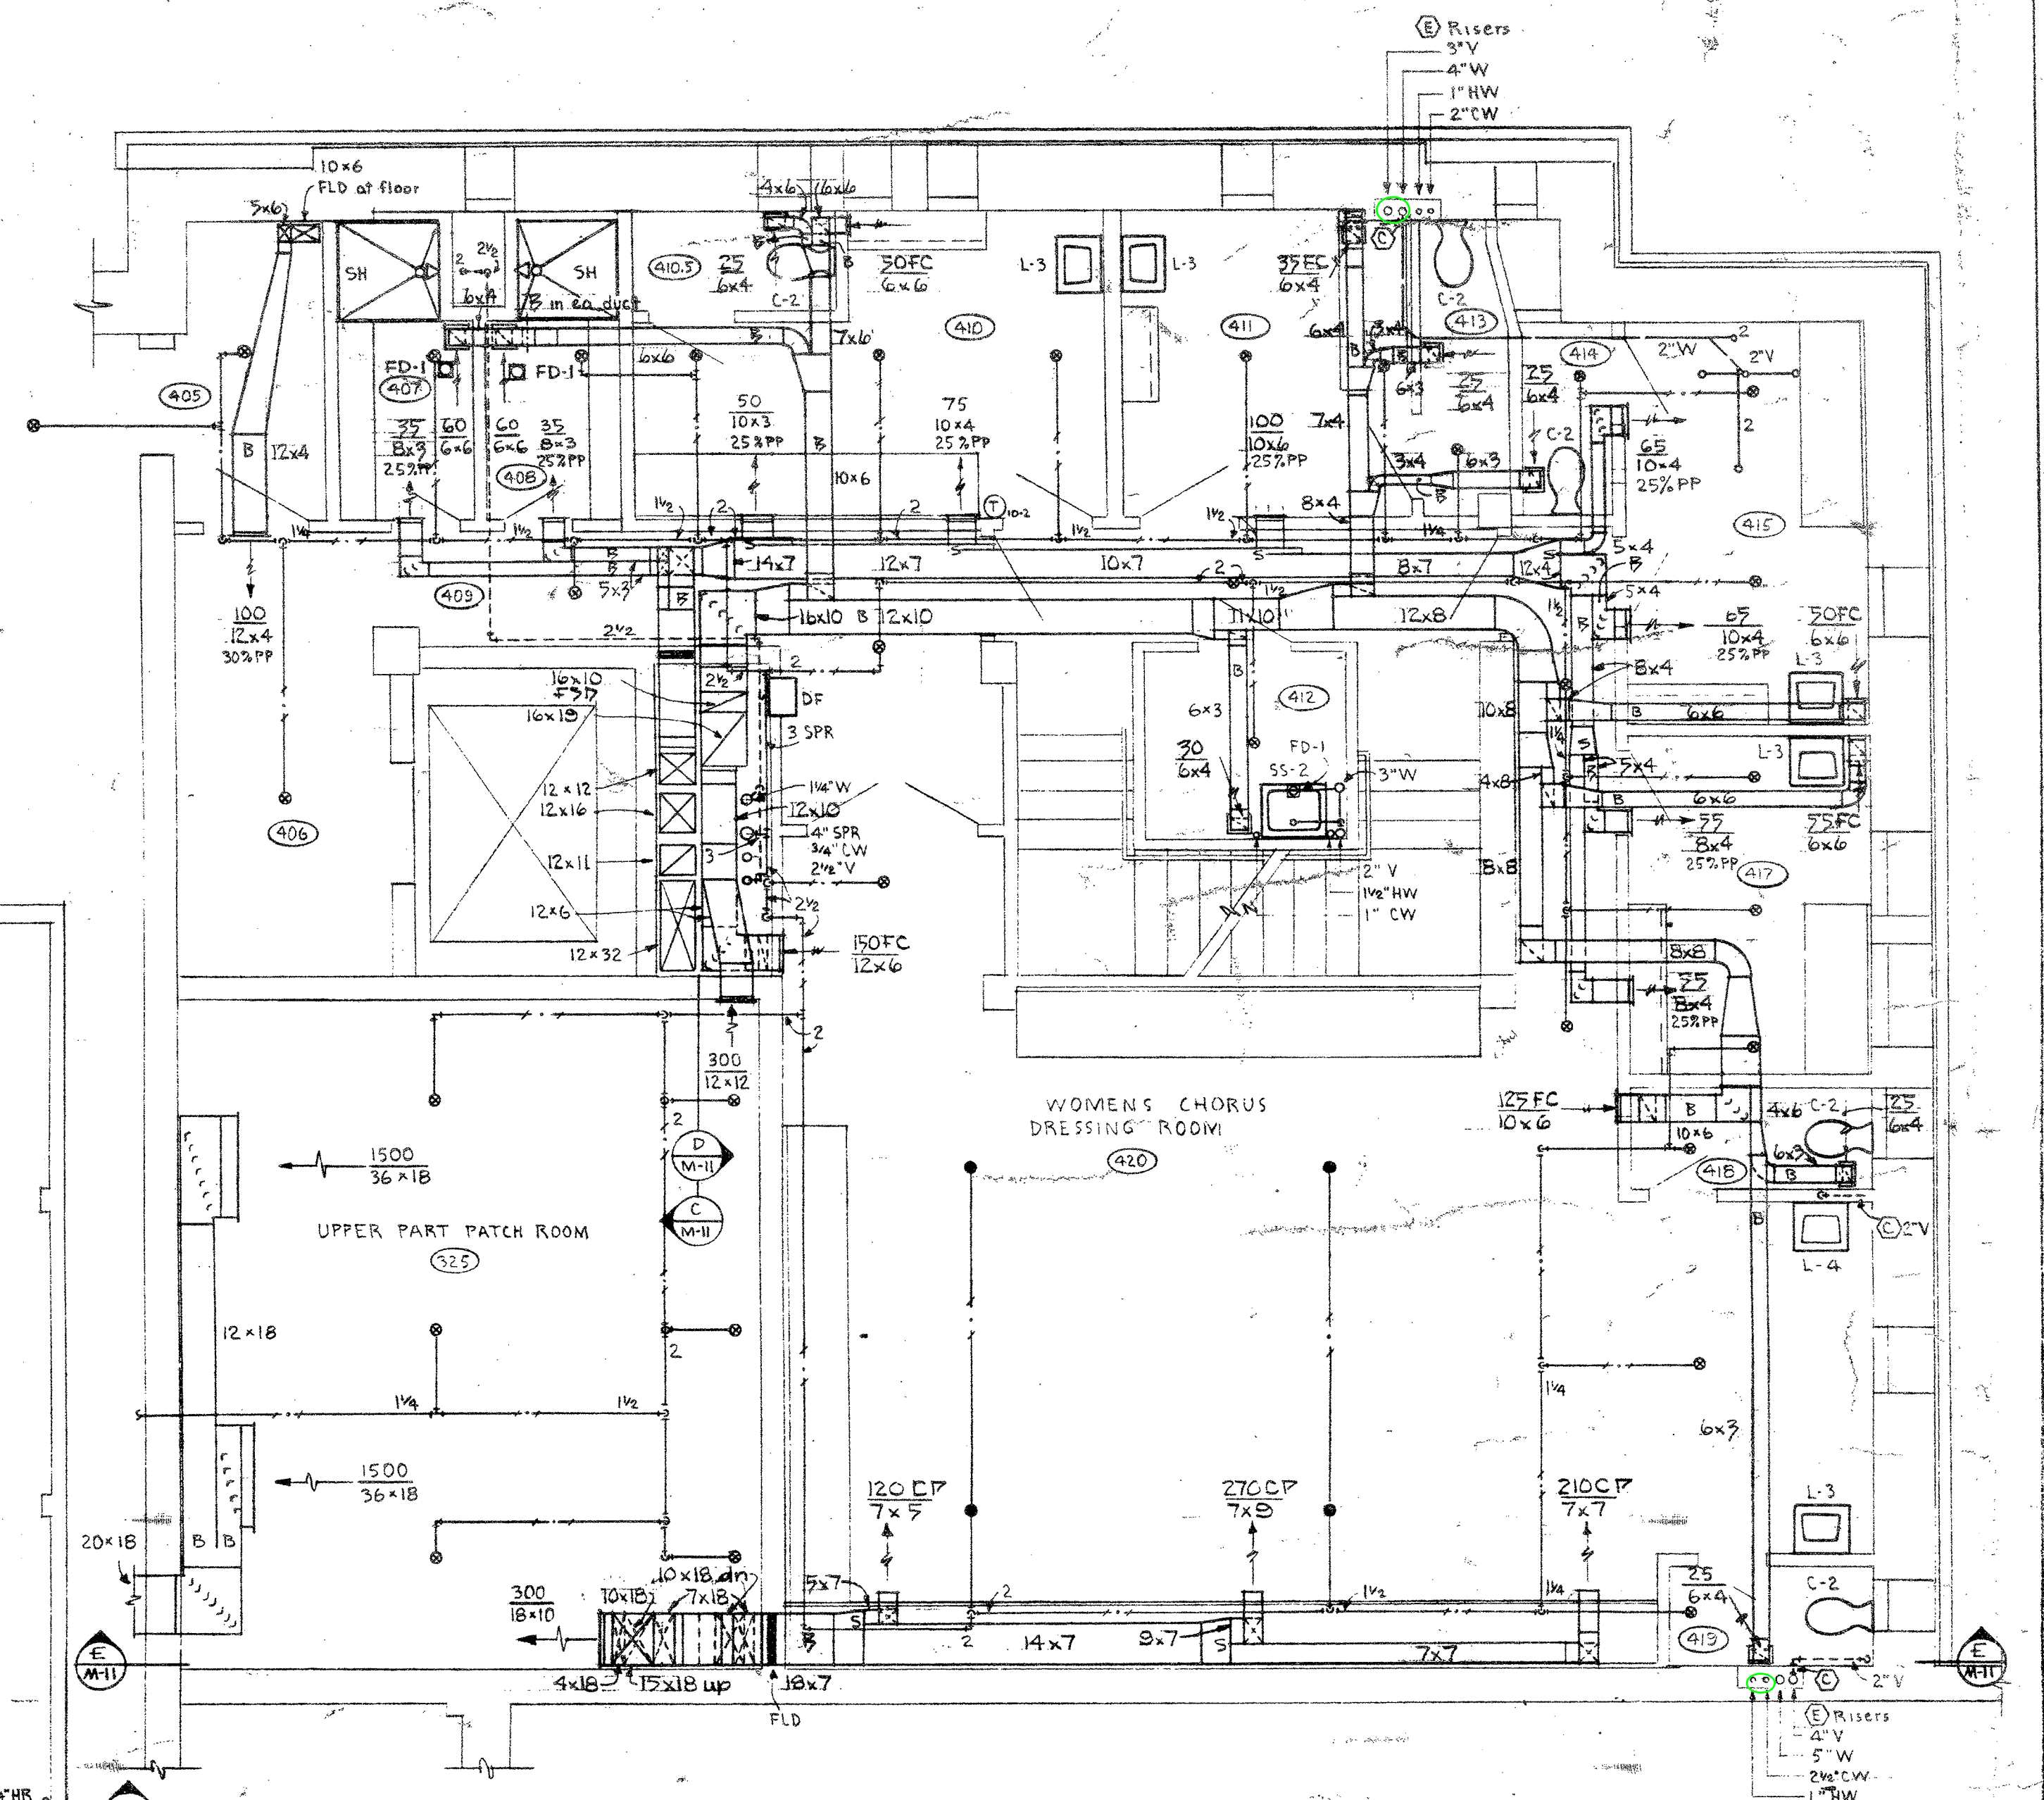

FLOOR PLAN - DRESSING ROOM AREA  
INTERMEDIATE LEVEL NO. 1  
1/4" = 1'-0"

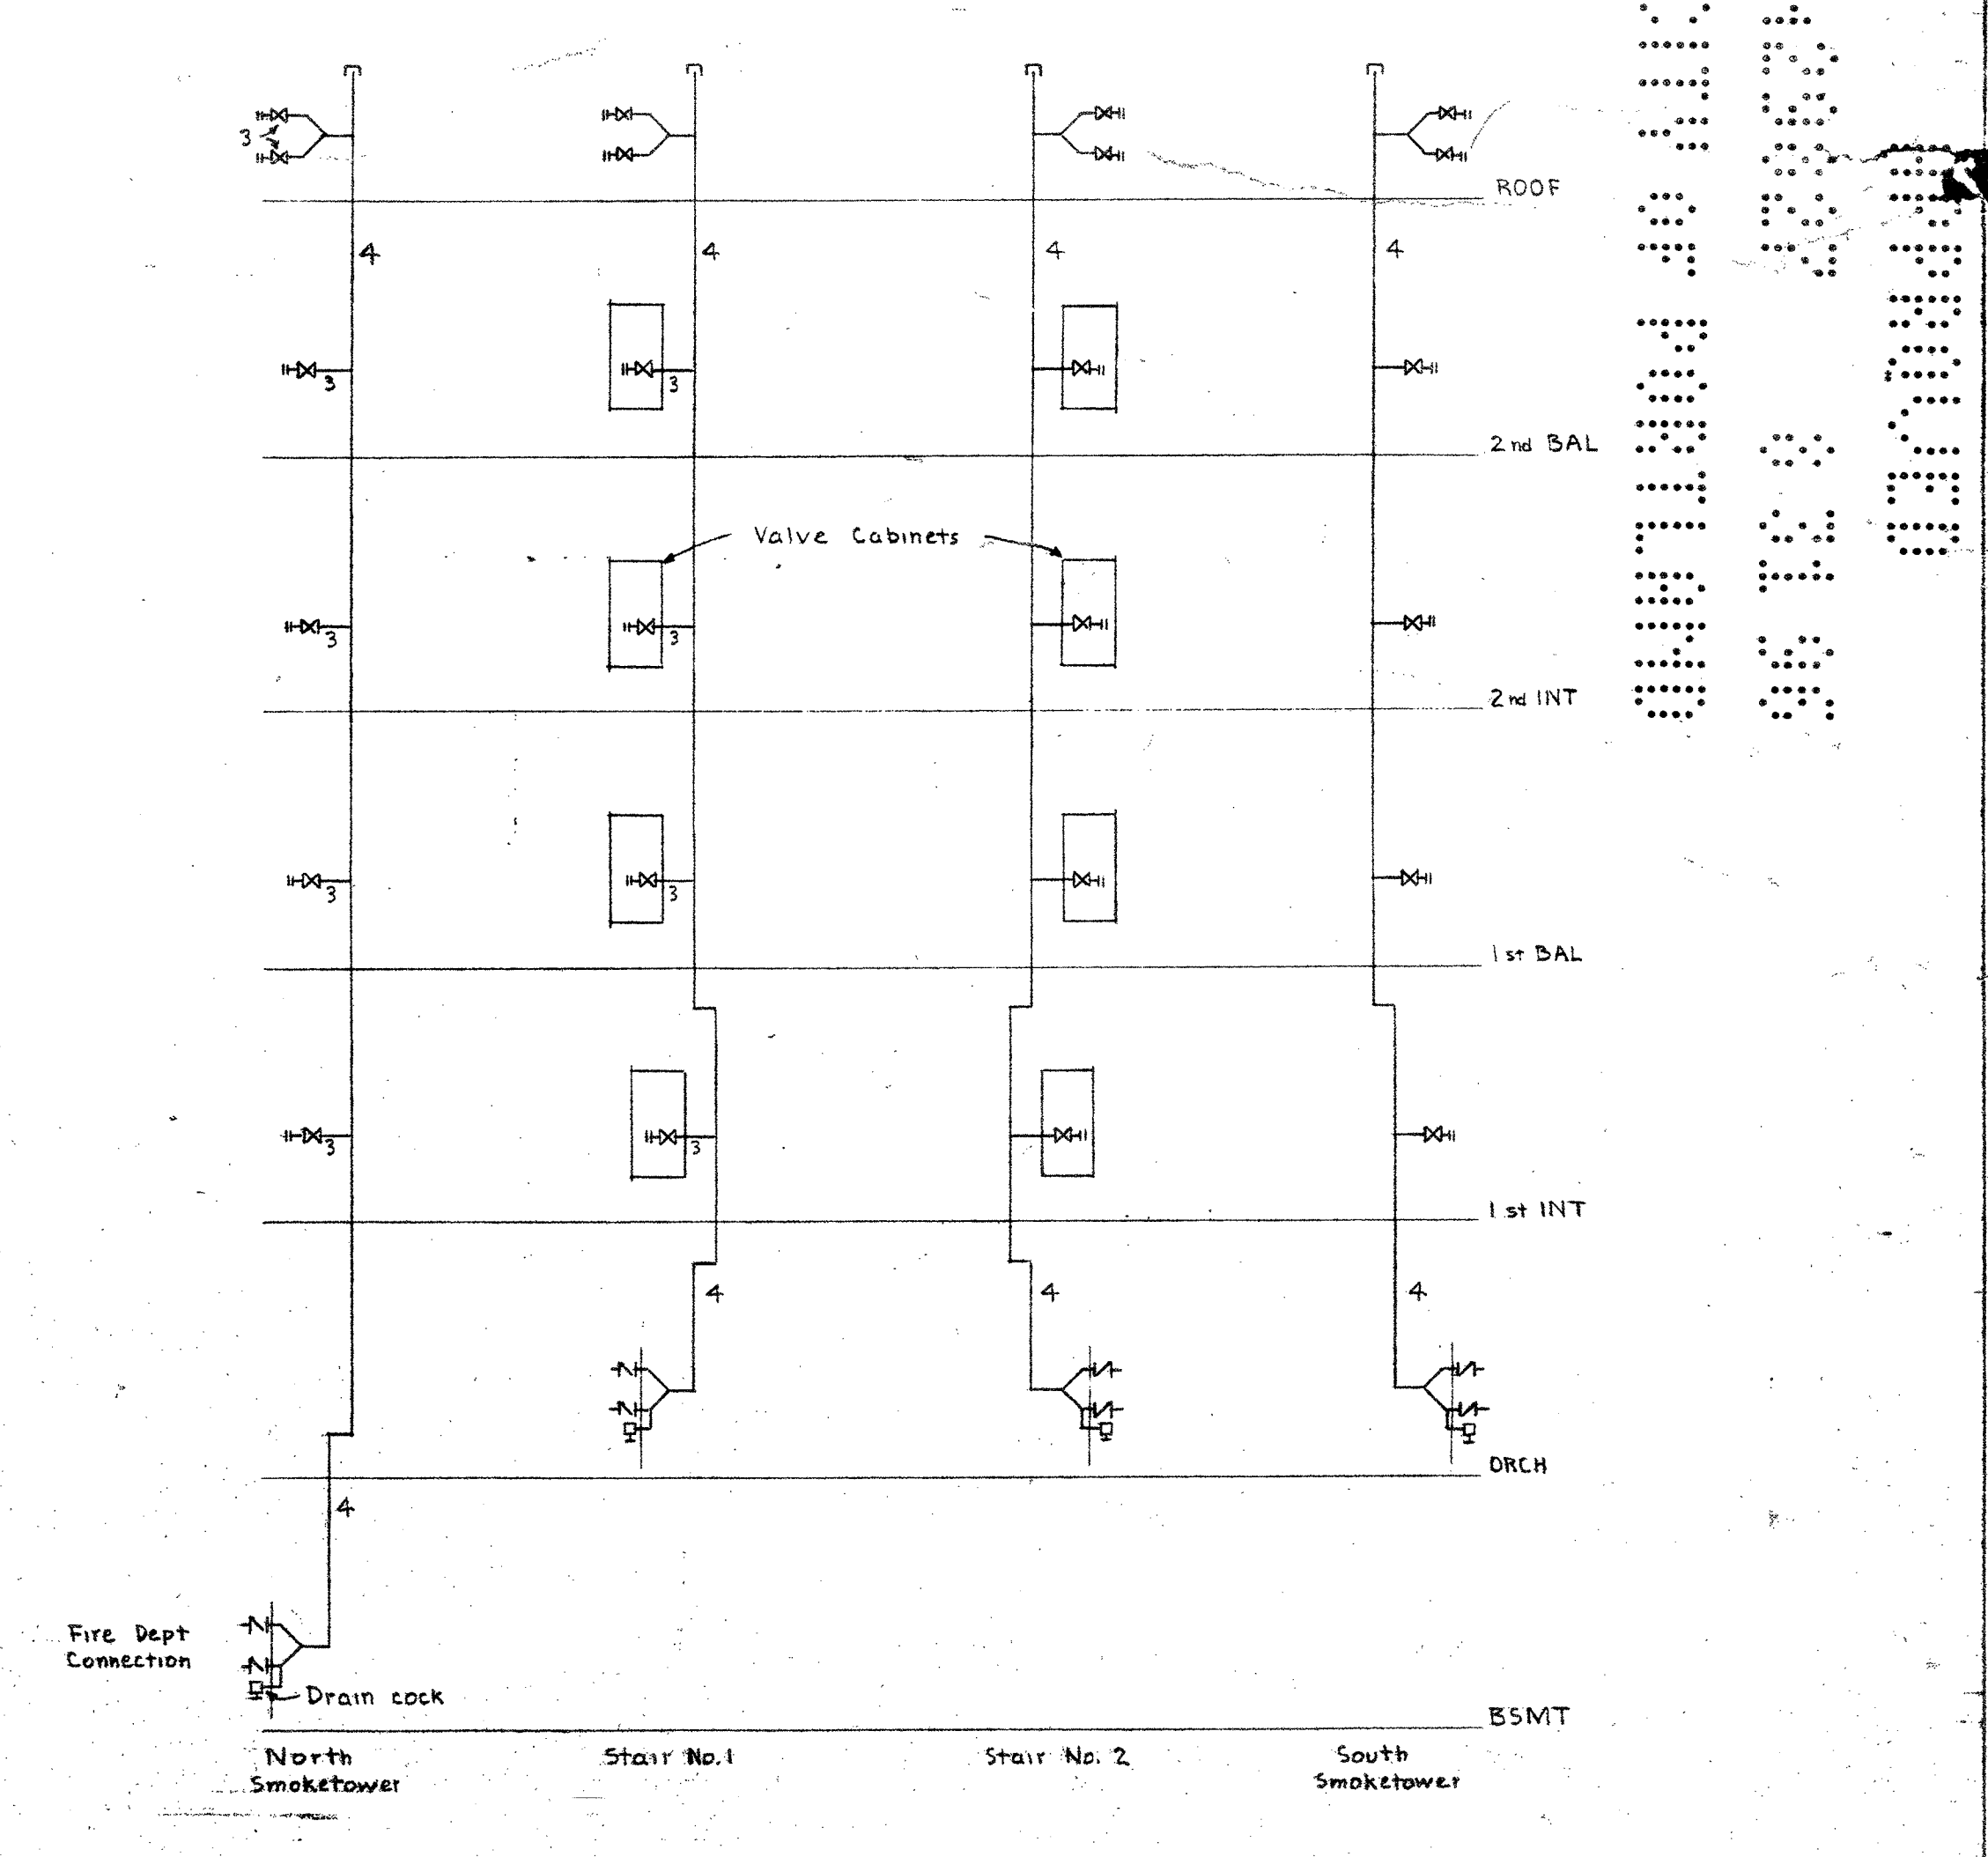

DRY STANDPIPE DIAGRAM  
No scale

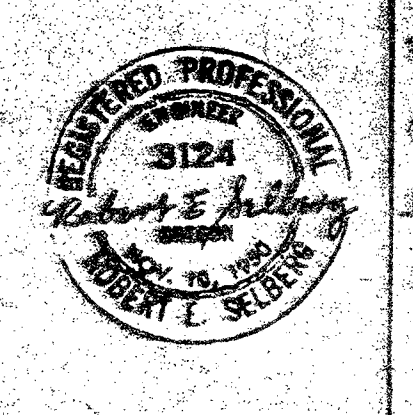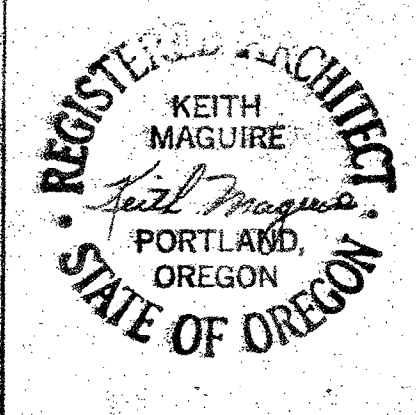

**MECHANICAL INTERMEDIATE LEVEL NO. 1 PLAN AND DETAILS**


**REBUILDING OF PORTLAND CIVIC AUDITORIUM**  
3 W. THIRD AVENUE & CLAY STREET  
FOR CITY OF PORTLAND, OREGON

**STANTON, BOLES, MAGUIRE & CHURCH ARCHITECTS**  
208 S. W. STARK ST., PORTLAND 4, OREGON  
COMM. NO. 6323  
DATE: MAY 24 1966


**M-5**

**1 MARCUS PRITECA** ARCHITECT  
**THOMAS COMBUSTANT** INSURANCE CONSULTANT  
**PAUL VENEKJAN & ASSOCIATES** ACUSTICAL CONSULTANTS  
**COOPER & ROSE & ASSOCIATES** STRUCTURAL ENGINEERS  
**J. DONALD REDDEN & ASSOCIATES** MECHANICAL ENGINEERS  
**GRANT KELLEY & ASSOCIATES** ELECTRICAL ENGINEERS  
**LILA COLWELL A.I.D.** INTERIOR CONSULTANT




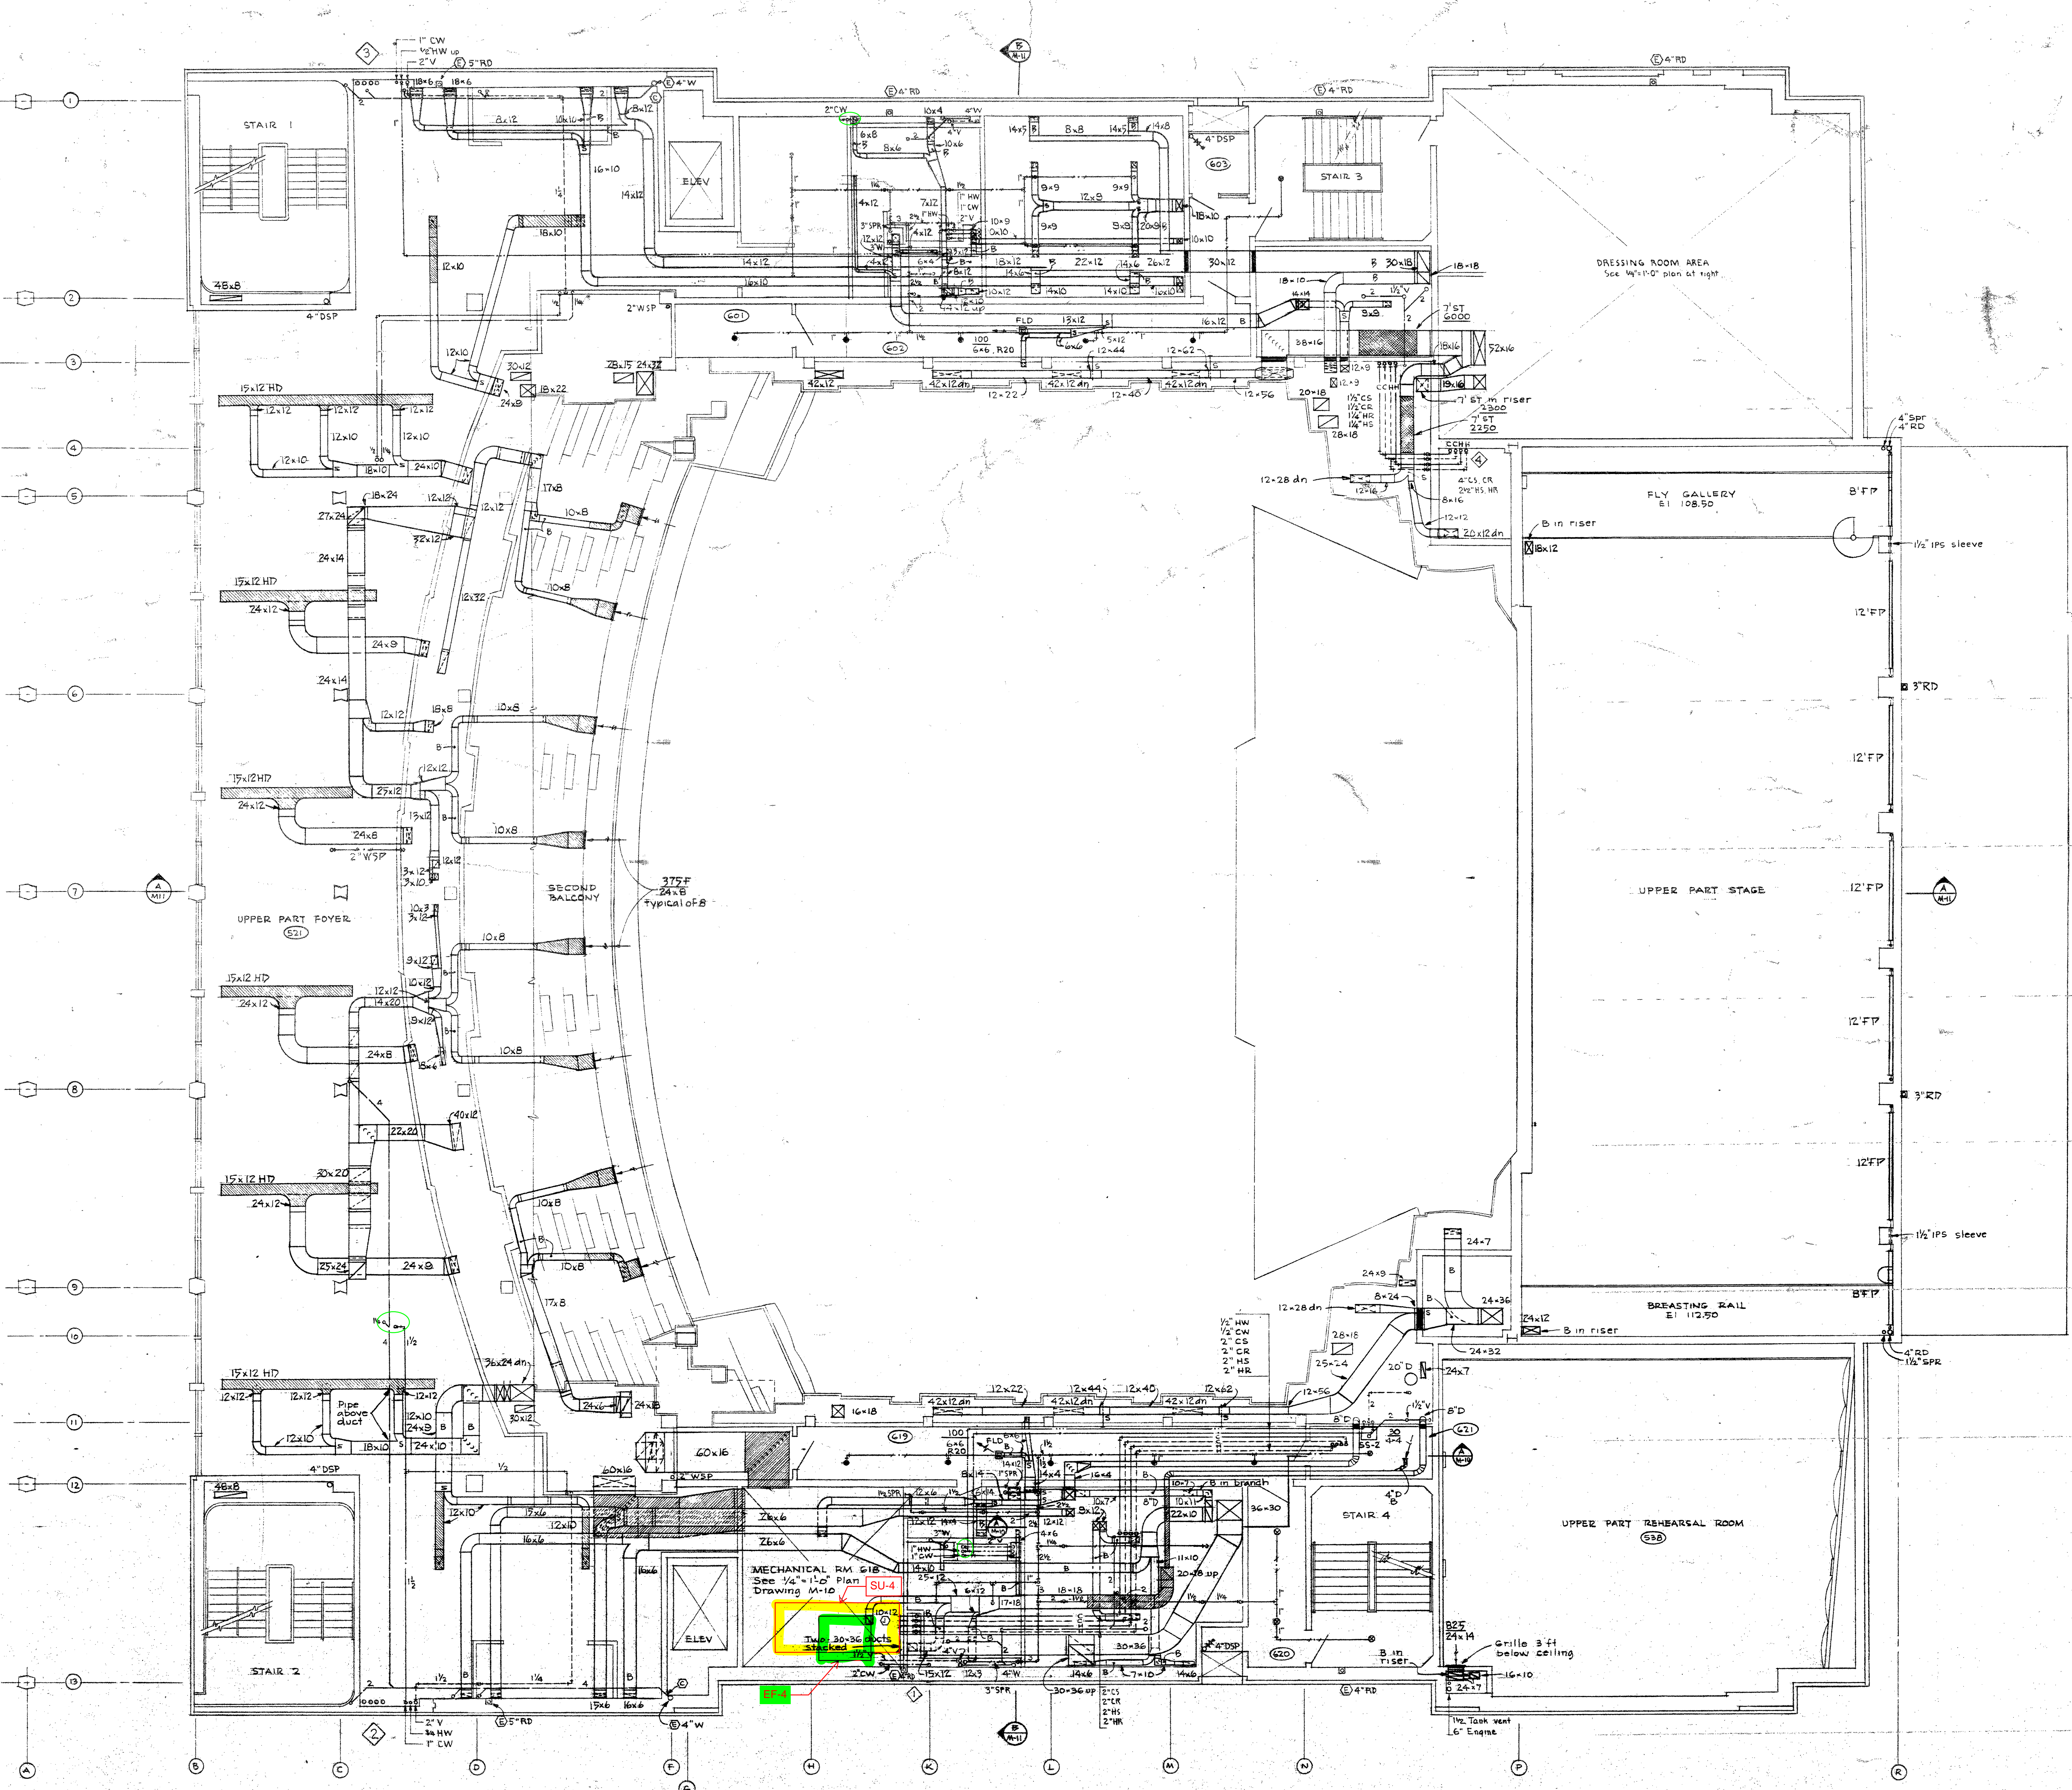


FLOOR PLAN - INTERMEDIATE LEVEL NO. 2  
 1/8" = 1'-0"

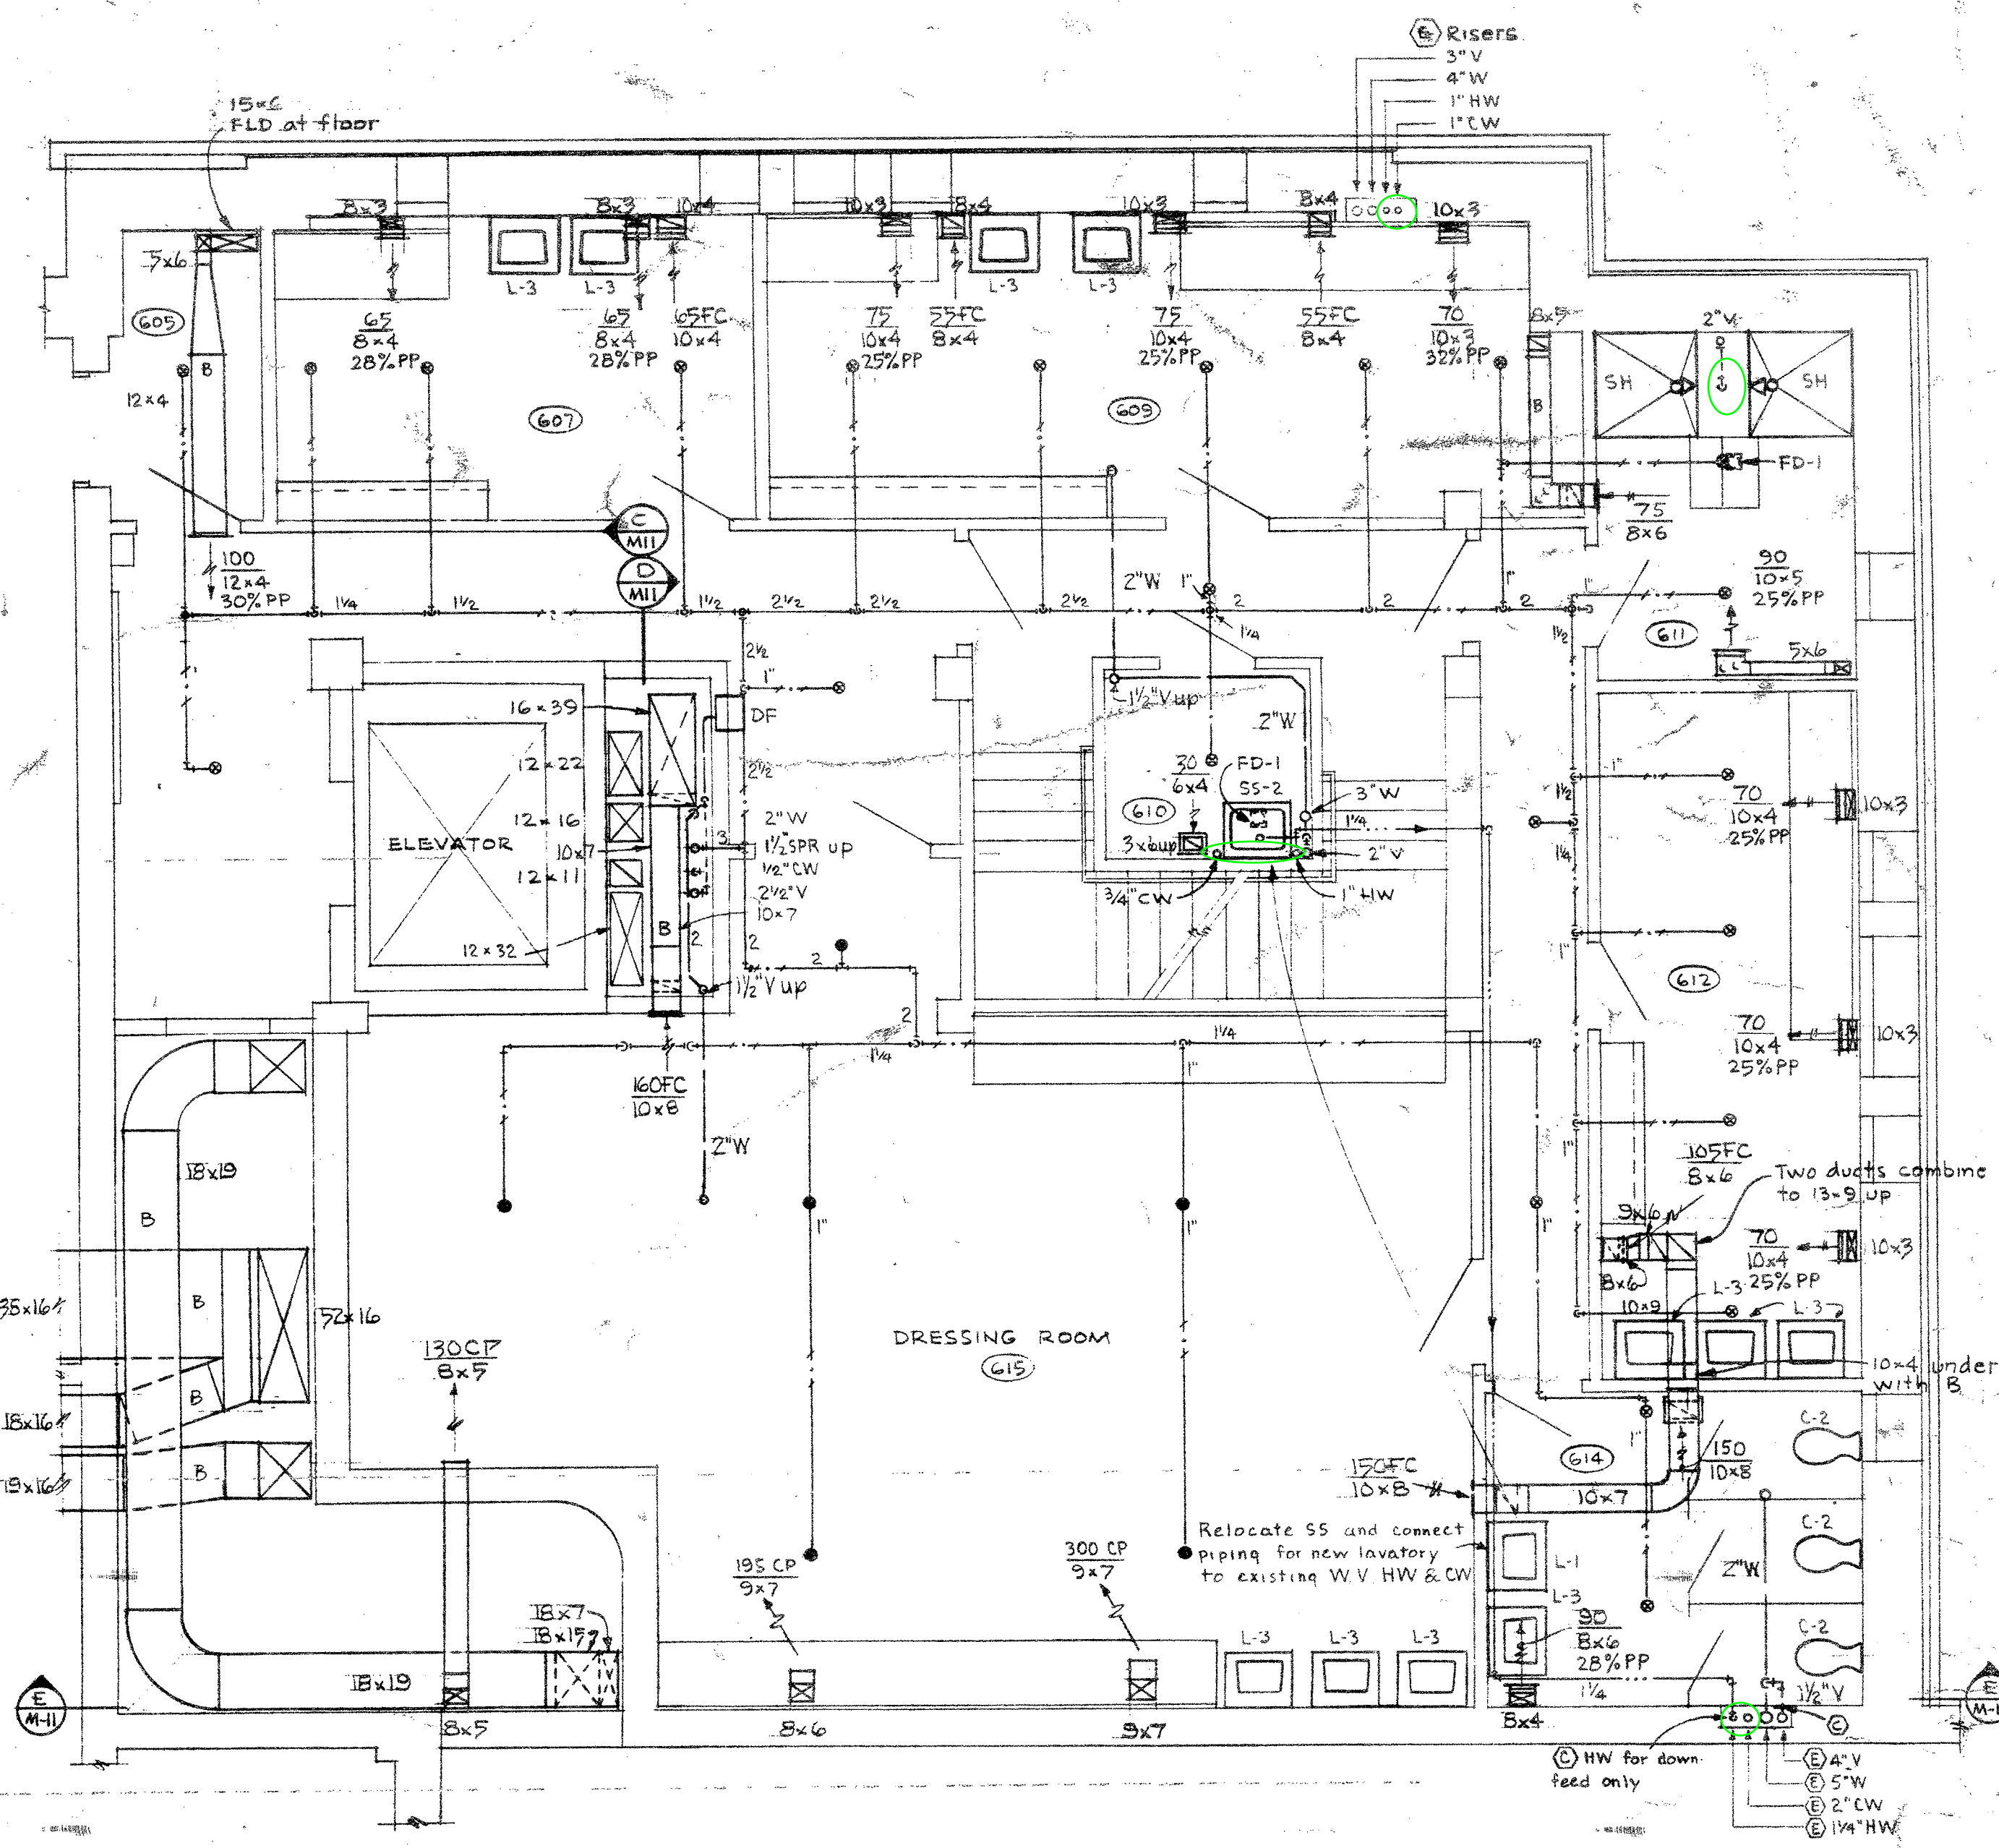

FLOOR PLAN - DRESSING ROOM AREA  
 INTERMEDIATE LEVEL NO. 2  
 1/4" = 1'-0"

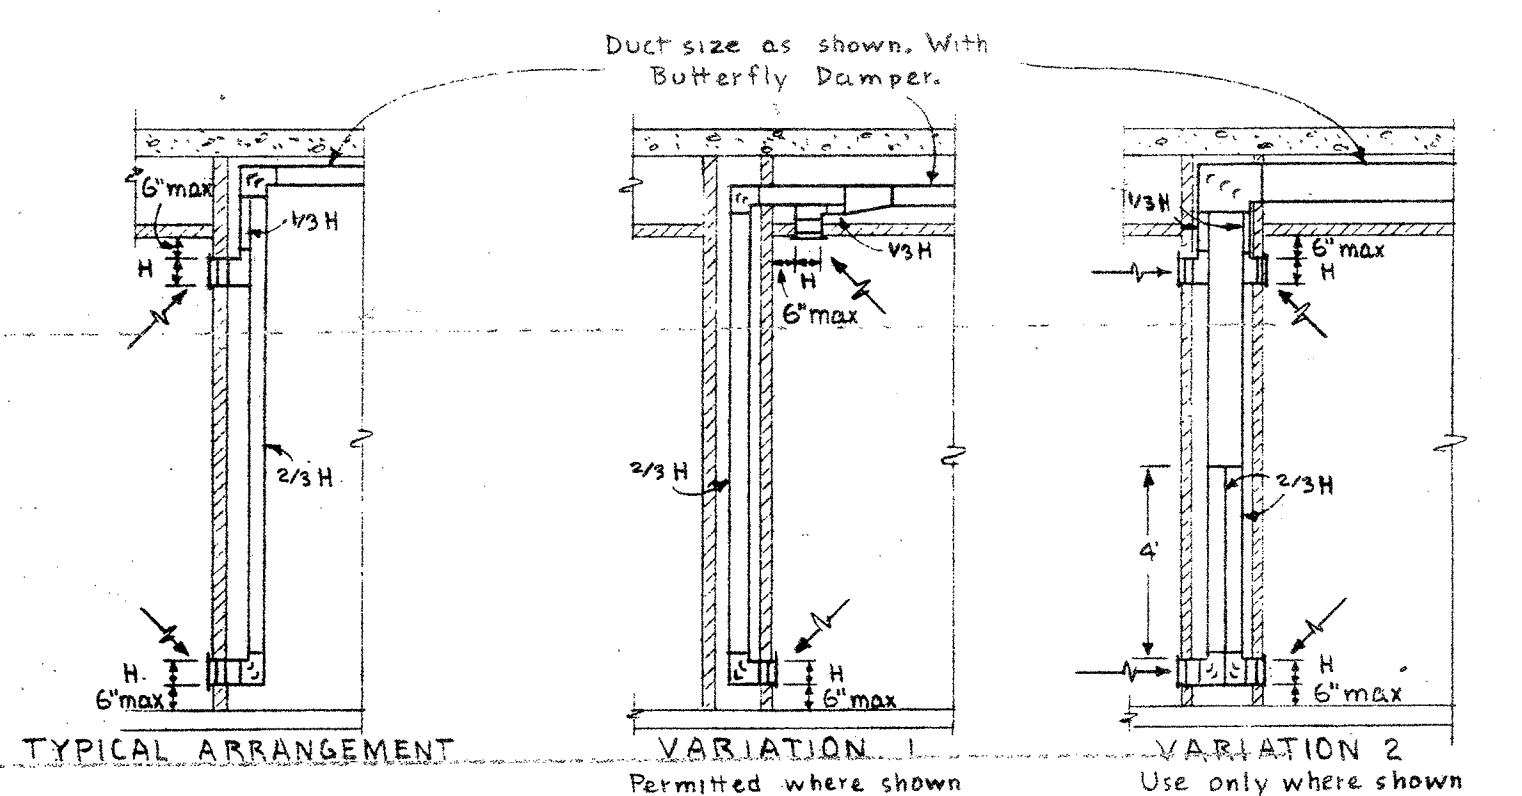

TYPICAL FC RETURN GRILLE DETAILS  
 No scale  
 Note: All FC grilles with integral key-operated backblade damper.

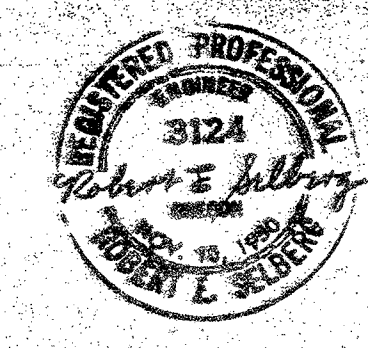

**MECHANICAL INTERMEDIATE LEVEL NO. 2 PLAN AND DETAILS**

**B. MARCUS PRITECA**  
 ARCHITECT  
 THEATER CONSULTANT

**PAUL VENEKLIEN & ASSOCIATES**  
 ACoustICAL CONSULTANTS

**COOPER & ROUSE & ASSOCIATES**  
 STRUCTURAL ENGINEERS

**J. DONALD KROEGER & ASSOCIATES**  
 MECHANICAL ENGINEERS

**GRANT KELLEY & ASSOCIATES**  
 ELECTRICAL ENGINEERS


**LILA COLWELL A.I.D.**  
 INTERIOR CONSULTANT

**REBUILDING OF PORTLAND CIVIC AUDITORIUM**  
 3 W. THIRD AVENUE & CLAY STREET  
 CITY OF PORTLAND, OREGON


**STANTON, BOLES, MADURE & CHURCH ARCHITECTS**  
 208 S. W. STARK ST., PORTLAND 4, OREGON  
 DRAWN BY: M-7  
 DATE: MAY 24 1966






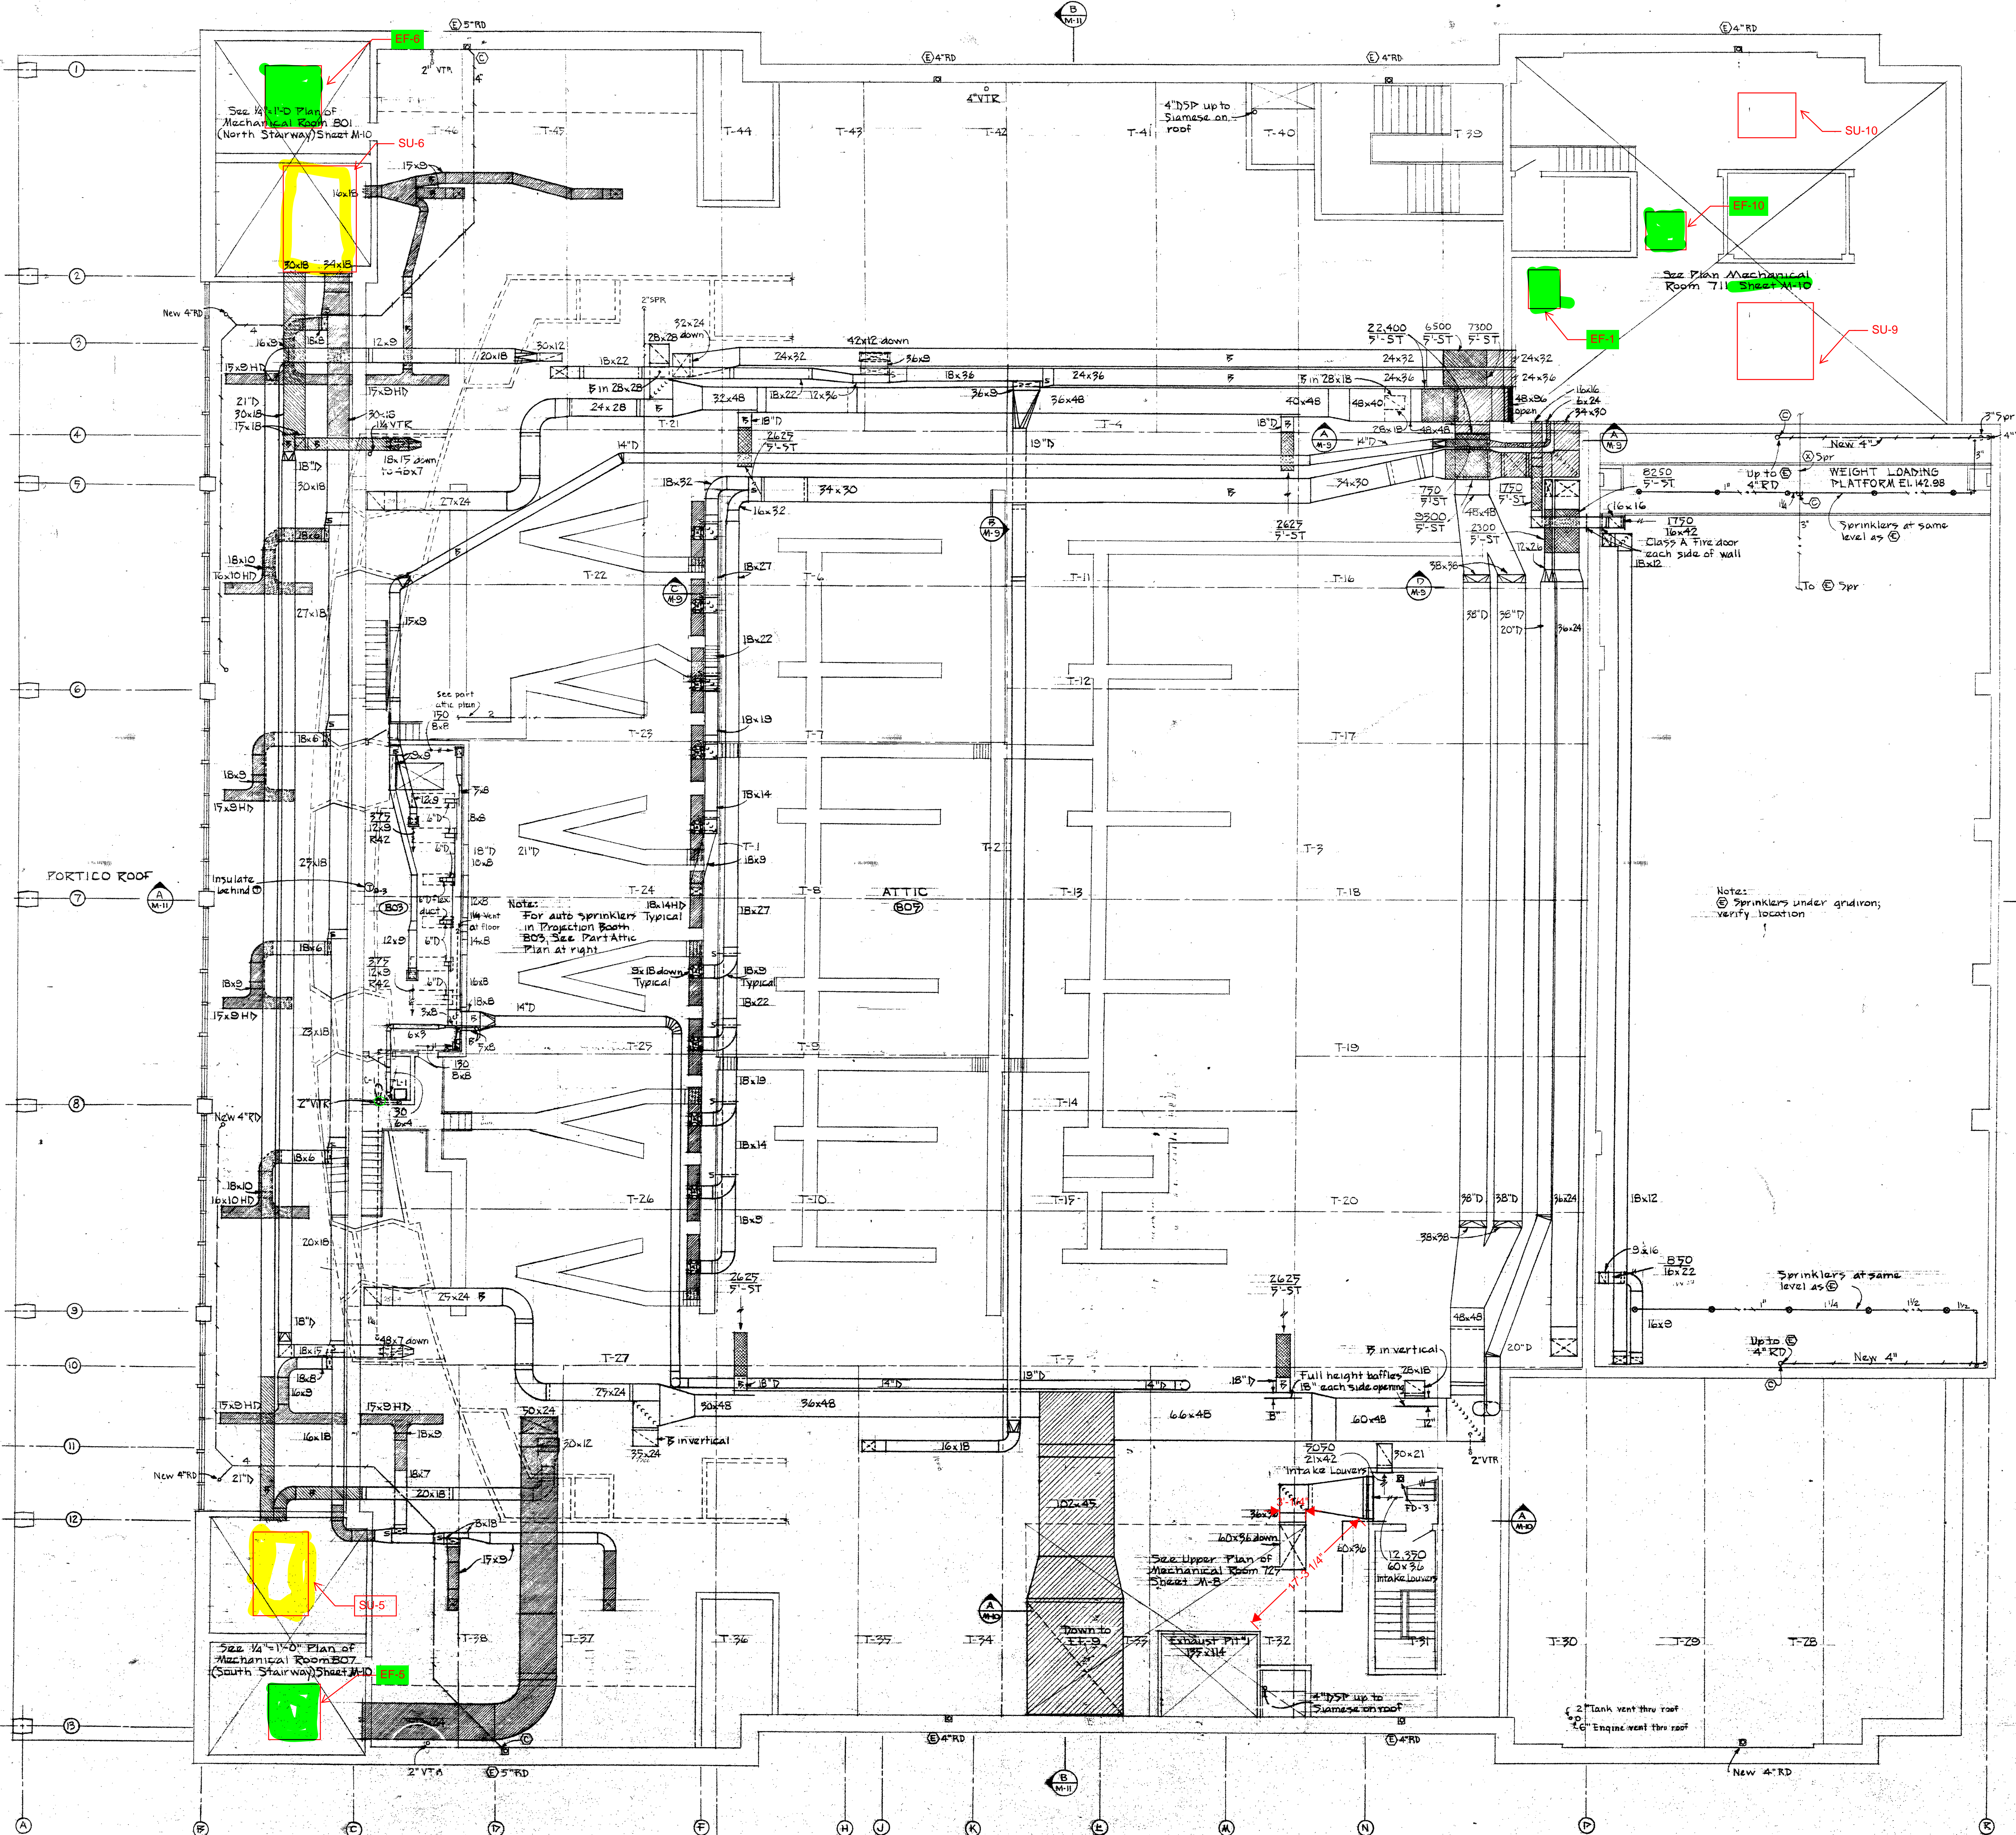


ATTIC PLAN  
1/8" = 1'-0"

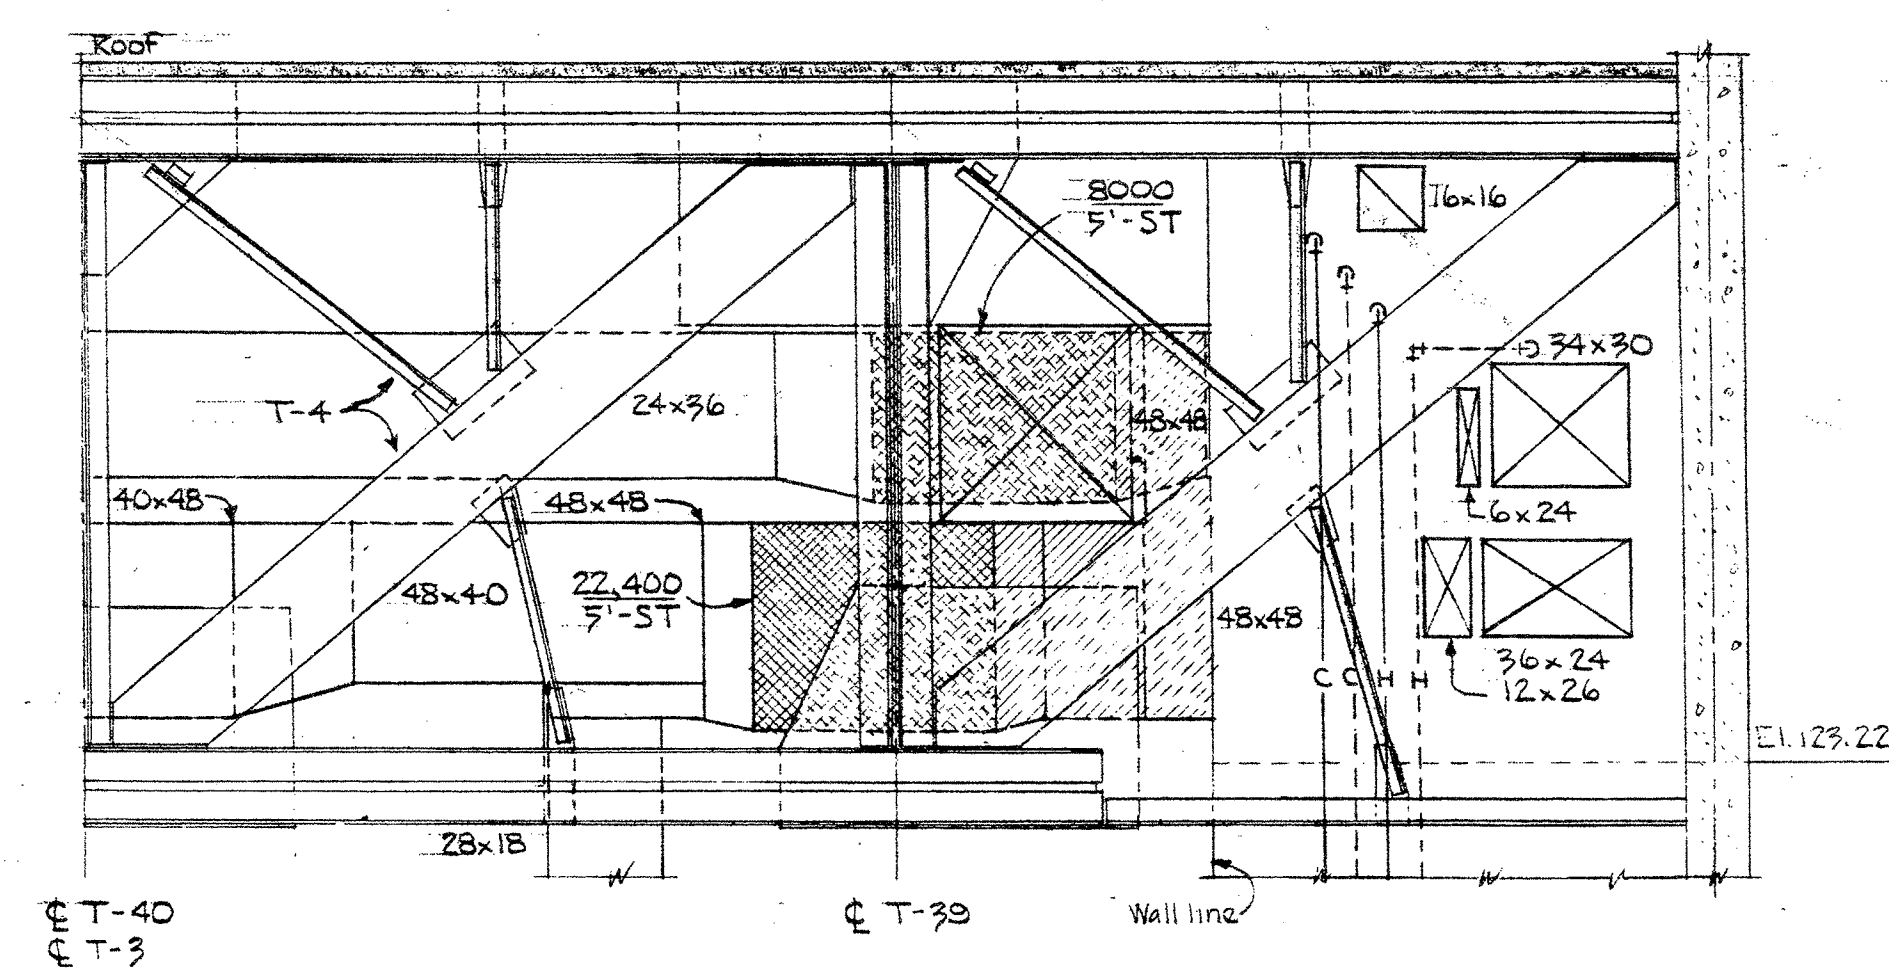


SECTION A-M-9  
1/4" = 1'-0"

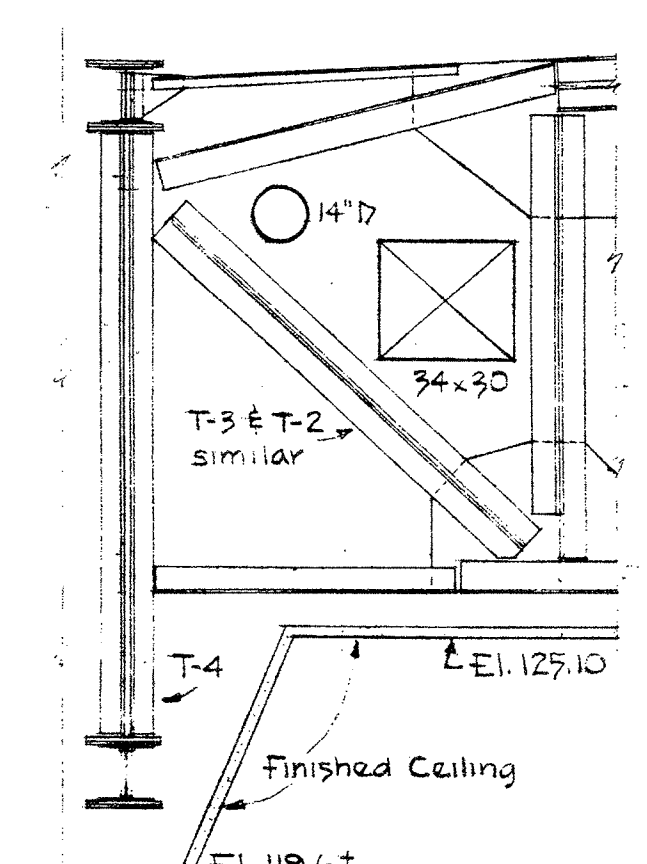


SECTION B-M-9  
1/4" = 1'-0"

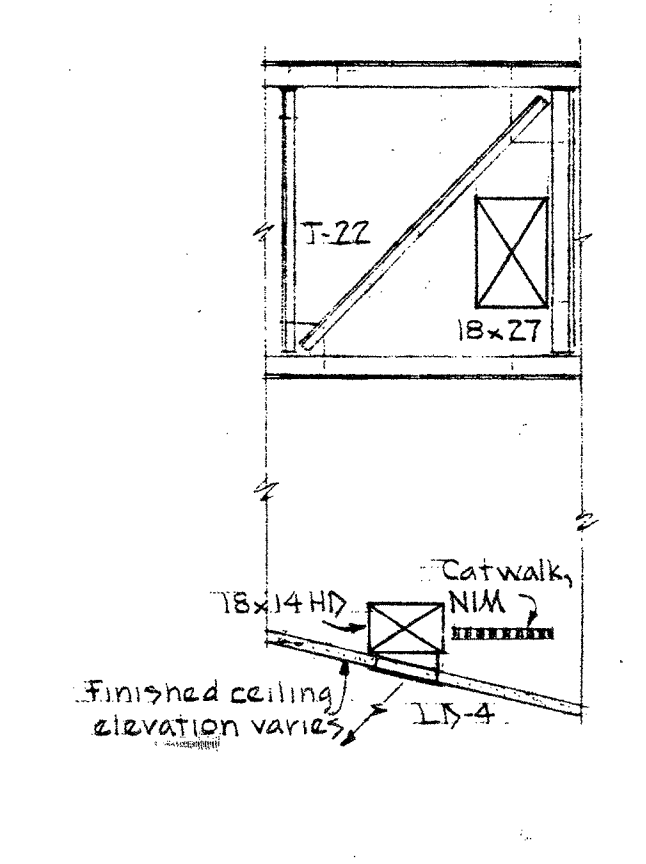


SECTION C-M-9  
1/4" = 1'-0"

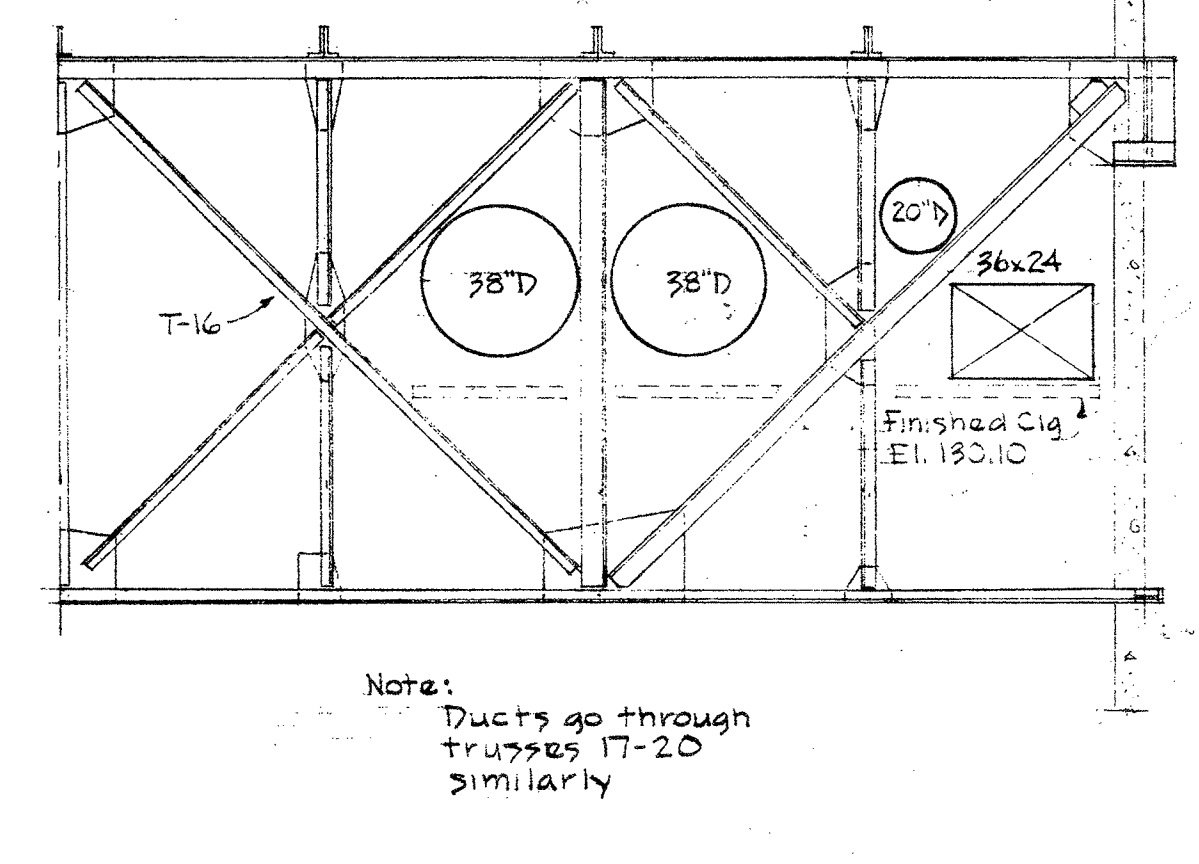


SECTION D-M-9  
1/4" = 1'-0"

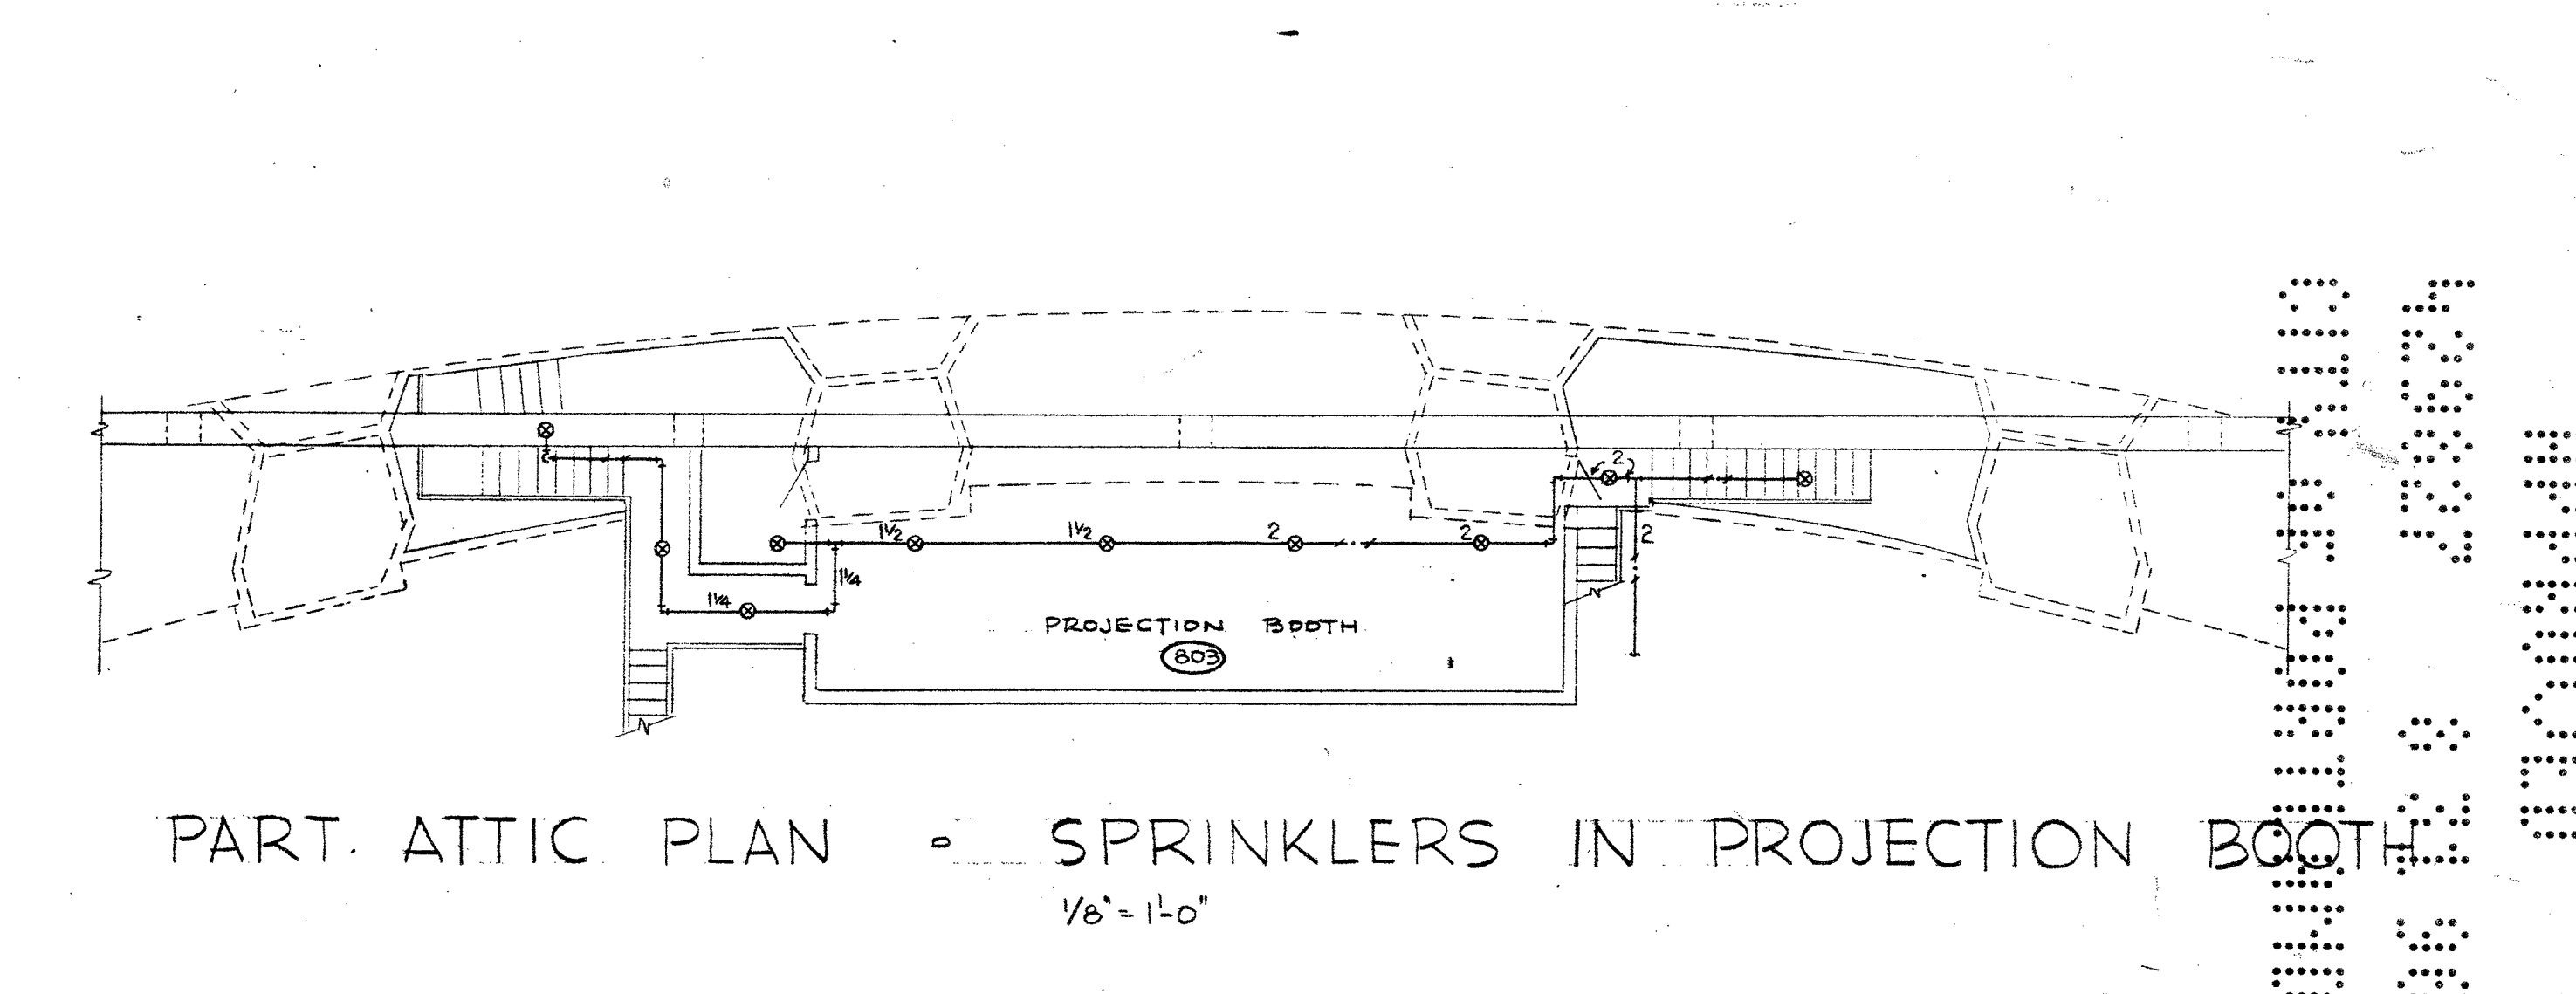


PART ATTIC PLAN - SPRINKLERS IN PROJECTION BOOTH  
1/8" = 1'-0"

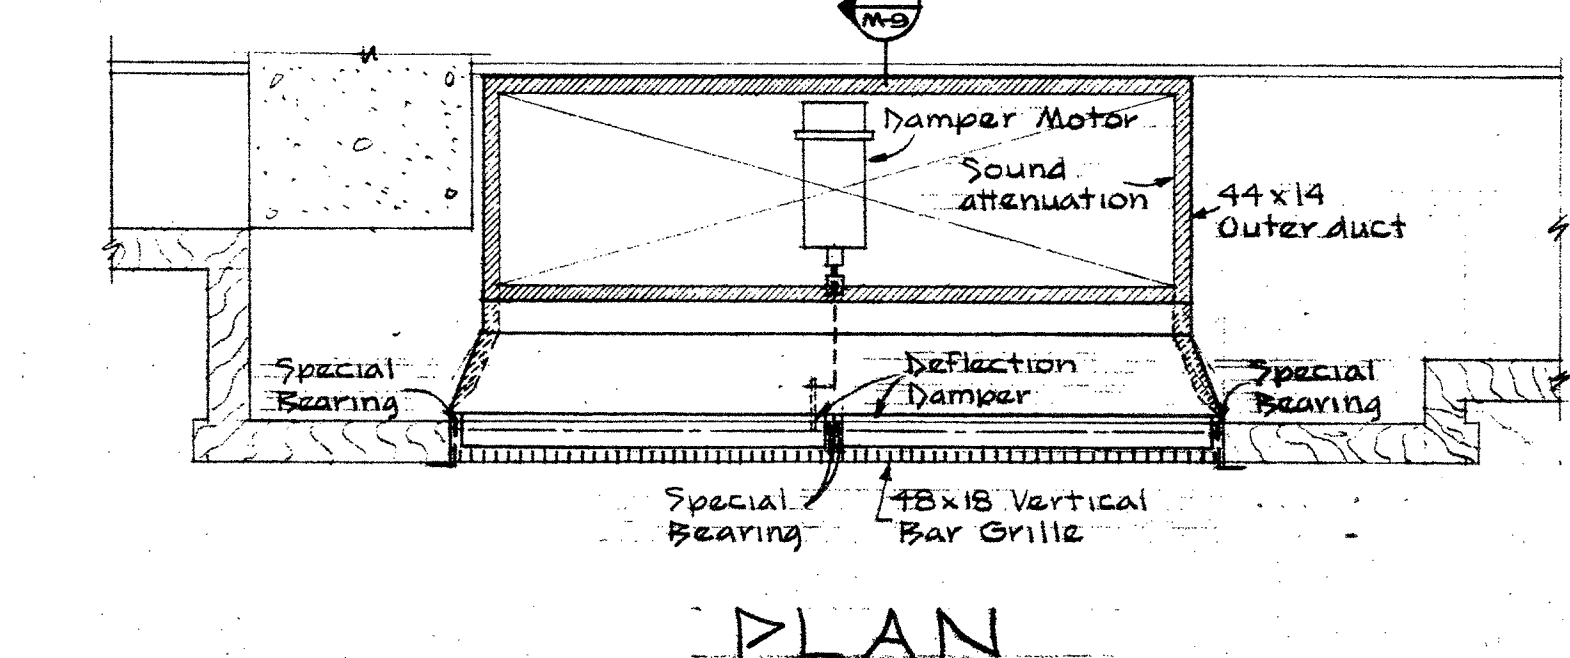

PLAN  
1" = 1'-0"

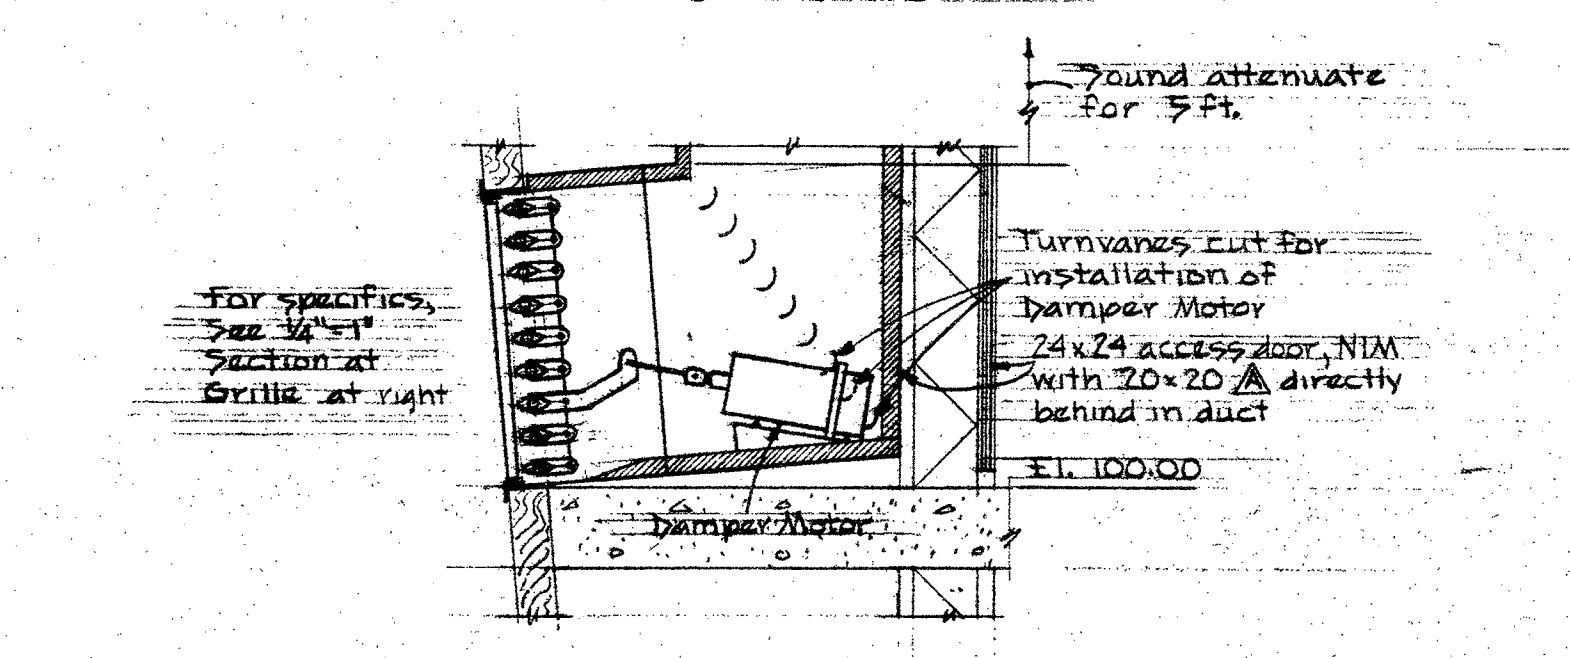

SECTION E-M-9  
1" = 1'-0"

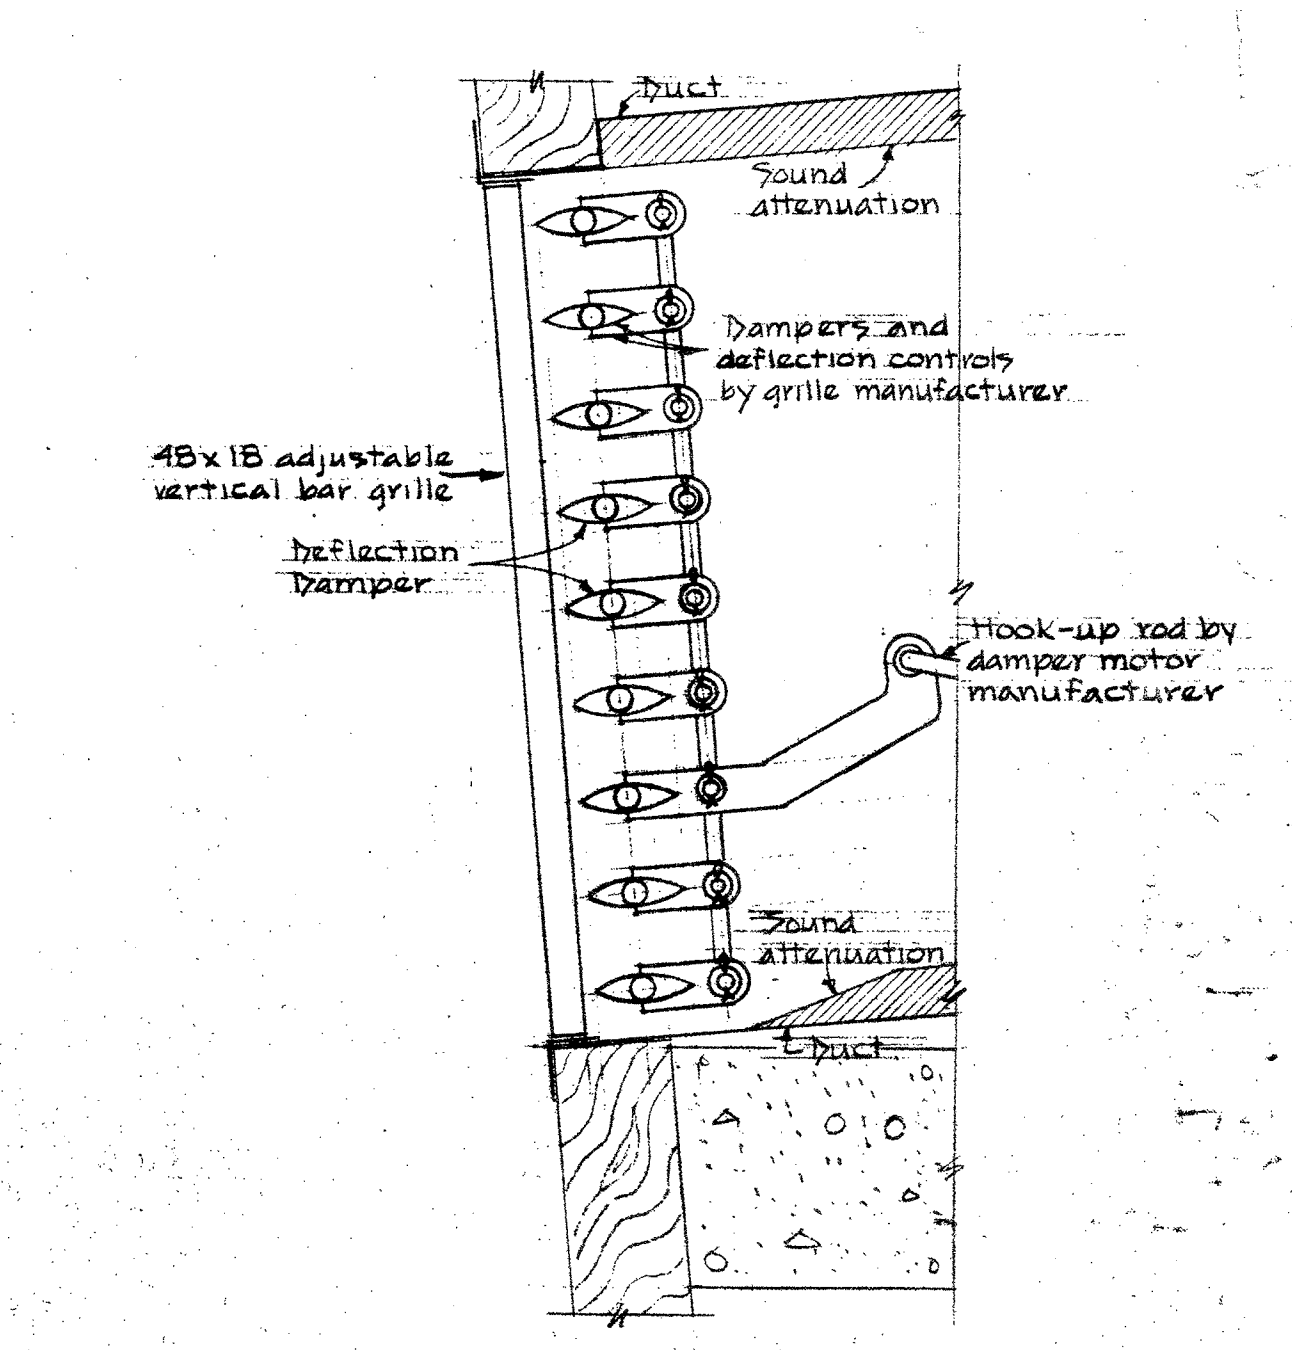

SECTION AT GRILLE  
1/4" = 1"

DETAILS OF TYPICAL HIGH SIDEWALL SUPPLY GRILLES IN AUDITORIUM WITH DD

**MECHANICAL ATTIC PLAN AND DETAILS**

**B MARCUS PRITECA**  
ARCHITECT

**REBUILDING OF PORTLAND CIVIC AUDITORIUM**  
3 W. THIRD AVENUE & CLAY STREET  
FOR  
CITY OF PORTLAND OREGON

**PAUL VENEGLASEN & ASSOCIATES**  
ACoustICAL CONSULTANTS

**COOPER & ROSE & ASSOCIATES**  
STRUCTURAL ENGINEERS

**J. DONALD KROEBER & ASSOCIATES**  
MECHANICAL ENGINEERS


**GRANT KELLEY & ASSOCIATES**  
ELECTRICAL ENGINEERS












**LILA COLWELL A.I.D.**  
INTERIOR CONSULTANT

**DRAWING M-9**

**STANTON, BOLES, MAGUIRE & CHURCH ARCHITECTS**  
208 B. W. STARK ST., PORTLAND 4, OREGON  
COMM. NO. 6323  
DATE: MAY 24 1956

DRAWN  
CHECKED

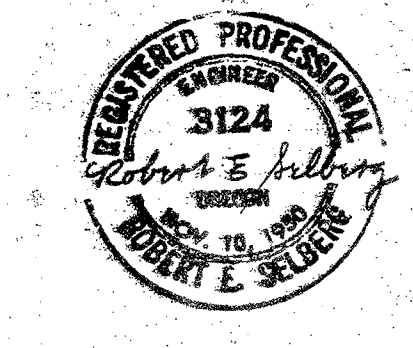

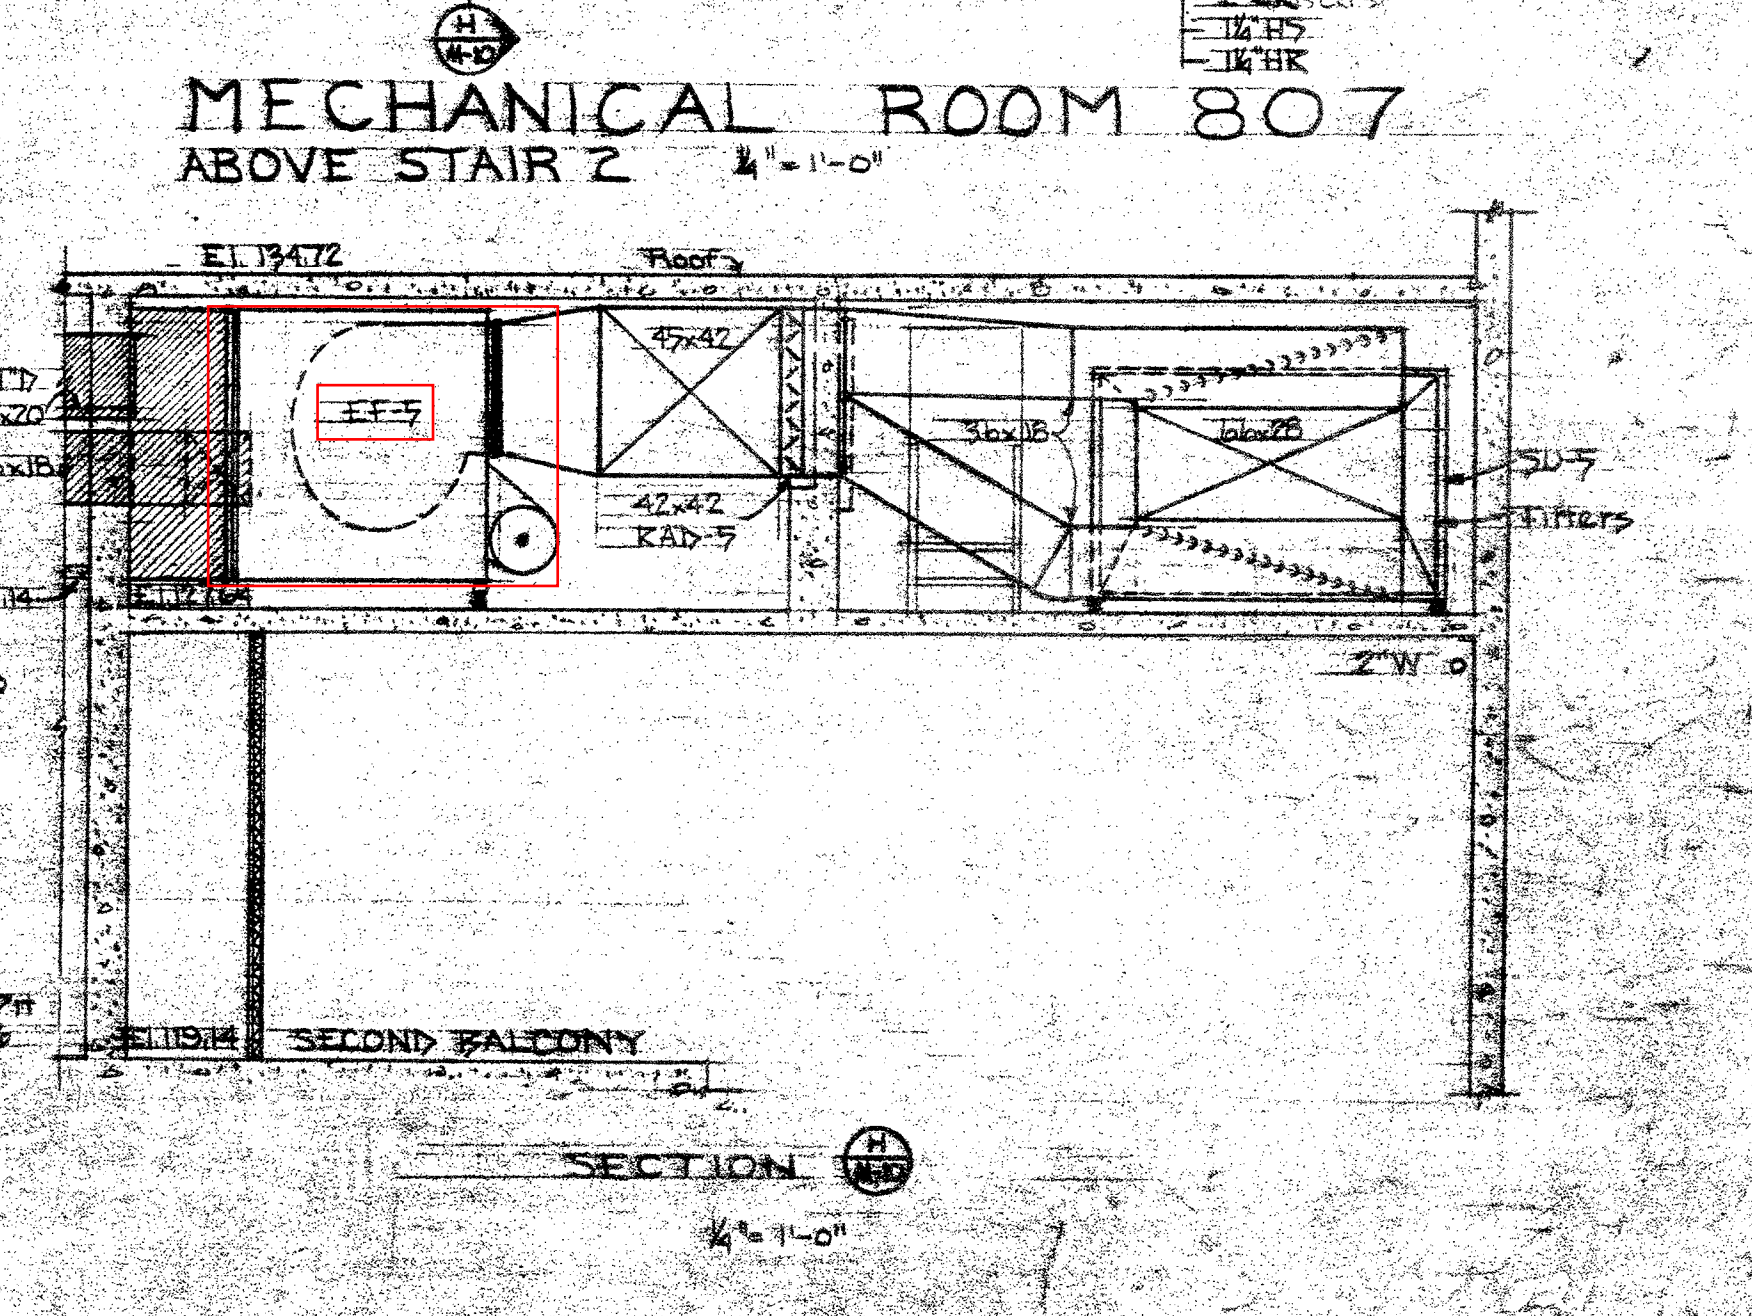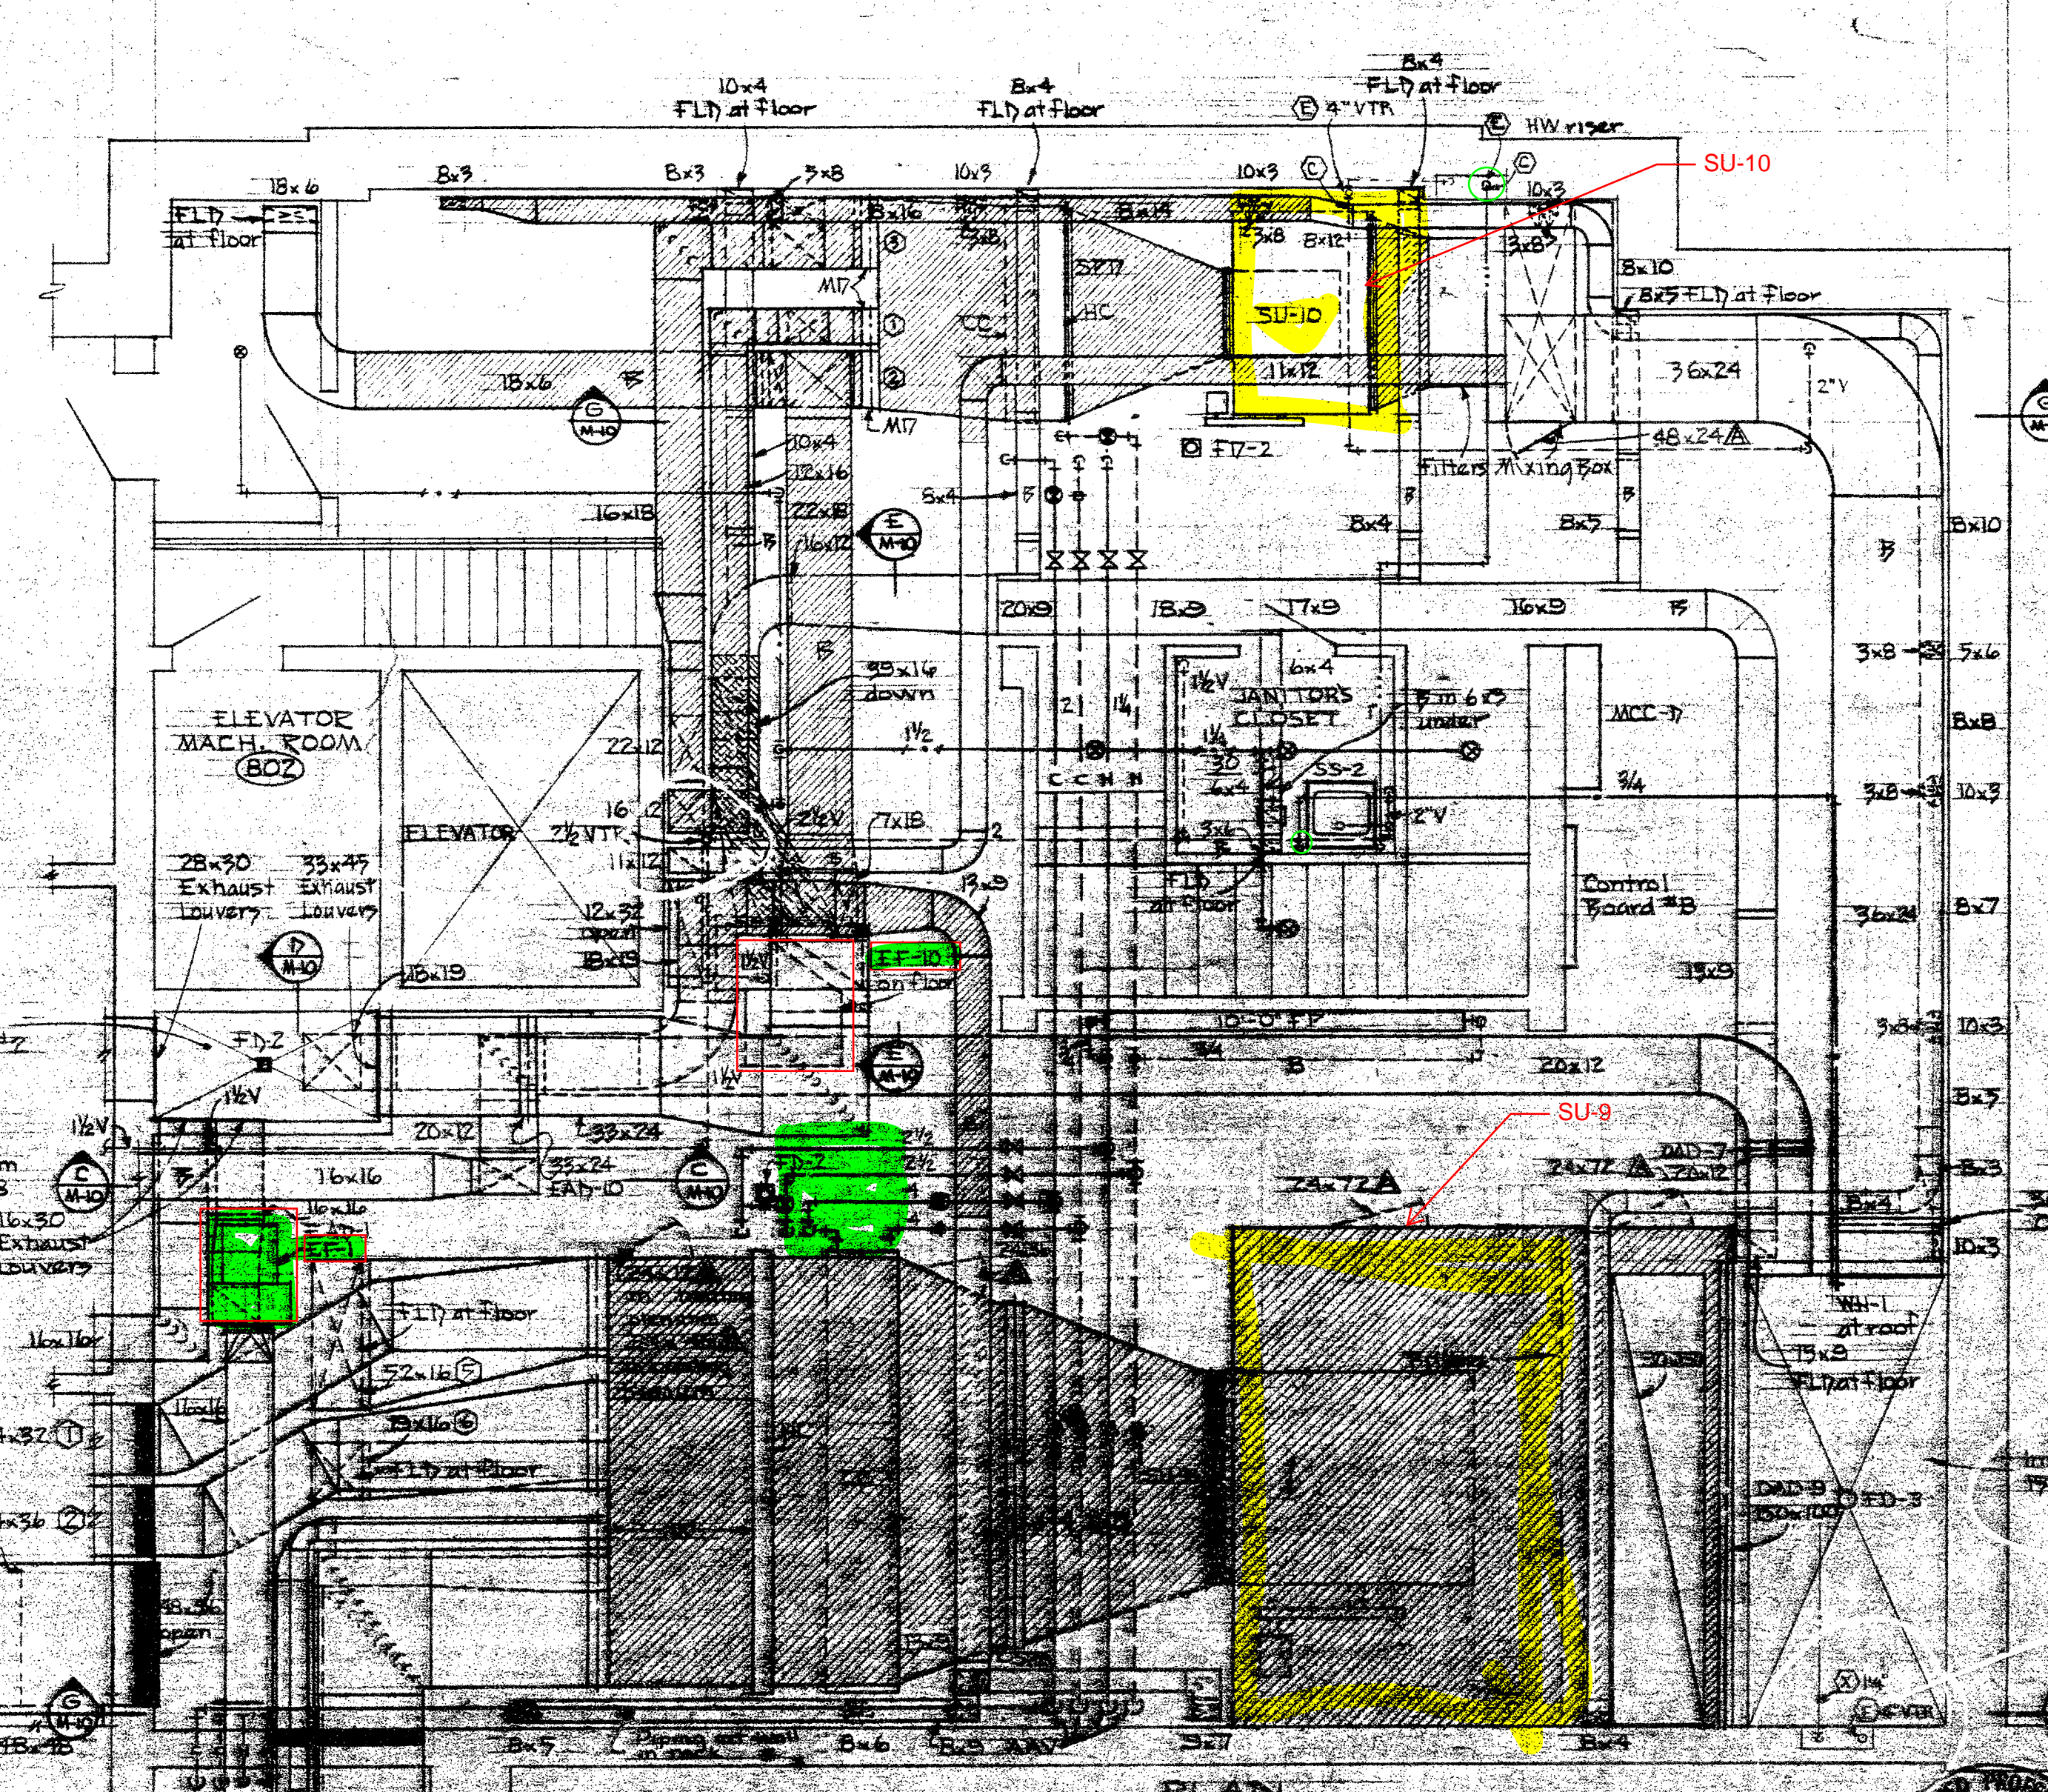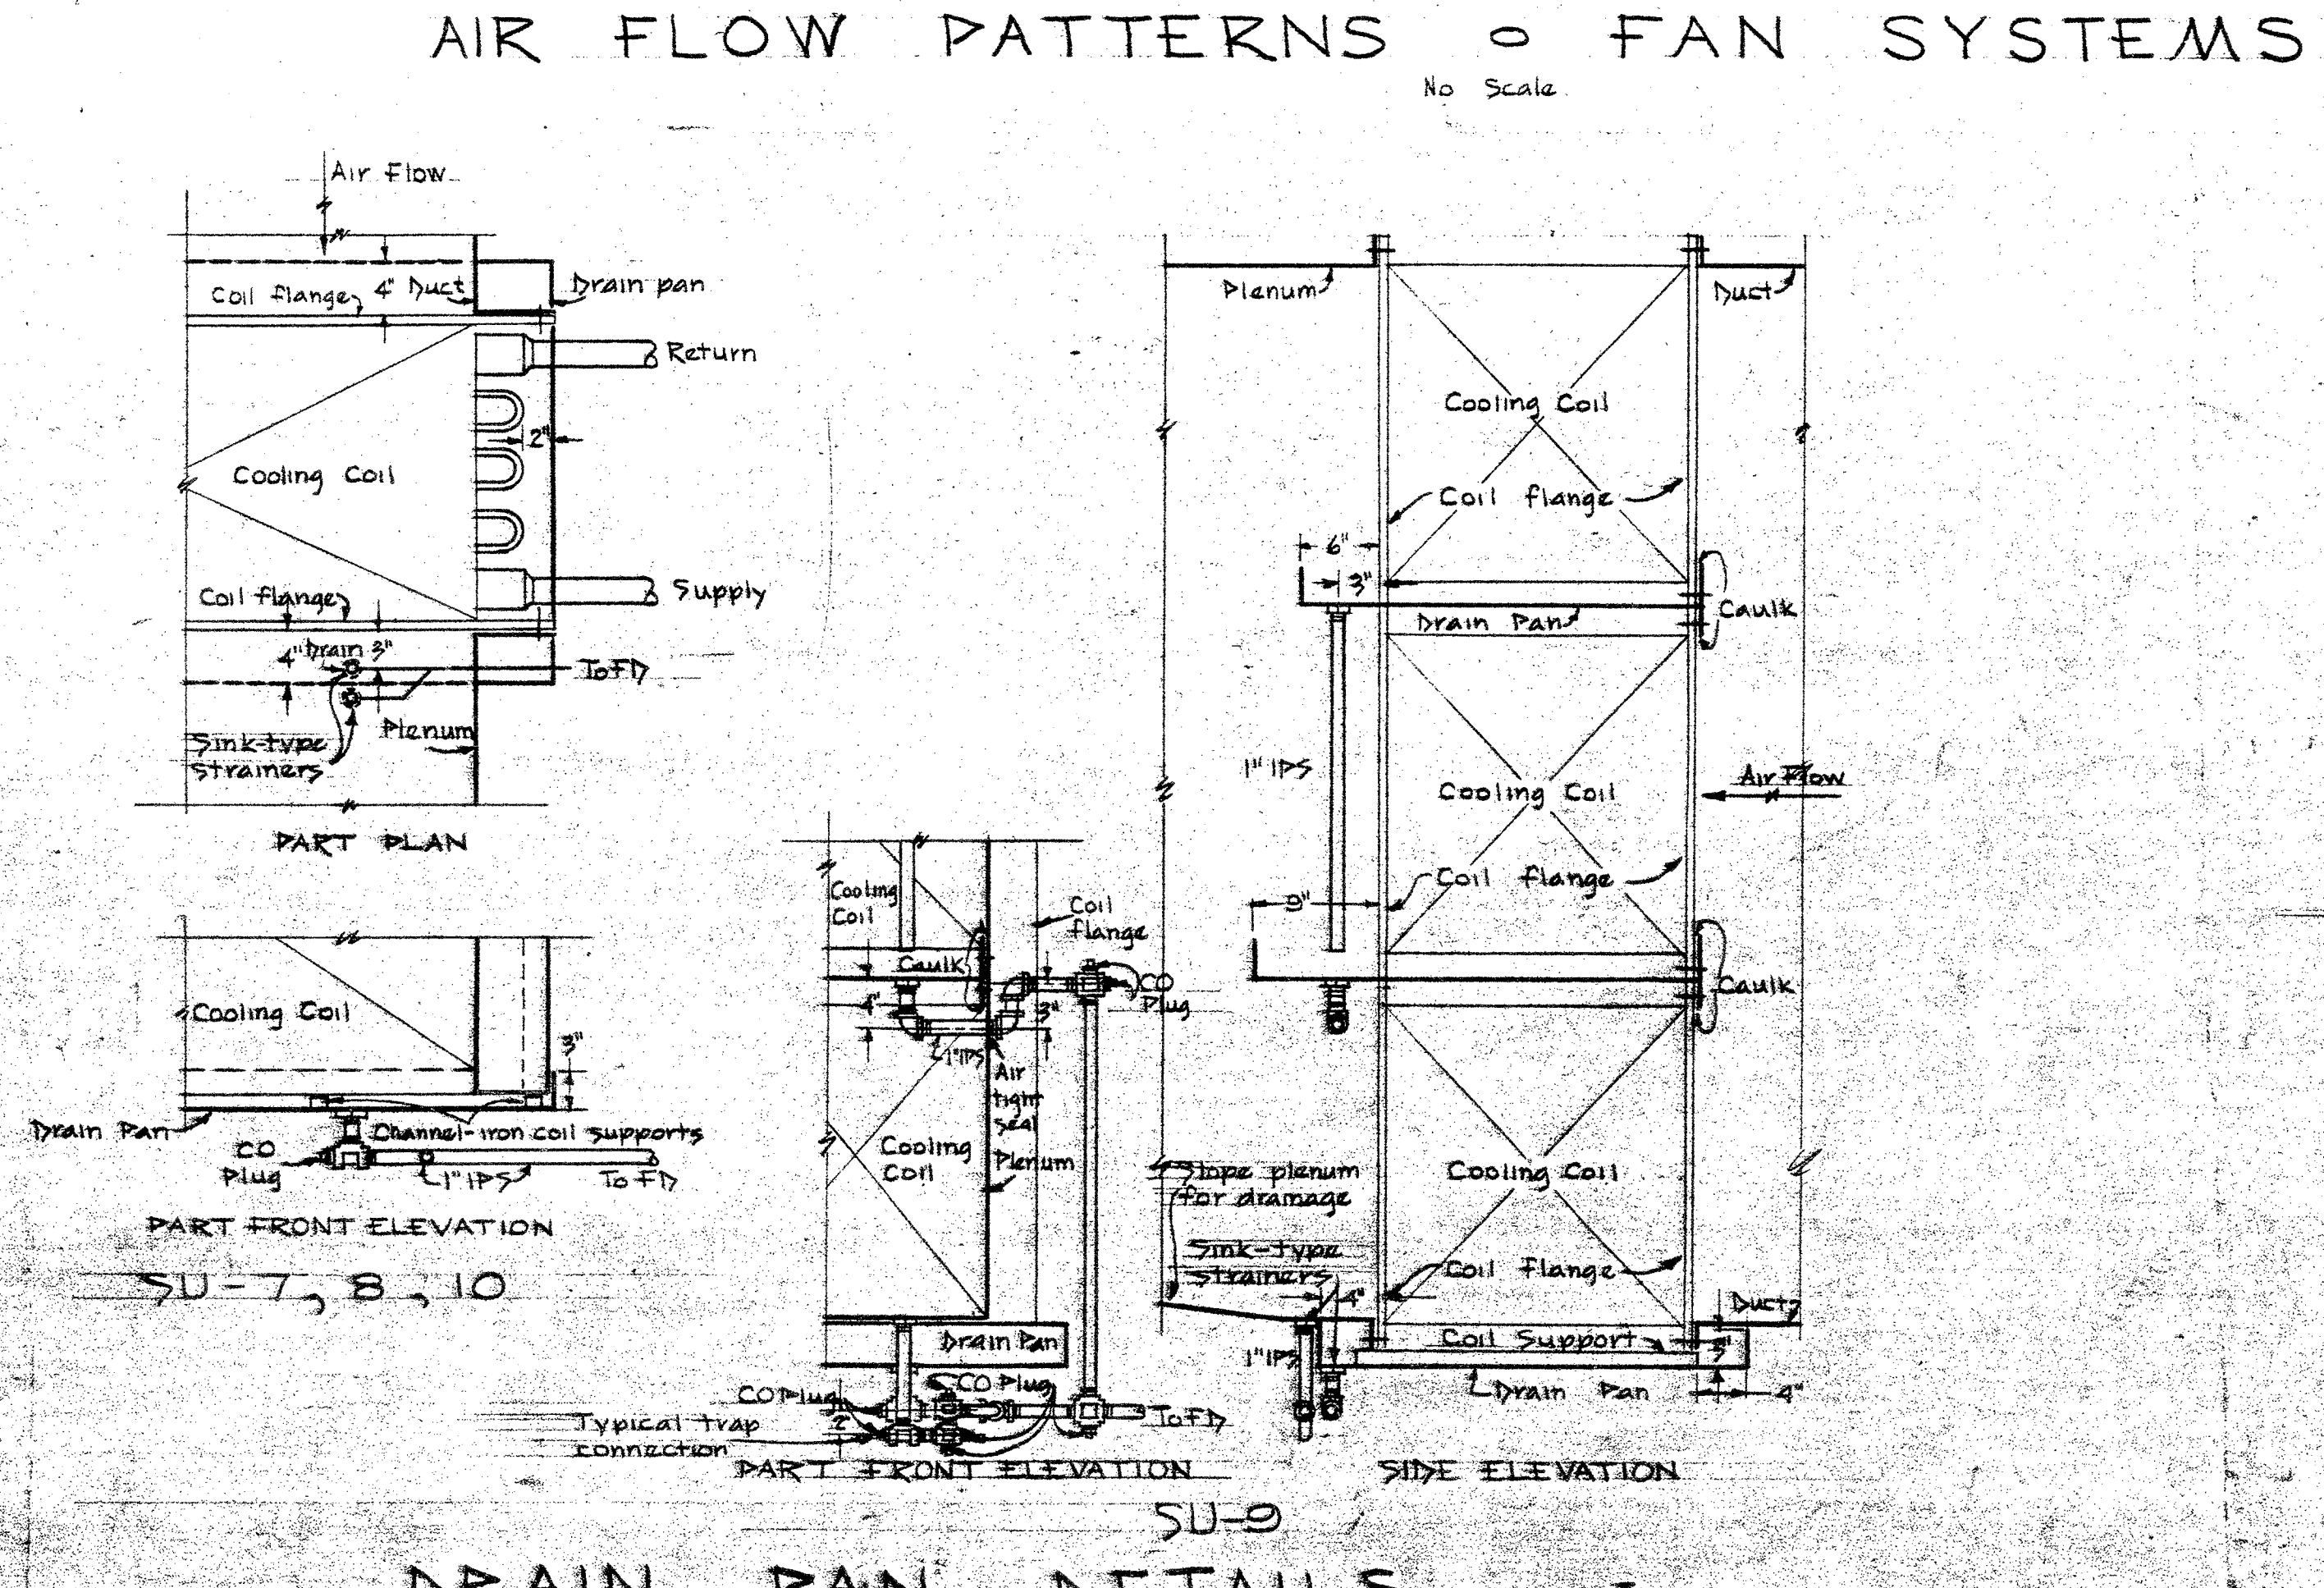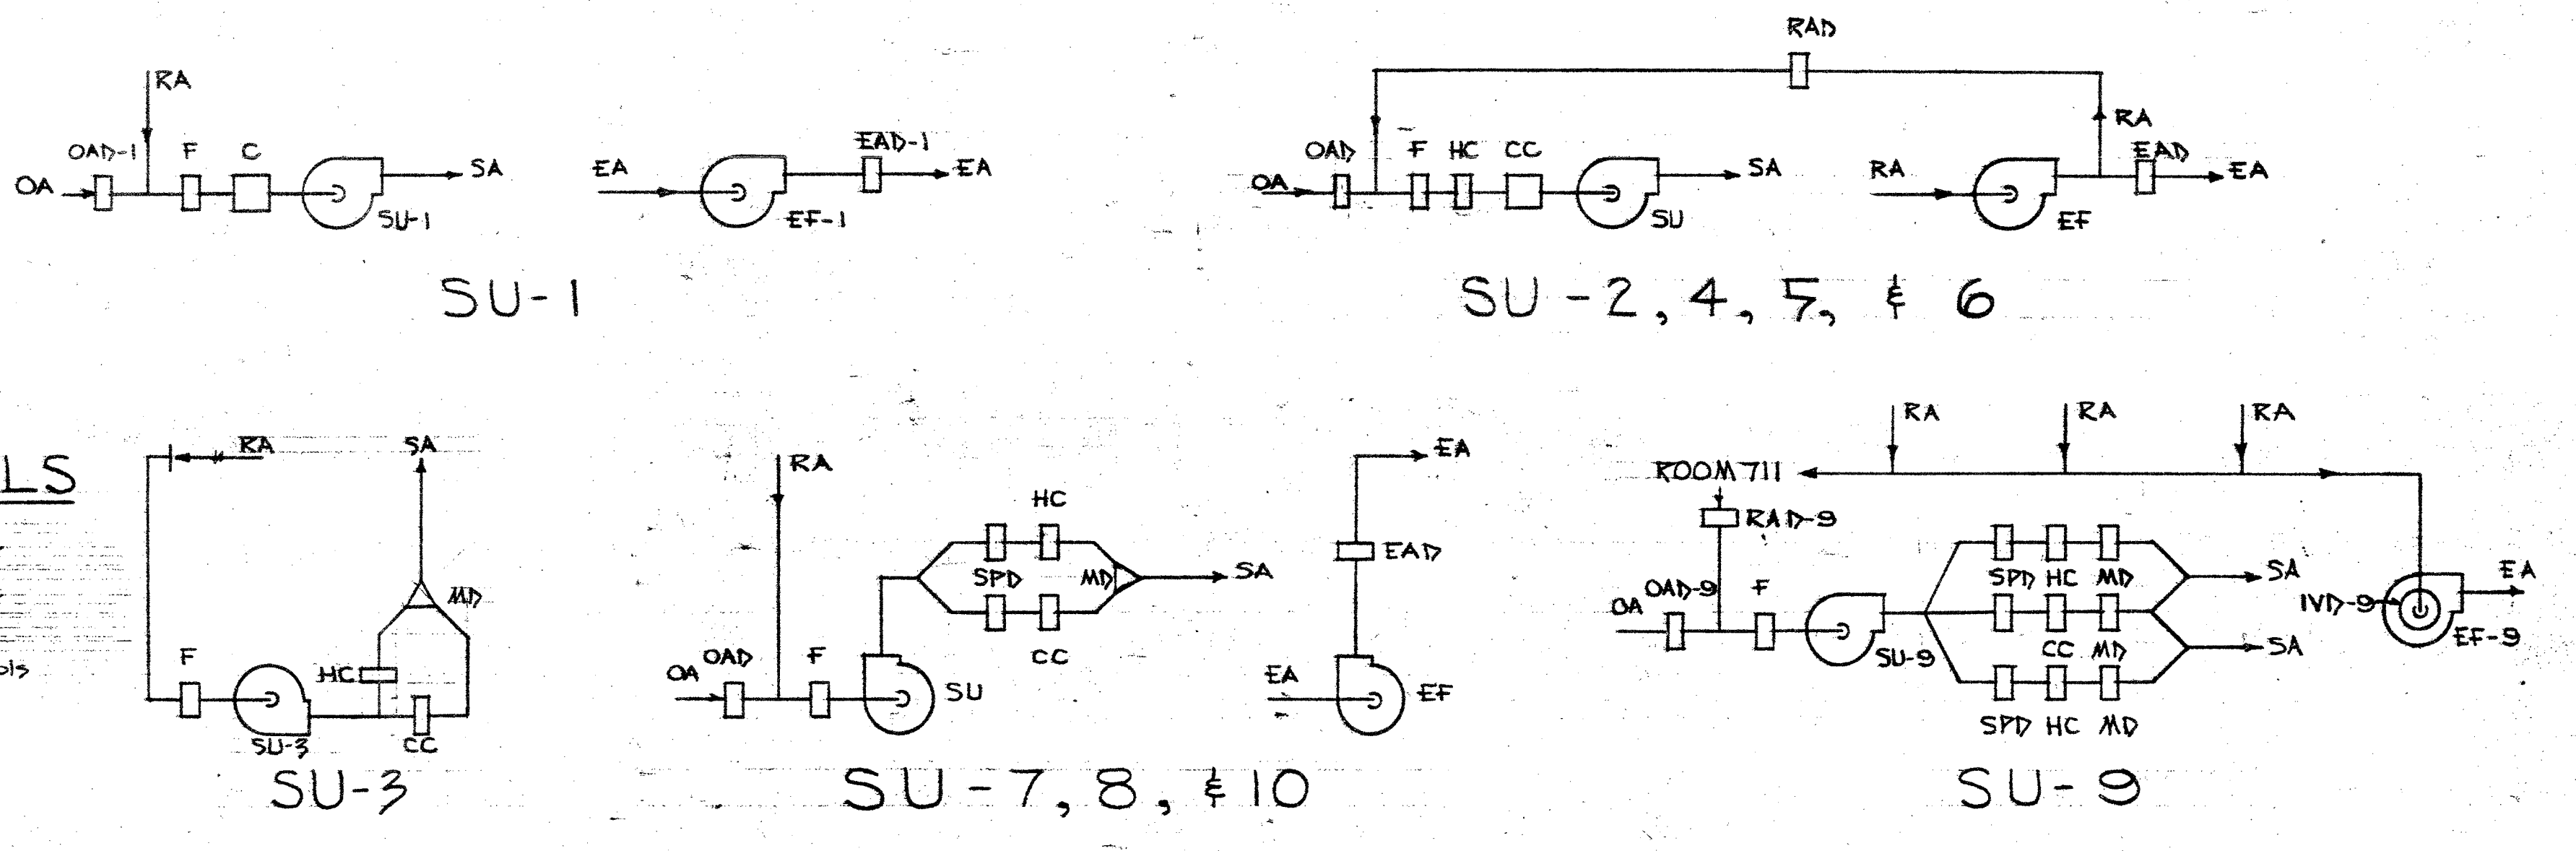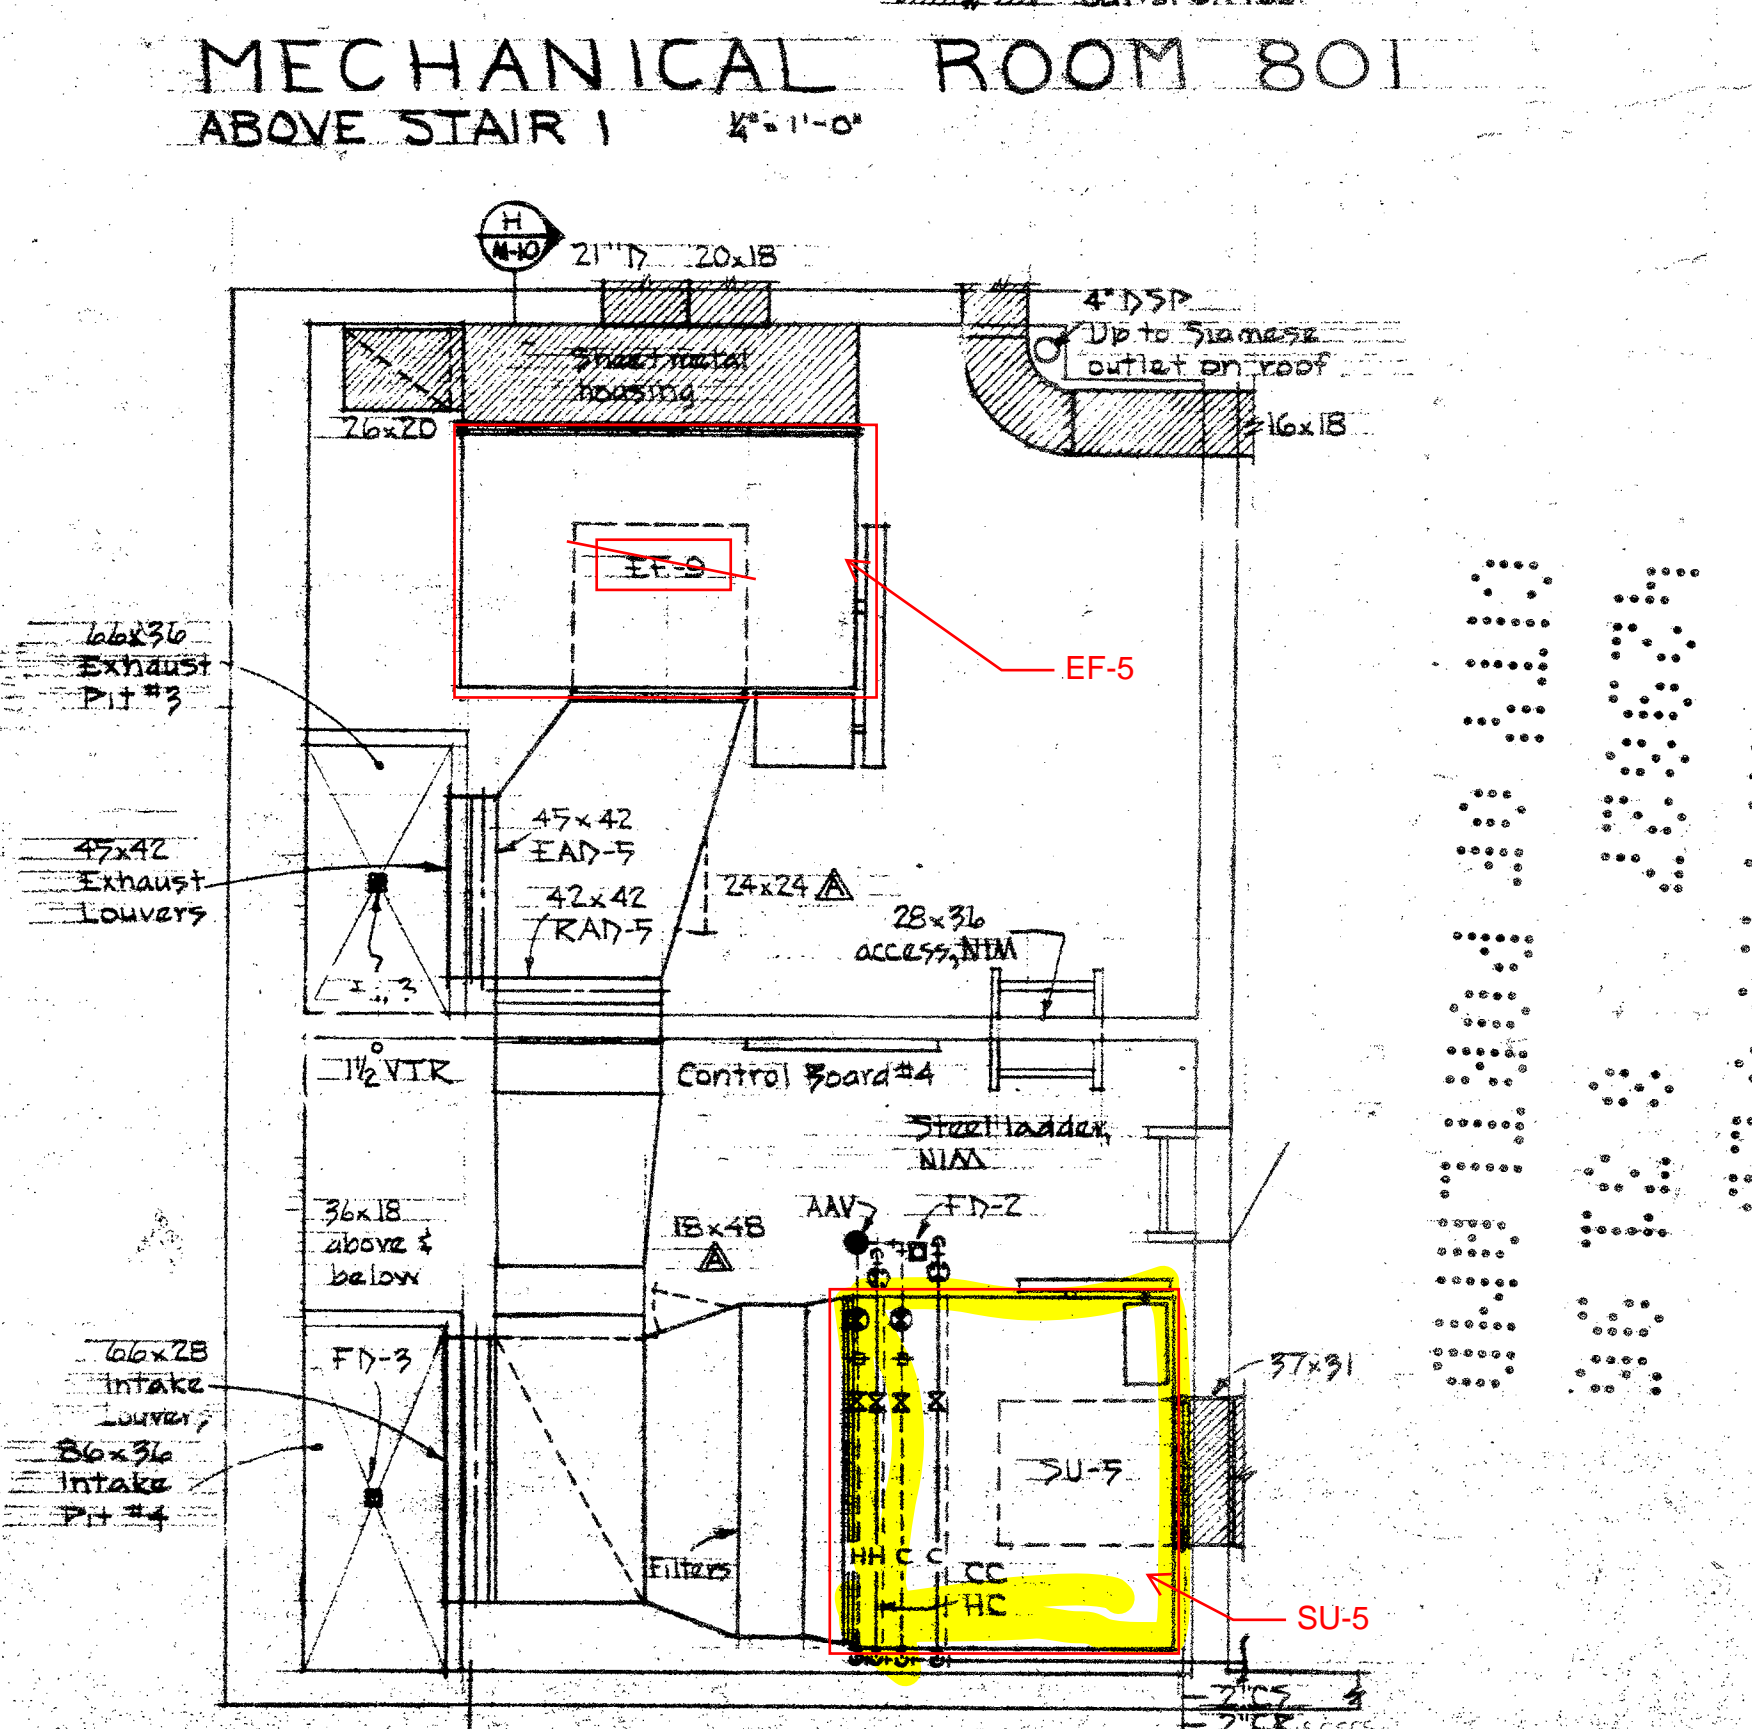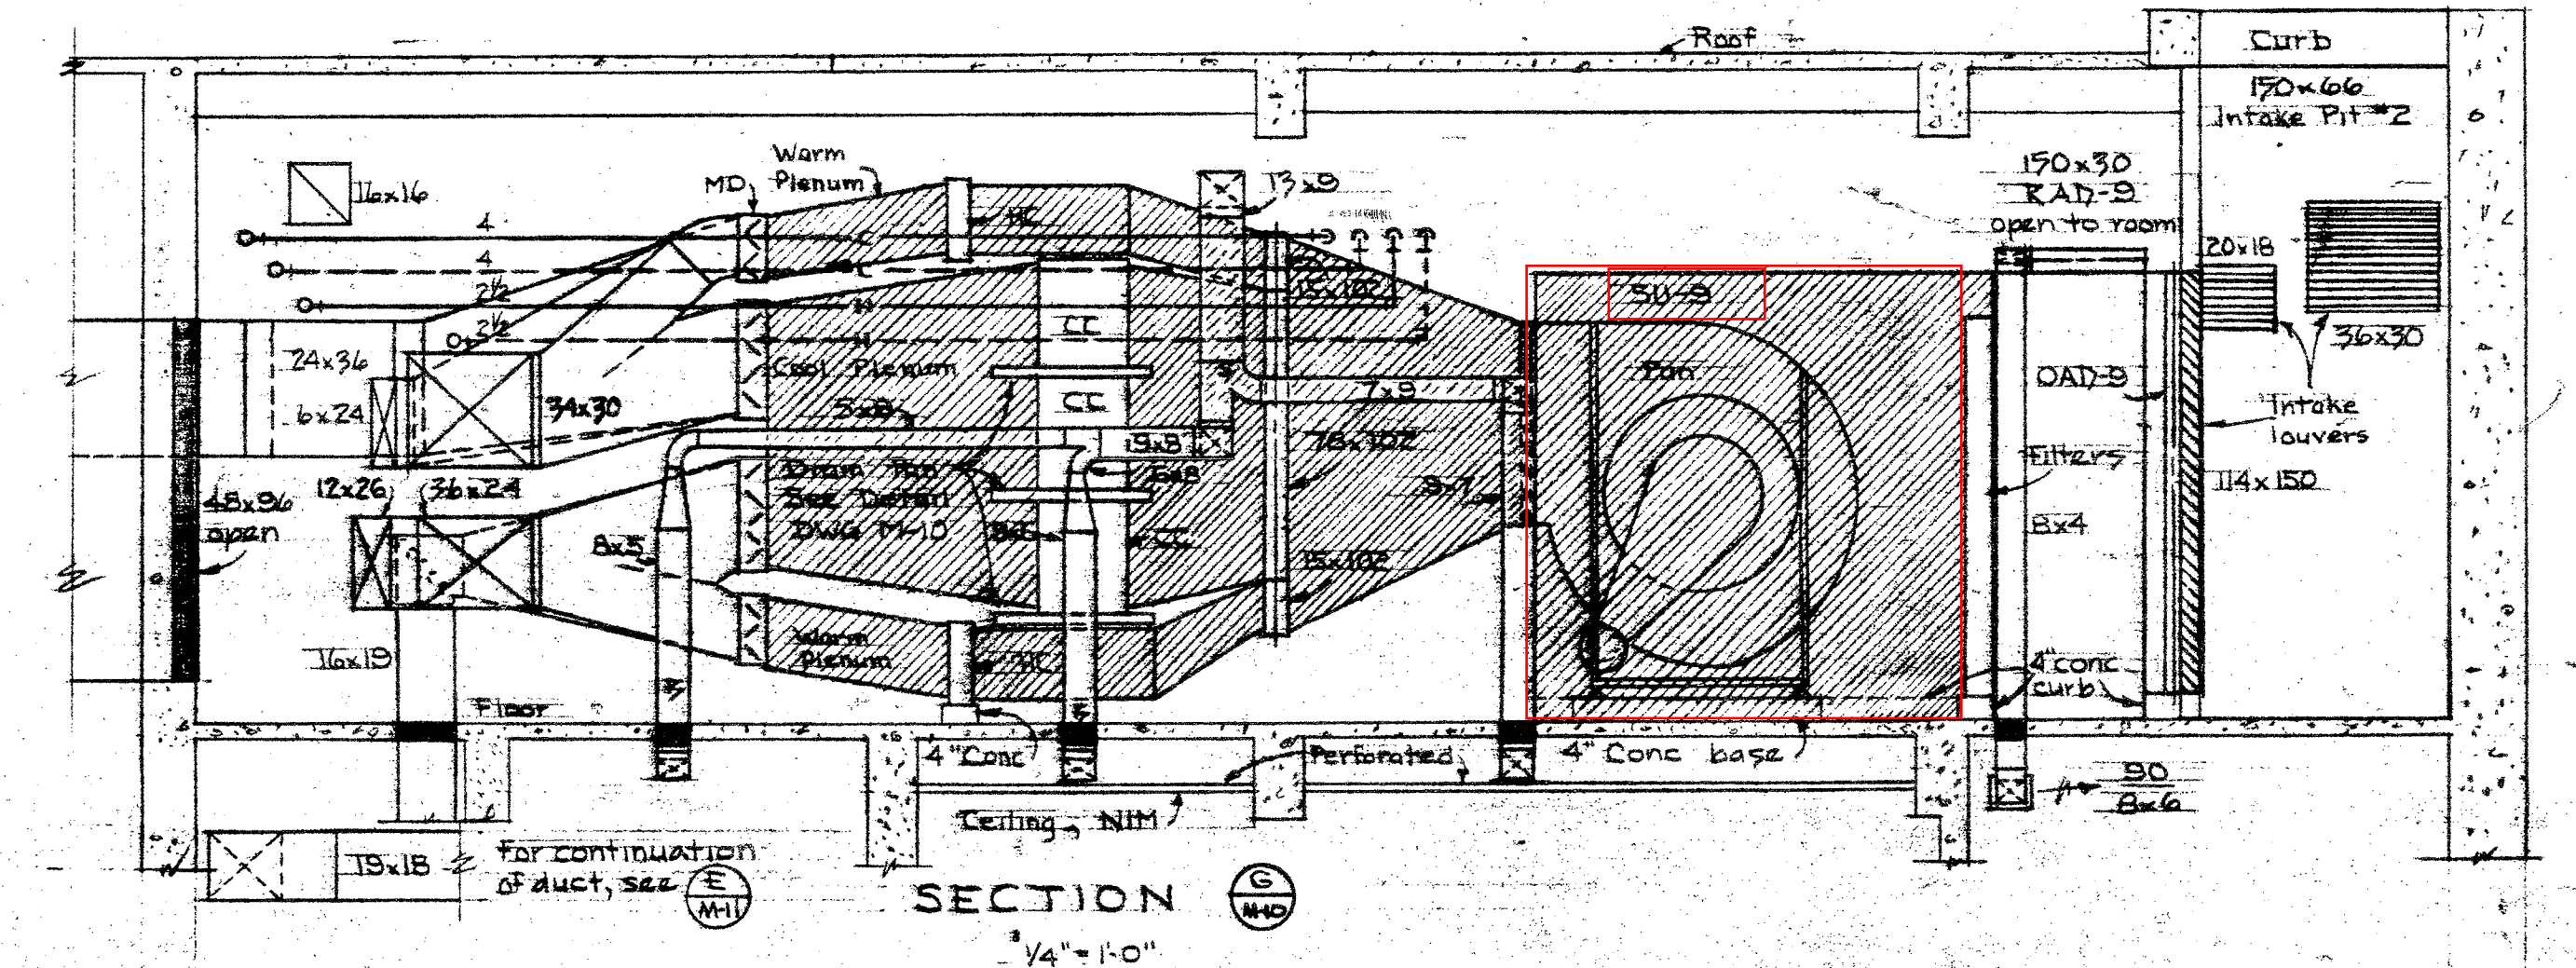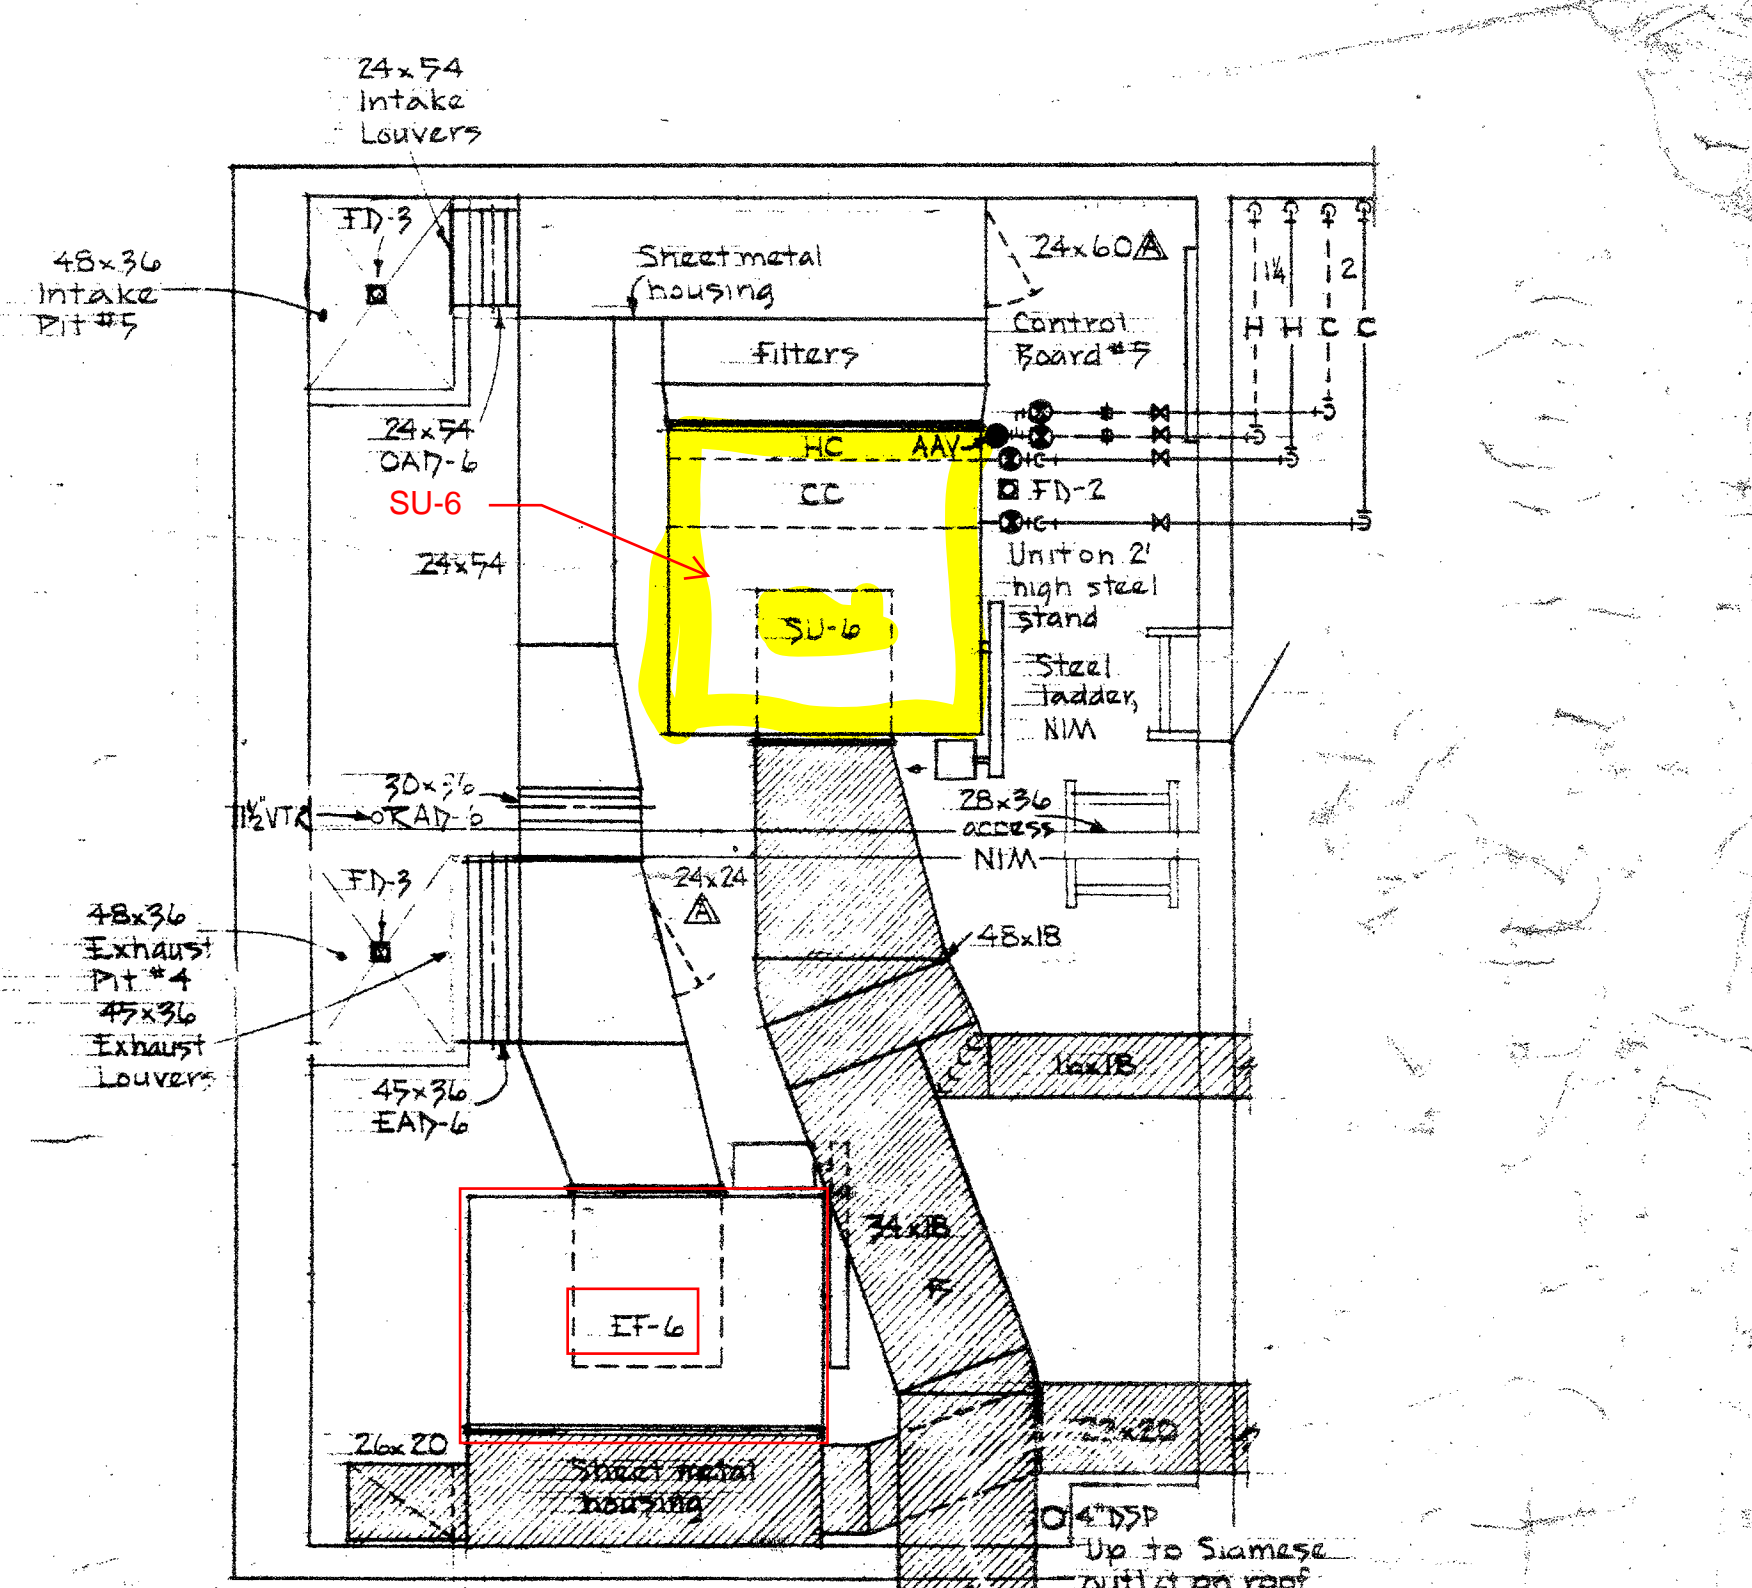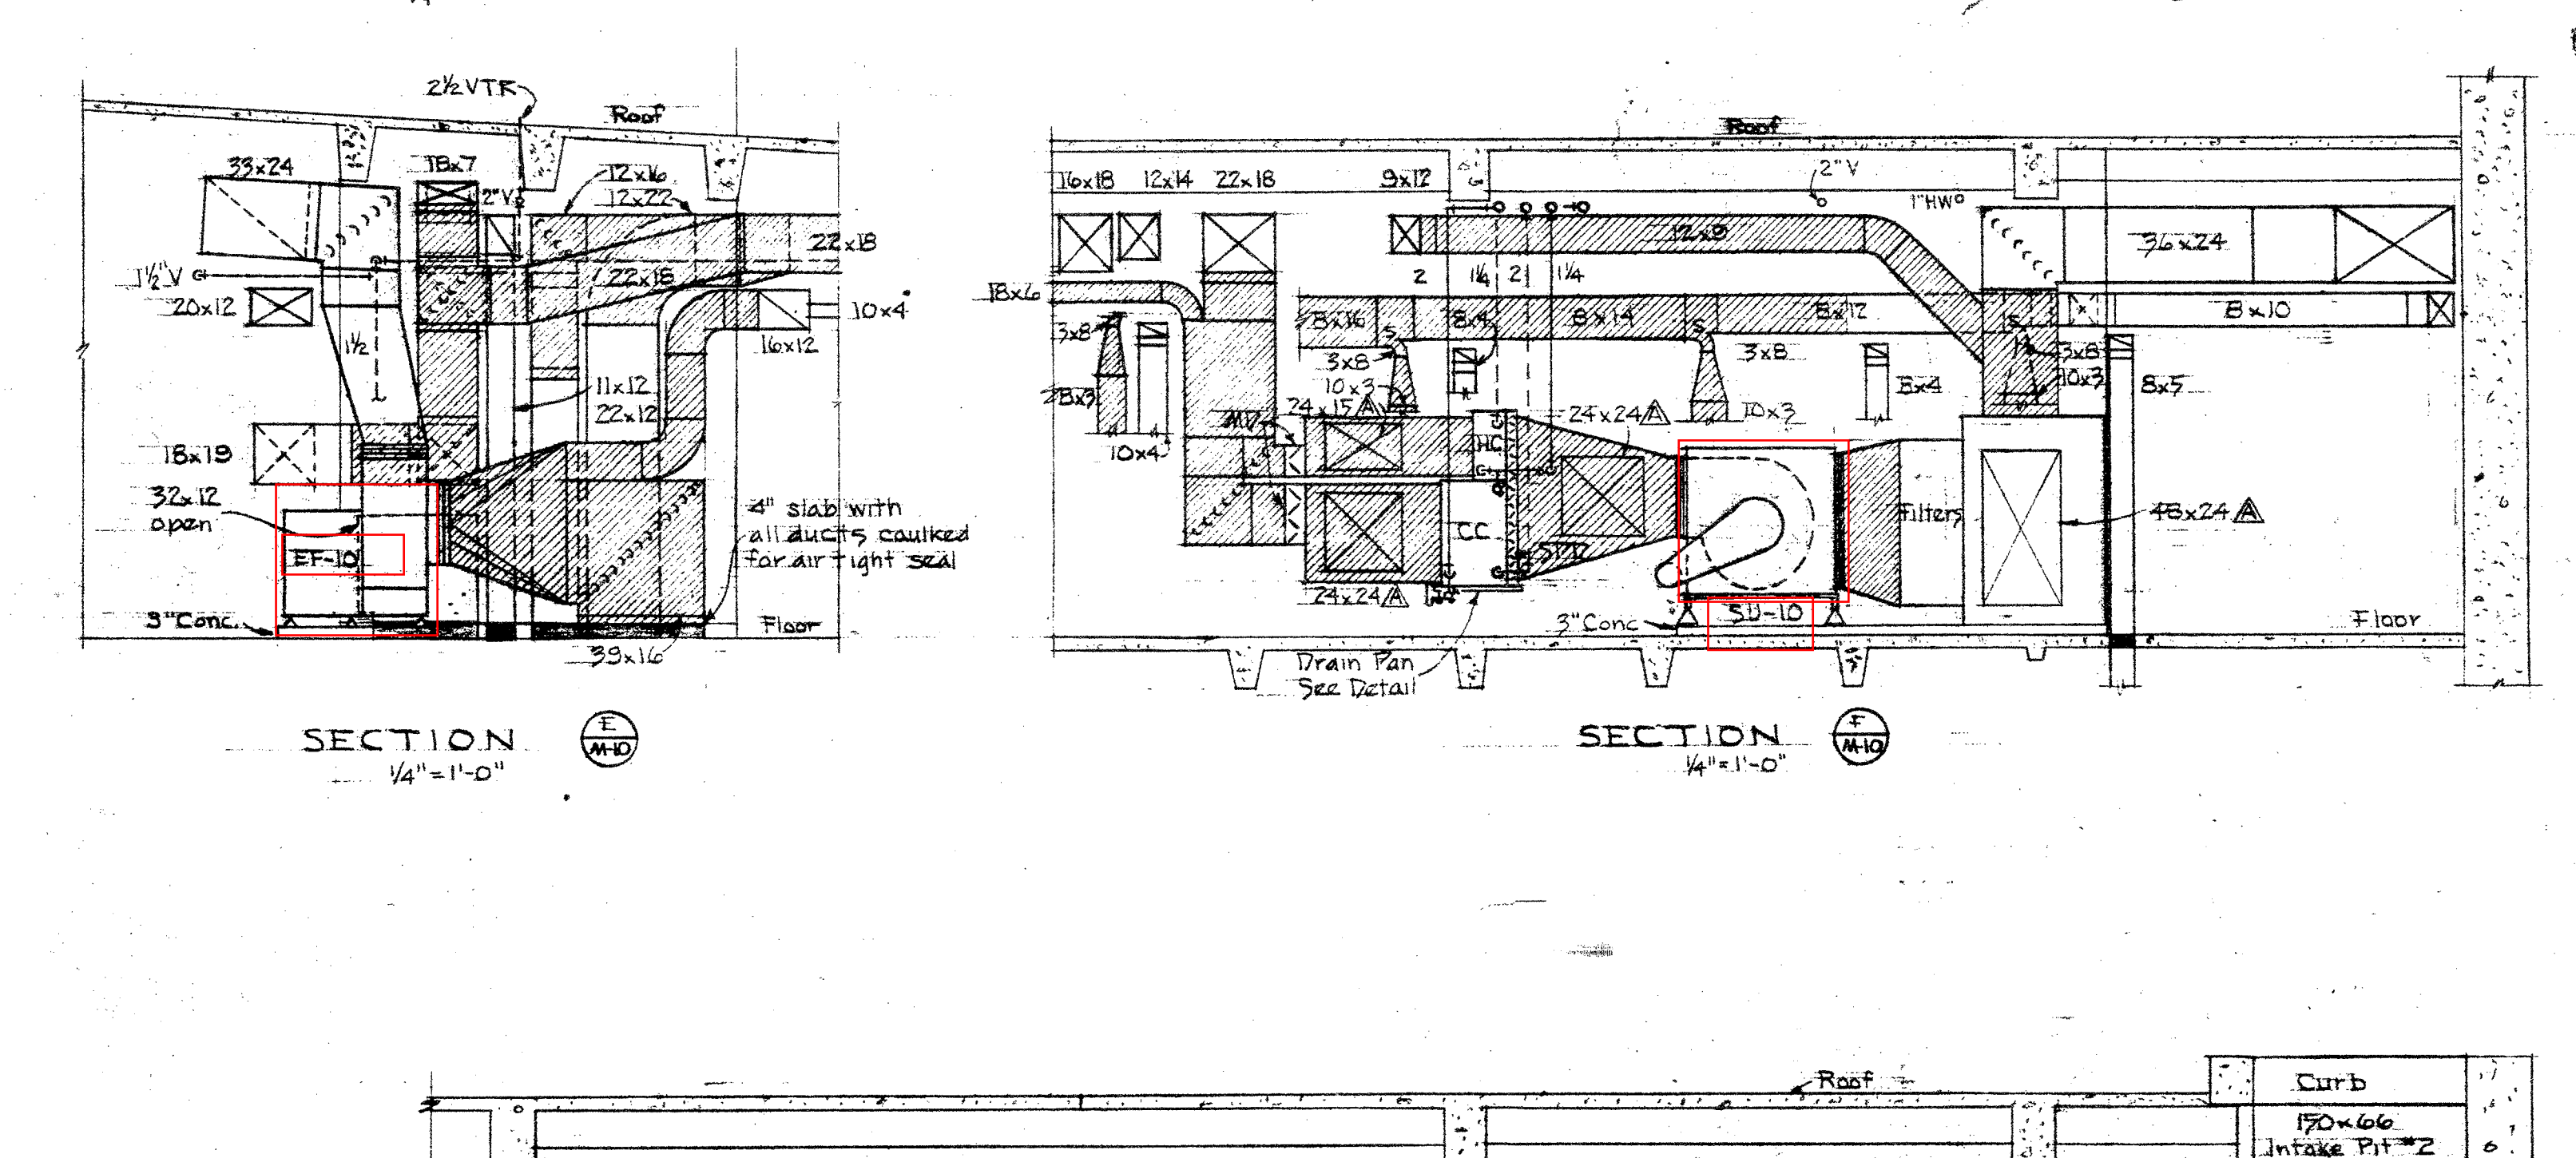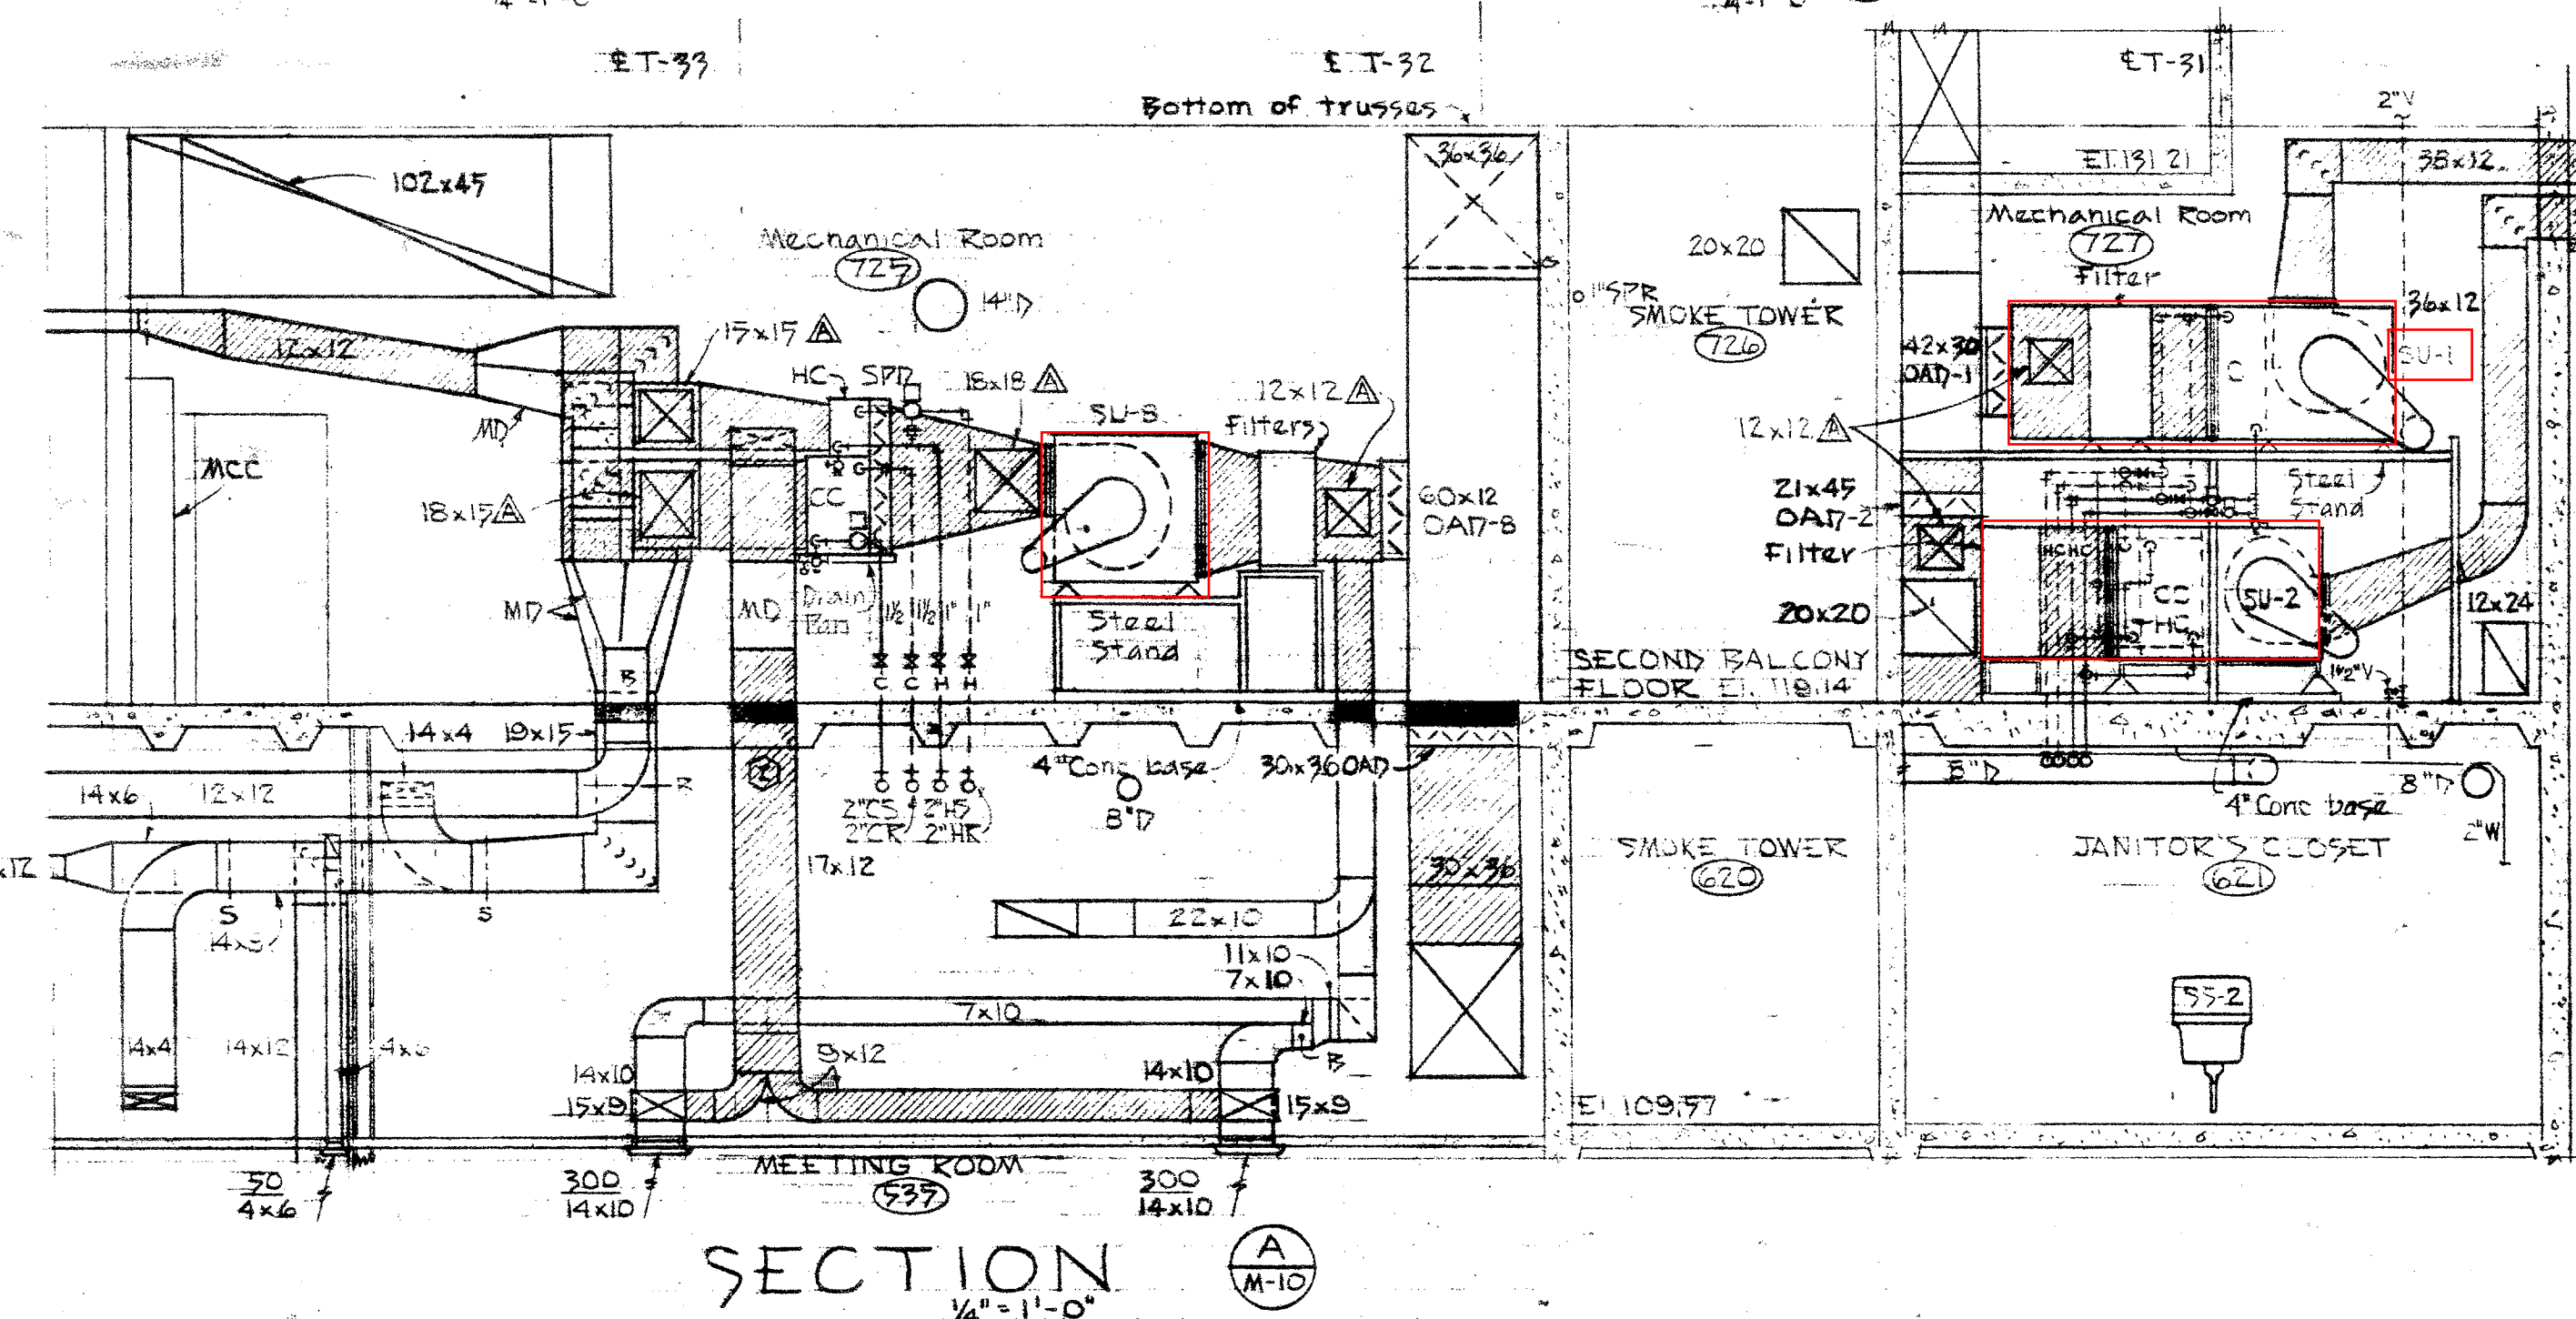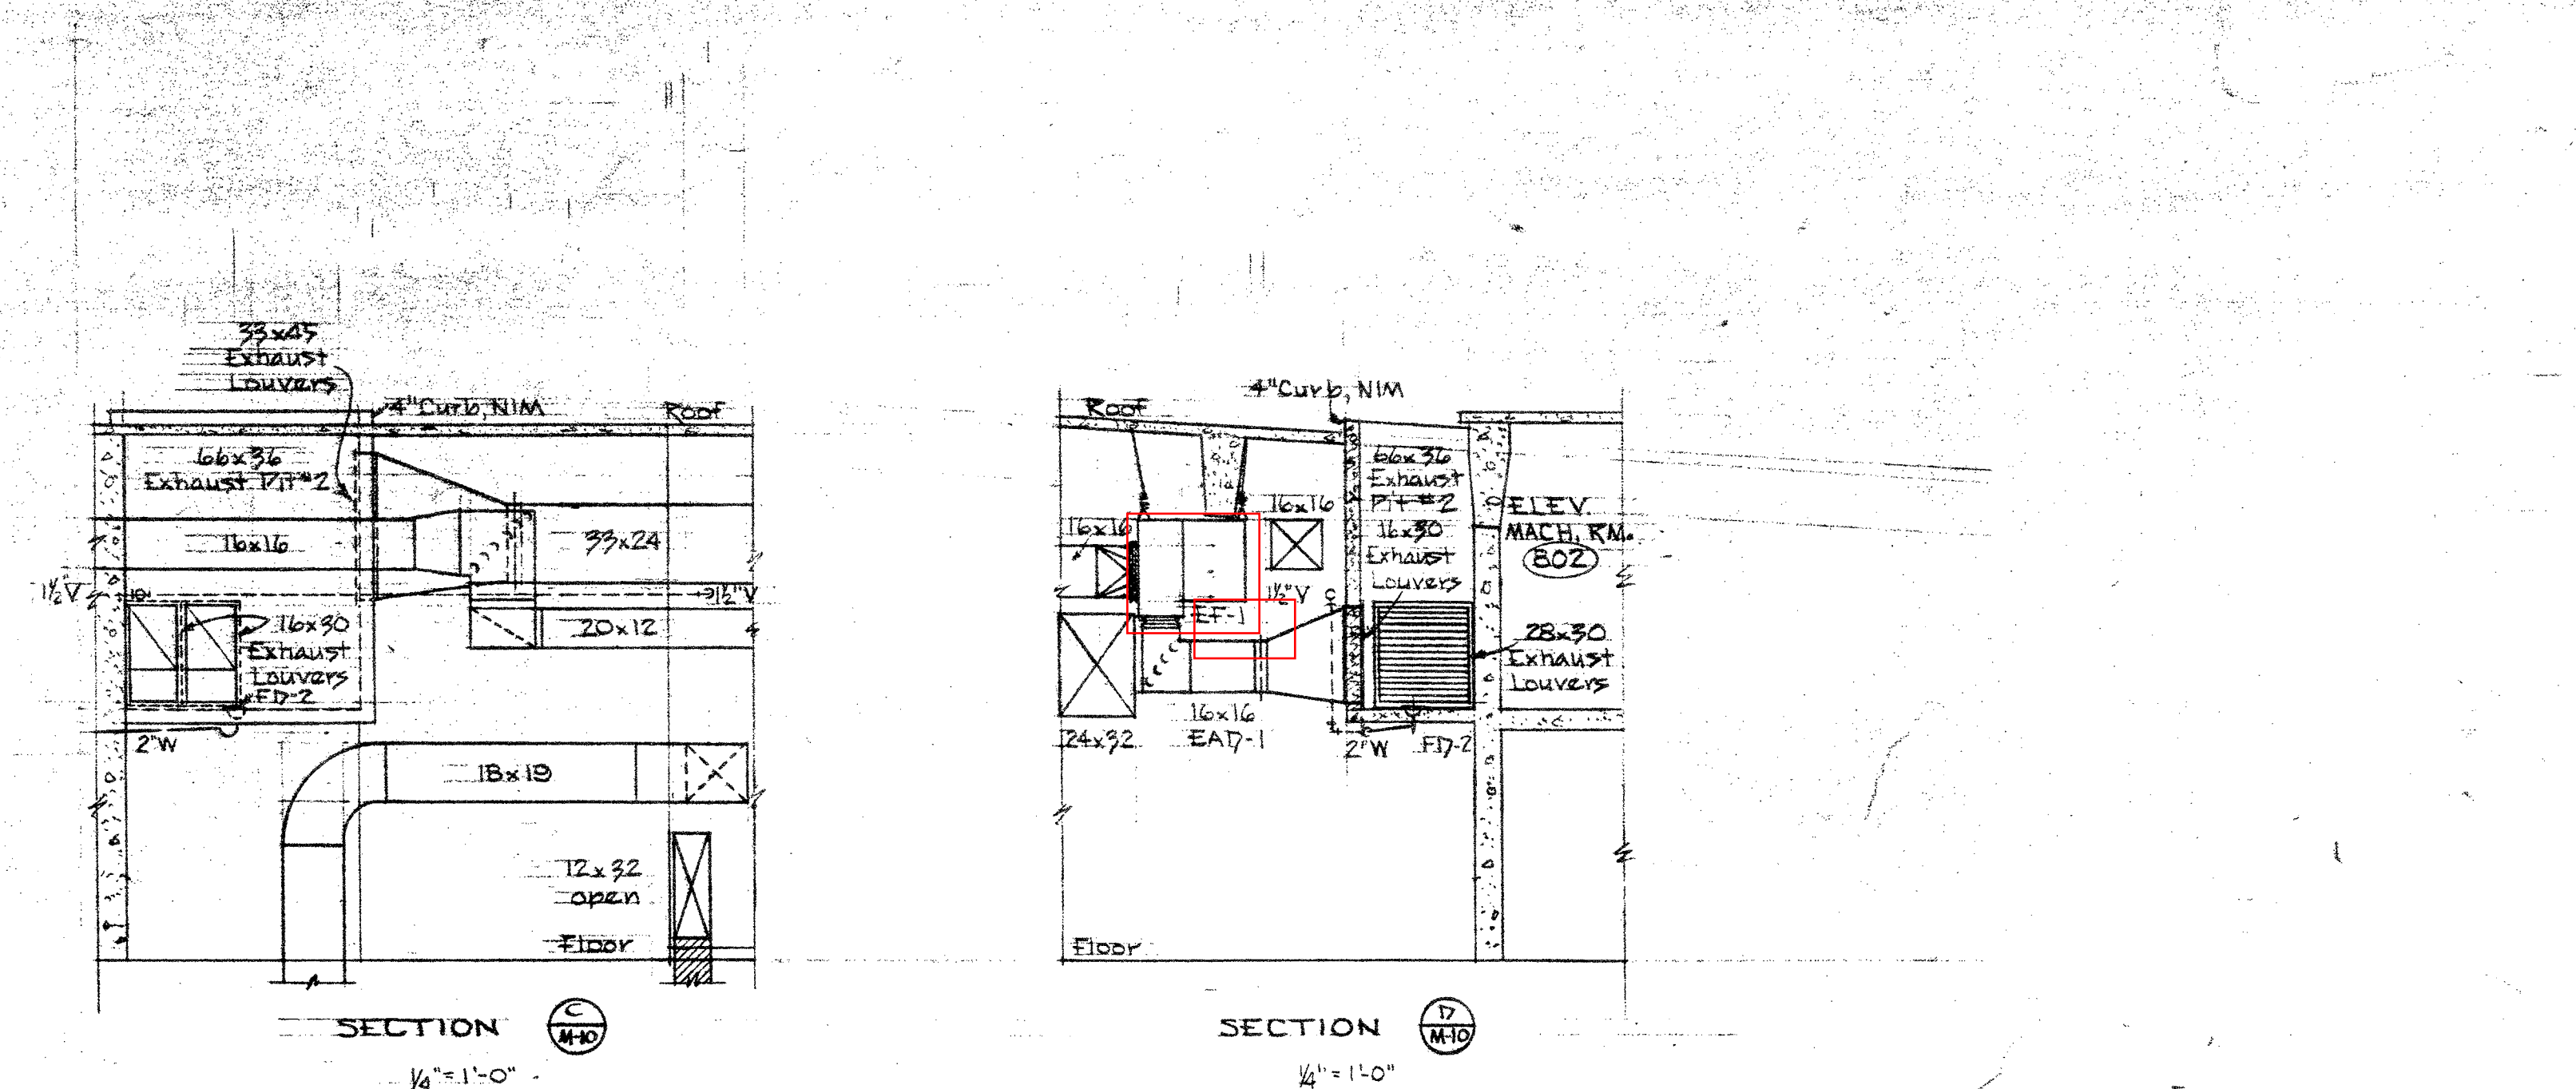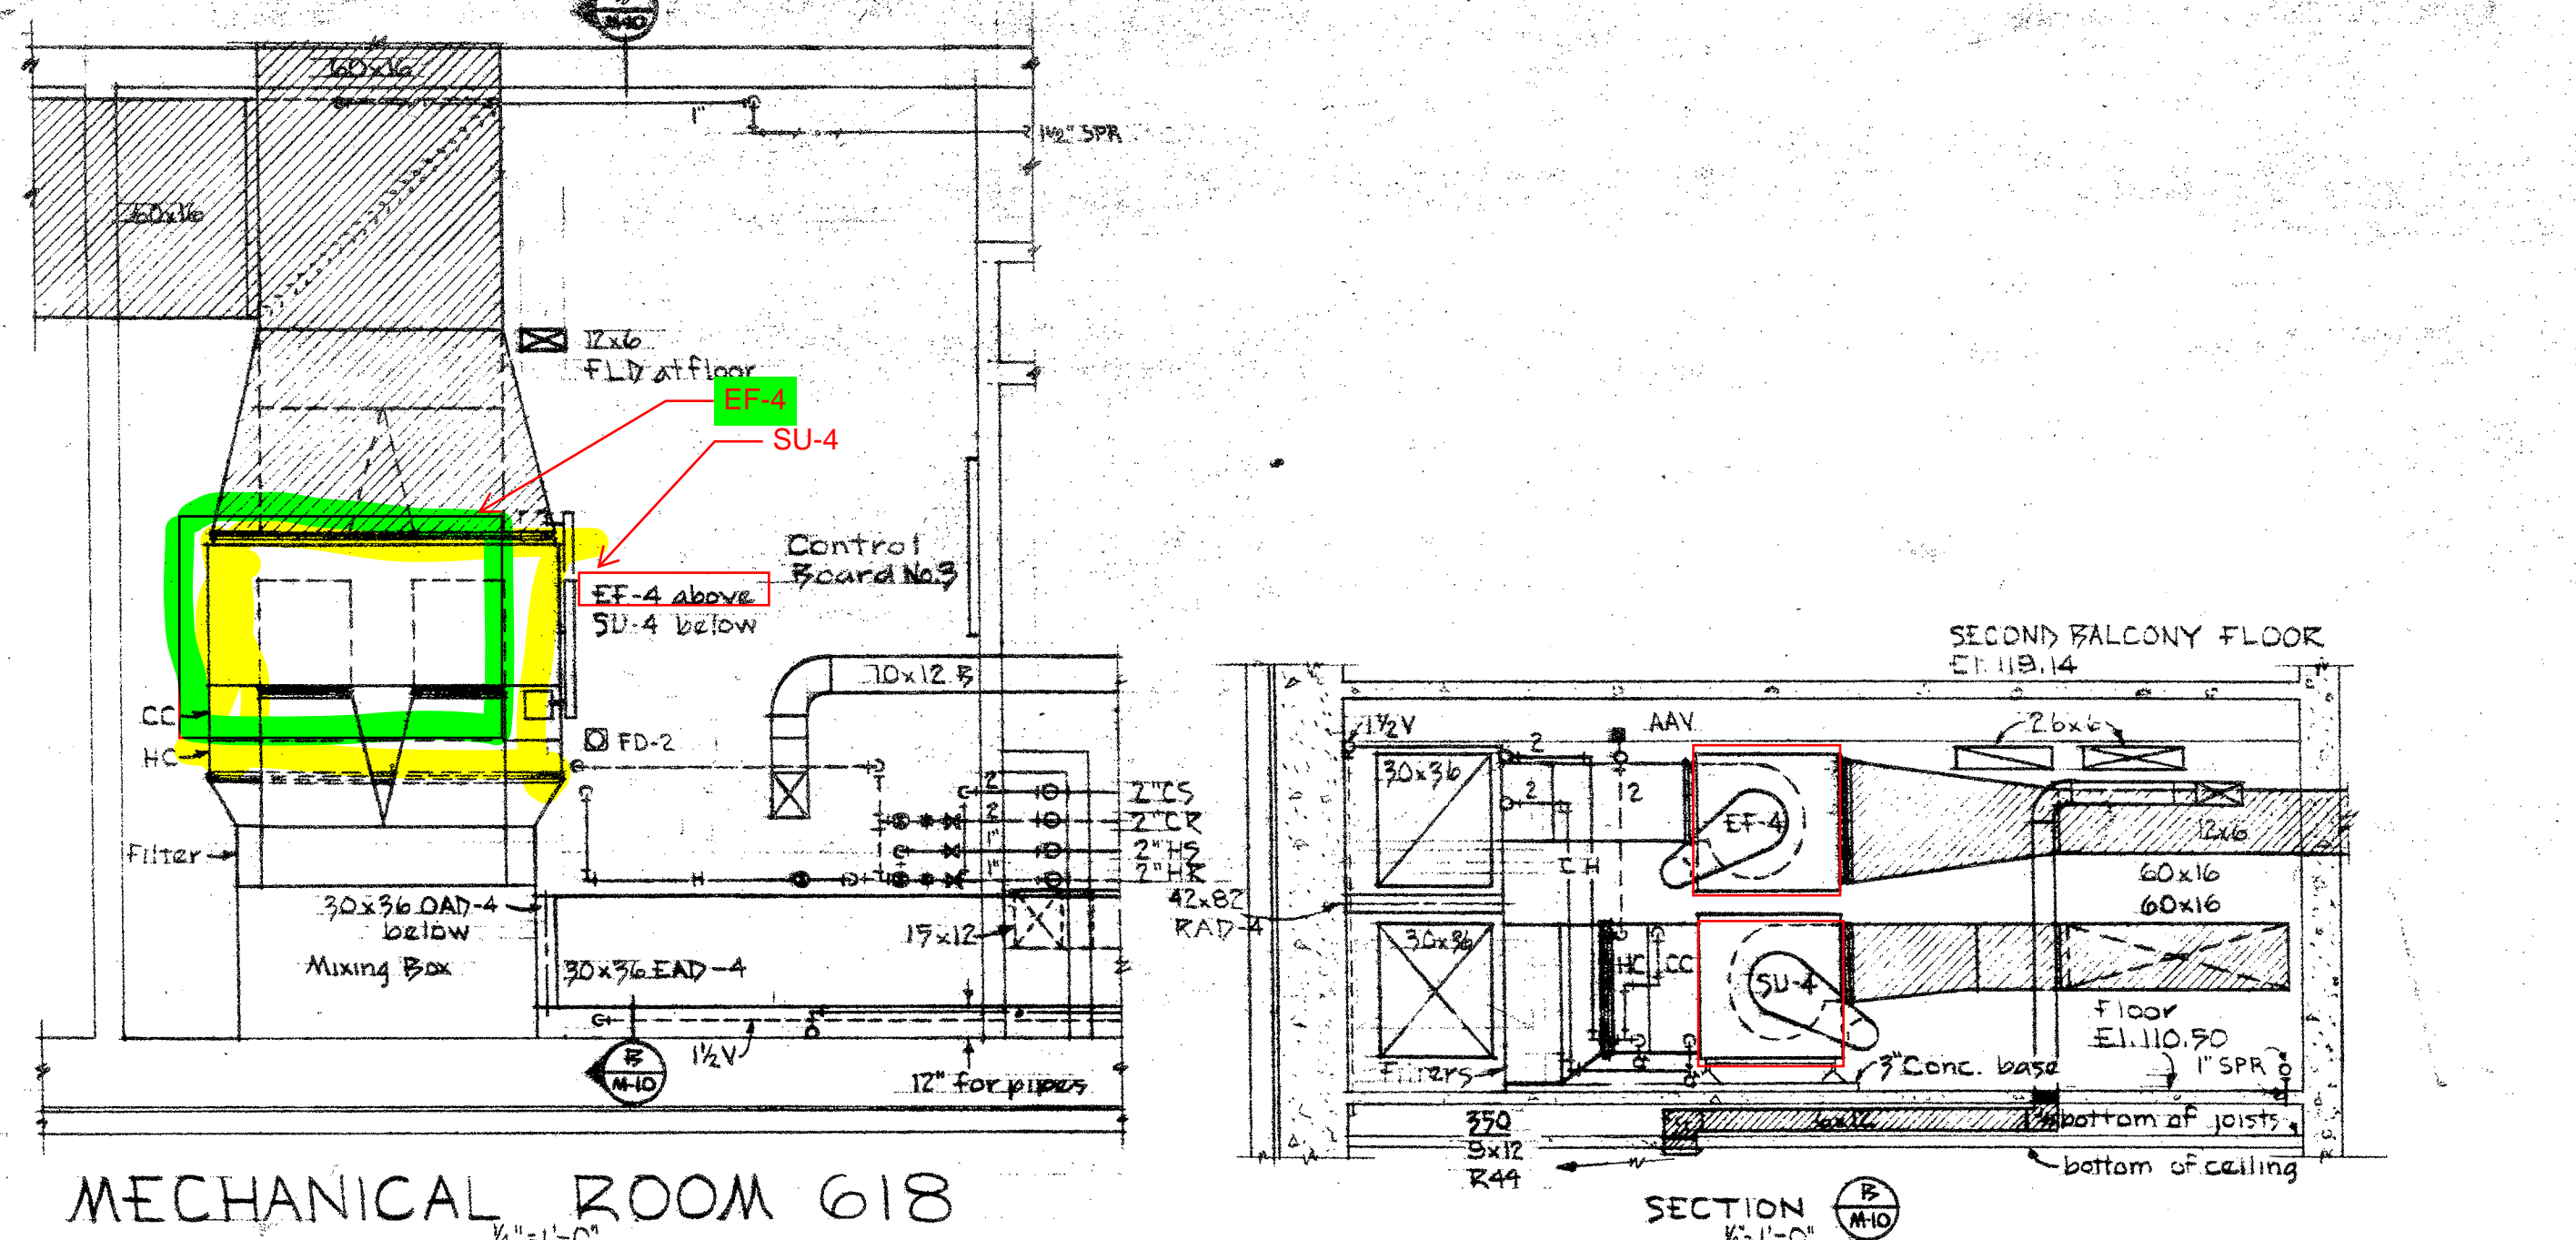

**MECHANICAL ROOM DETAILS**



REBUILDING OF PORTLAND CIVIC AUDITORIUM  
1000 NE 10TH AVENUE & 1ST STREET  
CITY OF PORTLAND, OREGON

ARCHITECTS: SCHULTZ/KELLER/HARTFORD




MECHANICAL ENGINEERS: J. DONALD KROENER AND ASSOCIATES

DRAWING: M-10



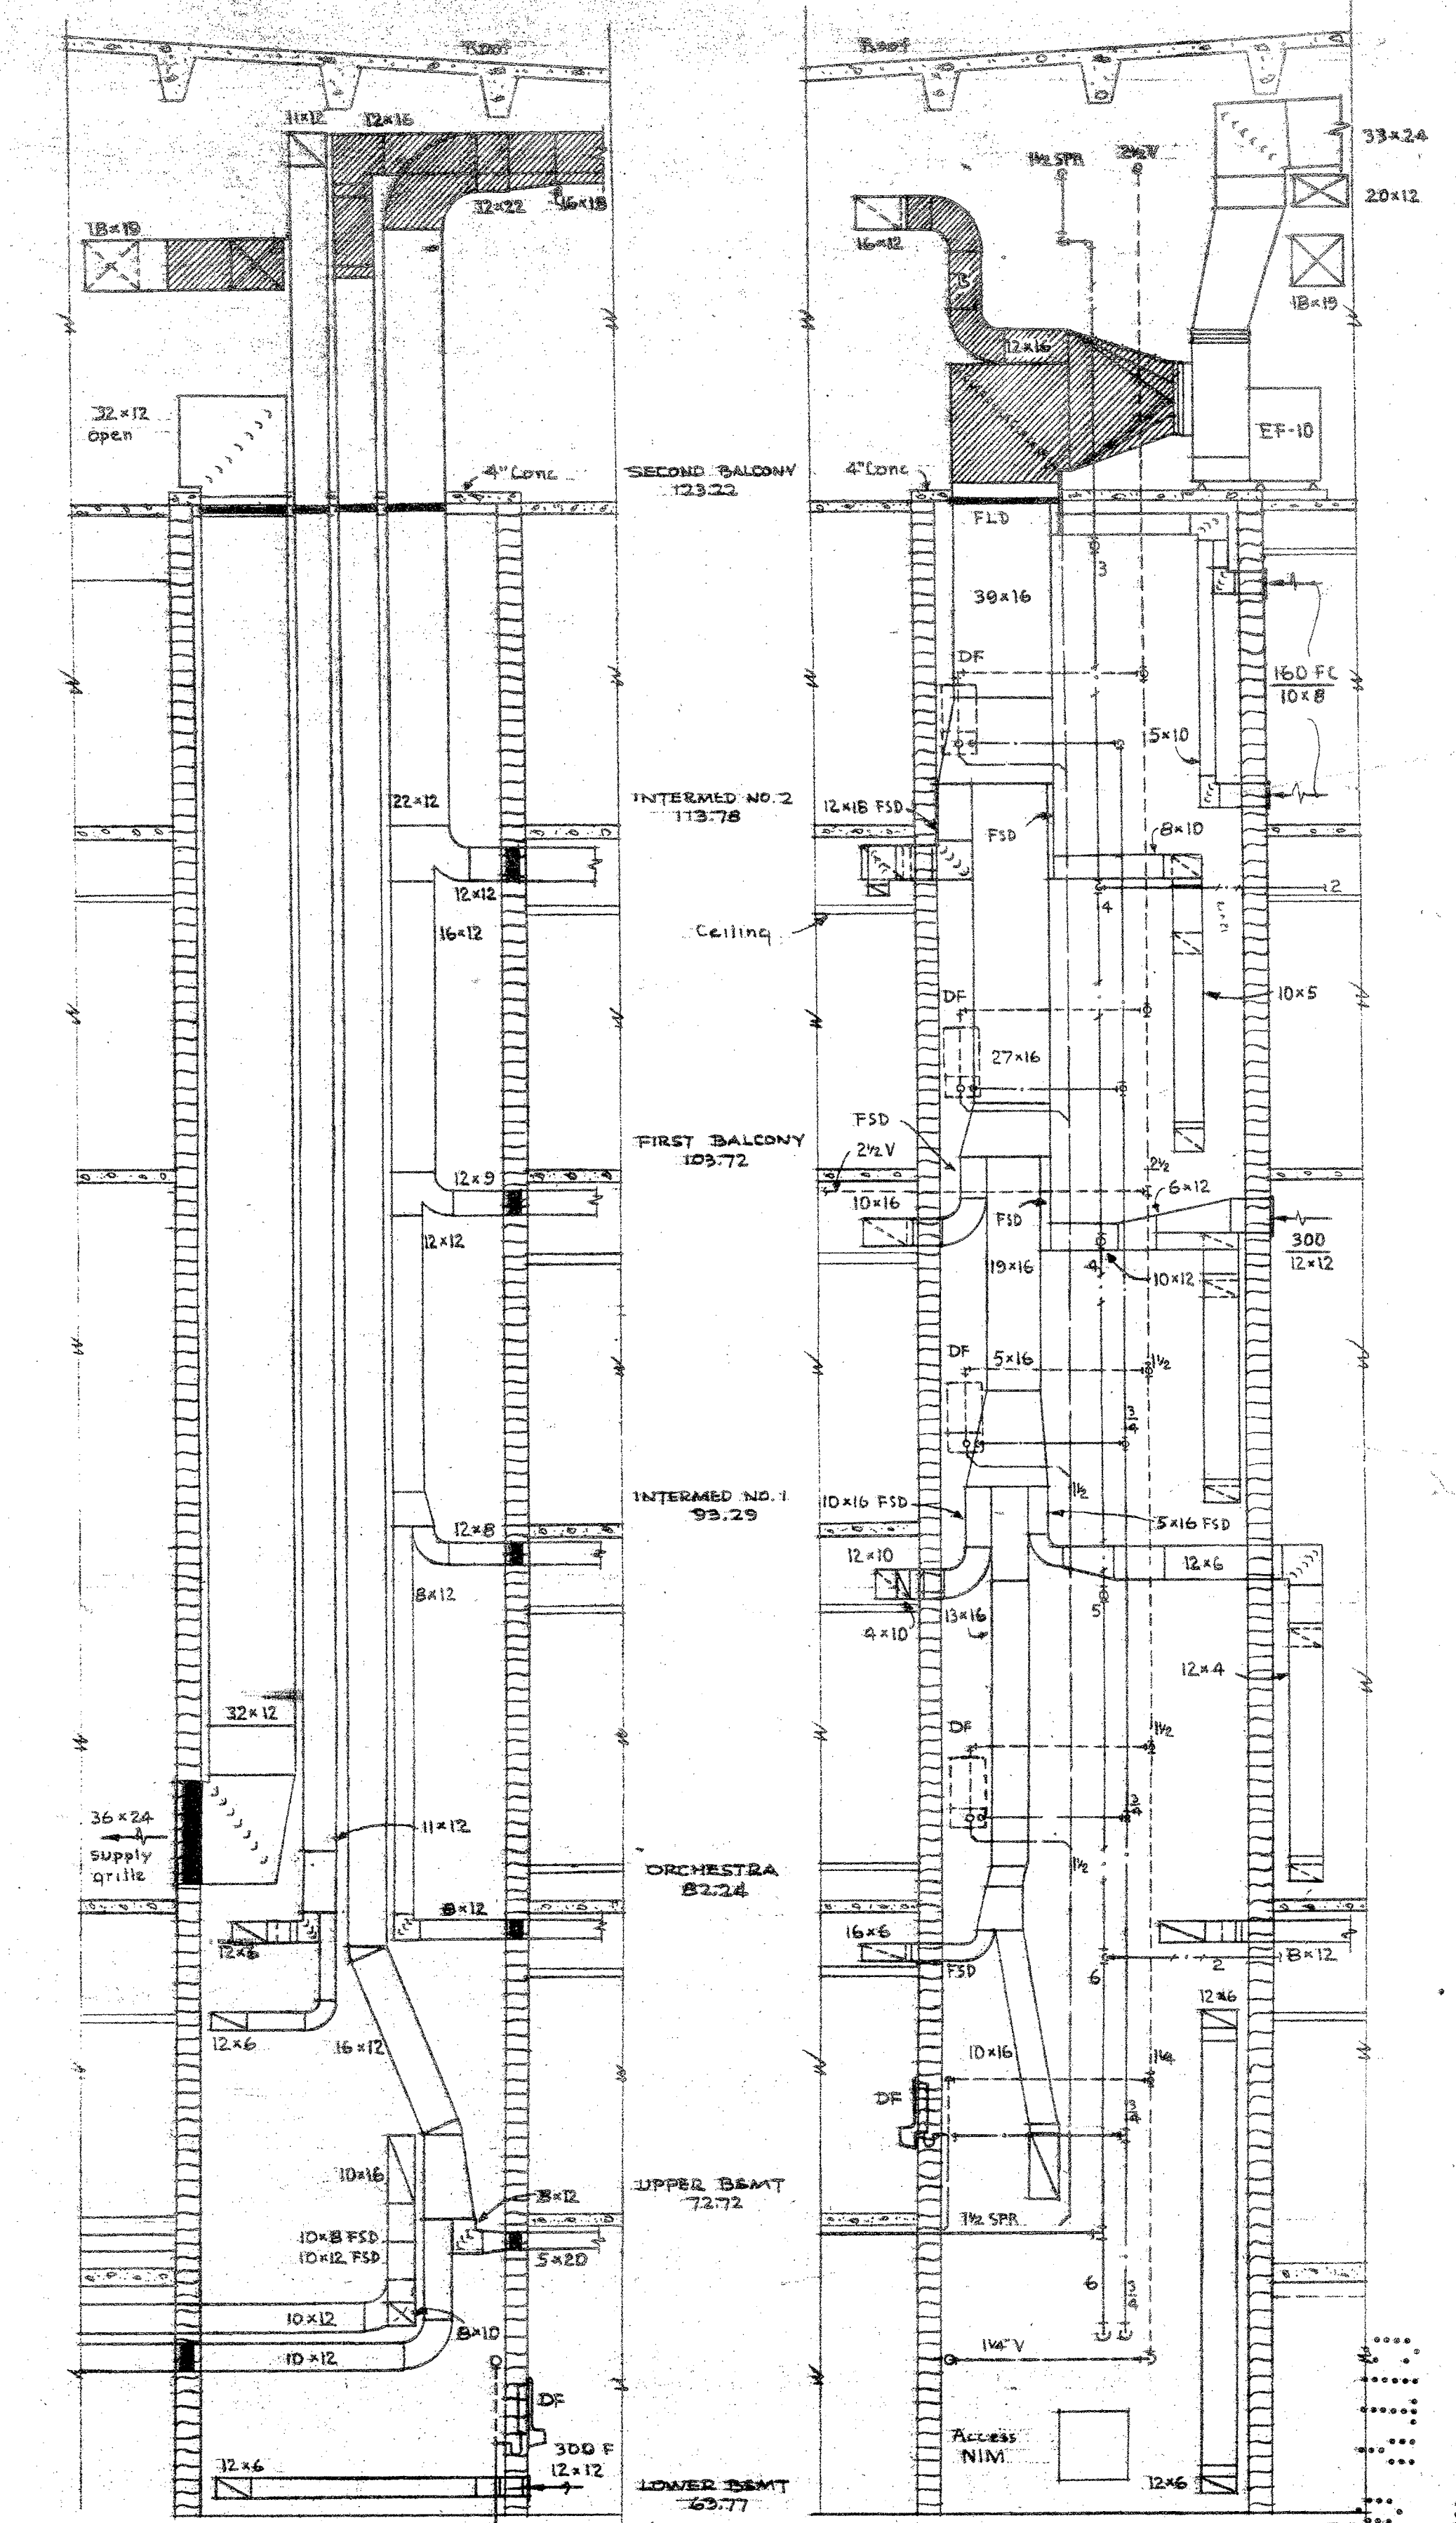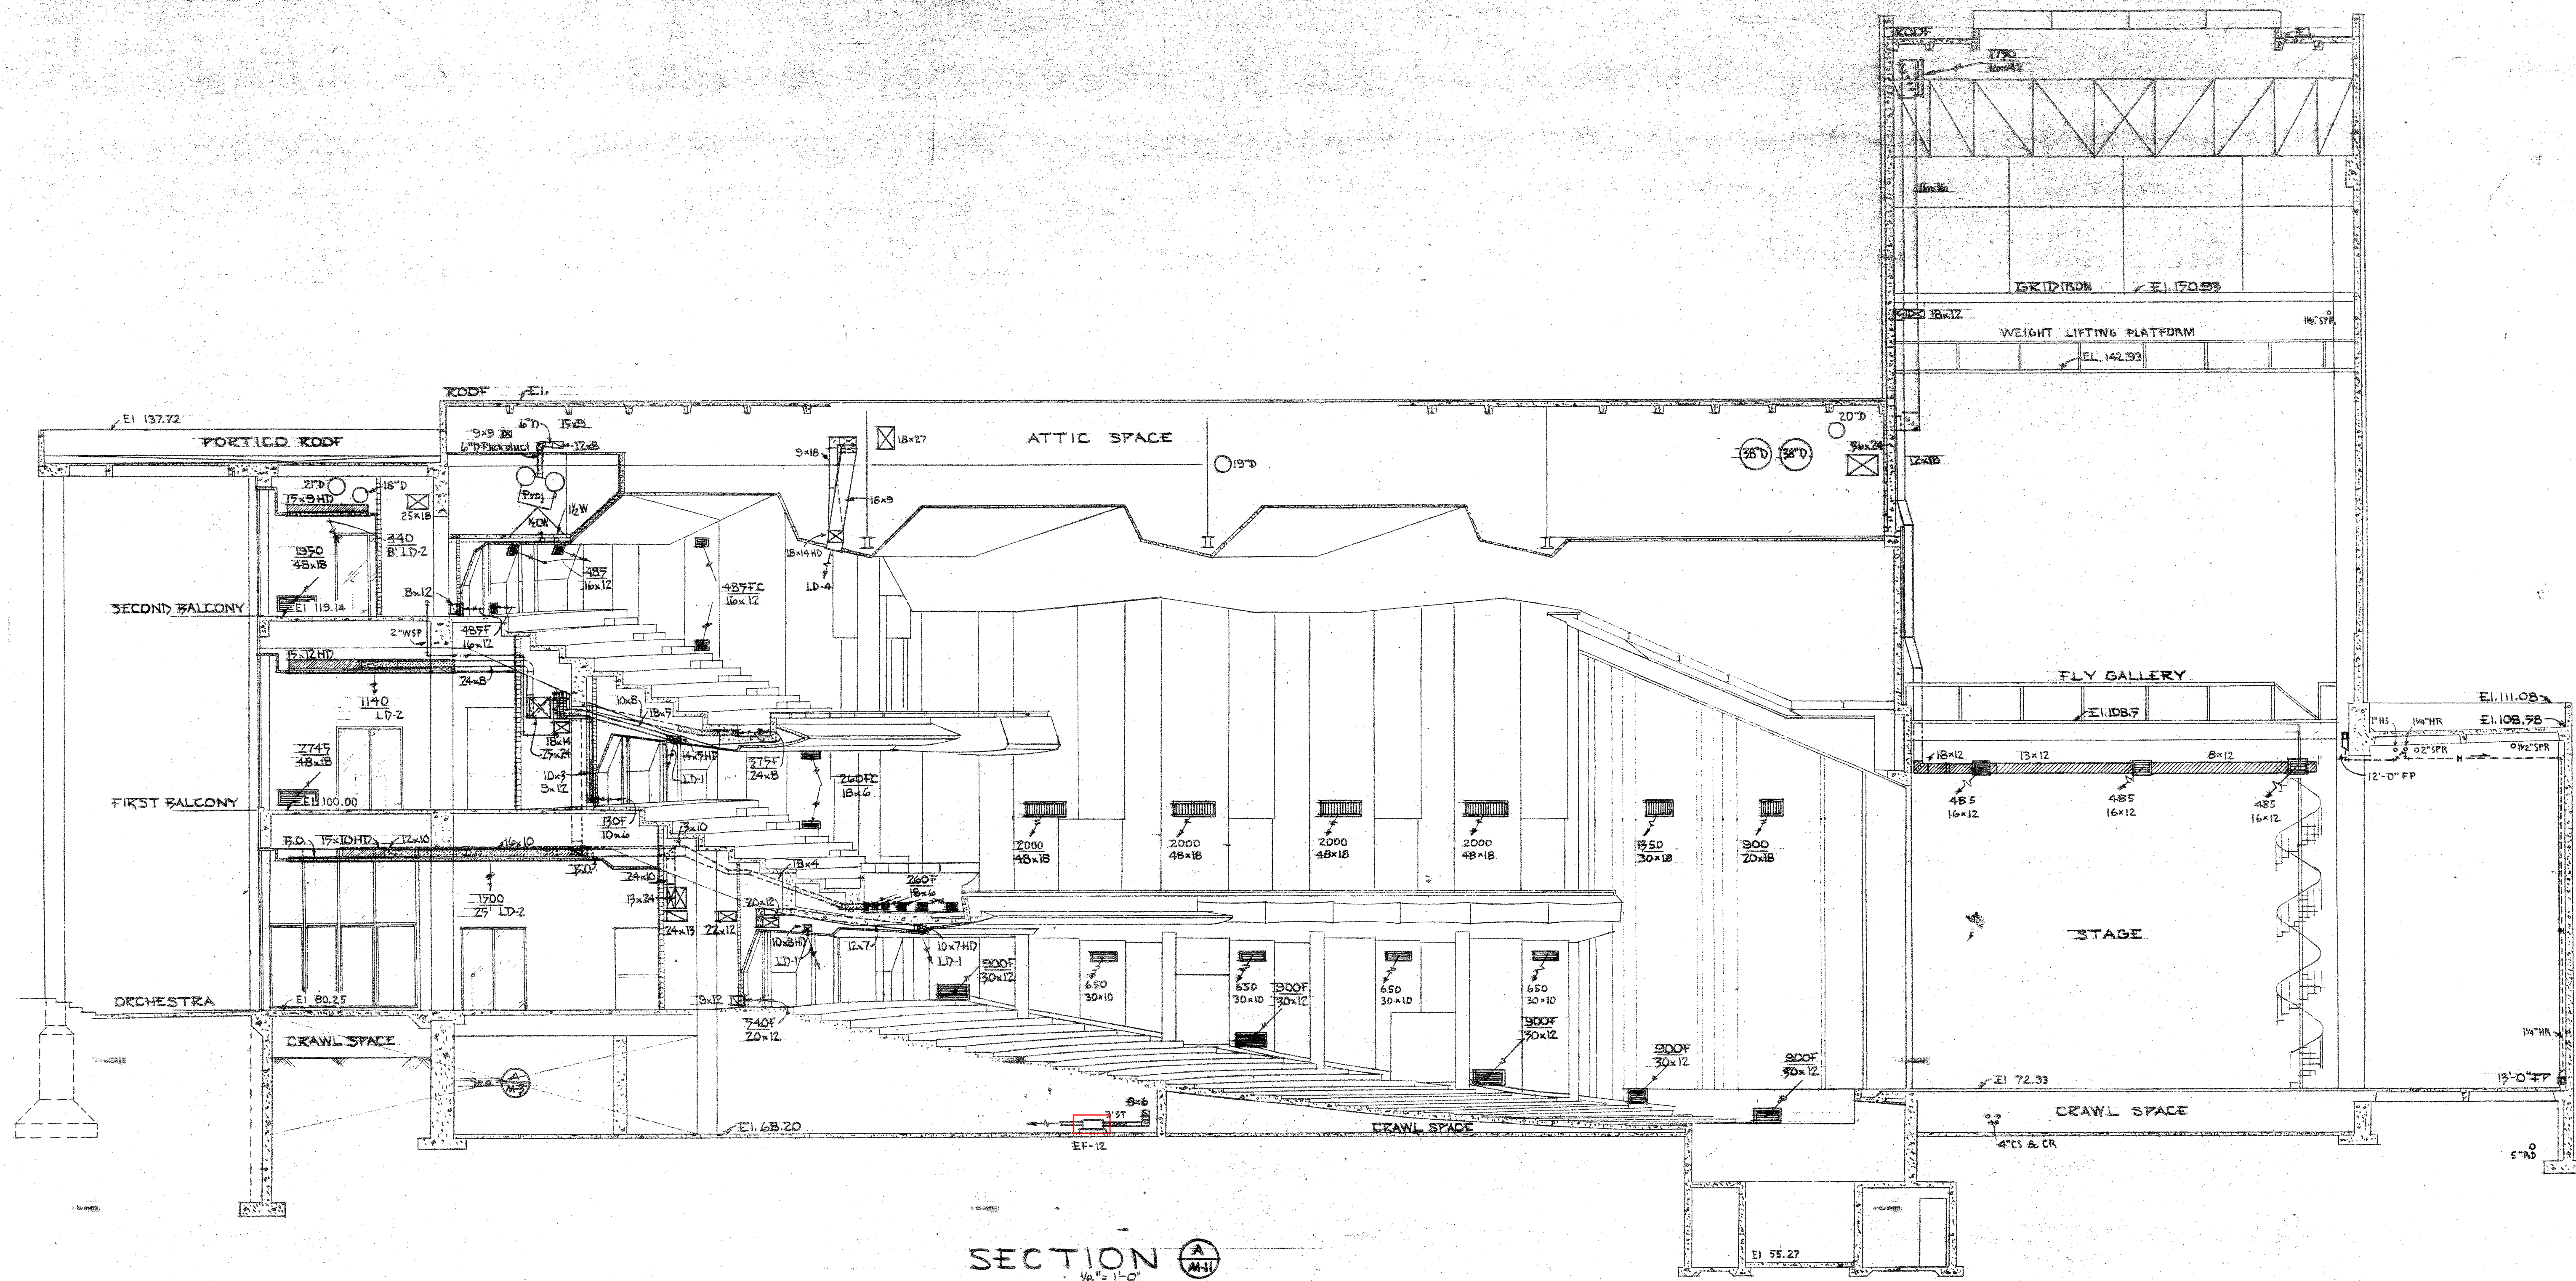

DUCT SHAFT DETAILS - DRESSING ROOM AREA  
1/4" = 1'-0"

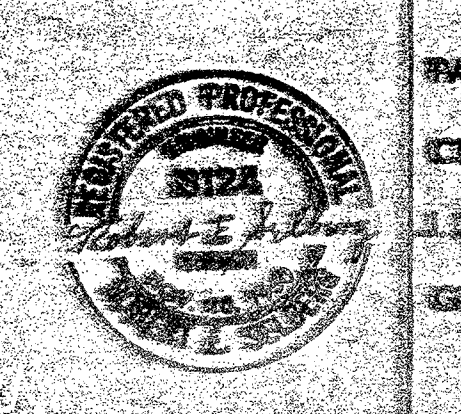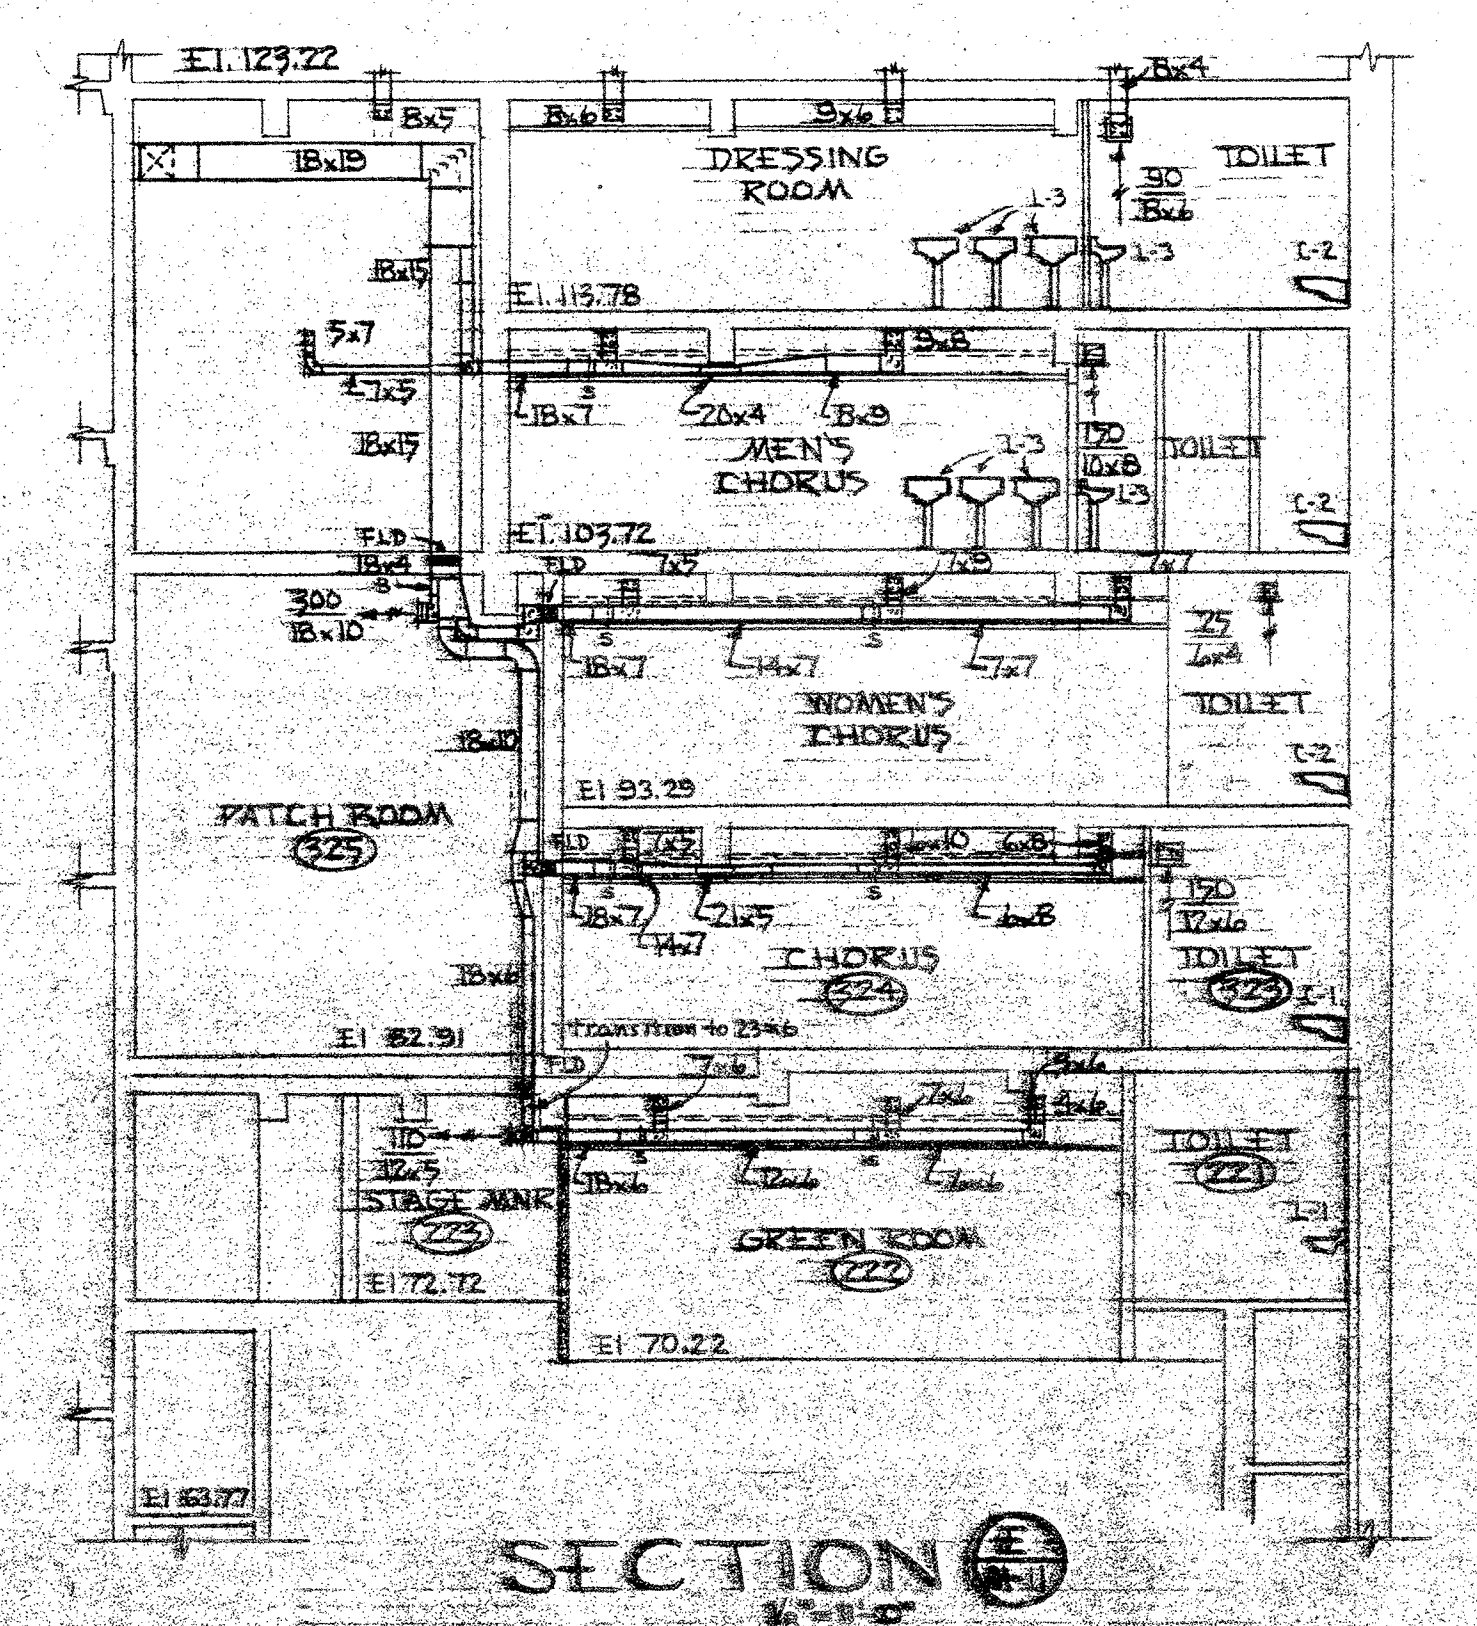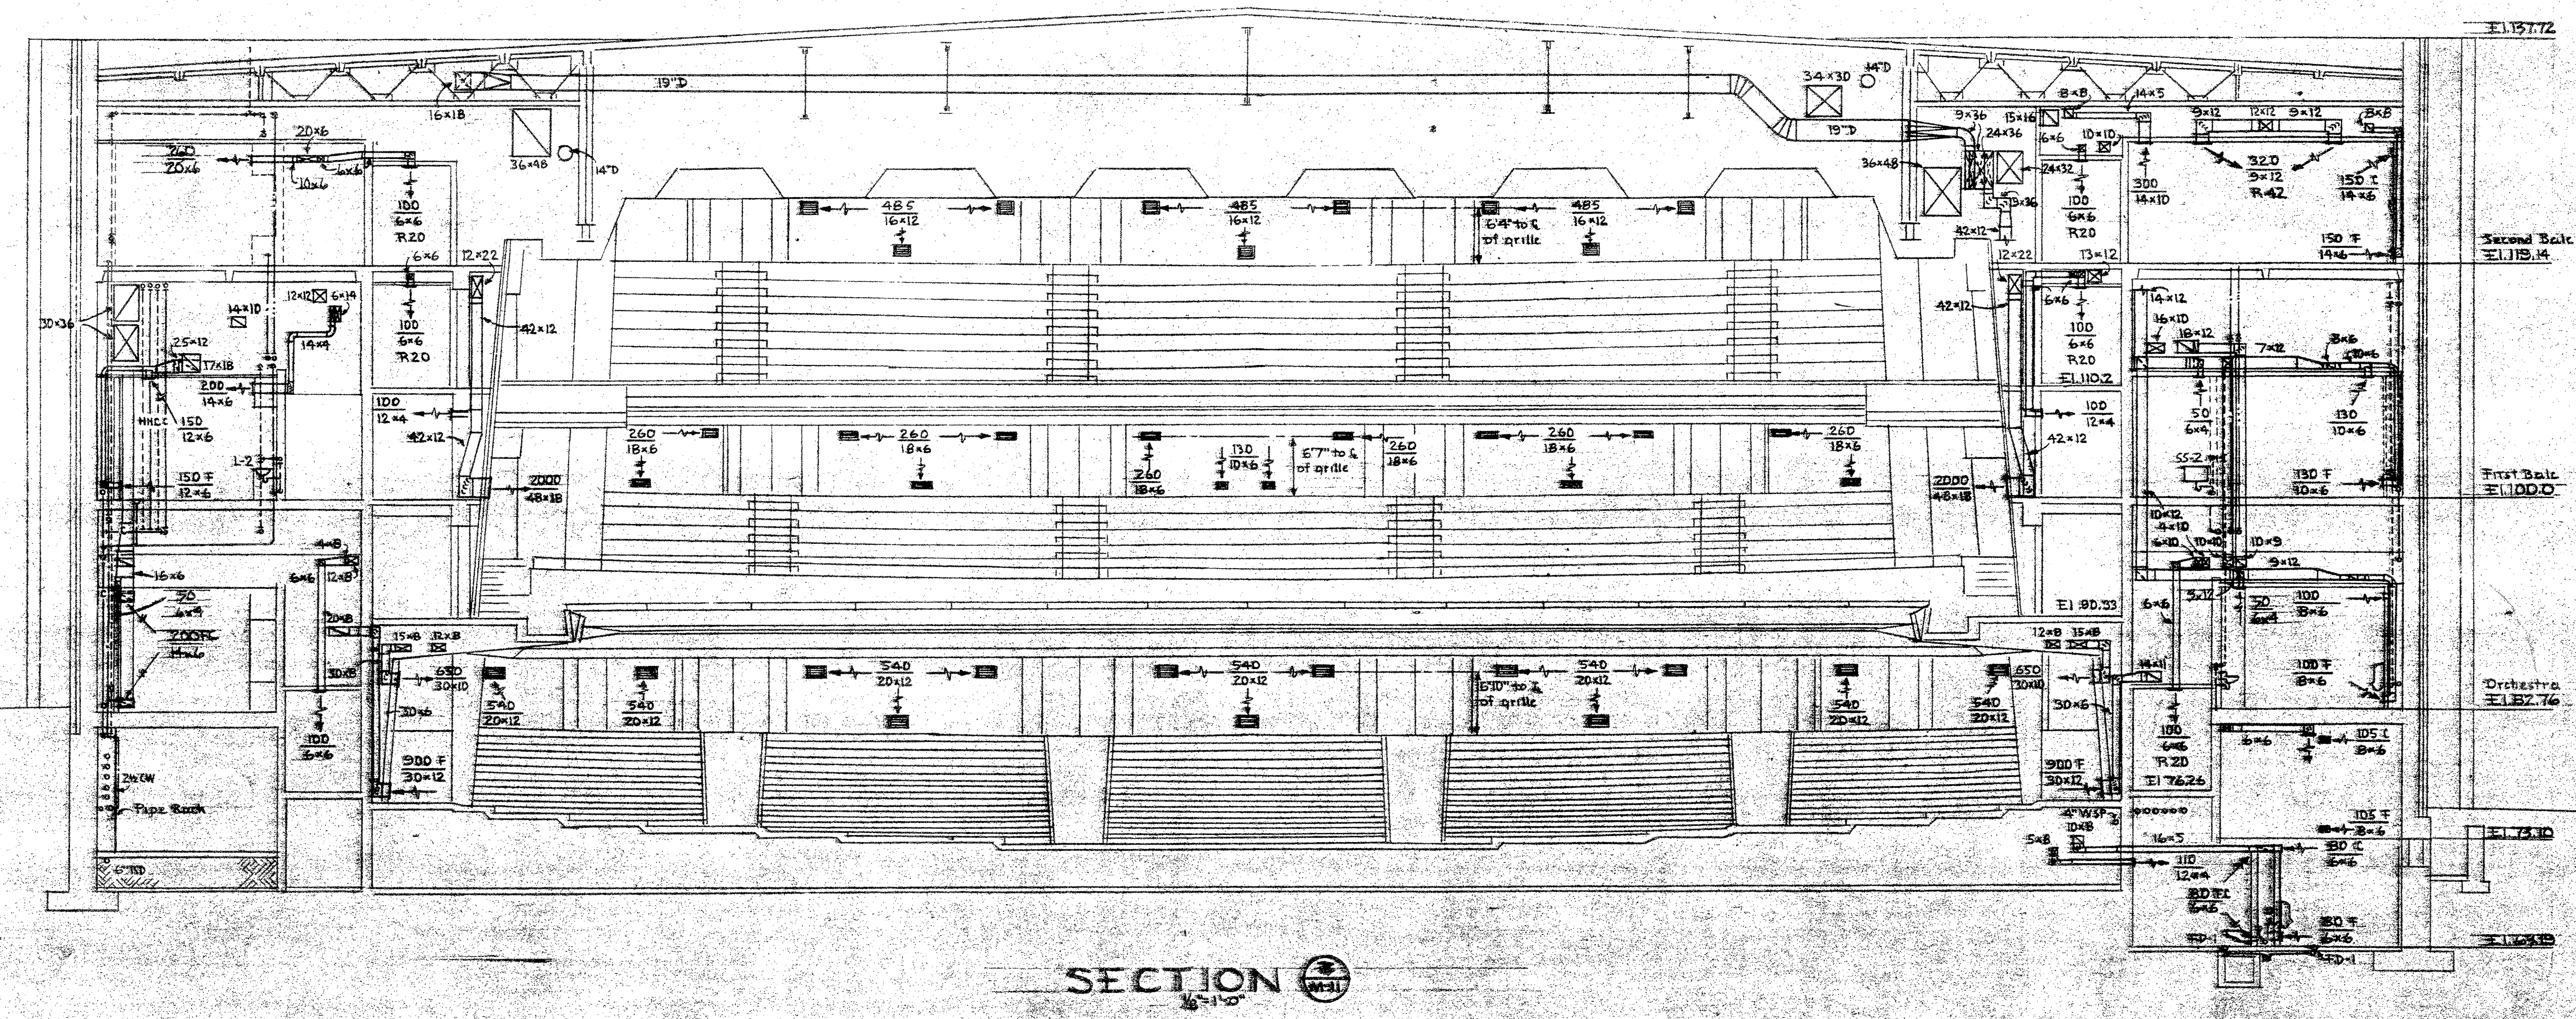


**MECHANICAL BUILDING SECTIONS AND DETAILS**

**REBUILDING OF PORTLAND CIVIC AUDITORIUM**  
 3 W. THIRD AVENUE & CLAY STREET  
 PORTLAND, OREGON  
 CITY OF PORTLAND, OREGON

**ARCHITECTS**  
 STANIOR, BILES, MAGUIRE & CHURCH  
 308 S. W. STARK ST., PORTLAND 4, OREGON  
 PHONE 2-6329

**REGISTERED PROFESSIONAL ENGINEERS**  
 MII  
 308 S. W. STARK ST., PORTLAND 4, OREGON  
 PHONE 2-6329

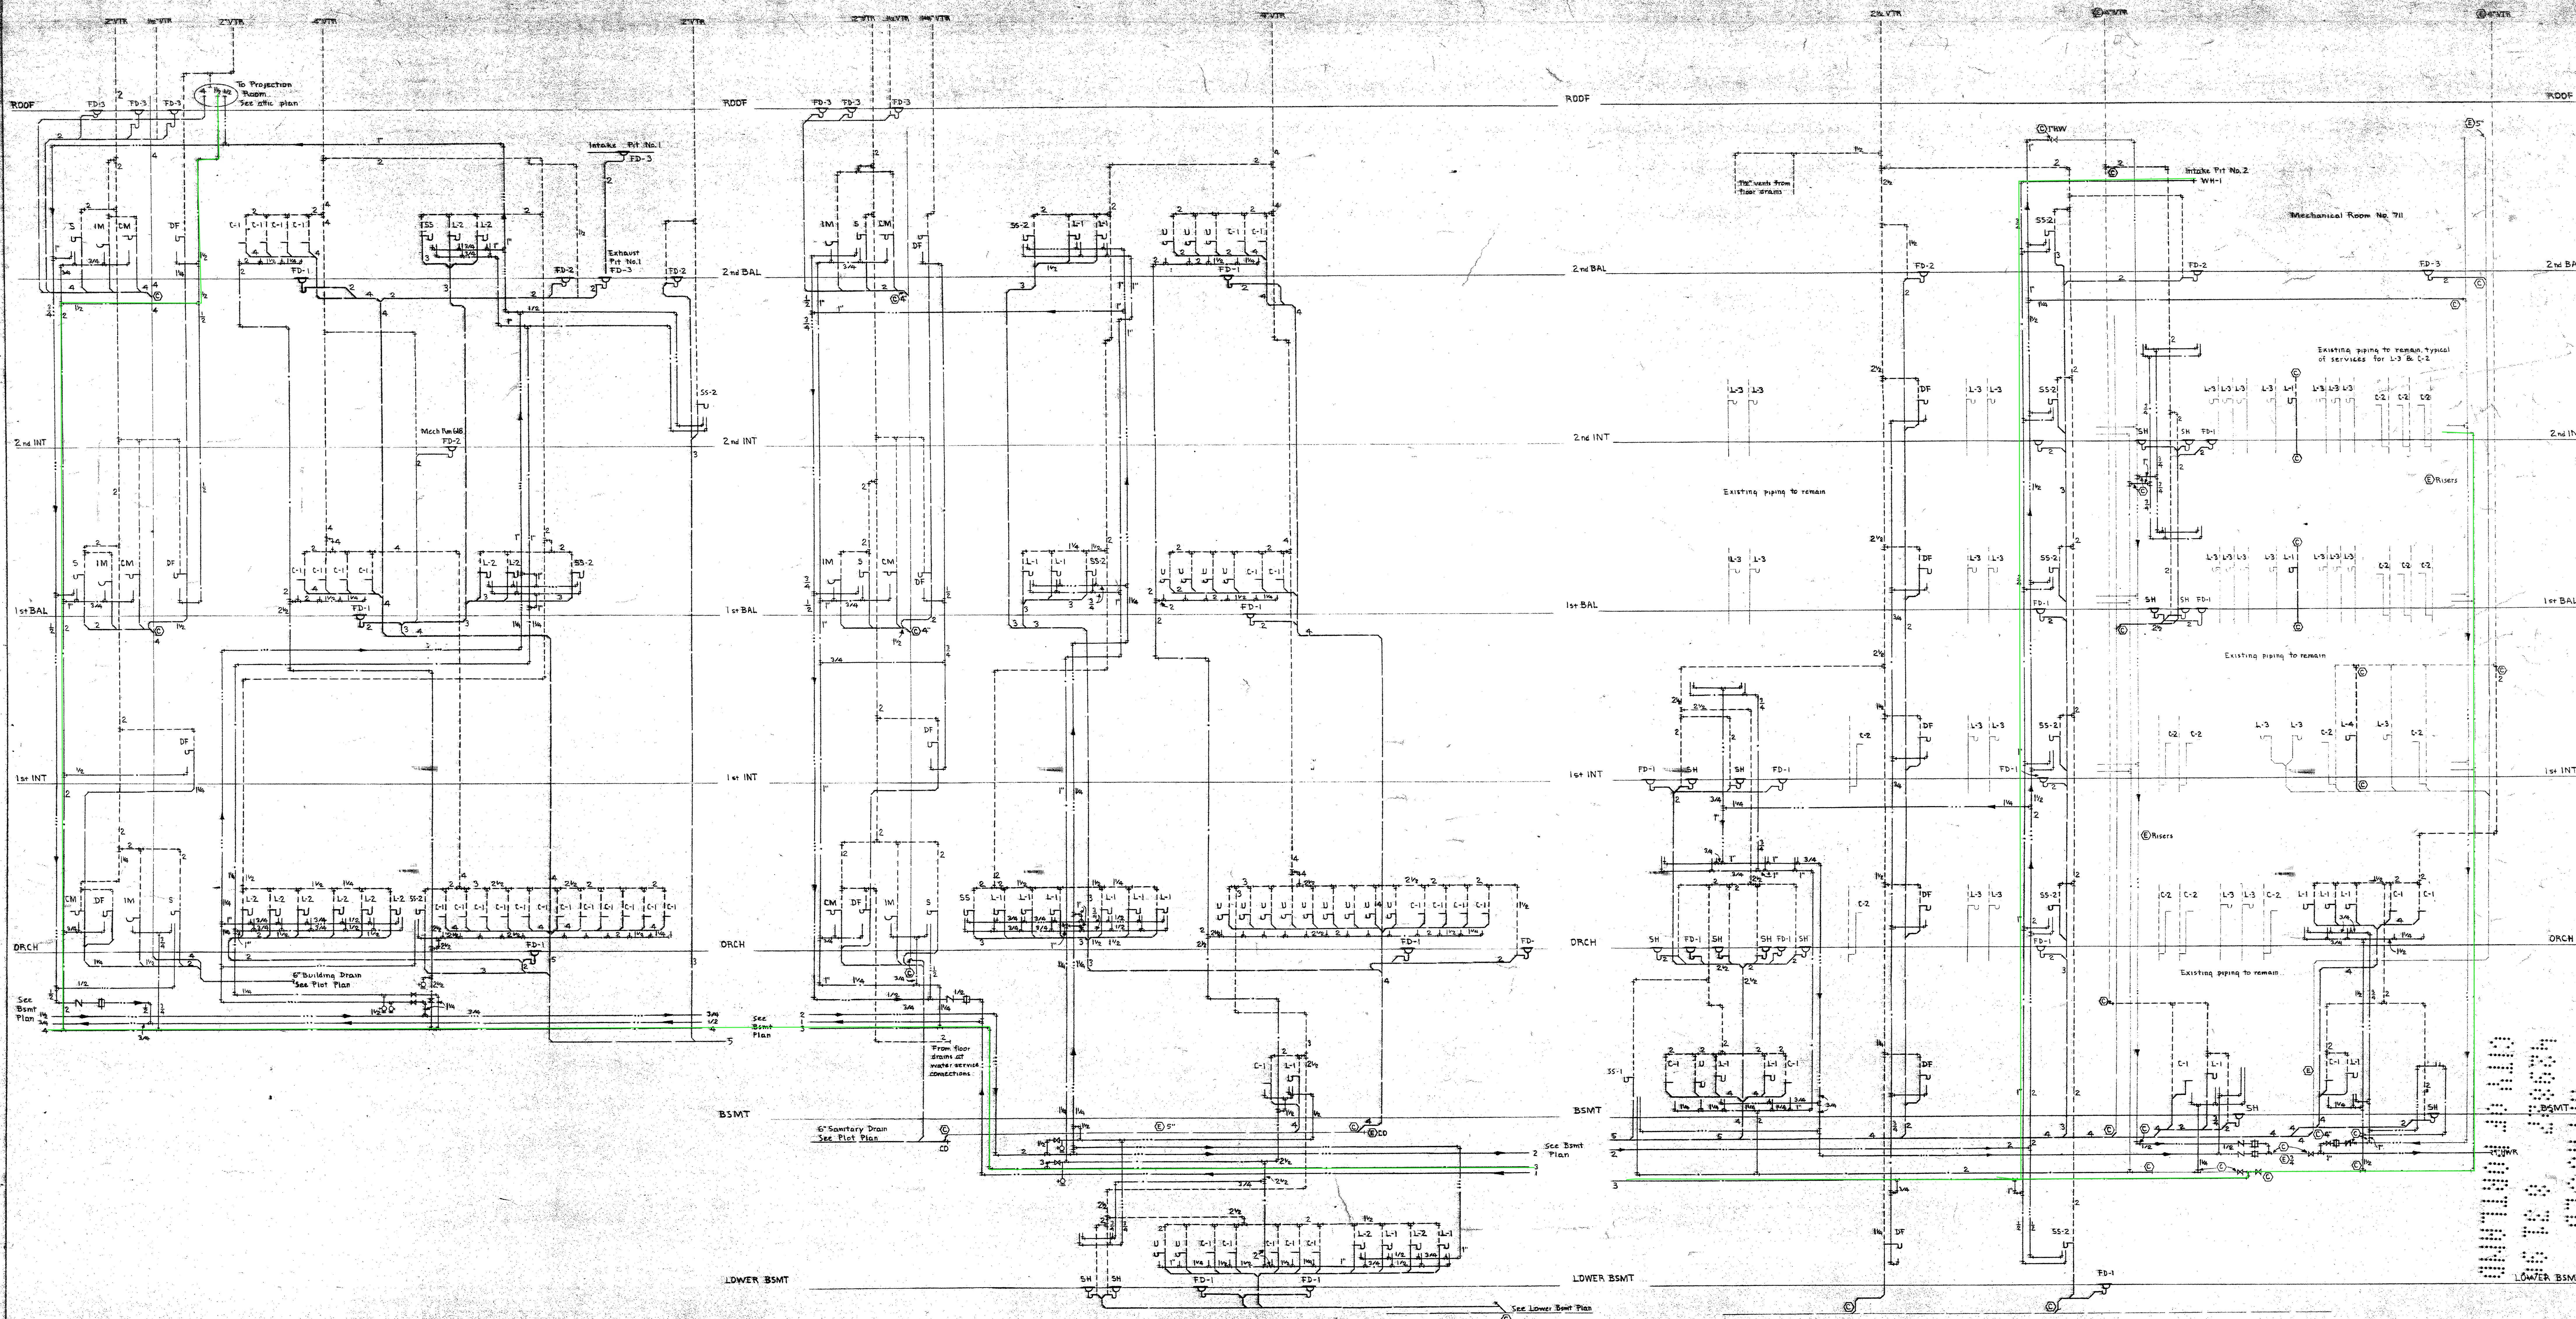


SOUTH SIDE

NORTH SIDE

DRESSING ROOM AREA

PART PLUMBING RISER DIAGRAMS

No scale

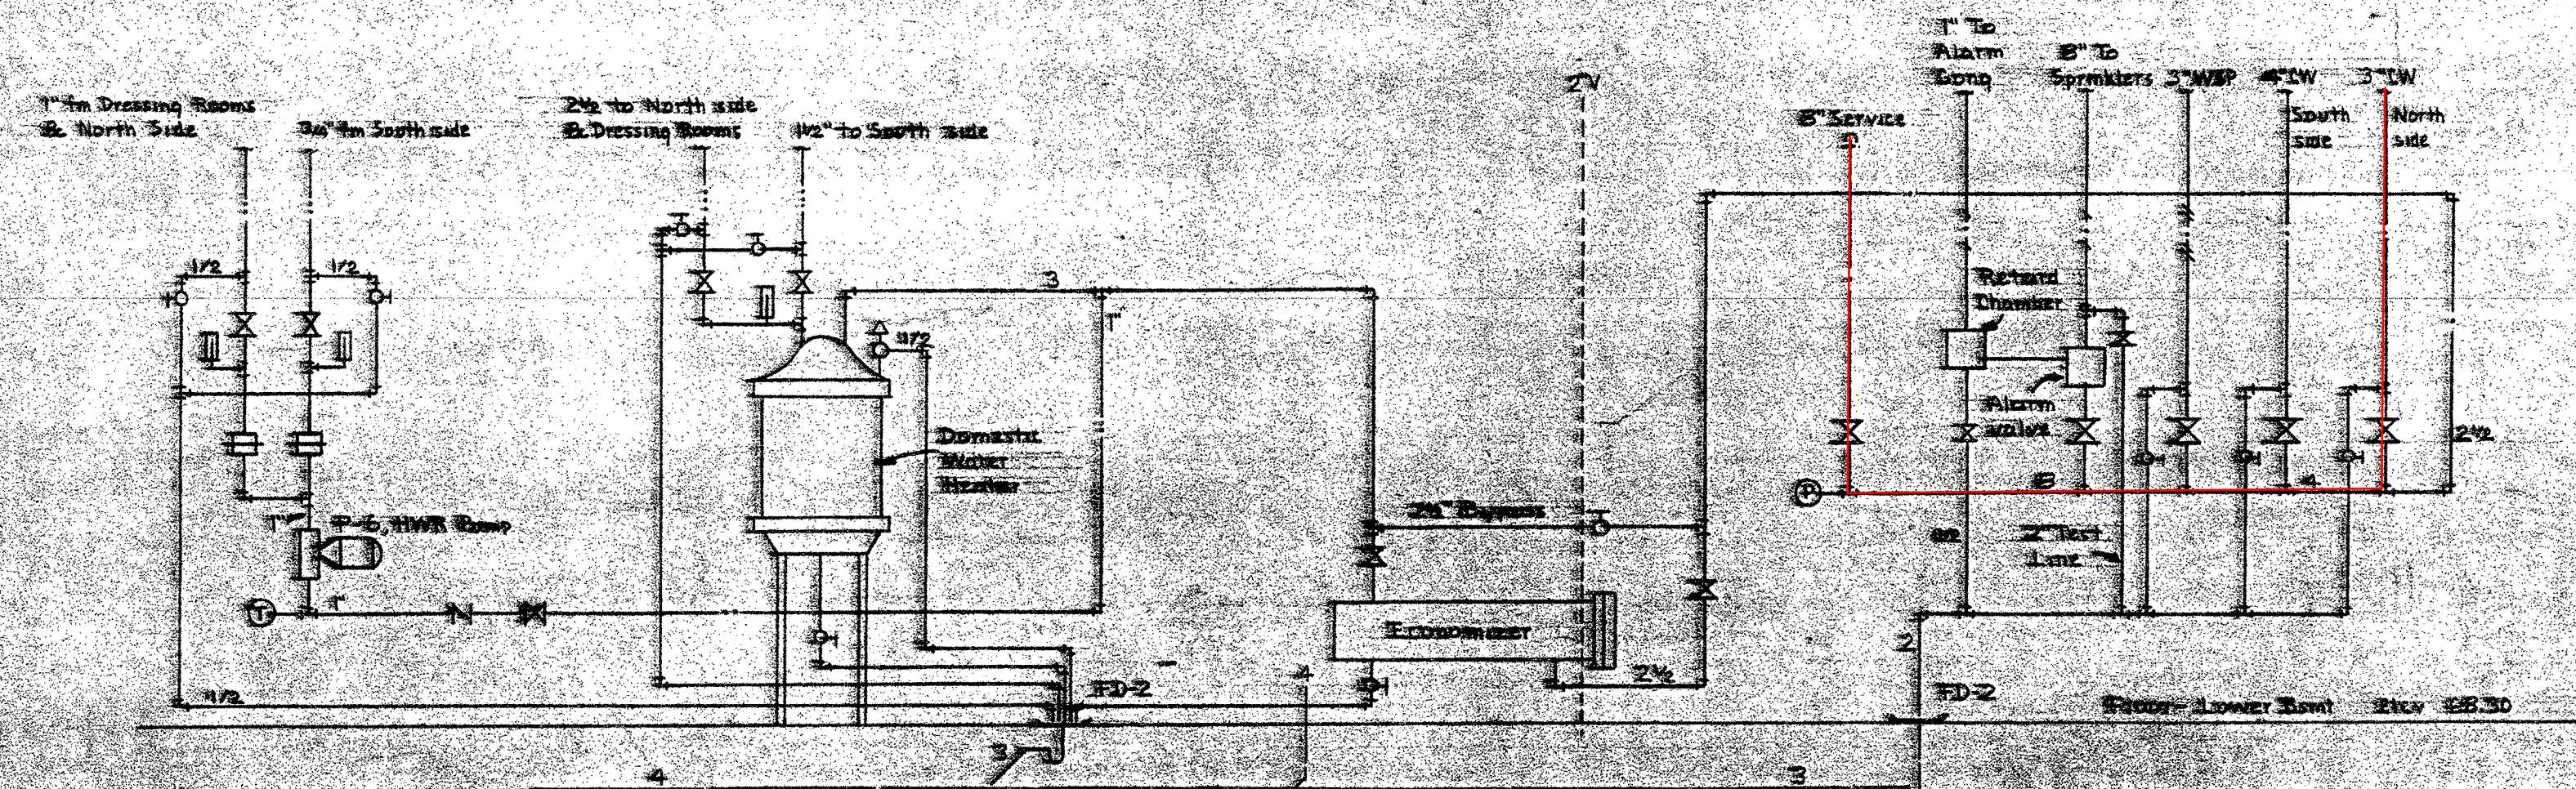

PIPING DIAGRAM - WATER SERVICE CONNECTIONS

No Scale

Note: See Floor Plan of Room 278, Drawings M-2 & M-3



MECHANICAL PLUMBING PIPING DIAGRAMS

**B. MARCUS PRITECA**  
REGISTERED PROFESSIONAL ENGINEER  
MECHANICAL ENGINEER

**PAUL VESSELSEN & ASSOCIATES**  
REGISTERED PROFESSIONAL ENGINEERS  
MECHANICAL ENGINEERS

**COOPER & ROSE & ASSOCIATES**  
REGISTERED PROFESSIONAL ENGINEERS  
MECHANICAL ENGINEERS


**J. DONALD KROBBER & ASSOCIATES**  
REGISTERED PROFESSIONAL ENGINEERS  
MECHANICAL ENGINEERS

**GRANT KEELEY & ASSOCIATES**  
REGISTERED PROFESSIONAL ENGINEERS  
MECHANICAL ENGINEERS


**ALVA EDWELL, A.B.D.**  
REGISTERED PROFESSIONAL ENGINEER  
MECHANICAL ENGINEER

**REBUILDING OF PORTLAND CIVIC AUDITORIUM**  
S. W. THIRD AVENUE & CLAY STREET  
FOR  
CITY OF PORTLAND OREGON

**STANTON, BOLES, MAGUIRE & CHURCH ARCHITECTS**  
208 S. W. STARK ST., PORTLAND 4, OREGON  
DRAWN: M-12  
DATE: MAY 24 1953

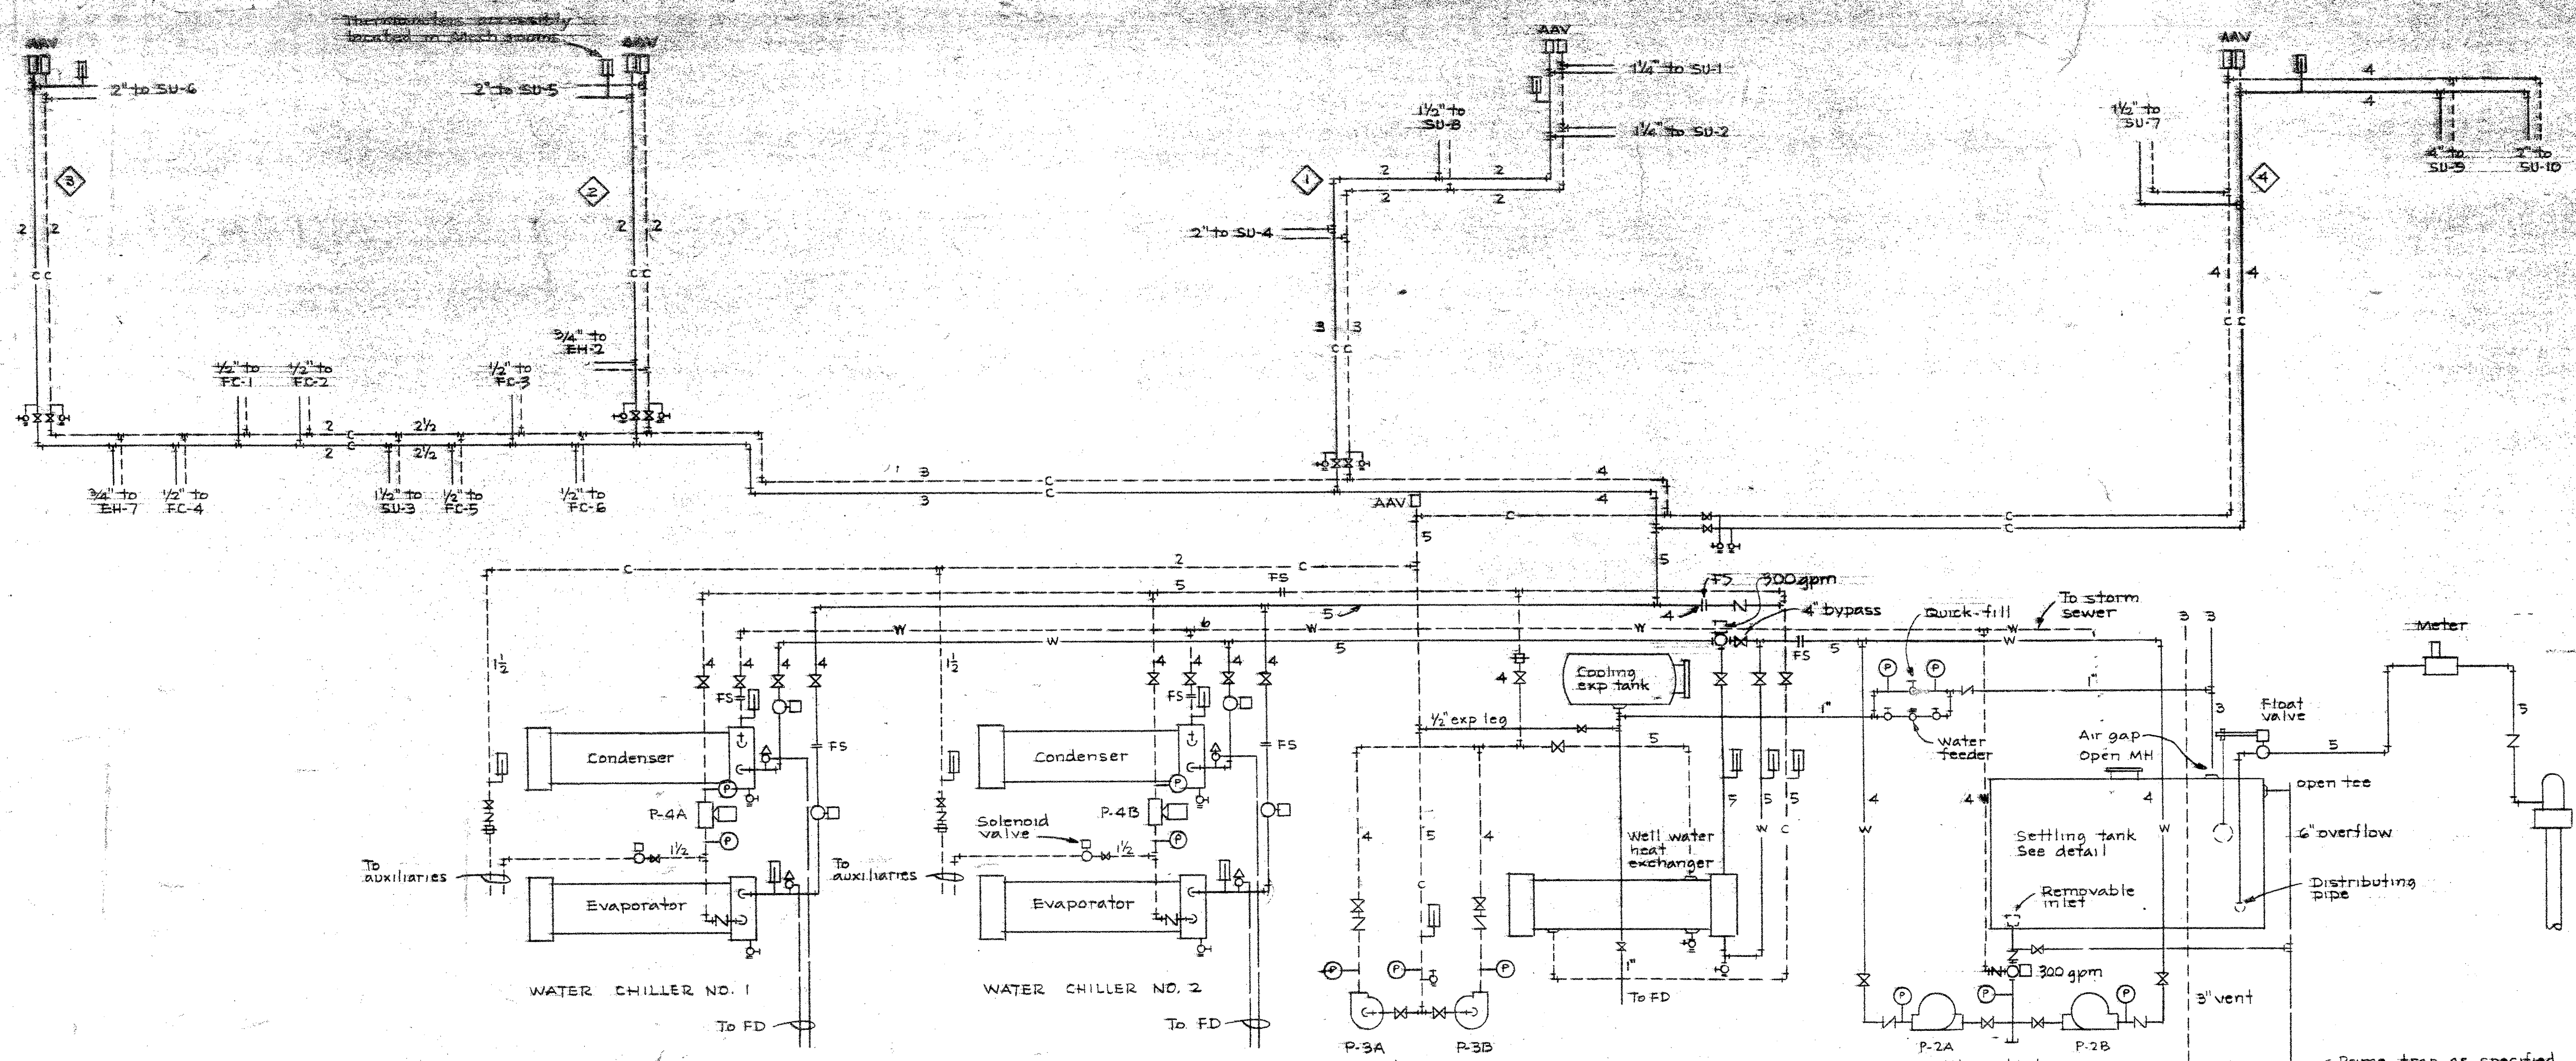


**COOLING SYSTEM PIPING DIAGRAM**  
No Scale  
Notes: Pipe sizes shown for branch piping to equipment are for both supply and return.

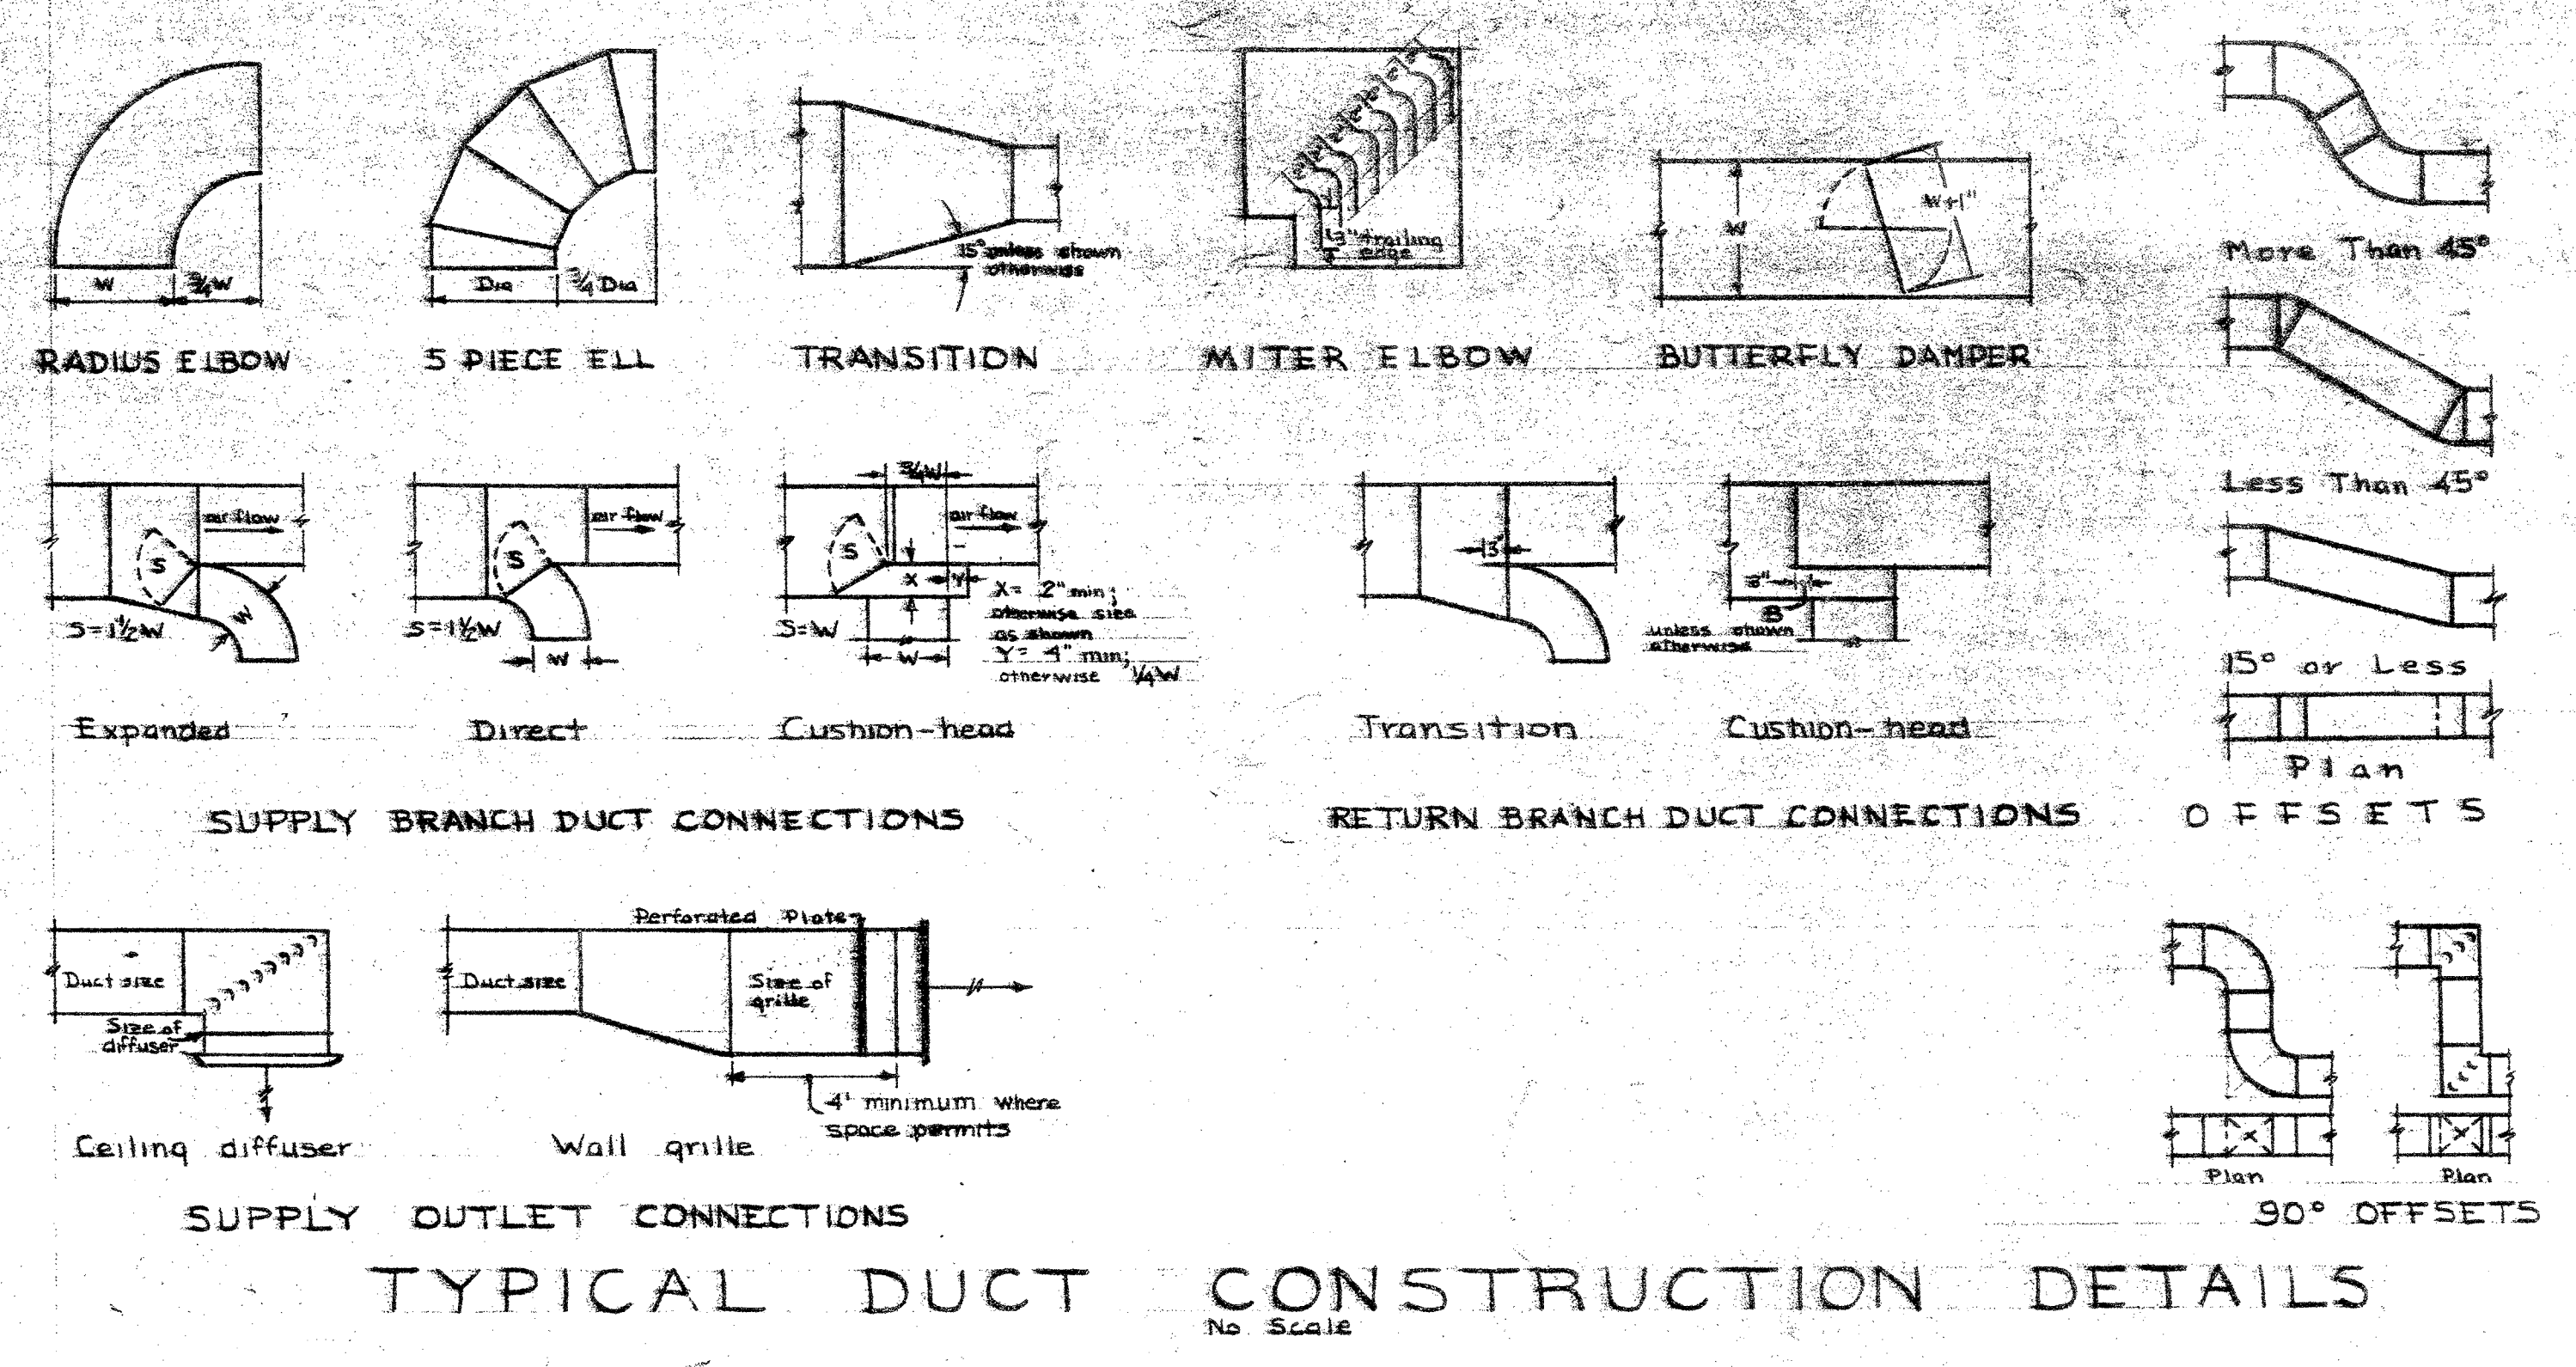


**TYPICAL DUCT CONSTRUCTION DETAILS**  
No Scale

**MIXING DAMPER SCHEDULE**


UNIT ZONE	CFM	Damper Width	Dimensions (inches)		Length	TYPE	Room Thermostat Location
			X (Warm)	Y (Cool)	L		
SU-7							
1	610	14	12	12	22	C	705
2	700	10	14	14	22	C	202
3	1000	16	16	16	22	C	306
4	1000	16	14	14	22	C	40
5	750	8	18	18	22	C	424
6	1100	17	14	14	22	C	506
7	780	9	18	18	22	C	608
8	1280	14	18	18	22	C	708
SU-8							
1	1860	22	17	14	22	C	346
2	1250	19	14	14	22	C	532
3	720	14	14	14	22	C	722
4	800	14	14	14	22	C	421
SU-9							
1	6700	32	18	32		A	340
2	7500	38	18	32		A	525
3	750	18	18	26		A	609
4	3750	24	18	32		A	715
5	8250	34	18	32		A	340
6	2500	17	18	32		A	540
7	8250	34	18	32		A	540
8	2500	17	18	32		A	540
SU-10							
1	1350	14	12	16		B	107
2	2875	21	17	30		B	410
3	3900	20	30	30		B	212

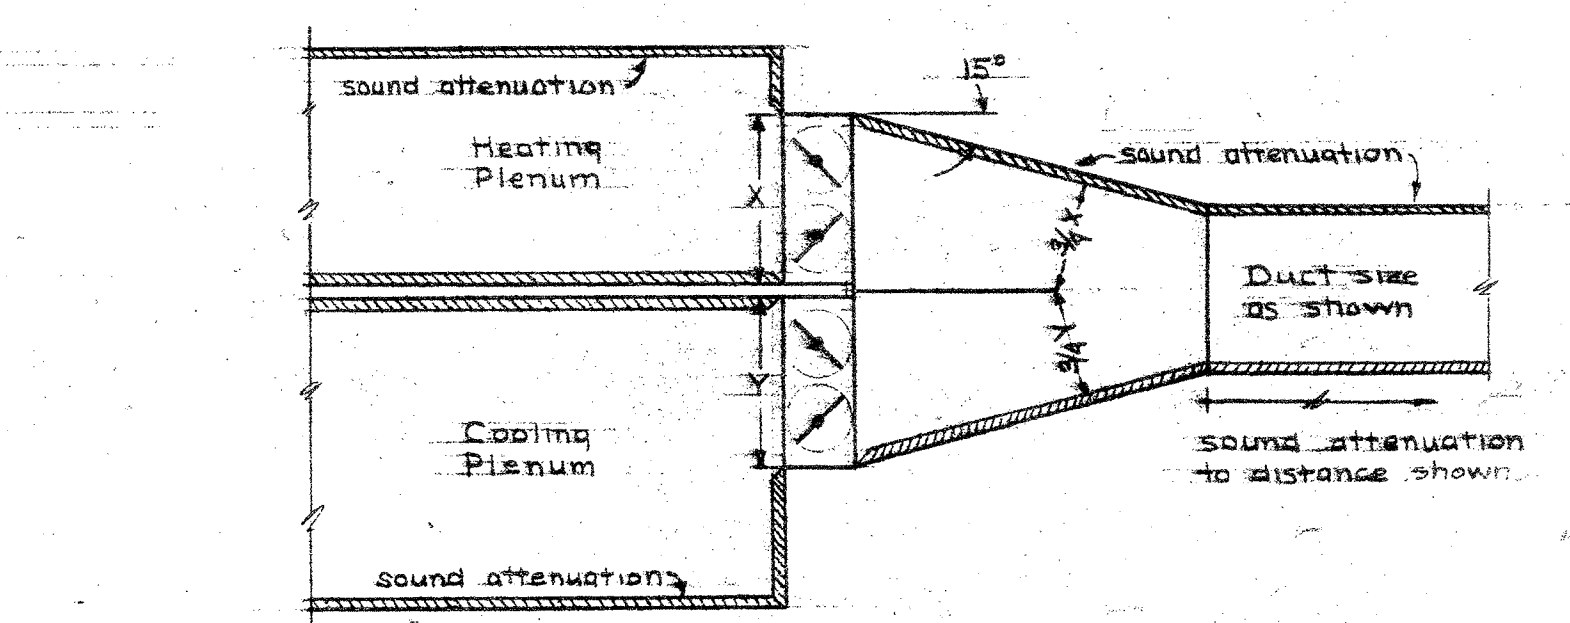


**MIXING DAMPERS**  
No Scale

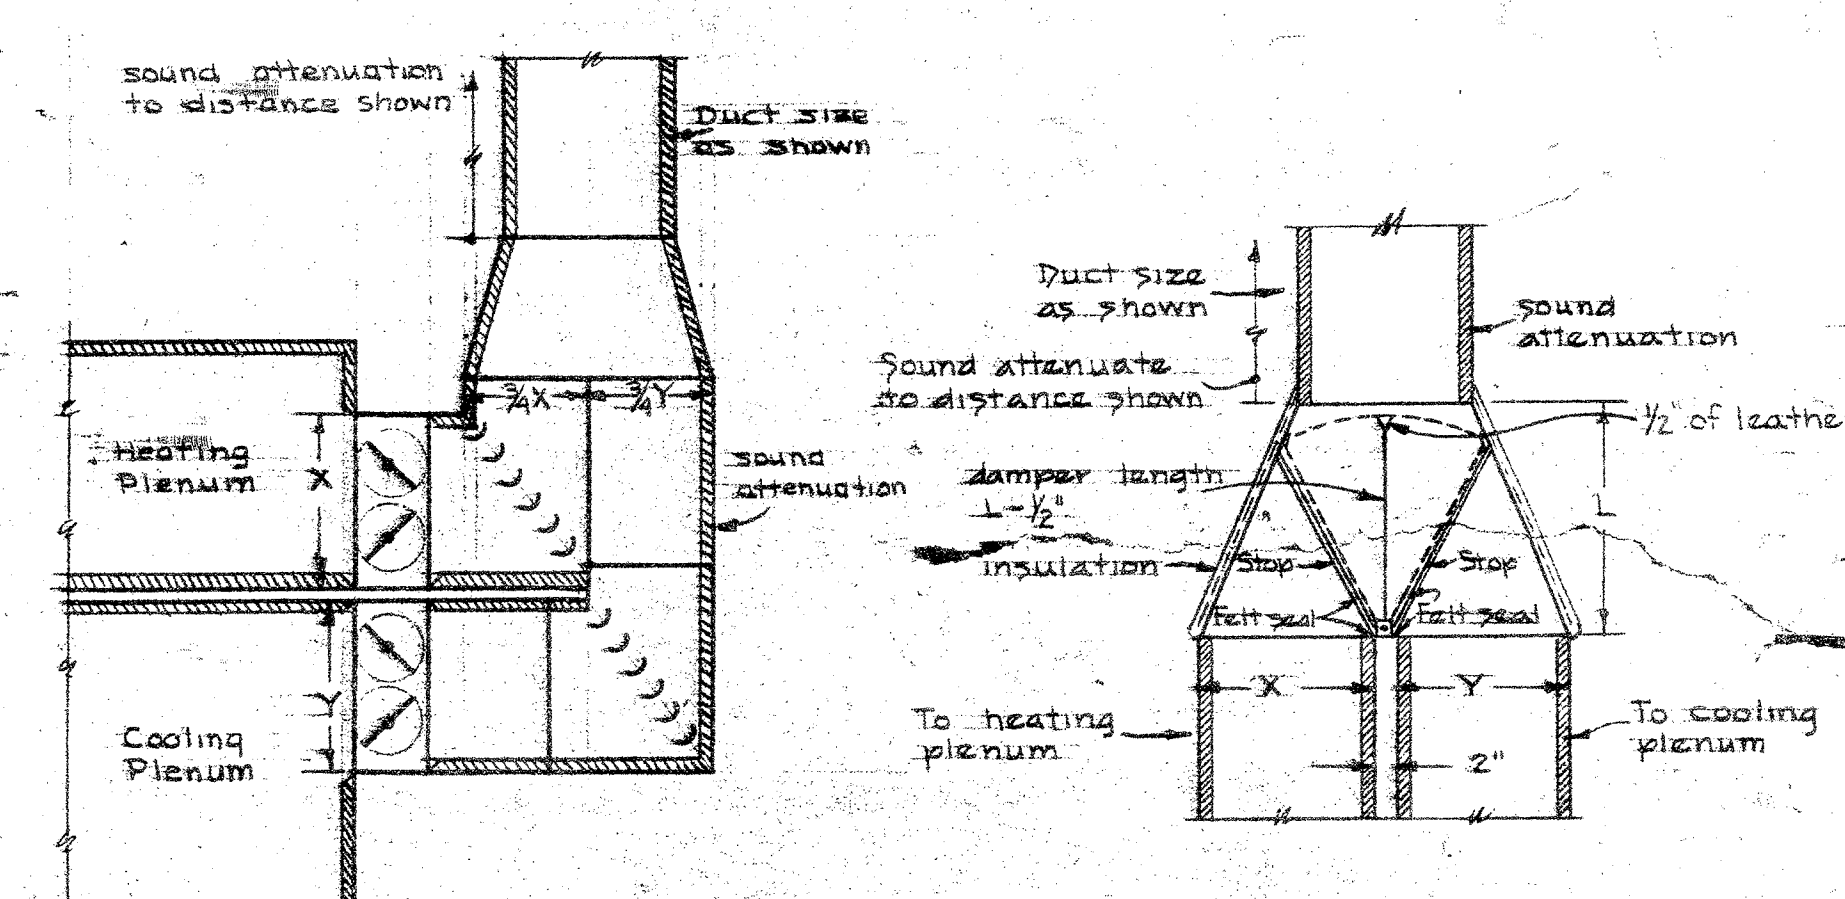


**MIXING DAMPERS**  
No Scale

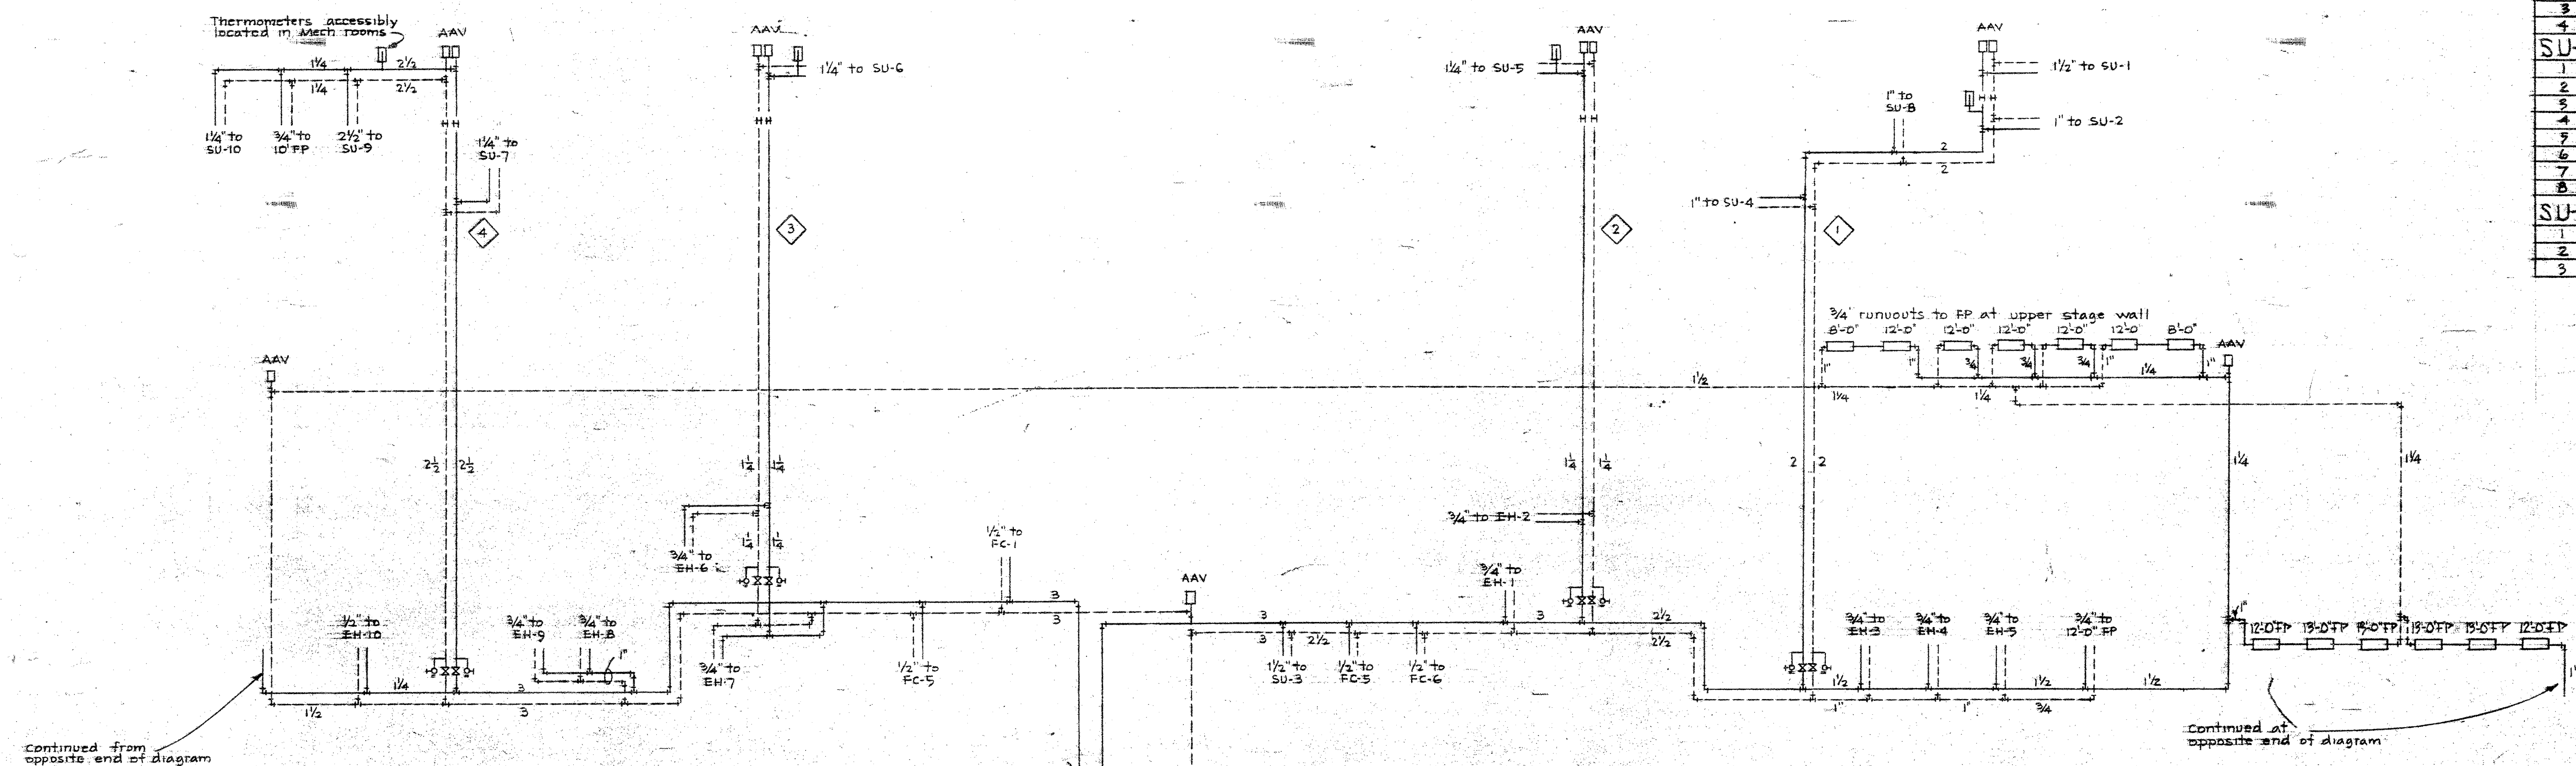


**HEATING SYSTEM PIPING DIAGRAM**  
No Scale  
Notes: Pipe sizes shown for branch piping to equipment are for both supply and return.

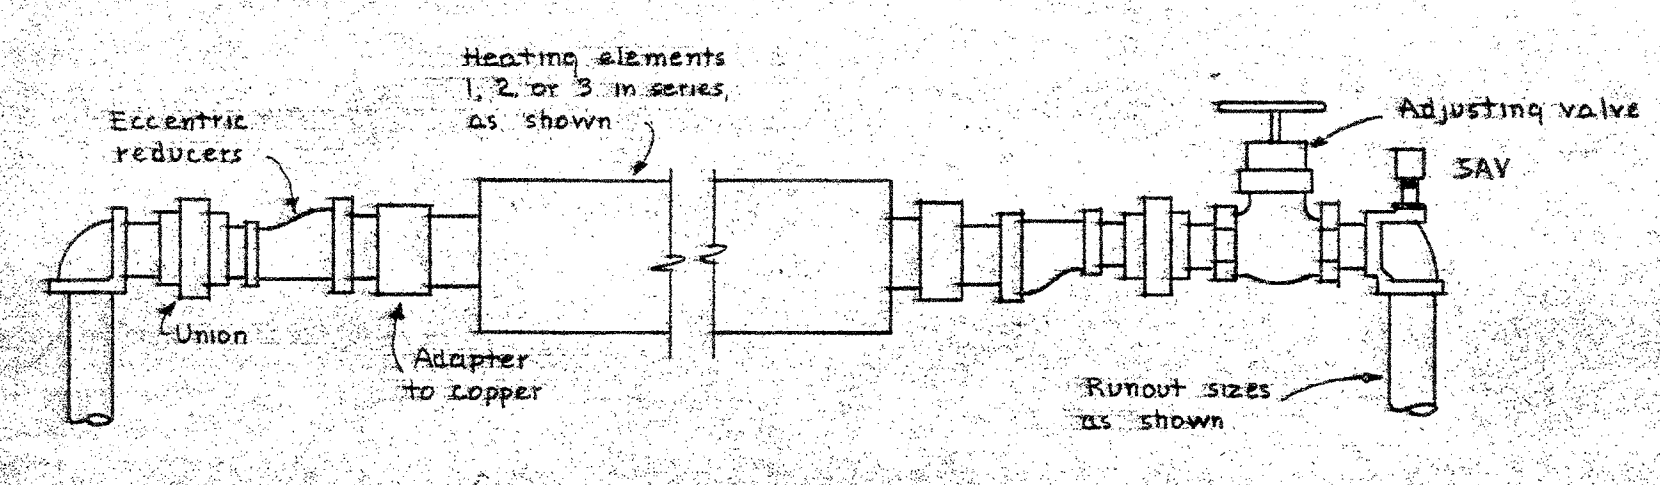

**TYPICAL FP CONNECTIONS**  
No Scale

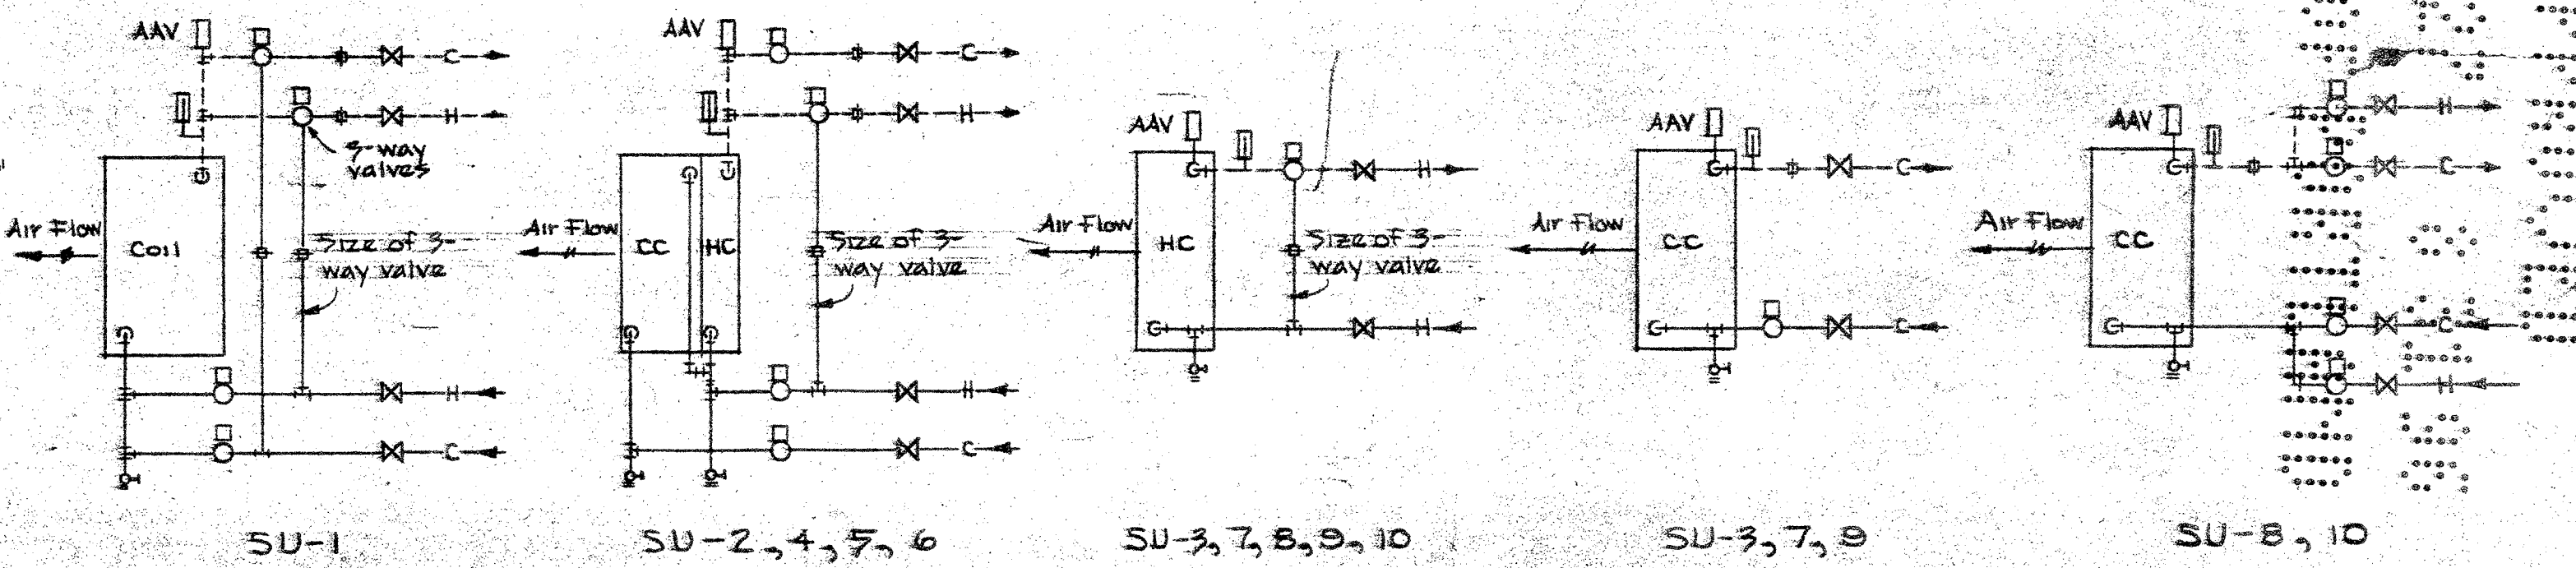


**COIL PIPING DIAGRAMS**  
No Scale

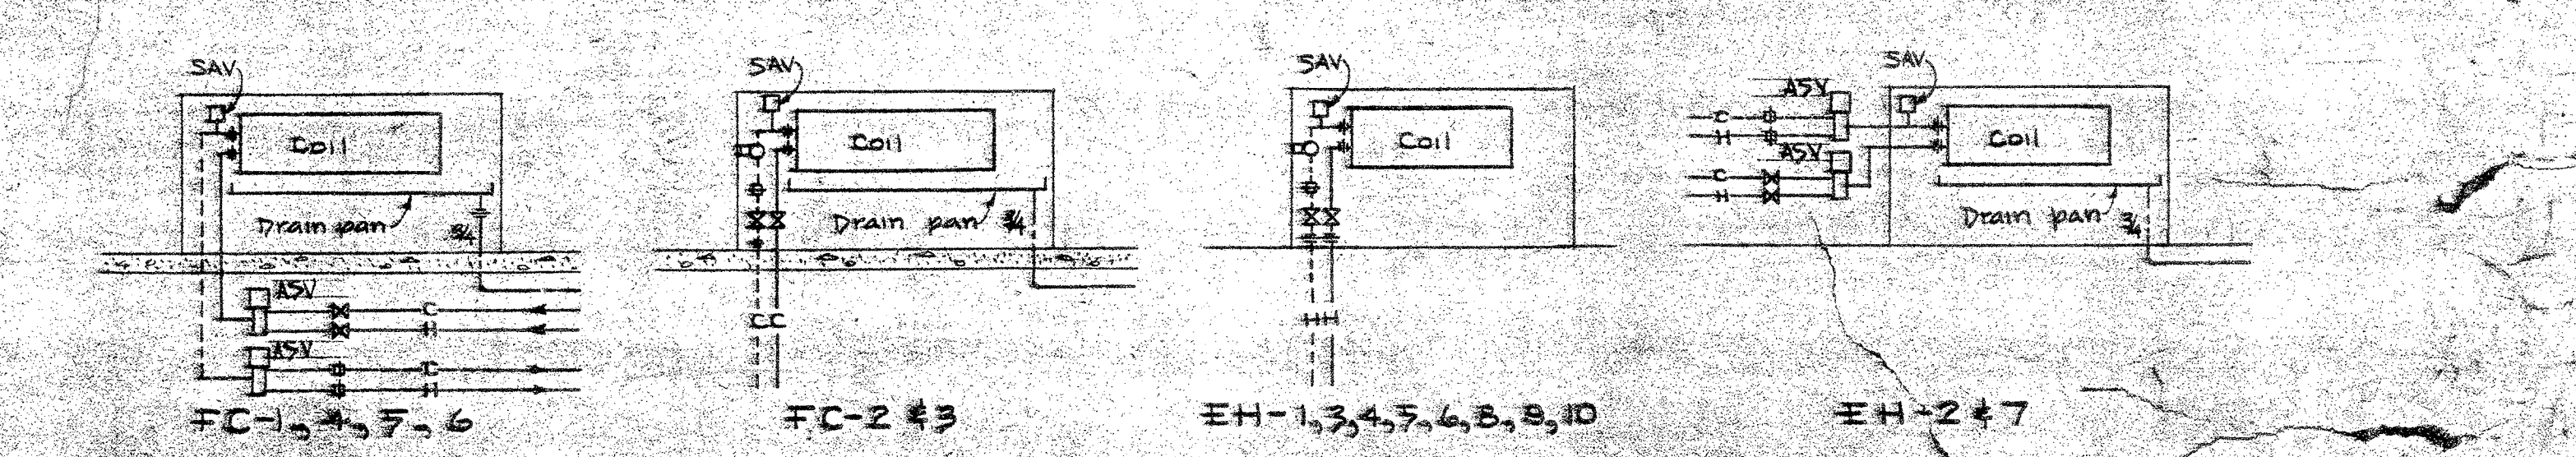


**FAN COIL UNIT PIPING DIAGRAMS**  
No Scale


**ENTRY HEATER PIPING DIAGRAMS**  
No Scale

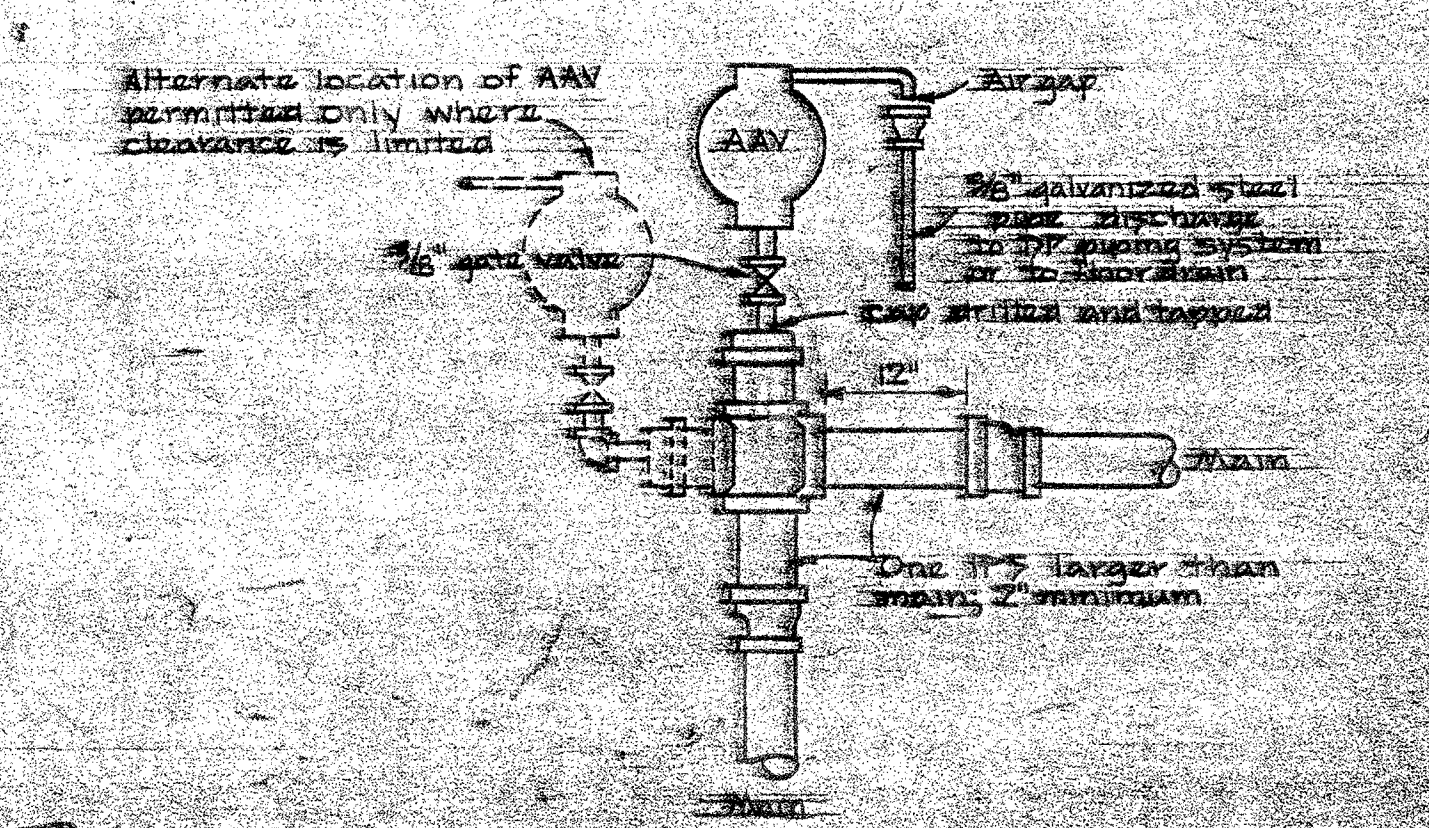

**TYPICAL AAV DETAIL**  
No Scale

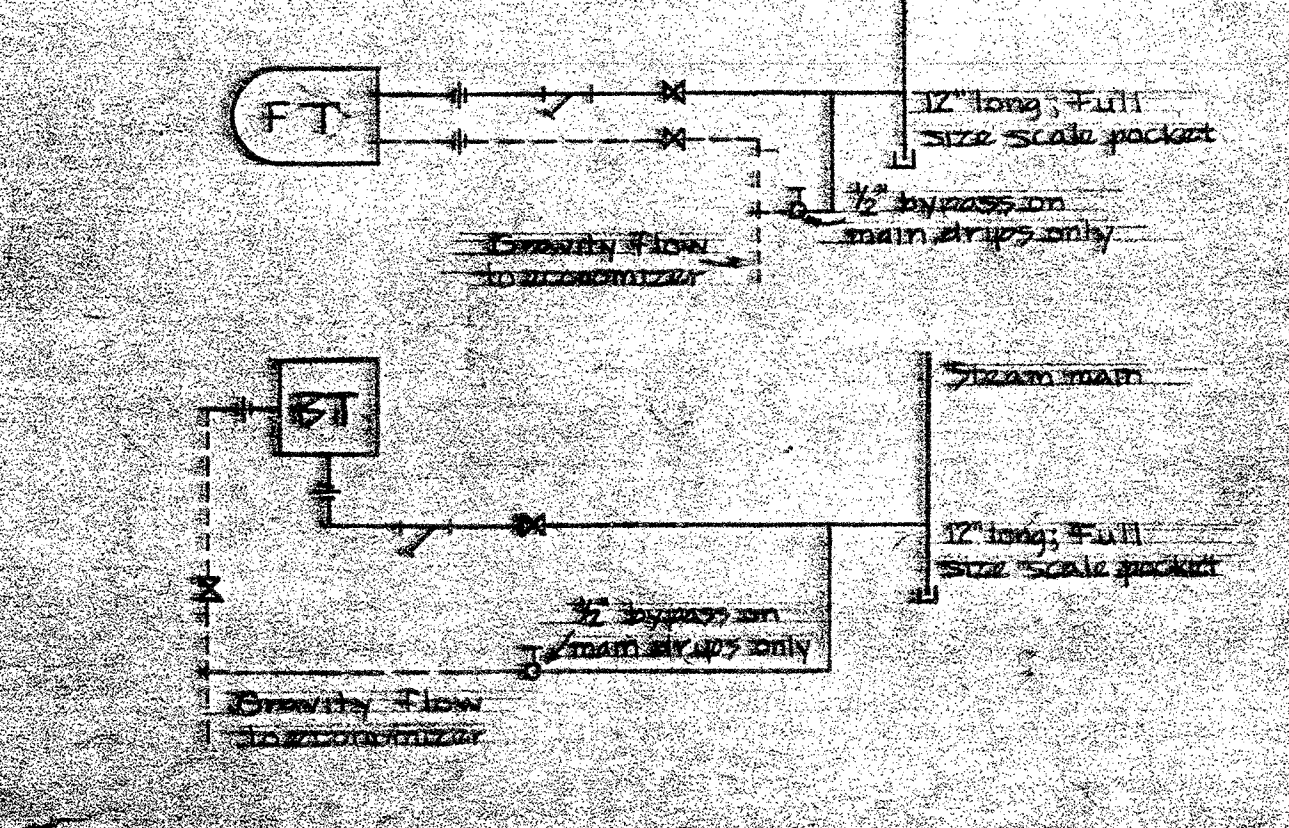

**TYPICAL STEAM TRAP PIPING DIAGRAMS**  
No Scale

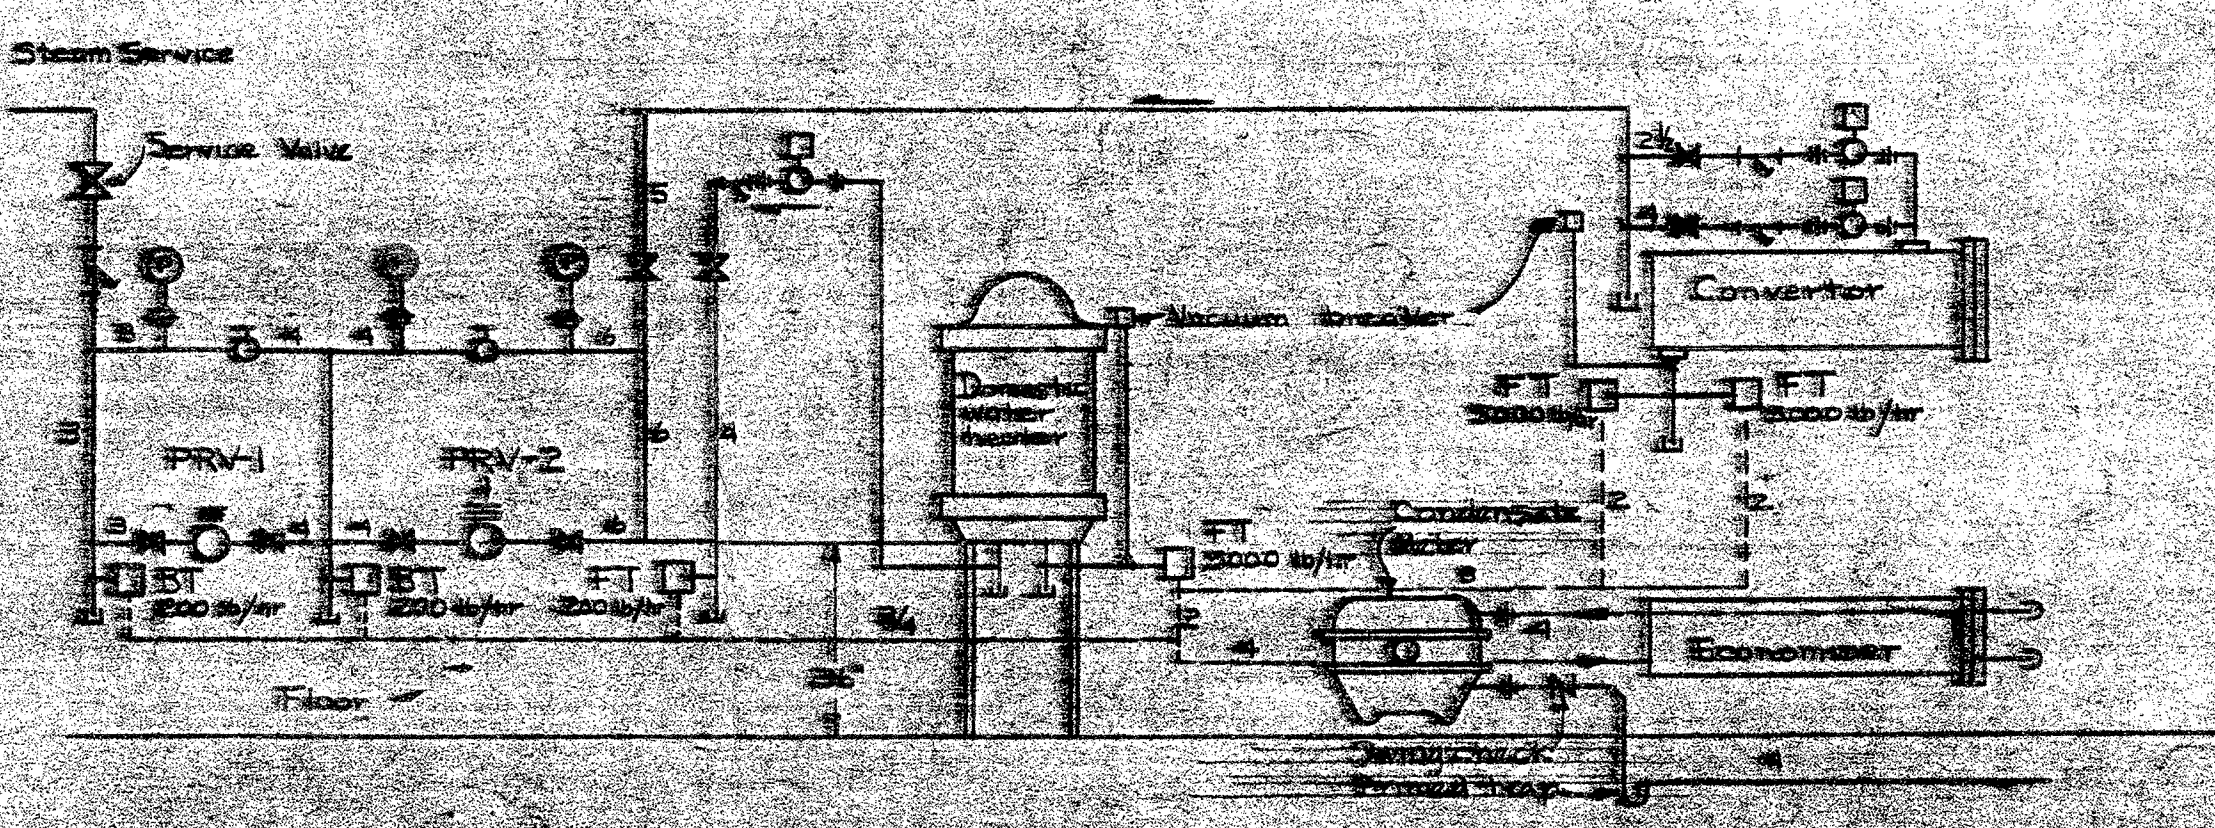

**STEAM AND CONDENSATE SYSTEM PIPING DIAGRAM**  
No Scale  
Notes: All condensate piping to be done by the contractor member by specialty.

**MECHANICAL HEATING AND COOLING PIPING DIAGRAMS & DUCT DETAILS**

**B. MARCUS FREIDA ARCHITECT**  
MARCUS FREIDA & ASSOCIATES  
MECHANICAL ENGINEERS  
1000 BROADWAY, NEW YORK, N.Y. 10018  
TELEPHONE: (212) 691-1000

**REBUILDING OF PORTLAND CIVIC AUDITORIUM**  
100 BROAD AVENUE, 4TH FLOOR  
NEW YORK, N.Y. 10002  
CITY OF PORTLAND DESIGN

**STANTON BOLES MARSHRE & BROWN ARCHITECTS**  
300 N. 3RD ST., PORTLAND, OREGON  
503-241-1000

**DATE: MAY 24 1988**

