

ABBREVIATIONS		PLUMBING AND HVAC PIPING		HVAC DUCT SYMBOLS		DRAWING SCHEDULE	
AC	PACKAGED ROOFTOP AC UNIT	ID	INSIDE DIAMETER	ELBOW		M0.1	LEGEND - MECHANICAL
AD	ACCESS DOOR	LBS	POUNDS	TEE		M2.1	PARTIAL FLOOR PLANS - HVAC - DEMOLITION
AF	ABOVE FINISHED FLOOR	LH	LATENT HEAT	CAP		M3.1	DETAILS - HVAC
AFU	AIR HANDLING UNIT	IN	INCHES	FLOW INDICATOR		M4.1	SCHEDULES - HVAC
ARI	AMERICAN REFRIGERATION INSTITUTE	KW	KILOWATT	GLOBE VALVE		P2.1	FLOOR PLAN - PLUMBING
B	BOILER	LWT	LEAVING WATER TEMPERATURE	CHECK VALVE		P2.2	DETAILS AND SCHEDULES - PLUMBING
BDD	BACKDRAFT DAMPER	MAU	MAKE-UP AIR UNIT	PRESSURE REDUCING VALVE			
BFP	BACKFLOW PREVENTOR	MAX	MAXIMUM	QUARTER TURN VALVE (BALL OR BUTTERFLY)			
BFF	BELOW FINISHED FLOOR	MBH	THOUSAND BTU PER HOUR	THERMOMETER			
BHP	BRAKE HORSE POWER	MD	MOTORIZED DAMPER	PRESSURE GAUGE W/COCK			
CC	COOLING COIL	MH	MOUNTING HEIGHT	AUTOMATIC AIR VENT			
CD	CEILING DIFFUSER	MN	MINIMUM	MANUAL AIR VENT			
CF	CONDENSATE DRAIN	MS	MAKE-UP WATER	CONCENTRIC REDUCER			
CFM	CUBIC FEET PER MINUTE	MW	MAKE-UP WATER	ECCENTRIC REDUCER			
CH	CHILLED WATER RETURN	N/A	NOT APPLICABLE	PIPE GUIDE			
CHRS	CHILLED WATER SUPPLY	NC	NOISE CRITERIA	TEST PORT (PETE'S PLUG, OR EQUAL)			
CI	CENTRIFUGAL COMPRESSOR	NIC	NOT IN CONTRACT	FLEXIBLE CONNECTOR			
CO	CARBON MONOXIDE	NLL	NIGHT LOW LIMIT	T & P RELIEF VALVE (W/ PIPE TO DRAIN)			
CO2	CARBON DIOXIDE	NO	NUMBER	SHOCK ABSORBER			
COEFF.	COEFFICIENT OF PERFORMANCE	NO2	NORMALLY OPEN	BACKFLOW PREVENTOR			
CONT.	CONTINUATION	NTS	NOT TO SCALE	WATER METER			
CPR	AIR COMPRESSOR	OD	OPPOSED BLADE DAMPER	HOSE BIBB			
CR	CONDENSATE RETURN	OC	ON CENTER	STRAINER			
CRU	SPLIT SYSTEM COMPUTER ROOM UNIT	ODD	OUTSIDE DIAMETER	UNION			
CT	CONDENSING TOWER	ODS	SPLIT SYSTEM HEAT PUMP (OUTDOOR)	PUMP			
CU	CONDENSING UNIT	OSA	OUTSIDE AIR	PIPE ANCHOR			
CUH	CABINET UNIT HEATER	P	PUMP	PRESSURE RELIEF VALVE			
CV	CHECK VALVE	PA	PAINT SPRAY BOOTH	FLOOR CLEAN OUT			
CVF	VALVE FLOW COEFFICIENT	PCRU	PACKAGED COMPUTER ROOM UNIT	CLEAN OUT - EXPOSED			
OW	COLD WATER	PD	PRESSURE DROP	WALL CLEAN OUT			
CWR	CONDENSOR WATER RETURN	PH	PHASE	CLEAN OUT TOP TO GRADE			
CWS	CONDENSOR WATER SUPPLY	PHM	PROJECT MANAGER	FLOOR DRAIN			
D	DUCT DROP	PHV	PRESSURE REDUCING VALVE	ROOF DRAIN			
DB	DECEASED	PS	POUNDS PER SQUARE INCH	FLOOR SINK			
DC	DUCT COLLECTOR	PTAC	PACKAGED TERMINAL AC UNIT	CATCH BASIN			
DD	DUCT DRAIN	PTHF	PACKAGED TERMINAL HEAT PUMP	BALANCING VALVE (CIRCUIT SETTER, OR EQUAL)			
DE	DUCT HEATER	QTY	QUANTITY	MOTORIZED VALVE, 2 WAY			
DH	DUCT HEATER	R	DUCT RISE	EXPANSION TANK			
DHU	DEHUMIDIFIER	RA	RETURN AIR	FLOW METER			
DIA	DIAMETER	RET	RETURN	FLOW SWITCH			
DN	DOWN	RF	RETURN FAN	EXPANSION JOINT			
DP	DEW POINT	RH	RELATIVE HUMIDITY	AIR SEPARATOR			
DSH	DOWN SPOUT NOZZLE	RL	REFRIGERANT LIQUID	TEMPERATURE SENSOR			
DX	DIRECT EXPANSION	RLD	RELIEF DAMPER	TEE WITH RISER			
EA	EXHAUST AIR	RPM	REVOLUTIONS PER MINUTE	TEE WITH DROP			
EAT	ENTERING AIR TEMPERATURE	RS	REFRIGERANT SUCTION	RISER UP FROM TEE			
EDH	EXHAUST DUCT HEATER	S	SANITARY	DROP FROM TEE			
EE	ENERGY EFFICIENCY RATING	SA	SUPPLY AIR	VERTICAL OFFSET			
EF	EXHAUST FAN	SAO	SMOKE DETECTOR	RISER UP FROM ELBOW			
EFL	ELEVATION	SEER	SEASONAL ENERGY EFFICIENCY RATING	DROP FROM ELBOW			
ELECT	ELECTRICAL	SF	SQUARE FEET	PRESSURE SENSOR			
ET	EXPANSION TANK	SFP	SUPPLY FAN	MOTORIZED VALVE, 3 WAY			
EW	ELECTRIC WALL HEATER	SH	SENSIBLE HEAT	CONTINUATION			
EWT	ENTERING WATER TEMPERATURE	SHV	SHUT OFF VALVE				
EXH	EXHAUST	ST	STORAGE TANK				
F	FAN	ST	SOUND TRAP				
FA	FACE AREA	SP	STATIC PRESSURE				
FAP	FAN POWERED BOX	SST	SATURATED SUCTION TEMPERATURE				
FC	FLEXIBLE CONNECTOR	SSM	STEAM				
FCD	FLOOR CLEANOUT	T	TEMPERATURE				
FD	FIRE DAMPER	TD	TEMPERATURE DIFFERENCE				
FF	FLOOR FINISH	TEMP	TEMPERATURE				
FLA	FULL LOAD AMPS	TF	TRANSFER FAN				
FM	FLOW METER	TG	TRANSFER GRILLE				
FPI	FIRE PER INCH	TH	TOTAL HEAT				
PPM	FEET PER MINUTE	TP	TOTAL PRESSURE				
FPS	FEET PER SECOND	TU	VARIABLE VOLUME TERMINAL UNIT				
FS	FLOW SWITCH	UD	UNDERCUT DOOR				
FSD	FIRE SMOKE DAMPER	UH	UNIT HEATER				
FT	FINNED TUBE	UHO	UNLESS NOTED OTHERWISE				
FTU	FAN POWERED VARIABLE VOLUME TERMINAL UNIT	V	VENT				
FVEL	FACE VELOCITY	VAV	VARIABLE AIR VOLUME				
G	GALLONS	VD	VOLUME DAMPER (HAND OPERATOR)				
GPF	GALLONS PER FLUSH	VEL	VELOCITY				
GPM	GALLONS PER MINUTE	VTR	VENT THRU ROOF				
H	HOOD	W	WATT				
HC	HEATING COIL	W/	WITH				
HD	HEAD	WB	WET BULB				
HP	PACKAGED ROOFTOP HEAT PUMP	WC	WATER COLUMN				
HP	HORSE POWER	WCO	WALL CLEANOUT				
HRU	HEAT RECOVERY UNIT	W/O	WITHOUT				
HTG	HEATING	W/O	WITHOUT				
HTR	HEATER	WSP	WATER SOURCE HEAT PUMP				
HU	HUMIDIFIER						
HWC	HOT WATER COIL						
HWR	HEATING WATER RETURN						
HWS	HEATING WATER SUPPLY						
HX	HEAT EXCHANGER						
HYD	HYDRAULIC						

GROUP MACKENZIE
 Architectural
 Interior Design
 Land Use Planning
 Civil Engineering
 Structural Engineering
 Transportation Planning

1800 SW Bancroft St / PO Box 6039
 Portland, OR 97201-0639
 Tel: 503.224.1930 Fax: 503.224.2886



Project: OFFICE REMODEL FOR THE DEPARTMENT OF CORRECTIONS
 SALEM, OREGON

Mechanical/Electrical
 INTERFACE ENGINEERING, INC.
 6542 SE Lake Road
 Milwaukie, Oregon 97222-2138
 Phone: (503) 659-6394
 FAX: (503) 659-9029

GENERAL PROJECT NOTES

SHEET TITLE: LEGEND MECHANICAL

RECORD DRAWING
 RECORD DRAWING
 NOT FOR CONSTRUCTION

© GROUP MACKENZIE 1998
 ALL RIGHTS RESERVED
 THESE DRAWINGS ARE THE PROPERTY OF GROUP MACKENZIE AND ARE NOT TO BE USED OR REPRODUCED IN ANY MANNER, WITHOUT PRIOR WRITTEN PERMISSION.


REVISIONS:

REVISION EDITION
 CLOSING DATE
 USPS ROOM 11/24/99

DATE:


DRAWN BY: KDN
 CHECKED BY: RKD
 SHEET

MO.1
 OF
 JOB NO. 298349

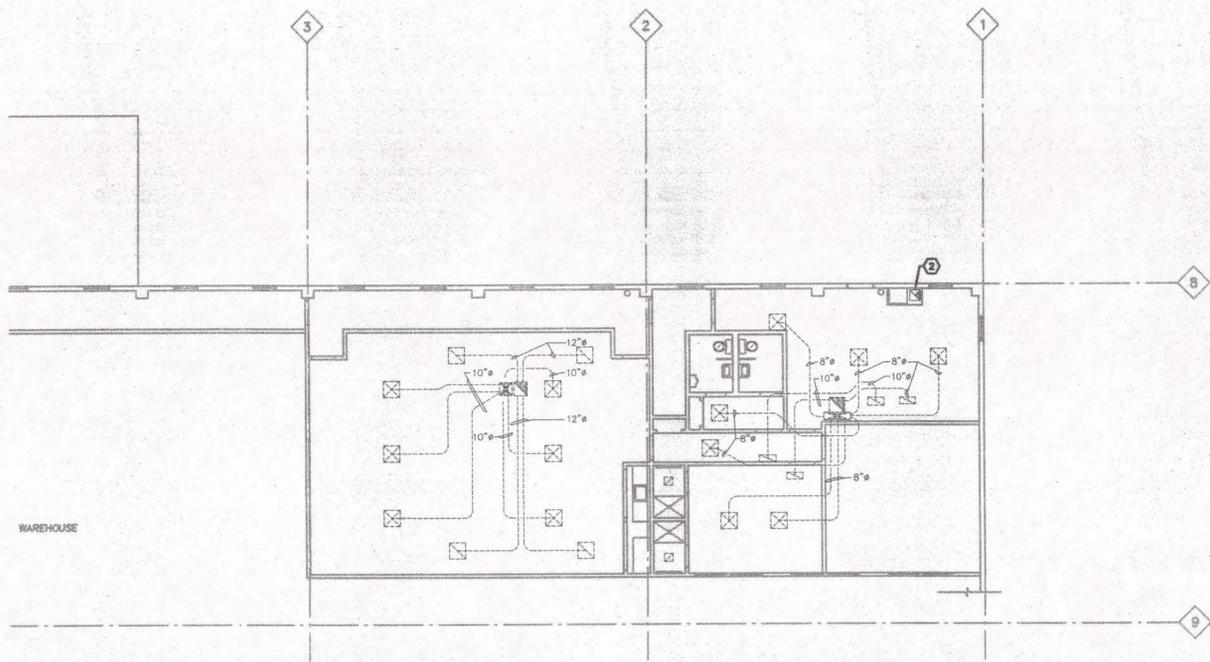

2 HVAC PARTIAL DEMOLITION PLAN
M2.1 1/8"=1'-0"

- NOTES THIS SHEET**
- ① REMOVE TRANSFER DUCT/GRILLS. PATCH PER ARCHITECTURAL/STRUCTURAL REQUIREMENTS.
 - ② REMOVE OSA HOOD, CAP AND DUCT. PATCH ROOF PER ARCHITECTURAL/STRUCTURAL REQUIREMENTS.
 - ③ TRANSITION TO EXISTING RETURN DUCT IN WALL.
 - ④ RETURN GRILLE TO BE REMOVED. RETURN DUCT IN WALL TO REMAIN. PATCH WALL AT OPENING.
 - ⑤ EXISTING TO REMAIN.

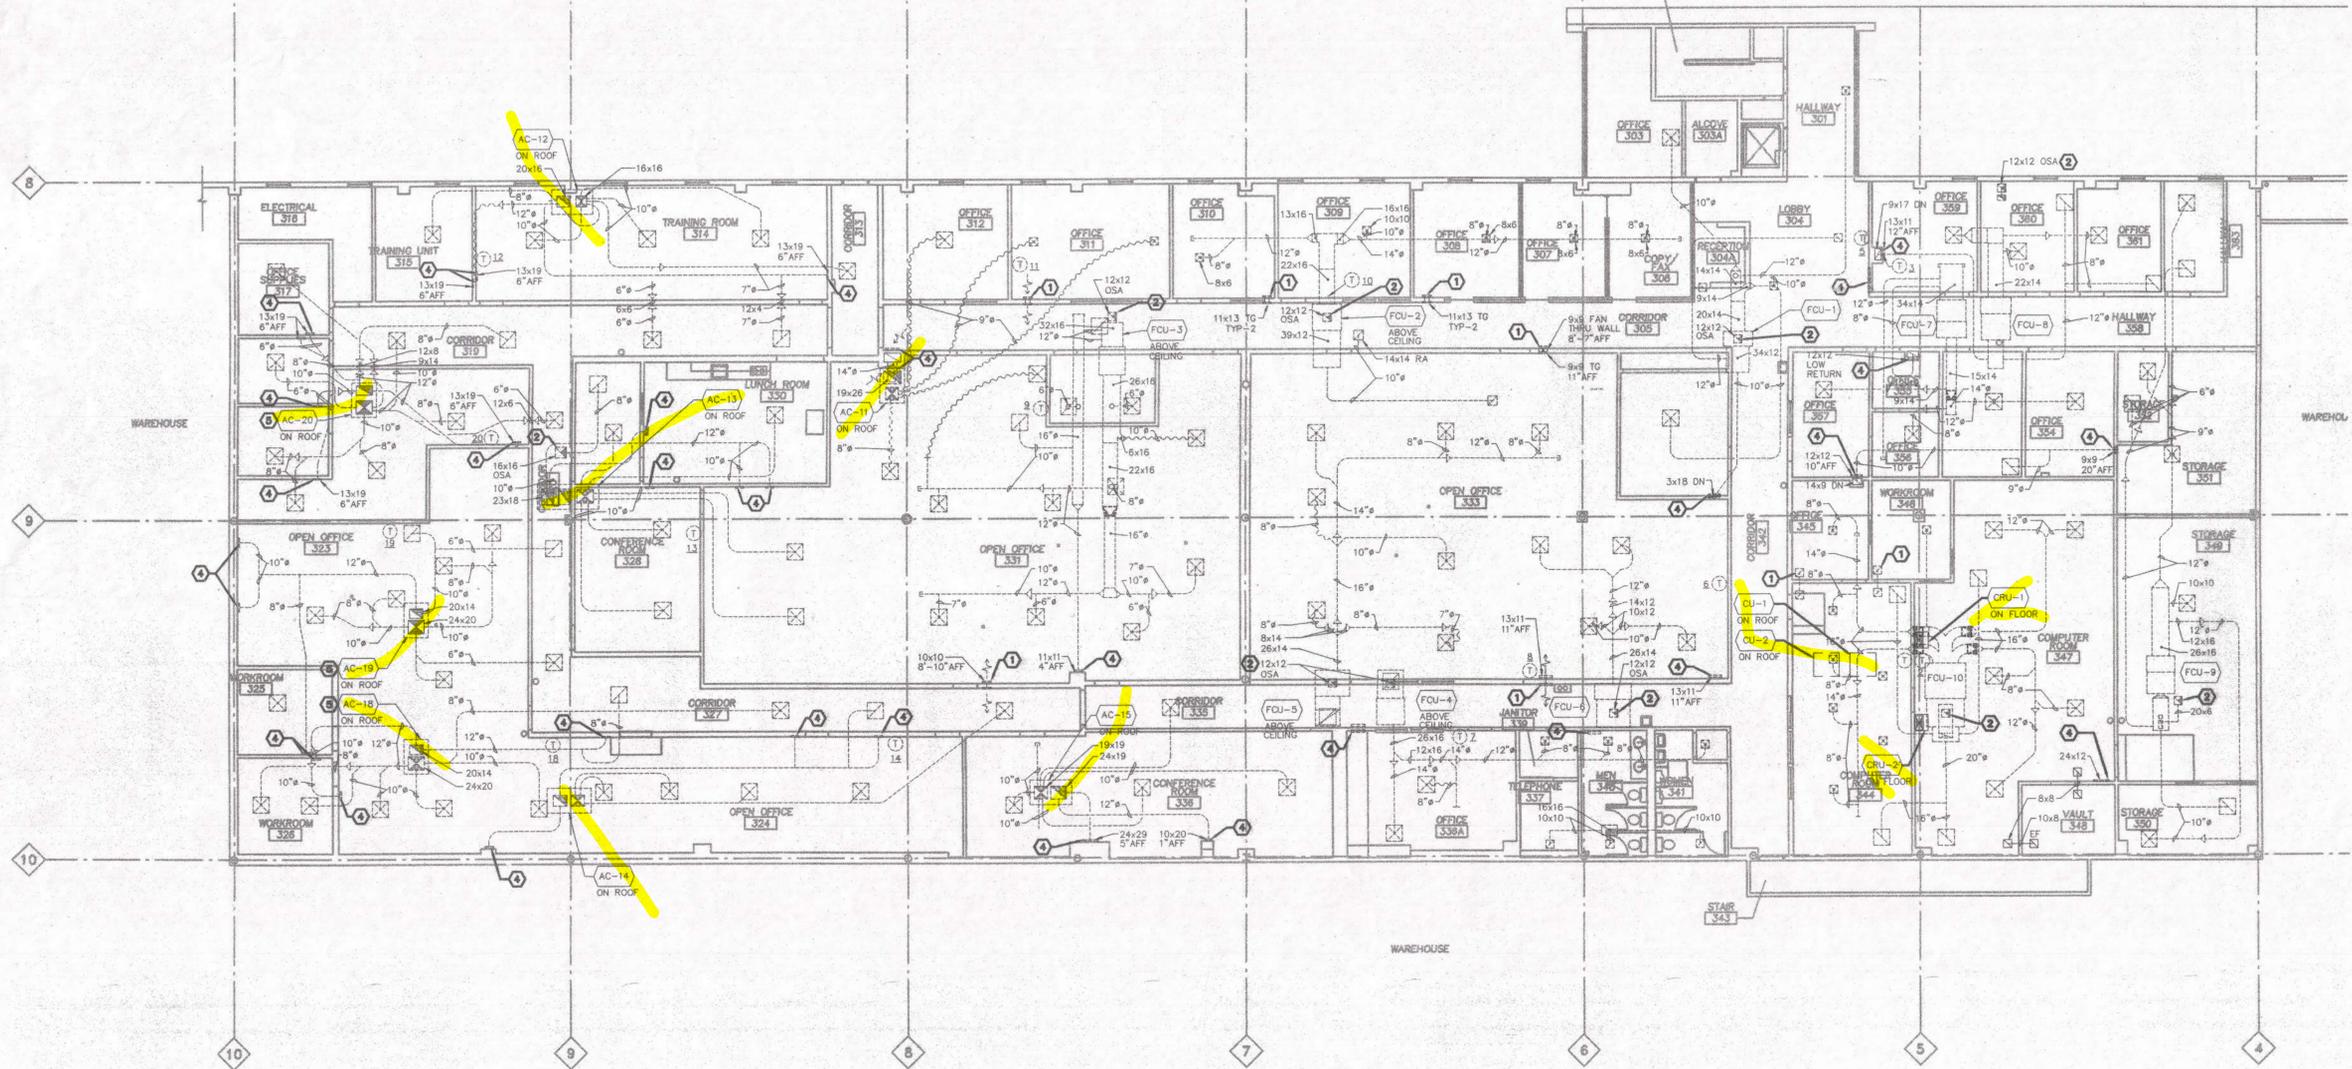

1 HVAC PARTIAL DEMOLITION PLAN
M2.1 1/8"=1'-0"

(BASED ON CONTRACTOR PROVIDED INFORMATION) RECORD DRAWINGS : 9/17/01

GROUP MACKENZIE
Architectural
Interior Design
Land Use Planning
Civil Engineering
Structural Engineering
Transportation Planning

INTERFACE ENGINEERING
MECHANICAL/ELECTRICAL
5000 NE 28TH AVE. SUITE 200
PORTLAND, OREGON 97218
PHONE: (503) 253-8800
FAX: (503) 253-8801

Project: **OFFICE REMODEL FOR THE DEPARTMENT OF CORRECTIONS**
SALEM, OREGON
Mechanical/Electrical
INTERFACE ENGINEERING, INC.
6542 SE Lake Road
Milwaukie, Oregon 97222-2138
Phone: (503) 659-6384
Fax: (503) 659-9029

SHEET TITLE:
DEMO PLANS HVAC

RECORD DRAWING
RECORD DRAWING
NOT FOR CONSTRUCTION

© GROUP MACKENZIE 1998
ALL RIGHTS RESERVED
THESE DRAWINGS ARE THE PROPERTY OF GROUP MACKENZIE AND ARE NOT TO BE USED OR REPRODUCED IN ANY MANNER, WITHOUT PRIOR WRITTEN PERMISSION.


REVISIONS:
REVISION EDITION CLOSING DATE
USPS ROOM 11/24/99

DATE:
DRAWN BY: KDN
CHECKED BY: JHC
SHEET


M2.1
OF
JOB NO. 298349

NOTES THIS SHEET

- ① CONNECT TO EXISTING RETURN DUCT IN CEILING.
- ② NEW CURB, SEE 1/M3.1.
- ③ CONNECT TO EXISTING RETURN DUCT IN WALL.
- ④ EXHAUST FROM EF-2,3,4,5. SEE 4/M3.1.
- ⑤ SEE 3/M3.1.
- ⑥ RELIEF FOR BATTERY CHARGE AREA. SEE CURB INSTALLATION DETAIL 3/M3.1.

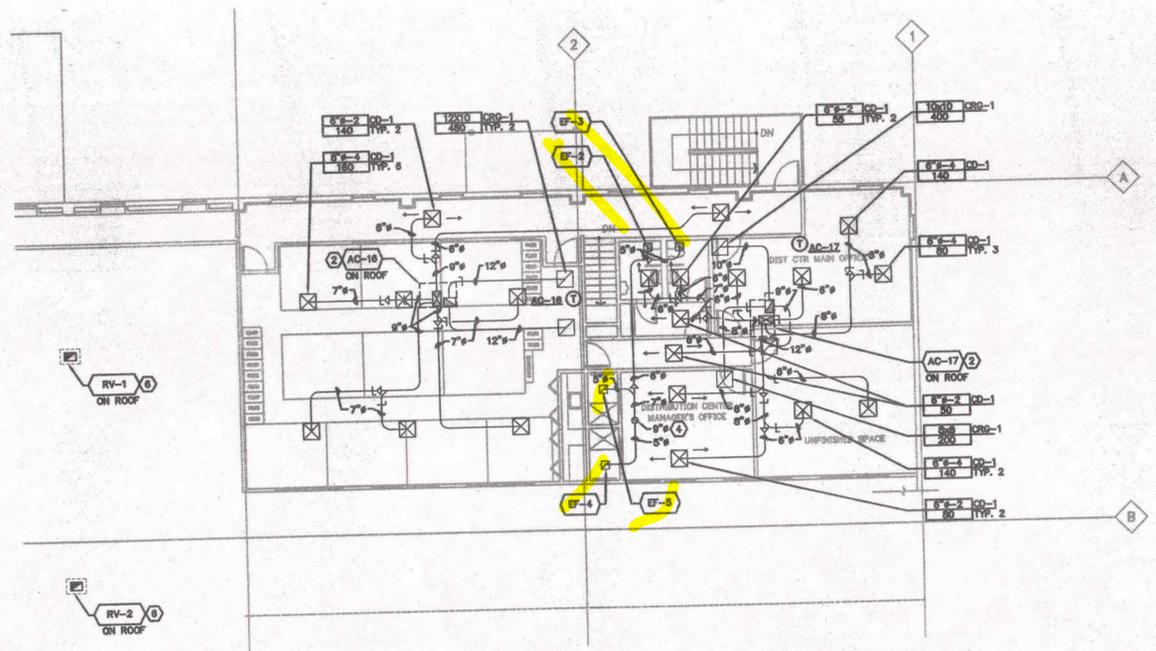

2 PARTIAL FLOOR PLAN - HVAC
 M2.2 1/8"=1'-0"

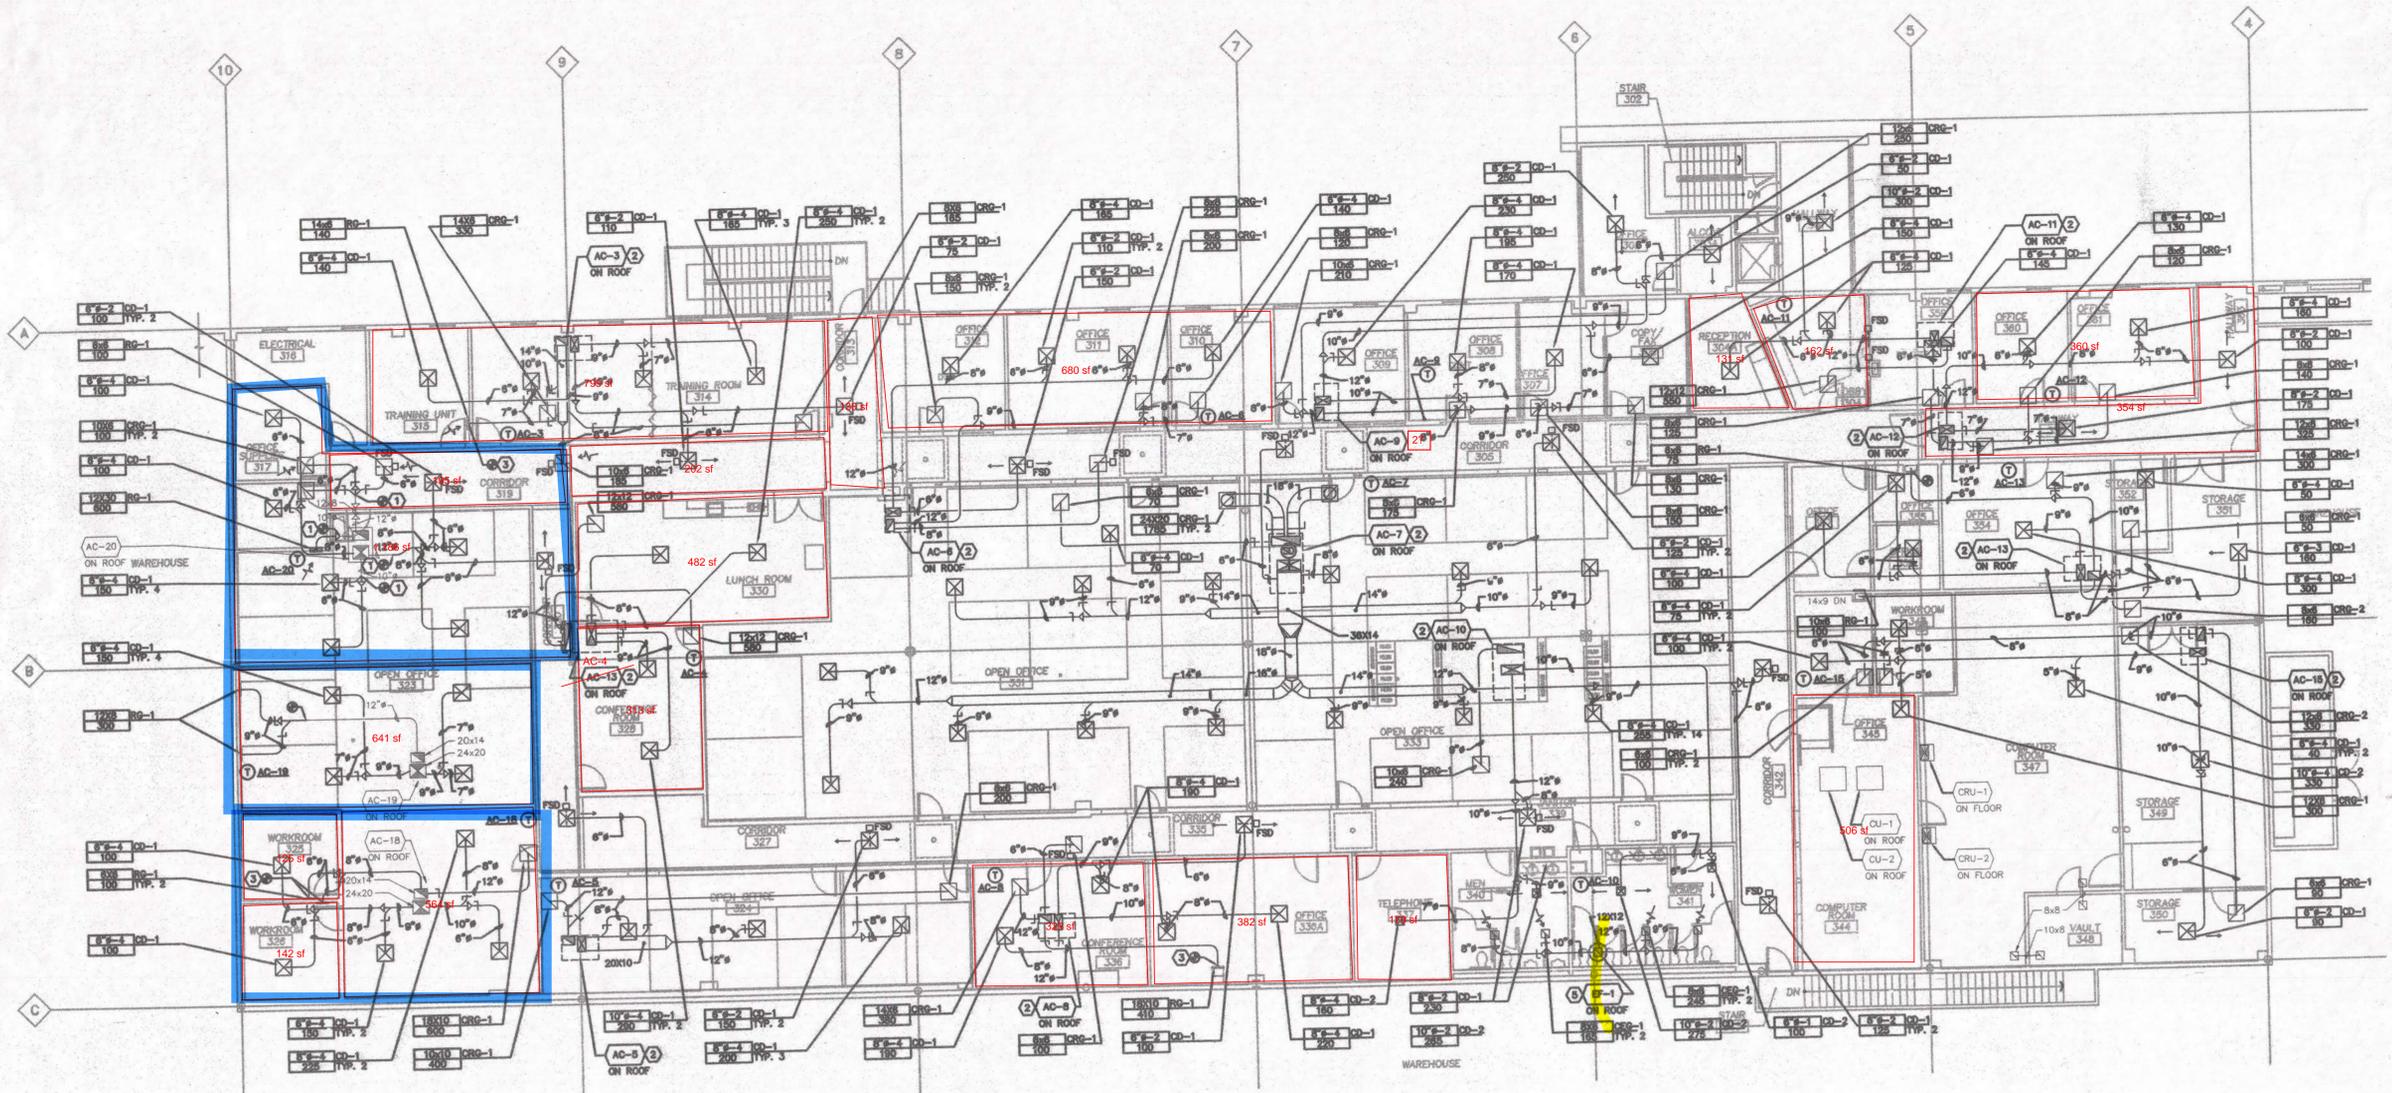

1 PARTIAL FLOOR PLAN - HVAC
 M2.2 1/8"=1'-0"

Project
**OFFICE REMODEL
 FOR THE
 DEPARTMENT
 OF
 CORRECTIONS**

SALEM,
 OREGON

Mechanical/Electrical
INTERFACE ENGINEERING, INC.
 6542 SE Lake Road
 Milwaukie, Oregon 97222-2138
 Phone: (503) 659-4394
 FAX: (503) 659-9029

SHEET TITLE:
**PARTIAL
 FLOOR PLANS
 HVAC**

RECORD DRAWING
 RECORD DRAWING
 RECORD DRAWING

© GROUP MACKENZIE 1998
 ALL RIGHTS RESERVED
 THESE DRAWINGS ARE THE PROPERTY OF
 GROUP MACKENZIE AND ARE NOT TO BE
 USED OR REPRODUCED IN ANY MANNER,
 WITHOUT PRIOR WRITTEN PERMISSION.






REVISIONS:
 REVISION EDITION
 CLOSING DATE
 USPS ROOM 11/24/99

DATE:
 DRAWN BY: KDN
 CHECKED BY: JHC
 SHEET

M2.2

OF
 JOB NO. 298349

(BASED ON CONTRACTOR PROVIDED INFORMATION) RECORD DRAWINGS : 9/17/01

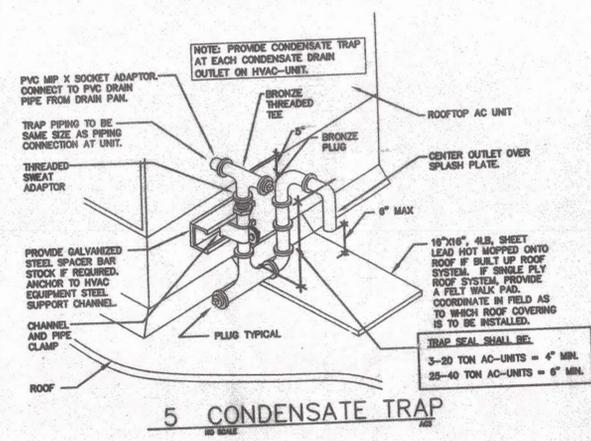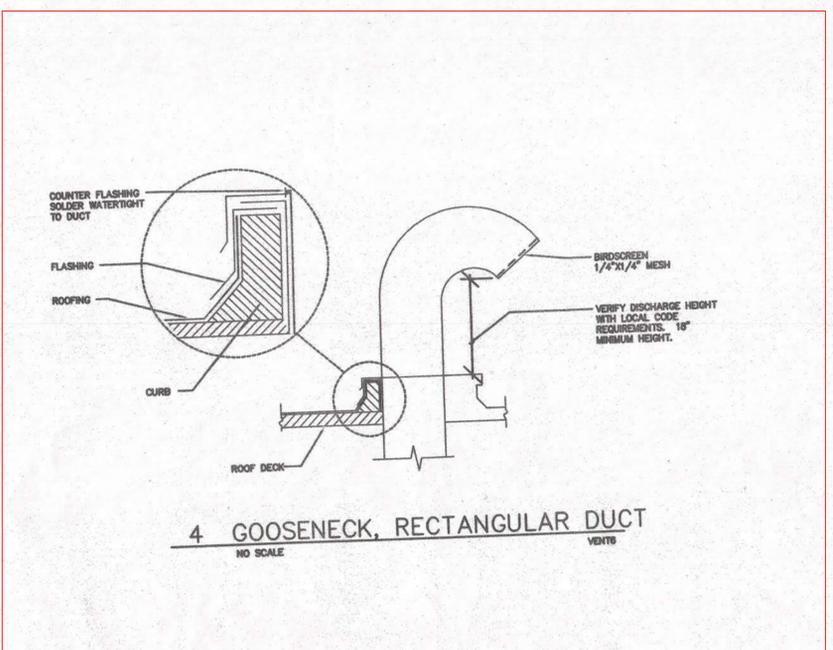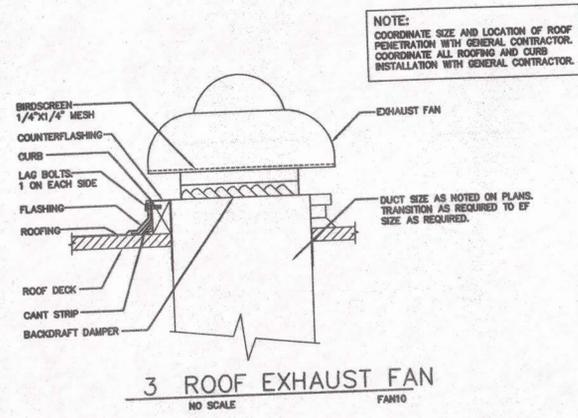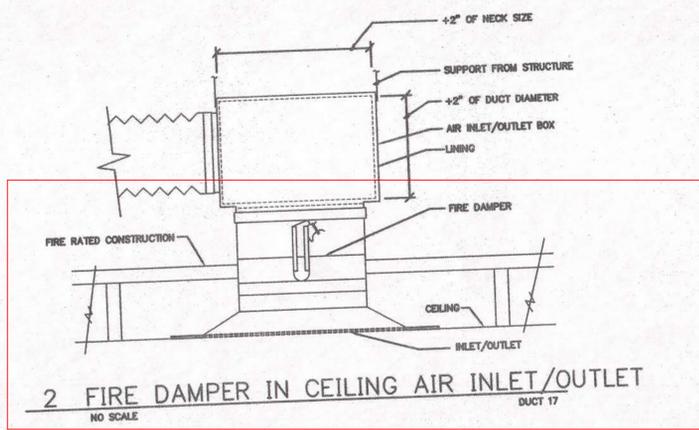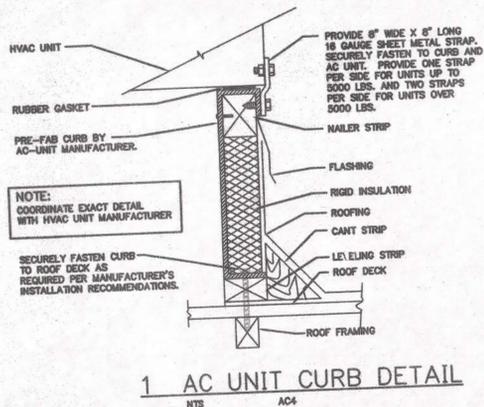

GROUP MACKENZIE
 Architecture
 Interior Design
 Land Use Planning
 Portland, OR 97201-0039
 Phone: 503.228.1285
 Fax: 503.228.1285

INTERFACE ENGINEERING
 Mechanical/Electrical
 6542 SE Lake Road
 Milwaukie, Oregon 97222-2138
 Phone: (503)659-4354
 Fax: (503)659-9029

Project
**OFFICE REMODEL
 FOR THE
 DEPARTMENT
 OF
 CORRECTIONS**
 SALEM,
 OREGON

Mechanical/Electrical
INTERFACE ENGINEERING, INC.
 6542 SE Lake Road
 Milwaukie, Oregon 97222-2138
 Phone: (503)659-4354
 Fax: (503)659-9029

SHEET TITLE:
**DETAILS
 HVAC**

RECORD DRAWING
 RECORD DRAWING
 NOT FOR CONSTRUCTION
RECORD DRAWING

© GROUP MACKENZIE 1998
 ALL RIGHTS RESERVED
 THESE DRAWINGS ARE THE PROPERTY OF
 GROUP MACKENZIE AND ARE NOT TO BE
 USED OR REPRODUCED IN ANY MANNER,
 WITHOUT PRIOR WRITTEN PERMISSION

REVISIONS:
 NO. REVISION EDITION
 CLOSING DATE
 USPS ROOM 11/24/99

DATE:
 DRAWN BY: KDN
 CHECKED BY: JHC
 SHEET

M3.1

OF
 JOB NO. 298349

DIFFUSER, REGISTER AND GRILLE SCHEDULE							
SYMBOL	TYPE	FACE	FRAME	DAMPER	FINISH	MODEL NO.	REMARKS
CD-1	CEILING DIFFUSER	LOUVERED	T-BAR	NONE	WHITE	TITUS TDC	ROUND NECK
CD-2	CEILING DIFFUSER	LOUVERED	SURFACE	NONE	WHITE	TITUS TDC	ROUND NECK
CR0-1	CEILING RETURN GRILLE	EGGCRATE	T-BAR	NONE	WHITE	TITUS 50F	
CR0-2	CEILING RETURN GRILLE	EGGCRATE	SURFACE	NONE	WHITE	TITUS 50F	
CE0-1	CEILING EXHAUST GRILLE	EGGCRATE	SURFACE	NONE	WHITE	TITUS 50F	
RO-1	SIDEWALL RETURN GRILLE	LOUVERED	SURFACE	NONE	WHITE	TITUS 23RL	45° DEFLECTION

EQUIPMENT SCHEDULE		
SYMBOL	DESCRIPTION	ELECTRICAL
AC-1	NOT USED	
AC-2	NOT USED	
AC-3	PACKAGED ROOFTOP A/C UNIT WITH GAS HEAT: SUPPLY: 810 CFM AT 0.5 IN. E.S.P. 80 CFM MIN. OSA. MIN. COOLING: 33.5 MBH TOTAL; 19.2 MBH SEN. AT 76.7°F EDB, 63.1°F EWB, 62.0°F AMBIENT. MIN. HEATING: 40.0 MBH INPUT; 32.0 MBH OUTPUT; WITH ROOF CURB AND ECONOMIZER. MIN. 10.0 EER. APPROXIMATE OPERATING WEIGHT: 350 LB. TRANE YD0024.	208V/1 ϕ 17.7 MCA 1/4 HP SUPPLY FAN.
AC-4	PACKAGED ROOFTOP A/C UNIT WITH GAS HEAT: SUPPLY: 1080 CFM AT 0.5 IN. E.S.P. 990 CFM MIN. OSA. MIN. COOLING: 43.7 MBH TOTAL; 22.0 MBH SEN. AT 77.4°F EDB, 63.4°F EWB, 62.0°F AMBIENT. MIN. HEATING: 80.0 MBH INPUT; 65.0 MBH OUTPUT; WITH ROOF CURB AND ECONOMIZER. MIN. 10.0 EER. APPROXIMATE OPERATING WEIGHT: 800 LB. TRANE YD0027.	208V/3 ϕ .40 HP SUPPLY FAN.
AC-5	PACKAGED ROOFTOP A/C UNIT WITH GAS HEAT: SUPPLY: 910 CFM AT 0.5 IN. E.S.P. 120 CFM MIN. OSA. MIN. COOLING: 33.5 MBH TOTAL; 22.0 MBH SEN. AT 77.4°F EDB, 63.4°F EWB, 62.0°F AMBIENT. MIN. HEATING: 40.0 MBH INPUT; 32.0 MBH OUTPUT; WITH ROOF CURB AND ECONOMIZER. MIN. 10.0 EER. APPROXIMATE OPERATING WEIGHT: 400 LB. TRANE YD0030.	208V/1 ϕ 22.7 MCA 1/4 HP SUPPLY FAN.
AC-6	PACKAGED ROOFTOP A/C UNIT WITH GAS HEAT: SUPPLY: 670 CFM AT 0.5 IN. E.S.P. 80 CFM MIN. OSA. MIN. COOLING: 35.4 MBH TOTAL; 15.4 MBH SEN. AT 77.4°F EDB, 63.4°F EWB, 62.0°F AMBIENT. MIN. HEATING: 40.0 MBH INPUT; 32.0 MBH OUTPUT; WITH ROOF CURB AND ECONOMIZER. MIN. 10.0 EER. APPROXIMATE OPERATING WEIGHT: 350 LB. TRANE YD0024.	208V/1 ϕ 17.7 MCA 1/4 HP SUPPLY FAN.
AC-7	PACKAGED ROOFTOP A/C UNIT WITH GAS HEAT: SUPPLY: 4100 CFM AT 0.5 IN. E.S.P. 620 CFM MIN. OSA. RETURN/EXHAUST 3,700 CFM AT 0.25 IN. E.S.P. MIN. COOLING: 106.0 MBH TOTAL; 100.0 MBH SEN. AT 77.4°F EDB, 63.4°F EWB, 62.0°F AMBIENT. MIN. HEATING: 135.0 MBH INPUT; 105.0 MBH OUTPUT; WITH ROOF CURB, ECONOMIZER AND POWER EXHAUST. MIN. 10.0 EER. APPROXIMATE OPERATING WEIGHT: 1,550 LB. TRANE YD125.	480V/3 ϕ 3 HP SUPPLY FAN.
AC-8	PACKAGED ROOFTOP A/C UNIT WITH GAS HEAT: SUPPLY: 900 CFM AT 0.5 IN. E.S.P. 640 CFM MIN. OSA. MIN. COOLING: 35.4 MBH TOTAL; 31.4 MBH SEN. AT 77.4°F EDB, 63.4°F EWB, 62.0°F AMBIENT. MIN. HEATING: 50.0 MBH INPUT; 40.0 MBH OUTPUT; WITH ROOF CURB AND ECONOMIZER. MIN. 10.0 EER. APPROXIMATE OPERATING WEIGHT: 400 LB. TRANE YD0030.	208V/1 ϕ 22.7 MCA 1/4 HP SUPPLY FAN.
AC-9	PACKAGED ROOFTOP A/C UNIT WITH GAS HEAT: SUPPLY: 1100 CFM AT 0.5 IN. E.S.P. 80 CFM MIN. OSA. MIN. COOLING: 35.4 MBH TOTAL; 24.4 MBH SEN. AT 77.4°F EDB, 63.4°F EWB, 62.0°F AMBIENT. MIN. HEATING: 40.0 MBH INPUT; 32.0 MBH OUTPUT; WITH ROOF CURB AND ECONOMIZER. MIN. 10.0 EER. APPROXIMATE OPERATING WEIGHT: 900 LB. TRANE YD0036.	208V/3 ϕ 0.4 HP SUPPLY FAN.
AC-10	PACKAGED ROOFTOP A/C UNIT WITH GAS HEAT: SUPPLY: 850 CFM AT 0.5 IN. E.S.P. 820 CFM MIN. OSA. MIN. COOLING: 35.4 MBH TOTAL; 32.2 MBH SEN. AT 77.4°F EDB, 63.4°F EWB, 62.0°F AMBIENT. MIN. HEATING: 80.0 MBH INPUT; 65.0 MBH OUTPUT; WITH ROOF CURB AND ECONOMIZER. MIN. 10.0 EER. APPROXIMATE OPERATING WEIGHT: 900 LB. TRANE YD0027.	208V/3 ϕ 0.4 HP SUPPLY FAN.
AC-11	PACKAGED ROOFTOP A/C UNIT WITH GAS HEAT: SUPPLY: 580 CFM AT 0.5 IN. E.S.P. 100 CFM MIN. OSA. MIN. COOLING: 14.8 MBH TOTAL; 13.4 MBH SEN. AT 75.0°F EDB, 77.3°F EWB, 68°F AMBIENT. MIN. HEATING: 40.0 MBH INPUT; 32.0 MBH OUTPUT; WITH ROOF CURB AND ECONOMIZER. MIN. 10.0 EER. APPROXIMATE OPERATING WEIGHT: 350 LB. TRANE YD0018.	208V/1 ϕ 15 MCA 1/4 HP SUPPLY FAN.
AC-12	PACKAGED ROOFTOP A/C UNIT WITH GAS HEAT: SUPPLY: 700 CFM AT 0.5 IN. E.S.P. 80 CFM MIN. OSA. MIN. COOLING: 35.4 MBH TOTAL; 14.2 MBH SEN. AT 75.0°F EDB, 76.5°F EWB, 62°F AMBIENT. MIN. HEATING: 40.0 MBH INPUT; 32.0 MBH OUTPUT; WITH ROOF CURB AND ECONOMIZER. MIN. 10.0 EER. APPROXIMATE OPERATING WEIGHT: 350 LB. TRANE YD0024.	208V/1 ϕ 17.7 MCA 1/4 HP SUPPLY FAN.
AC-13	PACKAGED ROOFTOP A/C UNIT WITH GAS HEAT: SUPPLY: 800 CFM AT 0.5 IN. E.S.P. 140 CFM MIN. OSA. MIN. COOLING: 35.4 MBH TOTAL; 14.2 MBH SEN. AT 75.0°F EDB, 64.0°F EWB, 62.0°F AMBIENT. MIN. HEATING: 40.0 MBH INPUT; 32.0 MBH OUTPUT; WITH ROOF CURB AND ECONOMIZER. MIN. 10.0 EER. APPROXIMATE OPERATING WEIGHT: 310 LB. TRANE YD0024.	208V/1 ϕ 17.7 MCA 1/4 HP SUPPLY FAN.
AC-14	PACKAGED ROOFTOP A/C UNIT WITH GAS HEAT: SUPPLY: 1050 CFM AT 0.5 IN. E.S.P. 80 CFM MIN. OSA. MIN. COOLING: 35.4 MBH TOTAL; 24.4 MBH SEN. AT 77.4°F EDB, 63.4°F EWB, 62.0°F AMBIENT. MIN. HEATING: 80.0 MBH INPUT; 62.0 MBH OUTPUT; WITH ROOF CURB AND ECONOMIZER. MIN. 10.0 EER. APPROXIMATE OPERATING WEIGHT: 900 LB. TRANE YD0036.	208V/1 ϕ 0.4 HP SUPPLY FAN.
AC-15	PACKAGED ROOFTOP A/C UNIT WITH GAS HEAT: SUPPLY: 820 CFM AT 0.5 IN. E.S.P. 0 CFM MIN. OSA. MIN. COOLING: 12.8 MBH TOTAL; 12.8 MBH SEN. AT 75.0°F EDB, 62.8°F EWB, 62.0°F AMBIENT. MIN. HEATING: 40.0 MBH INPUT; 32.0 MBH OUTPUT; WITH ROOF CURB AND ECONOMIZER. MIN. 10.0 EER. APPROXIMATE OPERATING WEIGHT: 350 LB. TRANE YD0018.	208V/1 ϕ 15 MCA 1/4 HP SUPPLY FAN.
AC-16	PACKAGED ROOFTOP A/C UNIT WITH GAS HEAT: SUPPLY: 1250 CFM AT 0.5 IN. E.S.P. 200 CFM MIN. OSA. MIN. COOLING: 35.4 MBH TOTAL; 29.0 MBH SEN. AT 77.4°F EDB, 63.4°F EWB, 62.0°F AMBIENT. MIN. HEATING: 80.0 MBH INPUT; 62.0 MBH OUTPUT; WITH ROOF CURB AND ECONOMIZER. MIN. 10.0 EER. APPROXIMATE OPERATING WEIGHT: 900 LB. TRANE YD0036.	208V/3 ϕ 0.4 HP SUPPLY FAN.
AC-17	PACKAGED ROOFTOP A/C UNIT WITH GAS HEAT: SUPPLY: 1050 CFM AT 0.5 IN. E.S.P. 180 CFM MIN. OSA. MIN. COOLING: 27.0 MBH TOTAL; 23.0 MBH SEN. AT 76.2°F EDB, 63.6°F EWB, 62.0°F AMBIENT. MIN. HEATING: 40.0 MBH INPUT; 32.0 MBH OUTPUT; WITH ROOF CURB AND ECONOMIZER. MIN. 10.0 EER. APPROXIMATE OPERATING WEIGHT: 350 LB. TRANE YD0030.	208V/1 ϕ 21.3 MCA 1/4 HP SUPPLY FAN.
EF-1	CENTRIFUGAL ROOF EXHAUST FAN WITH ALUMINUM HOUSING: 820 CFM AT 0.5 IN. T.S.P. WITH BACKDRAFT DAMPER. MAX RPM 1,200. APPROXIMATE OPERATING WEIGHT: 80 LB.	115V/1 ϕ 1/8 HP.
EF-2,3,4,5	CEILING MOUNTED EXHAUST FAN: 85 CFM AT 0.2 IN. T.S.P. WITH GRILLE AND BACKDRAFT DAMPER. MAX. 3.0 SONES.	115V/1 ϕ 1/20 HP.

GROUP
MACKENZIE
Architecture
Interior Design
Land Use Planning

INTERFACE ENGINEERING
MECHANICAL/ELECTRICAL
325 N. Washington Ave. Ste. 200
Portland, OR 97208
Phone: (503) 251-0000
Fax: (503) 251-0000

Project
**OFFICE REMODEL
FOR THE
DEPARTMENT
OF
CORRECTIONS**
SALEM,
OREGON

Mechanical/Electrical
INTERFACE ENGINEERING, INC.
6542 SE Lake Road
Milwaukie, Oregon 97222-2138
Phone: (503) 659-6344
FAX: (503) 659-9029

SHEET TITLE:
**SCHEDULES
HVAC**


RECORD DRAWING
RECORD DRAWING
NOT FOR CONSTRUCTION

© GROUP MACKENZIE 1999
ALL RIGHTS RESERVED
THESE DRAWINGS ARE THE PROPERTY OF
GROUP MACKENZIE AND ARE NOT TO BE
USED OR REPRODUCED IN ANY MANNER
WITHOUT PRIOR WRITTEN PERMISSION

REVISIONS:
REVISION EDITION
CLOSING DATE
USPS ROOM 11/24/99

DATE:
DRAWN BY: KDN
CHECKED BY: JHC
SHEET


M4.1
OF
JOB NO. 298349

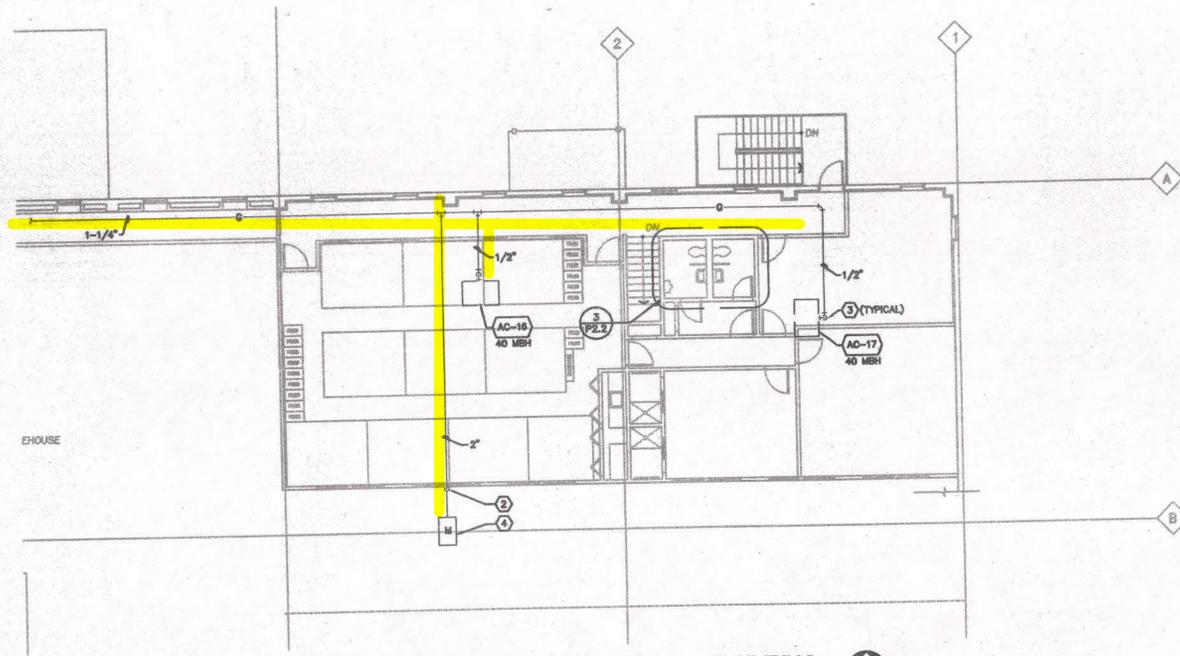

2 PARTIAL FLOOR PLAN - PLUMBING
P2.1 1/8"=1'-0"

NOTES THIS SHEET

- 1 REMOVE 3X1-1/2X1-1/2 TEE. INSTALL 3X3X3 TEE.
- 2 ROUTE 1-1/4" GAS PIPING UP EXTERIOR WALL AND PENETRATE INTO CEILING SPACE OF TOP FLOOR.
- 3 1/2" GAS UP THRU ROOF TO CONNECT TO ROOFTOP EQUIPMENT. SEE P.2.2.
- 4 2 LB. GAS SERVICE AND METER PROVIDED BY HW NATURAL GAS CO.
TOTAL DEVELOPED LENGTH: 400'
CONNECTED LOAD: 865 MBH FUTURE 240 MBH
SEE P.2.2 FOR CONNECTION SCHEDULE.
- 5 3/4" CAPPED BRANCH LINE FOR FUTURE GAS LOAD.
- 6 EXISTING TO REMAIN.
- 7 2-1/2" CW SECTION REPLACES EXISTING 1-1/2" SECTION. ABANDON EXISTING 1-1/2" SECTION IN PLACE.

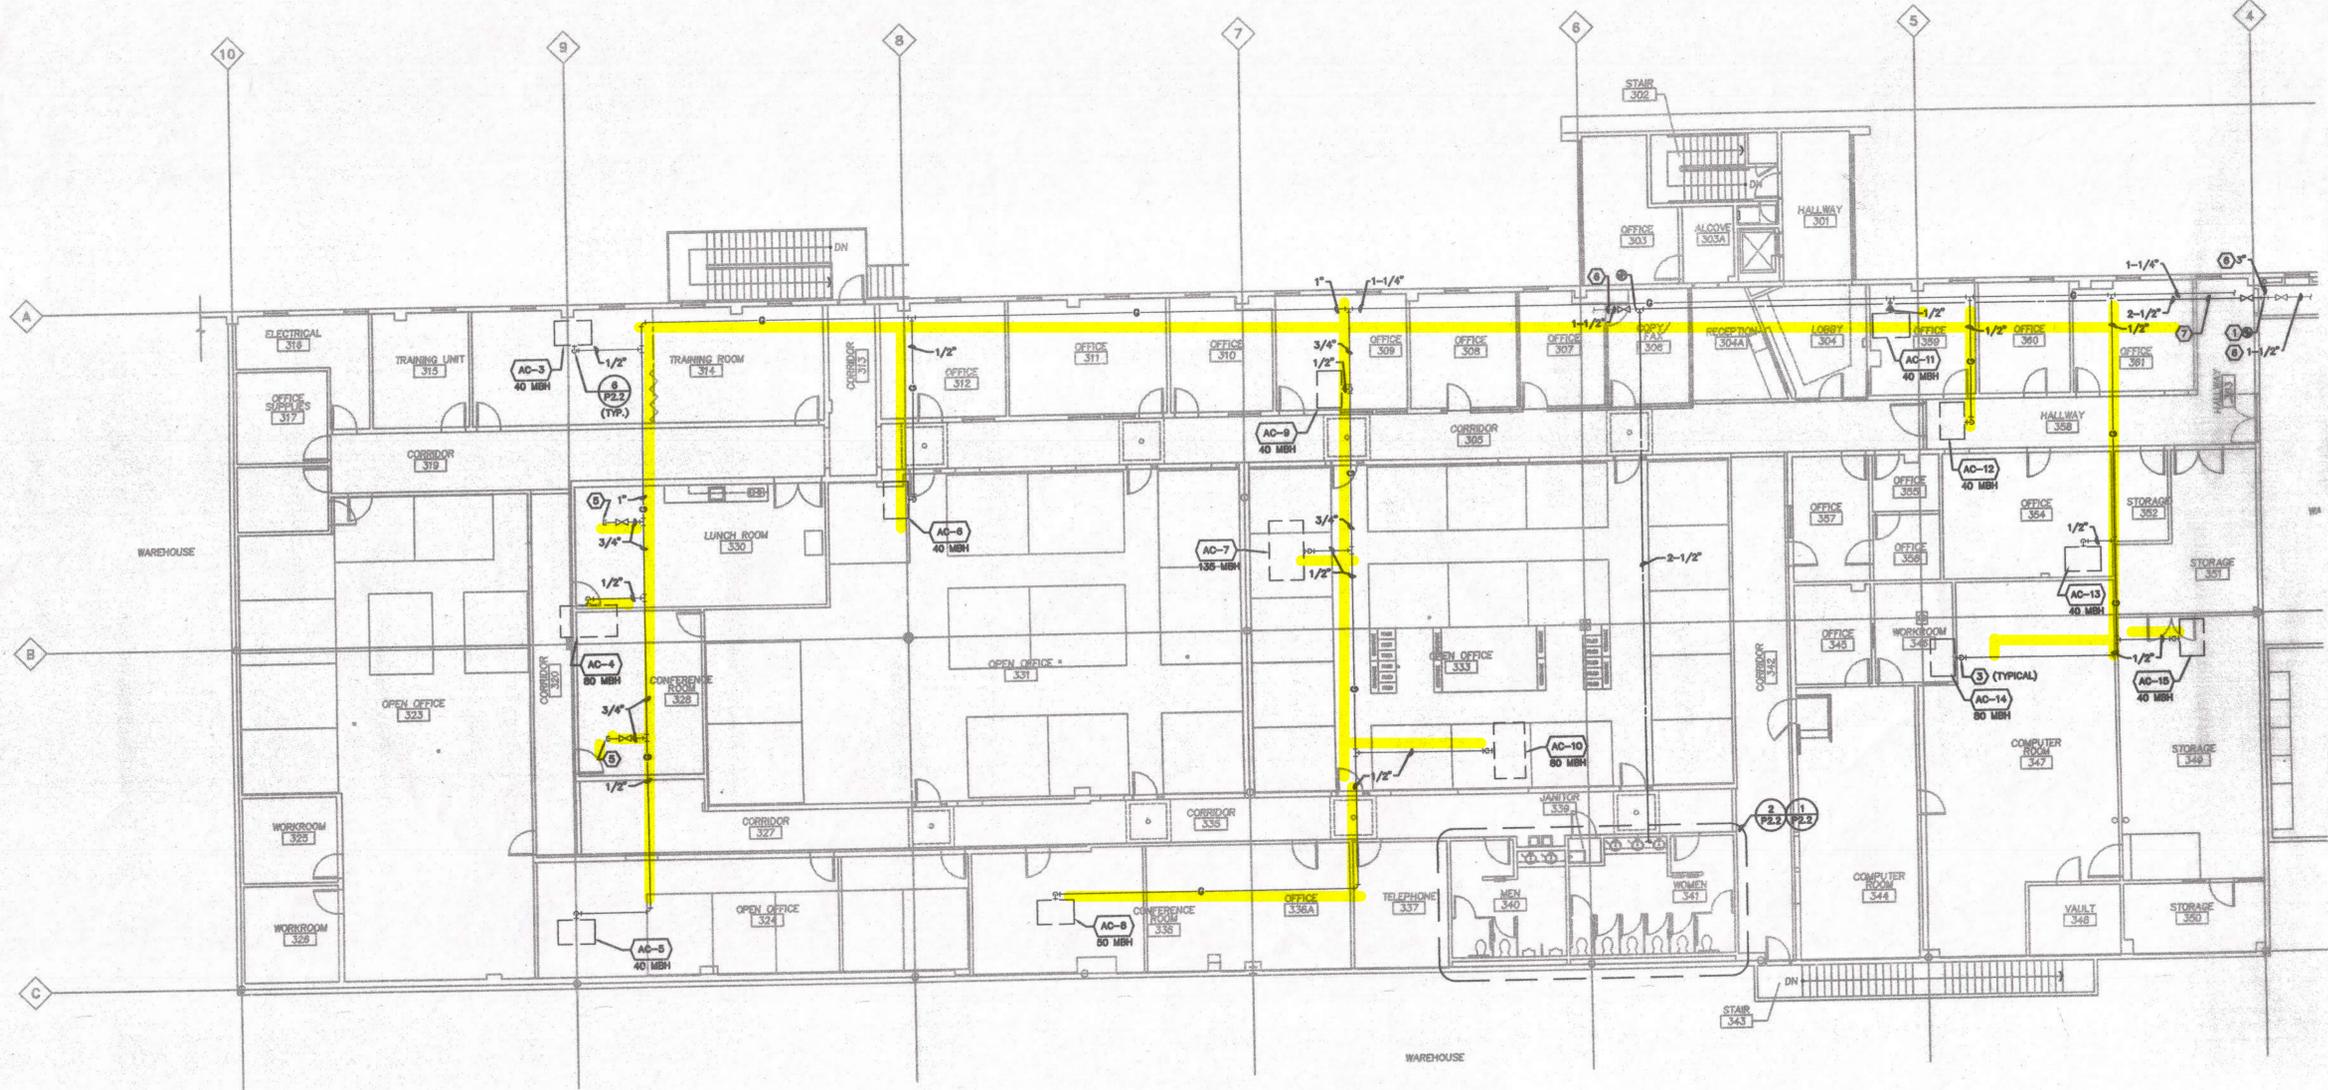

1 PARTIAL FLOOR PLAN - PLUMBING
P2.1 1/8"=1'-0"

(BASED ON CONTRACTOR PROVIDED INFORMATION) RECORD DRAWINGS : 9/17/01

GROUP MACKENZIE
Architecture
Interior Design
Land Use Planning

INTERFACE ENGINEERING
MECHANICAL/ELECTRICAL
PLUMBING
GENERAL CONTRACTOR

Project
OFFICE REMODEL
FOR THE
DEPARTMENT
OF
CORRECTIONS
SALEM,
OREGON

Mechanical/Electrical
INTERFACE ENGINEERING, INC.
6542 SE Lake Road
Milwaukie, Oregon 97222-2138
Phone: (503)659-6394
FAX: (503)659-9029

SHEET TITLE:
FLOOR PLAN
PLUMBING

RECORD DRAWING
NOT FOR CONSTRUCTION
RECORD DRAWING


GROUP MACKENZIE 1999
ALL RIGHTS RESERVED
THESE DRAWINGS ARE THE PROPERTY OF
GROUP MACKENZIE AND ARE NOT TO BE
USED OR REPRODUCED IN ANY MANNER,
WITHOUT PRIOR WRITTEN PERMISSION

REVISIONS:
REVISION EDITION
CLOSING DATE
USPS ROOM 11/24/99


DATE:
DRAWN BY: KDN
CHECKED BY: RKD
SHEET

P2.1


OF
JOB NO. 298349

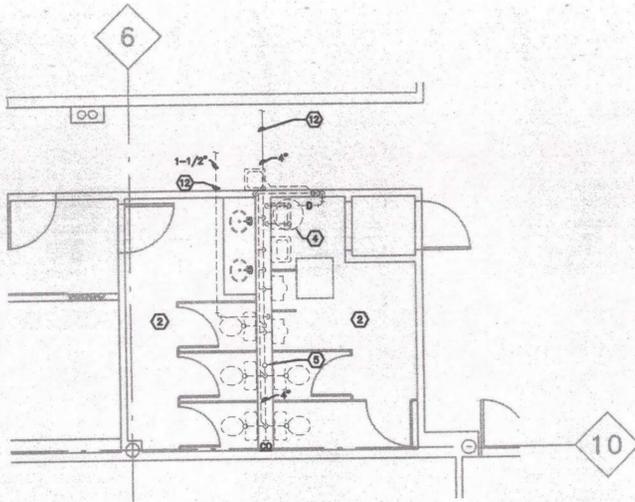


1 RESTROOM GROUP (WEST) DEMOLITION PLAN
P21 1/4"=1'-0"

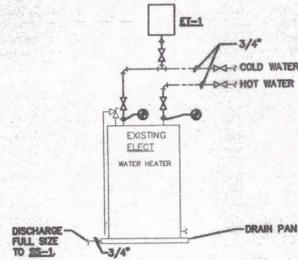


4 WATER HEATER DETAIL
P21 SCALE: NONE

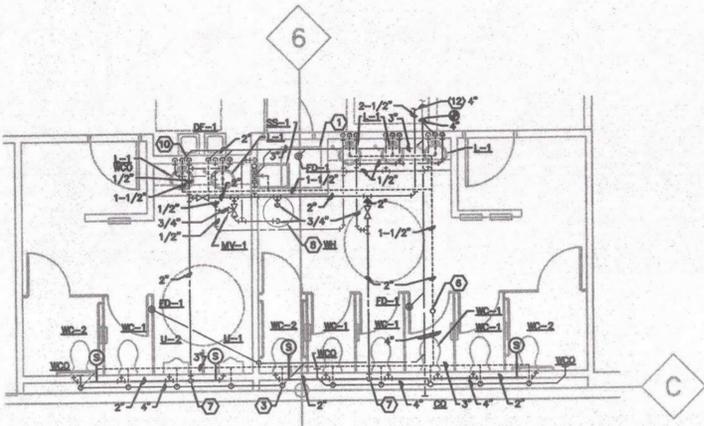


2 RESTROOM GROUP (WEST) FLOOR PLAN
P21 1/4"=1'-0"

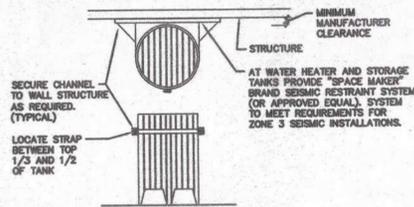

5 SEISMIC BRACING FOR WATER HEATER
P21 SCALE: NONE

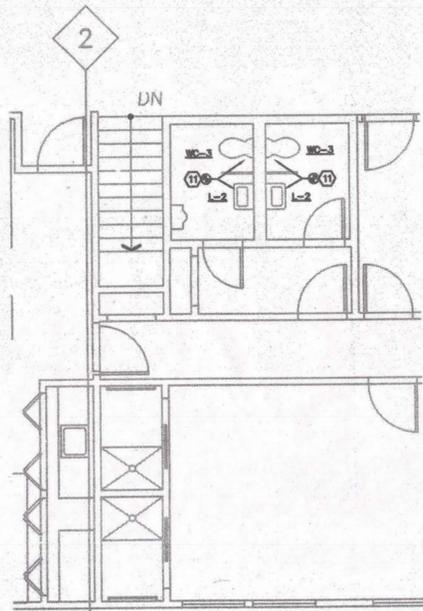

3 RESTROOM GROUP (EAST) FLOOR PLAN
P21 1/4"=1'-0"

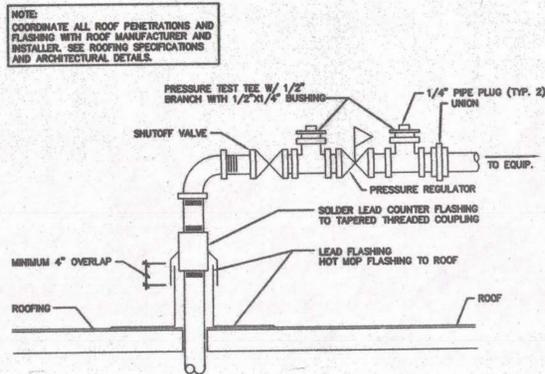

6 GAS PIPE ROOF PENETRATION
P21 SCALE: NONE

NOTES THIS SHEET

- 1 30X30 ACCESS PANEL COORDINATE WITH ARCHITECTURAL DWG'S.
- 2 REMOVE ALL PLUMBING FIXTURES. REMOVE ALL BELOW FLOOR DWV PIPING UP TO POINT WHERE NEW WORK CONNECTS TO EXISTING PER 2/P2.2. REMOVE ALL ABOVE FLOOR DWV AND CW/HW PIPING INSULATED CW/HW PIPING ABOVE CEILING TO BE ABANDONED IN PLACE.
- 3 4" SANITARY DN.
- 4 REMOVE AND REUSE EXISTING 40 GAL. ELECTRIC WATER HEATER. SEE 2/P2.2 FOR NEW LOCATION.
- 5 REMOVE EXISTING 3" VTR.
- 6 NEW 4" VTR. ROUTE THRU ROOF PENETRATION LEFT BY REMOVED 3" VENT.
- 7 2" CW DN TO 2" FIXTURE MANIFOLD.
- 8 REUSE EXISTING WATER HEATER. SEE 4/P2.2 AND 5/P2.2.
- 9 NOT USED.
- 10 1/2" CW DN TO SERVE BOTH L-1 AND DE-1.
- 11 REMOVE EXISTING FIXTURES USING EXISTING NEW FIXTURES USING EXISTING CONNECTIONS.
- 12 EXISTING TO REMAIN.

GAS CONNECTION SCHEDULE

UNIT	MBH
AC-3	40
AC-4	80
AC-5	40
AC-6	40
AC-7	135
AC-8	50
AC-9	40
AC-10	80
AC-11	40
AC-12	40
AC-13	40
AC-14	80
AC-15	40
AC-16	80
AC-17	40
FUTURE	240
TOTAL	1105

PLUMBING FIXTURE SCHEDULE

SYMBOL	DESCRIPTION	CONNECTION SIZE			
		W	V	CW	HW
DF-1	DRINKING FOUNTAIN: STAINLESS STEEL, DUAL HEIGHT, WALL HUNG, HANDICAP, CHROME PLATED BUBBLER, FRONT PUSH BAR, SELF-CLOSING VALVE, AUTOMATIC STREAM REGULATION, VANDAL-RESISTANT BOTTOM PLATE, 1/2 IN. SCREWDRIVER STOP AND TUBING SUPPLY, CHROME PLATED STRAINER, 1-1/4 IN. TRAP, 10 x 6 MOUNTING PLATE FOR INSTALLATION ON WALL STUDS. HANS 1106.	1-1/2"	1-1/2"	1/2"	---
ET-1	EXPANSION TANK: WATTS DET-5.	---	---	3/4"	---
FD-1	FLOOR DRAIN: CAST-IRON BODY WITH ADJUSTABLE ROUND POLISHED NICKEL BRONZE TOP. STRAINER DIAMETER 6 IN. VANDAL-PROOF SCREWS. TRAP PRIMER CONNECTION. PROVIDE WITH P-TRAP. J.R. SMITH 2005-A.	3"	SEE DWGS	---	---
L-1	LAVATORY: COUNTERTOP, FRONT OVERFLOW, VITREOUS CHINA, SELF-RIMMING, 20 IN. BY 17 IN. OVAL. SEALANT, FAUCET HOLES 4 IN. CENTERS. AMERICAN STANDARD 0476.028 "AQUALYN". FAUCET: LEVER HANDLE TYPE, 4 IN. CENTERS, C.P. METAL HANDLE, 1/2 IN. IPS ADAPTORS, VANDAL-RESISTANT 0.5 GPM AERATOR, NO LIFT ROD HOLE, CHROME FINISH WITH PIPE INSTALLATION KIT FOR ADA COMPLIANCE. DELTA 523 HPF. FITTINGS: 1-1/4 IN. BY 1-1/2 IN. P-TRAP. SUPPLIES AND STOPS.	1-1/2"	1-1/2"	1/2"	1/2"
L-2	LAVATORY: WALL HUNG, VITREOUS CHINA, 19 IN. BY 17 IN., FRONT OVERFLOW, SOAP DEPRESSION, FAUCET HOLES ON 4 IN. CENTERS. WALL HANGER. AMERICAN STANDARD 0321.028. AMERICAN STANDARD 0355.012 "LUCERNE". FAUCET: LEVER HANDLE TYPE, 4 IN. CENTERS, C.P. METAL HANDLE, 1/2 IN. IPS ADAPTORS, VANDAL-RESISTANT 0.5 GPM AERATOR, NO LIFT ROD HOLE, CHROME FINISH. DELTA 523 HPF. FITTINGS: 1-1/4 IN. BY 1-1/2 IN. P-TRAP. SUPPLIES AND STOPS. CARRIER: FLOOR MOUNTED WITH CONCEALED ARMS. SMITH AS APPLICABLE.	1-1/2"	1-1/2"	1/2"	1/2"
MV-1	THERMOSTATIC MIXING VALVE: 2.0 GPM AT 10 PSI PRESSURE DROP. SYMONS 5-130.	---	---	3/4"	3/4"
SS-1	SERVICE SINK: FLOOR-MOUNTED, 24 IN. x 24 IN. x 10 IN., MOLDED STONE, S.S. DOMED STRAINER, AND RIM GUARDS. FIAT MSB2424 WITH E-77 AA VINYL RIM GUARDS. FAUCET: HOSE END SPOUT TYPE WITH INTEGRAL VACUUM BREAKER, ADJUSTABLE ARMS WITH INTEGRAL STOPS AND WALL BRACE. CHICAGO 987.	3"	1-1/2"	1/2"	1/2"
U-1	URINAL: SIPHON JET, VITREOUS CHINA, 3/4 IN. TOP SPUD, FLUSHING RIM, EXTENDED WIDTH STALL SIDES, WALL HANGER. AMERICAN STANDARD 8561.017 "THUNDERBOLT". FLUSH VALVE: SLOAN ROYAL 186 WATER SAVER. CARRIER: FLOOR MOUNTED, HANGER PLATE, SMITH AS APPLICABLE, NO RESIDENTIAL.	2"	1-1/2"	3/4"	---
U-2	URINAL: SAME AS U-1, EXCEPT SPECIAL MOUNTING HEIGHT FOR ADA COMPLIANCE.	2"	1-1/2"	3/4"	---
WC-1	WATER CLOSET: WALL HUNG, 1.5 GPF, SIPHON-JET ACTION, VITREOUS CHINA, ELONGATED BOWL, 1-1/2 IN. TOP SPUD FOR EXPOSED FLUSH VALVE, BOLT CAPS. AMERICAN STANDARD 2257.103 "AFWALL AQUAMETER". SEAT: OPEN FRONT, COMMERCIAL WEIGHT HEAVY-DUTY PLASTIC, STAINLESS STEEL CHECK HINGE, WHITE, WITHOUT COVER. CHURCH 9500C. FLUSH VALVE: SLOAN ROYAL 111. CARRIER: SMITH AS APPLICABLE, NO RESIDENTIAL.	4"	2"	1"	---
WC-2	WATER CLOSET: SAME AS WC-1, EXCEPT SPECIAL MOUNTING HEIGHT FOR ADA COMPLIANCE.	4"	2"	1"	---
WC-3	WATER CLOSET: FLOOR MOUNTED, 1.5 GPF, TANK TYPE, ELONGATED BOWL, VITREOUS CHINA, SIPHON JET ACTION, BOLT CAPS, SUPPLY AND STOP. AMERICAN STANDARD 2282.203 "NEW CADET AQUAMETER". SEAT: COMMERCIAL WEIGHT HEAVY-DUTY SOLID PLASTIC, WHITE, OPEN FRONT, STAINLESS STEEL CHECK HINGE, WITHOUT COVER. CHURCH 9500C.	4"	2"	1/2"	---

GROUP MACKENZIE
Architecture
Interior Design
Land Use Planning

INTERFACE ENGINEERING
Mechanical/Electrical
Plumbing
Structural Engineering
Transportation Planning

Project
OFFICE REMODEL FOR THE DEPARTMENT OF CORRECTIONS
SALEM, OREGON

Mechanical/Electrical
INTERFACE ENGINEERING, INC.
6542 SE Lake Road
Milwaukie, Oregon 97222-2138
Phone: (503)659-6394
Fax: (503)659-9029

SHEET TITLE
DETAILS AND SCHEDULES - PLUMBING

RECORD DRAWING
RECORD DRAWING

GROUP MACKENZIE 1998
ALL RIGHTS RESERVED.
THESE DRAWINGS ARE THE PROPERTY OF GROUP MACKENZIE AND ARE NOT TO BE USED OR REPRODUCED IN ANY MANNER, WITHOUT PRIOR WRITTEN PERMISSION.

REVISIONS:
REVISION NUMBER REVISION EDITION CLOSING DATE
USPS ROOM 11/24/99

DATE:
DRAWN BY: KDN
CHECKED BY: RKD
SHEET

P2.2

OF
JOB NO. 298349