
ELECTRICAL SYMBOL LIST

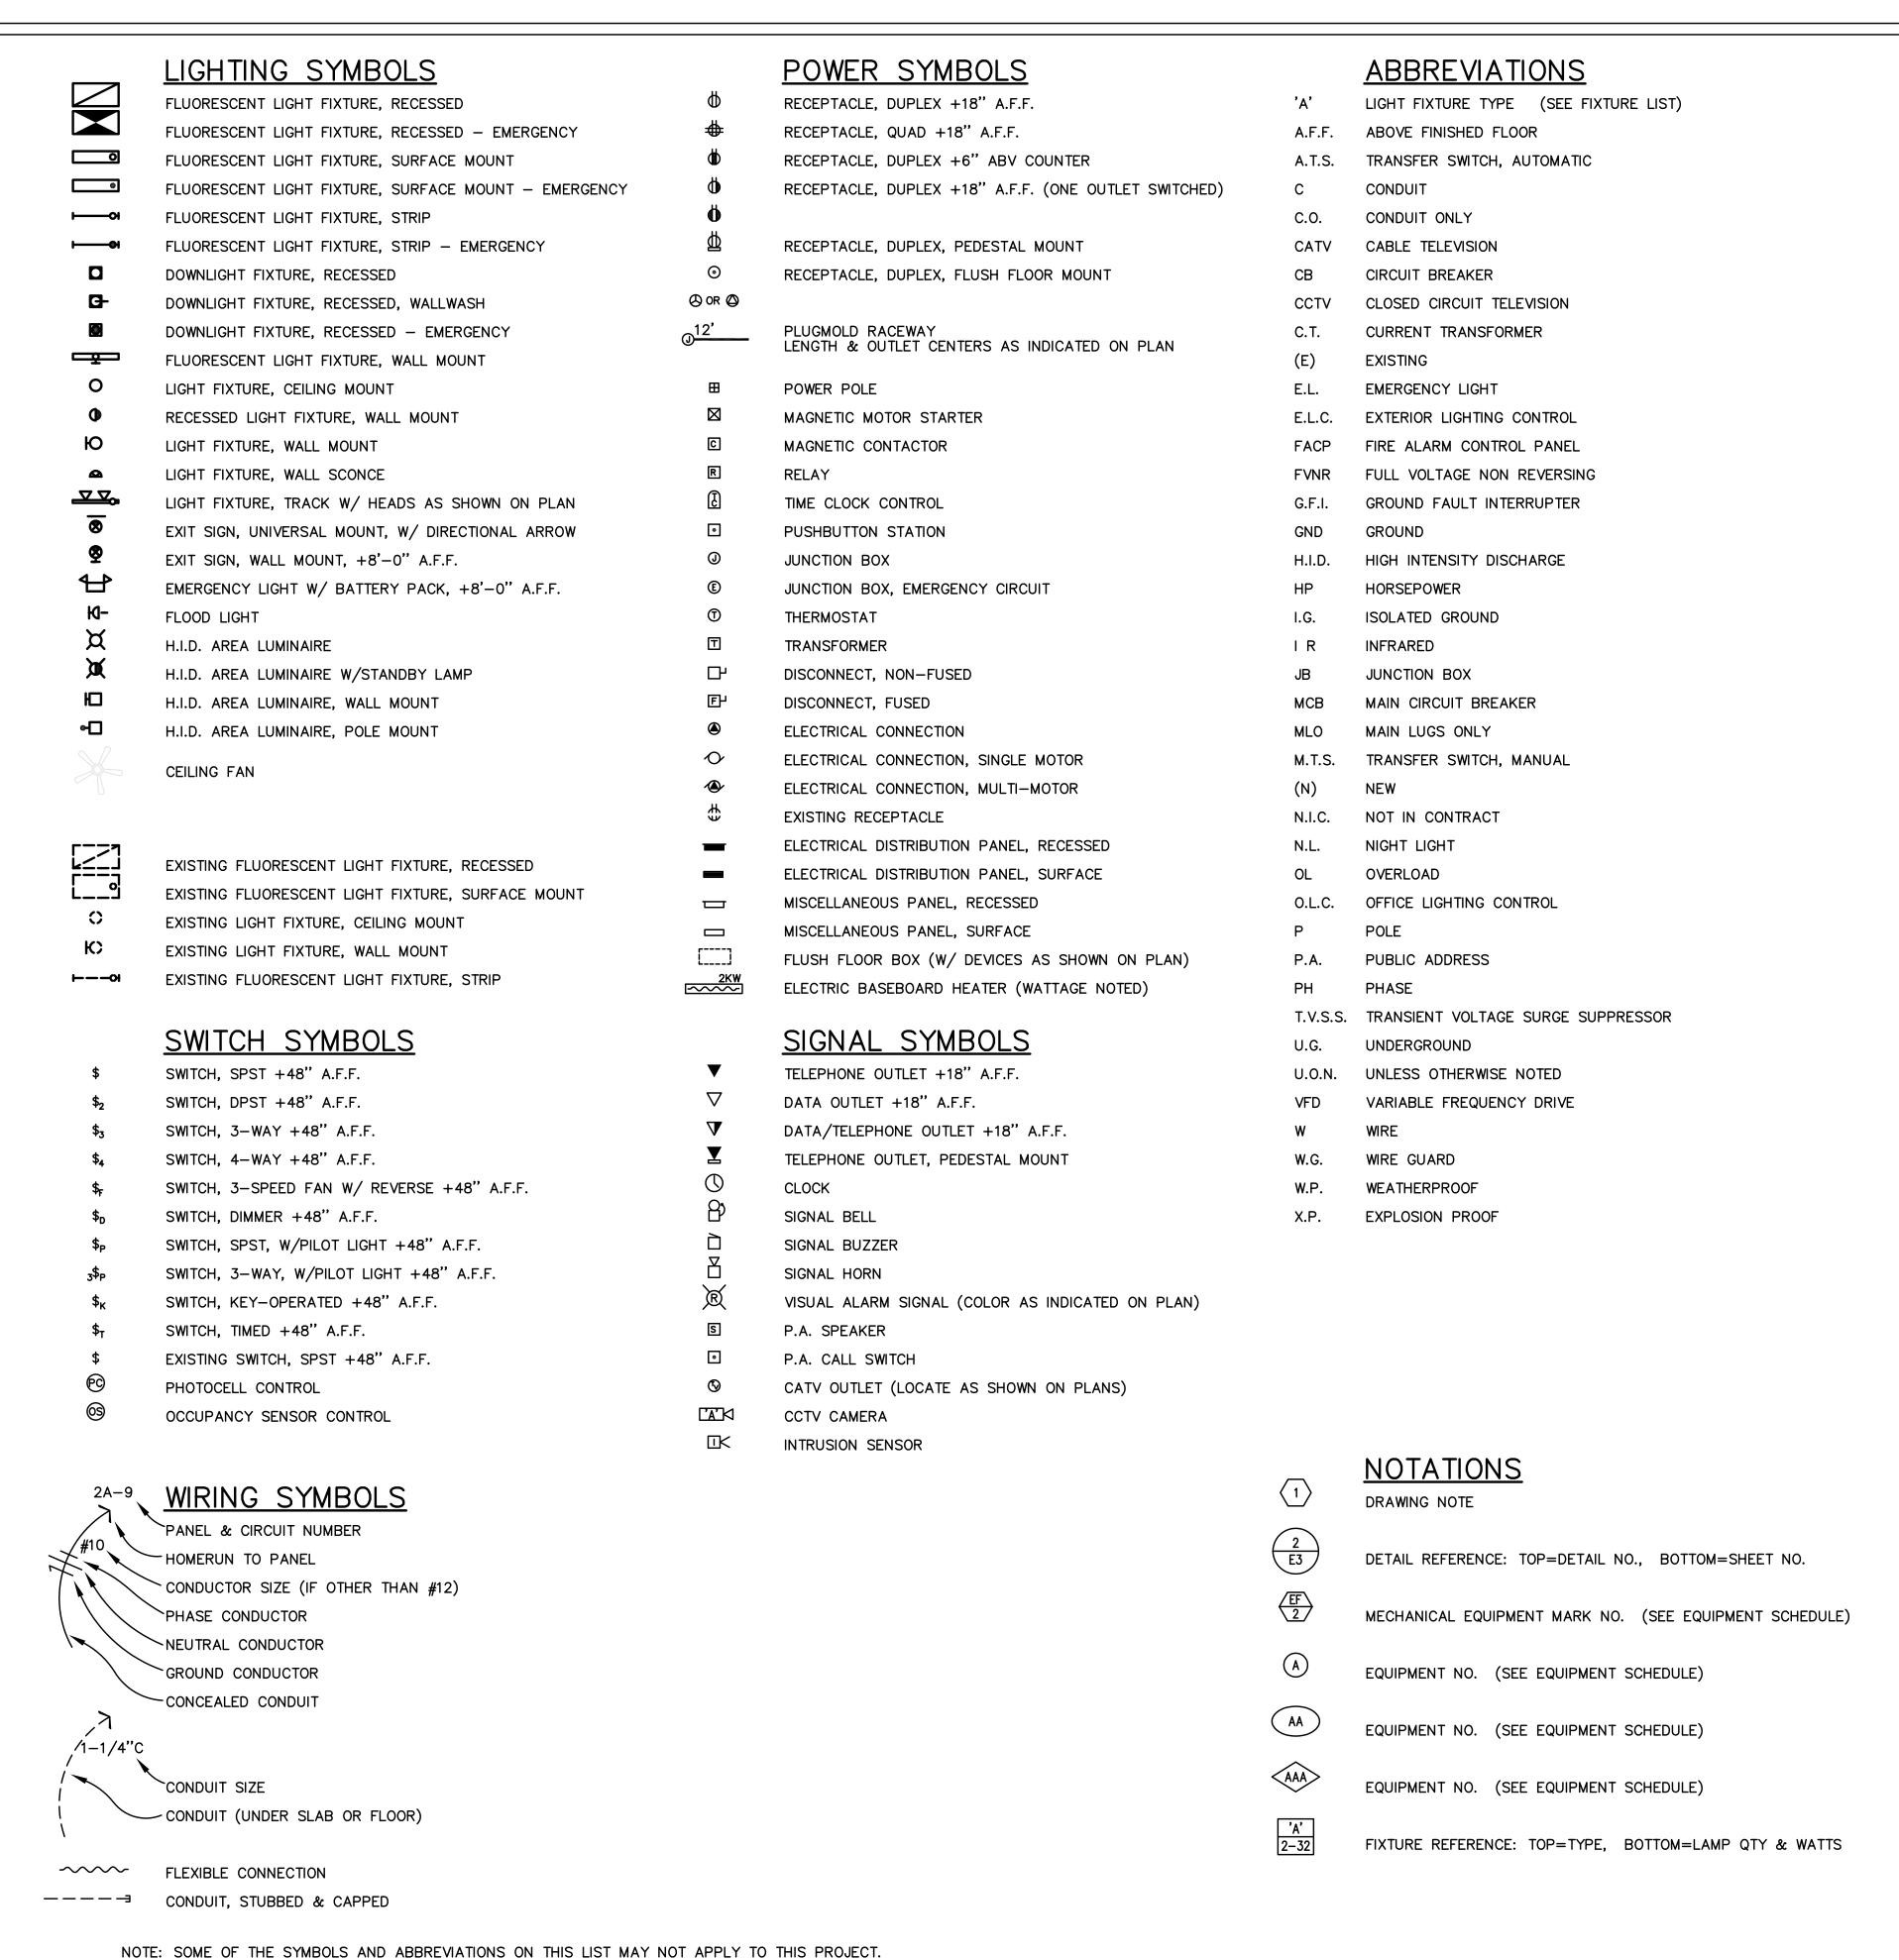

TYPE	LAMP	MANUFACTURER	CATALOG NUMBER	DESCRIPTION	OPTIONS
FA1 FA1E	(2) F32T8 (64W)	LITHONIA (OR APPROVED OTHER)	CLM SERIES	TYPE :4 FT WRAPAROUND MOUNTING :SURFACE HOUSING :STEEL LENS/REFL :ACRYLIC VOLTAGE :277V BALLAST :ELECTRONIC	TYPE 'FA1E' SIMILAR TO 'FA1' EXCEPT WITH EMERGENCY BATTERY BALLAST.
FA2	(2) F32T8 (64W)	LITHONIA (OR APPROVED OTHER)	AF SERIES	TYPE :4 FT INDUSTRIAL TRIP MOUNTING :CHAIN HUNG TO +8'-0" AFF HOUSING :STEEL LENS/REFL :NA VOLTAGE :277V BALLAST :ELECTRONIC	
FA3E	(2) 18 DTT (40W)	GOTHAM (OR APPROVED OTHER)	LAF SERIES	TYPE :11 INCH SQUARE DOWN LIGHT MOUNTING :RECESSED HOUSING :STEEL LENS/REFL :TEMPERED PRISMATIC LENS VOLTAGE :277V BALLAST :ELECTRONIC	REFER TO SHEET NOTES #7 & #8 ON SHEET E1.12 FOR ADDITIONAL INFORMATION. PROVIDE REMOTE EMERGENCY BATTERY PACK.
FB1 FB1E	(2) BF32T8 (64W)	LITHONIA (OR APPROVED OTHER)	GT8 SERIES	TYPE :2X2 TROFFER MOUNTING :RECESSED HOUSING :STEEL LENS/REFL :ACRYLIC VOLTAGE :277V BALLAST :ELECTRONIC	TYPE 'FB2E' SIMILAR TO 'FB2' EXCEPT WITH EMERGENCY BATTERY BALLAST.
FB2 FB2E	(2) F32T8 (64W)	LITHONIA (OR APPROVED OTHER)	GT8 SERIES	TYPE :2X4 TROFFER MOUNTING :RECESSED HOUSING :STEEL LENS/REFL :ACRYLIC VOLTAGE :277V BALLAST :ELECTRONIC	TYPE 'FB2E' SIMILAR TO 'FB2' EXCEPT WITH EMERGENCY BATTERY BALLAST.
CF	NONE 0.44 AMPS (122W)	ENVIROFAN (OR APPROVED OTHER)	SILVER LINE 60C-9 SERIES	TYPE :CEILING FAN (REVERSING) MOUNTING :SURFACE HOUSING :STEEL LENS/REFL:N/A VOLTAGE :277V BALLAST :N/A	SEE NOTES ON SHEET E1.11 FOR ADDITIONAL INFORMATION
CF1	0.30 AMPS (82W)	ENVIROFAN (OR APPROVED OTHER)	GOLD LINE 136F-7 SERIES	TYPE :CEILING FAN (REVERSING) MOUNTING :SURFACE HOUSING :STEEL LENS/REFL:N/A VOLTAGE :277V BALLAST :N/A	SEE NOTES ON SHEET E1.11 FOR ADDITIONAL INFORMATION CF1 TO BE USED IN ROOMS WITH 8'-0" CEILINGS. CONTRACTOR TO PROVIDE COMPARABLE ALTERNATIVE FOR LOW PROFILE FIXTURE

GENERAL LIGHTING NOTES:

- A. REFER TO ARCHITECTURAL REFLECTED CEILING PLANS FOR EXACT FIXTURE LOOCATION.
- B. ALL FIXTURES SHALL MEET SCHOOL DISTRICT STANDARDS. CONTRACTOR SHALL SUBMIT ALL PRODUCTS FOR APPROVAL PRIOR TO ROUGH IN.
- C. ALL FINISHES SHALL BE PER ARCHITECT'S DIRECTION.
- D. ALL CEILING FANS SHALL BE PROVIDED WITH ENVIROFAN SPEED CONTROL SWITCH MODEL 105FR WITH REVERSING CAPABILITY, OR APPROVED EQUAL. MOUNT SWITCH AT 48" A.F.F. AS INDICATED ON PLANS, UNLESS OTHERWISE

THIS DRAWING HAS BEEN UPDATED TO REFLECT CHANGES MADE DURING CONSTRUCTION BASED UPON INFORMATION FURNISHED TO THE ENGINEER BY THE INSTALLATION CONTRACTOR. NO WARRANTY EITHER EXPLICIT OR IMPLIED IS GIVEN BY MFIA, INC. AS TO THE ACCURACY AND/OR COMPLETENESS OF

THIS INFORMATION.

RECORD DRAWING:

Consulting Engineers 2007 S.E. Ash St. Portland, OR 97214 PHN: (503) 234-0548 FAX: (503) 234-0677 INC. WWW.MFIA-ENG.COM

14117.01 11-21-14 CHECKED BY DATE ADDENDUM 1 4/13/15

DRAWN BY

REVISIONS

COPYRIGHT 2015 STEELE ASSOCIATES ARCHITECTS LI All rights reserved. Reproduction or use in any form or by any means -graphic, electronic, mechanical, etc. -- without written permission of STEELE ASSOC. ARCHITECTS is unlawful and subject to criminal prosecution.

OCIA

REMO

ITAR

. LEMEN.