




4 ENLARGED SOUTH RESTROOM DEMO PLAN
SCALE: 1/4" = 1'-0"

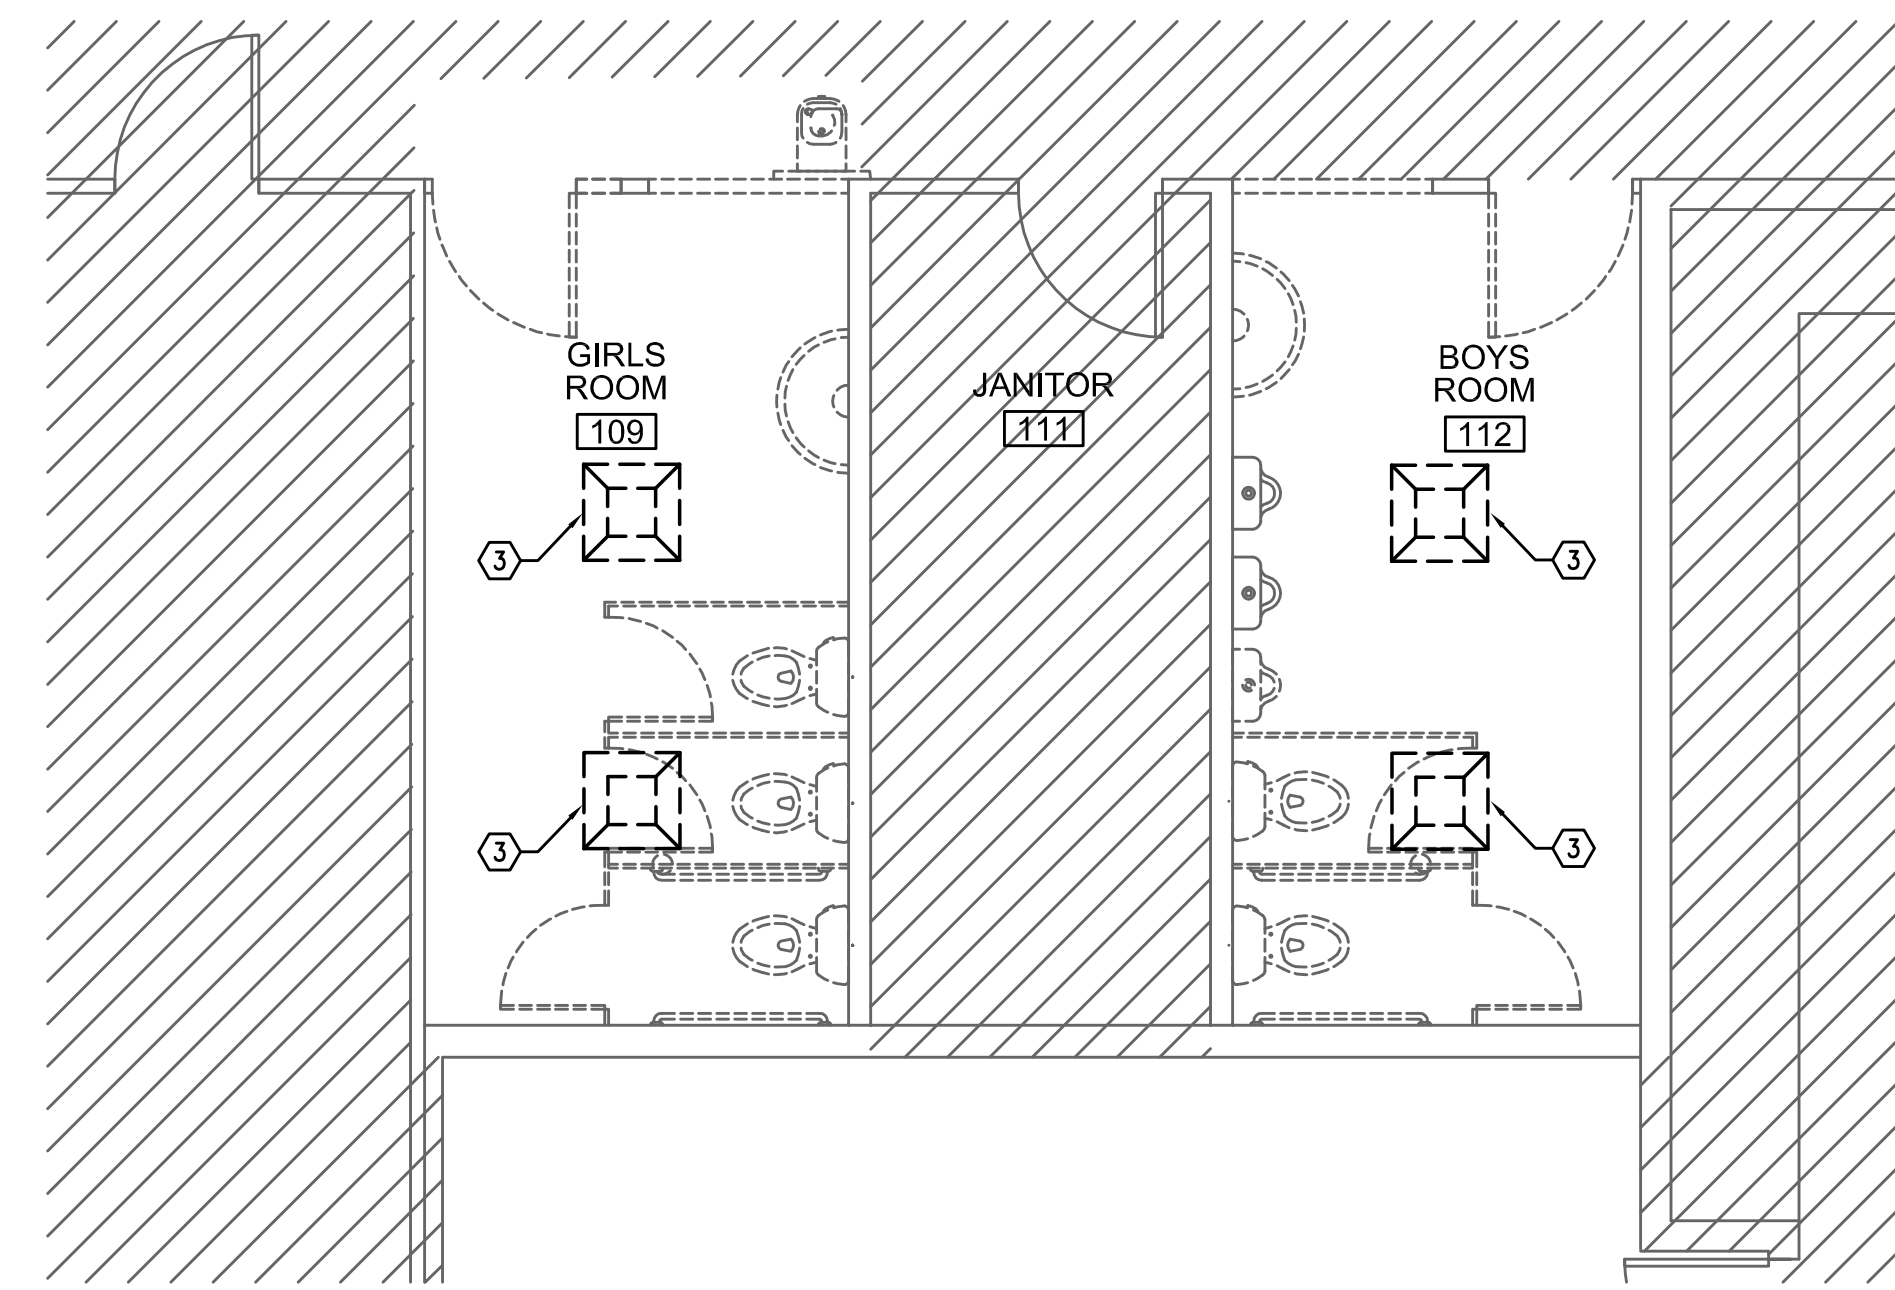

1 ENLARGED NORTH RESTROOM DEMO PLAN
SCALE: 1/4" = 1'-0"

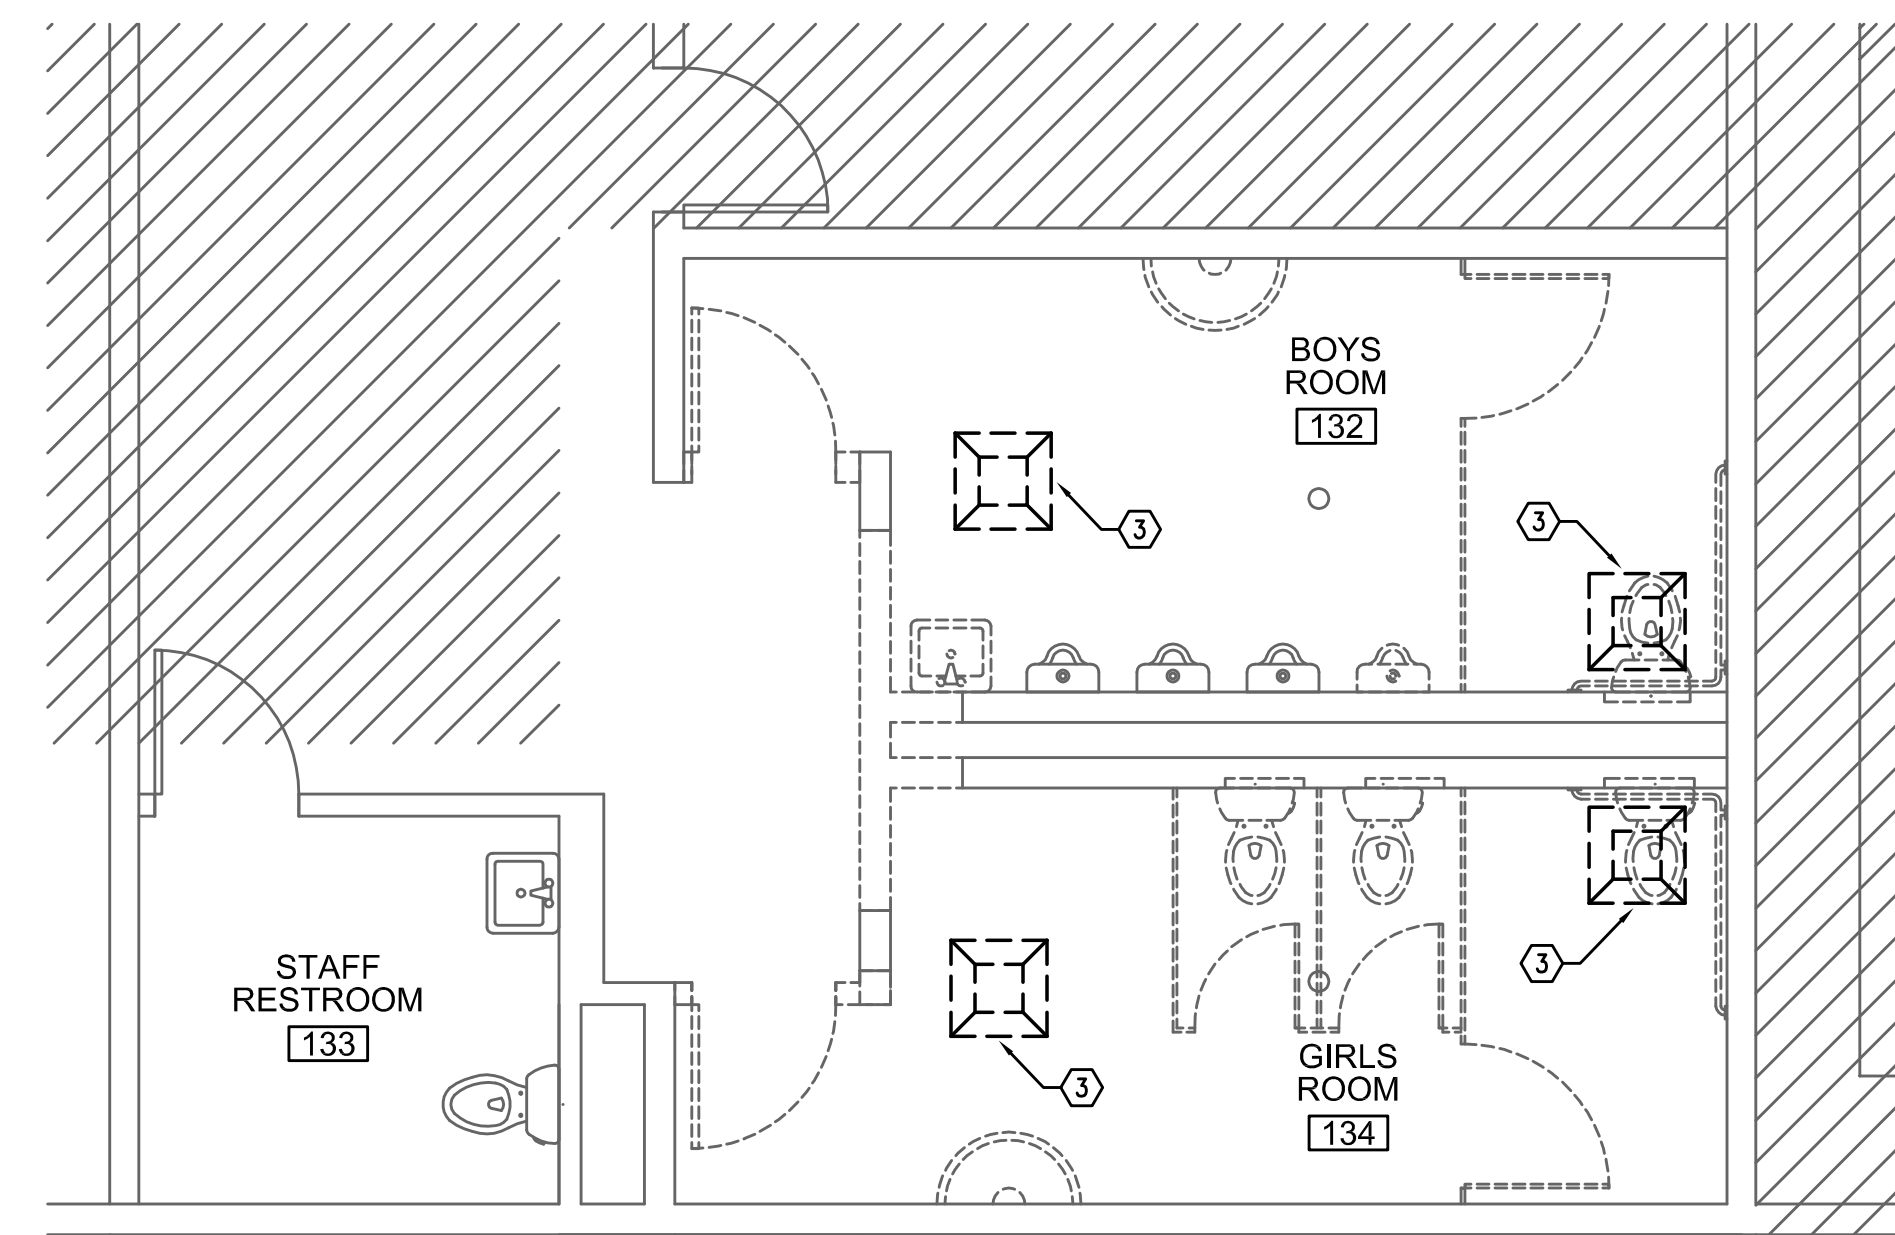

2 ENLARGED WEST RESTROOM DEMO PLAN
SCALE: 1/4" = 1'-0"

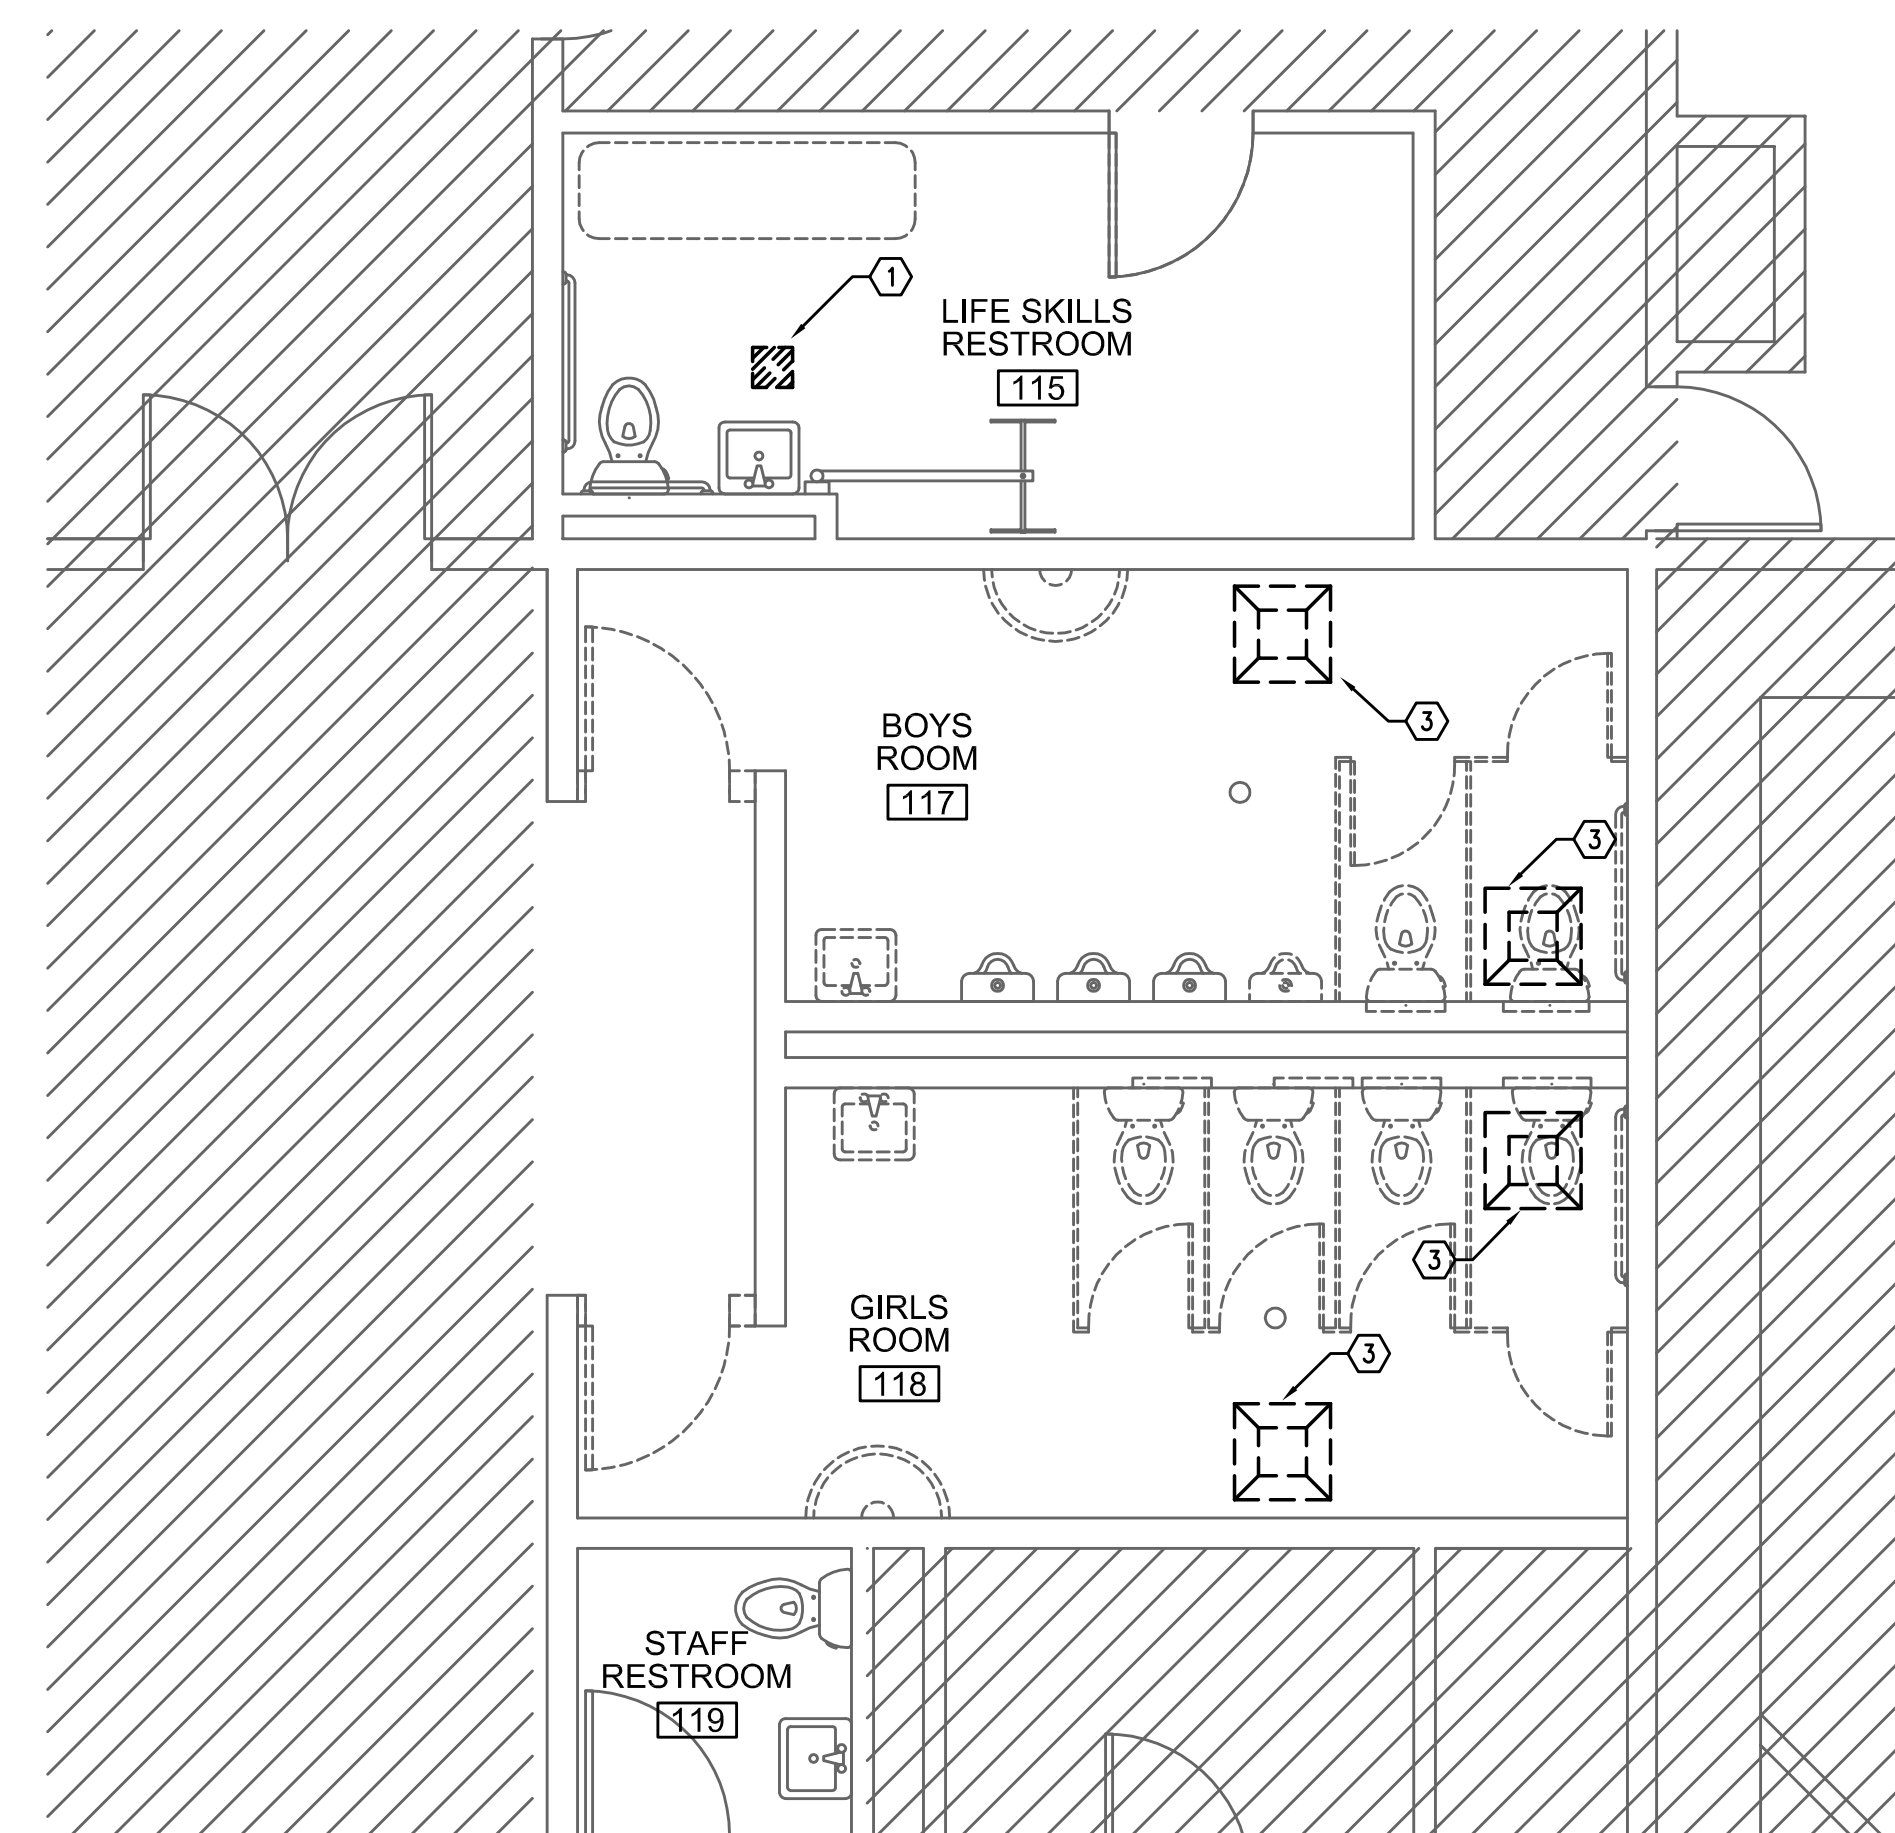

3 ENLARGED EAST RESTROOM DEMO PLAN
SCALE: 1/4" = 1'-0"

GENERAL NOTES:

1. VERIFY ALL EXISTING CONDITIONS RELATIVE TO THE SCOPE OF WORK.
2. COORDINATE WORK WITH OWNER, ELECTRICAL AND ARCHITECTURAL.
3. ALL FLOOR MOUNTED URINALS TO REMAIN EXCEPT WHERE NOTED OTHERWISE.

KEY NOTES:

- 1 REMOVE EXISTING EXHAUST FAN.
- 2 REMOVE EXISTING EXHAUST DUCTWORK UP TO STRUCTURE.
- 3 REMOVE SUPPLY DIFFUSER OR EXHAUST GRILLE.
- 4 RELOCATE EXISTING THERMOSTAT

RECORD DRAWING:

THIS DRAWING HAS BEEN UPDATED TO REFLECT CHANGES MADE DURING CONSTRUCTION BASED UPON INFORMATION FURNISHED TO THE ENGINEER BY THE INSTALLATION CONTRACTOR. NO WARRANTY, EITHER EXPLICIT OR IMPLIED IS GIVEN BY MFA, INC. AS TO THE ACCURACY AND/OR COMPLETENESS OF THIS INFORMATION.

M Consulting Engineers
2007 S.E. Ash St.
Portland, OR 97214
PH: (503) 234-0548
FAX: (503) 234-0677
INC. WWW.MFA-ENG.COM
CONTACT: JIM TORMEY

RECORD SET
1/29/2016

COPYRIGHT 2015
STEELE ASSOCIATES ARCHITECTS LLC
All rights reserved. Reproduction or
use in any form or by any means --
graphic, electronic, mechanical, etc.
-- without written permission of
STEELE ASSOCIATES ARCHITECTS LLC is
and subject to criminal prosecution.

STEELE ASSOCIATES
ARCHITECTS LLC

760 NW YORK DRIVE, SUITE 200
BEND, OR 97701
541.382.9867 FAX 541.385.8816
info@steele-arch.com



JEWELL ELEMENTARY REMODEL

20350 MURPHY ROAD

OREGON

BEND ENLARGED MECHANICAL DEMO PLANS

PRINTS ISSUED: DATE:

JOB NO. 14117.01

DATE 11-21-14

DRAWN BY BPCG CHECKED BY JLT

REVISIONS APPENDIX 1 DATE 4/13/15

SHEET NO.

M1.02

OF SHEETS

RECORD SET - JANUARY 29, 2016