

ELECTRICAL SYMBOL LIST

LIGHTING SYMBOLS

	LIGHT FIXTURE, RECESSED
	LIGHT FIXTURE, RECESSED - EMERGENCY
	LIGHT FIXTURE, SURFACE MOUNT
	LIGHT FIXTURE, SURFACE MOUNT - EMERGENCY
	LIGHT FIXTURE, STRIP
	LIGHT FIXTURE, STRIP - EMERGENCY
	DOWNLIGHT FIXTURE, RECESSED
	DOWNLIGHT FIXTURE, RECESSED, WALLWASH
	DOWNLIGHT FIXTURE, RECESSED - EMERGENCY
	LIGHT FIXTURE, WALL MOUNT
	LIGHT FIXTURE, CEILING MOUNT
	RECESSED LIGHT FIXTURE, WALL MOUNT
	LIGHT FIXTURE, WALL MOUNT
	LIGHT FIXTURE, COVE - RECESSED
	LIGHT FIXTURE, COVE - SURFACE
	LIGHT FIXTURE, UNDER CABINET/SHELF
	EXIT SIGN, UNIVERSAL MOUNT, W/ DIRECTIONAL ARROW
	EXIT SIGN, WALL MOUNT, +8'-0" A.F.F.
	EMERGENCY LIGHT W/ BATTERY PACK, +8'-0" A.F.F.
	FLOOD LIGHT
	AREA LUMINAIRE, POST TOP
	AREA LUMINAIRE, BOLLARD
	AREA LUMINAIRE, WALL MOUNT
	AREA LUMINAIRE, POLE MOUNT

SWITCH SYMBOLS

	SWITCH, SPST +48" A.F.F.
	SWITCH, DPST +48" A.F.F.
	SWITCH, 3-WAY +48" A.F.F.
	SWITCH, 4-WAY +48" A.F.F.
	SWITCH, MOMENTARY +48" A.F.F.
	SWITCH, DIMMER +48" A.F.F.
	SWITCH, SPST, W/PILOT LIGHT +48" A.F.F.
	SWITCH, 3-WAY, W/PILOT LIGHT +48" A.F.F.
	SWITCH, KEY-OPERATED +48" A.F.F.
	SWITCH, TIMED +48" A.F.F.
	EXISTING SWITCH, SPST
	PHOTOCELL CONTROL
	OCCUPANCY SENSOR CONTROL

WIRING SYMBOLS

	PANEL & CIRCUIT NUMBER
	HOMERUN TO PANEL
	CONDUCTOR SIZE (IF OTHER THAN #12)
	PHASE CONDUCTOR
	NEUTRAL CONDUCTOR
	GROUND CONDUCTOR
	CONCEALED CONDUIT
	CONDUIT SIZE
	CONDUIT (UNDER SLAB OR FLOOR)
	FLEXIBLE CONNECTION
	CONDUIT, STUBBED & CAPPED
	NORMAL POWER CIRCUIT LINETYPE
	EMERGENCY POWER CIRCUIT LINETYPE
	EXISTING POWER CIRCUIT LINETYPE

FIRE RATED INSTALLATION NOTE:
ELECTRICAL ITEMS (LIGHT FIXTURES, BOXES, ETC.) WHICH ARE RECESSED INTO FIRE-RATED CEILINGS OR WALLS, SHALL BE 'ALCOVED' IN GYPSUM BOARD ENCLOSURES PER ARCHITECTURAL DETAILS, OR THE DEVICES SHALL BE 'UL' LISTED WITH FIRE-RATING EQUAL TO OR GREATER THAN THE FIRE-RATING OF THE ADJACENT CONSTRUCTION.

POWER SYMBOLS

	RECEPTACLE, SINGLE +18" A.F.F.
	RECEPTACLE, DUPLEX +18" A.F.F.
	RECEPTACLE, QUAD +18" A.F.F.
	RECEPTACLE, DUPLEX +6" ABV COUNTER
	RECEPTACLE, DUPLEX +18" A.F.F. (ONE OUTLET SWITCHED)
	RECEPTACLE, DUPLEX +18" A.F.F. (BOTH OUTLETS SWITCHED)
	RECEPTACLE, DUPLEX, PEDESTAL MOUNT
	RECEPTACLE, DUPLEX, FLUSH FLOOR MOUNT
	RECEPTACLE, SPECIAL (COORDINATE WITH EQUIPMENT SERVED)
	RELAY
	TIME CLOCK CONTROL
	PUSHBUTTON STATION
	JUNCTION BOX
	JUNCTION BOX, EMERGENCY CIRCUIT
	THERMOSTAT
	TRANSFORMER
	DISCONNECT, NON-FUSED
	DISCONNECT, FUSED
	ELECTRICAL CONNECTION
	ELECTRICAL CONNECTION, SINGLE MOTOR
	ELECTRICAL CONNECTION, MULTI-MOTOR
	ELECTRICAL DISTRIBUTION PANEL, RECESSED
	ELECTRICAL DISTRIBUTION PANEL, SURFACE
	MISCELLANEOUS PANEL, RECESSED
	MISCELLANEOUS PANEL, SURFACE
	FLUSH FLOOR BOX (W/ DEVICES AS SHOWN ON PLAN)
	FIRE SMOKE DAMPER

ONE-LINE DIAGRAM SYMBOLS

	ELECTRICAL DISTRIBUTION PANELBOARD (MLO)
	ELECTRICAL DISTRIBUTION PANELBOARD (MCB)
	SUB-FEED CIRCUIT BREAKER
	CIRCUIT BREAKER (TRIP RATING & POLES AS INDICATED ON PLAN)
	MAIN SWITCH (RATING & POLES AS INDICATED ON PLAN)
	FUSE (RATING & CLASS AS INDICATED ON PLAN)
	TRANSFER SWITCH (MANUAL OR AUTOMATIC)
	GENERATOR (RATING AS INDICATED ON PLAN)
	TRANSFORMER (RATING AS INDICATED ON PLAN)
	FUSE (RATING & CLASS AS INDICATED ON PLAN)
	GROUND SYSTEM (SIZE AS INDICATED ON PLAN)
	WATER PIPE GROUND ELECTRODE
	TRANSIENT VOLTAGE SURGE SUPPRESSOR
	UTILITY METER & METER BASE
	UTILITY METER CURRENT TRANSFORMER
	FEEDER NO. (SEE FEEDER SCHEDULE)
	POTENTIAL TRANSFORMER (RATING AS INDICATED ON PLANS)

ABBREVIATIONS

'A'	LIGHT FIXTURE TYPE (SEE FIXTURE LIST)
A.F.F.	ABOVE FINISHED FLOOR
A.F.G.	ABOVE FINAL GRADE
A.F.I.	ARC FAULT INTERRUPTER
A.T.S.	TRANSFER SWITCH, AUTOMATIC
C	CONDUIT
C.O.	CONDUIT ONLY
CATV	CABLE TELEVISION
CB	CIRCUIT BREAKER
CCTV	CLOSED CIRCUIT TELEVISION
C.T.	CURRENT TRANSFORMER
(E)	EXISTING
E.L.	EMERGENCY LIGHT
E.L.C.	EXTERIOR LIGHTING CONTROL
FACP	FIRE ALARM CONTROL PANEL
G.F.I.	GROUND FAULT INTERRUPTER
GND	GROUND
H.I.D.	HIGH INTENSITY DISCHARGE
HP	HORSEPOWER
I.G.	ISOLATED GROUND
I R	INFRARED
JB	JUNCTION BOX
LCP	LIGHTING CONTROL PANEL
MCB	MAIN CIRCUIT BREAKER
MLO	MAIN LUGS ONLY
M.T.S.	TRANSFER SWITCH, MANUAL
(N)	NEW
N.I.C.	NOT IN CONTRACT
N.L.	NIGHT LIGHT
OL	OVERLOAD
O.L.C.	OFFICE LIGHTING CONTROL
P	POLE
P.A.	PUBLIC ADDRESS
PC	PARTIAL CIRCUIT
PH	PHASE
PRI	PRIMARY
R.T.U.	REMOTE TELEMETRY UNIT
SEC	SECONDARY
SCCR	SHORT CIRCUIT CURRENT RATING
T.V.S.S.	TRANSIENT VOLTAGE SURGE SUPPRESSOR
U.G.	UNDERGROUND
U.O.N.	UNLESS OTHERWISE NOTED
VFD	VARIABLE FREQUENCY DRIVE
W	WIRE
W.G.	WIRE GUARD
W.P.	WEATHERPROOF
W.T.	WATERTIGHT
X.P.	EXPLOSION PROOF

NOTATIONS

	DRAWING NOTE
	DETAIL REFERENCE: TOP=DETAIL NO., BOTTOM=SHEET NO.
	MECHANICAL EQUIPMENT MARK NO. (SEE EQUIPMENT SCHEDULE)
	EQUIPMENT NO. (SEE EQUIPMENT SCHEDULE)
	EQUIPMENT NO. (SEE EQUIPMENT SCHEDULE)
	EQUIPMENT NO. (SEE EQUIPMENT SCHEDULE)
	FIXTURE REFERENCE: TOP=TYPE, BOTTOM=LAMP QTY & WATTS

GENERAL CONSTRUCTION NOTES:

CONTRACTOR SHALL BE RESPONSIBLE FOR THOROUGHLY REVIEWING THE PLANS AND SPECIFICATION DOCUMENTS PRIOR TO THE START OF ANY WORK. ANY DISCREPANCIES IN THE PROJECT DOCUMENTS SHALL BE BROUGHT TO THE ATTENTION OF THE ARCHITECT IMMEDIATELY AND PRIOR TO THE START OF ANY WORK.

ALL DIMENSIONS ARE MEASURED TO THE CENTER OF THE DEVICE ABOVE FINISHED FLOOR UNLESS OTHERWISE NOTED AS IS STANDARD BUILDING PRACTICE.

ALL ELECTRICAL PLANS ARE DIAGRAMMATICAL AND THE CONTRACTOR SHALL CONSULT THE ARCHITECTURAL PLANS AND ELEVATIONS FOR EXACT LOCATION AND MOUNTING HEIGHTS OF DEVICES AND FIXTURES.

THE ELECTRICAL CONTRACTOR SHALL REVIEW ALL PROJECT DOCUMENTATION AND COORDINATE WITH ALL OTHER TRADES THROUGHOUT THE COURSE OF THE PROJECT.

ALL WORK SHALL BE IN ACCORDANCE WITH ALL NATIONAL, STATE AND LOCAL CODES. CONTRACTOR SHALL BE RESPONSIBLE TO BE INFORMED OF ALL SUCH CODES AS THEY APPLY TO THE SCOPE OF THE PROJECT.

GENERAL NOTES:

- ELECTRICAL DRAWINGS ARE DIAGRAMMATICAL AND MAY NOT ACCURATELY REFLECT ACTUAL CONSTRUCTION CONDITIONS. THE ELECTRICAL CONTRACTOR SHALL BE RESPONSIBLE FOR COORDINATING THE INSTALLATION OF ALL ELECTRICAL EQUIPMENT, WITH ALL TRADES PRIOR TO AND DURING CONSTRUCTION.
- ALL WORK SHALL BE DONE IN ACCORDANCE WITH ALL APPLICABLE LOCAL, STATE & NATIONAL CODES.
- CONTRACTOR SHALL REVIEW THE DIVISION 26 SPECIFICATIONS AND THE ENTIRE DRAWING PACKAGE FOR THIS PROJECT PRIOR TO THE START OF ANY WORK.
- THE ELECTRICAL CONTRACTOR SHALL CONSULT WITH ALL OTHER TRADES AND PROVIDE THE APPROPRIATE POWER CONNECTION(S) AND COORDINATE EXACT LOCATIONS PRIOR TO ROUGH IN.
- THE ELECTRICAL CONTRACTOR SHALL IMMEDIATELY ADVISE THE ARCHITECT OF ANY DISCREPANCIES DISCOVERED WITHIN THE DOCUMENTS.
- ALL PRODUCT SUBMITTALS AND SUBSTITUTIONS SHALL BE PROVIDED TO THE ARCHITECT FOR REVIEW AND APPROVAL PRIOR TO PLACING ANY ORDERS.
- THE ELECTRICAL CONTRACTOR SHALL REFER TO THE ARCHITECTURAL DRAWINGS FOR ALL MOUNTING HEIGHTS AND FINISHES OF DEVICES AND FIXTURES.
- REFER TO ENLARGED TYPICAL UNIT PLANS (E4 SERIES SHEETS) FOR TYPICAL POWER & LIGHTING LAYOUTS FOR THE APARTMENT UNITS.
- REFER TO INTERIOR DECORATOR AND/OR ARCHITECTURAL DRAWINGS FOR EXACT LOCATION(S) AND ELEVATIONS FOR FIXTURES & DEVICES.
- ELECTRICAL PANELS LOCATED IN PUBLIC OR UNSECURED SPACES SHALL BE PROVIDED WITH A LOCKABLE DOOR PANEL.
- SERVICE ENTRANCE AND METERING EQUIPMENT SHOWN TO APPROXIMATE SCALE, BASED ON INDUSTRY STANDARD PRODUCTS. ELECTRICAL CONTRACTOR SHALL ENSURE THAT ALL EQUIPMENT WILL FIT THE SPACE AND MAINTAIN REQUIRED WORKING CLEARANCES.
- COORDINATE WITH LOCAL UTILITY PROVIDER FOR EXACT SERVICE CONDUIT AND CONDUCTORS REQUIREMENTS.
- ALL UTILITY WORK SHALL BE DONE IN ACCORDANCE WITH THE UTILITY PROVIDER'S ELECTRICAL SERVICE REQUIREMENTS.
- THERE SHALL BE NO SURFACE MOUNTED DEVICES OR PATHWAYS (CONDUIT, ETC.) IN ANY PUBLICLY ACCESSIBLE SPACES, INCLUDING STAIRWELLS AND EXIT PASSAGEWAYS WITHOUT PRIOR APPROVAL BY OWNER AND ARCHITECT. ROUTE ALL PATHWAYS WITHIN STUD CAVITIES OR ABOVE FINISHED CEILINGS.
- ELECTRICAL CONTRACTOR SHALL CONSULT ARCHITECTURAL AND INTERIOR DECORATOR'S PLAN DOCUMENTS SUCH AS INTERIOR ELEVATIONS, REFLECTED CEILING PLANS, ETC., FOR FIXTURE AND DEVICE DIMENSIONS NOT OTHERWISE NOTED ON THE ELECTRICAL PLANS.


- SYMBOLS & ABBREVIATIONS MAY OR MAY NOT APPLY TO PROJECT
- REFER TO LOW VOLTAGE DRAWINGS FOR ASSOCIATED SYMBOLS

STUDIO

3

ARCHITECTURE
INCORPORATED

275 COURT ST. NE
SALEM, OR 97301-3442
P: 503.390.6500
www.studio3architecture.com

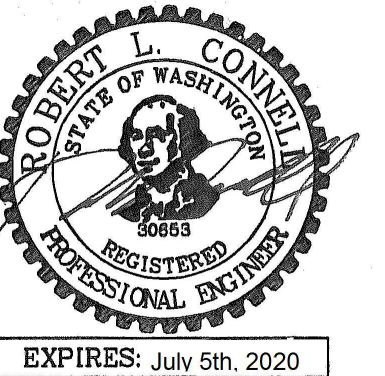

IN THE EVENT CONFLICTS ARE DISCOVERED BETWEEN THE ORIGINAL SIGNED AND SEALED DOCUMENTS PREPARED BY THE ARCHITECTS AND/OR THEIR CONSULTANTS, AND ANY COPY OF THE DOCUMENTS TRANSMITTED BY MAIL, FAX, ELECTRONICALLY OR OTHERWISE, THE ORIGINAL SIGNED AND SEALED DOCUMENTS SHALL GOVERN.

PROJECT # 2017-053
DATE: 11/06/2019
REVISIONS

- PLAN REVIEW 01.24.2020
- PLAN REVIEW 03.13.2020
- PLAN REVIEW 04.24.2020
- PLAN REVIEW 08.10.2020
- PLAN REVIEW 09.17.2020
- PLAN REVIEW 10.16.2020
- PLAN REVIEW 11.25.2020
- PLAN REVIEW 03.26.2021
- PLAN REVIEW 07.15.2021
- COORDINATION 08.27.2021
- COORDINATION 11.05.2021
- COORDINATION 12.10.2021

AEGIS
MIXED-USE DEVELOPMENT
312 E EVERGREEN BOULEVARD, VANCOUVER, WA 98660

SHEET:


E1.00

MFA
Consulting Engineers
2007 S.E. Ash St.
Portland, OR 97214
PHN: (503) 234-0548
FAX: (503) 234-0677
CONTACT: DENISE TAYLOR


C STREET

E. 12TH ST.

E. EVERGREEN BLVD.

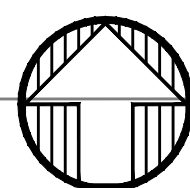

1 SITE ELECTRICAL PLAN
E1.01
SCALE: 1" = 30'-0"

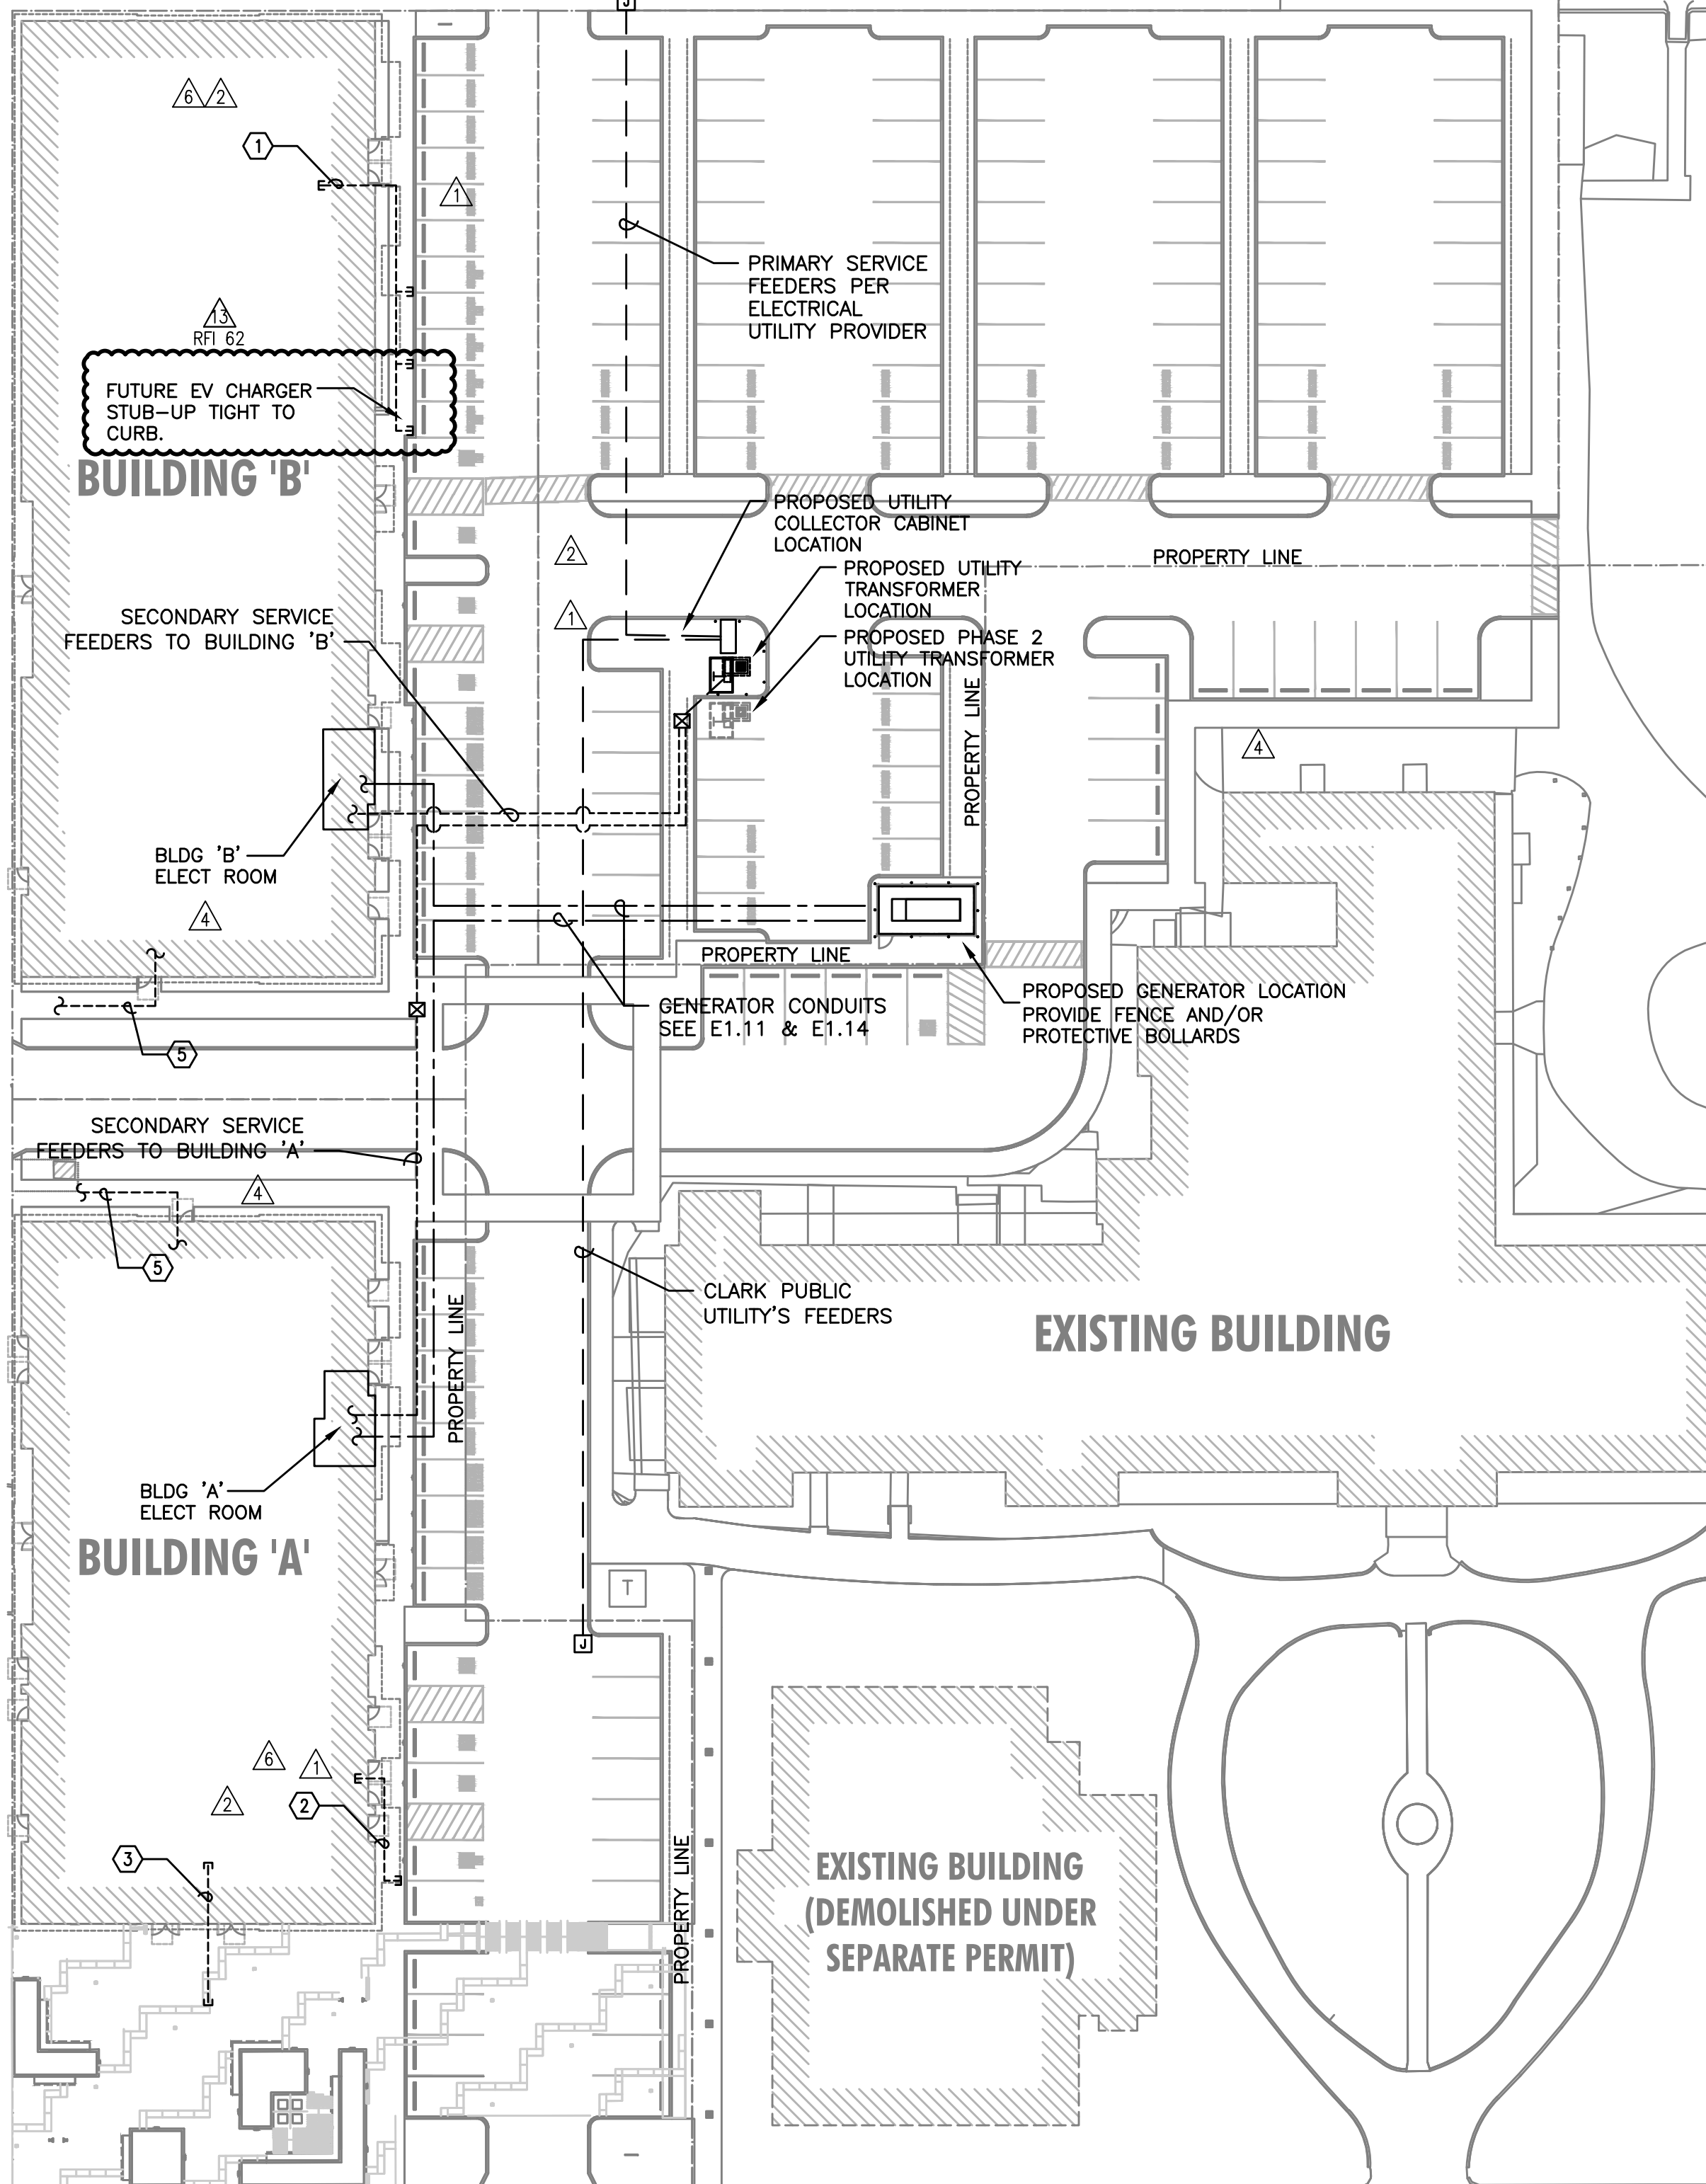

GENERAL NOTES:

- ALL WORK SHALL BE PERFORMED IN ACCORDANCE WITH ALL APPLICABLE LOCAL, STATE AND NATION CODES.
- ALL PLANS ARE CONSIDERED DIAGRAMMATICAL. THEREFORE ALL EQUIPMENT SIZES AND DEVICE LOCATIONS ARE APPROXIMATE AND SUBJECT TO FIELD CONDITIONS AND PRODUCT APPROVAL.
- ELECTRICAL SERVICE ENTRANCE EQUIPMENT DESIGN IS BASED ON SIEMENS PRODUCTS. ACTUAL PRODUCTS INSTALLED MAY DIFFER IN SIZE AND CONFIGURATION AND SHALL BE DOCUMENTED IN FINAL PROJECT DOCUMENTS.
- COORDINATE WITH LOCAL UTILITY PROVIDER FOR EXACT SERVICE CONDUIT AND CONDUCTORS REQUIREMENTS.
- ALL UTILITY WORK SHALL BE DONE IN ACCORDANCE WITH CLARK PUBLIC UTILITIES ELECTRICAL SERVICE REQUIREMENTS.
- U.G. PRIMARY FEEDER SHALL HAVE A MINIMUM 48 INCH BURY.
- U.G. SECONDARY FEEDER SHALL HAVE A MINIMUM 36 INCH BURY.
- REFER TO SHEETS E1.11 & E1.14 FOR ONE-LINE DIAGRAM, LOAD SUMMARY INFORMATION AND TYPICAL FEEDER SCHEDULE.
- SECONDARY CONDUIT SWEEPS SHALL BE MINIMUM 60 INCH RADIUS WITH A MINIMUM OF 7'-0" STRAIGHT CONDUIT RUN BETWEEN SWEEPS.
- CONTRACTOR SHALL REVIEW CLARK PUBLIC UTILITIES ELECTRICAL SERVICE REQUIREMENTS PRIOR TO THE START OF ANY WORK.
- LOCATION AND INSTALLATION OF THE PRIMARY AND SECONDARY CONDUITS, TRANSFORMER, ETC. SHALL BE PROVIDED PER CLARK PUBLIC UTILITIES ELECTRICAL SERVICE REQUIREMENTS.
- CONTRACTOR SHALL REVIEW ALL PROJECT DOCUMENTS AND SPECIFICATIONS IN DETAIL AND REFER TO THE DOCUMENTS THROUGHOUT THE CONSTRUCTION.

KEYED POWER NOTES:

- ROUTE (3) 3/4" PVC CONDUIT W/PULL STRING FROM BUILDING 'B' ELECTRICAL ROOM #198 TO PARKING LOT LOCATION FOR FUTURE EV CHARGING STATION. STUB-UP FLUSH WITH FINISHED GRADE AND CAP AT BOTH ENDS. RESERVE (4) 40A, 208V, 1P CIRCUITS IN PANEL 'M1' FOR FUTURE ELECTRICAL CONNECTION.
- ROUTE ONE 3/4" PVC CONDUIT W/PULL STRING FROM BUILDING 'A' ELECTRICAL ROOM #292 TO PARKING LOT LOCATION FOR FUTURE EV CHARGING STATION. STUB-UP FLUSH WITH FINISHED GRADE AND CAP AT BOTH ENDS. RESERVE ONE 40A, 208V, 1P CIRCUITS IN PANEL 'M1' FOR FUTURE ELECTRICAL CONNECTION.
- PROVIDE (2) 3/4" PVC CONDUIT W/PULL STRING, ROUTED UNDERGROUND FROM MAINTENANCE ROOM #192A TO BUILDING EXTERIOR FOR FUTURE CCTV CONNECTIONS AND CAP AT BOTH ENDS.
- NOT USED.
- PROVIDE (1) 3/4" PVC CONDUIT W/PULL STRING, ROUTED UNDERGROUND FROM RISER ROOM #196B TO BUILDING EXTERIOR FOR IRRIGATION AND CAP AT BOTH ENDS. VERIFY EXACT LOCATION WITH LANDSCAPING AND/OR CIVIL.

CONTRACTOR TO LOCATE ALL UNDERGROUND UTILITIES BEFORE TRENCHING.

UTILITY REQUIREMENTS

- CUSTOMER TO PROVIDE ALL TRENCHING AND BACKFILLING. TRENCH TO BE 36 INCHES DEEP AND 30 INCHES WIDE, MEASURED FROM FINAL GRADE.
- ALL UTILITY CONDUCTORS TO BE INSTALLED IN GRAY SCHEDULE 40, ELECTRICAL GRADE, PVC CONDUIT WITH NYLON PULL STRINGS (MIN 500 LBS. TEST). CLARK PUBLIC UTILITIES TO DETERMINE THE SIZE AND NUMBER OF CONDUITS REQUIRED. ALL ELBOWS TO BE 36 INCH (MIN) RADIUS. ALL BENDS MAY BE FACTORY MADE. IF MORE THAN 270 DEGREES OF BENDS OR IF RUN IS LONGER THAN 150 FEET, BENDS MUST BE RIGID STEEL.
- CONSULT WITH UTILITY REPRESENTATIVE 2 WEEKS BEFORE STARTING MAIN POWER TRENCHING FOR A PRE-CONSTRUCTION CONFERENCE. INCLUDED IN THIS CONFERENCE WILL BE EXCAVATOR, CPU, TELCO, CATV, AND GAS.
- ELECTRICAL UTILITY PROVIDER:
CLARK PUBLIC UTILITIES
CONSTRUCTION SERVICES
360.992.8558

INCOMING ELECTRICAL SERVICE DIVISION OF RESPONSIBILITY					
	ELEC. CONTR.	UTILITY CO.		ELEC. CONTR.	UTILITY CO.
PRIMARY CONDUIT	[X]	☐	SECONDARY CONDUIT	[X]	☐
PRIMARY CONDUCTORS	[X]	☐	SECONDARY CONDUCTORS	[X]	☐
TRANSFORMER	[X]	☐	O/T ENCLOSURE	[X]	☐
TRANSFORMER PAD	[X]	☐	O/T's	☐	[X]
PRIMARY GROUNDING	[X]	☐	METER BASE	[X]	☐
BOLLARDS	[X]	☐	METER	☐	[X]
TRANSFORMER CONNECTIONS	[X]	☐	METER GROUNDING	[X]	☐
ELECTRIC ROOM DOOR	[X]	☐			
LOCK BOX (OBTAIN FROM POWER COMPANY)		☐			

NOTES:

- CONTACT AND COORDINATE ALL REQUIREMENTS AND RESPONSIBILITIES WITH SERVING UTILITY COMPANIES PRIOR TO SUBMITTING BID.
- ALL SERVICE INSTALLATION WORK SHALL BE IN STRICT COMPLIANCE WITH THE REQUIREMENTS OF THE SERVING UTILITIES.

POWER/UTILITY CONTACT: CHARLIE BEATTY CLARK PUBLIC UTILITIES OFFICE: (360) 992-8721 CELL: (360) 253-0281 EMAIL: CBEATTY@CLARK.PUD.COM	TELEPHONE/UTILITY CONTACT: MANDY STUBBLEFIELD CENTURYLINK PHONE: MANDY.STUBBLEFIELD@CENTURYLINK.COM	CABLE/TV/UTILITY CONTACT: BOB MILLAR COMCAST PHONE: (360) 316-1128 EMAIL: BOB.MILLAR@COMCAST.COM
---	---	---

INTERFACE ENGINEERING, INC. HAS CONTACTED THE UTILITIES BUT HAS NOT RECEIVED IN WRITING THE FINAL REQUIREMENTS FROM CLARK PUBLIC UTILITIES, CENTURYLINK, COMCAST. THESE DRAWINGS INDICATE OUR BEST ESTIMATION OF THEIR REQUIREMENTS. PRIOR TO BID AND PRIOR TO ANY CONSTRUCTION CONTACT THE UTILITIES AND OBTAIN IN WRITING THEIR REQUIREMENTS.

M Consulting Engineers
2007 S.E. Ash St.
Portland, OR 97214
PHN: (503) 234-0548
FAX: (503) 234-0677
WWW.MFIA-ENG.COM
CONTACT: DENISE TAYLOR

STUDIO
3
ARCHITECTURE
INCORPORATED

275 COURT ST. NE
SALEM, OR 97301-3442
P: 503.390.6500
www.studio3architecture.com



EXPIRES: July 6th, 2020

IN THE EVENT CONFLICTS ARE DISCOVERED BETWEEN THE ORIGINAL SIGNED AND SEALED DOCUMENTS PREPARED BY THE ARCHITECTS AND/OR THEIR CONSULTANTS, AND ANY COPY OF THE DOCUMENTS TRANSMITTED BY MAIL, FAX, ELECTRONICALLY OR OTHERWISE, THE ORIGINAL SIGNED AND SEALED DOCUMENTS SHALL GOVERN.

PROJECT # 2017-053
DATE: 11/06/2019
REVISIONS

- PLAN REVIEW 01.24.2020
- PLAN REVIEW 03.13.2020
- PLAN REVIEW 04.24.2020
- PLAN REVIEW 08.10.2020
- PLAN REVIEW 09.17.2020
- PLAN REVIEW 10.16.2020
- PLAN REVIEW 11.25.2020
- PLAN REVIEW 03.26.2021
- PLAN REVIEW 07.15.2021
- COORDINATION 08.27.2021
- COORDINATION 11.05.2021
- COORDINATION 12.10.2021



AEGIS
MIXED-USE DEVELOPMENT
312 E EVERGREEN BOULEVARD, VANCOUVER, WA 98660

SHEET:

E1.01

C STREET

E. 12TH ST.

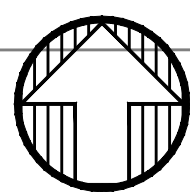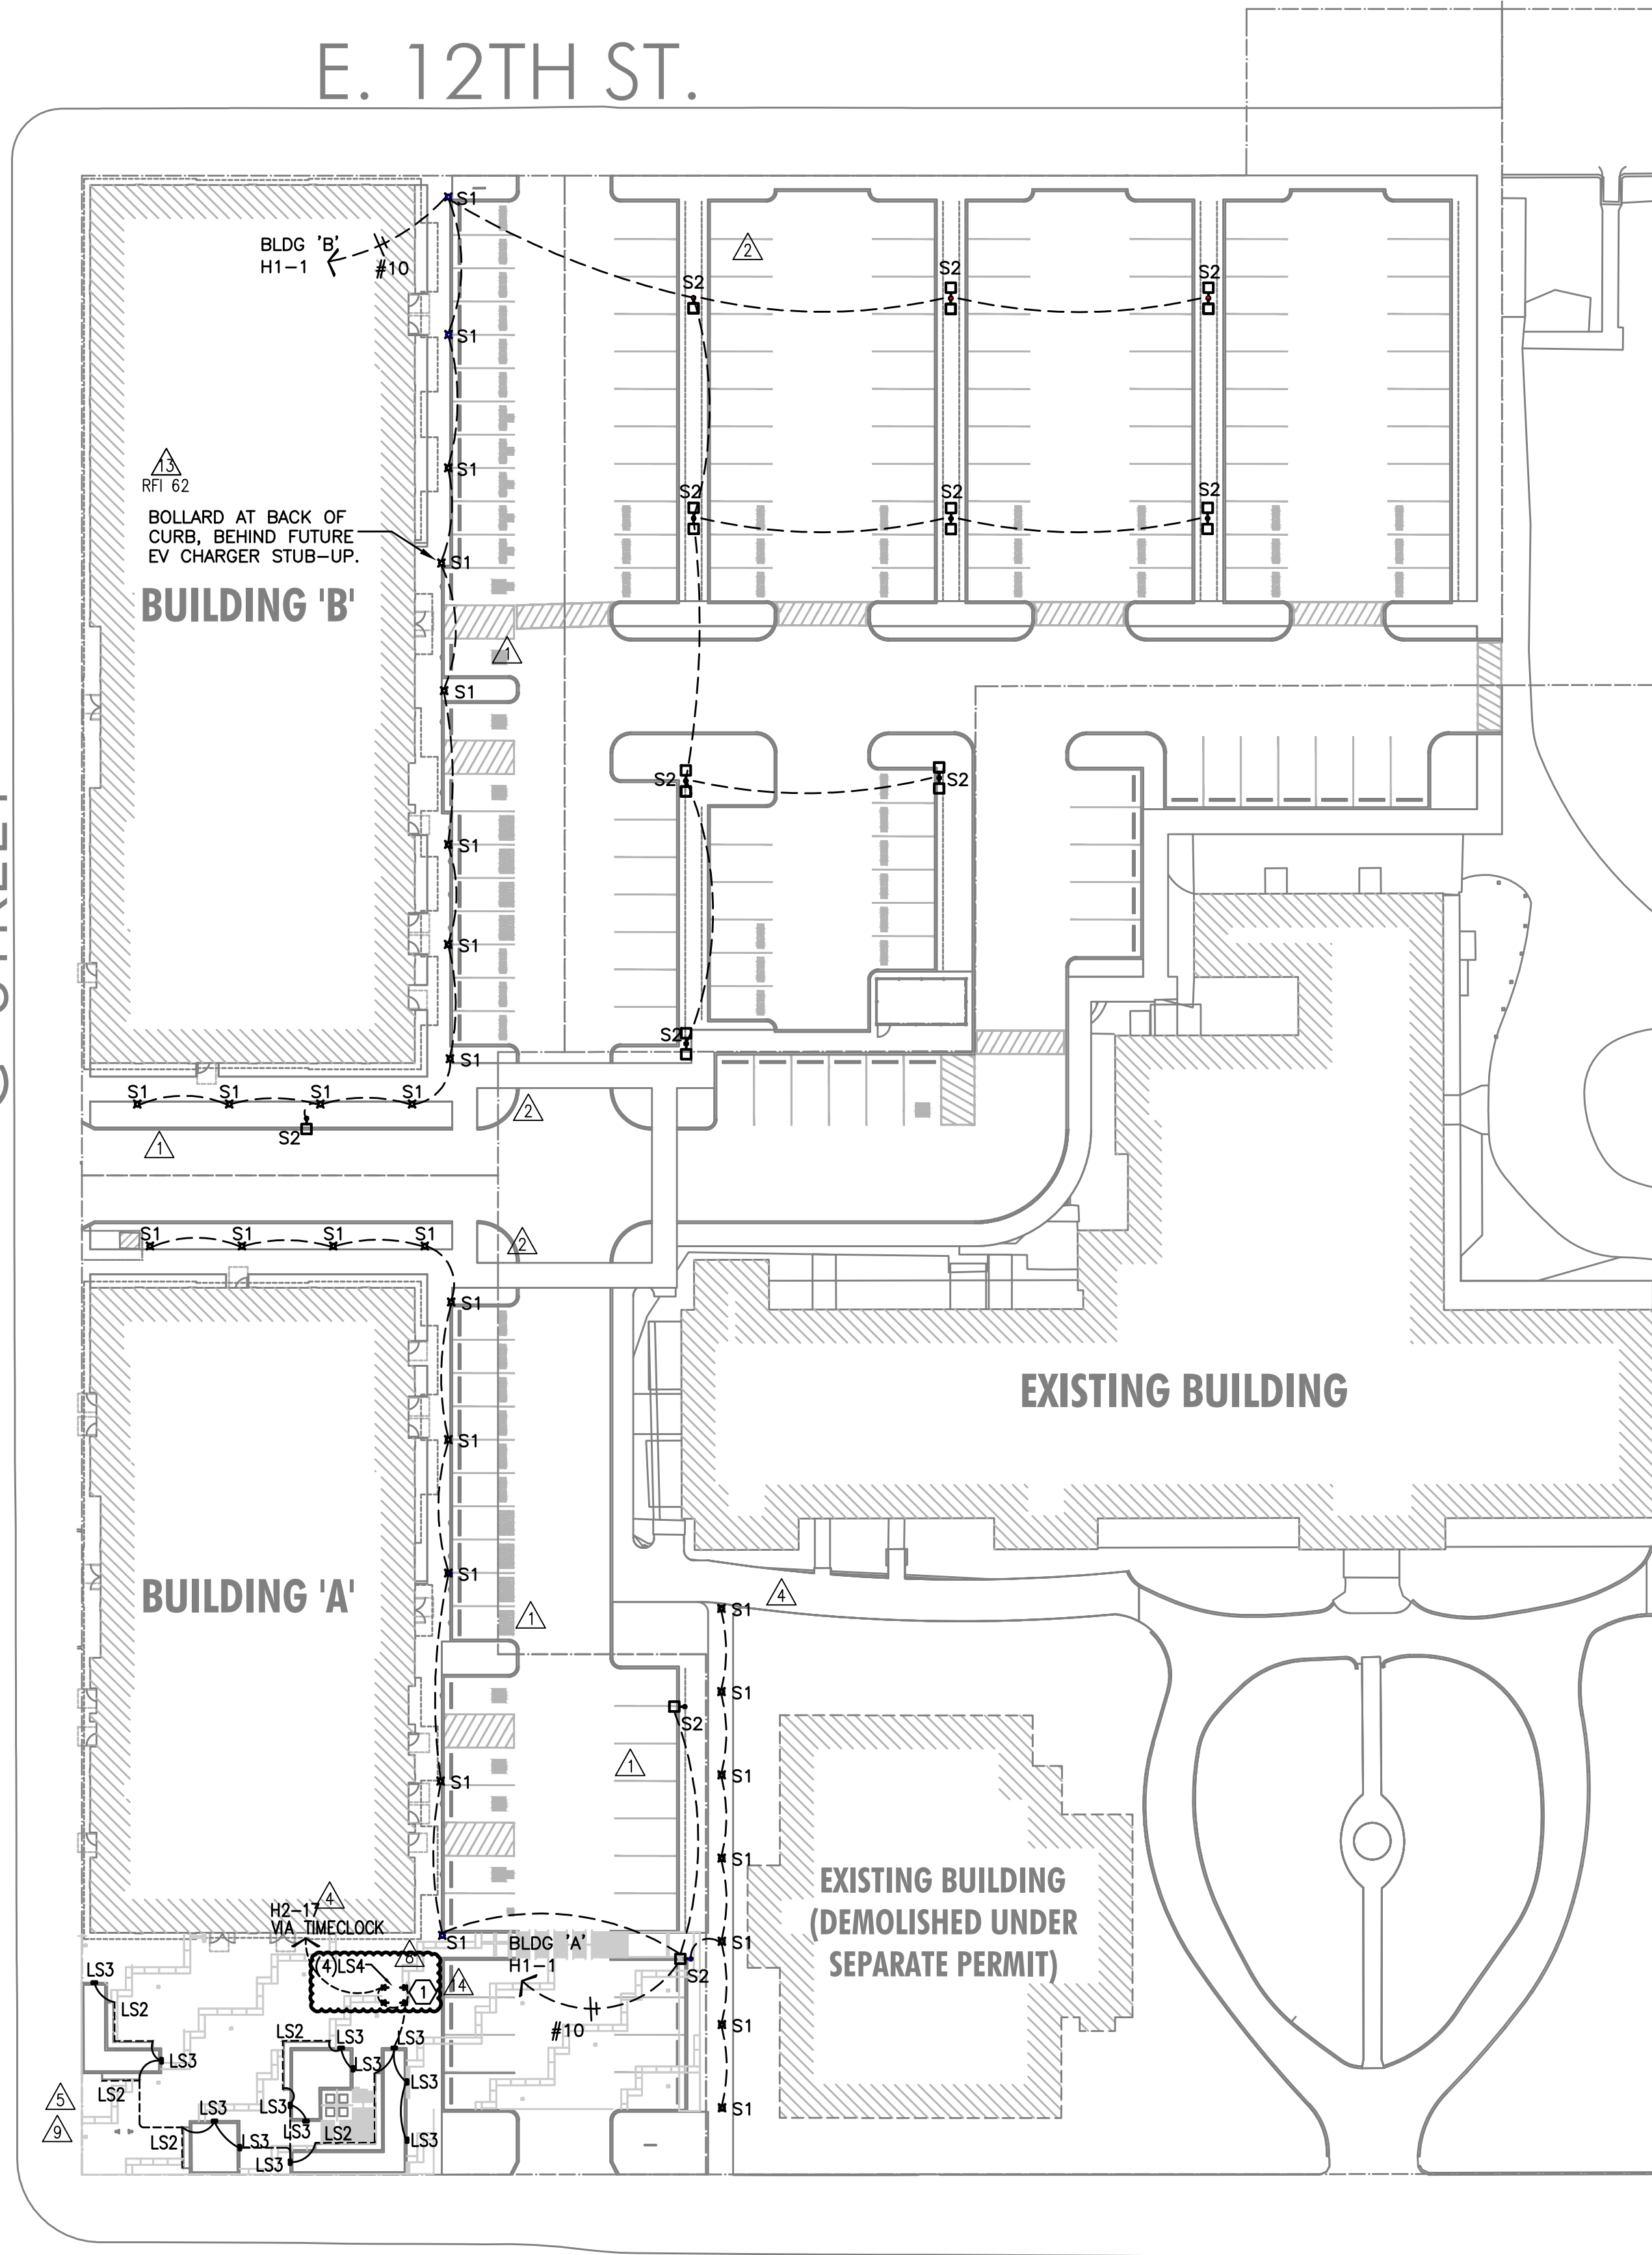


1 SITE LIGHTING PLAN
E1.02 SCALE: 1" = 30'-0"

GENERAL NOTES:

- ALL WORK SHALL BE PERFORMED IN ACCORDANCE WITH ALL APPLICABLE LOCAL, STATE AND NATION CODES.
- ALL PLANS ARE CONSIDERED DIAGRAMMATICAL. THEREFORE ALL EQUIPMENT SIZES AND DEVICE LOCATIONS ARE APPROXIMATE AND SUBJECT TO FIELD CONDITIONS AND PRODUCT APPROVAL.
- ELECTRICAL SERVICE ENTRANCE EQUIPMENT DESIGN IS BASED ON SIEMENS PRODUCTS. ACTUAL PRODUCTS INSTALLED MAY DIFFER IN SIZE AND CONFIGURATION AND SHALL BE DOCUMENTED IN FINAL PROJECT DOCUMENTS.
- COORDINATE WITH LOCAL UTILITY PROVIDER FOR EXACT SERVICE CONDUIT AND CONDUCTORS REQUIREMENTS.
- ALL UTILITY WORK SHALL BE DONE IN ACCORDANCE WITH CLARK PUBLIC UTILITIES ELECTRICAL SERVICE REQUIREMENTS.
- U.G. PRIMARY FEEDER SHALL HAVE A MINIMUM 48 INCH BURY.
- U.G. SECONDARY FEEDER SHALL HAVE A MINIMUM 36 INCH BURY.
- REFER TO SHEETS E1.11 & E1.14 FOR ONE-LINE DIAGRAM, LOAD SUMMARY INFORMATION AND TYPICAL FEEDER SCHEDULE.
- SECONDARY CONDUIT SWEEPS SHALL BE MINIMUM 60 INCH RADIUS WITH A MINIMUM OF 7'-0" STRAIGHT CONDUIT RUN BETWEEN SWEEPS.
- CONTRACTOR SHALL REVIEW CLARK PUBLIC UTILITIES ELECTRICAL SERVICE REQUIREMENTS PRIOR TO THE START OF ANY WORK.
- LOCATION AND INSTALLATION OF THE PRIMARY AND SECONDARY CONDUITS, TRANSFORMER, ETC. SHALL BE PROVIDED PER CLARK PUBLIC UTILITIES ELECTRICAL SERVICE REQUIREMENTS.
- CONTRACTOR SHALL REVIEW ALL PROJECT DOCUMENTS AND SPECIFICATIONS IN DETAIL AND REFER TO THE DOCUMENTS THROUGHOUT THE CONSTRUCTION.

KEYED LIGHTING NOTES:

1. PROVIDE WEATHER PROOF J-BOX, FLUSH WITH GRADE, FOR FUTURE LIGHT INSTALLATION. REFER TO LANDSCAPING PLANS FOR ADDITIONAL INFORMATION.

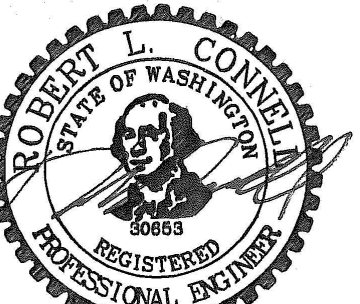

EXPIRES: July 5th, 2020

PROJECT # 2017-053
DATE: 11/06/2019
REVISIONS
PLAN REVIEW 01.24.2020
PLAN REVIEW 03.13.2020
PLAN REVIEW 04.24.2020
PLAN REVIEW 08.10.2020
PLAN REVIEW 09.17.2020
PLAN REVIEW 10.16.2020
PLAN REVIEW 11.25.2020
PLAN REVIEW 03.26.2021
PLAN REVIEW 07.15.2021
COORDINATION 08.27.2021
COORDINATION 11.05.2021
COORDINATION 12.10.2021

AEGIS
MIXED-USE DEVELOPMENT
312 E EVERGREEN BOULEVARD, VANCOUVER, WA 98660

M
F
I
A
INC.
Consulting Engineers
2007 S.E. Ash St.
Portland, OR 97214
PHN: (503) 234-0548
FAX: (503) 234-0677
CONTACT: DENISE TAYLOR
WWW.MFIA-ENG.COM

SHEET:

E1.02



EXPIRES: July 5th, 2020

IN THE EVENT CONFLICTS ARE DISCOVERED
BETWEEN THE ORIGINAL SIGNED AND SEALED
DOCUMENTS PREPARED BY THE ARCHITECTS
AND/OR THEIR CONSULTANTS, AND ANY COPY OF
THE DOCUMENTS TRANSMITTED BY MAIL, FAX,
ELECTRONICALLY OR OTHERWISE, THE ORIGINAL
SIGNED AND SEALED DOCUMENTS SHALL GOVERN.PROJECT # 2017-053
DATE: 11/06/2019

REVISIONS

PLAN REVIEW 01.24.2020

PLAN REVIEW 03.13.2020

PLAN REVIEW 04.24.2020

PLAN REVIEW 08.10.2020

PLAN REVIEW 09.17.2020

PLAN REVIEW 10.16.2020

PLAN REVIEW 11.25.2020

PLAN REVIEW 03.26.2021

PLAN REVIEW 07.15.2021

COORDINATION 08.27.2021

COORDINATION 11.05.2021

COORDINATION 12.10.2021

COORDINATION 12.10.2021

MFIA PANEL SCHEDULE											
panel			mounting SURFACE			location BLDG 'A'			connected load amps		
E1			2nd Flr Rm 294			52					
voltage			phase			bus & main			calculated load amps		
120/208V			3			100A SCCR: 22K MLO			55		
service			va	a/p	no.	a b c	no.	a/p	va	service	C
SPARE			500	20/1	1	*	2	20/1	1500	SMOKE DAMPERS - FLR 1	5
1 LIGHTS - BLDG EXTERIOR			500	20/1	3	*	4	20/1	1500	SMOKE DAMPERS - FLR 2&3	5
1 LIGHTS - FLR 1 EGRESS			542	20/1	5	*	6	20/1	1500	SMOKE DAMPERS - FLR 4&5	5
5 AREA OF REFUGE PANEL			500	20/1	7	*	8	20/1	1500	ELEVATOR PIT - LTS & PLUGS	2
1 LIGHTS - STAIR 1			266	20/1	9	*	10	20/1	1500	ELEVATOR CAD LIGHTS	1
1 LIGHTS - STAIR 2			266	20/1	11	*	12	20/1	1500	ELEVATOR CONTROLLER (OPT)	5
1 LIGHTS - FLR 2 & 3 EGRESS			262	20/1	13	*	14	20/1	0	SPARE	0
1 LIGHTS - FLR 4, 5 & 6 EGRESS			1500	20/1	15	*	16	20/1	1178	SP-1 (ELEVATOR PIT)	6
1 LIGHTS - TERRACE			500	20/1	17	*	18	20/1	1500	ELEVATOR SMOKE CURTAINS	5
5 FACP			500	20/1	19	*	20	20/1	500	EMERGENCY GAS SHUT OFF	5
SPARE			0	20/1	21	*	22	20/1	500	EMERGENCY GAS SHUT OFF	5
5 GENERATOR ANNUNCIATOR			500	20/1	23	*	24	20/1	500	RECEPT - ELEV MACH RM	2
BLANK							25	*	26	BLANK	
BLANK							27	*	28	BLANK	
BLANK							29	*	30	BLANK	
BLANK							31	*	32	BLANK	
BLANK							33	*	34	BLANK	
BLANK							35	*	36	BLANK	
BLANK							37	*	38	BLANK	
BLANK							39	*	40	BLANK	
BLANK							41	*	42	BLANK	
Phase A			4782 VA							line-line voltage	
Phase B			6942 VA							largest motor (va)	208
Phase C			6808 VA							calculated load (va)	0
Total Connected			18532 VA								
load code:			ph. A	ph. B	ph. C	total	factor				
1. LIGHTS=			282	3786	1308	VA	5556	1.25			6695
2. RECEPT=			1500	0	500	VA	2000	1 + 0.5			2000
3. HEATING=			0	0	0	VA	0	1.00			0
4. KITCHEN=			0	0	0	VA	0	1.00			0
5. EQUIP=			3000	2000	5000	VA	10000	1.00			10000
6. MOTORS=			0	1176	0	VA	1176	*			1176
7. MISC=			0	0	0	VA	0	1.00			0
(* 125% of the largest motor + 100% of the balance)											19871

MFIA PANEL SCHEDULE											
panel			mounting SURFACE			location BLDG 'A'			connected load amps		
H1			2nd Flr Rm 294			160					
voltage			phase			bus & main			calculated load amps		
120/208V			3			250A SCCR: 22K MLO			155		
service			va	a/p	no.	a b c	no.	a/p	va	service	C
1 LIGHTS - SITE/PARKING			500	20/1	1	*	2	20/1	1080	RECEPT - FLR 1	2
1 LIGHTS - BLDG EXTERIOR			500	20/1	3	*	4	20/1	900	RECEPT - FLR 1	2
1 LIGHTS - FLR 1 (LOBBY DECOR)			814	20/1	5	*	6	20/1	1080	RECEPT - FLR 1 (E. LOBBY)	2
1 LIGHTS - FLR 1 (LOBBY & CORRID)			407	20/1	7	*	8	20/1	1500	RECEPT - FLR 1 (PKG SYSTEM)	2
1 LIGHTS - FLR 1 (BOH)			464	20/1	9	*	10	20/1	1500	AUTO DOORS	5
5 BUILDING SIGNS			1500	20/1	11	*	12	20/1	1400	RECEPT - FLR 1	5
1 LIGHTS - FLR 2 & 3 (BOH)			566	20/1	13	*	14	20/1	1500	OH DOOR - TRASH ROOM	5
5 UNIT ENTRY SYSTEM			1500	20/1	15	*	16	20/1	1500	RECEPT - FLR 1	5
1 LIGHTS - PLAZA			1500	20/1	17	*	18	20/1	500	PHONE BOARD	5
SPARE			0	20/1	19	*	20	20/1	500	COMMUNICATIONS BOARD	5
2 RECEPT - FLR 2			1080	20/1	21	*	22	20/1	1500	ACCESS CONTROL SYSTEM	5
2 RECEPT - FLR 3			1080	20/1	23	*	24	20/1	500	EH-2 (N. STAIR)	3
2 RECEPT - MAINT. RM			1500	20/1	25	*	26	20/1	500	EH-4 (RISER RM)	3
2 SECURITY SYSTEM			1500	20/1	27	*	28	20/1	500	EH-2 (S. STAIR)	3
5 DAS SYSTEM			1500	20/1	29	*	30	20/1	500	EH-2 (E. VESTIBULE)	3
2 LEASE D&E (TEMP LTS & PLUGS)			1500	20/1	31	*	32	20/1	500	EH-2 (W. VESTIBULE)	3
2 LEASE B&C (TEMP LTS & PLUGS)			1500	20/1	33	*	34	20/1	228	LIGHTS - FLR 2 & 3 (CORRIDOR)	1
2 LEASE A (TEMP LTS & PLUGS)			1500	20/1	35	*	36	20/1	0	SPARE	
7 PANEL H2			8320	150/3	37	*	38	20/1	0	SPARE	
7 *			8054	*	39	*	40	20/1	0	SPARE	
7 *			7378	*	41	*	42	20/1	0	SPARE	
Phase A			18373 VA							line-line voltage	
Phase B			19946 VA							largest motor (va)	208
Phase C			19282 VA							calculated load (va)	0
Total Connected			57611 VA								
load code:			ph. A	ph. B	ph. C	total	factor				
1. LIGHTS=			1473	1192	2314	VA	4978	1.25			6224
2. RECEPT=			5580	5700	5100	VA	16380	1 + 0.5			13190
3. HEATING=			1000	500	1000	VA	2500	1.00			2500
4. KITCHEN=			0	0	0	VA	0	1.00			0
5. EQUIP=			2000	4500	3500	VA	10000	1.00			10000
6. MOTORS=			0	0	0	VA	0	*			0
7. MISC=			8320	8054	7378	VA	23752	1.00			23752
(* 125% of the largest motor + 100% of the balance)											55666

MFIA PANEL SCHEDULE												
panel		mounting			location			connected load amps				
M1		SURFACE			BLDG 'A'			174				
voltage		phase			bus & main			calculated load amps				
120/208V		3			250A (SCCR: 22K)			174				
C	service	va	a/p	no.	a	b	c	no.	va	service	C	
6	TRASH COMPACTOR	2100	40/3	1	*	*	*	2	50/3	3864	BP-1	6
6	*	2100	*	3	*	*	*	4	*	3864	*	6
6	*	2100	*	5	*	*	*	6	*	3864	*	6
6	TRASH COOMPACTOR	2100	40/3	7	*	*	*	8	20/3	1356	FC-1	6
6	*	2100	*	9	*	*	*	10	*	1356	*	6
6	*	2100	*	11	*	*	*	12	*	1356	*	6
3	WH-1.2 (GAS)	600	20/1	13	*	*	*	14	20/2	1500	EH-5 (TRASH RM)	3
6	RP-1	1176	20/1	15	*	*	*	16	1500	*	*	3
3	SPARE	0	20/1	17	*	*	*	18	20/2	1500	EH-5 (BIKE RM)	3
3	EH-3 (TEMP)	1500	20/2	19	*	*	*	20	*	1500	*	3
3	*	1500	*	21	*	*	*	22	20/1	218	EF-3 (TRASH RM)	6
3	EH-3 (TEMP)	1500	20/2	23	*	*	*	24	20/1	1500	DRINKING FOUNTAIN	5
3	*	1500	*	25	*	*	*	26	20/1	500	IRRIGATION CONTROLS	5
3	EH-3 (TEMP)	1500	20/2	27	*	*	*	28	20/1	1500	RECEPT - DATA RM FLR 2	2
3	*	1500	*	29	*	*	*	30	20/1	600	WH-3.4 (GAS)	3
3	EH-3 (TEMP)	1500	20/2	31	*	*	*	32	20/1	1176	RP-2	6
3	*	1500	*	33	*	*	*	34	40/2	*	EV CHARGING STATION (FUTURE)	5
3	EH-3 (TEMP)	1500	20/2	35	*	*	*	36	*	*	*	6
3	*	1500	*	37	*	*	*	38	20/1	1500	RECEPT - DATA RM FLR 2	2
3	EH-3 (TEMP)	1500	20/2	39	*	*	*	40	20/1	1500	RECEPT - DATA RM FLR 2	2
3	*	1500	*	41	*	*	*	42	20/1	1500	RECEPT - DATA RM FLR 2	2
Phase A		22196 VA			NOTES:					0		
Phase B		21014 VA								208		
Phase C		19020 VA										
Total Connected		62530 VA								largest motor (va)		
load code		ph. A	ph. B		ph. C	total	factor		calculated load (va)			
1. LIGHTS=		0	0	0	0	VA	0	1.25				
2. RECEPT=		1500	1500	0	0	VA	3000	+ 0.5	3000			
3. HEATING=		9600	7500	8100	VA	25200	1.00		25200			
4. KITCHEN=		0	0	0	0	VA	0	1.00	0			
5. EQUIP. =		500	1500	1500	VA	3500	1.00		3500			
6. MOTORS=		10596	10814	9420	VA	30830	*		30830			
7. MISC=		0	0	0	0	VA	0	1.00	0			
(* 125% of the largest motor + 100% of the balance)								TOTAL=	62530			

LIGHTING FIXTURE LIST					
TYPE	LAMP	MANUFACTURER	CATALOG NUMBER	DESCRIPTION	OPTIONS
⚠ A1 A1E	LED 3000K 2000LM/80CRI 28W	LITHONIA (OR APPROVED OTHER)	CSS L48 ALO3 SERIES	TYPE :4" GEN. PURPOSE STRIP MOUNTING :SURFACE HOUSING :STEEL LENS/REFL :DIFFUSED ACRYLIC VOLTAGE :MVOLT BALLAST :LED DRIVER	TYPE 'AE' SIMILAR TO TYPE 'A' EXCEPT WITH EMERGENCY BATTERY BACK-UP EQUIP. RMS, TRASH RM, LEASE SPACE
A2	LED 4000K 5000LM/80CRI 49W	LITHONIA (OR APPROVED OTHER)	XVML L48SERIES	TYPE :4" ENCLOSED INDUSTRIAL MOUNTING :SURFACE HOUSING :POLYCARBONATE LENS/REFL :CLEAR POLYCARBONATE VOLTAGE :MVOLT BALLAST :LED DRIVER	WALL MOUNT AT +7"-0" AFF IN ROOF TERRACE MECH. ROOM. ELEVATOR PIT & TOP OF SHAFT
B1 ②	LED 3000K 3000LM/80CRI 25W	LITHONIA (OR APPROVED OTHER)	BLWP4 3OL SERIES	TYPE :4" WRAP AROUND MOUNTING :SURFACE HOUSING :STEEL LENS/REFL :ACRYLIC VOLTAGE :MVOLT BALLAST :LED DRIVER	PROVIDE WITH INTEGRAL OCCUPANCY SENSOR, DIM50 STANDBY MODE STAIRWELLS
B2	LED 3000K 3000LM/80CRI 20W	LITHONIA (OR APPROVED OTHER)	CLXL48 SERIES	TYPE :4" WRAP AROUND MOUNTING :SURFACE HOUSING :STEEL LENS/REFL :WIDE DIFFUSED VOLTAGE :MVOLT BALLAST :LED DRIVER	WIDE DISTRIBUTION STANDARD OUTPUT BIKE ROOM
B3	LED 3000K 2000LM/80CRI 28W	LITHONIA (OR APPROVED OTHER)	CSS L48 ADPT SERIES	⚠ TYPE :3" WRAP AROUND MOUNTING :SURFACE HOUSING :STEEL LENS/REFL :WIDE DIFFUSED VOLTAGE :MVOLT BALLAST :LED DRIVER	STANDARD OUTPUT ELEVATOR MACHINE ROOM
⚠ C1a/b ① ③	LED 3000K/90CRI 127LM/FT 2W/FT	ECOSENSE (OR APPROVED OTHER)	TROV L35I SERIES	TYPE :LED COVE LIGHT MOUNTING :SURFACE (IN COVE) HOUSING :ALUMINUM LENS/REFL :CLEAR POLYCARBONATE/SNAP ON VOLTAGE :MVOLT BALLAST :LED DRIVER (0-10 DIMMING-ELV)	C1a = 2FT LENGTH C1b = 4FT LENGTH MAIN LOBBY ⚠
⚠ C2	LED 600LM/80CRI 3000K 10W	COOPER LIGHTING (OR APPROVED OTHER)	SMD4R12 SERIES	TYPE :4" DIA. DOWNLIGHT MOUNTING :SURFACE (J-BOX) HOUSING :ALUMINUM LENS/REFL :ACRYLIC VOLTAGE :MVOLT BALLAST :LED DRIVER (DIMMING)	WHITE TRIM UL LISTED DAMP LOCATION RESTROOMS, DOG WASH
C3	LED 1200LM/80CRI 3000K 15W	COOPER LIGHTING (OR APPROVED OTHER)	SMD6R12 SERIES	TYPE :4" DIA. DOWNLIGHT MOUNTING :SURFACE HOUSING :STEEL LENS/REFL :ACRYLIC/CLEAR DIFFUSE VOLTAGE :MVOLT BALLAST :LED DRIVER (DIMMING)	WHITE TRIM OR ARCHITECT LOBBY, CORRIDORS
C4	LED 1500LM/80CRI 3000K 16W	COOPER LIGHTING (OR APPROVED OTHER)	LCR6159F SERIES HL6RSMF	TYPE :5" DIA. DOWNLIGHT MOUNTING :RECESSED HOUSING :STEEL LENS/REFL :ACRYLIC/CLEAR DIFFUSE VOLTAGE :MVOLT BALLAST :LED DRIVER (DIMMING)	IC RATED WHITE TRIM CORRIDORS
⚠ C5	LED 650LM/80CRI 3000K 10W	COOPER LIGHTING (OR APPROVED OTHER)	HILA406FL SERIES	TYPE :4" DIA. ADJ.DOWNLIGHT MOUNTING :RECESSED HOUSING :STEEL LENS/REFL :ACRYLIC VOLTAGE :MVOLT BALLAST :LED DRIVER (DIMMING)	IC RATED FIELD AIM PER ARCHITECT'S DIRECTION WHITE TRIM LOBBY, CORRIDOR

⚠

⚠

Copyright © 2017-18 STUDIO 3 ARCHITECTURE, INC.

LIGHTING FIXTURE LIST – DECORATIVE					
TYPE	LAMP	MANUFACTURER	CATALOG NUMBER	DESCRIPTION	OPTIONS
⚠ LF1	LED 330LM/FT 3000K 3W/FT	KELVIX (OR APPROVED OTHER)	PH30K 24V W/ CH409 CHANNEL	TYPE :UNDER CABINET LIGHT MOUNTING :SURFACE HOUSING :ALUMINUM CHANNEL LENS/REFL :WHITE ACRYLIC LENS VOLTAGE :24V BALLAST :LED DRIVER 0-10 DIMMING	TAPE & CHANNEL TO MOUNT AT UNDER- SIDE OF SHELF. CONSULT WITH INTERIOR DECORATOR'S DETAILS AND COORDINATE INSTALLATION. COFFEE BAR, COMMUNITY RM
LF2	LED 3000K/90CRI 5040LM 56W	KUZCO (OR APPROVED OTHER)	EEREIE PD19347 SERIES	TYPE :LINEAR PENDANT MOUNTING :SUSPENDED HOUSING :ALUMINUM LENS/REFL :OPAL SILICON VOLTAGE :120V BALLAST :LED DRIVER (0-10 DIMMING/ELV)	FINISH PER INTERIOR DECORATOR MOUNTING HEIGHT PER INTERIOR DECORATOR MAIL ROOMS
LF3		NOT USED		TYPE : MOUNTING : HOUSING : LENS/REFL : VOLTAGE : BALLAST :	
LF4	LED 3000K 850LM/90CRI 9W	USAI LIGHTING (OR APPROVED OTHER)	B3RDM SERIES	TYPE :3" DIA DOWNLIGHT MOUNTING :RECESSED HOUSING :STEEL LENS/REFL :SOLITE VOLTAGE :MVOLT BALLAST :LED DRIVER (0-10 DIMMING)	45 DEGREE BEAM SPREAD PROVIDE WITH USAI POWER SUPPLY BLACK BEVEL TRIM & MILLWORK FLANGE IC RATED BLDG A COFFEE BAR
LF5	(8) JCD/G9 LED 3000K/80CRI 24W	ARTCRAFT LIGHTING (OR APPROVED OTHER)	AC1188 SERIES	TYPE :LARGE PENDANT MOUNTING :SUSPENDED HOUSING : LENS/REFL : VOLTAGE :120V BALLAST :LED DRIVER (0/10 DIMMING)	FINISH PER INTERIOR DECORATOR MOUNTING HEIGHT PER INTERIOR DECORATOR BLDG B LOBBY
⚠ LF6	(1) LED LAMP (MED. BASE) 3000K/80CRI 15W	CREATIVE SYSTEMS LTG (OR APPROVED OTHER)	LP2102730 SERIES	TYPE :MINI PENDANT MOUNTING :SUSPENDED HOUSING :UNKNOWN LENS/REFL :N/A VOLTAGE :120V BALLAST :LED DRIVER (0-10 DIMMING)	BLACK PATINE FINISH PER INTERIOR DECORATOR MOUNTING HEIGHT PER INTERIOR DECORATOR. BLDG B LOUNGE
LF7	(1) G9 LED 3000K 220LM/80CRI 4W	ANDLight (OR APPROVED OTHER)	ORB-P SERIES	TYPE :PENDANT MOUNTING :SUSPENDED HOUSING :STEEL WIRE LENS/REFL :ETCHED GLASS VOLTAGE :120V BALLAST :LED DRIVER (0-10 DIMMING)	BLACK FINISH PER INTERIOR DECORATOR MOUNTING HEIGHT PER INTERIOR DECORATOR RESTROOM
LF8	(3) LED LAMPS (MED. BASE) 3000K/80CRI 225W	TROY LIGHTING (OR APPROVED OTHER)	HENDRIX F6886 SERIES	TYPE :CHANDELIER MOUNTING :SUSPENDED HOUSING :UNKNOWN LENS/REFL :N/A VOLTAGE :120V BALLAST :LED DRIVER (0-10 DIMMING)	BLACK IRON FINISH PER INTERIOR DECORATOR MOUNTING HEIGHT PER INTERIOR DECORATOR BLDG A CLUBROOM
LF9	(1) GU10 LED 3000K/80CRI 9W	RESTORATION HARDWARE (OR APPROVED OTHER)	ORBITER II 68830997 SERIES	TYPE :SCONCE MOUNTING :SURFACE HOUSING :UNKNOWN LENS/REFL :N/A VOLTAGE :120V BALLAST :LED DRIVER (0-10 DIMMING)	BRONZE FINISH PER INTERIOR DECORATOR MOUNTING HEIGHT PER INTERIOR DECORATOR BLDG A CLUBROOM
⚠ LF10		NOT USED		TYPE : MOUNTING : HOUSING : LENS/REFL : VOLTAGE : BALLAST :	
⚠ LF11	LED 3000K/90CRI 780LM 13W	KUZCO LIGHTING (OR APPROVED OTHER)	WS83218 SERIES	TYPE :SCONCE MOUNTING :SURFACE HOUSING :STEEL LENS/REFL :OPAL GLASS VOLTAGE :120V BALLAST :LED DRIVER (DIMMING)	VERIFY ADA COMPLIANT BLACK FINISH PER INTERIOR DECORATOR MOUNTING HEIGHT PER INTERIOR DECORATOR TYPICAL UNIT ENTRY
⚠ LF12 ⑧	LED 3000K/80CRI 500LM/FT 9.4W/FT	NULITE (OR APPROVED OTHER)	RP14-B-FF SERIES	TYPE :8FT DIRECT/INDIRECT LINEAR MOUNTING :SUSPENDED HOUSING :ALUMINUM LENS/REFL :ACRYLIC VOLTAGE :MVOLT BALLAST :LED DRIVER (0-10 DIMMING)	60% DOWN-40% UP DISTRIBUTION MOUNT AT 10FT AFF TO BOTTOM OF FIXTURE. STANDARD WHITE FINISH BIKE ROOMS BLDG B FITNESS ROOM
LF13		NOT USED		TYPE : MOUNTING : HOUSING : LENS/REFL : VOLTAGE : BALLAST :	
LF14	LED 3000K/80CRI 1300LM 16W	KUZCO (OR APPROVED OTHER)	FM11410 SERIES	TYPE :9" DIA DOWNLIGHT MOUNTING :SURFACE HOUSING :STEEL LENS/REFL :ACRYLIC VOLTAGE :120V BALLAST :LED DRIVER (0-10 DIMMING/ELV)	BLACK FINISH PER INTERIOR DECORATOR BLDG A WOOD CEILINGS
⚠ LF15		NOT USED		TYPE : MOUNTING : HOUSING : LENS/REFL : VOLTAGE : BALLAST :	
LF16	(1) G9 LED (WEDGE BASE) 3000K/80CRI 13W	HUDSON VALLEY LIGHTING (OR APPROVED OTHER)	8701-AGB SERIES	TYPE :WALL SCONCE MOUNTING :SURFACE HOUSING :ALUMINUM LENS/REFL :GLASS VOLTAGE :120V BALLAST :LED DRIVER (DIMMING)	FINISH PER INTERIOR DECORATOR. MOUNTING HEIGHT PER INTERIOR DECORATOR. BLDG A LOBBY, CLUB RM/BLDG B LOBBY

⚠

⚠

GENERAL NOTES:

- ⚠

A.
- ALL LIGHT FIXTURES SHALL HAVE ENERGY EFFICIENT LAMPING AND BALLASTS.
- ⚠

B.
- LIGHT FIXTURES FOR LIVING UNITS SHALL BE "ENERGY STAR" RATED.
- ⚠

C.
- EXTERIOR LIGHT FIXTURES SHALL BE "NIGHT SKY" FRIENDLY.
- ⚠

D.
- VERIFY ALL FIXTURE FINISHES WITH ARCHITECT PRIOR TO BID.
- ⚠

E.
- VERIFY ALL FIXTURE MOUNTING HEIGHTS WITH ARCHITECT PRIOR TO BID.
- ⚠

F.
- VERIFY ALL FIXTURE LOCATIONS WITH ARCHITECT PRIOR TO ROUGH IN.
- ⚠

G.
- ALL INTERIOR LIGHTING SHALL BE 3000 KELVIN UNLESS OTHERWISE NOTED.
- ⚠

H.
- ALL PRODUCT SUBSTITUTIONS AND VALUE ENGINEERING SHALL BE SUBMITTED DURING BID PHASE, SHALL MEET DESIGN INTENT AND IS SUBJECT TO OWNER APPROVAL.
- ⚠

I.
- CONTRACTOR SHALL CONSULT MANUFACTURER INSTALLATION INSTRUCTIONS FOR ALL FIXTURES AND DEVICES AND INSTALL AS INSTRUCTED. THIS INCLUDES ALL ELECTRICAL COMPONENTS REQUIRED FOR COMPLETE INSTALLATION. WORK SHALL BE PERFORMED SUCH THAT MANUFACTURER WARRANTY IS NOT VOIDED.
- ⚠

J.
- THE ELECTRICAL CONTRACTOR SHALL CONSULT THE INTERIOR DESIGN PLAN SET FOR ALL FINISHES, MOUNTING HEIGHTS AND OTHER INSTALLATION REQUIREMENTS REGARDING THE "LF" LIGHT FIXTURES LISTED IN THE FIXTURE SCHEDULE ON THIS SHEET.
- ⚠

K.
- IF NECESSARY, CONTRACTOR SHALL PROVIDE IC RATED BOXES FOR ANY APPROVED, SUBSTITUTED FIXTURES NOT MEETING INSULATED CEILING REQUIREMENTS.
- ⚠

L.
- BUILDING MOUNTED EXTERIOR WALL SCONCES, TYPE S3b, TO BE CONTROLLED VIA PHOTOCELL AND BE PROVIDED WITH A TIME CLOCK TO REDUCE LIGHT OUTPUT BY 30% DURING LATE NIGHT TO REDUCE REFLECTANCE INTO TENANT LIVING UNITS. FIXTURES DESIGNATED TO BE EGRESS SHALL BE WIRED SUCH THAT IN THE EVENT OF A POWER OUTAGE, THE LIGHTS AUTOMATICALLY RETURN TO FULL OUTPUT. TIME CLOCK SETTINGS TO BE DETERMINED BY THE OWNER.

KEYED LIGHTING NOTES:

- ⚠

1.
- CONTRACTOR TO DETERMINE FIXTURE LENGTH BASED ON ARCHITECTURAL REFLECTED CEILING PLANS AND ELECTRICAL LIGHTING PLANS. DESIGN INTENT IS FOR THE FIXTURE TO RUN THE ENTIRE LENGTH OF THE "COVE" TO PROVIDE EVEN LIGHT DISTRIBUTION.
- ⚠

2.
- STAIRWELL AND BOH CORRIDOR LIGHT FIXTURES TO BE EQUIPPED WITH FACTORY INSTALLED (OR REMOTE) OCCUPANCY SENSORS FOR MIN. 50% LIGHT REDUCTION DURING PERIODS OF NO ACTIVITY.
- ⚠

3.
- MAXIMUM RUN LENGTH FOR SPECIFIED COVE LIGHT FIXTURE IS (186) 4FT UNITS. MULTIPLE RUNS SHALL BE CIRCUITED AS NOTED ON THE PLANS. CONTRACTOR SHALL PROVIDE THE APPROPRIATE MOUNTING AND CONNECTING HARDWARE PER MANUFACTURER'S REQUIREMENTS. CONSULT VENDOR FOR ADDITIONAL INSTALLATION INFORMATION.
- ⚠

4.
- CONTRACTOR TO PROVIDE ALL REQUIRED COMPONENTS FOR COMPLETE INSTALL. 24V FIXTURE TRANSFORMER/POWER SUPPLY TO BE LOCATED IN THE CABINET BELOW THE SHELVEING.
- ⚠

5.
- CONTRACTOR TO PROVIDE SINGLE POLE DIMMER SWITCHES AS INDICATED ON SHEETS E4.01-E4.03. DIMMER SWITCHES SHALL MATCH THE DECORATOR TYPE ROCKER SWITCH SPECIFIED IN THE TYPICAL UNIT LIGHTING PLANS OR AS DIRECTED BY THE OWNER. DIMMER SWITCHES SHALL BE COMPATIBLE WITH THE LED LIGHT FIXTURES AND SHALL BE FULLY ADJUSTABLE. CONTRACTOR SHALL FIELD ADJUST TO REDUCE ANY MOMENTARY FLASH DURING START UP.
- ⚠

6.
- PROVIDE BLOCKING AT CEILING TO SUPPORT 35LB., MINIMUM, FOR CEILING FAN INSTALLATION. REFER TO MANUFACTURER'S INSTALLATION INSTRUCTIONS FOR ADDITIONAL INFORMATION AND REQUIREMENTS. PROVIDE FIXTURE CONTROL SWITCH(ES) AS DIRECTED BY MANUFACTURER.
- ⚠

7.
- PROVIDE WITH WEATHER PROOF J-BOX FOR SOIL CONTACT.
- ⚠

8.
- VERIFY MOUNTING HEIGHT OF FIXTURES IS NOT IN CONFLICT WITH ROOM EQUIPMENT.
- ⚠


9.
- BOLLARD LIGHTS ALONG THE BUILDING WALKWAYS SHALL BE INSTALLED SUCH THAT ANY PROJECTION FACES AWAY FROM THE BUILDING.
- ⚠

10.
- LED TAPE & CHANNEL LIGHTS AT EXTERIOR PLAZA SHALL BE MOUNTED AS DIRECTED BY THE LANDSCAPE ARCHITECT. CONTRACTOR TO PROVIDE ALL REQUIRED COMPONENTS FOR COMPLETE INSTALL.
- ⚠

11.
- CONTRACTOR TO SUPPLY AND INSTALL BACK-LIT VANITY MIRROR. REFER TO ARCHITECTURAL ELEVATIONS FOR MOUNTING HEIGHT AND SIZE OF THE BACK-LIT VANITY MIRROR FOR EACH UNIT TYPE. MIRROR TO BE HARDWIRED INTO A RECESSED J-BOX. CONSULT ARCHITECT FOR ANY ADDITIONAL INFORMATION REGARDING THESE FIXTURES.
- ⚠

12.
- FIXTURE TYPE S9 TO BE MOUNTED BEHIND EXTERIOR ART INSTALLATION. CONTRACTOR SHALL CONSULT WITH THE OWNER FOR EXACT QUANTITY & LENGTHS OF FIXTURE, AND EXACT LOCATIONS FOR THE FIXTURE MOUNTING PRIOR TO PURCHASE AND ROUGH IN. CONTRACTOR SHALL PROVIDE ALL COMPONENTS FOR A COMPLETE INSTALL. REFER TO EXTERIOR ELEVATION DETAILS FOR MORE INFORMATION.

M
E
T
A
INC.
Consulting Engineers
2007 S.E. Ash St.
Portland, OR 97214
PHN: (503) 234-0548
FAX: (503) 234-0877
WWW.METIA-ENG.COM
CONTACT: DENISE TAYLOR

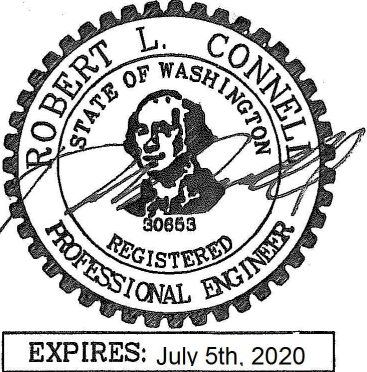

PROJECT # 2017-053
DATE: 11/06/2019
REVISIONS

- ⚠

PLAN REVIEW

01.24.2020
- ⚠

PLAN REVIEW

03.13.2020
- ⚠

PLAN REVIEW

04.24.2020
- ⚠

PLAN REVIEW

08.10.2020
- ⚠

PLAN REVIEW

09.17.2020
- ⚠

PLAN REVIEW

10.16.2020
- ⚠

PLAN REVIEW

11.25.2020
- ⚠

PLAN REVIEW

03.26.2021
- ⚠

PLAN REVIEW

07.15.2021
- ⚠

COORDINATION

08.27.2021
- ⚠

COORDINATION

11.05.2021
- ⚠

COORDINATION

12.10.2021

AEGIS
MIXED-USE DEVELOPMENT
312 E EVERGREEN BOULEVARD, VANCOUVER, WA 98660

SHEET:

E1.21


LIGHTING FIXTURE LIST – SITE & EXTERIOR					
TYPE	LAMP	MANUFACTURER	CATALOG NUMBER	DESCRIPTION	OPTIONS
LS1 ⑦	LED 3000K 100LM 3W	DALS LIGHTING (OR APPROVED OTHER)	LEDSTEP00SD SERIES	TYPE :STEP LIGHT (+10" AFF) RECESSED HOUSING :ALUMINUM LENS/REFL :ACRYLIC VOLTAGE :120V BALLAST :LED DRIVER (DIMMING)	VERIFY UL LISTED FOR WET LOCATION FINISH PER ARCHITECT. VERIFY EXACT LOCATION WITH LANDSCAPE DESIGNER PRIOR TO ROUGH IN. ROOF TERRACE
LS2 ⑩	LED 3000K 500LM/FT 5W/FT	JESCO LIGHTING (OR APPROVED OTHER)	DL-AC-FLEX SERIES DL-AC-FLEX2-HW08 DL-AC-FLEX2-UT-CH6M12 DL	TYPE :LED COVE LIGHT MOUNTING :SURFACE (CHANNEL) HOUSING :ALUMINUM LENS/REFL :ACRYLIC VOLTAGE :120V BALLAST :LED DRIVER (DIMMING)	MOUNT UNDER COUNTER TOP EDGE. VERIFY EXACT LENGTH BEFORE ORDERING VERIFY EXACT LOCATION WITH LANDSCAPE DESIGNER PRIOR TO ROUGH IN. UL LISTED FOR WET LOCATION ROOF TERRACE
LS3	LED 3000K 342LM 8W	BEGA LIGHTING (OR APPROVED OTHER)	33-054 SERIES	TYPE :LED STEP LIGHT MOUNTING :RECESSED HOUSING :ALUMINUM LENS/REFL :TEMPERED GLASS VOLTAGE :120V BALLAST :LED DRIVER	VERIFY EXACT LENGTH BEFORE ORDERING VERIFY EXACT LOCATION AND MOUNTING WITH LANDSCAPE DESIGNER PRIOR TO ROUGH IN. UL LISTED FOR WET LOCATION ROOF TERRACE, PLAZA
LS4 ④	LED 3000K 11W	TARGETTI LIGHTING (OR APPROVED OTHER)	KPLM-41 SERIES	TYPE :ADJ. GIMBLE FEATURE LIGHT MOUNTING :RECESSED (IN-GROUND) HOUSING :ALUMINUM LENS/REFL :TEMPERED GLASS VOLTAGE :120V BALLAST :LED DRIVER	VERIFY TRIM & BEAM SPREAD WITH ARCHITECT. COORDINATE WITH ART INSTALLER FOR FIELD ADJUSTMENT. UL LISTED FOR WET LOCATION PLAZA
S1 ⑨	LED 3000K 1000LM 12W	KUZCO LIGHTING (OR APPROVED OTHER)	EB3036 SERIES	TYPE :36" BOLLARD LIGHT MOUNTING :AT GRADE HOUSING :ALUMINUM LENS/REFL :TEMPERED GLASS VOLTAGE :MVOLT BALLAST :LED DRIVER	PROVIDE WITH PHOTOCELL, EITHER INTEGRAL OR REMOTE. TYPE II DISTRIBUTION. MOUNT PER MFR'S REQUIREMENTS UL LISTED WET LOCATION/VERIFY ADA BUILDING WALKWAYS
S2	LED 3000K 5500LM 51W	LITHONIA LIGHTING (OR APPROVED OTHER)	RSX1 LED P1 SERIES	TYPE :AREA LIGHT (SINGLE/TWIN HEAD) MOUNTING :POLE MOUNT (+20'-0") HOUSING : LENS/REFL : VOLTAGE :MVOLT BALLAST :LED DRIVER	TYPE III MEDIUM DISTRIBUTION INTEGRAL PHOTOCELL PARKING AREA
S3a	LED 3000K 975LM 14W	USAI LIGHTING (OR APPROVED OTHER)	BEVELED 1020 SERIES	TYPE :4.5" DIA. DOWNLIGHT MOUNTING :RECESSED HOUSING :ALUMINUM LENS/REFL :SOLITE VOLTAGE :MVOLT BALLAST :LED DRIVER	UL LISTED WET LOCATION CUSTOM FINISH TO MATCH METAL SOFFIT BLACK OR BRONZE FINISH PER ARCHITECT MAIN BUILDING ENTRANCES
S3b	LED 3000K 650LM 11W	LUMENART LIGHTING (OR APPROVED OTHER)	AWL18 SERIES	TYPE :EXTERIOR SCONCE MOUNTING :SURFACE (+8'-0" AFF) HOUSING :ALUMINUM LENS/REFL :TEMPERED GLASS VOLTAGE :MVOLT BALLAST :LED DRIVER	20 DEGREE BEAM ANGLE. FIXTURE SHALL BE DOWNLIGHT ONLY. FIXTURES LOCATED AT ROOF TERRACE MOUNT AT 7'-0" AFF. BLACK OR BRONZE FINISH PER ARCHITECT BUILDING EXTERIOR, ROOF TERRACE
S4	LED 3000K 1000LM 14W	COOPER LIGHTING (OR APPROVED OTHER)	SMD6R SERIES	TYPE :6" DIA. DOWNLIGHT MOUNTING :SURFACE HOUSING :STEEL LENS/REFL :ACRYLIC VOLTAGE :MVOLT BALLAST :LED DRIVER	WHITE FINISH UL LISTED WET LOCATION BUILDING EXTERIOR
S5	LED 3000K 2450LM 22W	GARDCO LIGHTING (OR APPROVED OTHER)	PWS SERIES	TYPE :EXTERIOR WALL PACK MOUNTING :SURFACE (+8'-0") HOUSING :ALUMINUM LENS/REFL :ACRYLIC VOLTAGE :MVOLT BALLAST :LED DRIVER	TYPE III DISTRIBUTION BUILDING SERVICE ENTRANCES
S6	LED 3000K 1000LM 15W	ALCON LIGHTING (OR APPROVED OTHER)	11235 DIR-15 SERIES	TYPE :5" DIA EXTERIOR CYLINDER MOUNTING :SURFACE HOUSING :ALUMINUM LENS/REFL :CLEAR TEMPERED GLASS VOLTAGE :MVOLT BALLAST :LED DRIVER	60 DEGREE WIDE FLOOD UL LISTED WET LOCATION ROOF TERRACE
S7	LED 3500K 1000LM 10W	EMERGENSEE LIGHTING (OR APPROVED OTHER)	SEEUVE SERIES	TYPE :EXTERIOR EMERGENCY LIGHT MOUNTING :MULLION MOUNTED HOUSING :ALUMINUM LENS/REFL : VOLTAGE :MVOLT BALLAST :LED DRIVER	DARK BRONZE FINISH PER ARCHITECT UL LISTED WET LOCATION LEASE SPACE STOREFRONT
S8 ④	LED 3000K 3400LM 17W/FT	INSIGHT LIGHTING (OR APPROVED OTHER)	ME-HO-30K SERIES	TYPE :LINEAR SIGN LIGHTER MOUNTING :SURFACE (VERIFY HEIGHT) HOUSING :ALUMINUM LENS/REFL :TEMPERED GLASS VOLTAGE :MVOLT BALLAST :LED DRIVER	VERIFY FIXTURE LENGTH, QUANTITY, FINISH, LENS AND BEAM SPREAD WITH THE OWNER. UL LISTED WET LOCATION BUILDING EXTERIOR
S9	LED 3000K 700LM/FT 5.3W/FT	KELVIX LIGHTING (OR APPROVED OTHER)	502-0 SERIES W/ CH-502 CHANNEL	TYPE :LED TAPE & CHANNEL MOUNTING :SURFACE HOUSING :ALUMINUM LENS/REFL :ACRYLIC VOLTAGE :24VOLT BALLAST :LED DRIVER	REFER TO KEYED NOTE #12 ON SHEET E1.21. CONTRACTOR TO PROVIDE ALL COMPONENTS FOR COMPLETE INSTALL UL LISTED WET LOCATION BUILDING EXTERIOR

LIGHTING NOTES:

A. REFER TO SHEET E1.21 FOR ADDITIONAL LIGHTING AND KEYED NOTES.


LIGHTING FIXTURE LIST – EXITING					
TYPE	LAMP	MANUFACTURER	CATALOG NUMBER	DESCRIPTION	OPTIONS
X1'	LED (GREEN LETTERS) (1.5W)	LITHONIA (OR APPROVED OTHER)	EXG LED EL SERIES ⑨	TYPE :EXIT SIGN MOUNTING :UNIVERSAL HOUSING :DIE-CAST ALUMINUM LENS/REFL :SINGLE FACE/DUAL FACE VOLTAGE :MVOLT BALLAST :NICKLE CADMIUM BATTERY	
X2		NOT USED		TYPE : MOUNTING : HOUSING : LENS/REFL : VOLTAGE : BALLAST :	
X3'	LED (GREEN LETTERS) (3.5W)	LITHONIA (OR APPROVED OTHER)	WLTE EL SERIES BLACK FINISH ⑨	TYPE :EXIT SIGN MOUNTING :UNIVERSAL HOUSING :DIE-CAST ALUMINUM LENS/REFL :SINGLE FACE VOLTAGE :MVOLT BALLAST :NICKLE CADMIUM BATTERY	UL LISTED WET LOCATION
X4'	LED (GREEN LETTERS) (1.5W)	LITHONIA (OR APPROVED OTHER)	EDGR 1 GMR EL SERIES ⑨	TYPE :EXIT SIGN MOUNTING :RECESSED HOUSING :DIE-CAST ALUMINUM LENS/REFL :SINGLE FACE VOLTAGE :MVOLT BALLAST :NICKLE CADMIUM BATTERY	MOUNTED CENTERED ABOVE DOOR UNLESS OTHERWISE NOTED.
X5'	LED (GREEN LETTERS) (3.5W)	EATON (OR APPROVED OTHER)	EUX SERIES	TYPE :EXIT SIGN MOUNTING :SURFACE HOUSING :DIE-CAST ALUMINUM LENS/REFL :SINGLE FACE VOLTAGE :MVOLT BALLAST :NICKLE CADMIUM BATTERY	SURFACE MOUNT AT STOREFRONT MULLION
X6'	LED (GREEN LETTERS) (3.5W)	EATON (OR APPROVED OTHER)	EUX SERIES	TYPE :EXIT SIGN MOUNTING :SURFACE HOUSING :DIE-CAST ALUMINUM LENS/REFL :SINGLE/DOUBLE FACE VOLTAGE :MVOLT BALLAST :NICKLE CADMIUM BATTERY	SURFACE MOUNT AT CEILING

LIGHTING FIXTURE LIST – TYPICAL LIVING UNITS					
TYPE	LAMP	MANUFACTURER	CATALOG NUMBER	DESCRIPTION	OPTIONS
U1 ⑤	LED 600 LM 3000K 10W	COOPER LIGHTING (OR APPROVED OTHER)	SMD4 SERIES	TYPE :4" DIA. DOWNLIGHT MOUNTING :SURFACE (J-BOX) HOUSING :ALUMINUM LENS/REFL :ACRYLIC VOLTAGE :MVOLT BALLAST :LED DRIVER (DIMMING)	FINISH PER ARCHITECT. UNIT KITCHEN, HALL
U2	LED 750 LUMEN 3000K (18W)	KUZCO LIGHTING (OR APPROVED OTHER)	FM3511 SERIES	TYPE :11" DIA. CEILING LIGHT MOUNTING :SURFACE HOUSING :STEEL LENS/REFL :GLASS VOLTAGE :120V BALLAST :LED DRIVER	CHROME FINISH UNIT DINING
U3	LED 3000K 200LM 5W	COOPER LIGHTING (OR APPROVED OTHER)	HU119D9SP SERIES	TYPE :UNDER CABINET LIGHT MOUNTING :SURFACE HOUSING :ALUMINUM LENS/REFL :ACRYLIC VOLTAGE :24V BALLAST :LED DRIVER	WHITE FINISH UNIT KITCHEN
U4 ⑥	LED 1200LM/90CRI 3000K 35W	ROYAL PACIFIC (OR APPROVED OTHER)	1097 SERIES	TYPE :52" CEILING FAN W/ LIGHT KIT MOUNTING :SURFACE HOUSING :STEEL LENS/REFL :ACRYLIC VOLTAGE :120V BALLAST :LAMP W/INTEGRAL LED DRIVER	WHITE FINISH PROVIDE BRACING AT CEILING TO SUPPORT A MINIMUM OF 35 LBS. PROVIDE W/ MODEL #WC2WH CONTROL SWITCH UNIT BEDROOM
U5 ⑪	LED 2400LM 3000K 29W	KUZCO LIGHTING (OR APPROVED OTHER)	VL61224 SERIES	TYPE :24" VANITY LIGHT MOUNTING :SURFACE (+6" ABOVE MIRROR) HOUSING :STEEL LENS/REFL :ACRYLIC VOLTAGE :120V BALLAST :INTEGRAL LED DRIVER	REFER TO ARCHITECTURAL ELEVATIONS FOR EXACT LOCATION/MOUNTING HEIGHT. FINISH PER ARCHITECT. UNIT BATHROOM

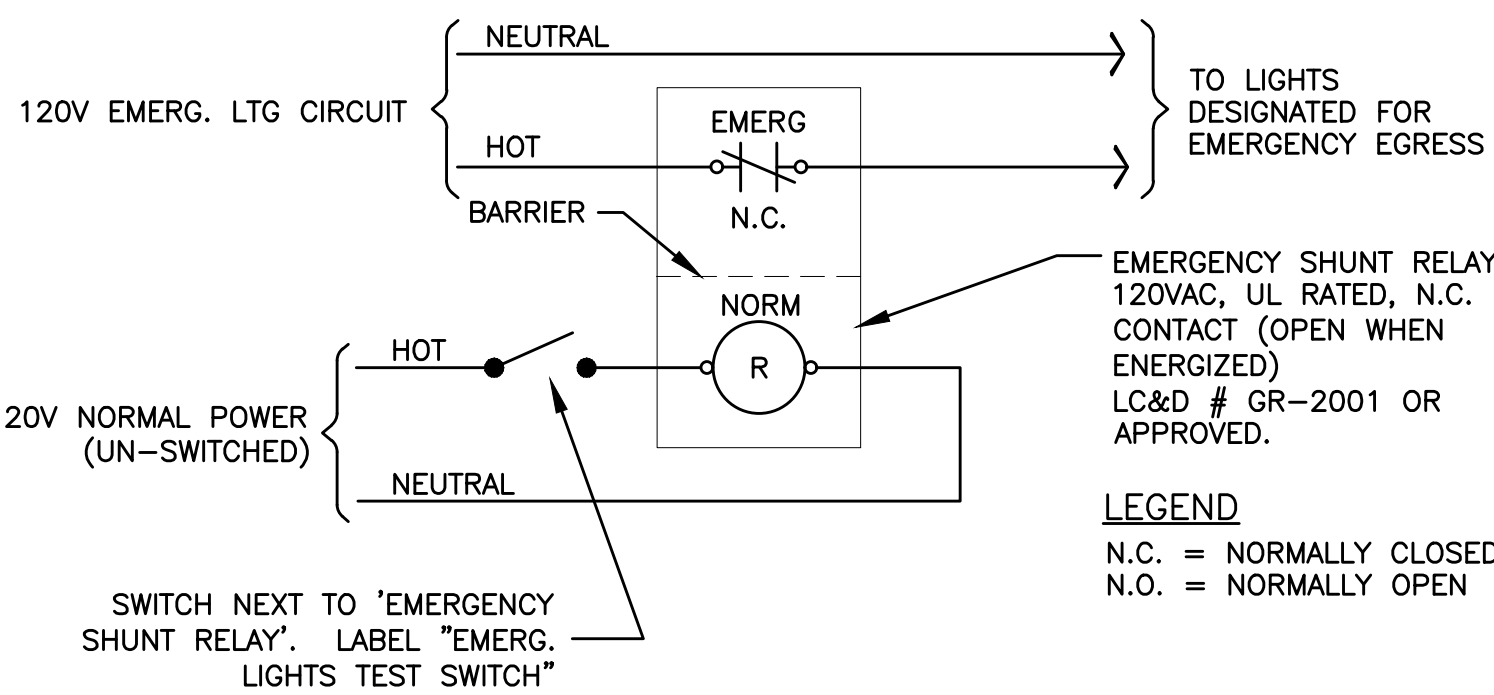


3
E1.22
NO SCALE

EMERGENCY EGRESS LIGHTING – UNSWITCHED

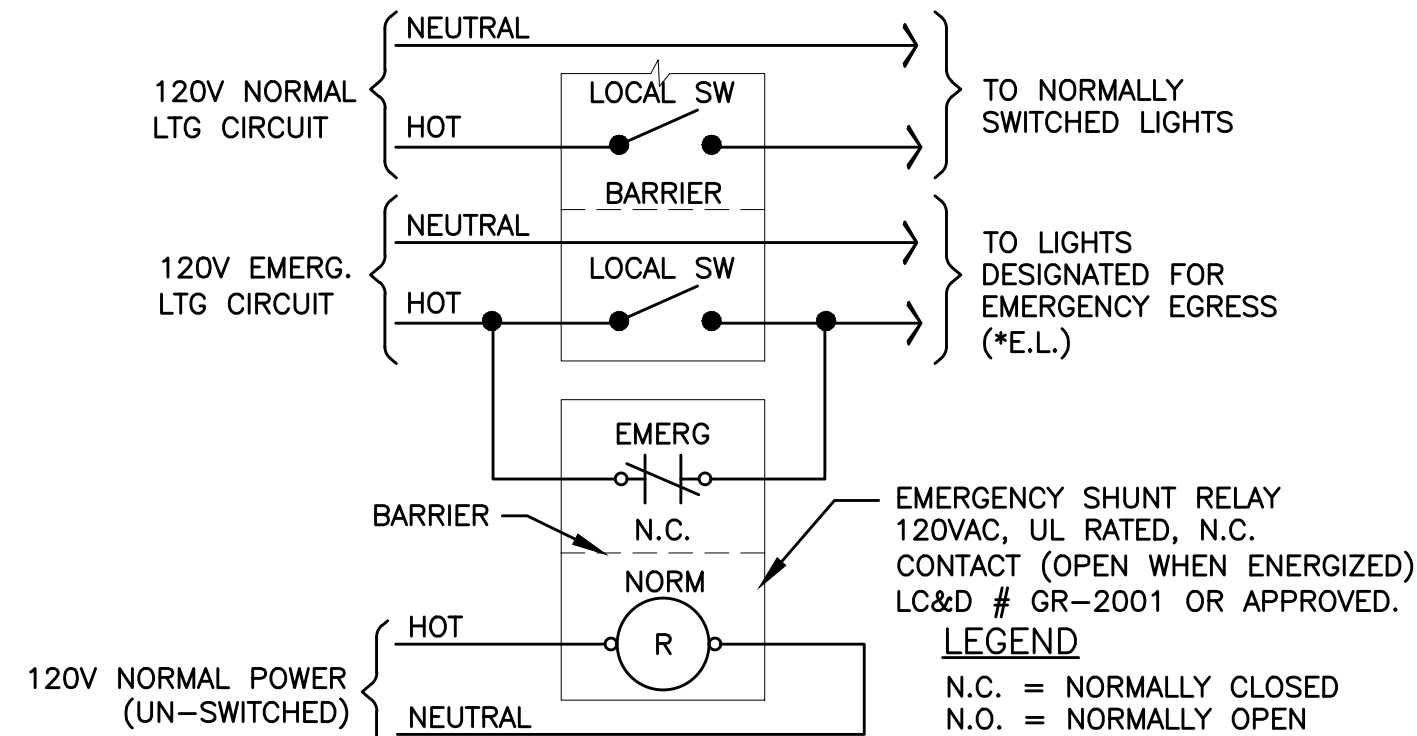

4
E1.22
NO SCALE


EMERGENCY EGRESS LIGHTING – SWITCHED

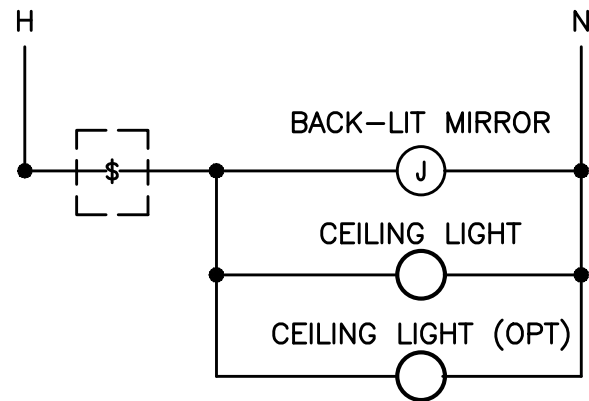

BATHROOM WITH CEILING LIGHT(S)
& BACK-LIT MIRROR


1
E1.22
NO SCALE

BATHROOM SWITCHING DIAGRAMS – TYPICAL

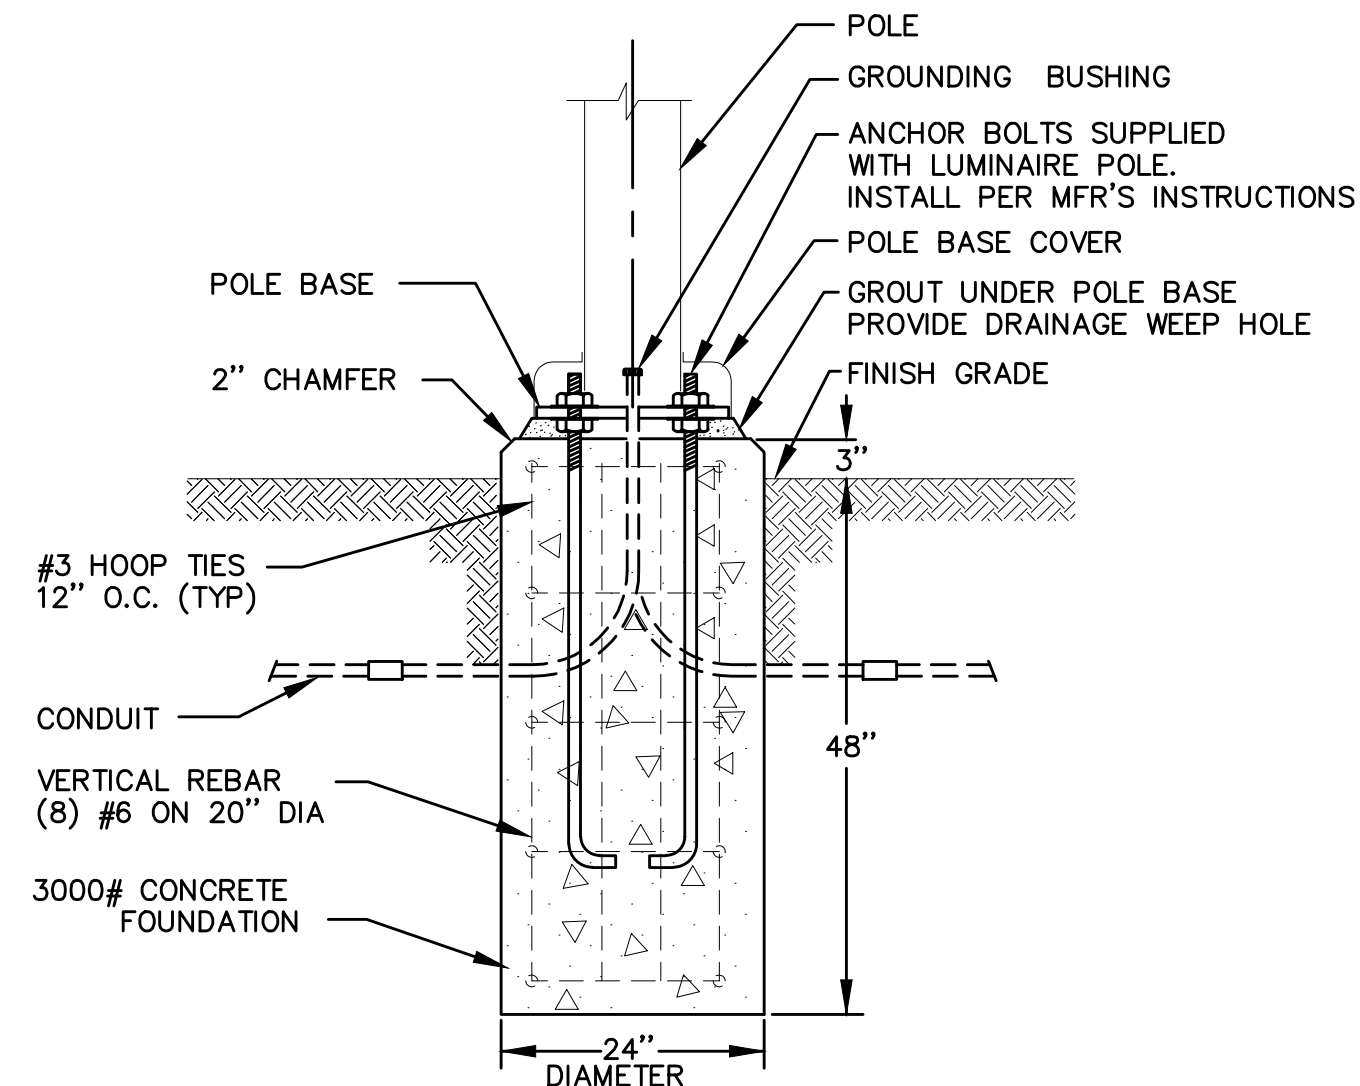

2
E1.22
NO SCALE

TYPICAL POLE BASE DETAIL

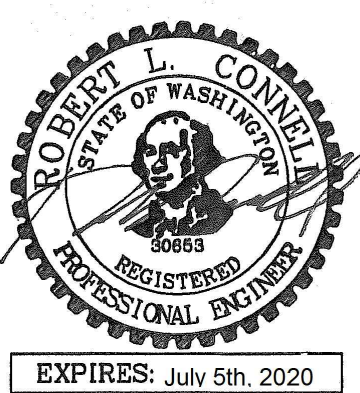

PROJECT # 2017-053
DATE: 11/06/2019
REVISIONS
PLAN REVIEW 01.24.2020
PLAN REVIEW 03.13.2020
PLAN REVIEW 04.24.2020
PLAN REVIEW 08.10.2020
PLAN REVIEW 09.17.2020
PLAN REVIEW 10.16.2020
PLAN REVIEW 11.25.2020
PLAN REVIEW 03.26.2021
PLAN REVIEW 07.15.2021
COORDINATION 08.27.2021
COORDINATION 11.05.2021
COORDINATION 12.10.2021

AEGIS
MIXED-USE DEVELOPMENT
312 E EVERGREEN BOULEVARD, VANCOUVER, WA 98660

SHEET:

E1.22

MFA Consulting Engineers
2007 S.E. Ash St.
Portland, OR 97214
PHN: (503) 234-0548
FAX: (503) 234-0877
CONTACT: DENISE TAYLOR



EXPIRES: July 6th, 2020

IN THE EVENT CONFLICTS ARE DISCOVERED

BETWEEN THE ORIGINAL SIGNED AND SEALED
DOCUMENTS PREPARED BY THE ARCHITECTS
AND/OR THEIR CONSULTANTS, AND ANY COPY OF
THE DOCUMENTS TRANSMITTED BY MAIL, FAX,
ELECTRONICALLY OR OTHERWISE, THE ORIGINAL
SIGNED AND SEALED DOCUMENTS SHALL GOVERN.

PROJECT # 2017-053

DATE: 11/06/2019

REVISIONS

PLAN REVIEW 01.24.2020

PLAN REVIEW 03.13.2020

PLAN REVIEW 04.24.2020

PLAN REVIEW 08.10.2020

PLAN REVIEW 09.17.2020

PLAN REVIEW 10.16.2020

PLAN REVIEW 11.25.2020

PLAN REVIEW 03.26.2021

PLAN REVIEW 07.15.2021

COORDINATION 08.27.2021

COORDINATION 11.05.2021

COORDINATION 12.10.2021

COORDINATION 12.10.2021

COORDINATION 12.10.2021

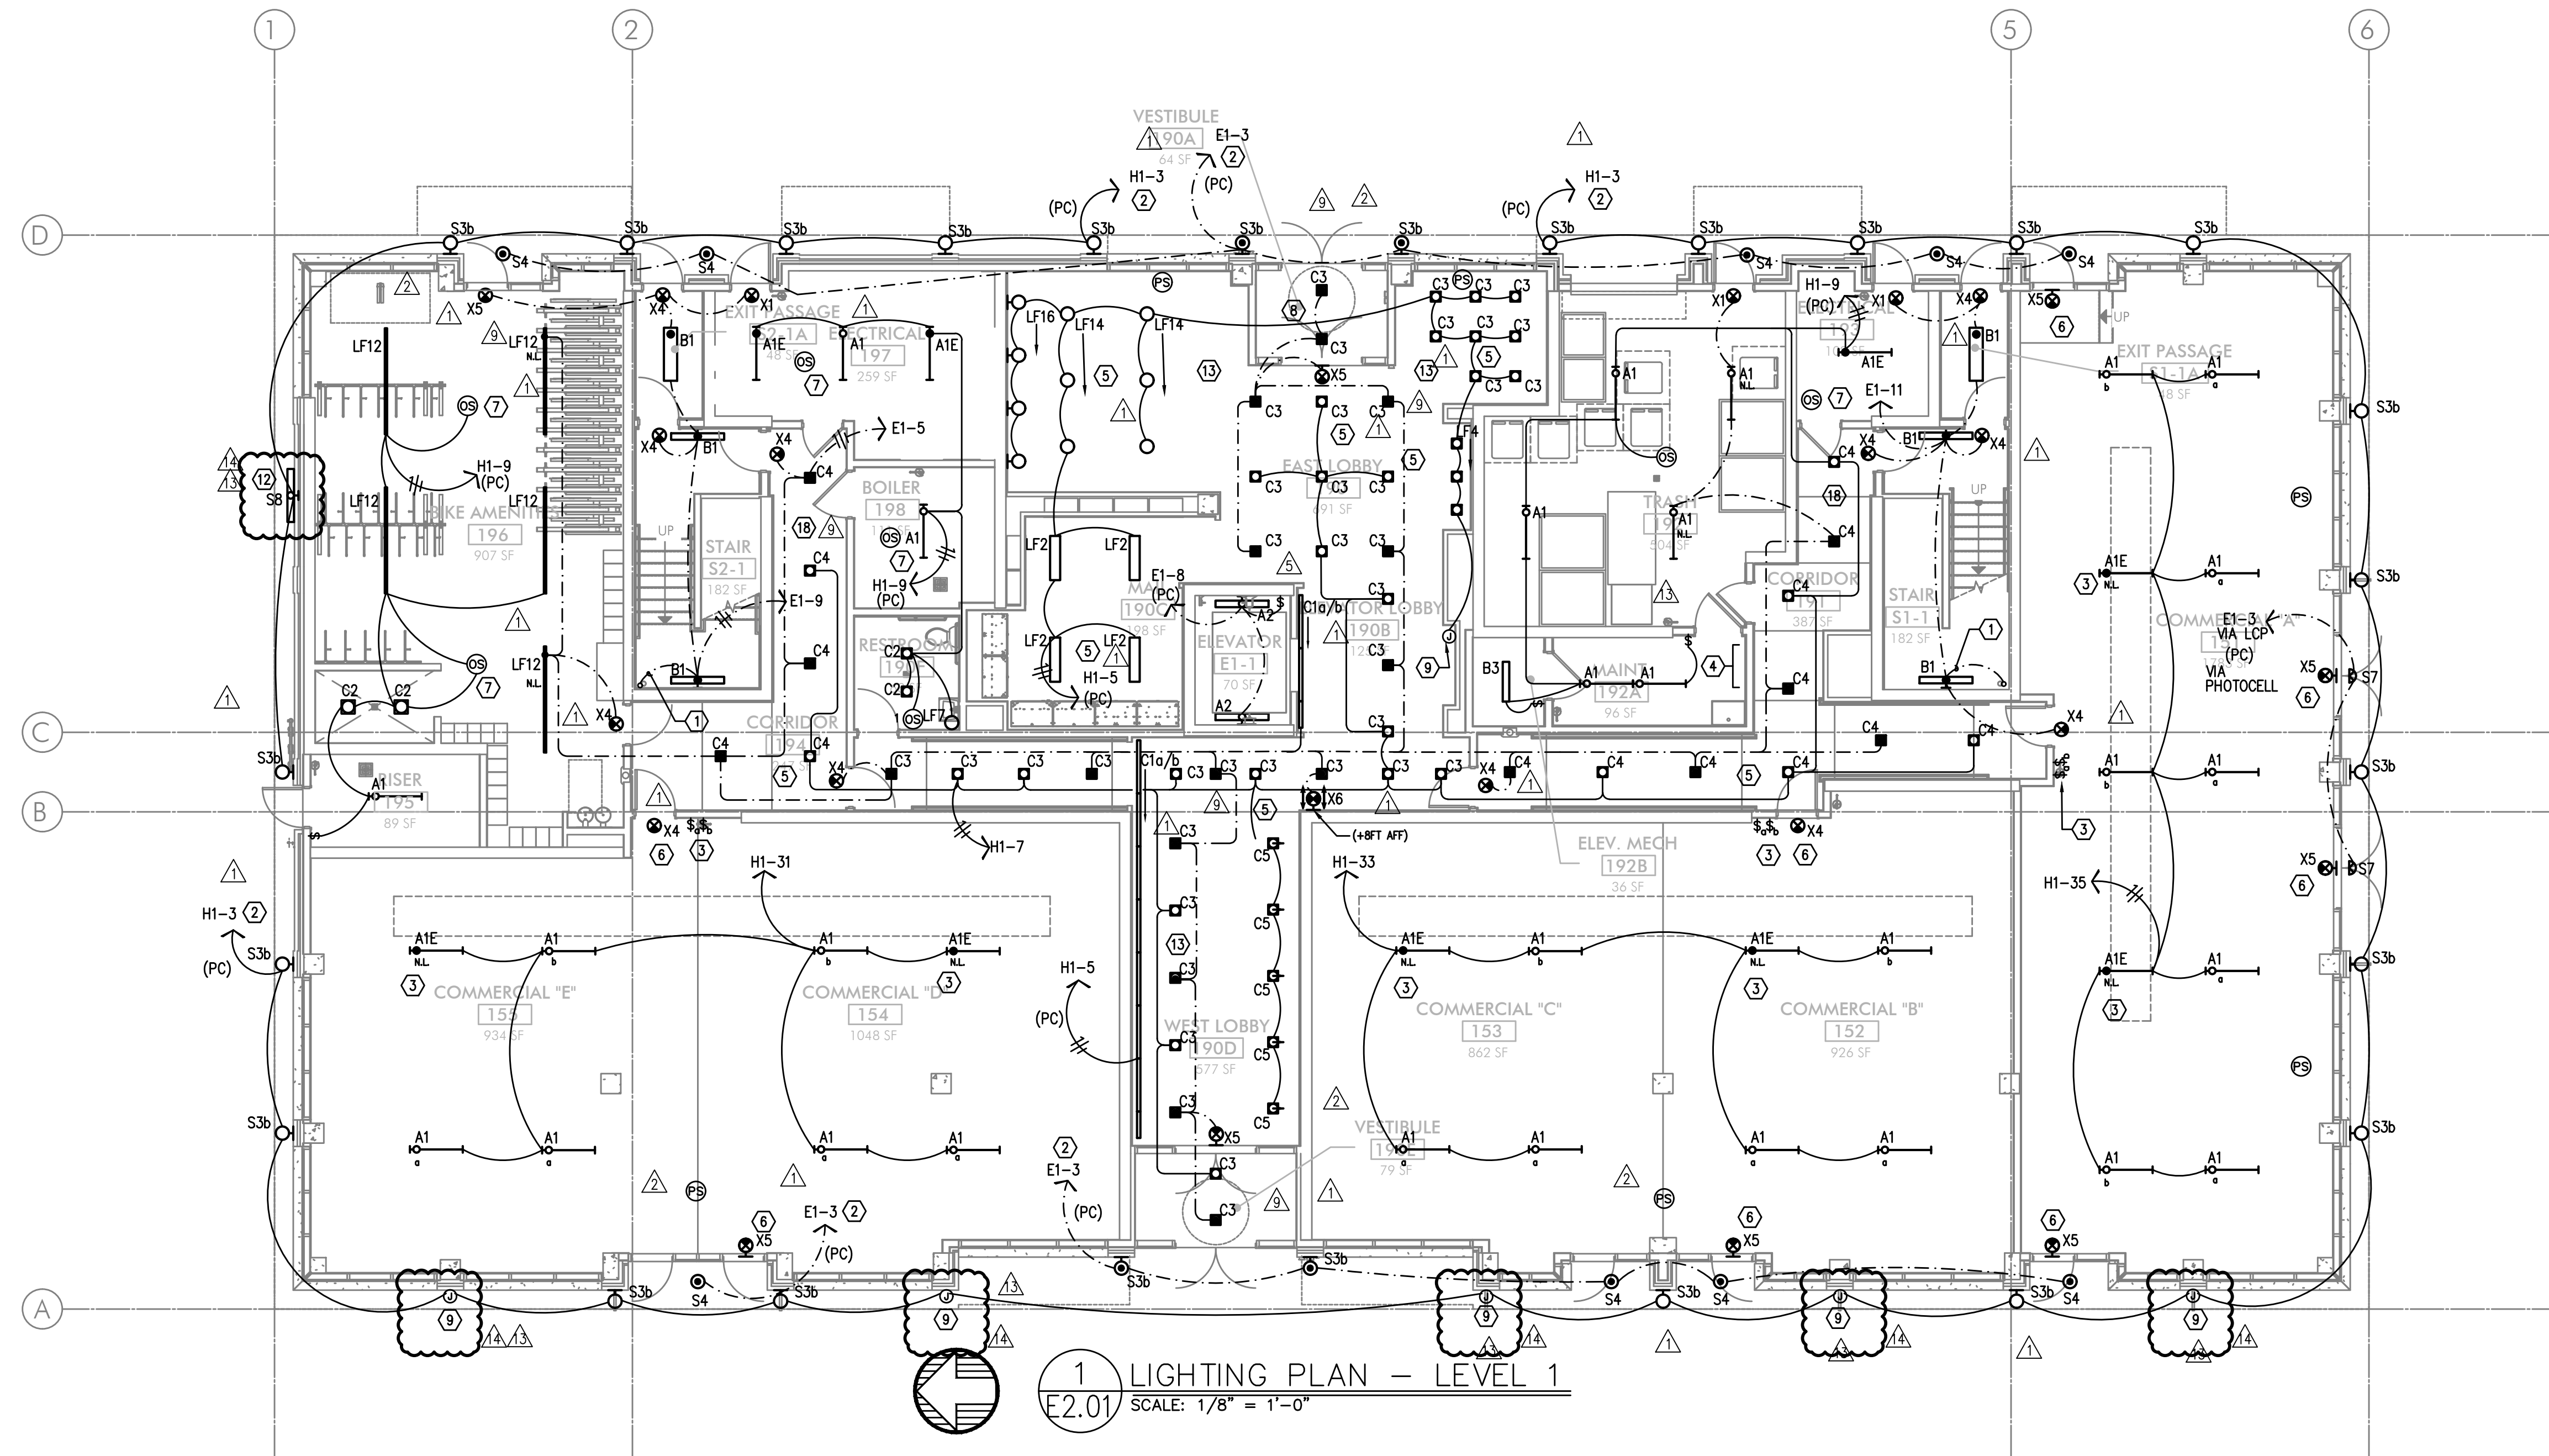

GENERAL LIGHTING NOTES:

- A. ELECTRICAL DRAWINGS ARE DIAGRAMMATICAL AND MAY NOT ACCURATELY REFLECT ACTUAL CONSTRUCTION CONDITIONS. THE ELECTRICAL CONTRACTOR SHALL BE RESPONSIBLE FOR COORDINATING THE INSTALLATION OF ALL ELECTRICAL EQUIPMENT, WITH ALL TRADES PRIOR TO AND DURING CONSTRUCTION.
- B. THE ELECTRICAL CONTRACTOR SHALL REFER TO THE ARCHITECTURAL & INTERIOR DESIGN DRAWINGS FOR ALL MOUNTING HEIGHTS AND FINISHES OF DEVICES AND FIXTURES.
- C. REFER TO ENLARGED TYPICAL UNIT PLANS (E4 SERIES SHEETS) FOR TYPICAL POWER & LIGHTING LAYOUTS FOR THE RESIDENTIAL UNITS.
- D. REFER TO SHEET E1.21 FOR LIGHT FIXTURE SCHEDULE.
- E. THE CONTRACTOR SHALL CONSULT THE ARCHITECT AND/OR INTERIOR DESIGNER FOR THE EXACT LOCATION OF ALL LIGHT FIXTURES PRIOR TO THE START OF ANY ROUGH IN WORK.
- F. REFER TO AVAILABLE ARCHITECTURAL AND/OR INTERIOR DESIGN DOCUMENTS & DRAWINGS FOR ADDITIONAL INFORMATION.
- G. OCCUPANCY SENSORS SHALL BE FIELD ADJUSTED TO ENSURE COVERAGE AND PROPER CONTROL.
- H. PROVIDE DIGITAL LIGHTING CONTROLS FOR EACH ROOM/SPACE, CONSISTING OF MULTI-BUTTON SWITCH(ES), OCC SENSORS, POWER PACKS, DAYLIGHT SENSORS, DIMMERS, INTERCONNECTING WIRING, ETC.
- I. CORRIDOR LIGHTING TO BE CONSTANT "ON" AND PROVIDED WITH LOCAL MANUAL OVERRIDE SWITCHES FOR MAINTENANCE. REFER TO SHEET E1.22 FOR SWITCH WIRING DIAGRAMS.
- J. REFER TO SHEET E1.23 FOR LIGHTING CONTROL DIAGRAMS AND DESIGN INTENT. VERIFY LIGHTING CONTROLLABILITY WITH ARCHITECT AND/OR OWNER'S REPRESENTATIVE TO DETERMINE EXACT NEEDS FOR ALL PUBLIC/Common AREAS SUCH AS LOBBIES, OFFICES, LOUNGE AREAS, ETC., PRIOR TO THE START OF ANY WORK.
- K. THERE SHALL BE NO SURFACE MOUNTED FIXTURES OR PATHWAYS (CONDUIT, ETC.) IN ANY PUBLICLY ACCESSIBLE SPACES, INCLUDING STAIRWELLS AND EXIT PASSAGEWAYS WITHOUT PRIOR APPROVAL BY OWNER AND ARCHITECT. ROUTE ALL PATHWAYS WITHIN STUD CAVITIES OR ABOVE FINISHED CEILINGS.
- L. ALL EGRESS FIXTURES SHALL BE WIRED SUCH THAT IN THE EVENT OF A POWER FAILURE, ALL LIGHTS WILL AUTOMATICALLY RETURN TO FULL POWER. REFER TO SWITCHING DETAILS ON SHEET E1.22.



KEYED NOTES:

1. CONTINUE CIRCUIT UP THROUGH THE STAIRWELL.
2. EXTERIOR BUILDING LIGHTS TO BE CONTROLLED VIA INTEGRAL AND/OR REMOTE PHOTOCELL FOR DUSK-TILL-DAWN OPERATION. REFER TO LIGHT FIXTURE SCHEDULE ON SHEET E1.21-E1.22 FOR ADDITIONAL INFORMATION.
3. LEASE SPACE LIGHTING TO HAVE DUAL SWITCHES. ONE TO CONTROL NORMAL POWER LIGHTS AND ONE TO ACT AS A MANUAL OVERRIDE FOR NIGHT LIGHT FIXTURES (NL). INTENT IS THAT THE NIGHT LIGHTS ARE TO BE "ON" 24/7 AND ONLY ILLUMINATED AT NIGHT VIA PHOTOCELL FOR DUSK-TILL-DAWN OPERATION. NIGHT LIGHT FIXTURES SHALL ALSO BE EQUIPPED WITH EMERGENCY BATTERY BACKUP IN THE EVENT OF A POWER FAILURE. ALL LIGHT FIXTURES IN THE LEASE SPACE ARE TO BE ON A SINGLE CIRCUIT AND TEMPORARILY FED FROM THE HOUSE PANEL.
4. LIGHTING CONTROL FOR LOBBY, CORRIDOR & COMMON SPACES. REFER TO DETAIL #1, SHEET E1.23 FOR MORE INFORMATION.
5. LIGHTING CONTROLS FOR THIS AREA LOCATED IN THE MAINTENANCE ROOM. SEE SHEET NOTE #4 FOR MORE INFORMATION.
6. TIE INTO TEMPORARY LIGHTING CIRCUIT AND ENSURE BATTERY BACK UP POWER FOR EGRESS.
7. LIGHT FIXTURES IN THIS SPACE CONTROLLED BY CEILING MOUNT OCCUPANCY SENSOR.
8. FIXTURE FINISH TO MATCH SOFFIT METAL.
9. PROVIDE J-BOXES; ONE MOUNTED AT 50.5" AFG AND ONE AT 69.5" AFG FOR LIGHT FIXTURES TO BE INSTALLED FOR ART INSTALLATIONS. CIRCUIT AS SHOWN. INSTALL TWO TYPE S9 LIGHT FIXTURES AT EACH LOCATION INDICATED. REFER TO THE LIGHTING SCHEDULE ON E1.22 FOR MORE INFORMATION. COORDINATE WORK WITH ALL TRADES, ARCHITECT AND DESIGNER.
10. REFER TO DETAIL #3, SHEET E1.23 FOR CLUBROOM LIGHTING CONTROL ASSIGNMENT.
11. PROVIDE PHOTOCELL FOR DAY-LIGHT REDUCTION OF LIGHT LEVELS.
12. PROVIDE LIGHT FIXTURE(S) AT TOP OF WALL FOR ART INSTALLATION. COORDINATE WITH THE ARTIST AND OWNER FOR EXACT LOCATION AND FIELD AIM.
13. CONTRACTOR TO COORDINATE WITH LANDSCAPE LIGHTING INSTALLER AND PROVIDE ROUGH-IN AND POWER CONNECTION(S) AS REQUIRED.
14. TYPICAL LIGHTING CONTROL FOR RESIDENTIAL CORRIDORS. REFER TO DETAIL #2, SHEET E1.23 FOR MORE INFORMATION.
15. TIE INTO 5TH FLOOR CORRIDOR CIRCUITS. SEE DETAIL 4 ON SHEET E1.23 FOR CONTROLS LOCATED IN THE 6TH FLOOR MAINTENANCE ROOM.
16. EGRESS LIGHT FIXTURES TO BE CONSTANT 'ON' AND FAIL SAFE TO FULL LIGHT OUTPUT IN THE EVENT OF A POWER OUTAGE. TIE FIXTURES INTO CORRIDOR EGRESS CIRCUIT. SEE DETAIL 4 ON E1.23.
17. COORDINATE EXACT LOCATION OF LIGHT FIXTURES WITH ARCHITECT PRIOR TO ROUGH IN.
18. CIRCUIT SERVICE CORRIDOR LIGHT FIXTURES AHEAD OF SWITCHED FIXTURES ON SAME CIRCUIT. CORRIDOR LIGHT FIXTURES TO BE CONSTANT 'ON'.

MFI Consulting Engineers
2007 S.E. Ash St.
Portland, OR 97214
PHN: (503) 234-0548
FAX: (503) 234-0877
www.MFIA-ENG.COM
CONTACT: DENISE TAYLOR

SHEET:

A
E2.01

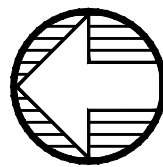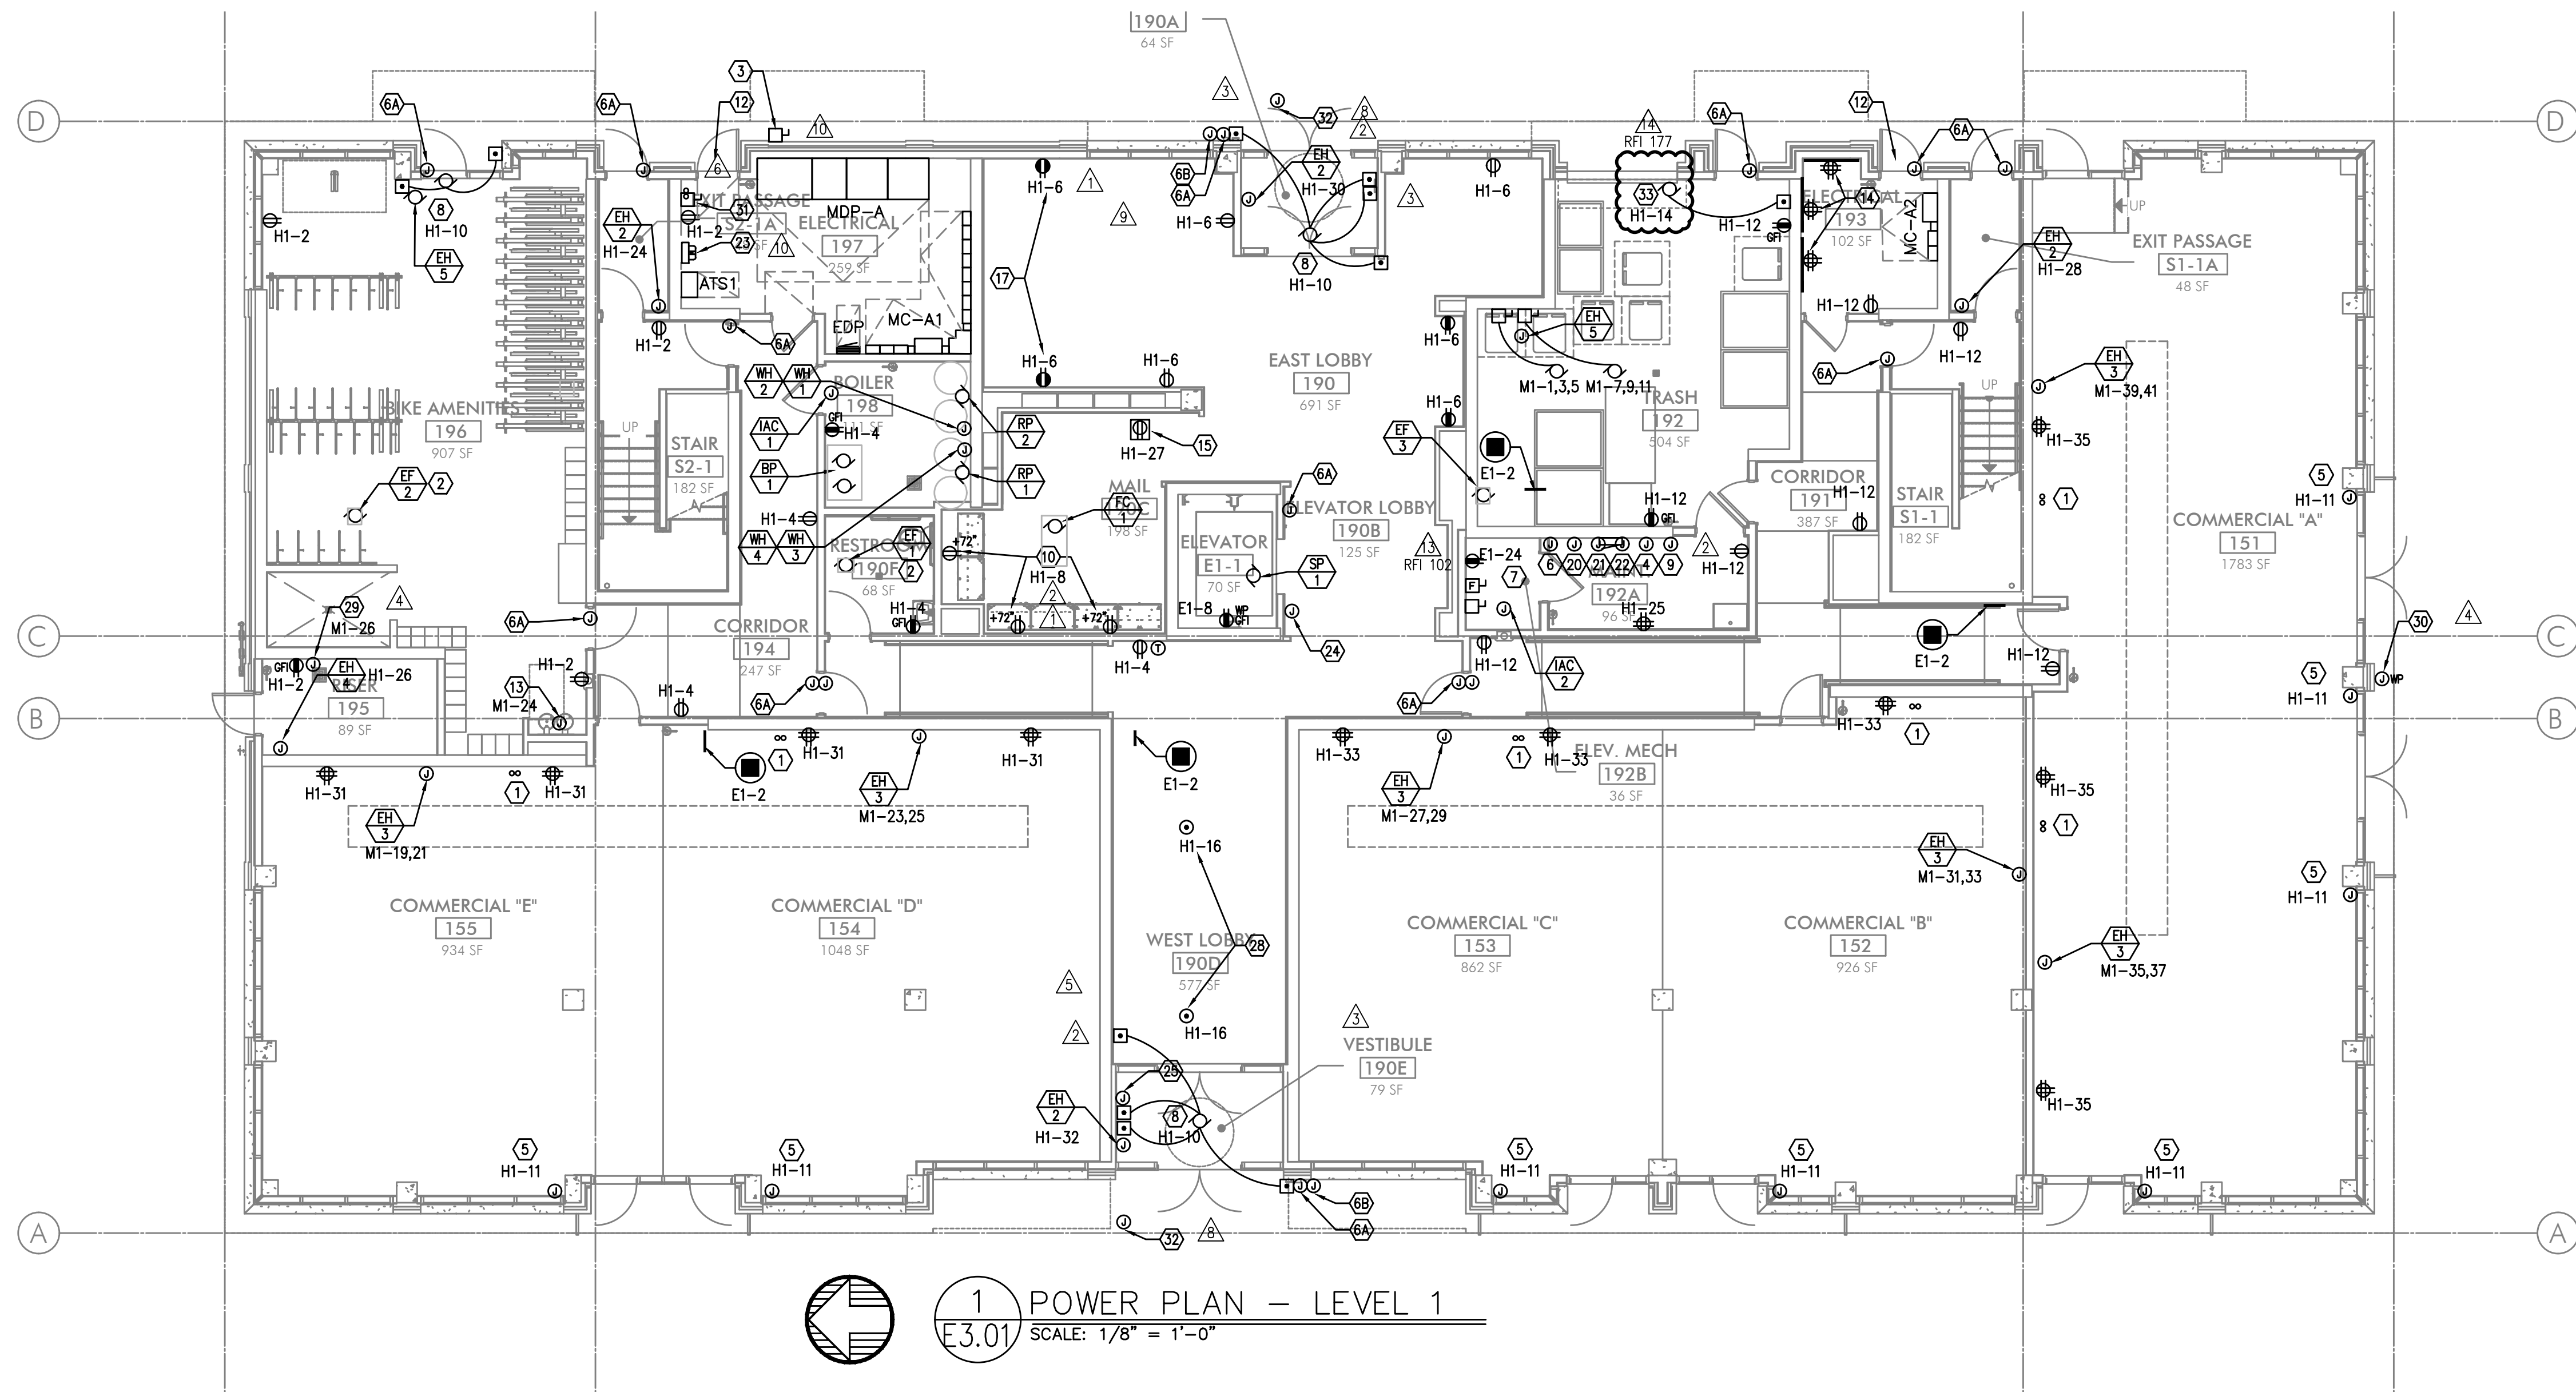

1 POWER PLAN - LEVEL 1
E3.01 SCALE: 1/8" = 1'-0"

GENERAL POWER NOTES:

- ALL PLANS ARE CONSIDERED DIAGRAMMATICAL. THEREFORE ALL EQUIPMENT SIZES AND DEVICE LOCATIONS ARE APPROXIMATE AND SUBJECT TO FIELD CONDITIONS AND PRODUCT APPROVAL.
- ELECTRICAL CONTRACTOR TO PROVIDE THERMOSTATS NOT SUPPLIED BY MECHANICAL CONTRACTOR. CONSULT MECHANICAL PLANS FOR ADDITIONAL INFORMATION.
- ELECTRICAL CONTRACTOR SHALL PROVIDE INSTALLATION AND FINAL CONNECTION OF THERMOSTATS. CONSULT MECHANICAL CONTRACTOR FOR EXACT REQUIREMENTS PRIOR TO ROUGH IN.
- REFER TO INTERIOR DECORATOR AND/OR ARCHITECTURAL DRAWINGS FOR DIMENSIONED LOCATION(S) AND ELEVATIONS OF FIXTURES & DEVICES. OTHER DEVICES SHOWN ON THE ELECTRICAL PLANS AND NOT INDICATED ON THE DECORATOR'S OR ARCHITECT'S DRAWINGS, SHALL BE INSTALLED AT STANDARD MOUNTING HEIGHT AS INDICATED THE SYMBOL LIST.
- REFER TO ENLARGED TYPICAL UNIT PLANS (E4 SERIES SHEETS) FOR TYPICAL POWER & LIGHTING LAYOUTS FOR THE APARTMENT UNITS.
- ELECTRICAL EQUIPMENT SHOWN IN THE ELECTRICAL ROOMS IS APPROXIMATE, BASED ON TYPICAL PRODUCTS. CONTRACTOR SHALL VERIFY ANY SUBMITTED EQUIPMENT WILL FIT WITHIN THE SPACE PROVIDED, PRIOR TO PRODUCT SUBMITTAL REVIEW.
- ELECTRICAL CONTRACTOR SHALL COORDINATE WITH THE LOW VOLTAGE ("T" SERIES) PLANS, INCLUDING FIRE ALARM AND SYSTEMS INSTALLER, AND PROVIDE ROUGH IN AS NEEDED.
- THERE SHALL BE NO SURFACE MOUNTED FIXTURES OR PATHWAYS (CONDUIT, ETC.) IN ANY PUBLICLY ACCESSIBLE SPACES, INCLUDING STAIRWELLS AND EXIT PASSAGEWAYS WITHOUT PRIOR APPROVAL BY OWNER AND ARCHITECT. ROUTE ALL PATHWAYS WITHIN STUD CAVITIES OR ABOVE FINISHED CEILINGS.
- "SOLAR READY" WORK FOR FUTURE PHOTOVOLTAIC ARRAY SHALL BE PER THE ELECTRICAL REQUIREMENTS AS DEFINED BY THE WASHINGTON STATE ADMINISTRATION CODE, TITLE 51, CHAPTER 51, SECTION 60106.

KEYED NOTES:

- ROUTE (2) EMPTY 3 1/2" CONDUIT WITH PULL STRING, FROM MC-A2 IN CEILING ABOVE AND STUBBED INTO LEASE SPACE FOR TENANT SUPPLIED BRANCH PANEL AND CAP OFF.
- CONTINUOUS OPERATING EXHAUST FAN TO BE TIED INTO LIGHTING CIRCUIT FOR THIS AREA.
- GENERATOR DISCONNECT. SEE ONE-LINE DIAGRAM ON SHEET E1.11.
- PROVIDE ONE 20A, 120V, 1P CIRCUIT FOR GENERATOR REMOTE ANNUNCIATOR. FED FROM PANEL E1, CKT 23.
- PROVIDE ONE 20A, 120V, 1P POWER CONNECTION FOR TENANT BUILDING SIGNS. CIRCUIT AS INDICATED VIA LIGHTING CONTROL PANEL. MOUNT JUNCTION BOX TIGHT TO CEILING (AT BUILDING INTERIOR), COORDINATING EXACT LOCATION WITH SIGN INSTALLER'S SLEEVE AND PER ARCHITECT'S DIRECTION AT EACH LOCATION.
- PROVIDE ONE 20A, 120V, 1P CIRCUIT FROM PANEL H1, CKT 22 FOR BUILDING ENTRY ACCESS CONTROL SYSTEM AND PROVIDE ROUGH IN AND WIRING TO ACCESS POINTS LOCATED ON PLANS. CONSULT WITH LOW VOLTAGE SYSTEMS INSTALLER AND THE "T" SERIES SHEETS FOR ADDITIONAL INFORMATION.
- ENTRY ACCESS POINT.
- APARTMENT CALL DIRECTORY.
- VERIFY ELEVATOR EQUIPMENT LOCATION AND ELECTRICAL REQUIREMENTS WITH ARCHITECT AND/OR ELEVATOR PROVIDER.
- PROVIDE ONE 20A, 120V, 1P CIRCUIT FROM PANEL H1, CKT 10 FOR AUTOMATIC DOOR OPENERS.
- PROVIDE ONE 20A, 120V, 1P DEDICATED CIRCUIT FROM PANEL H1, CKT 29 FOR DAS SYSTEM.
- PACKAGE CONCIERGE SYSTEM. MOUNT DUPLEX RECEPTACLES AT 76" AFF. CIRCUIT AS INDICATED.
- PROVIDE ONE 20A, 120V, 1P CIRCUIT FOR A/V SYSTEM CONTROL, FROM PANEL H2, CKT 15. CONSULT INTERIORS GROUP FOR EXACT LOCATION. COORDINATE WITH SYSTEM INSTALLER FOR EXACT REQUIREMENTS.
- ELECTRICAL SERVICE METER ROOMS SHALL HAVE OUTWARD SWING DOORS EQUIPPED WITH PANIC HARDWARE. PROVIDE A KEY BOX AT THE EXTERIOR FOR CLARK PUBLIC UTILITIES 24/7 ACCESS.
- PROVIDE ONE 20A, 120V, 1P CIRCUIT FOR DRINKING FOUNTAIN FROM PANEL M1, CKT 24. CONSULT MECHANICAL AND/OR PLUMBING CONTRACTOR FOR EXACT ELECTRICAL REQUIREMENTS PRIOR TO ROUGH IN.
- LOW VOLTAGE/COMMUNICATIONS SYSTEM DEMARCATION BOARD(S). COORDINATE LOCATIONS AND ELECTRICAL POWER REQUIREMENTS WITH THE TELECOM PLANS ("T" SERIES SHEETS) AND LOW VOLTAGE SYSTEMS INSTALLERS, AND PROVIDE ROUGH IN AND/OR FINAL ELECTRICAL POWER CONNECTIONS & DEVICES. REFER PANEL 'H1' SCHEDULE ON E1.13 FOR CIRCUITS.
- CEILING MOUNTED 20A DUPLEX RECEPTACLE FOR SECURITY CAMERA. CONSULT ARCHITECT FOR ADDITIONAL INFORMATION. CIRCUIT AS INDICATED.
- SHAFT FOR THE ROUTING OF ELECTRICAL FEEDERS FROM TENANT METERS TO RESIDENTIAL UNITS.
- PROVIDE RECEPTACLE WITH TYPES A & C USB PORTS, LEVITON T5633-T OR APPROVED EQUAL.
- PROVIDE ONE 20A, 120V, 1P CIRCUIT FROM PANEL E1, CKT 18 FOR ELEVATOR SMOKE CURTAINS. SMOKE CURTAINS ARE TO BE SMOKE GUARD SYSTEM MODEL 200 AND SHALL BE INSTALLED AT EACH ELEVATOR LOBBY. ELECTRICAL CONTRACTOR SHALL BE RESPONSIBLE TO COORDINATE INSTALLATION WITH THE EQUIPMENT PROVIDER/INSTALLER FOR ALL ELECTRICAL REQUIREMENTS PRIOR TO ROUGH IN. EACH SMOKE CURTAIN SHALL BE INTERLINKED WITH THE NEAREST SMOKE DETECTOR AT EACH LOCATION.
- CONSULT ARCHITECT AND/OR MECHANICAL PLANS FOR ADDITIONAL INFORMATION REGARDING THE FIREPLACE. PROVIDE ELECTRICAL CONNECTION(S) AS NEEDED FROM PANEL H2, CKT 19.
- PROVIDE ONE 20A, 120V, 1P CIRCUIT FROM PANEL H1, CKT 15 FOR THE APARTMENT ENTRY SYSTEM PRIMARY CONTROL PANEL AND PROVIDE ROUGH IN AND WIRING, AS NEEDED, TO EACH UNIT ENTRY. CONSULT WITH LOW VOLTAGE SYSTEMS INSTALLER AND THE "T" SERIES SHEETS FOR ADDITIONAL INFORMATION.
- PROVIDE ONE 20A, 120V, 1P CIRCUIT FROM PANEL H1, CKT 27 FOR THE SECURITY SYSTEM PANEL AND PROVIDE ROUGH IN AND WIRING, AS NEEDED. CONSULT WITH LOW VOLTAGE SYSTEMS INSTALLER AND THE "T" SERIES SHEETS FOR ADDITIONAL INFORMATION.
- PROVIDE ONE 20A, 120V, 1P CIRCUIT FROM PANEL E1, CKT 19 FOR THE FIRE ALARM CONTROL PANEL. CONSULT WITH LOW VOLTAGE SYSTEMS INSTALLER AND THE "T" SERIES SHEETS FOR ADDITIONAL INFORMATION.
- METER LOCATION FOR PV SYSTEM. VERIFY AND COORDINATE WITH SYSTEM INSTALLER.
- AREA OF REFUGE PANEL. CONSULT FIRE ALARM PLANS ("T" SERIES SHEETS) AND PROVIDE ROUGH IN AS NEEDED. PROVIDE POWER CONNECTION FROM PANEL E1.
- PROVIDE ROUGH IN, AS NEEDED, FOR FIRE ALARM REMOTE ANNUNCIATION PANEL.
- PROVIDE ROUGH IN, AS NEEDED, FOR AUDIO SYSTEM CONTROLS. COORDINATE EXACT LOCATION WITH THE SYSTEM INSTALLER.
- PROVIDE ROUGH IN, AS NEEDED, FOR WIFI SYSTEM.
- CONSULT INTERIORS PLANS TO VERIFY EXACT LOCATION OF FLOOR BOX DEVICES PRIOR TO ROUGH IN.
- PROVIDE ONE 20A, 120V CIRCUIT, FROM PANEL 'M1' FOR IRRIGATION CONTROLS. COORDINATE WITH LANDSCAPING FOR EXACT POWER REQUIREMENTS AND LOCATION PRIOR TO ROUGH IN.
- PROVIDE ONE 20A, 120V CIRCUIT, FROM PANEL 'H1' FOR LANDSCAPE LIGHTING EQUIPMENT CONNECTION. REFER TO E1.02 FOR MORE INFORMATION. COORDINATE WITH LANDSCAPING FOR EXACT POWER REQUIREMENTS AND LOCATION PRIOR TO ROUGH IN.
- PROVIDE TWO 1-1/2" EMPTY CONDUITS W/ PULL STRING, ROUTED FROM THE ELECTRICAL ROOM TO THE ROOF FOR PV SOLAR SYSTEM PROVIDED AND INSTALLED BY OTHERS. COORDINATE WITH THE STRUCTURAL ENGINEER FOR THE ROUTING OF THE CONDUITS UP THROUGH THE BUILDING PRIOR TO ANY WORK.
- PROVIDE ONE 20A, 120V, 1P CIRCUIT FROM PANEL M1, CKT 40 TO J-BOX BEHIND FACE OF CANOPY FOR BUILDING SIGNAGE BY OTHERS. REFER TO ARCHITECTURAL PLANS FOR EXACT LOCATION. SIGNS TO BE CONTROLLED VIA PHOTOCELL ALONG WITH BUILDING LIGHTS.
- PROVIDE ONE 20A, 120V, 1P CIRCUIT FROM PANEL H1, CKT 14 FOR OVERHEAD DOOR OPENER.




PROJECT # 2017-053
DATE: 11/06/2019
REVISIONS
PLAN REVIEW 01.24.2020
PLAN REVIEW 03.13.2020
PLAN REVIEW 04.24.2020
PLAN REVIEW 08.10.2020
PLAN REVIEW 09.17.2020
PLAN REVIEW 10.16.2020
PLAN REVIEW 11.25.2020
PLAN REVIEW 03.26.2021
PLAN REVIEW 07.15.2021
COORDINATION 08.27.2021
COORDINATION 11.05.2021
COORDINATION 12.10.2021

AEGIS
MIXED-USE DEVELOPMENT
312 E EVERGREEN BOULEVARD, VANCOUVER, WA 98660

MFA
Consulting Engineers
2007 S.E. Ash St.
Portland, OR 97214
PHN: (503) 234-0548
FAX: (503) 234-0677
WWW.MFA-ENG.COM
CONTACT: DENISE TAYLOR

SHEET:

A
E3.01

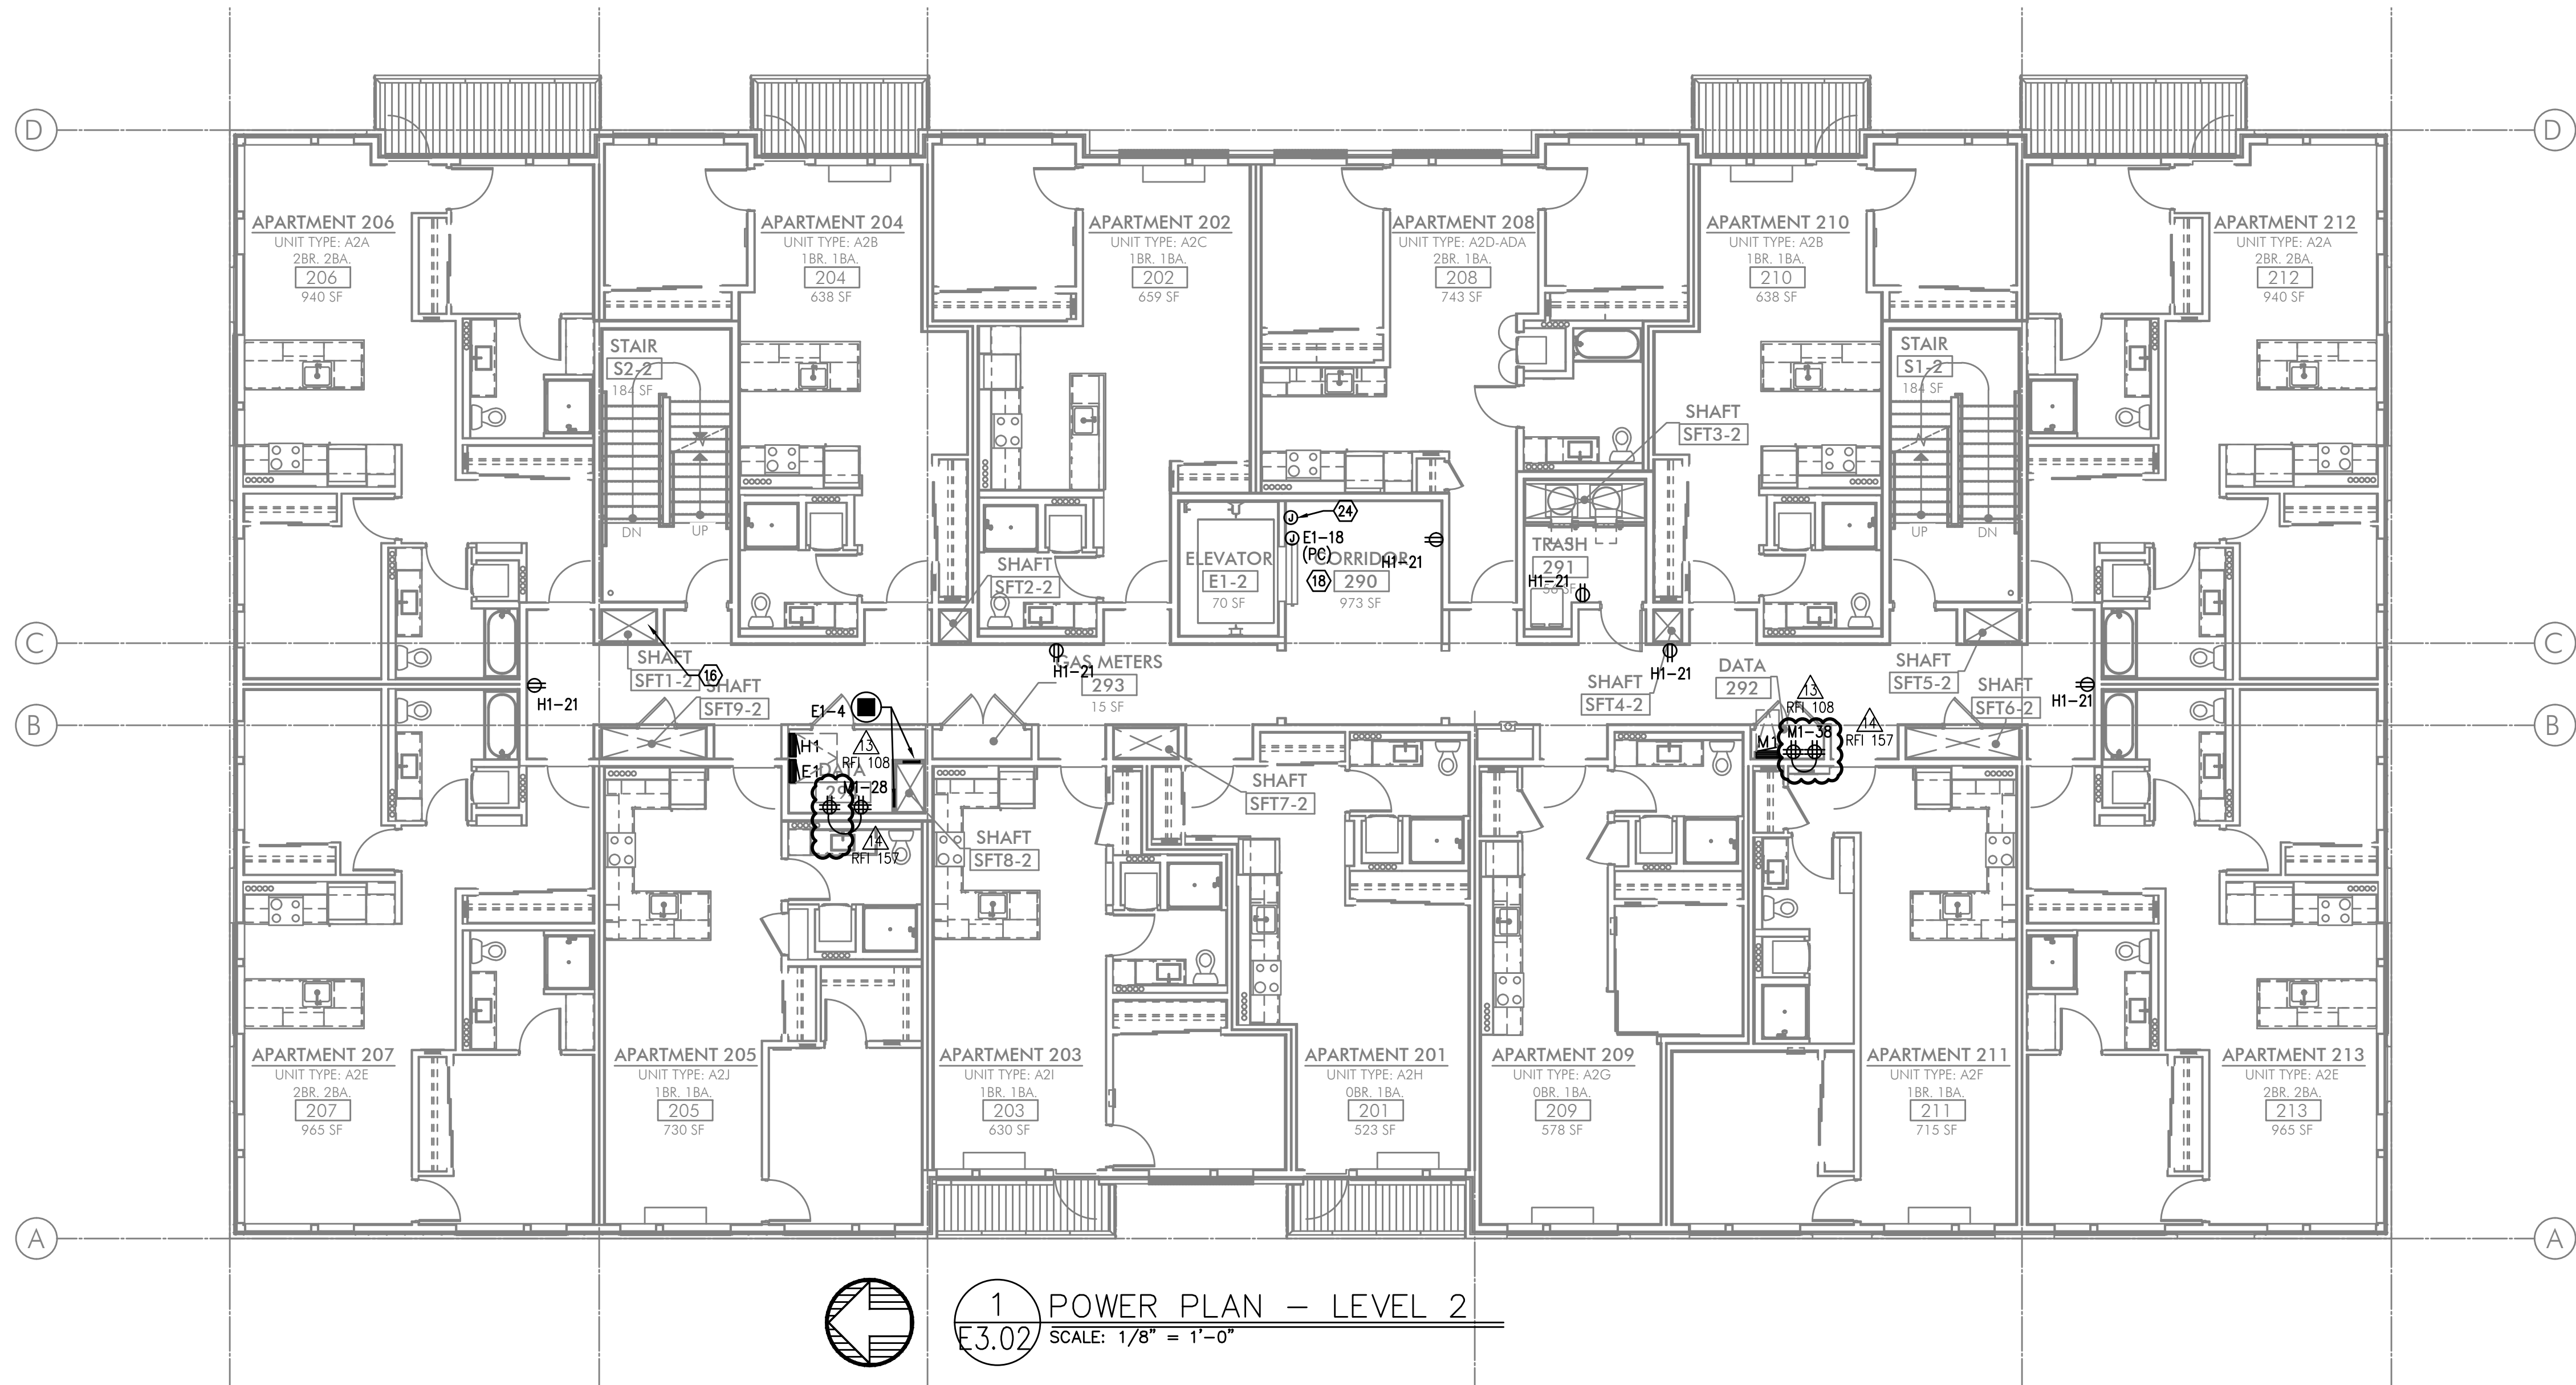

GENERAL POWER NOTES:

- ALL PLANS ARE CONSIDERED DIAGRAMMATICAL. THEREFORE ALL EQUIPMENT SIZES AND DEVICE LOCATIONS ARE APPROXIMATE AND SUBJECT TO FIELD CONDITIONS AND PRODUCT APPROVAL.
- ELECTRICAL CONTRACTOR TO PROVIDE THERMOSTATS NOT SUPPLIED BY MECHANICAL CONTRACTOR. CONSULT MECHANICAL PLANS FOR ADDITIONAL INFORMATION.
- ELECTRICAL CONTRACTOR SHALL PROVIDE INSTALLATION AND FINAL CONNECTION OF THERMOSTATS. CONSULT MECHANICAL CONTRACTOR FOR EXACT REQUIREMENTS PRIOR TO ROUGH IN.
- REFER TO INTERIOR DECORATOR AND/OR ARCHITECTURAL DRAWINGS FOR DIMENSIONED LOCATION(S) AND ELEVATIONS OF FIXTURES & DEVICES. OTHER DEVICES SHOWN ON THE ELECTRICAL PLANS AND NOT INDICATED ON THE DECORATOR'S OR ARCHITECT'S DRAWINGS, SHALL BE INSTALLED AT STANDARD MOUNTING HEIGHT AS INDICATED THE SYMBOL LIST.
- REFER TO ENLARGED TYPICAL UNIT PLANS (E4 SERIES SHEETS) FOR TYPICAL POWER & LIGHTING LAYOUTS FOR THE APARTMENT UNITS.
- ELECTRICAL EQUIPMENT SHOWN IN THE ELECTRICAL ROOMS IS APPROXIMATE, BASED ON TYPICAL PRODUCTS. CONTRACTOR SHALL VERIFY ANY SUBMITTED EQUIPMENT WILL FIT WITHIN THE SPACE PROVIDED, PRIOR TO PRODUCT SUBMITTAL REVIEW.
- ELECTRICAL CONTRACTOR SHALL COORDINATE WITH THE LOW VOLTAGE ('T' SERIES) PLANS, INCLUDING FIRE ALARM AND SYSTEMS INSTALLER, AND PROVIDE ROUGH IN AS NEEDED.
- THERE SHALL BE NO SURFACE MOUNTED FIXTURES OR PATHWAYS (CONDUIT, ETC.) IN ANY PUBLICLY ACCESSIBLE SPACES, INCLUDING STAIRWELLS AND EXIT PASSAGEWAYS WITHOUT PRIOR APPROVAL BY OWNER AND ARCHITECT. ROUTE ALL PATHWAYS WITHIN STUD CAVITIES OR ABOVE FINISHED CEILINGS.
- "SOLAR READY" WORK FOR FUTURE PHOTOVOLTAIC ARRAY SHALL BE PER THE ELECTRICAL REQUIREMENTS AS DEFINED BY THE WASHINGTON STATE ADMINISTRATION CODE, TITLE 51, CHAPTER 51, SECTION 60106.

KEYED NOTES:


- ROUTE (2) EMPTY 3 1/2" CONDUIT WITH PULL STRING, FROM MC-A2 IN CEILING ABOVE AND STUBBED INTO LEASE SPACE FOR TENANT SUPPLIED BRANCH PANEL AND CAP OFF.
- CONTINUOUS OPERATING EXHAUST FAN TO BE TIED INTO LIGHTING CIRCUIT FOR THIS AREA.
- GENERATOR DISCONNECT. SEE ONE-LINE DIAGRAM ON SHEET E1.11.
- PROVIDE ONE 20A, 120V, 1P CIRCUIT FOR GENERATOR REMOTE ANNUNCIATOR. FED FROM PANEL E1, CKT 23.
- PROVIDE ONE 20A, 120V, 1P POWER CONNECTION FOR TENANT BUILDING SIGNS. CIRCUIT AS INDICATED VIA LIGHTING CONTROL PANEL. MOUNT JUNCTION BOX TIGHT TO CEILING (AT BUILDING INTERIOR), COORDINATING EXACT LOCATION WITH SIGN INSTALLER'S SLEEVE AND PER ARCHITECT'S DIRECTION AT EACH LOCATION.
- PROVIDE ONE 20A, 120V, 1P CIRCUIT FROM PANEL H1, CKT 22 FOR BUILDING ENTRY ACCESS CONTROL SYSTEM AND PROVIDE ROUGH IN AND WIRING TO ACCESS POINTS LOCATED ON PLANS. CONSULT WITH LOW VOLTAGE SYSTEMS INSTALLER AND THE 'T' SERIES SHEETS FOR ADDITIONAL INFORMATION.
- ENTRY ACCESS POINT.
- APARTMENT CALL DIRECTORY.
- PROVIDE ONE 20A, 120V, 1P CIRCUIT FROM PANEL H1, CKT 10 FOR AUTOMATIC DOOR OPENERS.
- PROVIDE ONE 20A, 120V, 1P DEDICATED CIRCUIT FROM PANEL H1, CKT 29 FOR DAS SYSTEM.
- PACKAGE CONCIERGE SYSTEM. MOUNT DUPLEX RECEPTACLES AT 76" AFF. CIRCUIT AS INDICATED.

- PROVIDE ONE 20A, 120V, 1P CIRCUIT FOR A/V SYSTEM CONTROL, FROM PANEL H2, CKT 15. CONSULT INTERIORS GROUP FOR EXACT LOCATION. COORDINATE WITH SYSTEM INSTALLER FOR EXACT REQUIREMENTS.
- ELECTRICAL SERVICE METER ROOMS SHALL HAVE OUTWARD SWING DOORS EQUIPPED WITH PANIC HARDWARE. PROVIDE A KEY BOX AT THE EXTERIOR FOR CLARK PUBLIC UTILITIES 24/7 ACCESS.
- PROVIDE ONE 20A, 120V, 1P CIRCUIT FOR DRINKING FOUNTAIN FROM PANEL M1, CKT 24. CONSULT MECHANICAL AND/OR PLUMBING CONTRACTOR FOR EXACT ELECTRICAL REQUIREMENTS PRIOR TO ROUGH IN.
- LOW VOLTAGE/COMMUNICATIONS SYSTEM DEMARCATION BOARD(S). COORDINATE LOCATIONS AND ELECTRICAL POWER REQUIREMENTS WITH THE TELECOM PLANS ('T' SERIES SHEETS) AND LOW VOLTAGE SYSTEMS INSTALLERS, AND PROVIDE ROUGH IN AND/OR FINAL ELECTRICAL POWER CONNECTIONS & DEVICES. REFER PANEL 'H1' SCHEDULE ON E1.13 FOR CIRCUITS.
- CEILING MOUNTED 20A DUPLEX RECEPTACLE FOR SECURITY CAMERA. CONSULT ARCHITECT FOR ADDITIONAL INFORMATION. CIRCUIT AS INDICATED.
- SHAFT FOR THE ROUTING OF ELECTRICAL FEEDERS FROM TENANT METERS TO RESIDENTIAL UNITS.
- PROVIDE RECEPTACLE WITH TYPES A & C USB PORTS, LEVITON T5633-T OR APPROVED EQUAL.
- PROVIDE ONE 20A, 120V, 1P CIRCUIT FROM PANEL E1, CKT 18 FOR ELEVATOR SMOKE CURTAINS. SMOKE CURTAINS ARE TO BE SMOKE GUARD SYSTEM MODEL 200 AND SHALL BE INSTALLED AT EACH ELEVATOR LOBBY. ELECTRICAL CONTRACTOR SHALL BE RESPONSIBLE TO COORDINATE INSTALLATION WITH THE EQUIPMENT PROVIDER/INSTALLER FOR ALL ELECTRICAL REQUIREMENTS PRIOR TO ROUGH IN. EACH SMOKE CURTAIN SHALL BE INTERLINKED WITH THE NEAREST SMOKE DETECTOR AT

- CONSULT ARCHITECT AND/OR MECHANICAL PLANS FOR ADDITIONAL INFORMATION REGARDING THE FIREPLACE. PROVIDE ELECTRICAL CONNECTION(S) AS NEEDED FROM PANEL H2, CKT 19.
- PROVIDE ONE 20A, 120V, 1P CIRCUIT FROM PANEL H1, CKT 15 FOR THE APARTMENT ENTRY SYSTEM PRIMARY CONTROL PANEL AND PROVIDE ROUGH IN AND WIRING, AS NEEDED, TO EACH UNIT ENTRY. CONSULT WITH LOW VOLTAGE SYSTEMS INSTALLER AND THE 'T' SERIES SHEETS FOR ADDITIONAL INFORMATION.
- PROVIDE ONE 20A, 120V, 1P CIRCUIT FROM PANEL H1, CKT 27 FOR THE SECURITY SYSTEM PANEL AND PROVIDE ROUGH IN AND WIRING, AS NEEDED. CONSULT WITH LOW VOLTAGE SYSTEMS INSTALLER AND THE 'T' SERIES SHEETS FOR ADDITIONAL INFORMATION.
- PROVIDE ONE 20A, 120V, 1P CIRCUIT FROM PANEL E1, CKT 19 FOR THE FIRE ALARM CONTROL PANEL. CONSULT WITH LOW VOLTAGE SYSTEMS INSTALLER AND THE 'T' SERIES SHEETS FOR ADDITIONAL INFORMATION.
- METER LOCATION FOR PV SYSTEM. VERIFY AND COORDINATE WITH SYSTEM INSTALLER.
- AREA OF REFUGE PANEL. CONSULT FIRE ALARM PLANS ('T' SERIES SHEETS) AND PROVIDE ROUGH IN AS NEEDED. PROVIDE POWER CONNECTION FROM PANEL E1.
- PROVIDE ROUGH IN, AS NEEDED, FOR FIRE ALARM REMOTE ANNUNCIATION PANEL.
- PROVIDE ROUGH IN, AS NEEDED, FOR AUDIO SYSTEM CONTROLS. COORDINATE EXACT LOCATION WITH THE SYSTEM INSTALLER.
- PROVIDE ROUGH IN, AS NEEDED, FOR WIFI SYSTEM.
- CONSULT INTERIORS PLANS TO VERIFY EXACT LOCATION OF FLOOR BOX DEVICES PRIOR TO ROUGH IN.

- PROVIDE ONE 20A, 120V CIRCUIT, FROM PANEL 'M1' FOR IRRIGATION CONTROLS. COORDINATE WITH LANDSCAPING FOR EXACT POWER REQUIREMENTS AND LOCATION PRIOR TO ROUGH IN.
- PROVIDE ONE 20A, 120V CIRCUIT, FROM PANEL 'H1' FOR LANDSCAPE LIGHTING EQUIPMENT CONNECTION. REFER TO E1.02 FOR MORE INFORMATION. COORDINATE WITH LANDSCAPING FOR EXACT POWER REQUIREMENTS AND LOCATION PRIOR TO ROUGH IN.
- PROVIDE TWO 1-1/2" EMPTY CONDUITS W/ PULL STRING, ROUTED FROM THE ELECTRICAL ROOM TO THE ROOF FOR PV SOLAR SYSTEM PROVIDED AND INSTALLED BY OTHERS. COORDINATE WITH THE STRUCTURAL ENGINEER FOR THE ROUTING OF THE CONDUITS UP THROUGH THE BUILDING PRIOR TO ANY WORK.
- PROVIDE ONE 20A, 120V, 1P CIRCUIT FROM PANEL M1, CKT 40 TO J-BOX BEHIND FACE OF CANOPY FOR BUILDING SIGNAGE BY OTHERS. REFER TO ARCHITECTURAL PLANS FOR EXACT LOCATION. SIGNS TO BE CONTROLLED VIA PHOTOCELL, ALONG WITH BUILDING LIGHTS.
- PROVIDE ONE 20A, 120V, 1P CIRCUIT FROM PANEL H1, CKT 14 FOR OVERHEAD DOOR OPENER.

MFA
Consulting Engineers
2007 S.E. Ash St.
Portland, OR 97214
PHN: (503) 234-0548
FAX: (503) 234-0677
WWW.MFA-ENG.COM
CONTACT: DENISE TAYLOR

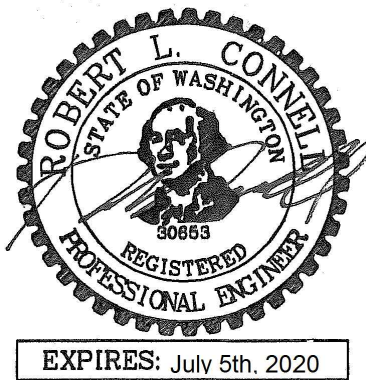

PROJECT # 2017-053
DATE: 11/06/2019

REVISIONS

- | NO. | REVISION | DATE |
|-----|--------------|------------|
| 1 | PLAN REVIEW | 01.24.2020 |
| 2 | PLAN REVIEW | 03.13.2020 |
| 3 | PLAN REVIEW | 04.24.2020 |
| 4 | PLAN REVIEW | 08.10.2020 |
| 5 | PLAN REVIEW | 09.17.2020 |
| 6 | PLAN REVIEW | 10.16.2020 |
| 7 | PLAN REVIEW | 11.25.2020 |
| 8 | PLAN REVIEW | 03.26.2021 |
| 9 | PLAN REVIEW | 07.15.2021 |
| 10 | COORDINATION | 08.27.2021 |
| 11 | COORDINATION | 11.05.2021 |
| 12 | COORDINATION | 12.10.2021 |

AEGIS
MIXED-USE DEVELOPMENT
312 E EVERGREEN BOULEVARD, VANCOUVER, WA 98660

SHEET:

A
E3.02



GENERAL POWER NOTES:

- A. ALL PLANS ARE CONSIDERED DIAGRAMMATICAL. THEREFORE ALL EQUIPMENT SIZES AND DEVICE LOCATIONS ARE APPROXIMATE AND SUBJECT TO FIELD CONDITIONS AND PRODUCT APPROVAL.
- B. ELECTRICAL CONTRACTOR TO PROVIDE THERMOSTATS NOT SUPPLIED BY MECHANICAL CONTRACTOR. CONSULT MECHANICAL PLANS FOR ADDITIONAL INFORMATION.
- C. ELECTRICAL CONTRACTOR SHALL PROVIDE INSTALLATION AND FINAL CONNECTION OF THERMOSTATS. CONSULT MECHANICAL CONTRACTOR FOR EXACT REQUIREMENTS PRIOR TO ROUGH IN.
- G. REFER TO INTERIOR DECORATOR AND/OR ARCHITECTURAL DRAWINGS FOR DIMENSIONED LOCATION(S) AND ELEVATIONS OF FIXTURES & DEVICES. OTHER DEVICES SHOWN ON THE ELECTRICAL PLANS AND NOT INDICATED ON THE DECORATOR'S OR ARCHITECT'S DRAWINGS, SHALL BE INSTALLED AT STANDARD MOUNTING HEIGHT AS INDICATED THE SYMBOL LIST.
- H. REFER TO ENLARGED TYPICAL UNIT PLANS (E4 SERIES SHEETS) FOR TYPICAL POWER & LIGHTING LAYOUTS FOR THE APARTMENT UNITS.
- I. ELECTRICAL EQUIPMENT SHOWN IN THE ELECTRICAL ROOMS IS APPROXIMATE, BASED ON TYPICAL PRODUCTS. CONTRACTOR SHALL VERIFY ANY SUBMITTED EQUIPMENT WILL FIT WITHIN THE SPACE PROVIDED, PRIOR TO PRODUCT SUBMITTAL REVIEW.
- J. ELECTRICAL CONTRACTOR SHALL COORDINATE WITH THE LOW VOLTAGE ("T" SERIES) PLANS, INCLUDING FIRE ALARM AND SYSTEMS INSTALLER, AND PROVIDE ROUGH IN AS NEEDED.
- K. THERE SHALL BE NO SURFACE MOUNTED FIXTURES OR PATHWAYS (CONDUIT, ETC.) IN ANY PUBLICLY ACCESSIBLE SPACES, INCLUDING STAIRWELLS AND EXIT PASSAGEWAYS WITHOUT PRIOR APPROVAL BY OWNER AND ARCHITECT. ROUTE ALL PATHWAYS WITHIN STUD CAVITIES OR ABOVE FINISHED CEILINGS.
- L. "SOLAR READY" WORK FOR FUTURE PHOTOVOLTAIC ARRAY SHALL BE PER THE ELECTRICAL REQUIREMENTS AS DEFINED BY THE WASHINGTON STATE ADMINISTRATION CODE, TITLE 51, CHAPTER 51, SECTION 60106.

KEYED NOTES:


1. ROUTE (2) EMPTY 3 1/2" CONDUIT WITH PULL STRING, FROM MC-A2 IN CEILING ABOVE AND STUBBED INTO LEASE SPACE FOR TENANT SUPPLIED BRANCH PANEL AND CAP OFF.
2. CONTINUOUS OPERATING EXHAUST FAN TO BE TIED INTO LIGHTING CIRCUIT FOR THIS AREA.
3. GENERATOR DISCONNECT. SEE ONE-LINE DIAGRAM ON SHEET E1.11.
4. PROVIDE ONE 20A, 120V, 1P CIRCUIT FOR GENERATOR REMOTE ANNUNCIATOR. FED FROM PANEL 'E1', CKT 23.
5. PROVIDE ONE 20A, 120V, 1P POWER CONNECTION FOR TENANT BUILDING SIGNS. CIRCUIT AS INDICATED VIA LIGHTING CONTROL PANEL. MOUNT JUNCTION BOX TIGHT TO CEILING (AT BUILDING INTERIOR), COORDINATING EXACT LOCATION WITH SIGN INSTALLER'S SLEEVE AND PER ARCHITECT'S DIRECTION AT EACH LOCATION.
6. PROVIDE ONE 20A, 120V, 1P CIRCUIT FROM PANEL H1, CKT 22 FOR BUILDING ENTRY ACCESS CONTROL SYSTEM AND PROVIDE ROUGH IN AND WIRING TO ACCESS POINTS LOCATED ON PLANS. CONSULT WITH LOW VOLTAGE SYSTEMS INSTALLER AND THE "T" SERIES SHEETS FOR ADDITIONAL INFORMATION.
- 6A. ENTRY ACCESS POINT.
- 6B. APARTMENT CALL DIRECTORY.
7. VERIFY ELEVATOR EQUIPMENT LOCATION AND ELECTRICAL REQUIREMENTS WITH ARCHITECT AND/OR ELEVATOR PROVIDER.
8. PROVIDE ONE 20A, 120V, 1P CIRCUIT FROM PANEL H1, CKT 10 FOR AUTOMATIC DOOR OPENERS.
9. PROVIDE ONE 20A, 120V, 1P DEDICATED CIRCUIT FROM PANEL H1, CKT 29 FOR DAS SYSTEM.
10. PACKAGE CONCIERGE SYSTEM. MOUNT DUPLEX RECEPTACLES AT 76" AFF. CIRCUIT AS INDICATED.

11. PROVIDE ONE 20A, 120V, 1P CIRCUIT FOR A/V SYSTEM CONTROL, FROM PANEL H2, CKT 15. CONSULT INTERIORS GROUP FOR EXACT LOCATION. COORDINATE WITH SYSTEM INSTALLER FOR EXACT REQUIREMENTS.
12. ELECTRICAL SERVICE METER ROOMS SHALL HAVE OUTWARD SWING DOORS EQUIPPED WITH PANIC HARDWARE. PROVIDE A KEY BOX AT THE EXTERIOR FOR CLARK PUBLIC UTILITIES 24/7 ACCESS.
13. PROVIDE ONE 20A, 120V, 1P CIRCUIT FOR DRINKING FOUNTAIN FROM PANEL M1, CKT 24. CONSULT MECHANICAL AND/OR PLUMBING CONTRACTOR FOR EXACT ELECTRICAL REQUIREMENTS PRIOR TO ROUGH IN.
14. LOW VOLTAGE/COMMUNICATIONS SYSTEM DEMARCATION BOARD(S). COORDINATE LOCATIONS AND ELECTRICAL POWER REQUIREMENTS WITH THE TELECOM PLANS ("T" SERIES SHEETS) AND LOW VOLTAGE SYSTEMS INSTALLERS, AND PROVIDE ROUGH IN AND/OR FINAL ELECTRICAL POWER CONNECTIONS & DEVICES. REFER PANEL 'H1' SCHEDULE ON E1.13 FOR CIRCUITS.
15. CEILING MOUNTED 20A DUPLEX RECEPTACLE FOR SECURITY CAMERA. CONSULT ARCHITECT FOR ADDITIONAL INFORMATION. CIRCUIT AS INDICATED.
16. SHAFT FOR THE ROUTING OF ELECTRICAL FEEDERS FROM TENANT METERS TO RESIDENTIAL UNITS.
17. PROVIDE RECEPTACLE WITH TYPES A & C USB PORTS, LEVITON T5633-T OR APPROVED EQUAL.
18. PROVIDE ONE 20A, 120V, 1P CIRCUIT FROM PANEL E1, CKT 18 FOR ELEVATOR SMOKE CURTAINS. SMOKE CURTAINS ARE TO BE SMOKE GUARD SYSTEM MODEL 200 AND SHALL BE INSTALLED AT EACH ELEVATOR LOBBY. ELECTRICAL CONTRACTOR SHALL BE RESPONSIBLE TO COORDINATE INSTALLATION WITH THE EQUIPMENT PROVIDER/INSTALLER FOR ALL ELECTRICAL REQUIREMENTS PRIOR TO ROUGH IN. EACH SMOKE CURTAIN SHALL BE INTERLINKED WITH THE NEAREST SMOKE DETECTOR AT EACH LOCATION.

19. CONSULT ARCHITECT AND/OR MECHANICAL PLANS FOR ADDITIONAL INFORMATION REGARDING THE FIREPLACE. PROVIDE ELECTRICAL CONNECTION(S) AS NEEDED FROM PANEL H2, CKT 19.
20. PROVIDE ONE 20A, 120V, 1P CIRCUIT FROM PANEL H1, CKT 15 FOR THE APARTMENT ENTRY SYSTEM PRIMARY CONTROL PANEL AND PROVIDE ROUGH IN AND WIRING, AS NEEDED, TO EACH UNIT ENTRY. CONSULT WITH LOW VOLTAGE SYSTEMS INSTALLER AND THE "T" SERIES SHEETS FOR ADDITIONAL INFORMATION.
21. PROVIDE ONE 20A, 120V, 1P CIRCUIT FROM PANEL H1, CKT 27 FOR THE SECURITY SYSTEM PANEL AND PROVIDE ROUGH IN AND WIRING, AS NEEDED. CONSULT WITH LOW VOLTAGE SYSTEMS INSTALLER AND THE "T" SERIES SHEETS FOR ADDITIONAL INFORMATION.
22. PROVIDE ONE 20A, 120V, 1P CIRCUIT FROM PANEL E1, CKT 19 FOR THE FIRE ALARM CONTROL PANEL. CONSULT WITH LOW VOLTAGE SYSTEMS INSTALLER AND THE "T" SERIES SHEETS FOR ADDITIONAL INFORMATION.
23. METER LOCATION FOR PV SYSTEM. VERIFY AND COORDINATE WITH SYSTEM INSTALLER.
24. AREA OF REFUGE PANEL. CONSULT FIRE ALARM PLANS ("T" SERIES SHEETS) AND PROVIDE ROUGH IN AS NEEDED. PROVIDE POWER CONNECTION FROM PANEL E1.
25. PROVIDE ROUGH IN, AS NEEDED, FOR FIRE ALARM REMOTE ANNUNCIATION PANEL.
26. PROVIDE ROUGH IN, AS NEEDED, FOR AUDIO SYSTEM CONTROLS. COORDINATE EXACT LOCATION WITH THE SYSTEM INSTALLER.
27. PROVIDE ROUGH IN, AS NEEDED, FOR WIFI SYSTEM.
28. CONSULT INTERIORS PLANS TO VERIFY EXACT LOCATION OF FLOOR BOX DEVICES PRIOR TO ROUGH IN.

29. PROVIDE ONE 20A, 120V CIRCUIT, FROM PANEL 'M1' FOR IRRIGATION CONTROLS. COORDINATE WITH LANDSCAPING FOR EXACT POWER REQUIREMENTS AND LOCATION PRIOR TO ROUGH IN.
30. PROVIDE ONE 20A, 120V CIRCUIT, FROM PANEL 'H1' FOR LANDSCAPE LIGHTING EQUIPMENT CONNECTION. REFER TO E1.02 FOR MORE INFORMATION. COORDINATE WITH LANDSCAPING FOR EXACT POWER REQUIREMENTS AND LOCATION PRIOR TO ROUGH IN.
31. PROVIDE TWO 1-1/2" EMPTY CONDUITS W/ PULL STRING, ROUTED FROM THE ELECTRICAL ROOM TO THE ROOF FOR PV SOLAR SYSTEM PROVIDED AND INSTALLED BY OTHERS. COORDINATE WITH THE STRUCTURAL ENGINEER FOR THE ROUTING OF THE CONDUITS UP THROUGH THE BUILDING PRIOR TO ANY WORK.
32. PROVIDE ONE 20A, 120V, 1P CIRCUIT FROM PANEL M1, CKT 40 TO J-BOX BEHIND FACE OF CANOPY FOR BUILDING SIGNAGE BY OTHERS. REFER TO ARCHITECTURAL PLANS FOR EXACT LOCATION. SIGNS TO BE CONTROLLED VIA PHOTOCELL ALONG WITH BUILDING LIGHTS.
33. PROVIDE ONE 20A, 120V, 1P CIRCUIT FROM PANEL H1, CKT 14 FOR OVERHEAD DOOR OPENER.

MFA Consulting Engineers
2007 S.E. Ash St.
Portland, OR 97214
PHN: (503) 234-0548
FAX: (503) 234-0677
CONTACT: DENISE TAYLOR

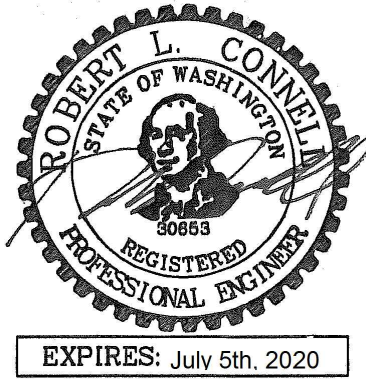

PROJECT # 2017-053
DATE: 11/06/2019
REVISIONS

- PLAN REVIEW 01.24.2020
PLAN REVIEW 03.13.2020
PLAN REVIEW 04.24.2020
PLAN REVIEW 08.10.2020
PLAN REVIEW 09.17.2020
PLAN REVIEW 10.16.2020
PLAN REVIEW 11.25.2020
PLAN REVIEW 03.26.2021
PLAN REVIEW 07.15.2021
COORDINATION 08.27.2021
COORDINATION 11.05.2021
COORDINATION 12.10.2021

AEGIS
MIXED-USE DEVELOPMENT
312 E EVERGREEN BOULEVARD, VANCOUVER, WA 98660

SHEET:

A
E3.03



GENERAL POWER NOTES:

- ALL PLANS ARE CONSIDERED DIAGRAMMATICAL. THEREFORE ALL EQUIPMENT SIZES AND DEVICE LOCATIONS ARE APPROXIMATE AND SUBJECT TO FIELD CONDITIONS AND PRODUCT APPROVAL.
- ELECTRICAL CONTRACTOR TO PROVIDE THERMOSTATS NOT SUPPLIED BY MECHANICAL CONTRACTOR. CONSULT MECHANICAL PLANS FOR ADDITIONAL INFORMATION.
- ELECTRICAL CONTRACTOR SHALL PROVIDE INSTALLATION AND FINAL CONNECTION OF THERMOSTATS. CONSULT MECHANICAL CONTRACTOR FOR EXACT REQUIREMENTS PRIOR TO ROUGH IN.
- REFER TO INTERIOR DECORATOR AND/OR ARCHITECTURAL DRAWINGS FOR DIMENSIONED LOCATION(S) AND ELEVATIONS OF FIXTURES & DEVICES. OTHER DEVICES SHOWN ON THE ELECTRICAL PLANS AND NOT INDICATED ON THE DECORATOR'S OR ARCHITECT'S DRAWINGS, SHALL BE INSTALLED AT STANDARD MOUNTING HEIGHT AS INDICATED THE SYMBOL LIST.
- REFER TO ENLARGED TYPICAL UNIT PLANS (E4 SERIES SHEETS) FOR TYPICAL POWER & LIGHTING LAYOUTS FOR THE APARTMENT UNITS.
- ELECTRICAL EQUIPMENT SHOWN IN THE ELECTRICAL ROOMS IS APPROXIMATE, BASED ON TYPICAL PRODUCTS. CONTRACTOR SHALL VERIFY ANY SUBMITTED EQUIPMENT WILL FIT WITHIN THE SPACE PROVIDED, PRIOR TO PRODUCT SUBMITTAL REVIEW.
- ELECTRICAL CONTRACTOR SHALL COORDINATE WITH THE LOW VOLTAGE ("T" SERIES) PLANS, INCLUDING FIRE ALARM AND SYSTEMS INSTALLER, AND PROVIDE ROUGH IN AS NEEDED.
- THERE SHALL BE NO SURFACE MOUNTED FIXTURES OR PATHWAYS (CONDUIT, ETC.) IN ANY PUBLICLY ACCESSIBLE SPACES, INCLUDING STAIRWELLS AND EXIT PASSAGEWAYS WITHOUT PRIOR APPROVAL BY OWNER AND ARCHITECT. ROUTE ALL PATHWAYS WITHIN STUD CAVITIES OR ABOVE FINISHED CEILINGS.
- "SOLAR READY" WORK FOR FUTURE PHOTOVOLTAIC ARRAY SHALL BE PER THE ELECTRICAL REQUIREMENTS AS DEFINED BY THE WASHINGTON STATE ADMINISTRATION CODE, TITLE 51, CHAPTER 51, SECTION 60106.

KEYED NOTES:

- ROUTE (2) EMPTY 3 1/2" CONDUIT WITH PULL STRING, FROM MC-A2 IN CEILING ABOVE AND STUBBED INTO LEASE SPACE FOR TENANT SUPPLIED BRANCH PANEL AND CAP OFF.
- CONTINUOUS OPERATING EXHAUST FAN TO BE TIED INTO LIGHTING CIRCUIT FOR THIS AREA.
- GENERATOR DISCONNECT. SEE ONE-LINE DIAGRAM ON SHEET E1.11.
- PROVIDE ONE 20A, 120V, 1P CIRCUIT FOR GENERATOR REMOTE ANNUNCIATOR. FED FROM PANEL E1, CKT 23.
- PROVIDE ONE 20A, 120V, 1P POWER CONNECTION FOR TENANT BUILDING SIGNS. CIRCUIT AS INDICATED VIA LIGHTING CONTROL PANEL. MOUNT JUNCTION BOX TIGHT TO CEILING (AT BUILDING INTERIOR), COORDINATING EXACT LOCATION WITH SIGN INSTALLER'S SLEEVE AND PER ARCHITECT'S DIRECTION AT EACH LOCATION.
- PROVIDE ONE 20A, 120V, 1P CIRCUIT FROM PANEL H1, CKT 22 FOR BUILDING ENTRY ACCESS CONTROL SYSTEM AND PROVIDE ROUGH IN AND WIRING TO ACCESS POINTS LOCATED ON PLANS. CONSULT WITH LOW VOLTAGE SYSTEMS INSTALLER AND THE "T" SERIES SHEETS FOR ADDITIONAL INFORMATION.
- ENTRY ACCESS POINT.
- APARTMENT CALL DIRECTORY.
- VERIFY ELEVATOR EQUIPMENT LOCATION AND ELECTRICAL REQUIREMENTS WITH ARCHITECT AND/OR ELEVATOR PROVIDER.
- PROVIDE ONE 20A, 120V, 1P CIRCUIT FROM PANEL H1, CKT 10 FOR AUTOMATIC DOOR OPENERS.
- PROVIDE ONE 20A, 120V, 1P DEDICATED CIRCUIT FROM PANEL H1, CKT 29 FOR DAS SYSTEM.
- PACKAGE CONCERGE SYSTEM. MOUNT DUPLEX RECEPTACLES AT 76" AFF. CIRCUIT AS INDICATED.

- PROVIDE ONE 20A, 120V, 1P CIRCUIT FOR A/V SYSTEM CONTROL FROM PANEL H2, CKT 15. CONSULT INTERIORS GROUP FOR EXACT LOCATION. COORDINATE WITH SYSTEM INSTALLER FOR EXACT REQUIREMENTS.
- ELECTRICAL SERVICE METER ROOMS SHALL HAVE OUTWARD SWING DOORS EQUIPPED WITH PANIC HARDWARE. PROVIDE A KEY BOX AT THE EXTERIOR FOR CLARK PUBLIC UTILITIES 24/7 ACCESS.
- PROVIDE ONE 20A, 120V, 1P CIRCUIT FOR DRINKING FOUNTAIN FROM PANEL M1, CKT 24. CONSULT MECHANICAL AND/OR PLUMBING CONTRACTOR FOR EXACT ELECTRICAL REQUIREMENTS PRIOR TO ROUGH IN.
- LOW VOLTAGE/COMMUNICATIONS SYSTEM DEMARCATION BOARD(S). COORDINATE LOCATIONS AND ELECTRICAL POWER REQUIREMENTS WITH THE TELECOM PLANS ("T" SERIES SHEETS) AND LOW VOLTAGE SYSTEMS INSTALLERS, AND PROVIDE ROUGH IN AND/OR FINAL ELECTRICAL POWER CONNECTIONS & DEVICES. REFER PANEL 'H1' SCHEDULE ON E1.13 FOR CIRCUITS.
- CEILING MOUNTED 20A DUPLEX RECEPTACLE FOR SECURITY CAMERA. CONSULT ARCHITECT FOR ADDITIONAL INFORMATION. CIRCUIT AS INDICATED.
- SHAFT FOR THE ROUTING OF ELECTRICAL FEEDERS FROM TENANT METERS TO RESIDENTIAL UNITS.
- PROVIDE RECEPTACLE WITH TYPES A & C USB PORTS, LEVITON T5633-T OR APPROVED EQUAL.
- PROVIDE ONE 20A, 120V, 1P CIRCUIT FROM PANEL E1, CKT 18 FOR ELEVATOR SMOKE CURTAINS. SMOKE CURTAINS ARE TO BE SMOKE GUARD SYSTEM MODEL 200 AND SHALL BE INSTALLED AT EACH ELEVATOR LOBBY. ELECTRICAL CONTRACTOR SHALL BE RESPONSIBLE TO COORDINATE INSTALLATION WITH THE EQUIPMENT PROVIDER/INSTALLER FOR ALL ELECTRICAL REQUIREMENTS PRIOR TO ROUGH IN. EACH SMOKE CURTAIN SHALL BE INTERLINKED WITH THE NEAREST SMOKE DETECTOR AT EACH LOCATION.

- CONSULT ARCHITECT AND/OR MECHANICAL PLANS FOR ADDITIONAL INFORMATION REGARDING THE FIREPLACE. PROVIDE ELECTRICAL CONNECTION(S) AS NEEDED FROM PANEL H2, CKT 19.
- PROVIDE ONE 20A, 120V, 1P CIRCUIT FROM PANEL H1, CKT 15 FOR THE APARTMENT ENTRY SYSTEM PRIMARY CONTROL PANEL AND PROVIDE ROUGH IN AND WIRING, AS NEEDED, TO EACH UNIT ENTRY. CONSULT WITH LOW VOLTAGE SYSTEMS INSTALLER AND THE "T" SERIES SHEETS FOR ADDITIONAL INFORMATION.
- PROVIDE ONE 20A, 120V, 1P CIRCUIT FROM PANEL H1, CKT 27 FOR THE SECURITY SYSTEM PANEL AND PROVIDE ROUGH IN AND WIRING, AS NEEDED. CONSULT WITH LOW VOLTAGE SYSTEMS INSTALLER AND THE "T" SERIES SHEETS FOR ADDITIONAL INFORMATION.
- PROVIDE ONE 20A, 120V, 1P CIRCUIT FROM PANEL E1, CKT 19 FOR THE FIRE ALARM CONTROL PANEL. CONSULT WITH LOW VOLTAGE SYSTEMS INSTALLER AND THE "T" SERIES SHEETS FOR ADDITIONAL INFORMATION.
- METER LOCATION FOR PV SYSTEM. VERIFY AND COORDINATE WITH SYSTEM INSTALLER.
- AREA OF REFUGE PANEL. CONSULT FIRE ALARM PLANS ("T" SERIES SHEETS) AND PROVIDE ROUGH IN AS NEEDED. PROVIDE POWER CONNECTION FROM PANEL E1.
- PROVIDE ROUGH IN, AS NEEDED, FOR FIRE ALARM REMOTE ANNUNCIATION PANEL.
- PROVIDE ROUGH IN, AS NEEDED, FOR AUDIO SYSTEM CONTROLS. COORDINATE EXACT LOCATION WITH THE SYSTEM INSTALLER.
- PROVIDE ROUGH IN, AS NEEDED, FOR WIFI SYSTEM.
- CONSULT INTERIORS PLANS TO VERIFY EXACT LOCATION OF FLOOR BOX DEVICES PRIOR TO ROUGH IN.

- PROVIDE ONE 20A, 120V CIRCUIT, FROM PANEL 'M1' FOR IRRIGATION CONTROLS. COORDINATE WITH LANDSCAPING FOR EXACT POWER REQUIREMENTS AND LOCATION PRIOR TO ROUGH IN.
- PROVIDE ONE 20A, 120V CIRCUIT, FROM PANEL 'H1' FOR LANDSCAPE LIGHTING EQUIPMENT CONNECTION. REFER TO E1.02 FOR MORE INFORMATION. COORDINATE WITH LANDSCAPING FOR EXACT POWER REQUIREMENTS AND LOCATION PRIOR TO ROUGH IN.
- PROVIDE TWO 1-1/2" EMPTY CONDUITS W/ PULL STRING, ROUTED FROM THE ELECTRICAL ROOM TO THE ROOF FOR PV SOLAR SYSTEM PROVIDED AND INSTALLED BY OTHERS. COORDINATE WITH THE STRUCTURAL ENGINEER FOR THE ROUTING OF THE CONDUITS UP THROUGH THE BUILDING PRIOR TO ANY WORK.
- PROVIDE ONE 20A, 120V, 1P CIRCUIT FROM PANEL M1, CKT 40 TO J-BOX BEHIND FACE OF CANOPY FOR BUILDING SIGNAGE BY OTHERS. REFER TO ARCHITECTURAL PLANS FOR EXACT LOCATION. SIGNS TO BE CONTROLLED VIA PHOTOCELL ALONG WITH BUILDING LIGHTS.
- PROVIDE ONE 20A, 120V, 1P CIRCUIT FROM PANEL H1, CKT 14 FOR OVERHEAD DOOR OPENER.




PROJECT # 2017-053
DATE: 11/06/2019
REVISIONS
 PLAN REVIEW 01.24.2020
 PLAN REVIEW 03.13.2020
 PLAN REVIEW 04.24.2020
 PLAN REVIEW 08.10.2020
 PLAN REVIEW 09.17.2020
 PLAN REVIEW 10.16.2020
 PLAN REVIEW 11.25.2020
 PLAN REVIEW 03.26.2021
 PLAN REVIEW 07.15.2021
 COORDINATION 08.27.2021
 COORDINATION 11.05.2021
 COORDINATION 12.10.2021

AEGIS
MIXED-USE DEVELOPMENT
 312 E EVERGREEN BOULEVARD, VANCOUVER, WA 98660

MEFA Consulting Engineers
 2007 S.E. Ash St.
 Portland, OR 97214
 PHN: (503) 234-0548
 FAX: (503) 234-0677
 INC. WWW.MEFA-ENG.COM
 CONTACT: DENISE TAYLOR

SHEET:

A
E3.04

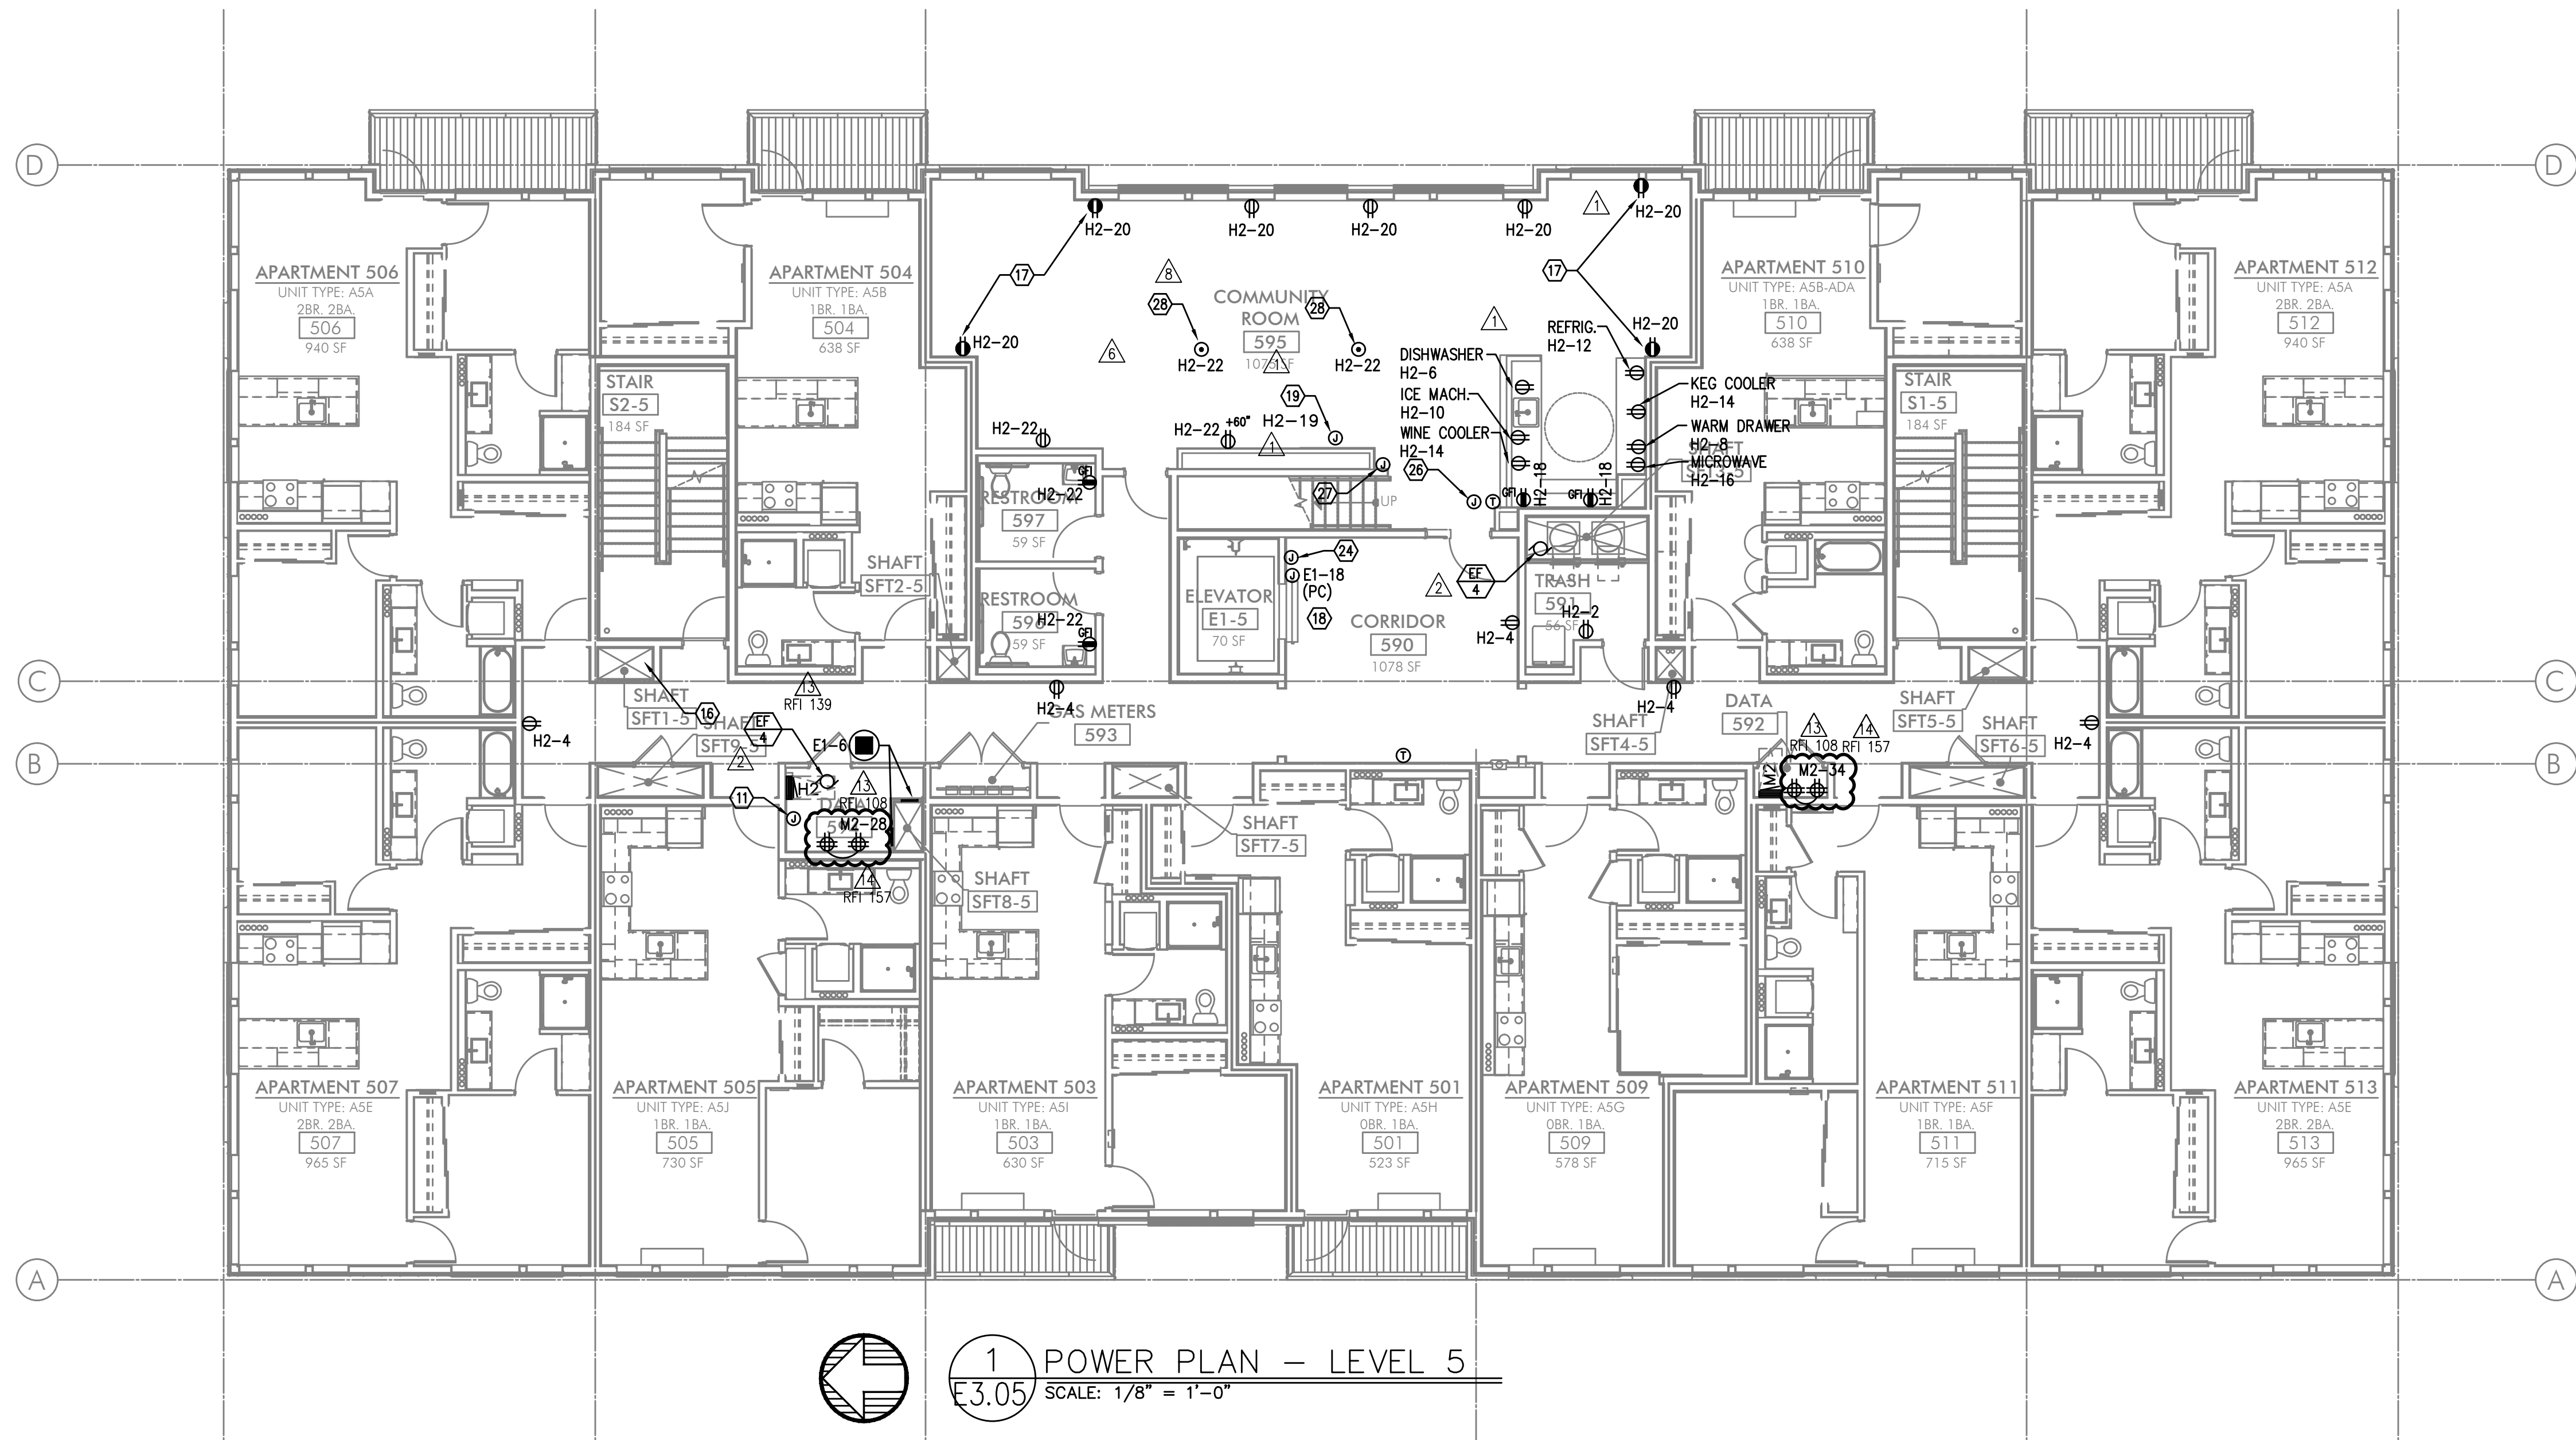

GENERAL POWER NOTES:

- ALL PLANS ARE CONSIDERED DIAGMATICAL. THEREFORE ALL EQUIPMENT SIZES AND DEVICE LOCATIONS ARE APPROXIMATE AND SUBJECT TO FIELD CONDITIONS AND PRODUCT APPROVAL.
- ELECTRICAL CONTRACTOR TO PROVIDE THERMOSTATS NOT SUPPLIED BY MECHANICAL CONTRACTOR. CONSULT MECHANICAL PLANS FOR ADDITIONAL INFORMATION.
- ELECTRICAL CONTRACTOR SHALL PROVIDE INSTALLATION AND FINAL CONNECTION OF THERMOSTATS. CONSULT MECHANICAL CONTRACTOR FOR EXACT REQUIREMENTS PRIOR TO ROUGH IN.
- REFER TO INTERIOR DECORATOR AND/OR ARCHITECTURAL DRAWINGS FOR DIMENSIONED LOCATION(S) AND ELEVATIONS OF FIXTURES & DEVICES. OTHER DEVICES SHOWN ON THE ELECTRICAL PLANS AND NOT INDICATED ON THE DECORATOR'S OR ARCHITECT'S DRAWINGS, SHALL BE INSTALLED AT STANDARD MOUNTING HEIGHT AS INDICATED THE SYMBOL LIST.
- REFER TO ENLARGED TYPICAL UNIT PLANS (E4 SERIES SHEETS) FOR TYPICAL POWER & LIGHTING LAYOUTS FOR THE APARTMENT UNITS.
- ELECTRICAL EQUIPMENT SHOWN IN THE ELECTRICAL ROOMS IS APPROXIMATE, BASED ON TYPICAL PRODUCTS. CONTRACTOR SHALL VERIFY ANY SUBMITTED EQUIPMENT WILL FIT WITHIN THE SPACE PROVIDED, PRIOR TO PRODUCT SUBMITTAL REVIEW.
- ELECTRICAL CONTRACTOR SHALL COORDINATE WITH THE LOW VOLTAGE ('T' SERIES) PLANS, INCLUDING FIRE ALARM AND SYSTEMS INSTALLER, AND PROVIDE ROUGH IN AS NEEDED.
- THERE SHALL BE NO SURFACE MOUNTED FIXTURES OR PATHWAYS (CONDUIT, ETC.) IN ANY PUBLICLY ACCESSIBLE SPACES, INCLUDING STAIRWELLS AND EXIT PASSAGEWAYS WITHOUT PRIOR APPROVAL BY OWNER AND ARCHITECT. ROUTE ALL PATHWAYS WITHIN STUD CAVITIES OR ABOVE FINISHED CEILINGS.
- "SOLAR READY" WORK FOR FUTURE PHOTOVOLTAIC ARRAY SHALL BE PER THE ELECTRICAL REQUIREMENTS AS DEFINED BY THE WASHINGTON STATE ADMINISTRATION CODE, TITLE 51, CHAPTER 51, SECTION 60106.

KEYED NOTES:


- ROUTE (2) EMPTY 3 1/2" CONDUIT WITH PULL STRING, FROM MC-A2 IN CEILING ABOVE AND STUBBED INTO LEASE SPACE FOR TENANT SUPPLIED BRANCH PANEL AND CAP OFF.
- CONTINUOUS OPERATING EXHAUST FAN TO BE TIED INTO LIGHTING CIRCUIT FOR THIS AREA.
- GENERATOR DISCONNECT. SEE ONE-LINE DIAGRAM ON SHEET E1.11.
- PROVIDE ONE 20A, 120V, 1P CIRCUIT FOR GENERATOR REMOTE ANNUNCIATOR. FED FROM PANEL E1, CKT 23.
- PROVIDE ONE 20A, 120V, 1P POWER CONNECTION FOR TENANT BUILDING SIGNS. CIRCUIT AS INDICATED VIA LIGHTING CONTROL PANEL. MOUNT JUNCTION BOX TIGHT TO CEILING (AT BUILDING INTERIOR), COORDINATING EXACT LOCATION WITH SIGN INSTALLER'S SLEEVE AND PER ARCHITECT'S DIRECTION AT EACH LOCATION.
- PROVIDE ONE 20A, 120V, 1P CIRCUIT FROM PANEL H1, CKT 22 FOR BUILDING ENTRY ACCESS CONTROL SYSTEM AND PROVIDE ROUGH IN AND WIRING TO ACCESS POINTS LOCATED ON PLANS. CONSULT WITH LOW VOLTAGE SYSTEMS INSTALLER AND THE 'T' SERIES SHEETS FOR ADDITIONAL INFORMATION.
- ENTRY ACCESS POINT.
- APARTMENT CALL DIRECTORY.
- VERIFY ELEVATOR EQUIPMENT LOCATION AND ELECTRICAL REQUIREMENTS WITH ARCHITECT AND/OR ELEVATOR PROVIDER.
- PROVIDE ONE 20A, 120V, 1P CIRCUIT FROM PANEL H1, CKT 10 FOR AUTOMATIC DOOR OPENERS.
- PROVIDE ONE 20A, 120V, 1P DEDICATED CIRCUIT FROM PANEL H1, CKT 29 FOR DAS SYSTEM.
- PACKAGE CONCIERGE SYSTEM. MOUNT DUPLEX RECEPTACLES AT 76" AFF. CIRCUIT AS INDICATED.

- PROVIDE ONE 20A, 120V, 1P CIRCUIT FOR A/V SYSTEM CONTROL, FROM PANEL H2, CKT 15. CONSULT INTERIORS GROUP FOR EXACT LOCATION. COORDINATE WITH SYSTEM INSTALLER FOR EXACT REQUIREMENTS.
- ELECTRICAL SERVICE METER ROOMS SHALL HAVE OUTWARD SWING DOORS EQUIPPED WITH PANIC HARDWARE. PROVIDE A KEY BOX AT THE EXTERIOR FOR CLARK PUBLIC UTILITIES 24/7 ACCESS.
- PROVIDE ONE 20A, 120V, 1P CIRCUIT FOR DRINKING FOUNTAIN FROM PANEL M1, CKT 24. CONSULT MECHANICAL AND/OR PLUMBING CONTRACTOR FOR EXACT ELECTRICAL REQUIREMENTS PRIOR TO ROUGH IN.
- LOW VOLTAGE/COMMUNICATIONS SYSTEM DEMARCATION BOARD(S). COORDINATE LOCATIONS AND ELECTRICAL POWER REQUIREMENTS WITH THE TELECOM PLANS ('T' SERIES SHEETS) AND LOW VOLTAGE SYSTEMS INSTALLERS, AND PROVIDE ROUGH IN AND/OR FINAL ELECTRICAL POWER CONNECTIONS & DEVICES. REFER PANEL 'H1' SCHEDULE ON E1.13 FOR CIRCUITS.
- CEILING MOUNTED 20A DUPLEX RECEPTACLE FOR SECURITY CAMERA. CONSULT ARCHITECT FOR ADDITIONAL INFORMATION. CIRCUIT AS INDICATED.
- SHAFT FOR THE ROUTING OF ELECTRICAL FEEDERS FROM TENANT METERS TO RESIDENTIAL UNITS.
- PROVIDE RECEPTACLE WITH TYPES A & C USB PORTS, LEVITON T5633-T OR APPROVED EQUAL.
- PROVIDE ONE 20A, 120V, 1P CIRCUIT FROM PANEL E1, CKT 18 FOR ELEVATOR SMOKE CURTAINS. SMOKE CURTAINS ARE TO BE SMOKE GUARD SYSTEM MODEL 200 AND SHALL BE INSTALLED AT EACH ELEVATOR LOBBY. ELECTRICAL CONTRACTOR SHALL BE RESPONSIBLE TO COORDINATE INSTALLATION WITH THE EQUIPMENT PROVIDER/INSTALLER FOR ALL ELECTRICAL REQUIREMENTS PRIOR TO ROUGH IN. EACH SMOKE CURTAIN SHALL BE INTERLINKED WITH THE NEAREST SMOKE DETECTOR AT EACH LOCATION.

- CONSULT ARCHITECT AND/OR MECHANICAL PLANS FOR ADDITIONAL INFORMATION REGARDING THE FIREPLACE. PROVIDE ELECTRICAL CONNECTION(S) AS NEEDED FROM PANEL H2, CKT 19.
- PROVIDE ONE 20A, 120V, 1P CIRCUIT FROM PANEL H1, CKT 15 FOR THE APARTMENT ENTRY SYSTEM PRIMARY CONTROL PANEL AND PROVIDE ROUGH IN AND WIRING, AS NEEDED, TO EACH UNIT ENTRY. CONSULT WITH LOW VOLTAGE SYSTEMS INSTALLER AND THE 'T' SERIES SHEETS FOR ADDITIONAL INFORMATION.
- PROVIDE ONE 20A, 120V, 1P CIRCUIT FROM PANEL H1, CKT 27 FOR THE SECURITY SYSTEM PANEL AND PROVIDE ROUGH IN AND WIRING, AS NEEDED. CONSULT WITH LOW VOLTAGE SYSTEMS INSTALLER AND THE 'T' SERIES SHEETS FOR ADDITIONAL INFORMATION.
- PROVIDE ONE 20A, 120V, 1P CIRCUIT FROM PANEL E1, CKT 19 FOR THE FIRE ALARM CONTROL PANEL. CONSULT WITH LOW VOLTAGE SYSTEMS INSTALLER AND THE 'T' SERIES SHEETS FOR ADDITIONAL INFORMATION.
- METER LOCATION FOR PV SYSTEM. VERIFY AND COORDINATE WITH SYSTEM INSTALLER.
- AREA OF REFUGE PANEL. CONSULT FIRE ALARM PLANS ('T' SERIES SHEETS) AND PROVIDE ROUGH IN AS NEEDED. PROVIDE POWER CONNECTION FROM PANEL E1.
- PROVIDE ROUGH IN, AS NEEDED, FOR FIRE ALARM REMOTE ANNUNCIATION PANEL.
- PROVIDE ROUGH IN, AS NEEDED, FOR AUDIO SYSTEM CONTROLS. COORDINATE EXACT LOCATION WITH THE SYSTEM INSTALLER.
- PROVIDE ROUGH IN, AS NEEDED, FOR WIFI SYSTEM.
- CONSULT INTERIORS PLANS TO VERIFY EXACT LOCATION OF FLOOR BOX DEVICES PRIOR TO ROUGH IN.

- PROVIDE ONE 20A, 120V CIRCUIT, FROM PANEL 'M1' FOR IRRIGATION CONTROLS. COORDINATE WITH LANDSCAPING FOR EXACT POWER REQUIREMENTS AND LOCATION PRIOR TO ROUGH IN.
- PROVIDE ONE 20A, 120V CIRCUIT, FROM PANEL 'H1' FOR LANDSCAPE LIGHTING EQUIPMENT CONNECTION. REFER TO E1.02 FOR MORE INFORMATION. COORDINATE WITH LANDSCAPING FOR EXACT POWER REQUIREMENTS AND LOCATION PRIOR TO ROUGH IN.
- PROVIDE TWO 1-1/2" EMPTY CONDUITS W/ PULL STRING, ROUTED FROM THE ELECTRICAL ROOM TO THE ROOF FOR PV SOLAR SYSTEM PROVIDED AND INSTALLED BY OTHERS. COORDINATE WITH THE STRUCTURAL ENGINEER FOR THE ROUTING OF THE CONDUITS UP THROUGH THE BUILDING PRIOR TO ANY WORK.
- PROVIDE ONE 20A, 120V, 1P CIRCUIT FROM PANEL M1, CKT 40 TO J-BOX BEHIND FACE OF CANOPY FOR BUILDING SIGNAGE BY OTHERS. REFER TO ARCHITECTURAL PLANS FOR EXACT LOCATION. SIGNS TO BE CONTROLLED VIA PHOTOCELL, ALONG WITH BUILDING LIGHTS.
- PROVIDE ONE 20A, 120V, 1P CIRCUIT FROM PANEL H1, CKT 14 FOR OVERHEAD DOOR OPENER.

MFA
Consulting Engineers
2007 S.E. Ash St.
Portland, OR 97214
PHN: (503) 234-0548
FAX: (503) 234-0677
CONTACT: DENISE TAYLOR

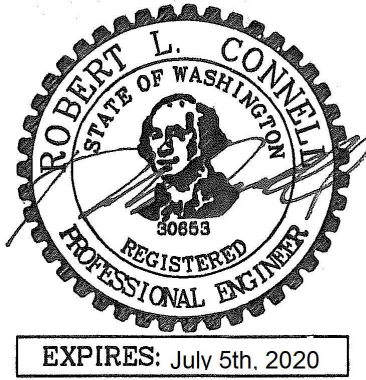

PROJECT # 2017-053
DATE: 11/06/2019
REVISIONS

- PLAN REVIEW 01.24.2020
- PLAN REVIEW 03.13.2020
- PLAN REVIEW 04.24.2020
- PLAN REVIEW 08.10.2020
- PLAN REVIEW 09.17.2020
- PLAN REVIEW 10.16.2020
- PLAN REVIEW 11.25.2020
- PLAN REVIEW 03.26.2021
- PLAN REVIEW 07.15.2021
- COORDINATION 08.27.2021
- COORDINATION 11.05.2021
- COORDINATION 12.10.2021

AEGIS
MIXED-USE DEVELOPMENT
312 E EVERGREEN BOULEVARD, VANCOUVER, WA 98660

SHEET:


A
E3.05

GENERAL LIGHTING NOTES:

- ELECTRICAL DRAWINGS ARE DIAGRAMMATICAL AND MAY NOT ACCURATELY REFLECT ACTUAL CONSTRUCTION CONDITIONS. THE ELECTRICAL CONTRACTOR SHALL BE RESPONSIBLE FOR COORDINATING THE INSTALLATION OF ALL ELECTRICAL EQUIPMENT, WITH ALL TRADES PRIOR TO AND DURING CONSTRUCTION.
- ELECTRICAL CONTRACTOR TO PROVIDE THERMOSTATS NOT SUPPLIED BY MECHANICAL CONTRACTOR. CONSULT MECHANICAL PLANS FOR ADDITIONAL INFORMATION.
- ELECTRICAL CONTRACTOR SHALL PROVIDE INSTALLATION AND FINAL CONNECTION OF THERMOSTATS. CONSULT MECHANICAL CONTRACTOR FOR EXACT REQUIREMENTS PRIOR TO ROUGH IN.
- THE ELECTRICAL CONTRACTOR SHALL REFER TO THE ARCHITECTURAL & INTERIOR DESIGN DRAWINGS FOR ALL MOUNTING HEIGHTS AND FINISHES OF DEVICES AND FIXTURES.
- REFER TO ENLARGED TYPICAL UNIT PLANS (E4 SERIES SHEETS) FOR TYPICAL POWER & LIGHTING LAYOUTS FOR THE RESIDENTIAL UNITS.
- REFER TO SHEET E1.21 FOR LIGHT FIXTURE SCHEDULE.
- THE CONTRACTOR SHALL CONSULT THE ARCHITECT AND INTERIOR DESIGNER FOR ALL FIXTURE LOCATIONS PRIOR TO THE START OF ANY ROUGH IN WORK.
- REFER TO AVAILABLE ARCHITECTURAL AND/OR INTERIOR DESIGN DOCUMENTS & DRAWINGS FOR ADDITIONAL INFORMATION.
- OCCUPANCY SENSORS SHALL BE FIELD ADJUSTED TO ENSURE COVERAGE AND PROPER CONTROL.
- PROVIDE DIGITAL LIGHTING CONTROLS FOR EACH ROOM/SPACE, CONSISTING OF MULTI-BUTTON SWITCH(ES), OCC SENSORS, POWER PACKS, DAYLIGHT SENSORS, DIMMERS, INTERCONNECTING WIRING, ETC.
- THERE SHALL BE NO SURFACE MOUNTED FIXTURES OR PATHWAYS (CONDUIT, ETC) IN ANY PUBLICLY ACCESSIBLE SPACES, INCLUDING STAIRWELLS AND EXIT PASSAGEWAYS WITHOUT PRIOR APPROVAL BY OWNER AND ARCHITECT. ROUTE ALL PATHWAYS WITHIN STUD CAVITIES OR ABOVE FINISHED CEILINGS.
- ALL EGRESS FIXTURES SHALL BE WIRED SUCH THAT IN THE EVENT OF A POWER FAILURE, ALL LIGHTS WILL AUTOMATICALLY RETURN TO FULL POWER. REFER TO SWITCHING DETAILS ON SHEET E1.22.

KEYED NOTES:

- CONTINUE CIRCUIT UP THROUGH THE STAIRWELL.
- EXTERIOR BUILDING LIGHTS TO BE CONTROLLED VIA INTEGRAL AND/OR REMOTE PHOTOCELL FOR DUSK-TILL-DAWN OPERATION. REFER TO LIGHT FIXTURE SCHEDULE ON SHEET E1.21-E1.22 FOR ADDITIONAL INFORMATION.
- LEASE SPACE LIGHTING TO HAVE DUAL SWITCHES. ONE TO CONTROL NORMAL POWER LIGHTS AND ONE TO ACT AS A MANUAL OVERRIDE FOR NIGHT LIGHT FIXTURES (NL). INTENT IS THAT THE NIGHT LIGHTS ARE TO BE "ON" 24/7 AND ONLY ILLUMINATED AT NIGHT VIA PHOTOCELL FOR DUSK-TILL-DAWN OPERATION. NIGHT LIGHT FIXTURES SHALL ALSO BE EQUIPPED WITH EMERGENCY BATTERY BACKUP IN THE EVENT OF A POWER FAILURE. ALL LIGHT FIXTURES IN THE LEASE SPACE ARE TO BE ON A SINGLE CIRCUIT AND TEMPORARILY FED FROM THE HOUSE PANEL.
- LIGHTING CONTROL FOR LOBBY, CORRIDOR & COMMON SPACES. REFER TO DETAIL #1, SHEET E1.23 FOR MORE INFORMATION.
- LIGHTING CONTROLS FOR THIS AREA LOCATED IN THE MAINTENANCE ROOM. SEE SHEET NOTE #4 FOR MORE INFORMATION.
- TIE INTO TEMPORARY LIGHTING CIRCUIT AND ENSURE BATTERY BACK UP POWER FOR EGRESS.
- BIKE ROOM LIGHT FIXTURES CONTROLLED BY CEILING MOUNTED OCCUPANCY SENSOR.
- FIXTURE FINISH TO MATCH SOFFIT METAL.
- PROVIDE POWER CONNECTION FOR COVE LIGHTING AT ALL WALL NICHES TO WALL WASH ART INSTALLATIONS. REFER TO INTERIOR DECORATOR'S INTERIOR ELEVATIONS FOR ADDITIONAL INFORMATION REGARDING LENGTH, LOCATIONS AND CONTROL TYPE TO BE INSTALLED. USE FIXTURE TYPE 'C1' AND TIE INTO LOBBY LIGHTING CIRCUIT H1-5.
- PROVIDE CEILING MOUNTED PHOTOCELL TO PROVIDE DIMMING OF LIGHT FIXTURES DURING DAYLIGHT PERIODS.
- PROVIDE J-BOXES; ONE MOUNTED AT 50.5" AFG AND ONE AT 69.5" AFG FOR LIGHT FIXTURES TO BE INSTALLED FOR ART INSTALLATIONS. CIRCUIT AS SHOWN. INSTALL TWO TYPE S9 LIGHT FIXTURES AT EACH LOCATION INDICATED. REFER TO THE LIGHTING SCHEDULE ON E1.22 FOR MORE INFORMATION. COORDINATE WORK WITH ALL TRADES, ARCHITECT AND DESIGNER.
- TYPICAL LIGHTING CONTROL FOR RESIDENTIAL CORRIDORS. REFER TO DETAIL #2, SHEET E1.23 FOR MORE INFORMATION.
- FITNESS ROOM LIGHT FIXTURES SHALL BE CONTROLLED VIA OCCUPANCY SENSOR, SUCH THAT LIGHTS SHALL DIM DOWN BY 50% DURING PERIODS OF NO ACTIVITY AND RETURN TO 100% LIGHT OUTPUT ON OCCUPANCY DETECTION. FIXTURES SHALL REMAIN ON FOR A MINIMUM OF 30 MINUTES OF AREA VACANCY.
- CIRCUIT SERVICE CORRIDOR LIGHT FIXTURES AHEAD OF SWITCHED FIXTURES ON SAME CIRCUIT. CORRIDOR LIGHT FIXTURES TO BE CONSTANT 'ON'.
- PROVIDE LIGHT FIXTURE(S) AT TOP OF WALL FOR ART INSTALLATION. COORDINATE WITH THE ARTIST AND OWNER FOR EXACT LOCATION AND FIELD AIM.

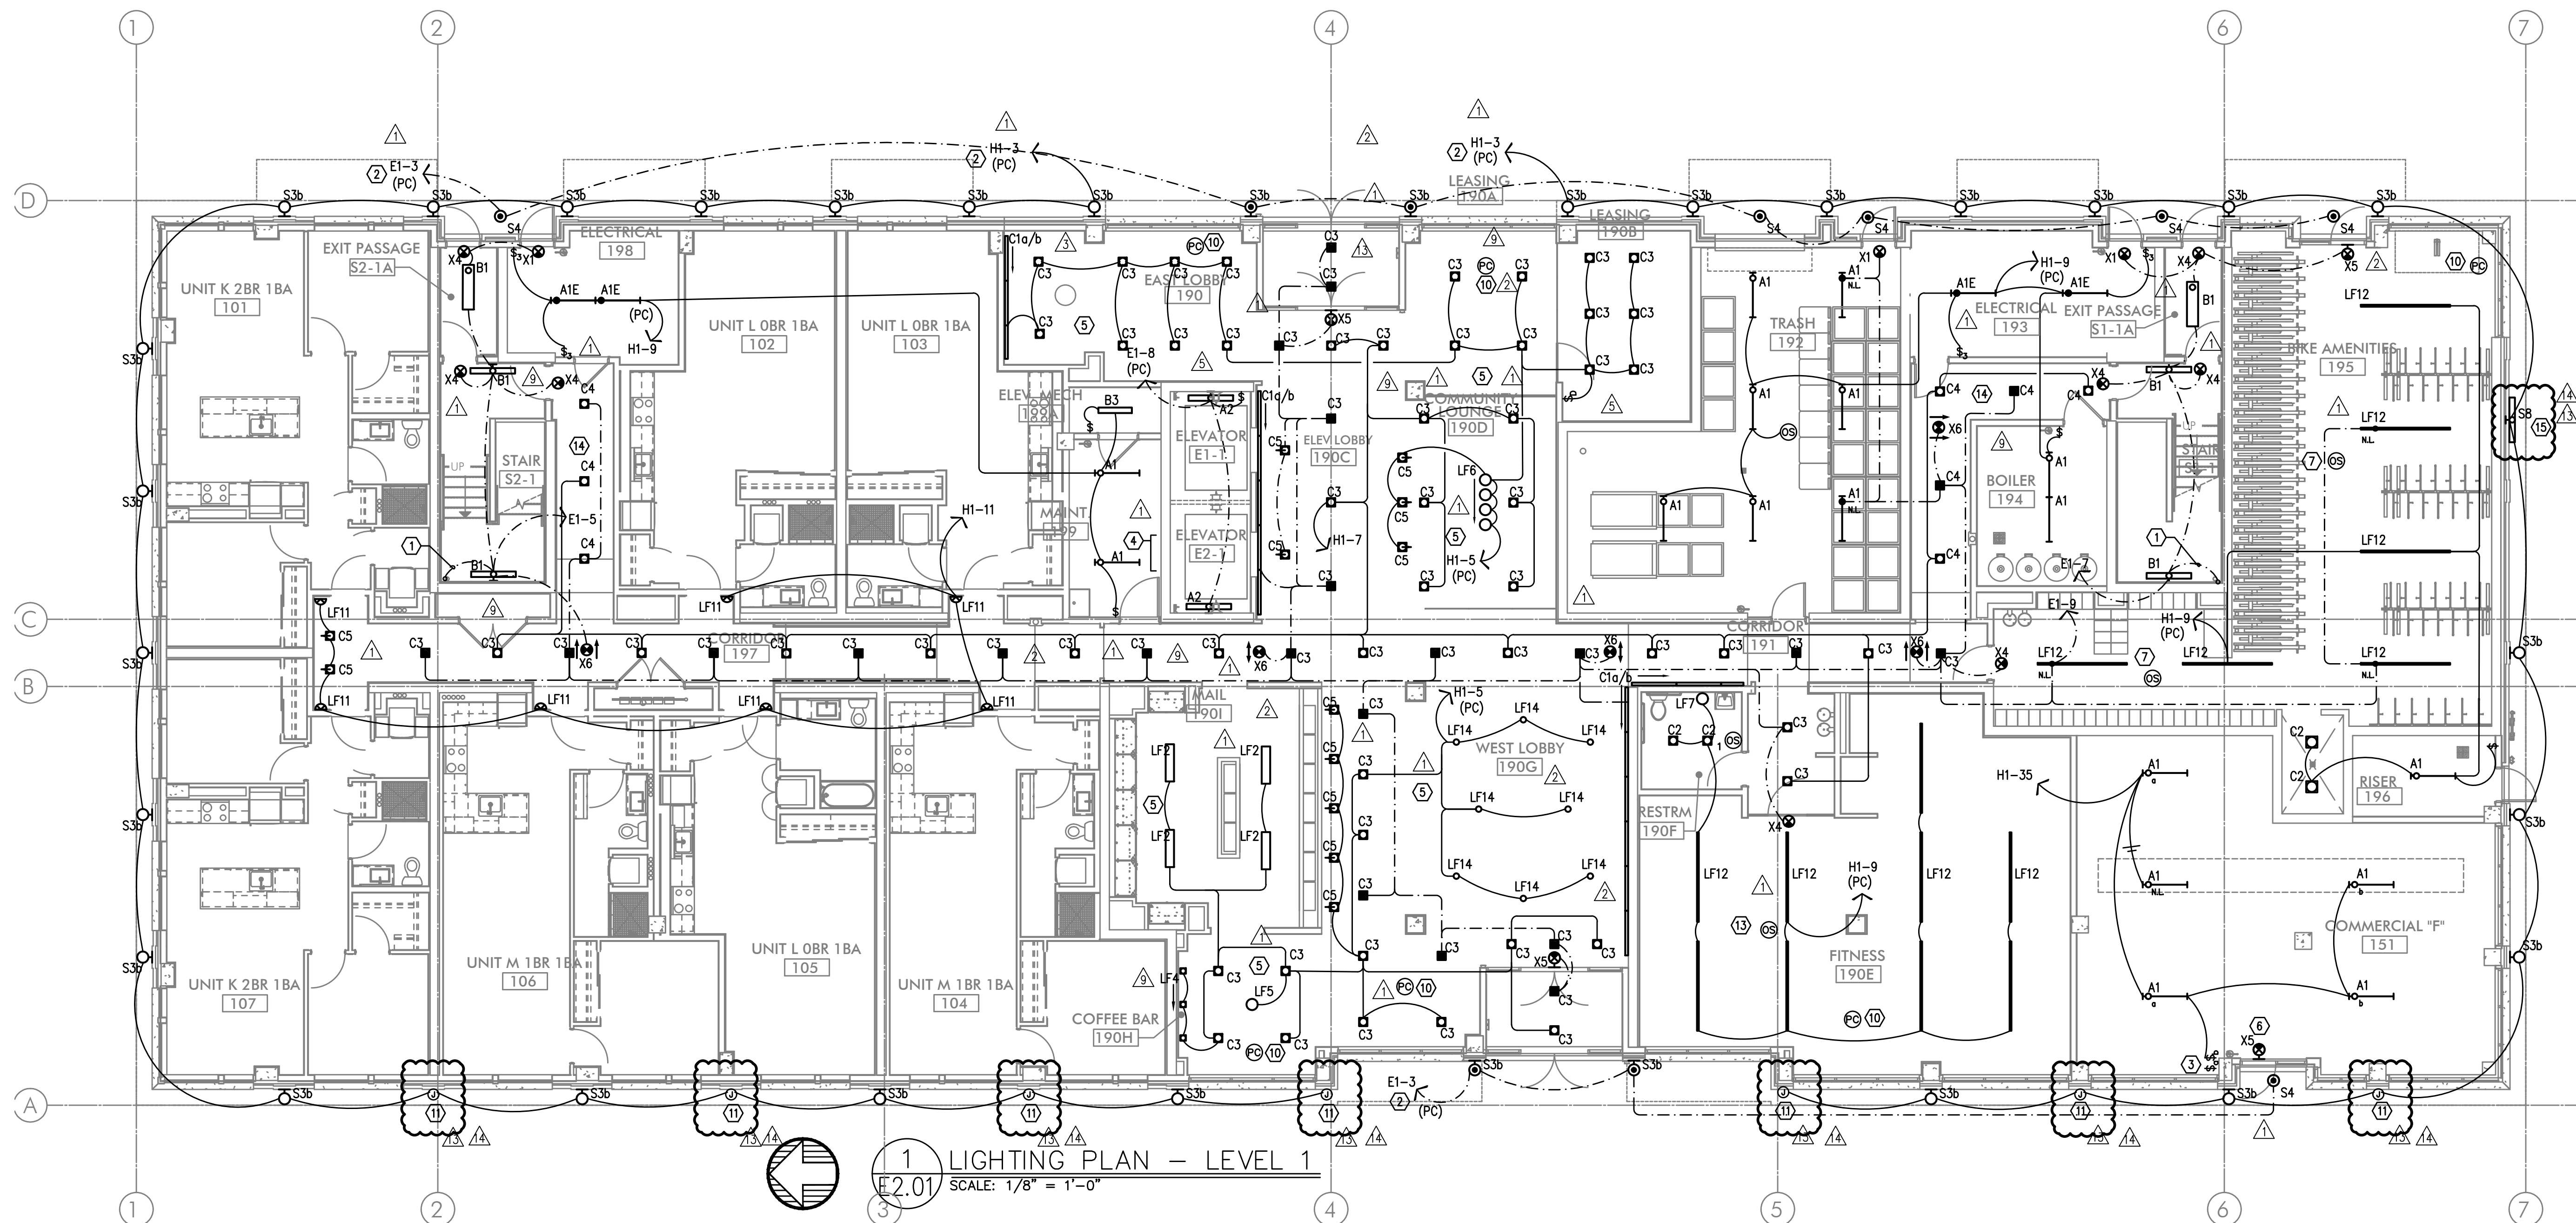

1 LIGHTING PLAN - LEVEL 1

E2.01 SCALE: 1/8" = 1'-0"

STUDIO

3

ARCHITECTURE
INCORPORATED

275 COURT ST. NE
SALEM, OR 97301-3442
P: 503.390.6500
www.studio3architecture.com



EXPIRES: July 6th, 2020

IN THE EVENT CONFLICTS ARE DISCOVERED
BETWEEN THE ORIGINAL SIGNED AND SEALED
DOCUMENTS PREPARED BY THE ARCHITECTS
AND/OR THEIR CONSULTANTS, AND ANY COPY OF
THE DOCUMENTS TRANSMITTED BY MAIL, FAX,
ELECTRONICALLY OR OTHERWISE, THE ORIGINAL
SIGNED AND SEALED DOCUMENTS SHALL GOVERN.

PROJECT # 2017-053

DATE: 11/06/2019

REVISIONS

PLAN REVIEW 01.24.2020

PLAN REVIEW 03.13.2020

PLAN REVIEW 04.24.2020

PLAN REVIEW 08.10.2020

PLAN REVIEW 09.17.2020

PLAN REVIEW 10.16.2020

PLAN REVIEW 11.25.2020

PLAN REVIEW 03.26.2021

PLAN REVIEW 07.15.2021

COORDINATION 08.27.2021

COORDINATION 11.05.2021

COORDINATION 12.10.2021

COORDINATION 12.10.2021

M
E
A
INC.
Consulting Engineers
2007 S.E. Ash St.
Portland, OR 97214
PHN: (503) 234-0548
FAX: (503) 234-0677
WWW.MEIA-ENG.COM
CONTACT: DENISE TAYLOR

SHEET:

B


E2.01

GENERAL POWER NOTES:

- ALL PLANS ARE CONSIDERED DIAGRAMMATICAL. THEREFORE ALL EQUIPMENT SIZES AND DEVICE LOCATIONS ARE APPROXIMATE AND SUBJECT TO FIELD CONDITIONS AND PRODUCT APPROVAL.
- ELECTRICAL CONTRACTOR TO PROVIDE THERMOSTATS NOT SUPPLIED BY MECHANICAL CONTRACTOR. CONSULT MECHANICAL PLANS FOR ADDITIONAL INFORMATION.
- ELECTRICAL CONTRACTOR SHALL PROVIDE INSTALLATION AND FINAL CONNECTION OF THERMOSTATS. CONSULT MECHANICAL CONTRACTOR FOR EXACT REQUIREMENTS PRIOR TO ROUGH IN.
- REFER TO INTERIOR DECORATOR AND/OR ARCHITECTURAL DRAWINGS FOR DIMENSIONED LOCATION(S) AND ELEVATIONS OF FIXTURES & DEVICES. OTHER DEVICES SHOWN ON THE ELECTRICAL PLANS AND NOT INDICATED ON THE DECORATOR'S OR ARCHITECT'S DRAWINGS, SHALL BE INSTALLED AT STANDARD MOUNTING HEIGHT AS INDICATED THE SYMBOL LIST.
- REFER TO ENLARGED TYPICAL UNIT PLANS (E4 SERIES SHEETS) FOR TYPICAL POWER & LIGHTING LAYOUTS FOR THE APARTMENT UNITS.
- ELECTRICAL EQUIPMENT SHOWN IN THE ELECTRICAL ROOMS IS APPROXIMATE, BASED ON TYPICAL PRODUCTS. CONTRACTOR SHALL VERIFY ANY SUBMITTED EQUIPMENT WILL FIT WITHIN THE SPACE PROVIDED, PRIOR TO PRODUCT SUBMITTAL REVIEW.
- CONSULT ARCHITECTURAL AND/OR INTERIOR DECORATOR PLANS FOR EXACT RECEPTACLE LOCATION IN THE COMMUNITY AREAS, SUCH AS THE LOBBY, CLUB ROOM, LEASE OFFICE, ETC.
- THERE SHALL BE NO SURFACE MOUNTED FIXTURES OR PATHWAYS (CONDUIT, ETC.) IN ANY PUBLICLY ACCESSIBLE SPACES, INCLUDING STAIRWELLS AND EXIT PASSAGEWAYS WITHOUT PRIOR APPROVAL BY OWNER AND ARCHITECT. ROUTE ALL PATHWAYS WITHIN STUD CAVITIES OR ABOVE FINISHED CEILINGS.
- "SOLAR READY" WORK FOR FUTURE PHOTOVOLTAIC ARRAY SHALL BE PER THE ELECTRICAL REQUIREMENTS AS DEFINED BY THE WASHINGTON STATE ADMINISTRATION CODE, TITLE 51, CHAPTER 51, SECTION 60106.

KEYED NOTES:

- ROUTE (2) EMPTY 3 1/2" CONDUIT WITH PULL STRING, FROM MC1 UNDER SLAB AND STUB-UP INTO LEASE SPACE FOR TENANT SUPPLIED BRANCH PANEL AND CAP OFF.
- EXHAUST FAN TO BE TIED INTO LIGHTING CIRCUIT FOR THIS AREA.
- GENERATOR DISCONNECT. SEE ONE-LINE DIAGRAM ON SHEET E1.11.
- PROVIDE ONE 20A, 120V, 1P CIRCUIT FOR GENERATOR REMOTE ANNUNCIATOR. FED FROM PANEL E1, CKT 27.
- 20A, 120V, 1P POWER CONNECTION FOR BLADE SIGNS. CIRCUIT AS INDICATED VIA PHOTOCELL & TIMECLOCK. MOUNT JUNCTION BOX TIGHT TO CEILING (AT BUILDING INTERIOR), COORDINATING EXACT LOCATION WITH SIGN INSTALLER'S SLEEVE AND PER ARCHITECT'S DIRECTION AT EACH LOCATION.
- PROVIDE ONE 20A, 120V, 1P CIRCUIT FROM PANEL M1, CKT 24 FOR BUILDING ENTRY ACCESS CONTROL SYSTEM AND PROVIDE ROUGH IN AND WIRING TO ACCESS POINTS LOCATED ON PLANS. CONSULT WITH LOW VOLTAGE SYSTEMS INSTALLER AND THE 'T' SERIES SHEETS FOR ADDITIONAL INFORMATION.
- ENTRY ACCESS POINT.
- APARTMENT CALL DIRECTORY.
- VERIFY ELEVATOR EQUIPMENT LOCATION AND ELECTRICAL REQUIREMENTS WITH ARCHITECT AND/OR ELEVATOR PROVIDER.
- PROVIDE ONE 20A, 120V, 1P CIRCUIT FROM PANEL 'M1' FOR AUTOMATIC DOOR OPENERS.
- PROVIDE ONE 20A, 120V, 1P CIRCUIT FROM PANEL 'H1' FOR DAS SYSTEM.
- PACKAGE CONCIERGE SYSTEM. MOUNT DUPLEX RECEPTACLES AT 76" AFF.
- PROVIDE ONE 20A, 120V, 1P CIRCUIT FOR A/V SYSTEM CONTROL, FROM PANEL H1, CKT 31. CONSULT INTERIORS GROUP FOR EXACT LOCATION. COORDINATE WITH SYSTEM INSTALLER FOR EXACT REQUIREMENTS.
- ELECTRICAL SERVICE METER ROOMS SHALL HAVE OUTWARD SWING DOORS EQUIPPED WITH PANIC HARDWARE. PROVIDE A KEY BOX AT THE EXTERIOR FOR CLARK PUBLIC UTILITIES 24/7 ACCESS.
- CONSULT MECHANICAL AND/OR PLUMBING CONTRACTOR FOR EXACT ELECTRICAL REQUIREMENTS OF THE DRINKING FOUNTAIN, IF ANY AND PROVIDE CIRCUIT FROM PANE H1.
- PER WASHINGTON STATE ENERGY CODE C405.10, AT LEAST 50% OF THE RECEPTACLES IN THIS SPACE SHALL BE CONTROLLED. RECEPTACLES NOTED WITH '*' SHALL BE CONTROLLED VIA OCCUPANCY SENSOR AND SHALL "TURN OFF" AFTER A MINIMUM OF 30 MINUTES OF IN-ACTIVITY WITHIN THE SPACE. PROVIDE APPROPRIATE IDENTIFICATION OF EACH CONTROLLED RECEPTACLE. REFER TO THE PANEL SCHEDULES ON E1.16 FOR ADDITIONAL INFORMATION ON WHICH CIRCUIT IS TO BE THE CONTROLLED CIRCUIT.
- LOW VOLTAGE/COMMUNICATIONS SYSTEM DEMARCATION BOARD(S). COORDINATE LOCATIONS AND ELECTRICAL POWER REQUIREMENTS WITH THE TELECOM PLANS ('T' SERIES SHEETS) AND LOW VOLTAGE SYSTEMS INSTALLERS, AND PROVIDE ROUGH IN AND/OR FINAL ELECTRICAL POWER CONNECTIONS & DEVICES. REFER PANEL 'M1' SCHEDULE ON E1.16 FOR CIRCUITS.
- CEILING MOUNTED 20A DUPLEX RECEPTACLE FOR SECURITY CAMERA. CONSULT ARCHITECT FOR ADDITIONAL INFORMATION.
- SHAFT FOR THE ROUTING OF ELECTRICAL FEEDERS FROM TENANT METERS TO RESIDENTIAL UNITS.
- HORIZONTAL RECEPTACLE IN BANQUETTE FACE. REFER TO THE ARCHITECT AND INTERIOR DECORATOR PLANS FOR ADDITIONAL INFORMATION. PROVIDE WITH TYPES A & C USB PORTS, LEVITON T5633-T OR APPROVED EQUAL.
- PROVIDE ONE 20A, 120V, 1P CIRCUIT FROM THE EMERGENCY PANEL E1, CKTS 19 & 21 FOR ELEVATOR SMOKE CURTAINS. SMOKE CURTAINS ARE TO BE SMOKE GUARD SYSTEM MODEL 200 AND SHALL BE INSTALLED AT EACH ELEVATOR LOBBY. ELECTRICAL CONTRACTOR SHALL BE RESPONSIBLE TO COORDINATE INSTALLATION WITH THE EQUIPMENT PROVIDER/INSTALLER FOR ALL ELECTRICAL REQUIREMENTS PRIOR TO ROUGH IN. EACH SMOKE CURTAIN SHALL BE INTERLINKED WITH THE NEAREST SMOKE DETECTOR AT EACH LOCATION.
- PROVIDE ONE 20A, 120V, 1P CIRCUIT FROM PANEL H1, CKT 17 FOR THE APARTMENT ENTRY SYSTEM PRIMARY CONTROL PANEL AND PROVIDE ROUGH IN AND WIRING, AS NEEDED, TO EACH UNIT ENTRY. CONSULT WITH LOW VOLTAGE SYSTEMS INSTALLER AND THE 'T' SERIES SHEETS FOR ADDITIONAL INFORMATION.
- PROVIDE ONE 20A, 120V, 1P CIRCUIT FROM PANEL H1, CKT 34 FOR THE SECURITY SYSTEM PANEL AND PROVIDE ROUGH IN AND WIRING, AS NEEDED. CONSULT WITH LOW VOLTAGE SYSTEMS INSTALLER AND THE 'T' SERIES SHEETS FOR ADDITIONAL INFORMATION.
- PROVIDE ONE 20A, 120V, 1P CIRCUIT FROM PANEL E1, CKT 23 FOR THE FIRE ALARM CONTROL PANEL. CONSULT WITH LOW VOLTAGE SYSTEMS INSTALLER AND THE 'T' SERIES SHEETS FOR ADDITIONAL INFORMATION.
- PROVIDE EMERGENCY SHUTOFF CONTROLS FOR GAS APPLIANCES. COORDINATE INSTALLATION WITH MECHANICAL CONTRACTOR. CIRCUIT FROM PANEL 'E1'. SEE DETAIL 5/E1.22 FOR EMERGENCY SHUFF-OFF DIAGRAM.
- AREA OF REFUGE PANEL. CONSULT FIRE ALARM PLANS ('T' SERIES SHEETS) AND PROVIDE ROUGH IN AS NEEDED. PROVIDE POWER CONNECTION FROM PANEL E1.
- PROVIDE ROUGH IN, AS NEEDED, FOR FIRE ALARM REMOTE ANNUNCIATION PANEL.
- PROVIDE ROUGH IN, AS NEEDED, FOR AUDIO SYSTEM CONTROLS.
- PROVIDE ROUGH IN, AS NEEDED, FOR WIFI SYSTEM. CIRCUIT FROM PANEL 'H1'.
- CONSULT ARCHITECT AND/OR MECHANICAL PLANS FOR ADDITIONAL INFORMATION REGARDING THE FIREPLACE. PROVIDE ELECTRICAL CONNECTION(S) AS NEEDED FROM PANEL 'H1', CKT 33. PROVIDE 120V TWIST-TIMER SWITCH (MAX. 60 MINUTES "NO HOLD") FOR FIREPLACE IGNITOR CONTROLS. INTERCONNECT WITH POWER VENT FAN LOCATED ON ROOF.
- PROVIDE TWO 20A, 120V CIRCUITS, FROM PANEL 'H1' FOR WALL MOUNTED FANS, PROVIDED BY OTHERS. CONSULT INTERIOR DECORATOR FOR EXACT POWER REQUIREMENTS AND MOUNTING HEIGHTS. PROVIDE CONTROL SWITCH PER MANUFACTURER'S/DECORATOR'S DIRECTION.
- PROVIDE ONE 20A, 120V CIRCUIT, FROM PANEL 'M1' FOR IRRIGATION CONTROLS. COORDINATE WITH LANDSCAPING FOR EXACT POWER REQUIREMENTS AND PREFERRED LOCATION PRIOR TO ROUGH IN.
- PROVIDE TWO 1-1/2" EMPTY CONDUITS W/ PULL STRING, ROUTED FROM THE ELECTRICAL ROOM TO THE ROOF FOR PV SOLAR SYSTEM PROVIDED AND INSTALLED BY OTHERS. COORDINATE WITH THE STRUCTURAL ENGINEER FOR THE ROUTING OF THE CONDUITS UP THROUGH THE BUILDING PRIOR TO ANY WORK.
- CONSULT INTERIORS PLANS TO VERIFY EXACT LOCATION OF FLOOR BOX DEVICES PRIOR TO ROUGH IN.
- PROVIDE ONE 20A, 120V, 1P CIRCUIT FROM PANEL H1, CKT 40 TO J-BOX BEHIND FACE OF CANOPY FOR BUILDING SIGNAGE BY OTHERS. REFER TO ARCHITECTURAL PLANS FOR EXACT LOCATION. SIGNS TO BE CONTROLLED VIA PHOTOCELL, ALONG WITH BUILDING LIGHTS.
- METER LOCATION FOR PV SYSTEM. VERIFY AND COORDINATE WITH SYSTEM INSTALLER.
- PROVIDE ONE 20A, 120V, 1P CIRCUIT FROM PANEL H1, CKT 17 FOR OVERHEAD DOOR OPENER.

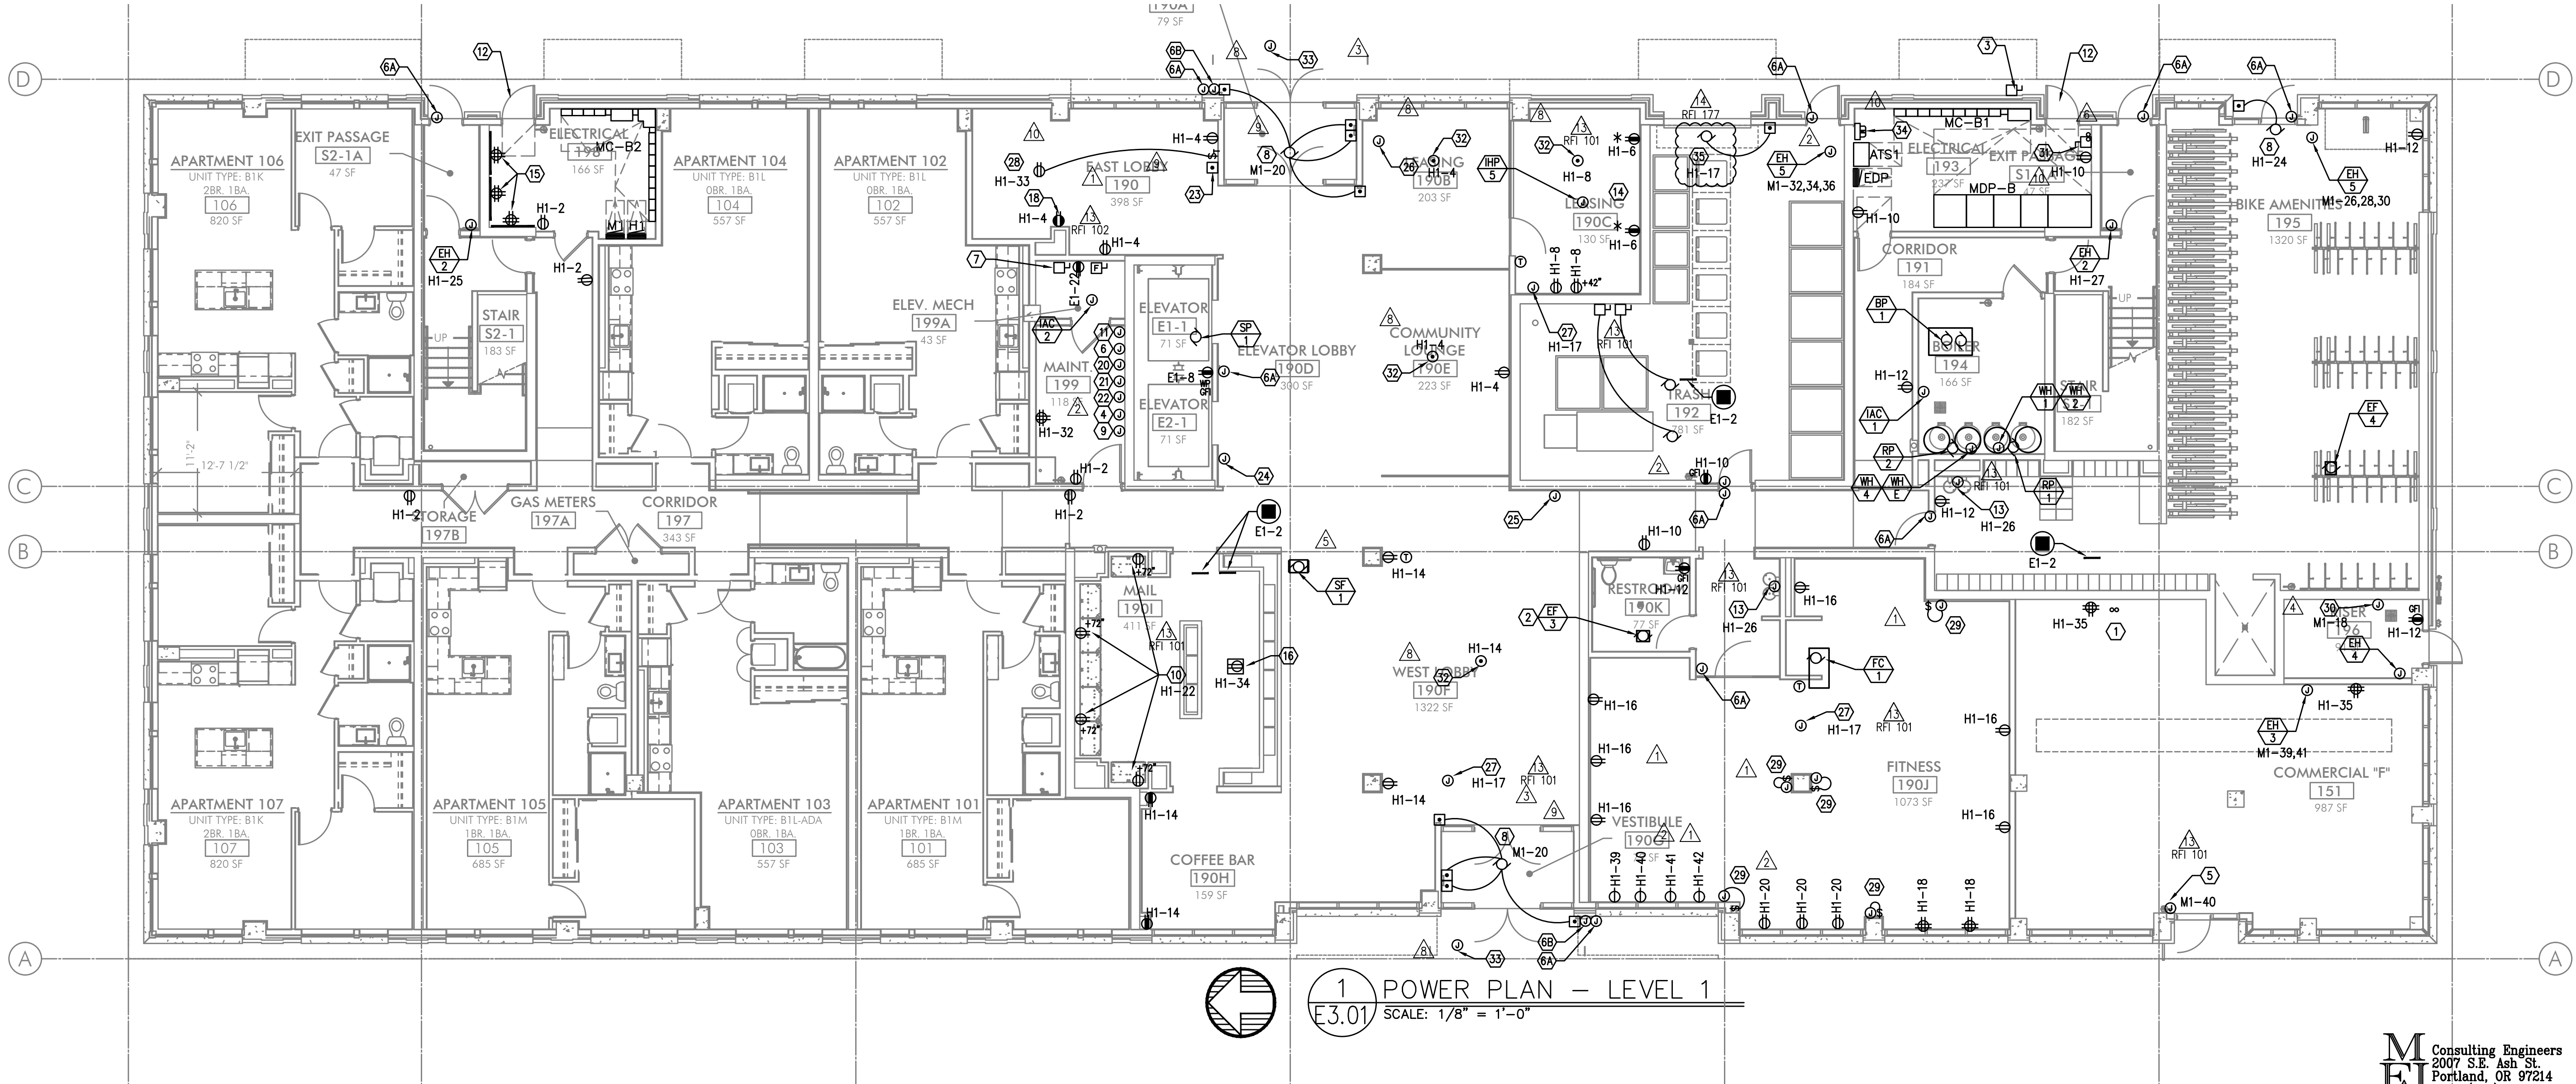

1 POWER PLAN - LEVEL 1
SCALE: 1/8" = 1'-0"



PROJECT # 2017-053
DATE: 11/06/2019
REVISIONS
 PLAN REVIEW 01.24.2020
 PLAN REVIEW 03.13.2020
 PLAN REVIEW 04.24.2020
 PLAN REVIEW 08.10.2020
 PLAN REVIEW 09.17.2020
 PLAN REVIEW 10.16.2020
 PLAN REVIEW 11.25.2020
 PLAN REVIEW 03.26.2021
 PLAN REVIEW 07.15.2021
 COORDINATION 08.27.2021
 COORDINATION 11.05.2021
 COORDINATION 12.10.2021

AEGIS
MIXED-USE DEVELOPMENT
312 E EVERGREEN BOULEVARD, VANCOUVER, WA 98660

SHEET:

B
E3.01

M
E
A
INC.
Consulting Engineers
2007 S.E. Ash St.
Portland, OR 97214
PHN: (503) 234-0548
FAX: (503) 234-0677
WWW.MEIA-ENG.COM
CONTACT: DENISE TAYLOR

GENERAL POWER NOTES:


- A. ALL PLANS ARE CONSIDERED DIAGRAMMATICAL. THEREFORE ALL EQUIPMENT SIZES AND DEVICE LOCATIONS ARE APPROXIMATE AND SUBJECT TO FIELD CONDITIONS AND PRODUCT APPROVAL.
- B. ELECTRICAL CONTRACTOR TO PROVIDE THERMOSTATS NOT SUPPLIED BY MECHANICAL CONTRACTOR. CONSULT MECHANICAL PLANS FOR ADDITIONAL INFORMATION.
- C. ELECTRICAL CONTRACTOR SHALL PROVIDE INSTALLATION AND FINAL CONNECTION OF THERMOSTATS. CONSULT MECHANICAL CONTRACTOR FOR EXACT REQUIREMENTS PRIOR TO ROUGH IN.
- D. REFER TO INTERIOR DECORATOR AND/OR ARCHITECTURAL DRAWINGS FOR DIMENSIONED LOCATION(S) AND ELEVATIONS OF FIXTURES & DEVICES. OTHER DEVICES SHOWN ON THE ELECTRICAL PLANS AND NOT INDICATED ON THE DECORATOR'S OR ARCHITECT'S DRAWINGS, SHALL BE INSTALLED AT STANDARD MOUNTING HEIGHT AS INDICATED THE SYMBOL LIST.
- E. REFER TO ENLARGED TYPICAL UNIT PLANS (E4 SERIES SHEETS) FOR TYPICAL POWER & LIGHTING LAYOUTS FOR THE APARTMENT UNITS.
- F. ELECTRICAL EQUIPMENT SHOWN IN THE ELECTRICAL ROOMS IS APPROXIMATE, BASED ON TYPICAL PRODUCTS. CONTRACTOR SHALL VERIFY ANY SUBMITTED EQUIPMENT WILL FIT WITHIN THE SPACE PROVIDED, PRIOR TO PRODUCT SUBMITTAL REVIEW.
- G. CONSULT ARCHITECTURAL AND/OR INTERIOR DECORATOR PLANS FOR EXACT RECEPTACLE LOCATION IN THE COMMUNITY AREAS, SUCH AS THE LOBBY, CLUB ROOM, LEASE OFFICE, ETC.
- H. THERE SHALL BE NO SURFACE MOUNTED FIXTURES OR PATHWAYS (CONDUIT, ETC.) IN ANY PUBLICLY ACCESSIBLE SPACES, INCLUDING STAIRWELLS AND EXIT PASSAGEWAYS WITHOUT PRIOR APPROVAL BY OWNER AND ARCHITECT. ROUTE ALL PATHWAYS WITHIN STUD CAVITIES OR ABOVE FINISHED CEILINGS.
- I. "SOLAR READY" WORK FOR FUTURE PHOTOVOLTAIC ARRAY SHALL BE PER THE ELECTRICAL REQUIREMENTS AS DEFINED BY THE WASHINGTON STATE ADMINISTRATION CODE, TITLE 51, CHAPTER 51, SECTION 60106.

KEYED NOTES:

1. ROUTE (2) EMPTY 3 1/2" CONDUIT WITH PULL STRING, FROM MC1 UNDER SLAB AND STUB-UP INTO LEASE SPACE FOR TENANT SUPPLIED BRANCH PANEL AND CAP OFF.
2. EXHAUST FAN TO BE TIED INTO LIGHTING CIRCUIT FOR THIS AREA.
3. GENERATOR DISCONNECT. SEE ONE-LINE DIAGRAM ON SHEET E1.11.
4. PROVIDE ONE 20A, 120V, 1P CIRCUIT FOR GENERATOR REMOTE ANNUNCIATOR. FED FROM PANEL E1, CKT 27.
5. 20A, 120V, 1P POWER CONNECTION FOR BLADE SIGNS. CIRCUIT AS INDICATED VIA PHOTOCELL & TIMECLOCK. MOUNT JUNCTION BOX TIGHT TO CEILING (AT BUILDING INTERIOR), COORDINATING EXACT LOCATION WITH SIGN INSTALLER'S SLEEVE AND PER ARCHITECT'S DIRECTION AT EACH LOCATION.
6. PROVIDE ONE 20A, 120V, 1P CIRCUIT FROM PANEL M1, CKT 24 FOR BUILDING ENTRY ACCESS CONTROL SYSTEM AND PROVIDE ROUGH IN AND WIRING TO ACCESS POINTS LOCATED ON PLANS. CONSULT WITH LOW VOLTAGE SYSTEMS INSTALLER AND THE 'T' SERIES SHEETS FOR ADDITIONAL INFORMATION.
- 6A. ENTRY ACCESS POINT.
- 6B. APARTMENT CALL DIRECTORY.
7. VERIFY ELEVATOR EQUIPMENT LOCATION AND ELECTRICAL REQUIREMENTS WITH ARCHITECT AND/OR ELEVATOR PROVIDER.
8. PROVIDE ONE 20A, 120V, 1P CIRCUIT FROM PANEL 'M1' FOR AUTOMATIC DOOR OPENERS.
9. PROVIDE ONE 20A, 120V, 1P CIRCUIT FROM PANEL 'H1' FOR DAS SYSTEM.
10. PACKAGE CONCIERGE SYSTEM. MOUNT DUPLEX RECEPTACLES AT 76" AFF.
11. PROVIDE ONE 20A, 120V, 1P CIRCUIT FOR A/V SYSTEM CONTROL, FROM PANEL H1, CKT 31. CONSULT INTERIORS GROUP FOR EXACT LOCATION. COORDINATE WITH SYSTEM INSTALLER FOR EXACT REQUIREMENTS.
12. ELECTRICAL SERVICE METER ROOMS SHALL HAVE OUTWARD SWING DOORS EQUIPPED WITH PANIC HARDWARE. PROVIDE A KEY BOX AT THE EXTERIOR FOR CLARK PUBLIC UTILITIES 24/7 ACCESS.
13. CONSULT MECHANICAL AND/OR PLUMBING CONTRACTOR FOR EXACT ELECTRICAL REQUIREMENTS OF THE DRINKING FOUNTAIN, IF ANY AND PROVIDE CIRCUIT FROM PANE H1.
14. PER WASHINGTON STATE ENERGY CODE C405.10, AT LEAST 50% OF THE RECEPTACLES IN THIS SPACE SHALL BE CONTROLLED. RECEPTACLES NOTED WITH '*' SHALL BE CONTROLLED VIA OCCUPANCY SENSOR AND SHALL 'TURN OFF' AFTER A MINIMUM OF 30 MINUTES OF IN-ACTIVITY WITHIN THE SPACE. PROVIDE APPROPRIATE IDENTIFICATION OF EACH CONTROLLED RECEPTACLE. REFER TO THE PANEL SCHEDULES ON E1.18 FOR ADDITIONAL INFORMATION ON WHICH CIRCUIT IS TO BE THE CONTROLLED CIRCUIT.
15. LOW VOLTAGE/COMMUNICATIONS SYSTEM DEMARCATION BOARD(S). COORDINATE LOCATIONS AND ELECTRICAL POWER REQUIREMENTS WITH THE TELECOM PLANS ('T' SERIES SHEETS) AND LOW VOLTAGE SYSTEMS INSTALLERS, AND PROVIDE ROUGH IN AND/OR FINAL ELECTRICAL POWER CONNECTIONS & DEVICES. REFER PANEL 'M1' SCHEDULE ON E1.16 FOR CIRCUITS.
16. CEILING MOUNTED 20A DUPLEX RECEPTACLE FOR SECURITY CAMERA. CONSULT ARCHITECT FOR ADDITIONAL INFORMATION.
17. SHAFT FOR THE ROUTING OF ELECTRICAL FEEDERS FROM TENANT METERS TO RESIDENTIAL UNITS.
18. HORIZONTAL RECEPTACLE IN BANQUETTE FACE. REFER TO THE ARCHITECT AND INTERIOR DECORATOR PLANS FOR ADDITIONAL INFORMATION. PROVIDE WITH TYPES A & C USB PORTS, LEVITON T5633-T OR APPROVED EQUAL.
19. PROVIDE ONE 20A, 120V, 1P CIRCUIT FROM THE EMERGENCY PANEL E1, CKTS 19 & 21 FOR ELEVATOR SMOKE CURTAINS. SMOKE CURTAINS ARE TO BE SMOKE GUARD SYSTEM MODEL 200 AND SHALL BE INSTALLED AT EACH ELEVATOR LOBBY. ELECTRICAL CONTRACTOR SHALL BE RESPONSIBLE TO COORDINATE INSTALLATION WITH THE EQUIPMENT PROVIDER/INSTALLER FOR ALL ELECTRICAL REQUIREMENTS PRIOR TO ROUGH IN. EACH SMOKE CURTAIN SHALL BE INTERLINKED WITH THE NEAREST SMOKE DETECTOR AT EACH LOCATION.
20. PROVIDE ONE 20A, 120V, 1P CIRCUIT FROM PANEL H1, CKT 17 FOR THE APARTMENT ENTRY SYSTEM PRIMARY CONTROL PANEL AND PROVIDE ROUGH IN AND WIRING, AS NEEDED, TO EACH UNIT ENTRY. CONSULT WITH LOW VOLTAGE SYSTEMS INSTALLER AND THE 'T' SERIES SHEETS FOR ADDITIONAL INFORMATION.
21. PROVIDE ONE 20A, 120V, 1P CIRCUIT FROM PANEL H1, CKT 34 FOR THE SECURITY SYSTEM PANEL AND PROVIDE ROUGH IN AND WIRING, AS NEEDED. CONSULT WITH LOW VOLTAGE SYSTEMS INSTALLER AND THE 'T' SERIES SHEETS FOR ADDITIONAL INFORMATION.
22. PROVIDE ONE 20A, 120V, 1P CIRCUIT FROM PANEL E1, CKT 23 FOR THE FIRE ALARM CONTROL PANEL. CONSULT WITH LOW VOLTAGE SYSTEMS INSTALLER AND THE 'T' SERIES SHEETS FOR ADDITIONAL INFORMATION.
23. PROVIDE EMERGENCY SHUTOFF CONTROLS FOR GAS APPLIANCES. COORDINATE INSTALLATION WITH MECHANICAL CONTRACTOR. CIRCUIT FROM PANEL 'E1'. SEE DETAIL 5/E1.22 FOR EMERGENCY SHUFF-OFF DIAGRAM.
24. AREA OF REFUGE PANEL. CONSULT FIRE ALARM PLANS ('T' SERIES SHEETS) AND PROVIDE ROUGH IN AS NEEDED. PROVIDE POWER CONNECTION FROM PANEL E1.
25. PROVIDE ROUGH IN, AS NEEDED, FOR FIRE ALARM REMOTE ANNUNCIATION PANEL.
26. PROVIDE ROUGH IN, AS NEEDED, FOR AUDIO SYSTEM CONTROLS.
27. PROVIDE ROUGH IN, AS NEEDED, FOR WIFI SYSTEM. CIRCUIT FROM PANEL 'H1'.
28. CONSULT ARCHITECT AND/OR MECHANICAL PLANS FOR ADDITIONAL INFORMATION REGARDING THE FIREPLACE. PROVIDE ELECTRICAL CONNECTION(S) AS NEEDED FROM PANEL 'H1', CKT 33. PROVIDE 120V TWIST-TIMER SWITCH (MAX. 60 MINUTES "NO HOLD") FOR FIREPLACE IGNITOR CONTROLS. INTERCONNECT WITH POWER VENT FAN LOCATED ON ROOF.
29. PROVIDE TWO 20A, 120V CIRCUITS, FROM PANEL 'H1' FOR WALL MOUNTED FANS, PROVIDED BY OTHERS. CONSULT INTERIOR DECORATOR FOR EXACT POWER REQUIREMENTS AND MOUNTING HEIGHTS. PROVIDE CONTROL SWITCH PER MANUFACTURER'S/DECORATOR'S DIRECTION.
30. PROVIDE ONE 20A, 120V CIRCUIT, FROM PANEL 'M1' FOR IRRIGATION CONTROLS. COORDINATE WITH LANDSCAPING FOR EXACT POWER REQUIREMENTS AND PREFERRED LOCATION PRIOR TO ROUGH IN.
31. PROVIDE TWO 1-1/2" EMPTY CONDUITS W/ PULL STRING, ROUTED FROM THE ELECTRICAL ROOM TO THE ROOF FOR PV SOLAR SYSTEM PROVIDED AND INSTALLED BY OTHERS. COORDINATE WITH THE STRUCTURAL ENGINEER FOR THE ROUTING OF THE CONDUITS UP THROUGH THE BUILDING PRIOR TO ANY WORK.
32. CONSULT INTERIORS PLANS TO VERIFY EXACT LOCATION OF FLOOR BOX DEVICES PRIOR TO ROUGH IN.
33. PROVIDE ONE 20A, 120V, 1P CIRCUIT FROM PANEL H1, CKT 40 TO J-BOX BEHIND FACE OF CANOPY FOR BUILDING SIGNAGE BY OTHERS. REFER TO ARCHITECTURAL PLANS FOR EXACT LOCATION. SIGNS TO BE CONTROLLED VIA PHOTOCELL, ALONG WITH BUILDING LIGHTS.
34. METER LOCATION FOR PV SYSTEM. VERIFY AND COORDINATE WITH SYSTEM INSTALLER.
35. PROVIDE ONE 20A, 120V, 1P CIRCUIT FROM PANEL H1, CKT 17 FOR OVERHEAD DOOR OPENER.



1 POWER PLAN - LEVEL 2
E3.02 SCALE: 1/8" = 1'-0"

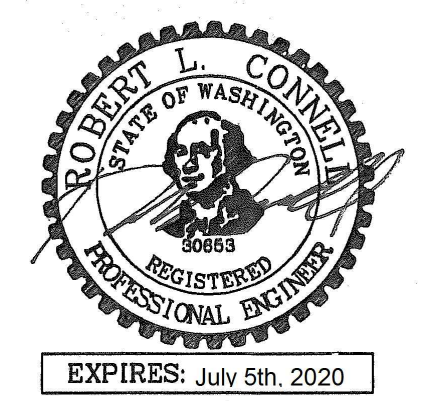

- PROJECT # 2017-053
DATE: 11/06/2019
REVISIONS
PLAN REVIEW 01.24.2020
PLAN REVIEW 03.13.2020
PLAN REVIEW 04.24.2020
PLAN REVIEW 08.10.2020
PLAN REVIEW 09.17.2020
PLAN REVIEW 10.16.2020
PLAN REVIEW 11.25.2020
PLAN REVIEW 03.26.2021
PLAN REVIEW 07.15.2021
COORDINATION 08.27.2021
COORDINATION 11.05.2021
COORDINATION 12.10.2021

AEGIS
MIXED-USE DEVELOPMENT
312 E EVERGREEN BOULEVARD, VANCOUVER, WA 98660

MEI
Consulting Engineers
2007 S.E. Ash St.
Portland, OR 97214
PHN: (503) 234-0548
FAX: (503) 234-0677
WWW.MEIA-ENG.COM
CONTACT: DENISE TAYLOR


SHEET:
B
E3.02

GENERAL POWER NOTES:

- ALL PLANS ARE CONSIDERED DIAGRAMMATICAL. THEREFORE ALL EQUIPMENT SIZES AND DEVICE LOCATIONS ARE APPROXIMATE AND SUBJECT TO FIELD CONDITIONS AND PRODUCT APPROVAL.
- ELECTRICAL CONTRACTOR TO PROVIDE THERMOSTATS NOT SUPPLIED BY MECHANICAL CONTRACTOR. CONSULT MECHANICAL PLANS FOR ADDITIONAL INFORMATION.
- ELECTRICAL CONTRACTOR SHALL PROVIDE INSTALLATION AND FINAL CONNECTION OF THERMOSTATS. CONSULT MECHANICAL CONTRACTOR FOR EXACT REQUIREMENTS PRIOR TO ROUGH IN.
- REFER TO INTERIOR DECORATOR AND/OR ARCHITECTURAL DRAWINGS FOR DIMENSIONED LOCATION(S) AND ELEVATIONS OF FIXTURES & DEVICES. OTHER DEVICES SHOWN ON THE ELECTRICAL PLANS AND NOT INDICATED ON THE DECORATOR'S OR ARCHITECT'S DRAWINGS, SHALL BE INSTALLED AT STANDARD MOUNTING HEIGHT AS INDICATED THE SYMBOL LIST.
- REFER TO ENLARGED TYPICAL UNIT PLANS (E4 SERIES SHEETS) FOR TYPICAL POWER & LIGHTING LAYOUTS FOR THE APARTMENT UNITS.
- ELECTRICAL EQUIPMENT SHOWN IN THE ELECTRICAL ROOMS IS APPROXIMATE, BASED ON TYPICAL PRODUCTS. CONTRACTOR SHALL VERIFY ANY SUBMITTED EQUIPMENT WILL FIT WITHIN THE SPACE PROVIDED, PRIOR TO PRODUCT SUBMITTAL REVIEW.
- CONSULT ARCHITECTURAL AND/OR INTERIOR DECORATOR PLANS FOR EXACT RECEPTACLE LOCATION IN THE COMMUNITY AREAS, SUCH AS THE LOBBY, CLUB ROOM, LEASE OFFICE, ETC.
- THERE SHALL BE NO SURFACE MOUNTED FIXTURES OR PATHWAYS (CONDUIT, ETC.) IN ANY PUBLICLY ACCESSIBLE SPACES, INCLUDING STAIRWELLS AND EXIT PASSAGEWAYS WITHOUT PRIOR APPROVAL BY OWNER AND ARCHITECT. ROUTE ALL PATHWAYS WITHIN STUD CAVITIES OR ABOVE FINISHED CEILINGS.
- "SOLAR READY" WORK FOR FUTURE PHOTOVOLTAIC ARRAY SHALL BE PER THE ELECTRICAL REQUIREMENTS AS DEFINED BY THE WASHINGTON STATE ADMINISTRATION CODE, TITLE 51, CHAPTER 51, SECTION 60106.

KEYED NOTES:

- ROUTE (2) EMPTY 3 1/2" CONDUIT WITH PULL STRING, FROM MC1 UNDER SLAB AND STUB-UP INTO LEASE SPACE FOR TENANT SUPPLIED BRANCH PANEL AND CAP OFF.
- EXHAUST FAN TO BE TIED INTO LIGHTING CIRCUIT FOR THIS AREA.
- GENERATOR DISCONNECT. SEE ONE-LINE DIAGRAM ON SHEET E1.11.
- PROVIDE ONE 20A, 120V, 1P CIRCUIT FOR GENERATOR REMOTE ANNUNCIATOR. FED FROM PANEL E1, CKT 27.
- 20A, 120V, 1P POWER CONNECTION FOR BLADE SIGNS. CIRCUIT AS INDICATED VIA PHOTOCELL & TIMECLOCK. MOUNT JUNCTION BOX TIGHT TO CEILING (AT BUILDING INTERIOR), COORDINATING EXACT LOCATION WITH SIGN INSTALLER'S SLEEVE AND PER ARCHITECT'S DIRECTION AT EACH LOCATION.
- PROVIDE ONE 20A, 120V, 1P CIRCUIT FROM PANEL M1, CKT 24 FOR BUILDING ENTRY ACCESS CONTROL SYSTEM AND PROVIDE ROUGH IN AND WIRING TO ACCESS POINTS LOCATED ON PLANS. CONSULT WITH LOW VOLTAGE SYSTEMS INSTALLER AND THE 'T' SERIES SHEETS FOR ADDITIONAL INFORMATION.
- ENTRY ACCESS POINT.
- APARTMENT CALL DIRECTORY.
- VERIFY ELEVATOR EQUIPMENT LOCATION AND ELECTRICAL REQUIREMENTS WITH ARCHITECT AND/OR ELEVATOR PROVIDER.
- PROVIDE ONE 20A, 120V, 1P CIRCUIT FROM PANEL 'M1' FOR AUTOMATIC DOOR OPENERS.
- PROVIDE ONE 20A, 120V, 1P CIRCUIT FROM PANEL 'H1' FOR DAS SYSTEM.
- PACKAGE CONCIERGE SYSTEM. MOUNT DUPLEX RECEPTACLES AT 76" AFF.
- PROVIDE ONE 20A, 120V, 1P CIRCUIT FOR A/V SYSTEM CONTROL, FROM PANEL H1, CKT 31. CONSULT INTERIORS GROUP FOR EXACT LOCATION. COORDINATE WITH SYSTEM INSTALLER FOR EXACT REQUIREMENTS.
- ELECTRICAL SERVICE METER ROOMS SHALL HAVE OUTWARD SWING DOORS EQUIPPED WITH PANIC HARDWARE. PROVIDE A KEY BOX AT THE EXTERIOR FOR CLARK PUBLIC UTILITIES 24/7 ACCESS.
- CONSULT MECHANICAL AND/OR PLUMBING CONTRACTOR FOR EXACT ELECTRICAL REQUIREMENTS OF THE DRINKING FOUNTAIN, IF ANY AND PROVIDE CIRCUIT FROM PANE H1.
- PER WASHINGTON STATE ENERGY CODE C405.10, AT LEAST 50% OF THE RECEPTACLES IN THIS SPACE SHALL BE CONTROLLED. RECEPTACLES NOTED WITH '*' SHALL BE CONTROLLED VIA OCCUPANCY SENSOR AND SHALL "TURN OFF" AFTER A MINIMUM OF 30 MINUTES OF IN-ACTIVITY WITHIN THE SPACE. PROVIDE APPROPRIATE IDENTIFICATION OF EACH CONTROLLED RECEPTACLE. REFER TO THE PANEL SCHEDULES ON E1.16 FOR ADDITIONAL INFORMATION ON WHICH CIRCUIT IS TO BE THE CONTROLLED CIRCUIT.
- LOW VOLTAGE/COMMUNICATIONS SYSTEM DEMARCATION BOARD(S). COORDINATE LOCATIONS AND ELECTRICAL POWER REQUIREMENTS WITH THE TELECOM PLANS ('T' SERIES SHEETS) AND LOW VOLTAGE SYSTEMS INSTALLERS, AND PROVIDE ROUGH IN AND/OR FINAL ELECTRICAL POWER CONNECTIONS & DEVICES. REFER PANEL 'M1' SCHEDULE ON E1.16 FOR CIRCUITS.
- CEILING MOUNTED 20A DUPLEX RECEPTACLE FOR SECURITY CAMERA. CONSULT ARCHITECT FOR ADDITIONAL INFORMATION.
- SHAFT FOR THE ROUTING OF ELECTRICAL FEEDERS FROM TENANT METERS TO RESIDENTIAL UNITS.
- HORIZONTAL RECEPTACLE IN BANQUETTE FACE. REFER TO THE ARCHITECT AND INTERIOR DECORATOR PLANS FOR ADDITIONAL INFORMATION. PROVIDE WITH TYPES A & C USB PORTS, LEVITON T5633-T OR APPROVED EQUAL.
- PROVIDE ONE 20A, 120V, 1P CIRCUIT FROM THE EMERGENCY PANEL E1, CKTS 19 & 21 FOR ELEVATOR SMOKE CURTAINS. SMOKE CURTAINS ARE TO BE SMOKE GUARD SYSTEM MODEL 200 AND SHALL BE INSTALLED AT EACH ELEVATOR LOBBY. ELECTRICAL CONTRACTOR SHALL BE RESPONSIBLE TO COORDINATE INSTALLATION WITH THE EQUIPMENT PROVIDER/INSTALLER FOR ALL ELECTRICAL REQUIREMENTS PRIOR TO ROUGH IN. EACH SMOKE CURTAIN SHALL BE INTERLINKED WITH THE NEAREST SMOKE DETECTOR AT EACH LOCATION.
- PROVIDE ONE 20A, 120V, 1P CIRCUIT FROM PANEL H1, CKT 17 FOR THE APARTMENT ENTRY SYSTEM PRIMARY CONTROL PANEL AND PROVIDE ROUGH IN AND WIRING, AS NEEDED, TO EACH UNIT ENTRY. CONSULT WITH LOW VOLTAGE SYSTEMS INSTALLER AND THE 'T' SERIES SHEETS FOR ADDITIONAL INFORMATION.
- PROVIDE ONE 20A, 120V, 1P CIRCUIT FROM PANEL H1, CKT 34 FOR THE SECURITY SYSTEM PANEL AND PROVIDE ROUGH IN AND WIRING, AS NEEDED. CONSULT WITH LOW VOLTAGE SYSTEMS INSTALLER AND THE 'T' SERIES SHEETS FOR ADDITIONAL INFORMATION.
- PROVIDE ONE 20A, 120V, 1P CIRCUIT FROM PANEL E1, CKT 23 FOR THE FIRE ALARM CONTROL PANEL. CONSULT WITH LOW VOLTAGE SYSTEMS INSTALLER AND THE 'T' SERIES SHEETS FOR ADDITIONAL INFORMATION.
- PROVIDE EMERGENCY SHUTOFF CONTROLS FOR GAS APPLIANCES. COORDINATE INSTALLATION WITH MECHANICAL CONTRACTOR. CIRCUIT FROM PANEL 'E1'. SEE DETAIL 5/E1.22 FOR EMERGENCY SHUFF-OFF DIAGRAM.
- AREA OF REFUGE PANEL. CONSULT FIRE ALARM PLANS ('T' SERIES SHEETS) AND PROVIDE ROUGH IN AS NEEDED. PROVIDE POWER CONNECTION FROM PANEL E1.
- PROVIDE ROUGH IN, AS NEEDED, FOR FIRE ALARM REMOTE ANNUNCIATION PANEL.
- PROVIDE ROUGH IN, AS NEEDED, FOR AUDIO SYSTEM CONTROLS.
- PROVIDE ROUGH IN, AS NEEDED, FOR WIFI SYSTEM. CIRCUIT FROM PANEL 'H1'.
- CONSULT ARCHITECT AND/OR MECHANICAL PLANS FOR ADDITIONAL INFORMATION REGARDING THE FIREPLACE. PROVIDE ELECTRICAL CONNECTION(S) AS NEEDED FROM PANEL 'H1', CKT 33. PROVIDE 120V TWIST-TIMER SWITCH (MAX. 60 MINUTES "NO HOLD") FOR FIREPLACE IGNITOR CONTROLS. INTERCONNECT WITH POWER VENT FAN LOCATED ON ROOF.
- PROVIDE TWO 20A, 120V CIRCUITS, FROM PANEL 'H1' FOR WALL MOUNTED FANS, PROVIDED BY OTHERS. CONSULT INTERIOR DECORATOR FOR EXACT POWER REQUIREMENTS AND MOUNTING HEIGHTS. PROVIDE CONTROL SWITCH PER MANUFACTURER'S/DECORATOR'S DIRECTION.
- PROVIDE ONE 20A, 120V CIRCUIT, FROM PANEL 'M1' FOR IRRIGATION CONTROLS. COORDINATE WITH LANDSCAPING FOR EXACT POWER REQUIREMENTS AND PREFERRED LOCATION PRIOR TO ROUGH IN.
- PROVIDE TWO 1-1/2" EMPTY CONDUITS W/ PULL STRING, ROUTED FROM THE ELECTRICAL ROOM TO THE ROOF FOR PV SOLAR SYSTEM PROVIDED AND INSTALLED BY OTHERS. COORDINATE WITH THE STRUCTURAL ENGINEER FOR THE ROUTING OF THE CONDUITS UP THROUGH THE BUILDING PRIOR TO ANY WORK.
- CONSULT INTERIORS PLANS TO VERIFY EXACT LOCATION OF FLOOR BOX DEVICES PRIOR TO ROUGH IN.
- PROVIDE ONE 20A, 120V, 1P CIRCUIT FROM PANEL H1, CKT 40 TO J-BOX BEHIND FACE OF CANOPY FOR BUILDING SIGNAGE BY OTHERS. REFER TO ARCHITECTURAL PLANS FOR EXACT LOCATION. SIGNS TO BE CONTROLLED VIA PHOTOCELL, ALONG WITH BUILDING LIGHTS.
- METER LOCATION FOR PV SYSTEM. VERIFY AND COORDINATE WITH SYSTEM INSTALLER.
- PROVIDE ONE 20A, 120V, 1P CIRCUIT FROM PANEL H1, CKT 17 FOR OVERHEAD DOOR OPENER.

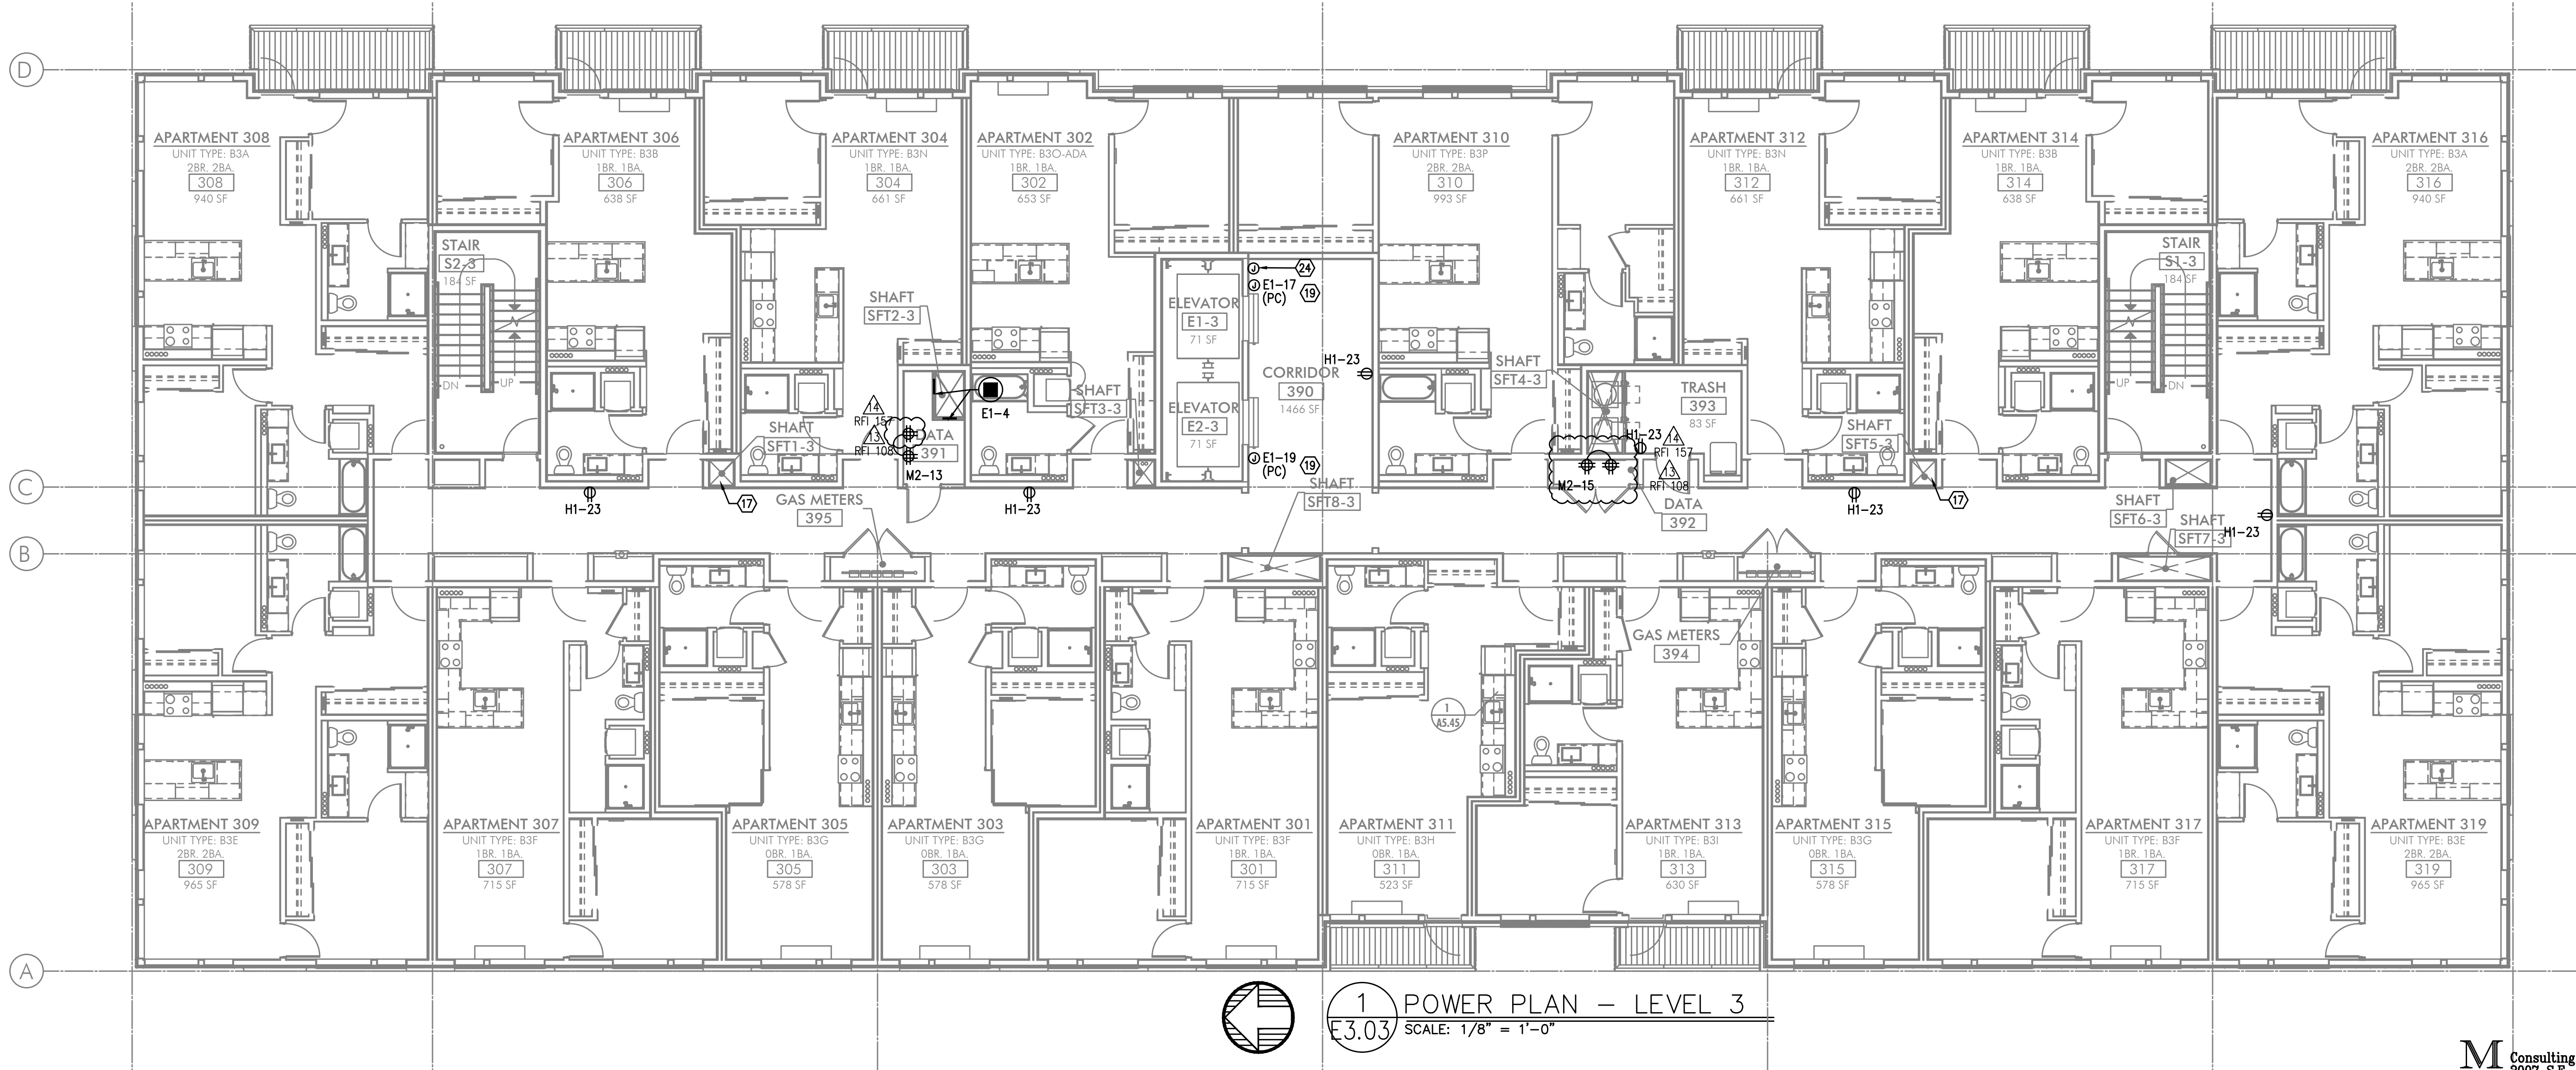

1 POWER PLAN - LEVEL 3
E3.03 SCALE: 1/8" = 1'-0"



PROJECT # 2017-053
DATE: 11/06/2019
REVISIONS
 ▲ PLAN REVIEW 01.24.2020
 ▲ PLAN REVIEW 03.13.2020
 ▲ PLAN REVIEW 04.24.2020
 ▲ PLAN REVIEW 08.10.2020
 ▲ PLAN REVIEW 09.17.2020
 ▲ PLAN REVIEW 10.16.2020
 ▲ PLAN REVIEW 11.25.2020
 ▲ PLAN REVIEW 03.26.2021
 ▲ PLAN REVIEW 07.15.2021
 ▲ COORDINATION 08.27.2021
 ▲ COORDINATION 11.05.2021
 ▲ COORDINATION 12.10.2021

AEGIS
MIXED-USE DEVELOPMENT
312 E EVERGREEN BOULEVARD, VANCOUVER, WA 98660

SHEET:

B
E3.03



MFA
Consulting Engineers
2007 S.E. Ash St.
Portland, OR 97214
PHN: (503) 234-0548
FAX: (503) 234-0577
WWW.MFA-ENG.COM
CONTACT: DENISE TAYLOR

GENERAL POWER NOTES:

- A. ALL PLANS ARE CONSIDERED DIAGRAMMATICAL. THEREFORE ALL EQUIPMENT SIZES AND DEVICE LOCATIONS ARE APPROXIMATE AND SUBJECT TO FIELD CONDITIONS AND PRODUCT APPROVAL.
- B. ELECTRICAL CONTRACTOR TO PROVIDE THERMOSTATS NOT SUPPLIED BY MECHANICAL CONTRACTOR. CONSULT MECHANICAL PLANS FOR ADDITIONAL INFORMATION.
- C. ELECTRICAL CONTRACTOR SHALL PROVIDE INSTALLATION AND FINAL CONNECTION OF THERMOSTATS. CONSULT MECHANICAL CONTRACTOR FOR EXACT REQUIREMENTS PRIOR TO ROUGH IN.
- D. REFER TO INTERIOR DECORATOR AND/OR ARCHITECTURAL DRAWINGS FOR DIMENSIONED LOCATION(S) AND ELEVATIONS OF FIXTURES & DEVICES. OTHER DEVICES SHOWN ON THE ELECTRICAL PLANS AND NOT INDICATED ON THE DECORATOR'S OR ARCHITECT'S DRAWINGS, SHALL BE INSTALLED AT STANDARD MOUNTING HEIGHT AS INDICATED THE SYMBOL LIST.
- E. REFER TO ENLARGED TYPICAL UNIT PLANS (E4 SERIES SHEETS) FOR TYPICAL POWER & LIGHTING LAYOUTS FOR THE APARTMENT UNITS.
- F. ELECTRICAL EQUIPMENT SHOWN IN THE ELECTRICAL ROOMS IS APPROXIMATE, BASED ON TYPICAL PRODUCTS. CONTRACTOR SHALL VERIFY ANY SUBMITTED EQUIPMENT WILL FIT WITHIN THE SPACE PROVIDED, PRIOR TO PRODUCT SUBMITTAL REVIEW.
- G. CONSULT ARCHITECTURAL AND/OR INTERIOR DECORATOR PLANS FOR EXACT RECEPTACLE LOCATION IN THE COMMUNITY AREAS, SUCH AS THE LOBBY, CLUB ROOM, LEASE OFFICE, ETC.
- H. THERE SHALL BE NO SURFACE MOUNTED FIXTURES OR PATHWAYS (CONDUIT, ETC.) IN ANY PUBLICLY ACCESSIBLE SPACES, INCLUDING STAIRWELLS AND EXIT PASSAGEWAYS WITHOUT PRIOR APPROVAL BY OWNER AND ARCHITECT. ROUTE ALL PATHWAYS WITHIN STUD CAVITIES OR ABOVE FINISHED CEILINGS.
- I. "SOLAR READY" WORK FOR FUTURE PHOTOVOLTAIC ARRAY SHALL BE PER THE ELECTRICAL REQUIREMENTS AS DEFINED BY THE WASHINGTON STATE ADMINISTRATION CODE TITLE 51, CHAPTER 51, SECTION 50106

KEYED NOTES:

1. ROUTE (2) EMPTY 3 1/2" CONDUIT WITH PULL STRING, FROM MC1 UNDER SLAB AND STUB-UP INTO LEASE SPACE FOR TENANT SUPPLIED BRANCH PANEL AND CAP OFF.
2. EXHAUST FAN TO BE TIED INTO LIGHTING CIRCUIT FOR THIS AREA.
3. GENERATOR DISCONNECT. SEE ONE-LINE DIAGRAM ON SHEET E1.11.
4. PROVIDE ONE 20A, 120V, 1P CIRCUIT FOR GENERATOR REMOTE ANNUNCIATOR. FED FROM PANEL E1, CKT 27.
5. 20A, 120V, 1P POWER CONNECTION FOR BLADE SIGNS. CIRCUIT AS INDICATED VIA PHOTOCELL & TIMECLOCK. MOUNT JUNCTION BOX TIGHT TO CEILING (AT BUILDING INTERIOR), COORDINATING EXACT LOCATION WITH SIGN INSTALLER'S SLEEVE AND PER ARCHITECT'S DIRECTION AT EACH LOCATION.
6. PROVIDE ONE 20A, 120V, 1P CIRCUIT FROM PANEL M1, CKT 24 FOR BUILDING ENTRY ACCESS CONTROL SYSTEM AND PROVIDE ROUGH IN AND WIRING TO ACCESS POINTS LOCATED ON PLANS. CONSULT WITH LOW VOLTAGE SYSTEMS INSTALLER AND THE 'T' SERIES SHEETS FOR ADDITIONAL INFORMATION.
- 6A. ENTRY ACCESS POINT.
- 6B. APARTMENT CALL DIRECTORY.
7. VERIFY ELEVATOR EQUIPMENT LOCATION AND ELECTRICAL REQUIREMENTS WITH ARCHITECT AND/OR ELEVATOR PROVIDER.
8. PROVIDE ONE 20A, 120V, 1P CIRCUIT FROM PANEL 'M1' FOR AUTOMATIC DOOR OPENERS.
9. PROVIDE ONE 20A, 120V, 1P CIRCUIT FROM PANEL 'H1' FOR DAS SYSTEM.
10. PACKAGE CONCIERGE SYSTEM. MOUNT DUPLEX RECEPTACLES AT 76" AFF.
11. PROVIDE ONE 20A, 120V, 1P CIRCUIT FOR A/V SYSTEM CONTROL, FROM PANEL H1, CKT 31. CONSULT INTERIORS GROUP FOR EXACT LOCATION. COORDINATE WITH SYSTEM INSTALLER FOR EXACT REQUIREMENTS.
12. ELECTRICAL SERVICE METER ROOMS SHALL HAVE OUTWARD SWING DOORS EQUIPPED WITH PANIC HARDWARE. PROVIDE A KEY BOX AT THE EXTERIOR FOR CLARK PUBLIC UTILITIES 24/7 ACCESS.
13. CONSULT MECHANICAL AND/OR PLUMBING CONTRACTOR FOR EXACT ELECTRICAL REQUIREMENTS OF THE DRINKING FOUNTAIN, IF ANY AND PROVIDE CIRCUIT FROM PANE H1.
14. PER WASHINGTON STATE ENERGY CODE C405.10, AT LEAST 50% OF THE RECEPTACLES IN THIS SPACE SHALL BE CONTROLLED. RECEPTACLES NOTED WITH '*' SHALL BE CONTROLLED VIA OCCUPANCY SENSOR AND SHALL 'TURN OFF' AFTER A MINIMUM OF 30 MINUTES OF IN-ACTIVITY WITHIN THE SPACE. PROVIDE APPROPRIATE IDENTIFICATION OF EACH CONTROLLED RECEPTACLE. REFER TO THE PANEL SCHEDULES ON E1.16 FOR ADDITIONAL INFORMATION ON WHICH CIRCUIT IS TO BE THE CONTROLLED CIRCUIT.
15. LOW VOLTAGE/COMMUNICATIONS SYSTEM DEMARCATION BOARD(S). COORDINATE LOCATIONS AND ELECTRICAL POWER REQUIREMENTS WITH THE TELECOM PLANS ('T' SERIES SHEETS) AND LOW VOLTAGE SYSTEMS INSTALLERS, AND PROVIDE ROUGH IN AND/OR FINAL ELECTRICAL POWER CONNECTIONS & DEVICES. REFER PANEL 'M1' SCHEDULE ON E1.16 FOR CIRCUITS.
16. CEILING MOUNTED 20A DUPLEX RECEPTACLE FOR SECURITY CAMERA. CONSULT ARCHITECT FOR ADDITIONAL INFORMATION.
17. SHAFT FOR THE ROUTING OF ELECTRICAL FEEDERS FROM TENANT METERS TO RESIDENTIAL UNITS.
18. HORIZONTAL RECEPTACLE IN BANQUETTE FACE. REFER TO THE ARCHITECT AND INTERIOR DECORATOR PLANS FOR ADDITIONAL INFORMATION. PROVIDE WITH TYPES A & C USB PORTS, LEVITON T5633-T OR APPROVED EQUAL.
19. PROVIDE ONE 20A, 120V, 1P CIRCUIT FROM THE EMERGENCY PANEL E1, CKTS 19 & 21 FOR ELEVATOR SMOKE CURTAINS. SMOKE CURTAINS ARE TO BE SMOKE GUARD SYSTEM MODEL 200 AND SHALL BE INSTALLED AT EACH ELEVATOR LOBBY. ELECTRICAL CONTRACTOR SHALL BE RESPONSIBLE TO COORDINATE INSTALLATION WITH THE EQUIPMENT PROVIDER/INSTALLER FOR ALL ELECTRICAL REQUIREMENTS PRIOR TO ROUGH IN. EACH SMOKE CURTAIN SHALL BE INTERLINKED WITH THE NEAREST SMOKE DETECTOR AT EACH LOCATION.
20. PROVIDE ONE 20A, 120V, 1P CIRCUIT FROM PANEL H1, CKT 17 FOR THE APARTMENT ENTRY SYSTEM PRIMARY CONTROL PANEL AND PROVIDE ROUGH IN AND WIRING, AS NEEDED, TO EACH UNIT ENTRY. CONSULT WITH LOW VOLTAGE SYSTEMS INSTALLER AND THE 'T' SERIES SHEETS FOR ADDITIONAL INFORMATION.
21. PROVIDE ONE 20A, 120V, 1P CIRCUIT FROM PANEL H1, CKT 34 FOR THE SECURITY SYSTEM PANEL AND PROVIDE ROUGH IN AND WIRING, AS NEEDED. CONSULT WITH LOW VOLTAGE SYSTEMS INSTALLER AND THE 'T' SERIES SHEETS FOR ADDITIONAL INFORMATION.
22. PROVIDE ONE 20A, 120V, 1P CIRCUIT FROM PANEL E1, CKT 23 FOR THE FIRE ALARM CONTROL PANEL. CONSULT WITH LOW VOLTAGE SYSTEMS INSTALLER AND THE 'T' SERIES SHEETS FOR ADDITIONAL INFORMATION.
23. PROVIDE EMERGENCY SHUTOFF CONTROLS FOR GAS APPLIANCES. COORDINATE INSTALLATION WITH MECHANICAL CONTRACTOR. CIRCUIT FROM PANEL 'E1'. SEE DETAIL 5/E1.22 FOR EMERGENCY SHUFF-OFF DIAGRAM.
24. AREA OF REFUGE PANEL. CONSULT FIRE ALARM PLANS ('T' SERIES SHEETS) AND PROVIDE ROUGH IN AS NEEDED. PROVIDE POWER CONNECTION FROM PANEL E1.
25. PROVIDE ROUGH IN, AS NEEDED, FOR FIRE ALARM REMOTE ANNUNCIATION PANEL.
26. PROVIDE ROUGH IN, AS NEEDED, FOR AUDIO SYSTEM CONTROLS.
27. PROVIDE ROUGH IN, AS NEEDED, FOR WIFI SYSTEM. CIRCUIT FROM PANEL 'H1'.
28. CONSULT ARCHITECT AND/OR MECHANICAL PLANS FOR ADDITIONAL INFORMATION REGARDING THE FIREPLACE. PROVIDE ELECTRICAL CONNECTION(S) AS NEEDED FROM PANEL 'H1', CKT 33. PROVIDE 120V TWIST-TIMER SWITCH (MAX. 60 MINUTES "NO HOLD") FOR FIREPLACE IGNITOR CONTROLS. INTERCONNECT WITH POWER VENT FAN LOCATED ON ROOF.
29. PROVIDE TWO 20A, 120V CIRCUITS, FROM PANEL 'H1' FOR WALL MOUNTED FANS, PROVIDED BY OTHERS. CONSULT INTERIOR DECORATOR FOR EXACT POWER REQUIREMENTS AND MOUNTING HEIGHTS. PROVIDE CONTROL SWITCH PER MANUFACTURER'S/DECORATOR'S DIRECTION.
30. PROVIDE ONE 20A, 120V CIRCUIT, FROM PANEL 'M1' FOR IRRIGATION CONTROLS. COORDINATE WITH LANDSCAPING FOR EXACT POWER REQUIREMENTS AND PREFERRED LOCATION PRIOR TO ROUGH IN.
31. PROVIDE TWO 1-1/2" EMPTY CONDUITS W/ PULL STRING, ROUTED FROM THE ELECTRICAL ROOM TO THE ROOF FOR PV SOLAR SYSTEM PROVIDED AND INSTALLED BY OTHERS. COORDINATE WITH THE STRUCTURAL ENGINEER FOR THE ROUTING OF THE CONDUITS UP THROUGH THE BUILDING PRIOR TO ANY WORK.
32. CONSULT INTERIORS PLANS TO VERIFY EXACT LOCATION OF FLOOR BOX DEVICES PRIOR TO ROUGH IN.
33. PROVIDE ONE 20A, 120V, 1P CIRCUIT FROM PANEL H1, CKT 40 TO J-BOX BEHIND FACE OF CANOPY FOR BUILDING SIGNAGE BY OTHERS. REFER TO ARCHITECTURAL PLANS FOR EXACT LOCATION. SIGNS TO BE CONTROLLED VIA PHOTOCELL, ALONG WITH BUILDING LIGHTS.
34. METER LOCATION FOR PV SYSTEM. VERIFY AND COORDINATE WITH SYSTEM INSTALLER.
35. PROVIDE ONE 20A, 120V, 1P CIRCUIT FROM PANEL H1, CKT 17 FOR OVERHEAD DOOR OPENER.

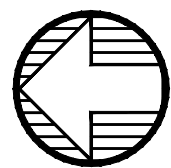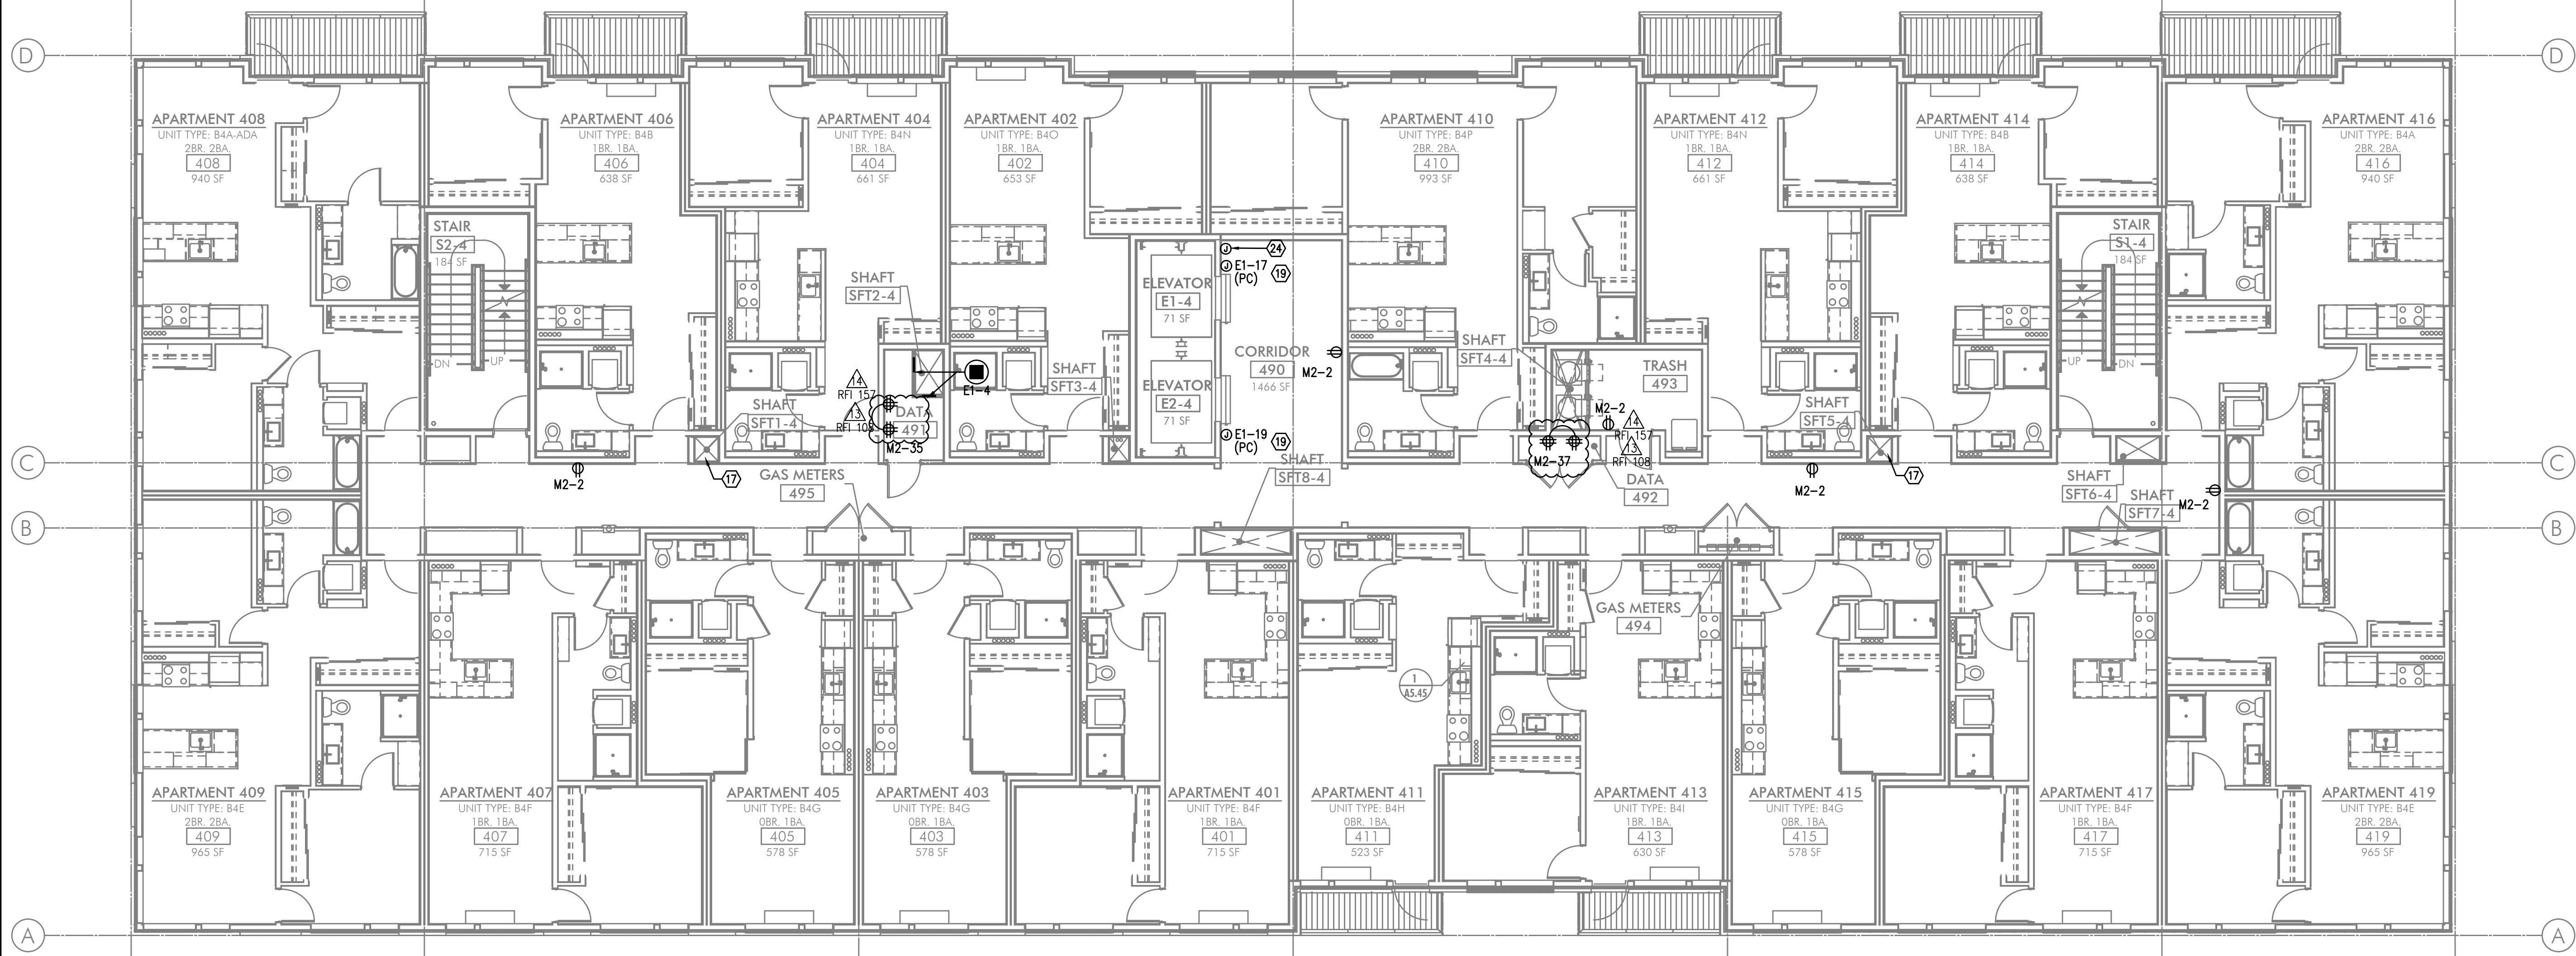

1 POWER PLAN - LEVEL 4
E3.04 SCALE: 1/8" = 1'-0"

M
E
T
A
INC. Consulting Engineers
2007 S.E. Ash St.
Portland, OR 97214
PHN: (503) 234-0548
FAX: (503) 234-0877
CONTACT: DENISE TAYLOR



PROJECT # 2017-053
DATE: 11/06/2019
REVISIONS
PLAN REVIEW 01.24.2020
PLAN REVIEW 03.13.2020
PLAN REVIEW 04.24.2020
PLAN REVIEW 08.10.2020
PLAN REVIEW 09.17.2020
PLAN REVIEW 10.16.2020
PLAN REVIEW 11.25.2020
PLAN REVIEW 03.26.2021
PLAN REVIEW 07.15.2021
COORDINATION 08.27.2021
COORDINATION 11.05.2021
COORDINATION 12.10.2021

AEGIS
MIXED-USE DEVELOPMENT
312 E EVERGREEN BOULEVARD, VANCOUVER, WA 98660

SHEET:



B
E3.04

GENERAL POWER NOTES:

- ALL PLANS ARE CONSIDERED DIAGRAMMATICAL. THEREFORE ALL EQUIPMENT SIZES AND DEVICE LOCATIONS ARE APPROXIMATE AND SUBJECT TO FIELD CONDITIONS AND PRODUCT APPROVAL.
- ELECTRICAL CONTRACTOR TO PROVIDE THERMOSTATS NOT SUPPLIED BY MECHANICAL CONTRACTOR. CONSULT MECHANICAL PLANS FOR ADDITIONAL INFORMATION.
- ELECTRICAL CONTRACTOR SHALL PROVIDE INSTALLATION AND FINAL CONNECTION OF THERMOSTATS. CONSULT MECHANICAL CONTRACTOR FOR EXACT REQUIREMENTS PRIOR TO ROUGH IN.
- REFER TO INTERIOR DECORATOR AND/OR ARCHITECTURAL DRAWINGS FOR DIMENSIONED LOCATION(S) AND ELEVATIONS OF FIXTURES & DEVICES. OTHER DEVICES SHOWN ON THE ELECTRICAL PLANS AND NOT INDICATED ON THE DECORATOR'S OR ARCHITECT'S DRAWINGS, SHALL BE INSTALLED AT STANDARD MOUNTING HEIGHT AS INDICATED THE SYMBOL LIST.
- REFER TO ENLARGED TYPICAL UNIT PLANS (E4 SERIES SHEETS) FOR TYPICAL POWER & LIGHTING LAYOUTS FOR THE APARTMENT UNITS.
- ELECTRICAL EQUIPMENT SHOWN IN THE ELECTRICAL ROOMS IS APPROXIMATE, BASED ON TYPICAL PRODUCTS. CONTRACTOR SHALL VERIFY ANY SUBMITTED EQUIPMENT WILL FIT WITHIN THE SPACE PROVIDED, PRIOR TO PRODUCT SUBMITTAL REVIEW.
- CONSULT ARCHITECTURAL AND/OR INTERIOR DECORATOR PLANS FOR EXACT RECEPTACLE LOCATION IN THE COMMUNITY AREAS, SUCH AS THE LOBBY, CLUB ROOM, LEASE OFFICE, ETC.
- THERE SHALL BE NO SURFACE MOUNTED FIXTURES OR PATHWAYS (CONDUIT, ETC.) IN ANY PUBLICLY ACCESSIBLE SPACES, INCLUDING STAIRWELLS AND EXIT PASSAGEWAYS WITHOUT PRIOR APPROVAL BY OWNER AND ARCHITECT. ROUTE ALL PATHWAYS WITHIN STUD CAVITIES OR ABOVE FINISHED CEILINGS.
- "SOLAR READY" WORK FOR FUTURE PHOTOVOLTAIC ARRAY SHALL BE PER THE ELECTRICAL REQUIREMENTS AS DEFINED BY THE WASHINGTON STATE ADMINISTRATION CODE, TITLE 51, CHAPTER 51, SECTION 60106.

KEYED NOTES:

- ROUTE (2) EMPTY 3 1/2" CONDUIT WITH PULL STRING, FROM MC1 UNDER SLAB AND STUB-UP INTO LEASE SPACE FOR TENANT SUPPLIED BRANCH PANEL AND CAP OFF.
- EXHAUST FAN TO BE TIED INTO LIGHTING CIRCUIT FOR THIS AREA.
- GENERATOR DISCONNECT. SEE ONE-LINE DIAGRAM ON SHEET E1.11.
- PROVIDE ONE 20A, 120V, 1P CIRCUIT FOR GENERATOR REMOTE ANNUNCIATOR. FED FROM PANEL E1, CKT 27.
- 20A, 120V, 1P POWER CONNECTION FOR BLADE SIGNS. CIRCUIT AS INDICATED VIA PHOTOCELL & TIMECLOCK. MOUNT JUNCTION BOX TIGHT TO CEILING (AT BUILDING INTERIOR), COORDINATING EXACT LOCATION WITH SIGN INSTALLER'S SLEEVE AND PER ARCHITECT'S DIRECTION AT EACH LOCATION.
- PROVIDE ONE 20A, 120V, 1P CIRCUIT FROM PANEL M1, CKT 24 FOR BUILDING ENTRY ACCESS CONTROL SYSTEM AND PROVIDE ROUGH IN AND WIRING TO ACCESS POINTS LOCATED ON PLANS. CONSULT WITH LOW VOLTAGE SYSTEMS INSTALLER AND THE 'T' SERIES SHEETS FOR ADDITIONAL INFORMATION.
- ENTRY ACCESS POINT.
- APARTMENT CALL DIRECTORY.
- VERIFY ELEVATOR EQUIPMENT LOCATION AND ELECTRICAL REQUIREMENTS WITH ARCHITECT AND/OR ELEVATOR PROVIDER.
- PROVIDE ONE 20A, 120V, 1P CIRCUIT FROM PANEL 'M1' FOR AUTOMATIC DOOR OPENERS.
- PROVIDE ONE 20A, 120V, 1P CIRCUIT FROM PANEL 'H1' FOR DAS SYSTEM.
- PACKAGE CONCERGE SYSTEM. MOUNT DUPLEX RECEPTACLES AT 76" AFF.
- PROVIDE ONE 20A, 120V, 1P CIRCUIT FOR A/V SYSTEM CONTROL, FROM PANEL H1, CKT 31. CONSULT INTERIORS GROUP FOR EXACT LOCATION. COORDINATE WITH SYSTEM INSTALLER FOR EXACT REQUIREMENTS.
- ELECTRICAL SERVICE METER ROOMS SHALL HAVE OUTWARD SWING DOORS EQUIPPED WITH PANIC HARDWARE. PROVIDE A KEY BOX AT THE EXTERIOR FOR CLARK PUBLIC UTILITIES 24/7 ACCESS.
- CONSULT MECHANICAL AND/OR PLUMBING CONTRACTOR FOR EXACT ELECTRICAL REQUIREMENTS OF THE DRINKING FOUNTAIN, IF ANY AND PROVIDE CIRCUIT FROM PANE H1.
- PER WASHINGTON STATE ENERGY CODE C405.10, AT LEAST 50% OF THE RECEPTACLES IN THIS SPACE SHALL BE CONTROLLED. RECEPTACLES NOTED WITH '*' SHALL BE CONTROLLED VIA OCCUPANCY SENSOR AND SHALL "TURN OFF" AFTER A MINIMUM OF 30 MINUTES OF IN-ACTIVITY WITHIN THE SPACE. PROVIDE APPROPRIATE IDENTIFICATION OF EACH CONTROLLED RECEPTACLE. REFER TO THE PANEL SCHEDULES ON E1.16 FOR ADDITIONAL INFORMATION ON WHICH CIRCUIT IS TO BE THE CONTROLLED CIRCUIT.
- LOW VOLTAGE/COMMUNICATIONS SYSTEM DEMARCATION BOARD(S). COORDINATE LOCATIONS AND ELECTRICAL POWER REQUIREMENTS WITH THE TELECOM PLANS ('T' SERIES SHEETS) AND LOW VOLTAGE SYSTEMS INSTALLERS, AND PROVIDE ROUGH IN AND/OR FINAL ELECTRICAL POWER CONNECTIONS & DEVICES. REFER PANEL 'M1' SCHEDULE ON E1.16 FOR CIRCUITS.
- CEILING MOUNTED 20A DUPLEX RECEPTACLE FOR SECURITY CAMERA. CONSULT ARCHITECT FOR ADDITIONAL INFORMATION.
- SHAFT FOR THE ROUTING OF ELECTRICAL FEEDERS FROM TENANT METERS TO RESIDENTIAL UNITS.
- HORIZONTAL RECEPTACLE IN BANQUETTE FACE. REFER TO THE ARCHITECT AND INTERIOR DECORATOR PLANS FOR ADDITIONAL INFORMATION. PROVIDE WITH TYPES A & C USB PORTS, LEVITON T5633-T OR APPROVED EQUAL.
- PROVIDE ONE 20A, 120V, 1P CIRCUIT FROM THE EMERGENCY PANEL E1, CKTS 19 & 21 FOR ELEVATOR SMOKE CURTAINS. SMOKE CURTAINS ARE TO BE SMOKE GUARD SYSTEM MODEL 200 AND SHALL BE INSTALLED AT EACH ELEVATOR LOBBY. ELECTRICAL CONTRACTOR SHALL BE RESPONSIBLE TO COORDINATE INSTALLATION WITH THE EQUIPMENT PROVIDER/INSTALLER FOR ALL ELECTRICAL REQUIREMENTS PRIOR TO ROUGH IN. EACH SMOKE CURTAIN SHALL BE INTERLINKED WITH THE NEAREST SMOKE DETECTOR AT EACH LOCATION.
- PROVIDE ONE 20A, 120V, 1P CIRCUIT FROM PANEL H1, CKT 17 FOR THE APARTMENT ENTRY SYSTEM PRIMARY CONTROL PANEL AND PROVIDE ROUGH IN AND WIRING, AS NEEDED, TO EACH UNIT ENTRY. CONSULT WITH LOW VOLTAGE SYSTEMS INSTALLER AND THE 'T' SERIES SHEETS FOR ADDITIONAL INFORMATION.
- PROVIDE ONE 20A, 120V, 1P CIRCUIT FROM PANEL H1, CKT 34 FOR THE SECURITY SYSTEM PANEL AND PROVIDE ROUGH IN AND WIRING, AS NEEDED. CONSULT WITH LOW VOLTAGE SYSTEMS INSTALLER AND THE 'T' SERIES SHEETS FOR ADDITIONAL INFORMATION.
- PROVIDE ONE 20A, 120V, 1P CIRCUIT FROM PANEL E1, CKT 23 FOR THE FIRE ALARM CONTROL PANEL. CONSULT WITH LOW VOLTAGE SYSTEMS INSTALLER AND THE 'T' SERIES SHEETS FOR ADDITIONAL INFORMATION.
- PROVIDE EMERGENCY SHUTOFF CONTROLS FOR GAS APPLIANCES. COORDINATE INSTALLATION WITH MECHANICAL CONTRACTOR. CIRCUIT FROM PANEL 'E1'. SEE DETAIL 5/E1.22 FOR EMERGENCY SHUFF-OFF DIAGRAM.
- AREA OF REFUGE PANEL. CONSULT FIRE ALARM PLANS ('T' SERIES SHEETS) AND PROVIDE ROUGH IN AS NEEDED. PROVIDE POWER CONNECTION FROM PANEL E1.
- PROVIDE ROUGH IN, AS NEEDED, FOR FIRE ALARM REMOTE ANNUNCIATION PANEL.
- PROVIDE ROUGH IN, AS NEEDED, FOR AUDIO SYSTEM CONTROLS.
- PROVIDE ROUGH IN, AS NEEDED, FOR WIFI SYSTEM. CIRCUIT FROM PANEL 'H1'.
- CONSULT ARCHITECT AND/OR MECHANICAL PLANS FOR ADDITIONAL INFORMATION REGARDING THE FIREPLACE. PROVIDE ELECTRICAL CONNECTION(S) AS NEEDED FROM PANEL 'H1', CKT 33. PROVIDE 120V TWIST-TIMER SWITCH (MAX. 60 MINUTES "NO HOLD") FOR FIREPLACE IGNITOR CONTROLS. INTERCONNECT WITH POWER VENT FAN LOCATED ON ROOF.
- PROVIDE TWO 20A, 120V CIRCUITS, FROM PANEL 'H1' FOR WALL MOUNTED FANS, PROVIDED BY OTHERS. CONSULT INTERIOR DECORATOR FOR EXACT POWER REQUIREMENTS AND MOUNTING HEIGHTS. PROVIDE CONTROL SWITCH PER MANUFACTURER'S/DECORATOR'S DIRECTION.
- PROVIDE ONE 20A, 120V CIRCUIT, FROM PANEL 'M1' FOR IRRIGATION CONTROLS. COORDINATE WITH LANDSCAPING FOR EXACT POWER REQUIREMENTS AND PREFERRED LOCATION PRIOR TO ROUGH IN.
- PROVIDE TWO 1-1/2" EMPTY CONDUITS W/ PULL STRING, ROUTED FROM THE ELECTRICAL ROOM TO THE ROOF FOR PV SOLAR SYSTEM PROVIDED AND INSTALLED BY OTHERS. COORDINATE WITH THE STRUCTURAL ENGINEER FOR THE ROUTING OF THE CONDUITS UP THROUGH THE BUILDING PRIOR TO ANY WORK.
- CONSULT INTERIORS PLANS TO VERIFY EXACT LOCATION OF FLOOR BOX DEVICES PRIOR TO ROUGH IN.
- PROVIDE ONE 20A, 120V, 1P CIRCUIT FROM PANEL H1, CKT 40 TO J-BOX BEHIND FACE OF CANOPY FOR BUILDING SIGNAGE BY OTHERS. REFER TO ARCHITECTURAL PLANS FOR EXACT LOCATION. SIGNS TO BE CONTROLLED VIA PHOTOCELL, ALONG WITH BUILDING LIGHTS.
- METER LOCATION FOR PV SYSTEM. VERIFY AND COORDINATE WITH SYSTEM INSTALLER.
- PROVIDE ONE 20A, 120V, 1P CIRCUIT FROM PANEL H1, CKT 17 FOR OVERHEAD DOOR OPENER.

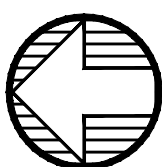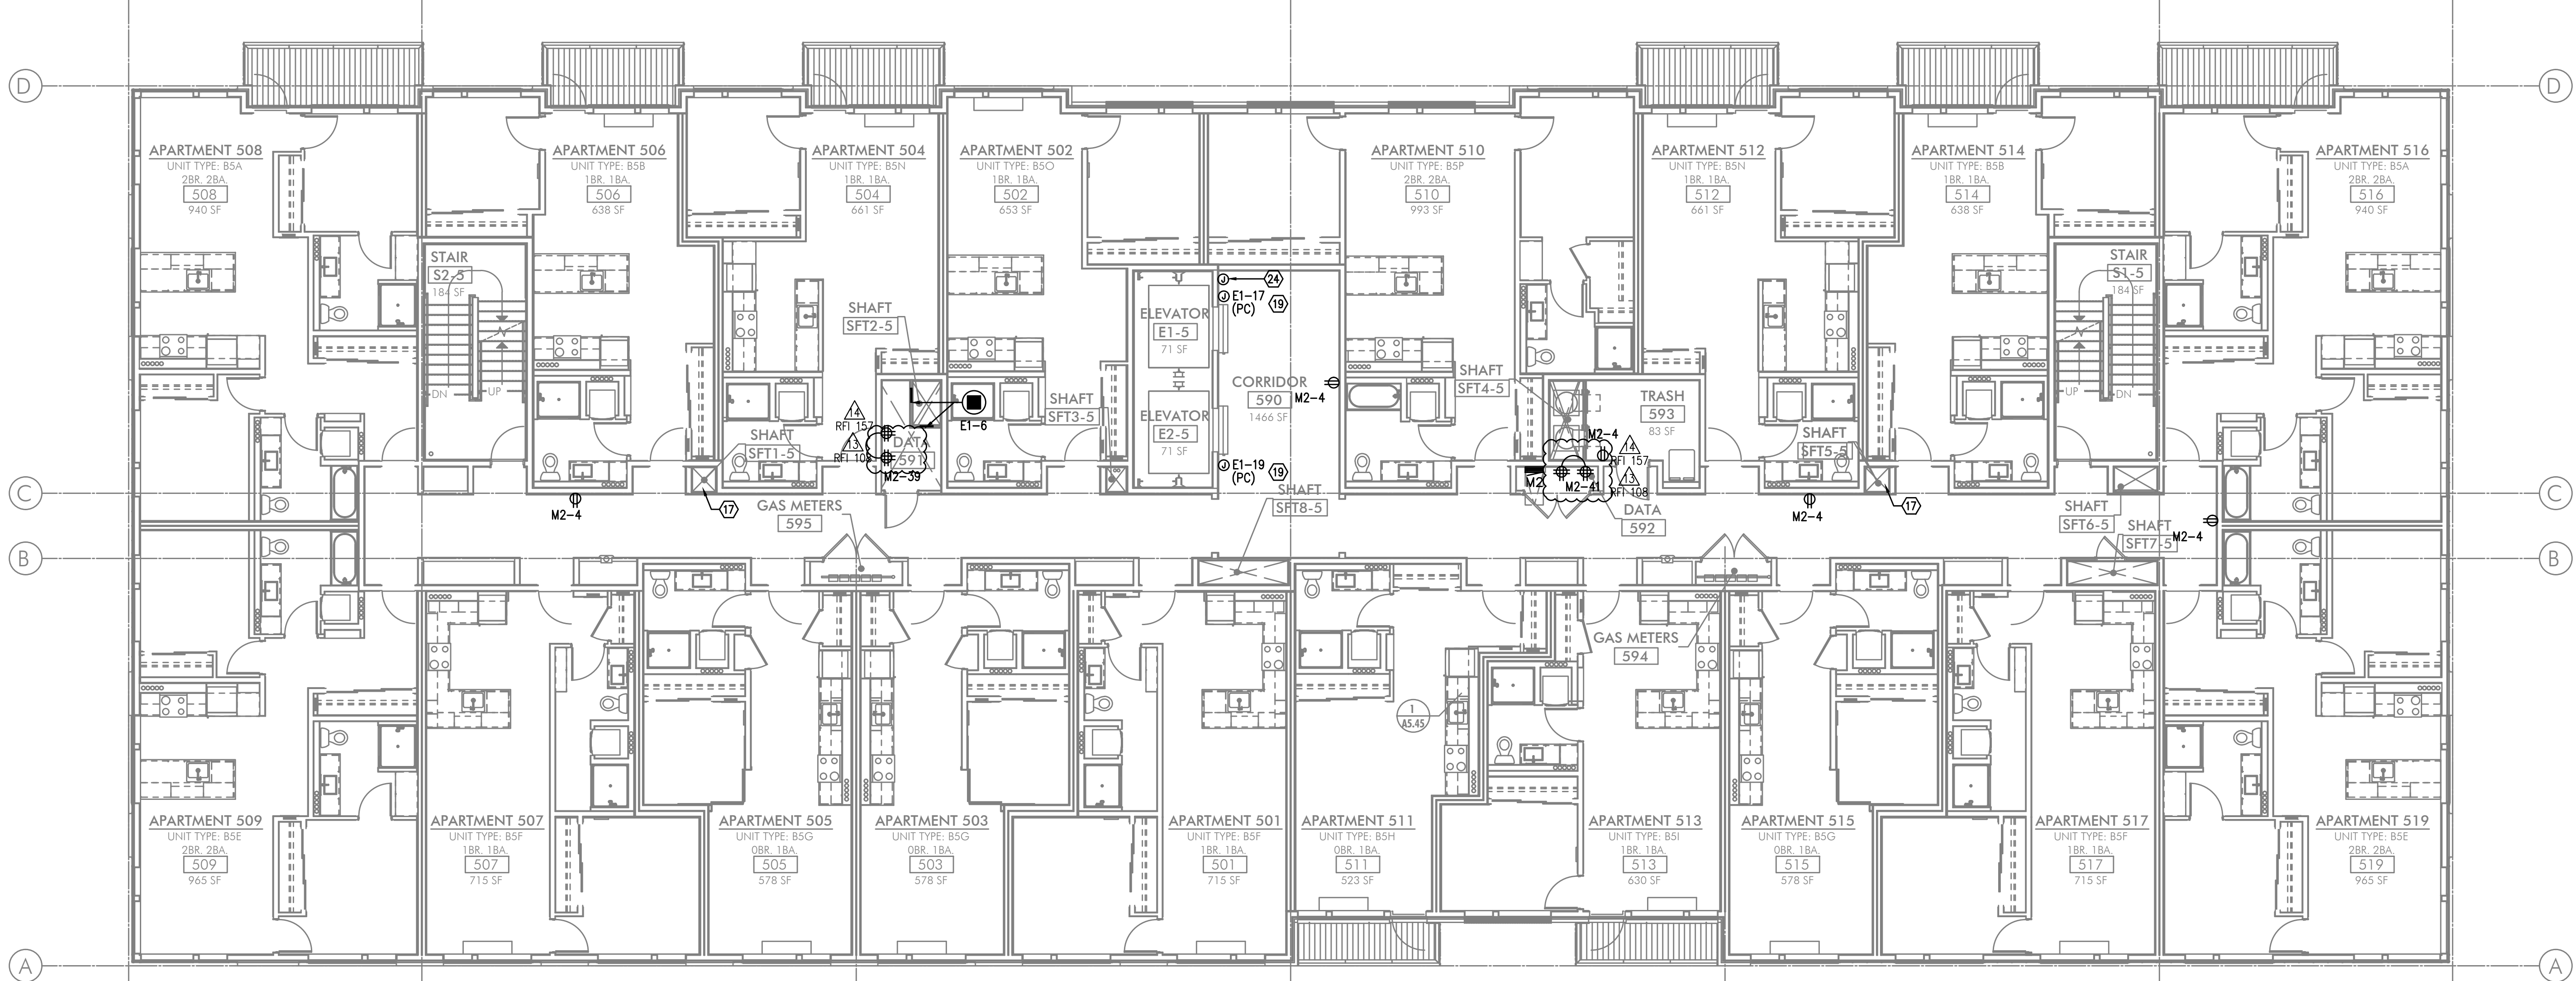

1 POWER PLAN - LEVEL 5
E3.05 SCALE: 1/8" = 1'-0"

MET
Consulting Engineers
2007 S.E. Ash St.
Portland, OR 97214
PHN: (503) 234-0548
FAX: (503) 234-0677
CONTACT: DENISE TAYLOR



PROJECT # 2017-053
DATE: 11/06/2019
REVISIONS
PLAN REVIEW 01.24.2020
PLAN REVIEW 03.13.2020
PLAN REVIEW 04.24.2020
PLAN REVIEW 08.10.2020
PLAN REVIEW 09.17.2020
PLAN REVIEW 10.16.2020
PLAN REVIEW 11.25.2020
PLAN REVIEW 03.26.2021
PLAN REVIEW 07.15.2021
COORDINATION 08.27.2021
COORDINATION 11.05.2021
COORDINATION 12.10.2021

AEGIS
MIXED-USE DEVELOPMENT
312 E EVERGREEN BOULEVARD, VANCOUVER, WA 98660

SHEET:


B
E3.05

GENERAL POWER NOTES:

- ALL PLANS ARE CONSIDERED DIAGRAMMATICAL. THEREFORE ALL EQUIPMENT SIZES AND DEVICE LOCATIONS ARE APPROXIMATE AND SUBJECT TO FIELD CONDITIONS AND PRODUCT APPROVAL.
- ELECTRICAL CONTRACTOR TO PROVIDE THERMOSTATS NOT SUPPLIED BY MECHANICAL CONTRACTOR. CONSULT MECHANICAL PLANS FOR ADDITIONAL INFORMATION.
- ELECTRICAL CONTRACTOR SHALL PROVIDE INSTALLATION AND FINAL CONNECTION OF THERMOSTATS. CONSULT MECHANICAL CONTRACTOR FOR EXACT REQUIREMENTS PRIOR TO ROUGH IN.
- REFER TO INTERIOR DECORATOR AND/OR ARCHITECTURAL DRAWINGS FOR DIMENSIONED LOCATION(S) AND ELEVATIONS OF FIXTURES & DEVICES. OTHER DEVICES SHOWN ON THE ELECTRICAL PLANS AND NOT INDICATED ON THE DECORATOR'S OR ARCHITECT'S DRAWINGS, SHALL BE INSTALLED AT STANDARD MOUNTING HEIGHT AS INDICATED THE SYMBOL LIST.
- REFER TO ENLARGED TYPICAL UNIT PLANS (E4 SERIES SHEETS) FOR TYPICAL POWER & LIGHTING LAYOUTS FOR THE APARTMENT UNITS.
- ELECTRICAL EQUIPMENT SHOWN IN THE ELECTRICAL ROOMS IS APPROXIMATE, BASED ON TYPICAL PRODUCTS. CONTRACTOR SHALL VERIFY ANY SUBMITTED EQUIPMENT WILL FIT WITHIN THE SPACE PROVIDED, PRIOR TO PRODUCT SUBMITTAL REVIEW.
- CONSULT ARCHITECTURAL AND/OR INTERIOR DECORATOR PLANS FOR EXACT RECEPTACLE LOCATION IN THE COMMUNITY AREAS, SUCH AS THE LOBBY, CLUB ROOM, LEASE OFFICE, ETC.
- THERE SHALL BE NO SURFACE MOUNTED FIXTURES OR PATHWAYS (CONDUIT, ETC.) IN ANY PUBLICLY ACCESSIBLE SPACES, INCLUDING STAIRWELLS AND EXIT PASSAGEWAYS WITHOUT PRIOR APPROVAL BY OWNER AND ARCHITECT. ROUTE ALL PATHWAYS WITHIN STUD CAVITIES OR ABOVE FINISHED CEILINGS.
- "SOLAR READY" WORK FOR FUTURE PHOTOVOLTAIC ARRAY SHALL BE PER THE ELECTRICAL REQUIREMENTS AS DEFINED BY THE WASHINGTON STATE ADMINISTRATION CODE, TITLE 51, CHAPTER 51, SECTION 60106.

KEYED NOTES:

- ROUTE (2) EMPTY 3 1/2" CONDUIT WITH PULL STRING, FROM MC1 UNDER SLAB AND STUB-UP INTO LEASE SPACE FOR TENANT SUPPLIED BRANCH PANEL AND CAP OFF.
- EXHAUST FAN TO BE TIED INTO LIGHTING CIRCUIT FOR THIS AREA.
- GENERATOR DISCONNECT. SEE ONE-LINE DIAGRAM ON SHEET E1.11.
- PROVIDE ONE 20A, 120V, 1P CIRCUIT FOR GENERATOR REMOTE ANNUNCIATOR. FED FROM PANEL E1, CKT 27.
- 20A, 120V, 1P POWER CONNECTION FOR BLADE SIGNS. CIRCUIT AS INDICATED VIA PHOTOCELL & TIMELOCK. MOUNT JUNCTION BOX TIGHT TO CEILING (AT BUILDING INTERIOR), COORDINATING EXACT LOCATION WITH SIGN INSTALLER'S SLEEVE AND PER ARCHITECT'S DIRECTION AT EACH LOCATION.
- PROVIDE ONE 20A, 120V, 1P CIRCUIT FROM PANEL M1, CKT 24 FOR BUILDING ENTRY ACCESS CONTROL SYSTEM AND PROVIDE ROUGH IN AND WIRING TO ACCESS POINTS LOCATED ON PLANS. CONSULT WITH LOW VOLTAGE SYSTEMS INSTALLER AND THE 'T' SERIES SHEETS FOR ADDITIONAL INFORMATION.
- ENTRY ACCESS POINT.
- APARTMENT CALL DIRECTORY.
- VERIFY ELEVATOR EQUIPMENT LOCATION AND ELECTRICAL REQUIREMENTS WITH ARCHITECT AND/OR ELEVATOR PROVIDER.
- PROVIDE ONE 20A, 120V, 1P CIRCUIT FROM PANEL 'M1' FOR AUTOMATIC DOOR OPENERS.
- PROVIDE ONE 20A, 120V, 1P CIRCUIT FROM PANEL 'H1' FOR DAS SYSTEM.
- PACKAGE CONCERGE SYSTEM. MOUNT DUPLEX RECEPTACLES AT 76" AFF.
- PROVIDE ONE 20A, 120V, 1P CIRCUIT FOR A/V SYSTEM CONTROL, FROM PANEL H1, CKT 31. CONSULT INTERIORS GROUP FOR EXACT LOCATION. COORDINATE WITH SYSTEM INSTALLER FOR EXACT REQUIREMENTS.
- ELECTRICAL SERVICE METER ROOMS SHALL HAVE OUTWARD SWING DOORS EQUIPPED WITH PANIC HARDWARE. PROVIDE A KEY BOX AT THE EXTERIOR FOR CLARK PUBLIC UTILITIES 24/7 ACCESS.
- CONSULT MECHANICAL AND/OR PLUMBING CONTRACTOR FOR EXACT ELECTRICAL REQUIREMENTS OF THE DRINKING FOUNTAIN, IF ANY AND PROVIDE CIRCUIT FROM PANE H1.
- PER WASHINGTON STATE ENERGY CODE C405.10, AT LEAST 50% OF THE RECEPTACLES IN THIS SPACE SHALL BE CONTROLLED. RECEPTACLES NOTED WITH '*' SHALL BE CONTROLLED VIA OCCUPANCY SENSOR AND SHALL "TURN OFF" AFTER A MINIMUM OF 30 MINUTES OF IN-ACTIVITY WITHIN THE SPACE. PROVIDE APPROPRIATE IDENTIFICATION OF EACH CONTROLLED RECEPTACLE. REFER TO THE PANEL SCHEDULES ON E1.16 FOR ADDITIONAL INFORMATION ON WHICH CIRCUIT IS TO BE THE CONTROLLED CIRCUIT.
- LOW VOLTAGE/COMMUNICATIONS SYSTEM DEMARCATION BOARD(S). COORDINATE LOCATIONS AND ELECTRICAL POWER REQUIREMENTS WITH THE TELECOM PLANS ('T' SERIES SHEETS) AND LOW VOLTAGE SYSTEMS INSTALLERS, AND PROVIDE ROUGH IN AND/OR FINAL ELECTRICAL POWER CONNECTIONS & DEVICES. REFER PANEL 'M1' SCHEDULE ON E1.16 FOR CIRCUITS.
- CEILING MOUNTED 20A DUPLEX RECEPTACLE FOR SECURITY CAMERA. CONSULT ARCHITECT FOR ADDITIONAL INFORMATION.
- SHAFT FOR THE ROUTING OF ELECTRICAL FEEDERS FROM TENANT METERS TO RESIDENTIAL UNITS.
- HORIZONTAL RECEPTACLE IN BANQUETTE FACE. REFER TO THE ARCHITECT AND INTERIOR DECORATOR PLANS FOR ADDITIONAL INFORMATION. PROVIDE WITH TYPES A & C USB PORTS, LEVITON T5633-T OR APPROVED EQUAL.
- PROVIDE ONE 20A, 120V, 1P CIRCUIT FROM THE EMERGENCY PANEL E1, CKTS 19 & 21 FOR ELEVATOR SMOKE CURTAINS. SMOKE CURTAINS ARE TO BE SMOKE GUARD SYSTEM MODEL 200 AND SHALL BE INSTALLED AT EACH ELEVATOR LOBBY. ELECTRICAL CONTRACTOR SHALL BE RESPONSIBLE TO COORDINATE INSTALLATION WITH THE EQUIPMENT PROVIDER/INSTALLER FOR ALL ELECTRICAL REQUIREMENTS PRIOR TO ROUGH IN. EACH SMOKE CURTAIN SHALL BE INTERLINKED WITH THE NEAREST SMOKE DETECTOR AT EACH LOCATION.
- PROVIDE ONE 20A, 120V, 1P CIRCUIT FROM PANEL H1, CKT 17 FOR THE APARTMENT ENTRY SYSTEM PRIMARY CONTROL PANEL AND PROVIDE ROUGH IN AND WIRING, AS NEEDED, TO EACH UNIT ENTRY. CONSULT WITH LOW VOLTAGE SYSTEMS INSTALLER AND THE 'T' SERIES SHEETS FOR ADDITIONAL INFORMATION.
- PROVIDE ONE 20A, 120V, 1P CIRCUIT FROM PANEL H1, CKT 34 FOR THE SECURITY SYSTEM PANEL AND PROVIDE ROUGH IN AND WIRING, AS NEEDED. CONSULT WITH LOW VOLTAGE SYSTEMS INSTALLER AND THE 'T' SERIES SHEETS FOR ADDITIONAL INFORMATION.
- PROVIDE ONE 20A, 120V, 1P CIRCUIT FROM PANEL E1, CKT 23 FOR THE FIRE ALARM CONTROL PANEL. CONSULT WITH LOW VOLTAGE SYSTEMS INSTALLER AND THE 'T' SERIES SHEETS FOR ADDITIONAL INFORMATION.
- PROVIDE EMERGENCY SHUTOFF CONTROLS FOR GAS APPLIANCES. COORDINATE INSTALLATION WITH MECHANICAL CONTRACTOR. CIRCUIT FROM PANEL 'E1'. SEE DETAIL 5/E1.22 FOR EMERGENCY SHUFF-OFF DIAGRAM.
- AREA OF REFUGE PANEL. CONSULT FIRE ALARM PLANS ('T' SERIES SHEETS) AND PROVIDE ROUGH IN AS NEEDED. PROVIDE POWER CONNECTION FROM PANEL E1.
- PROVIDE ROUGH IN, AS NEEDED, FOR FIRE ALARM REMOTE ANNUNCIATION PANEL.
- PROVIDE ROUGH IN, AS NEEDED, FOR AUDIO SYSTEM CONTROLS.
- PROVIDE ROUGH IN, AS NEEDED, FOR WIFI SYSTEM. CIRCUIT FROM PANEL 'H1'.
- CONSULT ARCHITECT AND/OR MECHANICAL PLANS FOR ADDITIONAL INFORMATION REGARDING THE FIREPLACE. PROVIDE ELECTRICAL CONNECTION(S) AS NEEDED FROM PANEL 'H1', CKT 33. PROVIDE 120V TWIST-TIMER SWITCH (MAX. 60 MINUTES "NO HOLD") FOR FIREPLACE IGNITOR CONTROLS. INTERCONNECT WITH POWER VENT FAN LOCATED ON ROOF.
- PROVIDE TWO 20A, 120V CIRCUITS, FROM PANEL 'H1' FOR WALL MOUNTED FANS, PROVIDED BY OTHERS. CONSULT INTERIOR DECORATOR FOR EXACT POWER REQUIREMENTS AND MOUNTING HEIGHTS. PROVIDE CONTROL SWITCH PER MANUFACTURER'S/DECORATOR'S DIRECTION.
- PROVIDE ONE 20A, 120V CIRCUIT, FROM PANEL 'M1' FOR IRRIGATION CONTROLS. COORDINATE WITH LANDSCAPING FOR EXACT POWER REQUIREMENTS AND PREFERRED LOCATION PRIOR TO ROUGH IN.
- PROVIDE TWO 1-1/2" EMPTY CONDUITS W/ PULL STRING, ROUTED FROM THE ELECTRICAL ROOM TO THE ROOF FOR PV SOLAR SYSTEM PROVIDED AND INSTALLED BY OTHERS. COORDINATE WITH THE STRUCTURAL ENGINEER FOR THE ROUTING OF THE CONDUITS UP THROUGH THE BUILDING PRIOR TO ANY WORK.
- CONSULT INTERIORS PLANS TO VERIFY EXACT LOCATION OF FLOOR BOX DEVICES PRIOR TO ROUGH IN.
- PROVIDE ONE 20A, 120V, 1P CIRCUIT FROM PANEL H1, CKT 40 TO J-BOX BEHIND FACE OF CANOPY FOR BUILDING SIGNAGE BY OTHERS. REFER TO ARCHITECTURAL PLANS FOR EXACT LOCATION. SIGNS TO BE CONTROLLED VIA PHOTOCELL, ALONG WITH BUILDING LIGHTS.
- METER LOCATION FOR PV SYSTEM. VERIFY AND COORDINATE WITH SYSTEM INSTALLER.
- PROVIDE ONE 20A, 120V, 1P CIRCUIT FROM PANEL H1, CKT 17 FOR OVERHEAD DOOR OPENER.

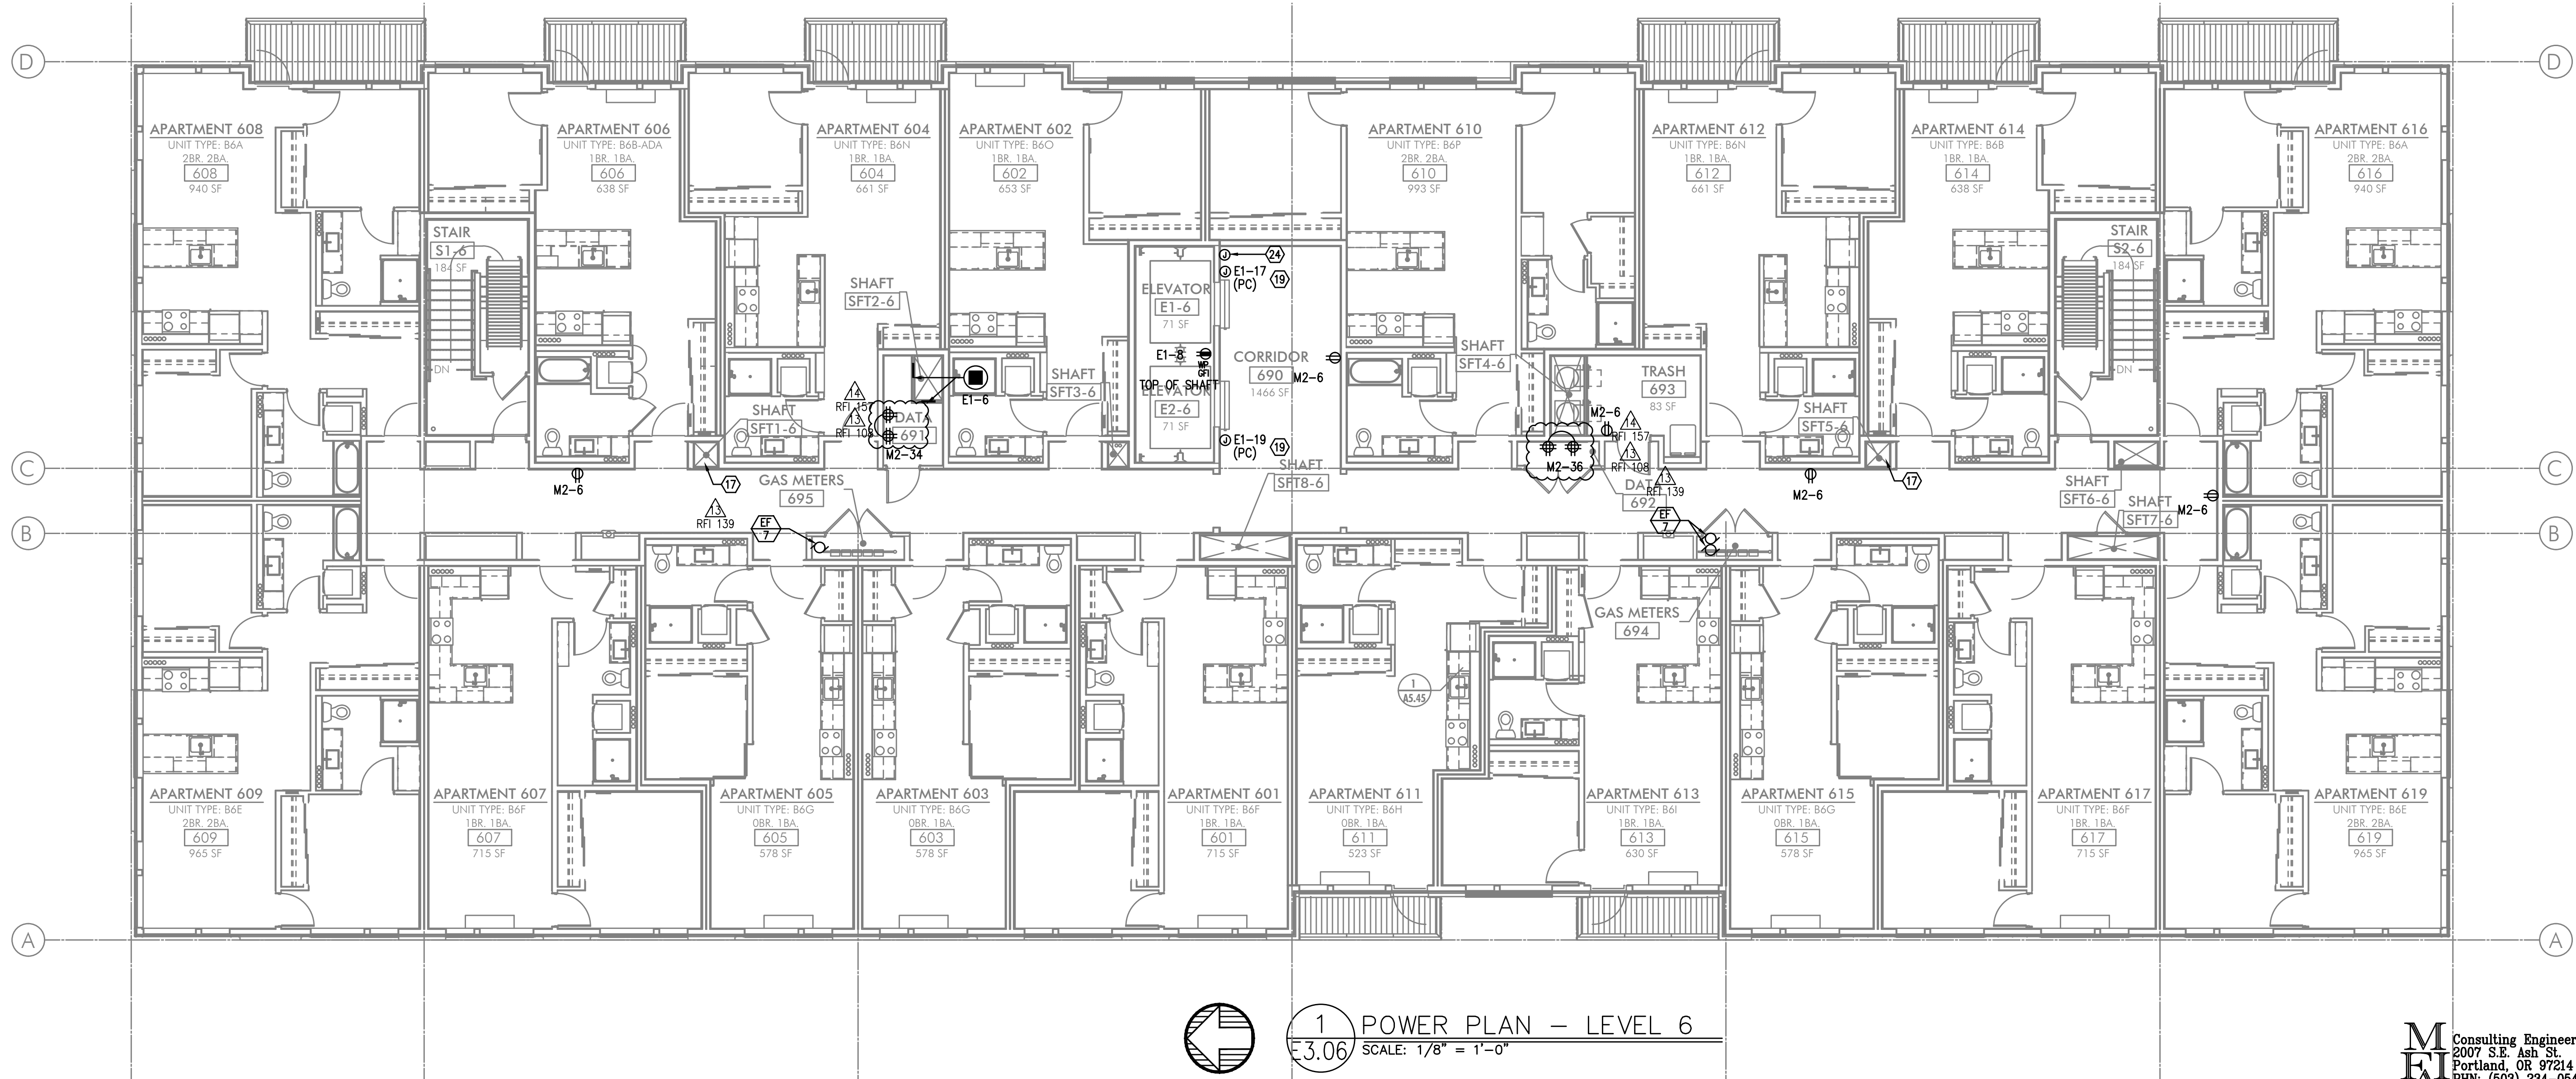

PROJECT # 2017-053
 DATE: 11/06/2019
 REVISIONS
 PLAN REVIEW 01.24.2020
 PLAN REVIEW 03.13.2020
 PLAN REVIEW 04.24.2020
 PLAN REVIEW 08.10.2020
 PLAN REVIEW 09.17.2020
 PLAN REVIEW 10.16.2020
 PLAN REVIEW 11.25.2020
 PLAN REVIEW 03.26.2021
 PLAN REVIEW 07.15.2021
 COORDINATION 08.27.2021
 COORDINATION 11.05.2021
 COORDINATION 12.10.2021

AEGIS
MIXED-USE DEVELOPMENT
 312 E EVERGREEN BOULEVARD, VANCOUVER, WA 98660



SHEET:

B
E3.06

MEFA
 Consulting Engineers
 2007 S.E. Ash St.
 Portland, OR 97214
 PHN: (503) 234-0548
 FAX: (503) 234-0677
 CONTACT: DENISE TAYLOR

C STREET

E. 12TH ST.

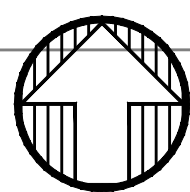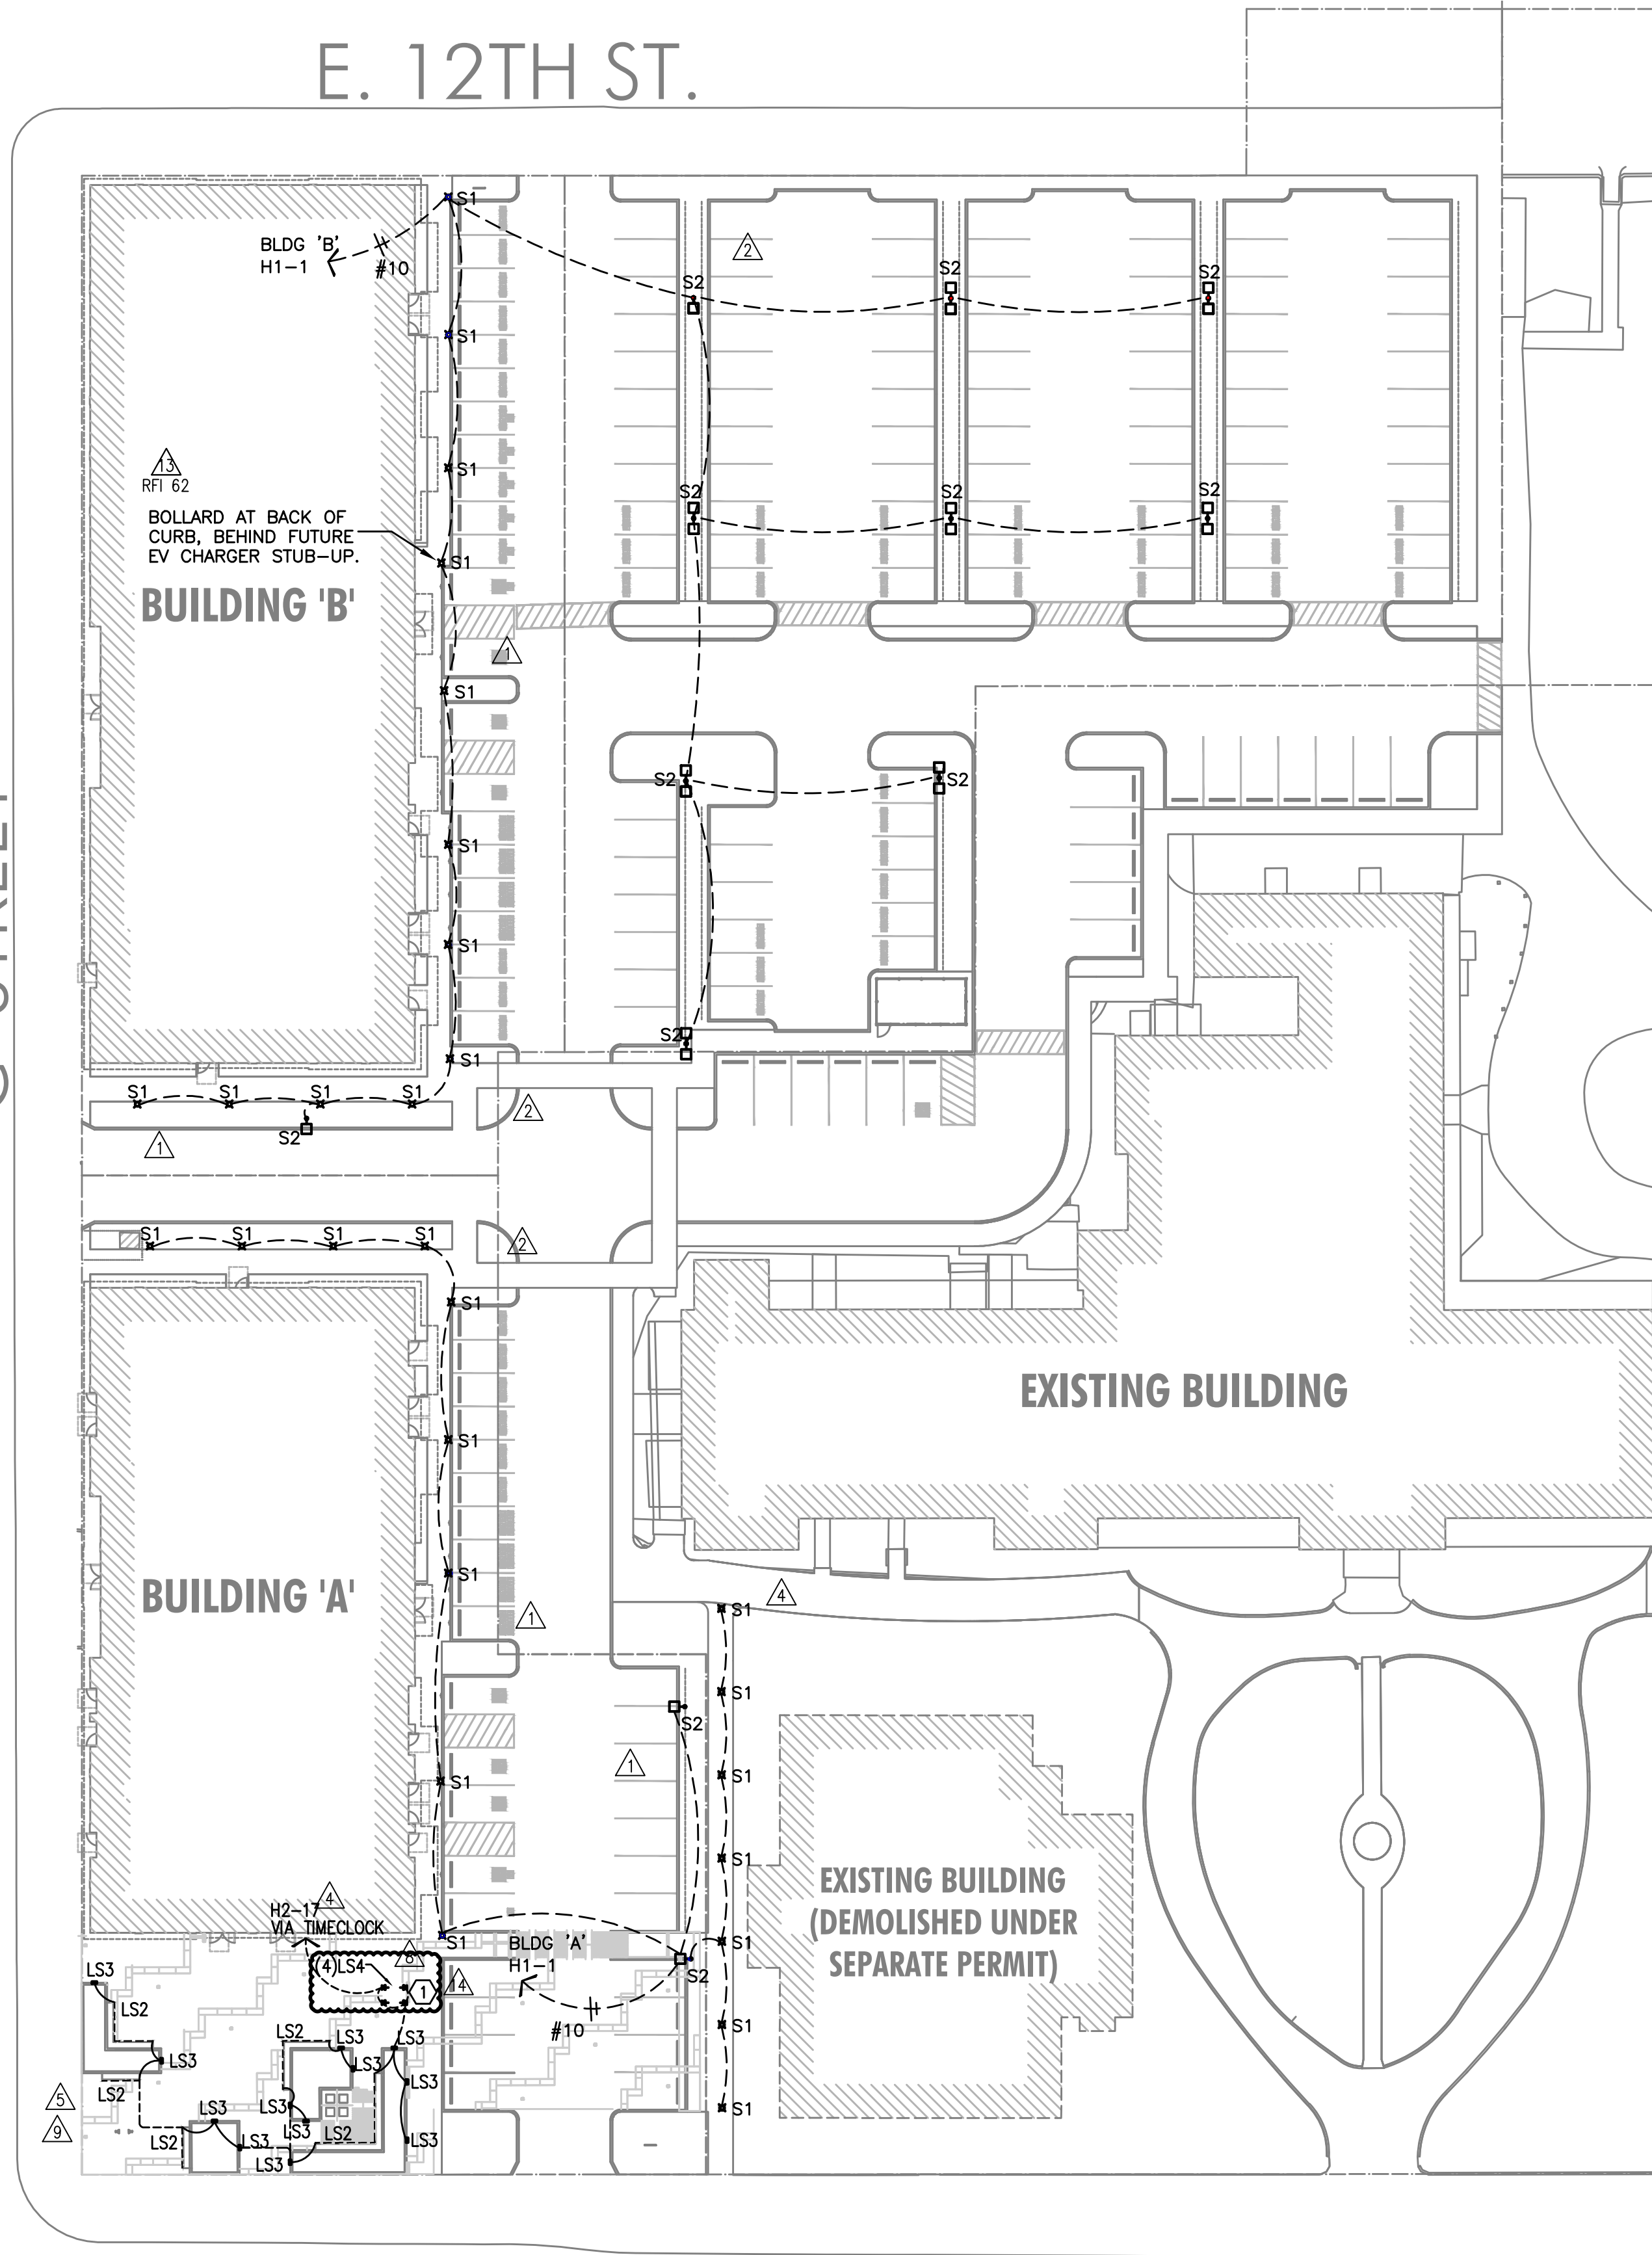


1 SITE LIGHTING PLAN
E1.02 SCALE: 1" = 30'-0"

GENERAL NOTES:

- ALL WORK SHALL BE PERFORMED IN ACCORDANCE WITH ALL APPLICABLE LOCAL, STATE AND NATION CODES.
- ALL PLANS ARE CONSIDERED DIAGRAMMATICAL. THEREFORE ALL EQUIPMENT SIZES AND DEVICE LOCATIONS ARE APPROXIMATE AND SUBJECT TO FIELD CONDITIONS AND PRODUCT APPROVAL.
- ELECTRICAL SERVICE ENTRANCE EQUIPMENT DESIGN IS BASED ON SIEMENS PRODUCTS. ACTUAL PRODUCTS INSTALLED MAY DIFFER IN SIZE AND CONFIGURATION AND SHALL BE DOCUMENTED IN FINAL PROJECT DOCUMENTS.
- COORDINATE WITH LOCAL UTILITY PROVIDER FOR EXACT SERVICE CONDUIT AND CONDUCTORS REQUIREMENTS.
- ALL UTILITY WORK SHALL BE DONE IN ACCORDANCE WITH CLARK PUBLIC UTILITIES ELECTRICAL SERVICE REQUIREMENTS.
- U.G. PRIMARY FEEDER SHALL HAVE A MINIMUM 48 INCH BURY.
- U.G. SECONDARY FEEDER SHALL HAVE A MINIMUM 36 INCH BURY.
- REFER TO SHEETS E1.11 & E1.14 FOR ONE-LINE DIAGRAM, LOAD SUMMARY INFORMATION AND TYPICAL FEEDER SCHEDULE.
- SECONDARY CONDUIT SWEEPS SHALL BE MINIMUM 60 INCH RADIUS WITH A MINIMUM OF 7'-0" STRAIGHT CONDUIT RUN BETWEEN SWEEPS.
- CONTRACTOR SHALL REVIEW CLARK PUBLIC UTILITIES ELECTRICAL SERVICE REQUIREMENTS PRIOR TO THE START OF ANY WORK.
- LOCATION AND INSTALLATION OF THE PRIMARY AND SECONDARY CONDUITS, TRANSFORMER, ETC. SHALL BE PROVIDED PER CLARK PUBLIC UTILITIES ELECTRICAL SERVICE REQUIREMENTS.
- CONTRACTOR SHALL REVIEW ALL PROJECT DOCUMENTS AND SPECIFICATIONS IN DETAIL AND REFER TO THE DOCUMENTS THROUGHOUT THE CONSTRUCTION.

KEYED LIGHTING NOTES:

1. PROVIDE WEATHER PROOF J-BOX, FLUSH WITH GRADE, FOR FUTURE LIGHT INSTALLATION. REFER TO LANDSCAPING PLANS FOR ADDITIONAL INFORMATION.

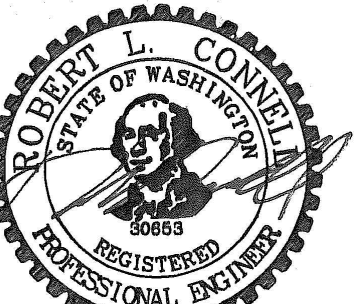

EXPIRES: July 5th, 2020


PROJECT # 2017-053
DATE: 11/06/2019
REVISIONS
PLAN REVIEW 01.24.2020
PLAN REVIEW 03.13.2020
PLAN REVIEW 04.24.2020
PLAN REVIEW 08.10.2020
PLAN REVIEW 09.17.2020
PLAN REVIEW 10.16.2020
PLAN REVIEW 11.25.2020
PLAN REVIEW 03.26.2021
PLAN REVIEW 07.15.2021
COORDINATION 08.27.2021
COORDINATION 11.05.2021
COORDINATION 12.10.2021

AEGIS
MIXED-USE DEVELOPMENT
312 E EVERGREEN BOULEVARD, VANCOUVER, WA 98660

M
F
I
A
INC.
Consulting Engineers
2007 S.E. Ash St.
Portland, OR 97214
PHN: (503) 234-0548
FAX: (503) 234-0677
CONTACT: DENISE TAYLOR
WWW.MFIA-ENG.COM


SHEET:

E1.02

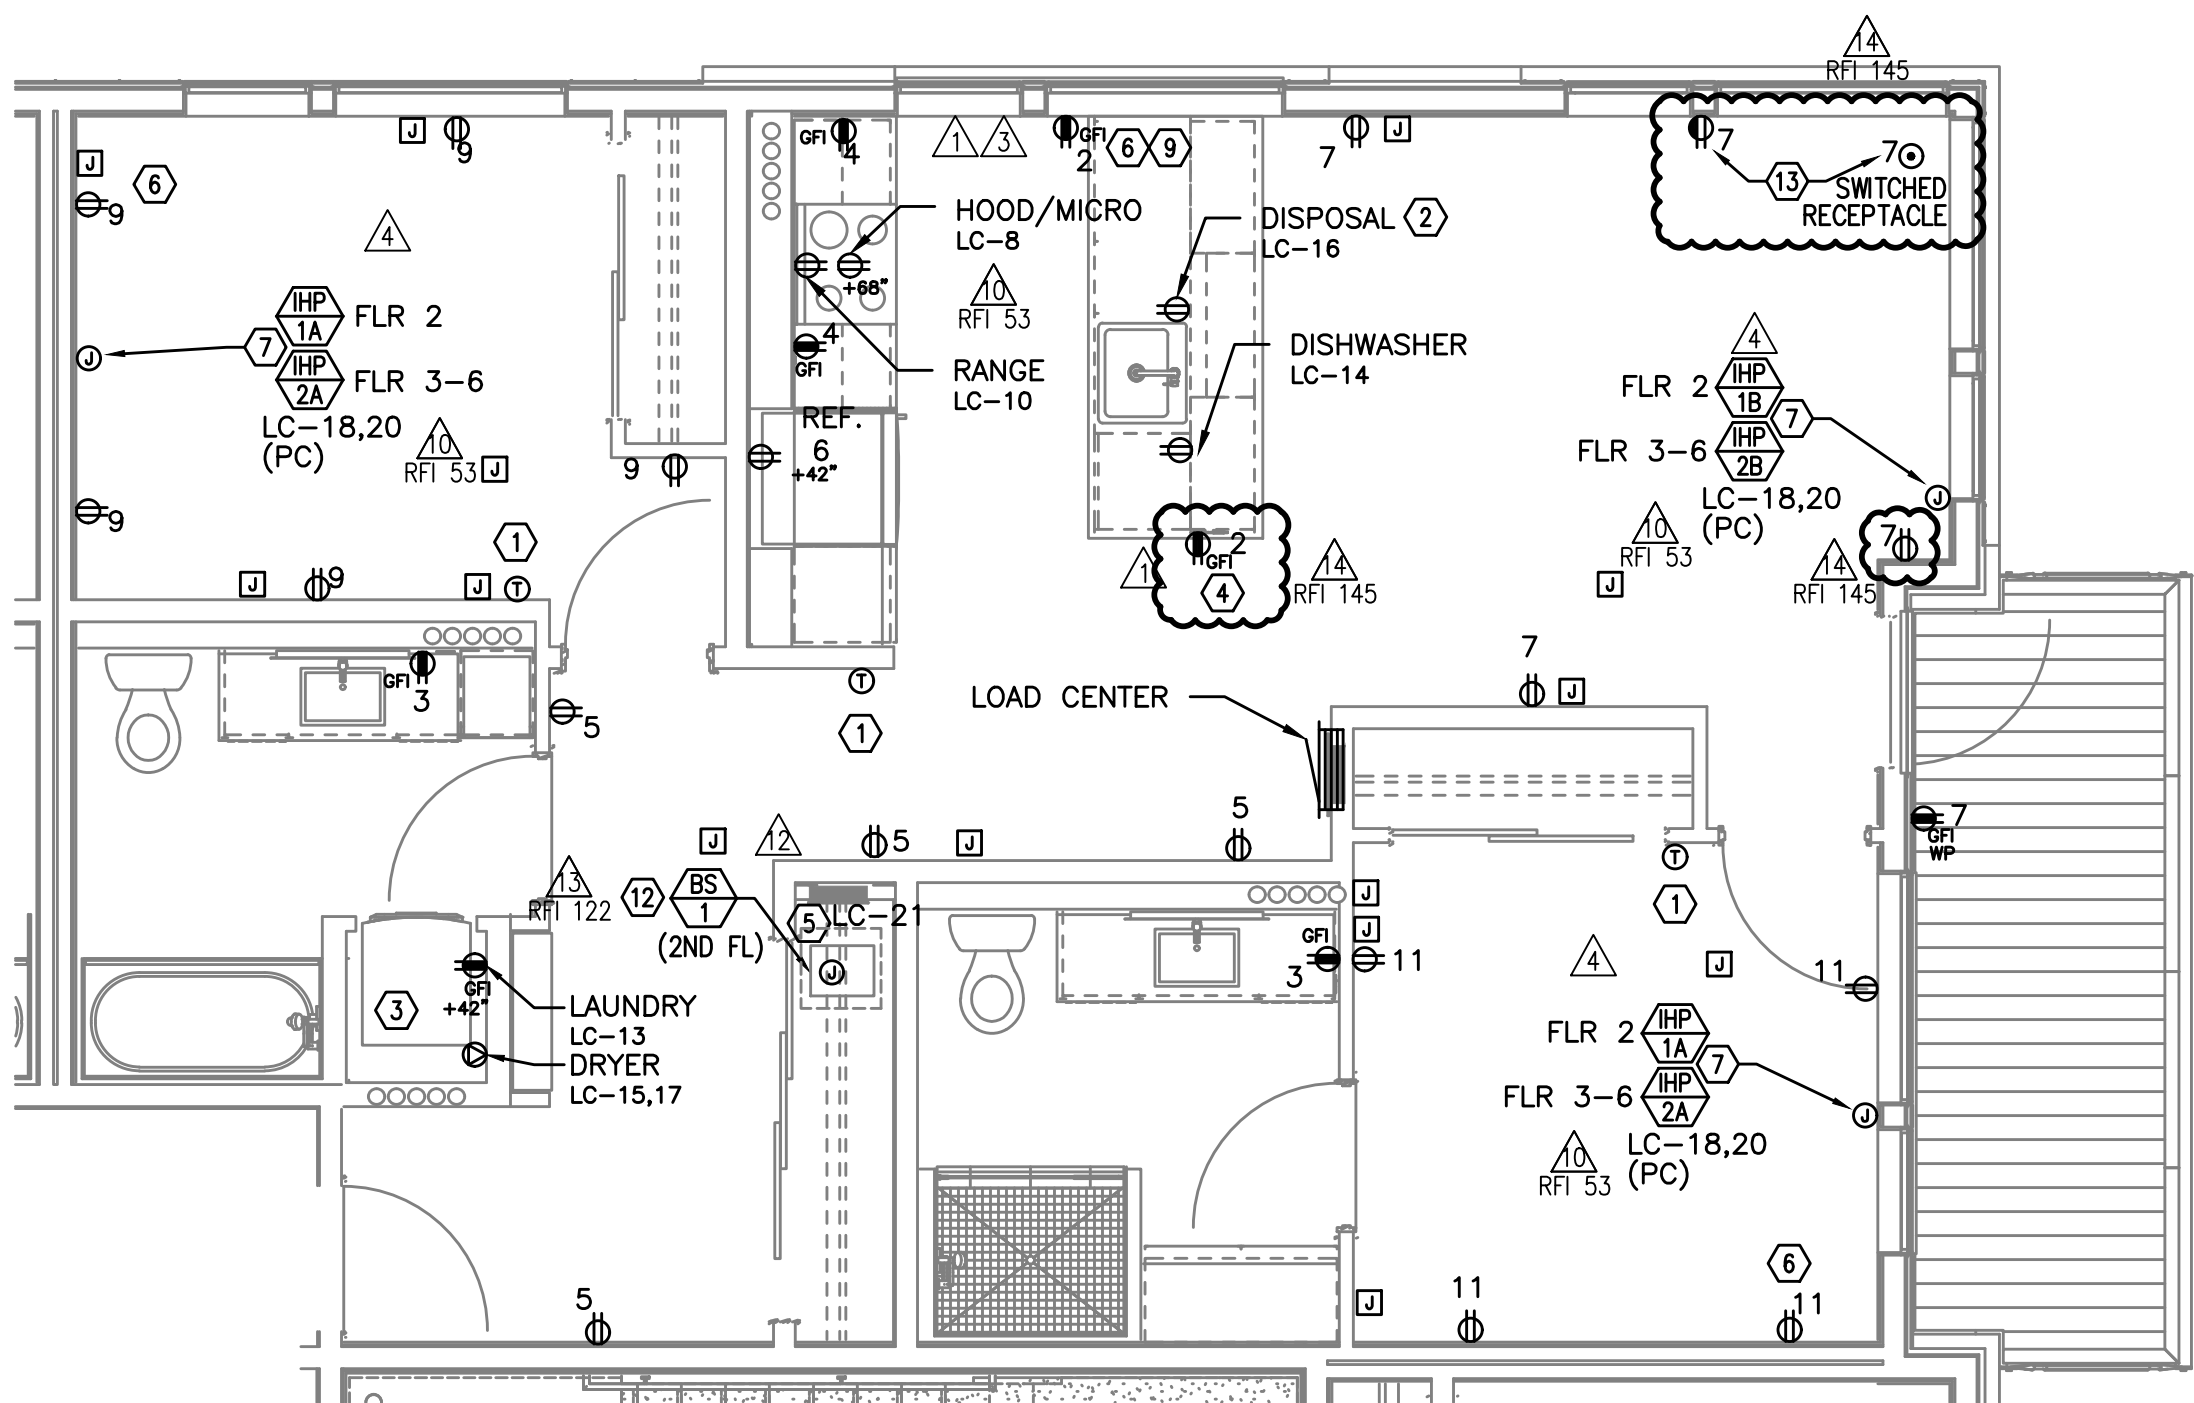


1
E4.11

TYPICAL UNIT TYPE A
2 BED/2 BATH – POWER PLAN
SCALE: 1/4" = 1'-0"

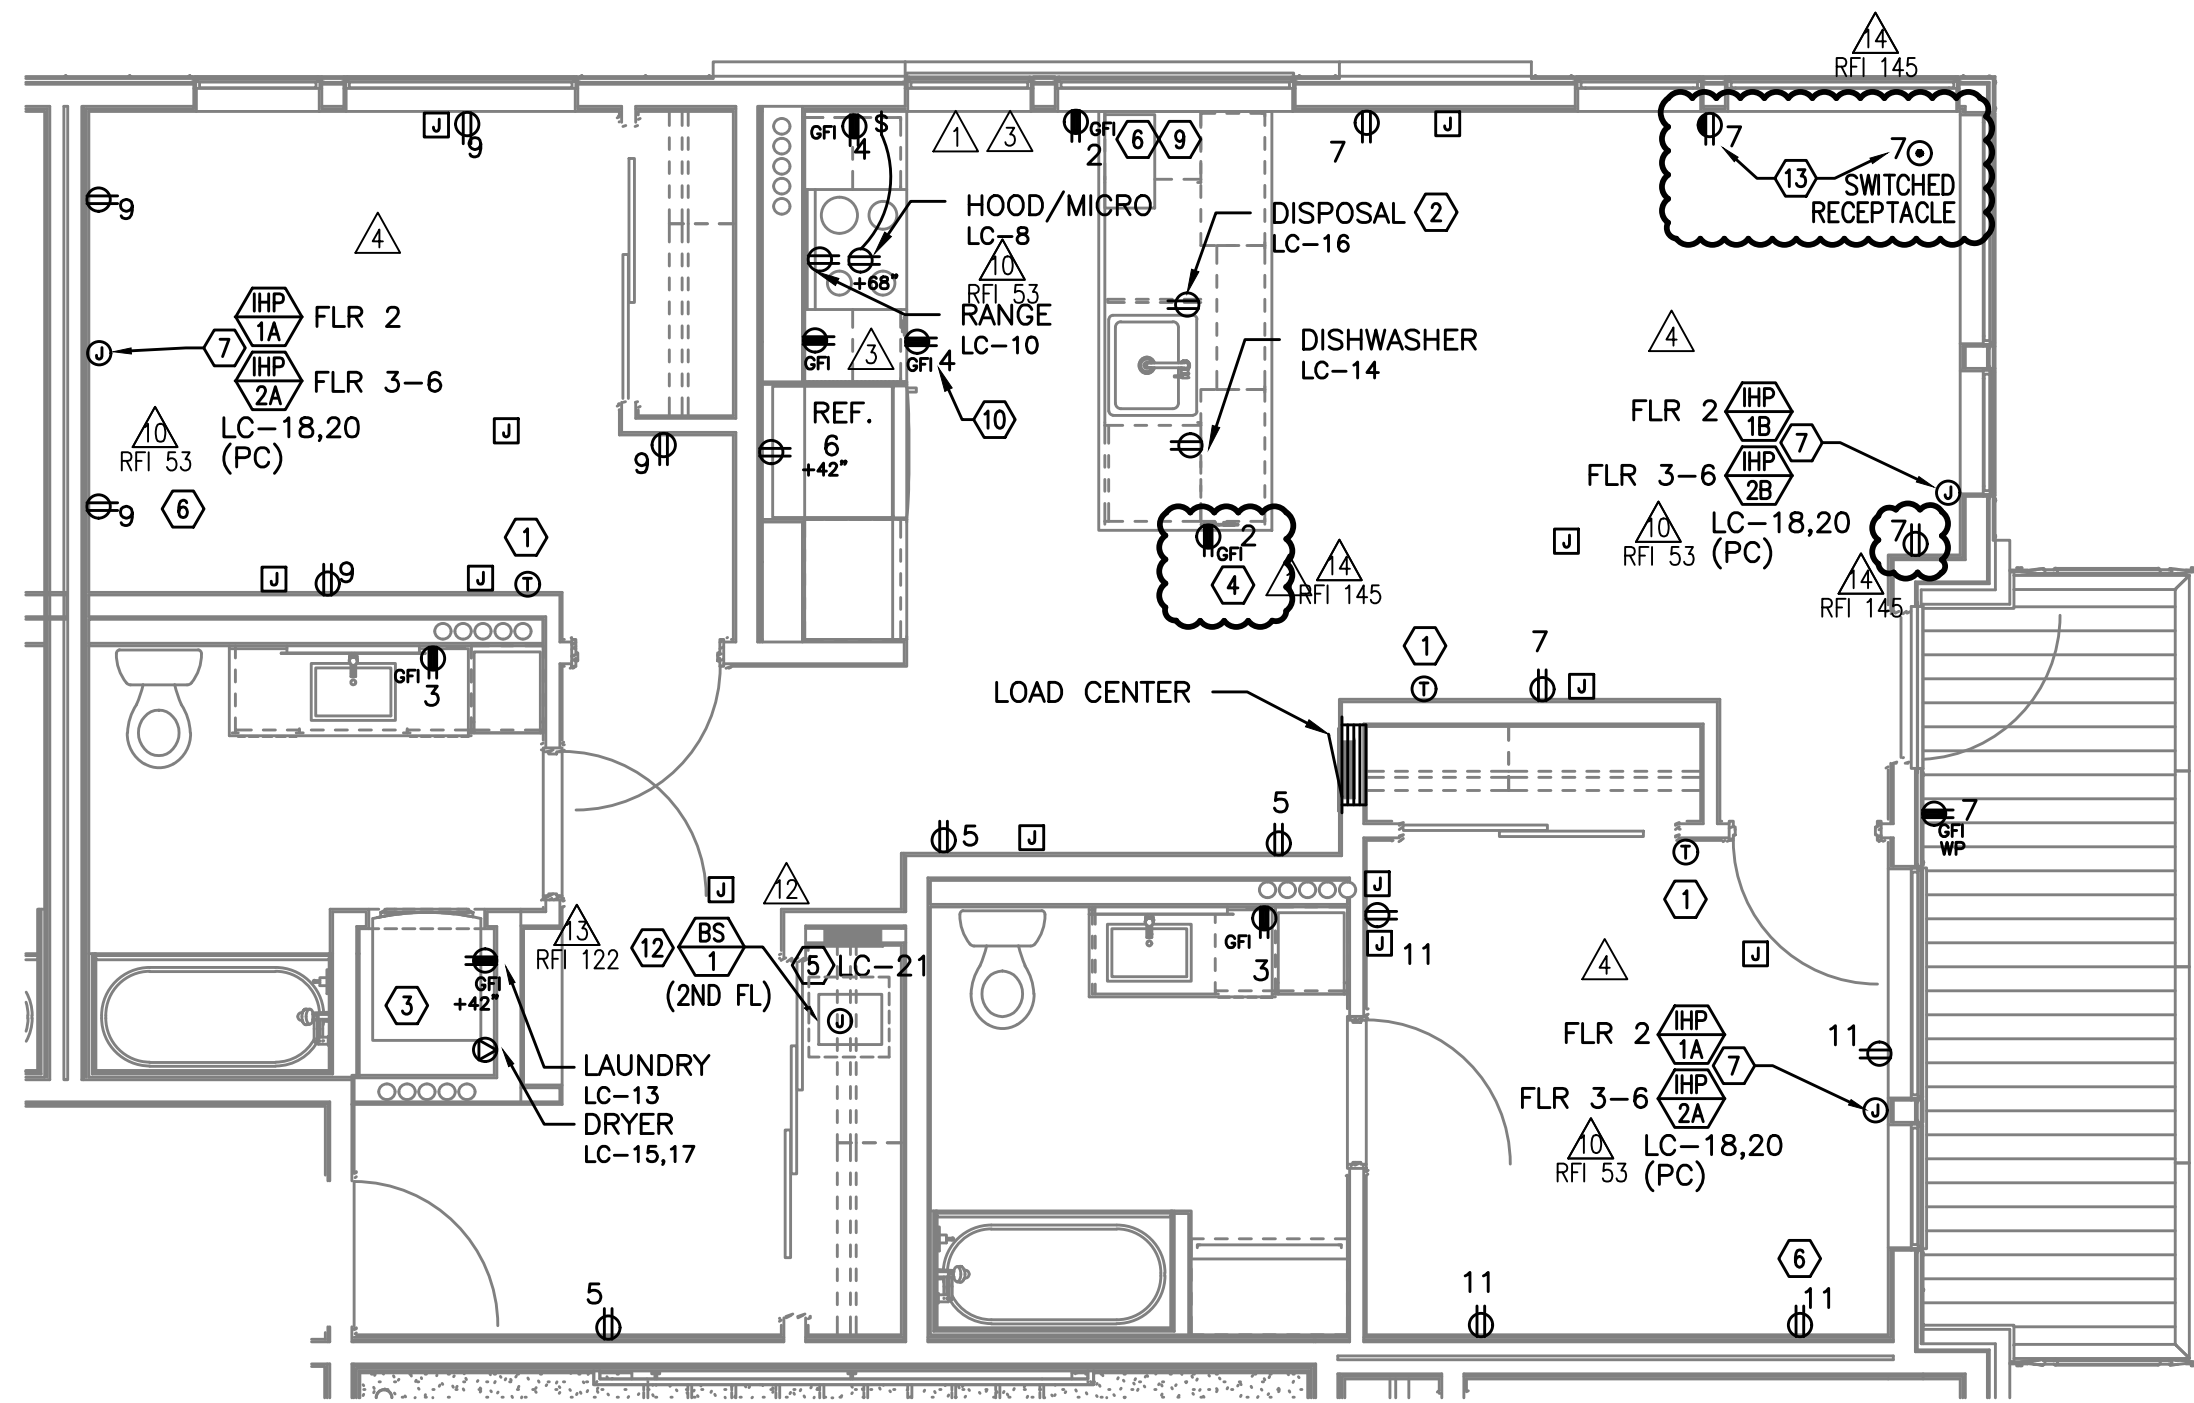


2
E4.11

TYPICAL UNIT TYPE A-ADA
2 BED/2 BATH – POWER PLAN
SCALE: 1/4" = 1'-0"

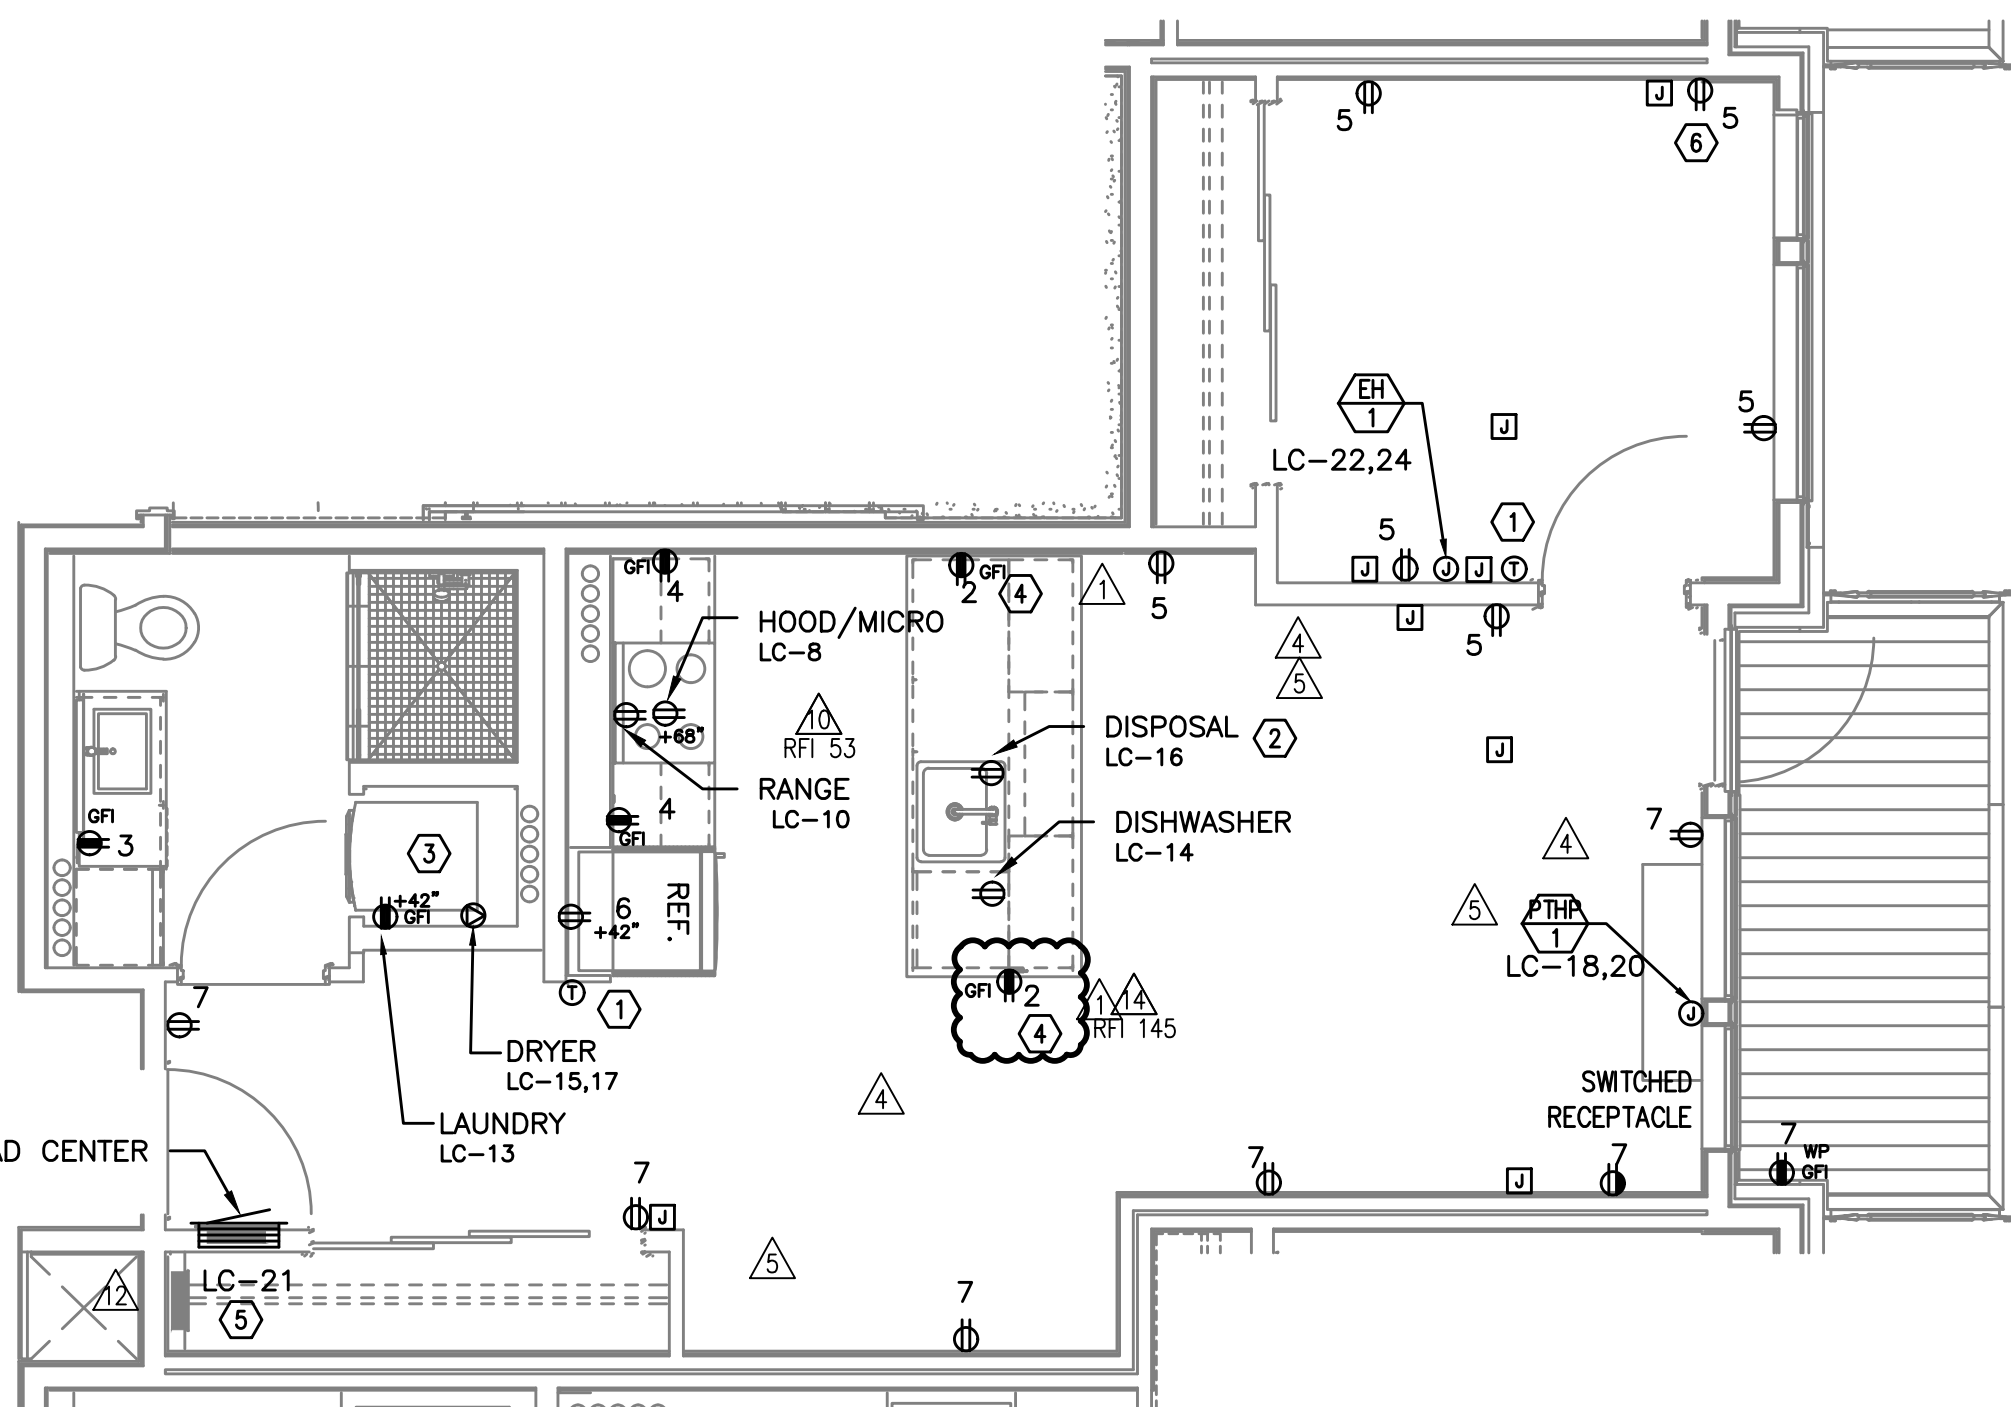

3
E4.11

TYPICAL UNIT TYPE B
1 BED/1 BATH – POWER PLAN
SCALE: 1/4" = 1'-0"

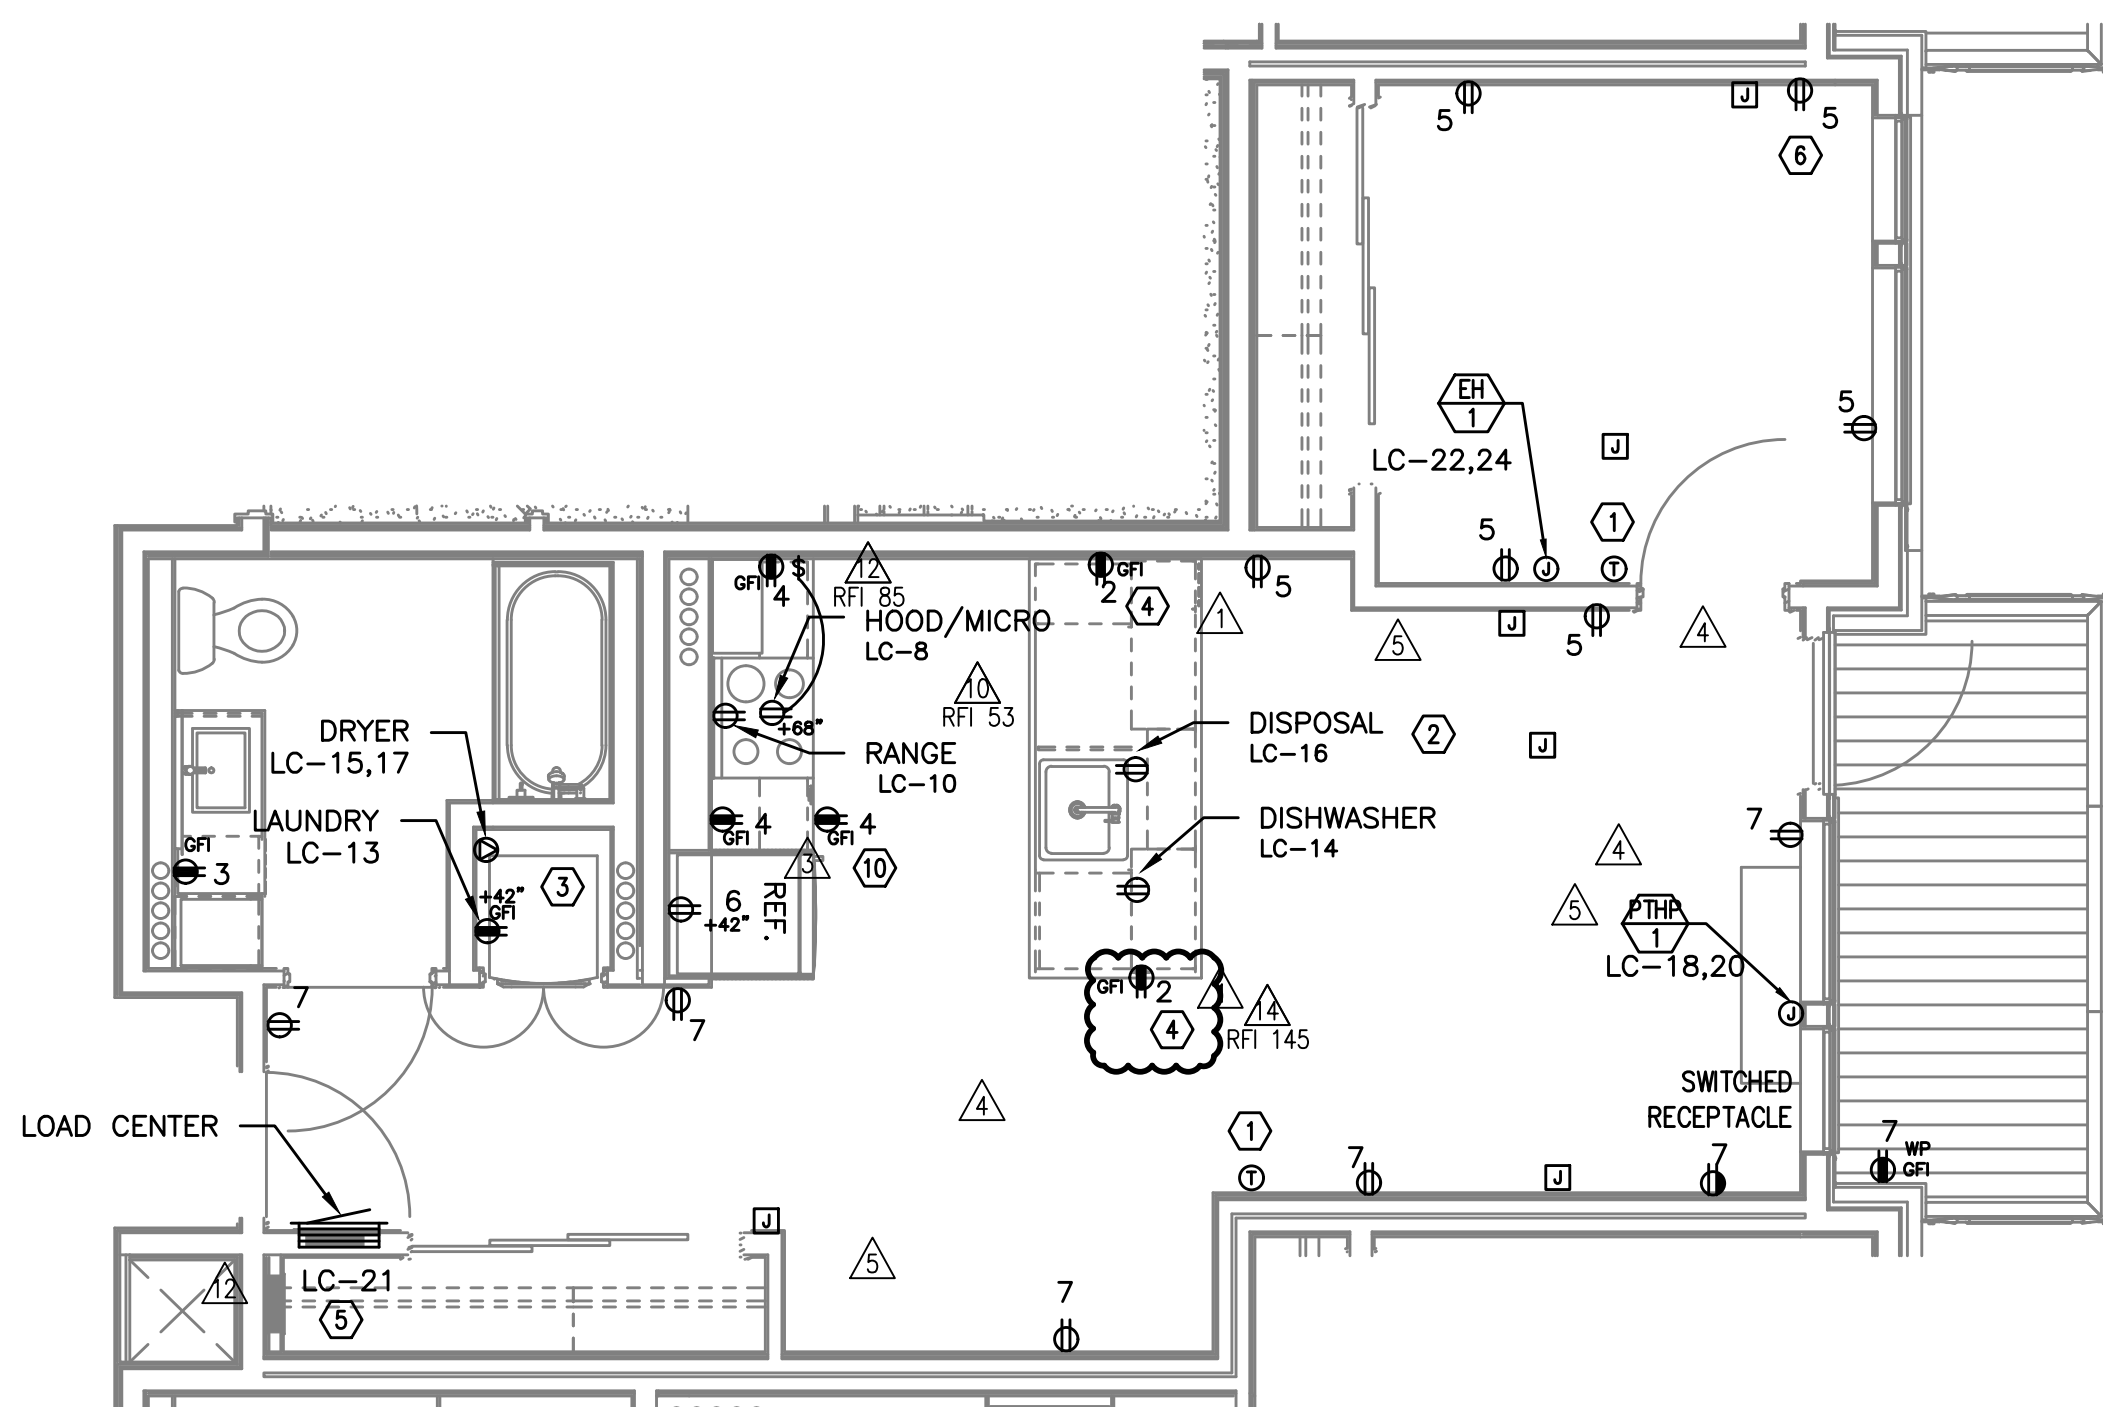

4
E4.11


TYPICAL UNIT TYPE B-ADA
1 BED/1 BATH – POWER PLAN
SCALE: 1/4" = 1'-0"

GENERAL NOTES:

- KITCHEN RECEPTACLES LOCATED IN ISLANDS OR PENINSULAS WHERE THE BACK SPLASH WILL NOT ACCOMMODATE VERTICAL PLACEMENT OR THE DUPLEX RECEPTACLE, THE CONTRACTOR SHALL ROTATE THE DEVICE 90 DEGREES SO THAT THE RECEPTACLE IS INSTALLED HORIZONTALLY.
- REFER TO DETAILS ON SHEET E1.23 FOR ADDITIONAL INFORMATION REGARDING ADA REACH REQUIREMENTS FOR RECEPTACLE AND SWITCH MOUNTING HEIGHT.
- STANDARD RECEPTACLE MOUNTING HEIGHT IS 18" A.F.F. UNLESS OTHERWISE SPECIFIED. RECEPTACLES LOCATED BELOW WINDOW SILLS SHALL NOT BE LESS THE 15" A.F.F.
- ALL PLANS ARE DIAGRAMMATICAL. CONSULT ARCHITECTURAL PLANS AND ELEVATIONS FOR EXACT LOCATION AND MOUNTING HEIGHT OF ALL DEVICES AND FIXTURES.
- REFER TO SHEET E1.17 FOR TYPICAL UNIT LOAD CENTER DIRECTORIES.
- RECEPTACLE FOR PTHP UNIT SHALL BE LOCATED BELOW THE UNIT, NEAR THE BASE OF THE WALL SUCH THAT THE CORD SET IS CONCEALED AS MUCH AS POSSIBLE. COORDINATE INSTALLATION WITH THE MECHANICAL INSTALLER.
- COORDINATE WITH THE "T" SERIES SHEETS AND PROVIDE ROUGH IN FOR LOW VOLTAGE SYSTEMS () REFERS TO ROUGH IN BOXES.
- ALL KITCHEN COUNTER TOP RECEPTACLES SHALL BE INSTALLED A MINIMUM OF 36" FROM A CORNER WALL PER ADA REQUIREMENTS. WHERE COUNTERS ARE NOT LONG ENOUGH TO ACCOMMODATE THIS, THE RECEPTACLE SHALL BE PLACE ON AN END WALL, NO MORE THAN 12" FROM THE FRONT EDGE OF THE COUNTER.

KEYED NOTES:

- PROVIDE WIRE CONNECTION FOR THERMOSTAT(S). COORDINATE WITH MECHANICAL INSTALLER FOR EXACT LOCATION AND POWER REQUIREMENTS PRIOR TO ROUGH IN. THERMOSTATS TO BE MOUNTED AT 48" AFF MAX. TO HIGHEST OPERABLE PART.
- PROVIDE ONE 20A, 120V, 1P GFCI DUPLEX RECEPTACLE UNDER KITCHEN SINK FOR DISPOSAL POWER CONNECTION. DISPOSAL TO BE PROVIDED WITH "SAFEAIRE" SINK DISPOSAL AIR SWITCH, MOUNTED PER ARCHITECT'S DIRECTION. VERIFY DEVICE FINISH WITH ARCHITECT PRIOR TO ORDERING.
- REFER TO DETAIL 2/E1.17 FOR TYPICAL LAUNDRY ALCOVE RECEPTACLE LOCATIONS. COORDINATE INSTALLATION WITH MECHANICAL & PLUMBING CONTRACTOR.
- MOUNT DEVICES HORIZONTALLY, JUST UNDER THE EDGE OF THE COUNTER TOP.
- PROVIDE ONE 15A, RECEPTACLE CIRCUIT FROM TENANT LOAD CENTER FOR TELECOM SMART PANEL. COORDINATE WORK WITH SERVICE PROVIDER FOR EXACT LOCATION AND FINAL CONNECTION.
- PROVIDE ONE 20A, 120V, 1P RECEPTACLE WITH USB PORT, MOUNTED AT 44" A.F.F. (MAX) AT KITCHEN ISLAND/PENNISULA COUNTER & AT 18" AFF IN BEDROOMS. CONSULT ARCHITECT AND/OR INTERIOR DESIGNER FOR ADDITIONAL LOCATIONS WHERE REQUIRED.
- INDOOR HEAT PUMP UNIT INTERCONNECTED WITH OUTDOOR UNIT LOCATED ON ROOF. CONTRACTOR SHALL COORDINATE WITH THE MECHANICAL HVAC INSTALLER AND MECHANICAL PLANS FOR EXACT POWER REQUIREMENTS & LOCATION OF EACH UNIT PRIOR TO ROUGH IN.
- COORDINATE WITH MECHANICAL EQUIPMENT INSTALLER FOR EXACT POWER REQUIREMENTS, CONTROLS & LOCATION OF THRU-WALL FAN. TIE INTO BEDROOM RECEPTACLE CIRCUIT.
- MOUNT DEVICES HORIZONTALLY, UNDER WINDOW SILL.
- RECEPTACLE MOUNTED IN FACE OF CABINET.
- COORDINATE WITH MECHANICAL EQUIPMENT INSTALLER FOR EXACT POWER REQUIREMENTS & LOCATION OF CONTINUOUS OPERATING EXHAUST FAN. TIE INTO LIVING ROOM LIGHTING RECEPTACLE CIRCUIT.
- PROVIDE POWER CONNECTION FOR BRANCH BOX, TIED INTO THE MINI-SPLIT SYSTEM, FROM THE TENANT LOAD CENTER. COORDINATE WORK WITH THE MECHANICAL EQUIPMENT INSTALLER.
- IN UNITS AT THE PT DECK, PROVIDE SURFACE MOUNTED RECEPTACLES AT STANDARD MOUNTING HEIGHT ON THE CORNER COLUMN. CONSULT ARCHITECT FOR ADDITIONAL INFORMATION.

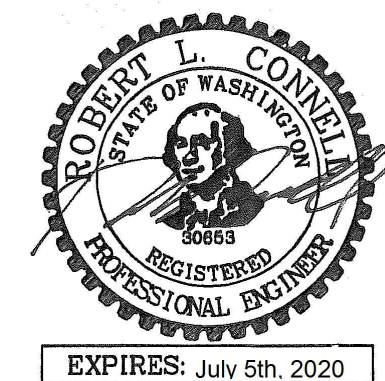

PROJECT # 2017-053
DATE: 11/06/2019
REVISIONS


PLAN REVIEW 01.24.2020
PLAN REVIEW 03.13.2020
PLAN REVIEW 04.24.2020
PLAN REVIEW 08.10.2020
PLAN REVIEW 09.17.2020
PLAN REVIEW 10.16.2020
PLAN REVIEW 11.25.2020
PLAN REVIEW 03.26.2021
PLAN REVIEW 07.15.2021
COORDINATION 08.27.2021
COORDINATION 11.05.2021
COORDINATION 12.10.2021

AEGIS
MIXED-USE DEVELOPMENT
312 E EVERGREEN BOULEVARD, VANCOUVER, WA 98660


M
F
I
A
INC.
Consulting Engineers
2007 S.E. Ash St.
Portland, OR 97214
PHN: (503) 234-0548
FAX: (503) 234-0677
CONTACT: DENISE TAYLOR

SHEET:


E4.11

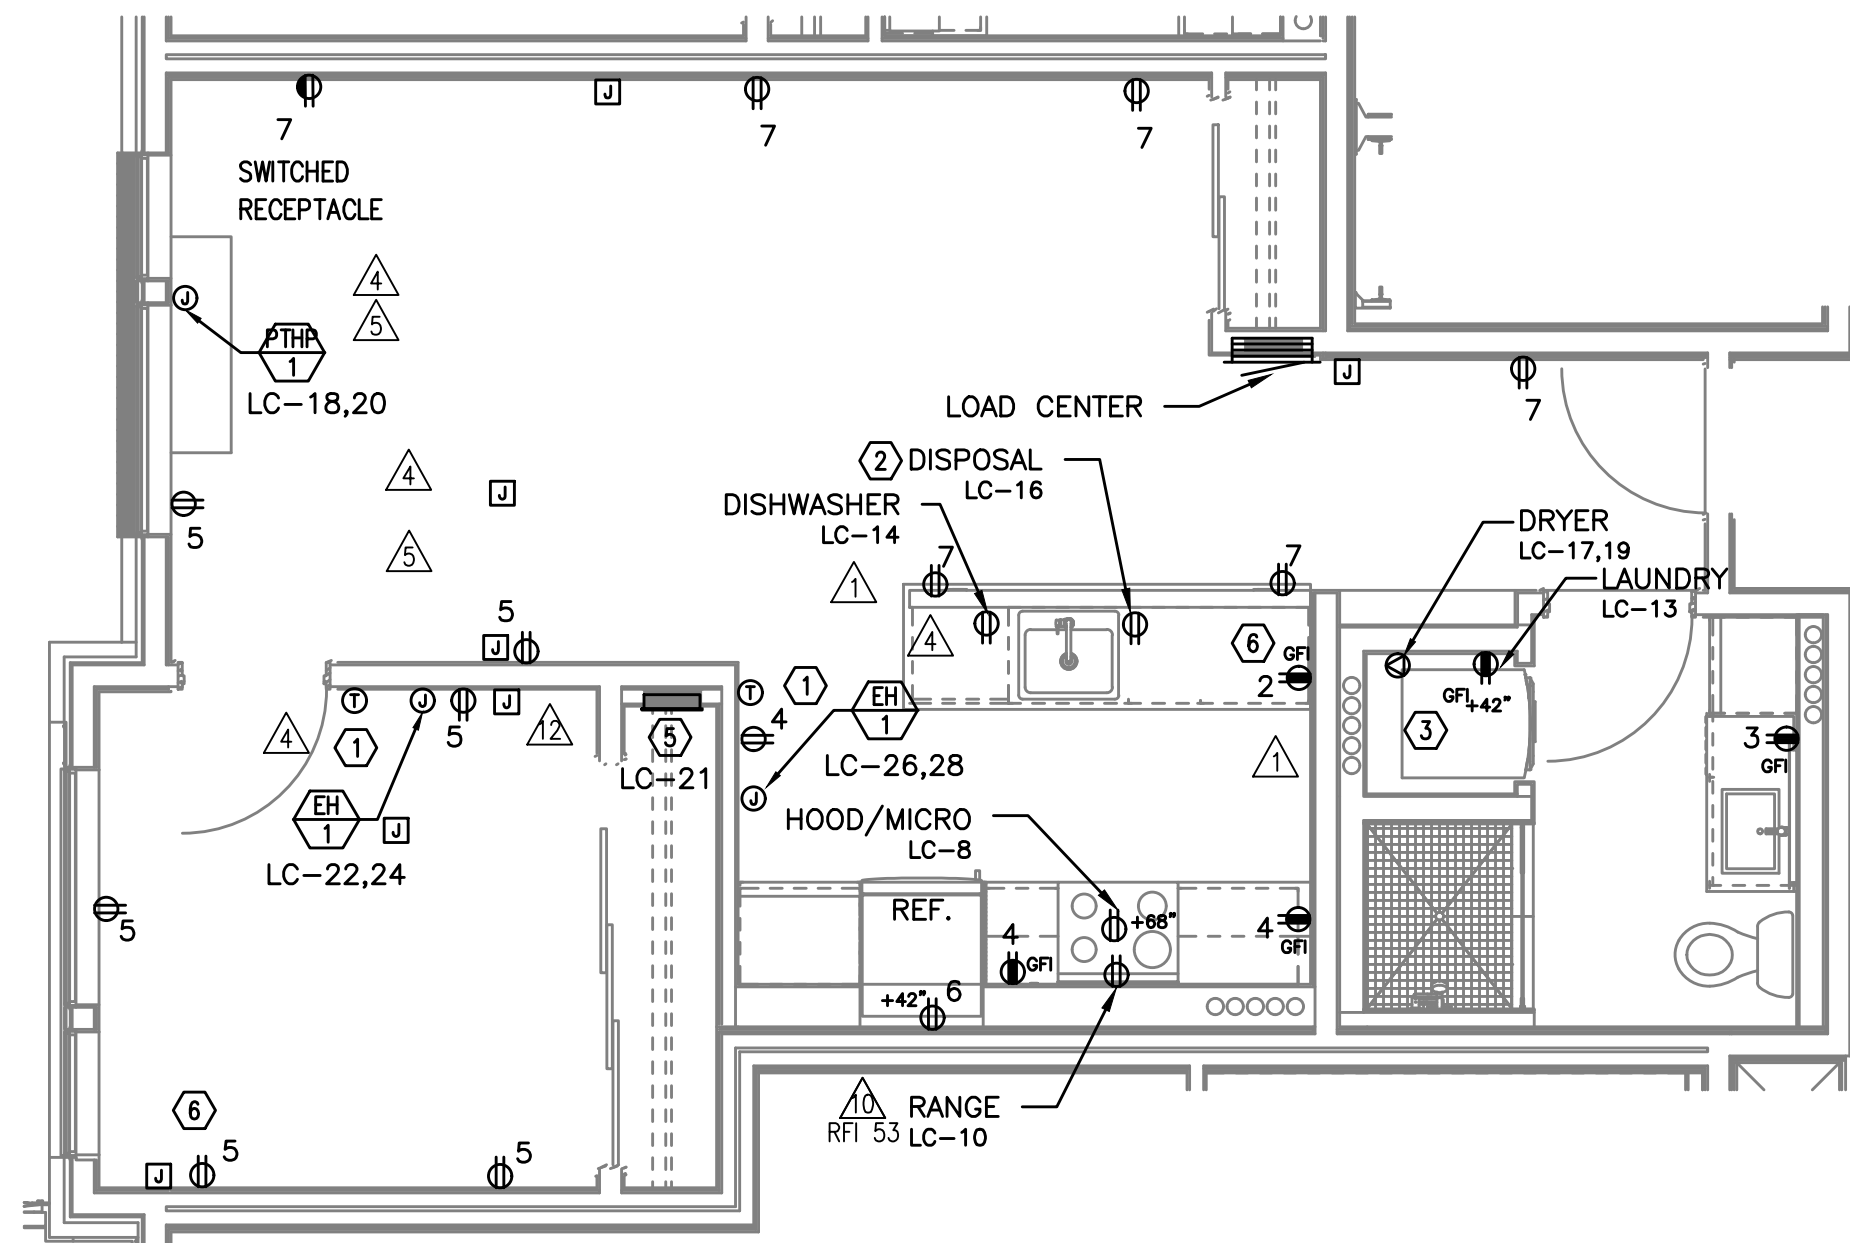

TYPICAL UNIT TYPE C
 1 1 BED/1 BATH – POWER PLAN
 E4.12 SCALE: 1/4" = 1'-0"

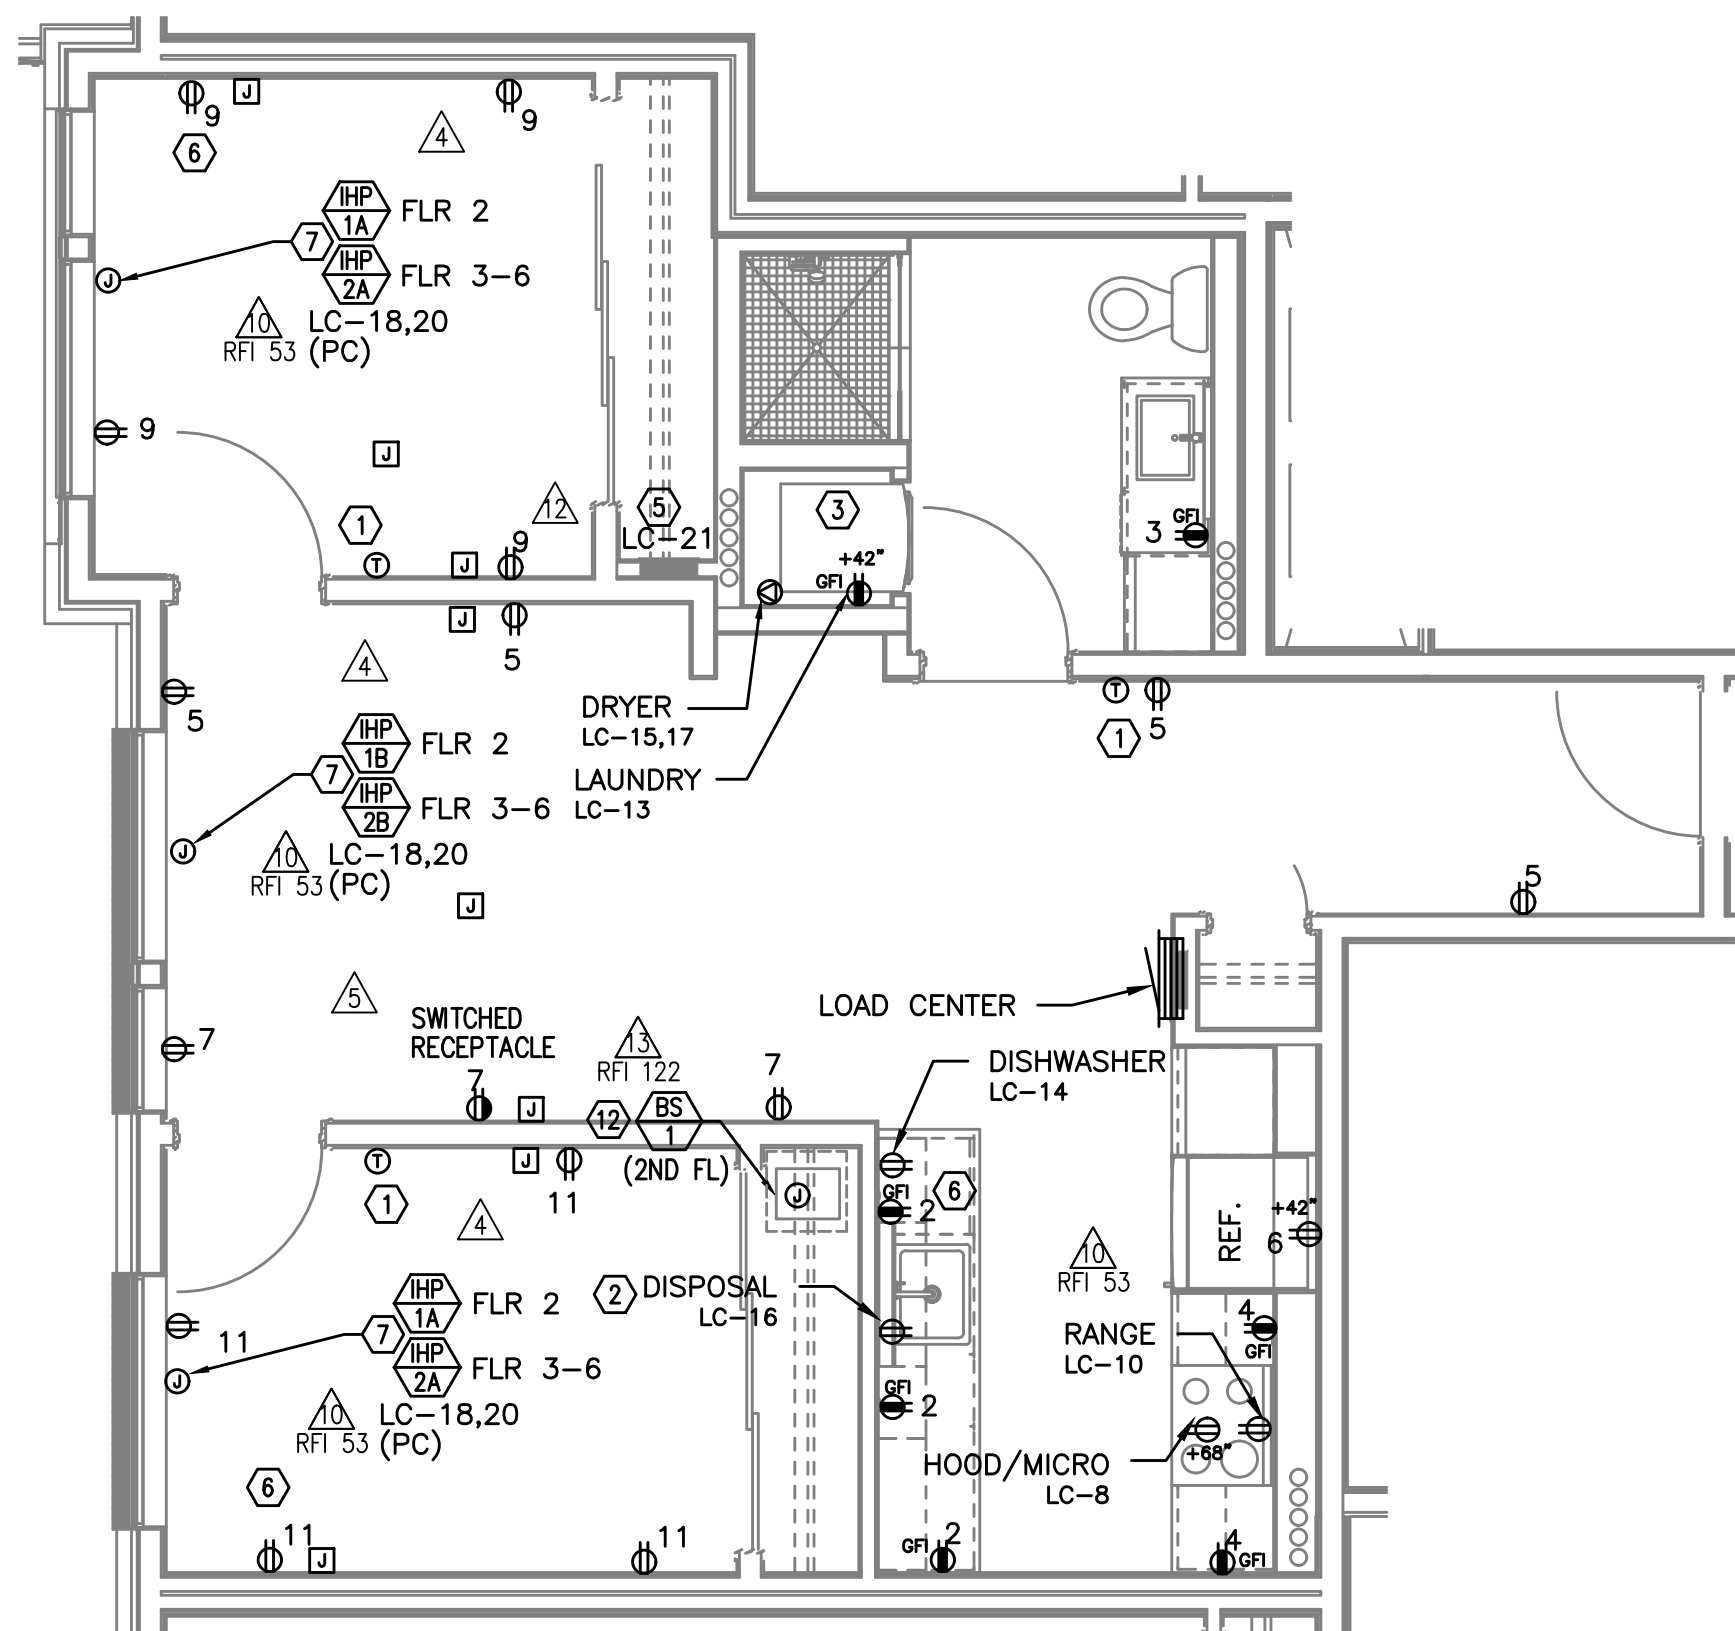

TYPICAL UNIT TYPE D
 2 2 BED/1 BATH – POWER PLAN
 E4.12 SCALE: 1/4" = 1'-0"

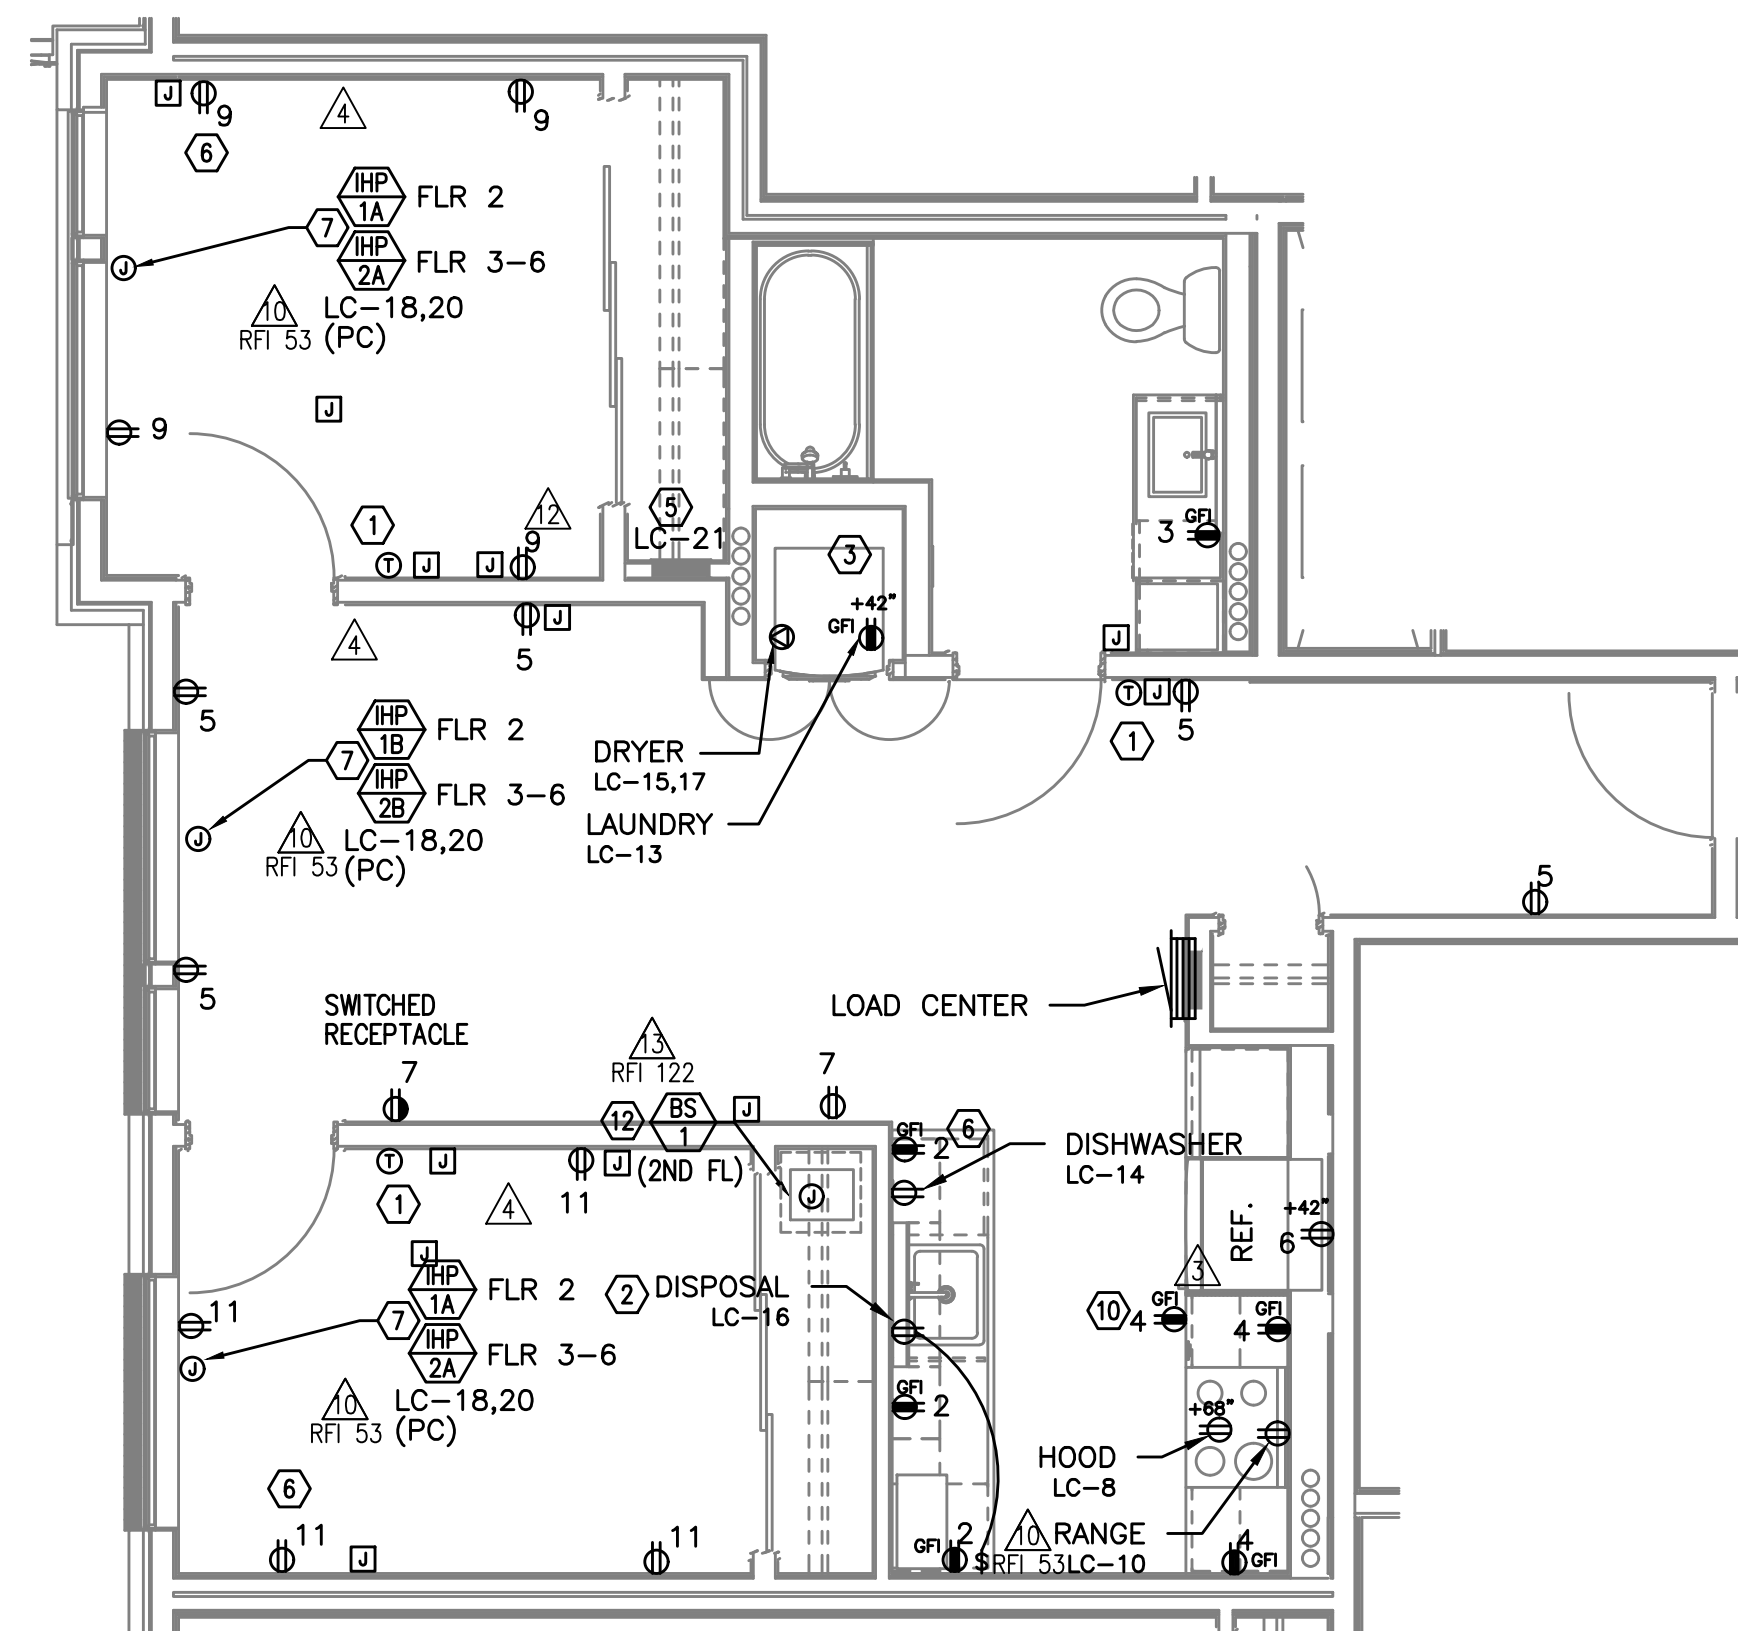


TYPICAL UNIT TYPE D-ADA
 3 2 BED/1 BATH – POWER PLAN
 E4.12 SCALE: 1/4" = 1'-0"

GENERAL NOTES:

- KITCHEN RECEPTACLES LOCATED IN ISLANDS OR PENINSULAS WHERE THE BACK SPLASH WILL NOT ACCOMMODATE VERTICAL PLACEMENT OR THE DUPLEX RECEPTACLE, THE CONTRACTOR SHALL ROTATE THE DEVICE 90 DEGREES SO THAT THE RECEPTACLE IS INSTALLED HORIZONTALLY.
- REFER TO DETAILS ON SHEET E1.23 FOR ADDITIONAL INFORMATION REGARDING ADA REACH REQUIREMENTS FOR RECEPTACLE AND SWITCH MOUNTING HEIGHT.
- STANDARD RECEPTACLE MOUNTING HEIGHT IS 18" A.F.F. UNLESS OTHERWISE SPECIFIED. RECEPTACLES LOCATED BELOW WINDOW SILLS SHALL NOT BE LESS THE 15" A.F.F.
- ALL PLANS ARE DIAGRAMMATICAL. CONSULT ARCHITECTURAL PLANS AND ELEVATIONS FOR EXACT LOCATION AND MOUNTING HEIGHT OF ALL DEVICES AND FIXTURES.
- REFER TO SHEET E1.17 FOR TYPICAL UNIT LOAD CENTER DIRECTORIES.
- RECEPTACLE FOR PTHP UNIT SHALL BE LOCATED BELOW THE UNIT, NEAR THE BASE OF THE WALL SUCH THAT THE CORD SET IS CONCEALED AS MUCH AS POSSIBLE. COORDINATE INSTALLATION WITH THE MECHANICAL INSTALLER.
- COORDINATE WITH THE 'T' SERIES SHEETS AND PROVIDE ROUGH IN FOR LOW VOLTAGE SYSTEMS () REFERS TO ROUGH IN BOXES.
- ALL KITCHEN COUNTER TOP RECEPTACLES SHALL BE INSTALLED A MINIMUM OF 36" FROM A CORNER WALL PER ADA REQUIREMENTS. WHERE COUNTERS ARE NOT LONG ENOUGH TO ACCOMMODATE THIS, THE RECEPTACLE SHALL BE PLACE ON AN END WALL, NO MORE THAN 12" FROM THE FRONT EDGE OF THE COUNTER.

KEYED NOTES:

- PROVIDE WIRE CONNECTION FOR THERMOSTAT(S). COORDINATE WITH MECHANICAL INSTALLER FOR EXACT LOCATION AND POWER REQUIREMENTS PRIOR TO ROUGH IN. THERMOSTATS TO BE MOUNTED AT 48" AFF MAX. TO HIGHEST OPERABLE PART.
- PROVIDE ONE 20A, 120V, 1P GFCI DUPLEX RECEPTACLE UNDER KITCHEN SINK FOR DISPOSAL POWER CONNECTION. DISPOSAL TO BE PROVIDED WITH "SAFEAIRE" SINK DISPOSAL AIR SWITCH, MOUNTED PER ARCHITECT'S DIRECTION. VERIFY DEVICE FINISH WITH ARCHITECT PRIOR TO ORDERING.
- REFER TO DETAIL 2/E1.17 FOR TYPICAL LAUNDRY ALCOVE RECEPTACLE LOCATIONS. COORDINATE INSTALLATION WITH MECHANICAL & PLUMBING CONTRACTOR.
- MOUNT DEVICES HORIZONTALLY, JUST UNDER THE EDGE OF THE COUNTER TOP.
- PROVIDE ONE 15A, RECEPTACLE CIRCUIT FROM TENANT LOAD CENTER FOR TELECOM SMART PANEL. COORDINATE WORK WITH SERVICE PROVIDER FOR EXACT LOCATION AND FINAL CONNECTION.
- PROVIDE ONE 20A, 120V, 1P RECEPTACLE WITH USB PORT, MOUNTED AT 44" A.F.F. (MAX) AT KITCHEN ISLAND/PENINSULA COUNTER & AT 18" AFF IN BEDROOMS. CONSULT ARCHITECT AND/OR INTERIOR DESIGNER FOR ADDITIONAL LOCATIONS WHERE REQUIRED.
- INDOOR HEAT PUMP UNIT INTERCONNECTED WITH OUTDOOR UNIT LOCATED ON ROOF. CONTRACTOR SHALL COORDINATE WITH THE MECHANICAL HVAC INSTALLER AND MECHANICAL PLANS FOR EXACT POWER REQUIREMENTS & LOCATION OF EACH UNIT PRIOR TO ROUGH IN.
- COORDINATE WITH MECHANICAL EQUIPMENT INSTALLER FOR EXACT POWER REQUIREMENTS, CONTROLS & LOCATION OF THRU-WALL FAN. TIE INTO BEDROOM RECEPTACLE CIRCUIT.
- MOUNT DEVICES HORIZONTALLY, UNDER WINDOW SILL.
- RECEPTACLE MOUNTED IN FACE OF CABINET.
- COORDINATE WITH MECHANICAL EQUIPMENT INSTALLER FOR EXACT POWER REQUIREMENTS & LOCATION OF CONTINUOUS OPERATING EXHAUST FAN. TIE INTO LIVING ROOM LIGHTING RECEPTACLE CIRCUIT.
- PROVIDE POWER CONNECTION FOR BRANCH BOX, TIED INTO THE MINI-SPLIT SYSTEM, FROM THE TENANT LOAD CENTER. COORDINATE WORK WITH THE MECHANICAL EQUIPMENT INSTALLER.
- IN UNITS AT THE PT DECK, PROVIDE SURFACE MOUNTED RECEPTACLES AT STANDARD MOUNTING HEIGHT ON THE CORNER COLUMN. CONSULT ARCHITECT FOR ADDITIONAL INFORMATION.

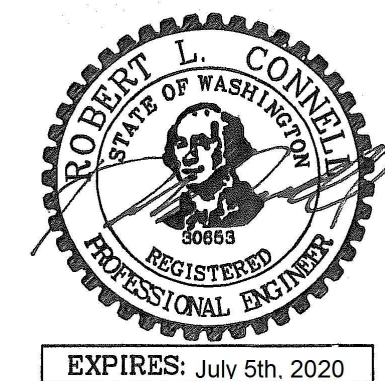

PROJECT # 2017-053
 DATE: 11/06/2019
 REVISIONS


- △ PLAN REVIEW 01.24.2020
- △ PLAN REVIEW 03.13.2020
- △ PLAN REVIEW 04.24.2020
- △ PLAN REVIEW 08.10.2020
- △ PLAN REVIEW 09.17.2020
- △ PLAN REVIEW 10.16.2020
- △ PLAN REVIEW 11.25.2020
- △ PLAN REVIEW 03.26.2021
- △ PLAN REVIEW 07.15.2021
- △ COORDINATION 08.27.2021
- △ COORDINATION 11.05.2021
- △ COORDINATION 12.10.2021

AEGIS
MIXED-USE DEVELOPMENT
 312 E EVERGREEN BOULEVARD, VANCOUVER, WA 98660

M F I A
 Consulting Engineers
 2007 S.E. Ash St.
 Portland, OR 97214
 PHN: (503) 234-0548
 FAX: (503) 234-0677
 CONTACT: DENISE TAYLOR


SHEET:

E4.12

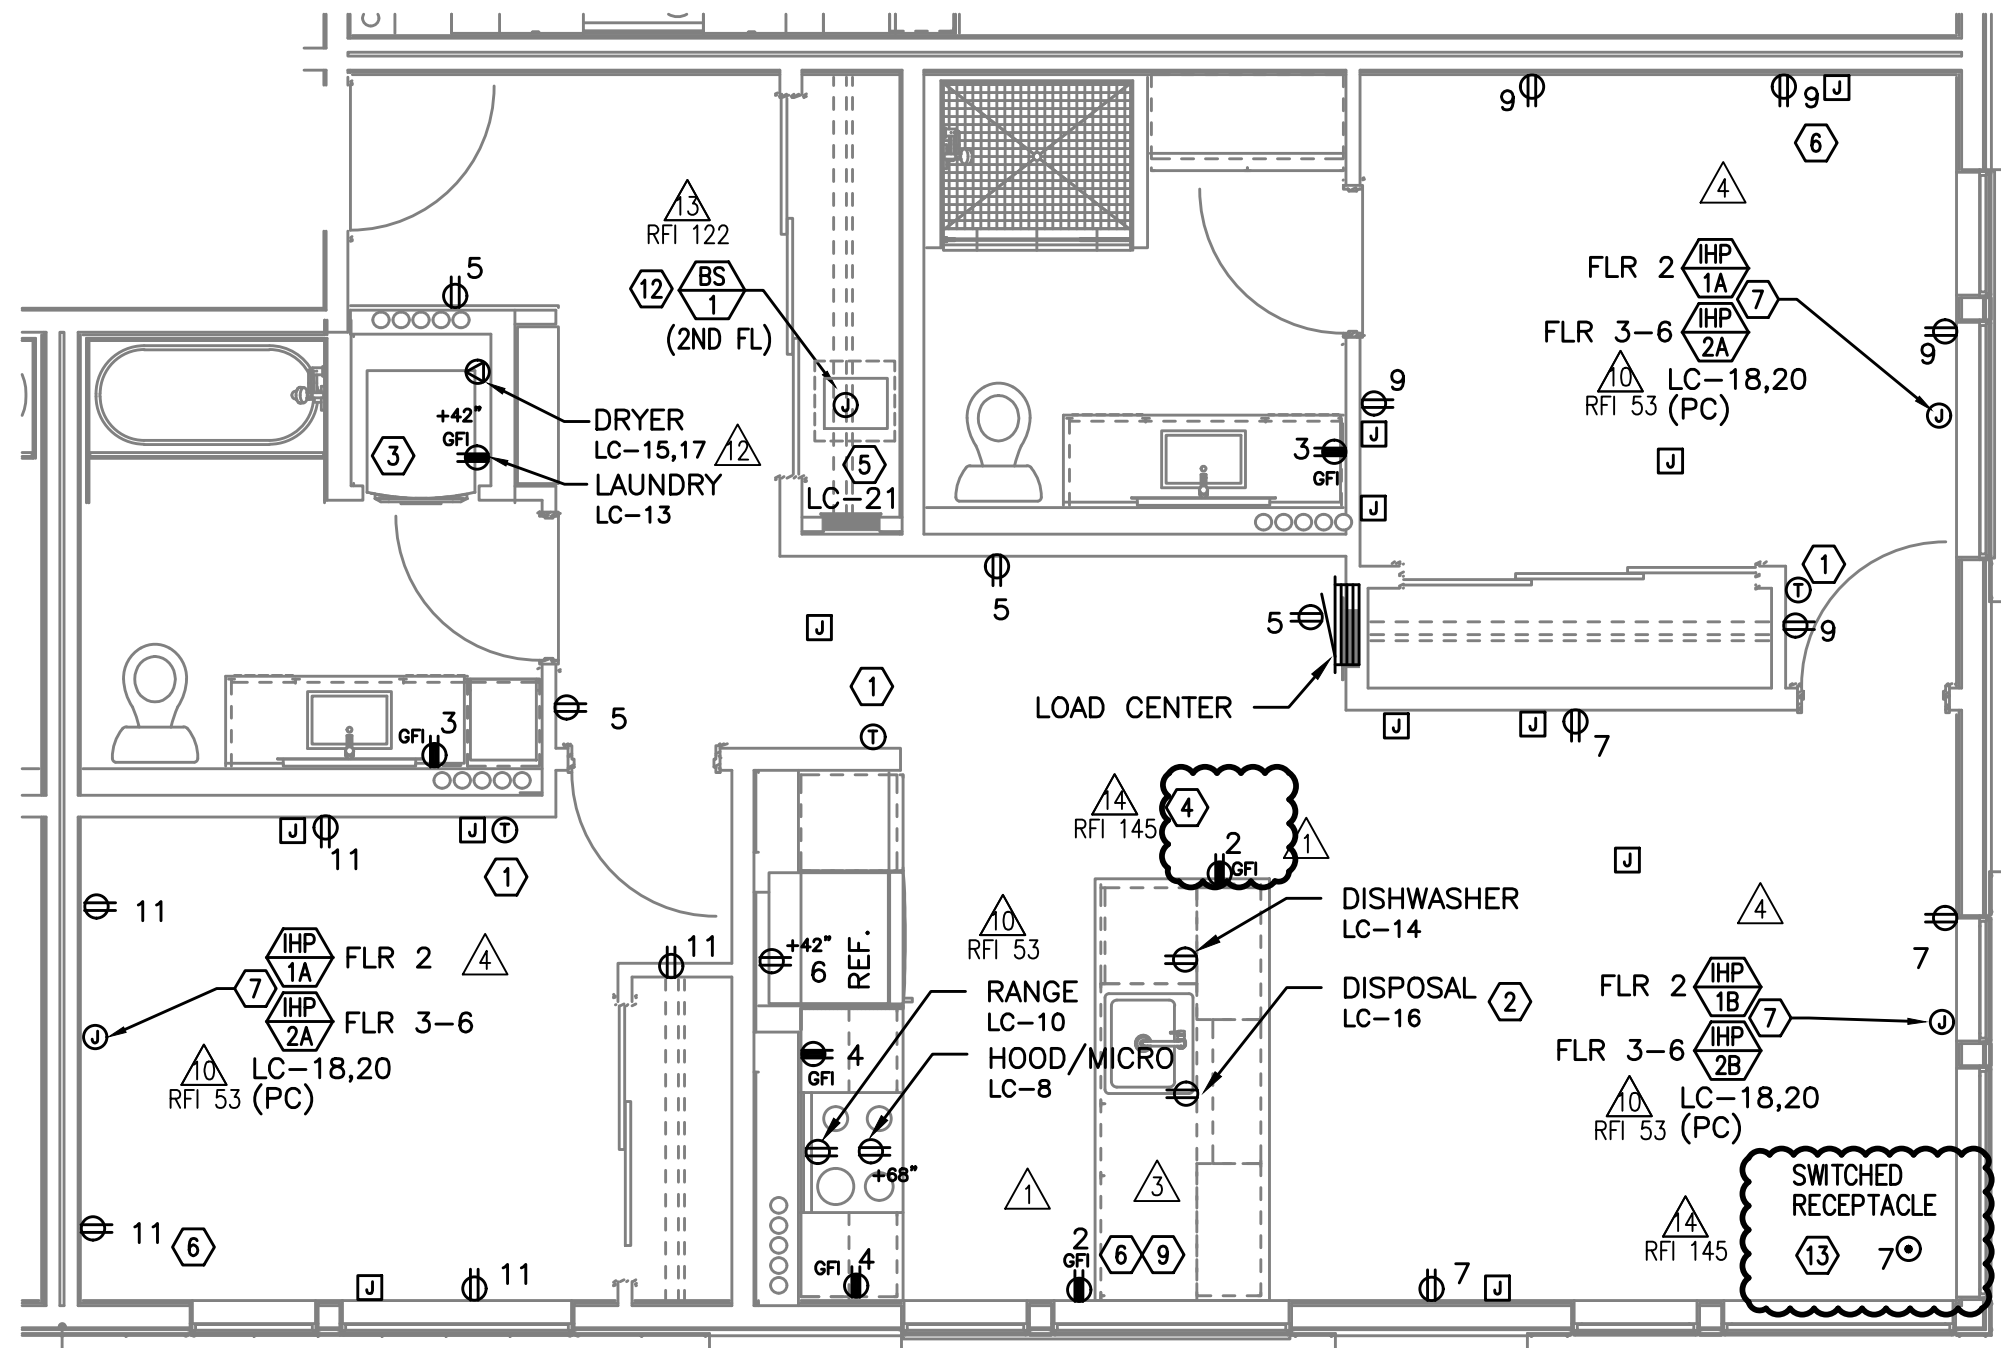


1
E4.13

TYPICAL UNIT TYPE E
2 BED/2 BATH – POWER PLAN
SCALE: 1/4" = 1'-0"

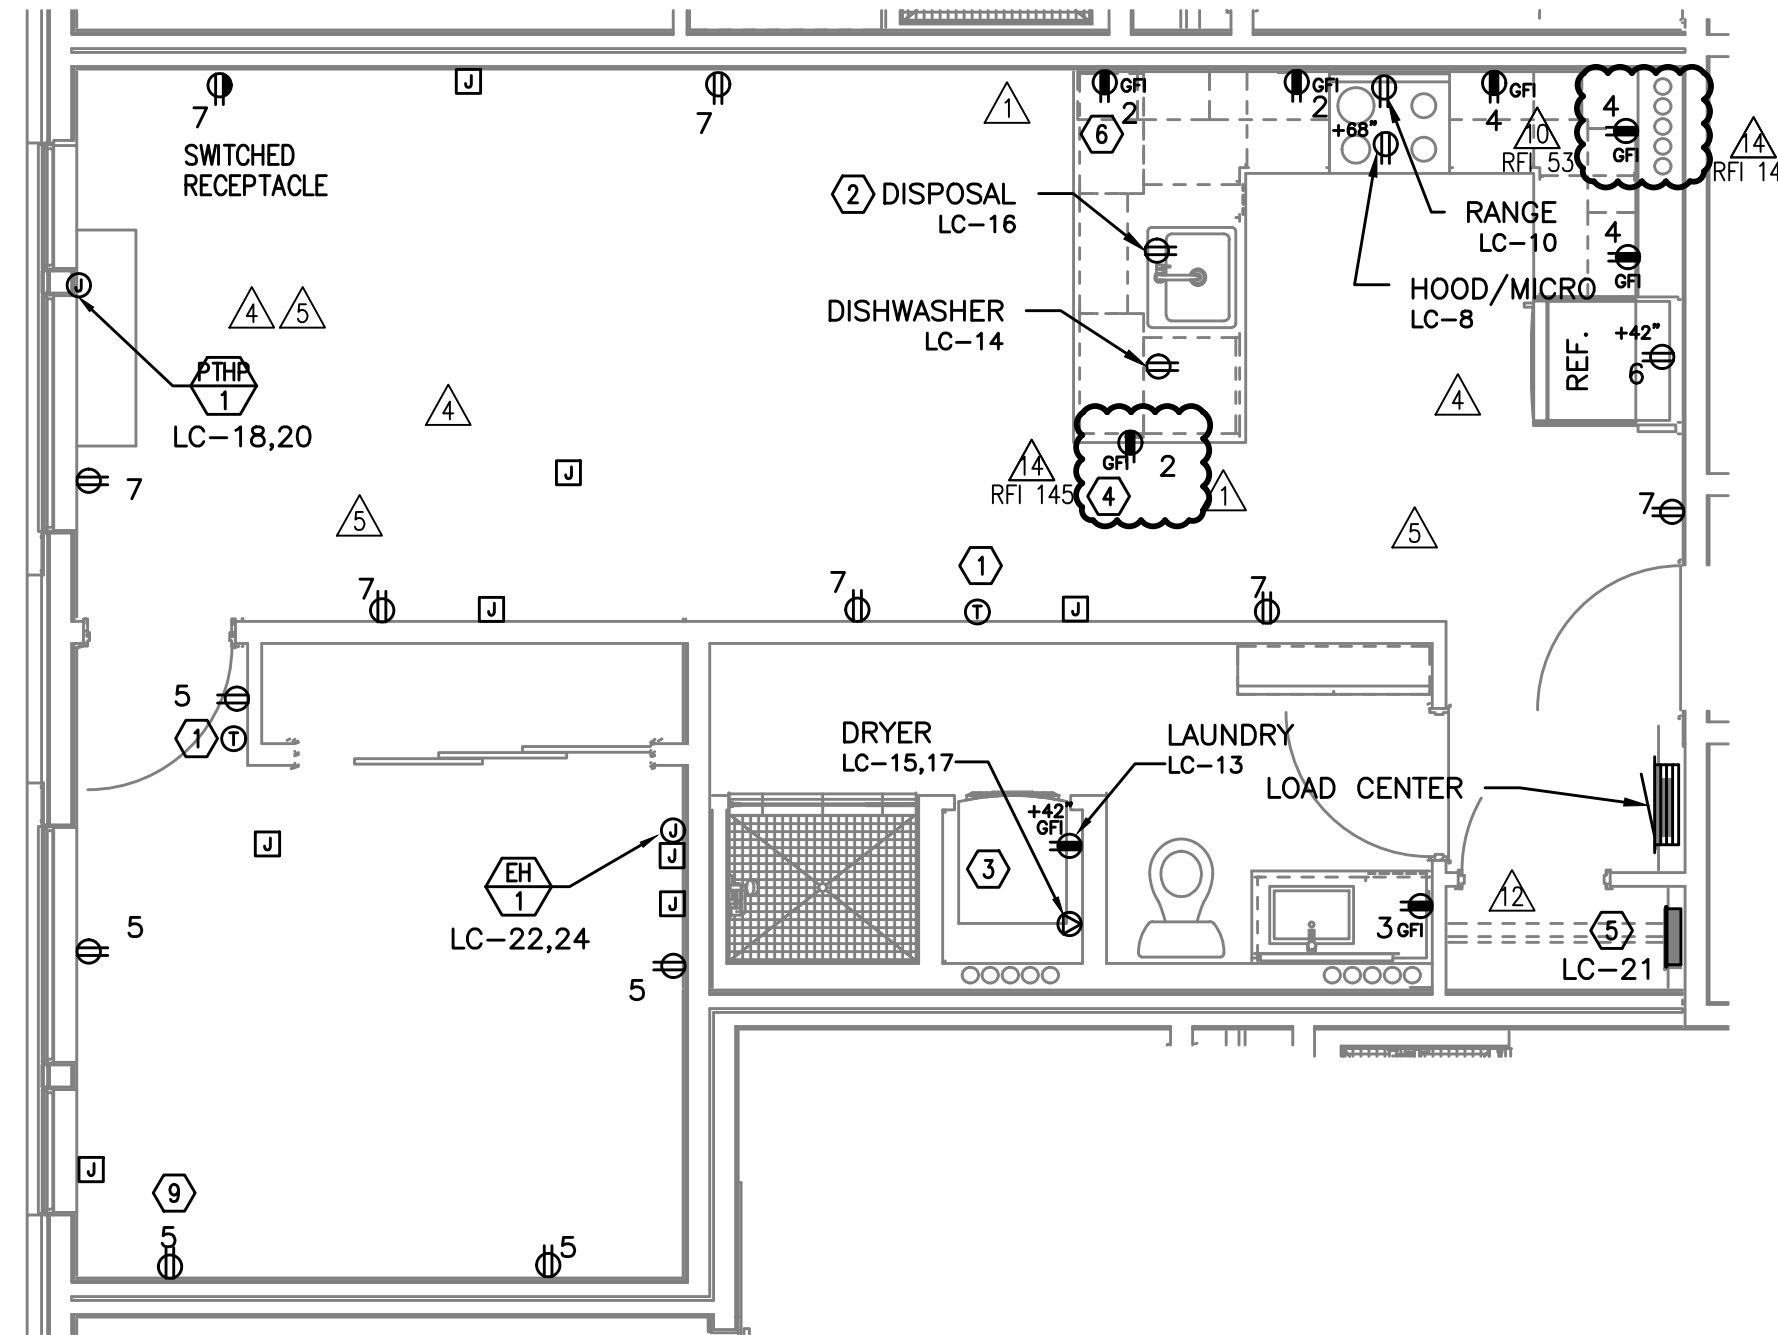


2
E4.13

TYPICAL UNIT TYPE F
1 BED/1 BATH – POWER PLAN
SCALE: 1/4" = 1'-0"

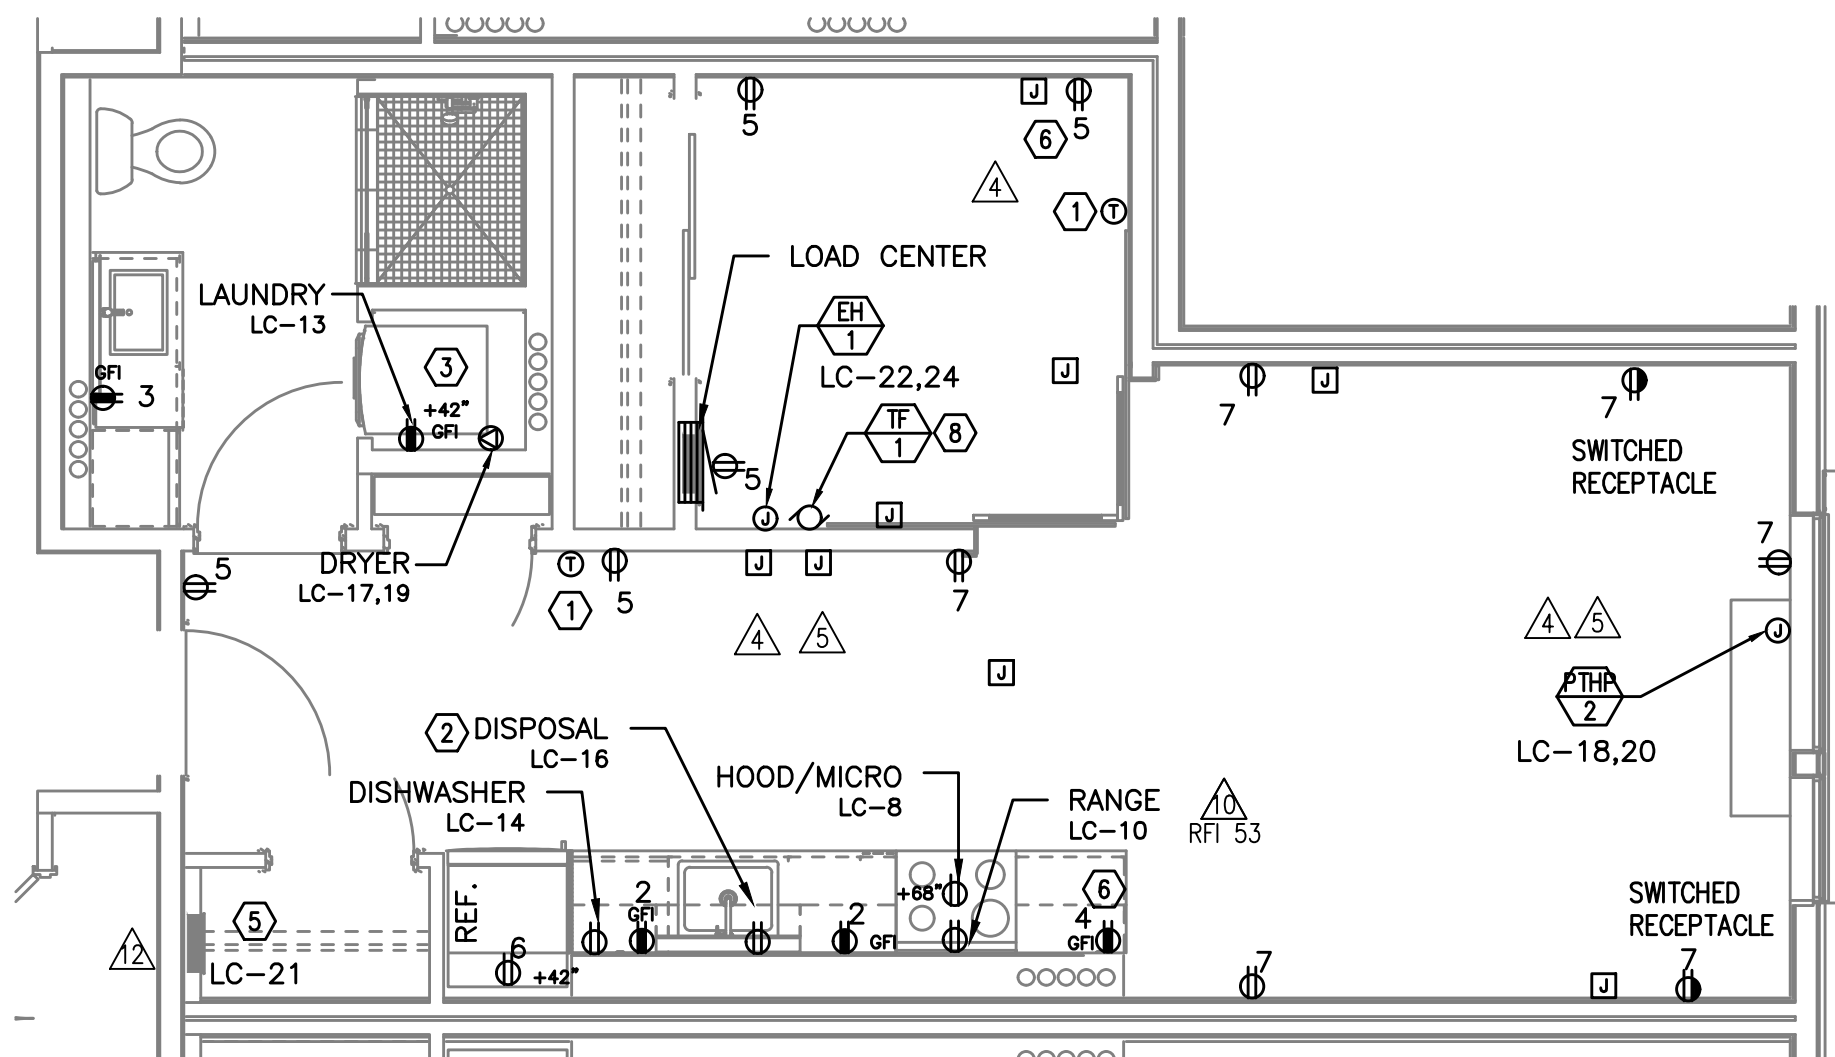

3
E4.13

TYPICAL UNIT TYPE G
0 BED/1 BATH – POWER PLAN
SCALE: 1/4" = 1'-0"

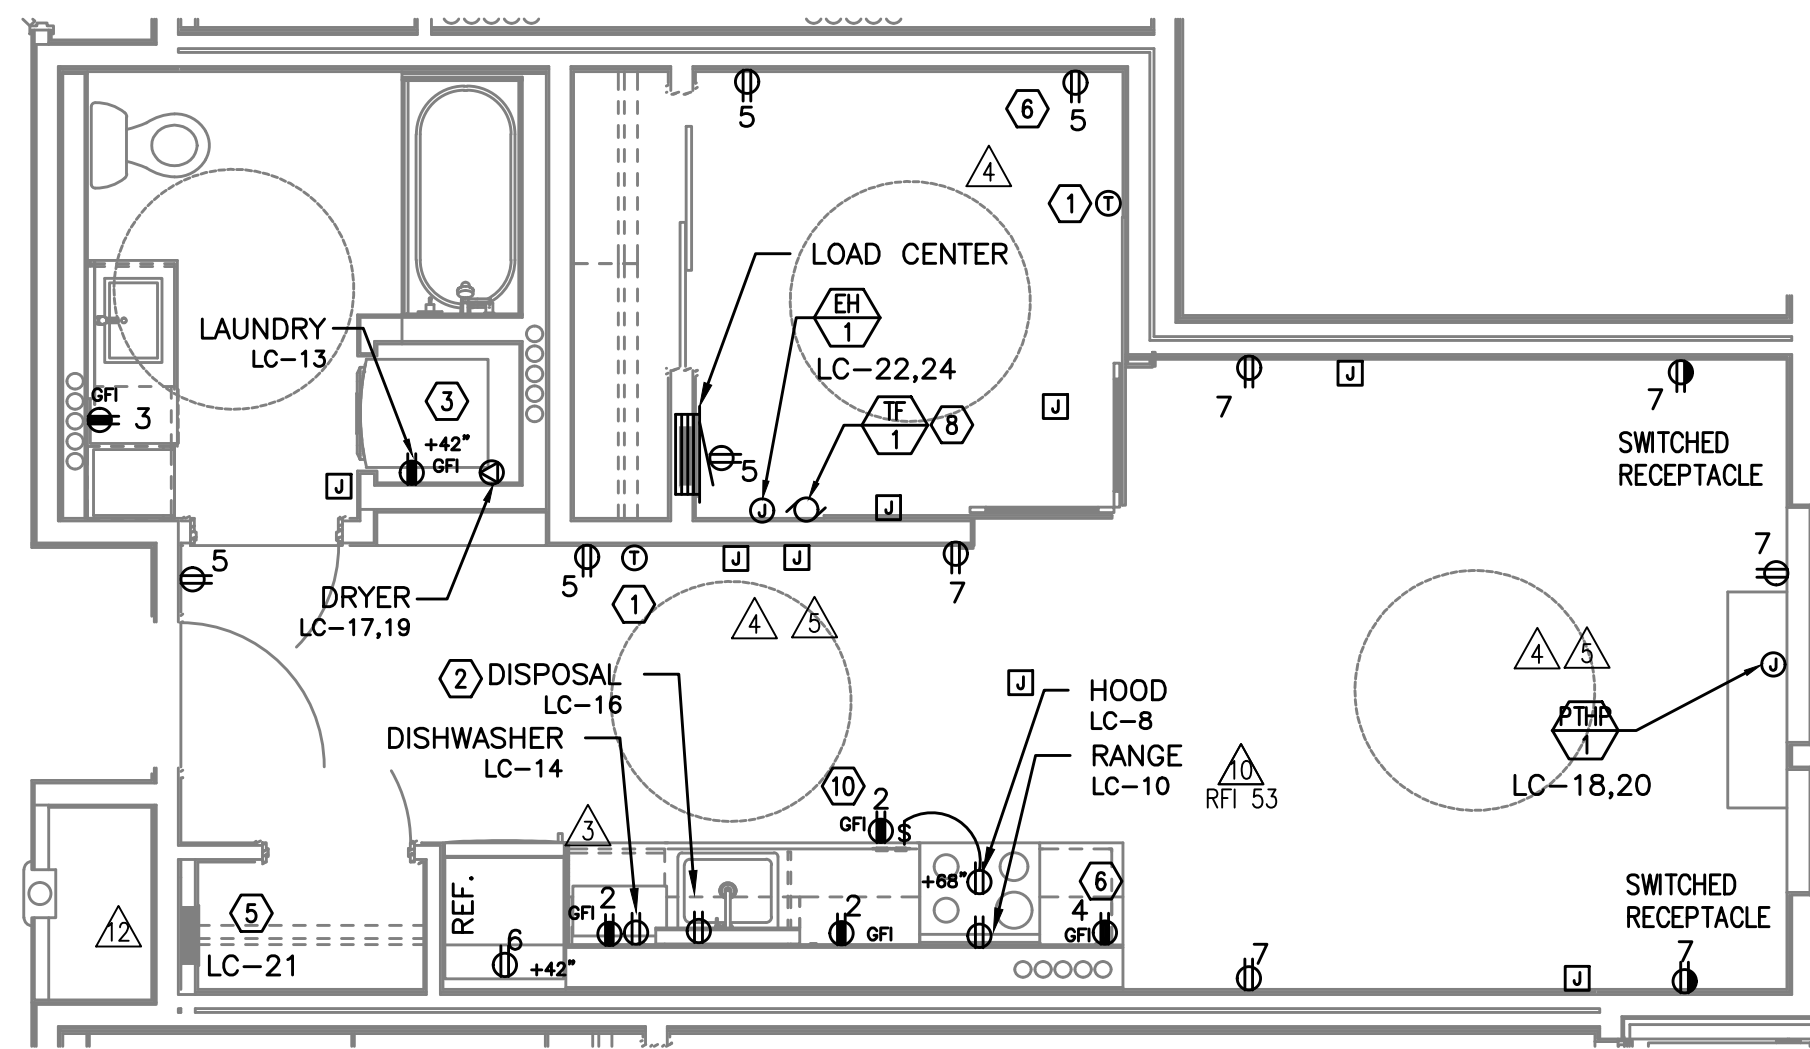

4
E4.13

TYPICAL UNIT TYPE G-ADA
0 BED/1 BATH – POWER PLAN
SCALE: 1/4" = 1'-0"

GENERAL NOTES:

- KITCHEN RECEPTACLES LOCATED IN ISLANDS OR PENINSULAS WHERE THE BACK SPLASH WILL NOT ACCOMMODATE VERTICAL PLACEMENT OR THE DUPLEX RECEPTACLE, THE CONTRACTOR SHALL ROTATE THE DEVICE 90 DEGREES SO THAT THE RECEPTACLE IS INSTALLED HORIZONTALLY.
- REFER TO DETAILS ON SHEET E1.23 FOR ADDITIONAL INFORMATION REGARDING ADA REACH REQUIREMENTS FOR RECEPTACLE AND SWITCH MOUNTING HEIGHT.
- STANDARD RECEPTACLE MOUNTING HEIGHT IS 18" A.F.F. UNLESS OTHERWISE SPECIFIED. RECEPTACLES LOCATED BELOW WINDOW SILLS SHALL NOT BE LESS THE 15" A.F.F.
- ALL PLANS ARE DIAGRAMMATICAL. CONSULT ARCHITECTURAL PLANS AND ELEVATIONS FOR EXACT LOCATION AND MOUNTING HEIGHT OF ALL DEVICES AND FIXTURES.
- REFER TO SHEET E1.17 FOR TYPICAL UNIT LOAD CENTER DIRECTORIES.
- RECEPTACLE FOR PTHP UNIT SHALL BE LOCATED BELOW THE UNIT, NEAR THE BASE OF THE WALL SUCH THAT THE CORD SET IS CONCEALED AS MUCH AS POSSIBLE. COORDINATE INSTALLATION WITH THE MECHANICAL INSTALLER.
- COORDINATE WITH THE 'T' SERIES SHEETS AND PROVIDE ROUGH IN FOR LOW VOLTAGE SYSTEMS () REFERS TO ROUGH IN BOXES.
- ALL KITCHEN COUNTER TOP RECEPTACLES SHALL BE INSTALLED A MINIMUM OF 36" FROM A CORNER WALL PER ADA REQUIREMENTS. WHERE COUNTERS ARE NOT LONG ENOUGH TO ACCOMMODATE THIS, THE RECEPTACLE SHALL BE PLACE ON AN END WALL, NO MORE THAN 12" FROM THE FRONT EDGE OF THE COUNTER.

KEYED NOTES:

- PROVIDE WIRE CONNECTION FOR THERMOSTAT(S). COORDINATE WITH MECHANICAL INSTALLER FOR EXACT LOCATION AND POWER REQUIREMENTS PRIOR TO ROUGH IN. THERMOSTATS TO BE MOUNTED AT 48" AFF MAX. TO HIGHEST OPERABLE PART.
- PROVIDE ONE 20A, 120V, 1P GFCI DUPLEX RECEPTACLE UNDER KITCHEN SINK FOR DISPOSAL POWER CONNECTION. DISPOSAL TO BE PROVIDED WITH "SAFEAIRE" SINK DISPOSAL AIR SWITCH, MOUNTED PER ARCHITECT'S DIRECTION. VERIFY DEVICE FINISH WITH ARCHITECT PRIOR TO ORDERING.
- REFER TO DETAIL 2/E1.17 FOR TYPICAL LAUNDRY ALCOVE RECEPTACLE LOCATIONS. COORDINATE INSTALLATION WITH MECHANICAL & PLUMBING CONTRACTOR.
- MOUNT DEVICES HORIZONTALLY, JUST UNDER THE EDGE OF THE COUNTER TOP.
- PROVIDE ONE 15A, RECEPTACLE CIRCUIT FROM TENANT LOAD CENTER FOR TELECOM SMART PANEL. COORDINATE WORK WITH SERVICE PROVIDER FOR EXACT LOCATION AND FINAL CONNECTION.
- PROVIDE ONE 20A, 120V, 1P RECEPTACLE WITH USB PORT, MOUNTED AT 44" A.F.F (MAX) AT KITCHEN ISLAND/PENNISULA COUNTER & AT 18" AFF IN BEDROOMS. CONSULT ARCHITECT AND/OR INTERIOR DESIGNER FOR ADDITIONAL LOCATIONS WHERE REQUIRED.
- INDOOR HEAT PUMP UNIT INTERCONNECTED WITH OUTDOOR UNIT LOCATED ON ROOF. CONTRACTOR SHALL COORDINATE WITH THE MECHANICAL HVAC INSTALLER AND MECHANICAL PLANS FOR EXACT POWER REQUIREMENTS & LOCATION OF EACH UNIT PRIOR TO ROUGH IN.
- COORDINATE WITH MECHANICAL EQUIPMENT INSTALLER FOR EXACT POWER REQUIREMENTS, CONTROLS & LOCATION OF THRU-WALL FAN. TIE INTO BEDROOM RECEPTACLE CIRCUIT.
- MOUNT DEVICES HORIZONTALLY, UNDER WINDOW SILL.
- RECEPTACLE MOUNTED IN FACE OF CABINET.
- COORDINATE WITH MECHANICAL EQUIPMENT INSTALLER FOR EXACT POWER REQUIREMENTS & LOCATION OF CONTINUOUS OPERATING EXHAUST FAN. TIE INTO LIVING ROOM LIGHTING RECEPTACLE CIRCUIT.
- PROVIDE POWER CONNECTION FOR BRANCH BOX, TIED INTO THE MINI-SPLIT SYSTEM, FROM THE TENANT LOAD CENTER. COORDINATE WORK WITH THE MECHANICAL EQUIPMENT INSTALLER.
- IN UNITS AT THE PT DECK, PROVIDE SURFACE MOUNTED RECEPTACLES AT STANDARD MOUNTING HEIGHT ON THE CORNER COLUMN. CONSULT ARCHITECT FOR ADDITIONAL INFORMATION.

M F I A
Consulting Engineers
2007 S.E. Ash St.
Portland, OR 97214
PHN: (503) 234-0548
FAX: (503) 234-0677
CONTACT: DENISE TAYLOR




PROJECT # 2017-053
DATE: 11/06/2019
REVISIONS
PLAN REVIEW 01.24.2020
PLAN REVIEW 03.13.2020
PLAN REVIEW 04.24.2020
PLAN REVIEW 08.10.2020
PLAN REVIEW 09.17.2020
PLAN REVIEW 10.16.2020
PLAN REVIEW 11.25.2020
PLAN REVIEW 03.26.2021
PLAN REVIEW 07.15.2021
COORDINATION 08.27.2021
COORDINATION 11.05.2021
COORDINATION 12.10.2021


AEGIS
MIXED-USE DEVELOPMENT
312 E EVERGREEN BOULEVARD, VANCOUVER, WA 98660

SHEET:


E4.13

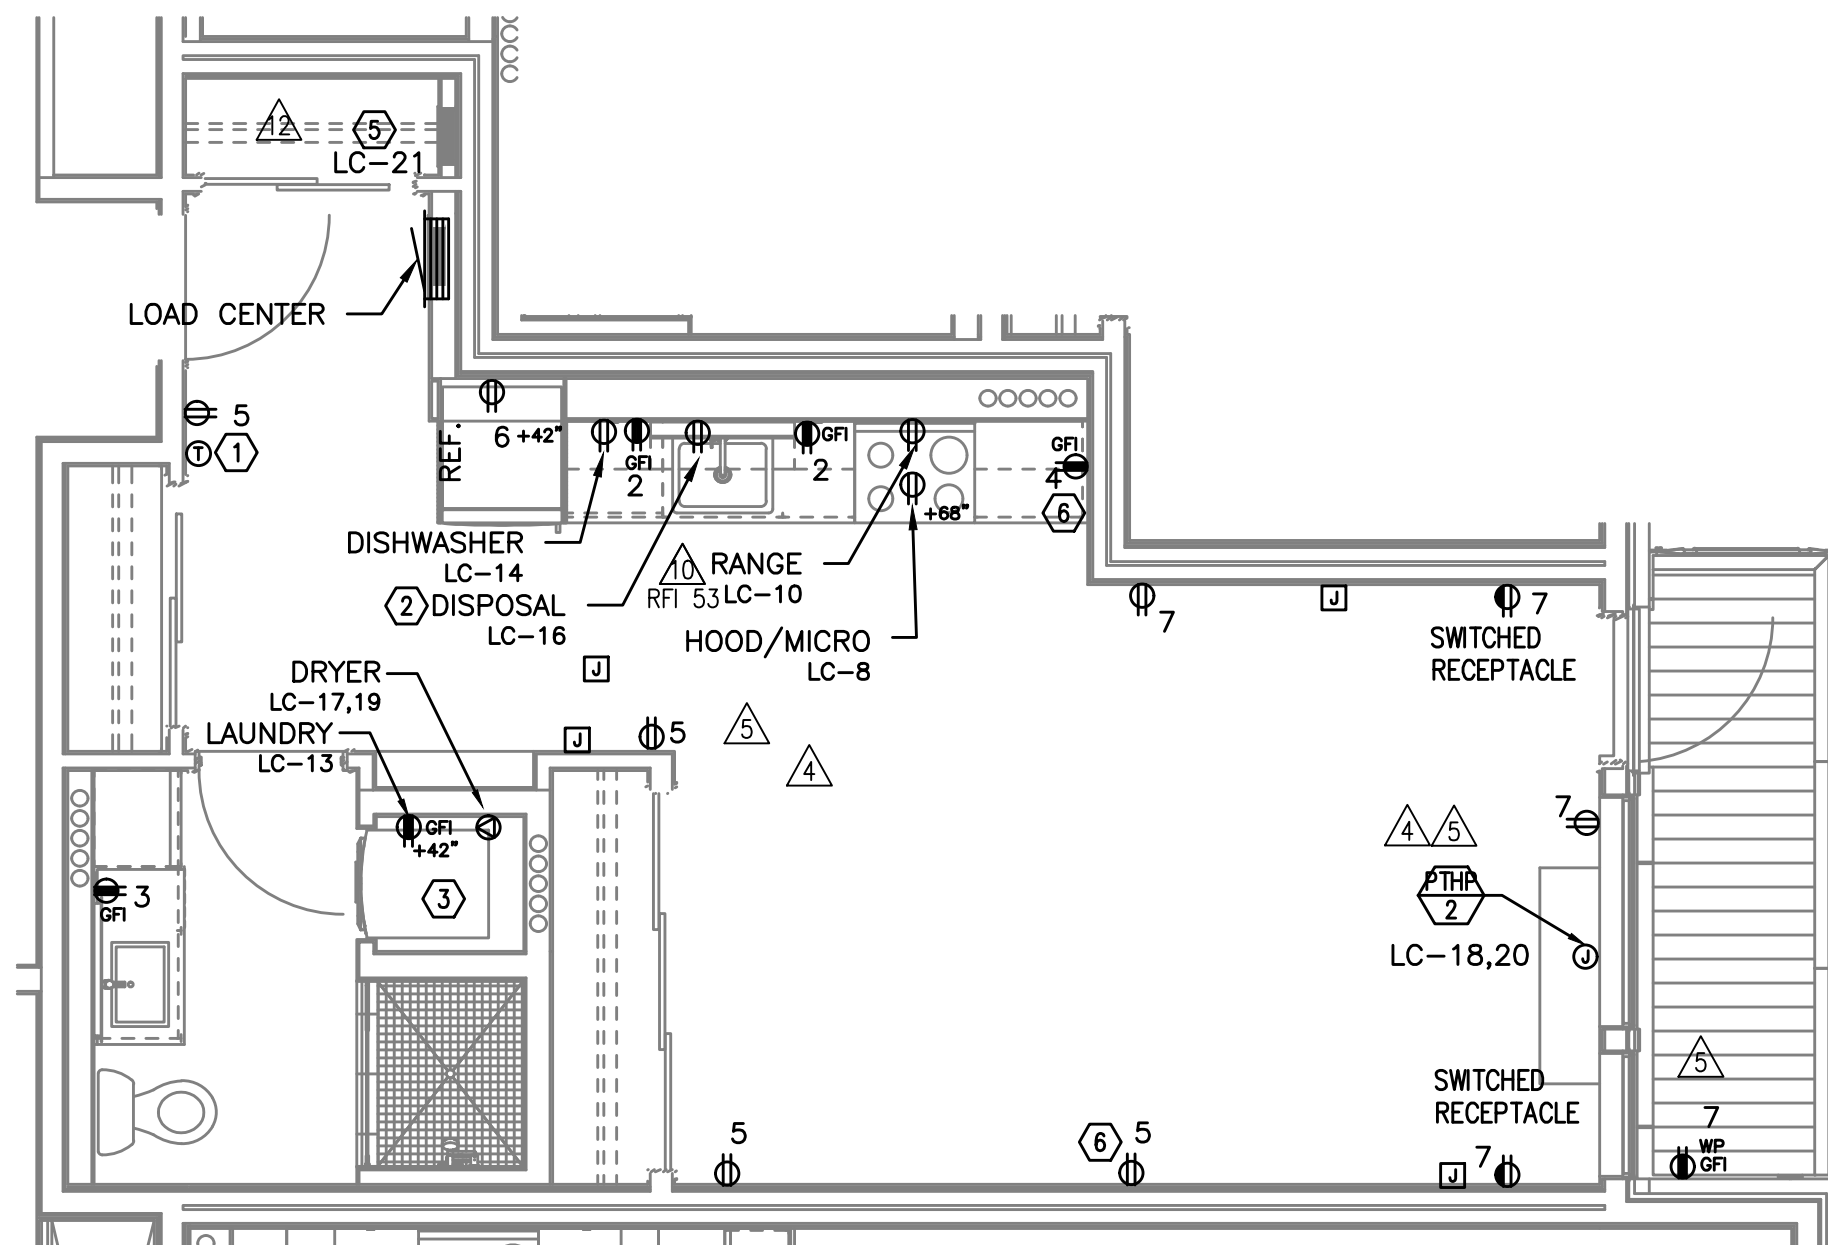


1
E4.14
TYPICAL UNIT TYPE H
0 BED/2 BATH – POWER PLAN
SCALE: 1/4" = 1'-0"

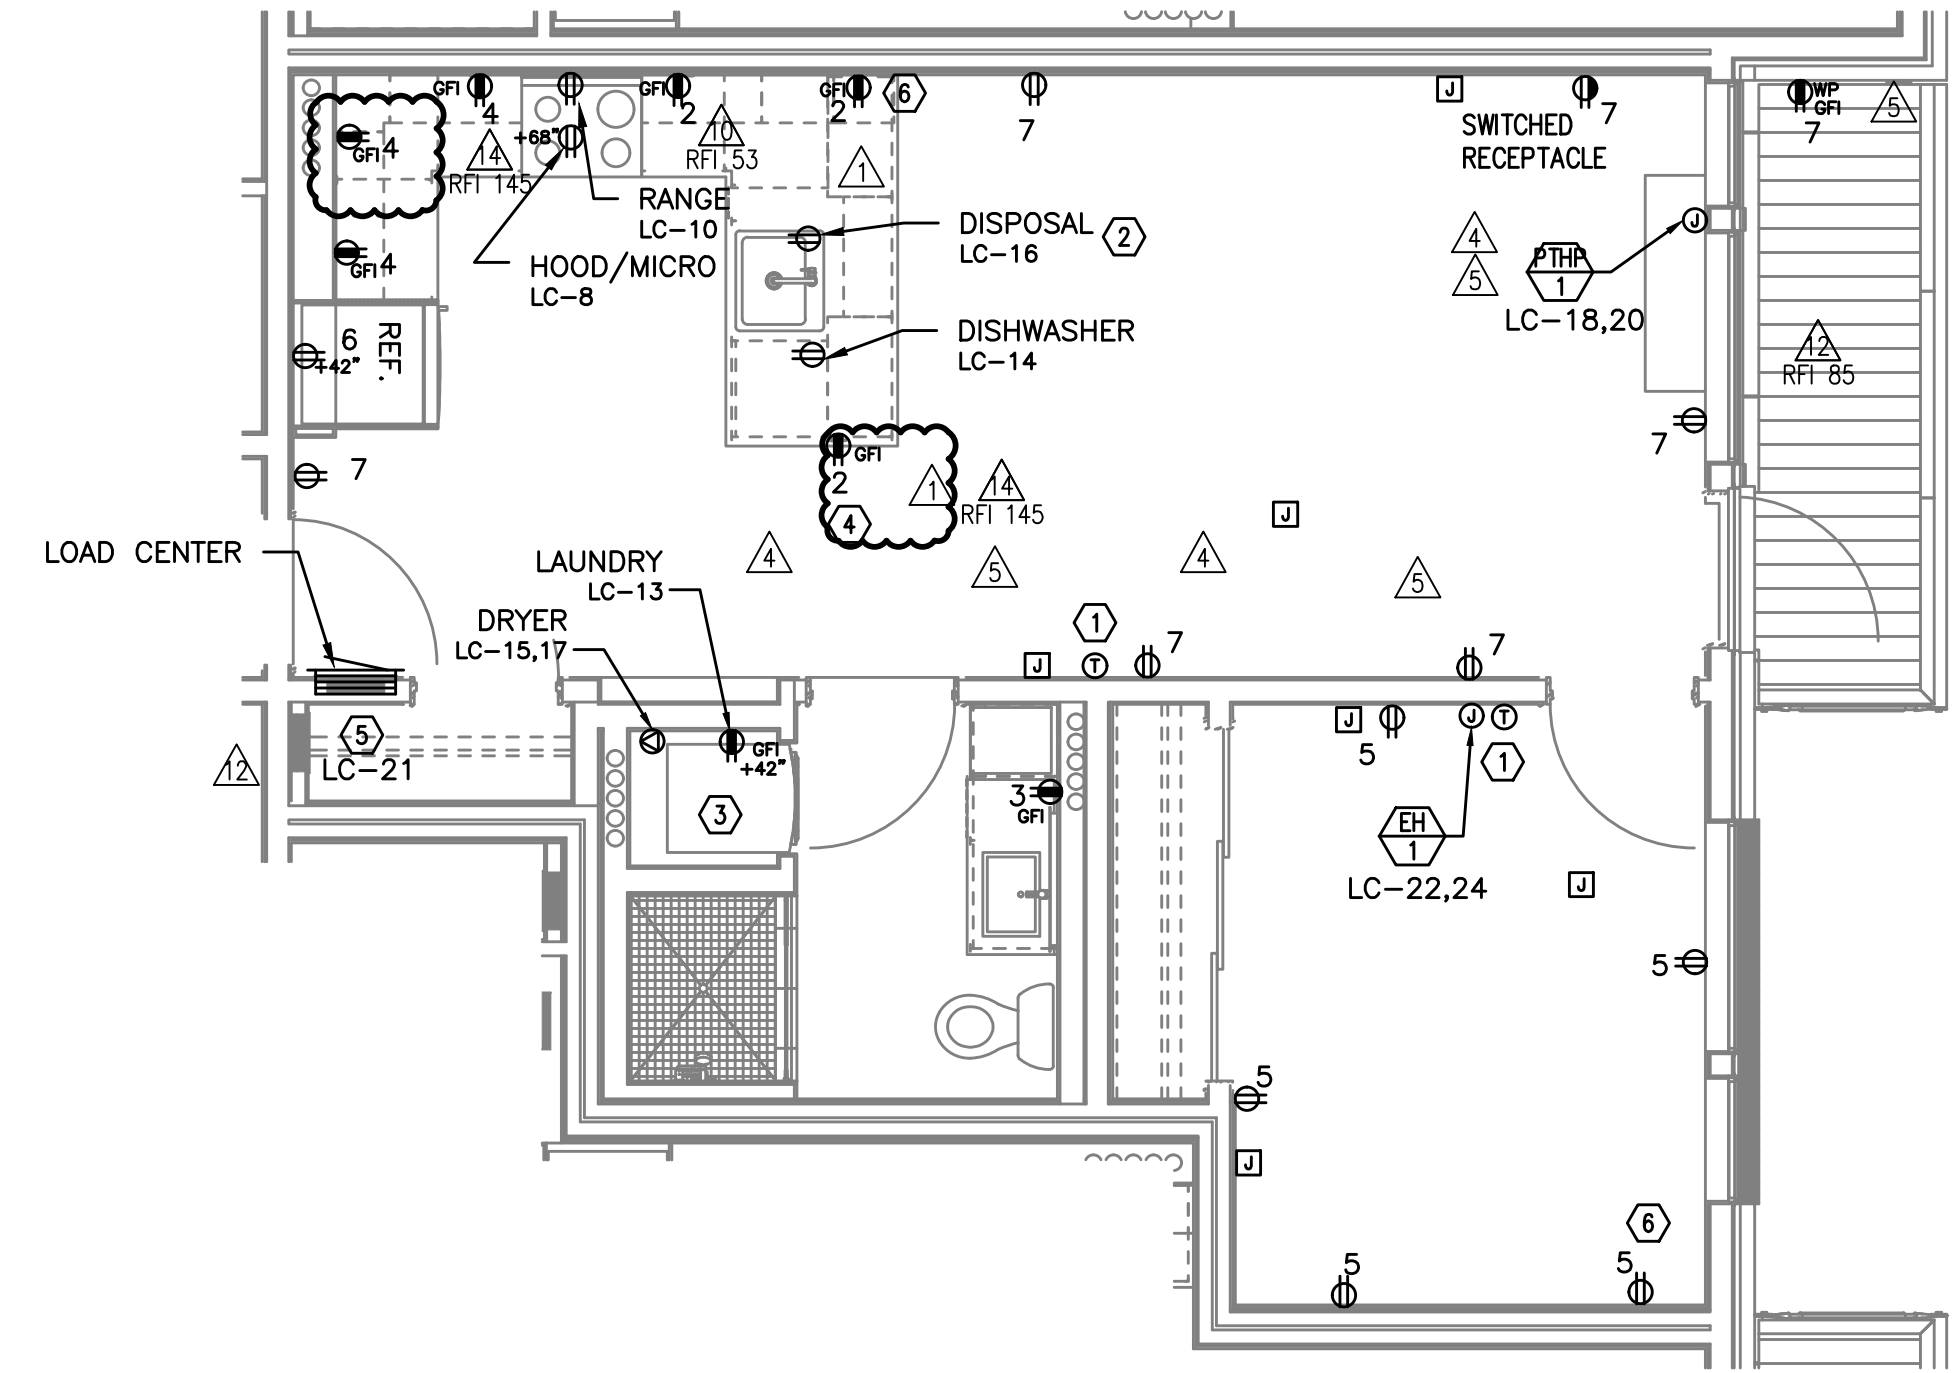

2
E4.14
TYPICAL UNIT TYPE I
1 BED/1 BATH – POWER PLAN
SCALE: 1/4" = 1'-0"

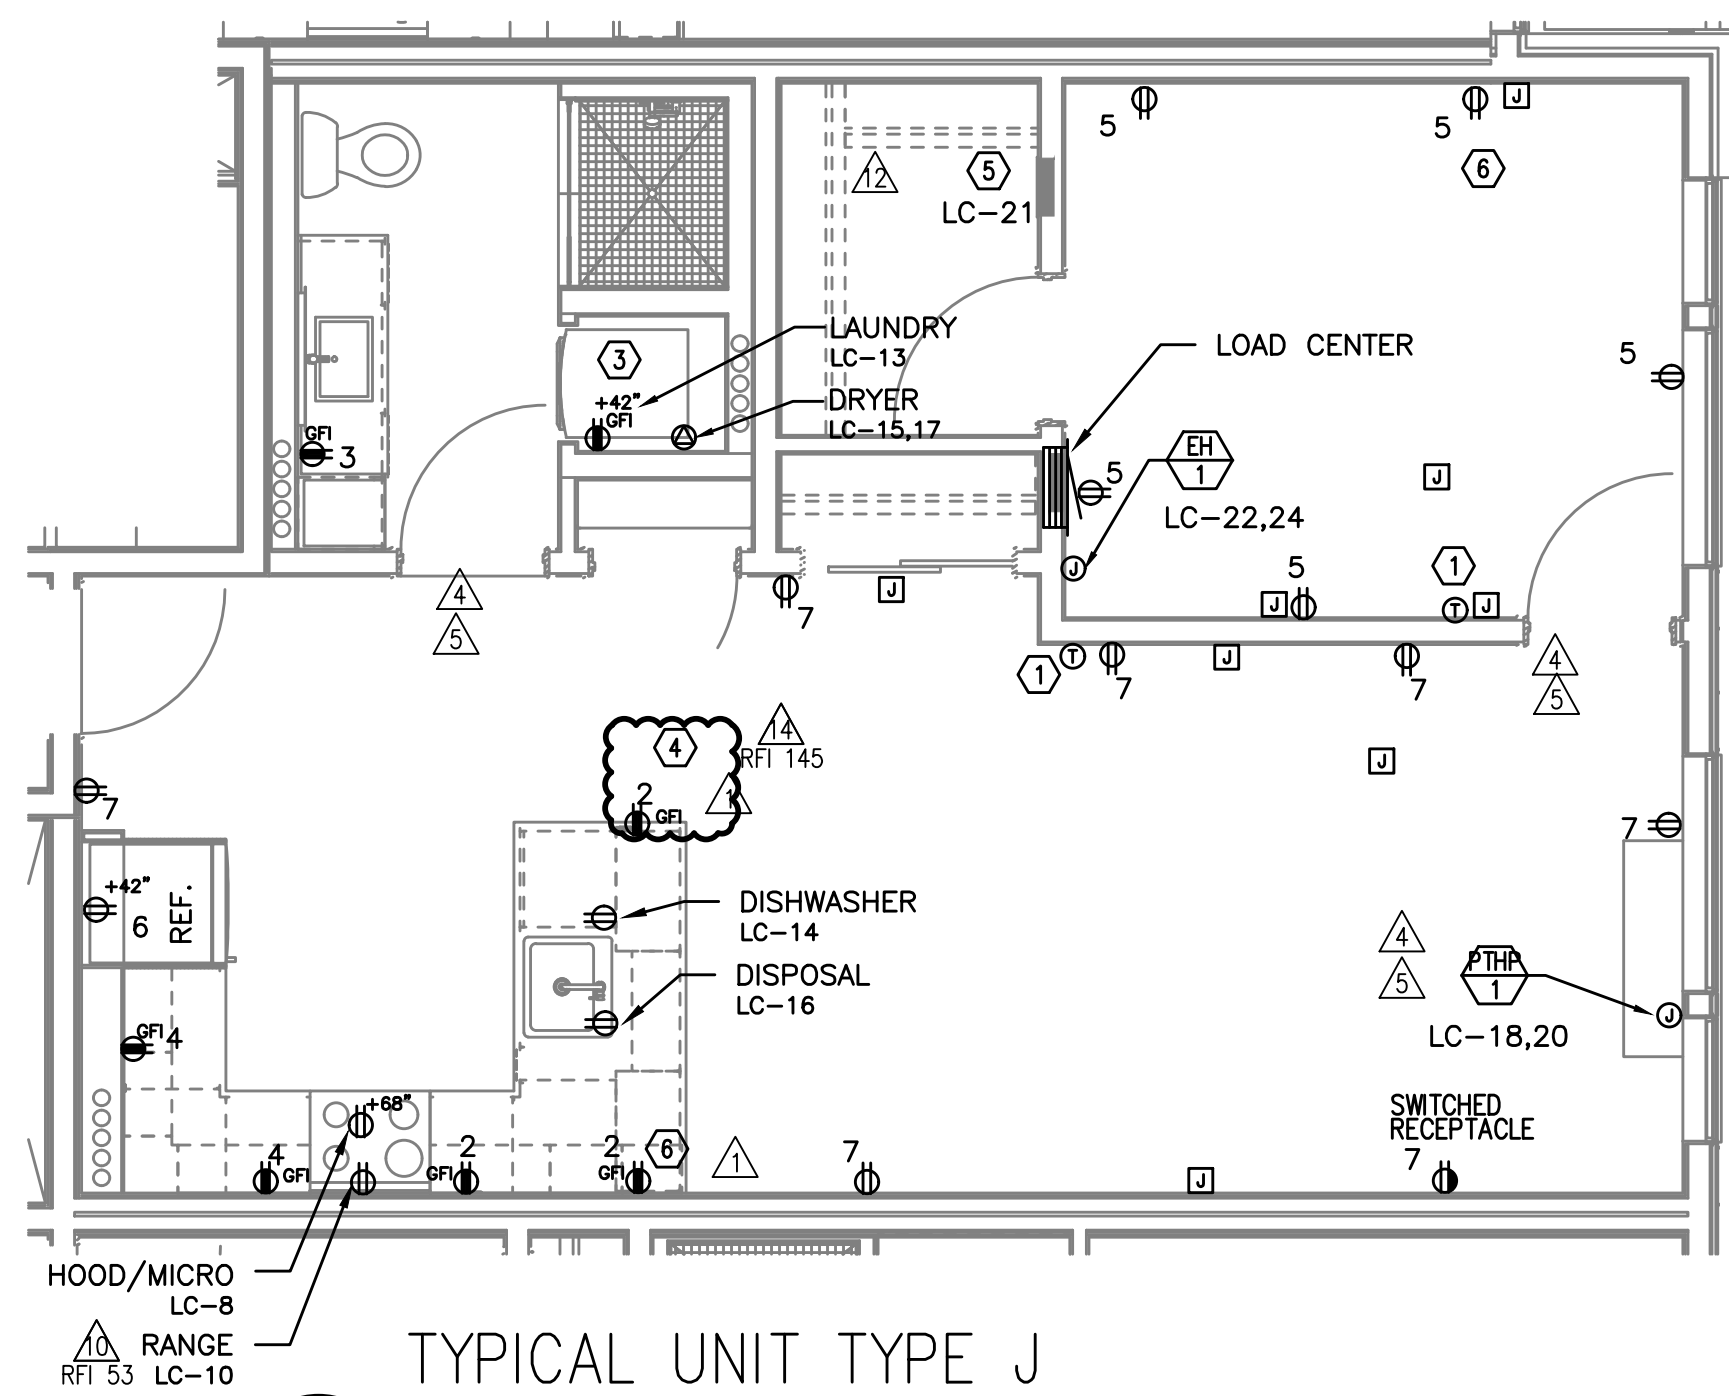

3
E4.14
TYPICAL UNIT TYPE J
1 BED/1 BATH – POWER PLAN
SCALE: 1/4" = 1'-0"

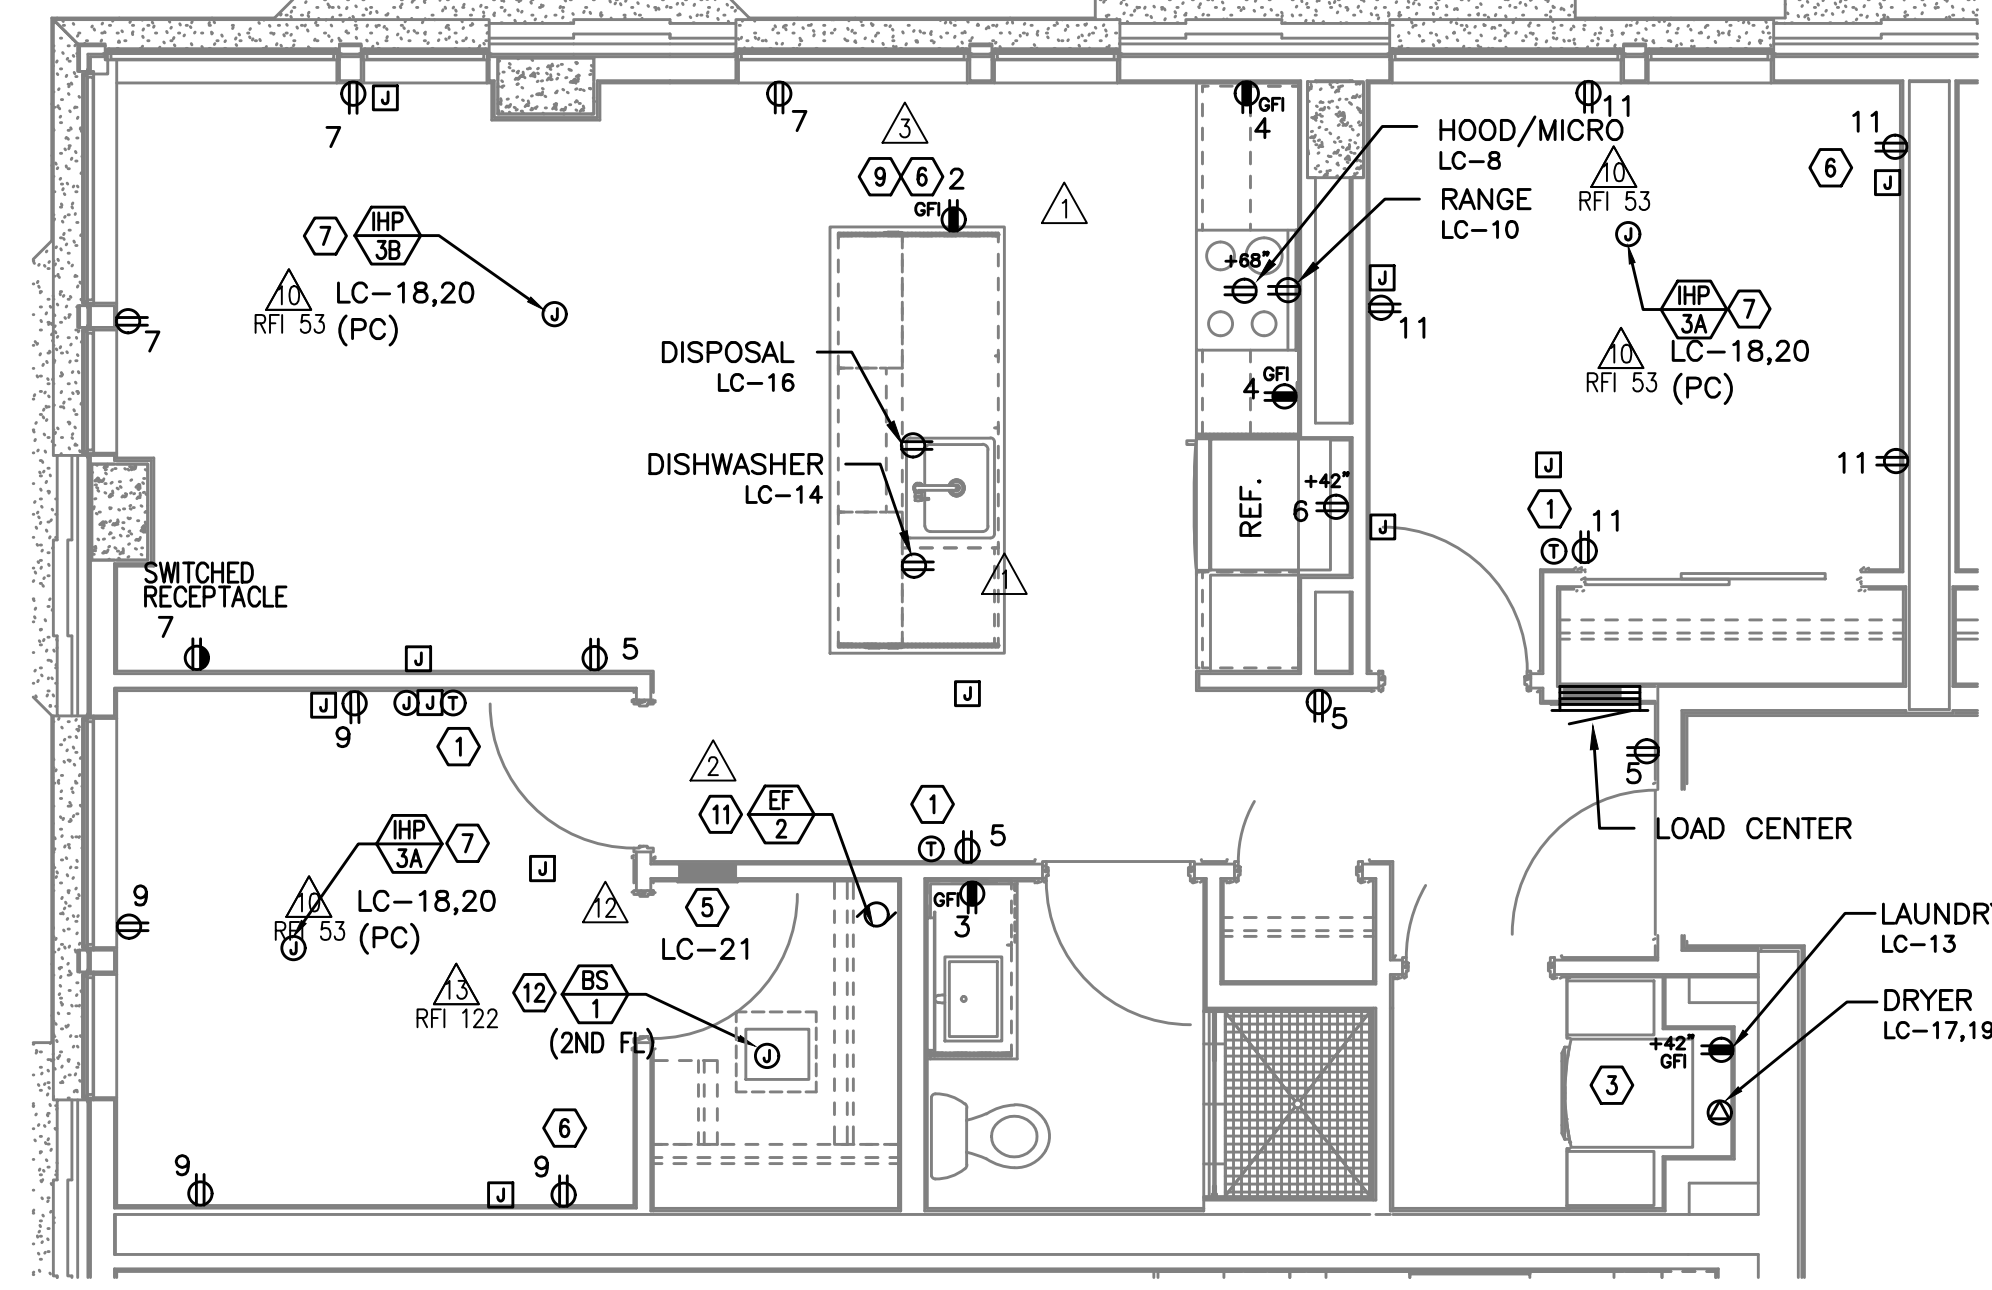

4
E4.14
TYPICAL UNIT TYPE K
2 BED/1 BATH – POWER PLAN
SCALE: 1/4" = 1'-0"

GENERAL NOTES:

- KITCHEN RECEPTACLES LOCATED IN ISLANDS OR PENINSULAS WHERE THE BACK SPLASH WILL NOT ACCOMMODATE VERTICAL PLACEMENT OR THE DUPLEX RECEPTACLE, THE CONTRACTOR SHALL ROTATE THE DEVICE 90 DEGREES SO THAT THE RECEPTACLE IS INSTALLED HORIZONTALLY.
- REFER TO DETAILS ON SHEET E1.23 FOR ADDITIONAL INFORMATION REGARDING ADA REACH REQUIREMENTS FOR RECEPTACLE AND SWITCH MOUNTING HEIGHT.
- STANDARD RECEPTACLE MOUNTING HEIGHT IS 18" A.F.F. UNLESS OTHERWISE SPECIFIED. RECEPTACLES LOCATED BELOW WINDOW SILLS SHALL NOT BE LESS THE 15" A.F.F.
- ALL PLANS ARE DIAGRAMMATICAL. CONSULT ARCHITECTURAL PLANS AND ELEVATIONS FOR EXACT LOCATION AND MOUNTING HEIGHT OF ALL DEVICES AND FIXTURES.
- REFER TO SHEET E1.17 FOR TYPICAL UNIT LOAD CENTER DIRECTORIES.
- RECEPTACLE FOR PTHP UNIT SHALL BE LOCATED BELOW THE UNIT, NEAR THE BASE OF THE WALL SUCH THAT THE CORD SET IS CONCEALED AS MUCH AS POSSIBLE. COORDINATE INSTALLATION WITH THE MECHANICAL INSTALLER.
- COORDINATE WITH THE "T" SERIES SHEETS AND PROVIDE ROUGH IN FOR LOW VOLTAGE SYSTEMS () REFERS TO ROUGH IN BOXES.
- ALL KITCHEN COUNTER TOP RECEPTACLES SHALL BE INSTALLED A MINIMUM OF 36" FROM A CORNER WALL PER ADA REQUIREMENTS. WHERE COUNTERS ARE NOT LONG ENOUGH TO ACCOMMODATE THIS, THE RECEPTACLE SHALL BE PLACED ON AN END WALL, NO MORE THAN 12" FROM THE FRONT EDGE OF THE COUNTER.

KEYED NOTES:

- PROVIDE WIRE CONNECTION FOR THERMOSTAT(S). COORDINATE WITH MECHANICAL INSTALLER FOR EXACT LOCATION AND POWER REQUIREMENTS PRIOR TO ROUGH IN. THERMOSTATS TO BE MOUNTED AT 48" AFF MAX. TO HIGHEST OPERABLE PART.
- PROVIDE ONE 20A, 120V, 1P GFCI DUPLEX RECEPTACLE UNDER KITCHEN SINK FOR DISPOSAL POWER CONNECTION. DISPOSAL TO BE PROVIDED WITH "SAFEAIRE" SINK DISPOSAL AIR SWITCH, MOUNTED PER ARCHITECT'S DIRECTION. VERIFY DEVICE FINISH WITH ARCHITECT PRIOR TO ORDERING.
- REFER TO DETAIL 2/E1.17 FOR TYPICAL LAUNDRY ALCOVE RECEPTACLE LOCATIONS. COORDINATE INSTALLATION WITH MECHANICAL & PLUMBING CONTRACTOR.
- MOUNT DEVICES HORIZONTALLY, JUST UNDER THE EDGE OF THE COUNTER TOP.
- PROVIDE ONE 15A, RECEPTACLE CIRCUIT FROM TENANT LOAD CENTER FOR TELECOM SMART PANEL. COORDINATE WORK WITH SERVICE PROVIDER FOR EXACT LOCATION AND FINAL CONNECTION.
- PROVIDE ONE 20A, 120V, 1P RECEPTACLE WITH USB PORT, MOUNTED AT 44" A.F.F. (MAX) AT KITCHEN ISLAND/PENINSULA COUNTER & AT 18" AFF IN BEDROOMS. CONSULT ARCHITECT AND/OR INTERIOR DESIGNER FOR ADDITIONAL LOCATIONS WHERE REQUIRED.
- INDOOR HEAT PUMP UNIT INTERCONNECTED WITH OUTDOOR UNIT LOCATED ON ROOF. CONTRACTOR SHALL COORDINATE WITH THE MECHANICAL HVAC INSTALLER AND MECHANICAL PLANS FOR EXACT POWER REQUIREMENTS & LOCATION OF EACH UNIT PRIOR TO ROUGH IN.
- COORDINATE WITH MECHANICAL EQUIPMENT INSTALLER FOR EXACT POWER REQUIREMENTS, CONTROLS & LOCATION OF THRU-WALL FAN. TIE INTO BEDROOM RECEPTACLE CIRCUIT.
- MOUNT DEVICES HORIZONTALLY, UNDER WINDOW SILL.
- RECEPTACLE MOUNTED IN FACE OF CABINET.
- COORDINATE WITH MECHANICAL EQUIPMENT INSTALLER FOR EXACT POWER REQUIREMENTS & LOCATION OF CONTINUOUS OPERATING EXHAUST FAN. TIE INTO LIVING ROOM LIGHTING RECEPTACLE CIRCUIT.
- PROVIDE POWER CONNECTION FOR BRANCH BOX, TIED INTO THE MINI-SPLIT SYSTEM, FROM THE TENANT LOAD CENTER. COORDINATE WORK WITH THE MECHANICAL EQUIPMENT INSTALLER.
- IN UNITS AT THE PT DECK, PROVIDE SURFACE MOUNTED RECEPTACLES AT STANDARD MOUNTING HEIGHT ON THE CORNER COLUMN. CONSULT ARCHITECT FOR ADDITIONAL INFORMATION.




PROJECT #	2017-053
DATE:	11/06/2019
REVISIONS	
△	PLAN REVIEW 01.24.2020
△	PLAN REVIEW 03.13.2020
△	PLAN REVIEW 04.24.2020
△	PLAN REVIEW 08.10.2020
△	PLAN REVIEW 09.17.2020
△	PLAN REVIEW 10.16.2020
△	PLAN REVIEW 11.25.2020
△	PLAN REVIEW 03.26.2021
△	PLAN REVIEW 07.15.2021
△	COORDINATION 08.27.2021
△	COORDINATION 11.05.2021
△	COORDINATION 12.10.2021

AEGIS
MIXED-USE DEVELOPMENT
312 E EVERGREEN BOULEVARD, VANCOUVER, WA 98660


M
F
I
A
INC.
Consulting Engineers
2007 S.E. Ash St.
Portland, OR 97214
PHN: (503) 234-0548
FAX: (503) 234-0677
CONTACT: DENISE TAYLOR

SHEET:


E4.14

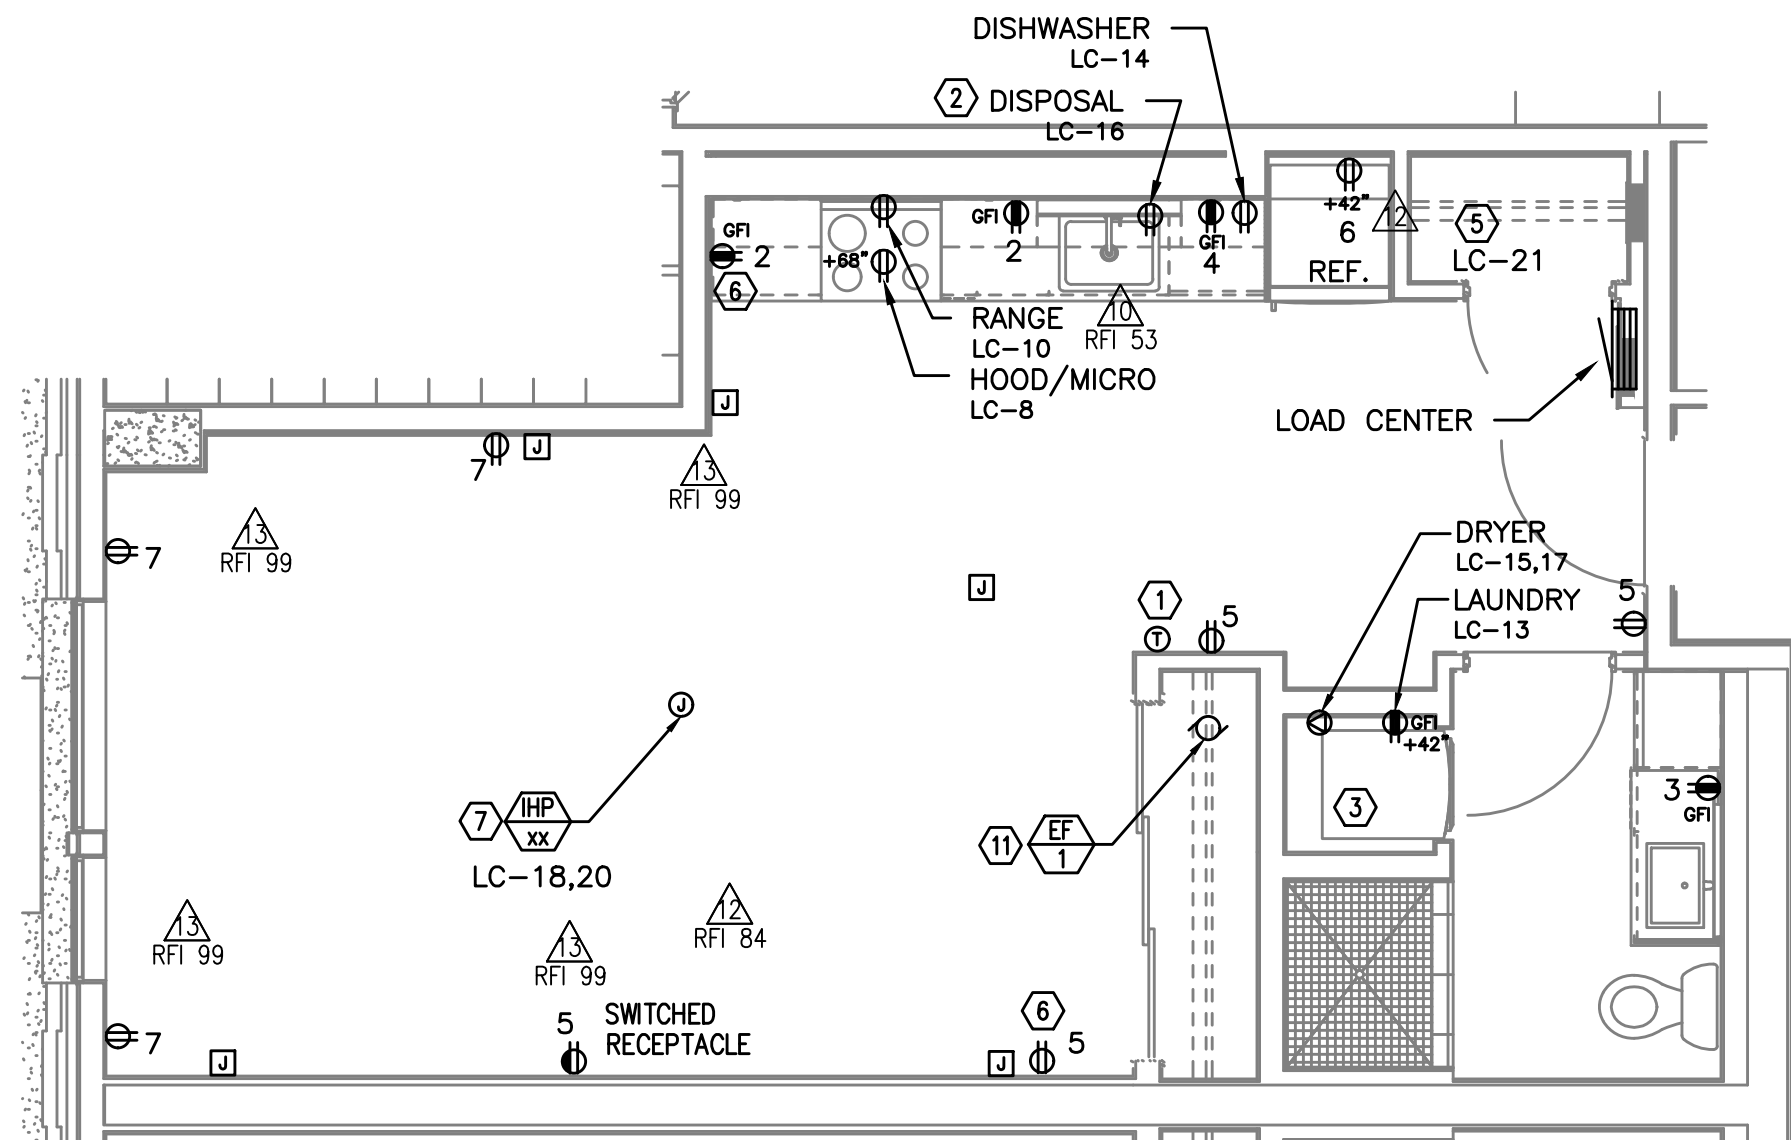


1
E4.15
TYPICAL UNIT TYPE L
0 BED/1 BATH – POWER PLAN
SCALE: 1/4" = 1'-0"

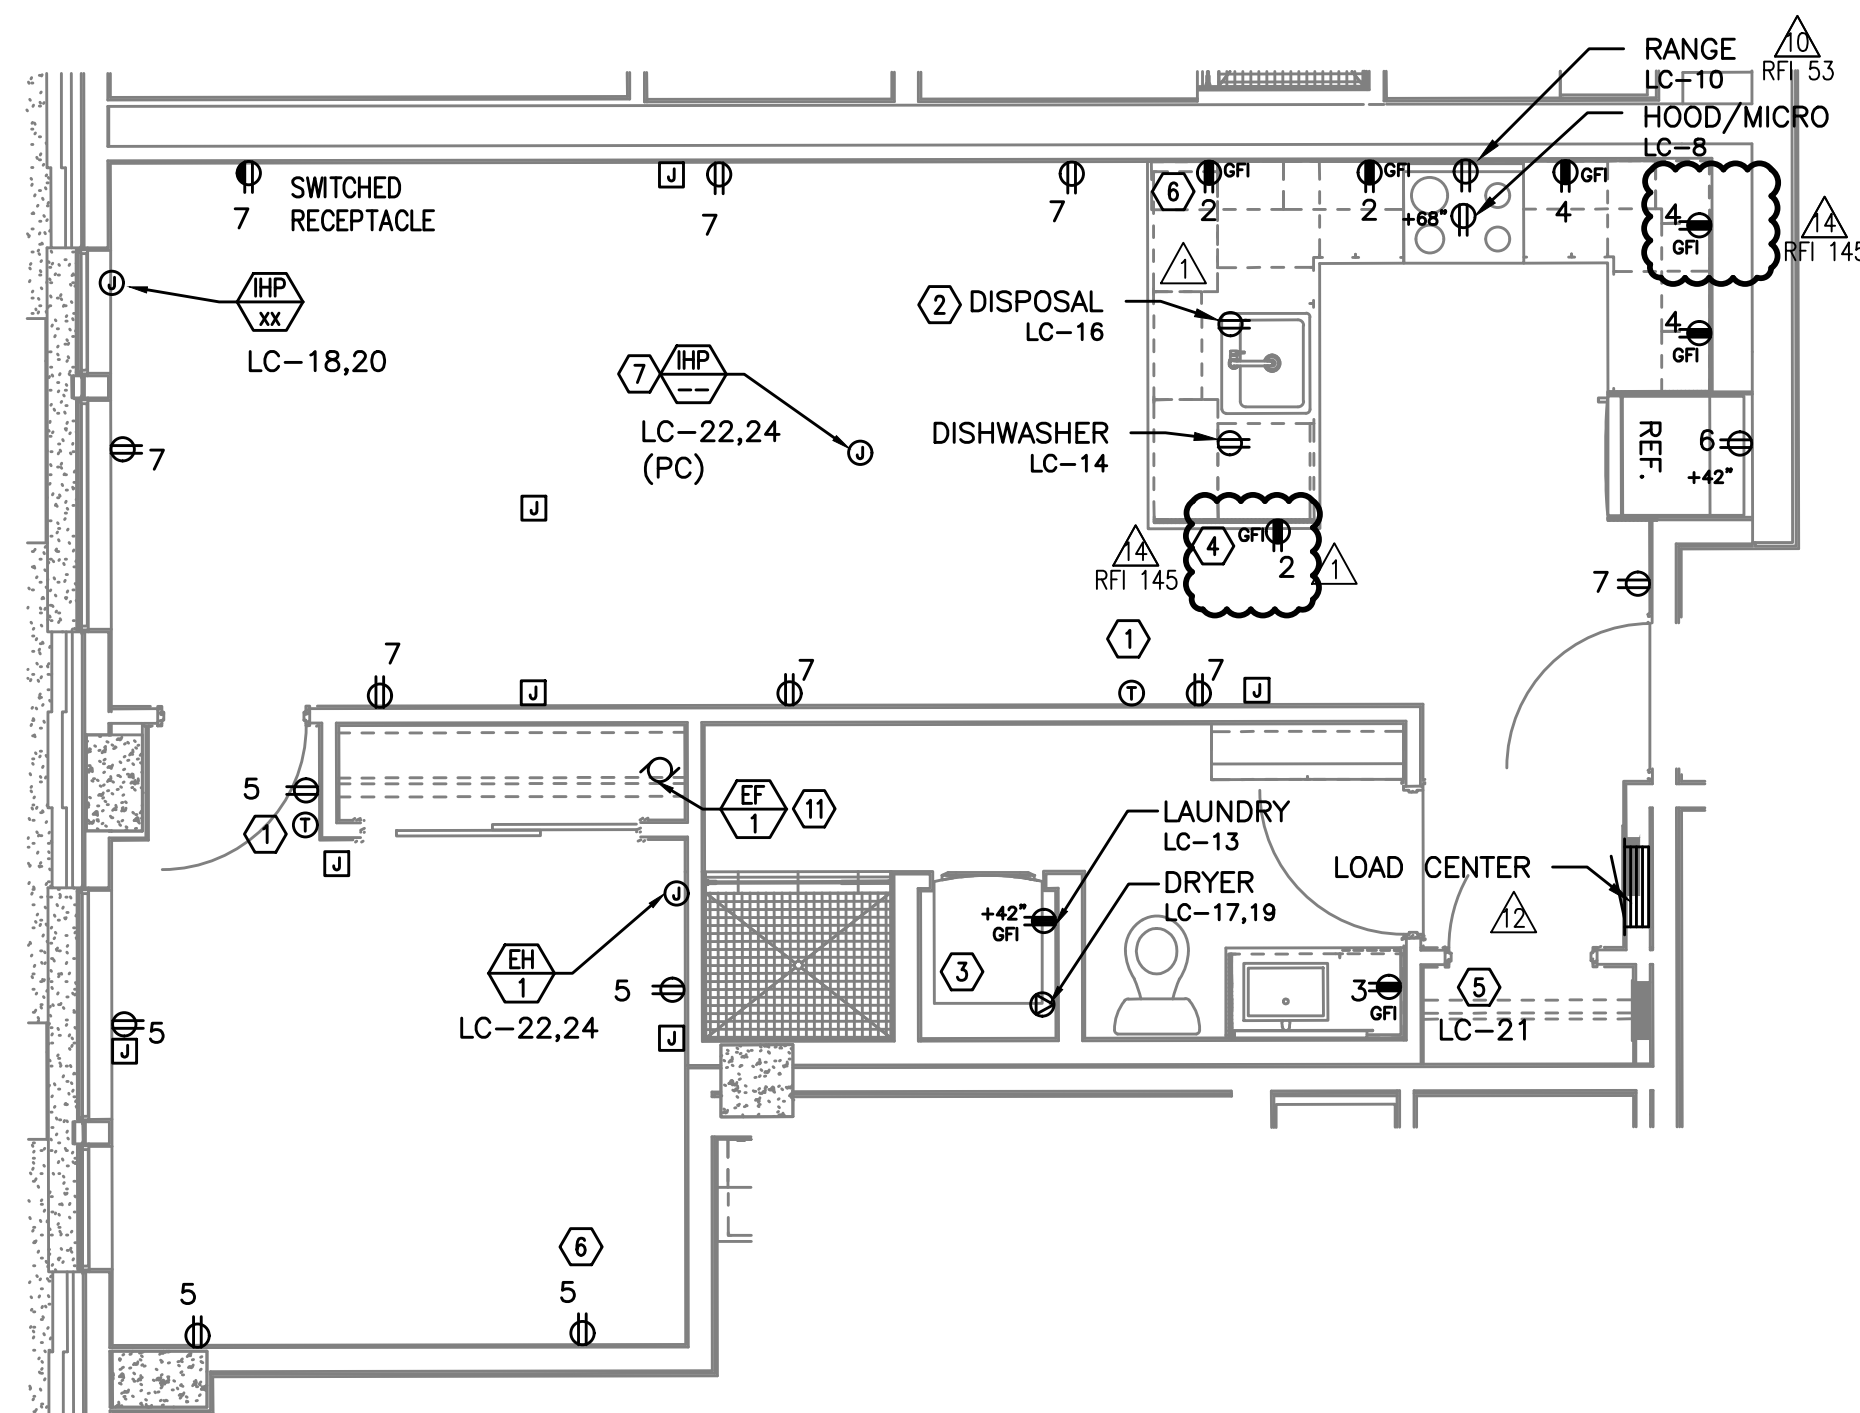

3
E4.15
TYPICAL UNIT TYPE M
1 BED/1 BATH – POWER PLAN
SCALE: 1/4" = 1'-0"

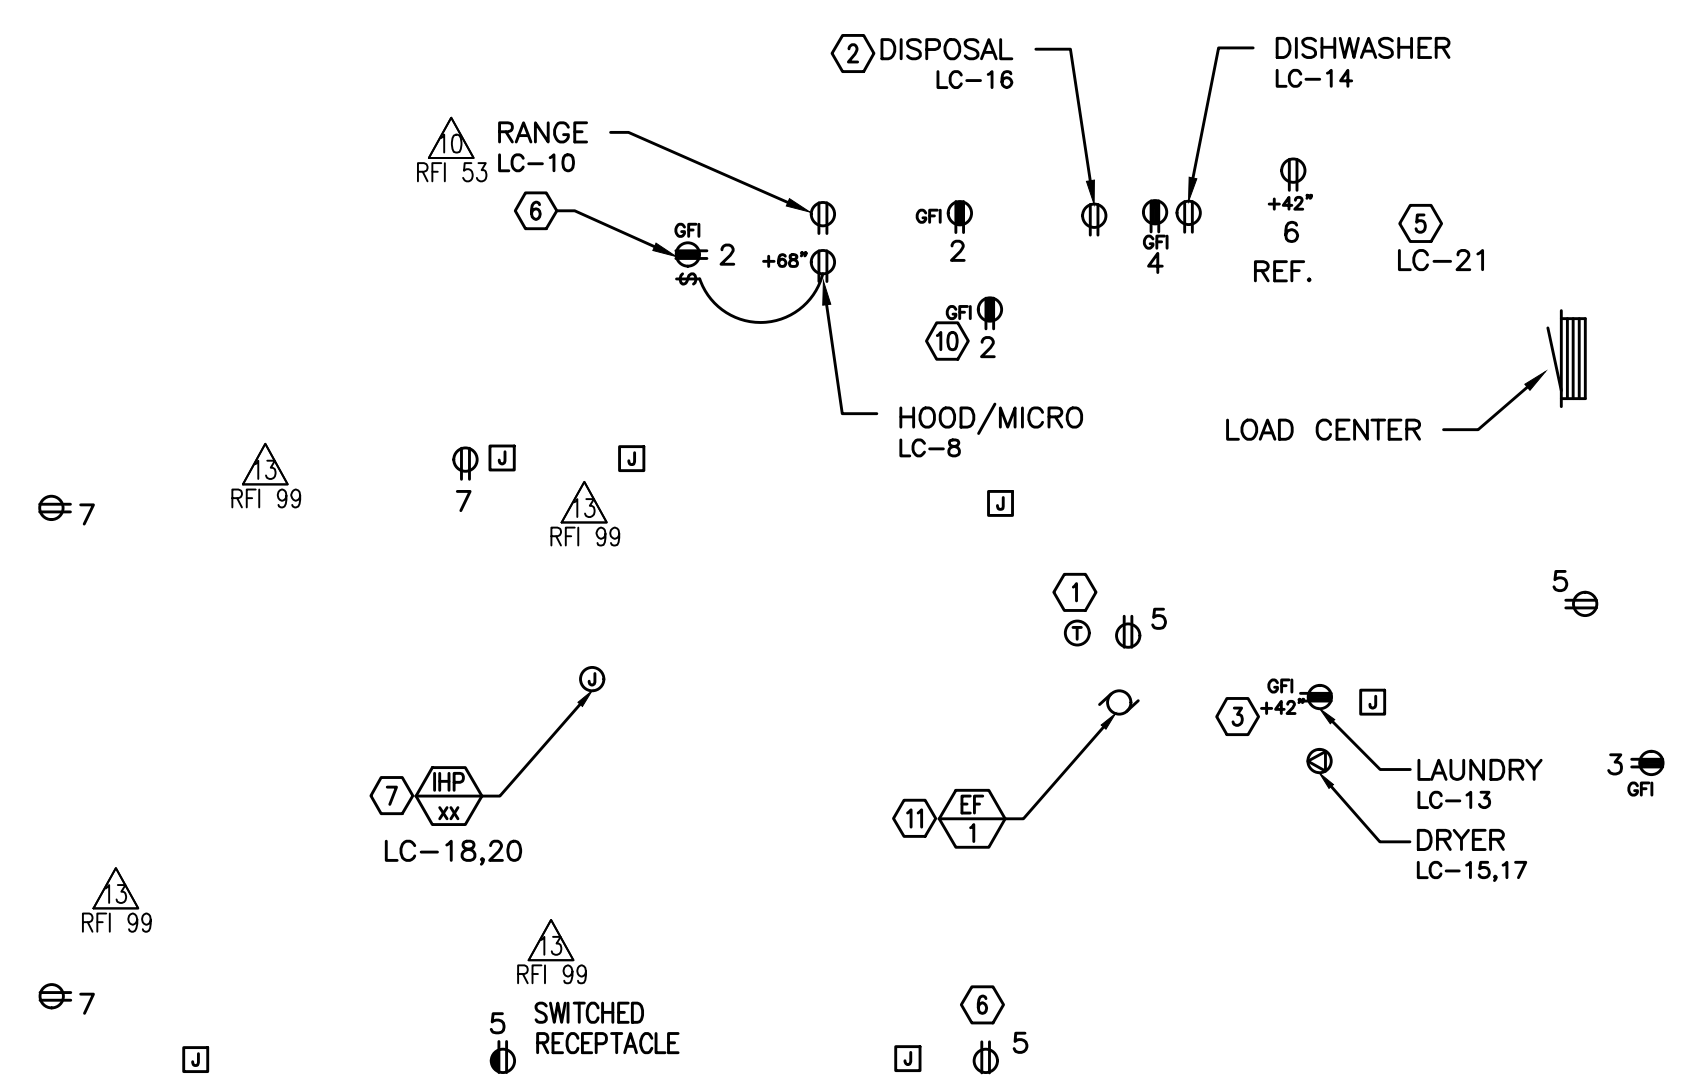

2
E4.15
TYPICAL UNIT TYPE L-ADA
0 BED/1 BATH – POWER PLAN
SCALE: 1/4" = 1'-0"

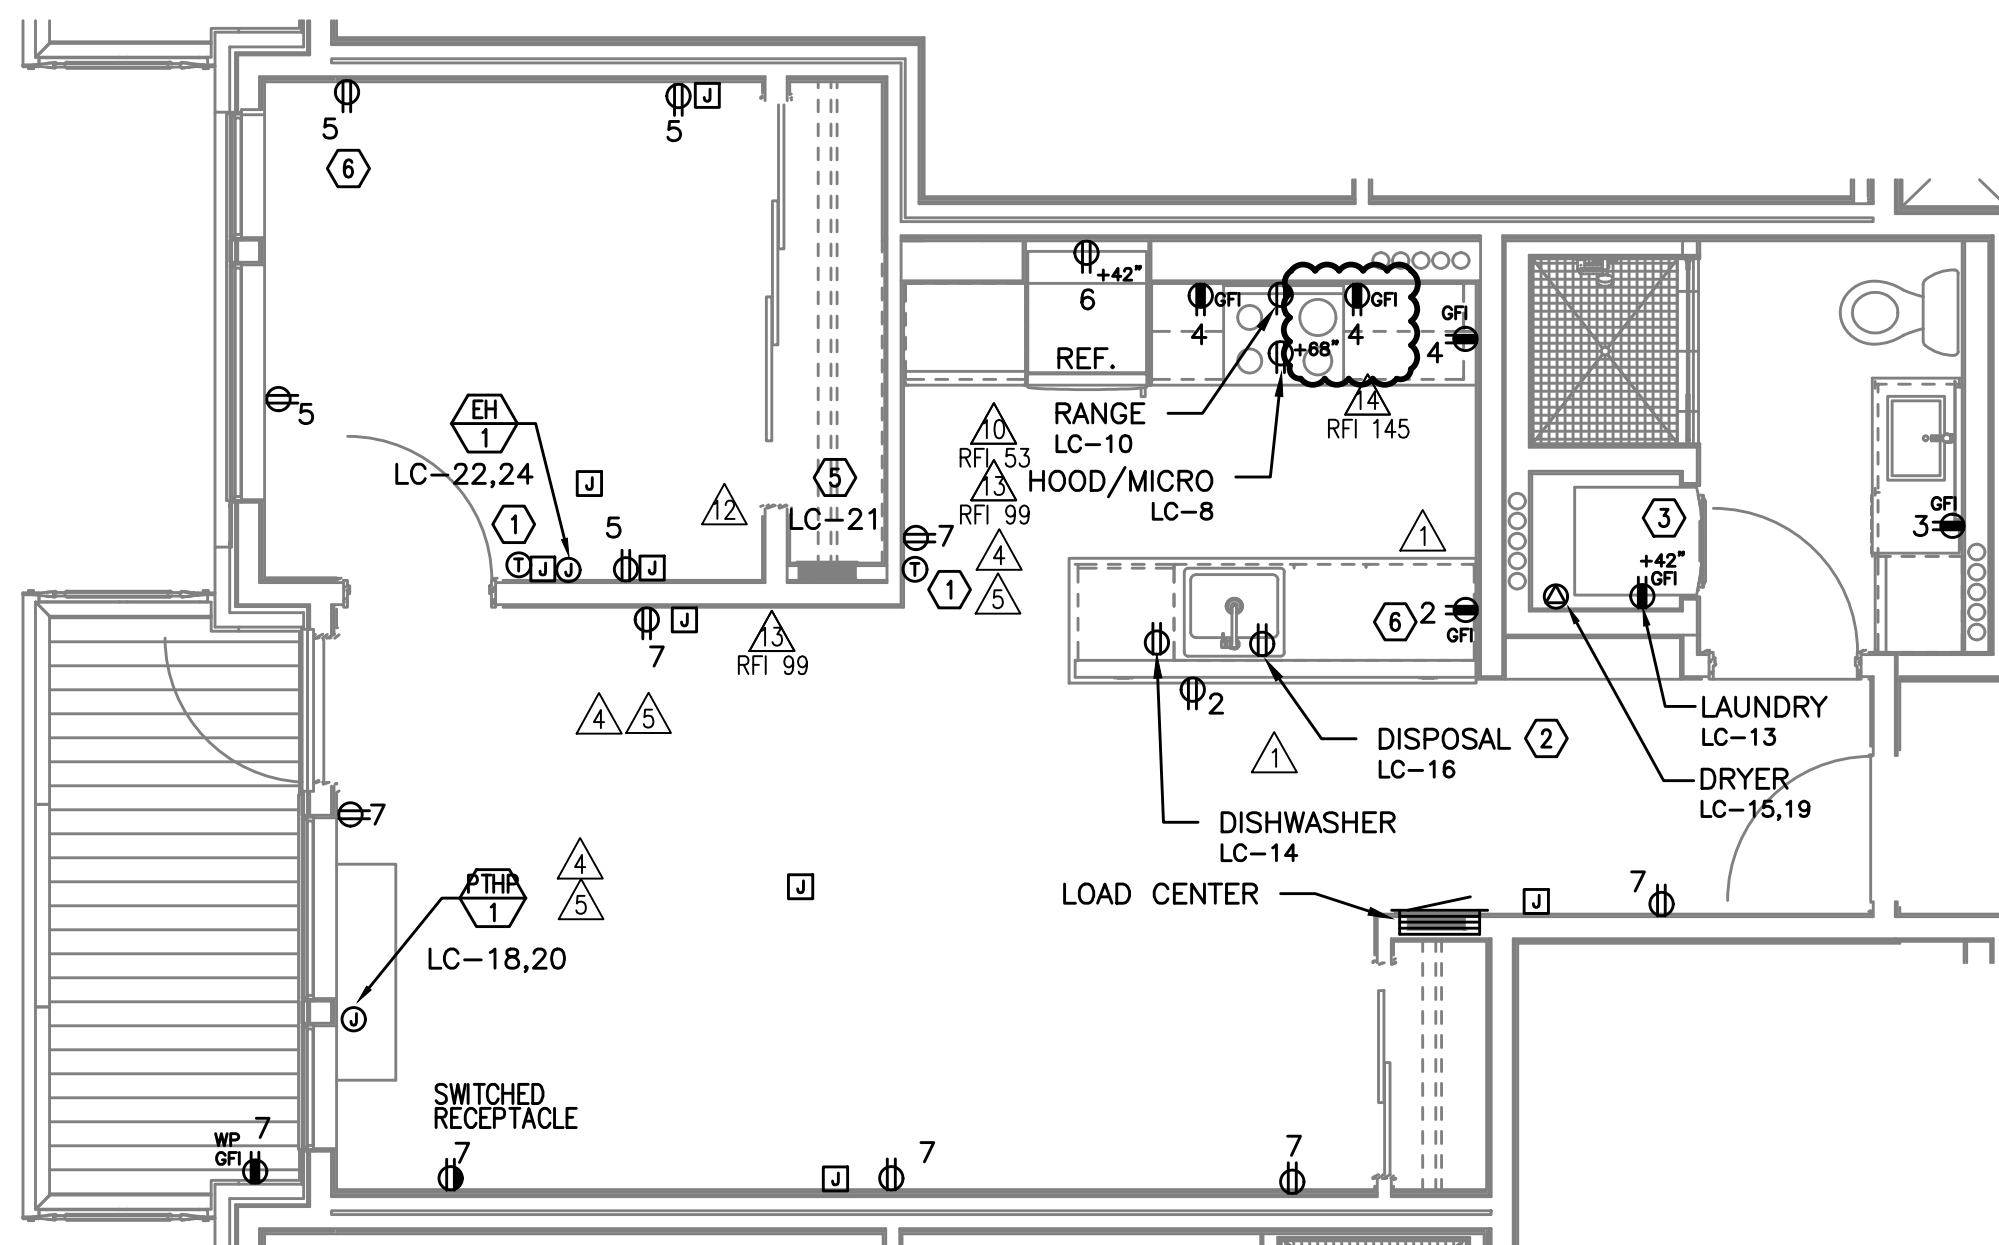

4
E4.15
TYPICAL UNIT TYPE N
1 BED/1 BATH – POWER PLAN
SCALE: 1/4" = 1'-0"

GENERAL NOTES:

- KITCHEN RECEPTACLES LOCATED IN ISLANDS OR PENINSULAS WHERE THE BACK SPLASH WILL NOT ACCOMMODATE VERTICAL PLACEMENT OR THE DUPLEX RECEPTACLE, THE CONTRACTOR SHALL ROTATE THE DEVICE 90 DEGREES SO THAT THE RECEPTACLE IS INSTALLED HORIZONTALLY.
- REFER TO DETAILS ON SHEET E1.23 FOR ADDITIONAL INFORMATION REGARDING ADA REACH REQUIREMENTS FOR RECEPTACLE AND SWITCH MOUNTING HEIGHT.
- STANDARD RECEPTACLE MOUNTING HEIGHT IS 18" A.F.F. UNLESS OTHERWISE SPECIFIED. RECEPTACLES LOCATED BELOW WINDOW SILLS SHALL NOT BE LESS THE 15" A.F.F.
- ALL PLANS ARE DIAGRAMMATICAL. CONSULT ARCHITECTURAL PLANS AND ELEVATIONS FOR EXACT LOCATION AND MOUNTING HEIGHT OF ALL DEVICES AND FIXTURES.
- REFER TO SHEET E1.17 FOR TYPICAL UNIT LOAD CENTER DIRECTORIES.
- RECEPTACLE FOR PTHP UNIT SHALL BE LOCATED BELOW THE UNIT, NEAR THE BASE OF THE WALL SUCH THAT THE CORD SET IS CONCEALED AS MUCH AS POSSIBLE. COORDINATE INSTALLATION WITH THE MECHANICAL INSTALLER.
- COORDINATE WITH THE 'T' SERIES SHEETS AND PROVIDE ROUGH IN FOR LOW VOLTAGE SYSTEMS () REFERS TO ROUGH IN BOXES.
- ALL KITCHEN COUNTER TOP RECEPTACLES SHALL BE INSTALLED A MINIMUM OF 36" FROM A CORNER WALL PER ADA REQUIREMENTS. WHERE COUNTERS ARE NOT LONG ENOUGH TO ACCOMMODATE THIS, THE RECEPTACLE SHALL BE PLACED ON AN END WALL, NO MORE THAN 12" FROM THE FRONT EDGE OF THE COUNTER.

KEYED NOTES:

- PROVIDE WIRE CONNECTION FOR THERMOSTAT(S). COORDINATE WITH MECHANICAL INSTALLER FOR EXACT LOCATION AND POWER REQUIREMENTS PRIOR TO ROUGH IN. THERMOSTATS TO BE MOUNTED AT 48" AFF MAX. TO HIGHEST OPERABLE PART.
- PROVIDE ONE 20A, 120V, 1P GFCI DUPLEX RECEPTACLE UNDER KITCHEN SINK FOR DISPOSAL POWER CONNECTION. DISPOSAL TO BE PROVIDED WITH "SAFEAIRE" SINK DISPOSAL AIR SWITCH, MOUNTED PER ARCHITECT'S DIRECTION. VERIFY DEVICE FINISH WITH ARCHITECT PRIOR TO ORDERING.
- REFER TO DETAIL 2/E1.17 FOR TYPICAL LAUNDRY ALCOVE RECEPTACLE LOCATIONS. COORDINATE INSTALLATION WITH MECHANICAL & PLUMBING CONTRACTOR.
- MOUNT DEVICES HORIZONTALLY, JUST UNDER THE EDGE OF THE COUNTER TOP.
- PROVIDE ONE 15A, RECEPTACLE CIRCUIT FROM TENANT LOAD CENTER FOR TELECOM SMART PANEL. COORDINATE WORK WITH SERVICE PROVIDER FOR EXACT LOCATION AND FINAL CONNECTION.
- PROVIDE ONE 20A, 120V, 1P RECEPTACLE WITH USB PORT, MOUNTED AT 44" A.F.F. (MAX) AT KITCHEN ISLAND/PENINSULA COUNTER & AT 18" AFF IN BEDROOMS. CONSULT ARCHITECT AND/OR INTERIOR DESIGNER FOR ADDITIONAL LOCATIONS WHERE REQUIRED.
- INDOOR HEAT PUMP UNIT INTERCONNECTED WITH OUTDOOR UNIT LOCATED ON ROOF. CONTRACTOR SHALL COORDINATE WITH THE MECHANICAL HVAC INSTALLER AND MECHANICAL PLANS FOR EXACT POWER REQUIREMENTS & LOCATION OF EACH UNIT PRIOR TO ROUGH IN.
- COORDINATE WITH MECHANICAL EQUIPMENT INSTALLER FOR EXACT POWER REQUIREMENTS, CONTROLS & LOCATION OF THRU-WALL FAN. TIE INTO BEDROOM RECEPTACLE CIRCUIT.
- MOUNT DEVICES HORIZONTALLY, UNDER WINDOW SILL.
- RECEPTACLE MOUNTED IN FACE OF CABINET.
- COORDINATE WITH MECHANICAL EQUIPMENT INSTALLER FOR EXACT POWER REQUIREMENTS & LOCATION OF CONTINUOUS OPERATING EXHAUST FAN. TIE INTO LIVING ROOM LIGHTING RECEPTACLE CIRCUIT.
- PROVIDE POWER CONNECTION FOR BRANCH BOX, TIED INTO THE MINI-SPLIT SYSTEM, FROM THE TENANT LOAD CENTER. COORDINATE WORK WITH THE MECHANICAL EQUIPMENT INSTALLER.
- IN UNITS AT THE PT DECK, PROVIDE SURFACE MOUNTED RECEPTACLES AT STANDARD MOUNTING HEIGHT ON THE CORNER COLUMN. CONSULT ARCHITECT FOR ADDITIONAL INFORMATION.




PROJECT # 2017-053
DATE: 11/06/2019
REVISIONS
PLAN REVIEW 01.24.2020
PLAN REVIEW 03.13.2020
PLAN REVIEW 04.24.2020
PLAN REVIEW 08.10.2020
PLAN REVIEW 09.17.2020
PLAN REVIEW 10.16.2020
PLAN REVIEW 11.25.2020
PLAN REVIEW 03.26.2021
PLAN REVIEW 07.15.2021
COORDINATION 08.27.2021
COORDINATION 11.05.2021
COORDINATION 12.10.2021

AEGIS
MIXED-USE DEVELOPMENT
312 E EVERGREEN BOULEVARD, VANCOUVER, WA 98660

SHEET:


E4.15

M
F
I
A
INC.
Consulting Engineers
2007 S.E. Ash St.
Portland, OR 97214
PHN: (503) 234-0548
FAX: (503) 234-0677
CONTACT: DENISE TAYLOR

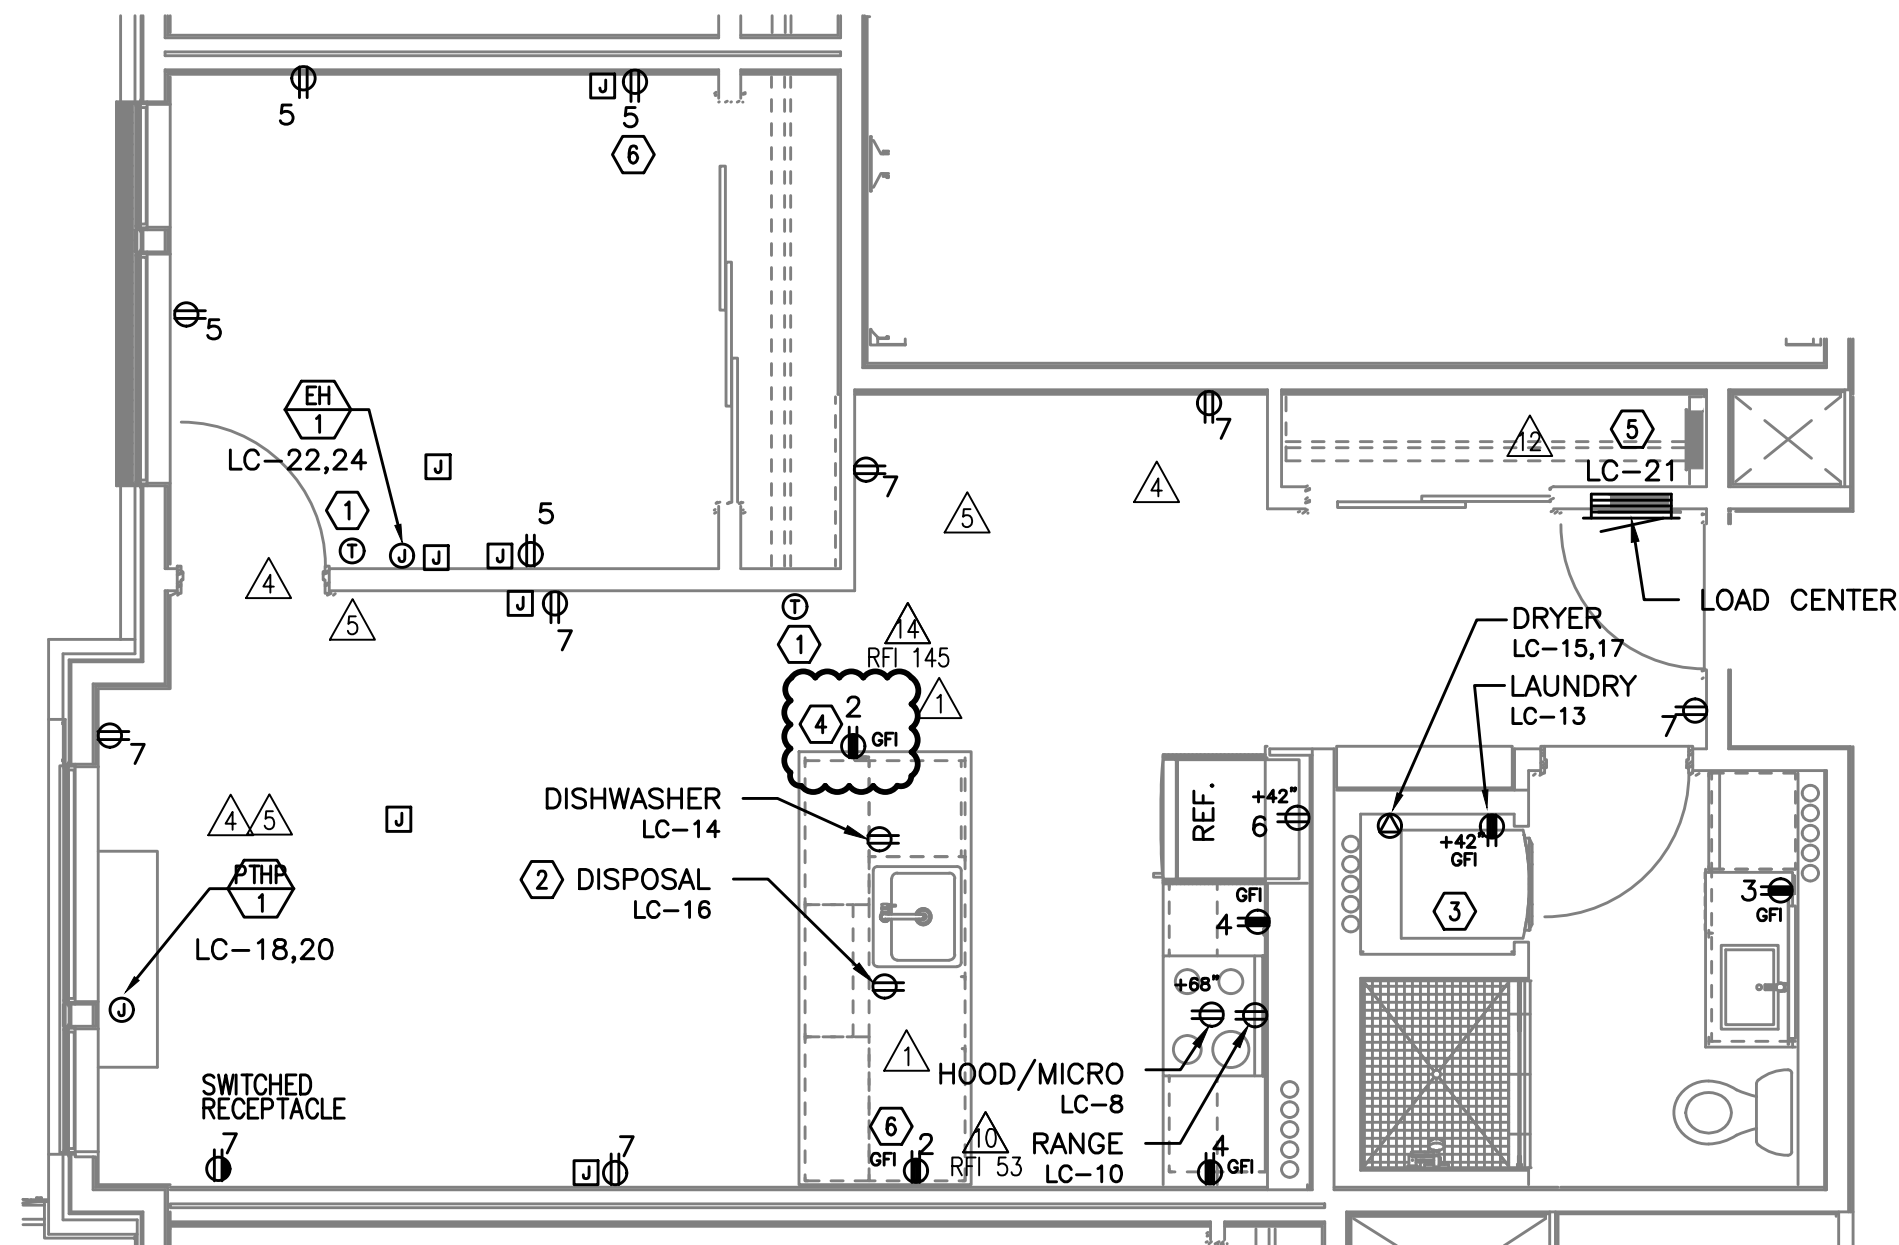


1
E4.16

TYPICAL UNIT TYPE O
1 BED/1 BATH – POWER PLAN
SCALE: 1/4" = 1'-0"

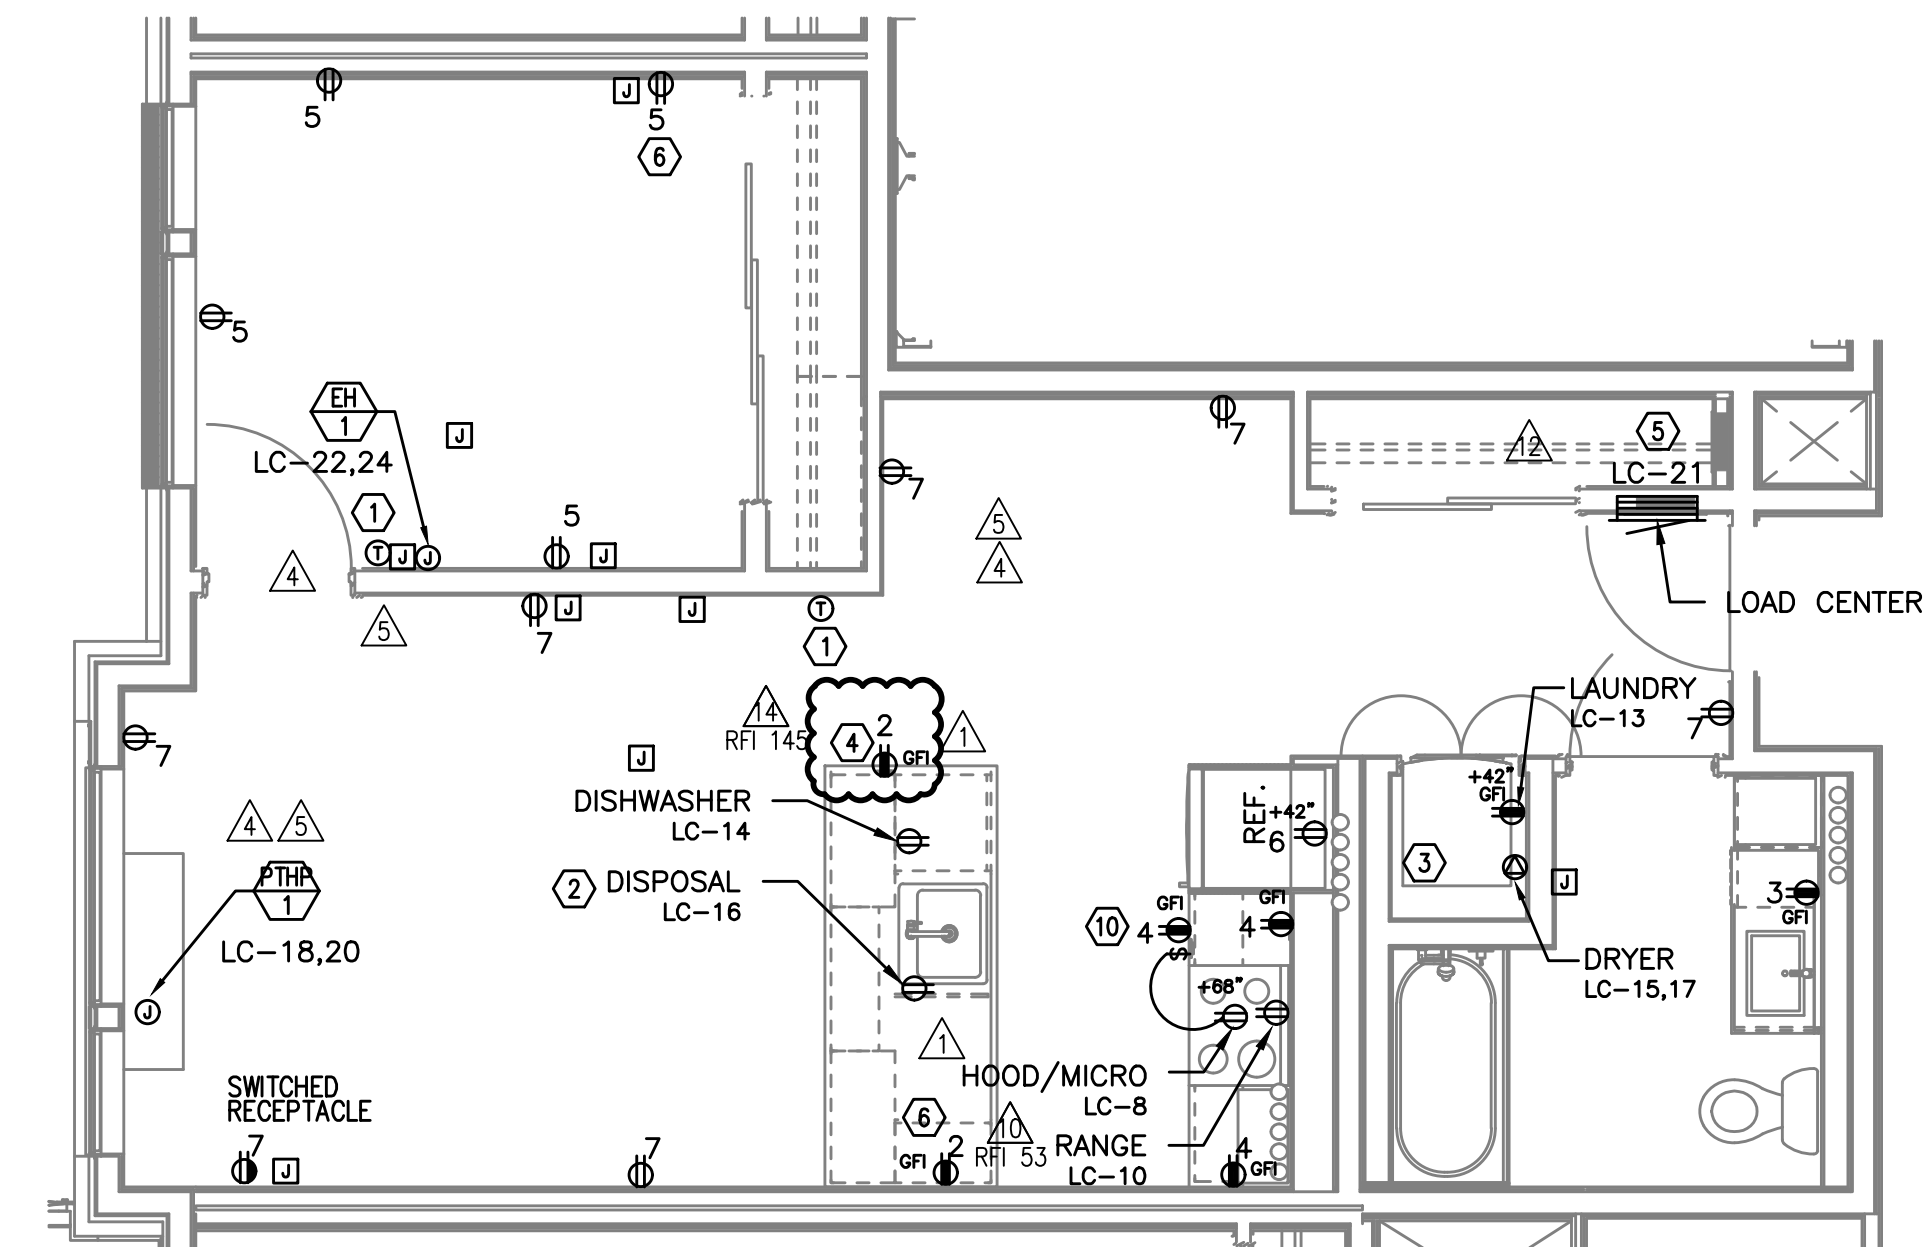

2
E4.16

TYPICAL UNIT TYPE O-ADA
1 BED/1 BATH – POWER PLAN
SCALE: 1/4" = 1'-0"

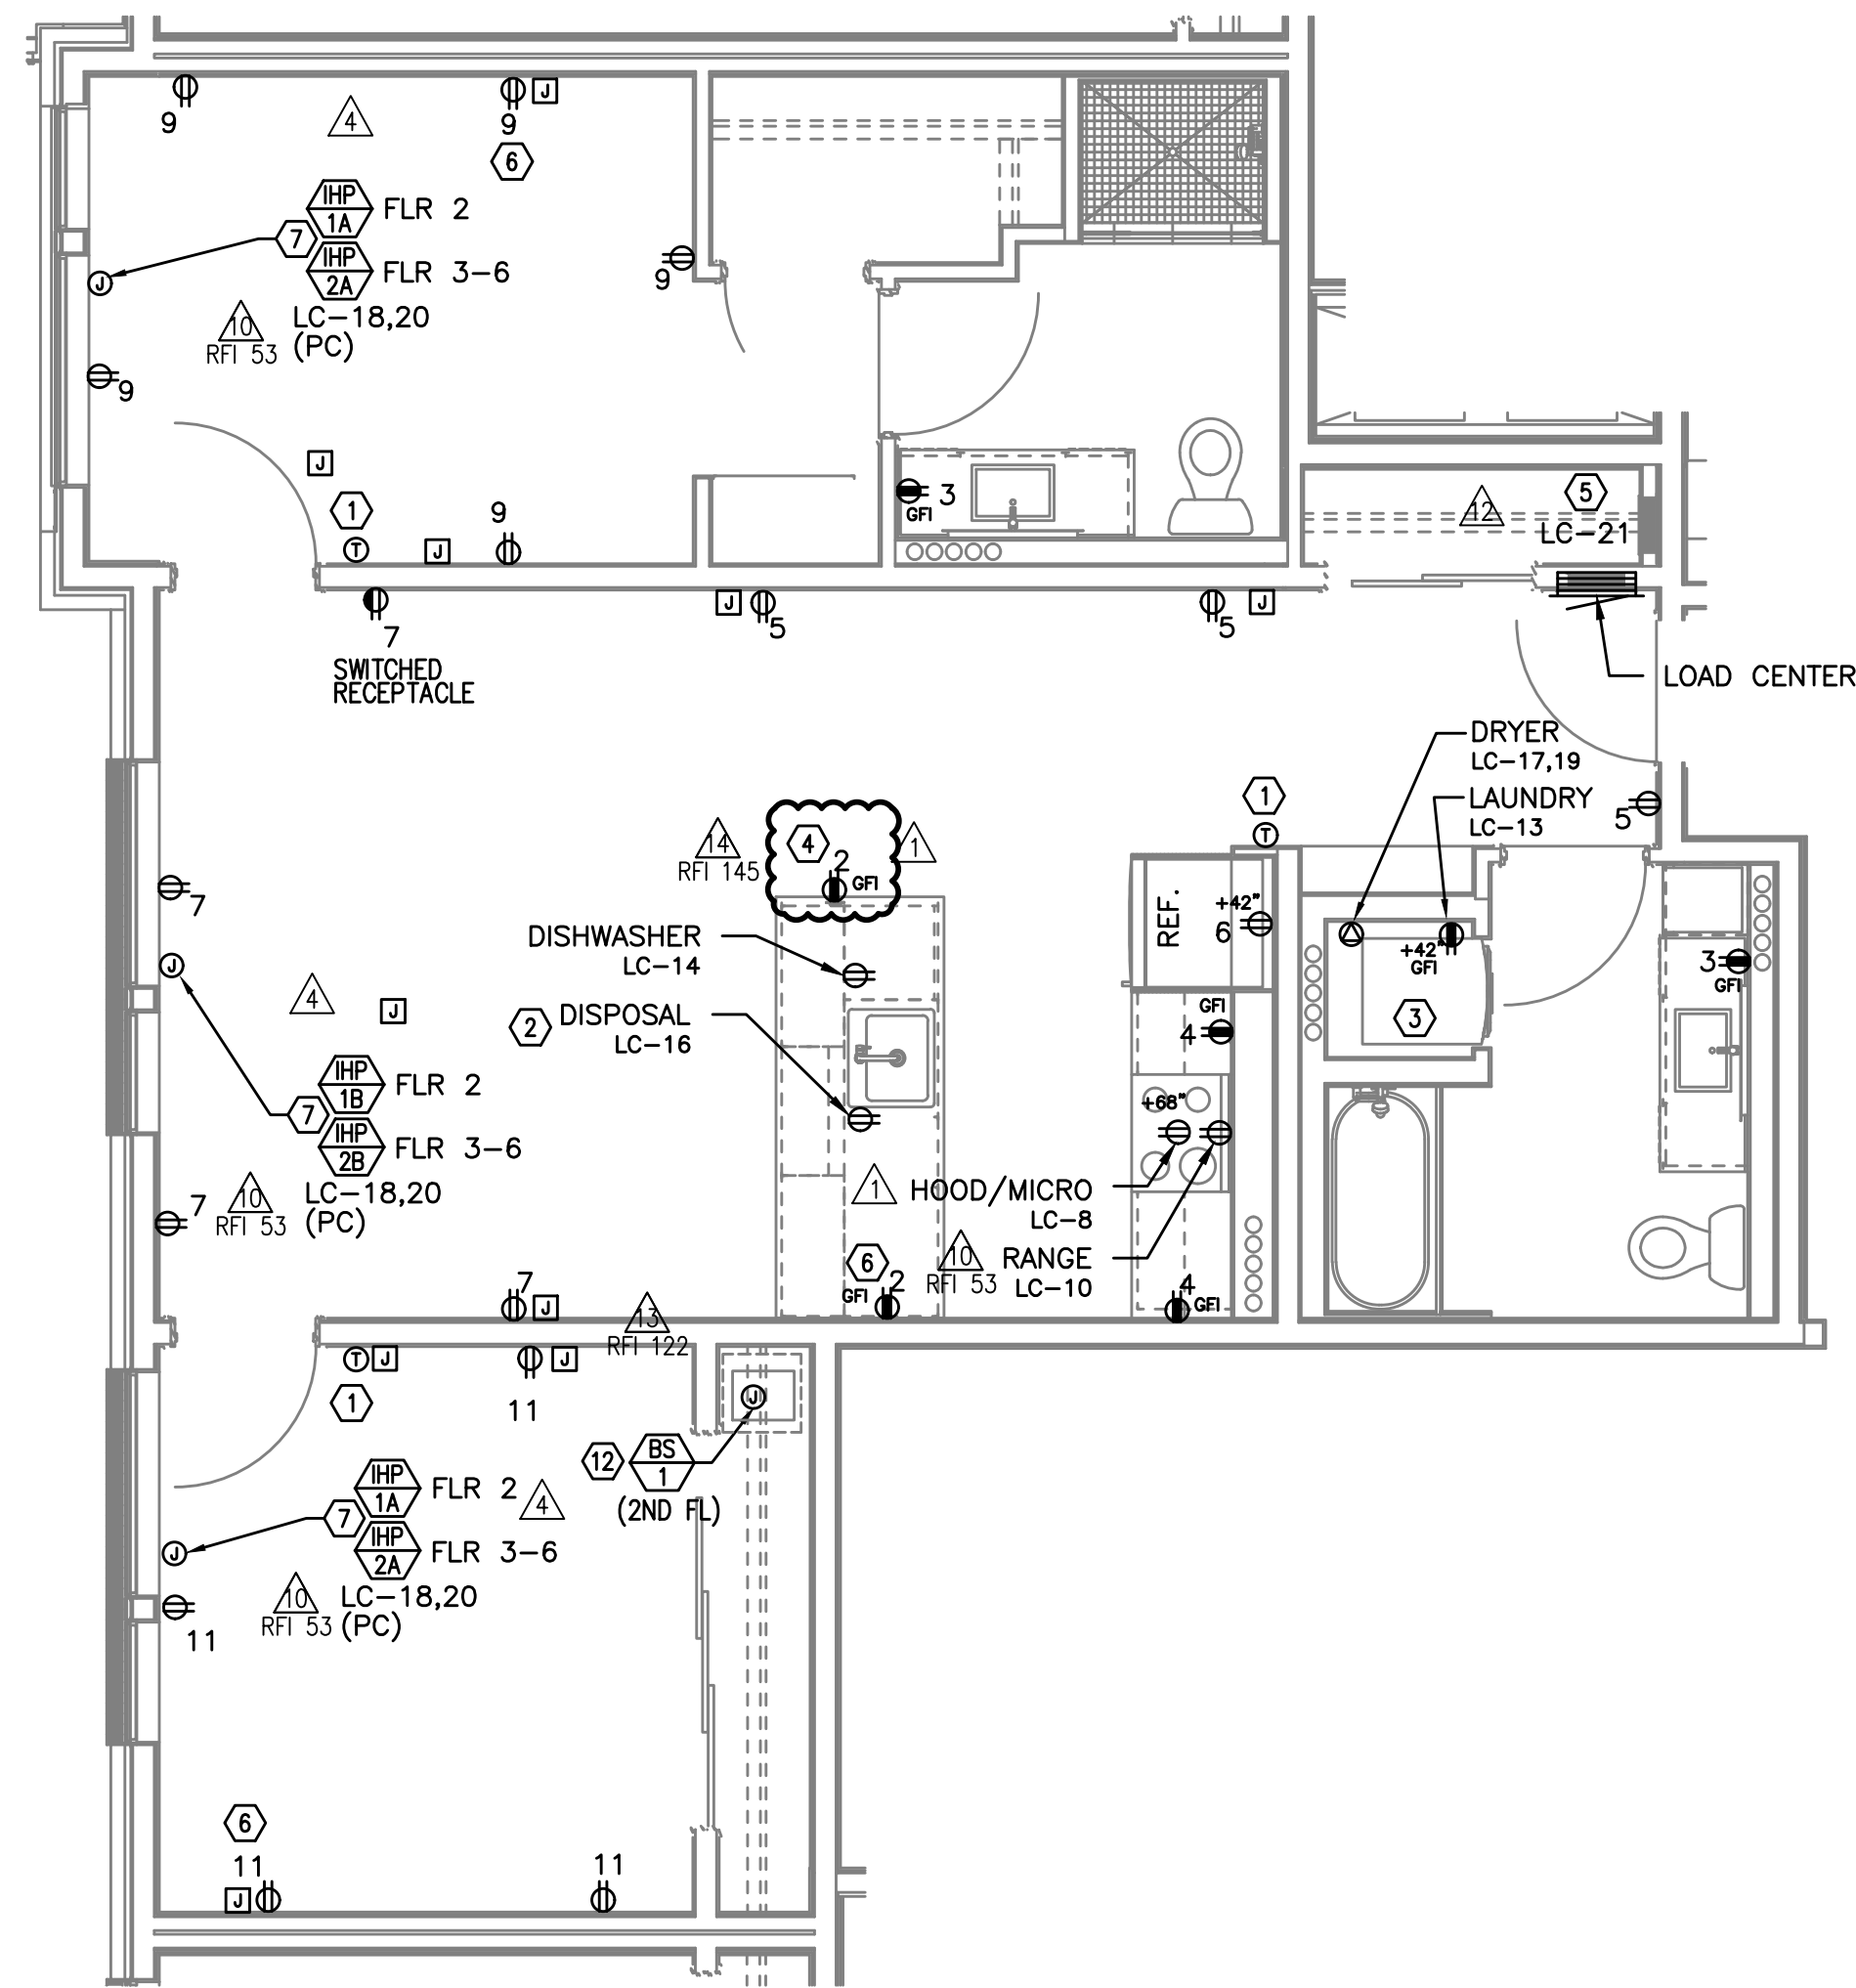

2
E4.16

TYPICAL UNIT TYPE P
2 BED/2 BATH – POWER PLAN
SCALE: 1/4" = 1'-0"


GENERAL NOTES:

- KITCHEN RECEPTACLES LOCATED IN ISLANDS OR PENINSULAS WHERE THE BACK SPLASH WILL NOT ACCOMMODATE VERTICAL PLACEMENT OR THE DUPLEX RECEPTACLE, THE CONTRACTOR SHALL ROTATE THE DEVICE 90 DEGREES SO THAT THE RECEPTACLE IS INSTALLED HORIZONTALLY.
- REFER TO DETAILS ON SHEET E1.23 FOR ADDITIONAL INFORMATION REGARDING ADA REACH REQUIREMENTS FOR RECEPTACLE AND SWITCH MOUNTING HEIGHT.
- STANDARD RECEPTACLE MOUNTING HEIGHT IS 18" A.F.F. UNLESS OTHERWISE SPECIFIED. RECEPTACLES LOCATED BELOW WINDOW SILLS SHALL NOT BE LESS THAN 15" A.F.F.
- ALL PLANS ARE DIAGRAMMATICAL. CONSULT ARCHITECTURAL PLANS AND ELEVATIONS FOR EXACT LOCATION AND MOUNTING HEIGHT OF ALL DEVICES AND FIXTURES.
- REFER TO SHEET E1.17 FOR TYPICAL UNIT LOAD CENTER DIRECTORIES.
- RECEPTACLE FOR PTHP UNIT SHALL BE LOCATED BELOW THE UNIT, NEAR THE BASE OF THE WALL SUCH THAT THE CORD SET IS CONCEALED AS MUCH AS POSSIBLE. COORDINATE INSTALLATION WITH THE MECHANICAL INSTALLER.
- COORDINATE WITH THE 'T' SERIES SHEETS AND PROVIDE ROUGH IN FOR LOW VOLTAGE SYSTEMS () REFERS TO ROUGH IN BOXES.

- ALL KITCHEN COUNTER TOP RECEPTACLES SHALL BE INSTALLED A MINIMUM OF 36" FROM A CORNER WALL PER ADA REQUIREMENTS. WHERE COUNTERS ARE NOT LONG ENOUGH TO ACCOMMODATE THIS, THE RECEPTACLE SHALL BE PLACED ON AN END WALL, NO MORE THAN 12" FROM THE FRONT EDGE OF THE COUNTER.

KEYED NOTES:

- PROVIDE WIRE CONNECTION FOR THERMOSTAT(S). COORDINATE WITH MECHANICAL INSTALLER FOR EXACT LOCATION AND POWER REQUIREMENTS PRIOR TO ROUGH IN. THERMOSTATS TO BE MOUNTED AT 48" AFF MAX. TO HIGHEST OPERABLE PART.
- PROVIDE ONE 20A, 120V, 1P GFCI DUPLEX RECEPTACLE UNDER KITCHEN SINK FOR DISPOSAL POWER CONNECTION. DISPOSAL TO BE PROVIDED WITH "SAFEAIRE" SINK DISPOSAL AIR SWITCH, MOUNTED PER ARCHITECT'S DIRECTION. VERIFY DEVICE FINISH WITH ARCHITECT PRIOR TO ORDERING.
- REFER TO DETAIL 2/E1.17 FOR TYPICAL LAUNDRY ALCOVE RECEPTACLE LOCATIONS. COORDINATE INSTALLATION WITH MECHANICAL & PLUMBING CONTRACTOR.
- MOUNT DEVICES HORIZONTALLY, JUST UNDER THE EDGE OF THE COUNTER TOP.
- PROVIDE ONE 15A, RECEPTACLE CIRCUIT FROM TENANT LOAD CENTER FOR TELECOM SMART PANEL. COORDINATE WORK WITH SERVICE PROVIDER FOR EXACT LOCATION AND FINAL CONNECTION.
- PROVIDE ONE 20A, 120V, 1P RECEPTACLE WITH USB PORT, MOUNTED AT 44" A.F.F. (MAX) AT KITCHEN ISLAND/PENINSULA COUNTER & AT 18" AFF IN BEDROOMS. CONSULT ARCHITECT AND/OR INTERIOR DESIGNER FOR ADDITIONAL LOCATIONS WHERE REQUIRED.
- INDOOR HEAT PUMP UNIT INTERCONNECTED WITH OUTDOOR UNIT LOCATED ON ROOF. CONTRACTOR SHALL COORDINATE WITH THE MECHANICAL HVAC INSTALLER AND MECHANICAL PLANS FOR EXACT POWER REQUIREMENTS & LOCATION OF EACH UNIT PRIOR TO ROUGH IN.
- COORDINATE WITH MECHANICAL EQUIPMENT INSTALLER FOR EXACT POWER REQUIREMENTS, CONTROLS & LOCATION OF THRU-WALL FAN. TIE INTO BEDROOM RECEPTACLE CIRCUIT.
- MOUNT DEVICES HORIZONTALLY, UNDER WINDOW SILL.
- RECEPTACLE MOUNTED IN FACE OF CABINET.
- COORDINATE WITH MECHANICAL EQUIPMENT INSTALLER FOR EXACT POWER REQUIREMENTS & LOCATION OF CONTINUOUS OPERATING EXHAUST FAN. TIE INTO LIVING ROOM LIGHTING RECEPTACLE CIRCUIT.
- PROVIDE POWER CONNECTION FOR BRANCH BOX, TIED INTO THE MINI-SPLIT SYSTEM, FROM THE TENANT LOAD CENTER. COORDINATE WORK WITH THE MECHANICAL EQUIPMENT INSTALLER.
- IN UNITS AT THE PT DECK, PROVIDE SURFACE MOUNTED RECEPTACLES AT STANDARD MOUNTING HEIGHT ON THE CORNER COLUMN. CONSULT ARCHITECT FOR ADDITIONAL INFORMATION.

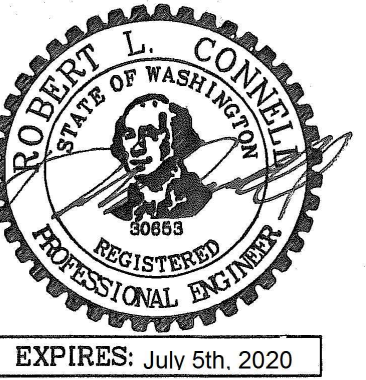

PROJECT # 2017-053
DATE: 11/06/2019
REVISIONS
PLAN REVIEW 01.24.2020
PLAN REVIEW 03.13.2020
PLAN REVIEW 04.24.2020
PLAN REVIEW 08.10.2020
PLAN REVIEW 09.17.2020
PLAN REVIEW 10.16.2020
PLAN REVIEW 11.25.2020
PLAN REVIEW 03.26.2021
PLAN REVIEW 07.15.2021
COORDINATION 08.27.2021
COORDINATION 11.05.2021
COORDINATION 12.10.2021

AEGIS
MIXED-USE DEVELOPMENT
312 E EVERGREEN BOULEVARD, VANCOUVER, WA 98660

M
F
I
A
INC.
Consulting Engineers
2007 S.E. Ash St.
Portland, OR 97214
PHN: (503) 234-0548
FAX: (503) 234-0677
CONTACT: DENISE TAYLOR

SHEET:

E4.16