


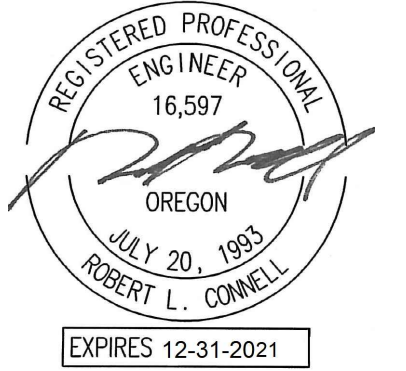

IN THE EVENT CONFLICTS ARE DISCOVERED
BETWEEN THE ORIGINAL SIGNED AND SEALED
DOCUMENTS PREPARED BY THE ARCHITECT
AND/OR THEIR CONSULTANTS, AND ANY COPY OF
THE DOCUMENTS TRANSMITTED BY EMAIL, FAX,
ELECTRONICALLY OR OTHERWISE, THE ORIGINAL
SIGNED AND SEALED DOCUMENTS SHALL GOVERN.

PROJECT # 2019-179
DATE: 28 AUGUST 2020

REVISIONS

PLAN REVIEW 11.03.2020

McKINNEY LANE APARTMENTS PHASE II
RUSSELL DRIVE & MCKINNEY LANE
LEBANON, OREGON

E1.00

ELECTRICAL SYMBOL LIST



LIGHTING SYMBOLS

- LIGHT FIXTURE, RECESSED
- LIGHT FIXTURE, RECESSED - EMERGENCY
- LIGHT FIXTURE, SURFACE MOUNT
- LIGHT FIXTURE, SURFACE MOUNT - EMERGENCY
- LIGHT FIXTURE, STRIP
- LIGHT FIXTURE, STRIP - EMERGENCY
- DOWNLIGHT FIXTURE, RECESSED
- DOWNLIGHT FIXTURE, RECESSED, WALLWASH
- DOWNLIGHT FIXTURE, RECESSED - EMERGENCY
- LIGHT FIXTURE, WALL MOUNT
- LIGHT FIXTURE, CEILING MOUNT
- RECESSED LIGHT FIXTURE, WALL MOUNT
- LIGHT FIXTURE, WALL MOUNT
- LIGHT FIXTURE, WALL SCONCE
- LIGHT FIXTURE, COVE - RECESSED
- LIGHT FIXTURE, COVE - SURFACE
- LIGHT FIXTURE, UNDER CABINET/SHELF
- EXIT SIGN, UNIVERSAL MOUNT, W/ DIRECTIONAL ARROW
- EXIT SIGN, WALL MOUNT, +8"-0" A.F.F.
- EMERGENCY LIGHT W/ BATTERY PACK, +8"-0" A.F.F.
- FLOOD LIGHT
- AREA LUMINAIRE, POST TOP
- AREA LUMINAIRE, BOLLARD
- AREA LUMINAIRE, WALL MOUNT
- AREA LUMINAIRE, POLE MOUNT

SWITCH SYMBOLS

- SWITCH, SPST +48" A.F.F.
- SWITCH, DPST +48" A.F.F.
- SWITCH, 3-WAY +48" A.F.F.
- SWITCH, 4-WAY +48" A.F.F.
- SWITCH, MOMENTARY +48" A.F.F.
- SWITCH, DIMMER +48" A.F.F.
- SWITCH, SPST, W/PILOT LIGHT +48" A.F.F.
- SWITCH, 3-WAY, W/PILOT LIGHT +48" A.F.F.
- SWITCH, KEY-OPERATED +48" A.F.F.
- SWITCH, TIMED +48" A.F.F.
- EXISTING SWITCH, SPST
- PHOTOCELL CONTROL
- OCCUPANCY SENSOR CONTROL

WIRING SYMBOLS

- PANEL & CIRCUIT NUMBER
- HOMERUN TO PANEL
- CONDUCTOR SIZE (IF OTHER THAN #12)
- PHASE CONDUCTOR
- NEUTRAL CONDUCTOR
- GROUND CONDUCTOR
- CONCEALED CONDUIT
- CONDUIT SIZE
- CONDUIT (UNDER SLAB OR FLOOR)
- FLEXIBLE CONNECTION
- CONDUIT, STUBBED & CAPPED
- NORMAL POWER CIRCUIT LINETYPE
- EMERGENCY POWER CIRCUIT LINETYPE
- EXISTING POWER CIRCUIT LINETYPE
- PRIMARY ELECTRICAL UTILITY FEEDER
- SECONDARY ELECTRICAL UTILITY FEEDER

FIRE-RATED INSTALLATION NOTE:

ELECTRICAL ITEMS (LIGHT FIXTURES, BOXES, ETC.) WHICH ARE RECESSED INTO FIRE-RATED CEILINGS OR WALLS, SHALL BE "ALCOVE" IN GYPSUM BOARD ENCLOSURES PER ARCHITECTURAL DETAILS, OR THE DEVICES SHALL BE "UL" LISTED WITH FIRE-RATING EQUAL TO OR GREATER THAN THE FIRE-RATING OF THE ADJACENT CONSTRUCTION.

1. SYMBOLS & ABBREVIATIONS MAY OR MAY NOT APPLY TO PROJECT
2. REFER TO LOW VOLTAGE DRAWINGS FOR ASSOCIATED SYMBOLS

POWER SYMBOLS

- RECEPTACLE, SINGLE +18" A.F.F.
- RECEPTACLE, DUPLEX +18" A.F.F.
- RECEPTACLE, QUAD +18" A.F.F.
- RECEPTACLE, DUPLEX +6" ABV COUNTER
- RECEPTACLE, DUPLEX +18" A.F.F. (ONE OUTLET SWITCHED)
- RECEPTACLE, DUPLEX +18" A.F.F. (BOTH OUTLETS SWITCHED)
- RECEPTACLE, DUPLEX, PEDESTAL MOUNT
- RECEPTACLE, DUPLEX, FLUSH FLOOR MOUNT
- RECEPTACLE, SPECIAL (COORDINATE WITH EQUIPMENT SERVED)
- RELAY
- TIME CLOCK CONTROL
- PUSHBUTTON STATION
- JUNCTION BOX
- JUNCTION BOX, EMERGENCY CIRCUIT
- THERMOSTAT
- TRANSFORMER
- DISCONNECT, NON-FUSED
- DISCONNECT, FUSED
- ELECTRICAL CONNECTION
- ELECTRICAL CONNECTION, SINGLE MOTOR
- ELECTRICAL CONNECTION, MULTI-MOTOR
- ELECTRICAL DISTRIBUTION PANEL, RECESSED
- ELECTRICAL DISTRIBUTION PANEL, SURFACE
- MISCELLANEOUS PANEL, RECESSED
- MISCELLANEOUS PANEL, SURFACE
- FLUSH FLOOR BOX (W/ DEVICES AS SHOWN ON PLAN)
- FIRE SMOKE DAMPER

ONE-LINE DIAGRAM SYMBOLS

- ELECTRICAL DISTRIBUTION PANELBOARD (MLO)
- ELECTRICAL DISTRIBUTION PANELBOARD (MCB)
- SUB-FEED CIRCUIT BREAKER
- CIRCUIT BREAKER (TRIP RATING & POLES AS INDICATED ON PLAN)
- MAIN SWITCH (RATING & POLES AS INDICATED ON PLAN)
- FUSE (RATING & CLASS AS INDICATED ON PLAN)
- TRANSFER SWITCH (MANUAL OR AUTOMATIC)
- GENERATOR (RATING AS INDICATED ON PLAN)
- TRANSFORMER (RATING AS INDICATED ON PLAN)
- FUSE (RATING & CLASS AS INDICATED ON PLAN)
- GROUND SYSTEM (SIZE AS INDICATED ON PLAN)
- WATER PIPE GROUND ELECTRODE
- TRANSIENT VOLTAGE SURGE SUPPRESSOR
- UTILITY METER & METER BASE
- UTILITY METER CURRENT TRANSFORMER
- FEEDER NO. (SEE FEEDER SCHEDULE)
- POTENTIAL TRANSFORMER (RATING AS INDICATED ON PLANS)

ABBREVIATIONS

- 'A' LIGHT FIXTURE TYPE (SEE FIXTURE LIST)
- A.F.F. ABOVE FINISHED FLOOR
- A.F.G. ABOVE FINAL GRADE
- A.F.I. ARC FAULT INTERRUPTER
- A.T.S. TRANSFER SWITCH, AUTOMATIC
- C CONDUIT
- C.O. CONDUIT ONLY
- CAV. CABLE TELEVISION
- CB CIRCUIT BREAKER
- CCV. CLOSED CIRCUIT TELEVISION
- C.T. CURRENT TRANSFORMER
- (E) EXISTING
- E.L. EMERGENCY LIGHT
- E.L.C. EXTERIOR LIGHTING CONTROL
- FACP FIRE ALARM CONTROL PANEL
- G.F.I. GROUND FAULT INTERRUPTER
- GND GROUND
- H.I.D. HIGH INTENSITY DISCHARGE
- HP HORSEPOWER
- I.G. ISOLATED GROUND
- I R INFRARED
- JB JUNCTION BOX
- LCP LIGHTING CONTROL PANEL
- MCB MAIN CIRCUIT BREAKER
- MLO MAIN LUGS ONLY
- M.T.S. TRANSFER SWITCH, MANUAL
- (N) NEW
- N.I.C. NOT IN CONTRACT
- N.L. NIGHT LIGHT
- OL OVERLOAD
- O.L.C. OFFICE LIGHTING CONTROL
- P POLE
- P.A. PUBLIC ADDRESS
- PC PARTIAL CIRCUIT
- PH PHASE
- PRI PRIMARY
- R.T.U. REMOTE TELEMETRY UNIT
- SEC SECONDARY
- SCCR SHORT CIRCUIT CURRENT RATING
- T.V.S.S. TRANSIENT VOLTAGE SURGE SUPPRESSOR
- U.G. UNDERGROUND
- U.O.N. UNLESS OTHERWISE NOTED
- VFD VARIABLE FREQUENCY DRIVE
- W WIRE
- W.G. WIRE GUARD
- W.P. WEATHERPROOF
- W.T. WATERTIGHT
- X.P. EXPLOSION PROOF

NOTATIONS

- DRAWING NOTE
- DETAIL REFERENCE: TOP=DETAIL NO., BOTTOM=SHEET NO.
- MECHANICAL EQUIPMENT MARK NO. (SEE EQUIPMENT SCHEDULE)
- EQUIPMENT NO. (SEE EQUIPMENT SCHEDULE)
- EQUIPMENT NO. (SEE EQUIPMENT SCHEDULE)
- EQUIPMENT NO. (SEE EQUIPMENT SCHEDULE)
- FIXTURE REFERENCE: TOP=TYPE, BOTTOM=LAMP QTY & WATTS

GENERAL CONSTRUCTION NOTES:


CONTRACTOR SHALL BE RESPONSIBLE FOR THOROUGHLY REVIEWING THE PLANS AND SPECIFICATION DOCUMENTS PRIOR TO THE START OF ANY WORK. ANY DISCREPANCIES IN THE PROJECT DOCUMENTS SHALL BE BROUGHT TO THE ATTENTION OF THE ARCHITECT IMMEDIATELY AND PRIOR TO THE START OF ANY WORK.

ALL DIMENSIONS ARE MEASURED TO THE CENTER OF THE DEVICE ABOVE FINISHED FLOOR UNLESS OTHERWISE NOTED AS IS STANDARD BUILDING PRACTICE.

ALL ELECTRICAL PLANS ARE DIAGRAMMATICAL AND THE CONTRACTOR SHALL CONSULT THE ARCHITECTURAL PLANS AND ELEVATIONS FOR EXACT LOCATION AND MOUNTING HEIGHTS OF DEVICES AND FIXTURES.

THE ELECTRICAL CONTRACTOR SHALL REVIEW ALL PROJECT DOCUMENTATION AND COORDINATE WITH ALL OTHER TRADES THROUGHOUT THE COURSE OF THE PROJECT.

ALL WORK SHALL BE IN ACCORDANCE WITH ALL NATIONAL, STATE AND LOCAL CODES. CONTRACTOR SHALL BE RESPONSIBLE TO BE INFORMED OF ALL SUCH CODES AS THEY APPLY TO THE SCOPE OF THE PROJECT.

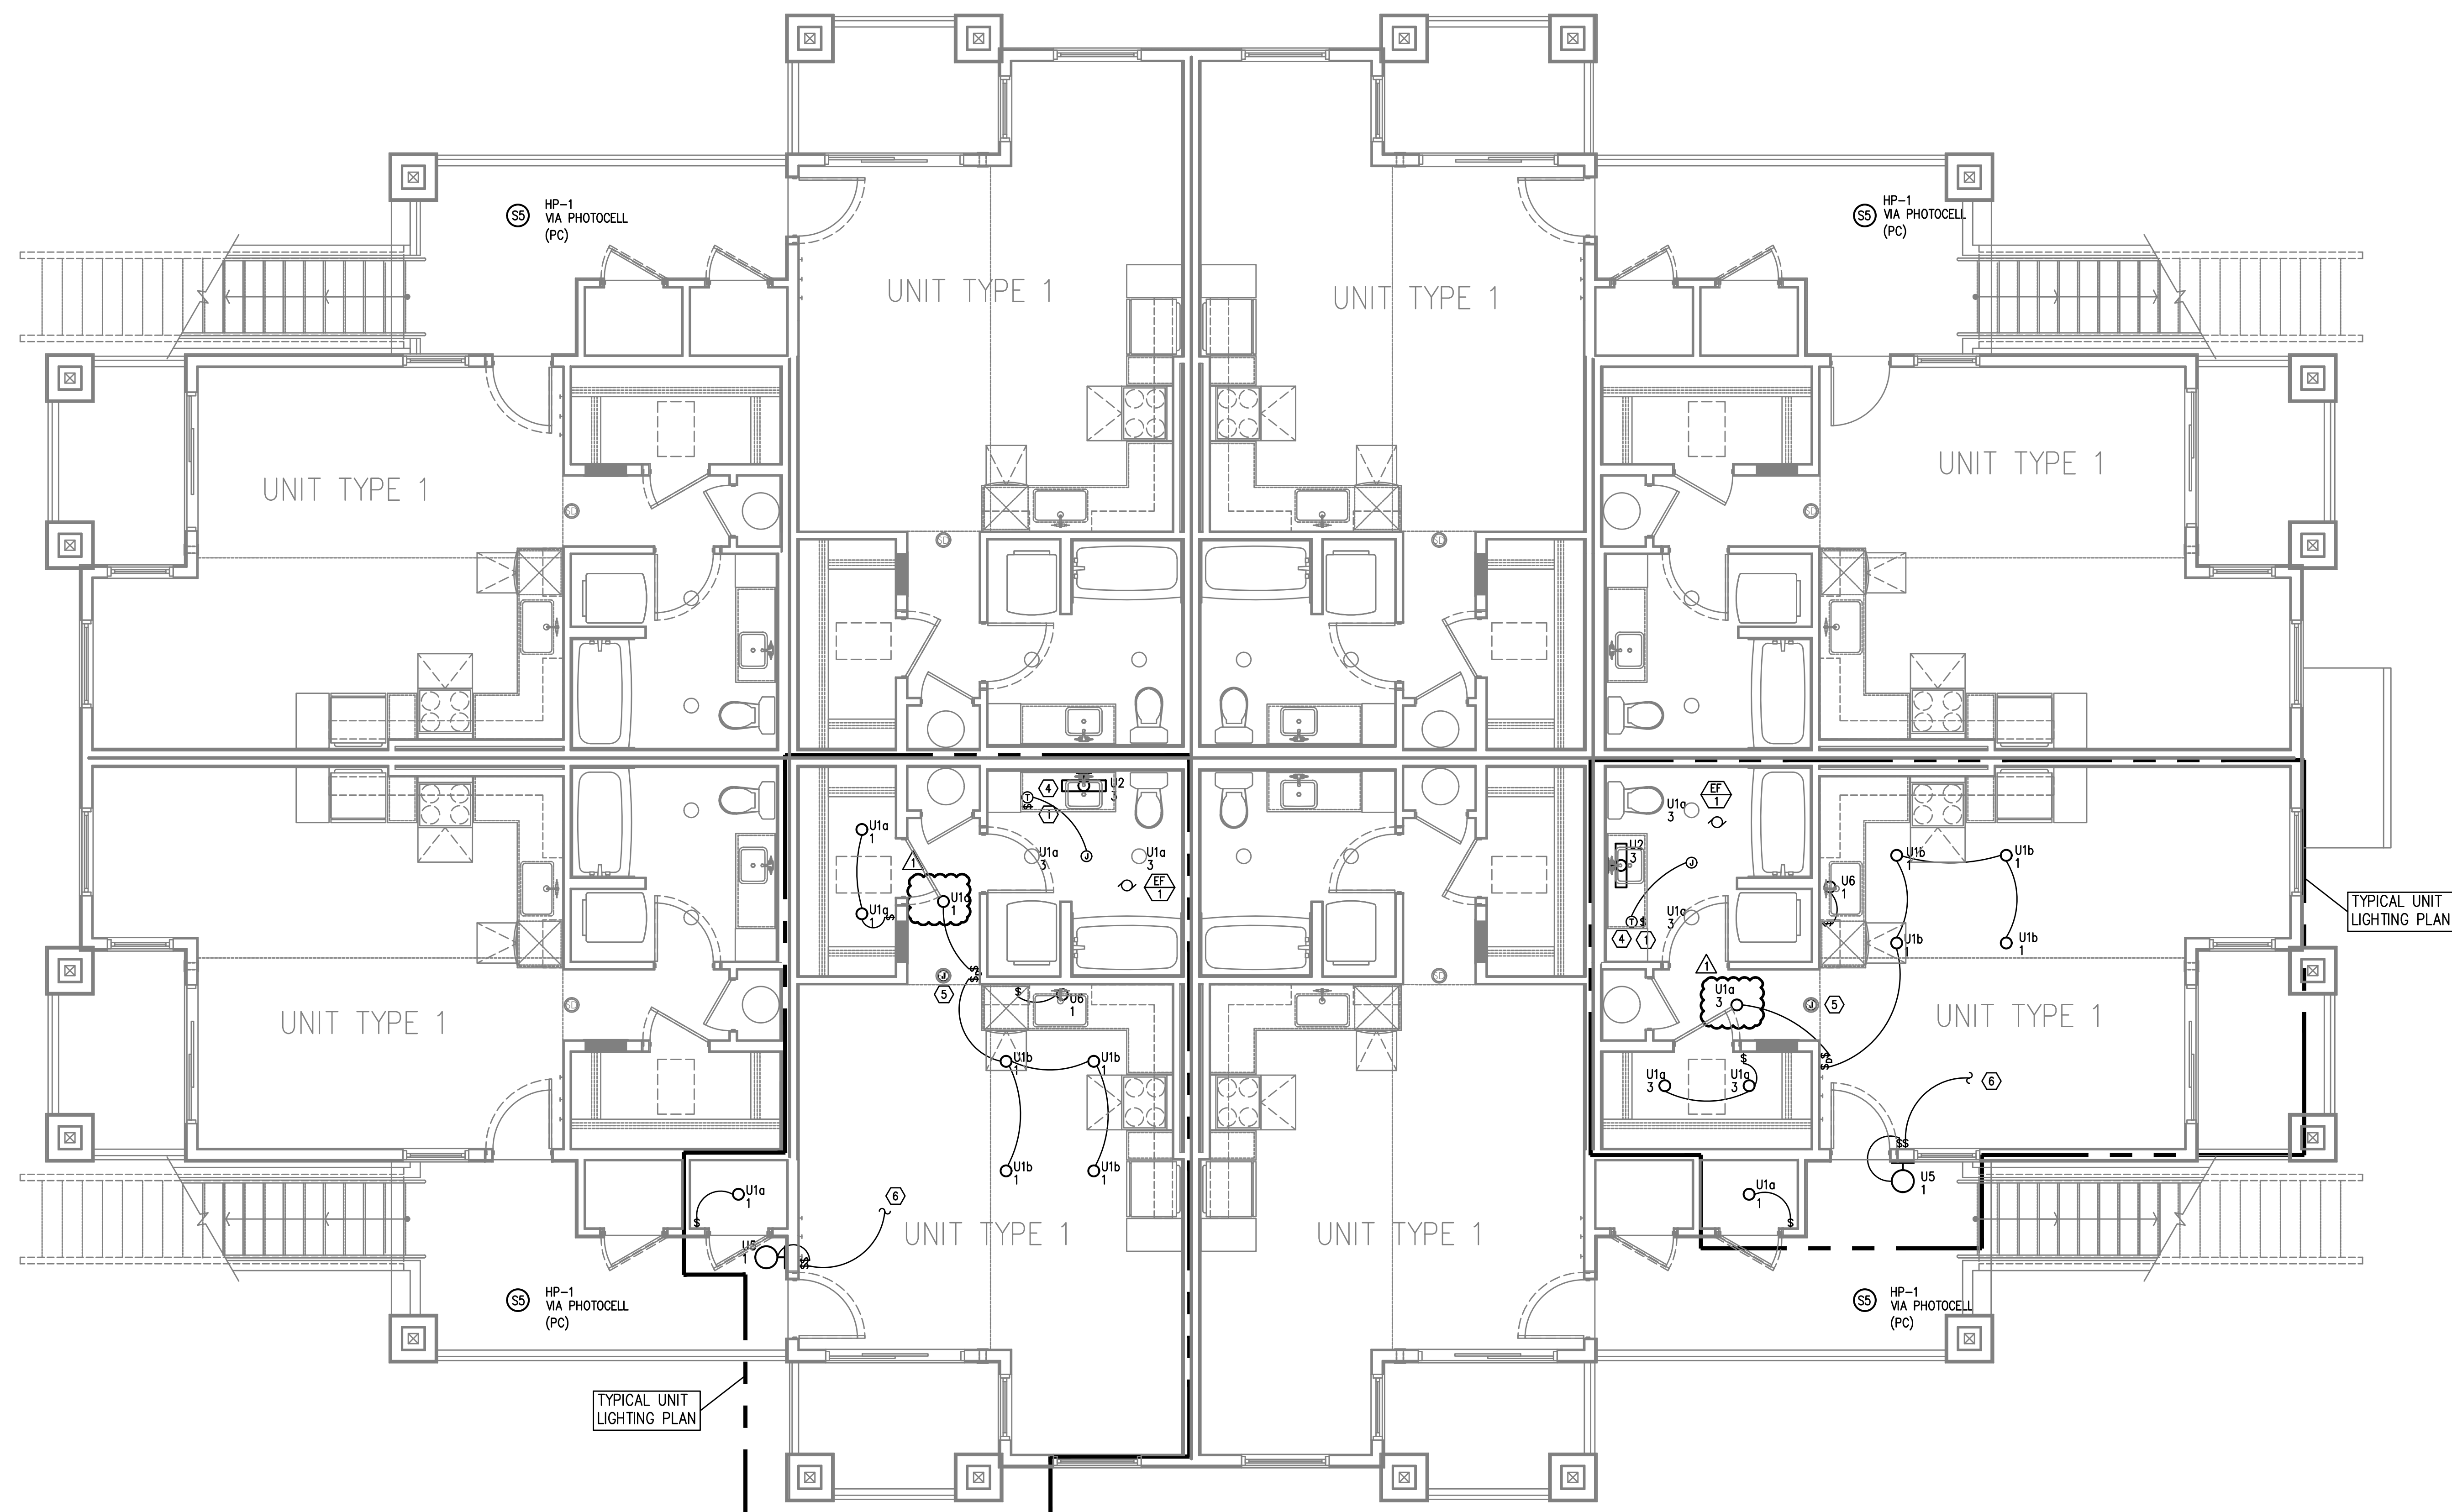


1 BLDG TYPE A – BLDGS 'A' & 'F'
E2.02 SECOND FLOOR – LIGHTING PLAN
SCALE: 1/4" = 1'-0"

GENERAL LIGHTING NOTES:

- ELECTRICAL DRAWINGS ARE DIAGRAMMATICAL AND MAY NOT ACCURATELY REFLECT ACTUAL CONSTRUCTION CONDITIONS. THE ELECTRICAL CONTRACTOR SHALL BE RESPONSIBLE FOR COORDINATING THE INSTALLATION OF ALL ELECTRICAL EQUIPMENT, WITH ALL TRADES PRIOR TO AND DURING CONSTRUCTION.
- THE ELECTRICAL CONTRACTOR SHALL REFER TO THE ARCHITECTURAL DRAWINGS FOR ALL MOUNTING HEIGHTS AND FINISHES OF DEVICES AND FIXTURES.
- REFER TO SHEET E1.21 FOR LIGHT FIXTURE SCHEDULES.
- THE CONTRACTOR SHALL CONSULT THE ARCHITECT AND/OR INTERIOR DESIGNER FOR THE EXACT LOCATION OF ALL LIGHT FIXTURES PRIOR TO THE START OF ANY ROUGH IN WORK.
- REFER TO AVAILABLE ARCHITECTURAL AND/OR INTERIOR DESIGN DOCUMENTS & DRAWINGS FOR ADDITIONAL INFORMATION.
- EXTERIOR LIGHTING TO BE CONSTANT "ON" AND PROVIDED WITH PHOTOCELL, EITHER INTEGRAL OR REMOTE) FOR DUSK-TILL-DAWN OPERATION.
- ALL EXTERIOR BUILDING LIGHTS ON HOUSE POWER SHALL BE CONSIDERED EGRESS LIGHTING. FIXTURES ARE TO BE EQUIPPED WITH BATTERY BACK-UP (EITHER INTEGRAL OR REMOTE).
- REFER TO SHEET E1.14 FOR TYPICAL UNIT LOAD CENTER DIRECTORIES.
- ALL LIGHT SWITCHES SHALL BE ROCKER STYLE, SUCH AS LEVITON DECORA, OR APPROVED EQUAL.
- REFER TO ARCHITECTURAL REFLECTED CEILING PLANS FOR EXACT FIXTURE LOCATIONS (DIMENSIONS). CONSULT INTERIOR DESIGNER FOR MOUNTING HEIGHTS NOT SPECIFIED.
- REFER TO ARCHITECTURAL PLANS REGARDING "ACCESSIBLE" UNIT LOCATION(S), INTERIOR ELEVATIONS & DETAILS. COORDINATE INSTALLATION OF ALL DEVICES PER THE "AMERICAN DISABILITIES ACT" (ADA). REFER TO SHEET E1.21 FOR STANDARD ADA REACH REQUIREMENTS.

KEYED LIGHTING NOTES:

- REFER TO TYPICAL BATHROOM SWITCHING DETAILS ON SHEET E1.21.
- PROVIDE CEILING FAN CONTROL SWITCH(ES) AS DIRECTED BY MANUFACTURER.
- PROVIDE BLOCKING AT CEILING TO SUPPORT 35LB., MINIMUM, FOR CEILING FAN INSTALLATION.
- PROVIDE WIRE CONNECTION FOR THERMOSTAT(S). COORDINATE WITH MECHANICAL INSTALLER FOR EXACT LOCATION AND POWER REQUIREMENTS PRIOR TO ROUGH IN. CEILING HEATER TO BE TIED INTO BATHROOM POWER CIRCUIT.
- COORDINATE LOCATION OF POWER CONNECTION FOR FIRE ALARM DEVICES WITH THE SYSTEM CONTRACTOR/INSTALLER.
- TO SWITCHED RECEPTACLE. REFER TO POWER PLANS (E3 SERIES SHEETS) FOR OUTLET LOCATION.

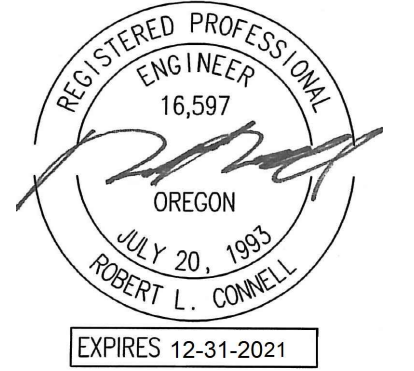

IN THE EVENT CONFLICTS ARE DISCOVERED BETWEEN THE ORIGINAL SIGNED AND SEALED DOCUMENTS PREPARED BY THE ARCHITECTS AND/OR THEIR CONSULTANTS, AND ANY COPY OF THE DOCUMENTS TRANSMITTED BY EMAIL, ELECTRONICALLY OR OTHERWISE, THE ORIGINAL SIGNED AND SEALED DOCUMENTS SHALL GOVERN.

PROJECT # 2019-179
DATE: 28 AUGUST 2020


REVISIONS

PLAN REVIEW 11.03.2020

MCKINNEY LANE APARTMENTS PHASE II
RUSSELL DRIVE & MCKINNEY LANE
LEBANON, OREGON

A

E3.01

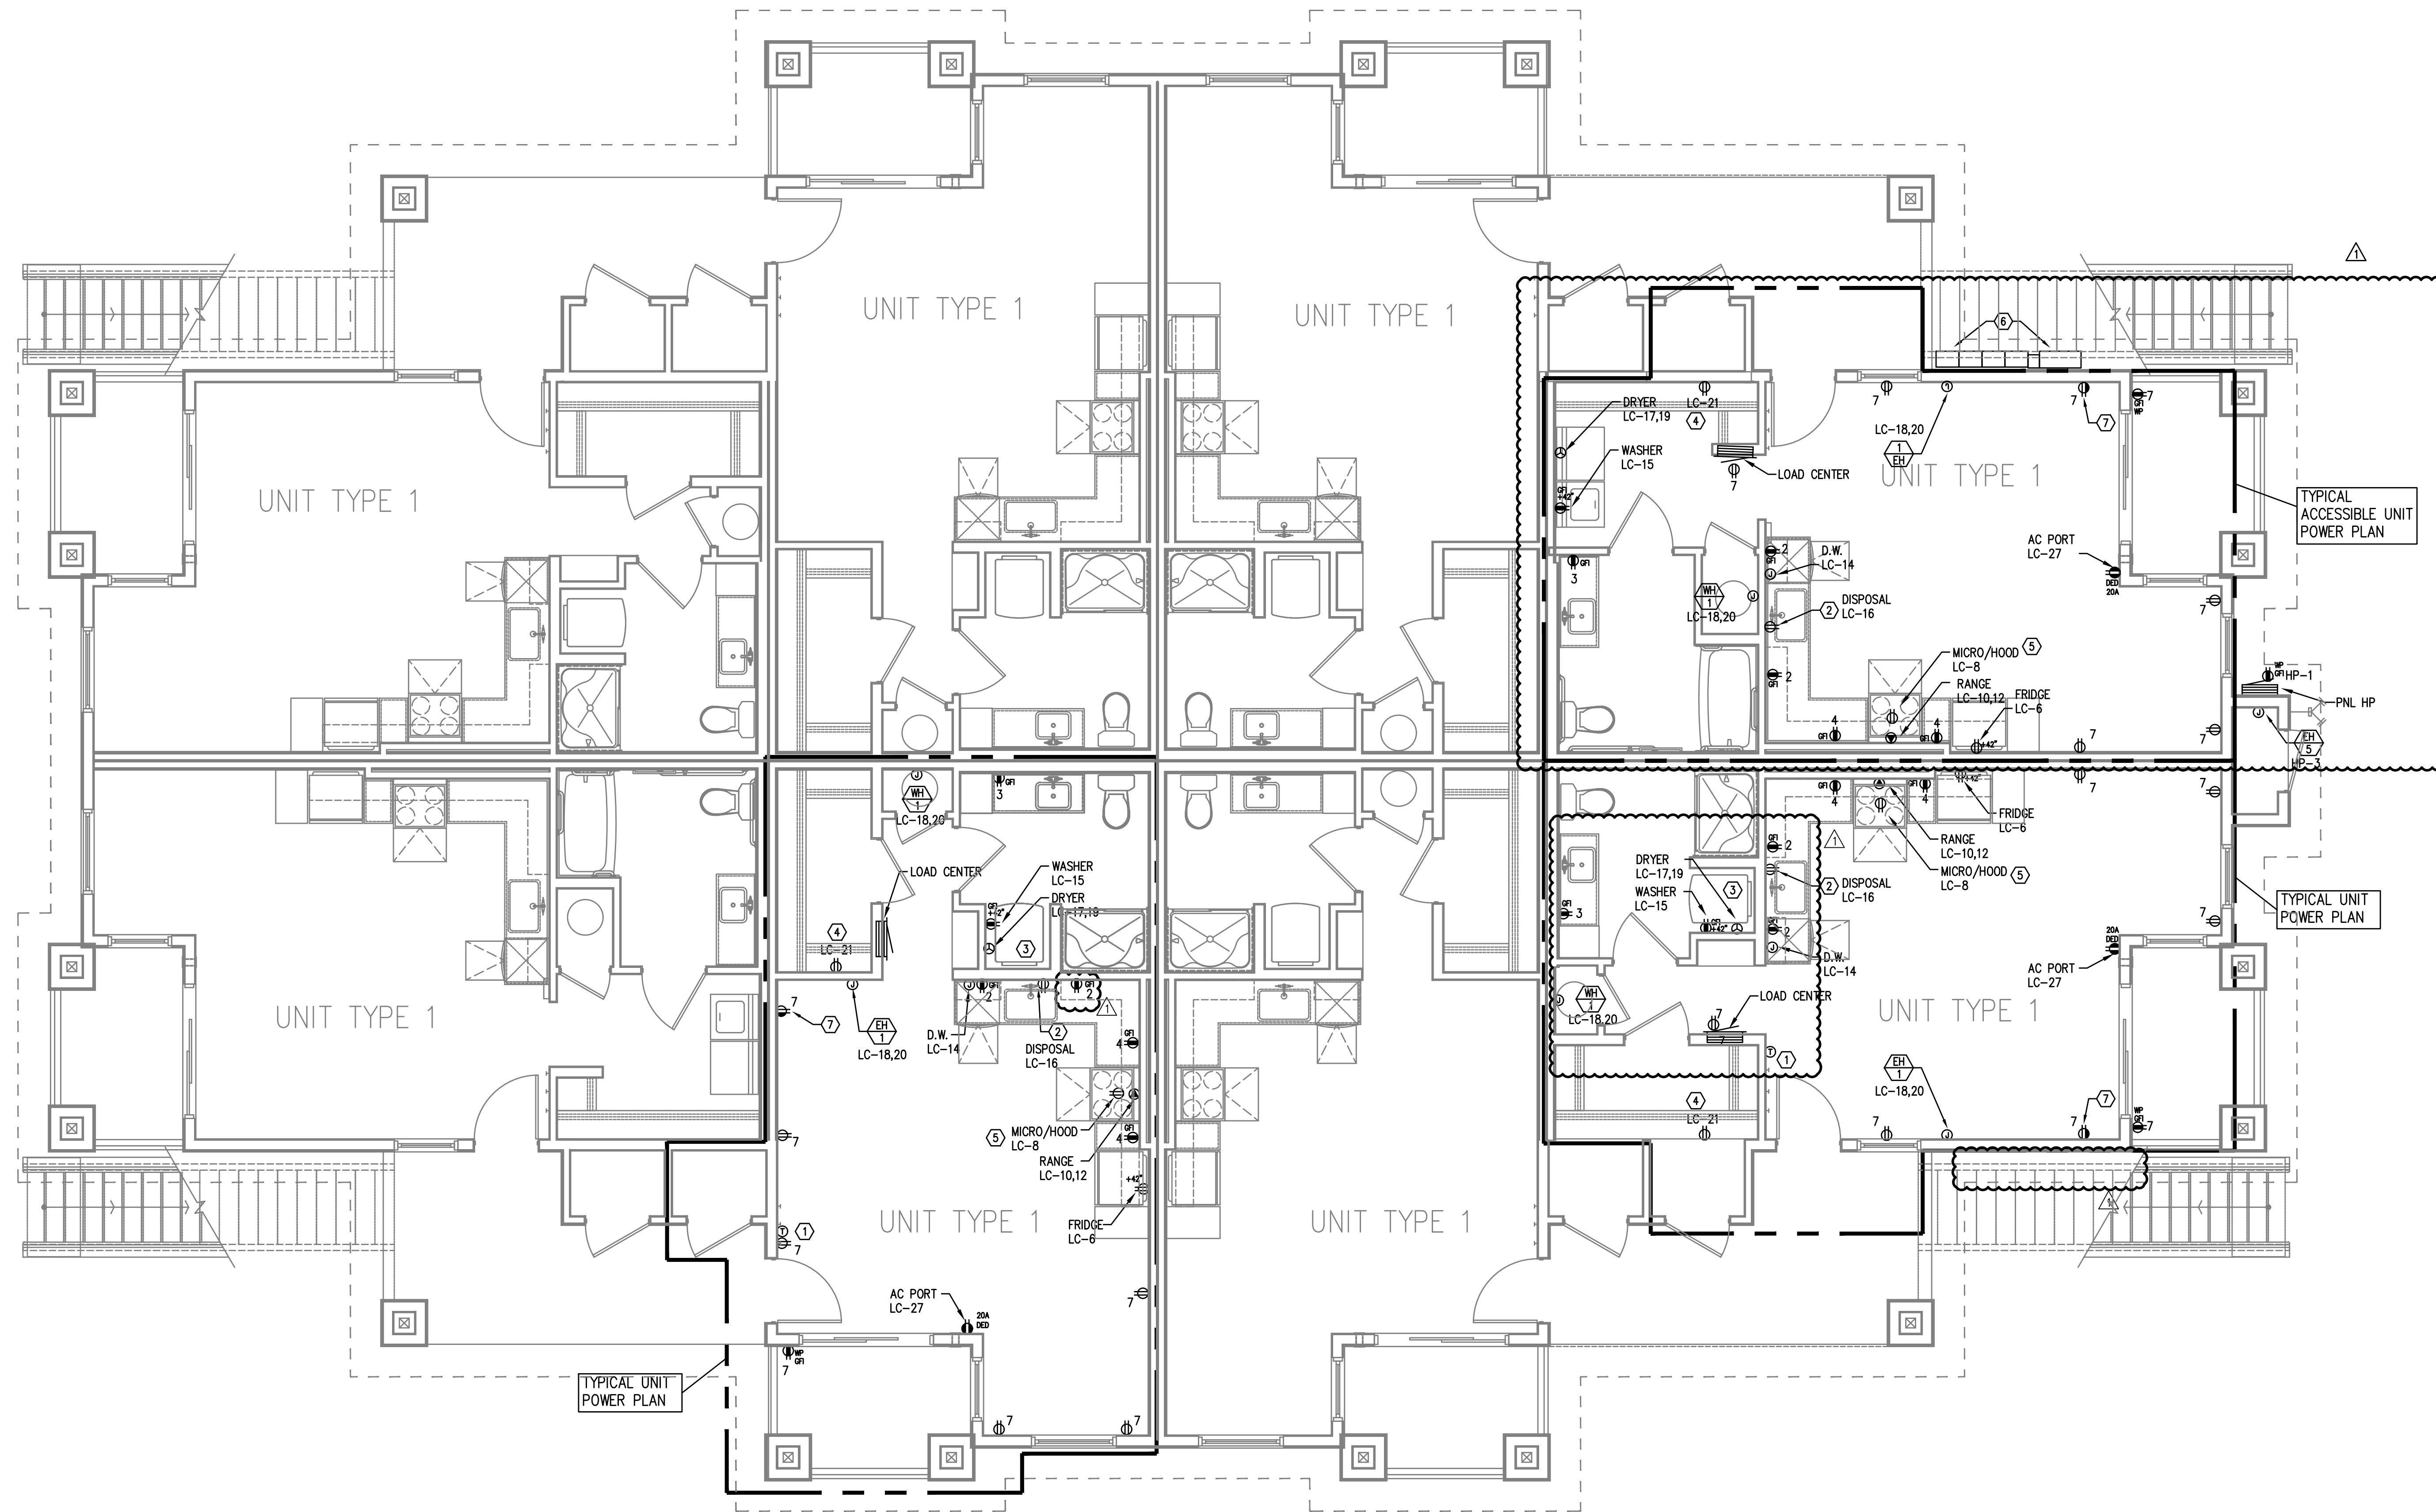


BLDG TYPE A – BLDGS 'A' & 'F'
FIRST FLOOR – POWER PLAN
(ACCESSIBLE)

GENERAL POWER NOTES:

- ALL PLANS ARE CONSIDERED DIAGRAMMATICAL. THEREFORE ALL EQUIPMENT SIZES AND DEVICE LOCATIONS ARE APPROXIMATE AND SUBJECT TO FIELD CONDITIONS AND PRODUCT APPROVAL.
- ELECTRICAL CONTRACTOR TO PROVIDE THERMOSTATS NOT SUPPLIED BY MECHANICAL CONTRACTOR. CONSULT MECHANICAL PLANS FOR ADDITIONAL INFORMATION.
- ELECTRICAL CONTRACTOR SHALL PROVIDE INSTALLATION AND FINAL CONNECTION OF THERMOSTATS. CONSULT MECHANICAL CONTRACTOR FOR EXACT REQUIREMENTS PRIOR TO ROUGH IN.
- REFER TO INTERIOR DECORATOR AND/OR ARCHITECTURAL DRAWINGS FOR DIMENSIONED LOCATION(S) AND ELEVATIONS OF FIXTURES & DEVICES. OTHER DEVICES SHOWN ON THE ELECTRICAL PLANS AND NOT INDICATED ON THE DECORATOR'S OR ARCHITECT'S DRAWINGS, SHALL BE INSTALLED AT STANDARD MOUNTING HEIGHT AS INDICATED THE SYMBOL LIST.
- BUILDING ELECTRICAL EQUIPMENT SHOWN IS APPROXIMATE, BASED ON INDUSTRY STANDARD PRODUCTS. CONTRACTOR SHALL VERIFY ANY SUBMITTED EQUIPMENT WILL FIT WITHIN THE SPACE PROVIDED, PRIOR TO PRODUCT SUBMITTAL REVIEW.
- ELECTRICAL CONTRACTOR SHALL COORDINATE WITH THE LOW VOLTAGE ('I' SERIES) PLANS, INCLUDING FIRE ALARM AND SYSTEMS INSTALLER, AND PROVIDE ROUGH IN AS NEEDED.
- REFER TO ARCHITECTURAL PLANS REGARDING "ACCESSIBLE" UNIT LOCATION(S), INTERIOR ELEVATIONS & DETAILS. COORDINATE INSTALLATION OF ALL DEVICES PER THE "AMERICAN DISABILITIES ACT" (ADA). REFER TO SHEET E1.21 FOR STANDARD ADA REACH REQUIREMENTS.

KEYED POWER NOTES:

- PROVIDE WIRE CONNECTION FOR THERMOSTAT(S). COORDINATE WITH MECHANICAL INSTALLER FOR EXACT LOCATION AND POWER REQUIREMENTS PRIOR TO ROUGH IN.
- PROVIDE ONE 20A, 120V, 1P GFCI DUPLEX RECEPTACLE UNDER KITCHEN SINK FOR DISPOSAL POWER CONNECTION.
- REFER TO DETAIL 1/E1.13 FOR TYPICAL LAUNDRY ALCOVE RECEPTACLE LOCATIONS. COORDINATE INSTALLATION WITH MECHANICAL & PLUMBING CONTRACTOR.
- PROVIDE ONE 15A, RECEPTACLE CIRCUIT FROM TENANT LOAD CENTER FOR TELECOM SMART PANEL. COORDINATE WORK WITH SERVICE PROVIDER FOR EXACT LOCATION AND FINAL CONNECTION.
- CONTRACTOR TO VERIFY POWER CONNECTION TYPE FOR THE HOOD/MICROWAVE PRIOR TO ROUGH IN. PROVIDE ONE DEDICATED 20A, 1P DUPLEX RECEPTACLE LOCATED INSIDE THE CABINET OVER THE RANGE FOR APPLIANCES SUPPLIED WITH CORD & PLUG SET. HOOD/MICROWAVES THAT ARE TO BE HARDWIRED, SHALL BE PROVIDED WITH THE DEDICATED CIRCUIT GOING TO A J-BOX WHICH IS TO BE MOUNTED DIRECTLY BEHIND THE APPLIANCE.
- METER LOCATION PER UTILITY PROVIDER'S APPROVAL (PENDING). REFER TO ONE-LINE DIAGRAM ON SHEET E1.11. PROVIDE NEMA 3R LOCKING CABINET FOR HOUSE PANEL 'HP'. REFER TO SHEET E1.01 FOR METER & PANEL LOCATION(S) AT EACH BUILDING.
- 15A SWITCHED SPLIT DUPLEX RECEPTACLE. REFER TO LIGHTING PLANS (E2 SERIES SHEETS) FOR SWITCH LOCATION.

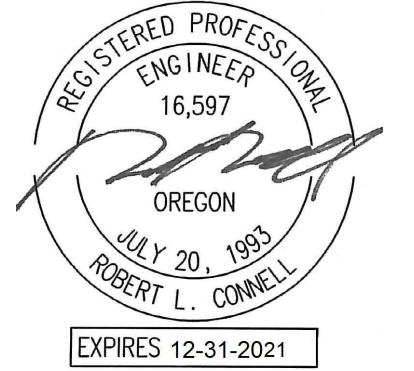


IN THE EVENT CONFLICTS ARE DISCOVERED BETWEEN THE ORIGINAL SIGNED AND SEALED DOCUMENTS PREPARED BY THE ARCHITECTS AND/OR THEIR CONSULTANTS, AND ANY COPY OF THE DOCUMENTS TRANSMITTED BY EMAIL, FAX, ELECTRONICALLY OR OTHERWISE, THE ORIGINAL SIGNED AND SEALED DOCUMENTS SHALL GOVERN.

PROJECT # 2019-179

DATE: 28 AUGUST 2020

REVISIONS

PLAN REVIEW 11.03.2020

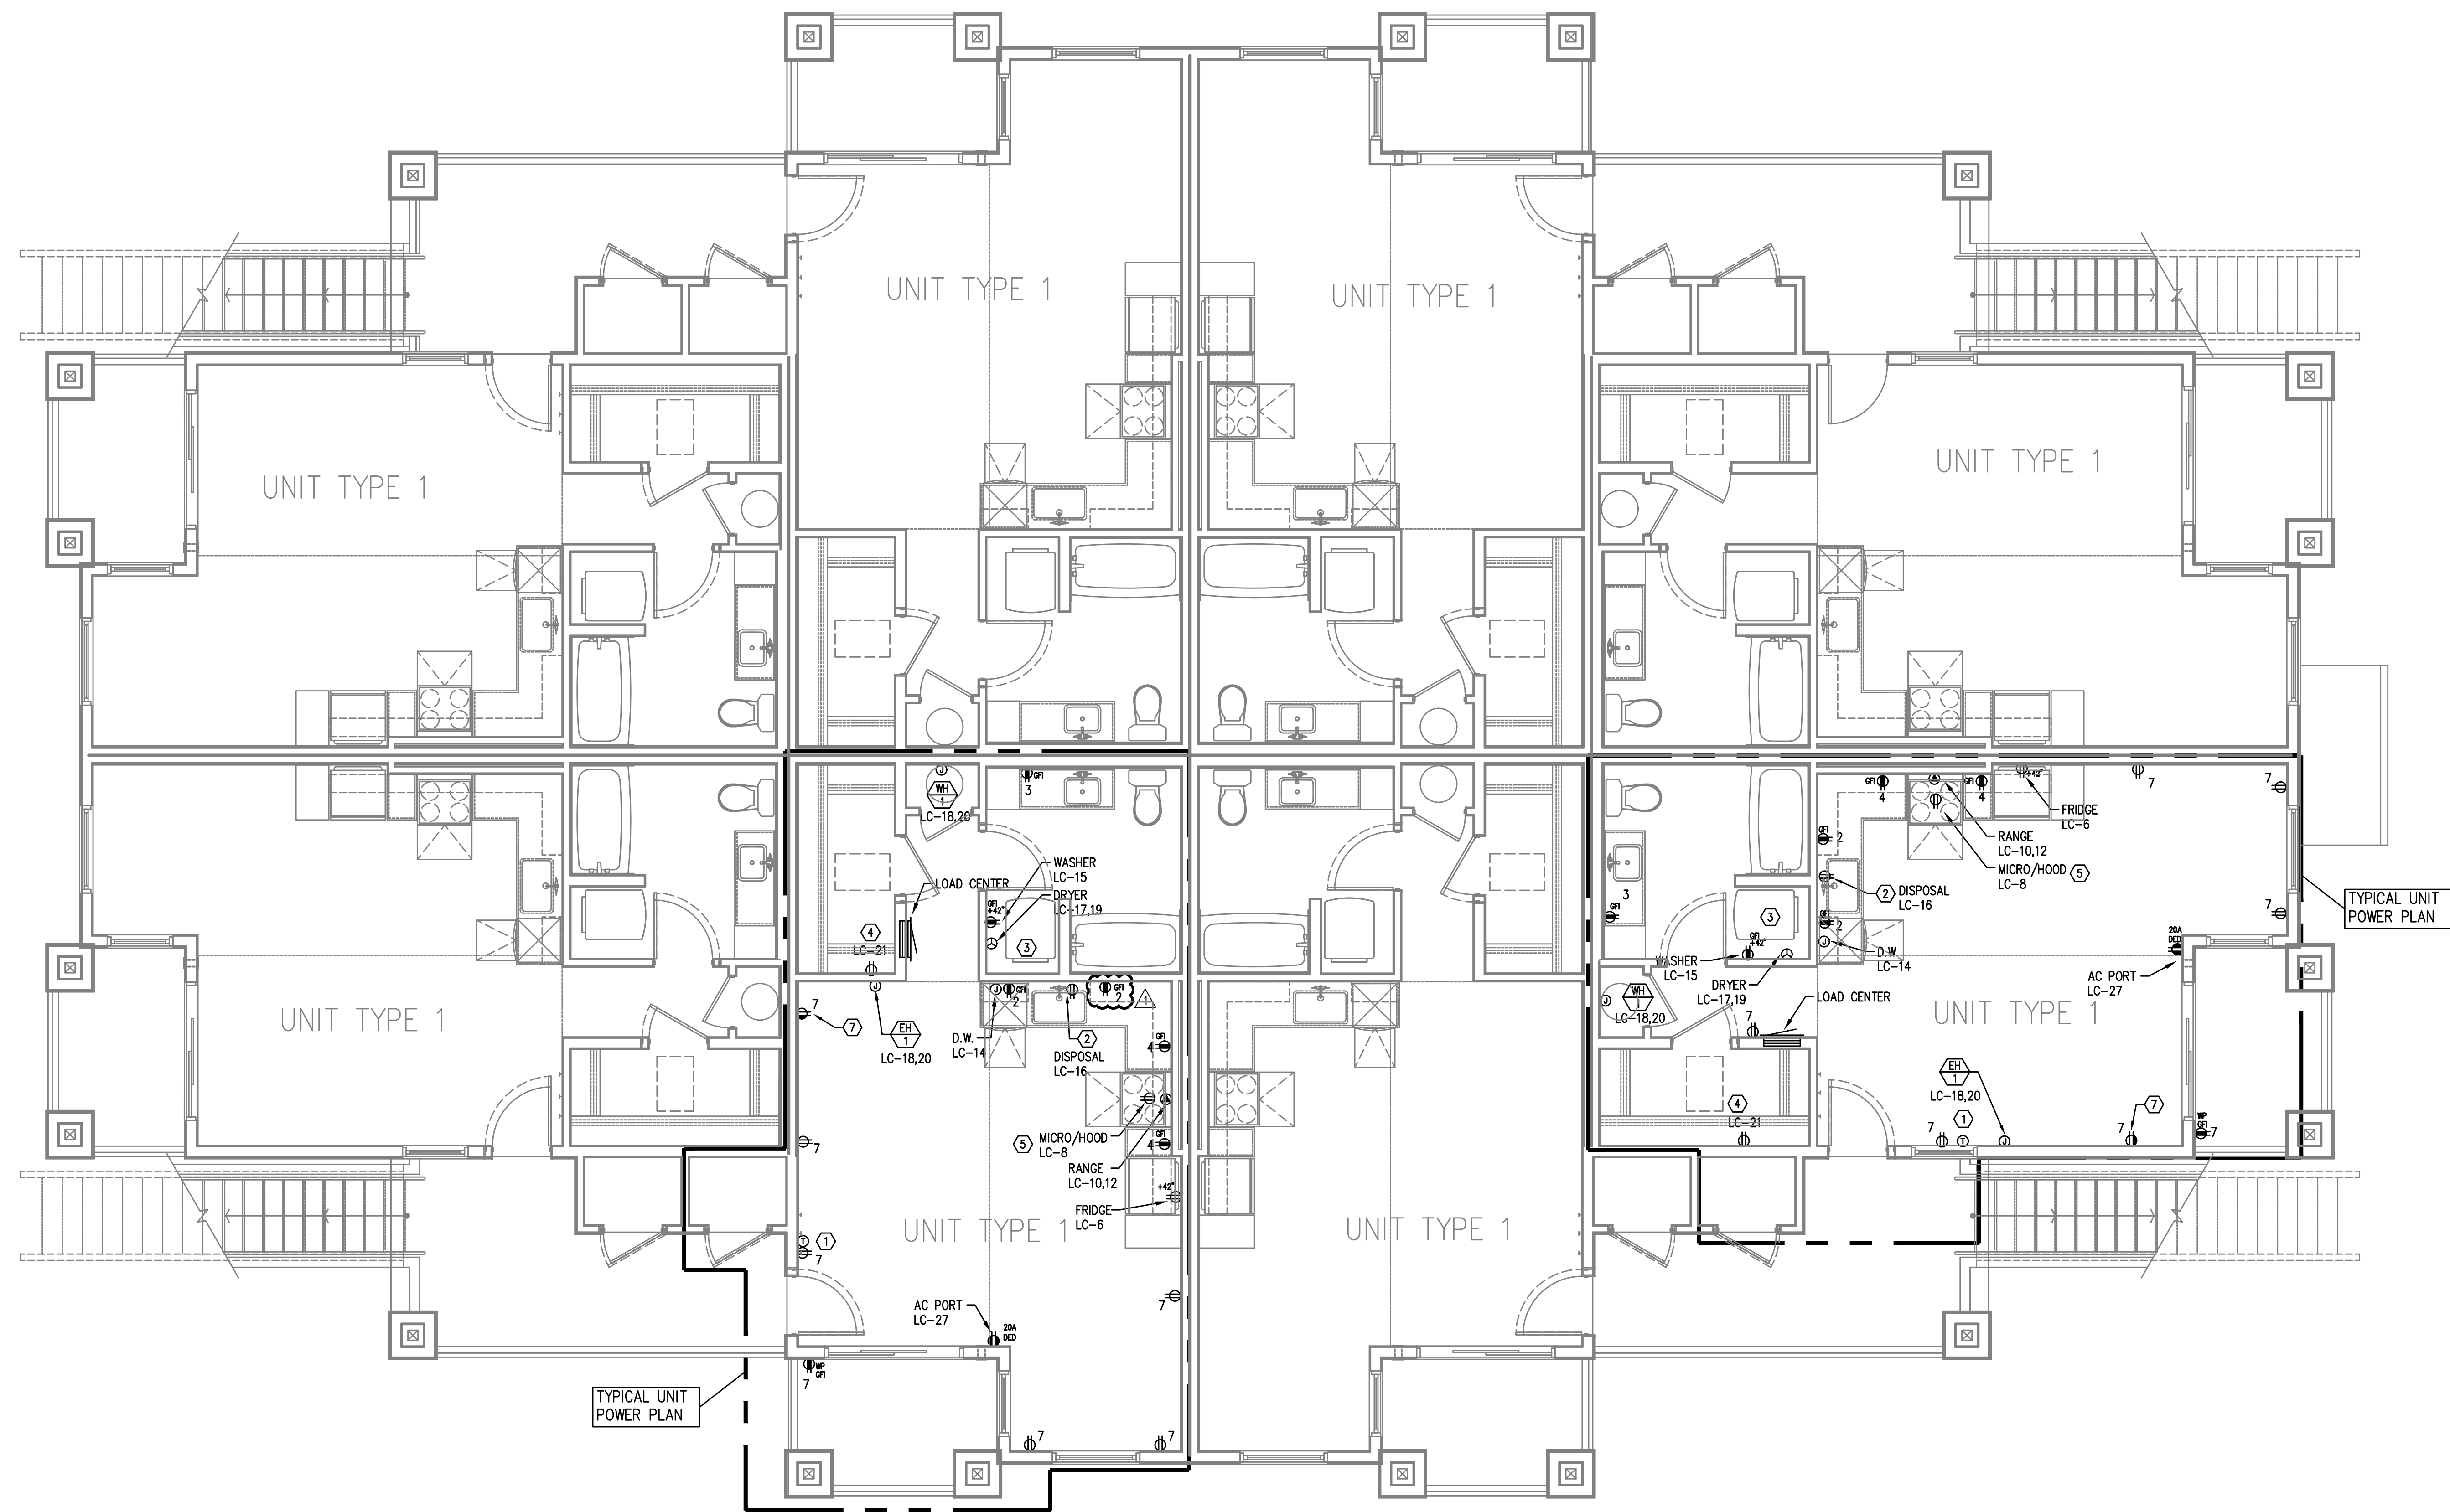

BLDG TYPE A – BLDGS 'A' & 'F'
SECOND FLOOR – POWER PLAN
SCALE: 1/4" = 1'-0"

GENERAL POWER NOTES:

- ALL PLANS ARE CONSIDERED DIAGRAMMATICAL. THEREFORE ALL EQUIPMENT SIZES AND DEVICE LOCATIONS ARE APPROXIMATE AND SUBJECT TO FIELD CONDITIONS AND PRODUCT APPROVAL.
- ELECTRICAL CONTRACTOR TO PROVIDE THERMOSTATS NOT SUPPLIED BY MECHANICAL CONTRACTOR. CONSULT MECHANICAL PLANS FOR ADDITIONAL INFORMATION.
- ELECTRICAL CONTRACTOR SHALL PROVIDE INSTALLATION AND FINAL CONNECTION OF THERMOSTATS. CONSULT MECHANICAL CONTRACTOR FOR EXACT REQUIREMENTS PRIOR TO ROUGH IN.
- REFER TO INTERIOR DECORATOR AND/OR ARCHITECTURAL DRAWINGS FOR DIMENSIONED LOCATION(S) AND ELEVATIONS OF FIXTURES & DEVICES. OTHER DEVICES SHOWN ON THE ELECTRICAL PLANS AND NOT INDICATED ON THE DECORATOR'S OR ARCHITECT'S DRAWINGS, SHALL BE INSTALLED AT STANDARD MOUNTING HEIGHT AS INDICATED THE SYMBOL LIST.
- BUILDING ELECTRICAL EQUIPMENT SHOWN IS APPROXIMATE, BASED ON INDUSTRY STANDARD PRODUCTS. CONTRACTOR SHALL VERIFY ANY SUBMITTED EQUIPMENT WILL FIT WITHIN THE SPACE PROVIDED, PRIOR TO PRODUCT SUBMITTAL REVIEW.
- ELECTRICAL CONTRACTOR SHALL COORDINATE WITH THE LOW VOLTAGE ('T' SERIES) PLANS, INCLUDING FIRE ALARM AND SYSTEMS INSTALLER, AND PROVIDE ROUGH IN AS NEEDED.
- REFER TO ARCHITECTURAL PLANS REGARDING "ACCESSIBLE" UNIT LOCATION(S), INTERIOR ELEVATIONS & DETAILS. COORDINATE INSTALLATION OF ALL DEVICES PER THE "AMERICAN DISABILITIES ACT" (ADA). REFER TO SHEET E1.21 FOR STANDARD ADA REACH REQUIREMENTS.

KEYED POWER NOTES:

- PROVIDE WIRE CONNECTION FOR THERMOSTAT(S). COORDINATE WITH MECHANICAL INSTALLER FOR EXACT LOCATION AND POWER REQUIREMENTS PRIOR TO ROUGH IN.
- *PROVIDE ONE 20A, 120V, 1P GFCI DUPLEX RECEPTACLE UNDER KITCHEN SINK FOR DISPOSAL POWER CONNECTION.
- REFER TO DETAIL 1/E1.13 FOR TYPICAL LAUNDRY ALCOVE RECEPTACLE LOCATIONS. COORDINATE INSTALLATION WITH MECHANICAL & PLUMBING CONTRACTOR.
- PROVIDE ONE 15A, RECEPTACLE CIRCUIT FROM TENANT LOAD CENTER FOR TELECOM SMART PANEL. COORDINATE WORK WITH SERVICE PROVIDER FOR EXACT LOCATION AND FINAL CONNECTION.
- CONTRACTOR TO VERIFY POWER CONNECTION TYPE FOR THE HOOD/MICROWAVE PRIOR TO ROUGH IN. PROVIDE ONE DEDICATED 20A, 1P DUPLEX RECEPTACLE LOCATED INSIDE THE CABINET OVER THE RANGE FOR APPLIANCES SUPPLIED WITH CORD & PLUG SET. HOOD/MICROWAVES THAT ARE TO BE HARDWIRED, SHALL BE PROVIDED WITH THE DEDICATED CIRCUIT GOING TO A J-BOX WHICH IS TO BE MOUNTED DIRECTLY BEHIND THE APPLIANCE.
- METER LOCATION PER UTILITY PROVIDER'S APPROVAL (PENDING). REFER TO ONE-LINE DIAGRAM ON SHEET E1.11. PROVIDE NEMA 3R LOCKING CABINET FOR HOUSE PANEL 'HP'. REFER TO SHEET E1.01 FOR METER & PANEL LOCATION(S) AT EACH BUILDING.
- 15A SWITCHED SPLIT DUPLEX RECEPTACLE. REFER TO LIGHTING PLANS (E2 SERIES SHEETS) FOR SWITCH LOCATION.



IN THE EVENT CONFLICTS ARE DISCOVERED BETWEEN THE ORIGINAL SIGNED AND SEALED DOCUMENTS PREPARED BY THE ARCHITECTS AND/OR THEIR CONSULTANTS, AND ANY COPY OF THE DOCUMENTS TRANSMITTED BY EMAIL, FAX, ELECTRONICALLY OR OTHERWISE, THE ORIGINAL SIGNED AND SEALED DOCUMENTS SHALL GOVERN.

PROJECT # 2019-179
DATE: 28 AUGUST 2020


REVISIONS

PLAN REVIEW 11.03.2020

MCKINNEY LANE APARTMENTS PHASE II
RUSSELL DRIVE & MCKINNEY LANE
LEBANON, OREGON

AS
E2.01

MEFA Consulting Engineers
2007 S.E. Ash St.
Portland, OR 97214
PH: (503) 234-0548
FAX: (503) 234-0677
INC. WWW.MFA-ENG.COM
CONTACT: DENISE TAYLOR

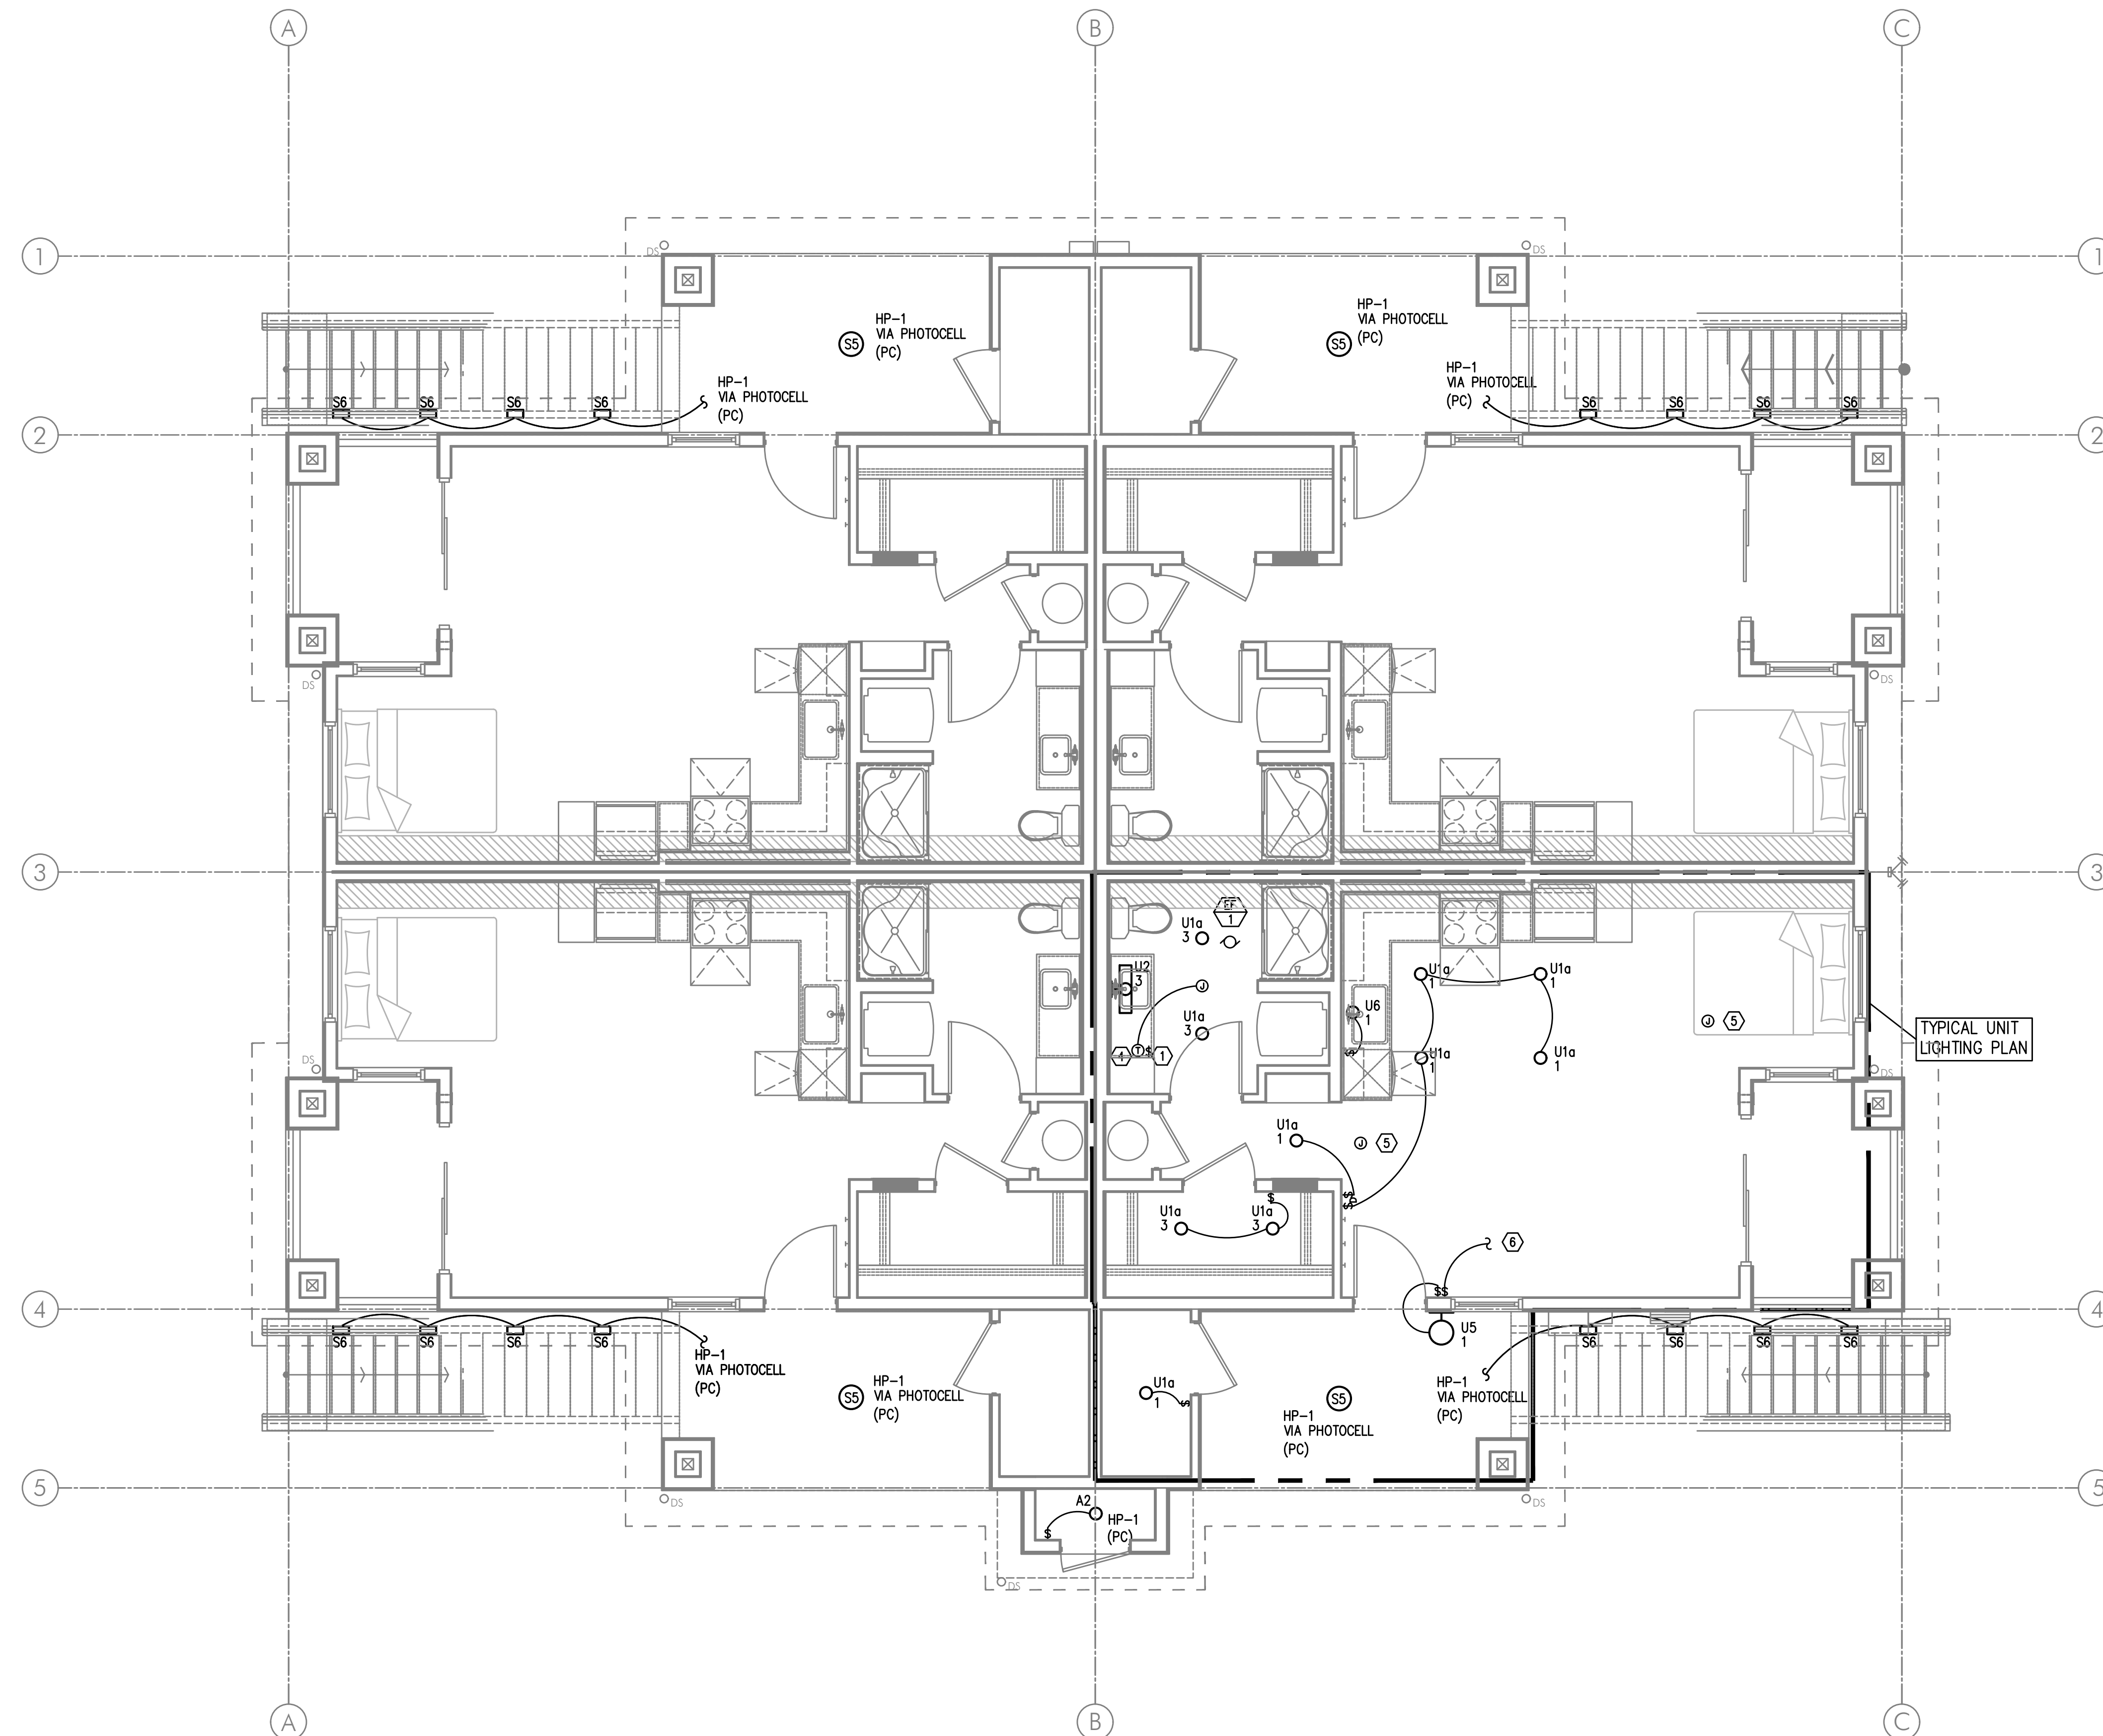

1 BLDG TYPE AS - BLDG "C"
E2.01 FIRST FLOOR - LIGHTING PLAN
SCALE: 1/4" = 1'-0"

GENERAL LIGHTING NOTES:

- ELECTRICAL DRAWINGS ARE DIAGRAMMATICAL AND MAY NOT ACCURATELY REFLECT ACTUAL CONSTRUCTION CONDITIONS. THE ELECTRICAL CONTRACTOR SHALL BE RESPONSIBLE FOR COORDINATING THE INSTALLATION OF ALL ELECTRICAL EQUIPMENT, WITH ALL TRADES PRIOR TO AND DURING CONSTRUCTION.
- THE ELECTRICAL CONTRACTOR SHALL REFER TO THE ARCHITECTURAL DRAWINGS FOR ALL MOUNTING HEIGHTS AND FINISHES OF DEVICES AND FIXTURES.
- REFER TO SHEET E1.21 FOR LIGHT FIXTURE SCHEDULES.
- THE CONTRACTOR SHALL CONSULT THE ARCHITECT AND/OR INTERIOR DESIGNER FOR THE EXACT LOCATION OF ALL LIGHT FIXTURES PRIOR TO THE START OF ANY ROUGH IN WORK.
- REFER TO AVAILABLE ARCHITECTURAL AND/OR INTERIOR DESIGN DOCUMENTS & DRAWINGS FOR ADDITIONAL INFORMATION.
- EXTERIOR LIGHTING TO BE CONSTANT "ON" AND PROVIDED WITH PHOTOCELL (EITHER INTEGRAL OR REMOTE) FOR DUSK-TIL-DAWN OPERATION.
- ALL EXTERIOR BUILDING LIGHTS ON HOUSE POWER SHALL BE CONSIDERED EGRESS LIGHTING. FIXTURES ARE TO BE EQUIPPED WITH BATTERY BACK-UP (EITHER INTEGRAL OR REMOTE).
- REFER TO SHEET E1.14 FOR TYPICAL UNIT LOAD CENTER DIRECTORIES.
- ALL LIGHT SWITCHES SHALL BE ROCKER STYLE, SUCH AS LEVITON DECORA, OR APPROVED EQUAL.
- REFER TO ARCHITECTURAL REFLECTED CEILING PLANS FOR EXACT FIXTURE LOCATIONS (DIMENSIONS). CONSULT INTERIOR DESIGNER FOR MOUNTING HEIGHTS NOT SPECIFIED.

KEYED LIGHTING NOTES:

- REFER TO TYPICAL BATHROOM SWITCHING DETAILS ON SHEET E1.21.
- PROVIDE CEILING FAN CONTROL SWITCH(ES) AS DIRECTED BY MANUFACTURER.
- PROVIDE BLOCKING AT CEILING TO SUPPORT 35LB., MINIMUM, FOR CEILING FAN INSTALLATION.
- PROVIDE WIRE CONNECTION FOR THERMOSTAT(S). COORDINATE WITH MECHANICAL INSTALLER FOR EXACT LOCATION AND POWER REQUIREMENTS PRIOR TO ROUGH IN. CEILING HEATER TO BE TIED INTO BATHROOM POWER CIRCUIT.
- COORDINATE LOCATION OF POWER CONNECTION FOR FIRE ALARM DEVICES WITH THE SYSTEM CONTRACTOR/INSTALLER.
- TO SWITCHED RECEPTACLE. REFER TO POWER PLANS (E3 SERIES SHEETS) FOR OUTLET LOCATION.



IN THE EVENT CONFLICTS ARE DISCOVERED BETWEEN THE ORIGINAL SIGNED AND SEALED DOCUMENTS PREPARED BY THE ARCHITECTS AND/OR THEIR CONSULTANTS, AND ANY COPY OF THE DOCUMENTS TRANSMITTED BY ELECTRONIC, ELECTRONICALLY OR OTHERWISE, THE ORIGINAL SIGNED AND SEALED DOCUMENTS SHALL GOVERN.


PROJECT # 2019-179
DATE: 28 AUGUST 2020

REVISIONS

PLAN REVIEW 11.03.2020

MCKINNEY LANE APARTMENTS PHASE II
RUSSELL DRIVE & MCKINNEY LANE
LEBANON, OREGON

AS
E3.01

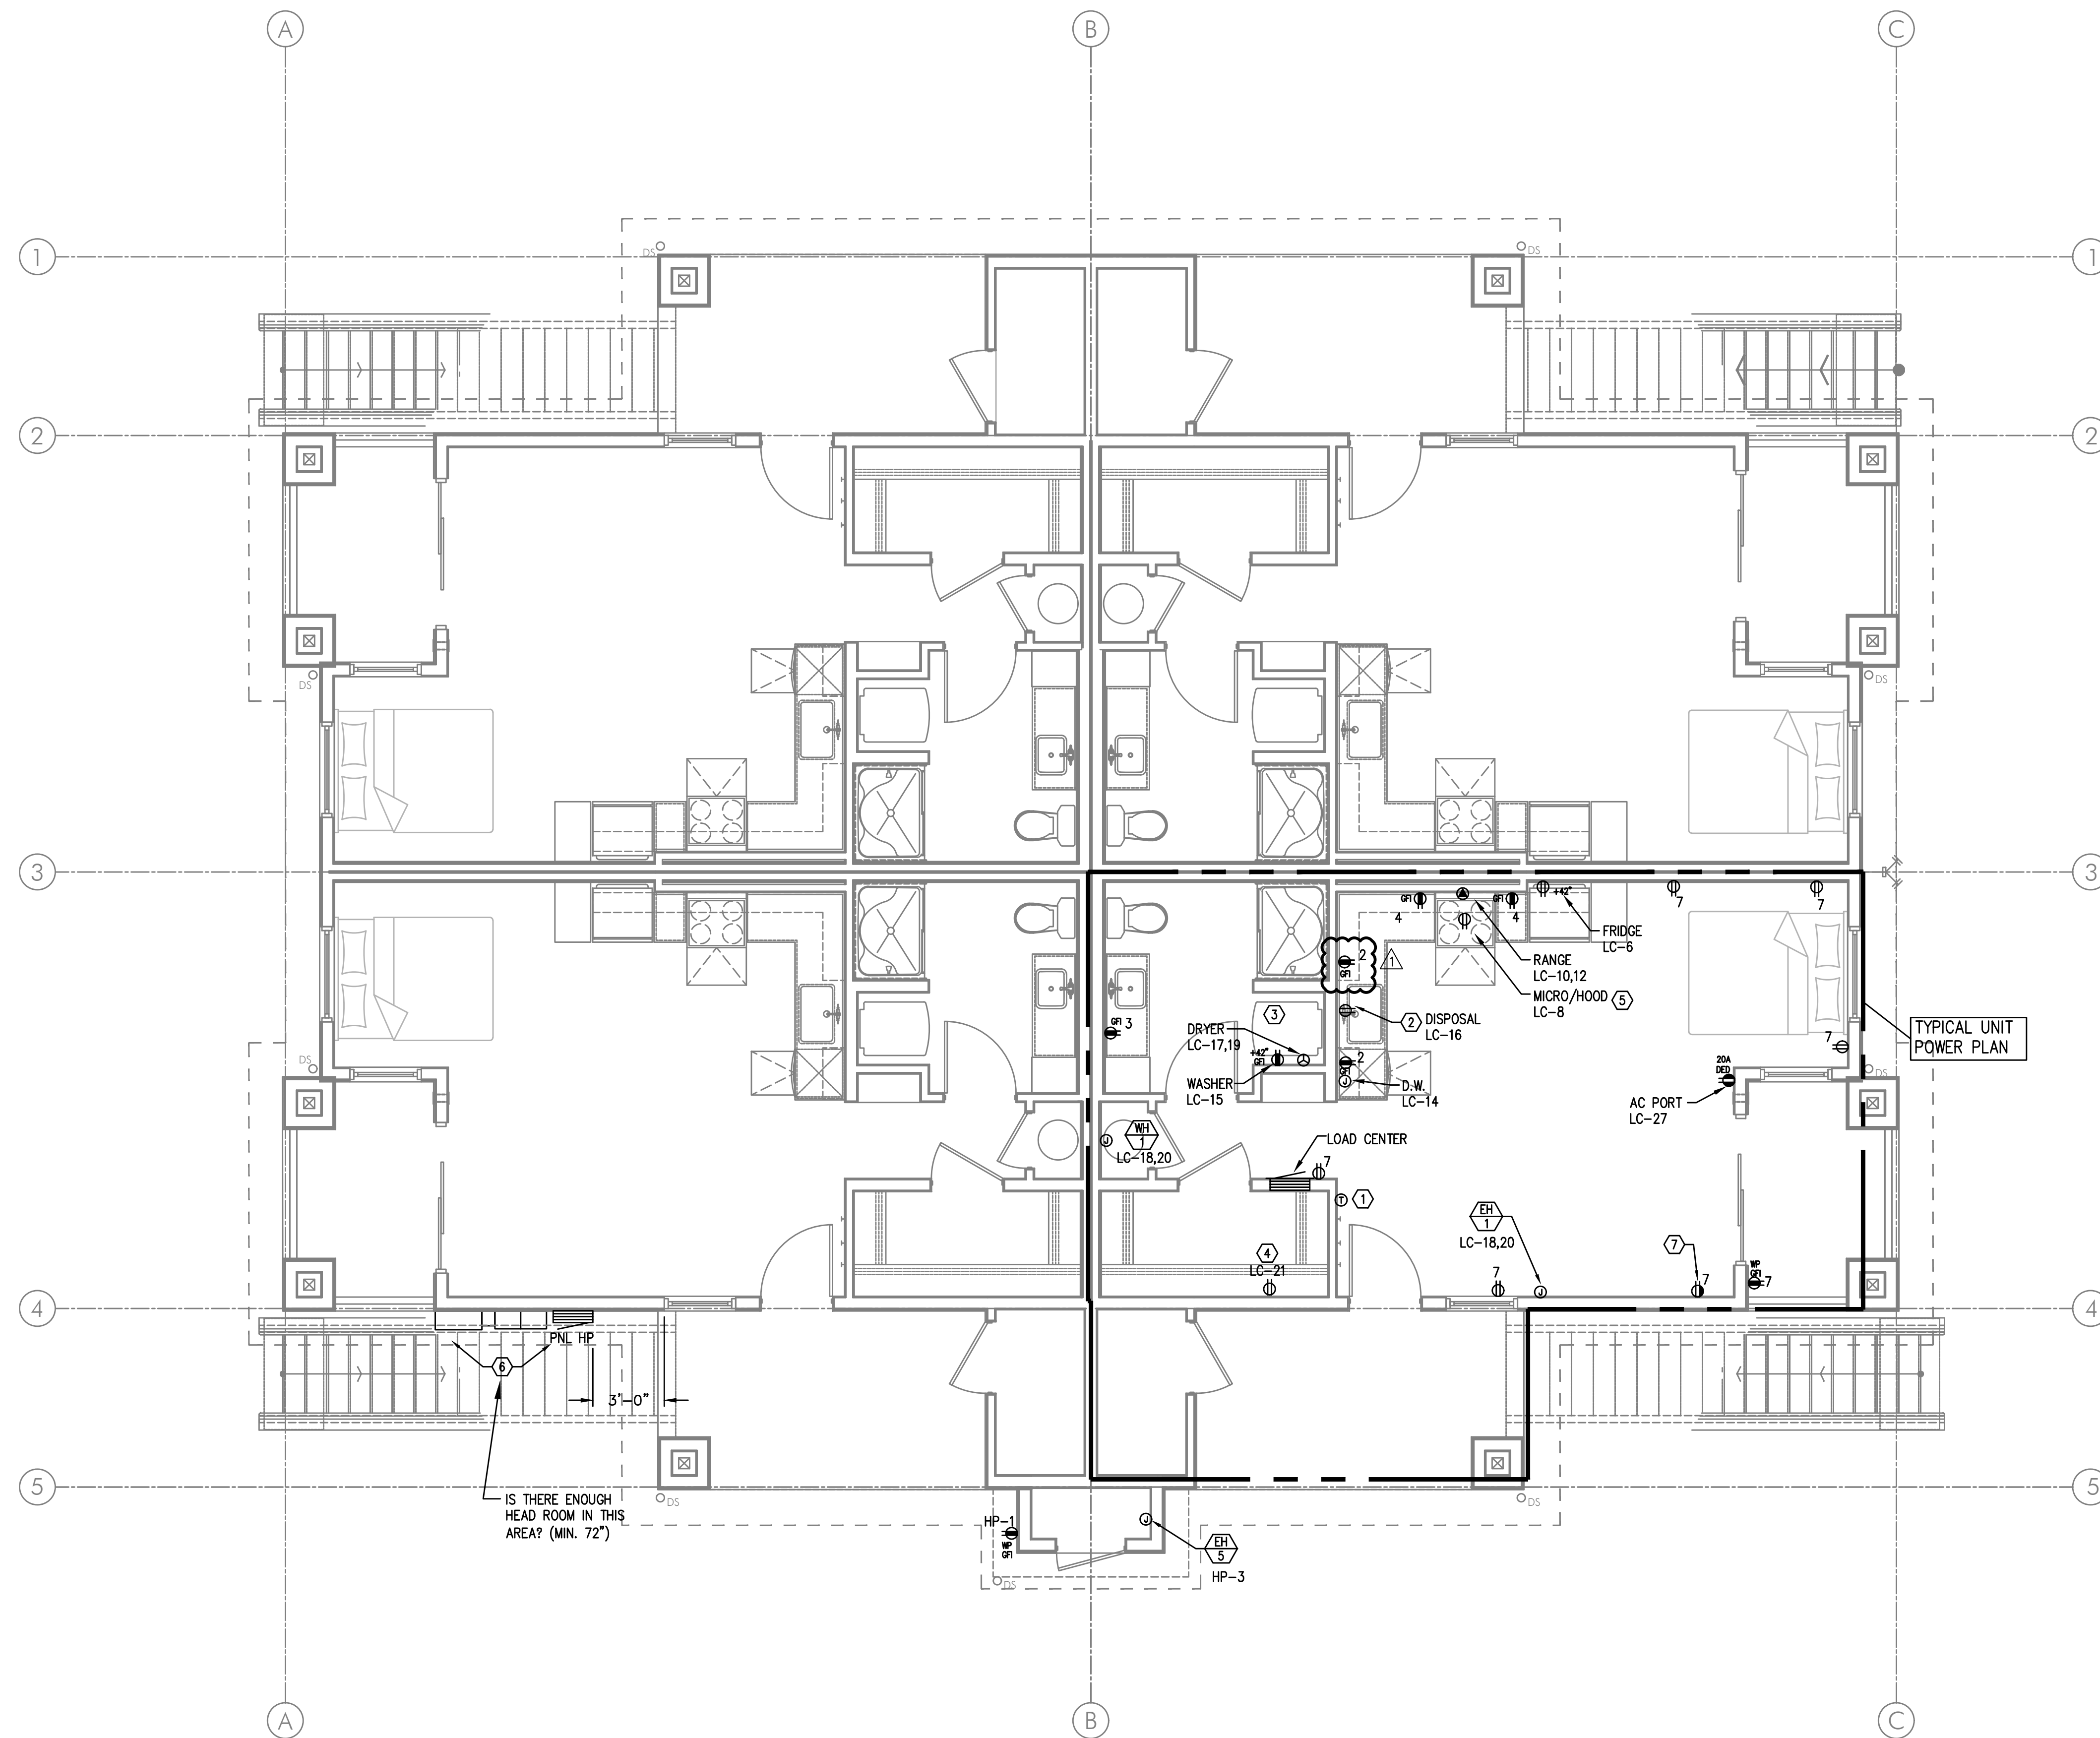


BLDG TYPE AS - BLDG "C"
FIRST FLOOR - POWER PLAN
1
E301
SCALE: 1/4" = 1'-0"

GENERAL POWER NOTES:

- ALL PLANS ARE CONSIDERED DIAGRAMMATICAL. THEREFORE ALL EQUIPMENT SIZES AND DEVICE LOCATIONS ARE APPROXIMATE AND SUBJECT TO FIELD CONDITIONS AND PRODUCT APPROVAL.
- ELECTRICAL CONTRACTOR TO PROVIDE THERMOSTATS NOT SUPPLIED BY MECHANICAL CONTRACTOR. CONSULT MECHANICAL PLANS FOR ADDITIONAL INFORMATION.
- ELECTRICAL CONTRACTOR SHALL PROVIDE INSTALLATION AND FINAL CONNECTION OF THERMOSTATS. CONSULT MECHANICAL CONTRACTOR FOR EXACT REQUIREMENTS PRIOR TO ROUGH IN.
- REFER TO INTERIOR DECORATOR AND/OR ARCHITECTURAL DRAWINGS FOR DIMENSIONED LOCATION(S) AND ELEVATIONS OF FIXTURES & DEVICES. OTHER DEVICES SHOWN ON THE ELECTRICAL PLANS AND NOT INDICATED ON THE DECORATOR'S OR ARCHITECT'S DRAWINGS, SHALL BE INSTALLED AT STANDARD MOUNTING HEIGHT AS INDICATED THE SYMBOL LIST.
- BUILDING ELECTRICAL EQUIPMENT SHOWN IS APPROXIMATE, BASED ON INDUSTRY STANDARD PRODUCTS. CONTRACTOR SHALL VERIFY ANY SUBMITTED EQUIPMENT WILL FIT WITHIN THE SPACE PROVIDED, PRIOR TO PRODUCT SUBMITTAL REVIEW.
- ELECTRICAL CONTRACTOR SHALL COORDINATE WITH THE LOW VOLTAGE ("T" SERIES) PLANS, INCLUDING FIRE ALARM AND SYSTEMS INSTALLER, AND PROVIDE ROUGH IN AS NEEDED.

KEYED POWER NOTES:

- PROVIDE WIRE CONNECTION FOR THERMOSTAT(S). COORDINATE WITH MECHANICAL INSTALLER FOR EXACT LOCATION AND POWER REQUIREMENTS PRIOR TO ROUGH IN.
- *PROVIDE ONE 20A, 120V, 1P GFCI DUPLEX RECEPTACLE UNDER KITCHEN SINK FOR DISPOSAL POWER CONNECTION.
- REFER TO DETAIL 1/E1.13 FOR TYPICAL LAUNDRY ALCOVE RECEPTACLE LOCATIONS. COORDINATE INSTALLATION WITH MECHANICAL & PLUMBING CONTRACTOR.
- PROVIDE ONE 15A, RECEPTACLE CIRCUIT FROM TENANT LOAD CENTER FOR TELECOM SMART PANEL. COORDINATE WORK WITH SERVICE PROVIDER FOR EXACT LOCATION AND FINAL CONNECTION.
- CONTRACTOR TO VERIFY POWER CONNECTION TYPE FOR THE HOOD/MICROWAVE PRIOR TO ROUGH IN. PROVIDE ONE DEDICATED 20A, 1P DUPLEX RECEPTACLE LOCATED INSIDE THE CABINET OVER THE RANGE FOR APPLIANCES SUPPLIED WITH CORD & PLUG SET. HOOD/MICROWAVES THAT ARE TO BE HARDWIRED, SHALL BE PROVIDED WITH THE DEDICATED CIRCUIT GOING TO A J-BOX WHICH IS TO BE MOUNTED DIRECTLY BEHIND THE APPLIANCE.
- METER LOCATION PER UTILITY PROVIDER'S APPROVAL (PENDING). REFER TO ONE-LINE DIAGRAM ON SHEET E1.11. PROVIDE NEMA 3R LOCKING CABINET FOR HOUSE PANEL 'HP'. REFER TO SHEET E1.01 FOR METER & PANEL LOCATION(S) AT EACH BUILDING.
- 15A SWITCHED SPLIT DUPLEX RECEPTACLE. REFER TO LIGHTING PLANS (E2 SERIES SHEETS) FOR SWITCH LOCATION.

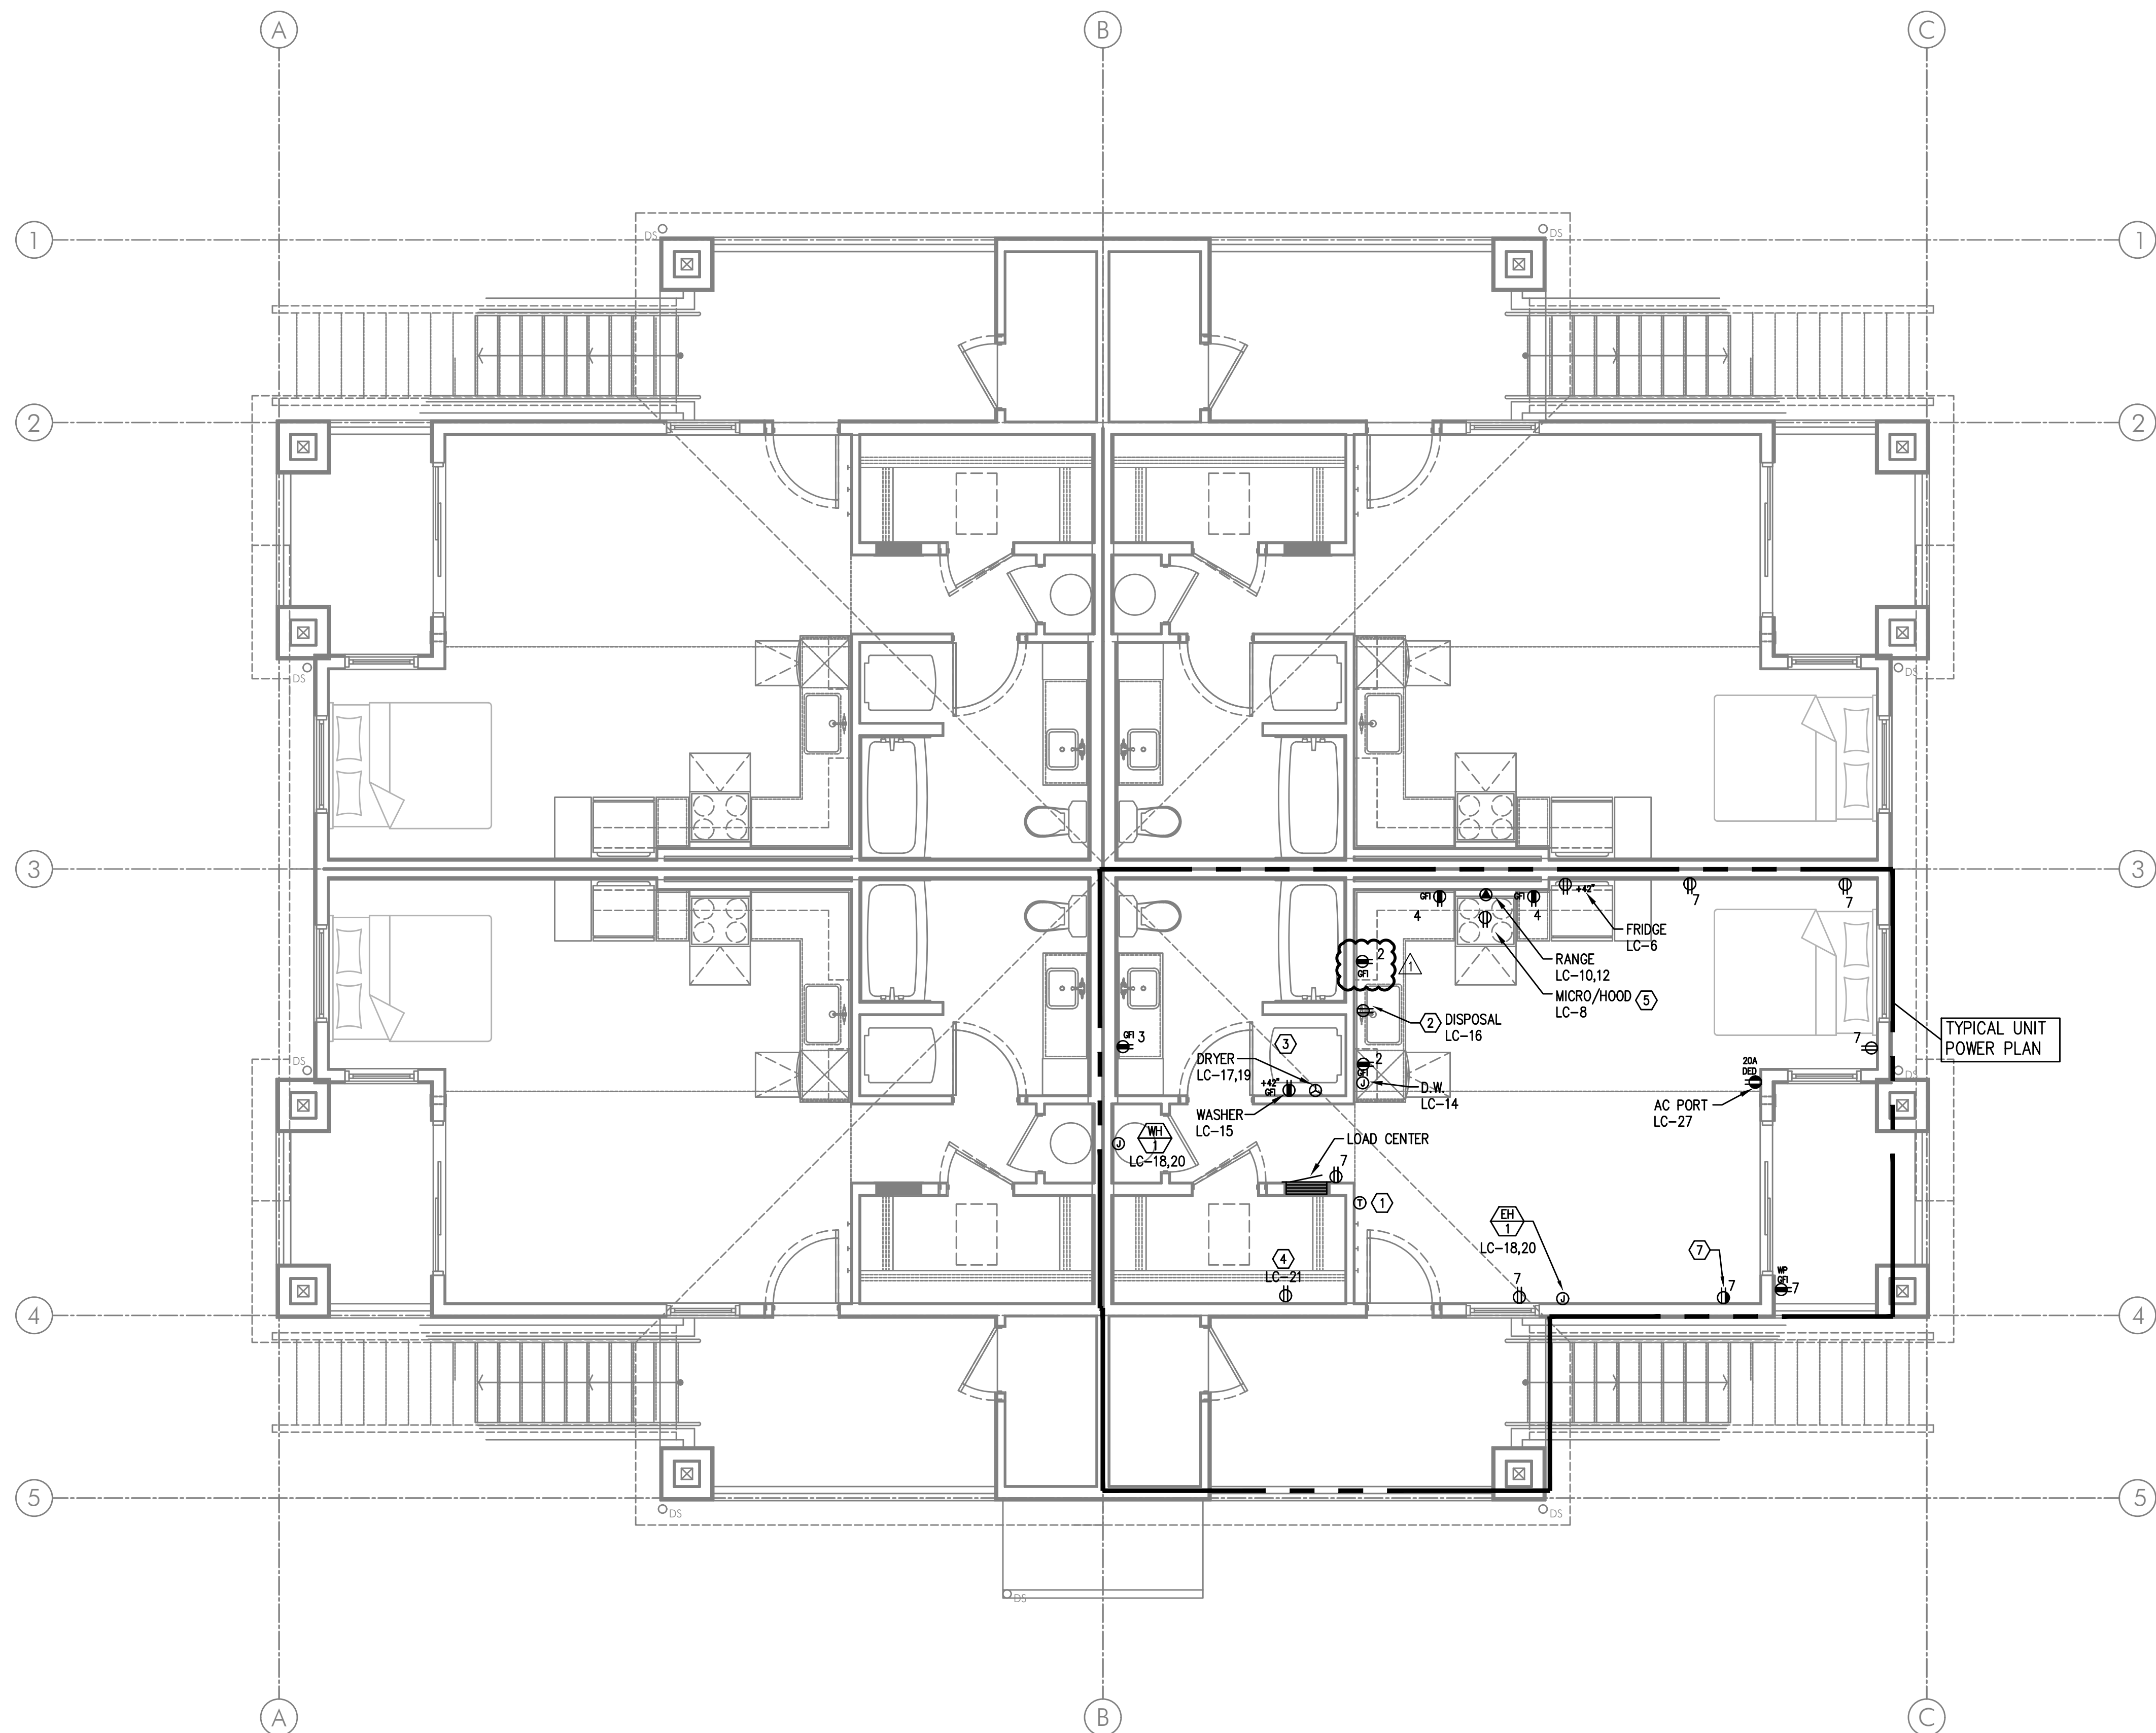


1
E302 BLDG TYPE AS - BLDG "C"
SECOND FLOOR - POWER PLAN
SCALE: 1/4" = 1'-0"

GENERAL POWER NOTES:

- ALL PLANS ARE CONSIDERED DIAGRAMMATICAL. THEREFORE ALL EQUIPMENT SIZES AND DEVICE LOCATIONS ARE APPROXIMATE AND SUBJECT TO FIELD CONDITIONS AND PRODUCT APPROVAL.
- ELECTRICAL CONTRACTOR TO PROVIDE THERMOSTATS NOT SUPPLIED BY MECHANICAL CONTRACTOR. CONSULT MECHANICAL PLANS FOR ADDITIONAL INFORMATION.
- ELECTRICAL CONTRACTOR SHALL PROVIDE INSTALLATION AND FINAL CONNECTION OF THERMOSTATS. CONSULT MECHANICAL CONTRACTOR FOR EXACT REQUIREMENTS PRIOR TO ROUGH IN.
- REFER TO INTERIOR DECORATOR AND/OR ARCHITECTURAL DRAWINGS FOR DIMENSIONED LOCATION(S) AND ELEVATIONS OF FIXTURES & DEVICES. OTHER DEVICES SHOWN ON THE ELECTRICAL PLANS AND NOT INDICATED ON THE DECORATOR'S OR ARCHITECT'S DRAWINGS, SHALL BE INSTALLED AT STANDARD MOUNTING HEIGHT AS INDICATED THE SYMBOL LIST.
- BUILDING ELECTRICAL EQUIPMENT SHOWN IS APPROXIMATE, BASED ON INDUSTRY STANDARD PRODUCTS. CONTRACTOR SHALL VERIFY ANY SUBMITTED EQUIPMENT WILL FIT WITHIN THE SPACE PROVIDED, PRIOR TO PRODUCT SUBMITTAL REVIEW.
- ELECTRICAL CONTRACTOR SHALL COORDINATE WITH THE LOW VOLTAGE ("T" SERIES) PLANS, INCLUDING FIRE ALARM AND SYSTEMS INSTALLER, AND PROVIDE ROUGH IN AS NEEDED.

KEYED POWER NOTES:

- PROVIDE WIRE CONNECTION FOR THERMOSTAT(S). COORDINATE WITH MECHANICAL INSTALLER FOR EXACT LOCATION AND POWER REQUIREMENTS PRIOR TO ROUGH IN.
- *PROVIDE ONE 20A, 120V, 1P GFCI DUPLEX RECEPTACLE UNDER KITCHEN SINK FOR DISPOSAL POWER CONNECTION.
- REFER TO DETAIL 1/E1.13 FOR TYPICAL LAUNDRY ALCOVE RECEPTACLE LOCATIONS. COORDINATE INSTALLATION WITH MECHANICAL & PLUMBING CONTRACTOR.
- PROVIDE ONE 15A, RECEPTACLE CIRCUIT FROM TENANT LOAD CENTER FOR TELECOM SMART PANEL. COORDINATE WORK WITH SERVICE PROVIDER FOR EXACT LOCATION AND FINAL CONNECTION.
- CONTRACTOR TO VERIFY POWER CONNECTION TYPE FOR THE HOOD/MICROWAVE PRIOR TO ROUGH IN. PROVIDE ONE DEDICATED 20A, 1P DUPLEX RECEPTACLE LOCATED INSIDE THE CABINET OVER THE RANGE FOR APPLIANCES SUPPLIED WITH CORD & PLUG SET. HOOD/MICROWAVES THAT ARE TO BE HARDWIRED, SHALL BE PROVIDED WITH THE DEDICATED CIRCUIT GOING TO A J-BOX WHICH IS TO BE MOUNTED DIRECTLY BEHIND THE APPLIANCE.
- METER LOCATION PER UTILITY PROVIDER'S APPROVAL (PENDING). REFER TO ONE-LINE DIAGRAM ON SHEET E1.11. PROVIDE NEMA 3R LOCKING CABINET FOR HOUSE PANEL "HP". REFER TO SHEET E1.01 FOR METER & PANEL LOCATION(S) AT EACH BUILDING.
- 15A SWITCHED SPLIT DUPLEX RECEPTACLE. REFER TO LIGHTING PLANS (E2 SERIES SHEETS) FOR SWITCH LOCATION.

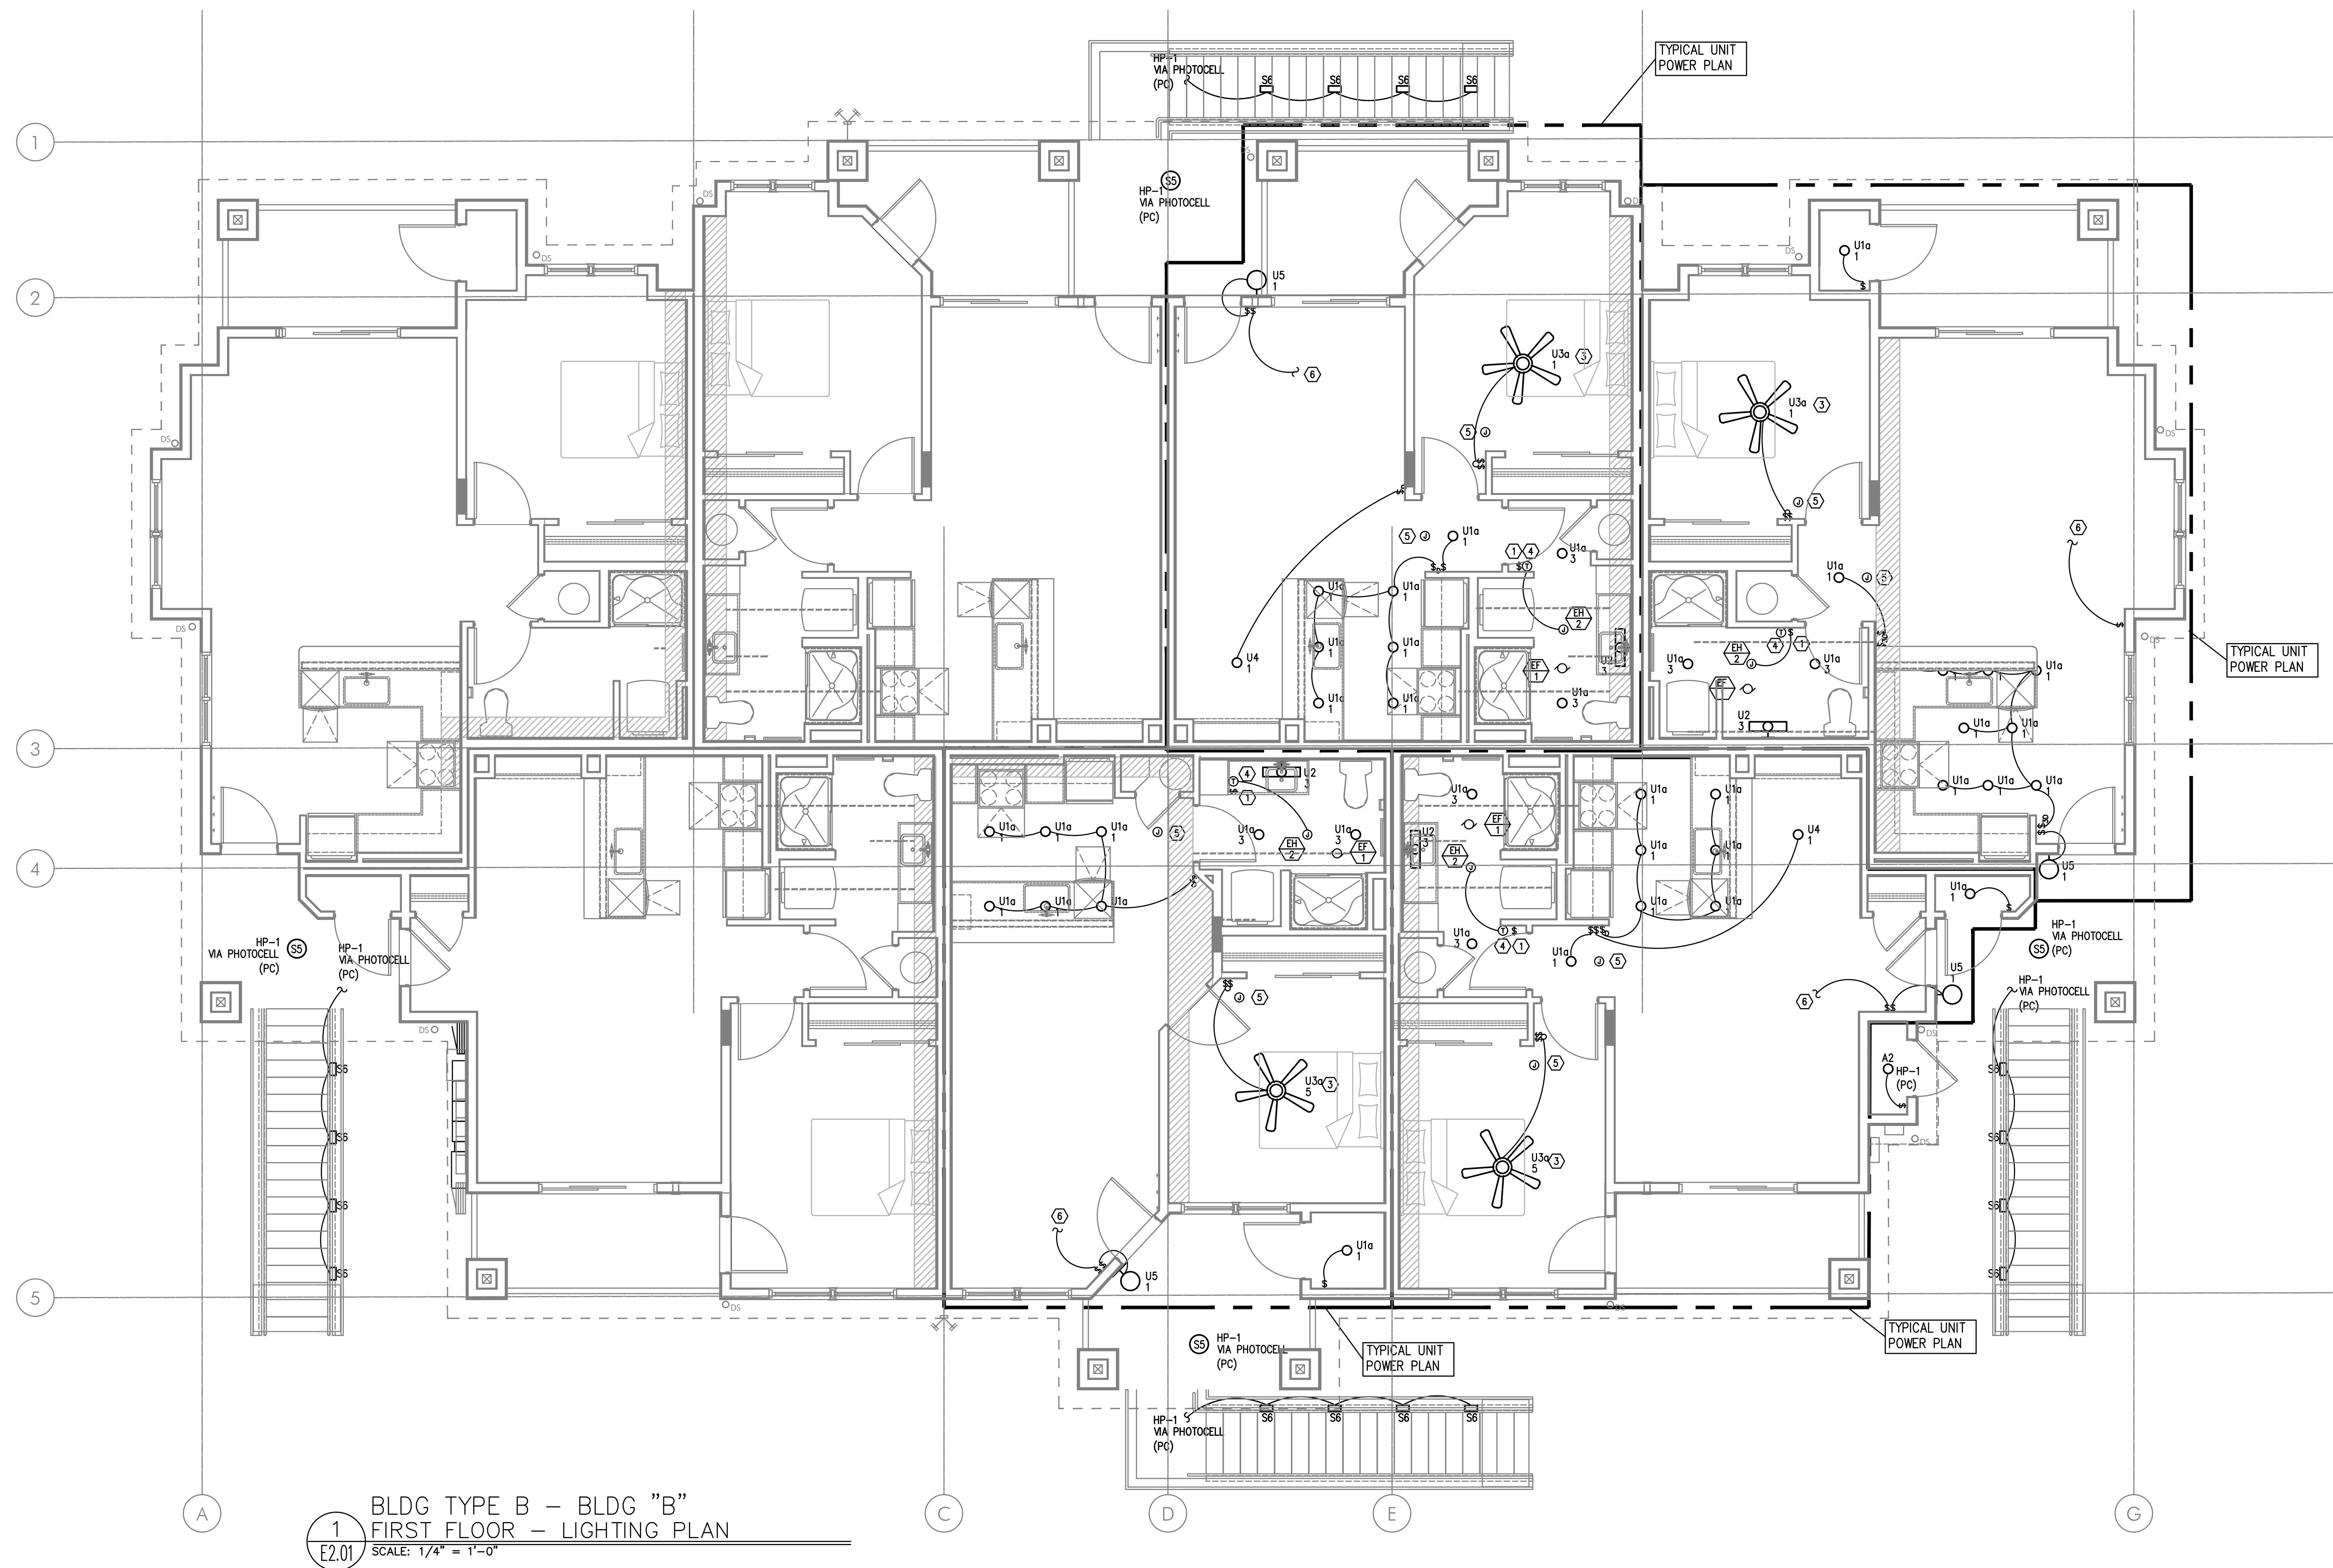


GENERAL LIGHTING NOTES:

- ELECTRICAL DRAWINGS ARE DIAGRAMMATICAL AND MAY NOT ACCURATELY REFLECT ACTUAL CONSTRUCTION CONDITIONS. THE ELECTRICAL CONTRACTOR SHALL BE RESPONSIBLE FOR COORDINATING THE INSTALLATION OF ALL ELECTRICAL EQUIPMENT, WITH ALL TRADES PRIOR TO AND DURING CONSTRUCTION.
- THE ELECTRICAL CONTRACTOR SHALL REFER TO THE ARCHITECTURAL DRAWINGS FOR ALL MOUNTING HEIGHTS AND FINISHES OF DEVICES AND FIXTURES.
- REFER TO SHEET E1.21 FOR LIGHT FIXTURE SCHEDULES.
- THE CONTRACTOR SHALL CONSULT THE ARCHITECT AND/OR INTERIOR DESIGNER FOR THE EXACT LOCATION OF ALL LIGHT FIXTURES PRIOR TO THE START OF ANY ROUGH IN WORK.
- REFER TO AVAILABLE ARCHITECTURAL AND/OR INTERIOR DESIGN DOCUMENTS & DRAWINGS FOR ADDITIONAL INFORMATION.
- EXTERIOR LIGHTING TO BE CONSTANT "ON" AND PROVIDED WITH PHOTOCELL, EITHER INTEGRAL OR REMOTE) FOR DUSK-TIL-DAWN OPERATION.
- ALL EXTERIOR BUILDING LIGHTS ON HOUSE POWER SHALL BE CONSIDERED EGRESS LIGHTING. FIXTURES ARE TO BE EQUIPPED WITH BATTERY BACK-UP (EITHER INTEGRAL OR REMOTE).
- REFER TO SHEET E1.14 FOR TYPICAL UNIT LOAD CENTER DIRECTORIES.
- ALL LIGHT SWITCHES SHALL BE ROCKER STYLE, SUCH AS LEVITON DECORA, OR APPROVED EQUAL.
- REFER TO ARCHITECTURAL REFLECTED CEILING PLANS FOR EXACT FIXTURE LOCATIONS (DIMENSIONS). CONSULT INTERIOR DESIGNER FOR MOUNTING HEIGHTS NOT SPECIFIED.

KEYED LIGHTING NOTES:

- REFER TO TYPICAL BATHROOM SWITCHING DETAILS ON SHEET E1.21.
- PROVIDE CEILING FAN CONTROL SWITCH(ES) AS DIRECTED BY MANUFACTURER.
- PROVIDE BLOCKING AT CEILING TO SUPPORT 35LB., MINIMUM, FOR CEILING FAN INSTALLATION.
- PROVIDE WIRE CONNECTION FOR THERMOSTAT(S). COORDINATE WITH MECHANICAL INSTALLER FOR EXACT LOCATION AND POWER REQUIREMENTS PRIOR TO ROUGH IN. CEILING HEATER TO BE TIED INTO BATHROOM POWER CIRCUIT.
- COORDINATE LOCATION OF POWER CONNECTION FOR FIRE ALARM DEVICES WITH THE SYSTEM CONTRACTOR/INSTALLER.
- TO SWITCHED RECEPTACLE. REFER TO POWER PLANS (E3 SERIES SHEETS) FOR OUTLET LOCATION.

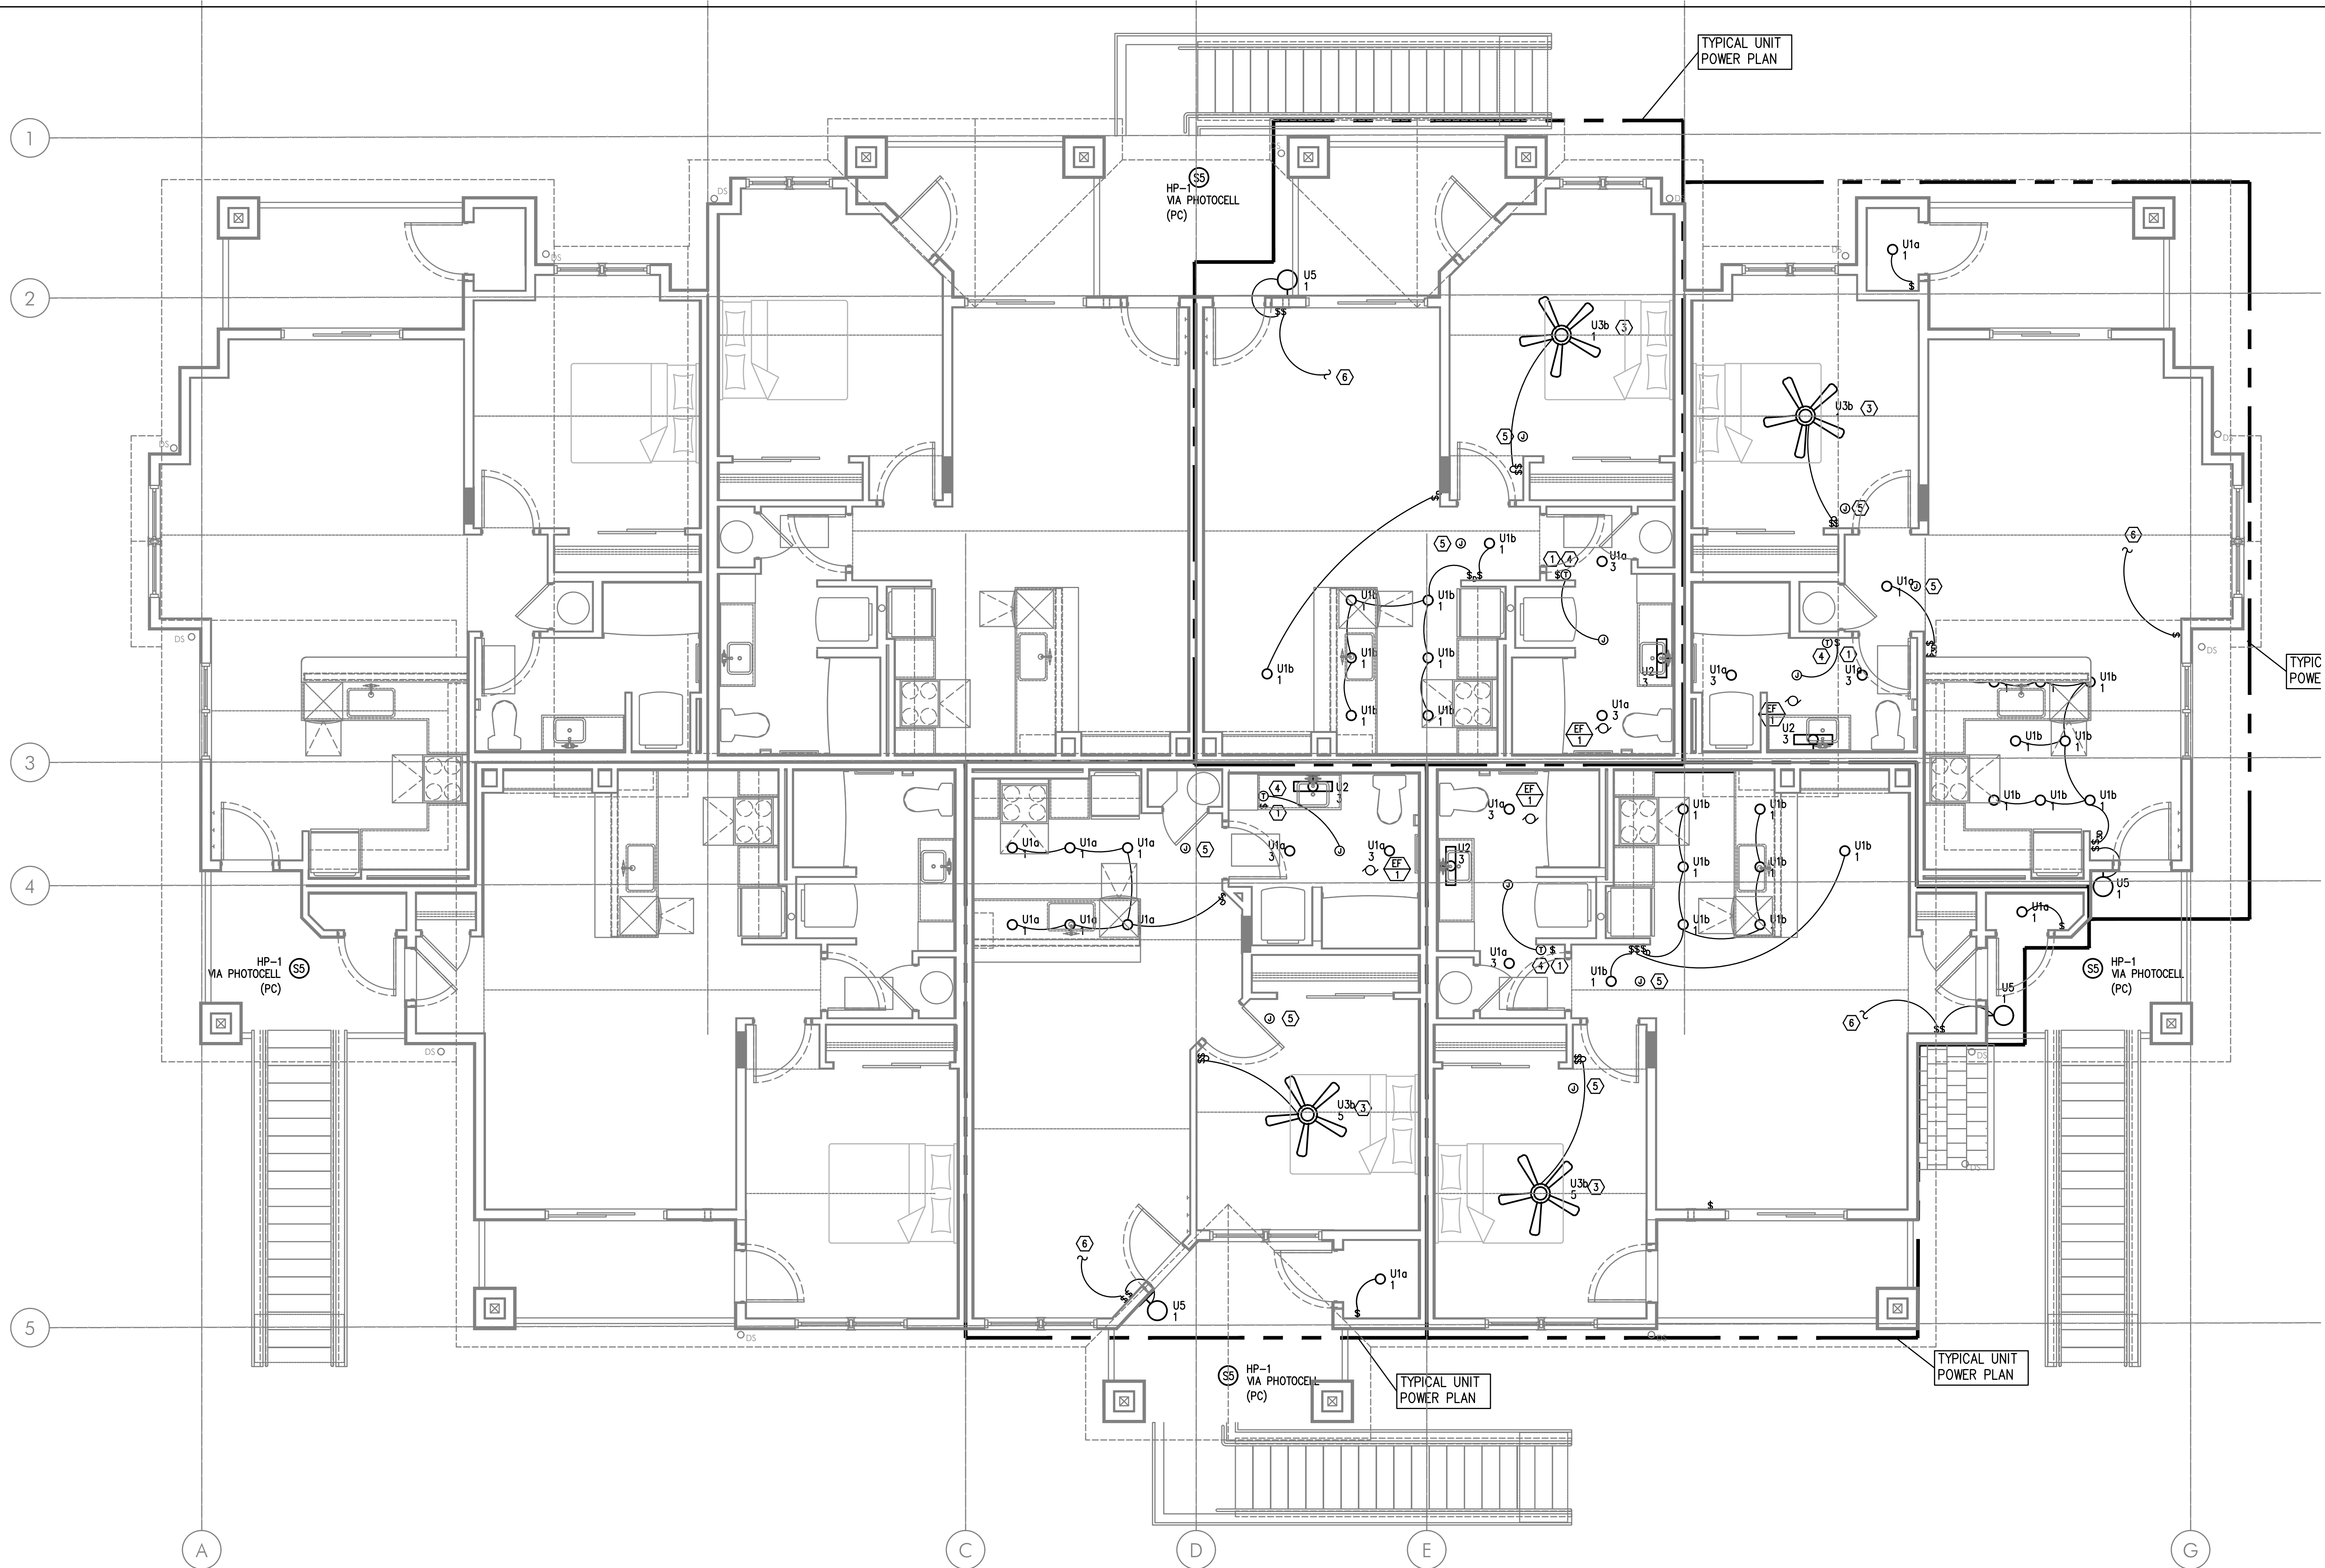

1 BLDG TYPE B - BLDG "B"
E2.02 SECOND FLOOR - LIGHTING PLAN
SCALE: 1/4" = 1'-0"

GENERAL LIGHTING NOTES:

- ELECTRICAL DRAWINGS ARE DIAGRAMMATICAL AND MAY NOT ACCURATELY REFLECT ACTUAL CONSTRUCTION CONDITIONS. THE ELECTRICAL CONTRACTOR SHALL BE RESPONSIBLE FOR COORDINATING THE INSTALLATION OF ALL ELECTRICAL EQUIPMENT, WITH ALL TRADES PRIOR TO AND DURING CONSTRUCTION.
- THE ELECTRICAL CONTRACTOR SHALL REFER TO THE ARCHITECTURAL DRAWINGS FOR ALL MOUNTING HEIGHTS AND FINISHES OF DEVICES AND FIXTURES.
- REFER TO SHEET E1.21 FOR LIGHT FIXTURE SCHEDULES.
- THE CONTRACTOR SHALL CONSULT THE ARCHITECT AND/OR INTERIOR DESIGNER FOR THE EXACT LOCATION OF ALL LIGHT FIXTURES PRIOR TO THE START OF ANY ROUGH IN WORK.
- REFER TO AVAILABLE ARCHITECTURAL AND/OR INTERIOR DESIGN DOCUMENTS & DRAWINGS FOR ADDITIONAL INFORMATION.
- EXTERIOR LIGHTING TO BE CONSTANT "ON" AND PROVIDED WITH PHOTOCELL, EITHER INTEGRAL OR REMOTE) FOR DUSK-TILL-DAWN OPERATION.
- ALL EXTERIOR BUILDING LIGHTS ON HOUSE POWER SHALL BE CONSIDERED EGRESS LIGHTING. FIXTURES ARE TO BE EQUIPPED WITH BATTERY BACK-UP (EITHER INTEGRAL OR REMOTE).
- REFER TO SHEET E1.14 FOR TYPICAL UNIT LOAD CENTER DIRECTORIES.
- ALL LIGHT SWITCHES SHALL BE ROCKER STYLE, SUCH AS LEVITON DECORA, OR APPROVED EQUAL.
- REFER TO ARCHITECTURAL REFLECTED CEILING PLANS FOR EXACT FIXTURE LOCATIONS (DIMENSIONS). CONSULT INTERIOR DESIGNER FOR MOUNTING HEIGHTS NOT SPECIFIED.


KEYED LIGHTING NOTES:


- REFER TO TYPICAL BATHROOM SWITCHING DETAILS ON SHEET E1.21.
- PROVIDE CEILING FAN CONTROL SWITCH(ES) AS DIRECTED BY MANUFACTURER.
- PROVIDE BLOCKING AT CEILING TO SUPPORT 35LB., MINIMUM, FOR CEILING FAN INSTALLATION.
- PROVIDE WIRE CONNECTION FOR THERMOSTAT(S). COORDINATE WITH MECHANICAL INSTALLER FOR EXACT LOCATION AND POWER REQUIREMENTS PRIOR TO ROUGH IN. CEILING HEATER TO BE TIED INTO BATHROOM POWER CIRCUIT.
- COORDINATE LOCATION OF POWER CONNECTION FOR FIRE ALARM DEVICES WITH THE SYSTEM CONTRACTOR/INSTALLER.
- TO SWITCHED RECEPTACLE. REFER TO POWER PLANS (E3 SERIES SHEETS) FOR OUTLET LOCATION.

E3.01



1. PROVIDE WIRE CONNECTION FOR THERMOSTAT(S). COORDINATE WITH MECHANICAL INSTALLER FOR EXACT LOCATION AND POWER REQUIREMENTS PRIOR TO ROUGH IN.
2. PROVIDE ONE 20A, 120V, 1P GFCI DUPLEX RECEPTACLE UNDER KITCHEN SINK FOR DISPOSAL POWER CONNECTION.
3. REFER TO DETAIL 1/E1.13 FOR TYPICAL LAUNDRY ALCOVE RECEPTACLE LOCATIONS. COORDINATE INSTALLATION WITH MECHANICAL & PLUMBING CONTRACTOR.
4. PROVIDE ONE 15A, RECEPTACLE CIRCUIT FROM TENANT LOAD CENTER FOR TELECOM SMART PANEL. COORDINATE WORK WITH SERVICE PROVIDER FOR EXACT LOCATION AND FINAL CONNECTION.
5. CONTRACTOR TO VERIFY POWER CONNECTION TYPE FOR THE HOOD/MICROWAVE PRIOR TO ROUGH IN. PROVIDE ONE 20A, 120V, 1P GFCI RECEPTACLE LOCATED INSIDE THE CABINET OVER THE RANGE FOR APPLIANCES SUPPLIED WITH CORD & PLUG SET. HOOD/MICROWAVES THAT ARE TO BE HARDWIRED, SHALL BE PROVIDED WITH THE DEDICATED CIRCUIT GOING TO A J-BOX WHICH IS TO BE MOUNTED DIRECTLY BEHIND THE APPLIANCE.
6. METER LOCATION PER UTILITY PROVIDER'S APPROVAL (PENDING). REFER TO ONE-LINE DIAGRAM ON SHEET E1.11: PROVIDE NEMA 3R LOCKING CABINET FOR HOUSE PANEL "HP". REFER TO SHEET E1.01 FOR METER & PANEL LOCATION(S) AT EACH BUILDING.
7. 15A SWITCHED SPLIT DUPLEX RECEPTACLE. REFER TO LIGHTING PLANS (E2 SERIES SHEETS) FOR SWITCH LOCATION.

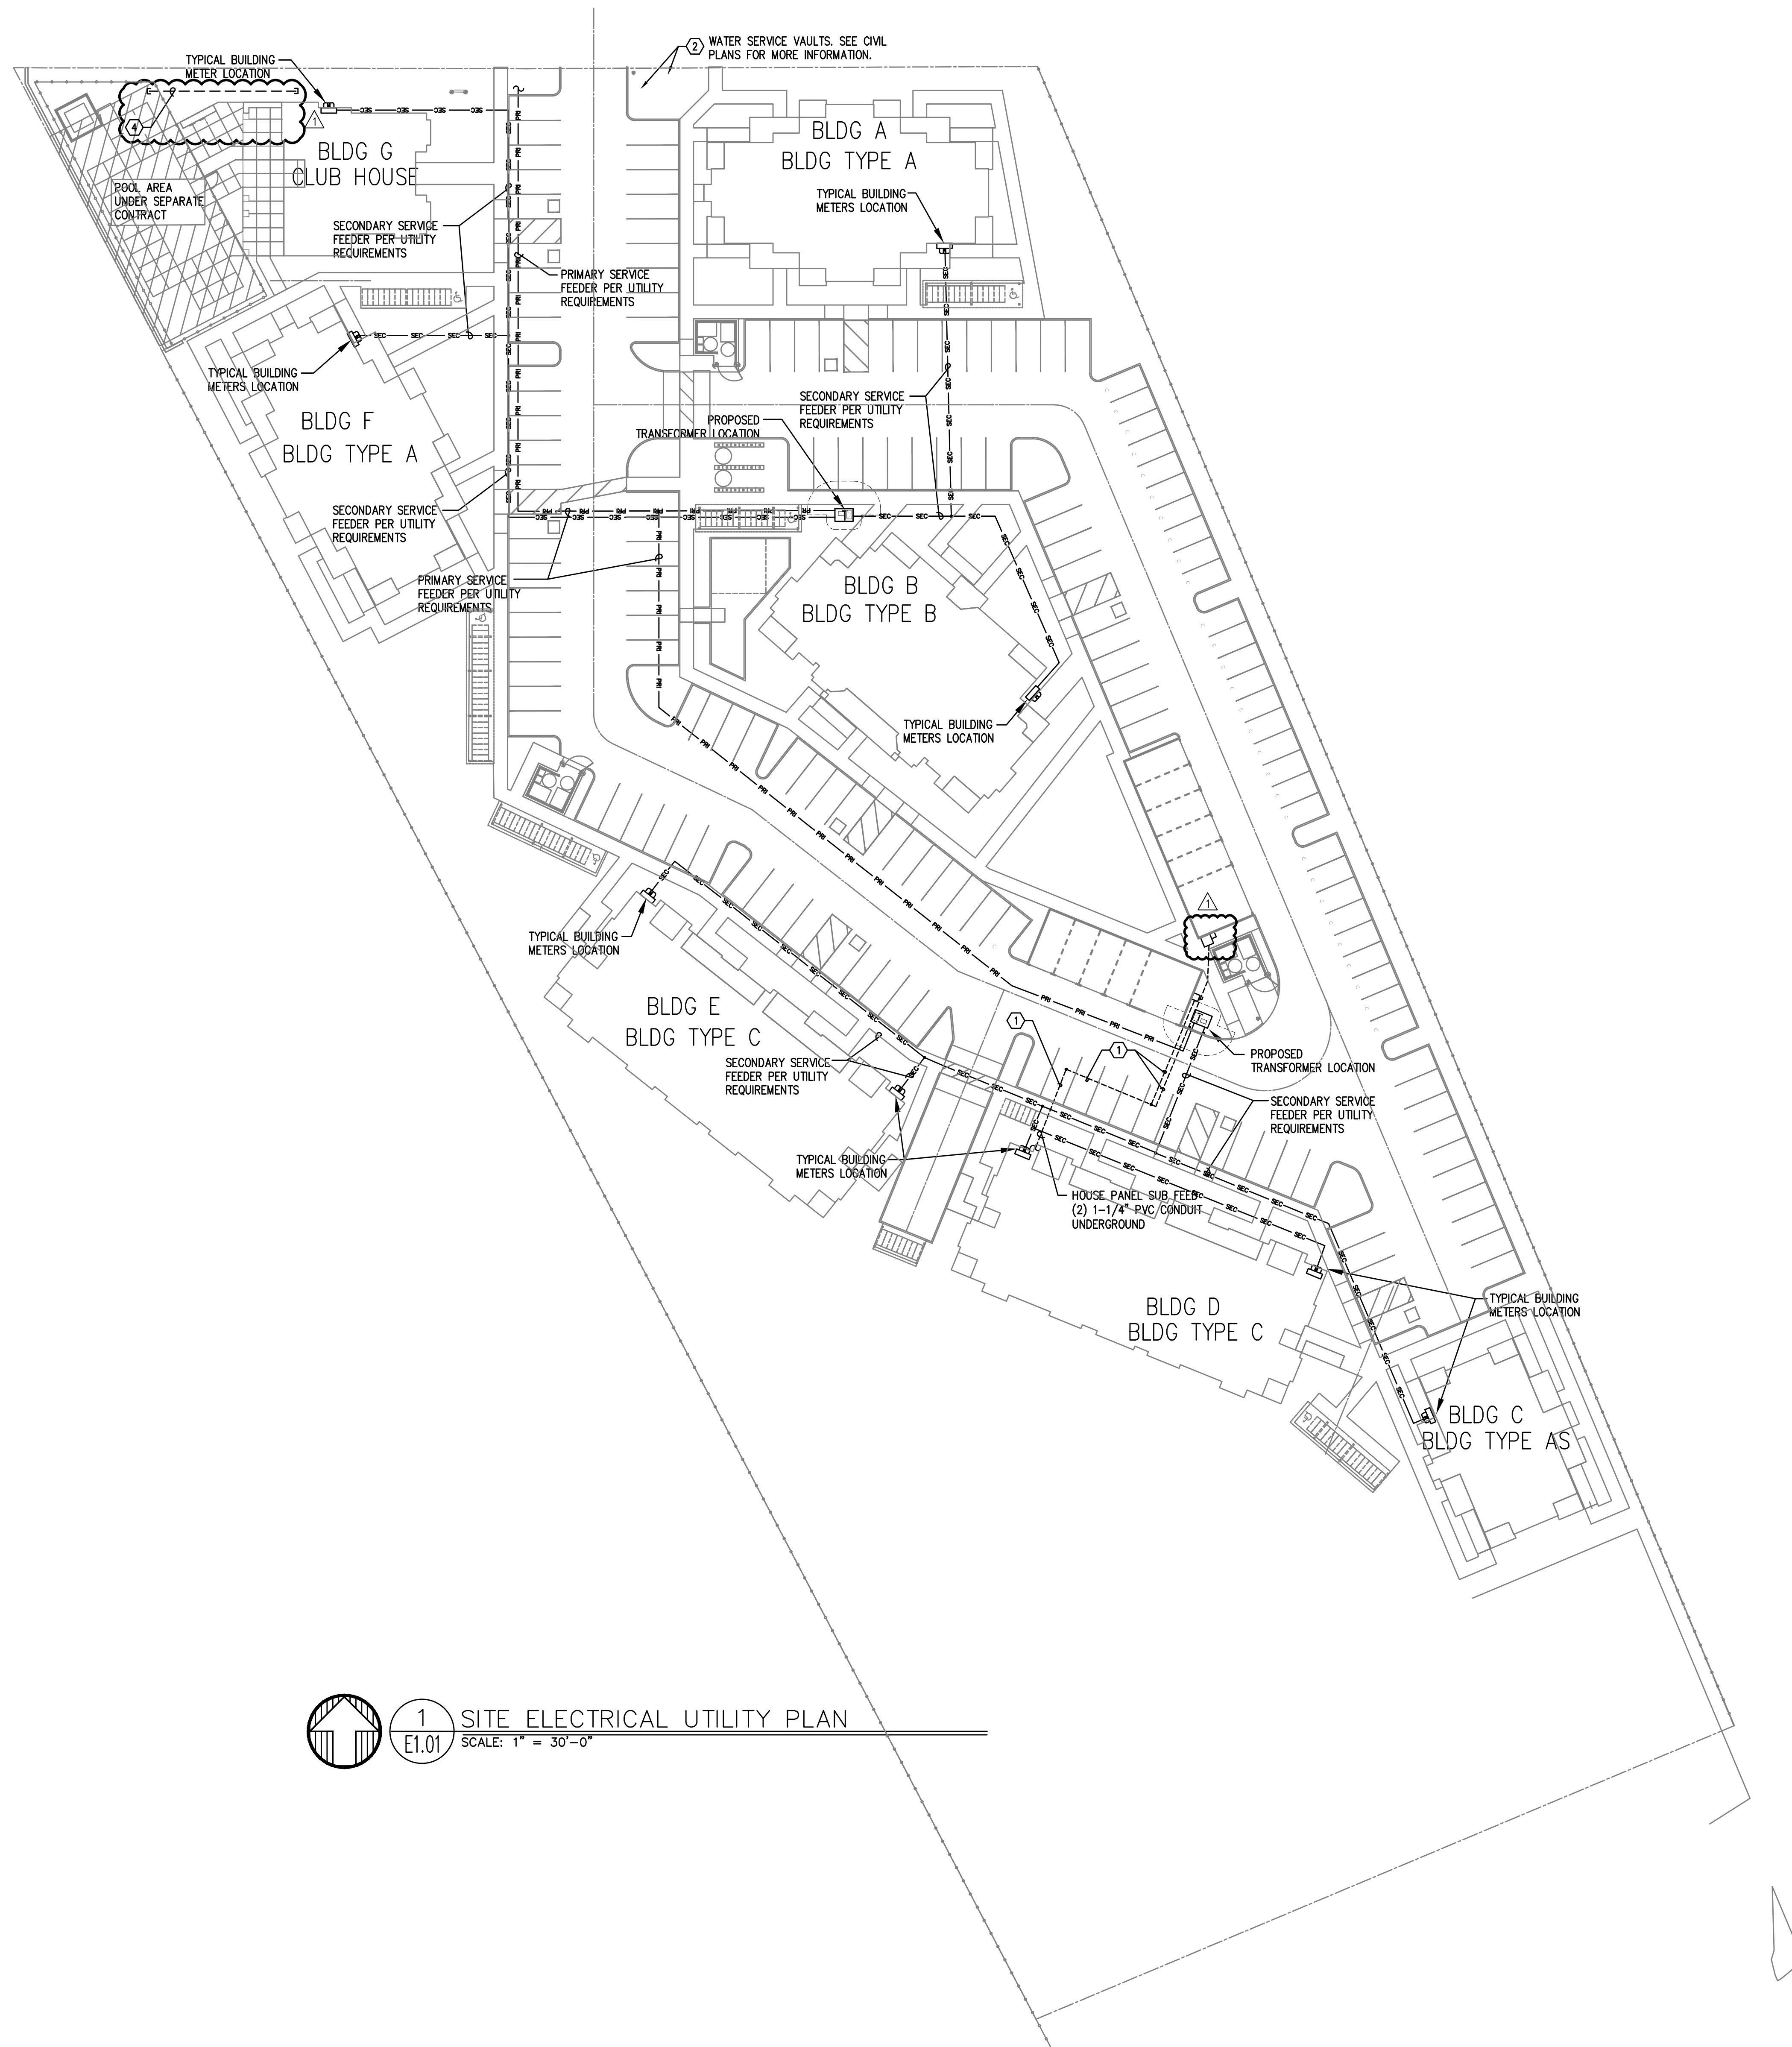

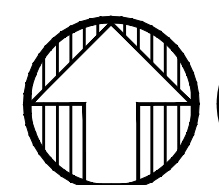 1 SITE ELECTRICAL UTILITY PLAN
E1.01 SCALE: 1" = 30'-0"

GENERAL NOTES:

- ALL WORK SHALL BE PERFORMED IN ACCORDANCE WITH ALL APPLICABLE LOCAL, STATE AND NATIONAL CODES.
- ELECTRICAL PLANS ARE DIAGRAMMATIC AND MAY OR MAY NOT REFLECT ACTUAL FIELD CONDITIONS.
- REFER TO LIGHTING PLANS FOR BUILDING MOUNTED LIGHT FIXTURE LOCATIONS.
- COORDINATE WITH LOCAL UTILITY PROVIDER FOR EXACT SERVICE CONDUIT AND CONDUCTORS REQUIREMENTS.
- ALL UTILITY WORK SHALL BE DONE IN ACCORDANCE WITH CLARK PUBLIC UTILITIES ELECTRICAL SERVICE REQUIREMENTS.
- U.G. PRIMARY FEEDER SHALL HAVE A MINIMUM 48 INCH BURY.
- U.G. SECONDARY FEEDER SHALL HAVE A MINIMUM 36 INCH BURY.
- REFER TO SHEET E1.11 FOR ONE-LINE DIAGRAM, LOAD SUMMARY INFORMATION AND TYPICAL FEEDER SCHEDULE.
- SECONDARY CONDUIT SWEEPS SHALL BE MINIMUM 60 INCH RADIUS WITH A MINIMUM OF 7'-0" STRAIGHT CONDUIT RUN BETWEEN SWEEPS.
- CONTRACTOR SHALL REVIEW THE UTILITY PROVIDER'S ELECTRICAL SERVICE REQUIREMENTS PRIOR TO THE START OF ANY WORK.
- LOCATION AND INSTALLATION OF THE PRIMARY AND SECONDARY CONDUITS, TRANSFORMER, ETC. SHALL BE PROVIDED PER UTILITY PROVIDER'S ELECTRICAL SERVICE REQUIREMENTS.
- CONTRACTOR SHALL REVIEW ALL PROJECT DOCUMENTS AND SPECIFICATIONS IN DETAIL AND REFER TO THE DOCUMENTS THROUGHOUT THE CONSTRUCTION.
- CONTRACTOR SHALL CONSULT WITH THE CIVIL ENGINEER TO IDENTIFY ALL EXISTING UNDERGROUND UTILITIES PRIOR TO ANY TRENCHING.
- TRENCHING AND UNDERGROUND UTILITY CONDUIT RUNS SHALL BE PERFORMED IN COORDINATION WITH THE CIVIL PLANS.

KEYED POWER NOTES:

- 1" PVC CONDUIT ROUTED UNDER GROUND FROM HOUSE PANEL TO BUILDING DISCONNECT SWITCH. REFER TO PANEL SCHEDULES ON SHEET E1.11 FOR ADDITIONAL INFORMATION.
- PROVE WEATHER PROOF GFCI 20A 120V DUPLEX RECEPTACLES AT WATER VAULT(S) AS DIRECTED BE CIVIL ENGINEER. ROUTE EACH CIRCUIT IN 3/4" PVC CONDUIT UNDER GROUND FROM THE BUILDING #6 HOUSE PANEL.
- PROVIDE ONE EMPTY 1-1/2" PVC CONDUIT WITH PULL STRING FOR FUTURE POOL BRANCH PANEL, ROUTED FROM HOUSE PANEL LOCATION TO FUTURE POOL HOUSE AND CAP AT BOTH END.

UTILITY REQUIREMENTS

- CUSTOMER TO PROVIDE ALL TRENCHING AND BACKFILLING. TRENCH TO BE 36 INCHES DEEP AND 30 INCHES WIDE, MEASURED FROM FINAL GRADE.
- ALL UTILITY CONDUCTORS TO BE INSTALLED IN GRAY SCHEDULE 40, ELECTRICAL GRADE, PVC CONDUIT WITH NYLON PULL STRINGS (MIN 500 LBS. TEST). CLARK PUBLIC UTILITIES TO DETERMINE THE SIZE AND NUMBER OF CONDUITS REQUIRED. ALL ELBOWS TO BE 36 INCH (MIN) RADIUS. ALL BENDS MAY BE FACTORY MADE. IF MORE THAN 270 DEGREES OF BENDS OR IF RUN IS LONGER THAN 150 FEET, BENDS MUST BE RIGID STEEL.
- CONSULT WITH UTILITY REPRESENTATIVE 2 WEEKS BEFORE STARTING MAIN POWER TRENCHING FOR A PRE-CONSTRUCTION CONFERENCE. INCLUDED IN THIS CONFERENCE WILL BE EXCAVATOR, CPU, TELCO, CATV, AND GAS.



IN THE EVENT CONFLICTS ARE DISCOVERED
BETWEEN THE ORIGINAL SIGNED AND SEALED
DOCUMENTS PREPARED BY THE ARCHITECTS
AND/OR THEIR CONSULTANTS, AND ANY COPY OF
THE DOCUMENTS TRANSMITTED BY EMAIL, FAX,
ELECTRONICALLY OR OTHERWISE, THE ORIGINAL
SIGNED AND SEALED DOCUMENTS SHALL GOVERN.

PROJECT # 2019-179
DATE: 28 AUGUST 2020


REVISIONS

PLAN REVIEW 11.03.2020

MCKINNEY LANE APARTMENTS PHASE II
RUSSELL DRIVE & MCKINNEY LANE
LEBANON, OREGON

B

E3.02

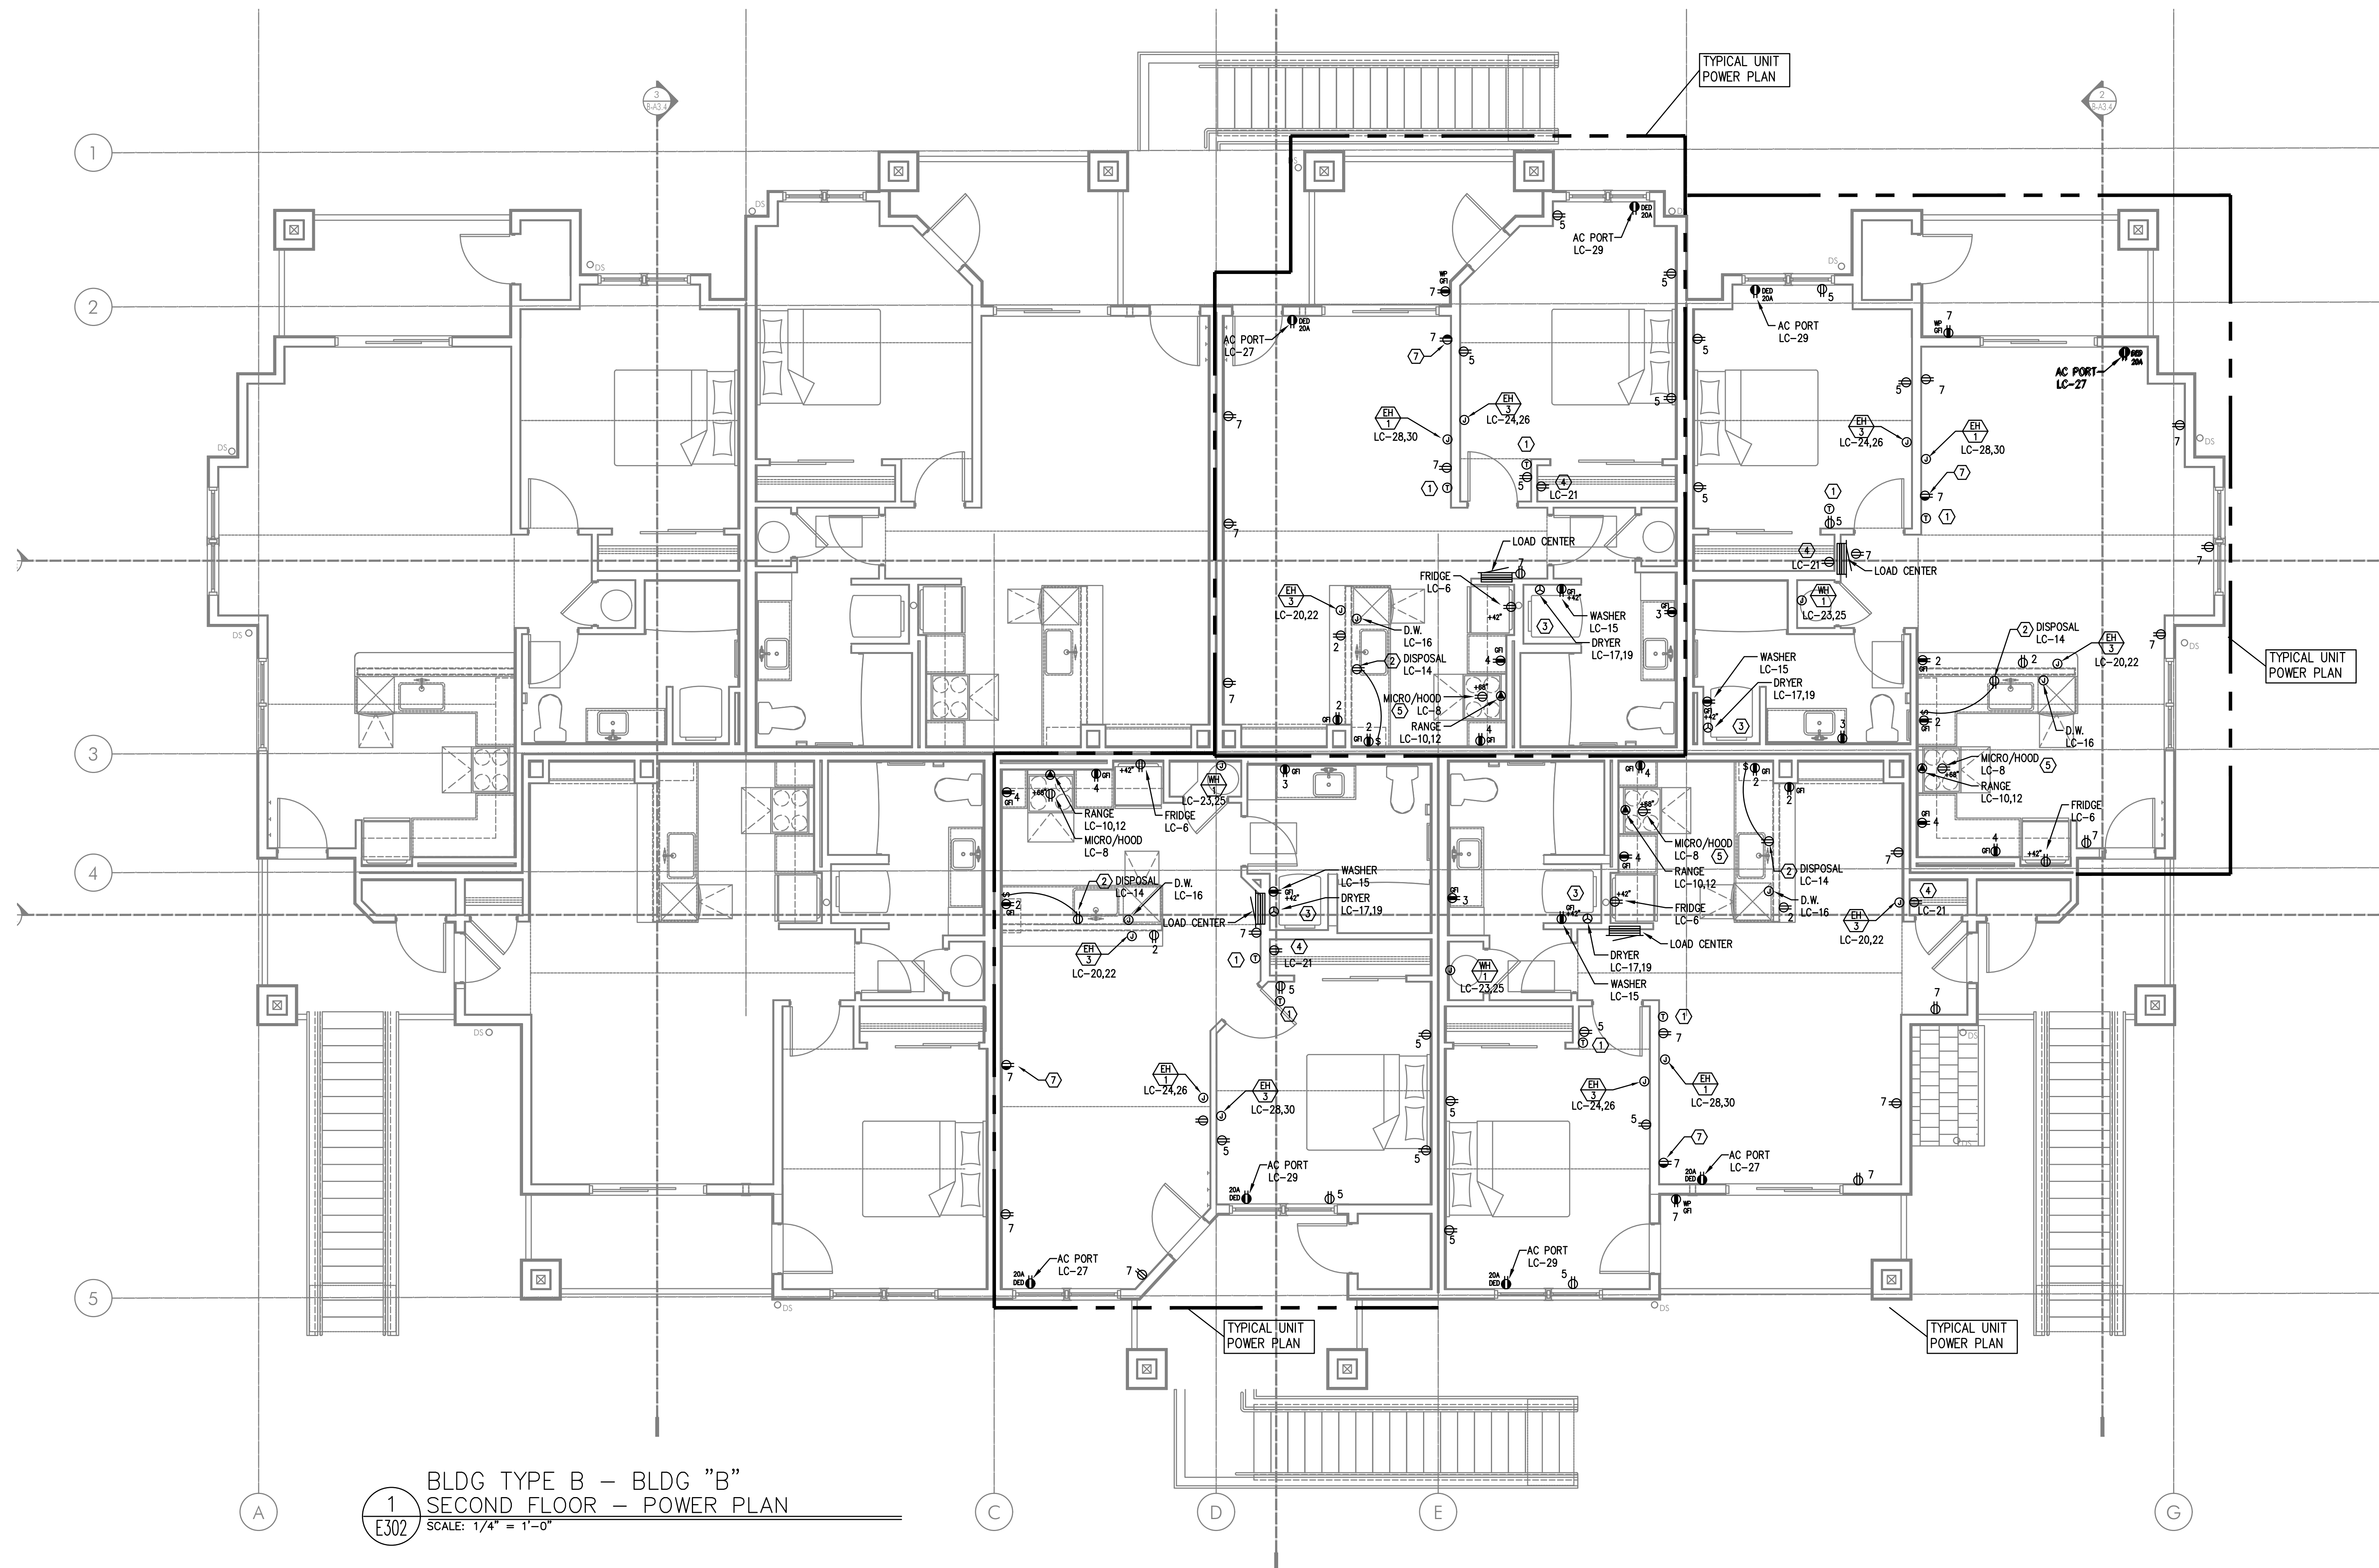


BLDG TYPE B – BLDG "B"
SECOND FLOOR – POWER PLAN
SCALE: 1/4" = 1'-0"

GENERAL POWER NOTES:

- A. ALL PLANS ARE CONSIDERED DIAGRAMMATICAL. THEREFORE ALL EQUIPMENT SIZES AND DEVICE LOCATIONS ARE APPROXIMATE AND SUBJECT TO FIELD CONDITIONS AND PRODUCT APPROVAL.
- B. ELECTRICAL CONTRACTOR TO PROVIDE THERMOSTATS NOT SUPPLIED BY MECHANICAL CONTRACTOR. CONSULT MECHANICAL PLANS FOR ADDITIONAL INFORMATION.
- C. ELECTRICAL CONTRACTOR SHALL PROVIDE INSTALLATION AND FINAL CONNECTION OF THERMOSTATS. CONSULT MECHANICAL CONTRACTOR FOR EXACT REQUIREMENTS PRIOR TO ROUGH IN.
- D. REFER TO INTERIOR DECORATOR AND/OR ARCHITECTURAL DRAWINGS FOR DIMENSIONED LOCATION(S) AND ELEVATIONS OF FIXTURES & DEVICES. OTHER DEVICES SHOWN ON THE ELECTRICAL PLANS AND NOT INDICATED ON THE DECORATOR'S OR ARCHITECT'S DRAWINGS, SHALL BE INSTALLED AT STANDARD MOUNTING HEIGHT AS INDICATED THE SYMBOL LIST.
- E. BUILDING ELECTRICAL EQUIPMENT SHOWN IS APPROXIMATE, BASED ON INDUSTRY STANDARD PRODUCTS. CONTRACTOR SHALL VERIFY ANY SUBMITTED EQUIPMENT WILL FIT WITHIN THE SPACE PROVIDED, PRIOR TO PRODUCT SUBMITTAL REVIEW.
- F. ELECTRICAL CONTRACTOR SHALL COORDINATE WITH THE LOW VOLTAGE ('T' SERIES) PLANS, INCLUDING FIRE ALARM AND SYSTEMS INSTALLER, AND PROVIDE ROUGH IN AS NEEDED.

KEYED POWER NOTES:

1. PROVIDE WIRE CONNECTION FOR THERMOSTAT(S). COORDINATE WITH MECHANICAL INSTALLER FOR EXACT LOCATION AND POWER REQUIREMENTS PRIOR TO ROUGH IN.
2. PROVIDE ONE 20A, 120V, 1P GFCI DUPLEX RECEPTACLE UNDER KITCHEN SINK FOR DISPOSAL POWER CONNECTION.
3. REFER TO DETAIL 1/E1.13 FOR TYPICAL LAUNDRY ALCOVE RECEPTACLE LOCATIONS. COORDINATE INSTALLATION WITH MECHANICAL & PLUMBING CONTRACTOR.
4. PROVIDE ONE 15A RECEPTACLE CIRCUIT FROM TENANT LOAD CENTER FOR TELECOM SMART PANEL. COORDINATE WORK WITH SERVICE PROVIDER FOR EXACT LOCATION AND FINAL CONNECTION.
5. CONTRACTOR TO VERIFY POWER CONNECTION TYPE FOR THE HOOD/MICROWAVE PRIOR TO ROUGH IN. PROVIDE ONE DEDICATED 20A, 1P DUPLEX RECEPTACLE LOCATED INSIDE THE CABINET OVER THE RANGE FOR APPLIANCES SUPPLIED WITH CORD & PLUG SET. HOOD/MICROWAVES THAT ARE TO BE HARDWIRED, SHALL BE PROVIDED WITH THE DEDICATED CIRCUIT GOING TO A J-BOX WHICH IS TO BE MOUNTED DIRECTLY BEHIND THE APPLIANCE.
6. METER LOCATION PER UTILITY PROVIDER'S APPROVAL (PENDING). REFER TO ONE-LINE DIAGRAM ON SHEET E1.11. PROVIDE NEMA 3R LOCKING CABINET FOR HOUSE PANEL 'HP'. REFER TO SHEET E1.01 FOR METER & PANEL LOCATION(S) AT EACH BUILDING.
7. 15A SWITCHED SPLIT DUPLEX RECEPTACLE. REFER TO LIGHTING PLANS (E2 SERIES SHEETS) FOR SWITCH LOCATION.

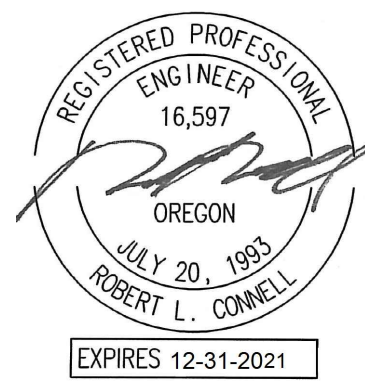


IN THE EVENT CONFLICTS ARE DISCOVERED BETWEEN THE ORIGINAL SIGNED AND SEALED DOCUMENTS PREPARED BY THE ARCHITECT AND/OR THEIR CONSULTANTS, AND ANY COPY OF THE DOCUMENTS TRANSMITTED BY EMAIL, FAX, ELECTRONICALLY OR OTHERWISE, THE ORIGINAL SIGNED AND SEALED DOCUMENTS SHALL GOVERN.

PROJECT # 2019-179
DATE: 28 AUGUST 2020

REVISIONS

PLAN REVIEW 11.03.2020

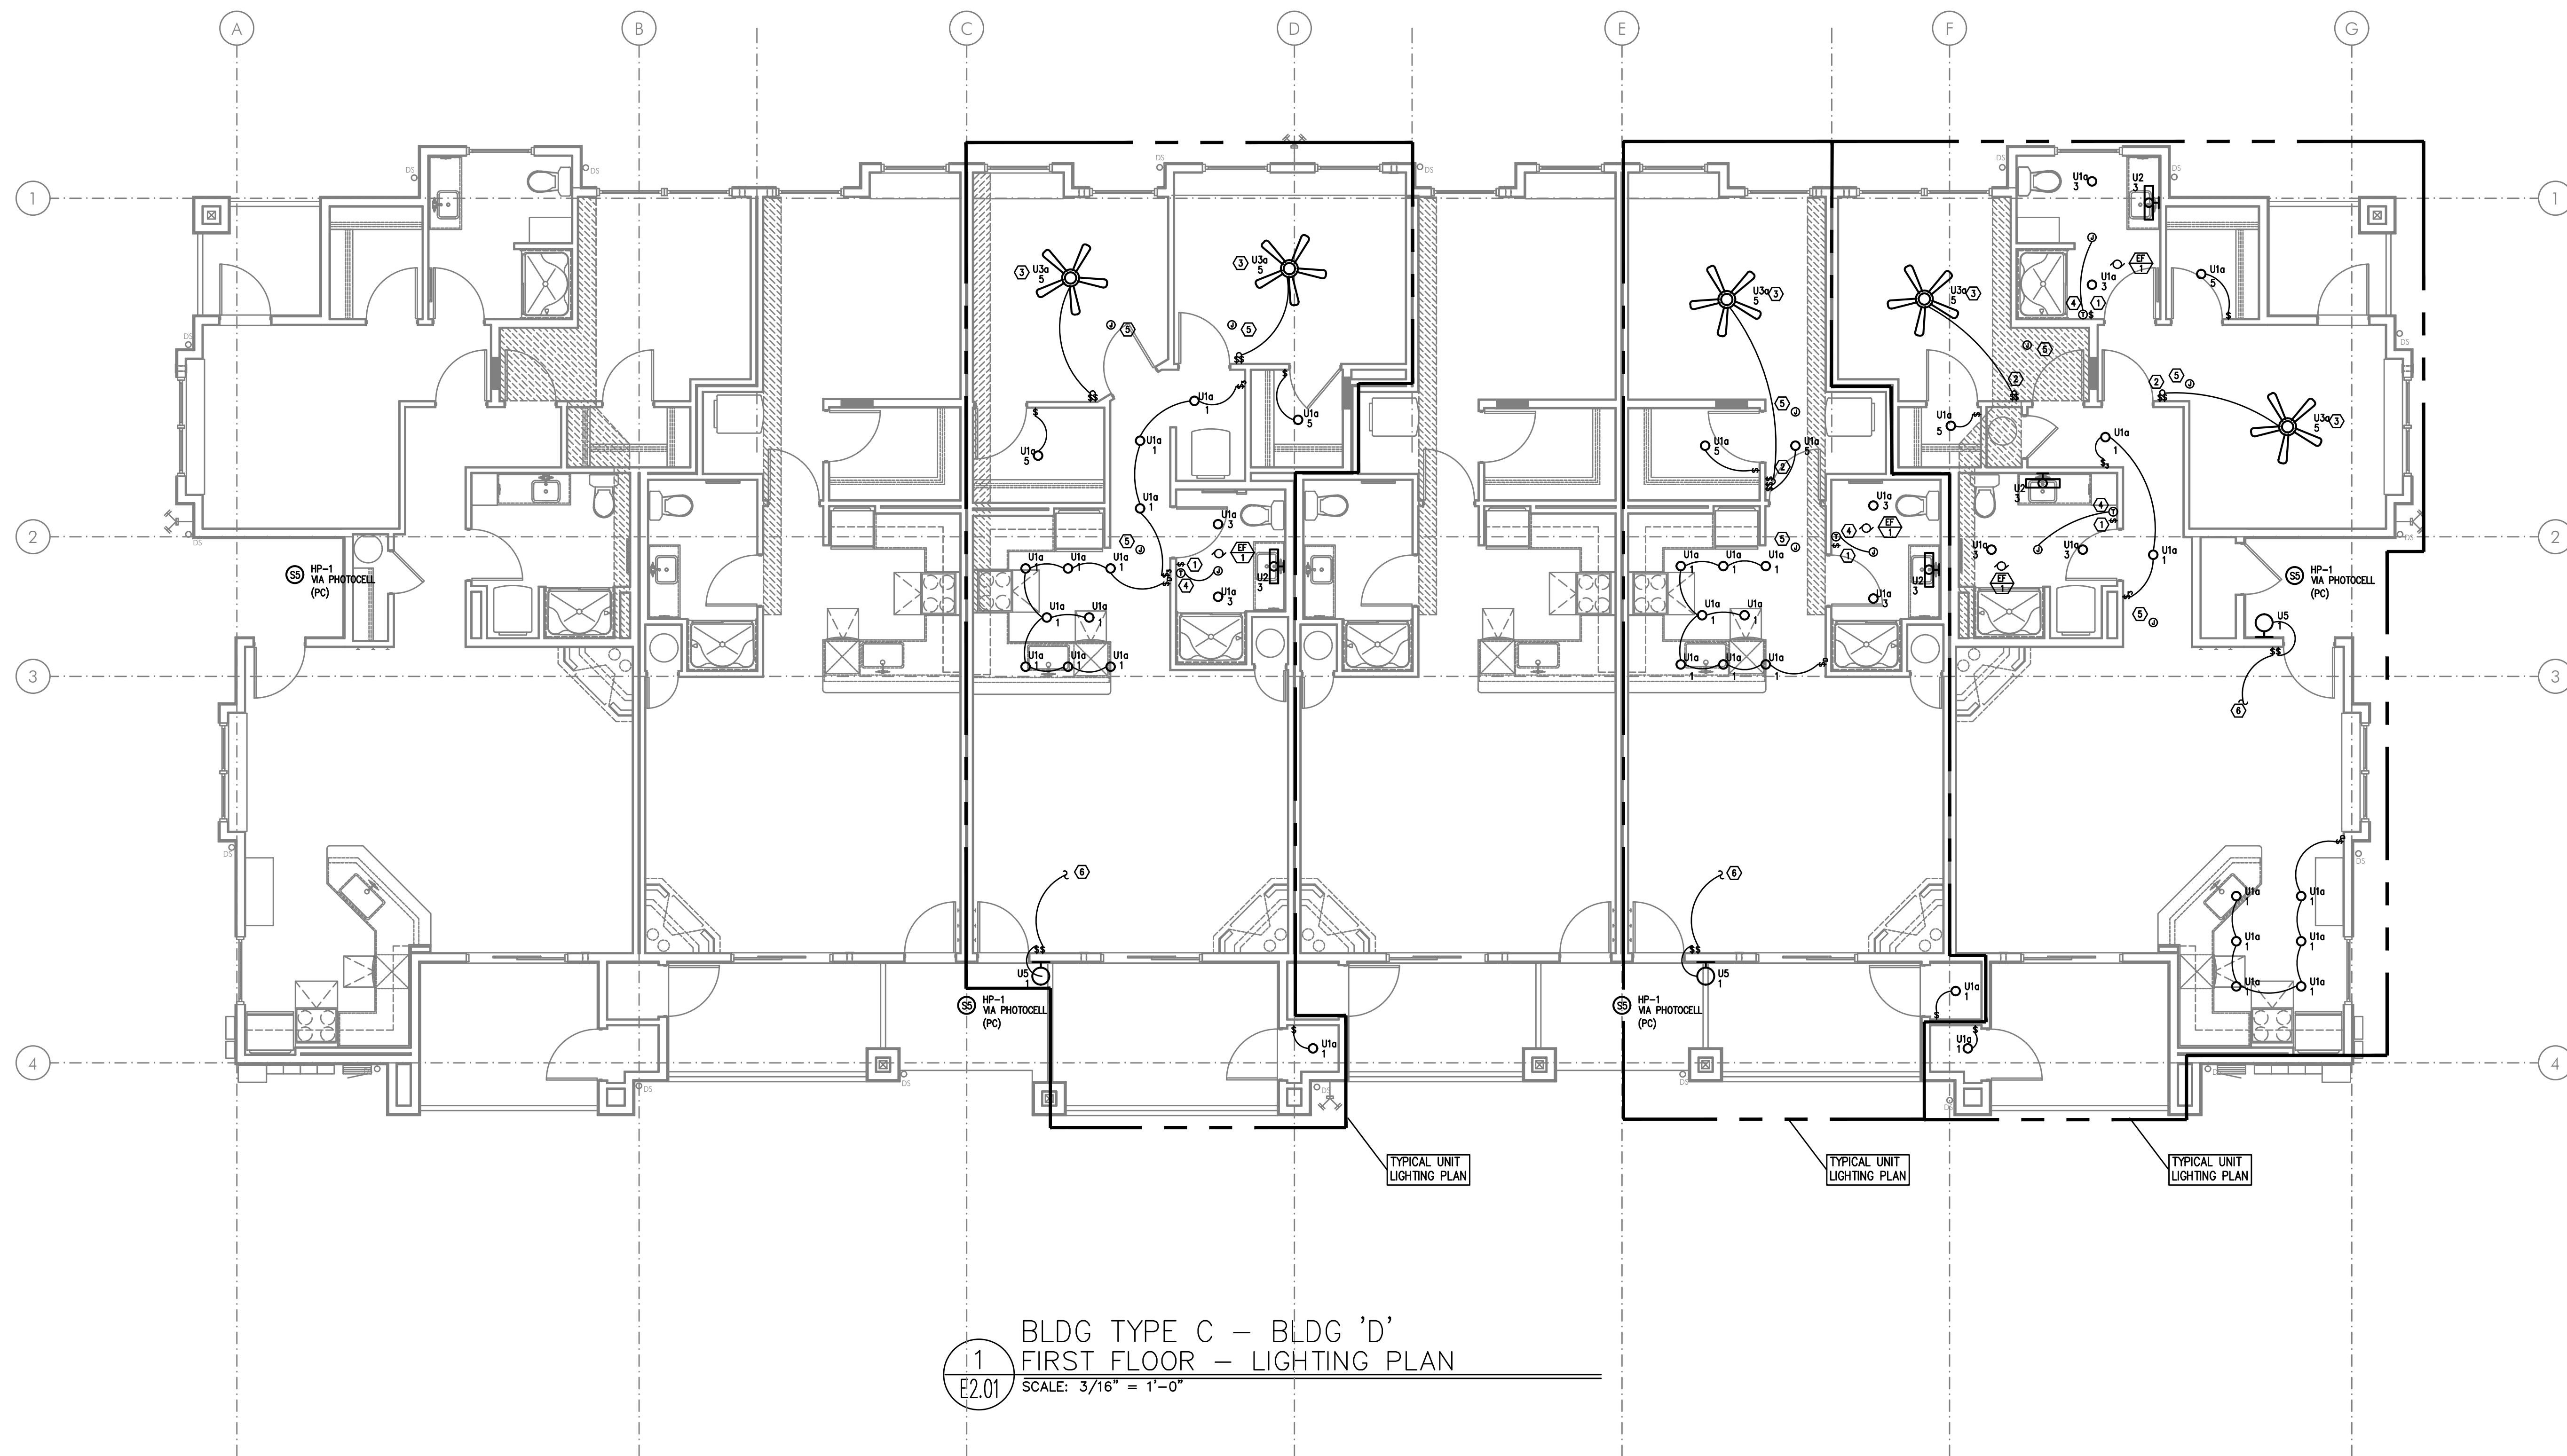


GENERAL LIGHTING NOTES:

- ELECTRICAL DRAWINGS ARE DIAGRAMMATICAL AND MAY NOT ACCURATELY REFLECT ACTUAL CONSTRUCTION CONDITIONS. THE ELECTRICAL CONTRACTOR SHALL BE RESPONSIBLE FOR COORDINATING THE INSTALLATION OF ALL ELECTRICAL EQUIPMENT, WITH ALL TRADES PRIOR TO AND DURING CONSTRUCTION.
- THE ELECTRICAL CONTRACTOR SHALL REFER TO THE ARCHITECTURAL DRAWINGS FOR ALL MOUNTING HEIGHTS AND FINISHES OF DEVICES AND FIXTURES.
- REFER TO SHEET E1.21 FOR LIGHT FIXTURE SCHEDULES.
- THE CONTRACTOR SHALL CONSULT THE ARCHITECT AND/OR INTERIOR DESIGNER FOR THE EXACT LOCATION OF ALL LIGHT FIXTURES PRIOR TO THE START OF ANY ROUGH IN WORK.
- REFER TO AVAILABLE ARCHITECTURAL AND/OR INTERIOR DESIGN DOCUMENTS & DRAWINGS FOR ADDITIONAL INFORMATION.
- EXTERIOR LIGHTING TO BE CONSTANT "ON" AND PROVIDED WITH PHOTOCELL, EITHER INTEGRAL OR REMOTE) FOR DUSK-TILL-DAWN OPERATION.
- ALL EXTERIOR BUILDING LIGHTS ON HOUSE POWER SHALL BE CONSIDERED EGRESS LIGHTING. FIXTURES ARE TO BE EQUIPPED WITH BATTERY BACK-UP (EITHER INTEGRAL OR REMOTE).
- REFER TO SHEET E1.14 FOR TYPICAL UNIT LOAD CENTER DIRECTORIES.
- ALL LIGHT SWITCHES SHALL BE ROCKER STYLE, SUCH AS LEVITON DECORA, OR APPROVED EQUAL.
- REFER TO ARCHITECTURAL REFLECTED CEILING PLANS FOR EXACT FIXTURE LOCATIONS (DIMENSIONS). CONSULT INTERIOR DESIGNER FOR MOUNTING HEIGHTS NOT SPECIFIED.

KEYED LIGHTING NOTES:

- REFER TO TYPICAL BATHROOM SWITCHING DETAILS ON SHEET E1.21.
- PROVIDE CEILING FAN CONTROL SWITCH(ES) AS DIRECTED BY MANUFACTURER.
- PROVIDE BLOCKING AT CEILING TO SUPPORT 35LB., MINIMUM, FOR CEILING FAN INSTALLATION.
- PROVIDE WIRE CONNECTION FOR THERMOSTAT(S). COORDINATE WITH MECHANICAL INSTALLER FOR EXACT LOCATION AND POWER REQUIREMENTS PRIOR TO ROUGH IN. CEILING HEATER TO BE TIED INTO BATHROOM POWER CIRCUIT.
- COORDINATE LOCATION OF POWER CONNECTION FOR FIRE ALARM DEVICES WITH THE SYSTEM CONTRACTOR/INSTALLER.
- TO SWITCHED RECEPTACLE. REFER TO POWER PLANS (E3 SERIES SHEETS) FOR OUTLET LOCATION.

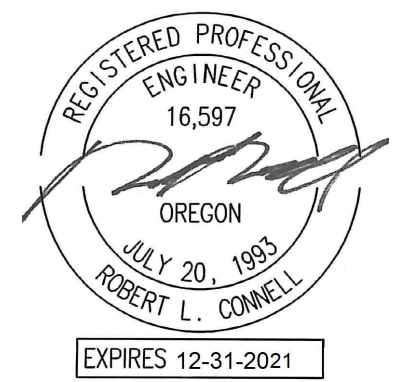

IN THE EVENT CONFLICTS ARE DISCOVERED BETWEEN THE ORIGINAL SIGNED AND SEALED DOCUMENTS PREPARED BY THE ARCHITECT AND/OR THEIR CONSULTANTS, AND ANY COPY OF THE DOCUMENTS TRANSMITTED BY EMAIL, FAX, ELECTRONICALLY OR OTHERWISE, THE ORIGINAL SIGNED AND SEALED DOCUMENTS SHALL GOVERN.


PROJECT # 2019-179
DATE: 28 AUGUST 2020

REVISIONS

PLAN REVIEW 11.03.2020

MCKINNEY LANE APARTMENTS PHASE II
RUSSELL DRIVE & MCKINNEY LANE
LEBANON, OREGON

C-D
E2.02

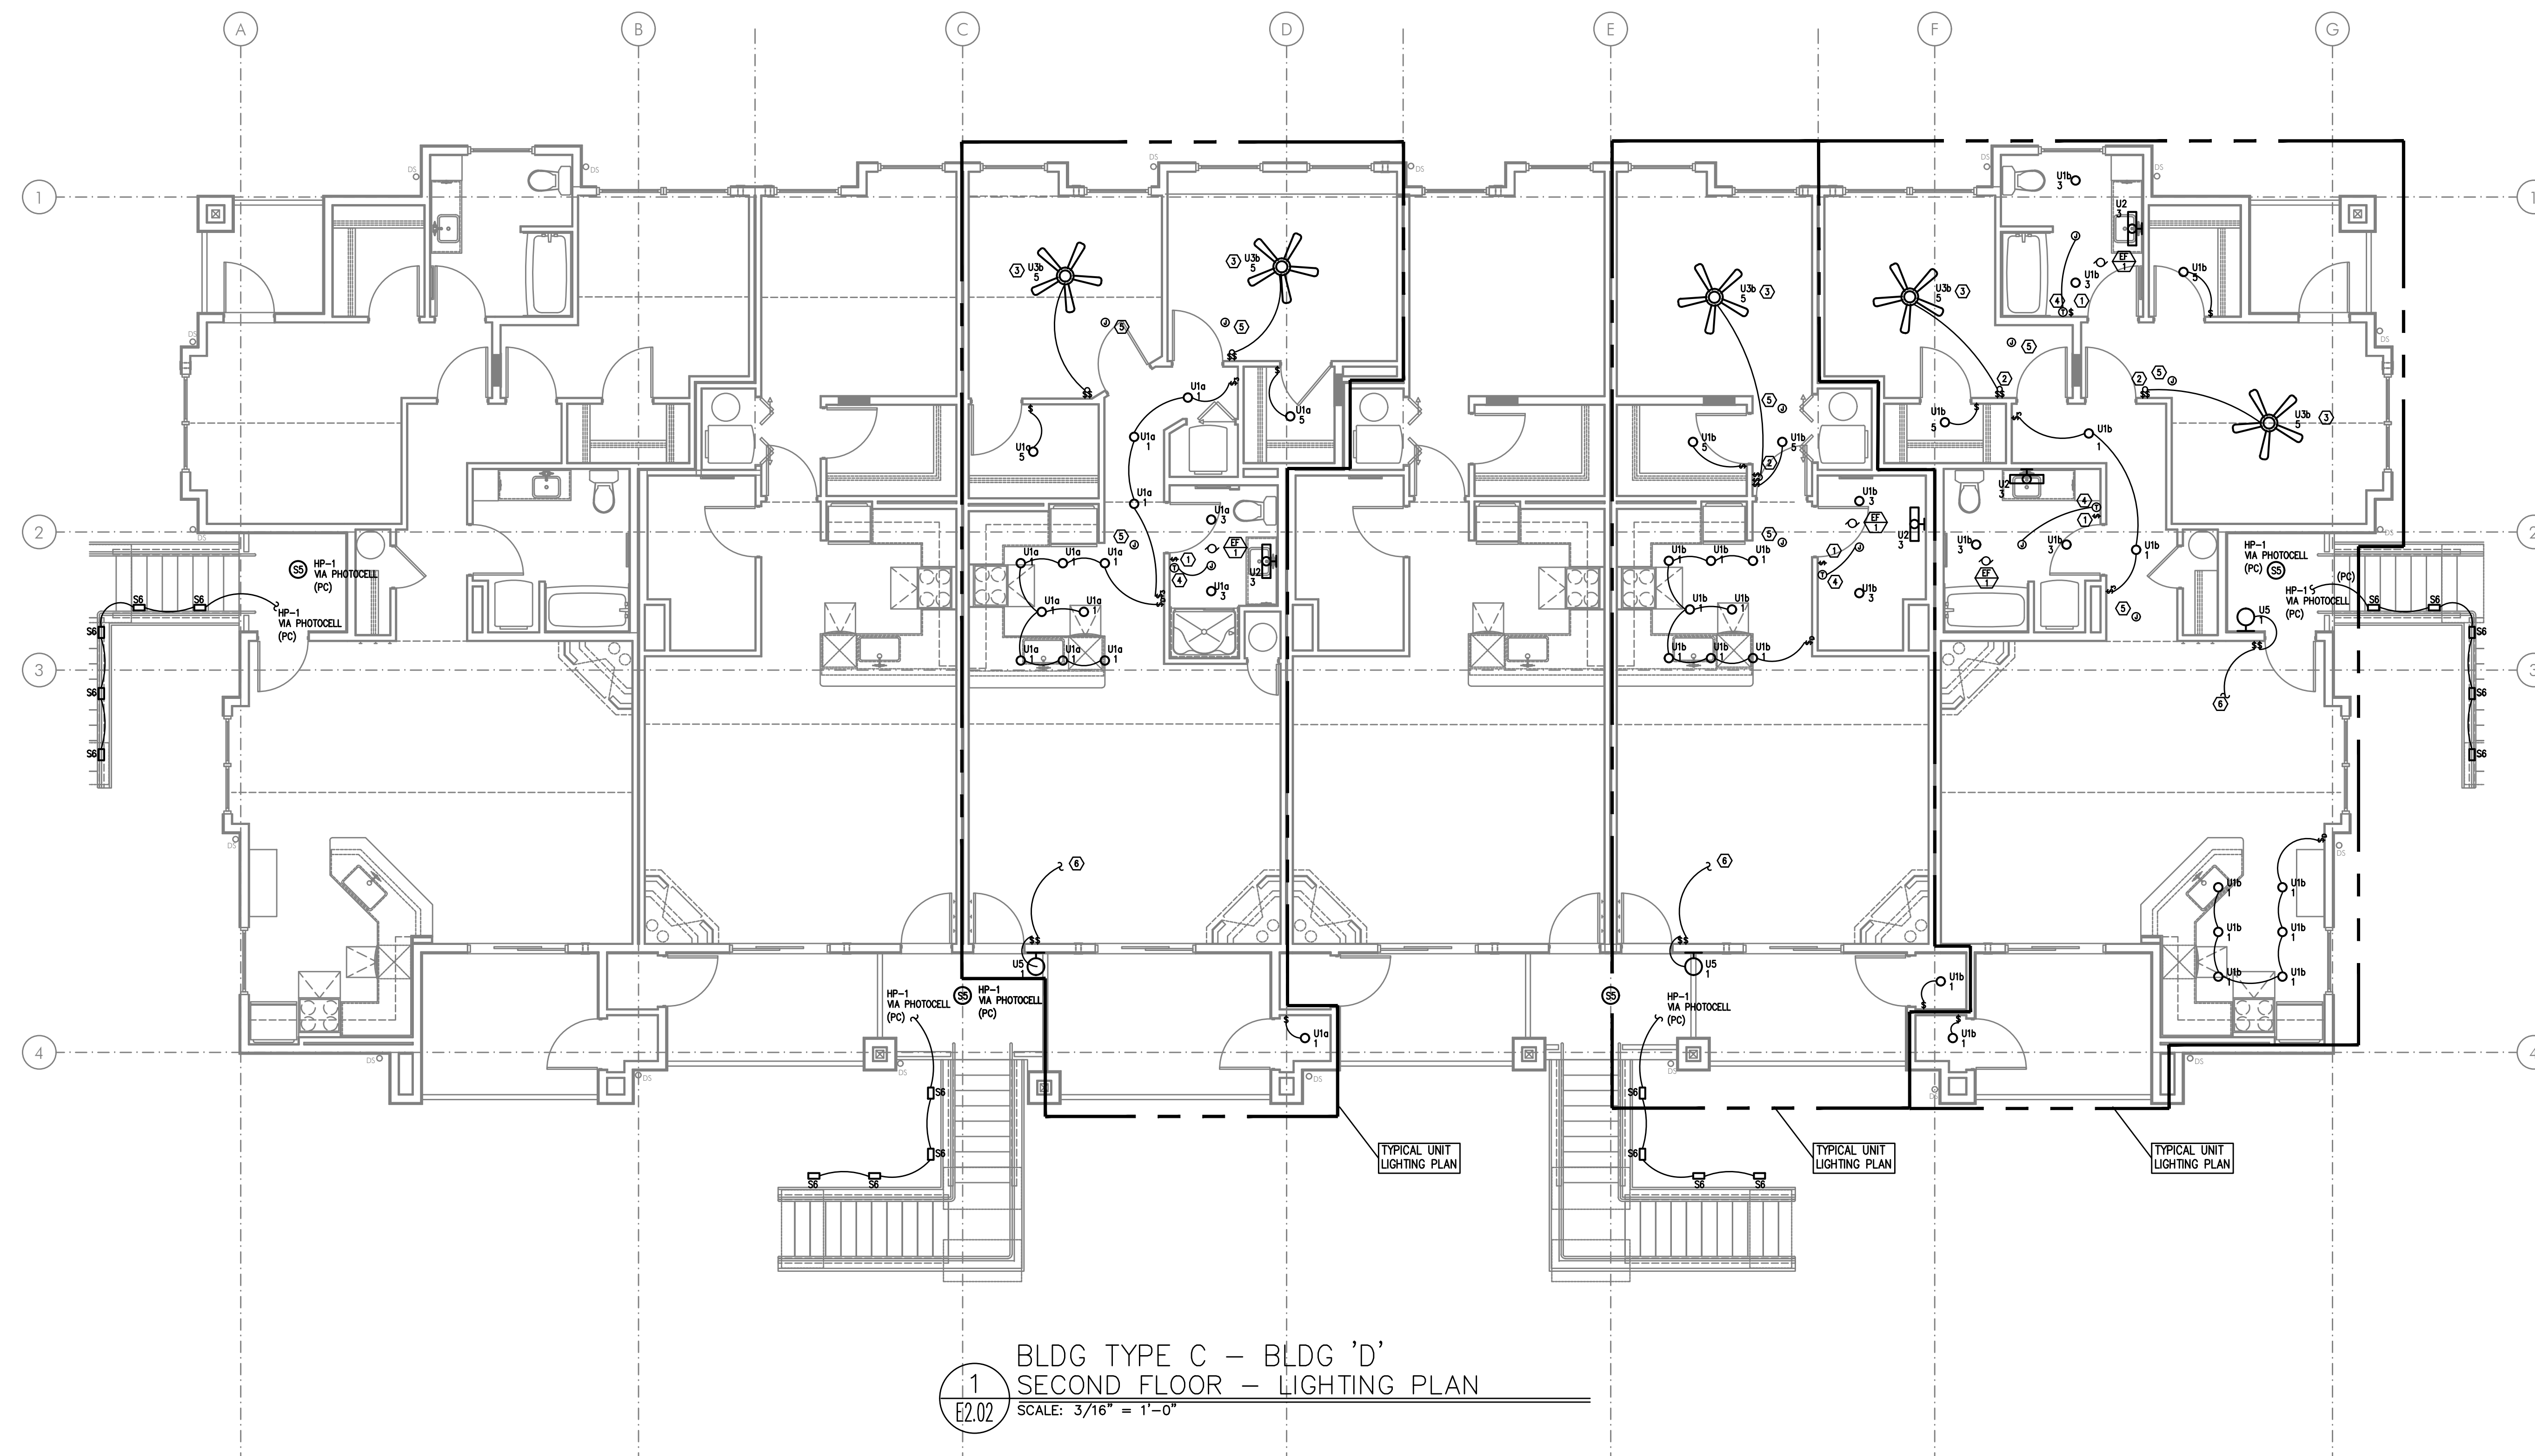


GENERAL LIGHTING NOTES:

- ELECTRICAL DRAWINGS ARE DIAGRAMMATICAL AND MAY NOT ACCURATELY REFLECT ACTUAL CONSTRUCTION CONDITIONS. THE ELECTRICAL CONTRACTOR SHALL BE RESPONSIBLE FOR COORDINATING THE INSTALLATION OF ALL ELECTRICAL EQUIPMENT, WITH ALL TRADES PRIOR TO AND DURING CONSTRUCTION.
- THE ELECTRICAL CONTRACTOR SHALL REFER TO THE ARCHITECTURAL DRAWINGS FOR ALL MOUNTING HEIGHTS AND FINISHES OF DEVICES AND FIXTURES.
- REFER TO SHEET E1.21 FOR LIGHT FIXTURE SCHEDULES.
- THE CONTRACTOR SHALL CONSULT THE ARCHITECT AND/OR INTERIOR DESIGNER FOR THE EXACT LOCATION OF ALL LIGHT FIXTURES PRIOR TO THE START OF ANY ROUGH IN WORK.
- REFER TO AVAILABLE ARCHITECTURAL AND/OR INTERIOR DESIGN DOCUMENTS & DRAWINGS FOR ADDITIONAL INFORMATION.
- EXTERIOR LIGHTING TO BE CONSTANT "ON" AND PROVIDED WITH PHOTOCELL, EITHER INTEGRAL OR REMOTE) FOR DUSK-TILL-DAWN OPERATION.
- ALL EXTERIOR BUILDING LIGHTS ON HOUSE POWER SHALL BE CONSIDERED EGRESS LIGHTING. FIXTURES ARE TO BE EQUIPPED WITH BATTERY BACK-UP (EITHER INTEGRAL OR REMOTE).
- REFER TO SHEET E1.14 FOR TYPICAL UNIT LOAD CENTER DIRECTORIES.
- ALL LIGHT SWITCHES SHALL BE ROCKER STYLE, SUCH AS LEVITON DECORA, OR APPROVED EQUAL.
- REFER TO ARCHITECTURAL REFLECTED CEILING PLANS FOR EXACT FIXTURE LOCATIONS (DIMENSIONS). CONSULT INTERIOR DESIGNER FOR MOUNTING HEIGHTS NOT SPECIFIED.

KEYED LIGHTING NOTES:

- REFER TO TYPICAL BATHROOM SWITCHING DETAILS ON SHEET E1.21.
- PROVIDE CEILING FAN CONTROL SWITCH(ES) AS DIRECTED BY MANUFACTURER.
- PROVIDE BLOCKING AT CEILING TO SUPPORT 35LB., MINIMUM, FOR CEILING FAN INSTALLATION.
- PROVIDE WIRE CONNECTION FOR THERMOSTAT(S). COORDINATE WITH MECHANICAL INSTALLER FOR EXACT LOCATION AND POWER REQUIREMENTS PRIOR TO ROUGH IN. CEILING HEATER TO BE TIED INTO BATHROOM POWER CIRCUIT.
- COORDINATE LOCATION OF POWER CONNECTION FOR FIRE ALARM DEVICES WITH THE SYSTEM CONTRACTOR/INSTALLER.
- TO SWITCHED RECEPTACLE. REFER TO POWER PLANS (E3 SERIES SHEETS) FOR OUTLET LOCATION.

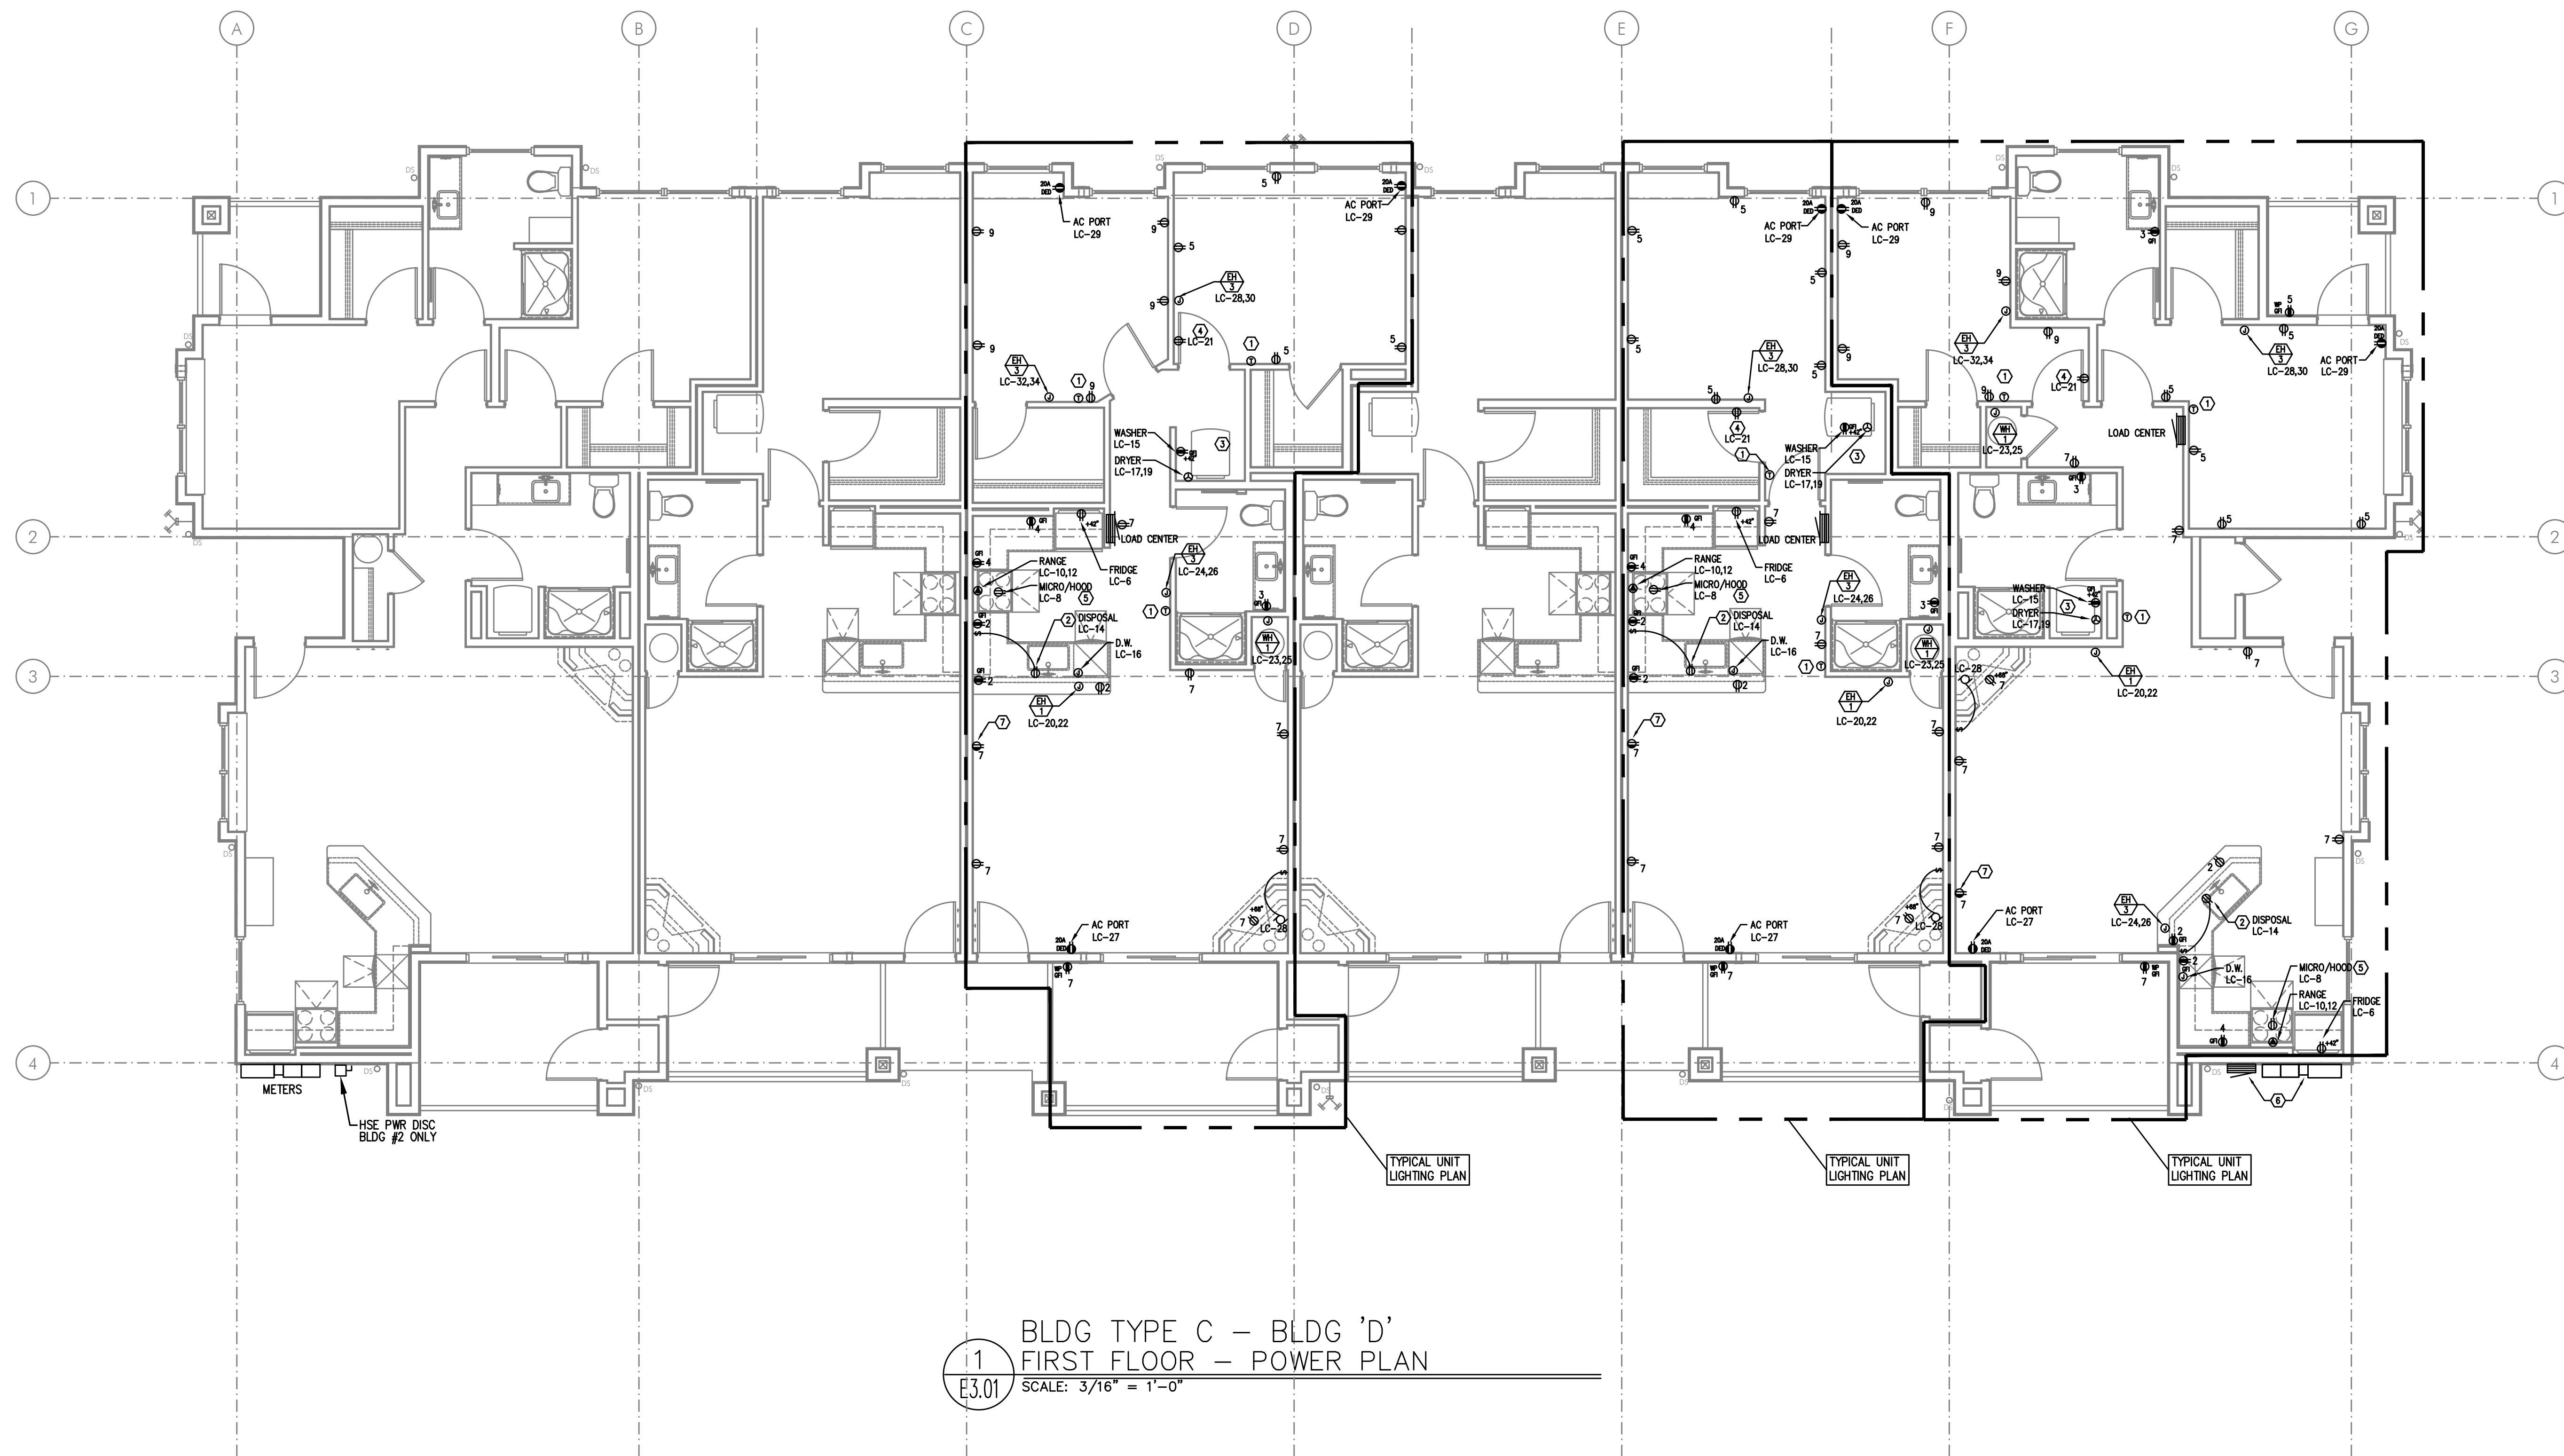

BLDG TYPE C – BLDG 'D'
FIRST FLOOR – POWER PLAN
SCALE: 3/16" = 1'-0"

GENERAL POWER NOTES:

- ALL PLANS ARE CONSIDERED DIAGRAMMATICAL. THEREFORE ALL EQUIPMENT SIZES AND DEVICE LOCATIONS ARE APPROXIMATE AND SUBJECT TO FIELD CONDITIONS AND PRODUCT APPROVAL.
- ELECTRICAL CONTRACTOR TO PROVIDE THERMOSTATS NOT SUPPLIED BY MECHANICAL CONTRACTOR. CONSULT MECHANICAL PLANS FOR ADDITIONAL INFORMATION.
- ELECTRICAL CONTRACTOR SHALL PROVIDE INSTALLATION AND FINAL CONNECTION OF THERMOSTATS. CONSULT MECHANICAL CONTRACTOR FOR EXACT REQUIREMENTS PRIOR TO ROUGH IN.
- REFER TO INTERIOR DECORATOR AND/OR ARCHITECTURAL DRAWINGS FOR DIMENSIONED LOCATION(S) AND ELEVATIONS OF FIXTURES & DEVICES. OTHER DEVICES SHOWN ON THE ELECTRICAL PLANS AND NOT INDICATED ON THE DECORATOR'S OR ARCHITECT'S DRAWINGS, SHALL BE INSTALLED AT STANDARD MOUNTING HEIGHT AS INDICATED THE SYMBOL LIST.
- BUILDING ELECTRICAL EQUIPMENT SHOWN IS APPROXIMATE, BASED ON INDUSTRY STANDARD PRODUCTS. CONTRACTOR SHALL VERIFY ANY SUBMITTED EQUIPMENT WILL FIT WITHIN THE SPACE PROVIDED, PRIOR TO PRODUCT SUBMITTAL REVIEW.
- ELECTRICAL CONTRACTOR SHALL COORDINATE WITH THE LOW VOLTAGE ("T" SERIES) PLANS, INCLUDING FIRE ALARM AND SYSTEMS INSTALLER, AND PROVIDE ROUGH IN AS NEEDED.

KEYED POWER NOTES:

- PROVIDE WIRE CONNECTION FOR THERMOSTAT(S). COORDINATE WITH MECHANICAL INSTALLER FOR EXACT LOCATION AND POWER REQUIREMENTS PRIOR TO ROUGH IN.
- PROVIDE ONE 20A, 120V, 1P GFCI DUPLEX RECEPTACLE UNDER KITCHEN SINK FOR DISPOSAL POWER CONNECTION.
- REFER TO DETAIL 1/E1.13 FOR TYPICAL LAUNDRY ALCOVE RECEPTACLE LOCATIONS. COORDINATE INSTALLATION WITH MECHANICAL & PLUMBING CONTRACTOR.
- PROVIDE ONE 15A, RECEPTACLE CIRCUIT FROM TENANT LOAD CENTER FOR TELECOM SMART PANEL. COORDINATE WORK WITH SERVICE PROVIDER FOR EXACT LOCATION AND FINAL CONNECTION.
- CONTRACTOR TO VERIFY POWER CONNECTION TYPE FOR THE HOOD/MICROWAVE PRIOR TO ROUGH IN. PROVIDE ONE DEDICATED 20A, 1P DUPLEX RECEPTACLE LOCATED INSIDE THE CABINET OVER THE RANGE FOR APPLIANCES SUPPLIED WITH CORD & PLUG SET. HOOD/MICROWAVES THAT ARE TO BE HARDWIRED, SHALL BE PROVIDED WITH THE DEDICATED CIRCUIT GOING TO A J-BOX WHICH IS TO BE MOUNTED DIRECTLY BEHIND THE APPLIANCE.
- METER LOCATION PER UTILITY PROVIDER'S APPROVAL (PENDING). REFER TO ONE-LINE DIAGRAM ON SHEET E1.11. PROVIDE NEMA 3R LOCKING CABINET FOR HOUSE PANEL 'HP'. REFER TO SHEET E1.01 FOR METER & PANEL LOCATION(S) AT EACH BUILDING.
- 15A SWITCHED SPLIT DUPLEX RECEPTACLE. REFER TO LIGHTING PLANS (E2 SERIES SHEETS) FOR SWITCH LOCATION.




IN THE EVENT CONFLICTS ARE DISCOVERED BETWEEN THE ORIGINAL SIGNED AND SEALED DOCUMENT PREPARED BY THE ARCHITECT AND/OR THEIR CONSULTANTS, AND ANY COPY OF THE DOCUMENT TRANSMITTED BY EMAIL, FAX, ELECTRONICALLY OR OTHERWISE, THE ORIGINAL SIGNED AND SEALED DOCUMENTS SHALL GOVERN.

PROJECT # 2019-179
DATE: 28 AUGUST 2020

REVISIONS

PLAN REVIEW 11.03.2020

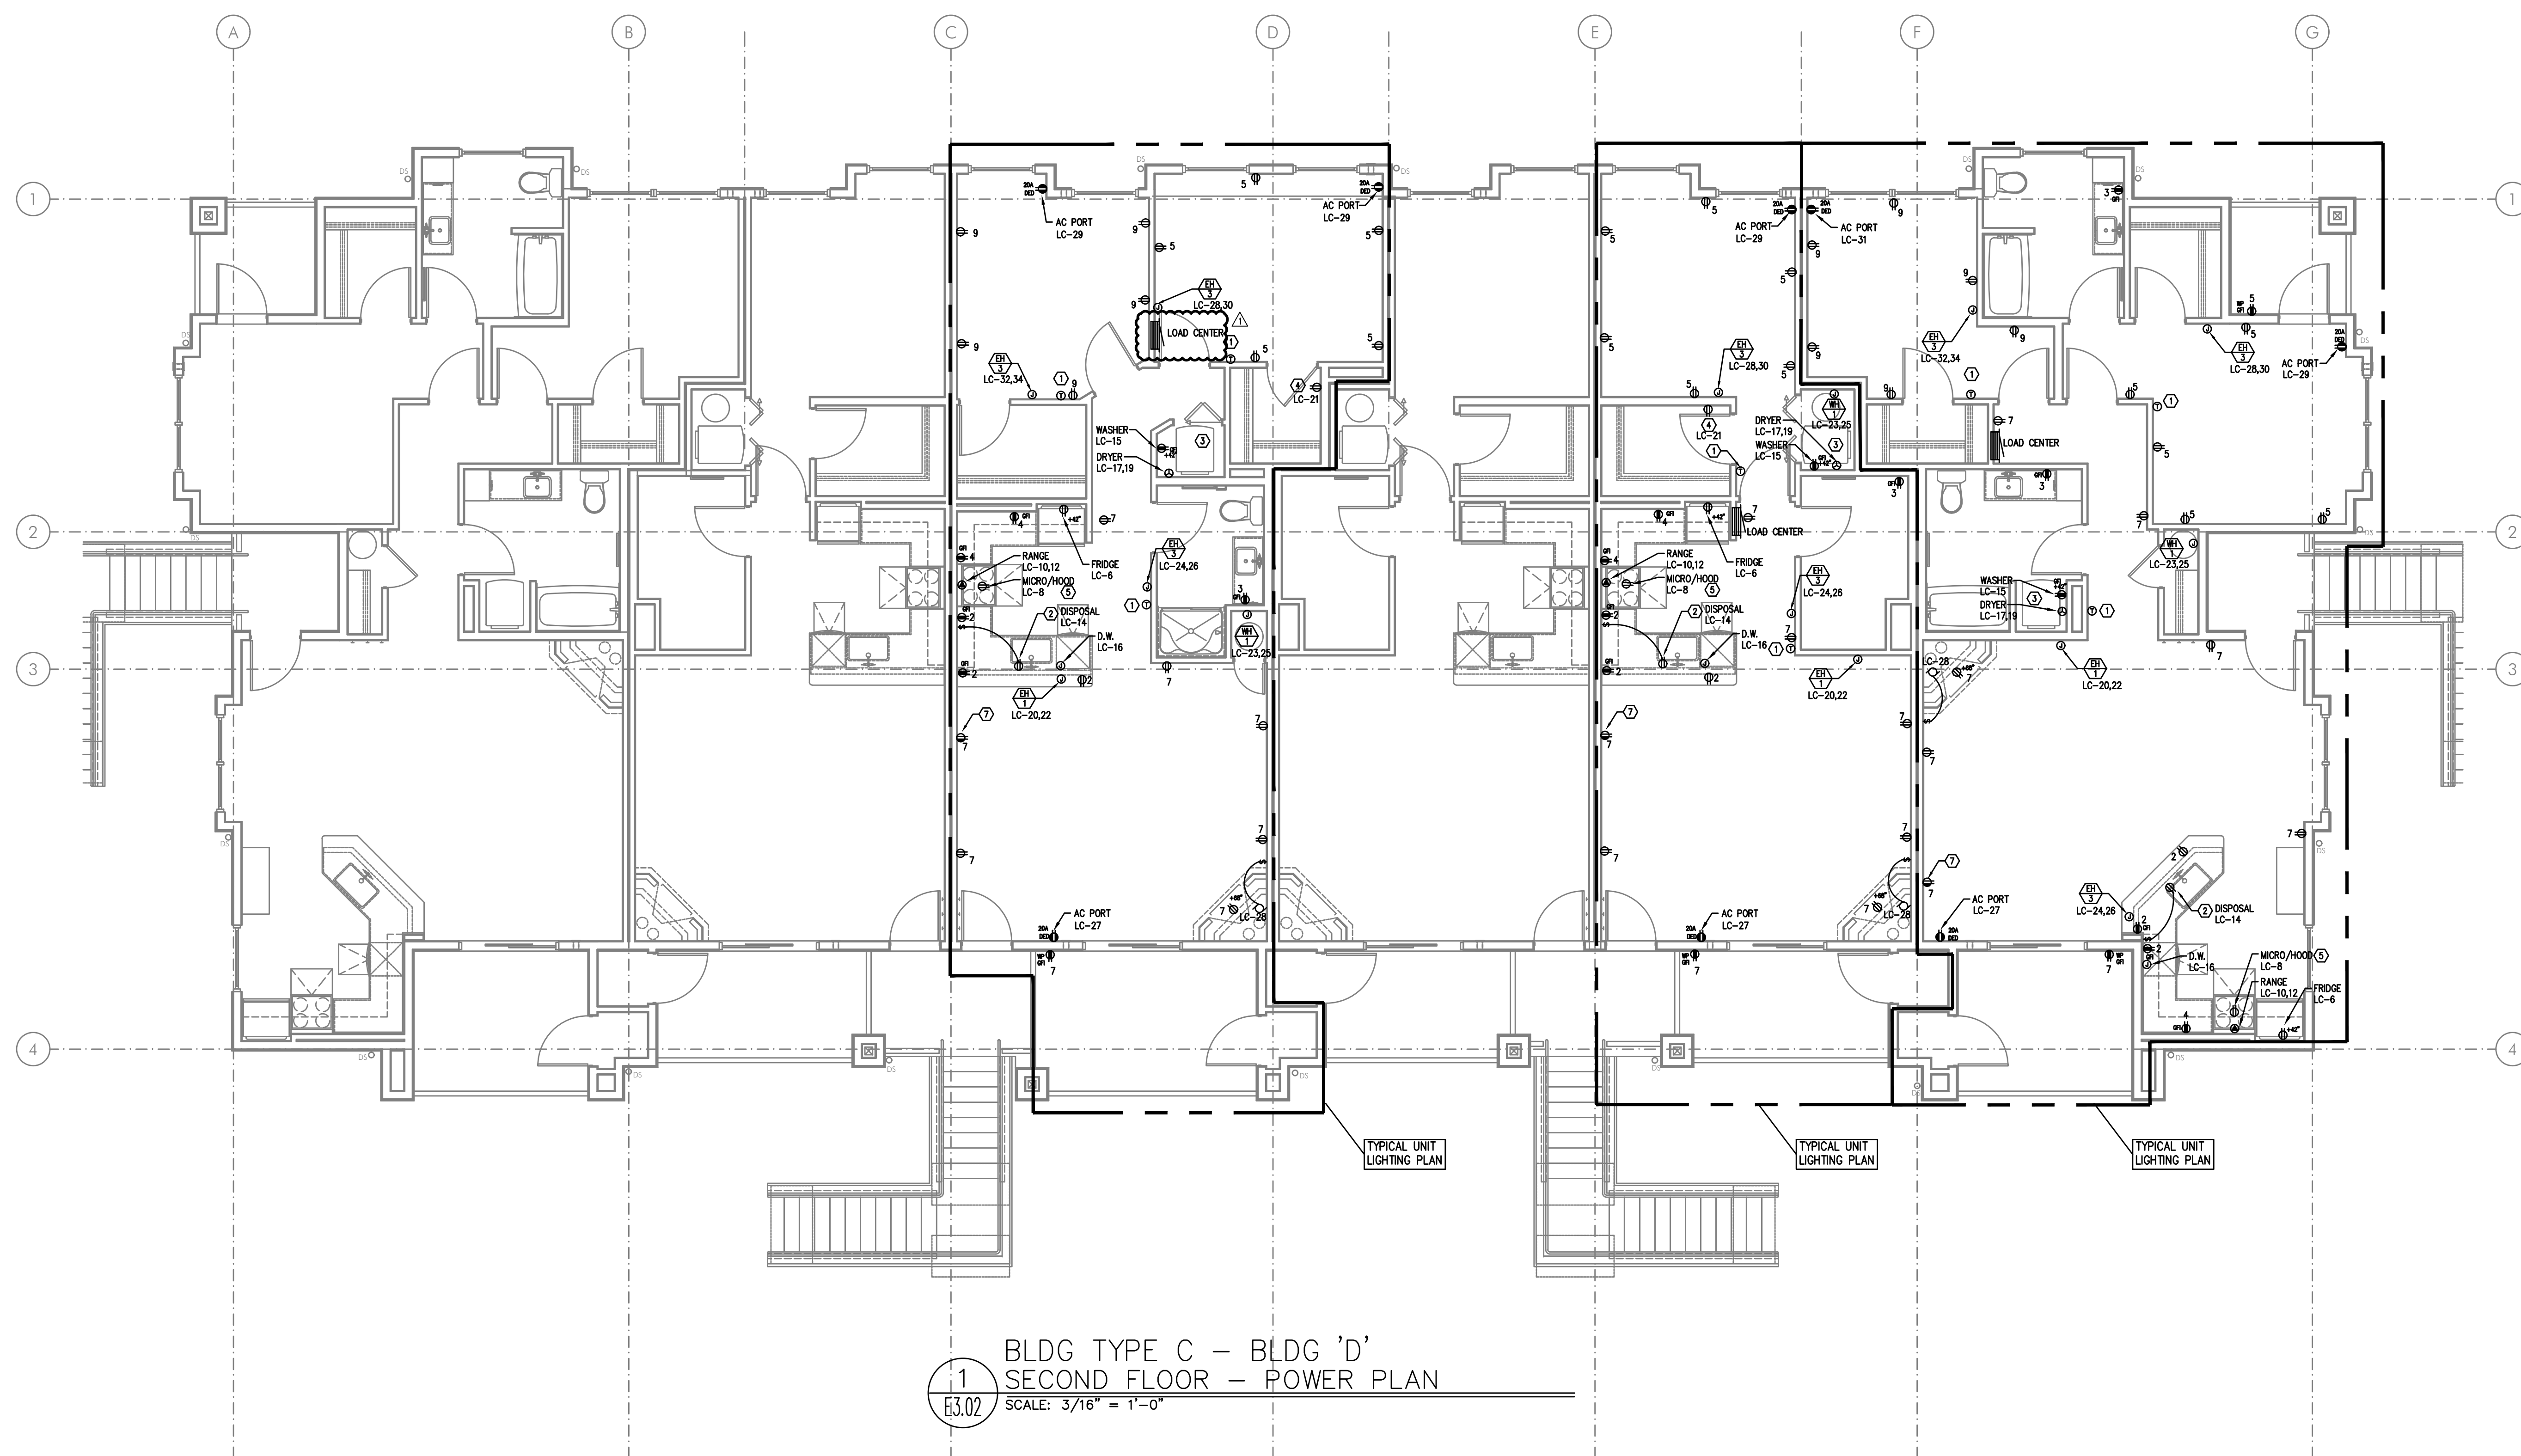


1
E3.02
BLDG TYPE C - BLDG 'D'
SECOND FLOOR - POWER PLAN
SCALE: 3/16" = 1'-0"

GENERAL POWER NOTES:

- ALL PLANS ARE CONSIDERED DIAGRAMMATICAL. THEREFORE ALL EQUIPMENT SIZES AND DEVICE LOCATIONS ARE APPROXIMATE AND SUBJECT TO FIELD CONDITIONS AND PRODUCT APPROVAL.
- ELECTRICAL CONTRACTOR TO PROVIDE THERMOSTATS NOT SUPPLIED BY MECHANICAL CONTRACTOR. CONSULT MECHANICAL PLANS FOR ADDITIONAL INFORMATION.
- ELECTRICAL CONTRACTOR SHALL PROVIDE INSTALLATION AND FINAL CONNECTION OF THERMOSTATS. CONSULT MECHANICAL CONTRACTOR FOR EXACT REQUIREMENTS PRIOR TO ROUGH IN.
- REFER TO INTERIOR DECORATOR AND/OR ARCHITECTURAL DRAWINGS FOR DIMENSIONED LOCATION(S) AND ELEVATIONS OF FIXTURES & DEVICES. OTHER DEVICES SHOWN ON THE ELECTRICAL PLANS AND NOT INDICATED ON THE DECORATOR'S OR ARCHITECT'S DRAWINGS, SHALL BE INSTALLED AT STANDARD MOUNTING HEIGHT AS INDICATED THE SYMBOL LIST.
- BUILDING ELECTRICAL EQUIPMENT SHOWN IS APPROXIMATE, BASED ON INDUSTRY STANDARD PRODUCTS. CONTRACTOR SHALL VERIFY ANY SUBMITTED EQUIPMENT WILL FIT WITHIN THE SPACE PROVIDED, PRIOR TO PRODUCT SUBMITTAL REVIEW.
- ELECTRICAL CONTRACTOR SHALL COORDINATE WITH THE LOW VOLTAGE ('T' SERIES) PLANS, INCLUDING FIRE ALARM AND SYSTEMS INSTALLER, AND PROVIDE ROUGH IN AS NEEDED.

KEYED POWER NOTES:

- PROVIDE WIRE CONNECTION FOR THERMOSTAT(S). COORDINATE WITH MECHANICAL INSTALLER FOR EXACT LOCATION AND POWER REQUIREMENTS PRIOR TO ROUGH IN.
- *PROVIDE ONE 20A, 120V, 1P GFCI DUPLEX RECEPTACLE UNDER KITCHEN SINK FOR DISPOSAL POWER CONNECTION.
- REFER TO DETAIL 1/E1.13 FOR TYPICAL LAUNDRY ALCOVE RECEPTACLE LOCATIONS. COORDINATE INSTALLATION WITH MECHANICAL & PLUMBING CONTRACTOR.
- PROVIDE ONE 15A RECEPTACLE CIRCUIT FROM TENANT LOAD CENTER FOR TELECOM SMART PANEL. COORDINATE WORK WITH SERVICE PROVIDER FOR EXACT LOCATION AND FINAL CONNECTION.
- CONTRACTOR TO VERIFY POWER CONNECTION TYPE FOR THE HOOD/MICROWAVE PRIOR TO ROUGH IN. PROVIDE ONE DEDICATED 20A, 1P DUPLEX RECEPTACLE LOCATED INSIDE THE CABINET OVER THE RANGE FOR APPLIANCES SUPPLIED WITH CORD & PLUG SET. HOOD/MICROWAVES THAT ARE TO BE HARDWIRED, SHALL BE PROVIDED WITH THE DEDICATED CIRCUIT GOING TO A J-BOX WHICH IS TO BE MOUNTED DIRECTLY BEHIND THE APPLIANCE.
- METER LOCATION PER UTILITY PROVIDER'S APPROVAL (PENDING). REFER TO ONE-LINE DIAGRAM ON SHEET E1.11. PROVIDE NEMA 3R LOCKING CABINET FOR HOUSE PANEL 'HP'. REFER TO SHEET E1.01 FOR METER & PANEL LOCATION(S) AT EACH BUILDING.
- 15A SWITCHED SPLIT DUPLEX RECEPTACLE. REFER TO LIGHTING PLANS (E2 SERIES SHEETS) FOR SWITCH LOCATION.

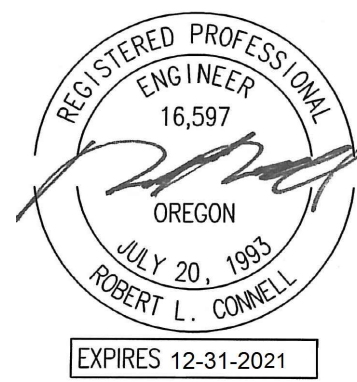


IN THE EVENT CONFLICTS ARE DISCOVERED
BETWEEN THE ORIGINAL SIGNED AND SEALED
DOCUMENTS PREPARED BY THE ARCHITECT
AND/OR THEIR CONSULTANTS, AND ANY COPY OF
THE DOCUMENTS TRANSMITTED BY EMAIL, FAX,
ELECTRONICALLY OR OTHERWISE, THE ORIGINAL
SIGNED AND SEALED DOCUMENTS SHALL GOVERN.

PROJECT # 2019-179
DATE: 28 AUGUST 2020

REVISIONS

PLAN REVIEW 11.03.2020

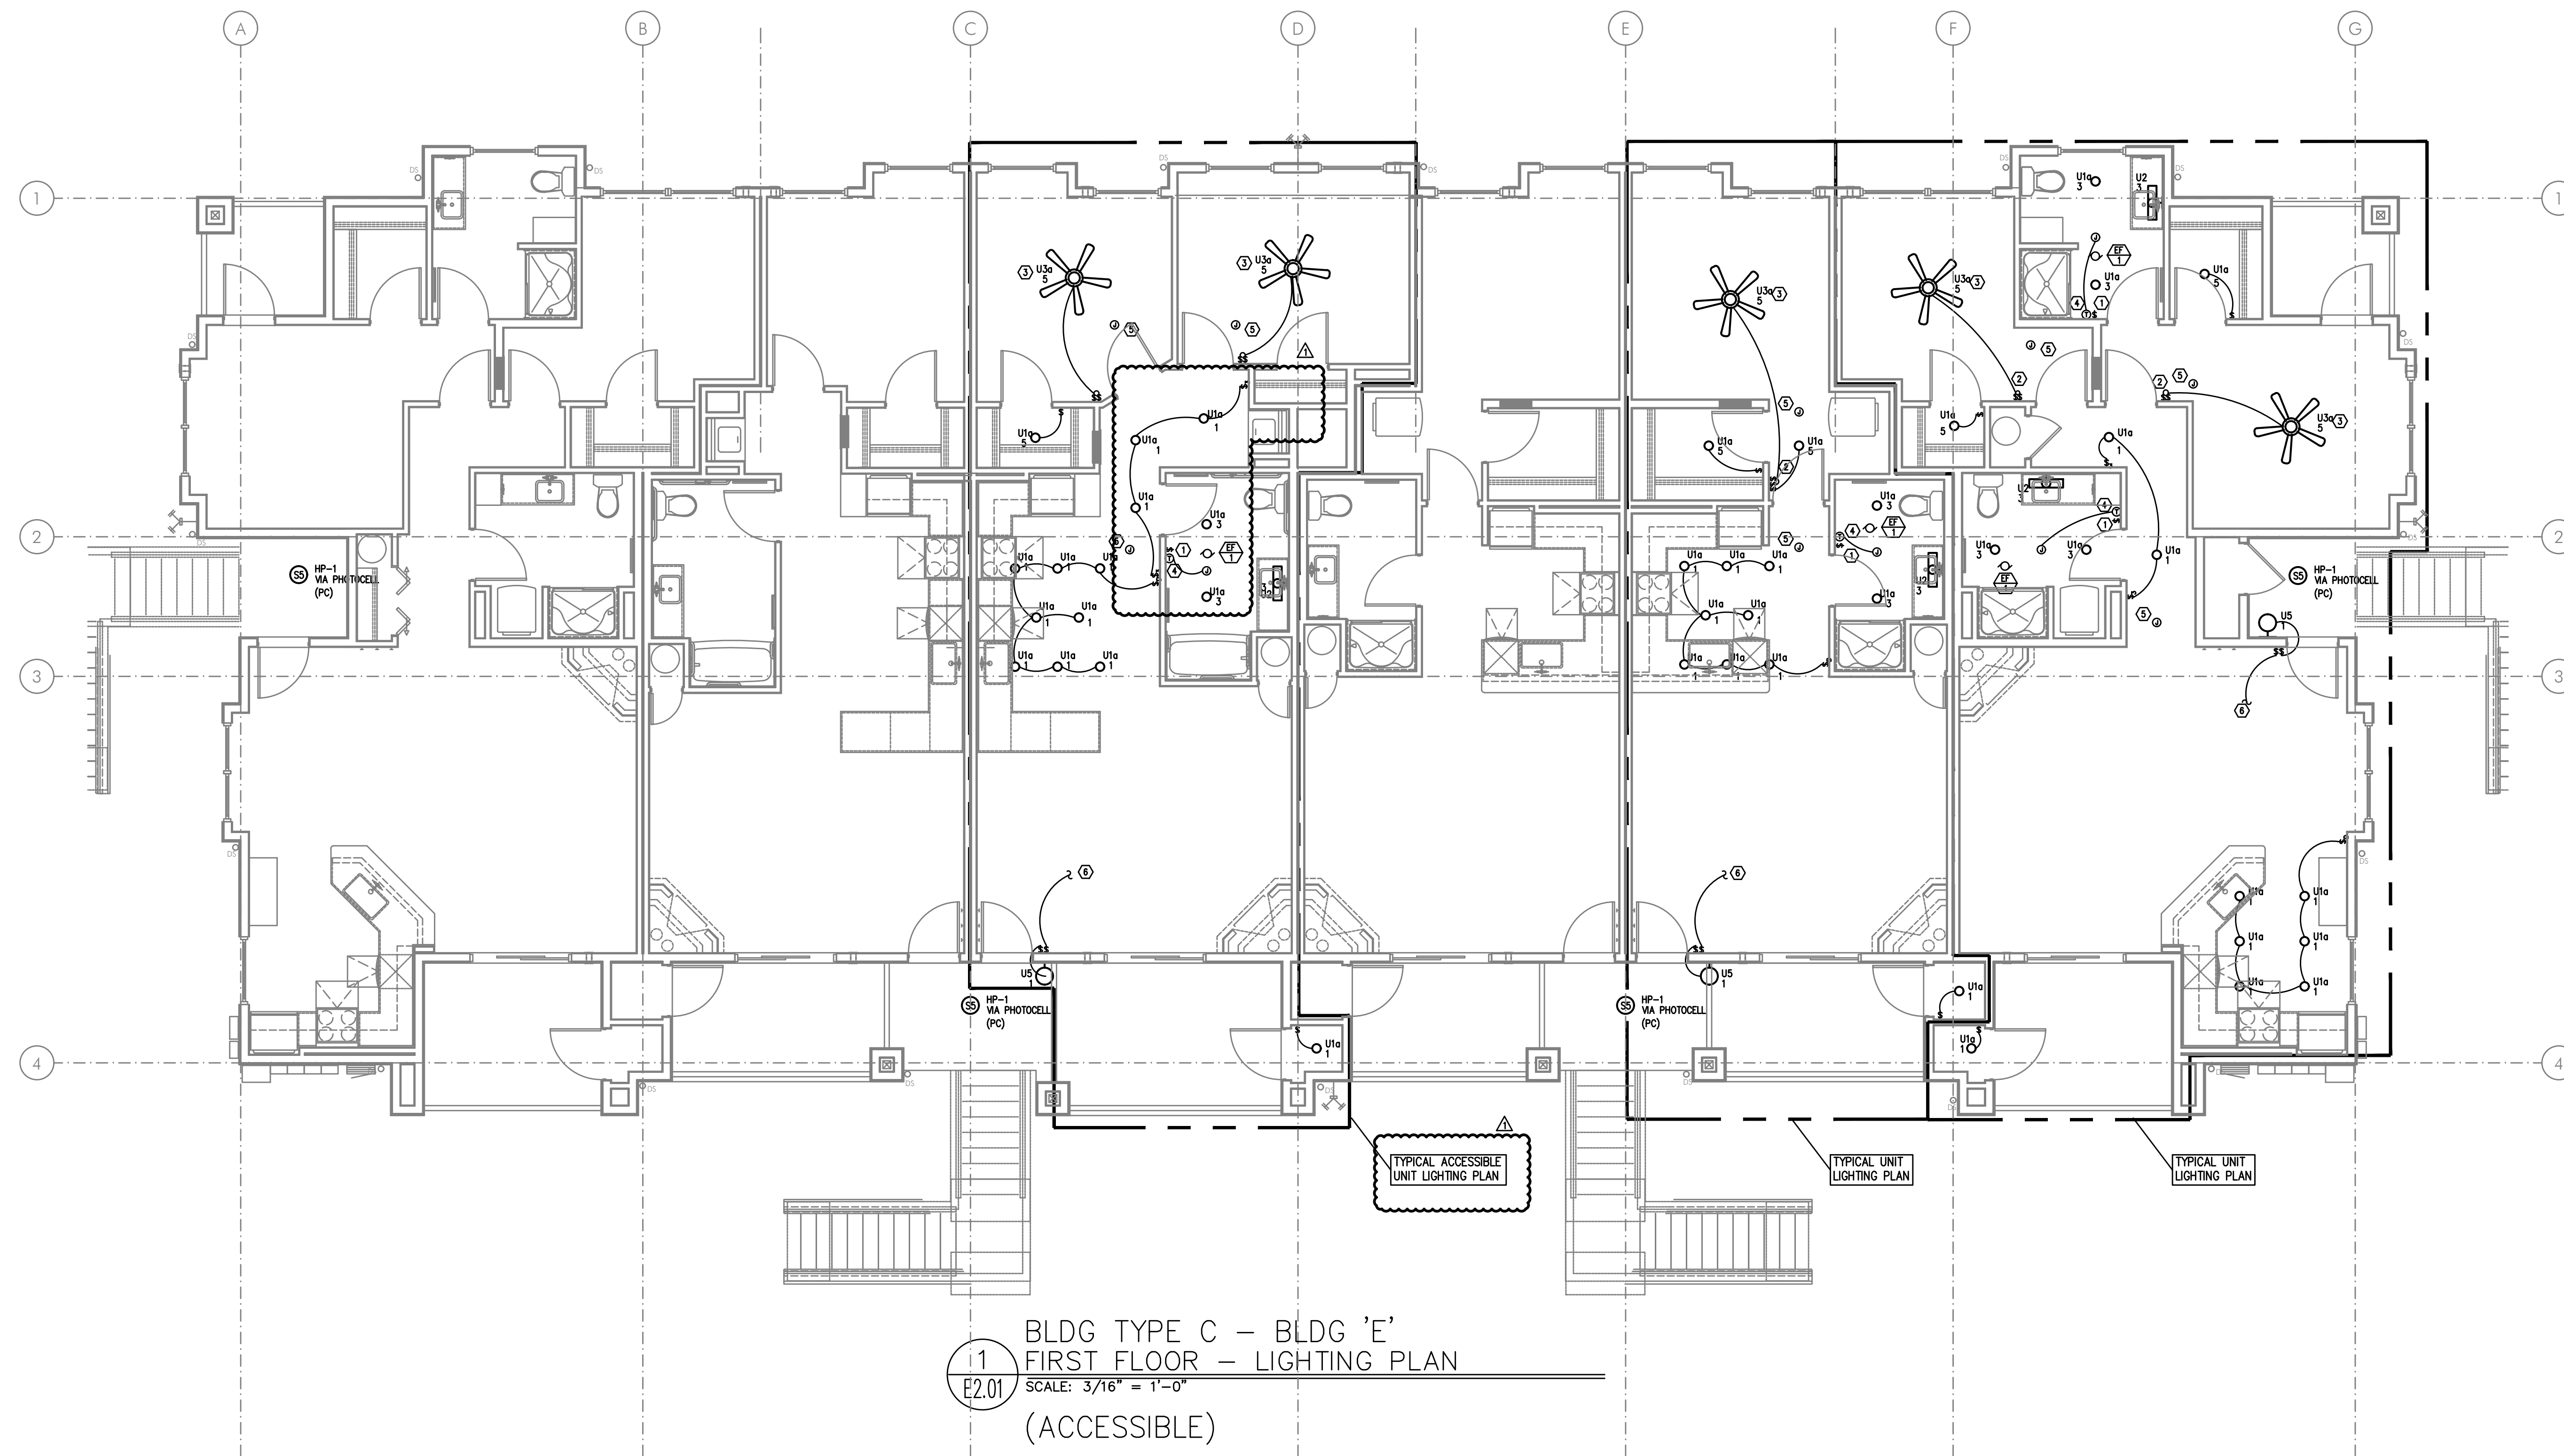


GENERAL LIGHTING NOTES:

- ELECTRICAL DRAWINGS ARE DIAGRAMMATICAL AND MAY NOT ACCURATELY REFLECT ACTUAL CONSTRUCTION CONDITIONS. THE ELECTRICAL CONTRACTOR SHALL BE RESPONSIBLE FOR COORDINATING THE INSTALLATION OF ALL ELECTRICAL EQUIPMENT, WITH ALL TRADES PRIOR TO AND DURING CONSTRUCTION.
- THE ELECTRICAL CONTRACTOR SHALL REFER TO THE ARCHITECTURAL DRAWINGS FOR ALL MOUNTING HEIGHTS AND FINISHES OF DEVICES AND FIXTURES.
- REFER TO SHEET E1.21 FOR LIGHT FIXTURE SCHEDULES.
- THE CONTRACTOR SHALL CONSULT THE ARCHITECT AND/OR INTERIOR DESIGNER FOR THE EXACT LOCATION OF ALL LIGHT FIXTURES PRIOR TO THE START OF ANY ROUGH IN WORK.
- REFER TO AVAILABLE ARCHITECTURAL AND/OR INTERIOR DESIGN DOCUMENTS & DRAWINGS FOR ADDITIONAL INFORMATION.
- EXTERIOR LIGHTING TO BE CONSTANT "ON" AND PROVIDED WITH PHOTOCELL, EITHER INTEGRAL OR REMOTE) FOR DUSK-TILL-DAWN OPERATION.
- ALL EXTERIOR BUILDING LIGHTS ON HOUSE POWER SHALL BE CONSIDERED EGRESS LIGHTING. FIXTURES ARE TO BE EQUIPPED WITH BATTERY BACK-UP (EITHER INTEGRAL OR REMOTE).
- REFER TO SHEET E1.14 FOR TYPICAL UNIT LOAD CENTER DIRECTORIES.
- ALL LIGHT SWITCHES SHALL BE ROCKER STYLE, SUCH AS LEVITON DECORA, OR APPROVED EQUAL.
- REFER TO ARCHITECTURAL REFLECTED CEILING PLANS FOR EXACT FIXTURE LOCATIONS (DIMENSIONS). CONSULT INTERIOR DESIGNER FOR MOUNTING HEIGHTS NOT SPECIFIED.
- REFER TO ARCHITECTURAL PLANS REGARDING "ACCESSIBLE" UNIT LOCATION(S), INTERIOR ELEVATIONS & DETAILS. COORDINATE INSTALLATION OF ALL DEVICES PER THE "AMERICAN DISABILITIES ACT" (ADA). REFER TO SHEET E1.21 FOR STANDARD ADA REACH REQUIREMENTS.

KEYED LIGHTING NOTES:

- REFER TO TYPICAL BATHROOM SWITCHING DETAILS ON SHEET E1.21.
- PROVIDE CEILING FAN CONTROL SWITCH(ES) AS DIRECTED BY MANUFACTURER.
- PROVIDE BLOCKING AT CEILING TO SUPPORT 35LB., MINIMUM, FOR CEILING FAN INSTALLATION.
- PROVIDE WIRE CONNECTION FOR THERMOSTAT(S). COORDINATE WITH MECHANICAL INSTALLER FOR EXACT LOCATION AND POWER REQUIREMENTS PRIOR TO ROUGH IN. CEILING HEATER TO BE TIED INTO BATHROOM POWER CIRCUIT.
- COORDINATE LOCATION OF POWER CONNECTION FOR FIRE ALARM DEVICES WITH THE SYSTEM CONTRACTOR/INSTALLER.
- TO SWITCHED RECEPTACLE. REFER TO POWER PLANS (E3 SERIES SHEETS) FOR OUTLET LOCATION.

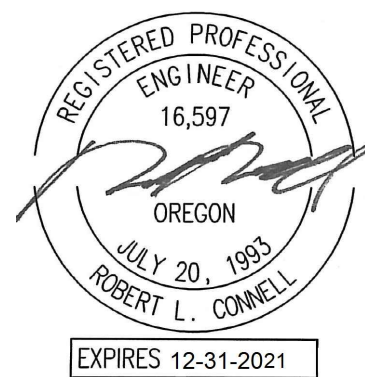

IN THE EVENT CONFLICTS ARE DISCOVERED BETWEEN THE ORIGINAL SIGNED AND SEALED DOCUMENTS PREPARED BY THE ARCHITECT AND/OR THEIR CONSULTANTS, AND ANY COPY OF THE DOCUMENTS TRANSMITTED BY EMAIL, FAX, ELECTRONICALLY OR OTHERWISE, THE ORIGINAL SIGNED AND SEALED DOCUMENTS SHALL GOVERN.

PROJECT # 2019-179
DATE: 28 AUGUST 2020

REVISIONS


PLAN REVIEW 11.03.2020

MCKINNEY LANE APARTMENTS PHASE II
RUSSELL DRIVE & MCKINNEY LANE
LEBANON, OREGON



C-E
E2.02

MEIA Consulting Engineers
2007 S.E. Ash St.
Portland, OR 97214
PH: (503) 234-0548
FAX: (503) 234-0677
INC. WWW.MEIA-ENG.COM
CONTACT: DENISE TAYLOR

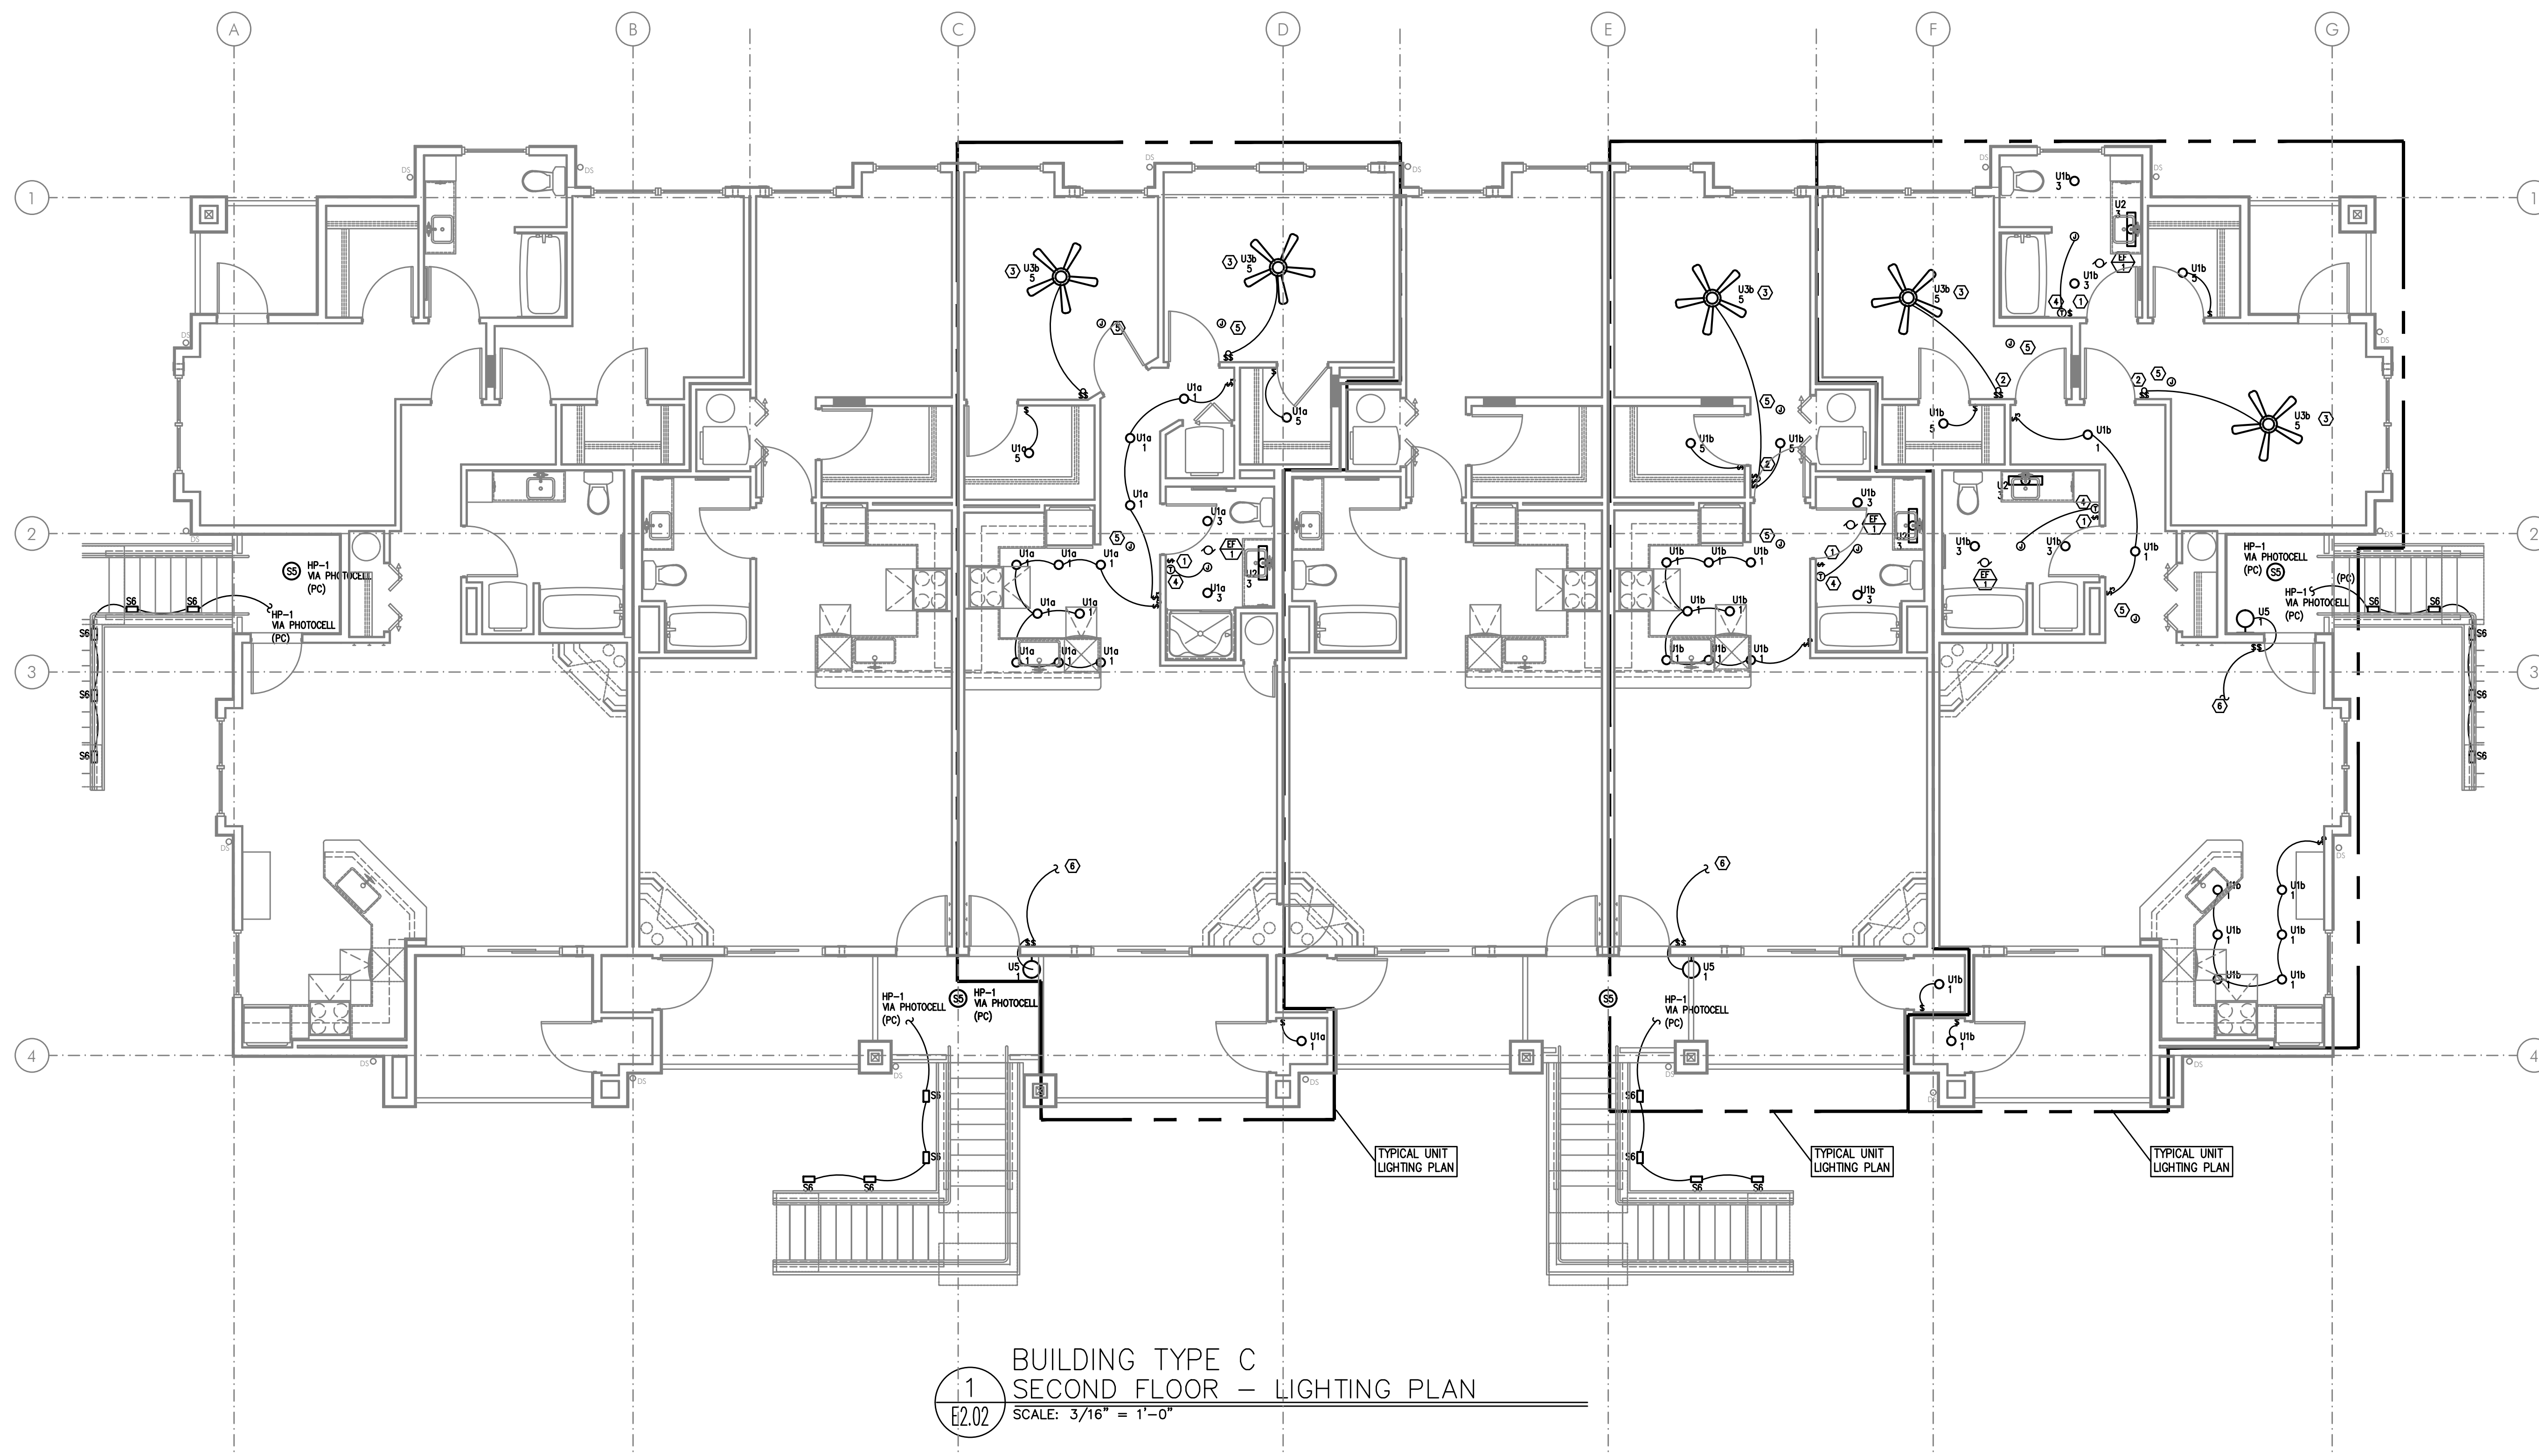

GENERAL LIGHTING NOTES:

- ELECTRICAL DRAWINGS ARE DIAGRAMMATICAL AND MAY NOT ACCURATELY REFLECT ACTUAL CONSTRUCTION CONDITIONS. THE ELECTRICAL CONTRACTOR SHALL BE RESPONSIBLE FOR COORDINATING THE INSTALLATION OF ALL ELECTRICAL EQUIPMENT, WITH ALL TRADES PRIOR TO AND DURING CONSTRUCTION.
- THE ELECTRICAL CONTRACTOR SHALL REFER TO THE ARCHITECTURAL DRAWINGS FOR ALL MOUNTING HEIGHTS AND FINISHES OF DEVICES AND FIXTURES.
- REFER TO SHEET E1.21 FOR LIGHT FIXTURE SCHEDULES.
- THE CONTRACTOR SHALL CONSULT THE ARCHITECT AND/OR INTERIOR DESIGNER FOR THE EXACT LOCATION OF ALL LIGHT FIXTURES PRIOR TO THE START OF ANY ROUGH IN WORK.
- REFER TO AVAILABLE ARCHITECTURAL AND/OR INTERIOR DESIGN DOCUMENTS & DRAWINGS FOR ADDITIONAL INFORMATION.
- EXTERIOR LIGHTING TO BE CONSTANT "ON" AND PROVIDED WITH PHOTOCELL, EITHER INTEGRAL OR REMOTE) FOR DUSK-TILL-DAWN OPERATION.
- ALL EXTERIOR BUILDING LIGHTS ON HOUSE POWER SHALL BE CONSIDERED EGRESS LIGHTING. FIXTURES ARE TO BE EQUIPPED WITH BATTERY BACK-UP (EITHER INTEGRAL OR REMOTE).
- REFER TO SHEET E1.14 FOR TYPICAL UNIT LOAD CENTER DIRECTORIES.
- ALL LIGHT SWITCHES SHALL BE ROCKER STYLE, SUCH AS LEVITON DECORA, OR APPROVED EQUAL.
- REFER TO ARCHITECTURAL REFLECTED CEILING PLANS FOR EXACT FIXTURE LOCATIONS (DIMENSIONS). CONSULT INTERIOR DESIGNER FOR MOUNTING HEIGHTS NOT SPECIFIED.
- REFER TO ARCHITECTURAL PLANS REGARDING "ACCESSIBLE" UNIT LOCATION(S), INTERIOR ELEVATIONS & DETAILS. COORDINATE INSTALLATION OF ALL DEVICES PER THE "AMERICAN DISABILITIES ACT" (ADA). REFER TO SHEET E1.21 FOR STANDARD ADA REACH REQUIREMENTS.

KEYED LIGHTING NOTES:

- REFER TO TYPICAL BATHROOM SWITCHING DETAILS ON SHEET E1.21.
- PROVIDE CEILING FAN CONTROL SWITCH(ES) AS DIRECTED BY MANUFACTURER.
- PROVIDE BLOCKING AT CEILING TO SUPPORT 35LB., MINIMUM, FOR CEILING FAN INSTALLATION.
- PROVIDE WIRE CONNECTION FOR THERMOSTAT(S). COORDINATE WITH MECHANICAL INSTALLER FOR EXACT LOCATION AND POWER REQUIREMENTS PRIOR TO ROUGH IN. CEILING HEATER TO BE TIED INTO BATHROOM POWER CIRCUIT.
- COORDINATE LOCATION OF POWER CONNECTION FOR FIRE ALARM DEVICES WITH THE SYSTEM CONTRACTOR/INSTALLER.
- TO SWITCHED RECEPTACLE. REFER TO POWER PLANS (E3 SERIES SHEETS) FOR OUTLET LOCATION.




IN THE EVENT CONFLICTS ARE DISCOVERED BETWEEN THE ORIGINAL SIGNED AND SEALED DOCUMENTS PREPARED BY THE ARCHITECT AND/OR THEIR CONSULTANTS, AND ANY COPY OF THE DOCUMENTS TRANSMITTED BY ELECTRONIC, ELECTRONICALLY OR OTHERWISE, THE ORIGINAL SIGNED AND SEALED DOCUMENTS SHALL GOVERN.

PROJECT # 2019-179

DATE: 28 AUGUST 2020

REVISIONS

PLAN REVIEW 11.03.2020

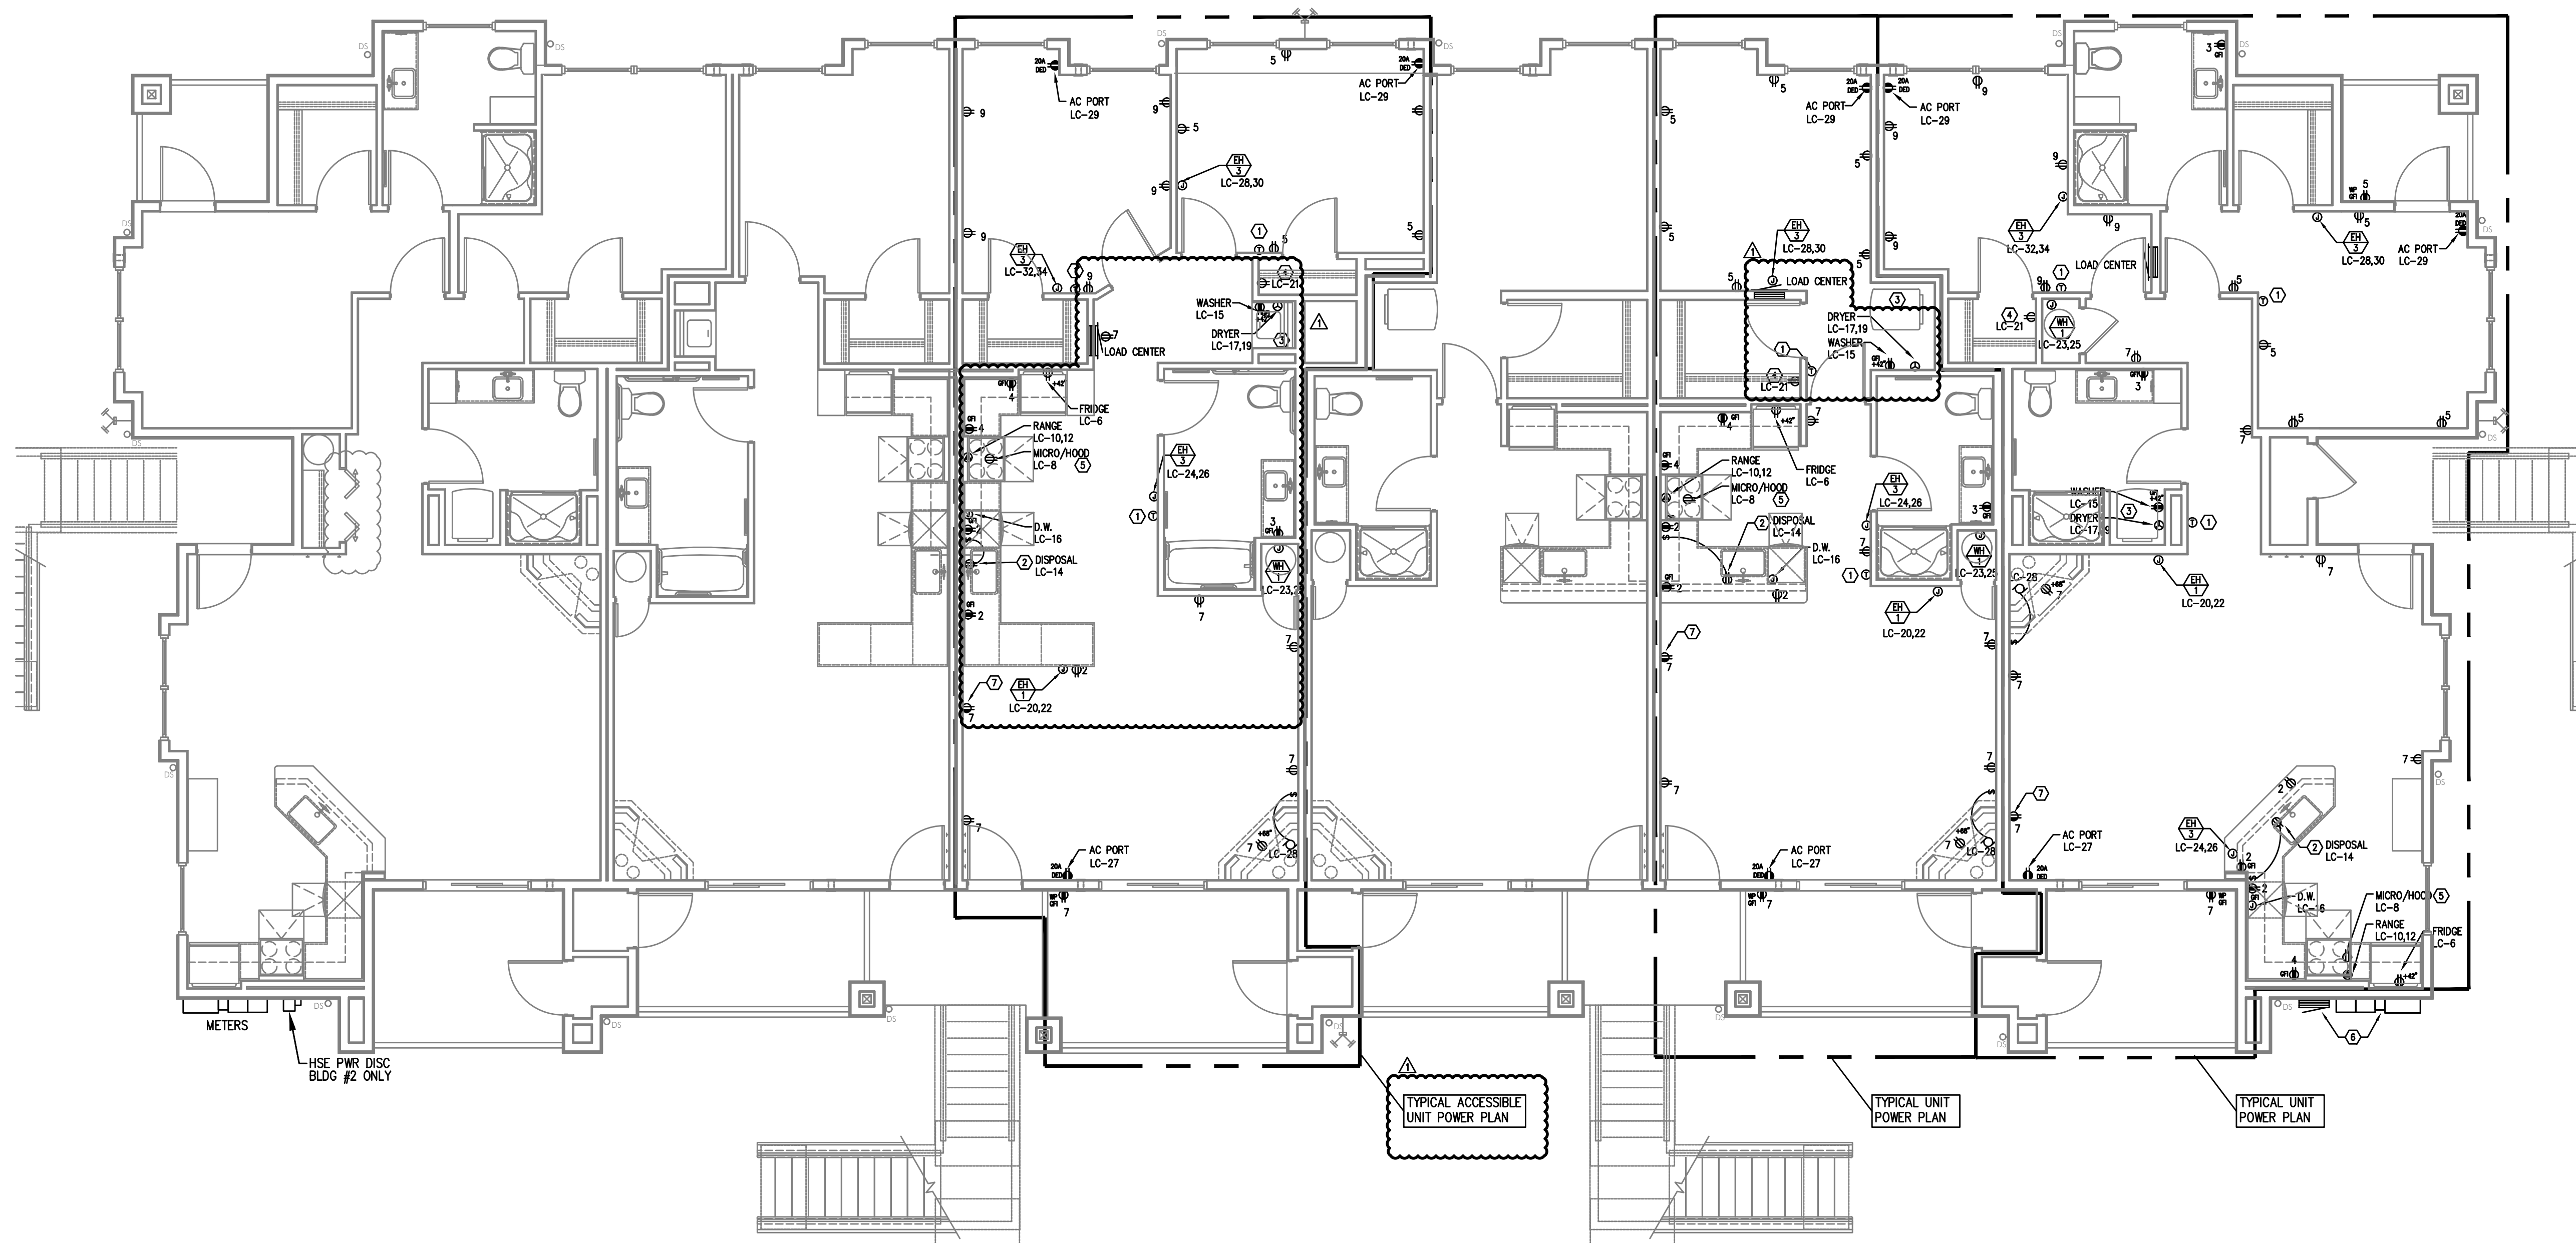


1 BLDG TYPE C – BLDG 'E'
E3.01 FIRST FLOOR – POWER PLAN
SCALE: 3/16" = 1'-0"
(ACCESSIBLE)

GENERAL POWER NOTES:

- ALL PLANS ARE CONSIDERED DIAGRAMMATICAL. THEREFORE ALL EQUIPMENT SIZES AND DEVICE LOCATIONS ARE APPROXIMATE AND SUBJECT TO FIELD CONDITIONS AND PRODUCT APPROVAL.
- ELECTRICAL CONTRACTOR TO PROVIDE THERMOSTATS NOT SUPPLIED BY MECHANICAL CONTRACTOR. CONSULT MECHANICAL PLANS FOR ADDITIONAL INFORMATION.
- ELECTRICAL CONTRACTOR SHALL PROVIDE INSTALLATION AND FINAL CONNECTION OF THERMOSTATS. CONSULT MECHANICAL CONTRACTOR FOR EXACT REQUIREMENTS PRIOR TO ROUGH IN.
- REFER TO INTERIOR DECORATOR AND/OR ARCHITECTURAL DRAWINGS FOR DIMENSIONED LOCATION(S) AND ELEVATIONS OF FIXTURES & DEVICES. OTHER DEVICES SHOWN ON THE ELECTRICAL PLANS AND NOT INDICATED ON THE DECORATOR'S OR ARCHITECT'S DRAWINGS, SHALL BE INSTALLED AT STANDARD MOUNTING HEIGHT AS INDICATED THE SYMBOL LIST.
- BUILDING ELECTRICAL EQUIPMENT SHOWN IS APPROXIMATE, BASED ON INDUSTRY STANDARD PRODUCTS. CONTRACTOR SHALL VERIFY ANY SUBMITTED EQUIPMENT WILL FIT WITHIN THE SPACE PROVIDED, PRIOR TO PRODUCT SUBMITTAL REVIEW.
- ELECTRICAL CONTRACTOR SHALL COORDINATE WITH THE LOW VOLTAGE ("T" SERIES) PLANS, INCLUDING FIRE ALARM AND SYSTEMS INSTALLER, AND PROVIDE ROUGH IN AS NEEDED.
- REFER TO ARCHITECTURAL PLANS REGARDING "ACCESSIBLE" UNIT LOCATION(S), INTERIOR ELEVATIONS & DETAILS. COORDINATE INSTALLATION OF ALL DEVICES PER THE "AMERICAN DISABILITIES ACT" (ADA). REFER TO SHEET E1.21 FOR STANDARD ADA REACH REQUIREMENTS.

KEYED POWER NOTES:

- PROVIDE WIRE CONNECTION FOR THERMOSTAT(S). COORDINATE WITH MECHANICAL INSTALLER FOR EXACT LOCATION AND POWER REQUIREMENTS PRIOR TO ROUGH IN.
- PROVIDE ONE 20A, 120V, 1P GFCI DUPLEX RECEPTACLE UNDER KITCHEN SINK FOR DISPOSAL POWER CONNECTION.
- REFER TO DETAIL 1/E1.13 FOR TYPICAL LAUNDRY ALCOVE RECEPTACLE LOCATIONS. COORDINATE INSTALLATION WITH MECHANICAL & PLUMBING CONTRACTOR.
- PROVIDE ONE 15A, RECEPTACLE CIRCUIT FROM TENANT LOAD CENTER FOR TELECOM SMART PANEL. COORDINATE WORK WITH SERVICE PROVIDER FOR EXACT LOCATION AND FINAL CONNECTION.
- CONTRACTOR TO VERIFY POWER CONNECTION TYPE FOR THE HOOD/MICROWAVE PRIOR TO ROUGH IN. PROVIDE ONE DEDICATED 20A, 1P DUPLEX RECEPTACLE LOCATED INSIDE THE CABINET OVER THE RANGE FOR APPLIANCES SUPPLIED WITH CORD & PLUG SET. HOOD/MICROWAVES THAT ARE TO BE HARDWIRED, SHALL BE PROVIDED WITH THE DEDICATED CIRCUIT GOING TO A J-BOX WHICH IS TO BE MOUNTED DIRECTLY BEHIND THE APPLIANCE.
- METER LOCATION PER UTILITY PROVIDER'S APPROVAL (PENDING). REFER TO ONE-LINE DIAGRAM ON SHEET E1.11. PROVIDE NEMA 3R LOCKING CABINET FOR HOUSE PANEL 'HP'. REFER TO SHEET E1.01 FOR METER & PANEL LOCATION(S) AT EACH BUILDING.
- 15A SWITCHED SPLIT DUPLEX RECEPTACLE. REFER TO LIGHTING PLANS (E2 SERIES SHEETS) FOR SWITCH LOCATION.

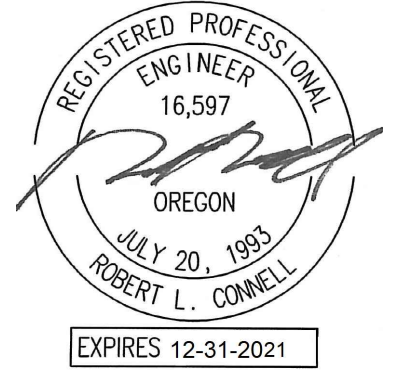


IN THE EVENT CONFLICTS ARE DISCOVERED BETWEEN THE ORIGINAL SIGNED AND SEALED DOCUMENTS PREPARED BY THE ARCHITECT AND/OR THEIR CONSULTANTS, AND ANY COPY OF THE DOCUMENTS TRANSMITTED BY EMAIL, FAX, ELECTRONICALLY OR OTHERWISE, THE ORIGINAL SIGNED AND SEALED DOCUMENTS SHALL GOVERN.

PROJECT # 2019-179

DATE: 28 AUGUST 2020

REVISIONS

PLAN REVIEW 11.03.2020

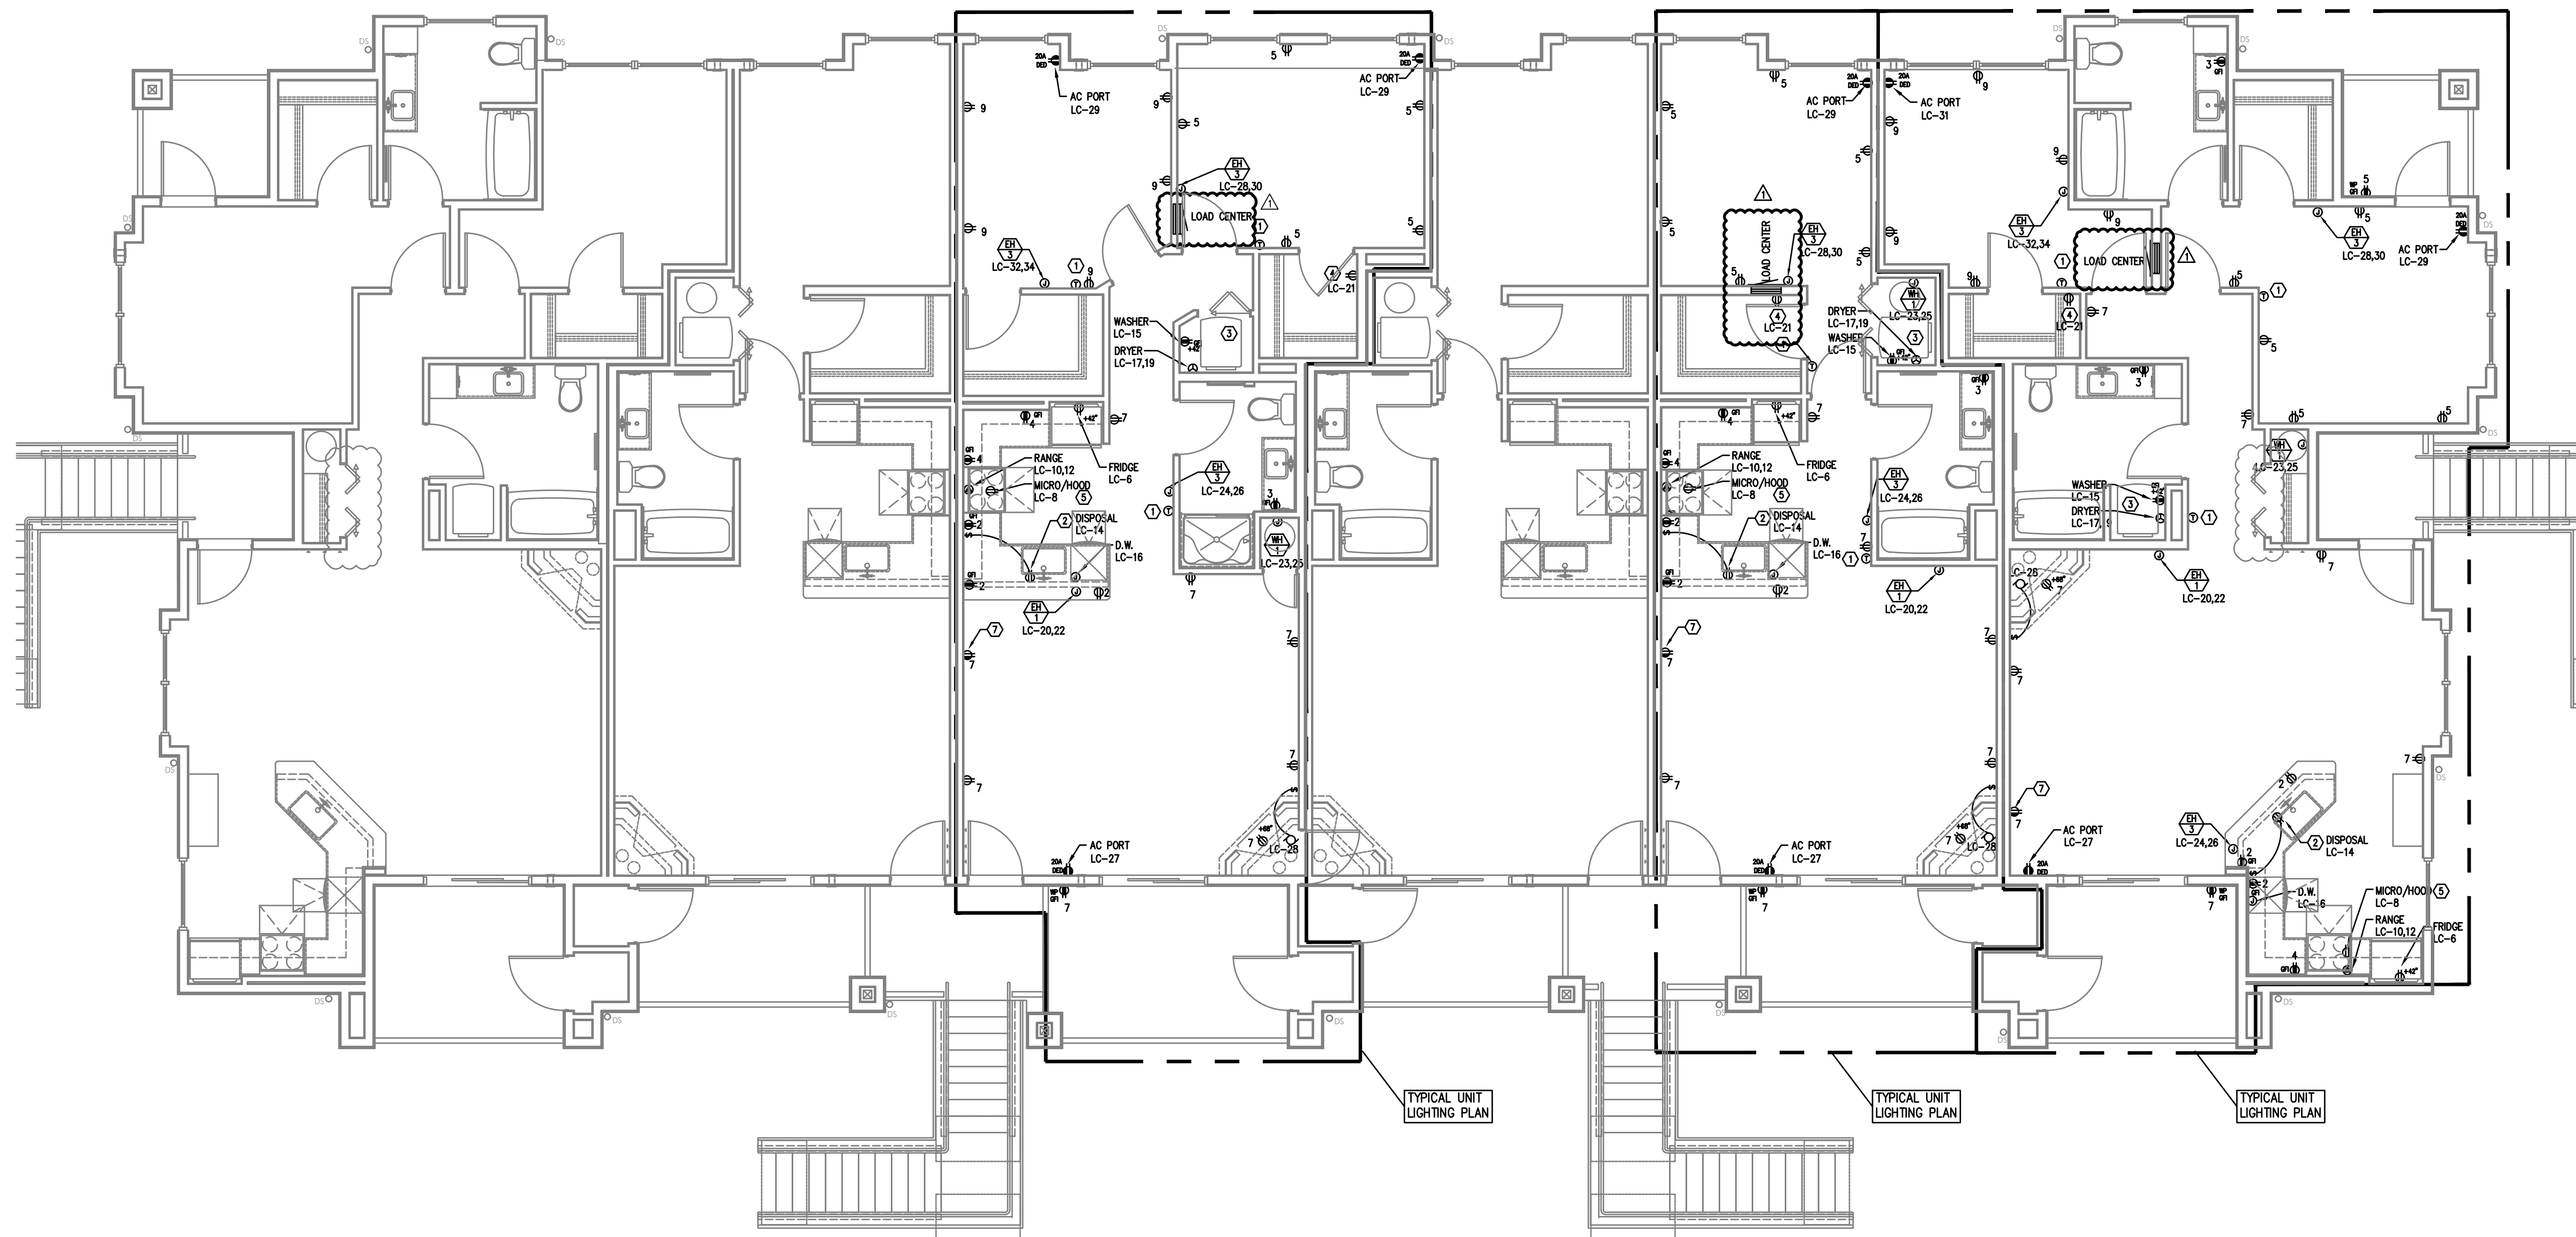

1 BLDG TYPE C - BLDG 'E'
E3.02 SECOND FLOOR - POWER PLAN
SCALE: 3/16" = 1'-0"

GENERAL POWER NOTES:

- ALL PLANS ARE CONSIDERED DIAGMMATICAL. THEREFORE ALL EQUIPMENT SIZES AND DEVICE LOCATIONS ARE APPROXIMATE AND SUBJECT TO FIELD CONDITIONS AND PRODUCT APPROVAL.
- ELECTRICAL CONTRACTOR TO PROVIDE THERMOSTATS NOT SUPPLIED BY MECHANICAL CONTRACTOR. CONSULT MECHANICAL PLANS FOR ADDITIONAL INFORMATION.
- ELECTRICAL CONTRACTOR SHALL PROVIDE INSTALLATION AND FINAL CONNECTION OF THERMOSTATS. CONSULT MECHANICAL CONTRACTOR FOR EXACT REQUIREMENTS PRIOR TO ROUGH IN.
- REFER TO INTERIOR DECORATOR AND/OR ARCHITECTURAL DRAWINGS FOR DIMENSIONED LOCATION(S) AND ELEVATIONS OF FIXTURES & DEVICES. OTHER DEVICES SHOWN ON THE ELECTRICAL PLANS AND NOT INDICATED ON THE DECORATOR'S OR ARCHITECT'S DRAWINGS, SHALL BE INSTALLED AT STANDARD MOUNTING HEIGHT AS INDICATED THE SYMBOL LIST.
- BUILDING ELECTRICAL EQUIPMENT SHOWN IS APPROXIMATE, BASED ON INDUSTRY STANDARD PRODUCTS. CONTRACTOR SHALL VERIFY ANY SUBMITTED EQUIPMENT WILL FIT WITHIN THE SPACE PROVIDED, PRIOR TO PRODUCT SUBMITTAL REVIEW.
- ELECTRICAL CONTRACTOR SHALL COORDINATE WITH THE LOW VOLTAGE ('T' SERIES) PLANS, INCLUDING FIRE ALARM AND SYSTEMS INSTALLER, AND PROVIDE ROUGH IN AS NEEDED.
- REFER TO ARCHITECTURAL PLANS REGARDING "ACCESSIBLE" UNIT LOCATION(S), INTERIOR ELEVATIONS & DETAILS. COORDINATE INSTALLATION OF ALL DEVICES PER THE "AMERICAN DISABILITIES ACT" (ADA). REFER TO SHEET E1.21 FOR STANDARD ADA REACH REQUIREMENTS.


KEYED POWER NOTES:

- PROVIDE WIRE CONNECTION FOR THERMOSTAT(S). COORDINATE WITH MECHANICAL INSTALLER FOR EXACT LOCATION AND POWER REQUIREMENTS PRIOR TO ROUGH IN.
- *PROVIDE ONE 20A, 120V, 1P GFCI DUPLEX RECEPTACLE UNDER KITCHEN SINK FOR DISPOSAL POWER CONNECTION.
- REFER TO DETAIL 1/E1.13 FOR TYPICAL LAUNDRY ALCOVE RECEPTACLE LOCATIONS. COORDINATE INSTALLATION WITH MECHANICAL & PLUMBING CONTRACTOR.
- PROVIDE ONE 15A, RECEPTACLE CIRCUIT FROM TENANT LOAD CENTER FOR TELECOM SMART PANEL. COORDINATE WORK WITH SERVICE PROVIDER FOR EXACT LOCATION AND FINAL CONNECTION.
- CONTRACTOR TO VERIFY POWER CONNECTION TYPE FOR THE HOOD/MICROWAVE PRIOR TO ROUGH IN. PROVIDE ONE DEDICATED 20A, 1P DUPLEX RECEPTACLE LOCATED INSIDE THE CABINET OVER THE RANGE FOR APPLIANCES SUPPLIED WITH CORD & PLUG SET. HOOD/MICROWAVES THAT ARE TO BE HARDWIRED, SHALL BE PROVIDED WITH THE DEDICATED CIRCUIT GOING TO A J-BOX WHICH IS TO BE MOUNTED DIRECTLY BEHIND THE APPLIANCE.
- METER LOCATION PER UTILITY PROVIDER'S APPROVAL (PENDING). REFER TO ONE-LINE DIAGRAM ON SHEET E1.11. PROVIDE NEMA 3R LOCKING CABINET FOR HOUSE PANEL 'HP'. REFER TO SHEET E1.01 FOR METER & PANEL LOCATION(S) AT EACH BUILDING.
- 15A SWITCHED SPLIT DUPLEX RECEPTACLE. REFER TO LIGHTING PLANS (E2 SERIES SHEETS) FOR SWITCH LOCATION.

E5.01

1. CONTRACTOR TO PROVIDE BLOCKING ABOVE THE CEILING TO SUPPORT A MINIMUM OF 35LBS. FOR CEILING FANS. FANS ARE TO BE PROVIDED BY OTHERS AND INSTALLED BY ELECTRICAL CONTRACTOR.

1 CLUBHOUSE LIGHTING PLAN

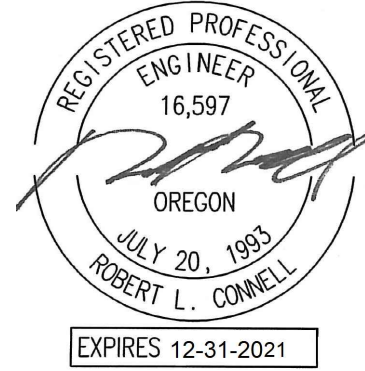

IN THE EVENT CONFLICTS ARE DISCOVERED
BETWEEN THE ORIGINAL SIGNED AND SEALED
DOCUMENT PREPARED BY THE ARCHITECT
AND/OR THEIR CONSULTANTS, AND ANY COPY OF
THE DOCUMENT TRANSMITTED BY EMAIL, FAX,
ELECTRONICALLY OR OTHERWISE, THE ORIGINAL
SIGNED AND SEALED DOCUMENTS SHALL GOVERN.

PROJECT # 2019-179
DATE: 28 AUGUST 2020

REVISIONS



PLAN REVIEW 11.03.2020

GENERAL SITE LIGHTING NOTES:

- ALL WORK SHALL BE PERFORMED IN ACCORDANCE WITH ALL APPLICABLE LOCAL, STATE AND NATION CODES.
- ALL PLANS ARE CONSIDERED DIAGRAMMATICAL. THEREFORE ALL EQUIPMENT SIZES AND DEVICE LOCATIONS ARE APPROXIMATE AND SUBJECT TO FIELD CONDITIONS AND PRODUCT APPROVAL.
- REFER TO SHEETS E1.11 FOR ONE-LINE DIAGRAM, LOAD SUMMARY INFORMATION AND TYPICAL FEEDER SCHEDULE.
- REFER TO SHEETS E2 SERIES SHEETS FOR EXTERIOR BUILDING LIGHTS.
- REFER TO SHEET E1.21 FOR LIGHT FIXTURE SCHEDULE.

KEYED POWER NOTES:


- 3/4" PVC CONDUIT ROUTED UNDER GROUND FROM HOUSE PANEL TO BUILDING STRUCTURE FOR LIGHTING CIRCUIT(S). REFER TO PANEL SCHEDULES ON SHEET E1.11 FOR ADDITIONAL INFORMATION.
- 3/4" PVC CONDUIT ROUTED UNDER GROUND FROM HOUSE PANEL TO WEATHER PROOF J-BOX FOR MONUMENT SIGN LIGHTING. REFER TO PANEL SCHEDULES ON SHEET E1.11 FOR ADDITIONAL INFORMATION.

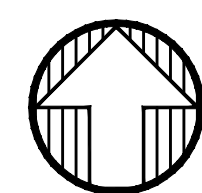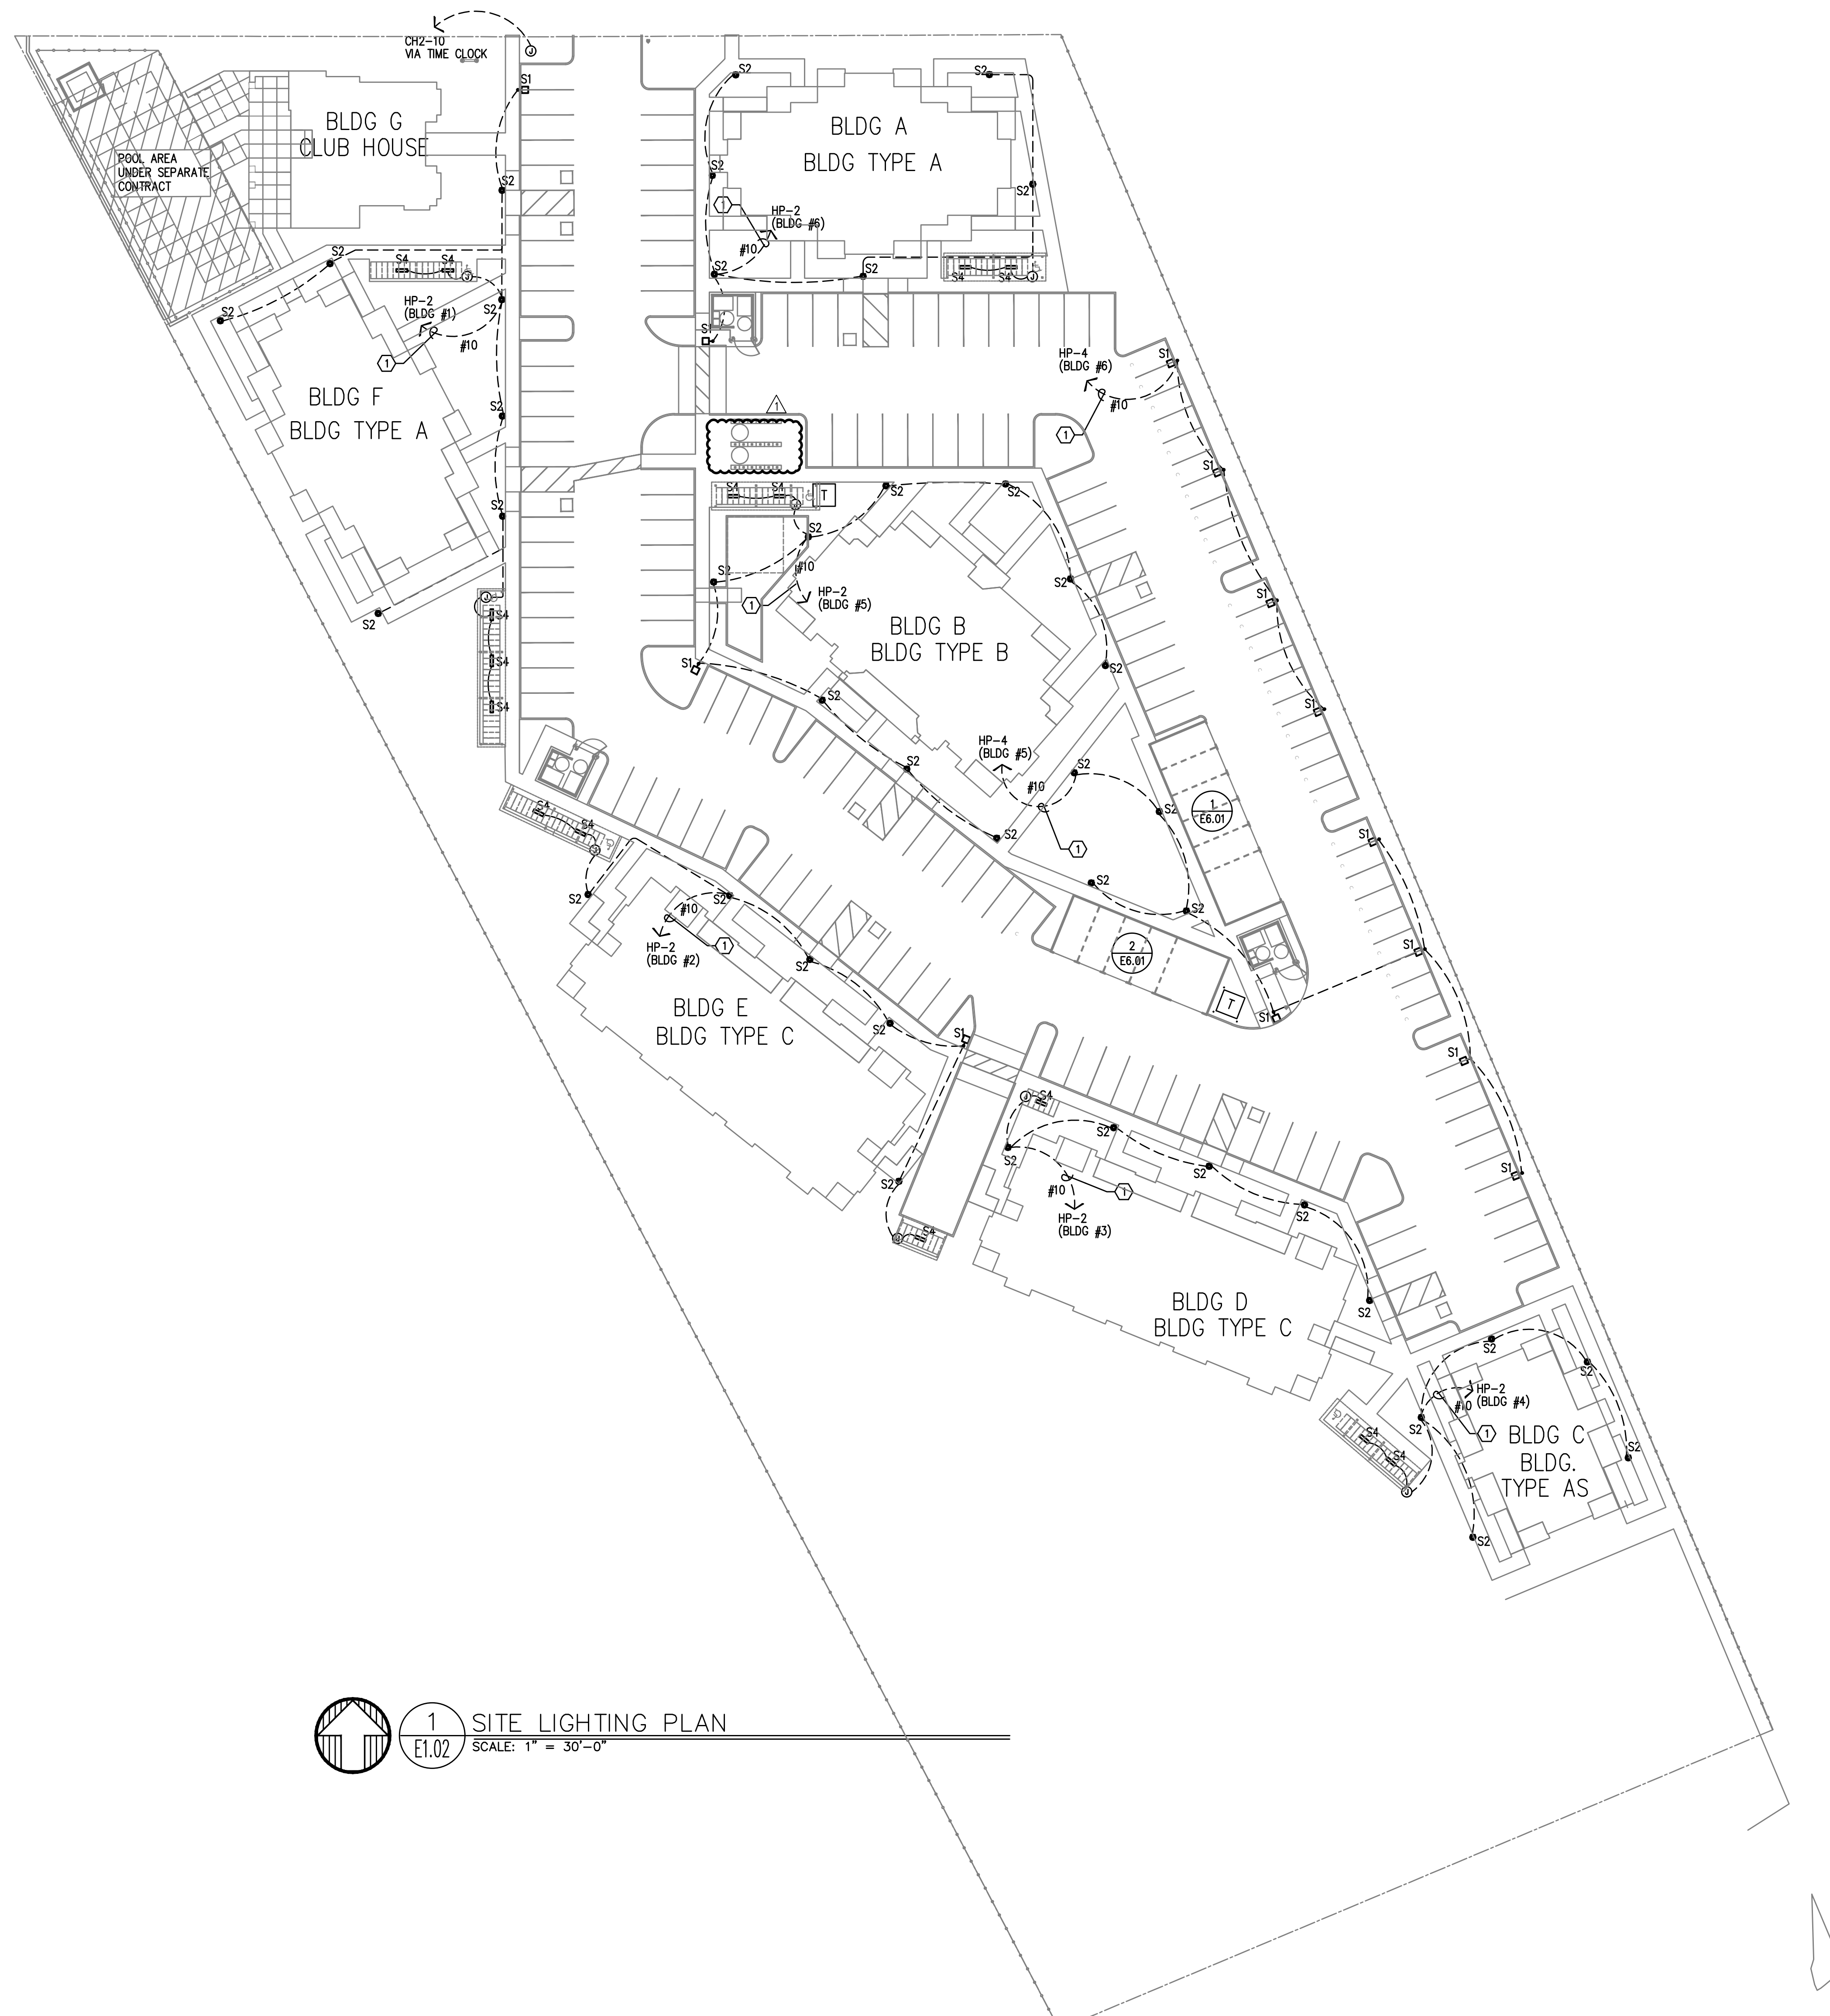

1 SITE LIGHTING PLAN
E1.02 SCALE: 1" = 30'-0"

MCKINNEY LANE APARTMENTS PHASE II
RUSSELL DRIVE & MCKINNEY LANE
LEBANON, OREGON 97331

E1.02

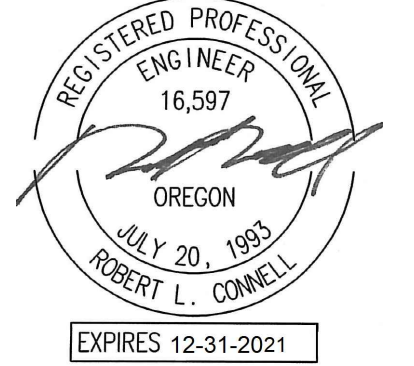

IN THE EVENT CONFLICTS ARE DISCOVERED BETWEEN THE ORIGINAL SIGNED AND SEALED DOCUMENTS PREPARED BY THE ARCHITECTS AND/OR THEIR CONSULTANTS, AND ANY COPY OF THE DOCUMENTS TRANSMITTED BY EMAIL, ELECTRONICALLY OR OTHERWISE, THE ORIGINAL SIGNED AND SEALED DOCUMENTS SHALL GOVERN.

PROJECT # 2019-179

DATE: 28 AUGUST 2020

REVISIONS

PLAN REVIEW 11.03.2020

GENERAL POWER NOTES:

- ELECTRICAL DRAWINGS ARE DIAGRAMMATICAL AND MAY NOT ACCURATELY REFLECT ACTUAL CONSTRUCTION CONDITIONS. THE ELECTRICAL CONTRACTOR SHALL BE RESPONSIBLE FOR COORDINATING THE INSTALLATION OF ALL ELECTRICAL EQUIPMENT, WITH ALL TRADES PRIOR TO AND DURING CONSTRUCTION.
- THE ELECTRICAL CONTRACTOR SHALL REFER TO THE ARCHITECTURAL AND/OR INTERIOR DESIGNER DRAWINGS FOR ALL MOUNTING HEIGHTS AND FINISHES OF DEVICES AND FIXTURES.
- REFER TO SHEET E1.11 FOR ELECTRICAL ONE-LINE DIAGRAM.
- THE CONTRACTOR SHALL CONSULT THE ARCHITECT AND/OR INTERIOR DESIGNER FOR THE EXACT LOCATION OF ALL AMENITY EQUIPMENT & APPLIANCES PRIOR TO THE START OF ANY ROUGH IN WORK.
- REFER TO AVAILABLE ARCHITECTURAL AND/OR INTERIOR DESIGN DOCUMENTS & DRAWINGS FOR ADDITIONAL INFORMATION.
- ELECTRICAL CONTRACTOR TO PROVIDE THERMOSTATS NOT SUPPLIED BY MECHANICAL CONTRACTOR. CONSULT MECHANICAL PLANS FOR ADDITIONAL INFORMATION.
- ELECTRICAL CONTRACTOR SHALL PROVIDE INSTALLATION AND FINAL CONNECTION OF THERMOSTATS. CONSULT MECHANICAL CONTRACTOR FOR EXACT REQUIREMENTS PRIOR TO ROUGH IN.
- PROVIDE ROUGH IN, FOR WIFI SYSTEM, FIRE ALARM DEVICES, TELECOM DEVICES, SECURITY AND AUDIO SYSTEMS AS REQUIRED. REFER TO 'T' SERIES SHEETS FOR ADDITIONAL INFORMATION.


◇ KITCHEN EQUIPMENT KEY:

FOR ADDITIONAL INFORMATION, REFER TO THE INTERIOR DESIGNER'S PLAN SET.

- UNDER COUNTER REFRIGERATOR, PNL CH, CKT 28
- MICROWAVE OVEN, PNL CH, CKT 30
- UNDER COUNTER REFRIGERATOR, PNL CH, CKT 12
- UNDER COUNTER ICE MAKER, PNL CH, CKT 14
- KEGERATOR, PNL CH, CKT 8
- WARMING DRAWER, PNL CH, CKT 16
- MICROWAVE OVEN, PNL CH, CKT 18
- FIREPLACE INSERT, PNL CH, CKT 20
- FLAT SCREEN DISPLAY, PNL CH, CKT 6
- COFFEE MAKER, PNL CH, CKT 22
- PRINTER, PNL CH, CKT 4


◇ KEYED NOTES:

- PROVIDE ONE 20A, 120V, 1P CIRCUIT FROM PANEL CH, CKT 38 FOR AUTOMATIC DOOR OPENERS.
- PROVIDE ONE 20A, 120V, 1P CIRCUIT FOR DRINKING FOUNTAIN FROM PANEL CH, CKT 24. CONSULT MECHANICAL AND/OR PLUMBING CONTRACTOR FOR EXACT ELECTRICAL REQUIREMENTS PRIOR TO ROUGH IN.
- PROVIDE RECEPTACLE WITH TYPES A & C USB PORTS, LEVITON T5633-T OR APPROVED EQUAL.
- CONSULT ARCHITECT AND/OR MECHANICAL PLANS FOR ADDITIONAL INFORMATION REGARDING THE FIREPLACE. PROVIDE ELECTRICAL CONNECTION(S) AS NEEDED FROM PANEL CH, CKT 20. PROVIDE 120V TWIST TIMER SWITCH (MAX. 60 MINUTES, "NO HOLD") FOR FIREPLACE IGNITER CONTROLS. INTERCONNECT WITH POWER VENT LOCATED ON ROOF. SEE DETAIL 4/E1.12 FOR EMERGENCY SHUFF-OFF DIAGRAM.
- PROVIDE (1) 1 1/2" SCHEDULE 40 PVC CONDUIT (EMPTY) WITH PULL STRING, FROM HOUSE PANEL LOCATION TO FUTURE EQUIPMENT SHED FOR FUTURE POOL EQUIPMENT PANEL (100A MAX.) AND CAP AT BOTH ENDS. CONSULT ARCHITECT FOR EXACT LOCATION AND ROUTING. COORDINATE WORK WITH POOL CONTRACTOR.
- PROVIDE ONE 20A, 120V, 1P CIRCUIT FROM PANEL CH, CKT 36 FOR LANDSCAPE EQUIPMENT.
- PROVIDE ONE 20A, 120V, 1P CIRCUIT TO A WEATHER PROOF J-BOX IN THE GRILL CABINET, TIED INTO CIRCUIT CH-15, FOR GRILL LIGHT CONNECTION. COORDINATE LOCATION WITH THE LANDSCAPE DESIGNER PRIOR TO ROUGH IN.
- PROVIDE ONE 120V TWIST TIMER SWITCH (MAX. 60 MINUTES, "NO HOLD") IN WEATHER PROOF BOX AT EACH GAS GRILL FOR IGNITER CONTROLS. CIRCUIT FROM PANEL 'CH2'. SEE DETAIL 4/E1.12 FOR EMERGENCY SHUFF-OFF DIAGRAM.
- PROVIDE EMERGENCY SHUTOFF CONTROLS FOR GAS APPLIANCES LOCATED ON TERRACE. COORDINATE INSTALLATION WITH MECHANICAL CONTRACTOR. CIRCUIT FROM PANEL 'CH2'. SEE DETAIL 4/E1.12 FOR EMERGENCY SHUFF-OFF DIAGRAM. PROVIDE WEATHER PROOF LABEL EACH BUTTON WITH DEVICE IT CONTROLS.
- MOUNT WEATHER PROOF GFCI RECEPTACLE NEAR THE BOTTOM SIDE OF THE PERGOLA FOR OWNER INSTALLED STRING LIGHTS.
- PROVIDE ONE 20A, 120V, 1P CIRCUIT FROM PANEL CH, FOR ACCESS CONTROL. REFER TO THE TELECOM PLANS FOR ADDITIONAL INFORMATION & COORDINATE INSTALLATION.

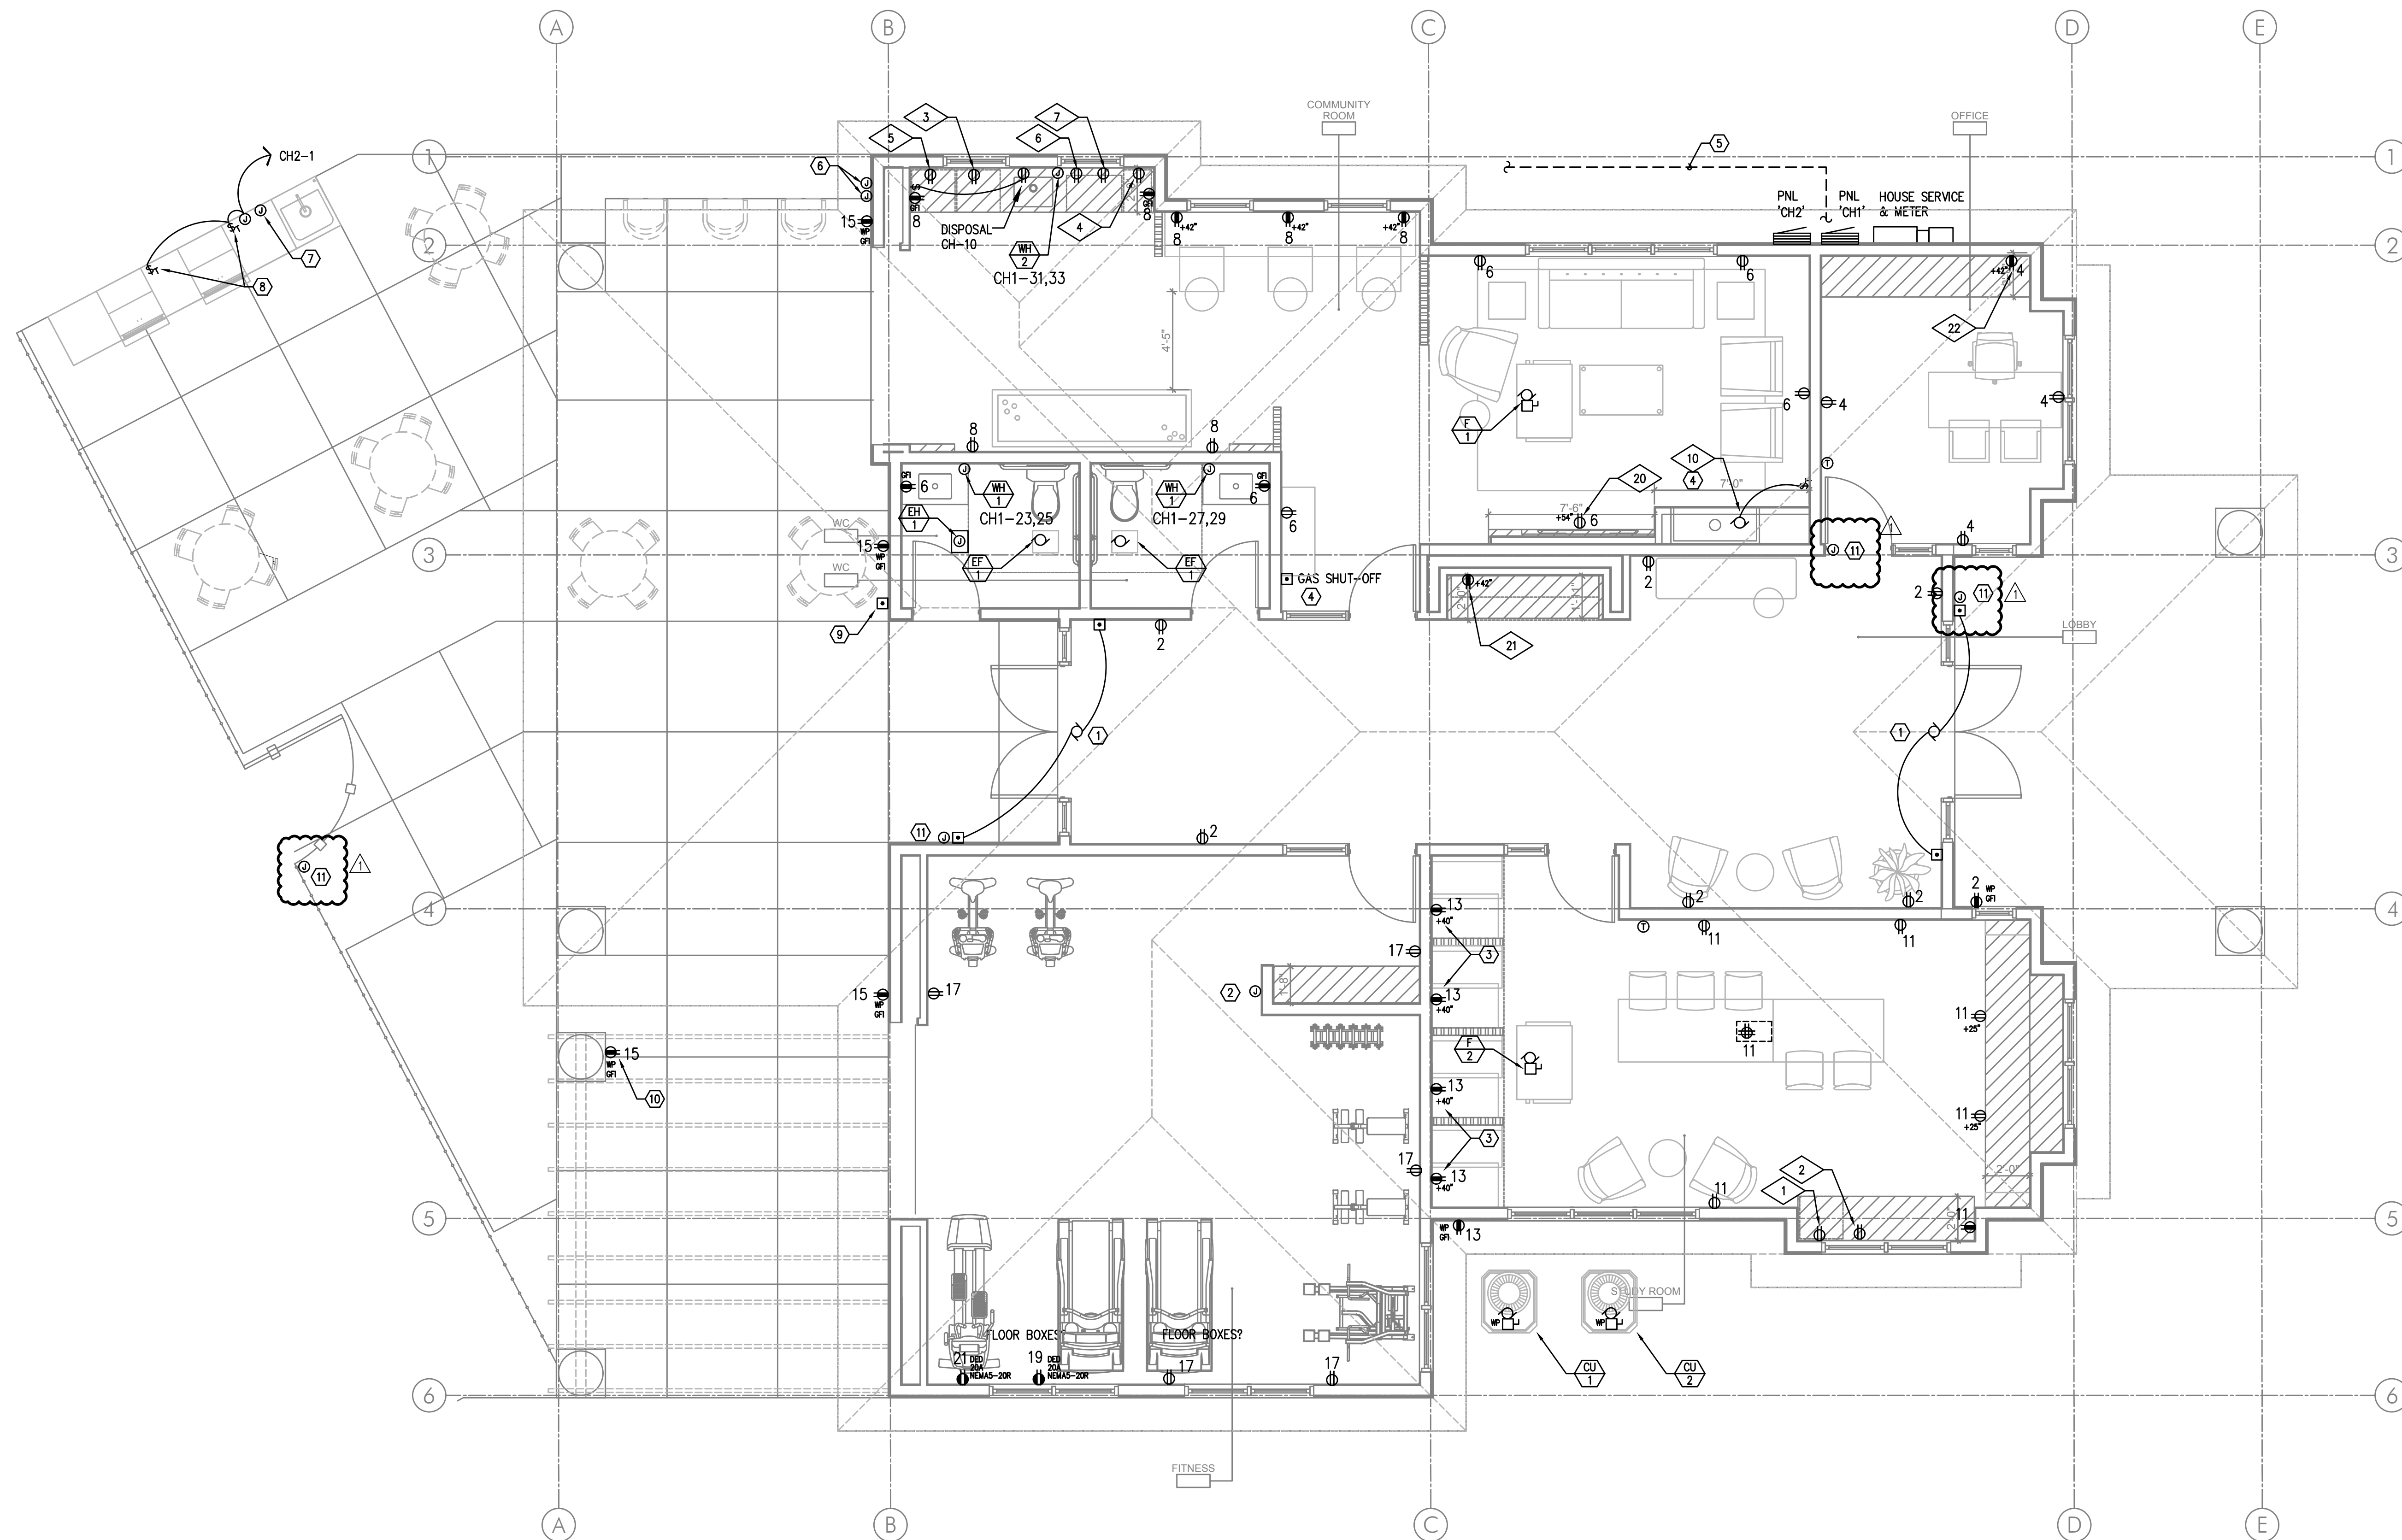

1 CLUBHOUSE POWER PLAN
E5.02 SCALE: 1/4" = 1'-0"

MCKINNEY LANE APARTMENTS PHASE II
RUSSELL DRIVE & MCKINNEY LANE
LEBANON, OREGON

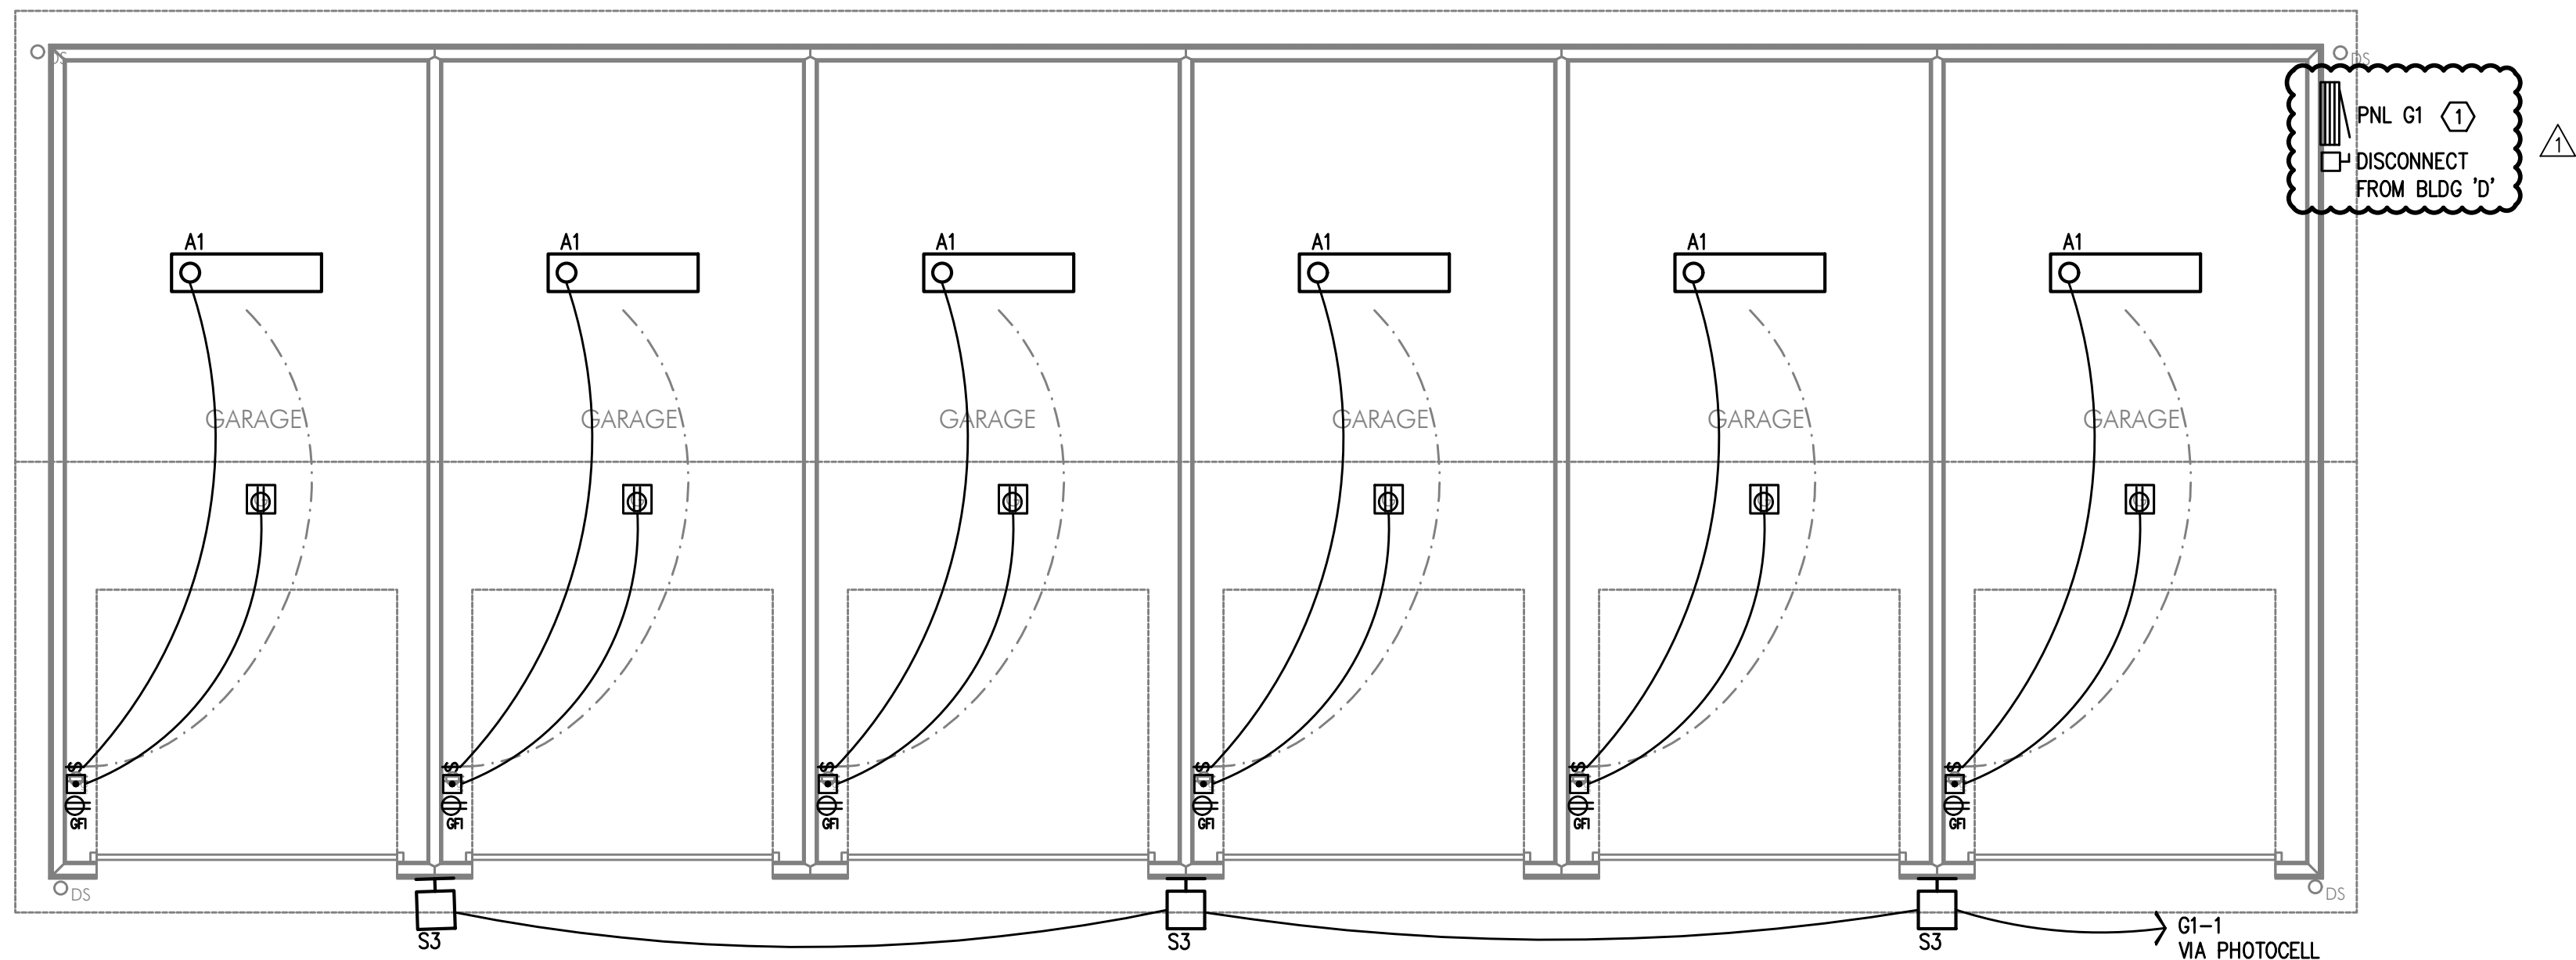


1 TYPICAL GARAGE ELECTRICAL PLAN
E6.01 SCALE: 1/4" = 1'-0"

GENERAL POWER NOTES:

- ELECTRICAL DRAWINGS ARE DIAGRAMMATICAL AND MAY NOT ACCURATELY REFLECT ACTUAL CONSTRUCTION CONDITIONS. THE ELECTRICAL CONTRACTOR SHALL BE RESPONSIBLE FOR COORDINATING THE INSTALLATION OF ALL ELECTRICAL EQUIPMENT, WITH ALL TRADES PRIOR TO AND DURING CONSTRUCTION.
- THE ELECTRICAL CONTRACTOR SHALL REFER TO THE ARCHITECTURAL AND/OR INTERIOR DESIGNER DRAWINGS FOR ALL MOUNTING HEIGHTS AND FINISHES OF DEVICES AND FIXTURES.
- REFER TO SHEET E1.11 FOR ELECTRICAL ONE-LINE DIAGRAM.
- THE CONTRACTOR SHALL CONSULT THE ARCHITECT AND/OR INTERIOR DESIGNER FOR THE EXACT LOCATION OF ALL AMENITY EQUIPMENT & APPLIANCES PRIOR TO THE START OF ANY ROUGH IN WORK.
- REFER TO AVAILABLE ARCHITECTURAL AND/OR INTERIOR DESIGN DOCUMENTS & DRAWINGS FOR ADDITIONAL INFORMATION.
- ELECTRICAL CONTRACTOR TO PROVIDE THERMOSTATS NOT SUPPLIED BY MECHANICAL CONTRACTOR. CONSULT MECHANICAL PLANS FOR ADDITIONAL INFORMATION.
- ELECTRICAL CONTRACTOR SHALL PROVIDE INSTALLATION AND FINAL CONNECTION OF THERMOSTATS. CONSULT MECHANICAL CONTRACTOR FOR EXACT REQUIREMENTS PRIOR TO ROUGH IN.
- ELECTRICAL CONTRACTOR SHALL COORDINATE WITH THE LOW VOLTAGE ("T" SERIES) PLANS, INCLUDING FIRE ALARM AND SYSTEMS INSTALLER, AND PROVIDE ROUGH IN AS NEEDED.

KEYED NOTES:

- GARAGE PANELS ARE TO BE NEMA 3R WITH LOCKING COVER. GARAGES ARE FED FROM THE HOUSE PANEL AT BUILDING XX. PROVIDE xxa WEATHER PROOF DISCONNECT AHEAD OF THE PANEL AS SHOWN.

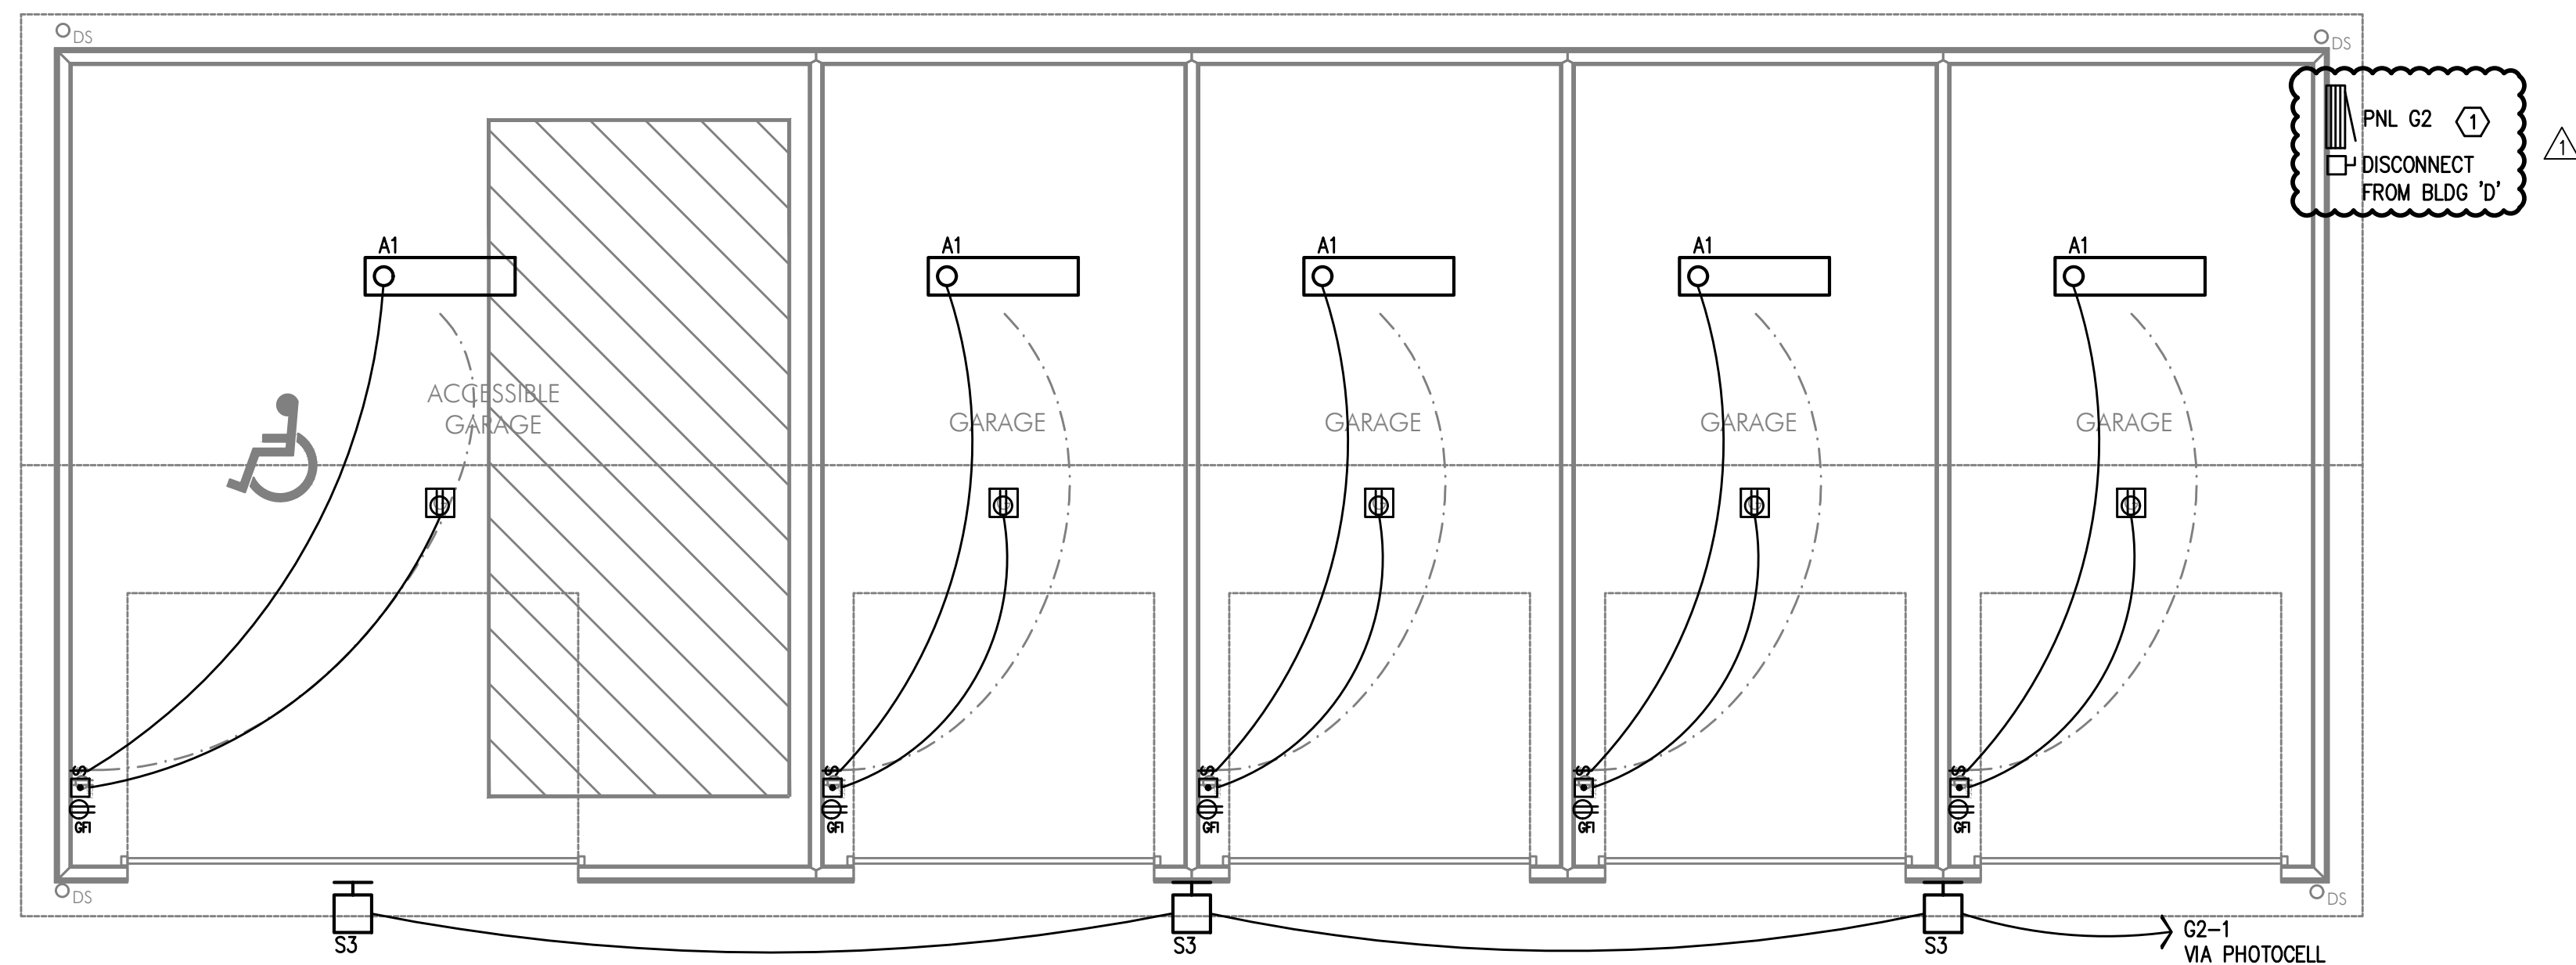

2 TYPICAL ADA GARAGE ELECTRICAL PLAN
E6.01 SCALE: 1/4" = 1'-0"




1 PARKING AREA PHOTOMETRIC STUDY
E1.03
SCALE: 1" = 30'-0"

LUMINAIRE SCHEDULE									
Symbol	Label	Qty	Catalog Number	Description	Lamp	File	Lumens	LLF	Watts
	S1	13	AA-20166-1-W30-Rev 2	Atlantic shepherds crook single medium shade post top LED	1 LED COB 3000K 0.4247/0.3936 3130K Ra84	S1 AA-20166-1-W30-Rev 2 IES	Absolute	1.00	41.2
	S2	40		photopiaALMINRF-L18-VF20photopia	LED 0.959W XLAMP OUTDOOR WHITE (350MA) (CORE ONLY)	S2 NRF-LE070-L18-30-CNS-VF20-UL3-IES	Absolute	1.00	70
	S3	5	AA-30186-1-W30-Rev 2	Atlantic shepherds crook medium shade wall light LED	1 LED COB 3000K 0.4247/0.3936 3130K Ra84	S3 AA-30186-1-W30-Rev 2 IES	Absolute	1.00	41.2
	S4	17	FEM L48 3000LM LPPFL PGD 90CRI 30K	FEM LED 48", 3,000 lumens, polycarbonate, low profile frosted lens, parking garage distribution, 90 CRI, 3000 K		S4 FEM_L48_3000LM_LPPFL_PGD_90CRI_30K IES	Absolute	1.00	18.05

STATISTICS						
Description	Symbol	Avg	Max	Min	Max/Min	Avg/Min
Parking 1	+	0.9 fc	3.8 fc	0.2 fc	19.0:1	4.5:1
Parking 2	+	0.9 fc	4.4 fc	0.2 fc	22.0:1	4.5:1
Parking 3	+	0.8 fc	3.8 fc	0.2 fc	19.0:1	4.0:1
Parking 4	+	1.2 fc	8.5 fc	0.3 fc	28.3:1	4.0:1
Parking 5	+	0.6 fc	2.1 fc	0.2 fc	10.5:1	3.0:1

- NOTES:
1. Photometric studies are for reference only and shall not be used for construction purposes. Refer to the electrical site plan sheet, E1.02 for additional information.
 2. Photometric data is based on manufacturer provided IES files. Illuminance calculations are approximate and may differ from actual field measurements.
 3. Refer to Light Fixture Schedule on sheet E1.21 for fixture type, lamp, and pole heights.
 4. Data does not factor in existing light fixtures on adjacent properties or at the street.
 5. For the purposes of this study, areas with "0.0" lumen levels have been masked to provide the statistics shown in the table.
 6. This study does not factor in building mounted light fixtures (other than those at the garages).

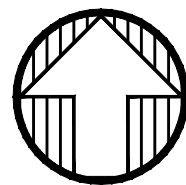

1 PEDESTRIAN AREAS PHOTOMETRIC STUDY
E1.04 SCALE: 1" = 30'-0"

LUMINAIRE SCHEDULE									
Symbol	Label	Qty	Catalog Number	Description	Lamp	File	Lumens	LLF	Watts
	S1	13	AA-20166-1-W30-Rev.2	Atlantic sheppards crook single medium shade post top LED	1 LED COB 3000K 0.4247 0.3936 3130K Ra84	S1 AA-20166-1-W30-Rev.2 IES	Absolute	1.00	41.2
	S2	41		photopiaALMRF-L18-YF2photopia	LED 0.959W XLAMP OUTDOOR WHITE (350MA) (CORE ONLY)	S2 NRRF-LE070-418-30-CNS-V720-UE3.98	Absolute	1.00	70
	S3	5	AA-30166-1-W30-Rev.2	Atlantic sheppards crook medium shade wall light LED	1 LED COB 3000K 0.4247 0.3936 3130K Ra84	S3 AA-30166-1-W30-Rev.2 IES	Absolute	1.00	41.2
	S4	17	FEM L48 3000LM LPFLL PCGD 90CRI 30K	FEM LED 48", 3000 lumens, polycarbonate, low profile frosted lens, parking garage distribution, 90 CRI, 3000 K		S4 FEM L48-300 OLM LPFLL_P 90CRI_30 K ies	Absolute	1.00	18.05

STATISTICS						
Description	Symbol	Avg	Max	Min	Max/Min	Avg/Min
Blgd 5 & Grounds	+	2.3 fc	6.6 fc	0.3 fc	22.0:1	7.7:1
Blgd 6 Walks	+	2.2 fc	4.9 fc	0.2 fc	24.5:1	11.0:1
Blgd #2, 3, 4	+	2.4 fc	6.0 fc	0.2 fc	30.0:1	12.0:1
Clubhouse/Blgd #1 Walks	+	2.3 fc	5.0 fc	0.4 fc	12.5:1	5.8:1

- NOTES:
1. Photometric studies are for reference only and shall not be used for construction purposes. Refer to the electrical site plan sheet, E1.02 for additional information.
 2. Photometric data is based on manufacturer provided IES files. Illuminance calculations are approximate and may differ from actual field measurements.
 3. Refer to Light Fixture Schedule on sheet E1.21 for fixture type, lamp, and pole heights.
 4. Data does not factor in existing light fixtures on adjacent properties or at the street.
 5. For the purposes of this study, areas with "0.0" lumen levels have been masked to provide the statistics shown in the table.
 6. This study does not factor in building mounted light fixtures (other than those at the garages).

FEEDER SCHEDULE (COPPER)					
NO.	AMPS	CONDUIT	CONDUCTOR		
1		*(5) 4"	BY UTILITY CO.	& (1)	GND
2	1200A	4"	ea w/ (3) #600Kcmil	& (1) #3/0	GND
3	800A	4"	ea w/ (3) #600Kcmil	& (1) #1/0	GND
4	400A	3"	ea w/ (3) #500Kcmil	& (1) #3	GND
5	125A	1 1/2"	(3) #1	& (1) #6	GND
6	100A	1 1/2"	(3) #1	& (1) #8	GND
7	60A	1"	(3) #4	& (1) #10	GND

* PARALLEL FEEDER

ONE-LINE GENERAL NOTES:

A. COORDINATE ALL WORK ASSOCIATED WITH ELECTRIC SERVICE WITH LOCAL UTILITY. PROVIDE ALL CONDUIT & CONDUCTORS, GROUNDING, TRANSFORMER VAULT/PAD, ETC., IN ACCORDANCE WITH SERVING UTILITY REQUIREMENTS.

B. COORDINATE METERING REQUIREMENTS WITH UTILITY.

C. FOR LOAD CENTER FEEDER LENGTHS GREATER THAN 145'-0" FROM METER CENTER, INCREASE WIRE SIZE ONE SIZE UP FOR VOLTAGE DROP.






ONE-LINE KEYED NOTES:

① GARAGES SUB-FED FROM BUILDING #3 ONLY.

MFA PANEL SCHEDULE										29-Oct-20
panel	mounting	location	connected load							
Pnl HP (Typical)	Surface NEMA 3R	8Bq Exterior bus & main	calculated load		40					
voltage	120/240V									
C	service	va	o/p	no.	L1	L2	no.	o/p	va	
1	LTS & RECEPT - BLDG EXTERIOR	500	20/1	1	*	4	20/1	1440	LIGHTING - SITE	
3	BT-H - RISER ROOM	500	20/1	5	*	4	20/1	720	LIGHTING - SITE	
	SPARE		20/1	5	*	6	20/1	1080	SPARE	
7	*GARAGE #1	3000	60/2	9	*	10	60/2	1260	SPARE	
		1500	*	11	*	12	*	1500	*#GARAGE #2	
	BLANK			13	*	14			BLANK	
	BLANK			15	*	16			BLANK	
	BLANK			17	*	18			BLANK	
	BLANK			19	*	20			BLANK	
	BLANK			21	*	22			BLANK	
	BLANK			23	*	24			BLANK	
	BLANK			25	*	26			BLANK	
	BLANK			27	*	28			BLANK	
	BLANK			29	*	30			BLANK	
	BLANK			31	*	32			BLANK	
	BLANK			33	*	34			BLANK	
	BLANK			35	*	36			BLANK	
	BLANK			37	*	38			BLANK	
	BLANK			39	*	40			BLANK	
	BLANK			41	*	42			BLANK	
Line 1	6000 VA	NOTES:								
Line 2	3500 VA	PROVIDE PANEL WITH COOLING COILS.								
		"MELDC D" PANEL ONLY.								
Total Connected	9500 VA	largest motor (va)							240	
load code:	line 1	line 2			total		factor		calculated load (va)	
1. LIGHTS=	0	0	VA	0	1.25				0	
2. RECEPT=	0	0	VA	0	0.8 + 0.5				0	
3. HEATING=	0	500	VA	500	1.00				500	
4. KITCHEN=	0	0	VA	0	*				0	
5. EQUIP=	0	0	VA	0	1.00				0	
6. MOTORS=	0	0	VA	0	*				0	
7. SUB-PANEL=	6000	3000	VA	9000	1.00				9000	
(* 125% of the largest motor + 100% of the balance)										
			TOTAL =		9500					

MFA PANEL SCHEDULE										29-Oct-20	
panel CH1 (CLUBHOUSE)		mounting Surface NEMA 3R		location		BUILDING EXTERIOR		connected load		259	
voltage 120/240V		service		400A		M.L.O.		calculated load		262	
C	service	va	o/p no.	L1	L2	no.	o/p no.	va	service	262	
1	LIGHTS - SITE	531	20/1	3	*	2	20/1	1440	RECEPTACLES		
1	LIGHTS - BLDG EXTERIOR	990	20/1	5	*	4	20/1	720	RECEPTACLES		
1	LIGHTS - INTERIOR	136	20/1	7	*	6	20/1	1080	RECEPTACLES		
1	LIGHTS - INTERIOR	780	20/1	9	*	10	20/1	1260	RECEPT & #6 REG COOLER		
1	LIGHTS - INTERIOR	1440	20/1	11	*	12	20/1	900	DISPOSAL		
2	RECEPTACLES	900	20/1	13	*	14	20/1	1500	UC ICE MAKER #4		
2	RECEPTACLES	900	20/1	15	*	16	20/1	1500	WARMING DRAWER #5		
2	RECEPTACLES	900	20/1	17	*	18	20/1	1500	MICROWAVE #1		
5	HEADMILL	1500	20/1	19	*	20	20/1	1500	FIRE PLACE & SHUT OFF		
5	HEADMILL	1500	20/1	21	*	22	20/1	1500	COFFEE MAKER #20		
3	WATER HEATER WH-1	1500	20/2	23	*	24	20/1	1500	WATER FOUNTAIN		
3	WATER HEATER WH-1	1500	20/2	25	*	26	20/1	1500	ACCESS CONTROL SYSTEM		
3	WATER HEATER WH-1	1500	20/2	27	*	28	20/1	1500	UC FRIDGE #1		
3	WATER HEATER WH-1	1500	20/2	29	*	30	20/1	0	SPARE		
3	WATER HEATER WH-2	1000	20/2	31	*	32	20/1	0	SPARE		
3	WATER HEATER WH-2	1000	20/2	33	*	34	20/1	0	SPARE		
SPARE		0	20/1	35	*	36	20/1	0	SPARE		
SPARE		0	20/1	37	*	38	20/1	0	SPARE		
7	SPARE (FUTURE POOL PANEL)	0	100/2	39	*	40	100/2	13644	PANEL CH2		
7	SPARE (FUTURE POOL PANEL)	0	100/2	41	*	42	100/2	10644	*		
Line 1	30634 VA								line-line voltage		240
Line 2	31633 VA								largest motor (va)		240
Total Connected		62267 VA						calculated load (va)			
load code:		line 1		line 2				total factor			
1.	LIGHTS=	1770	669					2439	1.25	3049	
2.	RECEPT=	4320	4320					8640	1.0	8640	
3.	HEATING=	4000	4000					8000	1.0	8000	
4.	KITCHEN=	0	0					0	1.00	0	
5.	EQUIP=	9000	9000					18000	1.00	18000	
6.	MOTORS=	0	0					0	1.0	0	
7.	SUB-PANEL=	10644	13644					24288	1.00	24288	
(* 125% of the largest motor + 100% of the balance)										TOTAL = 62267	


MFA PANEL SCHEDULE										25-Aug-20
panel			mounting		location		connected load			
PANEL CH2 (CLUBHOUSE)			Surface NEMA 3R		BUILDING EXTERIOR		calculated load			
voltage			phone		bus		M.L.O.			
120/240V			1		125A		100			
C	service	va	o/p	no.	L1	L2	no.	o/p	va	
5	F-1	1356	20/1	3	*	2	20/1	1500	FA/TELECOM	
3	CU-1	3144	40/2	5	*	4	20/1	1500	SECURITY	
6	F-2	3144	40/2	7	*	6	20/1	1500	IRRIGATION	
3	CU-2	1356	20/1	9	*	10	20/1	1500	AUTO DOORS	
6	F-3	3144	40/2	11	*	12	20/1	1500	MONUMENT SIGN	
6	CU-2	3144	40/2	13	*	14	20/1	0	SPARE	
	SPARE		20/1	15	*	16	20/1	0	SPARE	
	BLANK			17	*	18			BLANK	
	BLANK			19	*	20			BLANK	
	BLANK			21	*	22			BLANK	
	BLANK			23	*	24			BLANK	
	BLANK			25	*	26			BLANK	
	BLANK			27	*	28			BLANK	
	BLANK			29	*	30			BLANK	
	BLANK			31	*	32			BLANK	
	BLANK			33	*	34			BLANK	
	BLANK			35	*	36			BLANK	
	BLANK			37	*	38			BLANK	
	BLANK			39	*	40			BLANK	
	BLANK			41	*	42			BLANK	
Line 1	13644 VA								line-line voltage	
Line 2	10644 VA								largest motor (va)	
					PROVIDE PANEL WITH LOOSING COVER.				240	
Total Connected		24288 VA								
load code:		line 1	line 2				total	factor	calculated load (va)	
1. LIGHTS=	0	0					0	1.25	0	
2. RECEPT=	0	0					0	0.1 + 0.5	0	
3. HEATING=	1356	1356					2712	1.00	2712	
4. KITCHEN=	0	0					VA	0.100	0	
5. EQUIP=	6000	3000					9000	1.00	9000	
6. MOTORS=	6288	6288					VA	12576 *	12576	
7. SUB-PANEL=	0	0					VA	0.100	0	
(* 125% of the largest motor + 100% of the balance)										
24288										

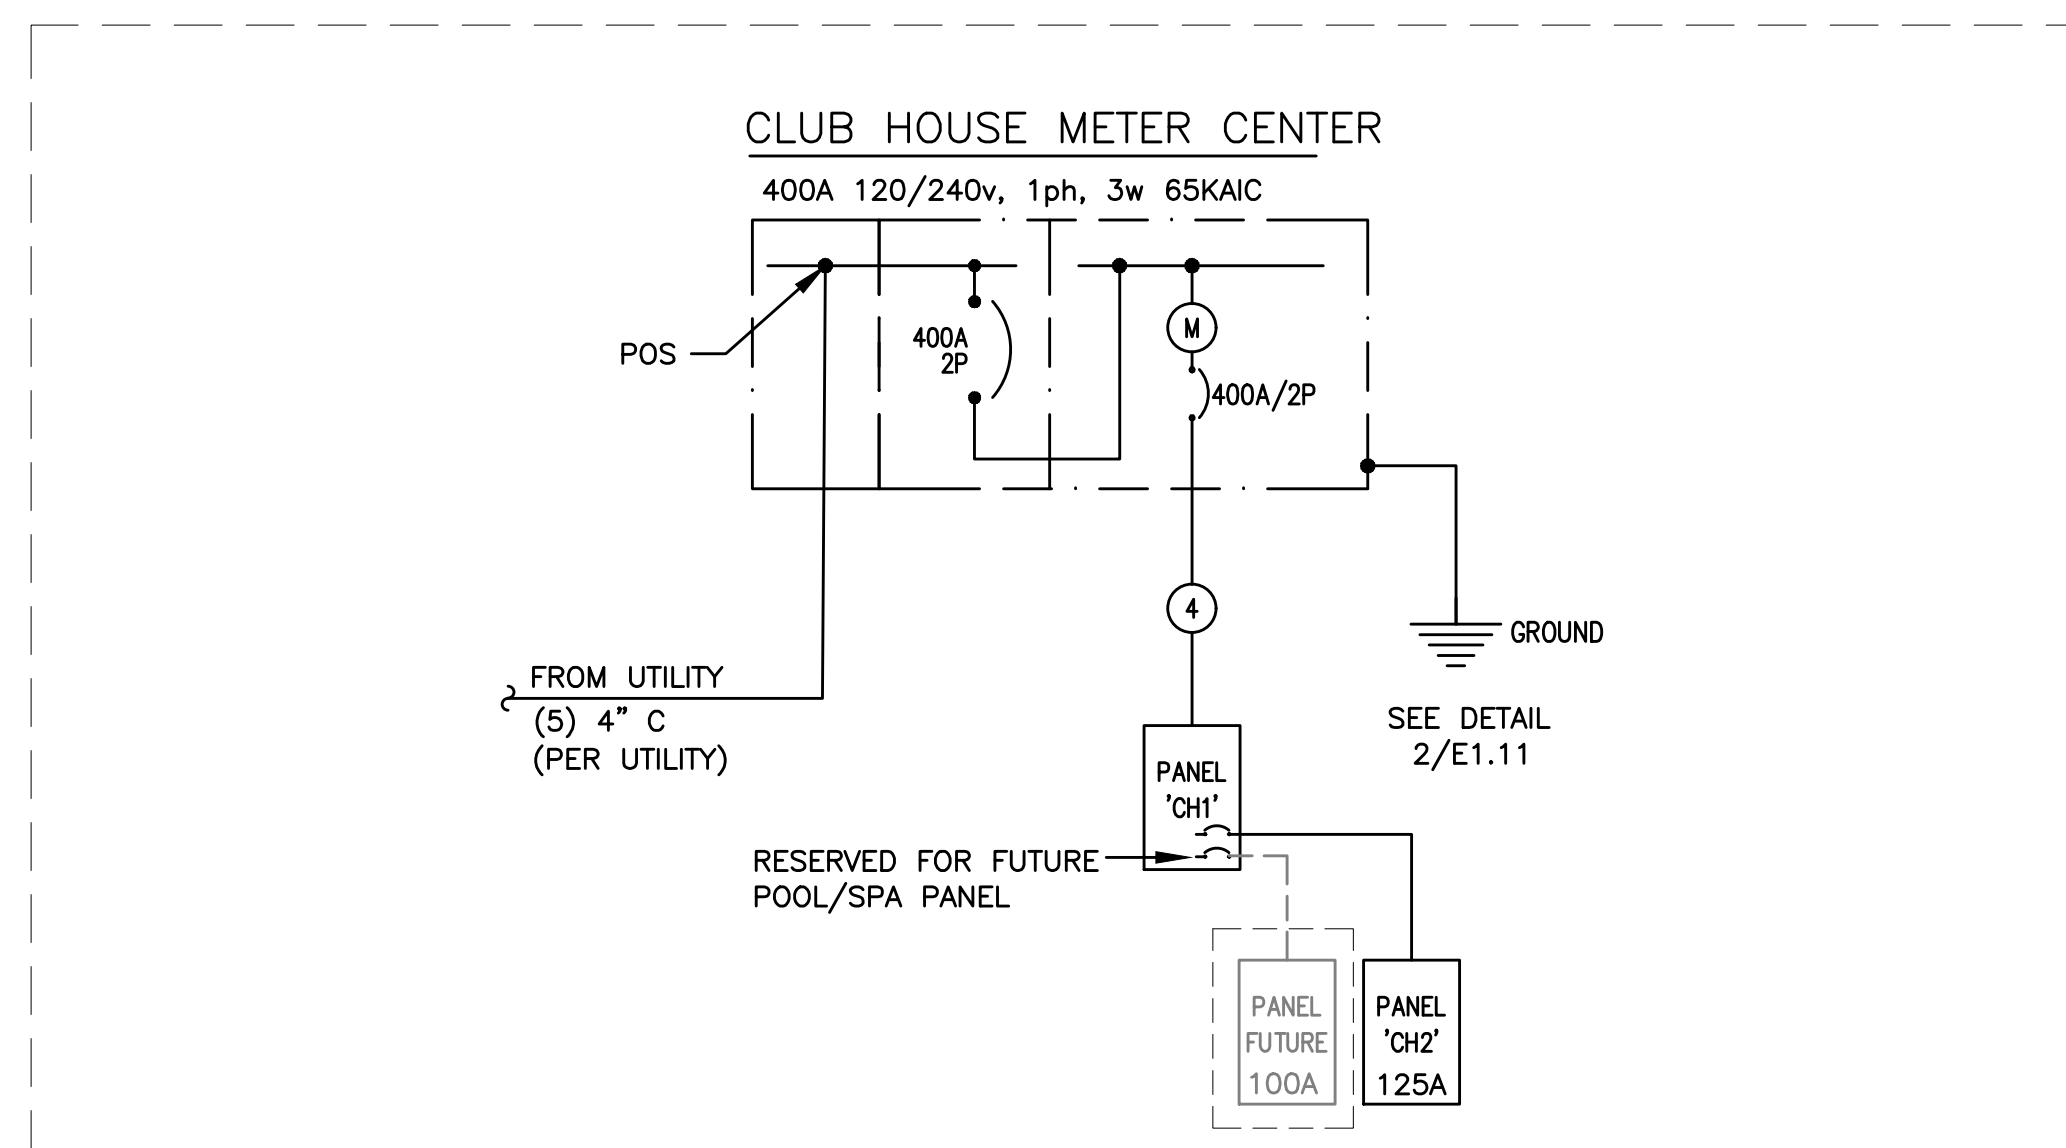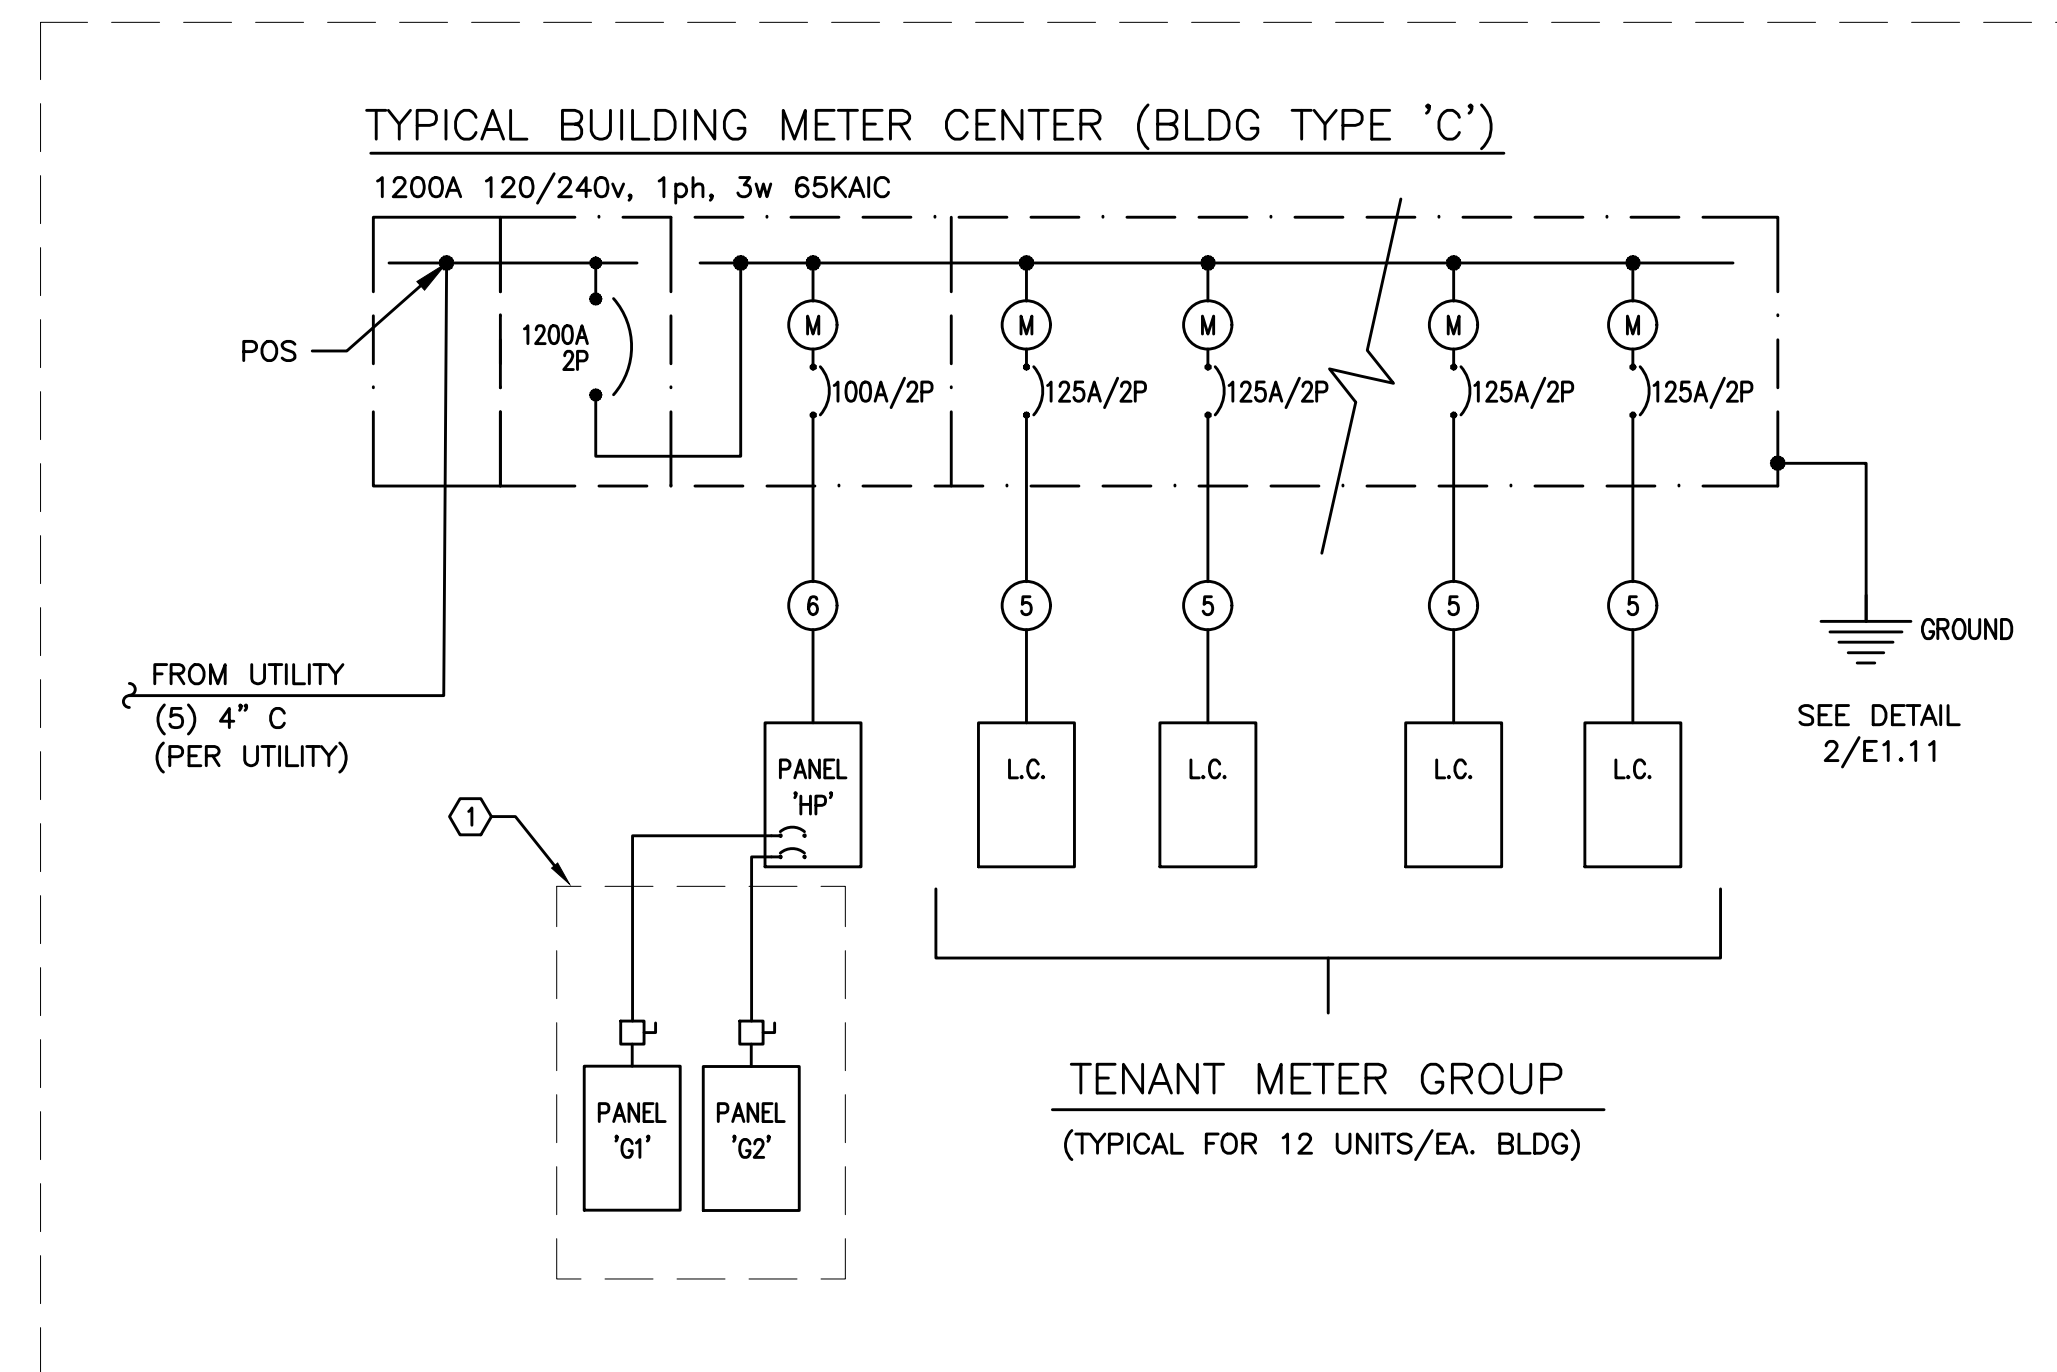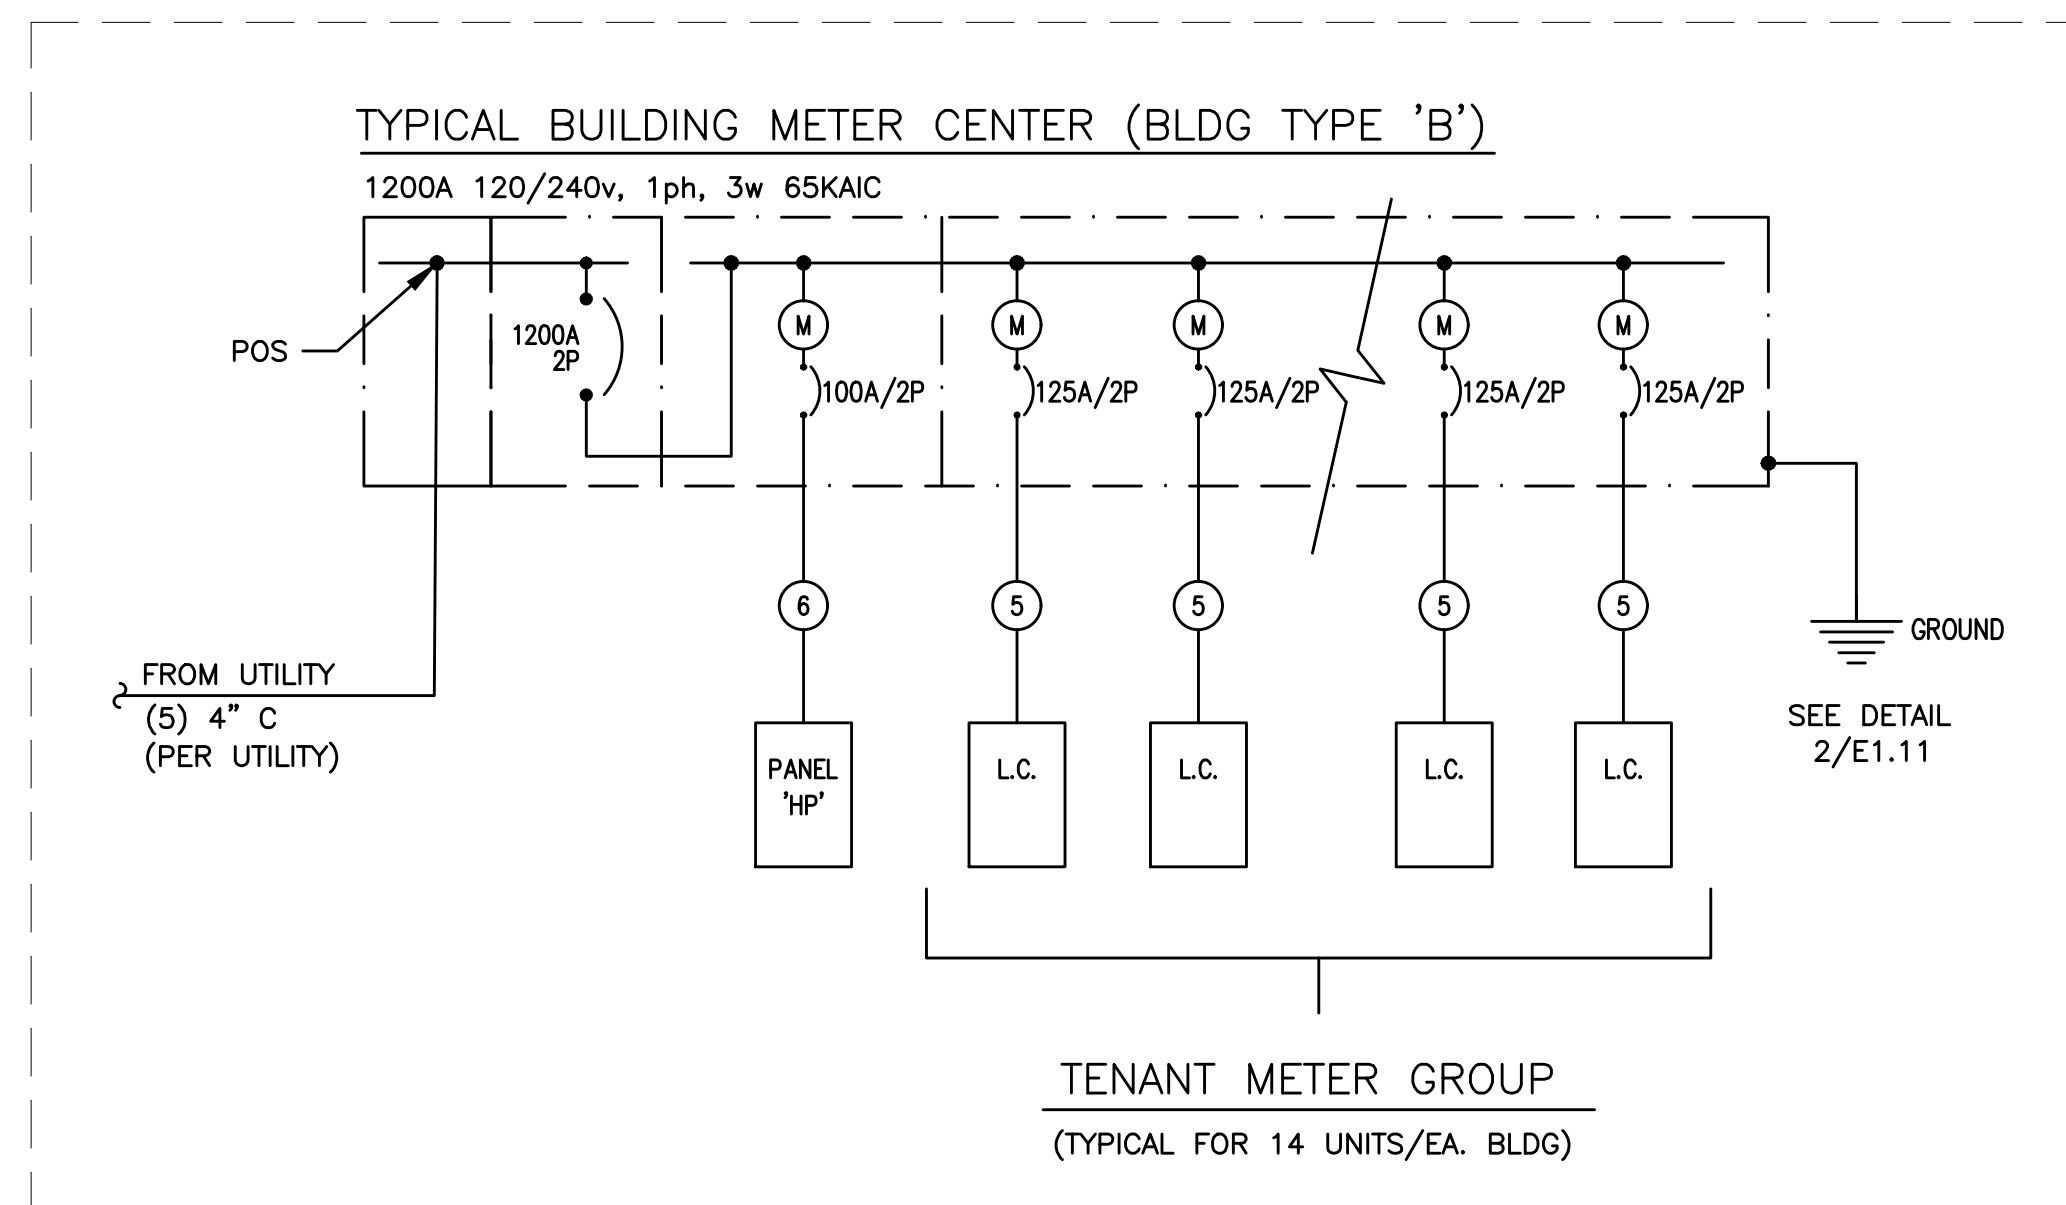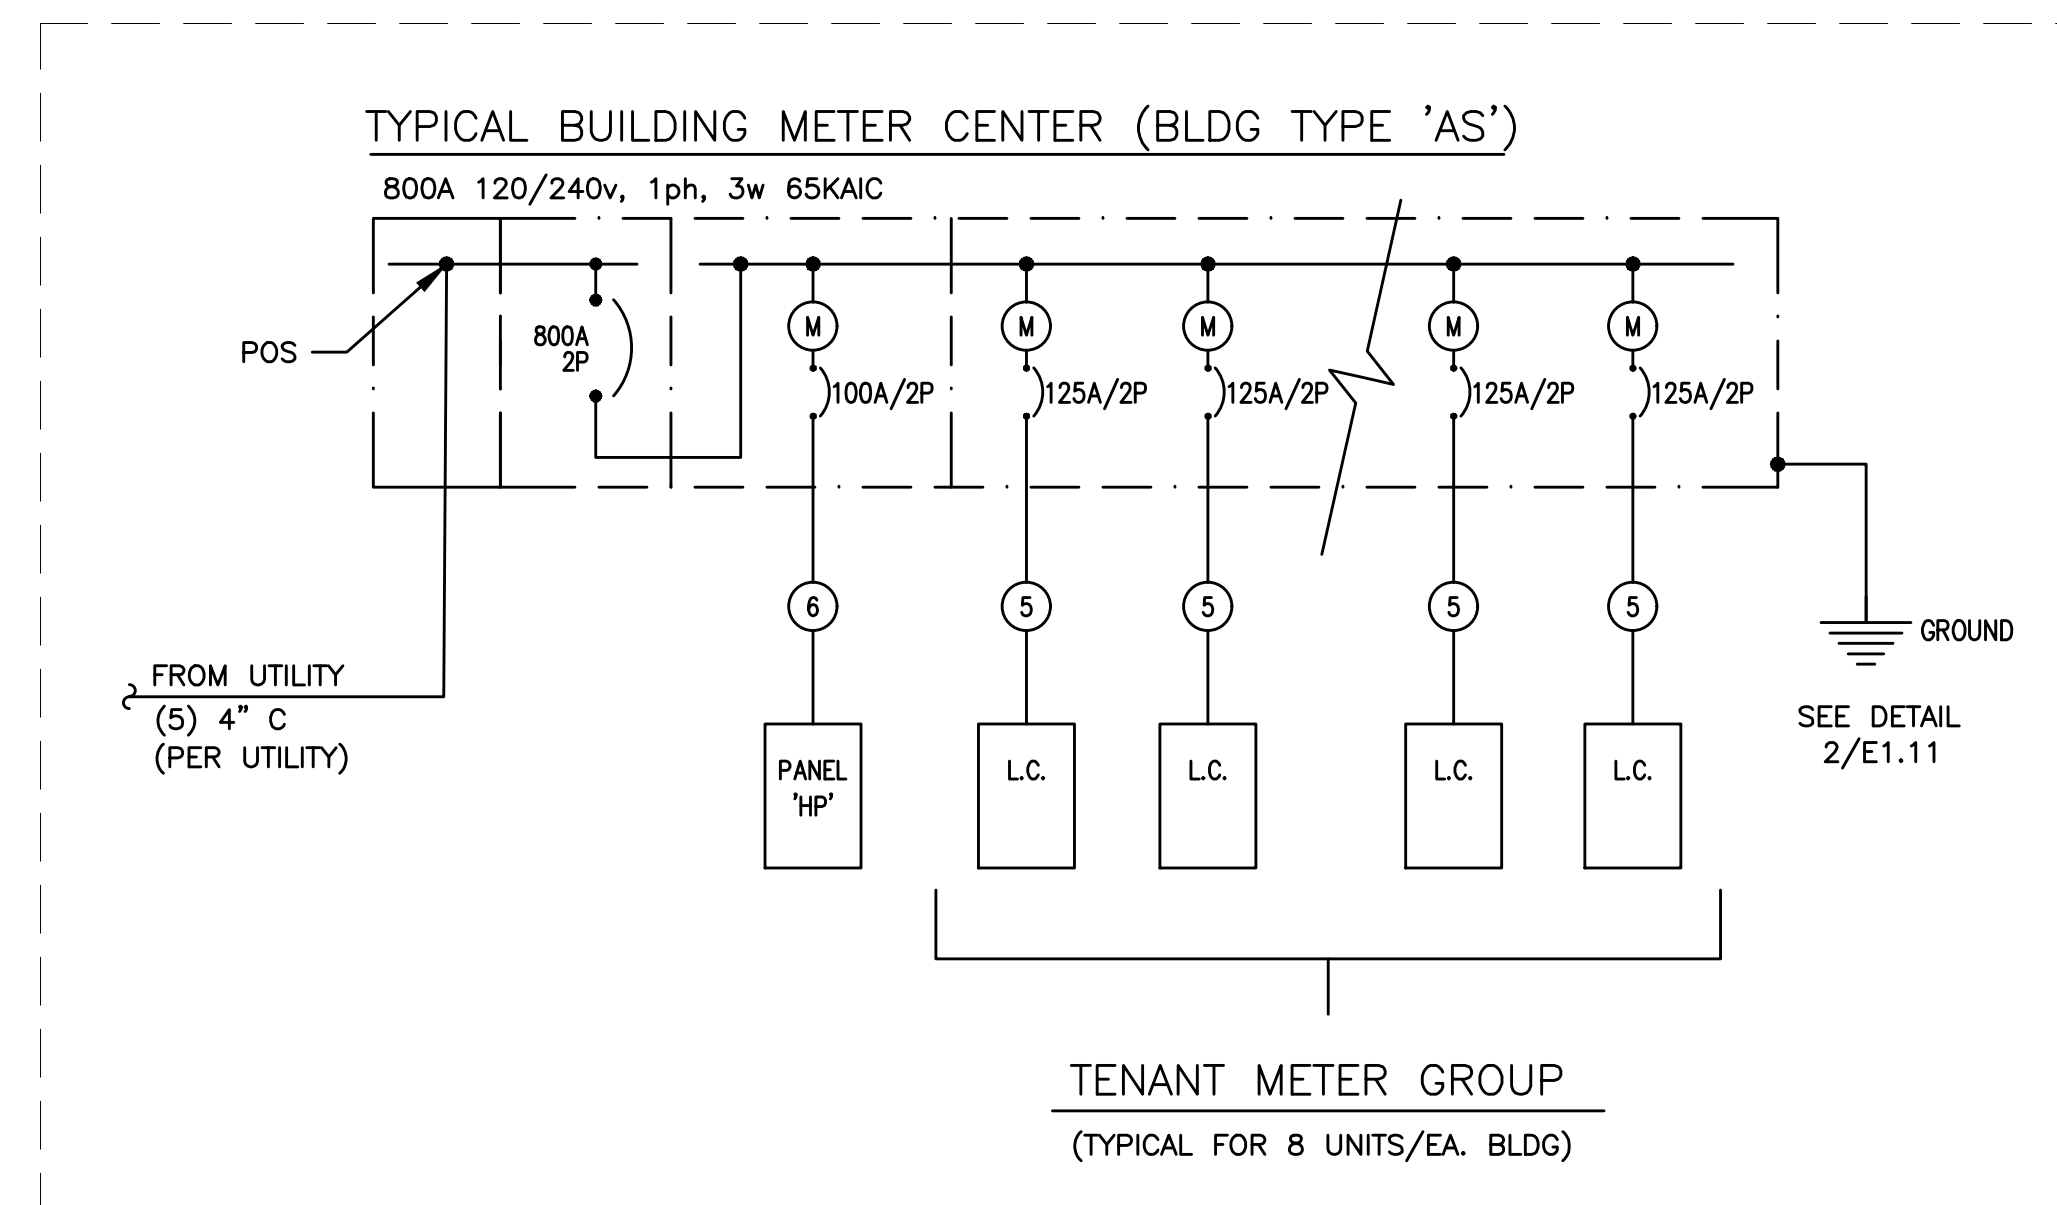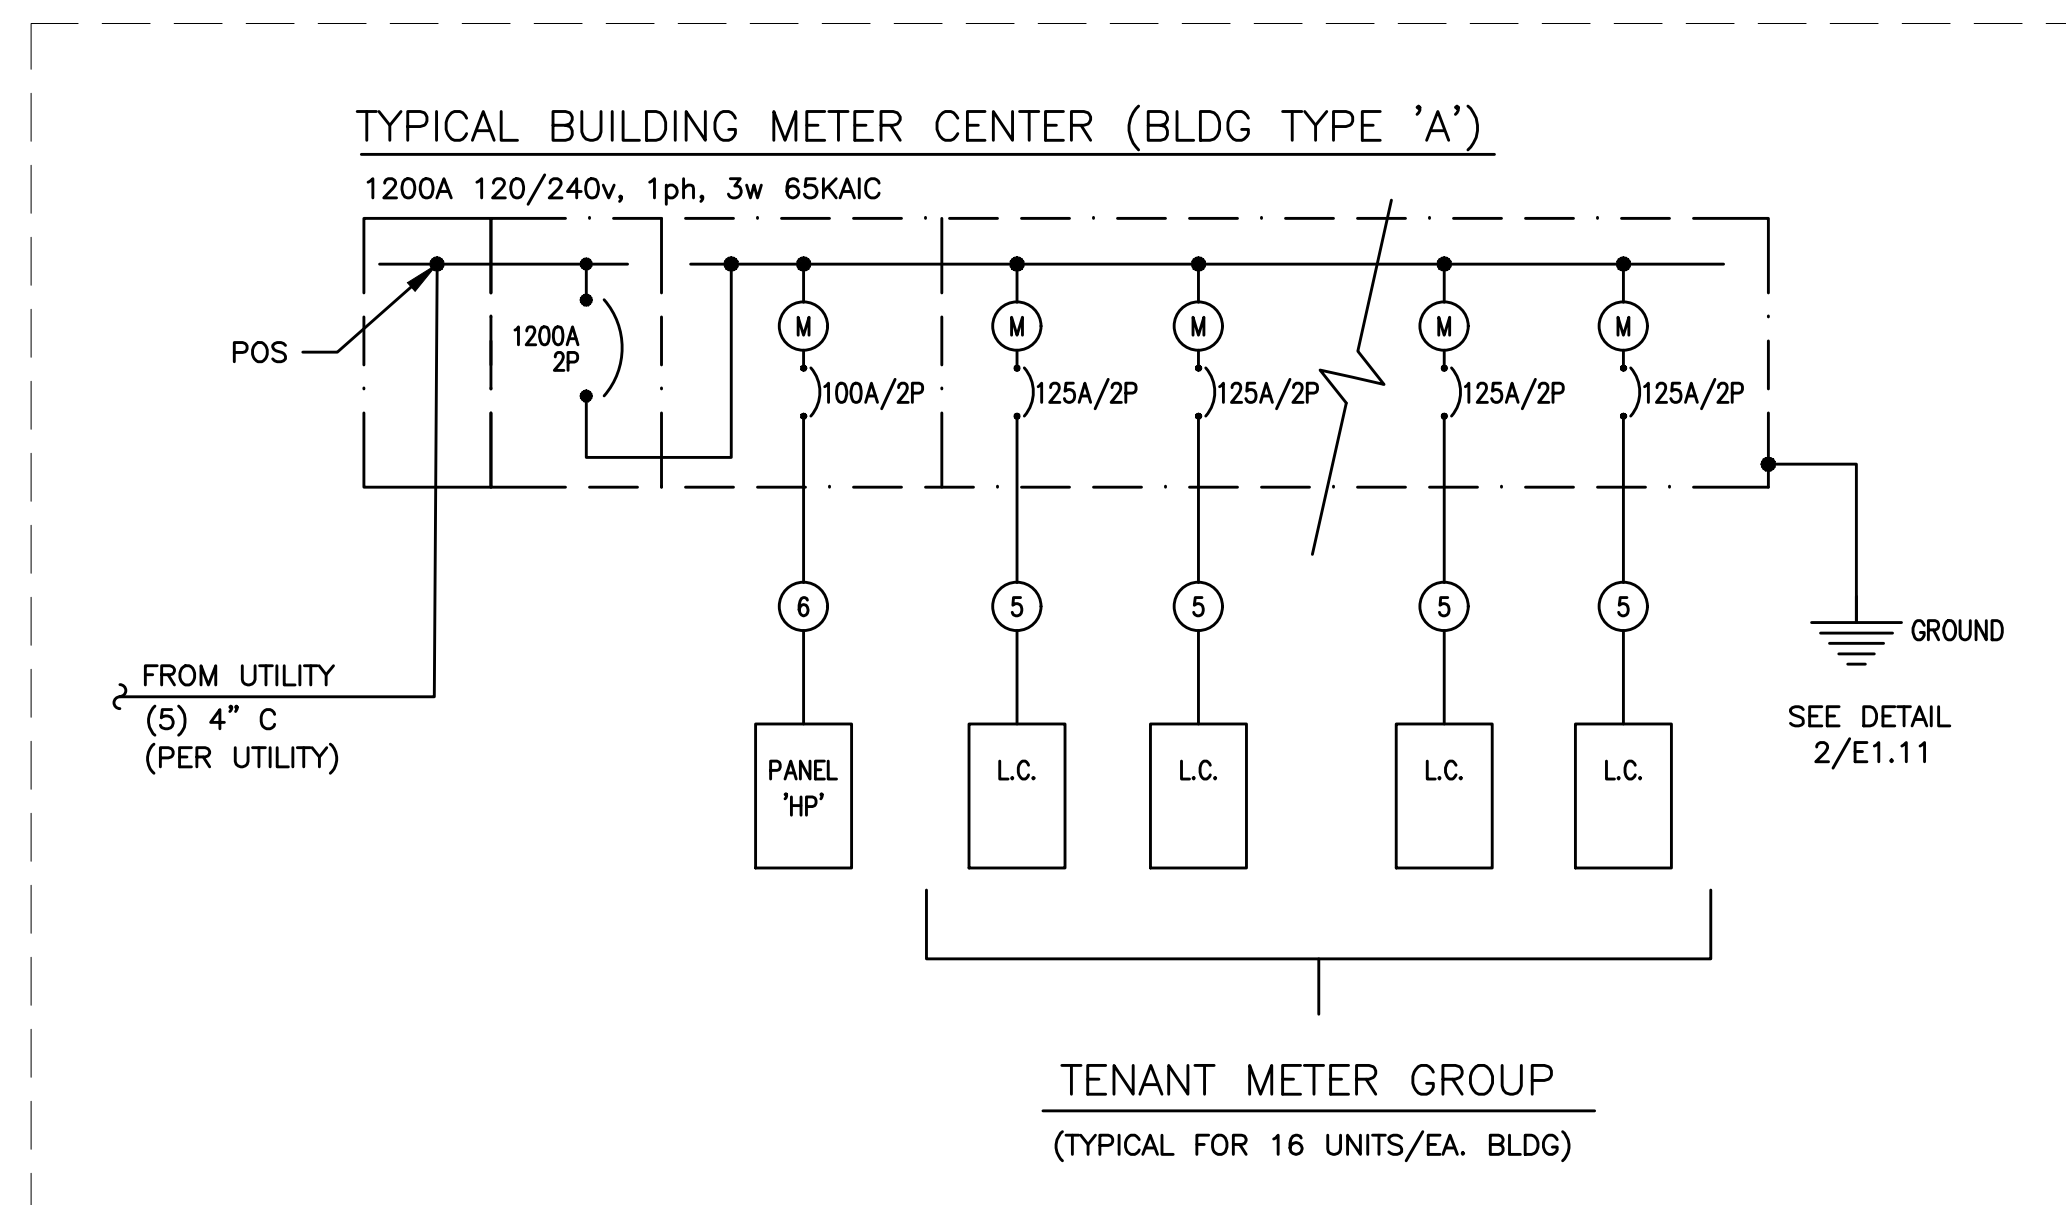ELECTRICAL ONE-LINE DIAGRAMS
(BY TYPICAL BUILDING TYPE)

MECHANICAL EQUIPMENT SCHEDULE									
NO.	EQUIPMENT NAME	HP/KW	VOLTS	PH	AMPS	CONDUIT	WIRE	GND	CIRCUIT
EF-1	EXHAUST FAN NO.1	11.7W	120	1		1/2"	#12	#12	SEE POWER PLANS
EH-1	ELECTRIC WALL HEATER NO.1	4.0 KW	240	1		1/2"	#12	#12	SEE POWER PLANS
EH-2	ELECTRIC WALL HEATER NO.2	500W	120	1		1/2"	#12	#12	SEE POWER PLANS
EH-3	ELECTRIC WALL HEATER NO.3	1.5 KW	240	1		1/2"	#12	#12	SEE POWER PLANS
EH-4	ELECTRIC WALL HEATER NO.4	500W	120	1		1/2"	#12	#12	SEE POWER PLANS
F-1	FAN COIL NO.1		120	1	11.7 MCA	1/2"	#12	#12	CH2-3
CU-1	CONDENSER NO.1		240	1	3/4"	#8	#10	#10	CH2-5,7
F-2	FAN COIL NO.2		120	1	11.7 MCA	1/2"	#12	#12	CH2-9
CU-2	CONDENSER NO.2		240	1	3/4"	#8	#10	#10	CH2-11,13
WH-1	WATER HEATER NO.1	4.5 KW	240	1		1/2"	#12	#12	SEE POWER PLANS

GENERAL EQUIPMENT NOTES:

- A. CONTRACTOR/DESIGNER SHALL VERIFY ALL MECHANICAL EQUIPMENT CONNECTION LOAD REQUIREMENTS WITH THE MECHANICAL EQUIPMENT PROVIDER PRIOR TO ROUGH IN.
- B. MECHANICAL EQUIPMENT SIZES SHOWN IN THE MECHANICAL SCHEDULE ABOVE ARE FOR REFERENCE ONLY AND MAY NOT REFLECT THE ACTUAL EQUIPMENT TO BE INSTALLED.

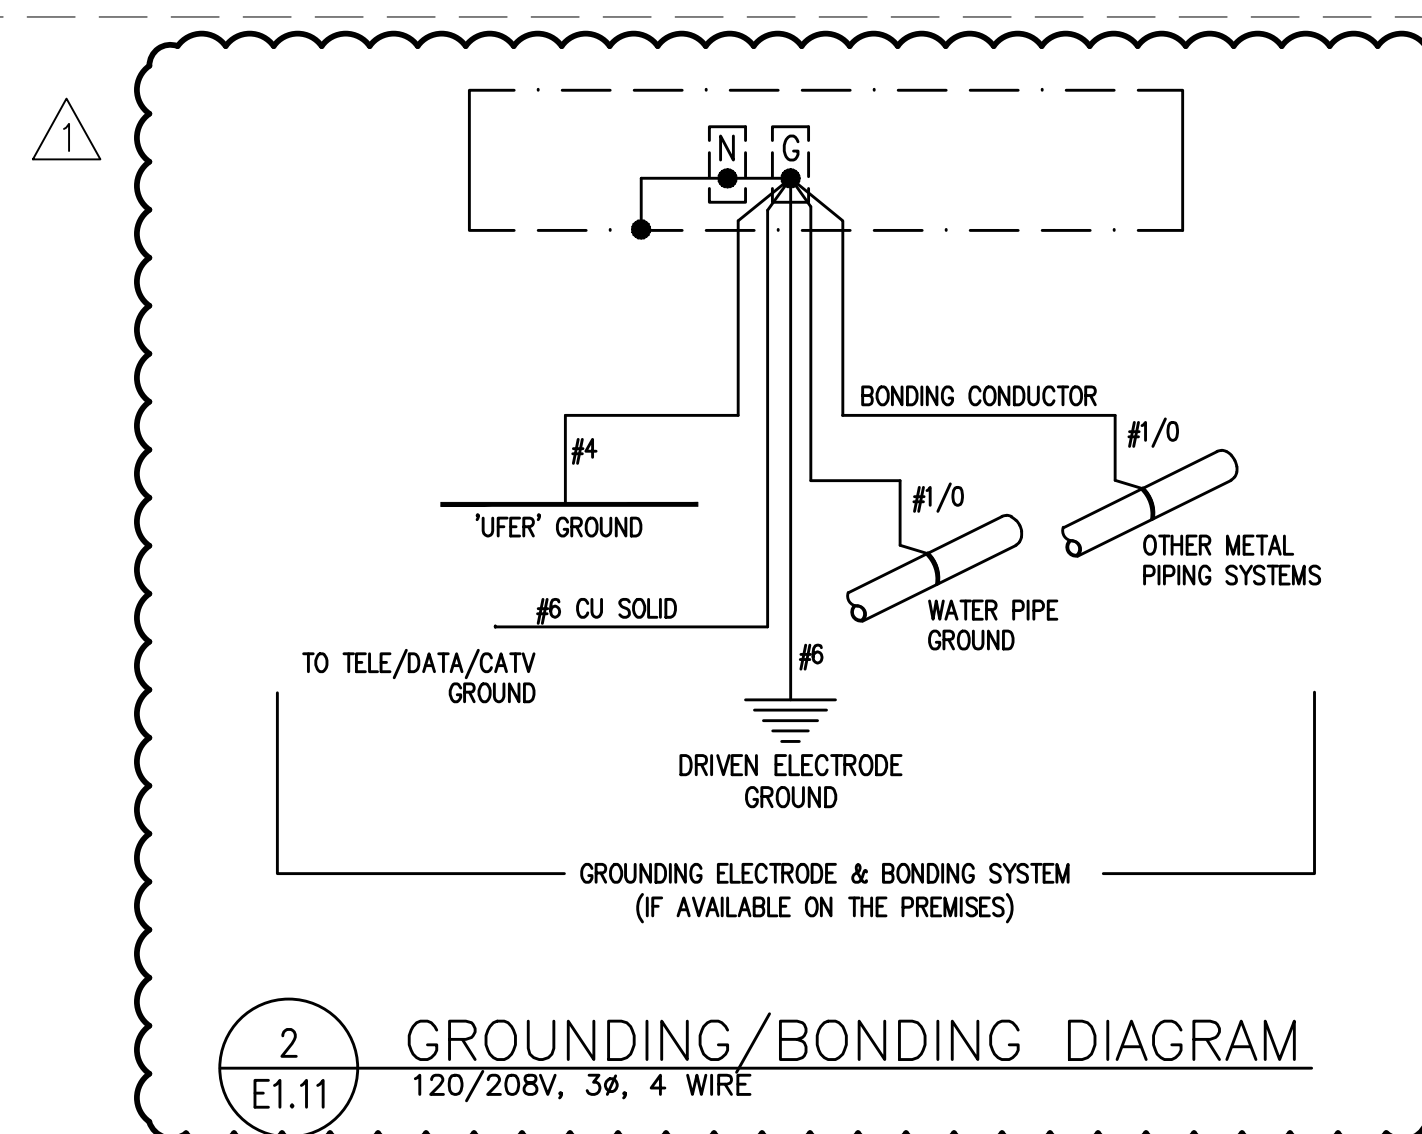

McKinney Lane Phase II RESIDENTIAL LOAD SUMMARY - Bldg Type "A"													
UNIT TYPE:	LW 1	LW 2		TOTAL	AREA (SF)	LTS/RECEPT (3VA / SF)	SM APPL (1500VA X 2)	LAUNDRY (1500VA)	COOKING (CONNECTED)	MICROWAVE (CONNECTED)	DISHWASHER (CONNECTED)	ELECT DRYER (CONNECTED)	WATER HEATER (CONNECTED)
Typical Studio Unit	8	8	0	0	16	500	1500	3000	1500	16500	1500	1200	4000
Typical 1 Brm Unit	0	0	0	0	0	660	1980	3000	1500	16500	1500	1200	4000
Typical 2 Brm Unit	0	0	0	0	0	1060	3180	3000	1500	16500	1500	1200	4000
TOTALS:	8	8	0	0	16	8000	24000	48000	24000	284000	24000	19200	64000
VOLTS: 240 TOTAL CONNECTED: 642 kVA DEMAND FACTOR: 0.39 TOTAL CALCULATED: 250 kVA CALCULATED AMPS: 1043 AMPS NOTE: Based on Total Number of Residential Units = 18-20 (See N.E.C. Article: 220.84)													

McKinney Lane Phase II RESIDENTIAL LOAD SUMMARY - Bldg Type "AS"													
UNIT TYPE:	LW 1	LW 2		TOTAL	AREA (SF)	LTS/RECEPT (3VA / SF)	SM APPL (1500VA X 2)	LAUNDRY (1500VA)	COOKING (CONNECTED)	MICROWAVE (CONNECTED)	DISHWASHER (CONNECTED)	ELECT DRYER (CONNECTED)	WATER HEATER (CONNECTED)
Typical Studio Unit	4	4	0	0	8	500	1500	3000	1500	16500	1500	1200	4000
Typical 1 Brm Unit	0	0	0	0	0	660	1980	3000	1500	16500	1500	1200	4000
Typical 2 Brm Unit	0	0	0	0	0	1060	3180	3000	1500	16500	1500	1200	4000
TOTALS:	4	4	0	0	8	4000	12000	24000	12000	132000	12000	9600	32000
VOLTS: 240 TOTAL CONNECTED: 321 kVA DEMAND FACTOR: 0.43 TOTAL CALCULATED: 138 kVA CALCULATED AMPS: 575 AMPS NOTE: Based on Total Number of Residential Units = 8-10 (See N.E.C. Article: 220.84)													

McKinney Lane Phase II RESIDENTIAL LOAD SUMMARY - Bldg Type "B"													
UNIT TYPE:	LW 1	LW 2		TOTAL	AREA (SF)	LTS/RECEPT (3VA / SF)	SM APPL (1500VA X 2)	LAUNDRY (1500VA)	COOKING (CONNECTED)	MICROWAVE (CONNECTED)	DISHWASHER (CONNECTED)	ELECT DRYER (CONNECTED)	WATER HEATER (CONNECTED)
Typical Studio Unit	0	0	0	0	0	500	1500	3000	1500	16500	1500	1200	4000
Typical 1 Brm Unit	7	7	0	0	14	660	1980	3000	1500	16500	1500	1200	4000
Typical 2 Brm Unit	0	0	0	0	0	1060	3180	3000	1500	16500	1500	1200	4000
TOTALS:	7	7	0	0	14	9240	27720	42000	21000	231000	21000	16800	56000
VOLTS: 240 TOTAL CONNECTED: 589 kVA DEMAND FACTOR: 0.40 TOTAL CALCULATED: 238 kVA CALCULATED AMPS: 982 AMPS NOTE: Based on Total Number of Residential Units = 14-15 (See N.E.C. Article: 220.84)													

McKinney Lane Phase II RESIDENTIAL LOAD SUMMARY - Bldg Type "C"													
UNIT TYPE:	LW 1	LW 2		TOTAL	AREA (SF)	LTS/RECEPT (3VA / SF)	SM APPL (1500VA X 2)	LAUNDRY (1500VA)	COOKING (CONNECTED)	MICROWAVE (CONNECTED)	DISHWASHER (CONNECTED)	ELECT DRYER (CONNECTED)	WATER HEATER (CONNECTED)
Typical Studio Unit	0	0	0	0	0	500	1500	3000	1500	16500	1500	1200	4000
Typical 1 Brm Unit	2	2	0	0	4	660	1980	3000	1500	16500	1500	1200	4000
Typical 2 Brm Unit	4	4	0	0	8	1060	3180	3000	1500	16500	1500	1200	4000
TOTALS:	6	6	0	0	12	11120	33360	36000	18000	198000	18000	14400	48000
VOLTS: 240 TOTAL CONNECTED: 527 kVA DEMAND FACTOR: 0.41 TOTAL CALCULATED: 216 kVA CALCULATED AMPS: 906 AMPS NOTE: Based on Total Number of Residential Units = 12-13 (See N.E.C. Article: 220.84)													

MFA PANEL SCHEDULE 28-Oct-20													
panel	mounting	location	connected load	calculated load	19	19	19	19	19	19	19	19	19
120/240V	1	60A	1	2	20/1	20/1	20/1	20/1	20/1	20/1	20/1	20/1	20/1
STALL 1 LTS & RECEPT	1500	20/1	3	4	20/1	20/1	20/1	20/1	20/1	20/1	20/1	20/1	20/1
STALL 2 LTS & RECEPT	1500	20/1	3	4	20/1	20/1	20/1	20/1	20/1	20/1	20/1	20/1	20/1
STALL 3 LTS & RECEPT	1500	20/1	3	4	20/1	20/1	20/1	20/1	20/1	20/1	20/1	20/1	20/1
SPARE	0	20/1	7	8	20/1	20/1	20/1	20/1	20/1	20/1	20/1	20/1	20/1
SPARE	0	20/1	9	10	20/1	20/1	20/1	20/1	20/1	20/1	20/1	20/1	20/1
SPARE	0	20/1	11	12	20/1	20/1	20/1	20/1	20/1	20/1	20/1	20/1	20/1
SPARE	0	20/1	13	14	20/1	20/1	20/1	20/1	20/1	20/1	20/1	20/1	20/1
BLANK	15	18	18	18	20/1	20/1	20/1	20/1	20/1	20/1	20/1	20/1	20/1
BLANK	17	18	18	18	20/1	20/1	20/1	20/1	20/1	20/1	20/1	20/1	20/1
BLANK	19	20	20	20	20/1	20/1	20/1	20/1	20/1	20/1	20/1	20/1	20/1
1. LIGHTS=	0	0	VA	0	1.25								
2. RECEPT=	0	0	VA	0	0.1 + 0.5								
3. HEATING=	0	0	VA	0	1.00								
4. KITCHEN=	0	0	VA	0	1.00								
5. EQUIP=	3000	1500	VA	4500	1.00								
6. MOTORS=	0	0	VA	0	*								
7. SUB-PANEL=	0	0	VA	0	1.00								
(* 125% of the largest motor + 100% of the balance)					TOTAL =								

DWELLING UNIT LOAD CALCULATION		
Project: <u>McKinney Lane Phase II</u>		
Unit Type: <u>Studio</u>		
Area:	<u>500</u>	square feet(average)
Minimum Size Feeder (NEC 220.40):		
General lighting load at 3 VA / SF		1,500 VA
Small Appliance load (2 dckts at 1500VA each)		3,000 VA
Laundry Load (1 dkt at 1500VA)		1,500 VA
Range (GAS)		1,500 VA
Other Cooking Appliance Load (Microwave Oven)		1,500 VA
Dishwasher Load		1,200 VA
Electric Dryer Load		4,000 VA
Electric Water Heater Load		4,500 VA
Disposal load		900 VA
Other motor loads		0 VA
Total "General Loads"		34,600 VA
First 10 kVA of "general loads" at 100%		10,000 VA
Remainder of "general loads" at 40%		8,840 VA
Net "general load"		10,840 VA
Largest of:	4,000 VA of electric space heating (less than 4) at 65%	2,600 VA
—	VA of electric space heating (4 or more) at 40%	0 VA
—	VA of air conditioning/cooling/heat pumps at 100%	0 VA
TOTAL LOAD		22,440 VA
For 120/240-volt, 3-wire, single-phase service or feeder,		
22,440 VA / 240 volts =		94 Amps
Therefore, this dwelling unit shall be permitted to be served by a <u>125</u> amp service.		



IN THE EVENT CONFLICTS ARE DISCOVERED
BETWEEN THE ORIGINAL SIGNED AND SEALED
DOCUMENT PREPARED BY THE ARCHITECT
AND/OR THEIR CONSULTANTS, AND ANY COPY OF
THE DOCUMENTS TRANSMITTED BY EMAIL, FAX,
ELECTRONICALLY OR OTHERWISE, THE ORIGINAL
SIGNED AND SEALED DOCUMENTS SHALL GOVERN.

PROJECT # 2019-179
DATE: 28 AUGUST 2020

REVISIONS

PLAN REVIEW 11.03.2020


TYPE	LAMP	MANUFACTURER	CATALOG NUMBER	DESCRIPTION	OPTIONS
A1 A1E	LED 3000K 2000LM/80CRI	LITHONIA (OR APPROVED OTHER)	ZLIN SERIES	TYPE :4' GEN. PURPOSE STRIP MOUNTING :SURFACE HOUSING :STEEL LENS/REFL :DIFFUSED ACRYLIC VOLTAGE :MVOLT BALLAST :LED DRIVER	TYPE 'AE' SIMILAR TO TYPE 'A' EXCEPT WITH EMERGENCY BATTERY BACK-UP
A2	13W A19 LED (60W INCAND. EQUAL)	BRYANT		TYPE :PORCELAIN KEYLESS SOCKET MOUNTING :WALL +6" ABV. DOOR HOUSING :STEEL LENS/REFL :N/A VOLTAGE :120V BALLAST :INTEGRAL LED DRIVER	WITH PULL CHAIN FIRE RISER ROOM
C1 C1E	LED 1300 LM/80CRI 3000K	USAI LIGHTING (OR APPROVED OTHER)	BARDF SERIES	TYPE :4.5" DIA. DOWNLIGHT MOUNTING :RECESSED HOUSING :ALUMINUM LENS/REFL :NA VOLTAGE :MVOLT BALLAST :LED DRIVER (0-10 DIMMING)	WHITE TRIM AT CYP. CEILINGS 50 DEGREE BEAM C1E = EMERGENCY BATTERY BACK UP UL LISTED DAMP LOCATION CLUBHOUSE
C2 C2E	LED 1300 LM/80CRI 3000K	USAI LIGHTING (OR APPROVED OTHER)	BARGF30 SERIES	TYPE :4.5" DIA. DOWNLIGHT MOUNTING :RECESSED (SLOPED CLING) HOUSING :ALUMINUM LENS/REFL :NA VOLTAGE :MVOLT BALLAST :LED DRIVER (0-10 DIMMING)	BLACK TRIM AT WOOD CEILINGS 70 DEGREE BEAM C2E = EMERGENCY BATTERY BACK UP UL LISTED DAMP LOCATION CLUBHOUSE
C3 C3E	LED 1075 LM/80CRI 3000K	USAI LIGHTING (OR APPROVED OTHER)	PARDF SERIES	TYPE :EXTERIOR 4.5" DIA. DOWNLIGHT MOUNTING :RECESSED HOUSING :ALUMINUM LENS/REFL :ACRYLIC VOLTAGE :MVOLT BALLAST :LED DRIVER	TRIM & FINISH PER ARCHITECT/INTERIORS FLOOD BEAM C3E = EMERGENCY BATTERY BACK UP UL LISTED DAMP LOCATION CLUBHOUSE EXTERIOR CANOPY
DL1	LED 3000K	MATTEO LIGHTING (OR APPROVED OTHER)	C49703BK SERIES	TYPE :DECORATIVE PENDANT MOUNTING :SUSPENDED HOUSING :STEEL LENS/REFL :GLASS VOLTAGE :MVOLT BALLAST :INTEGRAL (0-10 DIMMING)	FINISH PER ARCHITECT/INTERIORS PER DECORATOR MOUNTING HEIGHT TO BE 6'-6" AFF. CLUBHOUSE
DL2	LED 3000K	HERMAN MILLER LIGHTING (OR APPROVED OTHER)	H761CCS SERIES	TYPE :DECORATIVE PENDANT MOUNTING :SUSPENDED HOUSING :STEEL LENS/REFL :GLASS VOLTAGE :MVOLT BALLAST :INTEGRAL (0-10 DIMMING)	FINISH PER ARCHITECT/INTERIORS PER DECORATOR MOUNTING HEIGHT TO BE 6'-6" AFF. CLUBHOUSE
DL3	LED 1150 LM 3000K	USAI LIGHTING (OR APPROVED OTHER)	LBRP6 SERIES	TYPE :CYLINDER LIGHT MOUNTING :SUSPENDED (CABLE HUNG) HOUSING :STEEL LENS/REFL :GLASS VOLTAGE :MVOLT BALLAST :LED DRIVER (0-10 DIMMING)	FINISH PER ARCHITECT/INTERIORS PER DECORATOR MOUNTING HEIGHT 11'-0" AFF. CLUBHOUSE
DL4	LED 3000K	CEDAR & MOSS LIGHTING (OR APPROVED OTHER)	TILT CONE SERIES	TYPE :ADJUSTABLE WALL SCONCE MOUNTING :SURFACE HOUSING :STEEL LENS/REFL :GLASS VOLTAGE :MVOLT BALLAST :INTEGRAL (0-10 DIMMING)	FINISH PER ARCHITECT/INTERIORS REFER TO INTERIOR ELEVATIONS FOR MOUNTING HEIGHT. CLUBHOUSE
DL5	LED 3000K	ANDREW NEVER LIGHTING (OR APPROVED OTHER)	DUMBBELL SERIES	TYPE :DECORATIVE PENDANT MOUNTING :SUSPENDED HOUSING :STEEL LENS/REFL :GLASS VOLTAGE :MVOLT BALLAST :INTEGRAL (0-10 DIMMING)	FINISH PER ARCHITECT. MOUNTING HEIGHT PER DECORATOR. CLUBHOUSE
'X1' (1.5W)	LED (GREEN LETTERS)	LITHONIA DMF LIGHTING (OR APPROVED OTHER)	LE EL N SERIES DLED500EM-G	TYPE :EXIT SIGN MOUNTING :UNIVERSAL HOUSING :DIE-CAST ALUMINUM LENS/REFL :SINGLE FACE/DUAL FACE VOLTAGE :MVOLT BALLAST :NICKLE CADMIUM BATTERY	

TYPE	LAMP	MANUFACTURER	CATALOG NUMBER	DESCRIPTION	OPTIONS
U1a	LED 650 LM 3000K	LIGHTOLIER (OR APPROVED OTHER)	SSR SERIES	TYPE :5" DIA. DOWNLIGHT MOUNTING :SURFACE (+-BOX) HOUSING :ALUMINUM LENS/REFL :ACRYLIC VOLTAGE :MVOLT BALLAST :LED DRIVER (DIMMING)	FINISH PER ARCHITECT/INTERIORS UNIT KITCHEN, HALL, BATHROOM
U1b	LED 750 LM 3000K	LITHONIA (OR APPROVED OTHER)	LK5G SERIES	TYPE :5" DIA. ADJUSTABLE DOWNLIGHT MOUNTING :RECESSED HOUSING :ALUMINUM LENS/REFL :ACRYLIC VOLTAGE :MVOLT BALLAST :LED DRIVER (DIMMING)	FINISH PER ARCHITECT/INTERIORS IC RATED UNIT KITCHEN (VAULTED CLING ONLY)
U2	LED 1400 LUMEN 3000K	MAXIM LIGHTING (OR APPROVED OTHER)	52102SN SERIES	TYPE :24" VANITY LIGHT MOUNTING :SURFACE (+6" ABOVE MIRROR) HOUSING :STEEL LENS/REFL :GLASS VOLTAGE :120V BALLAST :LED DRIVER	FINISH PER ARCHITECT/INTERIORS UNIT BATHROOM
U3a	LED 3000K 1400 LM	TBD (OR APPROVED OTHER)	TBD	TYPE :52" DIA. CEILING FAN W/ LIGHT MOUNTING :SURFACE HOUSING :ALUMINUM LENS/REFL :ACRYLIC VOLTAGE :120V BALLAST :LED DRIVER (0-10 DIMMING)	FINISH PER ARCHITECT/INTERIORS PROVIDE BRACING AT CEILING TO SUPPORT A MINIMUM OF 35 LBS. PROVIDE WITH DUAL SWITCH CONTROLS
U3b	LED 3000K 1400 LM	TBD (OR APPROVED OTHER)	TBD	TYPE :52" DIA. CEILING FAN W/ LIGHT MOUNTING :SURFACE (SLOPPED CEILING) HOUSING :ALUMINUM LENS/REFL :ACRYLIC VOLTAGE :120V BALLAST :LED DRIVER (0-10 DIMMING)	FINISH PER ARCHITECT. PROVIDE BRACING AT CEILING TO SUPPORT A MINIMUM OF 35 LBS. PROVIDE WITH DUAL SWITCH CONTROLS.
U4	LED 1400 LM 3000K	KUZCO LIGHTING (OR APPROVED OTHER)	FM3511	TYPE :11" DIA. CEILING LIGHT MOUNTING :SURFACE HOUSING :STEEL LENS/REFL :GLASS VOLTAGE :120V BALLAST :LED DRIVER (0-10 DIMMING)	FINISH PER ARCHITECT/INTERIORS UNIT DINING ROOM
U5	LED 800 LM 3000K	KUZCO LIGHTING (OR APPROVED OTHER)	EW3105	TYPE :EXTERIOR WALL SCONCE MOUNTING :SURFACE HOUSING :STEEL LENS/REFL :GLASS VOLTAGE :120V BALLAST :LED DRIVER	FINISH PER ARCHITECT/INTERIORS UNIT ENTRY
U6	LED 3000K 200LM	WAC LIGHTING (OR APPROVED OTHER)	HR-LED90 SERIES	TYPE :UNDER CABINET LIGHT MOUNTING :SURFACE HOUSING :ALUMINUM LENS/REFL :ACRYLIC VOLTAGE :24V BALLAST :LED DRIVER (ELV DIMMING)	FINISH PER ARCHITECT. UNIT KITCHEN


TYPE	LAMP	MANUFACTURER	CATALOG NUMBER	DESCRIPTION	OPTIONS
S1	LED 3000K 2632 LM	LIGMAN LIGHTING (OR APPROVED OTHER)	UAA-20166 SERIES	TYPE :AREA LIGHT MOUNTING :ROUND POLE (16' AFG) HOUSING :STEEL LENS/REFL :OPAL GLASS/STRAIGHT SHADE VOLTAGE :MVOLT BALLAST :LED DRIVER	BLACK FINISH PARKING AREA
S2	LED 3000K 2420 LM	LIGHTWAY LIGHTING DABMAR LIGHTING (OR APPROVED OTHER)	WWP-14LED SERIES GM260 SERIES	TYPE :POST TOP AREA LIGHT MOUNTING :ROUND POLE (8FT AFG) HOUSING :STEEL LENS/REFL :OPAL GLASS VOLTAGE :MVOLT BALLAST :LED DRIVER	BLACK FINISH WALKWAYS
S3	LED 3000K 1856 LM	LIGMAN LIGHTING DABMAR LIGHTING (OR APPROVED OTHER)	UAA-30186 SERIES GM996 SERIES	TYPE :EXTERIOR WALL SCONCE MOUNTING :SURFACE (+8.5 FT AFF) HOUSING :STEEL LENS/REFL :OPAL GLASS/STRAIGHT SHADE VOLTAGE :MVOLT BALLAST :LED DRIVER	BLACK FINISH GARAGES
S4	LED 3000K 4800 LM	SAYLITE LIGHTING	CV800 SERIES	TYPE :4FT ENCLOSED STRIP LIGHT MOUNTING :SURFACE HOUSING :STEEL LENS/REFL :ACRYLIC VOLTAGE :MVOLT BALLAST :LED DRIVER	VANDAL RESISTANT CARPORTS, SHELTERS
S5	LED 3000K 1200 LM	KUZCO LIGHTING	EC44505 SERIES	TYPE :CEILING LIGHT MOUNTING :SURFACE HOUSING :STEEL LENS/REFL :ACRYLIC VOLTAGE :MVOLT BALLAST :LED DRIVER	FINISH PER ARCHITECT BUILDING PORCHES, LANDINGS
S6	LED 3000K 200 LM	HADCO LIGHTING	DAL1 4121 SERIES	TYPE :DECK LIGHT MOUNTING :SURFACE HOUSING :STEEL LENS/REFL :ACRYLIC VOLTAGE :24V BALLAST :INTEGRAL LED DRIVER	FINISH PER ARCHITECT VERIFY MOUNTING HEIGHT PROVIDE WITH APPROPRIATE TRANSFORMERS AND OTHER HARDWARE
S7	LED 3000K 1454 LM	LIGMAN LIGHTING	UAA-10086 SERIES	TYPE :42" BOLLARD LIGHT MOUNTING :SURFACE HOUSING :STEEL LENS/REFL :LOUVERED GLASS VOLTAGE :120V BALLAST :LED DRIVER	BLACK FINISH PROVIDE WITH ROUND TOP CLUBHOUSE TERRACE

GENERAL LIGHTING NOTES:


- ALL LIGHT FIXTURES SHALL HAVE ENERGY EFFICIENT LAMPING, DRIVERS AND BALLASTS.
- LIGHT FIXTURES FOR LIVING UNITS SHALL BE "ENERGY STAR" RATED.
- EXTERIOR LIGHT FIXTURES SHALL BE "NIGHT SKY" FRIENDLY.
- VERIFY ALL FIXTURE FINISHES WITH ARCHITECT/INTERIORS PRIOR TO BID.
- VERIFY ALL FIXTURE MOUNTING HEIGHTS WITH ARCHITECT/INTERIORS PRIOR TO BID.
- VERIFY ALL FIXTURE LOCATIONS WITH ARCHITECT/INTERIOR PRIOR TO ROUGH IN.
- ALL INTERIOR LIGHTING SHALL BE 3000 KELVIN UNLESS OTHERWISE NOTED.
- ALL EXTERIOR LIGHTING SHALL BE 3000 KELVIN UNLESS OTHERWISE NOTED.
- ALL PRODUCT SUBSTITUTIONS AND VALUE ENGINEERING SHALL BE SUBMITTED DURING BID PHASE, SHALL MEET DESIGN INTENT AND IS SUBJECT TO OWNER APPROVAL.
- CONTRACTOR SHALL CONSULT MANUFACTURER INSTALLATION INSTRUCTIONS FOR ALL FIXTURES AND DEVICES AND INSTALL AS INSTRUCTED. THIS INCLUDES ALL ELECTRICAL COMPONENTS REQUIRED FOR COMPLETE INSTALLATION. WORK SHALL BE PERFORMED SUCH THAT MANUFACTURER WARRANTY IS NOT VOIDED.
- IF NECESSARY, CONTRACTOR SHALL PROVIDE IC RATED BOXES FOR ANY APPROVED, SUBSTITUTED FIXTURES NOT MEETING INSULATED CEILING REQUIREMENTS.
- SITE LIGHTING AND BUILDING MOUNTED EXTERIOR LIGHTS (EXCEPT APARTMENT PATIO/BALCONY LIGHTS) SHALL BE CONTROLLED VIA PHOTOCELL, EITHER INTEGRAL OR REMOTE FOR DUST-TILL-DAWN OPERATION.
- POLE MOUNTED SITE LIGHTING AND CARPORT LIGHTING SHALL BE PROVIDED WITH THE ABILITY TO REDUCE LIGHT LEVELS BY 30% DURING PERIODS OF LOW NIGHT-TIME ACTIVITY, EITHER BY MOTION SENSING AND/OR TIME CLOCK.
- CONTRACTOR TO PROVIDE SINGLE POLE DIMMER SWITCHES AS INDICATED. DIMMER SWITCHES SHALL MATCH THE DECORATOR TYPE ROCKER SWITCH SPECIFIED IN THE TYPICAL UNIT LIGHTING PLANS OR AS DIRECTED BY THE OWNER. DIMMER SWITCHES SHALL BE COMPATIBLE WITH THE LED LIGHT FIXTURES AND SHALL BE FULLY ADJUSTABLE. CONTRACTOR SHALL FIELD ADJUST TO REDUCE ANY MOMENTARY FLASH DURING START UP.
- PROVIDE BLOCKING AT CEILING TO SUPPORT 35LB., MINIMUM, FOR CEILING FAN INSTALLATION. REFER TO MANUFACTURER'S INSTALLATION INSTRUCTIONS FOR ADDITIONAL INFORMATION AND REQUIREMENTS. PROVIDE FIXTURE CONTROL SWITCH(ES) AS DIRECTED BY MANUFACTURER.

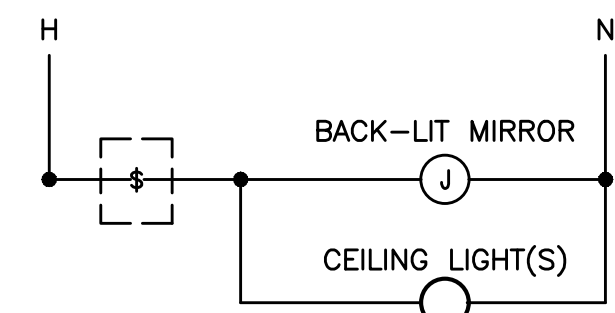

BATHROOM WITH CEILING LIGHT(S)
& BACK-LIT MIRROR

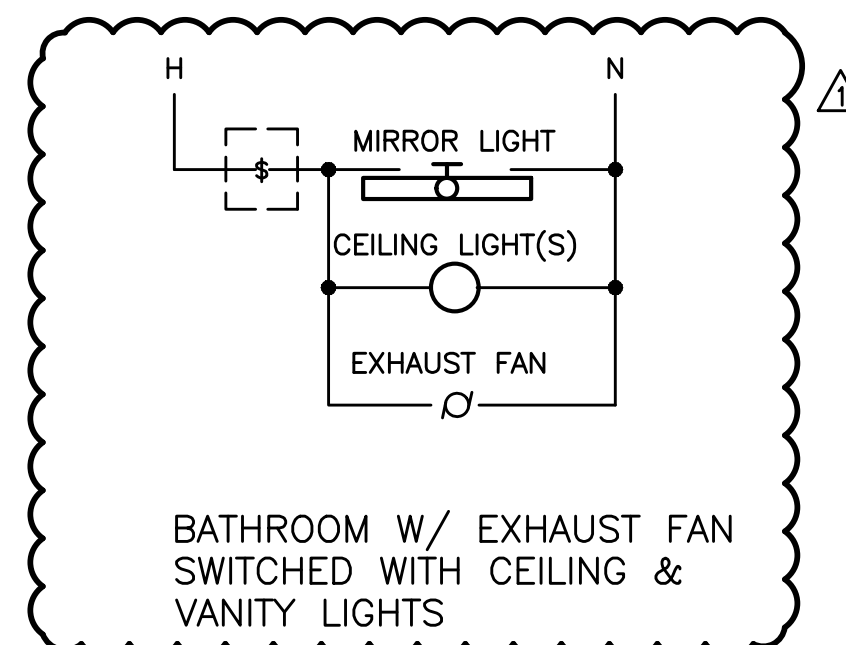


BATHROOM W/ EXHAUST FAN
SWITCHED WITH CEILING &
VANITY LIGHTS

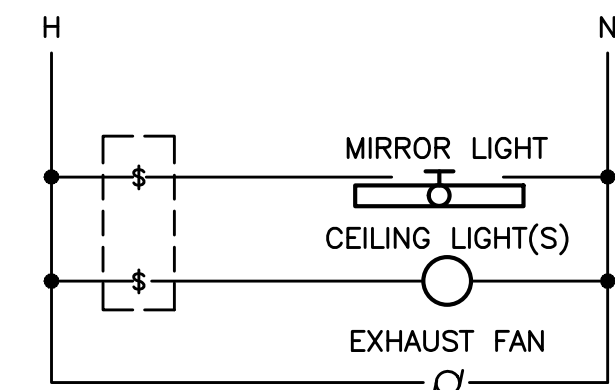


BATHROOM W/ VANITY LIGHT
SWITCHED SEPARATE FROM
CEILING LIGHTS
& CONTINUOUS OPERATION
EXHAUST FAN

1
E1.21
NO SCALE
BATHROOM SWITCHING DIAGRAMS – TYPICAL

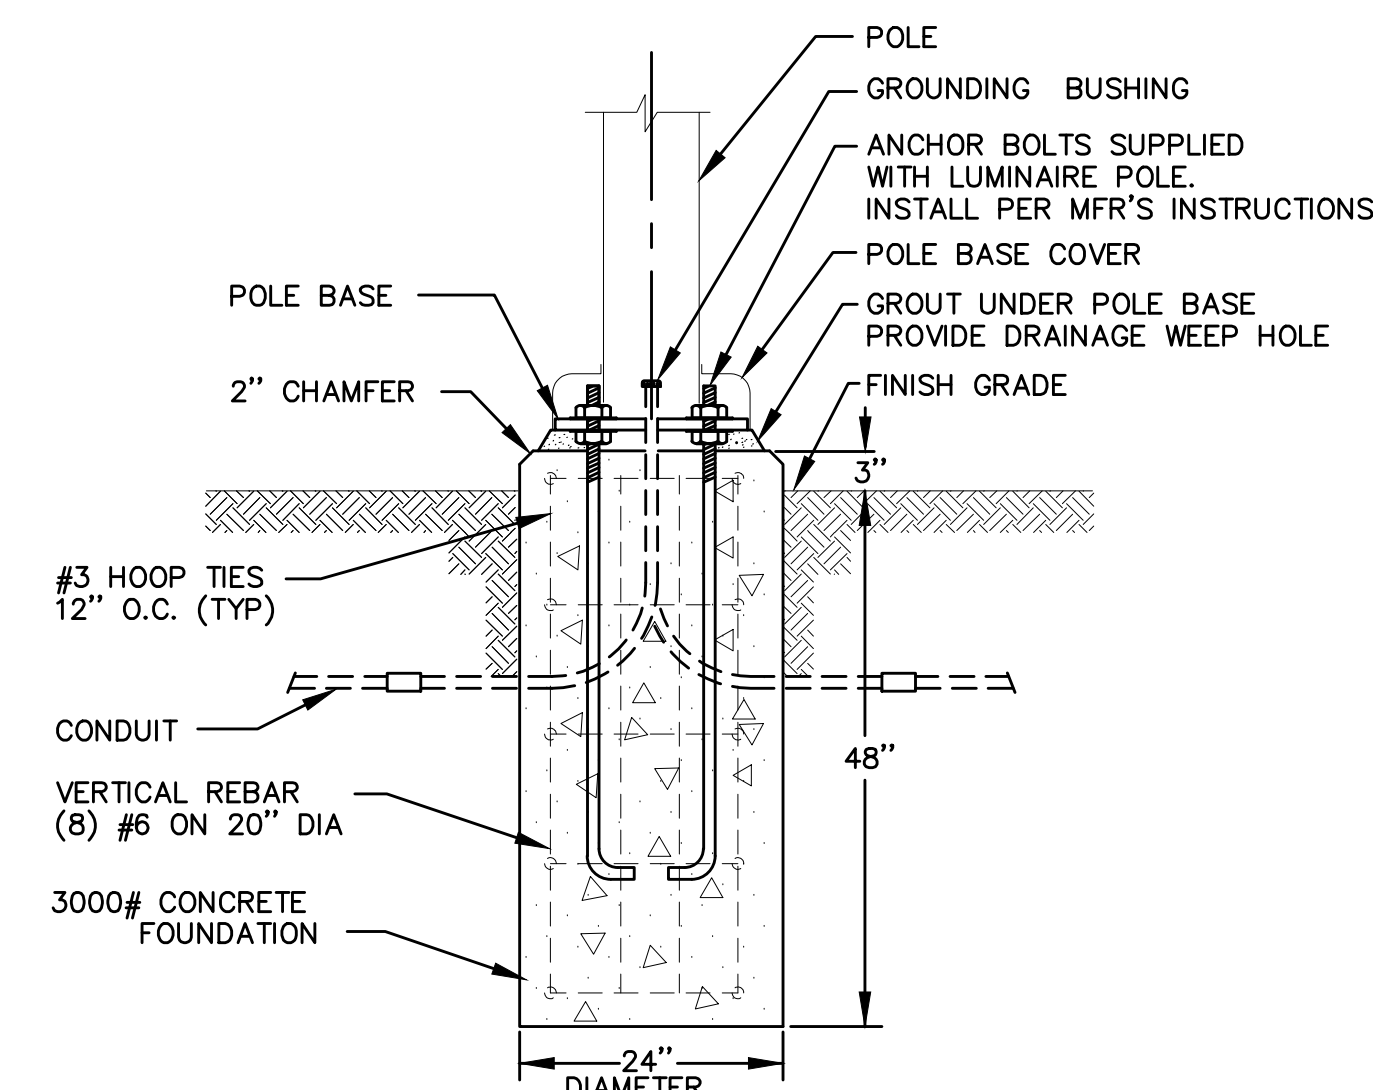

2
E1.21
NO SCALE
TYPICAL POLE BASE DETAIL

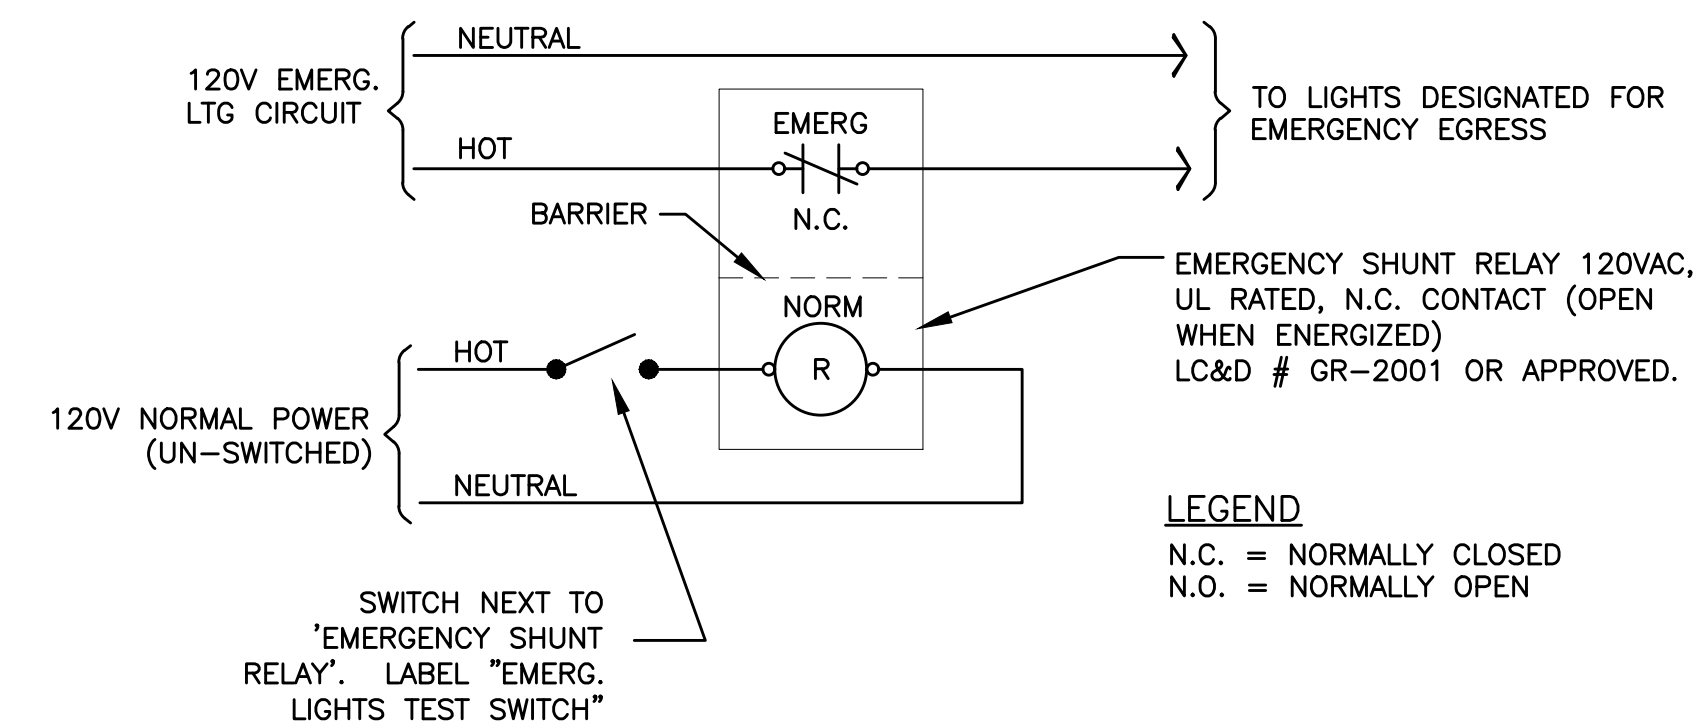

3
E1.21
NO SCALE
EMERGENCY EGRESS LIGHTING – UNSWITCHED

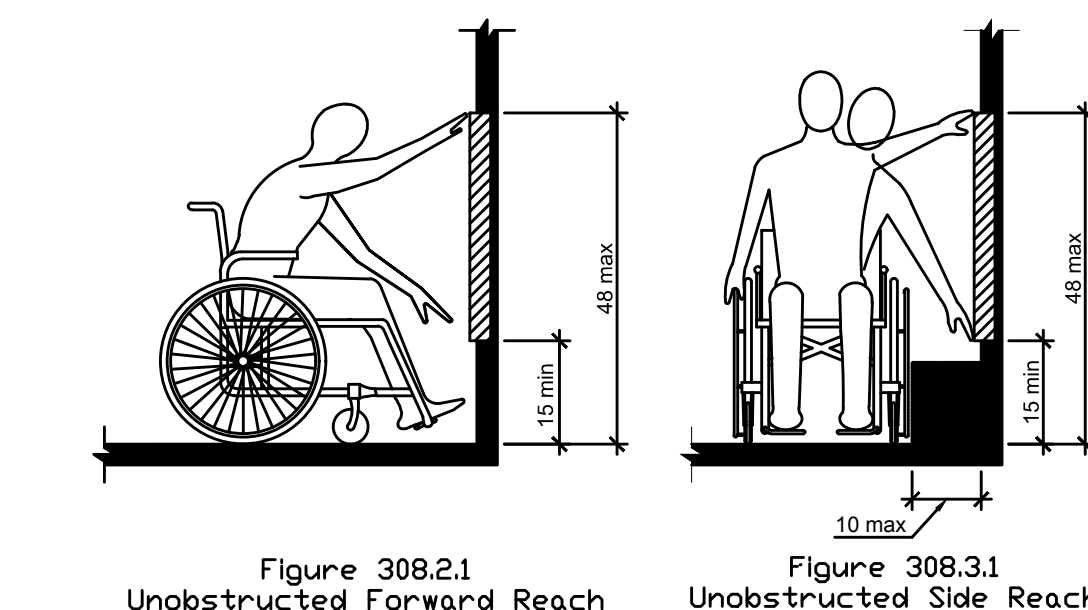


Figure 308.2.1
Unobstructed Forward Reach

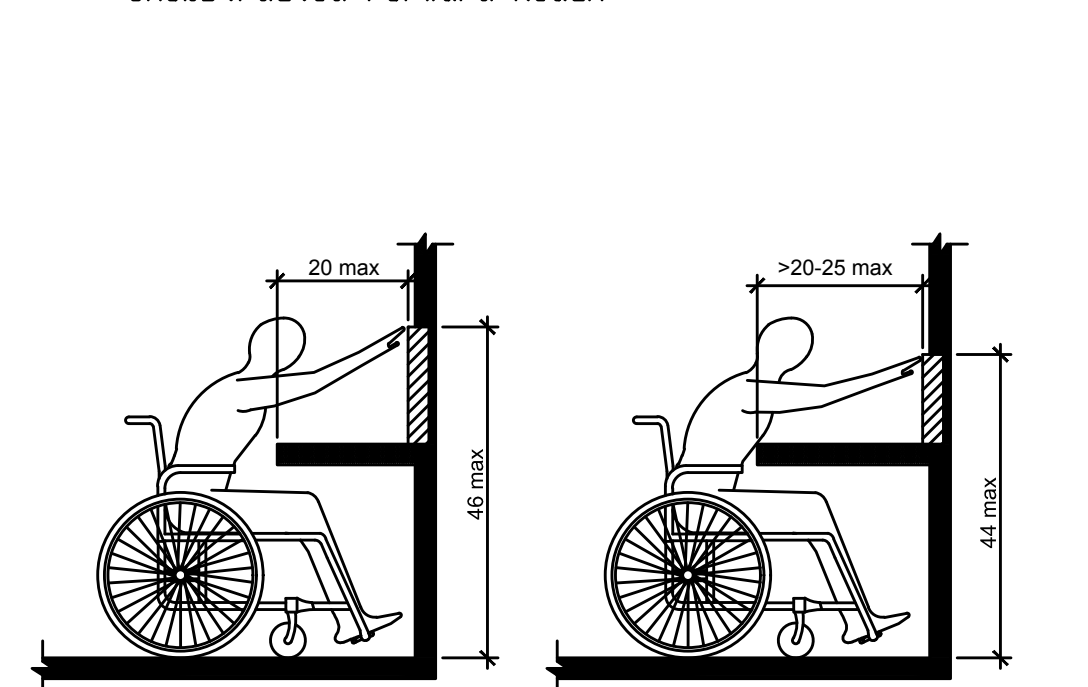


Figure 308.3.1
Unobstructed Side Reach

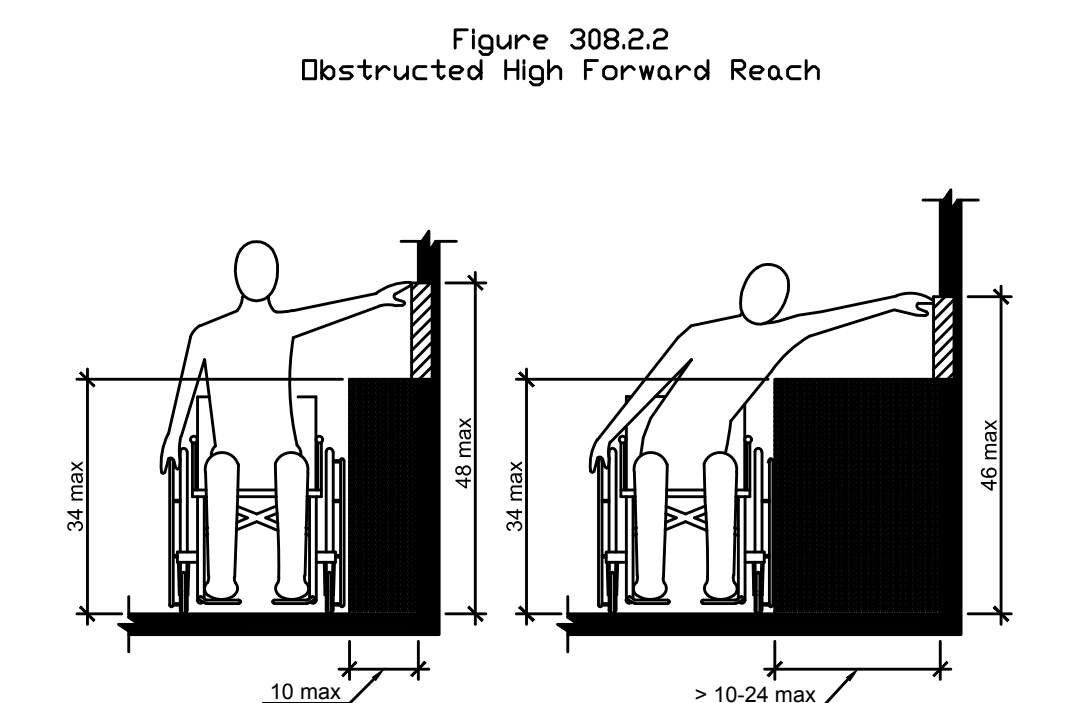


Figure 308.2.2
Obstructed High Forward Reach

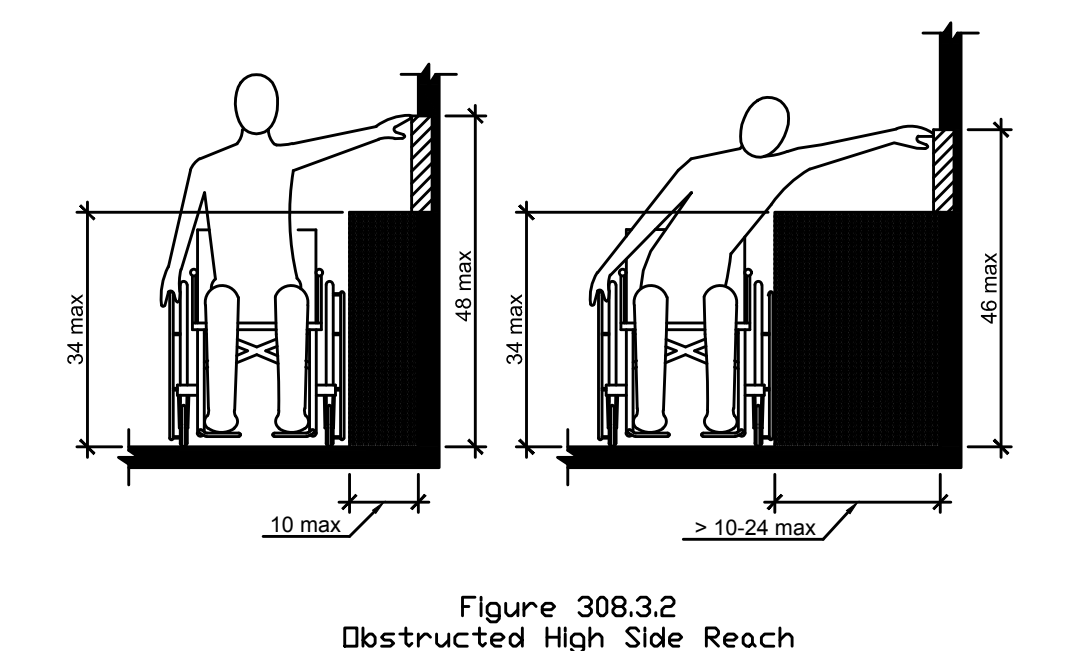


Figure 308.3.2
Obstructed High Side Reach

1
E1.22
NO SCALE
ADA REACH REQUIREMENTS

308.2 Forward Reach.

308.2.1 Unobstructed. Where a forward reach is unobstructed, the high forward reach shall be 48" maximum and the low forward reach shall be 15" minimum above the floor or ground.


308.2.2 Obstructed High Reach. Where a high forward reach is over an obstruction, the clear floor or ground space shall extend beneath the element for a distance not less than the required reach depth over the obstruction. The high forward reach shall be 48" maximum where the reach depth is 20" maximum. Where the reach depth exceeds 20", the high forward reach shall be 44" maximum and the reach depth shall be 25" maximum.

308.3 Side Reach.

308.3.1 Unobstructed. Where a clear floor or ground space allows a parallel approach to an object and the side reach is unobstructed, the high side reach shall be 48" maximum and the low side reach shall be 15" minimum above the floor or ground.

Exception: Existing elements shall be permitted at 54" maximum above the floor or ground.

308.3.2 Obstructed High Reach. Where a clear floor or ground space allows a parallel approach to an object and the high side reach is over an obstruction, the height of the obstruction shall be 34" maximum and the depth of the obstruction shall 24" maximum. The high side reach shall be 48" maximum for a reach depth of 10" maximum. Where the reach depth exceeds 10", the high side reach shall be 46" maximum for a reach depth of 24" maximum.

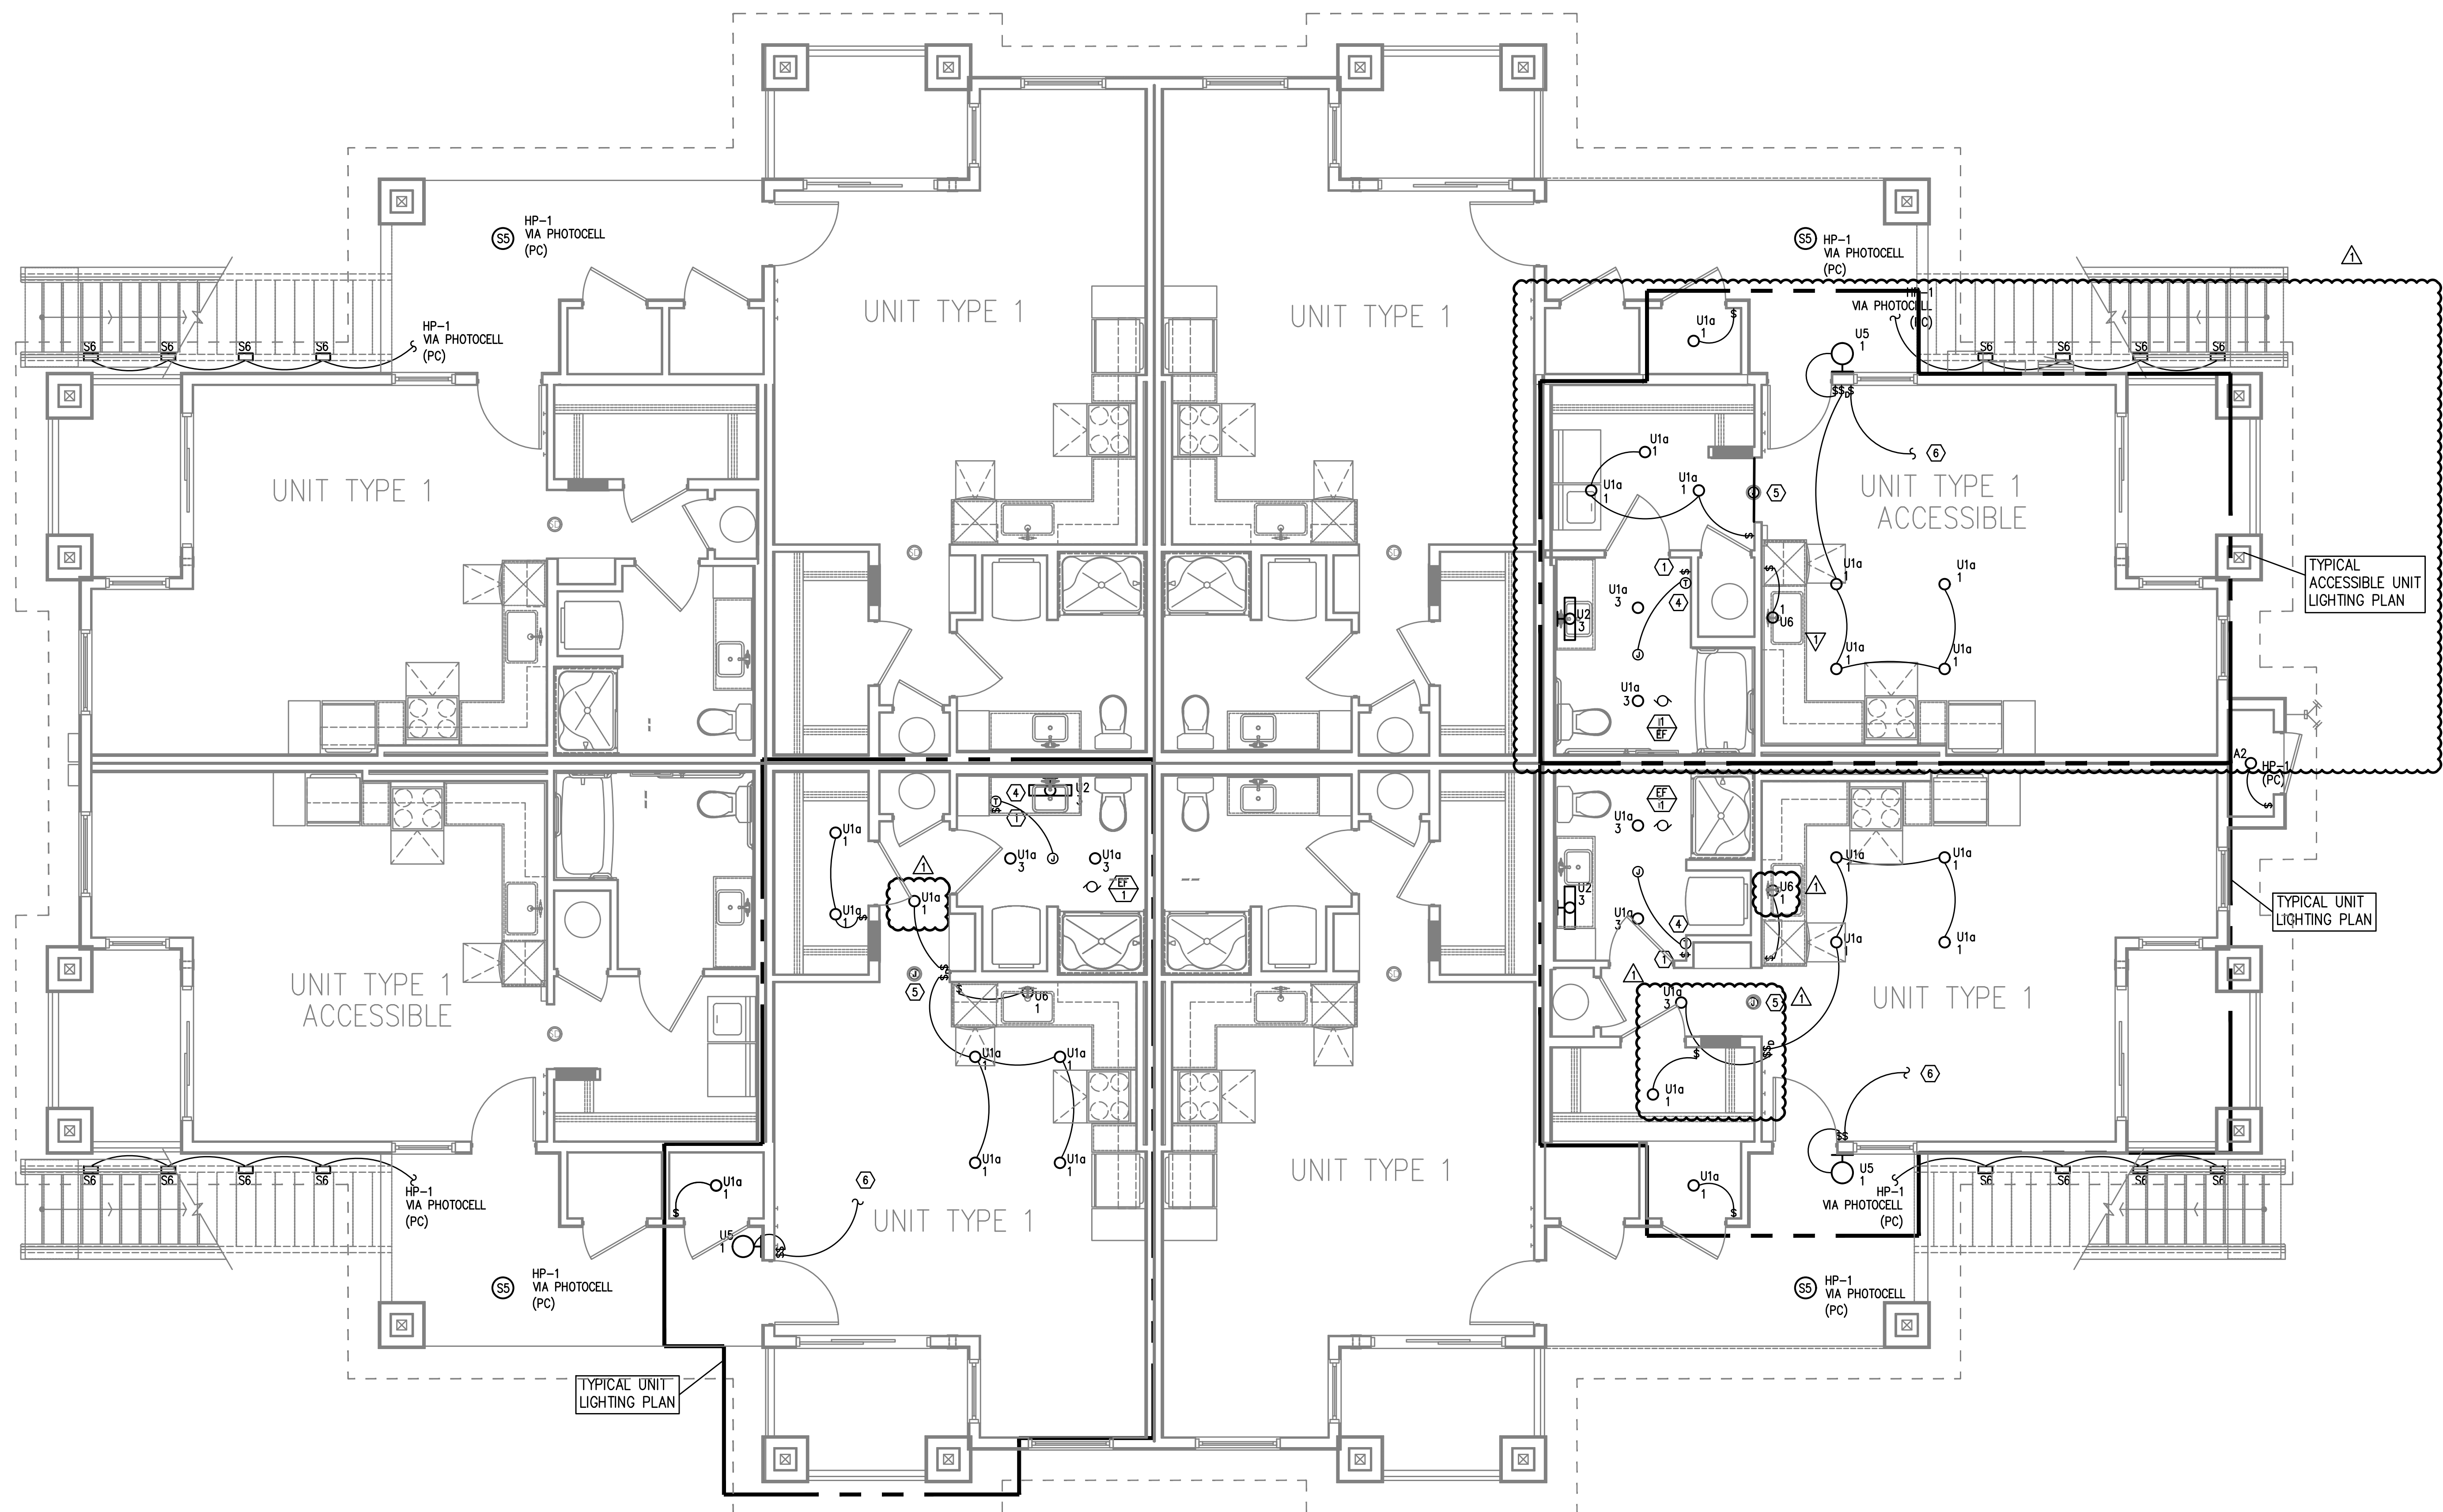

1
E2.01
BLDG TYPE A - BLDGS 'A' & 'F'
FIRST FLOOR - LIGHTING PLAN
(ACCESSIBLE)
SCALE: 1/4" = 1'-0"

GENERAL LIGHTING NOTES:

- ELECTRICAL DRAWINGS ARE DIAGRAMMATICAL AND MAY NOT ACCURATELY REFLECT ACTUAL CONSTRUCTION CONDITIONS. THE ELECTRICAL CONTRACTOR SHALL BE RESPONSIBLE FOR COORDINATING THE INSTALLATION OF ALL ELECTRICAL EQUIPMENT, WITH ALL TRADES PRIOR TO AND DURING CONSTRUCTION.
- THE ELECTRICAL CONTRACTOR SHALL REFER TO THE ARCHITECTURAL DRAWINGS FOR ALL MOUNTING HEIGHTS AND FINISHES OF DEVICES AND FIXTURES.
- REFER TO SHEET E1.21 FOR LIGHT FIXTURE SCHEDULES.
- THE CONTRACTOR SHALL CONSULT THE ARCHITECT AND/OR INTERIOR DESIGNER FOR THE EXACT LOCATION OF ALL LIGHT FIXTURES PRIOR TO THE START OF ANY ROUGH IN WORK.
- REFER TO AVAILABLE ARCHITECTURAL AND/OR INTERIOR DESIGN DOCUMENTS & DRAWINGS FOR ADDITIONAL INFORMATION.
- EXTERIOR LIGHTING TO BE CONSTANT "ON" AND PROVIDED WITH PHOTOCELL, EITHER INTEGRAL OR REMOTE) FOR DUSK-TILL-DAWN OPERATION.
- ALL EXTERIOR BUILDING LIGHTS ON HOUSE POWER SHALL BE CONSIDERED EGRESS LIGHTING. FIXTURES ARE TO BE EQUIPPED WITH BATTERY BACK-UP (EITHER INTEGRAL OR REMOTE).
- REFER TO SHEET E1.14 FOR TYPICAL UNIT LOAD CENTER DIRECTORIES.
- ALL LIGHT SWITCHES SHALL BE ROCKER STYLE, SUCH AS LEVITON DECORA, OR APPROVED EQUAL.
- REFER TO ARCHITECTURAL REFLECTED CEILING PLANS FOR EXACT FIXTURE LOCATIONS (DIMENSIONS). CONSULT INTERIOR DESIGNER FOR MOUNTING HEIGHTS NOT SPECIFIED.
- REFER TO ARCHITECTURAL PLANS REGARDING "ACCESSIBLE" UNIT LOCATION(S), INTERIOR ELEVATIONS & DETAILS. COORDINATE INSTALLATION OF ALL DEVICES PER THE "AMERICAN DISABILITIES ACT" (ADA). REFER TO SHEET E1.21 FOR STANDARD ADA REACH REQUIREMENTS.

KEYED LIGHTING NOTES:

- REFER TO TYPICAL BATHROOM SWITCHING DETAILS ON SHEET E1.21.
- PROVIDE CEILING FAN CONTROL SWITCH(ES) AS DIRECTED BY MANUFACTURER.
- PROVIDE BLOCKING AT CEILING TO SUPPORT 35LB., MINIMUM, FOR CEILING FAN INSTALLATION.
- PROVIDE WIRE CONNECTION FOR THERMOSTAT(S). COORDINATE WITH MECHANICAL INSTALLER FOR EXACT LOCATION AND POWER REQUIREMENTS PRIOR TO ROUGH IN. CEILING HEATER TO BE TIED INTO BATHROOM POWER CIRCUIT.
- COORDINATE LOCATION OF POWER CONNECTION FOR FIRE ALARM DEVICES WITH THE SYSTEM CONTRACTOR/INSTALLER.
- TO SWITCHED RECEPTACLE. REFER TO POWER PLANS (E3 SERIES SHEETS) FOR OUTLET LOCATION.