


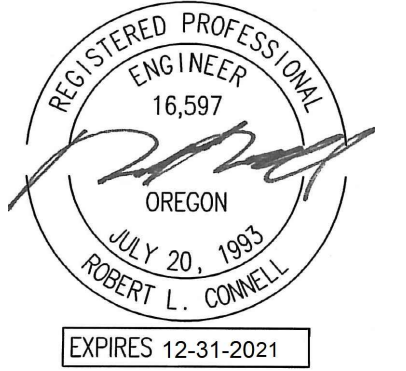

IN THE EVENT CONFLICTS ARE DISCOVERED
BETWEEN THE ORIGINAL SIGNED AND SEALED
DOCUMENTS PREPARED BY THE ARCHITECTS
AND/OR THEIR CONSULTANTS, AND ANY COPY OF
THE DOCUMENTS TRANSMITTED BY EMAIL, FAX,
ELECTRONICALLY OR OTHERWISE, THE ORIGINAL
SIGNED AND SEALED DOCUMENTS SHALL GOVERN.

PROJECT # 2019-179
DATE: 28 AUGUST 2020

REVISIONS

PLAN REVIEW 11.03.2020
PLAN REVIEW 03.19.2021

McKINNEY LANE APARTMENTS PHASE II
RUSSELL DRIVE & MCKINNEY LANE
LEBANON, OREGON

E1.00

ELECTRICAL SYMBOL LIST

LIGHTING SYMBOLS

- LIGHT FIXTURE, RECESSED
- LIGHT FIXTURE, RECESSED - EMERGENCY
- LIGHT FIXTURE, SURFACE MOUNT
- LIGHT FIXTURE, SURFACE MOUNT - EMERGENCY
- LIGHT FIXTURE, STRIP
- LIGHT FIXTURE, STRIP - EMERGENCY
- DOWNLIGHT FIXTURE, RECESSED
- DOWNLIGHT FIXTURE, RECESSED, WALLWASH
- DOWNLIGHT FIXTURE, RECESSED - EMERGENCY
- LIGHT FIXTURE, WALL MOUNT
- LIGHT FIXTURE, CEILING MOUNT
- RECESSED LIGHT FIXTURE, WALL MOUNT
- LIGHT FIXTURE, WALL MOUNT
- LIGHT FIXTURE, WALL SCONCE
- LIGHT FIXTURE, COVE - RECESSED
- LIGHT FIXTURE, COVE - SURFACE
- LIGHT FIXTURE, UNDER CABINET/SHELF
- EXIT SIGN, UNIVERSAL MOUNT, W/ DIRECTIONAL ARROW
- EXIT SIGN, WALL MOUNT, +8"-0" A.F.F.
- EMERGENCY LIGHT W/ BATTERY PACK, +8"-0" A.F.F.
- FLOOD LIGHT
- AREA LUMINAIRE, POST TOP
- AREA LUMINAIRE, BOLLARD
- AREA LUMINAIRE, WALL MOUNT
- AREA LUMINAIRE, POLE MOUNT

SWITCH SYMBOLS

- SWITCH, SPST +48" A.F.F.
- SWITCH, DPST +48" A.F.F.
- SWITCH, 3-WAY +48" A.F.F.
- SWITCH, 4-WAY +48" A.F.F.
- SWITCH, MOMENTARY +48" A.F.F.
- SWITCH, DIMMER +48" A.F.F.
- SWITCH, SPST, W/PILOT LIGHT +48" A.F.F.
- SWITCH, 3-WAY, W/PILOT LIGHT +48" A.F.F.
- SWITCH, KEY-OPERATED +48" A.F.F.
- SWITCH, TIMED +48" A.F.F.
- EXISTING SWITCH, SPST
- PHOTOCELL CONTROL
- OCCUPANCY SENSOR CONTROL

WIRING SYMBOLS

- PANEL & CIRCUIT NUMBER
- HOMERUN TO PANEL
- CONDUCTOR SIZE (IF OTHER THAN #12)
- PHASE CONDUCTOR
- NEUTRAL CONDUCTOR
- GROUND CONDUCTOR
- CONCEALED CONDUIT
- CONDUIT SIZE
- CONDUIT (UNDER SLAB OR FLOOR)
- FLEXIBLE CONNECTION
- CONDUIT, STUBBED & CAPPED
- NORMAL POWER CIRCUIT LINETYPE
- EMERGENCY POWER CIRCUIT LINETYPE
- EXISTING POWER CIRCUIT LINETYPE
- PRIMARY ELECTRICAL UTILITY FEEDER
- SECONDARY ELECTRICAL UTILITY FEEDER

FIRE-RATED INSTALLATION NOTE:

ELECTRICAL ITEMS (LIGHT FIXTURES, BOXES, ETC.) WHICH ARE RECESSED INTO FIRE-RATED CEILINGS OR WALLS, SHALL BE "ALCOVE" IN GYPSUM BOARD ENCLOSURES PER ARCHITECTURAL DETAILS, OR THE DEVICES SHALL BE "UL" LISTED WITH FIRE-RATING EQUAL TO OR GREATER THAN THE FIRE-RATING OF THE ADJACENT CONSTRUCTION.

1. SYMBOLS & ABBREVIATIONS MAY OR MAY NOT APPLY TO PROJECT
2. REFER TO LOW VOLTAGE DRAWINGS FOR ASSOCIATED SYMBOLS

POWER SYMBOLS

- RECEPTACLE, SINGLE +18" A.F.F.
- RECEPTACLE, DUPLEX +18" A.F.F.
- RECEPTACLE, QUAD +18" A.F.F.
- RECEPTACLE, DUPLEX +6" ABV COUNTER
- RECEPTACLE, DUPLEX +18" A.F.F. (ONE OUTLET SWITCHED)
- RECEPTACLE, DUPLEX +18" A.F.F. (BOTH OUTLETS SWITCHED)
- RECEPTACLE, DUPLEX, PEDESTAL MOUNT
- RECEPTACLE, DUPLEX, FLUSH FLOOR MOUNT
- RECEPTACLE, SPECIAL (COORDINATE WITH EQUIPMENT SERVED)
- RELAY
- TIME CLOCK CONTROL
- PUSHBUTTON STATION
- JUNCTION BOX
- JUNCTION BOX, EMERGENCY CIRCUIT
- THERMOSTAT
- TRANSFORMER
- DISCONNECT, NON-FUSED
- DISCONNECT, FUSED
- ELECTRICAL CONNECTION
- ELECTRICAL CONNECTION, SINGLE MOTOR
- ELECTRICAL CONNECTION, MULTI-MOTOR
- ELECTRICAL DISTRIBUTION PANEL, RECESSED
- ELECTRICAL DISTRIBUTION PANEL, SURFACE
- MISCELLANEOUS PANEL, RECESSED
- MISCELLANEOUS PANEL, SURFACE
- FLUSH FLOOR BOX (W/ DEVICES AS SHOWN ON PLAN)
- FIRE SMOKE DAMPER

ONE-LINE DIAGRAM SYMBOLS

- ELECTRICAL DISTRIBUTION PANELBOARD (MLO)
- ELECTRICAL DISTRIBUTION PANELBOARD (MCB)
- SUB-FEED CIRCUIT BREAKER
- CIRCUIT BREAKER (TRIP RATING & POLES AS INDICATED ON PLAN)
- MAIN SWITCH (RATING & POLES AS INDICATED ON PLAN)
- FUSE (RATING & CLASS AS INDICATED ON PLAN)
- TRANSFER SWITCH (MANUAL OR AUTOMATIC)
- GENERATOR (RATING AS INDICATED ON PLAN)
- TRANSFORMER (RATING AS INDICATED ON PLAN)
- FUSE (RATING & CLASS AS INDICATED ON PLAN)
- GROUND SYSTEM (SIZE AS INDICATED ON PLAN)
- WATER PIPE GROUND ELECTRODE
- TRANSIENT VOLTAGE SURGE SUPPRESSOR
- UTILITY METER & METER BASE
- UTILITY METER CURRENT TRANSFORMER
- FEEDER NO. (SEE FEEDER SCHEDULE)
- POTENTIAL TRANSFORMER (RATING AS INDICATED ON PLANS)

ABBREVIATIONS

- 'A' LIGHT FIXTURE TYPE (SEE FIXTURE LIST)
- A.F.F. ABOVE FINISHED FLOOR
- A.F.G. ABOVE FINAL GRADE
- A.F.I. ARC FAULT INTERRUPTER
- A.T.S. TRANSFER SWITCH, AUTOMATIC
- C CONDUIT
- C.O. CONDUIT ONLY
- CAV. CABLE TELEVISION
- CB CIRCUIT BREAKER
- CCTV CLOSED CIRCUIT TELEVISION
- C.T. CURRENT TRANSFORMER
- (E) EXISTING
- E.L. EMERGENCY LIGHT
- E.L.C. EXTERIOR LIGHTING CONTROL
- FACP FIRE ALARM CONTROL PANEL
- G.F.I. GROUND FAULT INTERRUPTER
- GND GROUND
- H.I.D. HIGH INTENSITY DISCHARGE
- HP HORSEPOWER
- I.G. ISOLATED GROUND
- I R INFRARED
- JB JUNCTION BOX
- LCP LIGHTING CONTROL PANEL
- MCB MAIN CIRCUIT BREAKER
- MLO MAIN LUSS ONLY
- M.T.S. TRANSFER SWITCH, MANUAL
- (N) NEW
- N.I.C. NOT IN CONTRACT
- N.L. NIGHT LIGHT
- OL OVERLOAD
- O.L.C. OFFICE LIGHTING CONTROL
- P POLE
- P.A. PUBLIC ADDRESS
- PC PARTIAL CIRCUIT
- PH PHASE
- PRI PRIMARY
- R.T.U. REMOTE TELEMETRY UNIT
- SEC SECONDARY
- SCCR SHORT CIRCUIT CURRENT RATING
- T.V.S.S. TRANSIENT VOLTAGE SURGE SUPPRESSOR
- U.G. UNDERGROUND
- U.O.N. UNLESS OTHERWISE NOTED
- VFD VARIABLE FREQUENCY DRIVE
- W WIRE
- W.G. WIRE GUARD
- W.P. WEATHERPROOF
- W.T. WATERTIGHT
- X.P. EXPLOSION PROOF

NOTATIONS

- DRAWING NOTE
- DETAIL REFERENCE: TOP=DETAIL NO., BOTTOM=SHEET NO.
- MECHANICAL EQUIPMENT MARK NO. (SEE EQUIPMENT SCHEDULE)
- EQUIPMENT NO. (SEE EQUIPMENT SCHEDULE)
- EQUIPMENT NO. (SEE EQUIPMENT SCHEDULE)
- EQUIPMENT NO. (SEE EQUIPMENT SCHEDULE)
- FIXTURE REFERENCE: TOP=TYPE, BOTTOM=LAMP QTY & WATTS

GENERAL CONSTRUCTION NOTES:

CONTRACTOR SHALL BE RESPONSIBLE FOR THOROUGHLY REVIEWING THE PLANS AND SPECIFICATION DOCUMENTS PRIOR TO THE START OF ANY WORK. ANY DISCREPANCIES IN THE PROJECT DOCUMENTS SHALL BE BROUGHT TO THE ATTENTION OF THE ARCHITECT IMMEDIATELY AND PRIOR TO THE START OF ANY WORK.

ALL DIMENSIONS ARE MEASURED TO THE CENTER OF THE DEVICE ABOVE FINISHED FLOOR UNLESS OTHERWISE NOTED AS IS STANDARD BUILDING PRACTICE.

ALL ELECTRICAL PLANS ARE DIAGRAMMATICAL AND THE CONTRACTOR SHALL CONSULT THE ARCHITECTURAL PLANS AND ELEVATIONS FOR EXACT LOCATION AND MOUNTING HEIGHTS OF DEVICES AND FIXTURES.

THE ELECTRICAL CONTRACTOR SHALL REVIEW ALL PROJECT DOCUMENTATION AND COORDINATE WITH ALL OTHER TRADES THROUGHOUT THE COURSE OF THE PROJECT.

ALL WORK SHALL BE IN ACCORDANCE WITH ALL NATIONAL, STATE AND LOCAL CODES. CONTRACTOR SHALL BE RESPONSIBLE TO BE INFORMED OF ALL SUCH CODES AS THEY APPLY TO THE SCOPE OF THE PROJECT.



IN THE EVENT CONFLICTS ARE DISCOVERED
BETWEEN THE ORIGINAL SIGNED AND SEALED
DOCUMENT PREPARED BY THE ARCHITECT
AND/OR OTHER CONSULTANTS, AND ANY COPY OF
THE DOCUMENTS TRANSMITTED BY EMAIL, FAX,
ELECTRONICALLY OR OTHERWISE, THE ORIGINAL
SIGNED AND SEALED DOCUMENTS SHALL GOVERN.

PROJECT # 2019-179
DATE: 28 AUGUST 2020

REVISIONS

PLAN REVIEW 11.03.2020
PLAN REVIEW 03.19.2021

GENERAL NOTES:


- ALL WORK SHALL BE PERFORMED IN ACCORDANCE WITH ALL APPLICABLE LOCAL, STATE AND NATIONAL CODES.
- ELECTRICAL PLANS ARE DIAGRAMMATIC AND MAY OR MAY NOT REFLECT ACTUAL FIELD CONDITIONS.
- REFER TO LIGHTING PLANS FOR BUILDING MOUNTED LIGHT FIXTURE LOCATIONS.
- COORDINATE WITH LOCAL UTILITY PROVIDER FOR EXACT SERVICE CONDUIT AND CONDUCTORS REQUIREMENTS.
- ALL UTILITY WORK SHALL BE DONE IN ACCORDANCE WITH CLARK PUBLIC UTILITIES ELECTRICAL SERVICE REQUIREMENTS.
- U.G. PRIMARY FEEDER SHALL HAVE A MINIMUM 48 INCH BURY.
- U.G. SECONDARY FEEDER SHALL HAVE A MINIMUM 36 INCH BURY.
- REFER TO SHEET E1.11 FOR ONE-LINE DIAGRAM, LOAD SUMMARY INFORMATION AND TYPICAL FEEDER SCHEDULE.
- SECONDARY CONDUIT SWEEPS SHALL BE MINIMUM 60 INCH RADIUS WITH A MINIMUM OF 7'-0" STRAIGHT CONDUIT RUN BETWEEN SWEEPS.
- CONTRACTOR SHALL REVIEW THE UTILITY PROVIDER'S ELECTRICAL SERVICE REQUIREMENTS PRIOR TO THE START OF ANY WORK.
- LOCATION AND INSTALLATION OF THE PRIMARY AND SECONDARY CONDUITS, TRANSFORMER, ETC. SHALL BE PROVIDED PER UTILITY PROVIDER'S ELECTRICAL SERVICE REQUIREMENTS.
- CONTRACTOR SHALL REVIEW ALL PROJECT DOCUMENTS AND SPECIFICATIONS IN DETAIL AND REFER TO THE DOCUMENTS THROUGHOUT THE CONSTRUCTION.
- CONTRACTOR SHALL CONSULT WITH THE CIVIL ENGINEER TO IDENTIFY ALL EXISTING UNDERGROUND UTILITIES PRIOR TO ANY TRENCHING.
- TRENCHING AND UNDERGROUND UTILITY CONDUIT RUNS SHALL BE PERFORMED IN COORDINATION WITH THE CIVIL PLANS.

KEYED POWER NOTES:

- 1" PVC CONDUIT ROUTED UNDER GROUND FROM HOUSE PANEL TO BUILDING DISCONNECT SWITCH. REFER TO PANEL SCHEDULES ON SHEET E1.11 FOR ADDITIONAL INFORMATION.
- PROVE WEATHER PROOF GFCI 20A 120V DUPLEX RECEPTACLES AT WATER VAULT(S) AS DIRECTED BY CIVIL ENGINEER. ROUTE EACH CIRCUIT IN 3/4" PVC CONDUIT UNDER GROUND FROM THE BUILDING #6 HOUSE PANEL.
- PROVIDE ONE EMPTY 1" PVC CONDUIT WITH PULL STRING FOR FUTURE POOL ELECTRICAL PANEL, ROUTED UNDERGROUND FROM CLUBHOUSE PANEL 'CH' TO THE EQUIPMENT PANEL AT THE POOL EQUIPMENT ROOM. A 60A, 208V, 1P DISCONNECT SHALL BE LOCATED AT THE BUILDING EXTERIOR, AHEAD FOR THE PANEL. REFER TO E5.02 FOR ADDITIONAL INFORMATION.
- ELECTRICAL CONTRACTOR SHALL COORDINATE WITH THE POOL EQUIPMENT INSTALLER TO PROVIDE AND INSTALL THE APPROPRIATE DISCONNECT MEANS FOR THE POOL EQUIPMENT FROM THE PANEL AT THE EQUIPMENT ROOM, AND PROVIDE FINAL ELECTRICAL CONNECTION(S).

UTILITY REQUIREMENTS

- CUSTOMER TO PROVIDE ALL TRENCHING AND BACKFILLING. TRENCH TO BE 36 INCHES DEEP AND 30 INCHES WIDE, MEASURED FROM FINAL GRADE.
- ALL UTILITY CONDUCTORS TO BE INSTALLED IN GRAY SCHEDULE 40, ELECTRICAL GRADE, PVC CONDUIT WITH NYLON PULL STRINGS (MIN 500 LBS. TEST). CLARK PUBLIC UTILITIES TO DETERMINE THE SIZE AND NUMBER OF CONDUITS REQUIRED. ALL ELBOWS TO BE 36 INCH (MIN) RADIUS. ALL BENDS MAY BE FACTORY MADE. IF MORE THAN 270 DEGREES OF BENDS OR IF RUN IS LONGER THAN 150 FEET, BENDS MUST BE RIGID STEEL.
- CONSULT WITH UTILITY REPRESENTATIVE 2 WEEKS BEFORE STARTING MAIN POWER TRENCHING FOR A PRE-CONSTRUCTION CONFERENCE. INCLUDED IN THIS CONFERENCE WILL BE EXCAVATOR, CPU, TELCO, CATV, AND GAS.

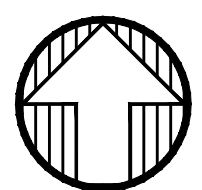

1 SITE ELECTRICAL UTILITY PLAN
E1.01 SCALE: 1" = 30'-0"

MCKINNEY LANE APARTMENTS PHASE II
RUSSELL DRIVE & MCKINNEY LANE
LEBANON, OREGON




GENERAL SITE LIGHTING NOTES:

- ALL WORK SHALL BE PERFORMED IN ACCORDANCE WITH ALL APPLICABLE LOCAL, STATE AND NATION CODES.
- ALL PLANS ARE CONSIDERED DIAGRAMMATICAL. THEREFORE ALL EQUIPMENT SIZES AND DEVICE LOCATIONS ARE APPROXIMATE AND SUBJECT TO FIELD CONDITIONS AND PRODUCT APPROVAL.
- REFER TO SHEETS E1.11 FOR ONE-LINE DIAGRAM, LOAD SUMMARY INFORMATION AND TYPICAL FEEDER SCHEDULE.
- REFER TO SHEETS E2 SERIES SHEETS FOR EXTERIOR BUILDING LIGHTS.
- REFER TO SHEET E1.21 FOR LIGHT FIXTURE SCHEDULE.

KEYED POWER NOTES:

- 3/4" PVC CONDUIT ROUTED UNDER GROUND FROM HOUSE PANEL TO BUILDING STRUCTURE FOR LIGHTING CIRCUIT(S). REFER TO PANEL SCHEDULES ON SHEET E1.11 FOR ADDITIONAL INFORMATION.
- 3/4" PVC CONDUIT ROUTED UNDER GROUND FROM HOUSE PANEL TO WEATHER PROOF J-BOX FOR MONUMENT SIGN LIGHTING. REFER TO PANEL SCHEDULES ON SHEET E1.11 FOR ADDITIONAL INFORMATION.

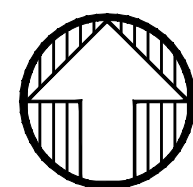

1 SITE LIGHTING PLAN
E1.02 SCALE: 1" = 30'-0"



LUMINAIRE SCHEDULE									
Symbol	Label	Qty	Catalog Number	Description	Lamp	File	Lumens	LLF	Watts
	S1	13	AA-20166-1-W30-Rev 2	Atlantic sheppards crook single medium shade post top LED	1 LED COB 3000K 0.4247/0.3936 3130K Ra84	S1 AA-20166-1-W30-Rev 2 IES	Absolute	1.00	41.2
	S2	40		photopiaALMINRF-L18-VF20photopia	LED 0.959W XLAMP OUTDOOR WHITE (350MA) (CORE ONLY)	S2 NRF-LE070-L18-30-CNS-VF20-ULS-IES	Absolute	1.00	70
	S3	5	AA-30186-1-W30-Rev 2	Atlantic sheppards crook medium shade wall light LED	1 LED COB 3000K 0.4247/0.3936 3130K Ra84	S3 AA-30186-1-W30-Rev 2 IES	Absolute	1.00	41.2
	S4	17	FEM L48 3000LM LPPFL PGD 90CRI 30K	FEM LED 48", 3,000 lumens, polycarbonate, low profile frosted lens, parking garage distribution, 90 CRI, 3000 K		S4 FEM L48_300 0LM_LPPFL_P GD_90CRI_30 K.ies	Absolute	1.00	18.05

STATISTICS						
Description	Symbol	Avg	Max	Min	Max/Min	Avg/Min
Parking 1	+	0.9 fc	3.8 fc	0.2 fc	19.0:1	4.5:1
Parking 2	+	0.9 fc	4.4 fc	0.2 fc	22.0:1	4.5:1
Parking 3	+	0.8 fc	3.8 fc	0.2 fc	19.0:1	4.0:1
Parking 4	+	1.2 fc	8.5 fc	0.3 fc	28.3:1	4.0:1
Parking 5	+	0.6 fc	2.1 fc	0.2 fc	10.5:1	3.0:1



- NOTES:
1. Photometric studies are for reference only and shall not be used for construction purposes. Refer to the electrical site plan sheet, E1.02 for additional information.
 2. Photometric data is based on manufacturer provided IES files. Illuminance calculations are approximate and may differ from actual field measurements.
 3. Refer to Light Fixture Schedule on sheet E1.21 for fixture type, lamp, and pole heights.
 4. Data does not factor in existing light fixtures on adjacent properties or at the street.
 5. For the purposes of this study, areas with "0.0" lumen levels have been masked to provide the statistics shown in the table.
 6. This study does not factor in building mounted light fixtures (other than those at the garages).



LUMINAIRE SCHEDULE									
Symbol	Label	Qty	Catalog Number	Description	Lamp	File	Lumens	LLF	Watts
	S1	13	AA-20166-1-W30-Rev.2	Atlantic sheppards crook single medium shade post top LED	1 LED COB 3000K 0.4247 0.3936 3130K Ra84	S1 AA-20166-1-W30-Rev.2 IES	Absolute	1.00	41.2
	S2	41		photopiaALMRF-L18-YF2photopia	LED 0.959W XLAMP OUTDOOR WHITE (350MA) (CORE ONLY)	S2 NRFL-LE070-418-30-CNS-V720-UE3.98	Absolute	1.00	70
	S3	5	AA-30166-1-W30-Rev.2	Atlantic sheppards crook medium shade wall light LED	1 LED COB 3000K 0.4247 0.3936 3130K Ra84	S3 AA-30166-1-W30-Rev.2 IES	Absolute	1.00	41.2
	S4	17	FEM L48 3000LM LPFLL PCGD 90CRI 30K	FEM LED 48", 3000 lumens, polycarbonate, low profile frosted lens, parking garage distribution, 90 CRI, 3000 K		S4 FEM L48-300 OLM LPFLL_P 90CRI_30 K ies	Absolute	1.00	18.05

STATISTICS						
Description	Symbol	Avg	Max	Min	Max/Min	Avg/Min
Blgd 5 & Grounds	+	2.3 fc	6.6 fc	0.3 fc	22.0:1	7.7:1
Blgd 6 Walks	+	2.2 fc	4.9 fc	0.2 fc	24.5:1	11.0:1
Blgd #2, 3, 4	+	2.4 fc	6.0 fc	0.2 fc	30.0:1	12.0:1
Clubhouse/Blgd #1 Walks	+	2.3 fc	5.0 fc	0.4 fc	12.5:1	5.8:1

- NOTES:
1. Photometric studies are for reference only and shall not be used for construction purposes. Refer to the electrical site plan sheet, E1.02 for additional information.
 2. Photometric data is based on manufacturer provided IES files. Illuminance calculations are approximate and may differ from actual field measurements.
 3. Refer to Light Fixture Schedule on sheet E1.21 for fixture type, lamp, and pole heights.
 4. Data does not factor in existing light fixtures on adjacent properties or at the street.
 5. For the purposes of this study, areas with "0.0" lumen levels have been masked to provide the statistics shown in the table.
 6. This study does not factor in building mounted light fixtures (other than those at the garages).

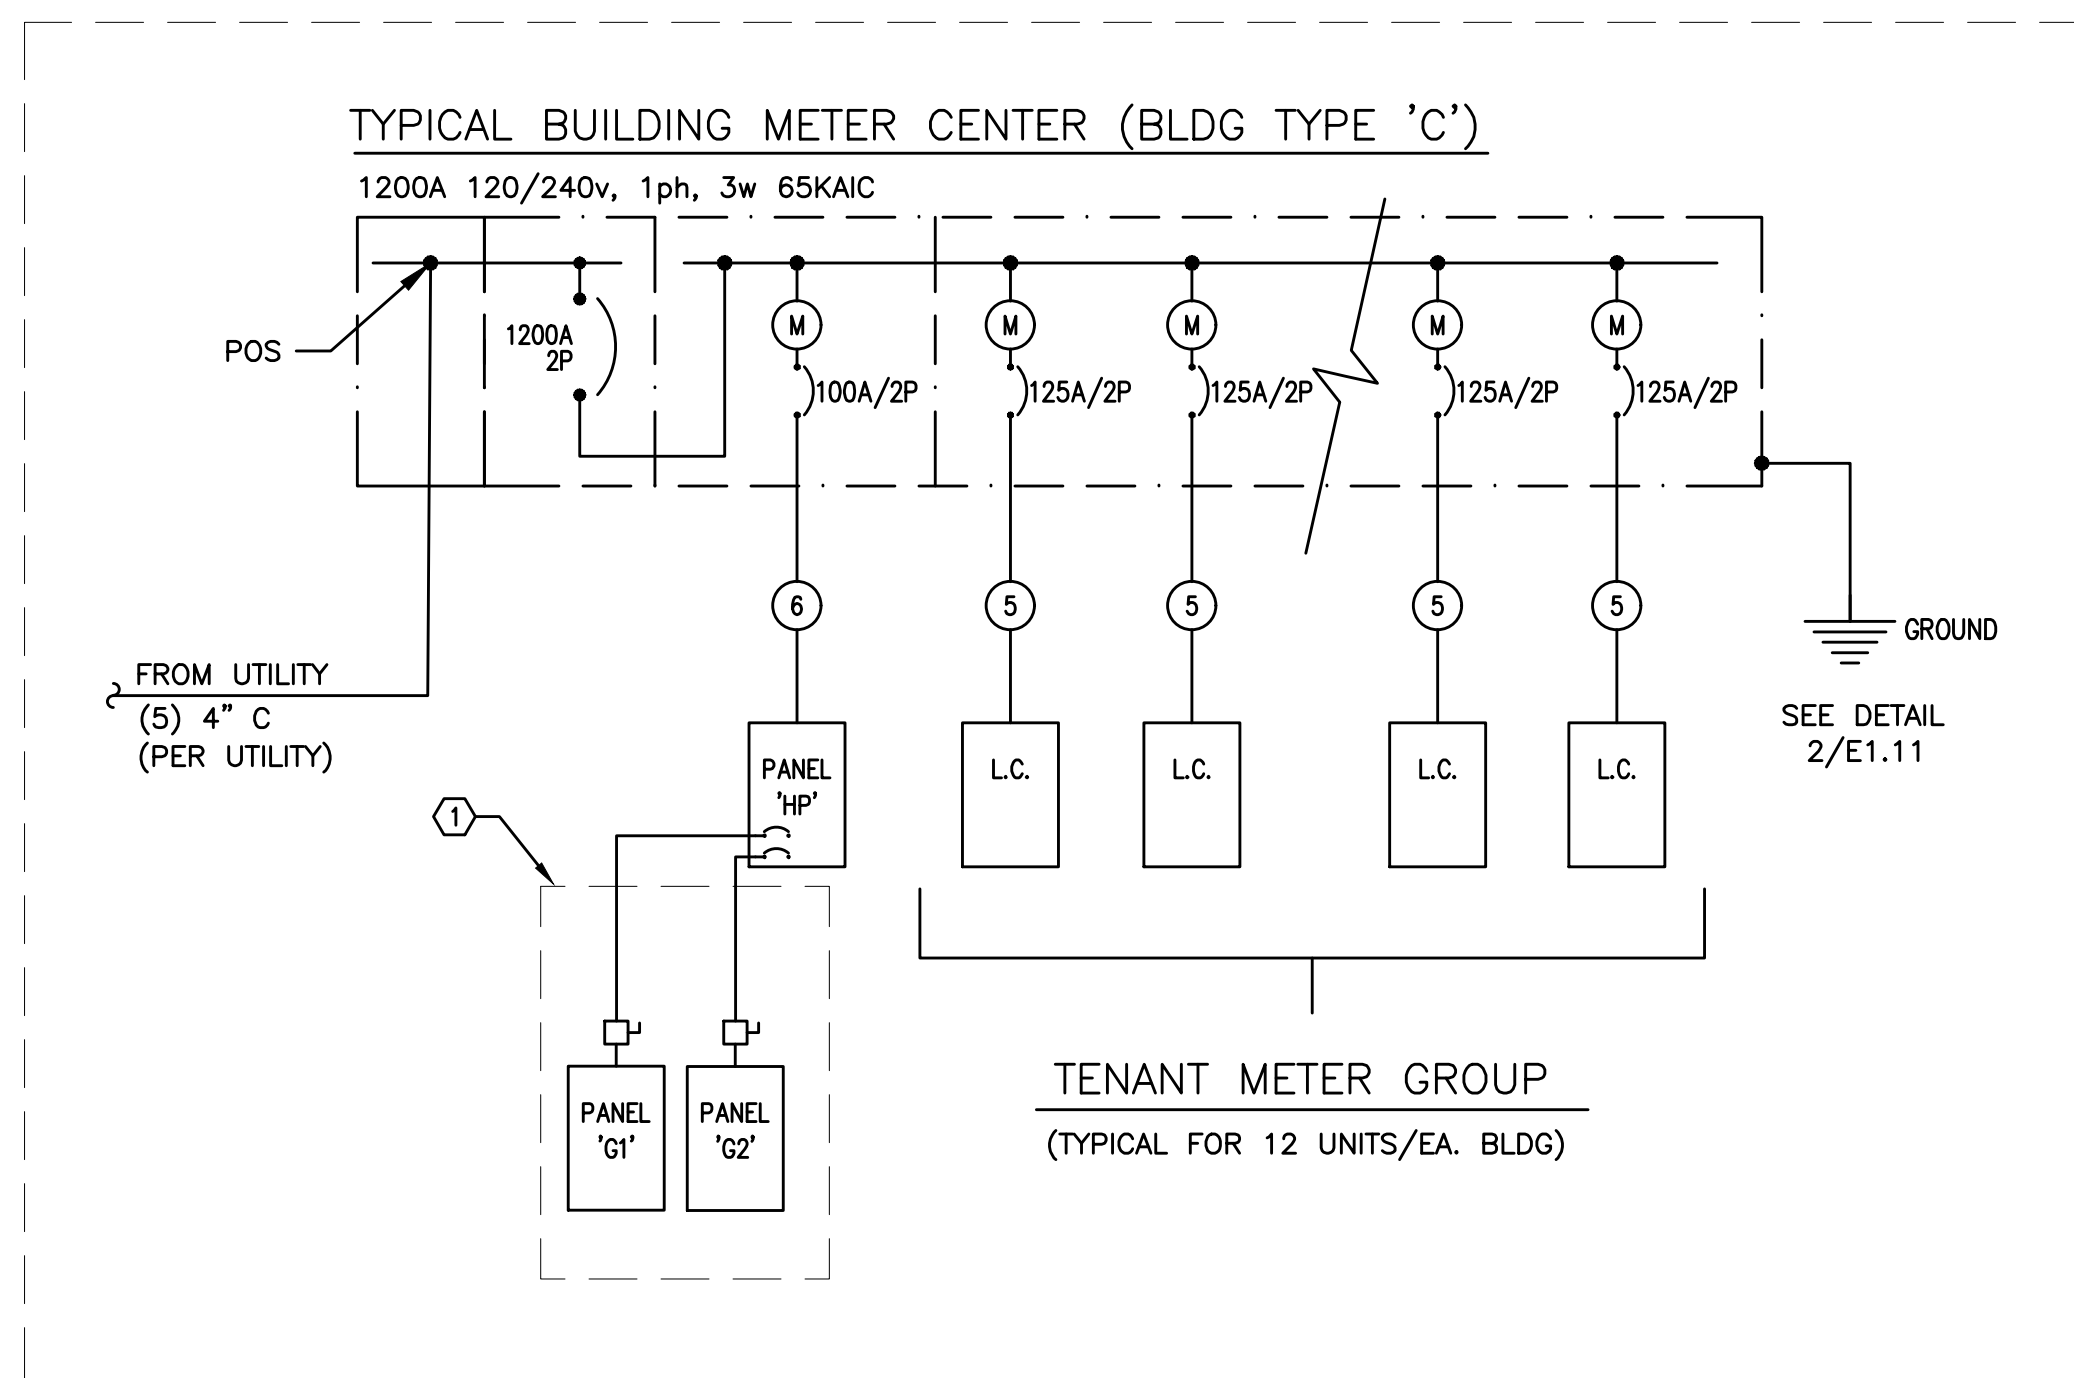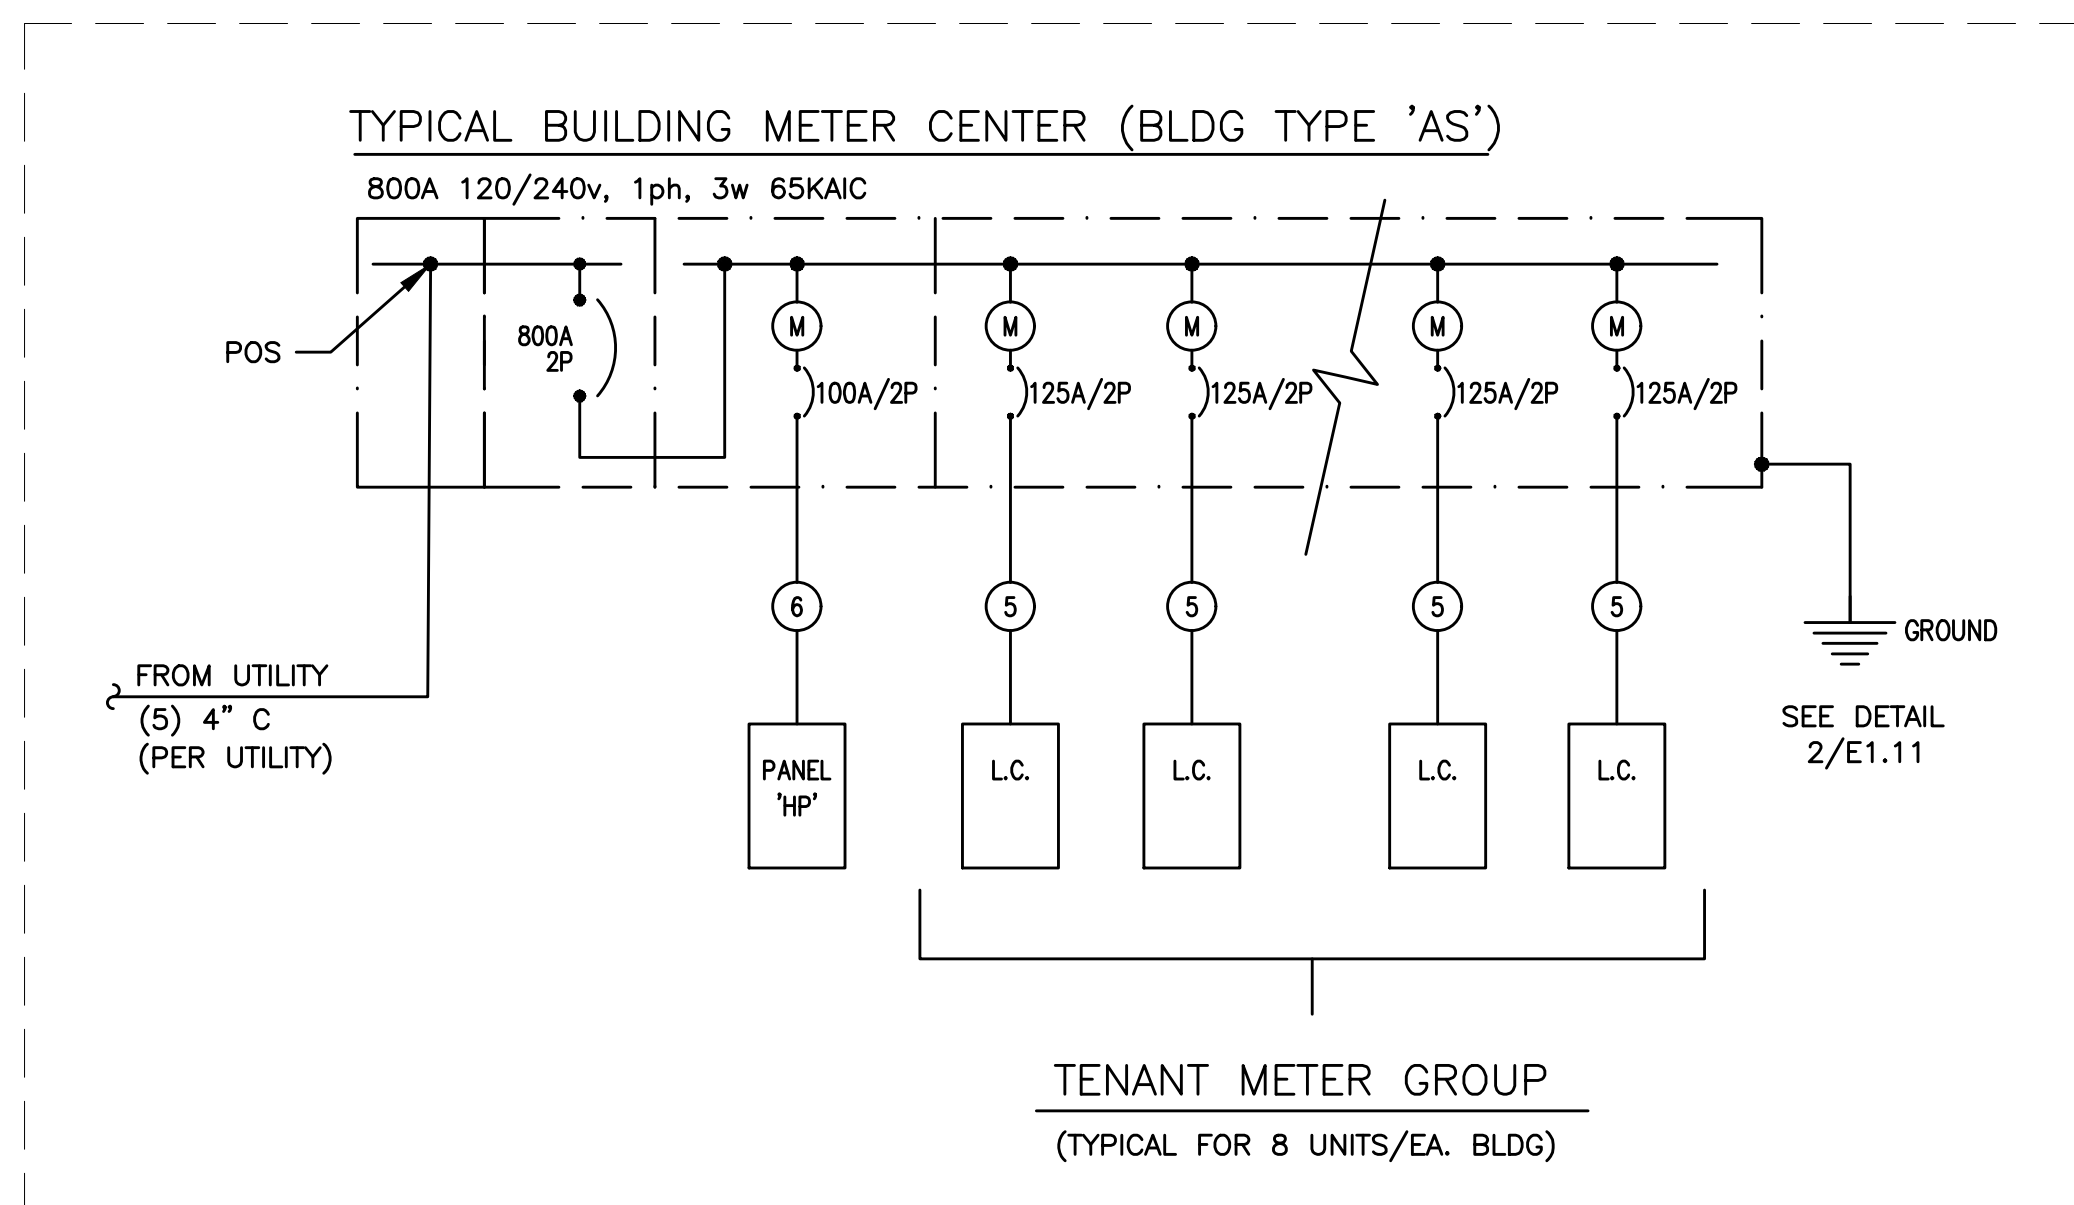

MECHANICAL EQUIPMENT SCHEDULE									
NO.	EQUIPMENT NAME	HP/KW	VOLTS	PH	AMPS	CONDUIT	WIRE	GND	CIRCUIT
EF-1	EXHAUST FAN NO.1	11.7W	120	1		1/2"	#12	#12	SEE POWER PLANS
EH-1	ELECTRIC WALL HEATER NO.1	4.0 KW	240	1		1/2"	#12	#12	SEE POWER PLANS
EH-2	ELECTRIC WALL HEATER NO.2	500W	120	1		1/2"	#12	#12	SEE POWER PLANS
EH-3	ELECTRIC WALL HEATER NO.3	1.5 KW	240	1		1/2"	#12	#12	SEE POWER PLANS
EH-4	ELECTRIC WALL HEATER NO.4	500W	120	1		1/2"	#12	#12	SEE POWER PLANS
F-1	FAN COIL NO.1		120	1	11.7 MCA	1/2"	#12	#12	CH2-3
CU-1	CONDENSER NO.1		120	1		3/4"	#8	#10	CH2-5,7
F-2	FAN COIL NO.2		240	1	11.7 MCA	1/2"	#12	#12	CH2-9
CU-2	CONDENSER NO.2		240	1		3/4"	#8	#10	CH2-11,13
WH-1	WATER HEATER NO.1	4.5 KW	240	1		1/2"	#12	#12	SEE POWER PLANS

A. CONTRACTOR/DESIGNER SHALL VERIFY ALL MECHANICAL EQUIPMENT CONNECTION LOAD REQUIREMENTS WITH THE MECHANICAL EQUIPMENT PROVIDER PRIOR TO ROUGH IN.

B. MECHANICAL EQUIPMENT SIZES SHOWN IN THE MECHANICAL SCHEDULE ABOVE ARE FOR REFERENCE ONLY AND MAY NOT REFLECT THE ACTUAL EQUIPMENT TO BE INSTALLED.



FEEDER SCHEDULE (COPPER)					
NO.	AMPS	CONDUIT	CONDUCTOR		
(1)		*5" 4"	BY UTILITY CO.	& (1)	GND
(2)	1200A	4"	ea w/ (3) #60AKcmil	& (1) #3/0 GND	
(3)	800A	4"	ea w/ (3) #60AKcmil	& (1) #1/0 GND	
(4)	400A	3"	ea w/ (3) #500Kcmil	& (1) #3 GND	
(5)	125A	1 1/2"	(3) #1	& (1) #6 GND	
(6)	100A	1 1/2"	(3) #1	& (1) #8 GND	
(7)	60A	1"	(3) #4	& (1) #10 GND	

ONE-LINE GENERAL NOTES:

A. COORDINATE ALL WORK ASSOCIATED WITH ELECTRIC SERVICE WITH LOCAL UTILITY. PROVIDE ALL CONDUIT & CONDUCTORS, GROUNDING, TRANSFORMER VAULT/PAD, ETC., IN ACCORDANCE WITH SERVING UTILITY REQUIREMENTS.

B. COORDINATE METERING REQUIREMENTS WITH UTILITY.

C. FOR LOAD CENTER FEEDER LENGTHS GREATER THAN 145'-0" FROM METER CENTER, INCREASE WIRE SIZE ONE SIZE UP FOR VOLTAGE DROP.

ONE-LINE KEYED NOTES:

- ① GARAGES SUB-FED FROM BUILDING #3 ONLY.
- ② PROVIDE GROUNDING AS REQUIRED BY CODE.

MFA PANEL SCHEDULE															18-Mar-21	
panel Pnt HP (Typical) voltage 120/240V			mounting *Marco NEMA 3R phase 1			location Bldg Exterior bus & main			connected load							
service			va			L2			MLO			calculated load				
120/240V			va			L2			MLO			169				
C	1	LTS + RECPY = BLDG INT	500	20/1	3	0	4/5	20/1	0	0	0	0	0	1		
	2	EH-4 = RISER ROOM	500	20/1	3	0	4/5	20/1	0	0	0	0	0	1		
	3	SPARE	250	20/1	3	0	4/5	20/1	0	0	0	0	0	1		
	4	SPARE	250	20/1	3	0	4/5	20/1	0	0	0	0	0	1		
	5	*GARAGE #1	11500	125/2	9	1	100	125/2	11500	8500	0	0	0	7		
	6	BLANK	0	0	0	0	0	0	0	0	0	0	0	0		
	7	BLANK	0	0	0	0	0	0	0	0	0	0	0	0		
	1															

MFA PANEL SCHEDULE										19-Mar-21	
panel PANEL CH1 (CLB/HOUSE)		mounting Norma NF8A 31		location building & room		connected load		318			
voltage 120/240V		voltage		bus & mt		calculated load					
C	service	va	501	1	400A	va	501	va	320		
1	LIGHTS - SITE	20	20	L1	L2	20/1	140	RECEPTACLES	2		
1	LIGHTS - BLDG EXTERIOR	531	20	1	3	20/1	720	RECEPTACLES	2		
1	LIGHTS - INTERIOR	960	5	1	5	20/1	720	RECEPTACLES	2		
1	LIGHTS - INTERIOR	136	20	7	8	20/1	1260	RECEPT & #5 KEG COOLER	2		
1	LIGHTS - INTERIOR	780	19	9	10	20/1	900	DISPOSAL	2		
2	RECEPTACLES	1440	20	11	12	20/1	1000	UC FUDGE #1	5		
2	RECEPTACLES	900	20	13	14	20/1	1500	UC ICE MAKER #4	5		
2	RECEPTACLES	900	20	15	16	20/1	1500	WARMING DRAWER #6	5		
2	RECEPTACLES	900	20	17	18	20/1	1500	MICROWAVE #7	5		
5	TREASURM	1500	20	19	20	20/1	1500	FIRE PLACE & SHUT OFF	5		
5	WATER HEATER WH-1	1500	20	21	22	20/1	1500	COFFEE MAKER #20	5		
5	WATER HEATER WH-1	1500	20	23	24	20/1	1500	WATER FOUNTAIN	5		
5	WATER HEATER WH-1	1500	25	25	26	20/1	1500	AIRCRAFT CONTROL SYSTEM	5		
5	WATER HEATER WH-1	1500	20	27	28	20/1	1500	UC FUDGE #1	5		
5	WATER HEATER WH-1	1500	29	30	30	20/1	1500	MICROWAVE #2	5		
5	WATER HEATER WH-2	1000	20	31	32	20/1	0	0 SPARE	5		
5	WATER HEATER WH-2	1000	20	33	34	20/1	0	0 SPARE	5		
5	WATER HEATER WH-2	1000	20	35	36	20/1	0	0 SPARE	5		
5	WATER HEATER WH-2	1000	20	37	38	20/1	0	0 SPARE	5		
5	WATER HEATER WH-2	1000	20	39	40	20/1	0	0 SPARE	5		
5	WATER HEATER WH-2	1000	20	41	42	20/1	0	0 SPARE	5		
NOTES											
Line 2						3983.5 VA		line-voltage			
Line 2						3983.5 VA		240			
Total Connected						76287 VA		largest motor (n)			
load code:		line 1		line 2		total factor		calculated load			
1.	LIGHTS	1170	669	VA	2439	1.25	3049				
2.	RECEPT	4320	4320	VA	5400	1.0	5400				
3.	HEATING	4000	4000	VA	8000	1.00	8000				
4.	ITCHEN	0	0	VA	0	1.00	0				
5.	EQUIP	9900	8000	VA	18900	1.00	18900				
6.	MOTORS	0	0	VA	0	1.00	0				
7.	SUB-PANEL	1234	2094	VA	3528	1.00	3528				
1% fudge of the largest motor + 100% of the balance											
TOTAL = 76877											

MFA PANEL SCHEDULE										25-Aug-20	
panel		mounting		location		connected					
PANEL CH2 (CLUBHOUSE)		Surface NEMA 3R		BUILDING EXTERIOR		va		101			
voltage		phase		bus & main		calculated load		101			
120/240V		v		125A		MLO		service			
C	5 GAS GRILLS & SHUT OFF	1500	20/1	1	*	2	26/1	1500	FA/TELECOM		
5	7 F-1	1356	26/1	3	*	4	20/1	1500	SECURITY		
6	Q1-1	3144	40/2	5	*	6	20/1	1500	IRIGATION		
6	F-2	3144	40/1	7	*	8	20/1	1500	AUTO DOORS		
6	Q2-2	3144	40/2	11	*	12	20/1	1500	WORM SIGN		
6		3144	40/1	13	*	14	20/1	1500	SPARE		
	SPARE	15	20/1	15	*	16	20/1	1500	SPARE		
	BLANK	17	18	17	*	18		BLANK			
	BLANK	19	19	20	*	20		BLANK			
	BLANK	21	21	22	*	23		BLANK			
	BLANK	23	23	24	*	24		BLANK			
	BLANK	25	25	26	*	26		BLANK			
	BLANK	27	27	28	*	28		BLANK			
	BLANK	29	30	30	*	30		BLANK			
	BLANK	31	31	32	*	32		BLANK			
	BLANK	33	33	34	*	34		BLANK			
	BLANK	35	35	36	*	36		BLANK			
	BLANK	37	37	38	*	38		BLANK			
	BLANK	39	39	40	*	40		BLANK			
	BLANK	41	41	42	*	42		BLANK			
Line 1	13644	VA									
Line 2	10644	VA									
NOTES: line-line voltage											
*PROVIDE PANEL WITH LOCKING COVER.											
Total Connected		24288	VA					largest motor (va)	240		
load code:		line 1	line 2	2	VA	total	VA	calculated load (va)	0		
1.	LIGHTS=	0	0	0	VA	0	1.25		0		
2.	RECORD=	0	0	0	VA	0.9	0.5		0		
3.	HEATING=	1356	1356	0	VA	2712	1.00		2712		
4.	MOTEN=	0	0	0	VA	0	1.00		0		
5.	CLUP=	6000	3000	0	VA	9000	1.00		9000		
6.	MOTORS=	6288	6288	0	VA	12576	1.00		12576		
7.	SUB-PANEL=	0	0	0	VA	0	1.00		0		
1% slack of the largest motor + 100% of the balance											
0.00 = 24288											

McKinney Lane Phase II																	
RESIDENTIAL LOAD SUMMARY – Bldg Type "C"																	
UNIT TYPE:	OY PER FLOOR				TOTAL	AC (SF)	LTV/RECEPT (3VA / SF)	SM APPL (1500VA X 2)	LAUDRY (1500VA)	COOKING (CONNECTED)	MICROWAVE (CONNECTED)	DISHWASHER (CONNECTED)	ELECT DRYER (CONNECTED)	WATER HEATER (CONNECTED)	DISPOSAL (CONNECTED)	MOTORS (CONNECTED)	LARGEST OF AC/HEATING (CONNECTED)
	LW	1	Lvl	2													
Typical Studio Unit	0	0	0	0	0	500	1500	3000	1500	16500	1500	1200	4000	4500	900	0	5500
Typical 1 Brm Unit	2	2	0	0	4	660	1980	3000	1500	16500	1500	1200	4000	4500	900	0	7000
Typical 2 Brm Unit	4	4	0	0	8	1060	3180	3000	1500	16500	1500	1200	4000	4500	900	0	8500
TOTALS:	6	6	0	0	12	11120	33360	36000	18000	198000	18000	14400	48000	54000	10800	0	96000
VOLTS: 240 TOTAL CONNECTED: 527 KVA DEMAND FACTOR: 0.41 Based on Total Number of Residential Units = 12-13 (See N.E.C. Article: 220.84) TOTAL CALCULATED: 216 KVA CALCULATED AMPS: 900 AMPS NOTE:																	

DWELLING UNIT LOAD CALCULATION	
Project: <u>McKinney Lane II</u>	
Unit Type: <u>2Bedroom</u>	
Area: <u>1,080</u> square feet(average)	
Minimum Size Feeder (NEC 220.4):	
General lighting load of 3 VA / SF	3,180 VA
Small Appliances load (2 cks at 1500VA each)	3,000 VA
Laundry Load (1 ckt at 1500VA)	1,500 VA
Range	16,500 VA
Other Cooking Appliance Load (Microwave Oven)	1,500 VA
Dishwasher Load	1,200 VA
Electric Dryer Load	4,000 VA
Electric Water Heater Load	4,500 VA
Disposal load	900 VA
Other motor loads	0 VA
Total "General Loads"	36,280 VA
First 10 kVA of "general loads" at 100%	10,000 VA
Remainder of "general loads" at 40%	10,512 VA
Net "General Loads"	20,512 VA
Largest of: <u>8,500</u> VA of electric space heating (less than 4) at 65%	
—or— <u>0</u> VA of electric space heating (4 or more) at 40%	5,525 VA
—or— <u>0</u> VA of air conditioning/cooling/heat pumps at 100%	0 VA
TOTAL LOAD	
	26,037 VA
For 120/240-volt, 3-wire, single-phase service or feeder,	
	26,037 VA / 240 volts = 108 Amps
Therefore, this dwelling unit shall be permitted to be served by a <u>125</u> amp service.	

Loadcenter Name LC-19B (TYPICAL)		MHA CIRCUIT DIRECTORY						27-Jul-20
		mounting			location			
		RECESSED						
		phase 1		bus & main				
		voltage		125A MLO				
		120V/240				(SCOR: 22K)		
service		c/w		L1 L2		c/w		service
LIGHTS-KITCHEN/LIVING	20/1/A	3	*	4	20/1/A	APPLANCE CIRCUIT		
LTS & RECEPT - BATH	20/1/A	no.	1	*	4	20/1/A	APPLANCE CIRCUIT	
LTS & RECEPT - BEDROOM	20/1/A	5	*	*	6	20/1	REFRIGERATOR	
RECEPT - LIVING	20/1/A	7	*	*	8	20/1	MICRO/STOVE	
SPARE	20/1/A	9	*	*	10	20/1	RANGE (GAS)	
SPARE	20/1/A	11	*	*	12	20/1	SPARE	
SPARE	20/1/A	13	*	*	14	20/1	DISHWASHER	
WASHER	20/1/A	15	*	*	16	20/1	DISPOSAL	
DRYER	40/2 / 17	*	*	*	18	20/1	GAS FIRE PLACE (OPT)	
	20	19	*	*	20	20/1	HEAT	
SMART PANEL	20/1	21	*	*	22	20/1	HEAT	
WATER HEATER	20/2	23	*	*	24	20/2	HEAT	
	25	*	*	*	26	20/1	HEAT	
AC PORT (OPTIONAL)	20/1	27	*	*	28	20/2	HEAT	
AC PORT (OPTIONAL)	20/1	29	*	*	30	*	*	

NOTES:





- (A) DEVICES: ARC-FAULT INTERRUPTER CIRCUIT BREAKER. INSTALL PER NEC 210.12
- LOADS FOR THIS PANEL ARE INDICATED ON THE "WELLING UNIT LOAD CALCULATION".
- BREAKER & WIRE SHALL BE SIZED FOR EQUIPMENT INSTALLED.

(G) DEVICES GFCI RATED BREAKER.

Loadcenter Name LC-281 (TYPICAL)		MHA CIRCUIT DIRECTORY mounting				location		30-Oct-20
voltage 120/208		phase		125A MLO		bus & main		
service		a/p	no.	ls	lt	no.	a/p	service
LIGHTS-KITCHEN/LIVING		20/1(A)	1	*	2	20/(A)	APPLANCE CROUIT	
LTS & RECEPT - BATH		20/1	1	*	2	20/(A)	APPLANCE CROUIT	
LTS & RECEPT - BEDROOM		20/1(A)	1	*	6	20/(A)	REFRIGERATOR	
RECEPT - LIVING		20/1(A)	1	*	6	20/(A)	RANGE HOOD	
LTS & RECEPT - BEDROOM		20/1(A)	9	*	10	20/(A)		
SPARE		20/1(A)	11	*	12	20/(A)		
SPARE		20/1(A)	12	*	12	20/(A)		
WASHER		20/1(A)	15	*	16	20/(A)	DISHWASHER	
DREYR		46/2	17	*	18	20/(A)	SPARE	
			18	*	20	20/(A)	SPARE	
SMART PANEL		20/1	21	*	22	20/(A)		
BLANK		23	23	*	24	20/(A)	BLANK	
BLANK			25	*	26	20/(A)	BLANK	
BLANK			27	*	28	20/(A)	BLANK	
BLANK			28	*	30	20/(A)	BLANK	
BLANK			31	*	32	20/(A)	BLANK	
BLANK			33	*	34	20/(A)	BLANK	
BLANK			35	*	36	20/(A)	BLANK	
BLANK			37	*	38	20/(A)	BLANK	
BLANK			39	*	40	20/(A)	BLANK	
BLANK			41	*	42	20/(A)	BLANK	

NOTES:

- (A) DENOTES: ARC-FAULT INTERRUPTER CROUIT BREAKER. INSTALL PER NEC 210.12.
- LOADS FOR THIS PANEL ARE INDICATED ON THE "TWELFING UNIT LOAD CALCULATION".
- BREAKER & WIRE SHALL BE SIZED FOR EQUIPMENT INSTALLED.
- (G) DENOTES GFCI RATED BREAKER.

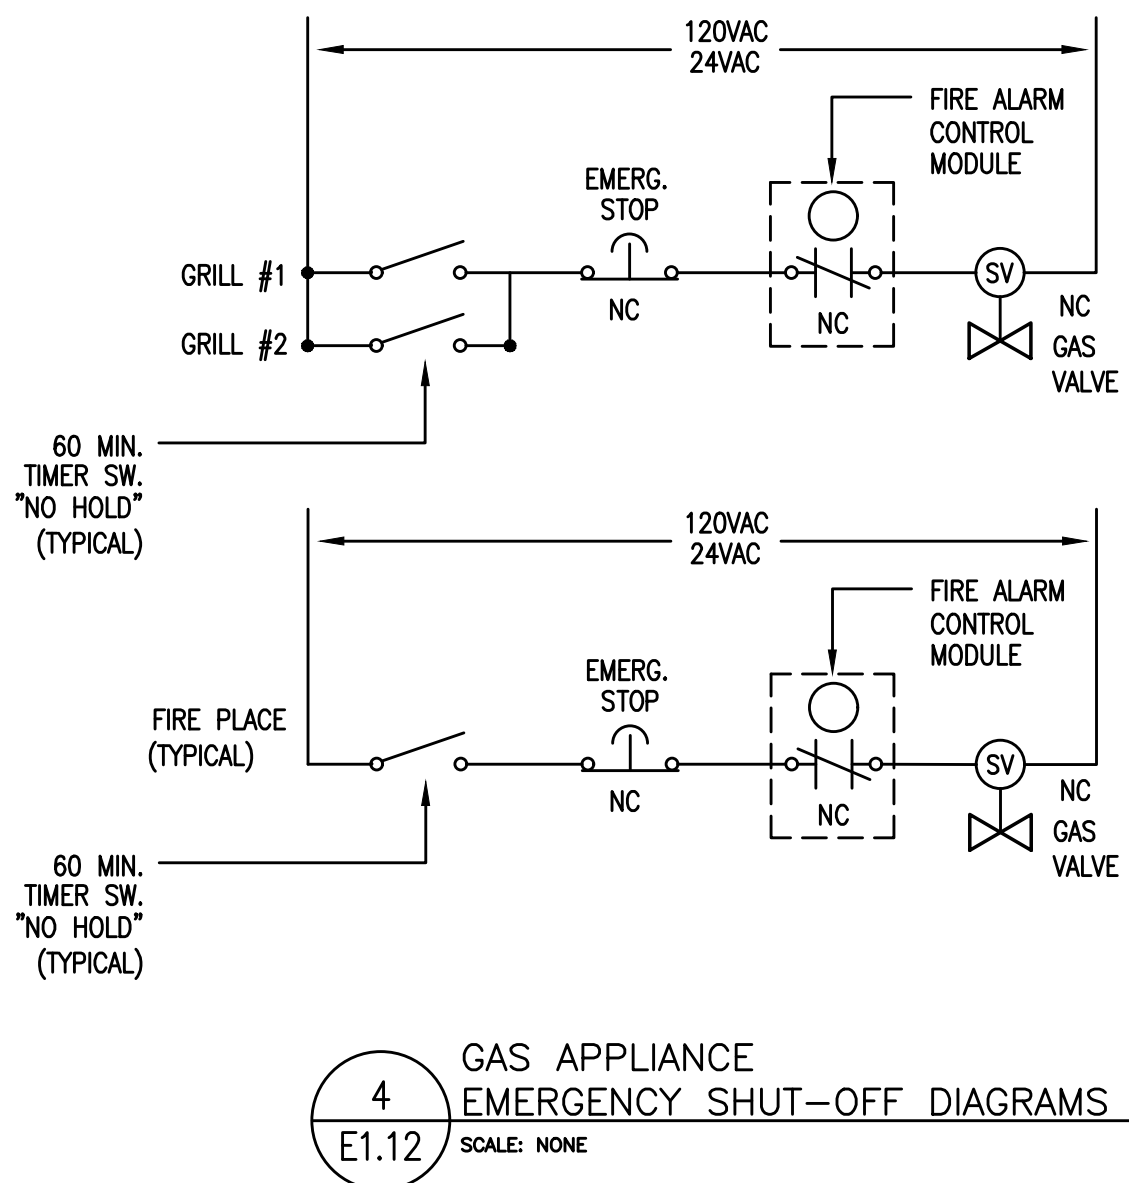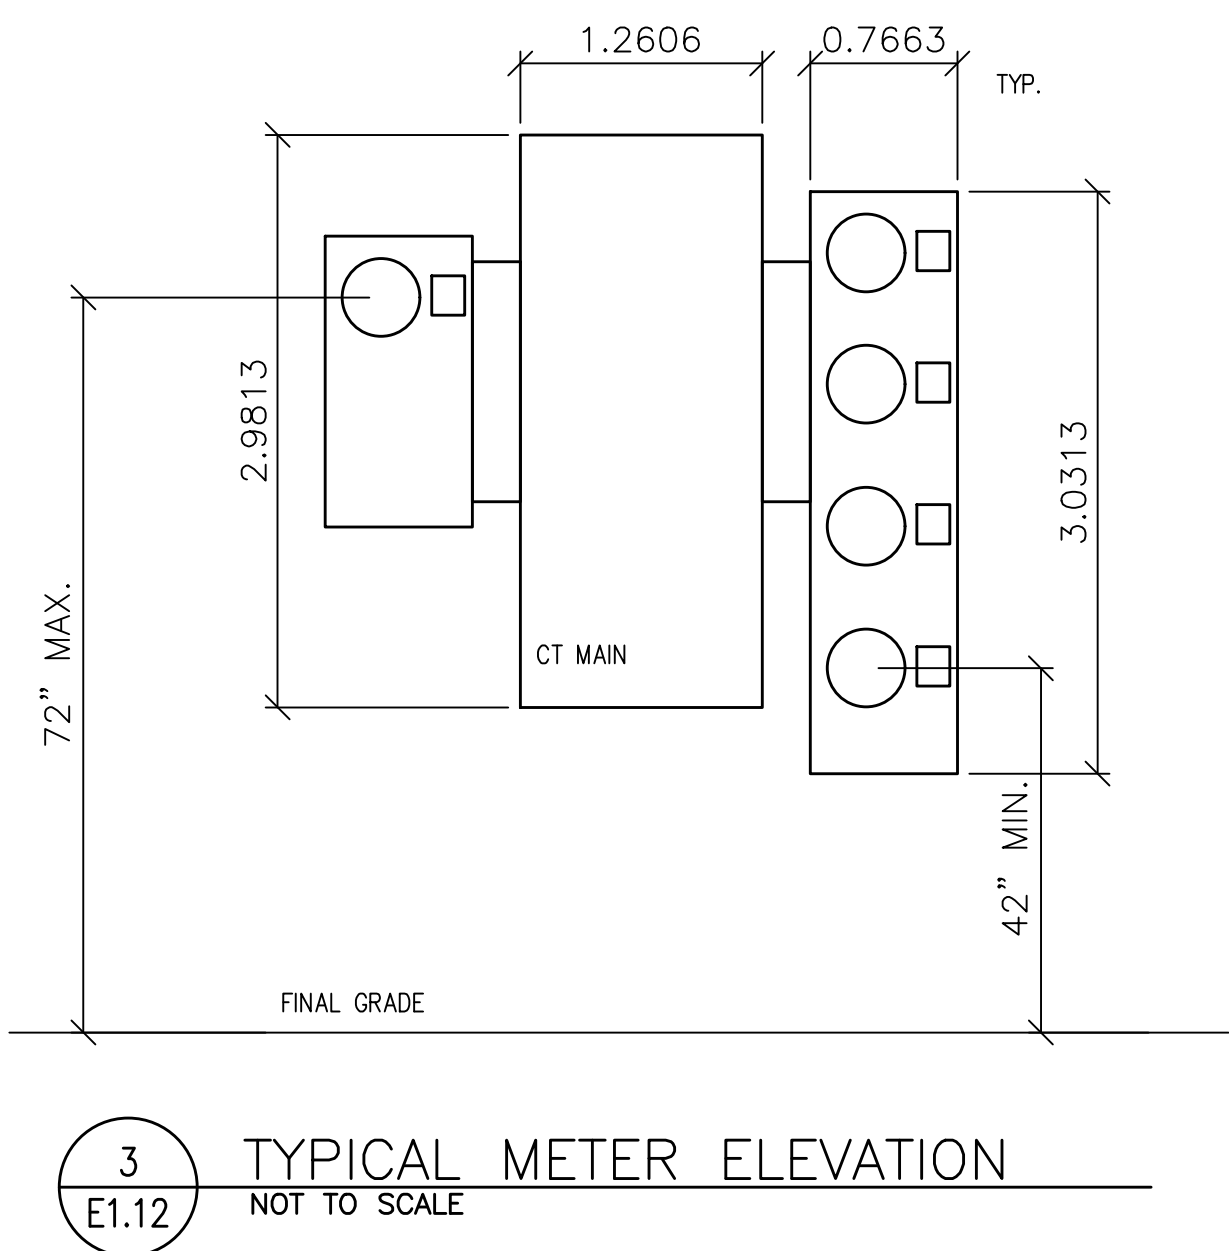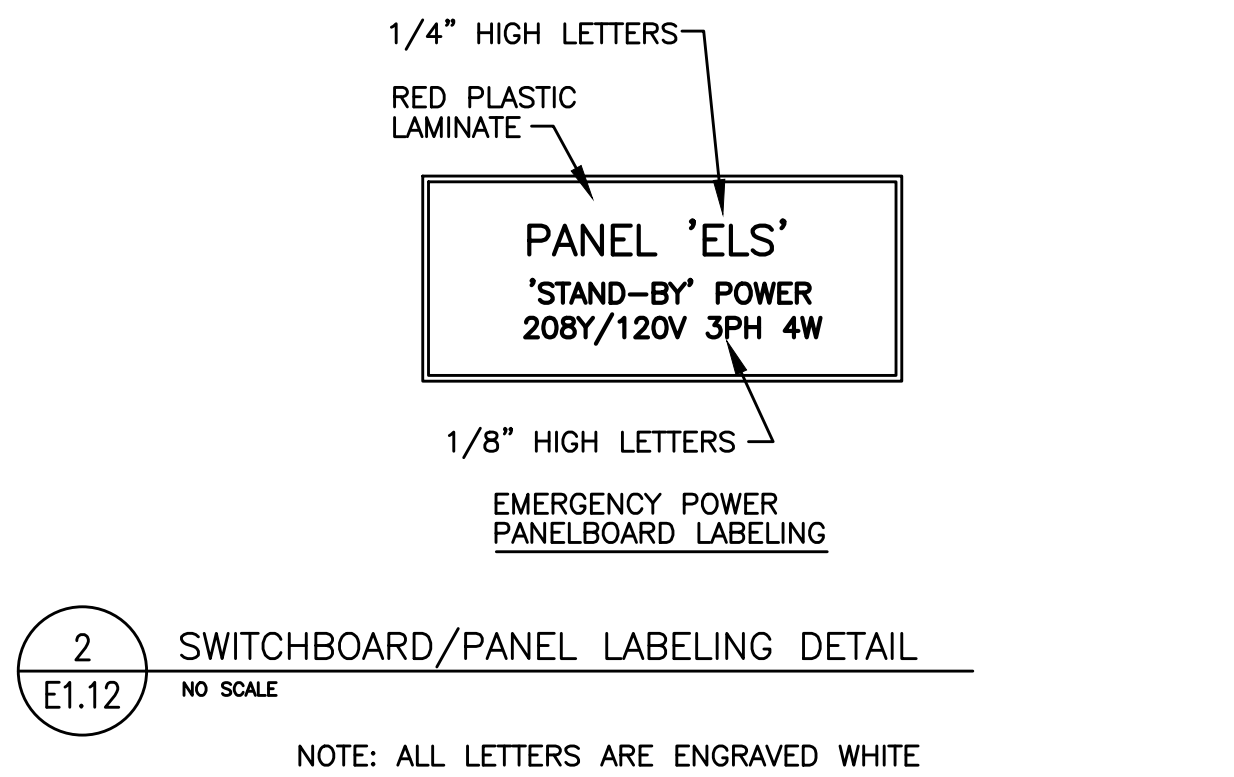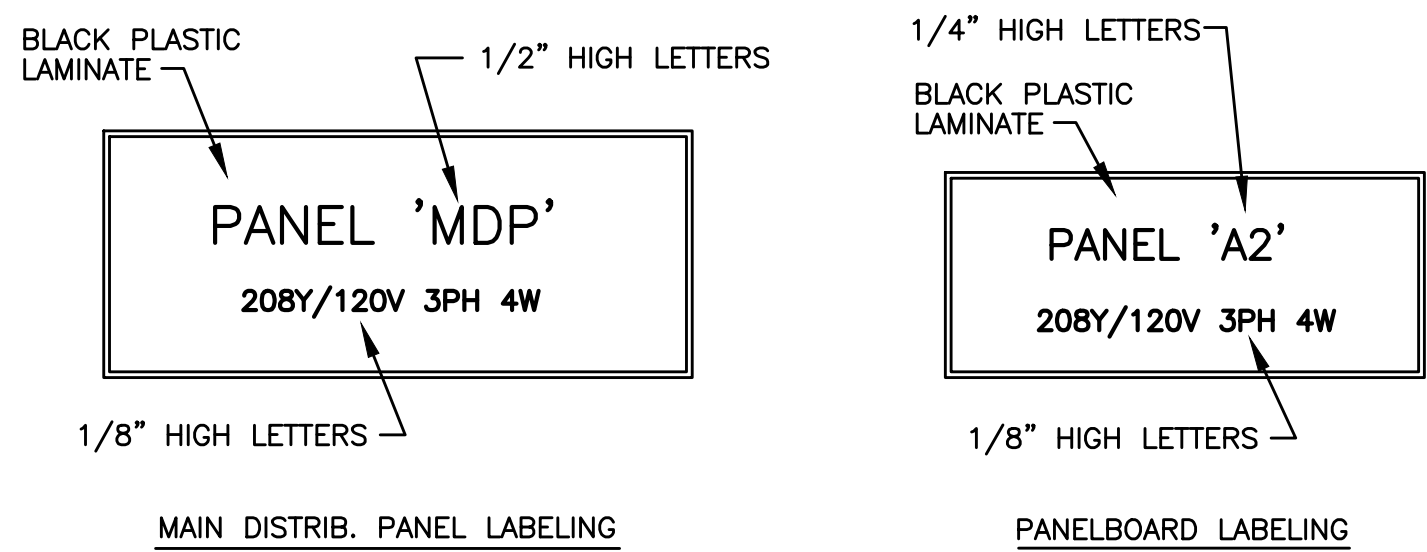

MFA PANEL SCHEDULE										18-Mar-21	
panel Pnl #1 120/240V		mounting Surface phase		location Pool House bus & main		connected load calculated load		58			
C	service	va	a/p	no.	L1	L2	a/p	va	service	59	
2	POOL PUMP RECEPT	5200	50/2	1	*	2	20/1	1500	POOL LIGHTS	1	
3	SPARE	5200	*	5	*	4	20/1	1500	POOL HOUSE LIGHTS	1	
4	SPARE	0	20/1	5	*	6	20/1	600	POOL HOUSE RECEPTACLES	1	
5	SPARE	0	20/1	7	*	8	20/1	0	SPARE	2	
6	SPARE	0	20/1	9	*	10	20/1	0	SPARE		
7	SPARE	0	20/1	11	*	12	20/1	0	SPARE		
8	BLANK	13	*	14	*	15		BLANK			
9	BLANK	15	*	16	*	17		BLANK			
10	BLANK	17	*	18	*	19		BLANK			
11	BLANK	19	*	20	*	21		BLANK			
12	BLANK	21	*	22	*	23		BLANK			
13	BLANK	23	*	24	*	25		BLANK			
14	BLANK	25	*	26	*	27		BLANK			
15	BLANK	27	*	28	*	29		BLANK			
16	BLANK	29	*	30	*	31		BLANK			
17	BLANK	31	*	32	*	33		BLANK			
18	BLANK	33	*	34	*	35		BLANK			
19	BLANK	35	*	36	*	37		BLANK			
20	BLANK	37	*	38	*	39		BLANK			
21	BLANK	39	*	40	*	41		BLANK			
NOTES:											
Line 1		7300 VA		line-line voltage		240					
Line 2		6700 VA									
Total Connected		14000 VA		largest motor (va)		240					
load code:		line 1 line 2		va		1000 1.25		calculated load (va)		3750	
1. LIGHTS:	0	0	1500	5800	5200	total factor = 1 + 0.5		10500			
2. RECEPT:	0	0	0	0	0	va		0			
3. HEATING:	0	0	0	0	0	va		0			
4. KITCHEN:	0	0	0	0	0	va		0			
5. EQUIP:	0	0	0	0	0	va		0			
6. MOTORS:	0	0	0	0	0	va		0			
7. SUB-PANEL:	0	0	0	0	0	va		0			
(125% of the largest motor + 100% of the balance)										14250	



IN THE EVENT CONFLICTS ARE DISCOVERED
BETWEEN THE ORIGINAL SIGNED AND SEALED
DOCUMENT PREPARED BY THE ARCHITECT
AND/OR THEIR CONSULTANTS, AND ANY COPY OF
THE DOCUMENTS TRANSMITTED BY EMAIL, FAX,
ELECTRONICALLY OR OTHERWISE, THE ORIGINAL
SIGNED AND SEALED DOCUMENTS SHALL GOVERN.

PROJECT # 2019-179
DATE: 28 AUGUST 2020

REVISIONS

PLAN REVIEW 11.03.2020
PLAN REVIEW 03.19.2021

MCKINNEY LANE APARTMENTS PHASE II
RUSSELL DRIVE & MCKINNEY LANE
LEBANON, OREGON 97355


TYPE	LAMP	MANUFACTURER	CATALOG NUMBER	DESCRIPTION	OPTIONS
A1 A1E	LED 3000K 2000LM/80CRI	LITHONIA (OR APPROVED OTHER)	ZLIN SERIES	TYPE : 4" GEN. PURPOSE STRIP MOUNTING : SURFACE HOUSING : STEEL LENS/REFL : DIFFUSED ACRYLIC VOLTAGE : 120V BALLAST : LED DRIVER	TYPE "AE" SIMILAR TO TYPE "A" EXCEPT WITH EMERGENCY BATTERY BACK-UP MAINTENANCE OFFICE, GARAGES
A2	13W A19 LED (60W INCAND. EQUAL)	BRYANT		TYPE : PORCELAIN KEYLESS SOCKET MOUNTING : WALL +6" ABV. DOOR HOUSING : STEEL LENS/REFL : N/A VOLTAGE : 120V BALLAST : INTEGRAL LED DRIVER	WITH PULL CHAIN FIRE RISER ROOM
C1 C1E	LED 1300 LM/80CRI 3000K	USAI LIGHTING (OR APPROVED OTHER)	BARDF SERIES	TYPE : 4.5" DIA. DOWNLIGHT MOUNTING : RECESSED HOUSING : ALUMINUM LENS/REFL : NA VOLTAGE : 120V BALLAST : LED DRIVER (0-10 DIMMING)	WHITE TRIM AT GYP. CEILINGS 50 DEGREE BEAM C1E = EMERGENCY BATTERY BACK UP UL LISTED DAMP LOCATION CLUBHOUSE
C2 C2E	LED 1300 LM/80CRI 3000K	USAI LIGHTING (OR APPROVED OTHER)	BARDF30 SERIES	TYPE : 4.5" DIA. DOWNLIGHT MOUNTING : RECESSED (SLOPED CLING) HOUSING : ALUMINUM LENS/REFL : NA VOLTAGE : 120V BALLAST : LED DRIVER (0-10 DIMMING)	BLACK TRIM AT WOOD CEILINGS 70 DEGREE BEAM C2E = EMERGENCY BATTERY BACK UP UL LISTED DAMP LOCATION CLUBHOUSE
C3 C3E	LED 1075 LM/80CRI 3000K	USAI LIGHTING (OR APPROVED OTHER)	PARDF SERIES	TYPE : EXTERIOR 4.5" DIA. DOWNLIGHT MOUNTING : RECESSED HOUSING : ALUMINUM LENS/REFL : ACRYLIC VOLTAGE : 120V BALLAST : LED DRIVER	TRIM & FINISH PER ARCHITECT/INTERIORS FLOOD BEAM C3E = EMERGENCY BATTERY BACK UP UL LISTED DAMP LOCATION CLUBHOUSE EXTERIOR CANOPY
DL1	LED 3000K	MATTEO LIGHTING (OR APPROVED OTHER)	C49703BK SERIES	TYPE : DECORATIVE PENDANT MOUNTING : SUSPENDED HOUSING : STEEL LENS/REFL : GLASS VOLTAGE : 120V BALLAST : INTEGRAL (0-10 DIMMING)	BLACK FINISH PER DECORATOR MOUNTING HEIGHT TO BE 6'-6" AFF. CLUBHOUSE
DL2	LED 3000K	HERMAN MILLER LIGHTING (OR APPROVED OTHER)	H761CCS SERIES	TYPE : DECORATIVE PENDANT MOUNTING : SUSPENDED HOUSING : STEEL LENS/REFL : GLASS VOLTAGE : 120V BALLAST : INTEGRAL (0-10 DIMMING)	BRUSHED NICKLE FINISH PER INTERIOR DECORATOR HEIGHT TO BE 6'-6" AFF. STUDY ROOM
DL3	LED 1150 LM 3000K	USAI LIGHTING (OR APPROVED OTHER)	LBRP6 SERIES	TYPE : CYLINDER LIGHT MOUNTING : SUSPENDED (CABLE HUNG) HOUSING : STEEL LENS/REFL : GLASS VOLTAGE : 120V BALLAST : LED DRIVER (0-10 DIMMING)	WHITE FINISH REFER TO INTERIOR ELEVATIONS FOR MOUNTING HEIGHT TO BE FIELD ADJUSTED CLUBHOUSE
DL4	LED 3000K	CEDAR & MOSS LIGHTING (OR APPROVED OTHER)	TILT CONE SERIES	TYPE : ADJUSTABLE WALL SCONCE MOUNTING : SURFACE HOUSING : STEEL LENS/REFL : GLASS VOLTAGE : 120V BALLAST : INTEGRAL (0-10 DIMMING)	MATTE BLACK FINISH REFER TO INTERIOR ELEVATIONS FOR MOUNTING HEIGHT. CLUBHOUSE
DL5	LED 3000K	ANDREW NEVER LIGHTING (OR APPROVED OTHER)	DUMBBELL SERIES	TYPE : DECORATIVE PENDANT MOUNTING : SUSPENDED HOUSING : STEEL LENS/REFL : GLASS VOLTAGE : 120V BALLAST : INTEGRAL (0-10 DIMMING)	BLACK FINISH MOUNTING HEIGHT PER DECORATOR. CLUBHOUSE RESTROOM
"X1"	LED (GREEN LETTERS)	LITHONIA DMF LIGHTING (OR APPROVED OTHER)	LE EL N SERIES DLED500EM-G	TYPE : EXIT SIGN MOUNTING : UNIVERSAL HOUSING : DIE-CAST ALUMINUM LENS/REFL : SINGLE FACE/DUAL FACE VOLTAGE : 120V BALLAST : NICKLE CADMIUM BATTERY	

TYPE	LAMP	MANUFACTURER	CATALOG NUMBER	DESCRIPTION	OPTIONS
U1a	LED 650 LM 3000K	LIGHTOLIER (OR APPROVED OTHER)	SSR SERIES	TYPE : 5" DIA. DOWNLIGHT MOUNTING : SURFACE (+-BOX) HOUSING : ALUMINUM LENS/REFL : ACRYLIC VOLTAGE : 120V BALLAST : LED DRIVER (DIMMING)	WHITE FINISH UNIT KITCHEN, HALL, BATHROOM
U1b	LED 750 LM 3000K	LITHONIA (OR APPROVED OTHER)	LK5G SERIES	TYPE : 5" DIA. ADJUSTABLE DOWNLIGHT MOUNTING : RECESSED HOUSING : ALUMINUM LENS/REFL : ACRYLIC VOLTAGE : 120V BALLAST : LED DRIVER (DIMMING)	WHITE FINISH IC RATED UNIT KITCHEN (VAULTED CLING ONLY)
U2	LED 1400 LUMEN 3000K	MAXIM LIGHTING (OR APPROVED OTHER)	52102SN SERIES	TYPE : 24" VANITY LIGHT MOUNTING : SURFACE (+6" ABOVE MIRROR) HOUSING : STEEL LENS/REFL : GLASS VOLTAGE : 120V BALLAST : LED DRIVER	POLISHED CHROME FINISH UNIT BATHROOM
U3a	LED 3000K 650LM	MINKA AIRE (OR APPROVED OTHER)	F753L-WHF	TYPE : 52" DIA. CEILING FAN W/ LIGHT MOUNTING : SURFACE HOUSING : ALUMINUM LENS/REFL : ACRYLIC VOLTAGE : 120V BALLAST : LED DRIVER (0-10 DIMMING)	WHITE FINISH PROVIDE BRACING AT CEILING TO SUPPORT A MINIMUM OF 35 LBS. PROVIDE WITH DUAL SWITCH CONTROLS
U3b	LED 3000K 650LM	MINKA AIRE (OR APPROVED OTHER)	F753L-WHF	TYPE : 52" DIA. CEILING FAN W/ LIGHT MOUNTING : SURFACE (SLOPED CEILING) HOUSING : ALUMINUM LENS/REFL : ACRYLIC VOLTAGE : 120V BALLAST : LED DRIVER (0-10 DIMMING)	WHITE FINISH PROVIDE BRACING AT CEILING TO SUPPORT A MINIMUM OF 35 LBS. PROVIDE WITH DUAL SWITCH CONTROLS
U4	LED 1400 LM 3000K	KUZCO LIGHTING (OR APPROVED OTHER)	FM3511	TYPE : 11" DIA. CEILING LIGHT MOUNTING : SURFACE HOUSING : STEEL LENS/REFL : GLASS VOLTAGE : 120V BALLAST : LED DRIVER (0-10 DIMMING)	CHROME/CLEAR FINISH UNIT DINING ROOM
U5	LED 800 LM 3000K	KUZCO LIGHTING (OR APPROVED OTHER)	EW3105	TYPE : EXTERIOR WALL SCONCE MOUNTING : SURFACE HOUSING : STEEL LENS/REFL : GLASS VOLTAGE : 120V BALLAST : LED DRIVER	BLACK FINISH UNIT ENTRY
U6	LED 3000K 200LM	WAC LIGHTING (OR APPROVED OTHER)	HR-LED90 SERIES	TYPE : UNDER CABINET LIGHT MOUNTING : SURFACE HOUSING : ALUMINUM LENS/REFL : ACRYLIC VOLTAGE : 24V BALLAST : LED DRIVER (ELV DIMMING)	WHITE FINISH UNIT KITCHEN


TYPE	LAMP	MANUFACTURER	CATALOG NUMBER	DESCRIPTION	OPTIONS
S1	LED 3000K 2632 LM	LIGMAN LIGHTING (OR APPROVED OTHER)	UAA-20166 SERIES	TYPE : AREA LIGHT MOUNTING : ROUND POLE (16' AFG) HOUSING : STEEL LENS/REFL : OPAL GLASS/STRAIGHT SHADE VOLTAGE : 120V BALLAST : LED DRIVER	BLACK FINISH PARKING AREA
S2	LED 3000K 2420 LM	LIGHTWAY LIGHTING DABMAR LIGHTING (OR APPROVED OTHER)	WWP-14LED SERIES GM260 SERIES	TYPE : POST TOP AREA LIGHT MOUNTING : ROUND POLE (8FT AFG) HOUSING : STEEL LENS/REFL : OPAL GLASS VOLTAGE : 120V BALLAST : LED DRIVER	BLACK FINISH WALKWAYS
S3	LED 3000K 1856 LM	LIGMAN LIGHTING DABMAR LIGHTING (OR APPROVED OTHER)	UAA-30186 SERIES GM996 SERIES	TYPE : EXTERIOR WALL SCONCE MOUNTING : SURFACE (+8.5 FT AFF) HOUSING : STEEL LENS/REFL : OPAL GLASS/STRAIGHT SHADE VOLTAGE : 120V BALLAST : LED DRIVER	BLACK FINISH GARAGES
S4	LED 3000K 4800 LM	SAYLITE LIGHTING	CV800 SERIES	TYPE : 4FT ENCLOSED STRIP LIGHT MOUNTING : SURFACE HOUSING : STEEL LENS/REFL : ACRYLIC VOLTAGE : 120V BALLAST : LED DRIVER	VANDAL RESISTANT CARPORTS, SHELTERS
S5	LED 3000K 1200 LM	KUZCO LIGHTING	EC44505 SERIES	TYPE : CEILING LIGHT MOUNTING : SURFACE HOUSING : STEEL LENS/REFL : ACRYLIC VOLTAGE : 120V BALLAST : LED DRIVER	FINISH PER ARCHITECT BUILDING PORCHES, LANDINGS
S6	LED 3000K 200 LM	HADCO LIGHTING	DAL1 4121 SERIES	TYPE : DECK LIGHT MOUNTING : SURFACE HOUSING : STEEL LENS/REFL : ACRYLIC VOLTAGE : 120V BALLAST : INTEGRAL LED DRIVER	FINISH PER ARCHITECT VERIFY MOUNTING HEIGHT PROVIDE WITH APPROPRIATE TRANSFORMERS AND OTHER HARDWARE
S7	LED 3000K 1454 LM	LIGMAN LIGHTING	UAA-10086 SERIES	TYPE : 42" BOLLARD LIGHT MOUNTING : SURFACE HOUSING : STEEL LENS/REFL : LOUVERED GLASS VOLTAGE : 120V BALLAST : LED DRIVER	BLACK FINISH PROVIDE WITH ROUND TOP CLUBHOUSE TERRACE

GENERAL LIGHTING NOTES:

- ALL LIGHT FIXTURES SHALL HAVE ENERGY EFFICIENT LAMPING, DRIVERS AND BALLASTS.
- LIGHT FIXTURES FOR LIVING UNITS SHALL BE "ENERGY STAR" RATED.
- EXTERIOR LIGHT FIXTURES SHALL BE "NIGHT SKY" FRIENDLY.
- FOR FIXTURES THAT DO NOT HAVE FINISH SPECIFIED, CONSULT WITH ARCHITECT/INTERIORS PRIOR TO BID.
- CONSULT INTERIORS PLANS FOR FIXTURE MOUNTING HEIGHTS IN THE CLUBHOUSE AND THE ARCHITECTURAL PLANS FOR ALL OTHER FIXTURE MOUNTING HEIGHTS.
- CONSULT INTERIORS PLANS FOR EXACT FIXTURE LOCATIONS IN THE CLUBHOUSE AND THE ARCHITECTURAL PLANS FOR ALL OTHER FIXTURE LOCATIONS.
- ALL INTERIOR LIGHTING SHALL BE 3000 KELVIN UNLESS OTHERWISE NOTED.
- ALL EXTERIOR LIGHTING SHALL BE 3000 KELVIN UNLESS OTHERWISE NOTED.
- ALL PRODUCT SUBSTITUTIONS AND VALUE ENGINEERING SHALL BE SUBMITTED DURING BID PHASE, SHALL MEET DESIGN INTENT AND IS SUBJECT TO OWNER APPROVAL.
- CONTRACTOR SHALL CONSULT MANUFACTURER INSTALLATION INSTRUCTIONS FOR ALL FIXTURES AND DEVICES AND INSTALL AS INSTRUCTED. THIS INCLUDES ALL ELECTRICAL COMPONENTS REQUIRED FOR COMPLETE INSTALLATION. WORK SHALL BE PERFORMED SUCH THAT MANUFACTURER WARRANTY IS NOT VOIDED.
- IF NECESSARY, CONTRACTOR SHALL PROVIDE IC RATED BOXES FOR ANY APPROVED, SUBSTITUTED FIXTURES NOT MEETING INSULATED CEILING REQUIREMENTS.
- SITE LIGHTING AND BUILDING MOUNTED EXTERIOR LIGHTS (EXCEPT APARTMENT PATIO/BALCONY LIGHTS) SHALL BE CONTROLLED VIA PHOTOCCELL, EITHER INTEGRAL OR REMOTE FOR DUST-TILL-DAWN OPERATION.
- POLE MOUNTED SITE LIGHTING AND CARPORT LIGHTING SHALL BE PROVIDED WITH THE ABILITY TO REDUCE LIGHT LEVELS BY 30% DURING PERIODS OF LOW NIGHT-TIME ACTIVITY, EITHER BY MOTION SENSING AND/OR TIME CLOCK.
- CONTRACTOR TO PROVIDE SINGLE POLE DIMMER SWITCHES AS INDICATED. DIMMER SWITCHES SHALL MATCH THE DECORATOR TYPE ROCKER SWITCH SPECIFIED IN THE TYPICAL UNIT LIGHTING PLANS OR AS DIRECTED BY THE OWNER. DIMMER SWITCHES SHALL BE COMPATIBLE WITH THE LED LIGHT FIXTURES AND SHALL BE FULLY ADJUSTABLE. CONTRACTOR SHALL FIELD ADJUST TO REDUCE ANY MOMENTARY FLASH DURING START UP.
- PROVIDE BLOCKING AT CEILING TO SUPPORT 35LB., MINIMUM, FOR CEILING FAN INSTALLATION. REFER TO MANUFACTURER'S INSTALLATION INSTRUCTIONS FOR ADDITIONAL INFORMATION AND REQUIREMENTS. PROVIDE FIXTURE CONTROL SWITCH(ES) AS DIRECTED BY MANUFACTURER.
- FOR ANY FIXTURE THAT WOULD REQUIRE RELOCATION DUE TO FIELD CONDITIONS WILL REQUIRE OWNER/ENGINEER WALK-THRU FOR APPROVAL.

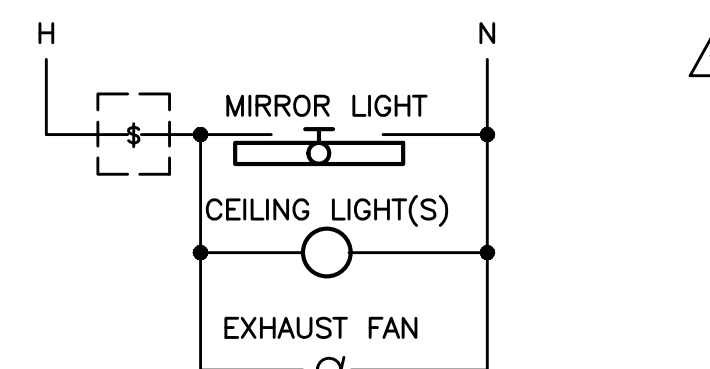


BATHROOM W/ EXHAUST FAN
SWITCHED WITH CEILING &
VANITY LIGHTS

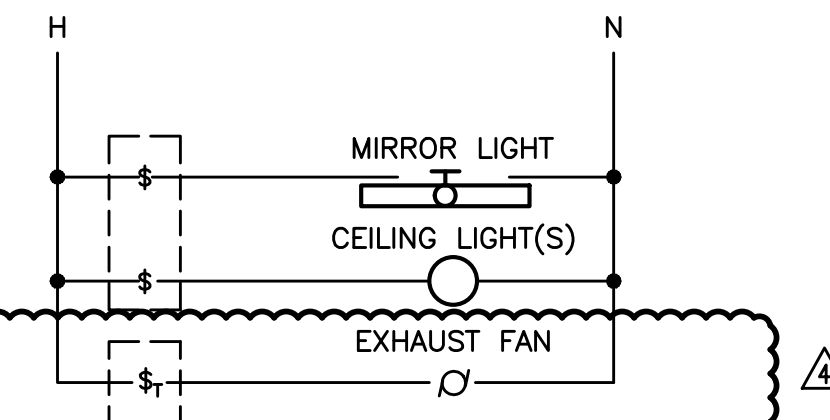


BATHROOM W/ VANITY LIGHT SWITCHED
SEPARATE FROM CEILING LIGHTS &
CONTINUOUS OPERATION EXHAUST FAN
ON (30 MIN. MINIMUM) TIMER.

1 BATHROOM SWITCHING DIAGRAMS – TYPICAL
E1.21 NO SCALE

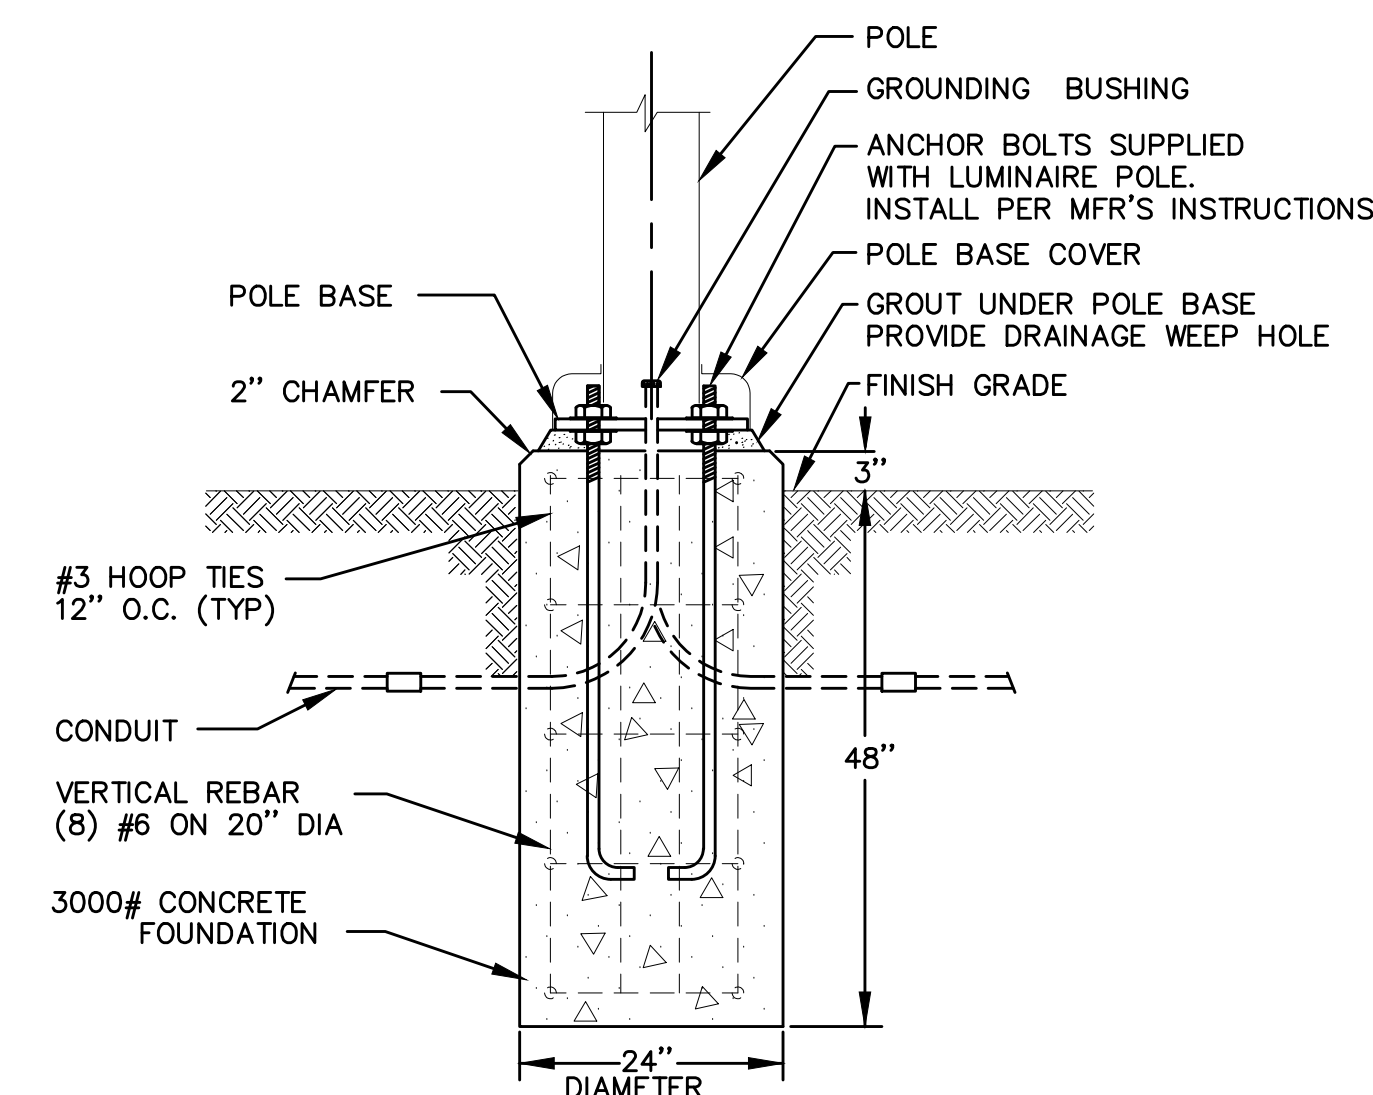

2 TYPICAL POLE BASE DETAIL
E1.21 NO SCALE

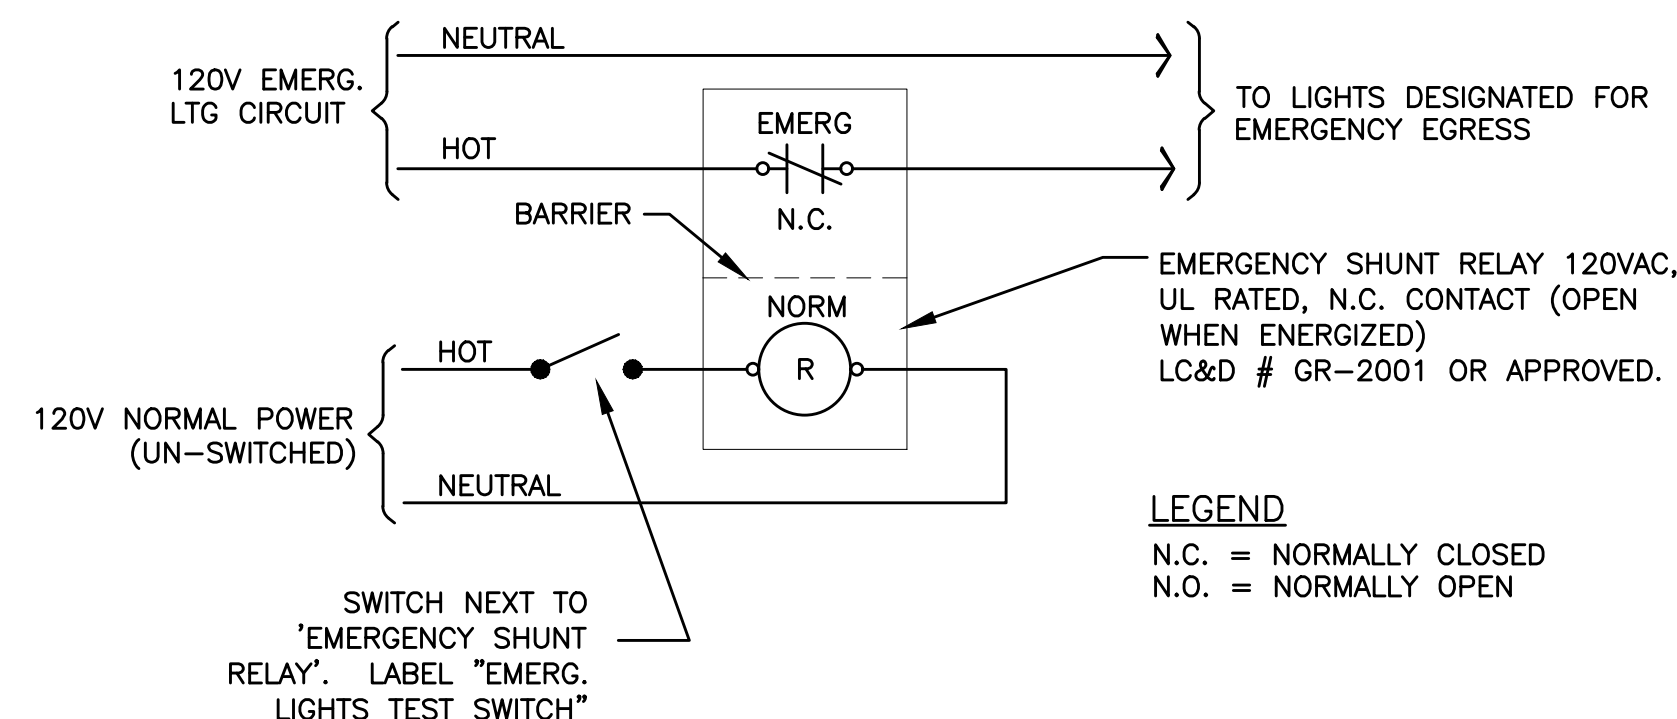

3 EMERGENCY EGRESS LIGHTING – UNSWITCHED
E1.21 NO SCALE

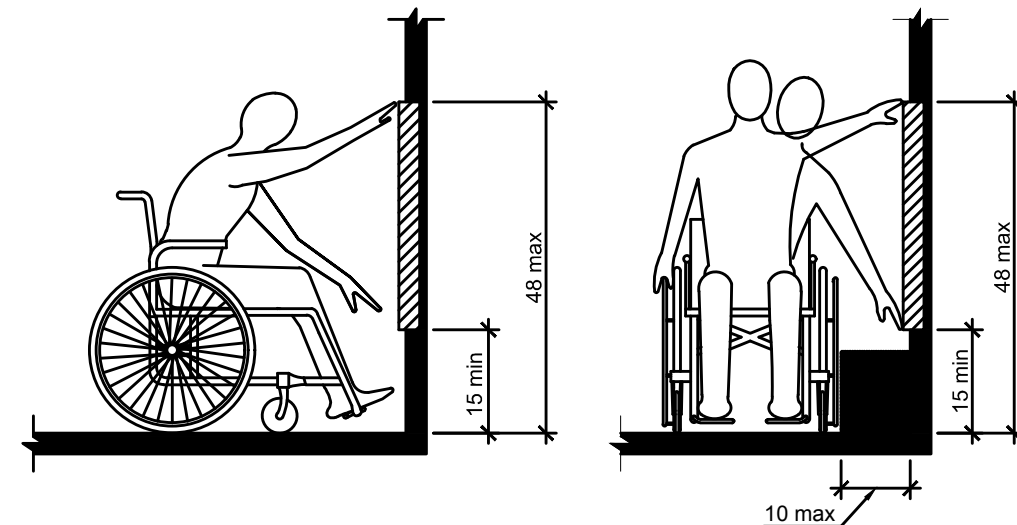


Figure 308.2.1 Unobstructed Forward Reach
Figure 308.3.1 Unobstructed Side Reach

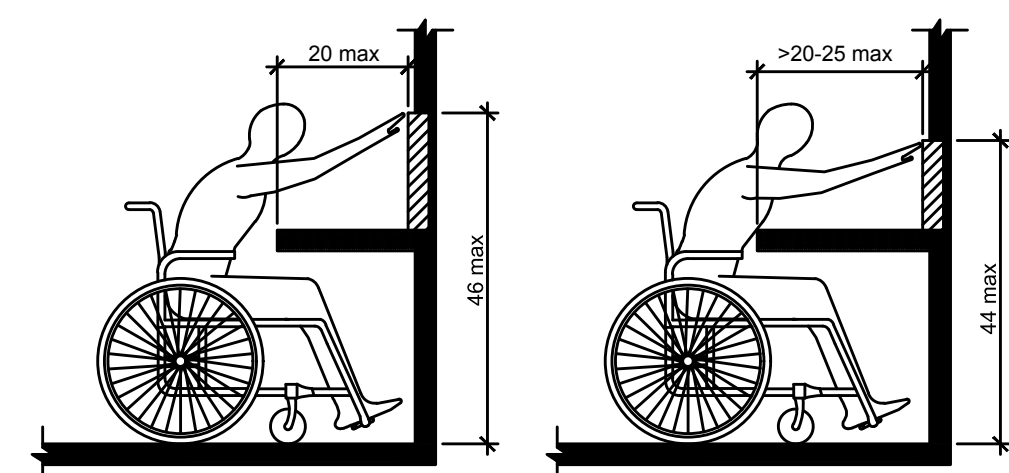


Figure 308.2.2 Obstructed High Forward Reach
Figure 308.3.2 Obstructed High Side Reach

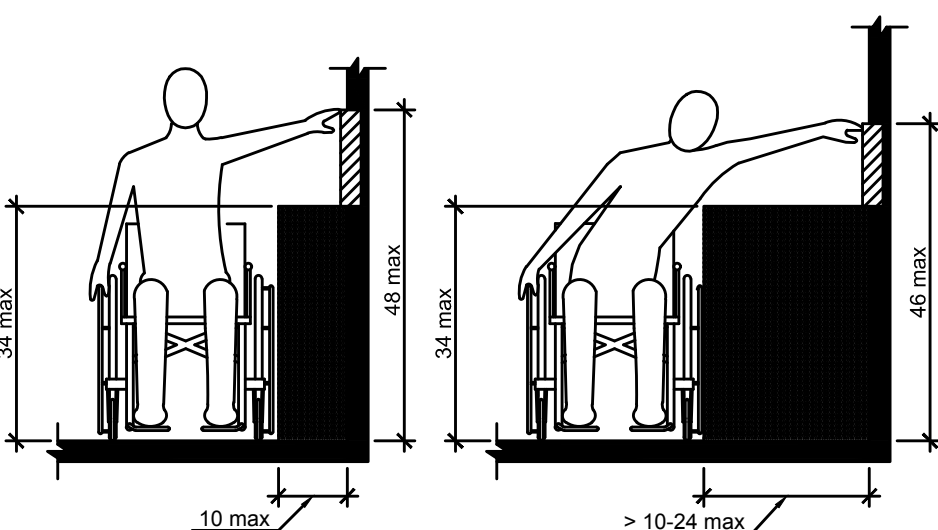


Figure 308.2.2 Obstructed High Side Reach

1 ADA REACH REQUIREMENTS
E1.22 NO SCALE

308.2 Forward Reach.

308.2.1 Unobstructed. Where a forward reach is unobstructed, the high forward reach shall be 48" maximum and the low forward reach shall be 15" minimum above the floor or ground.


308.2.2 Obstructed High Reach. Where a high forward reach is over an obstruction, the clear floor or ground space shall extend beneath the element for a distance not less than the required reach depth over the obstruction. The high forward reach shall be 48" maximum where the reach depth is 20" maximum. Where the reach depth exceeds 20", the high forward reach shall be 44" maximum and the reach depth shall be 25" maximum.

308.3 Side Reach.

308.3.1 Unobstructed. Where a clear floor or ground space allows a parallel approach to an object and the side reach is unobstructed, the high side reach shall be 48" maximum and the low side reach shall be 15" minimum above the floor or ground.

Exception: Existing elements shall be permitted at 54" maximum above the floor or ground.

308.3.2 Obstructed High Reach. Where a clear floor or ground space allows a parallel approach to an object and the high side reach is over an obstruction, the height of the obstruction shall be 34" maximum and the depth of the obstruction shall be 24" maximum. The high side reach shall be 48" maximum for a reach depth of 10" maximum. Where the reach depth exceeds 10", the high side reach shall be 46" maximum for a reach depth of 24" maximum.

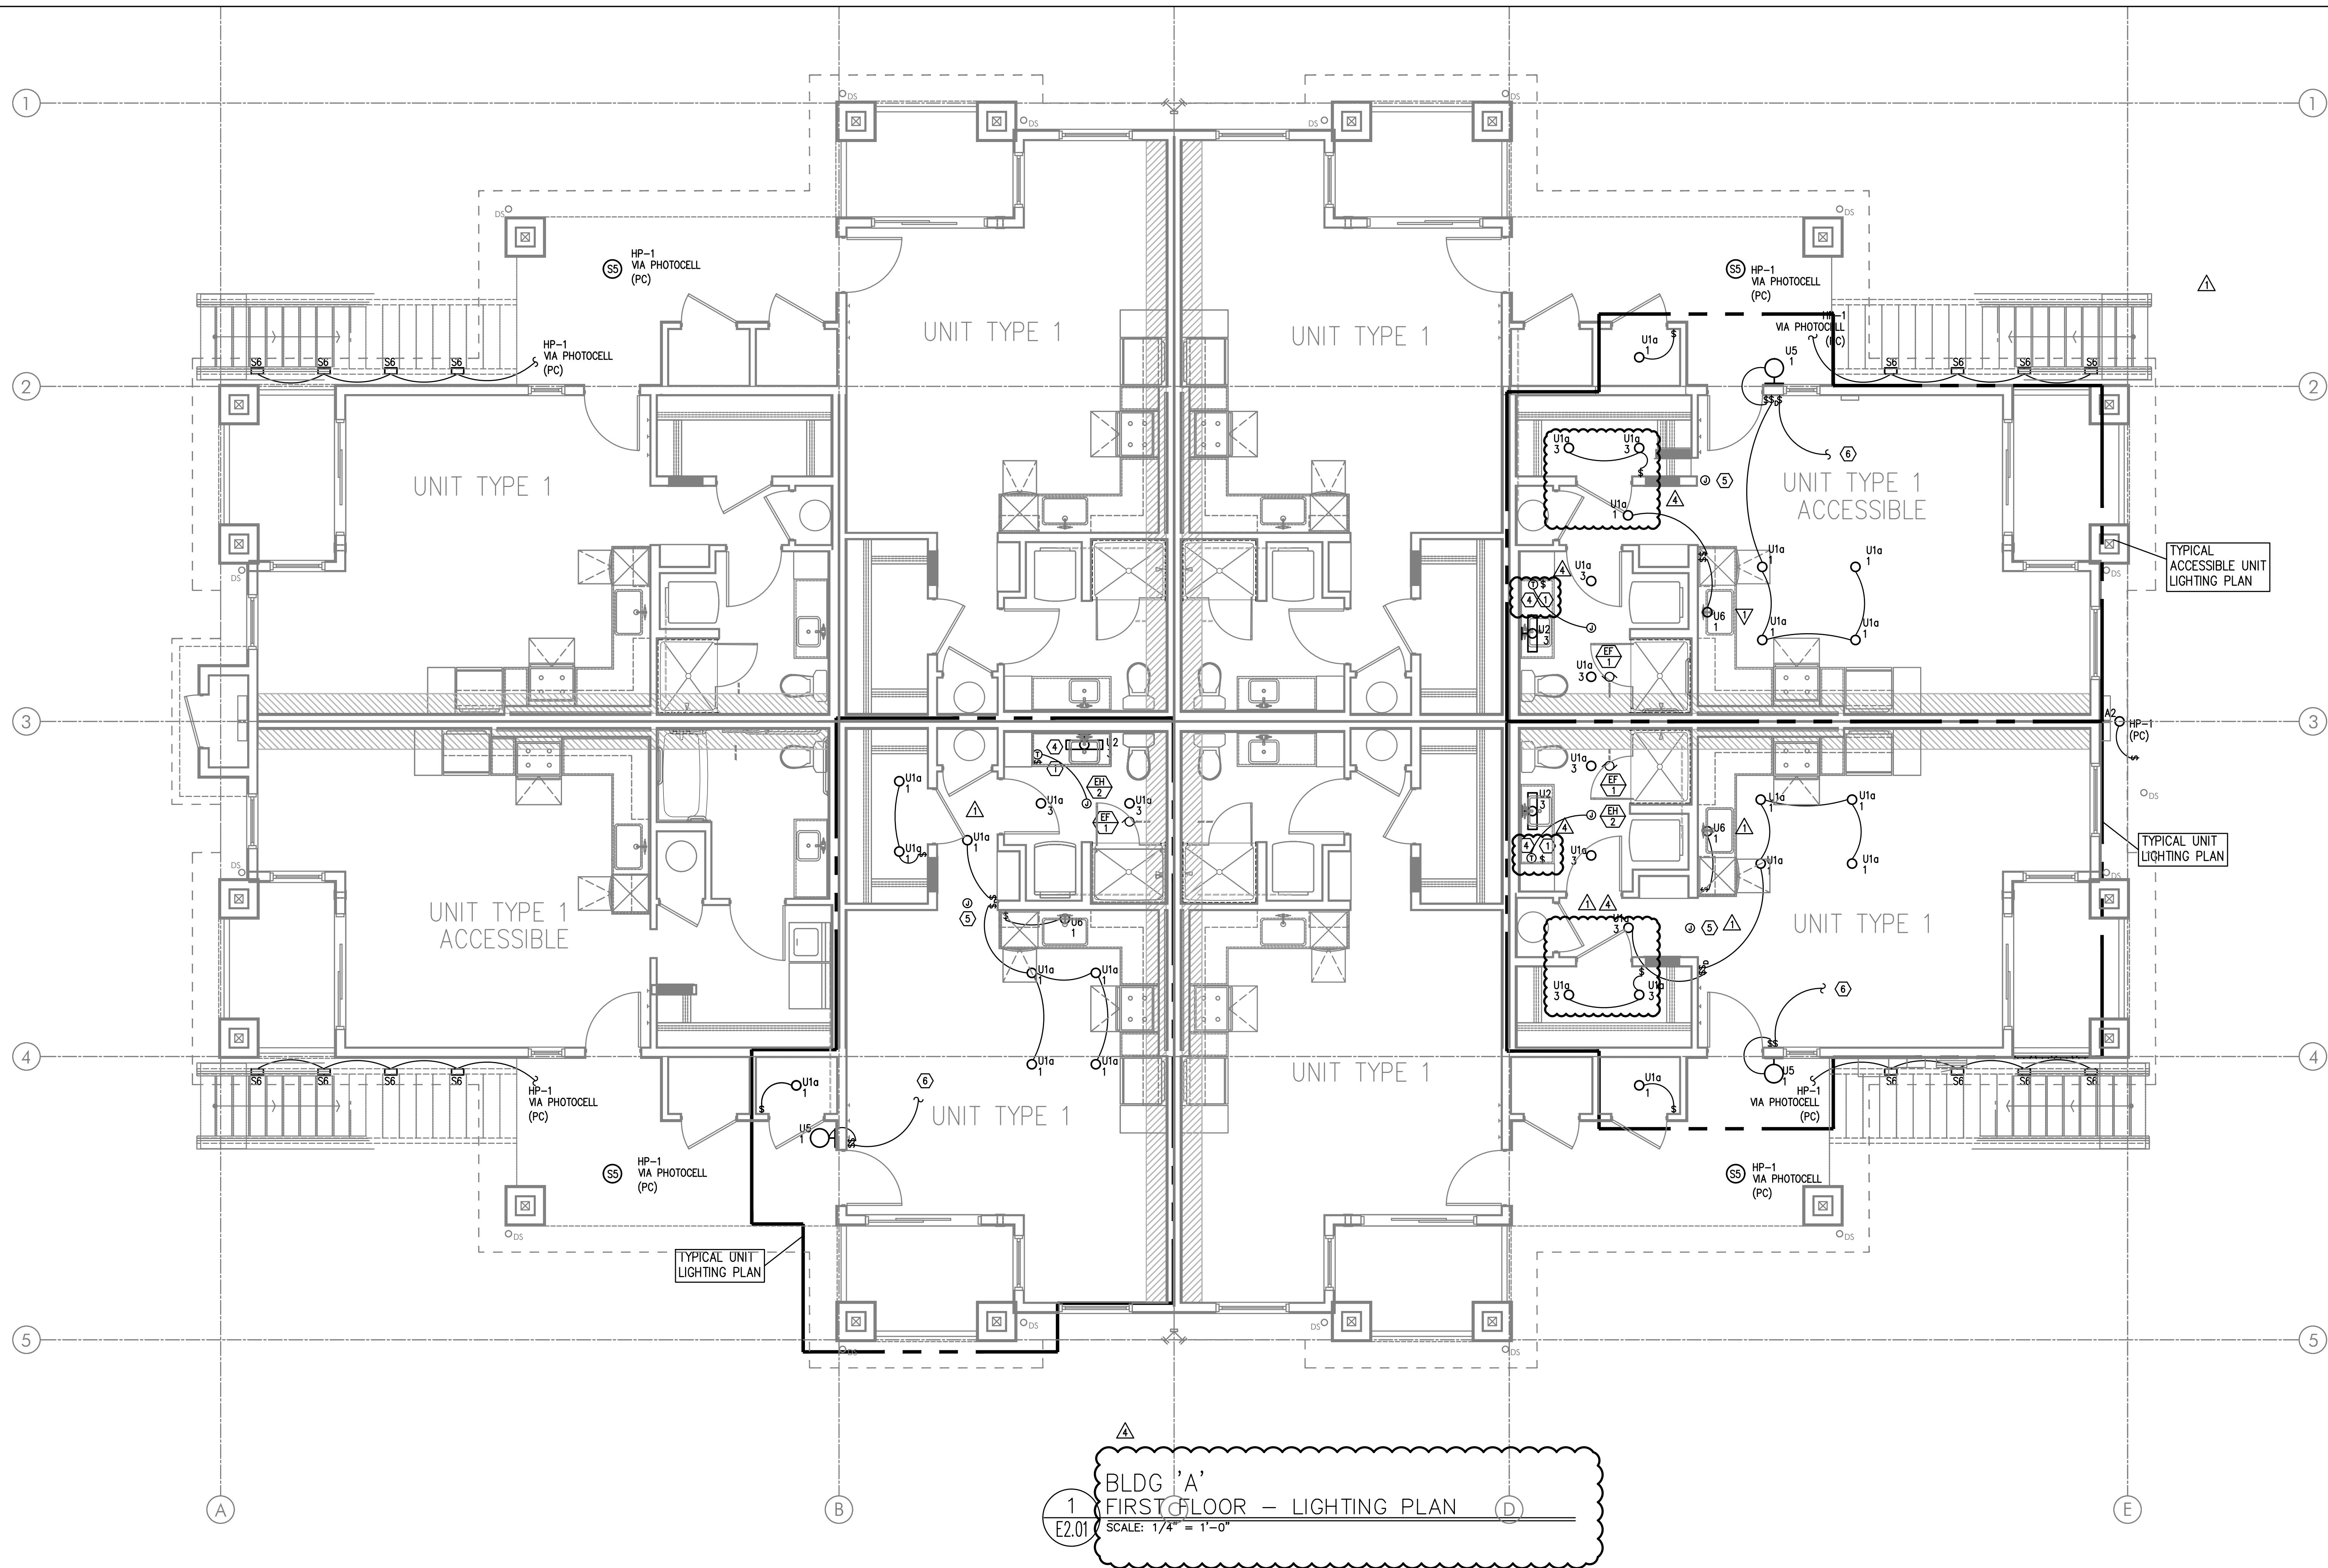


GENERAL LIGHTING NOTES:

- ELECTRICAL DRAWINGS ARE DIAGRAMMATICAL AND MAY NOT ACCURATELY REFLECT ACTUAL CONSTRUCTION CONDITIONS. THE ELECTRICAL CONTRACTOR SHALL BE RESPONSIBLE FOR COORDINATING THE INSTALLATION OF ALL ELECTRICAL EQUIPMENT, WITH ALL TRADES PRIOR TO AND DURING CONSTRUCTION.
- ALL DISCREPANCIES SHALL BE BROUGHT TO THE ATTENTION OF THE ARCHITECT IMMEDIATELY UPON DISCOVERY.
- REFER TO SHEET E1.21 FOR LIGHT FIXTURE SCHEDULES.
- THE ELECTRICAL CONTRACTOR SHALL REFER TO THE ARCHITECTURAL AND/OR INTERIORS PLAN SETS FOR DIMENSIONED LOCATIONS, MOUNTING HEIGHTS AND FINISHES OF DEVICES AND FIXTURES.
- REFER TO AVAILABLE ARCHITECTURAL AND/OR INTERIOR DESIGN DOCUMENTS & DRAWINGS FOR ADDITIONAL INFORMATION.
- EXTERIOR LIGHTING TO BE CONSTANT "ON" AND PROVIDED WITH PHOTOCELL, EITHER INTEGRAL OR REMOTE) FOR DUSK-TILL-DAWN OPERATION.
- ALL EXTERIOR BUILDING LIGHTS ON HOUSE POWER SHALL BE CONSIDERED EGRESS LIGHTING. FIXTURES ARE TO BE EQUIPPED WITH BATTERY BACK-UP (EITHER INTEGRAL OR REMOTE).
- REFER TO SHEET E1.14 FOR TYPICAL UNIT LOAD CENTER DIRECTORIES.
- ALL LIGHT SWITCHES SHALL BE ROCKER STYLE, SUCH AS LEVITON DECORA, OR APPROVED EQUAL.
- REFER TO ARCHITECTURAL REFLECTED CEILING PLANS FOR EXACT FIXTURE LOCATIONS (DIMENSIONS). CONSULT INTERIOR DESIGNER FOR MOUNTING HEIGHTS NOT SPECIFIED.
- REFER TO ARCHITECTURAL PLANS REGARDING "ACCESSIBLE" UNIT LOCATION(S), INTERIOR ELEVATIONS & DETAILS. COORDINATE INSTALLATION OF ALL DEVICES PER THE "AMERICAN DISABILITIES ACT" (ADA). REFER TO SHEET E1.21 FOR STANDARD ADA REACH REQUIREMENTS.

KEYED LIGHTING NOTES:

- REFER TO TYPICAL BATHROOM SWITCHING DETAILS ON SHEET E1.21.
- PROVIDE CEILING FAN CONTROL SWITCH(ES) AS DIRECTED BY MANUFACTURER.
- PROVIDE BLOCKING AT CEILING TO SUPPORT 35LB., MINIMUM, FOR CEILING FAN INSTALLATION.
- PROVIDE WIRE CONNECTION FOR THERMOSTAT(S) PROVIDED BY MECHANICAL INSTALLER. COORDINATE WITH MECHANICAL INSTALLER FOR EXACT LOCATION AND POWER REQUIREMENTS PRIOR TO ROUGH IN. CEILING HEATER (BY MECHANICAL) TO BE TIED INTO BATHROOM POWER CIRCUIT. REFER TO ARCHITECTURAL INTERIOR ELEVATIONS FOR DIMENSIONED LOCATIONS OF BATHROOM THERMOSTATS.
- COORDINATE LOCATION OF POWER CONNECTION FOR FIRE ALARM DEVICES WITH THE SYSTEM CONTRACTOR/INSTALLER.
- TO SWITCHED RECEPTACLE. REFER TO POWER PLANS (E3 SERIES SHEETS) FOR OUTLET LOCATION.

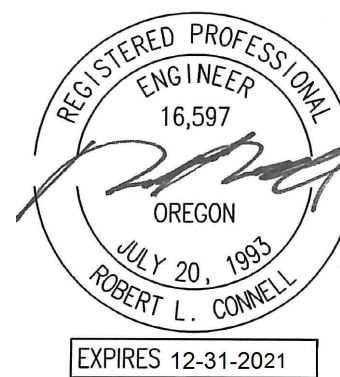

IN THE EVENT CONFLICTS ARE DISCOVERED
BETWEEN THE ORIGINAL SIGNED AND SEALED
DOCUMENT PREPARED BY THE ARCHITECT
AND/OR THEIR CONSULTANTS, AND ANY COPY OF
THE DOCUMENT TRANSMITTED BY ELECTRONIC
ELECTRONICALLY OR OTHERWISE, THE ORIGINAL
SIGNED AND SEALED DOCUMENTS SHALL GOVERN.

PROJECT # 2019-179
DATE: 28 AUGUST 2020


REVISIONS

△ PLAN REVIEW 11.03.2020
△ PLAN REVIEW 03.19.2021

MCKINNEY LANE APARTMENTS PHASE II
RUSSELL DRIVE & MCKINNEY LANE
LEBANON, OREGON

A

E2.02

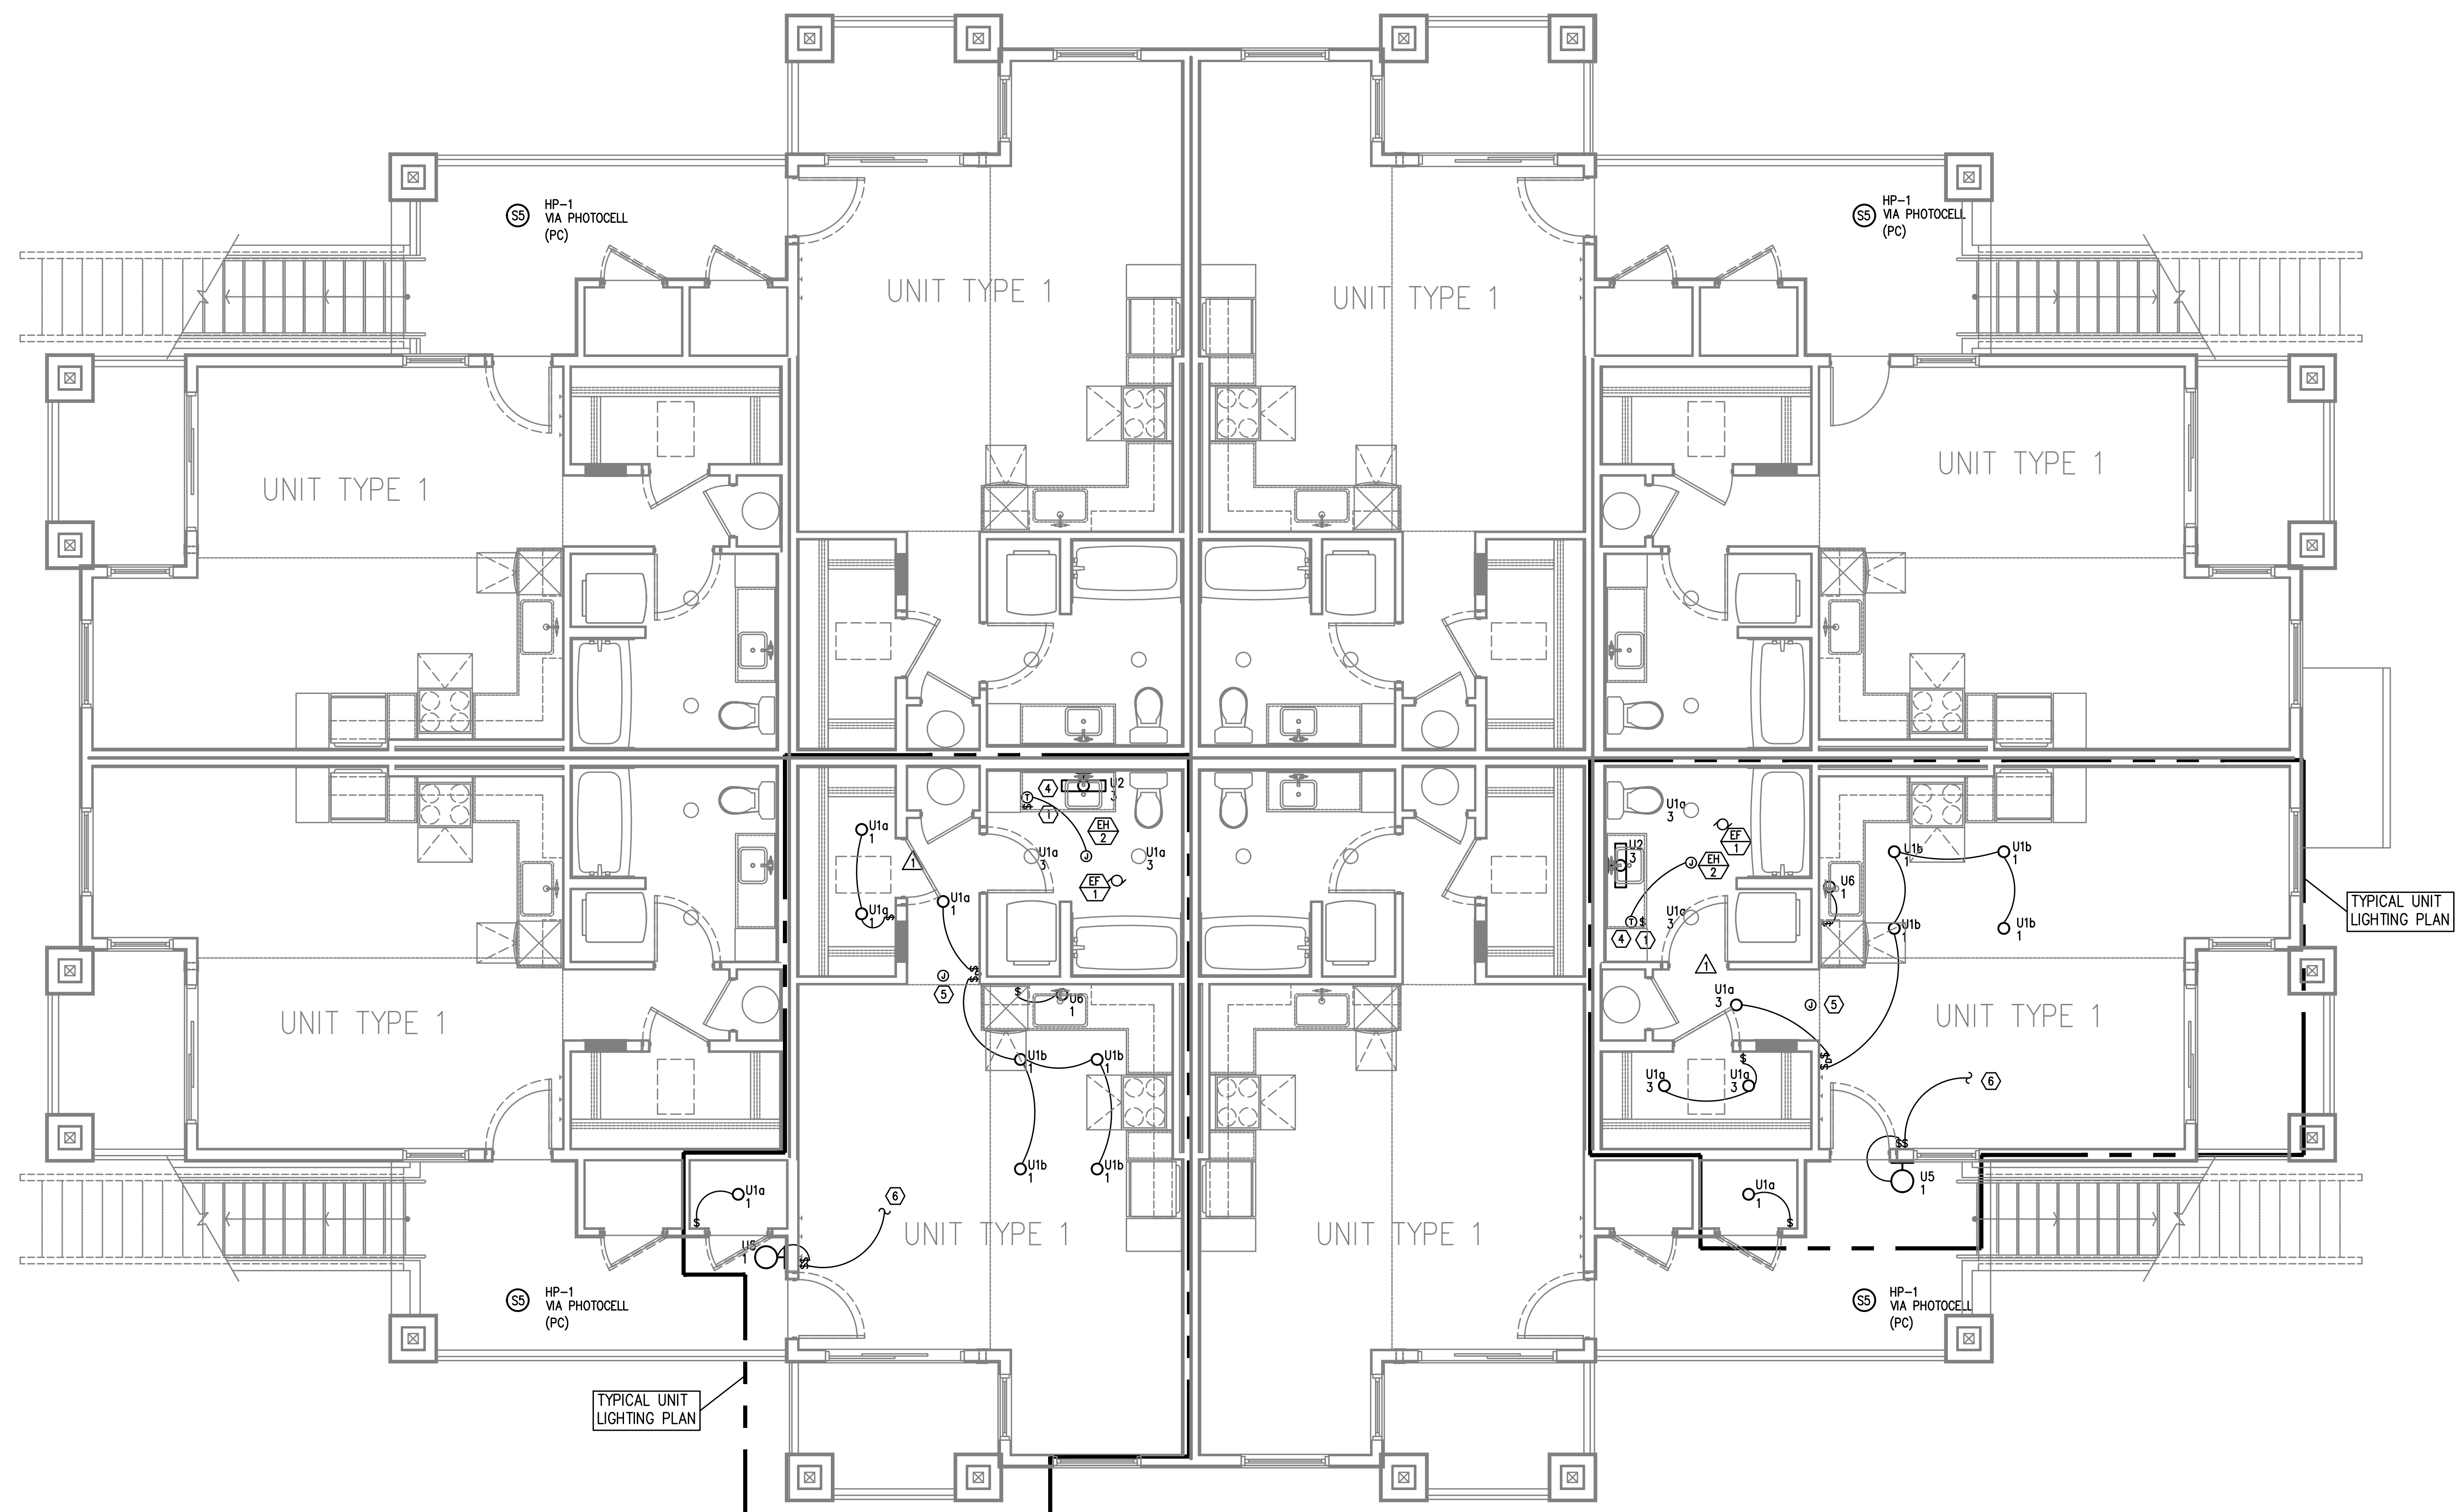

△
1 BLDG 'A'
E2.02 SECOND FLOOR - LIGHTING PLAN
SCALE: 1/4" = 1'-0"


GENERAL LIGHTING NOTES:

- ELECTRICAL DRAWINGS ARE DIAGRAMMATICAL AND MAY NOT ACCURATELY REFLECT ACTUAL CONSTRUCTION CONDITIONS. THE ELECTRICAL CONTRACTOR SHALL BE RESPONSIBLE FOR COORDINATING THE INSTALLATION OF ALL ELECTRICAL EQUIPMENT, WITH ALL TRADES PRIOR TO AND DURING CONSTRUCTION.
- △ ALL DISCREPANCIES SHALL BE BROUGHT TO THE ATTENTION OF THE ARCHITECT IMMEDIATELY UPON DISCOVERY.
- REFER TO SHEET E1.21 FOR LIGHT FIXTURE SCHEDULES.
- △ THE ELECTRICAL CONTRACTOR SHALL REFER TO THE ARCHITECTURAL AND/OR INTERIORS PLAN SETS FOR DIMENSIONED LOCATIONS, MOUNTING HEIGHTS AND FINISHES OF DEVICES AND FIXTURES.
- REFER TO AVAILABLE ARCHITECTURAL AND/OR INTERIOR DESIGN DOCUMENTS & DRAWINGS FOR ADDITIONAL INFORMATION.
- EXTERIOR LIGHTING TO BE CONSTANT "ON" AND PROVIDED WITH PHOTOCELL, EITHER INTEGRAL OR REMOTE) FOR DUSK-TILL-DAWN OPERATION.
- ALL EXTERIOR BUILDING LIGHTS ON HOUSE POWER SHALL BE CONSIDERED EGRESS LIGHTING. FIXTURES ARE TO BE EQUIPPED WITH BATTERY BACK-UP (EITHER INTEGRAL OR REMOTE).
- REFER TO SHEET E1.14 FOR TYPICAL UNIT LOAD CENTER DIRECTORIES.
- ALL LIGHT SWITCHES SHALL BE ROCKER STYLE, SUCH AS LEVITON DECORA, OR APPROVED EQUAL.
- REFER TO ARCHITECTURAL REFLECTED CEILING PLANS FOR EXACT FIXTURE LOCATIONS (DIMENSIONS). CONSULT INTERIOR DESIGNER FOR MOUNTING HEIGHTS NOT SPECIFIED.
- △ K. REFER TO ARCHITECTURAL PLANS REGARDING "ACCESSIBLE" UNIT LOCATION(S), INTERIOR ELEVATIONS & DETAILS. COORDINATE INSTALLATION OF ALL DEVICES PER THE "AMERICAN DISABILITIES ACT" (ADA). REFER TO SHEET E1.21 FOR STANDARD ADA REACH REQUIREMENTS.

○ KEYED LIGHTING NOTES:

- REFER TO TYPICAL BATHROOM SWITCHING DETAILS ON SHEET E1.21.
- PROVIDE CEILING FAN CONTROL SWITCH(ES) AS DIRECTED BY MANUFACTURER.
- PROVIDE BLOCKING AT CEILING TO SUPPORT 35LB., MINIMUM, FOR CEILING FAN INSTALLATION.
- △ 4. PROVIDE WIRE CONNECTION FOR THERMOSTAT(S) PROVIDED BY MECHANICAL INSTALLER. COORDINATE WITH MECHANICAL INSTALLER FOR EXACT LOCATION AND POWER REQUIREMENTS PRIOR TO ROUGH IN. CEILING HEATER (BY MECHANICAL) TO BE TIED INTO BATHROOM POWER CIRCUIT. REFER TO ARCHITECTURAL INTERIOR ELEVATIONS FOR DIMENSIONED LOCATIONS OF BATHROOM THERMOSTATS.
- COORDINATE LOCATION OF POWER CONNECTION FOR FIRE ALARM DEVICES WITH THE SYSTEM CONTRACTOR/INSTALLER.
- TO SWITCHED RECEPTACLE. REFER TO POWER PLANS (E3 SERIES SHEETS) FOR OUTLET LOCATION.



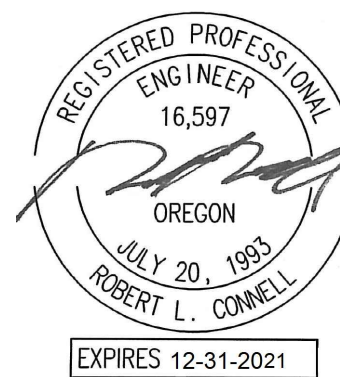


IN THE EVENT CONFLICTS ARE DISCOVERED
BETWEEN THE ORIGINAL SIGNED AND SEALED
DOCUMENTS PREPARED BY THE ARCHITECTS
AND/OR THEIR CONSULTANTS, AND ANY COPY OF
THE DOCUMENTS TRANSMITTED BY EMAIL, FAX,
ELECTRONICALLY OR OTHERWISE, THE ORIGINAL
SIGNED AND SEALED DOCUMENTS SHALL GOVERN.

PROJECT # 2019-179
DATE: 28 AUGUST 2020

REVISIONS

△ PLAN REVIEW 11.03.2020
△ PLAN REVIEW 03.19.2021

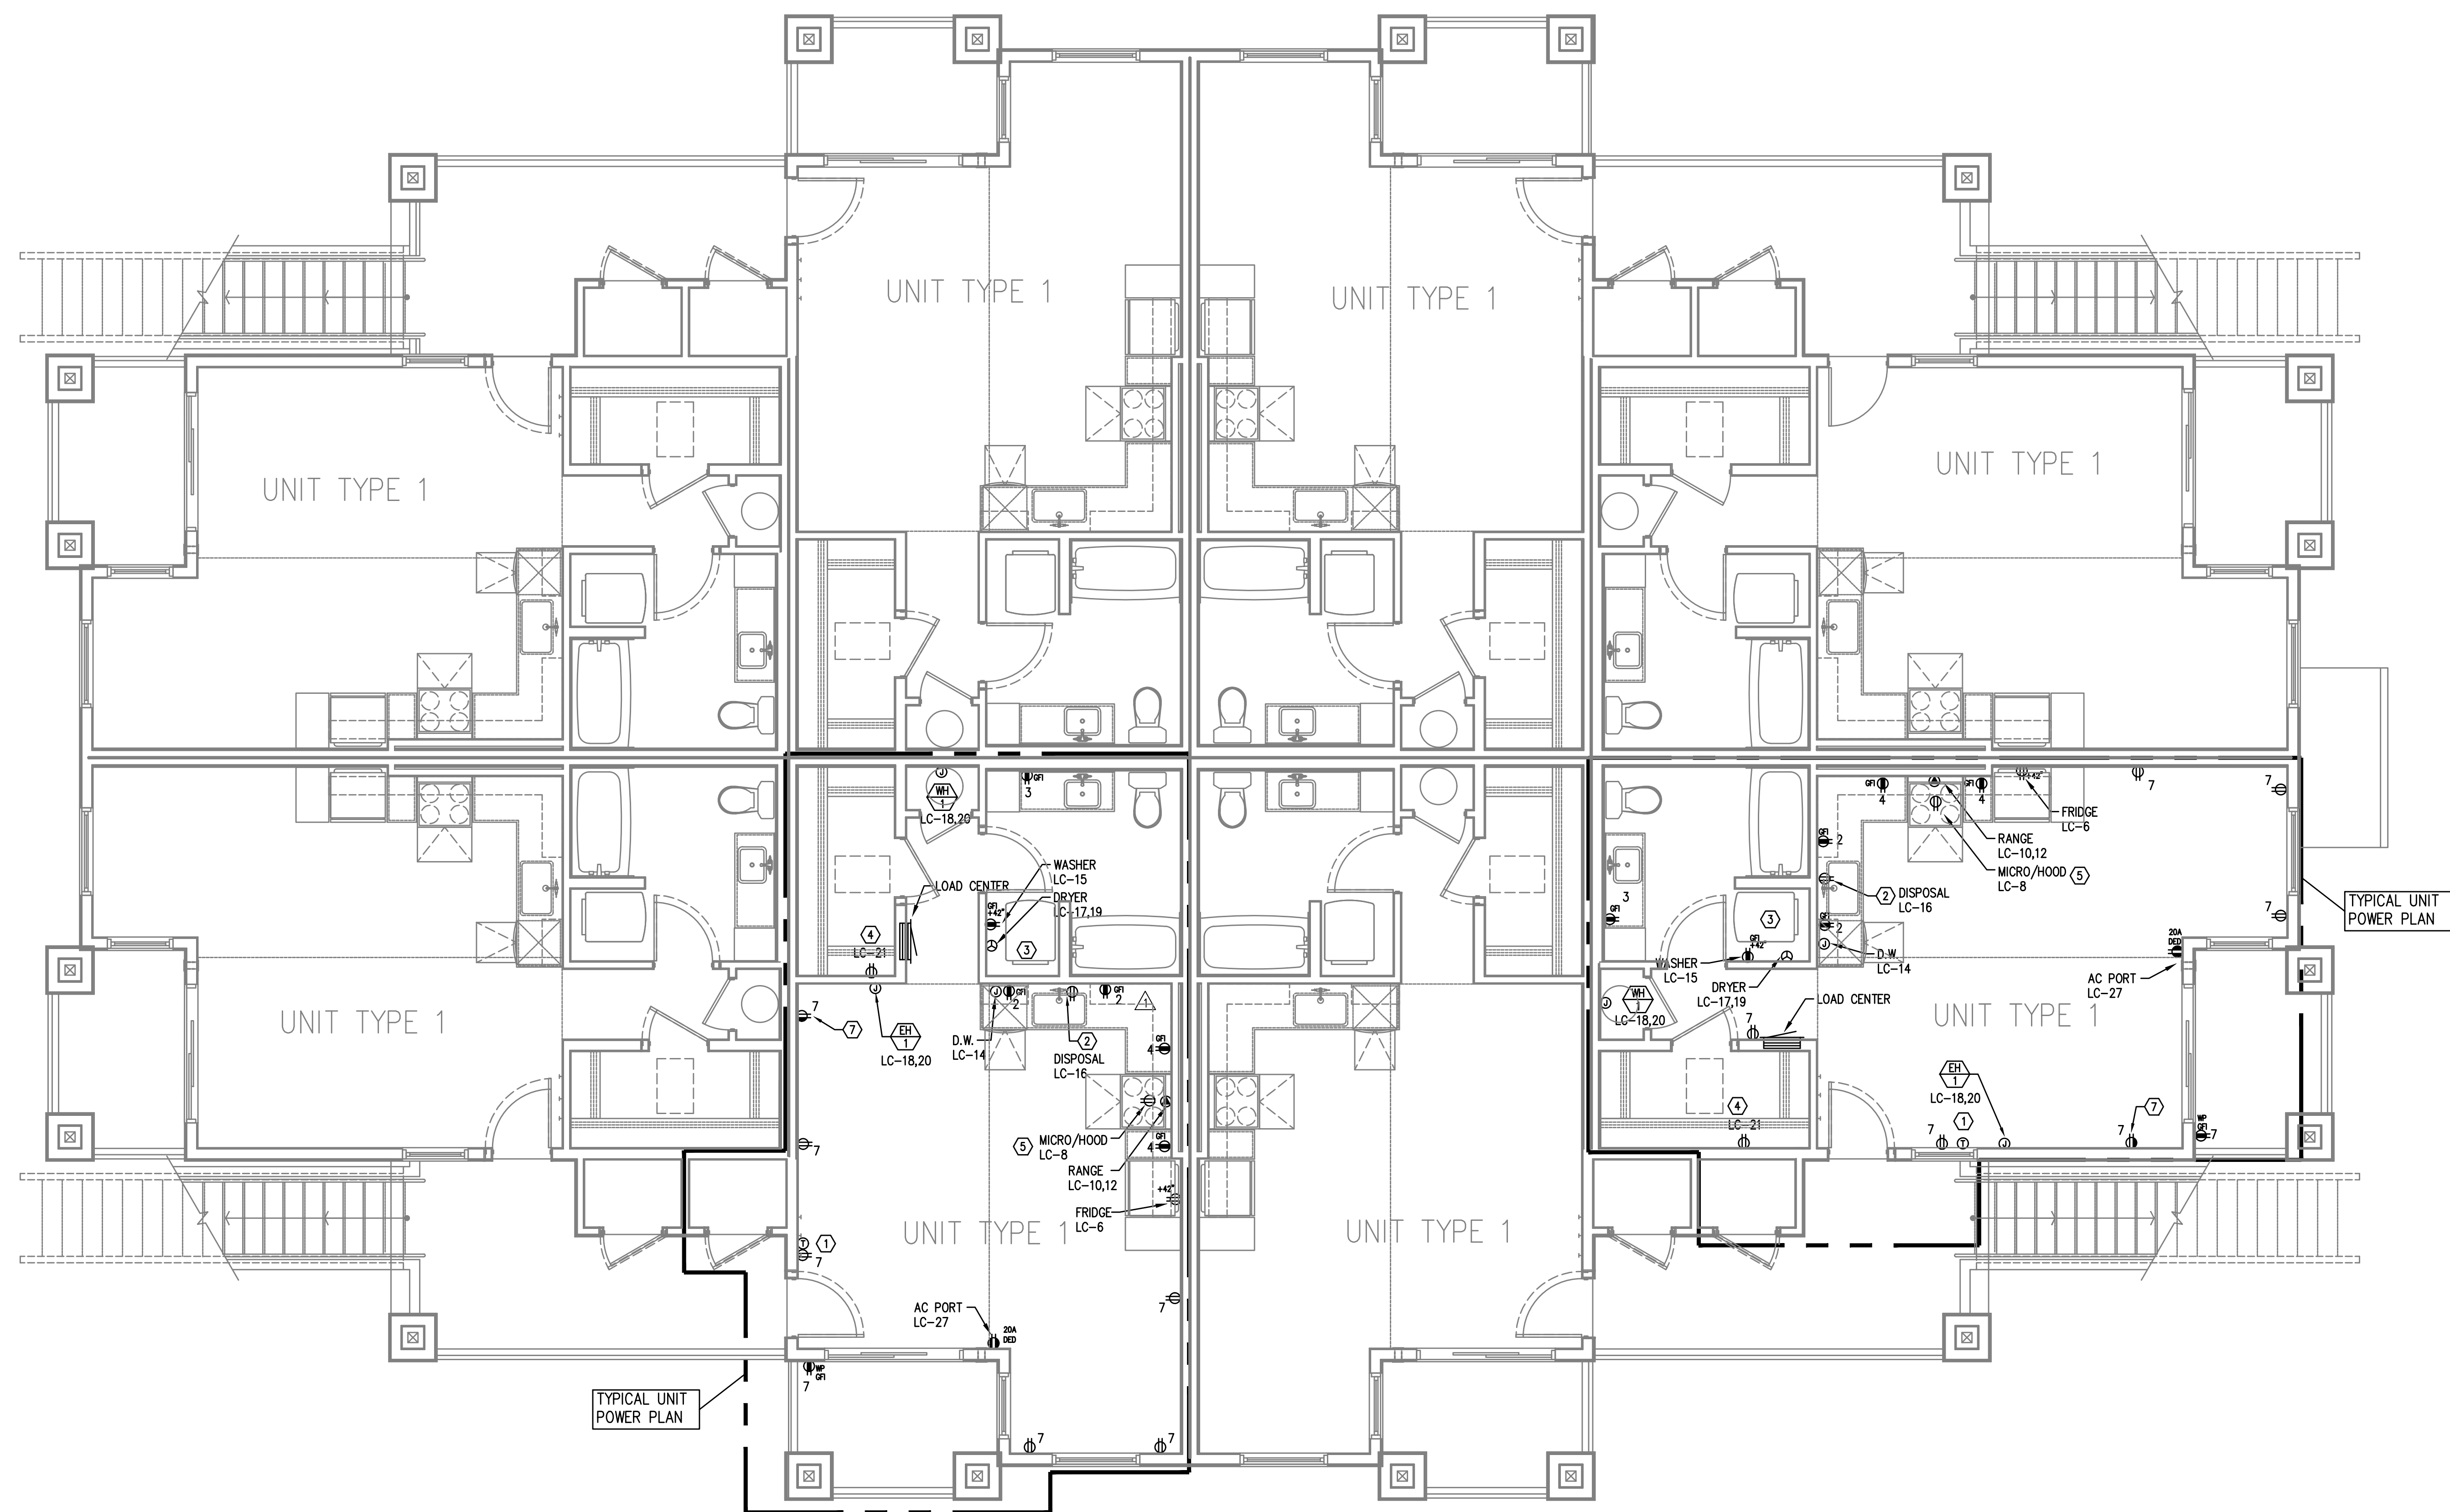


△
1
E302
BLDG 'A'
SECOND FLOOR - POWER PLAN
SCALE: 1/4" = 1'-0"

GENERAL POWER NOTES:


- ALL PLANS ARE CONSIDERED DIAGRAMMATICAL. THEREFORE ALL EQUIPMENT SIZES AND DEVICE LOCATIONS ARE APPROXIMATE AND SUBJECT TO FIELD CONDITIONS AND PRODUCT APPROVAL.
- NOT USED.
- ELECTRICAL CONTRACTOR SHALL PROVIDE INSTALLATION AND FINAL CONNECTION OF THERMOSTATS. CONSULT MECHANICAL CONTRACTOR FOR EXACT REQUIREMENTS PRIOR TO ROUGH IN.
- REFER TO INTERIOR DECORATOR AND/OR ARCHITECTURAL DRAWINGS FOR DIMENSIONED LOCATION(S) AND ELEVATIONS OF FIXTURES & DEVICES. OTHER DEVICES SHOWN ON THE ELECTRICAL PLANS AND NOT INDICATED ON THE DECORATOR'S OR ARCHITECT'S DRAWINGS, SHALL BE INSTALLED AT STANDARD MOUNTING HEIGHT AS INDICATED THE SYMBOL LIST.
- BUILDING ELECTRICAL EQUIPMENT SHOWN IS APPROXIMATE, BASED ON INDUSTRY STANDARD PRODUCTS. CONTRACTOR SHALL VERIFY ANY SUBMITTED EQUIPMENT WILL FIT WITHIN THE SPACE PROVIDED, PRIOR TO PRODUCT SUBMITTAL REVIEW.
- ELECTRICAL CONTRACTOR SHALL COORDINATE WITH THE LOW VOLTAGE ("T" SERIES) PLANS, INCLUDING FIRE ALARM AND SYSTEMS INSTALLER, AND PROVIDE ROUGH IN AS NEEDED.
- REFER TO ARCHITECTURAL PLANS REGARDING "ACCESSIBLE" UNIT LOCATION(S), INTERIOR ELEVATIONS & DETAILS. COORDINATE INSTALLATION OF ALL DEVICES PER THE "AMERICAN DISABILITIES ACT" (ADA). REFER TO SHEET E1.21 FOR STANDARD ADA REACH REQUIREMENTS.

KEYED POWER NOTES:

- PROVIDE WIRE CONNECTION FOR THERMOSTAT(S) PROVIDED BY MECHANICAL INSTALLER. COORDINATE WITH MECHANICAL INSTALLER FOR EXACT LOCATION AND POWER REQUIREMENTS PRIOR TO ROUGH IN.
- PROVIDE ONE 20A, 120V, 1P GFCI DUPLEX RECEPTACLE UNDER KITCHEN SINK FOR DISPOSAL POWER CONNECTION.
- REFER TO DETAIL 1/E1.13 FOR TYPICAL LAUNDRY ALCOVE RECEPTACLE LOCATIONS. COORDINATE INSTALLATION WITH MECHANICAL & PLUMBING CONTRACTOR.
- PROVIDE ONE 15A, RECEPTACLE CIRCUIT FROM TENANT LOAD CENTER FOR TELECOM SMART PANEL. COORDINATE WORK WITH SERVICE PROVIDER FOR EXACT LOCATION AND FINAL CONNECTION.
- CONTRACTOR TO VERIFY POWER CONNECTION TYPE FOR THE HOOD/MICROWAVE PRIOR TO ROUGH IN. PROVIDE ONE DEDICATED 20A, 1P DUPLEX RECEPTACLE LOCATED INSIDE THE CABINET OVER THE RANGE FOR APPLIANCES SUPPLIED WITH CORD & PLUG SET. HOOD/MICROWAVES THAT ARE TO BE HARDWIRED, SHALL BE PROVIDED WITH THE DEDICATED CIRCUIT GOING TO A J-BOX WHICH IS TO BE MOUNTED DIRECTLY BEHIND THE APPLIANCE.
- METER LOCATION PER UTILITY PROVIDER'S APPROVAL (PENDING). REFER TO ONE-LINE DIAGRAM ON SHEET E1.11. PROVIDE NEMA 3R LOCKING CABINET FOR HOUSE PANEL "HP". REFER TO SHEET E1.01 FOR METER & PANEL LOCATION(S) AT EACH BUILDING.
- 15A SWITCHED SPLIT DUPLEX RECEPTACLE. REFER TO LIGHTING PLANS (E2 SERIES SHEETS) FOR SWITCH LOCATION.

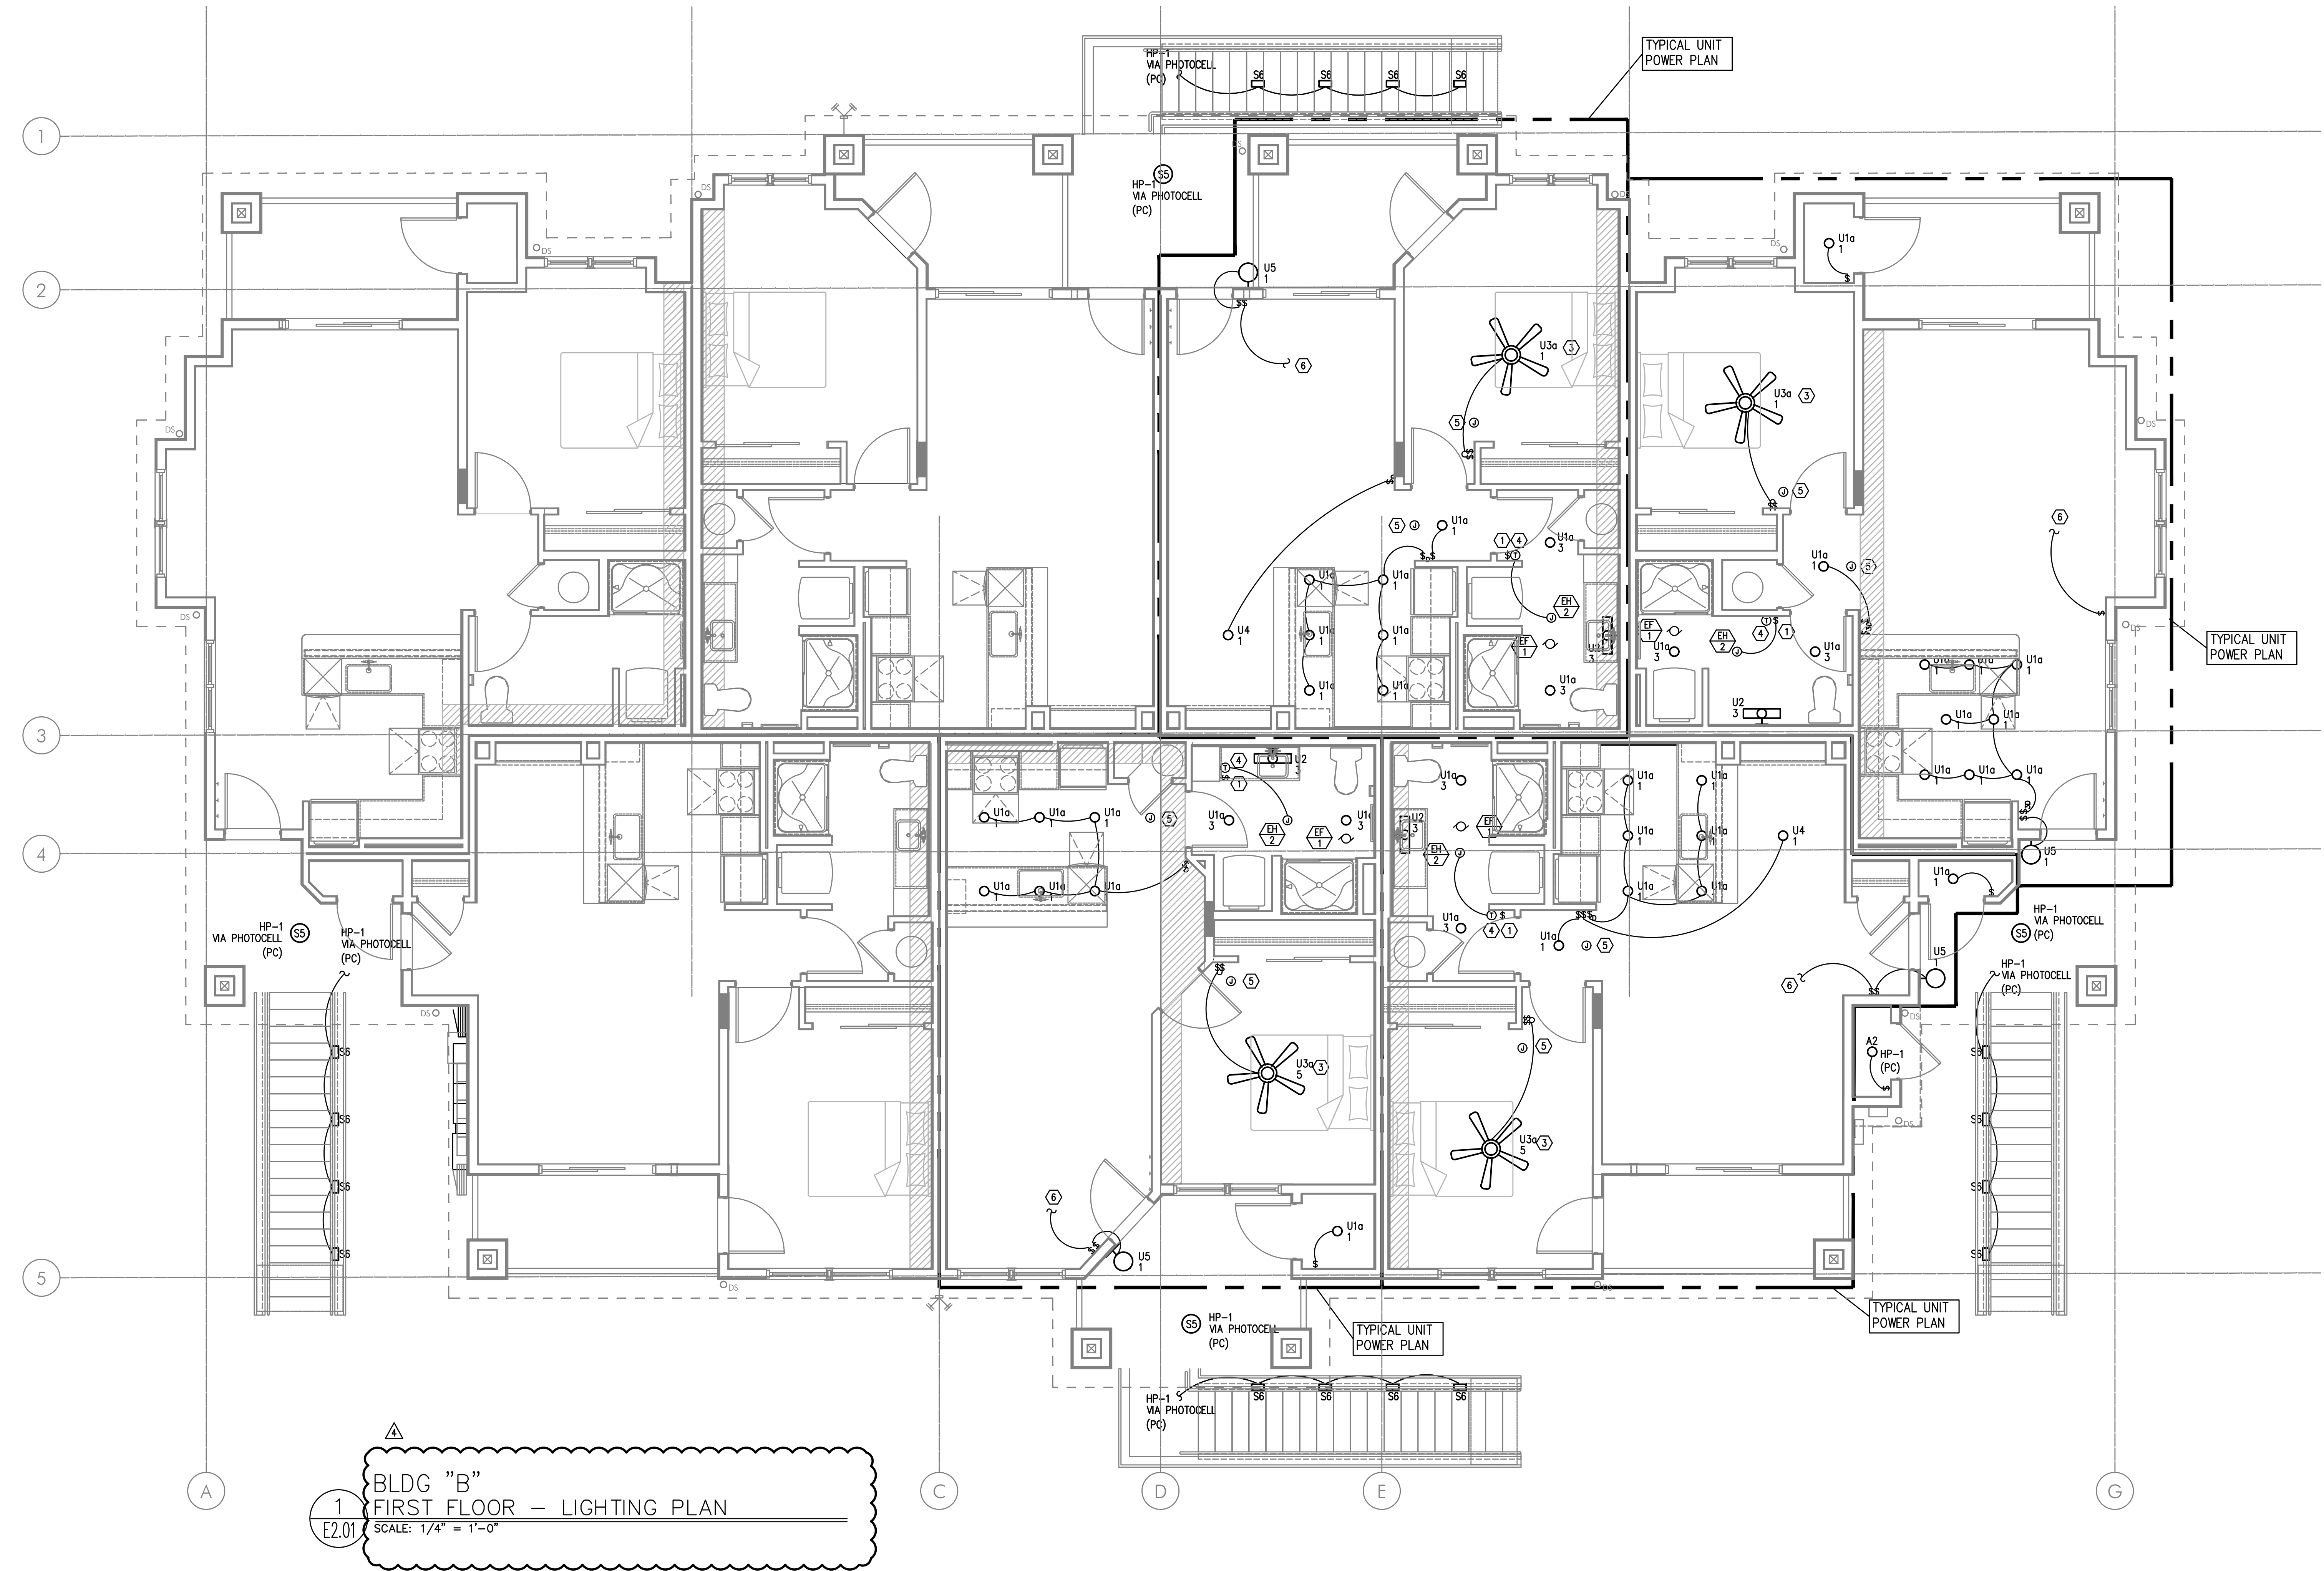

- GENERAL LIGHTING NOTES:
- ELECTRICAL DRAWINGS ARE DIAGRAMMATICAL AND MAY NOT ACCURATELY REFLECT ACTUAL CONSTRUCTION CONDITIONS. THE ELECTRICAL CONTRACTOR SHALL BE RESPONSIBLE FOR COORDINATING THE INSTALLATION OF ALL ELECTRICAL EQUIPMENT, WITH ALL TRADES PRIOR TO AND DURING CONSTRUCTION.
 - ALL DISCREPANCIES SHALL BE BROUGHT TO THE ATTENTION OF THE ARCHITECT IMMEDIATELY UPON DISCOVERY.
 - REFER TO SHEET E1.21 FOR LIGHT FIXTURE SCHEDULES.
 - THE ELECTRICAL CONTRACTOR SHALL REFER TO THE ARCHITECTURAL AND/OR INTERIORS PLAN SETS FOR DIMENSIONED LOCATIONS, MOUNTING HEIGHTS AND FINISHES OF DEVICES AND FIXTURES.
 - REFER TO AVAILABLE ARCHITECTURAL AND/OR INTERIOR DESIGN DOCUMENTS & DRAWINGS FOR ADDITIONAL INFORMATION.
 - EXTERIOR LIGHTING TO BE CONSTANT "ON" AND PROVIDED WITH PHOTOCELL, EITHER INTEGRAL OR REMOTE) FOR DUSK-TILL-DAWN OPERATION.
 - ALL EXTERIOR BUILDING LIGHTS ON HOUSE POWER SHALL BE CONSIDERED EGRESS LIGHTING. FIXTURES ARE TO BE EQUIPPED WITH BATTERY BACK-UP (EITHER INTEGRAL OR REMOTE).
 - REFER TO SHEET E1.14 FOR TYPICAL UNIT LOAD CENTER DIRECTORIES.
 - ALL LIGHT SWITCHES SHALL BE ROCKER STYLE, SUCH AS LEVITON DECORA, OR APPROVED EQUAL.
 - REFER TO ARCHITECTURAL REFLECTED CEILING PLANS FOR EXACT FIXTURE LOCATIONS (DIMENSIONS). CONSULT INTERIOR DESIGNER FOR MOUNTING HEIGHTS NOT SPECIFIED.
- KEYED LIGHTING NOTES:
- REFER TO TYPICAL BATHROOM SWITCHING DETAILS ON SHEET E1.21.
 - PROVIDE CEILING FAN CONTROL SWITCH(ES) AS DIRECTED BY MANUFACTURER.
 - PROVIDE BLOCKING AT CEILING TO SUPPORT 35LB., MINIMUM, FOR CEILING FAN INSTALLATION.
 - PROVIDE WIRE CONNECTION FOR THERMOSTAT(S) PROVIDED BY MECHANICAL INSTALLER. COORDINATE WITH MECHANICAL INSTALLER FOR EXACT LOCATION AND POWER REQUIREMENTS PRIOR TO ROUGH IN. CEILING HEATER (BY MECHANICAL) TO BE TIED INTO BATHROOM POWER CIRCUIT. REFER TO ARCHITECTURAL INTERIOR ELEVATIONS FOR DIMENSIONED LOCATIONS OF BATHROOM THERMOSTATS.
 - COORDINATE LOCATION OF POWER CONNECTION FOR FIRE ALARM DEVICES WITH THE SYSTEM CONTRACTOR/INSTALLER.
 - TO SWITCHED RECEPTACLE. REFER TO POWER PLANS (E3 SERIES SHEETS) FOR OUTLET LOCATION.

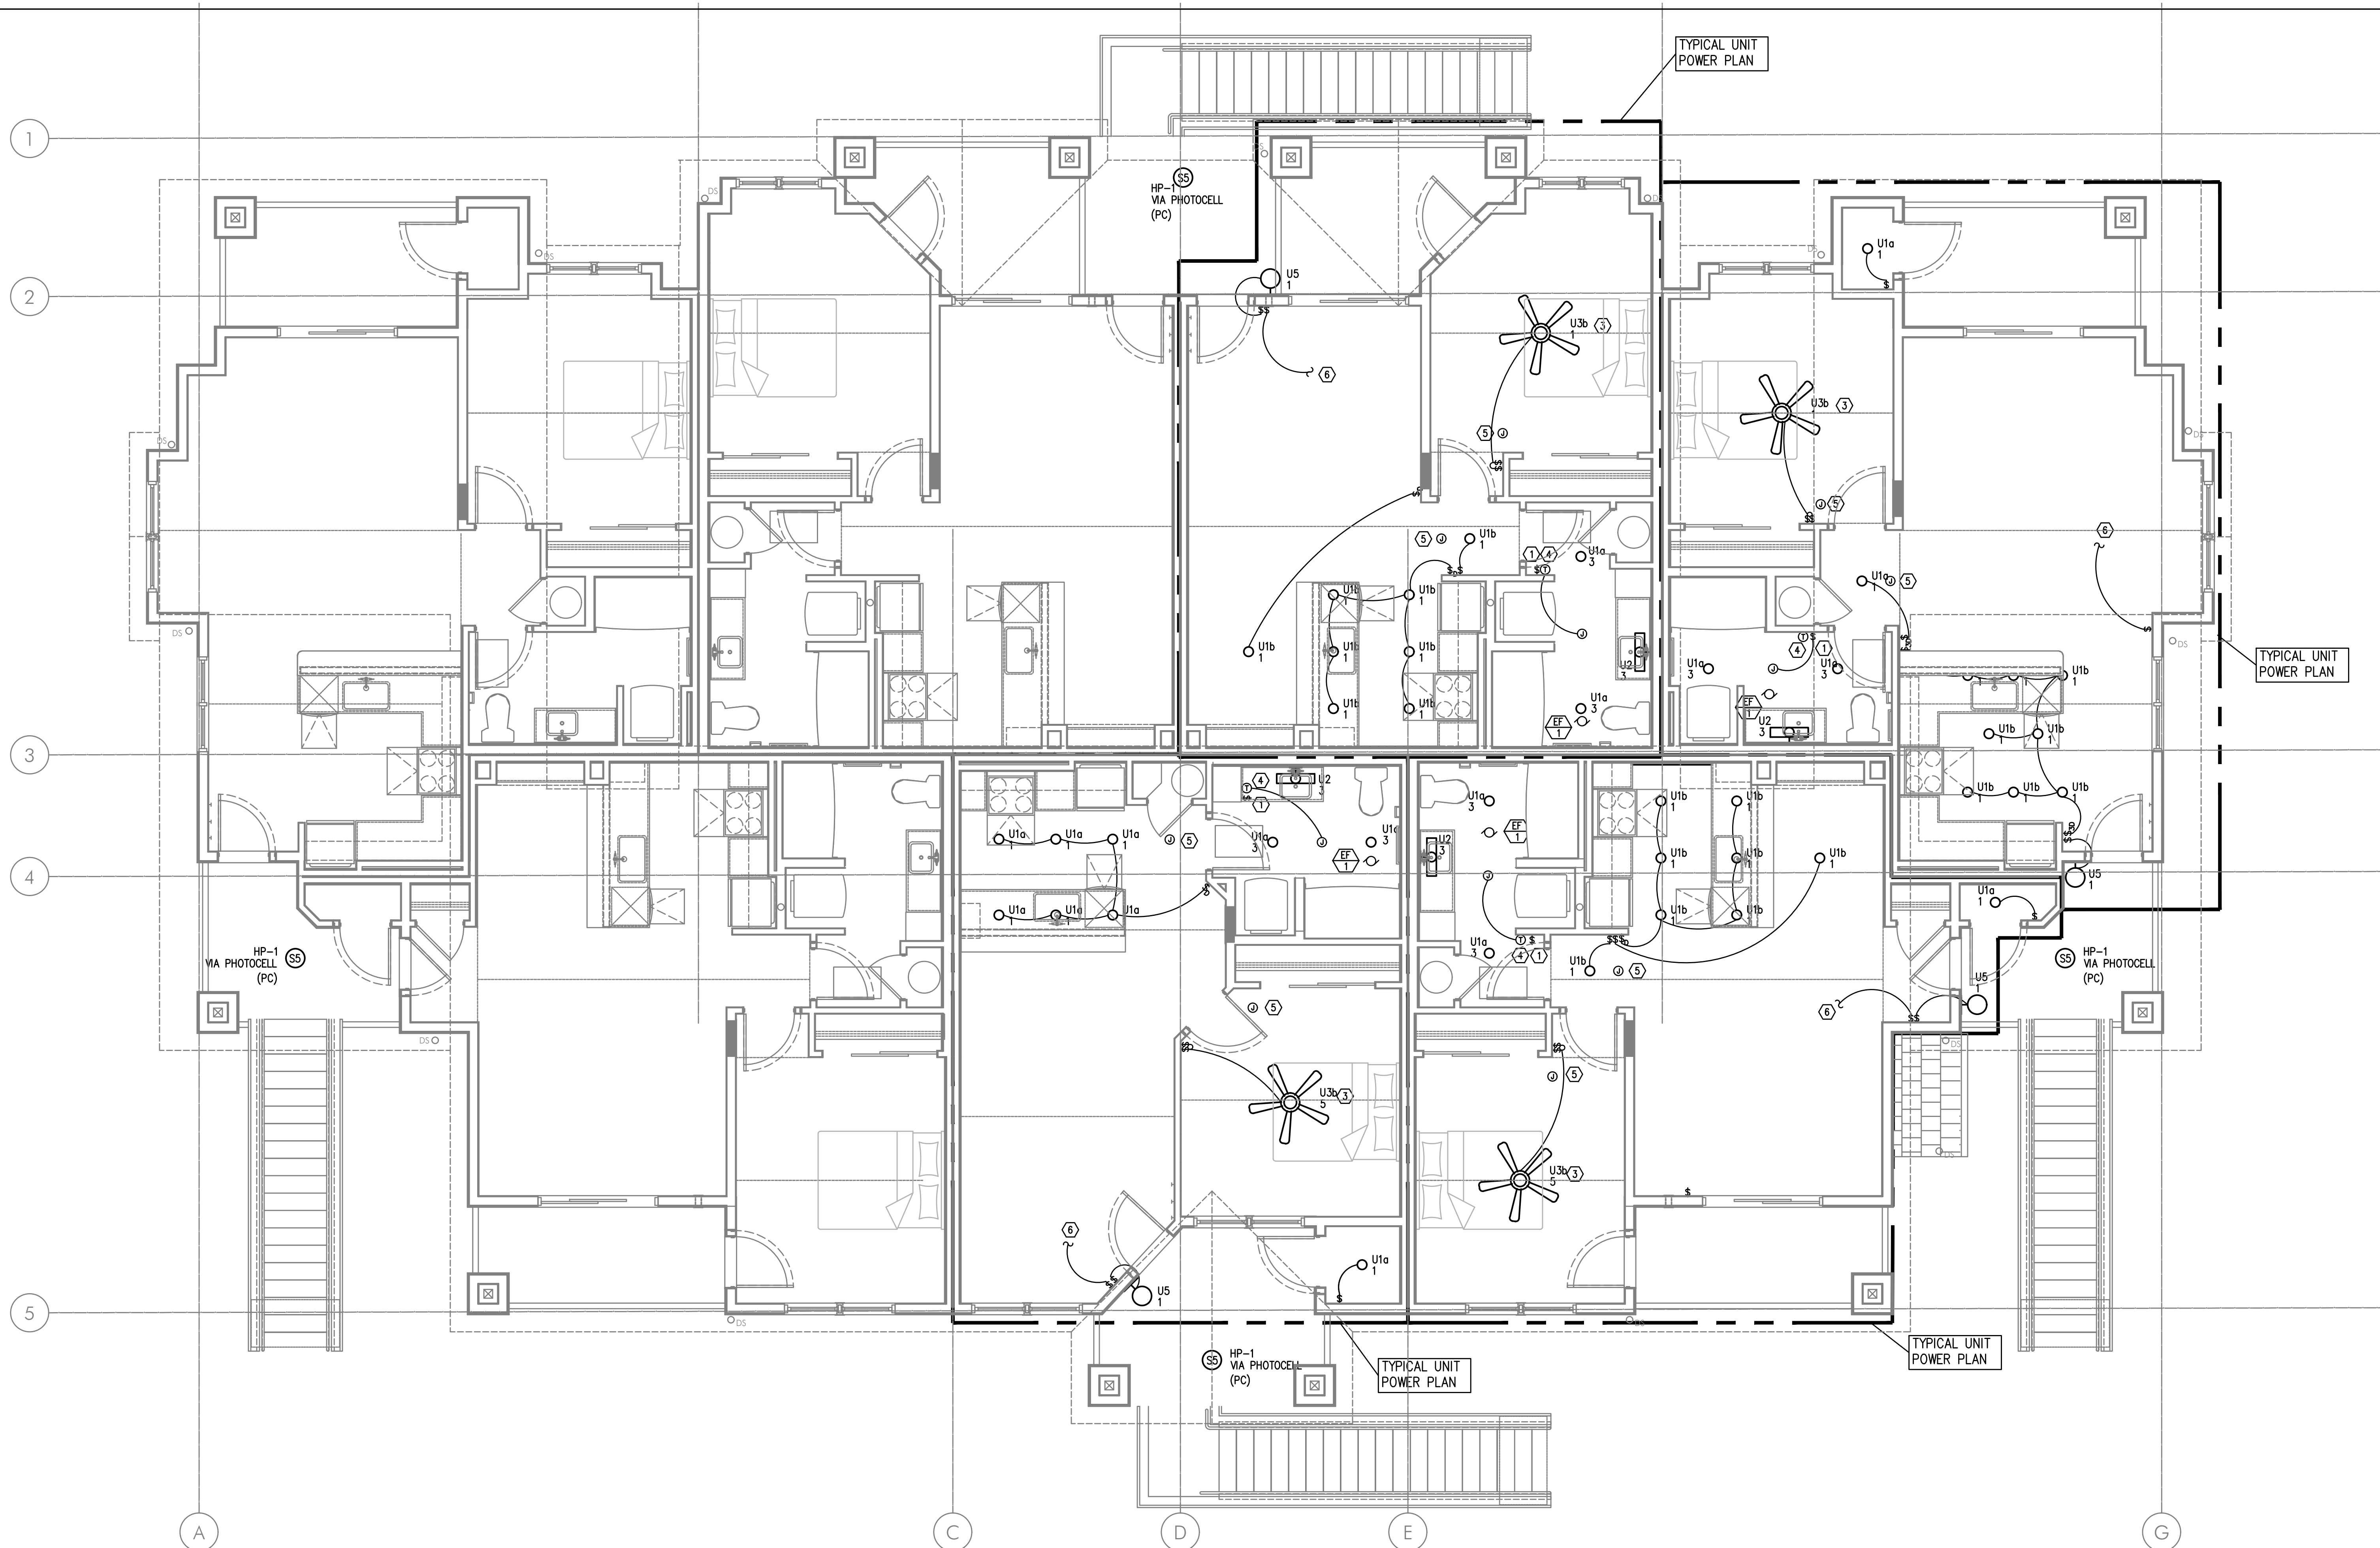


BLDG "B"
SECOND FLOOR - LIGHTING PLAN
SCALE: 1/4" = 1'-0"

GENERAL LIGHTING NOTES:

- ELECTRICAL DRAWINGS ARE DIAGRAMMATICAL AND MAY NOT ACCURATELY REFLECT ACTUAL CONSTRUCTION CONDITIONS. THE ELECTRICAL CONTRACTOR SHALL BE RESPONSIBLE FOR COORDINATING THE INSTALLATION OF ALL ELECTRICAL EQUIPMENT, WITH ALL TRADES PRIOR TO AND DURING CONSTRUCTION.
- ALL DISCREPANCIES SHALL BE BROUGHT TO THE ATTENTION OF THE ARCHITECT IMMEDIATELY UPON DISCOVERY.
- REFER TO SHEET E1-21 FOR LIGHT FIXTURE SCHEDULES.
- THE ELECTRICAL CONTRACTOR SHALL REFER TO THE ARCHITECTURAL AND/OR INTERIORS PLAN SETS FOR DIMENSIONED LOCATIONS, MOUNTING HEIGHTS AND FINISHES OF DEVICES AND FIXTURES.
- REFER TO AVAILABLE ARCHITECTURAL AND/OR INTERIOR DESIGN DOCUMENTS & DRAWINGS FOR ADDITIONAL INFORMATION.
- EXTERIOR LIGHTING TO BE CONSTANT "ON" AND PROVIDED WITH PHOTOCELL, EITHER INTEGRAL OR REMOTE) FOR DUSK-TILL-DAWN OPERATION.
- ALL EXTERIOR BUILDING LIGHTS ON HOUSE POWER SHALL BE CONSIDERED EGRESS LIGHTING. FIXTURES ARE TO BE EQUIPPED WITH BATTERY BACK-UP (EITHER INTEGRAL OR REMOTE).
- REFER TO SHEET E1-14 FOR TYPICAL UNIT LOAD CENTER DIRECTORIES.
- ALL LIGHT SWITCHES SHALL BE ROCKER STYLE, SUCH AS LEVITON DECORA, OR APPROVED EQUAL.
- REFER TO ARCHITECTURAL REFLECTED CEILING PLANS FOR EXACT FIXTURE LOCATIONS (DIMENSIONS). CONSULT INTERIOR DESIGNER FOR MOUNTING HEIGHTS NOT SPECIFIED.

KEYED LIGHTING NOTES:

- REFER TO TYPICAL BATHROOM SWITCHING DETAILS ON SHEET E1-21.
- PROVIDE CEILING FAN CONTROL SWITCH(ES) AS DIRECTED BY MANUFACTURER.
- PROVIDE BLOCKING AT CEILING TO SUPPORT 35LB., MINIMUM, FOR CEILING FAN INSTALLATION.
- PROVIDE WIRE CONNECTION FOR THERMOSTAT(S) PROVIDED BY MECHANICAL INSTALLER. COORDINATE WITH MECHANICAL INSTALLER FOR EXACT LOCATION AND POWER REQUIREMENTS PRIOR TO ROUGH IN. CEILING HEATER (BY MECHANICAL) TO BE TIED INTO BATHROOM POWER CIRCUIT. REFER TO ARCHITECTURAL INTERIOR ELEVATIONS FOR DIMENSIONED LOCATIONS OF BATHROOM THERMOSTATS.
- COORDINATE LOCATION OF POWER CONNECTION FOR FIRE ALARM DEVICES WITH THE SYSTEM CONTRACTOR/INSTALLER.
- TO SWITCHED RECEPTACLE. REFER TO POWER PLANS (E3 SERIES SHEETS) FOR OUTLET LOCATION.

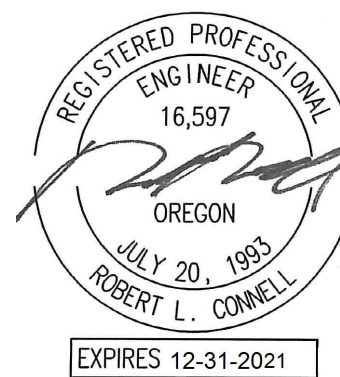

IN THE EVENT CONFLICTS ARE DISCOVERED
BETWEEN THE ORIGINAL SIGNED AND SEALED
DOCUMENTS PREPARED BY THE ARCHITECTS
AND/OR THEIR CONSULTANTS, AND ANY COPY OF
THE DOCUMENTS TRANSMITTED BY EMAIL, FAX,
ELECTRONICALLY OR OTHERWISE, THE ORIGINAL
SIGNED AND SEALED DOCUMENTS SHALL GOVERN.

PROJECT # 2019-179
DATE: 28 AUGUST 2020


REVISIONS

PLAN REVIEW 11.03.2020
PLAN REVIEW 03.19.2021

MCKINNEY LANE APARTMENTS PHASE II
RUSSELL DRIVE & MCKINNEY LANE
LEBANON, OREGON

B

E3.01

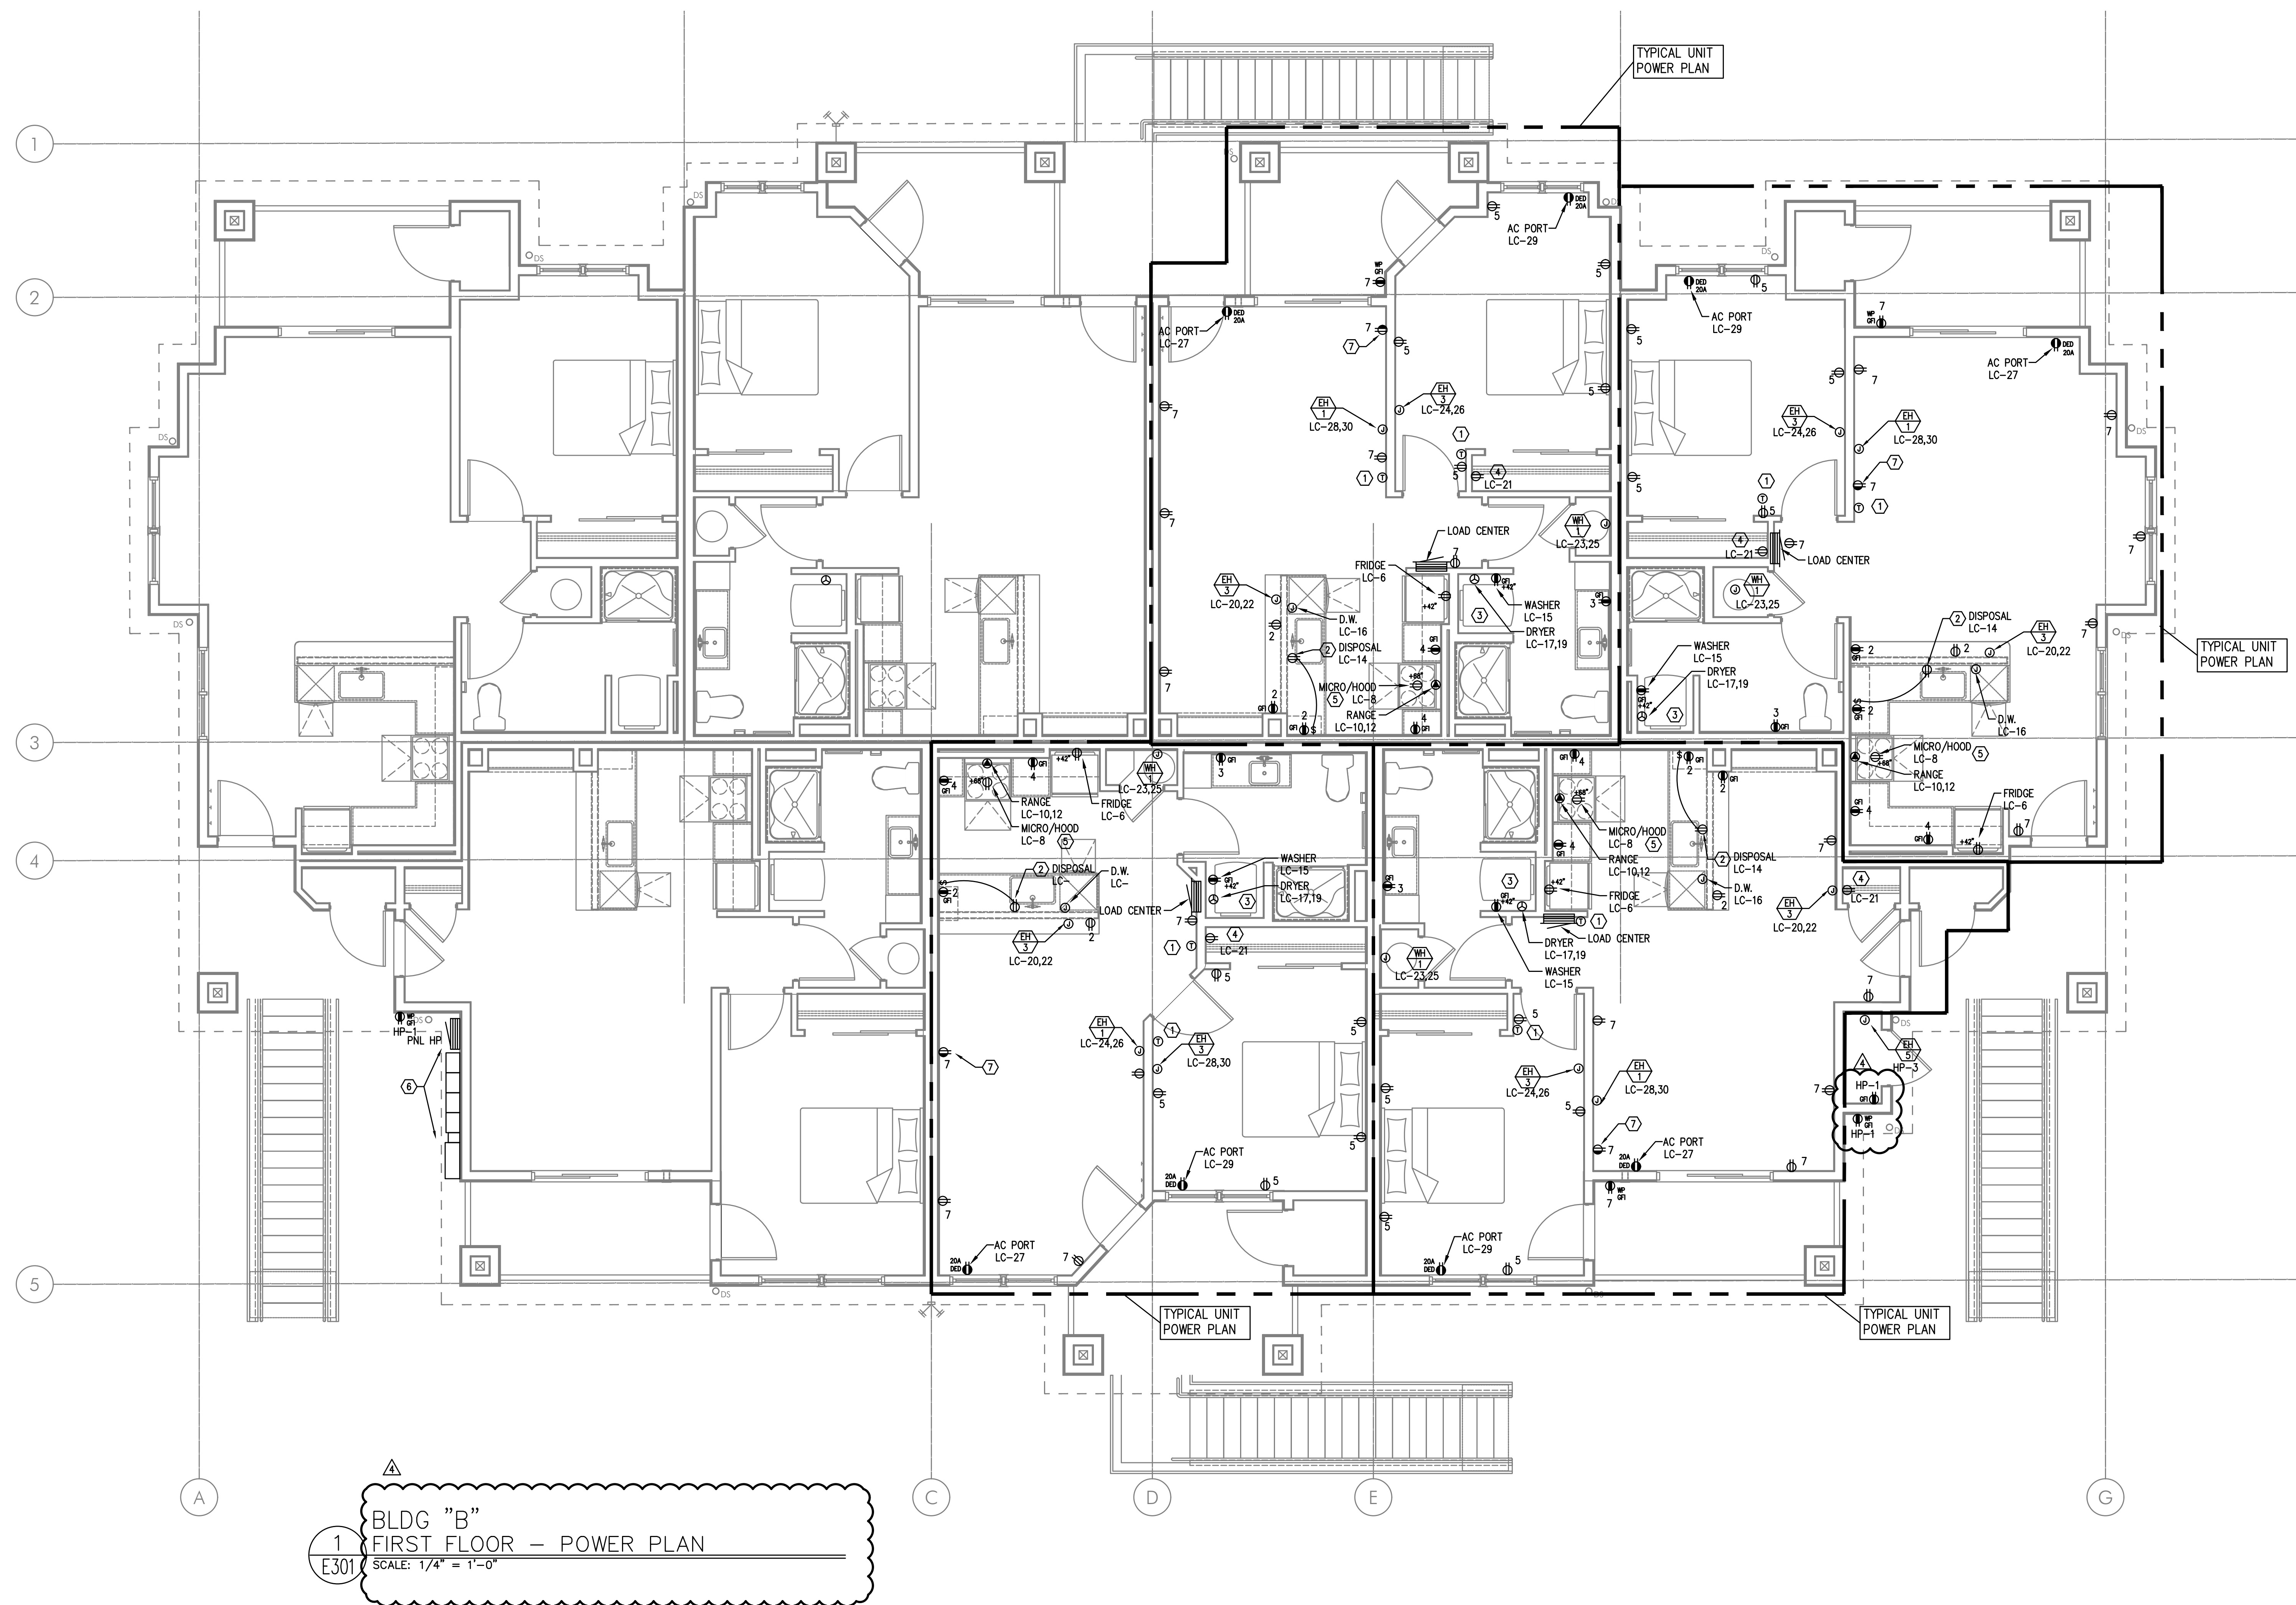

BLDG "B"
FIRST FLOOR - POWER PLAN
SCALE: 1/4" = 1'-0"


GENERAL POWER NOTES:

- ALL PLANS ARE CONSIDERED DIAGRAMMATICAL. THEREFORE ALL EQUIPMENT SIZES AND DEVICE LOCATIONS ARE APPROXIMATE AND SUBJECT TO FIELD CONDITIONS AND PRODUCT APPROVAL.
- NOT USED.
- ELECTRICAL CONTRACTOR SHALL PROVIDE INSTALLATION AND FINAL CONNECTION OF THERMOSTATS. CONSULT MECHANICAL CONTRACTOR FOR EXACT REQUIREMENTS PRIOR TO ROUGH IN.
- REFER TO INTERIOR DECORATOR AND/OR ARCHITECTURAL DRAWINGS FOR DIMENSIONED LOCATION(S) AND ELEVATIONS OF FIXTURES & DEVICES. OTHER DEVICES SHOWN ON THE ELECTRICAL PLANS AND NOT INDICATED ON THE DECORATOR'S OR ARCHITECT'S DRAWINGS, SHALL BE INSTALLED AT STANDARD MOUNTING HEIGHT AS INDICATED THE SYMBOL LIST.
- BUILDING ELECTRICAL EQUIPMENT SHOWN IS APPROXIMATE, BASED ON INDUSTRY STANDARD PRODUCTS. CONTRACTOR SHALL VERIFY ANY SUBMITTED EQUIPMENT WILL FIT WITHIN THE SPACE PROVIDED, PRIOR TO PRODUCT SUBMITTAL REVIEW.
- ELECTRICAL CONTRACTOR SHALL COORDINATE WITH THE LOW VOLTAGE ("T" SERIES) PLANS, INCLUDING FIRE ALARM AND SYSTEMS INSTALLER, AND PROVIDE ROUGH IN AS NEEDED.

KEYED POWER NOTES:

- PROVIDE WIRE CONNECTION FOR THERMOSTAT(S) PROVIDED BY MECHANICAL INSTALLER. COORDINATE WITH MECHANICAL INSTALLER FOR EXACT LOCATION AND POWER REQUIREMENTS PRIOR TO ROUGH IN. REFER TO ARCHITECTURAL INTERIOR ELEVATIONS FOR DIMENSIONED LOCATIONS OF THERMOSTATS.
- PROVIDE ONE 20A, 120V, 1P GFCI DUPLEX RECEPTACLE UNDER KITCHEN SINK FOR DISPOSAL POWER CONNECTION.
- REFER TO DETAIL 1/E1.13 FOR TYPICAL LAUNDRY ALCOVE RECEPTACLE LOCATIONS. COORDINATE INSTALLATION WITH MECHANICAL & PLUMBING CONTRACTOR.
- PROVIDE ONE 15A RECEPTACLE CIRCUIT FROM TENANT LOAD CENTER FOR TELECOM SMART PANEL. COORDINATE WORK WITH SERVICE PROVIDER FOR EXACT LOCATION AND FINAL CONNECTION.
- CONTRACTOR TO VERIFY POWER CONNECTION TYPE FOR THE HOOD/MICROWAVE PRIOR TO ROUGH IN. PROVIDE ONE DEDICATED 20A, 1P DUPLEX RECEPTACLE LOCATED INSIDE THE CABINET OVER THE RANGE FOR APPLIANCES SUPPLIED WITH CORD & PLUG SET. HOOD/MICROWAVES THAT ARE TO BE HARDWIRED, SHALL BE PROVIDED WITH THE DEDICATED CIRCUIT GOING TO A J-BOX WHICH IS TO BE MOUNTED DIRECTLY BEHIND THE APPLIANCE.
- METER LOCATION PER UTILITY PROVIDER'S APPROVAL (PENDING). REFER TO ONE-LINE DIAGRAM ON SHEET E1.11. PROVIDE NEMA 3R LOCKING CABINET FOR HOUSE PANEL "HP". REFER TO SHEET E1.01 FOR METER & PANEL LOCATION(S) AT EACH BUILDING.
- 15A SWITCHED SPLIT DUPLEX RECEPTACLE. REFER TO LIGHTING PLANS (E2 SERIES SHEETS) FOR SWITCH LOCATION.



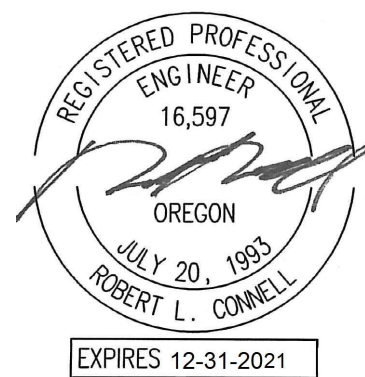


IN THE EVENT CONFLICTS ARE DISCOVERED BETWEEN THE ORIGINAL SIGNED AND SEALED DOCUMENTS PREPARED BY THE ARCHITECTS AND/OR THEIR CONSULTANTS, AND ANY COPY OF THE DOCUMENTS TRANSMITTED BY ELECTRONIC, ELECTRONICALLY OR OTHERWISE, THE ORIGINAL SIGNED AND SEALED DOCUMENTS SHALL GOVERN.

PROJECT # 2019-179
DATE: 28 AUGUST 2020

REVISIONS

△ PLAN REVIEW 11.03.2020
△ PLAN REVIEW 03.19.2021

MCKINNEY LANE APARTMENTS PHASE II
RUSSELL DRIVE & MCKINNEY LANE
LEBANON, OREGON 97331

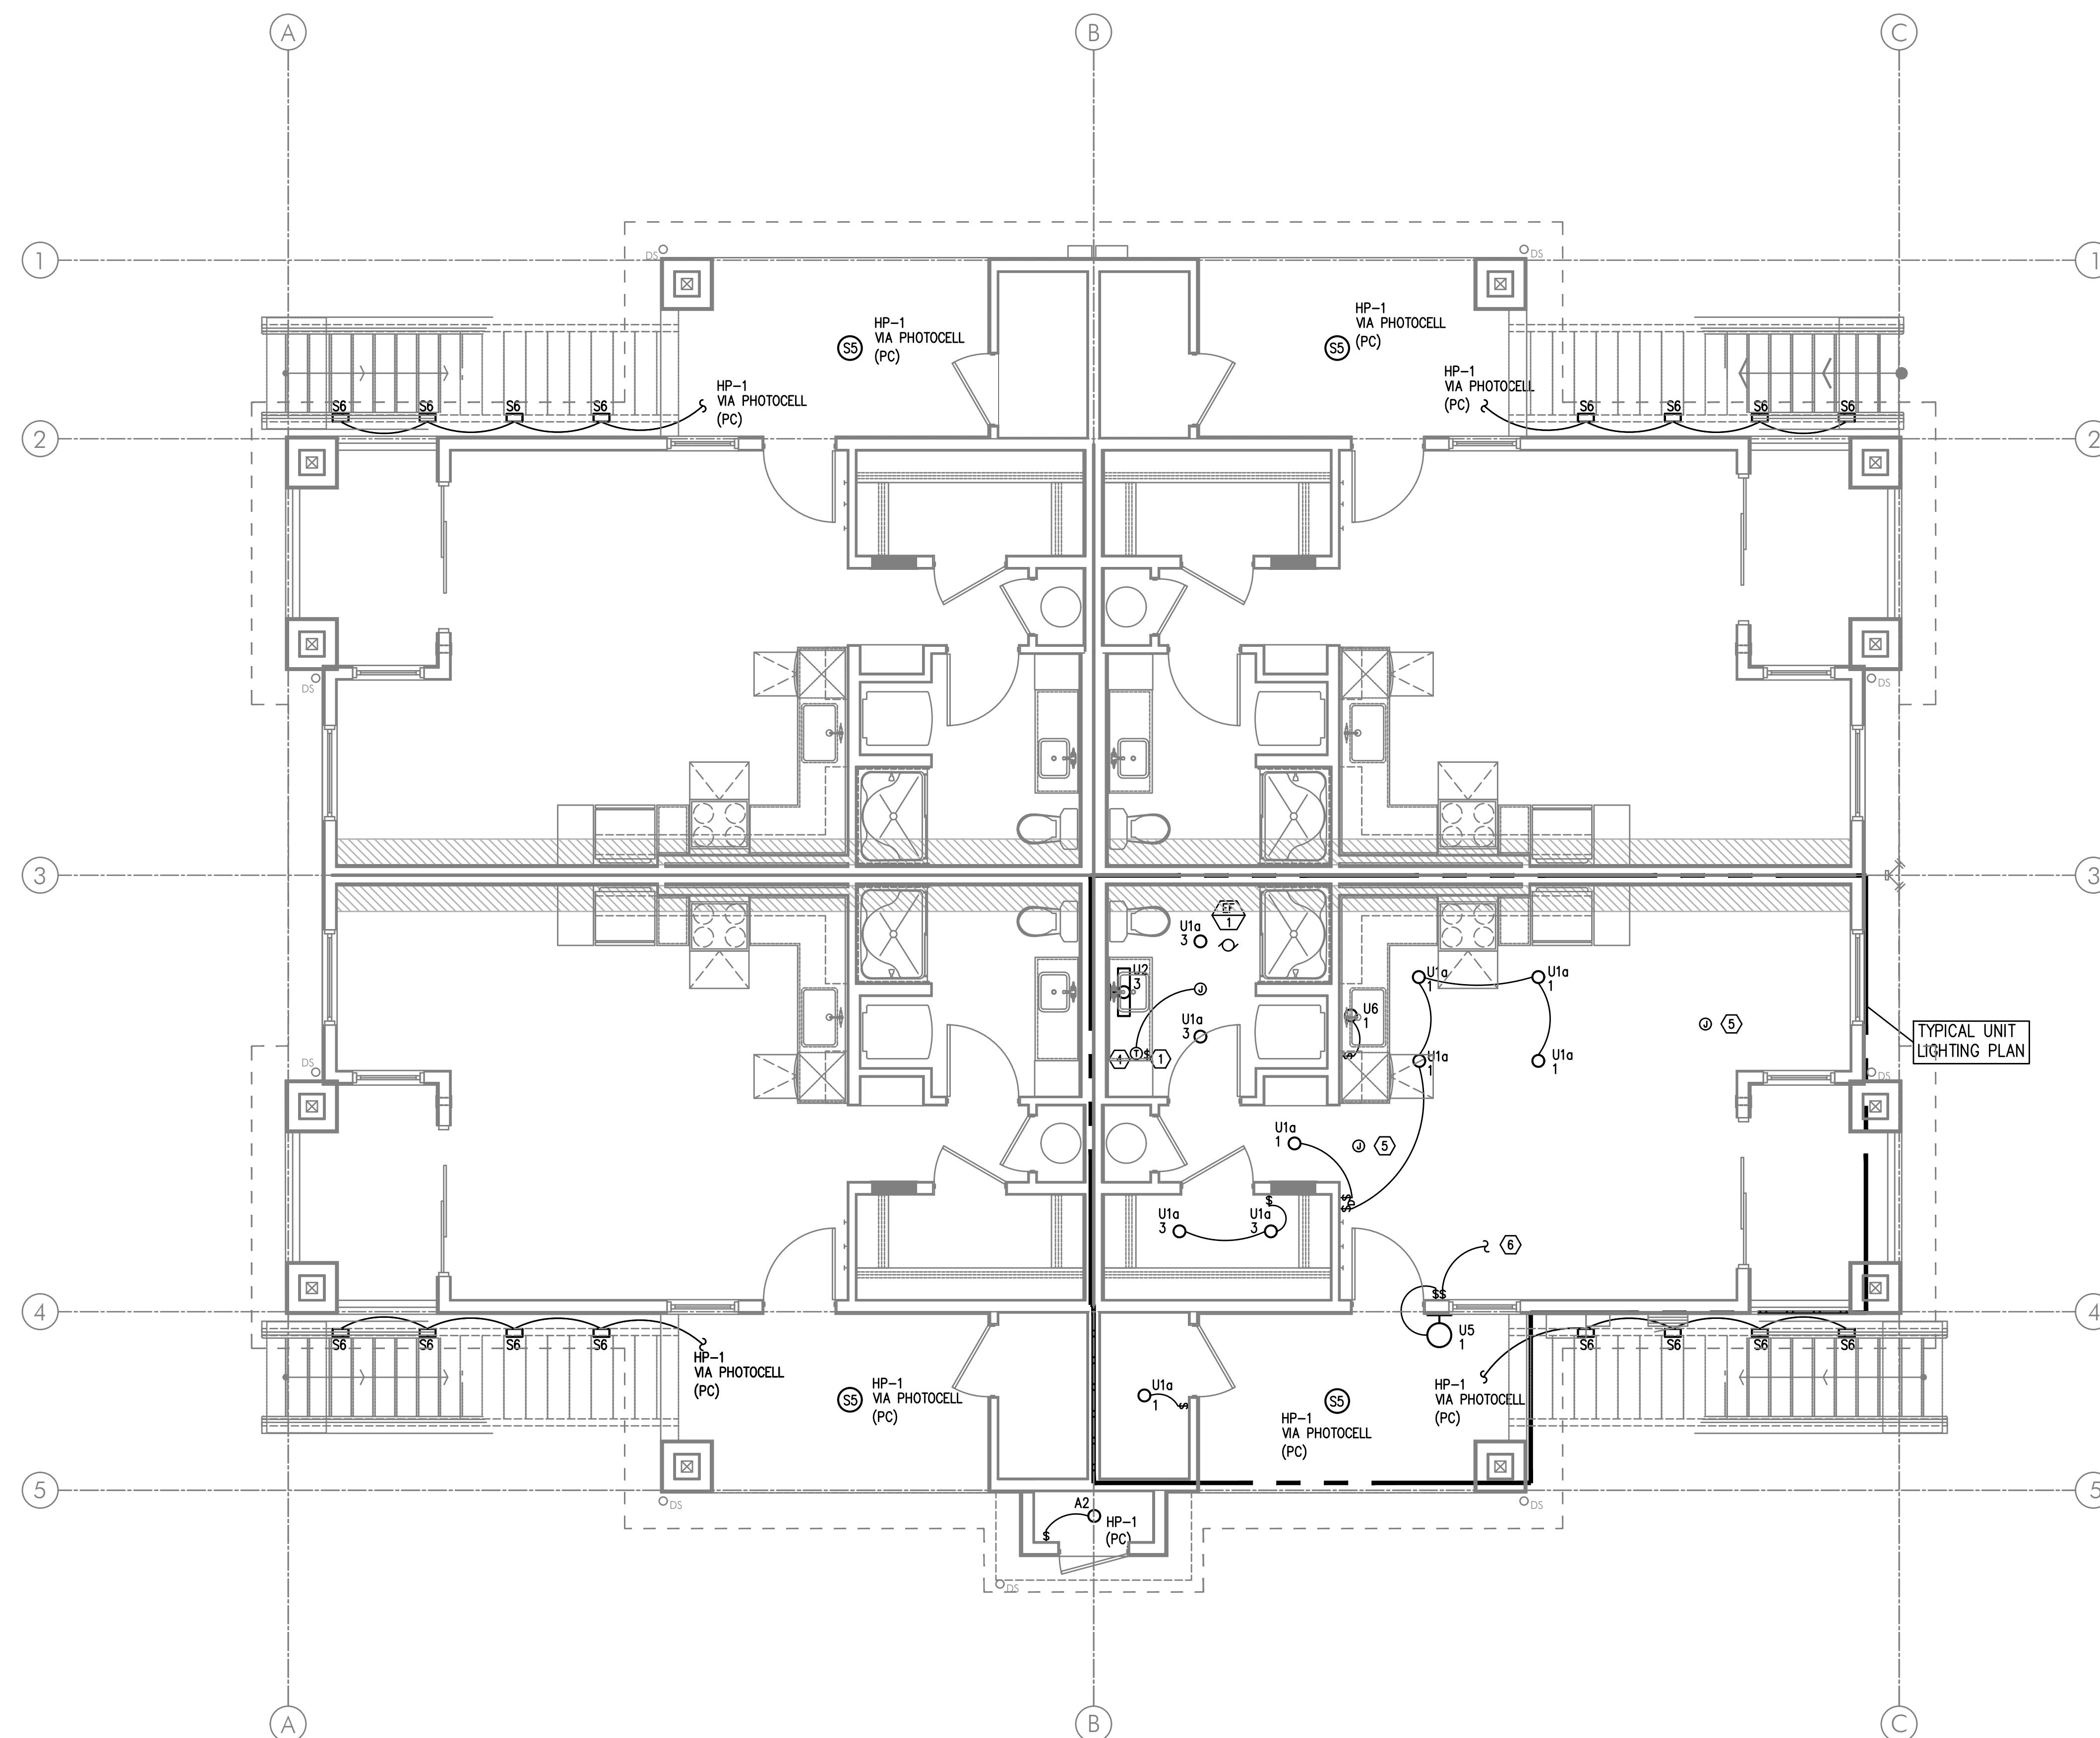


△
1
E2.01
BLDG "C"
FIRST FLOOR - LIGHTING PLAN
SCALE: 1/4" = 1'-0"

GENERAL LIGHTING NOTES:

- ELECTRICAL DRAWINGS ARE DIAGRAMMATICAL AND MAY NOT ACCURATELY REFLECT ACTUAL CONSTRUCTION CONDITIONS. THE ELECTRICAL CONTRACTOR SHALL BE RESPONSIBLE FOR COORDINATING THE INSTALLATION OF ALL ELECTRICAL EQUIPMENT, WITH ALL TRADES PRIOR TO AND DURING CONSTRUCTION.
- ALL DISCREPANCIES SHALL BE BROUGHT TO THE ATTENTION OF THE ARCHITECT IMMEDIATELY UPON DISCOVERY.
- REFER TO SHEET E1.21 FOR LIGHT FIXTURE SCHEDULES.
- THE ELECTRICAL CONTRACTOR SHALL REFER TO THE ARCHITECTURAL AND/OR INTERIORS PLAN SETS FOR DIMENSIONED LOCATIONS, MOUNTING HEIGHTS AND FINISHES OF DEVICES AND FIXTURES.
- REFER TO AVAILABLE ARCHITECTURAL AND/OR INTERIOR DESIGN DOCUMENTS & DRAWINGS FOR ADDITIONAL INFORMATION.
- EXTERIOR LIGHTING TO BE CONSTANT "ON" AND PROVIDED WITH PHOTOCELL (EITHER INTEGRAL OR REMOTE) FOR DUSK-TIL-DAWN OPERATION.
- ALL EXTERIOR BUILDING LIGHTS ON HOUSE POWER SHALL BE CONSIDERED EGRESS LIGHTING. FIXTURES ARE TO BE EQUIPPED WITH BATTERY BACK-UP (EITHER INTEGRAL OR REMOTE).
- REFER TO SHEET E1.14 FOR TYPICAL UNIT LOAD CENTER DIRECTORIES.
- ALL LIGHT SWITCHES SHALL BE ROCKER STYLE, SUCH AS LEVITON DECORA, OR APPROVED EQUAL.
- REFER TO ARCHITECTURAL REFLECTED CEILING PLANS FOR EXACT FIXTURE LOCATIONS (DIMENSIONS). CONSULT INTERIOR DESIGNER FOR MOUNTING HEIGHTS NOT SPECIFIED.

KEYED LIGHTING NOTES:

- REFER TO TYPICAL BATHROOM SWITCHING DETAILS ON SHEET E1.21.
- PROVIDE CEILING FAN CONTROL SWITCH(ES) AS DIRECTED BY MANUFACTURER.
- PROVIDE BLOCKING AT CEILING TO SUPPORT 35LB., MINIMUM, FOR CEILING FAN INSTALLATION.
- PROVIDE WIRE CONNECTION FOR THERMOSTAT(S) PROVIDED BY MECHANICAL INSTALLER. COORDINATE WITH MECHANICAL INSTALLER FOR EXACT LOCATION AND POWER REQUIREMENTS PRIOR TO ROUGH IN. CEILING HEATER (BY MECHANICAL) TO BE TIED INTO BATHROOM POWER CIRCUIT. REFER TO ARCHITECTURAL INTERIOR ELEVATIONS FOR DIMENSIONED LOCATIONS OF BATHROOM THERMOSTATS.
- COORDINATE LOCATION OF POWER CONNECTION FOR FIRE ALARM DEVICES WITH THE SYSTEM CONTRACTOR/INSTALLER.
- TO SWITCHED RECEPTACLE. REFER TO POWER PLANS (E3 SERIES SHEETS) FOR OUTLET LOCATION.

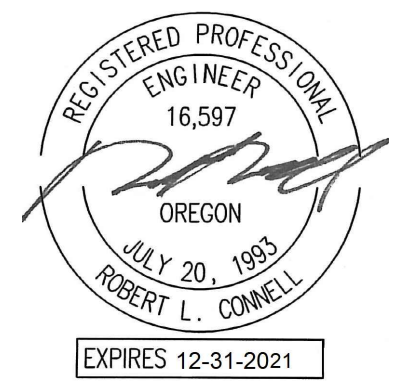

IN THE EVENT CONFLICTS ARE DISCOVERED BETWEEN THE ORIGINAL SIGNED AND SEALED DOCUMENTS PREPARED BY THE ARCHITECT AND/OR THEIR CONSULTANTS, AND ANY COPY OF THE DOCUMENTS TRANSMITTED BY MAIL, FAX, ELECTRONICALLY OR OTHERWISE, THE ORIGINAL SIGNED AND SEALED DOCUMENTS SHALL GOVERN.

PROJECT # 2019-179
DATE: 28 AUGUST 2020


REVISIONS

△ PLAN REVIEW 11.03.2020
△ PLAN REVIEW 03.19.2021

MCKINNEY LANE APARTMENTS PHASE II
RUSSELL DRIVE & MCKINNEY LANE
LEBANON, OREGON 97355

△
C
E2.02

M
E
A
Consulting Engineers
2007 S.E. Ash St.
Portland, OR 97214
PH: (503) 234-0548
FAX: (503) 234-0677
INC. WWW.MEIA-ENG.COM
CONTACT: DENISE TAYLOR

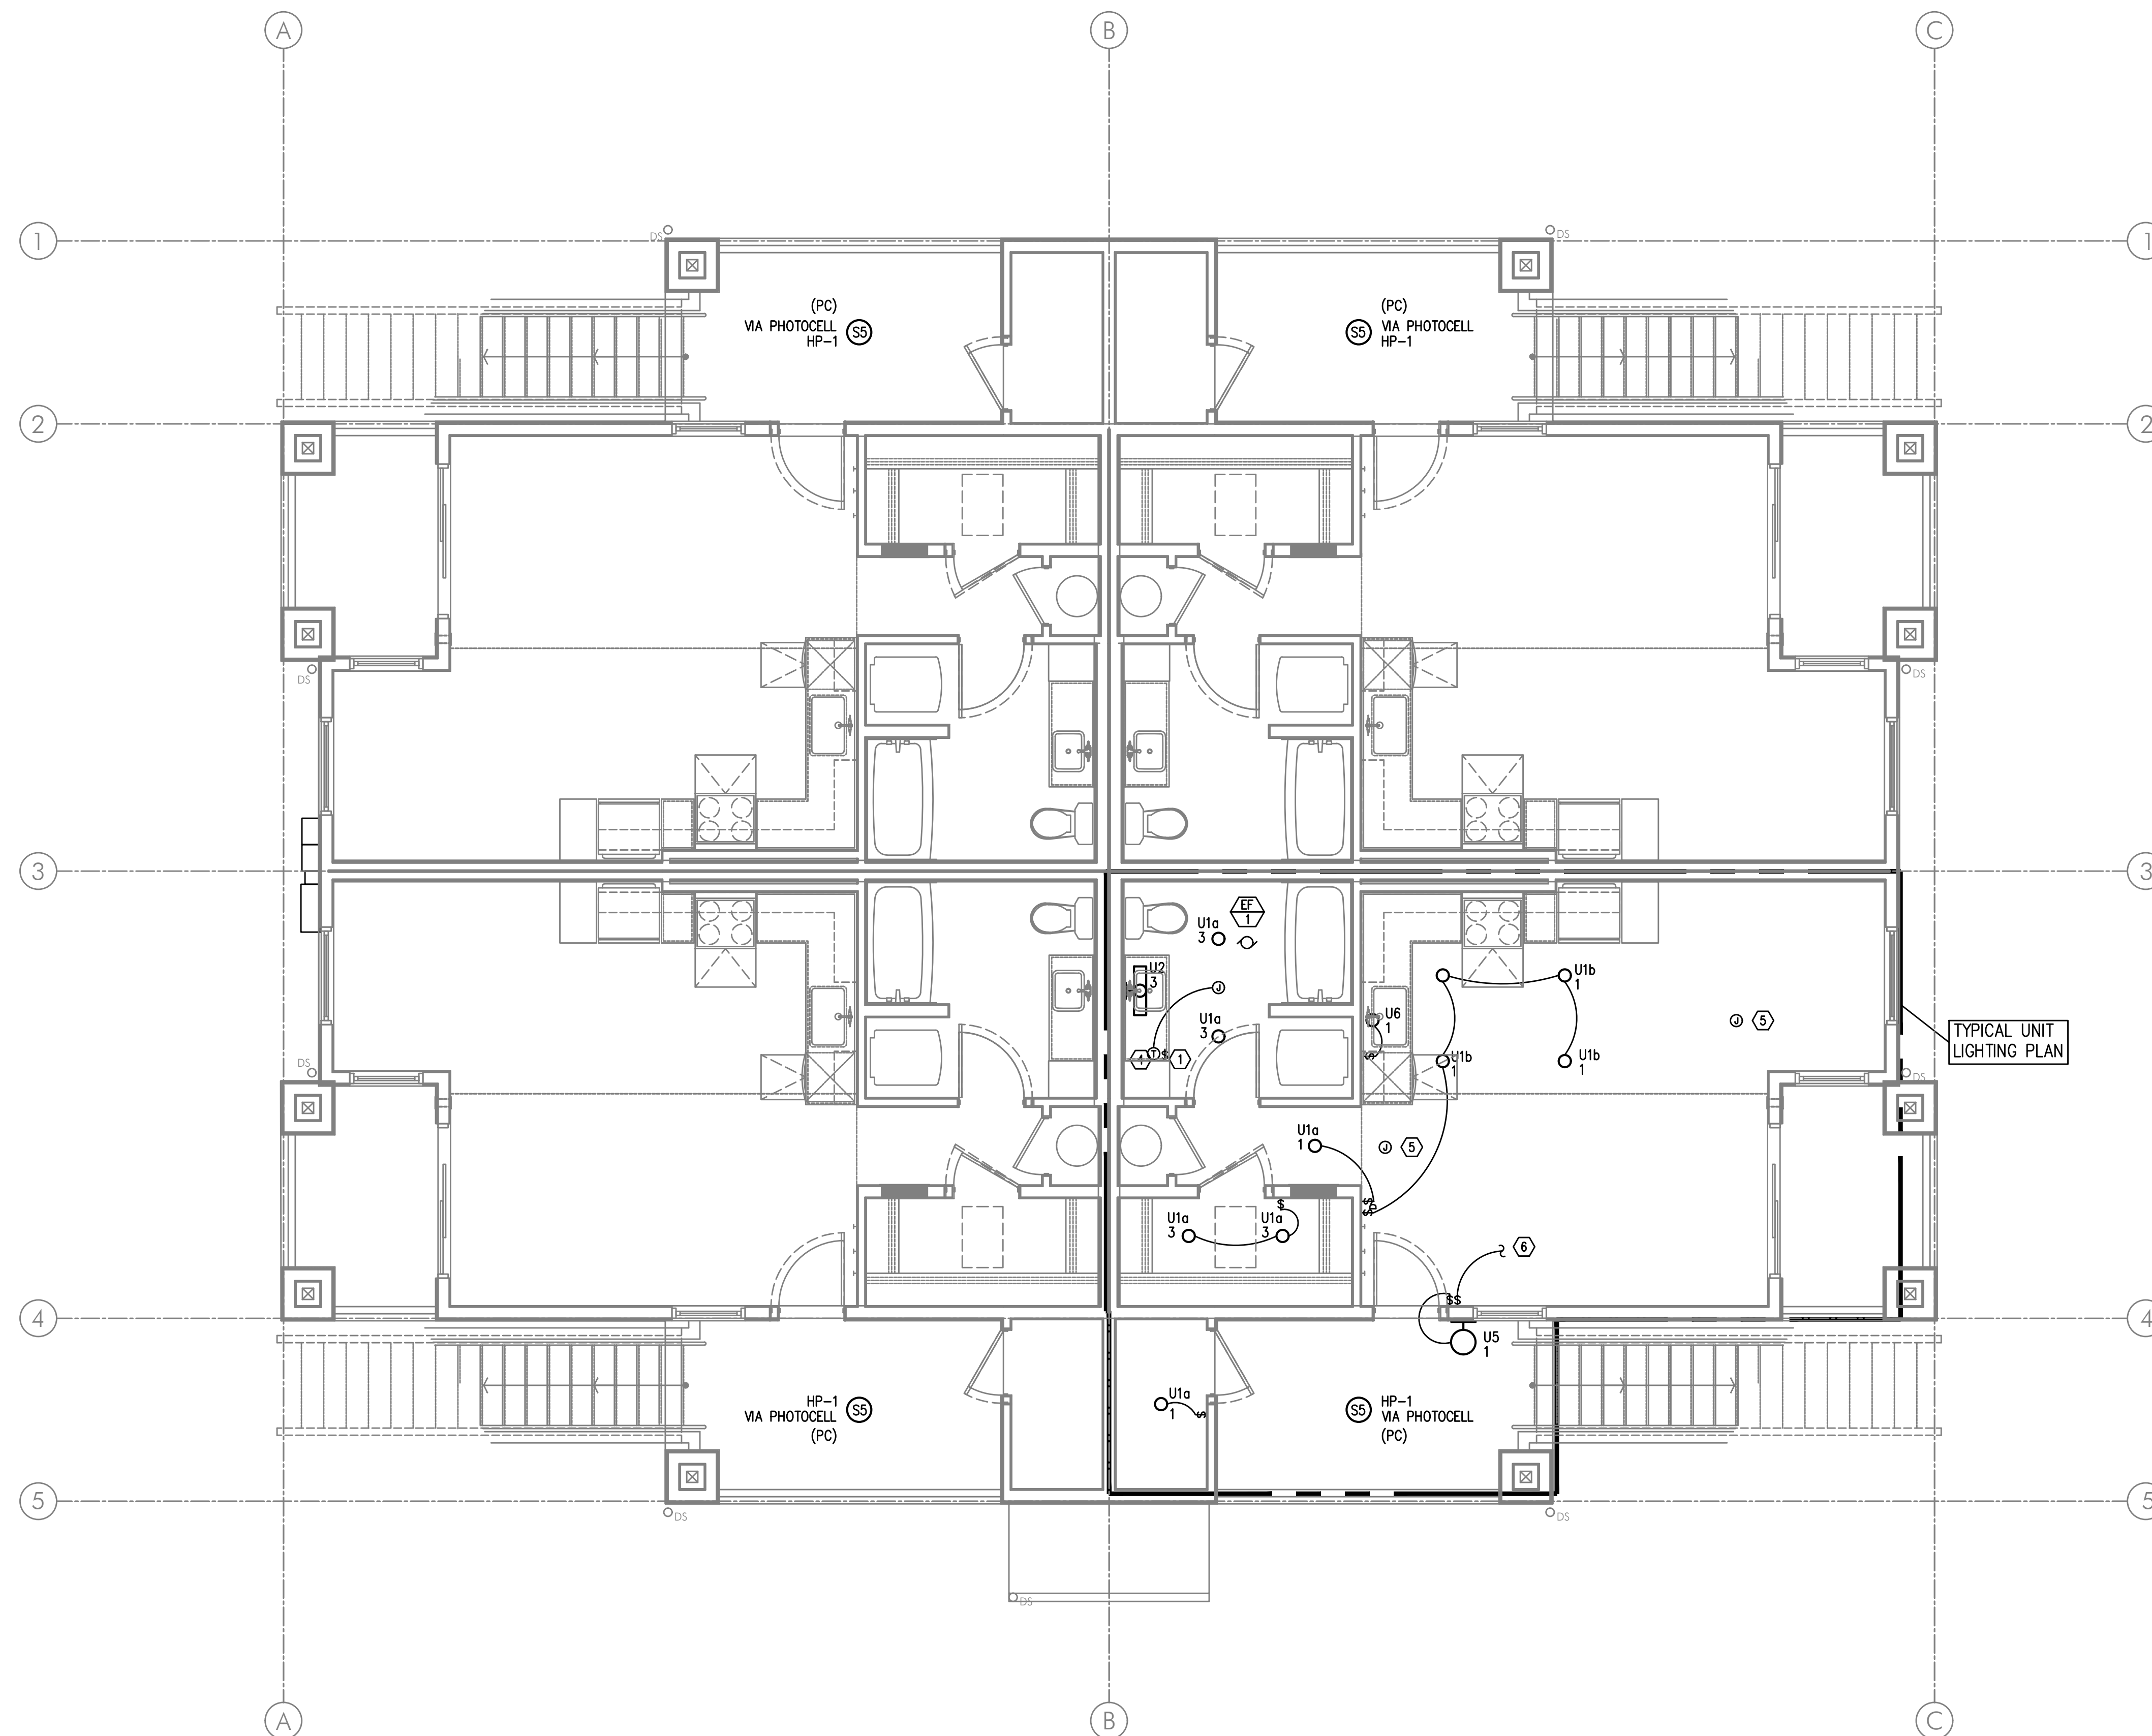


△
1
E2.02
BLDG 'C'
SECOND FLOOR - LIGHTING PLAN
SCALE: 1/4" = 1'-0"

GENERAL LIGHTING NOTES:

- ELECTRICAL DRAWINGS ARE DIAGRAMMATICAL AND MAY NOT ACCURATELY REFLECT ACTUAL CONSTRUCTION CONDITIONS. THE ELECTRICAL CONTRACTOR SHALL BE RESPONSIBLE FOR COORDINATING THE INSTALLATION OF ALL ELECTRICAL EQUIPMENT, WITH ALL TRADES PRIOR TO AND DURING CONSTRUCTION.
- ALL DISCREPANCIES SHALL BE BROUGHT TO THE ATTENTION OF THE ARCHITECT IMMEDIATELY UPON DISCOVERY.
- REFER TO SHEET E1.21 FOR LIGHT FIXTURE SCHEDULES.
- THE ELECTRICAL CONTRACTOR SHALL REFER TO THE ARCHITECTURAL AND/OR INTERIORS PLAN SETS FOR DIMENSIONED LOCATIONS, MOUNTING HEIGHTS AND FINISHES OF DEVICES AND FIXTURES.
- REFER TO AVAILABLE ARCHITECTURAL AND/OR INTERIOR DESIGN DOCUMENTS & DRAWINGS FOR ADDITIONAL INFORMATION.
- EXTERIOR LIGHTING TO BE CONSTANT "ON" AND PROVIDED WITH PHOTOCELL, EITHER INTEGRAL OR REMOTE) FOR DUSK-TILL-DAWN OPERATION.
- ALL EXTERIOR BUILDING LIGHTS ON HOUSE POWER SHALL BE CONSIDERED EGRESS LIGHTING. FIXTURES ARE TO BE EQUIPPED WITH BATTERY BACK-UP (EITHER INTEGRAL OR REMOTE).
- REFER TO SHEET E1.14 FOR TYPICAL UNIT LOAD CENTER DIRECTORIES.
- ALL LIGHT SWITCHES SHALL BE ROCKER STYLE, SUCH AS LEVITON DECORA, OR APPROVED EQUAL.
- REFER TO ARCHITECTURAL REFLECTED CEILING PLANS FOR EXACT FIXTURE LOCATIONS (DIMENSIONS). CONSULT INTERIOR DESIGNER FOR MOUNTING HEIGHTS NOT SPECIFIED.

KEYED LIGHTING NOTES:

- REFER TO TYPICAL BATHROOM SWITCHING DETAILS ON SHEET E1.21.
- PROVIDE CEILING FAN CONTROL SWITCH(ES) AS DIRECTED BY MANUFACTURER.
- PROVIDE BLOCKING AT CEILING TO SUPPORT 35LB., MINIMUM, FOR CEILING FAN INSTALLATION.
- PROVIDE WIRE CONNECTION FOR THERMOSTAT(S) PROVIDED BY MECHANICAL INSTALLER. COORDINATE WITH MECHANICAL INSTALLER FOR EXACT LOCATION AND POWER REQUIREMENTS PRIOR TO ROUGH IN. CEILING HEATER (BY MECHANICAL) TO BE TIED INTO BATHROOM POWER CIRCUIT. REFER TO ARCHITECTURAL INTERIOR ELEVATIONS FOR DIMENSIONED LOCATIONS OF BATHROOM THERMOSTATS.
- COORDINATE LOCATION OF POWER CONNECTION FOR FIRE ALARM DEVICES WITH THE SYSTEM CONTRACTOR/INSTALLER.
- TO SWITCHED RECEPTACLE. REFER TO POWER PLANS (E3 SERIES SHEETS) FOR OUTLET LOCATION.

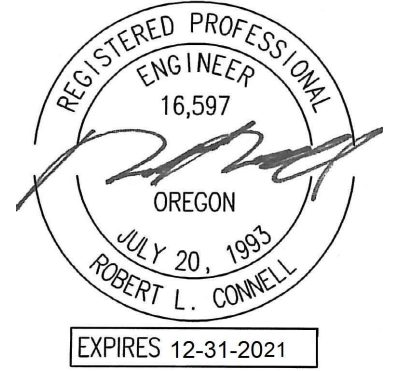


IN THE EVENT CONFLICTS ARE DISCOVERED BETWEEN THE ORIGINAL SIGNED AND SEALED DOCUMENTS PREPARED BY THE ARCHITECTS AND/OR THEIR CONSULTANTS, AND ANY COPY OF THE DOCUMENTS TRANSMITTED BY EMAIL, ELECTRONICALLY OR OTHERWISE, THE ORIGINAL SIGNED AND SEALED DOCUMENTS SHALL GOVERN.

PROJECT # 2019-179
DATE: 28 AUGUST 2020

REVISIONS

△ PLAN REVIEW 11.03.2020
△ PLAN REVIEW 03.19.2021

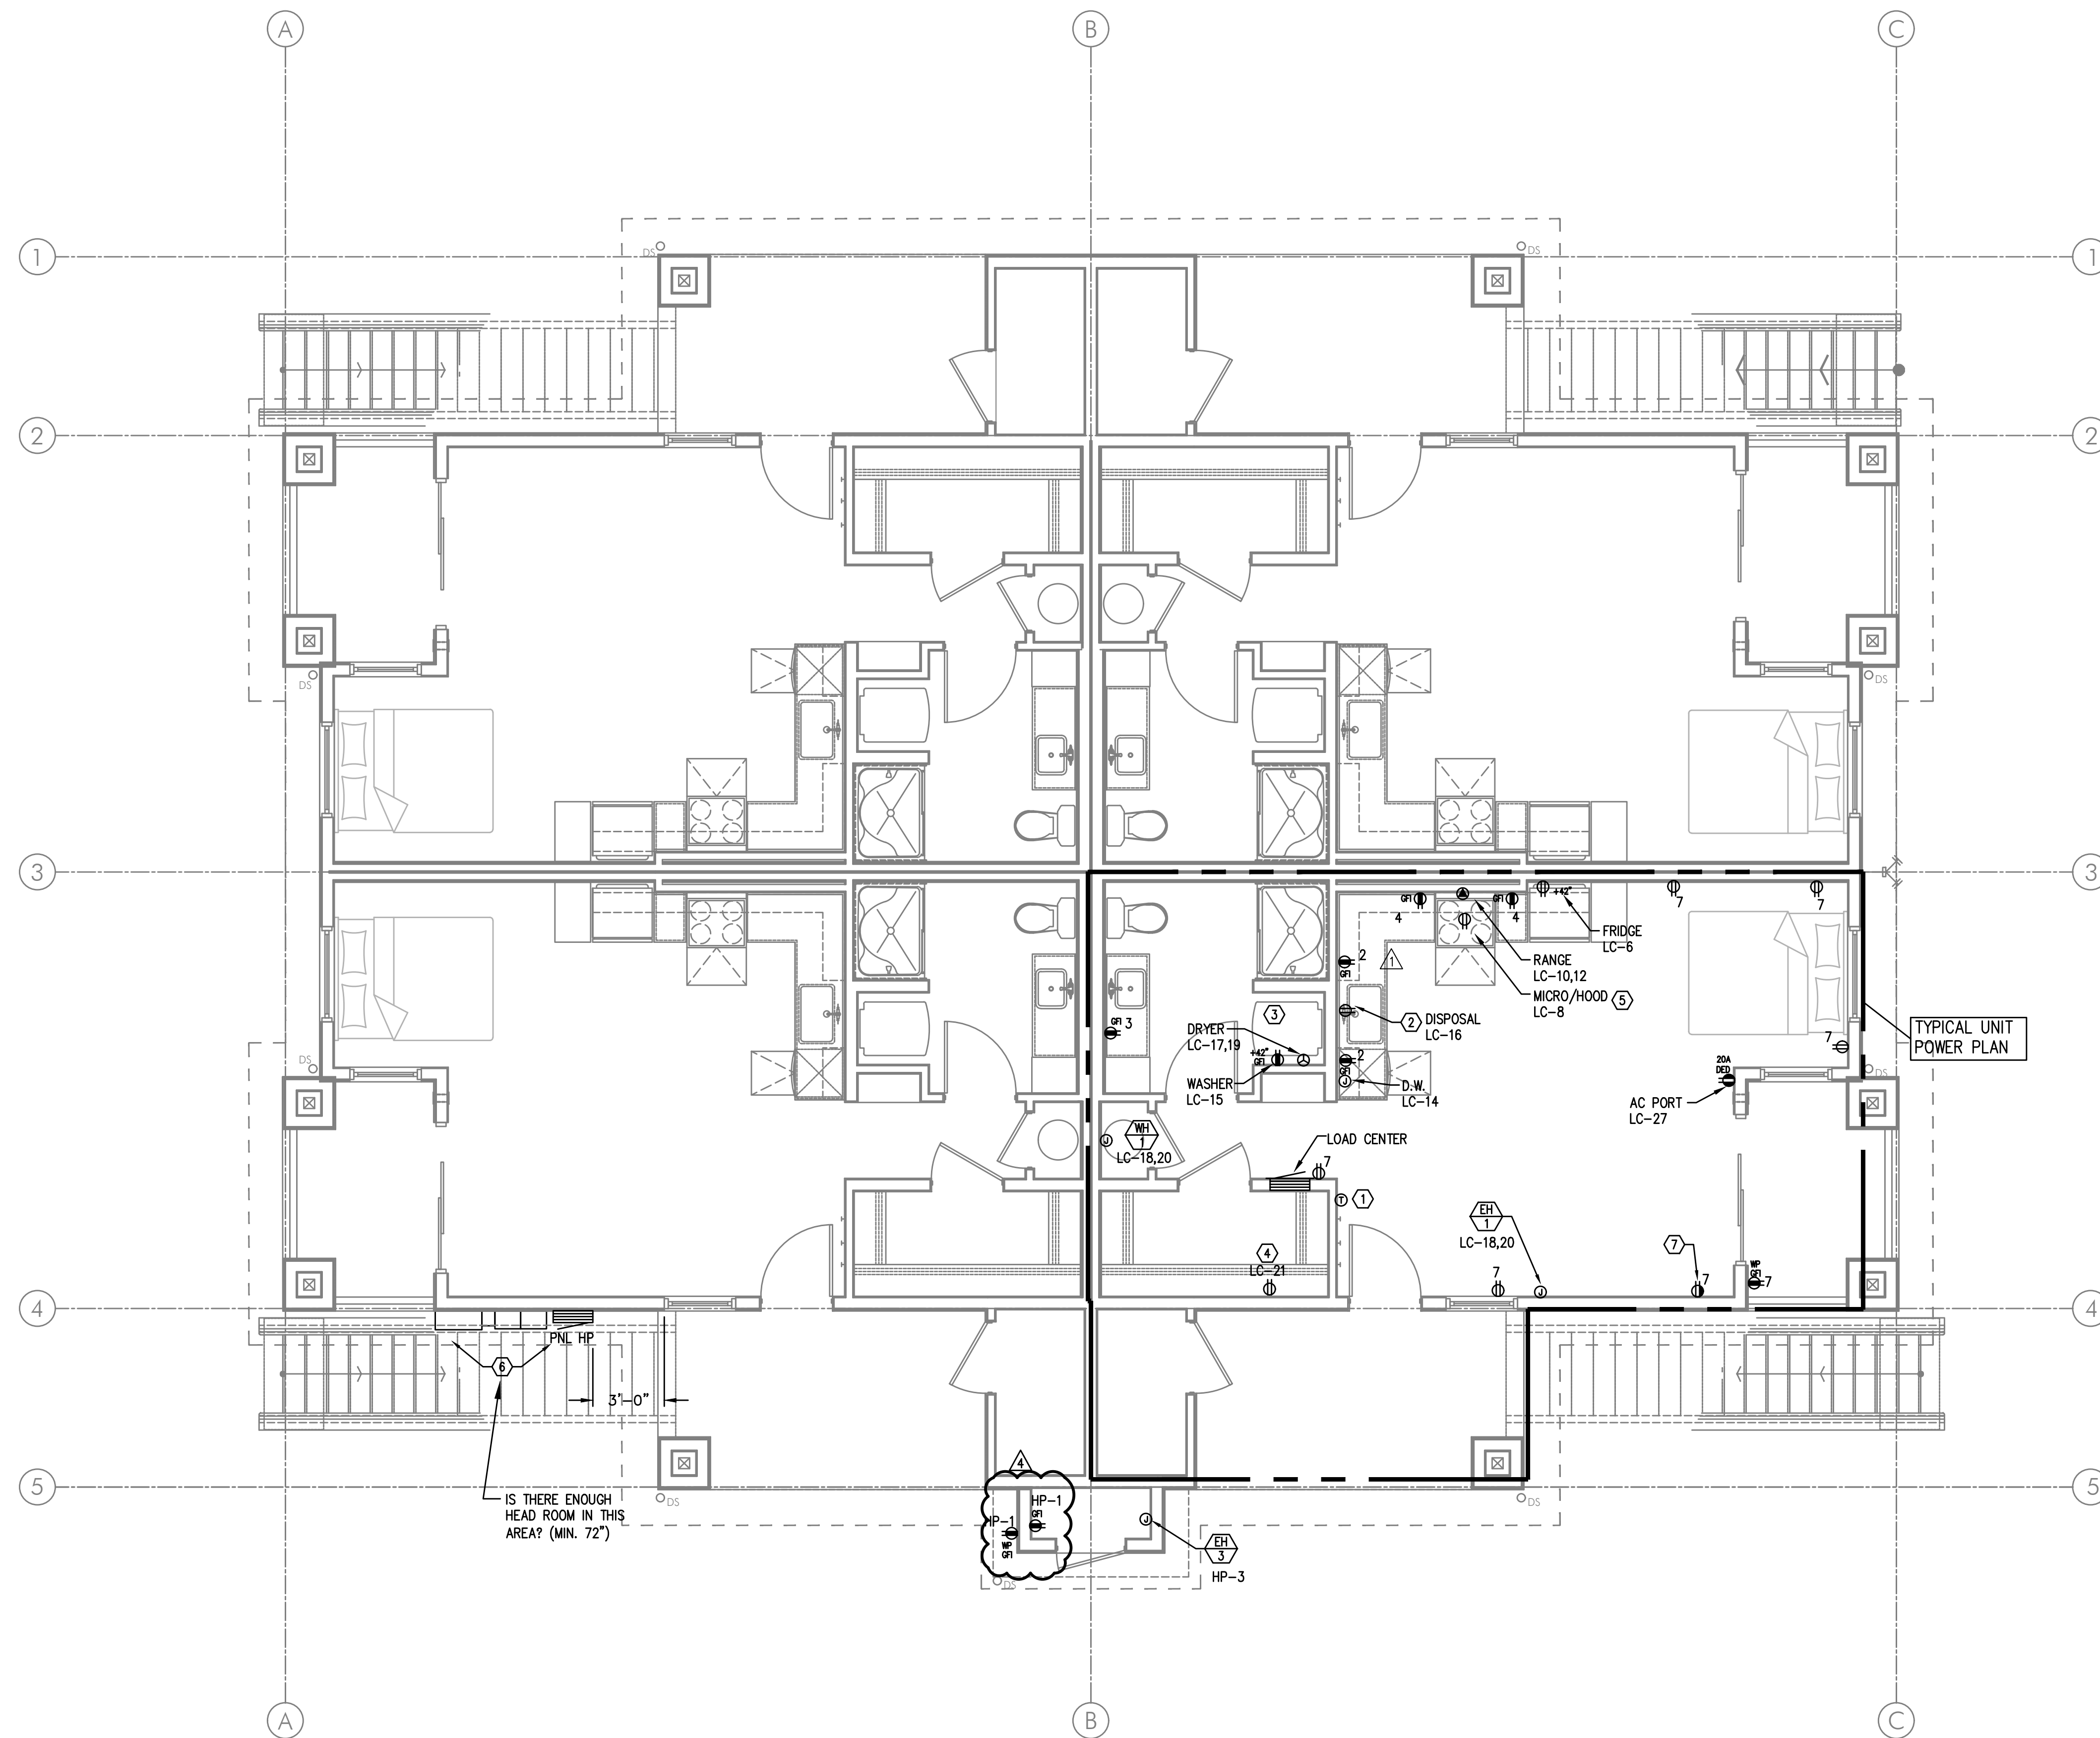

△
1
E301
BLDG "C"
FIRST FLOOR - POWER PLAN
SCALE: 1/4" = 1'-0"

GENERAL POWER NOTES:

- A. ALL PLANS ARE CONSIDERED DIAGRAMMATICAL. THEREFORE ALL EQUIPMENT SIZES AND DEVICE LOCATIONS ARE APPROXIMATE AND SUBJECT TO FIELD CONDITIONS AND PRODUCT APPROVAL.
- B. NOT USED.
- C. ELECTRICAL CONTRACTOR SHALL PROVIDE INSTALLATION AND FINAL CONNECTION OF THERMOSTATS. CONSULT MECHANICAL CONTRACTOR FOR EXACT REQUIREMENTS PRIOR TO ROUGH IN.
- D. REFER TO INTERIOR DECORATOR AND/OR ARCHITECTURAL DRAWINGS FOR DIMENSIONED LOCATION(S) AND ELEVATIONS OF FIXTURES & DEVICES. OTHER DEVICES SHOWN ON THE ELECTRICAL PLANS AND NOT INDICATED ON THE DECORATOR'S OR ARCHITECT'S DRAWINGS, SHALL BE INSTALLED AT STANDARD MOUNTING HEIGHT AS INDICATED THE SYMBOL LIST.
- E. BUILDING ELECTRICAL EQUIPMENT SHOWN IS APPROXIMATE, BASED ON INDUSTRY STANDARD PRODUCTS. CONTRACTOR SHALL VERIFY ANY SUBMITTED EQUIPMENT WILL FIT WITHIN THE SPACE PROVIDED, PRIOR TO PRODUCT SUBMITTAL REVIEW.
- F. ELECTRICAL CONTRACTOR SHALL COORDINATE WITH THE LOW VOLTAGE ("T" SERIES) PLANS, INCLUDING FIRE ALARM AND SYSTEMS INSTALLER, AND PROVIDE ROUGH IN AS NEEDED.

KEYED POWER NOTES:

1. PROVIDE WIRE CONNECTION FOR THERMOSTAT(S) PROVIDED BY MECHANICAL INSTALLER. COORDINATE WITH MECHANICAL INSTALLER FOR EXACT LOCATION AND POWER REQUIREMENTS PRIOR TO ROUGH IN. REFER TO ARCHITECTURAL INTERIOR ELEVATIONS FOR DIMENSIONED LOCATIONS OF THERMOSTATS.
2. PROVIDE ONE 20A, 120V, 1P 60% DUPLEX RECEPTACLE UNDER KITCHEN SINK FOR DISPOSAL POWER CONNECTION.
3. REFER TO DETAIL 1/E1.13 FOR TYPICAL LAUNDRY ALCOVE RECEPTACLE LOCATIONS. COORDINATE INSTALLATION WITH MECHANICAL & PLUMBING CONTRACTOR.
4. PROVIDE ONE 15A, RECEPTACLE CIRCUIT FROM TENANT LOAD CENTER FOR TELECOM SMART PANEL. COORDINATE WORK WITH SERVICE PROVIDER FOR EXACT LOCATION AND FINAL CONNECTION.
5. CONTRACTOR TO VERIFY POWER CONNECTION TYPE FOR THE HOOD/MICROWAVE PRIOR TO ROUGH IN. PROVIDE ONE DEDICATED 20A, 1P DUPLEX RECEPTACLE LOCATED INSIDE THE CABINET OVER THE RANGE FOR APPLIANCES SUPPLIED WITH CORD & PLUG SET. HOOD/MICROWAVES THAT ARE TO BE HARDWIRED, SHALL BE PROVIDED WITH THE DEDICATED CIRCUIT GOING TO A J-BOX WHICH IS TO BE MOUNTED DIRECTLY BEHIND THE APPLIANCE.
6. METER LOCATION PER UTILITY PROVIDER'S APPROVAL (PENDING). REFER TO ONE-LINE DIAGRAM ON SHEET E1.11. PROVIDE NEMA 3R LOCKING CABINET FOR HOUSE PANEL 'HP'. REFER TO SHEET E1.01 FOR METER & PANEL LOCATION(S) AT EACH BUILDING.
7. 15A SWITCHED SPLIT DUPLEX RECEPTACLE. REFER TO LIGHTING PLANS (E2 SERIES SHEETS) FOR SWITCH LOCATION.




IN THE EVENT CONFLICTS ARE DISCOVERED BETWEEN THE ORIGINAL SIGNED AND SEALED DOCUMENTS PREPARED BY THE ARCHITECT AND/OR THEIR CONSULTANTS, AND ANY COPY OF THE DOCUMENTS TRANSMITTED BY ELECTRONIC, ELECTRONICALLY OR OTHERWISE, THE ORIGINAL SIGNED AND SEALED DOCUMENTS SHALL GOVERN.

PROJECT # 2019-179
DATE: 28 AUGUST 2020

REVISIONS

△ PLAN REVIEW 11.03.2020
△ PLAN REVIEW 03.19.2021

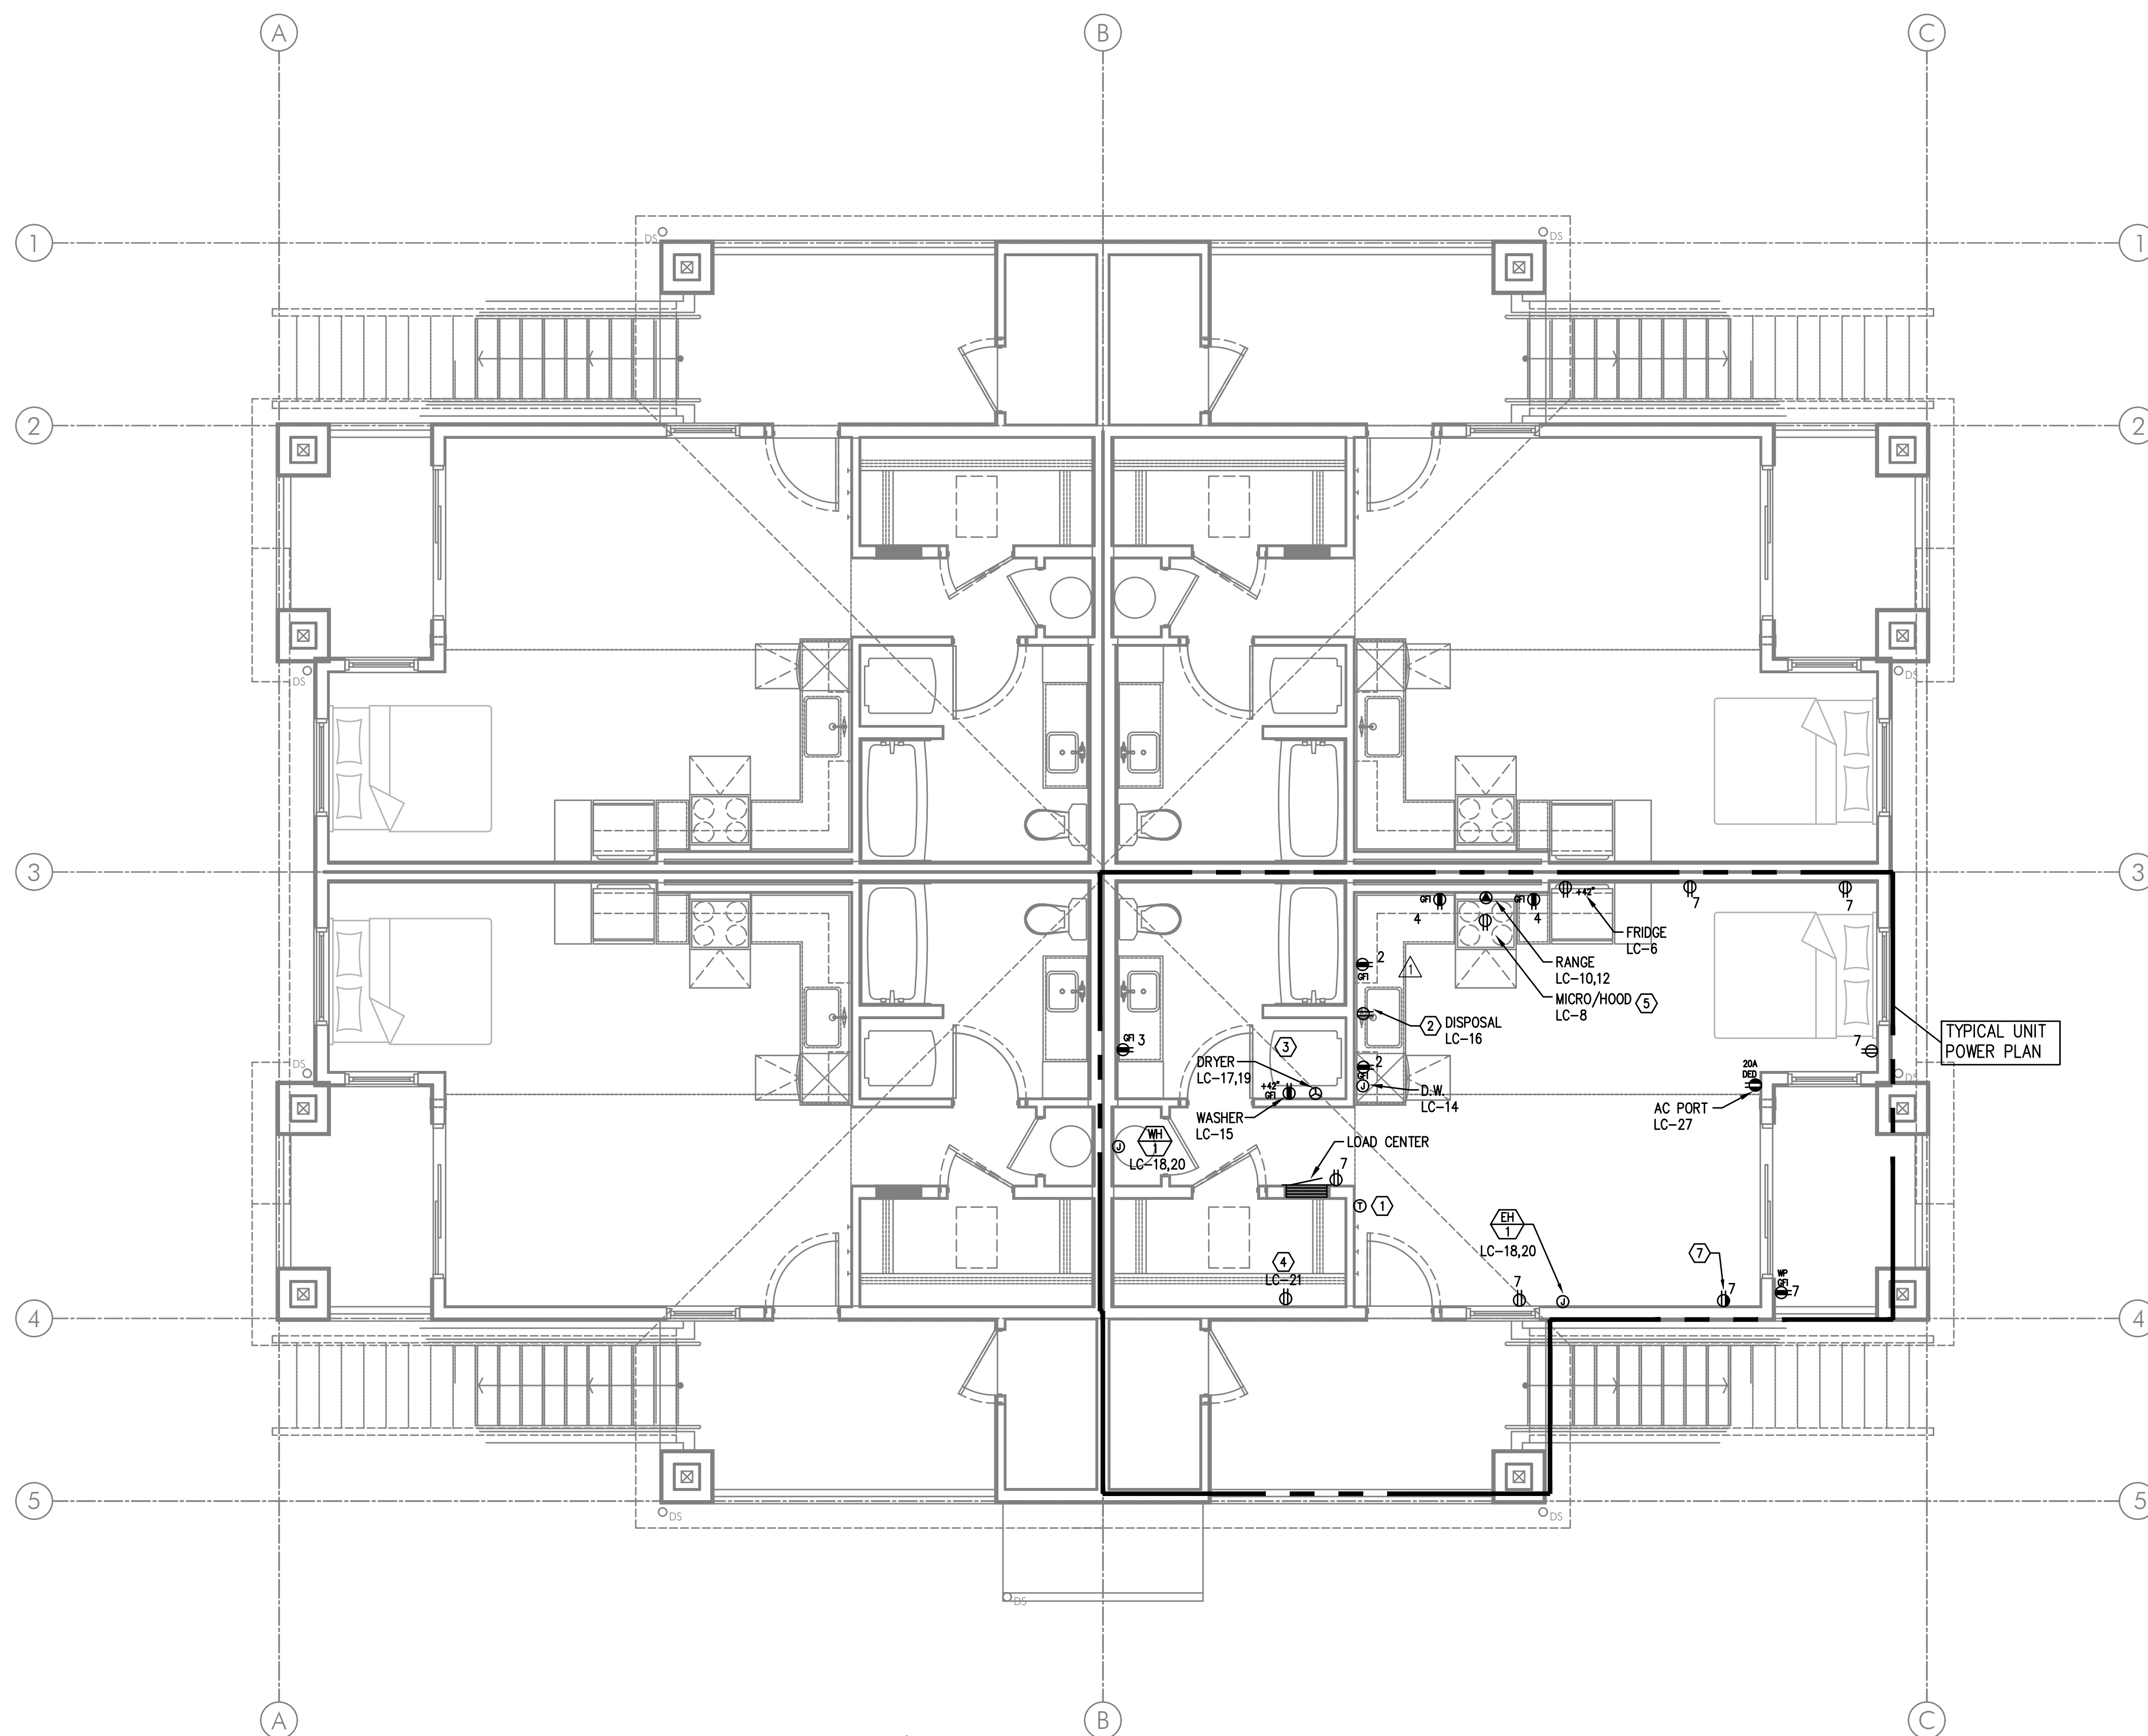


△
1
E302
BLDG "C"
SECOND FLOOR - POWER PLAN
SCALE: 1/4" = 1'-0"

GENERAL POWER NOTES:

- △ A. ALL PLANS ARE CONSIDERED DIAGRAMMATICAL. THEREFORE ALL EQUIPMENT SIZES AND DEVICE LOCATIONS ARE APPROXIMATE AND SUBJECT TO FIELD CONDITIONS AND PRODUCT APPROVAL.
- △ B. NOT USED.
- C. ELECTRICAL CONTRACTOR SHALL PROVIDE INSTALLATION AND FINAL CONNECTION OF THERMOSTATS. CONSULT MECHANICAL CONTRACTOR FOR EXACT REQUIREMENTS PRIOR TO ROUGH IN.
- D. REFER TO INTERIOR DECORATOR AND/OR ARCHITECTURAL DRAWINGS FOR DIMENSIONED LOCATION(S) AND ELEVATIONS OF FIXTURES & DEVICES. OTHER DEVICES SHOWN ON THE ELECTRICAL PLANS AND NOT INDICATED ON THE DECORATOR'S OR ARCHITECT'S DRAWINGS, SHALL BE INSTALLED AT STANDARD MOUNTING HEIGHT AS INDICATED THE SYMBOL LIST.
- E. BUILDING ELECTRICAL EQUIPMENT SHOWN IS APPROXIMATE, BASED ON INDUSTRY STANDARD PRODUCTS. CONTRACTOR SHALL VERIFY ANY SUBMITTED EQUIPMENT WILL FIT WITHIN THE SPACE PROVIDED, PRIOR TO PRODUCT SUBMITTAL REVIEW.
- F. ELECTRICAL CONTRACTOR SHALL COORDINATE WITH THE LOW VOLTAGE ("T" SERIES) PLANS, INCLUDING FIRE ALARM AND SYSTEMS INSTALLER, AND PROVIDE ROUGH IN AS NEEDED.

△ KEYED POWER NOTES:

- △ 1. PROVIDE WIRE CONNECTION FOR THERMOSTAT(S) PROVIDED BY MECHANICAL INSTALLER. COORDINATE WITH MECHANICAL INSTALLER FOR EXACT LOCATION AND POWER REQUIREMENTS PRIOR TO ROUGH IN. REFER TO ARCHITECTURAL INTERIOR ELEVATIONS FOR DIMENSIONED LOCATIONS OF THERMOSTATS.
2. PROVIDE ONE 20A, 120V, 1P DUPLEX RECEPTACLE UNDER KITCHEN SINK FOR DISPOSAL POWER CONNECTION.
3. REFER TO DETAIL 1/E1.13 FOR TYPICAL LAUNDRY ALCOVE RECEPTACLE LOCATIONS. COORDINATE INSTALLATION WITH MECHANICAL & PLUMBING CONTRACTOR.
4. PROVIDE ONE 15A, RECEPTACLE CIRCUIT FROM TENANT LOAD CENTER FOR TELECOM SMART PANEL. COORDINATE WORK WITH SERVICE PROVIDER FOR EXACT LOCATION AND FINAL CONNECTION.
5. CONTRACTOR TO VERIFY POWER CONNECTION TYPE FOR THE HOOD/MICROWAVE PRIOR TO ROUGH IN. PROVIDE ONE DEDICATED 20A, 1P DUPLEX RECEPTACLE LOCATED INSIDE THE CABINET OVER THE RANGE FOR APPLIANCES SUPPLIED WITH CORD & PLUG SET. HOOD/MICROWAVES THAT ARE TO BE HARDWIRED, SHALL BE PROVIDED WITH THE DEDICATED CIRCUIT GOING TO A J-BOX WHICH IS TO BE MOUNTED DIRECTLY BEHIND THE APPLIANCE.
6. METER LOCATION PER UTILITY PROVIDER'S APPROVAL (PENDING). REFER TO ONE-LINE DIAGRAM ON SHEET E1.11. PROVIDE NEMA 3R LOCKING CABINET FOR HOUSE PANEL 'HP'. REFER TO SHEET E1.01 FOR METER & PANEL LOCATION(S) AT EACH BUILDING.
7. 15A SWITCHED SPLIT DUPLEX RECEPTACLE. REFER TO LIGHTING PLANS (E2 SERIES SHEETS) FOR SWITCH LOCATION.

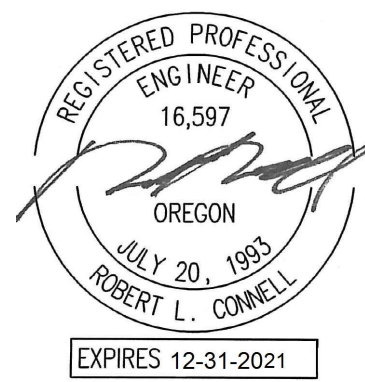


IN THE EVENT CONFLICTS ARE DISCOVERED BETWEEN THE ORIGINAL SIGNED AND SEALED DOCUMENT PREPARED BY THE ARCHITECT AND/OR THEIR CONSULTANTS, AND ANY COPY OF THE DOCUMENTS TRANSMITTED BY EMAIL, ELECTRONICALLY OR OTHERWISE, THE ORIGINAL SIGNED AND SEALED DOCUMENTS SHALL GOVERN.

PROJECT # 2019-179
DATE: 28 AUGUST 2020

REVISIONS

PLAN REVIEW 11.03.2020
PLAN REVIEW 03.19.2021

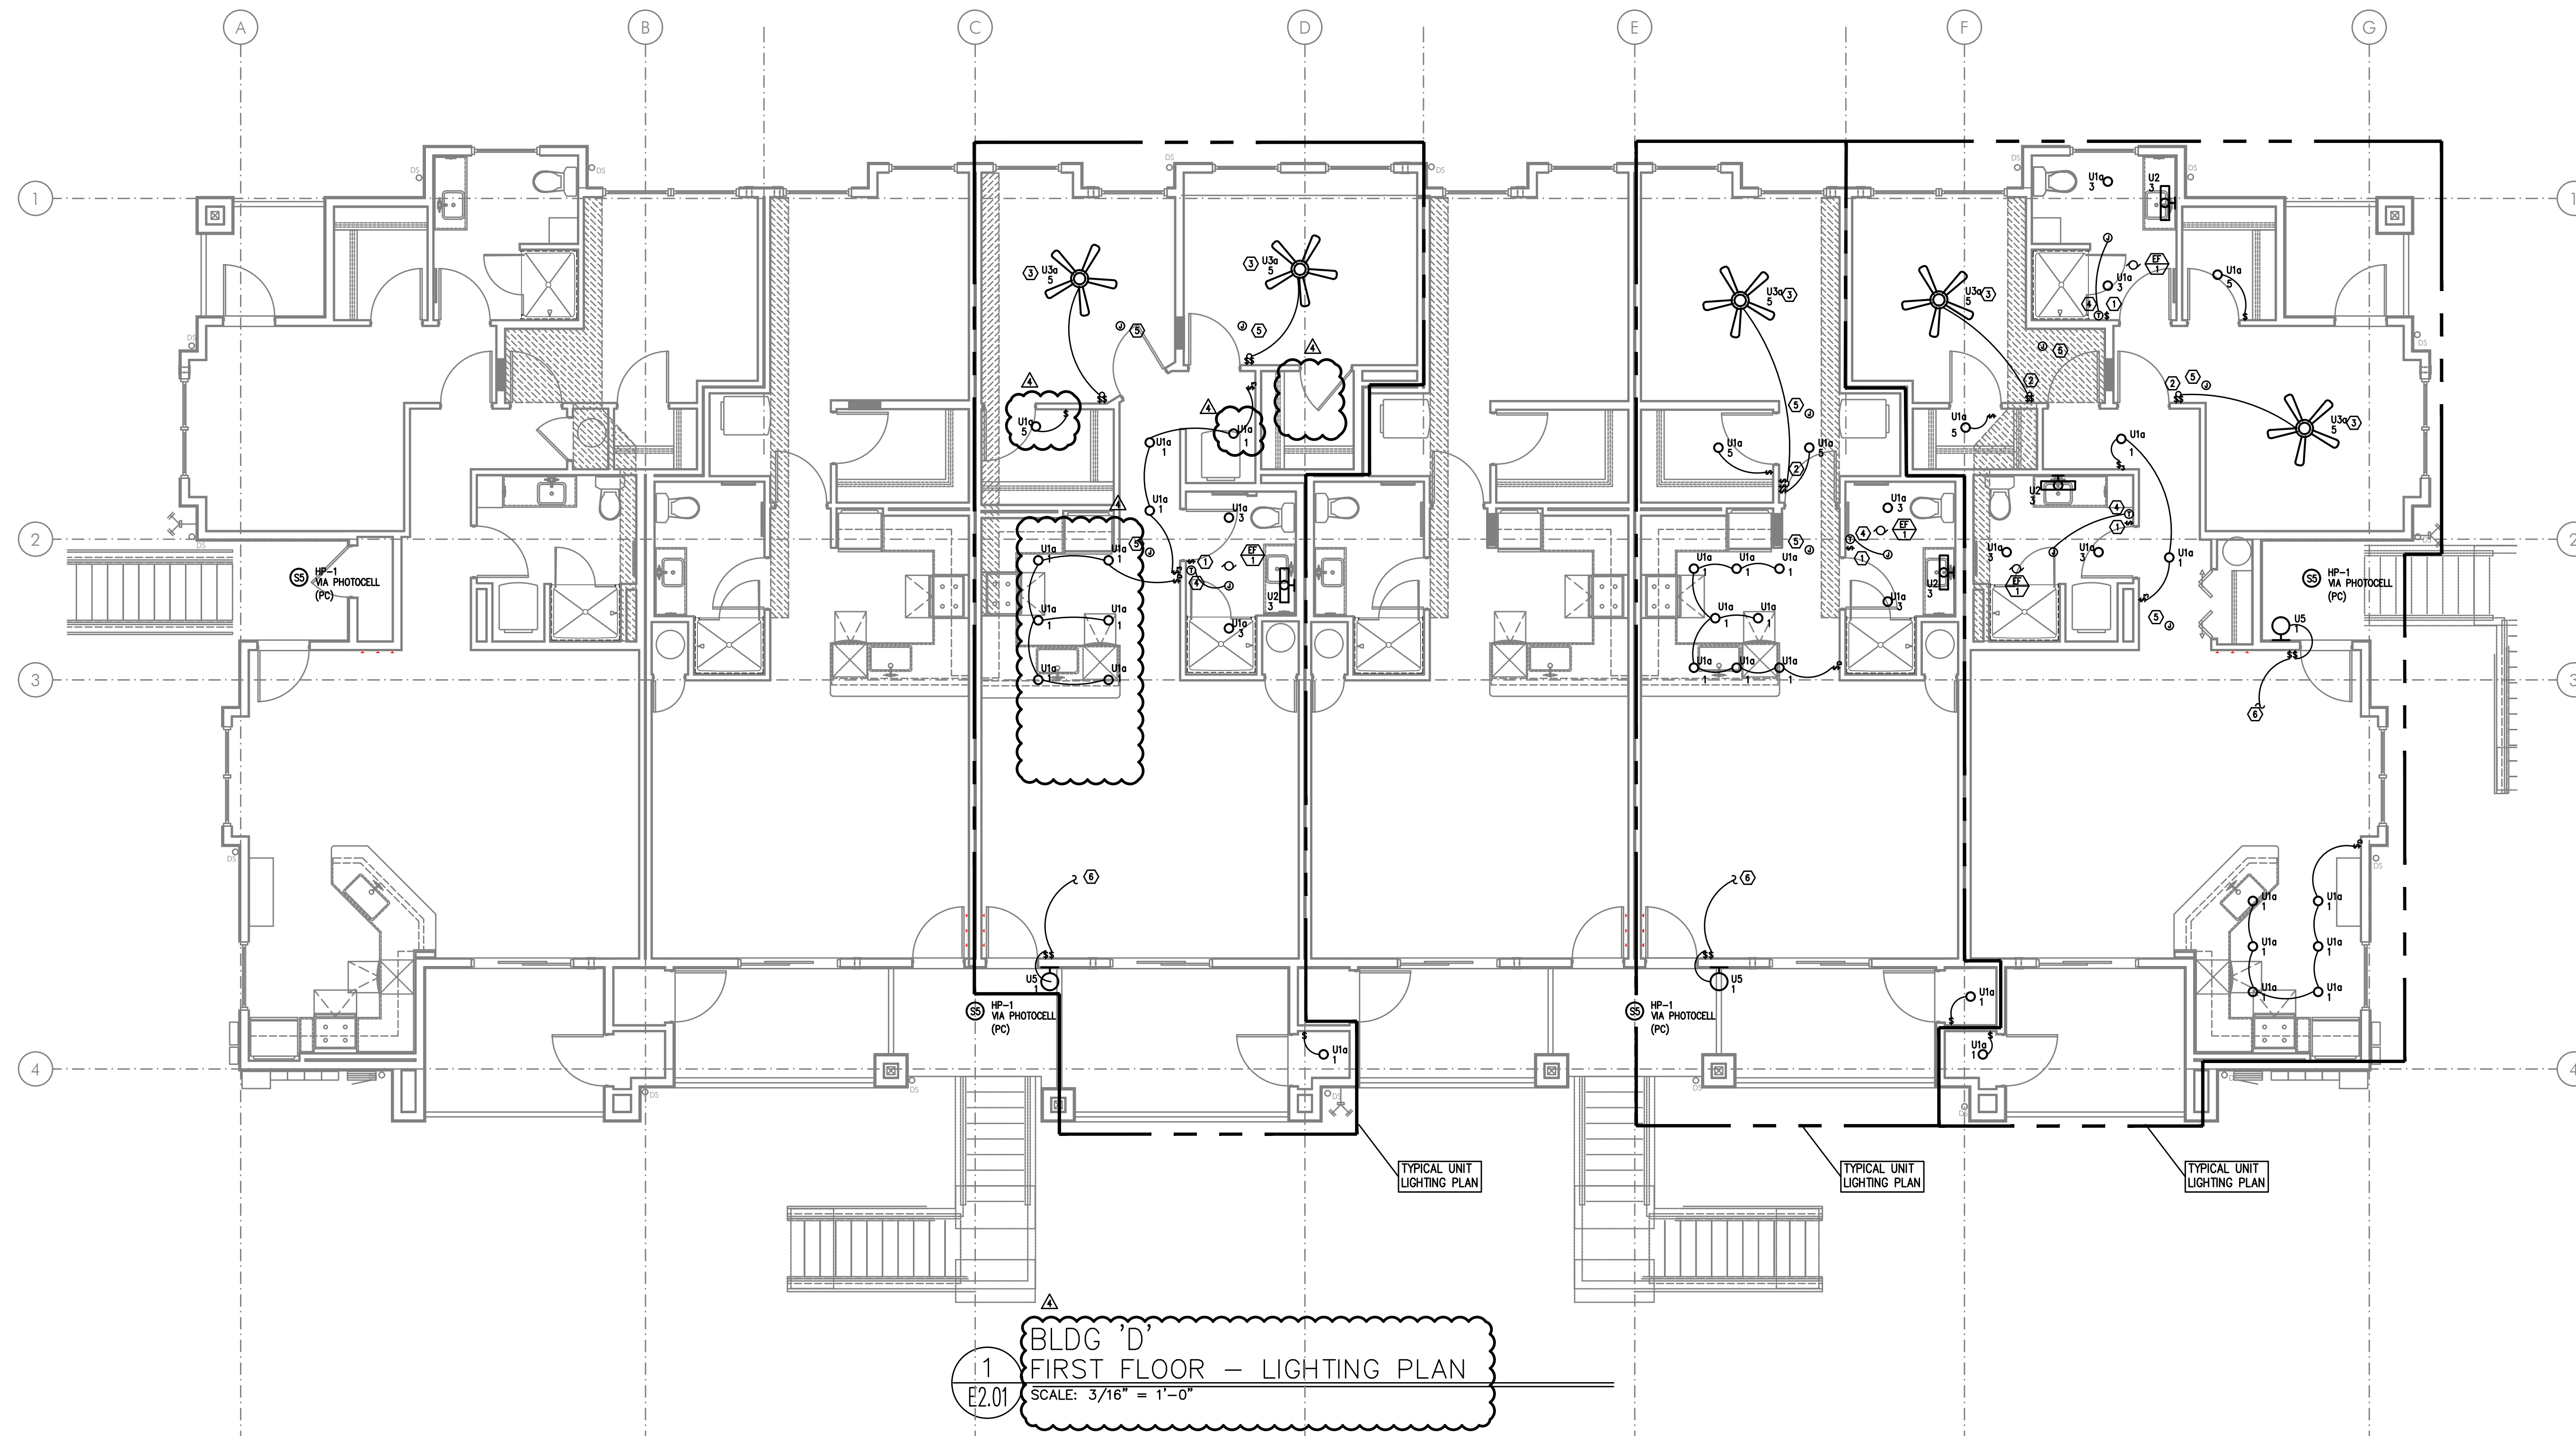

GENERAL LIGHTING NOTES:

- A. ELECTRICAL DRAWINGS ARE DIAGRAMMATICAL AND MAY NOT ACCURATELY REFLECT ACTUAL CONSTRUCTION CONDITIONS. THE ELECTRICAL CONTRACTOR SHALL BE RESPONSIBLE FOR COORDINATING THE INSTALLATION OF ALL ELECTRICAL EQUIPMENT, WITH ALL TRADES PRIOR TO AND DURING CONSTRUCTION.
- B. ALL DISCREPANCIES SHALL BE BROUGHT TO THE ATTENTION OF THE ARCHITECT IMMEDIATELY UPON DISCOVERY.
- C. REFER TO SHEET E1.21 FOR LIGHT FIXTURE SCHEDULES.
- D. THE ELECTRICAL CONTRACTOR SHALL REFER TO THE ARCHITECTURAL AND/OR INTERIORS PLAN SETS FOR DIMENSIONED LOCATIONS, MOUNTING HEIGHTS AND FINISHES OF DEVICES AND FIXTURES.
- E. REFER TO AVAILABLE ARCHITECTURAL AND/OR INTERIOR DESIGN DOCUMENTS & DRAWINGS FOR ADDITIONAL INFORMATION.
- F. EXTERIOR LIGHTING TO BE CONSTANT "ON" AND PROVIDED WITH PHOTOCELL, EITHER INTEGRAL OR REMOTE) FOR DUSK-TILL-DAWN OPERATION.
- G. ALL EXTERIOR BUILDING LIGHTS ON HOUSE POWER SHALL BE CONSIDERED EGRESS LIGHTING. FIXTURES ARE TO BE EQUIPPED WITH BATTERY BACK-UP (EITHER INTEGRAL OR REMOTE).
- H. REFER TO SHEET E1.14 FOR TYPICAL UNIT LOAD CENTER DIRECTORIES.
- I. ALL LIGHT SWITCHES SHALL BE ROCKER STYLE, SUCH AS LEVITON DECORA, OR APPROVED EQUAL.
- J. REFER TO ARCHITECTURAL REFLECTED CEILING PLANS FOR EXACT FIXTURE LOCATIONS (DIMENSIONS). CONSULT INTERIOR DESIGNER FOR MOUNTING HEIGHTS NOT SPECIFIED.

KEYED LIGHTING NOTES:


1. REFER TO TYPICAL BATHROOM SWITCHING DETAILS ON SHEET E1.21.
2. PROVIDE CEILING FAN CONTROL SWITCH(ES) AS DIRECTED BY MANUFACTURER.
3. PROVIDE BLOCKING AT CEILING TO SUPPORT 35LB. MINIMUM, FOR CEILING FAN INSTALLATION.
4. PROVIDE WIRE CONNECTION FOR THERMOSTAT(S) PROVIDED BY MECHANICAL INSTALLER. COORDINATE WITH MECHANICAL INSTALLER FOR EXACT LOCATION AND POWER REQUIREMENTS PRIOR TO ROUGH IN. CEILING HEATER (BY MECHANICAL) TO BE TIED INTO BATHROOM POWER CIRCUIT. REFER TO ARCHITECTURAL INTERIOR ELEVATIONS FOR DIMENSIONED LOCATIONS OF BATHROOM THERMOSTATS.
5. COORDINATE LOCATION OF POWER CONNECTION FOR FIRE ALARM DEVICES WITH THE SYSTEM CONTRACTOR/INSTALLER.
6. TO SWITCHED RECEPTACLE. REFER TO POWER PLANS (E3 SERIES SHEETS) FOR OUTLET LOCATION.

MCKINNEY LANE APARTMENTS PHASE II
RUSSELL DRIVE & MCKINNEY LANE
LEBANON, OREGON 97331



D

E2.01

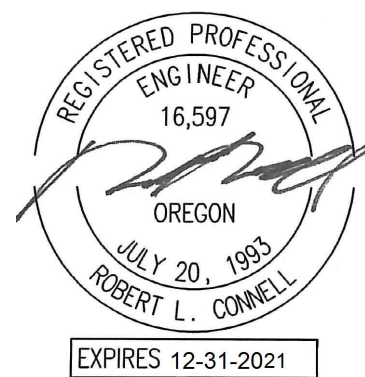

IN THE EVENT CONFLICTS ARE DISCOVERED BETWEEN THE ORIGINAL SIGNED AND SEALED DOCUMENTS PREPARED BY THE ARCHITECT AND/OR THEIR CONSULTANTS, AND ANY COPY OF THE DOCUMENTS TRANSMITTED BY EMAIL, FAX, ELECTRONICALLY OR OTHERWISE, THE ORIGINAL SIGNED AND SEALED DOCUMENTS SHALL GOVERN.


PROJECT # 2019-179
DATE: 28 AUGUST 2020

REVISIONS

PLAN REVIEW 11.03.2020
PLAN REVIEW 03.19.2021

MCKINNEY LANE APARTMENTS PHASE II
RUSSELL DRIVE & MCKINNEY LANE
LEBANON, OREGON

D
E2.02

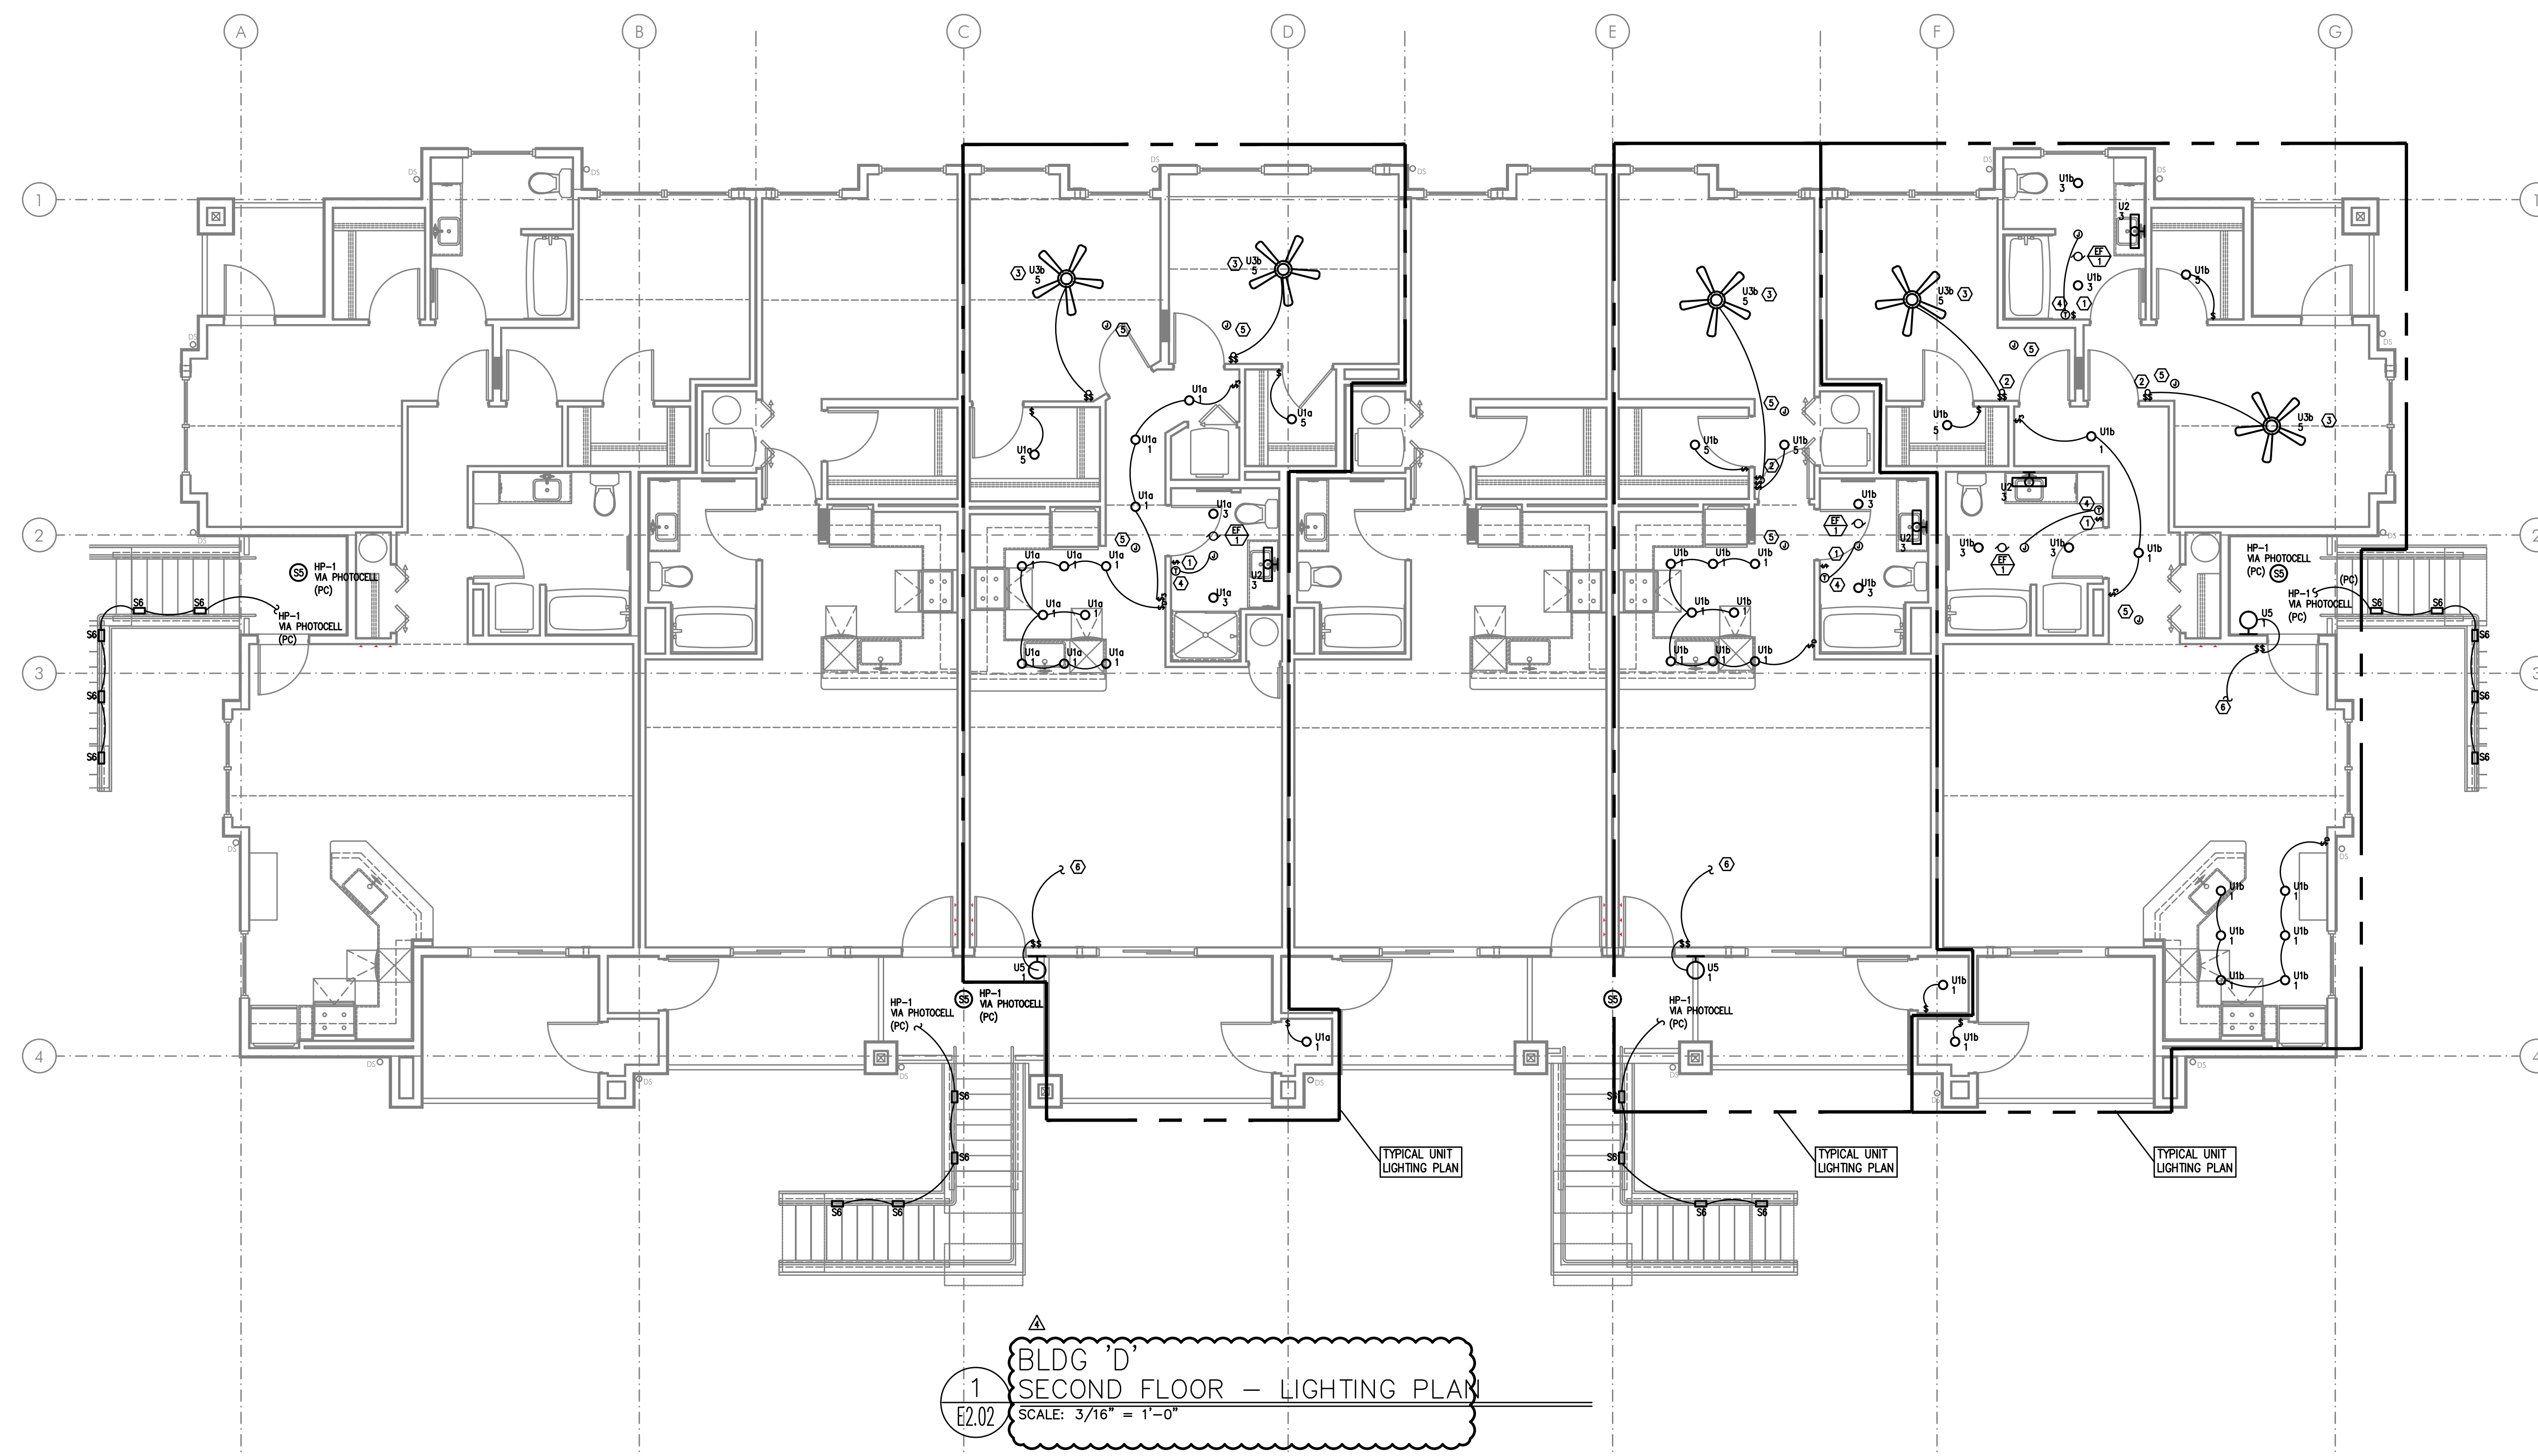


GENERAL LIGHTING NOTES:

- ELECTRICAL DRAWINGS ARE DIAGRAMMATICAL AND MAY NOT ACCURATELY REFLECT ACTUAL CONSTRUCTION CONDITIONS. THE ELECTRICAL CONTRACTOR SHALL BE RESPONSIBLE FOR COORDINATING THE INSTALLATION OF ALL ELECTRICAL EQUIPMENT, WITH ALL TRADES PRIOR TO AND DURING CONSTRUCTION.
- ALL DISCREPANCIES SHALL BE BROUGHT TO THE ATTENTION OF THE ARCHITECT IMMEDIATELY UPON DISCOVERY.
- REFER TO SHEET E1.21 FOR LIGHT FIXTURE SCHEDULES.
- THE ELECTRICAL CONTRACTOR SHALL REFER TO THE ARCHITECTURAL AND/OR INTERIORS PLAN SETS FOR DIMENSIONED LOCATIONS, MOUNTING HEIGHTS AND FINISHES OF DEVICES AND FIXTURES.
- REFER TO AVAILABLE ARCHITECTURAL AND/OR INTERIOR DESIGN DOCUMENTS & DRAWINGS FOR ADDITIONAL INFORMATION.
- EXTERIOR LIGHTING TO BE CONSTANT "ON" AND PROVIDED WITH PHOTOCELL, EITHER INTEGRAL OR REMOTE) FOR DUSK-TILL-DAWN OPERATION.
- ALL EXTERIOR BUILDING LIGHTS ON HOUSE POWER SHALL BE CONSIDERED EGRESS LIGHTING. FIXTURES ARE TO BE EQUIPPED WITH BATTERY BACK-UP (EITHER INTEGRAL OR REMOTE).
- REFER TO SHEET E1.14 FOR TYPICAL UNIT LOAD CENTER DIRECTORIES.
- ALL LIGHT SWITCHES SHALL BE ROCKER STYLE, SUCH AS LEVITON DECORA, OR APPROVED EQUAL.
- REFER TO ARCHITECTURAL REFLECTED CEILING PLANS FOR EXACT FIXTURE LOCATIONS (DIMENSIONS). CONSULT INTERIOR DESIGNER FOR MOUNTING HEIGHTS NOT SPECIFIED.

KEYED LIGHTING NOTES:

- REFER TO TYPICAL BATHROOM SWITCHING DETAILS ON SHEET E1.21.
- PROVIDE CEILING FAN CONTROL SWITCH(ES) AS DIRECTED BY MANUFACTURER.
- PROVIDE BLOCKING AT CEILING TO SUPPORT 35LB. MINIMUM, FOR CEILING FAN INSTALLATION.
- PROVIDE WIRE CONNECTION FOR THERMOSTAT(S) PROVIDED BY MECHANICAL INSTALLER. COORDINATE WITH MECHANICAL INSTALLER FOR EXACT LOCATION AND POWER REQUIREMENTS PRIOR TO ROUGH IN. CEILING HEATER (BY MECHANICAL) TO BE TIED INTO BATHROOM POWER CIRCUIT. REFER TO ARCHITECTURAL INTERIOR ELEVATIONS FOR DIMENSIONED LOCATIONS OF BATHROOM THERMOSTATS.
- COORDINATE LOCATION OF POWER CONNECTION FOR FIRE ALARM DEVICES WITH THE SYSTEM CONTRACTOR/INSTALLER.
- TO SWITCHED RECEPTACLE. REFER TO POWER PLANS (E3 SERIES SHEETS) FOR OUTLET LOCATION.

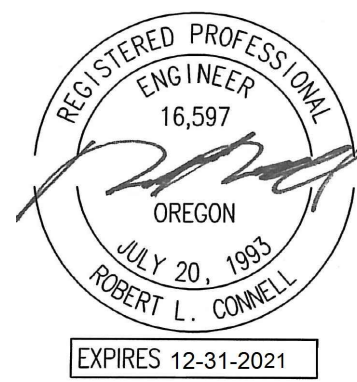


IN THE EVENT CONFLICTS ARE DISCOVERED
BETWEEN THE ORIGINAL SIGNED AND SEALED
DOCUMENT PREPARED BY THE ARCHITECT
AND/OR THEIR CONSULTANTS, AND ANY COPY OF
THE DOCUMENTS TRANSMITTED BY ANY MEANS,
ELECTRONICALLY OR OTHERWISE, THE ORIGINAL
SIGNED AND SEALED DOCUMENTS SHALL GOVERN.

PROJECT # 2019-179
DATE: 28 AUGUST 2020

REVISIONS

PLAN REVIEW 11.03.2020
PLAN REVIEW 03.19.2021

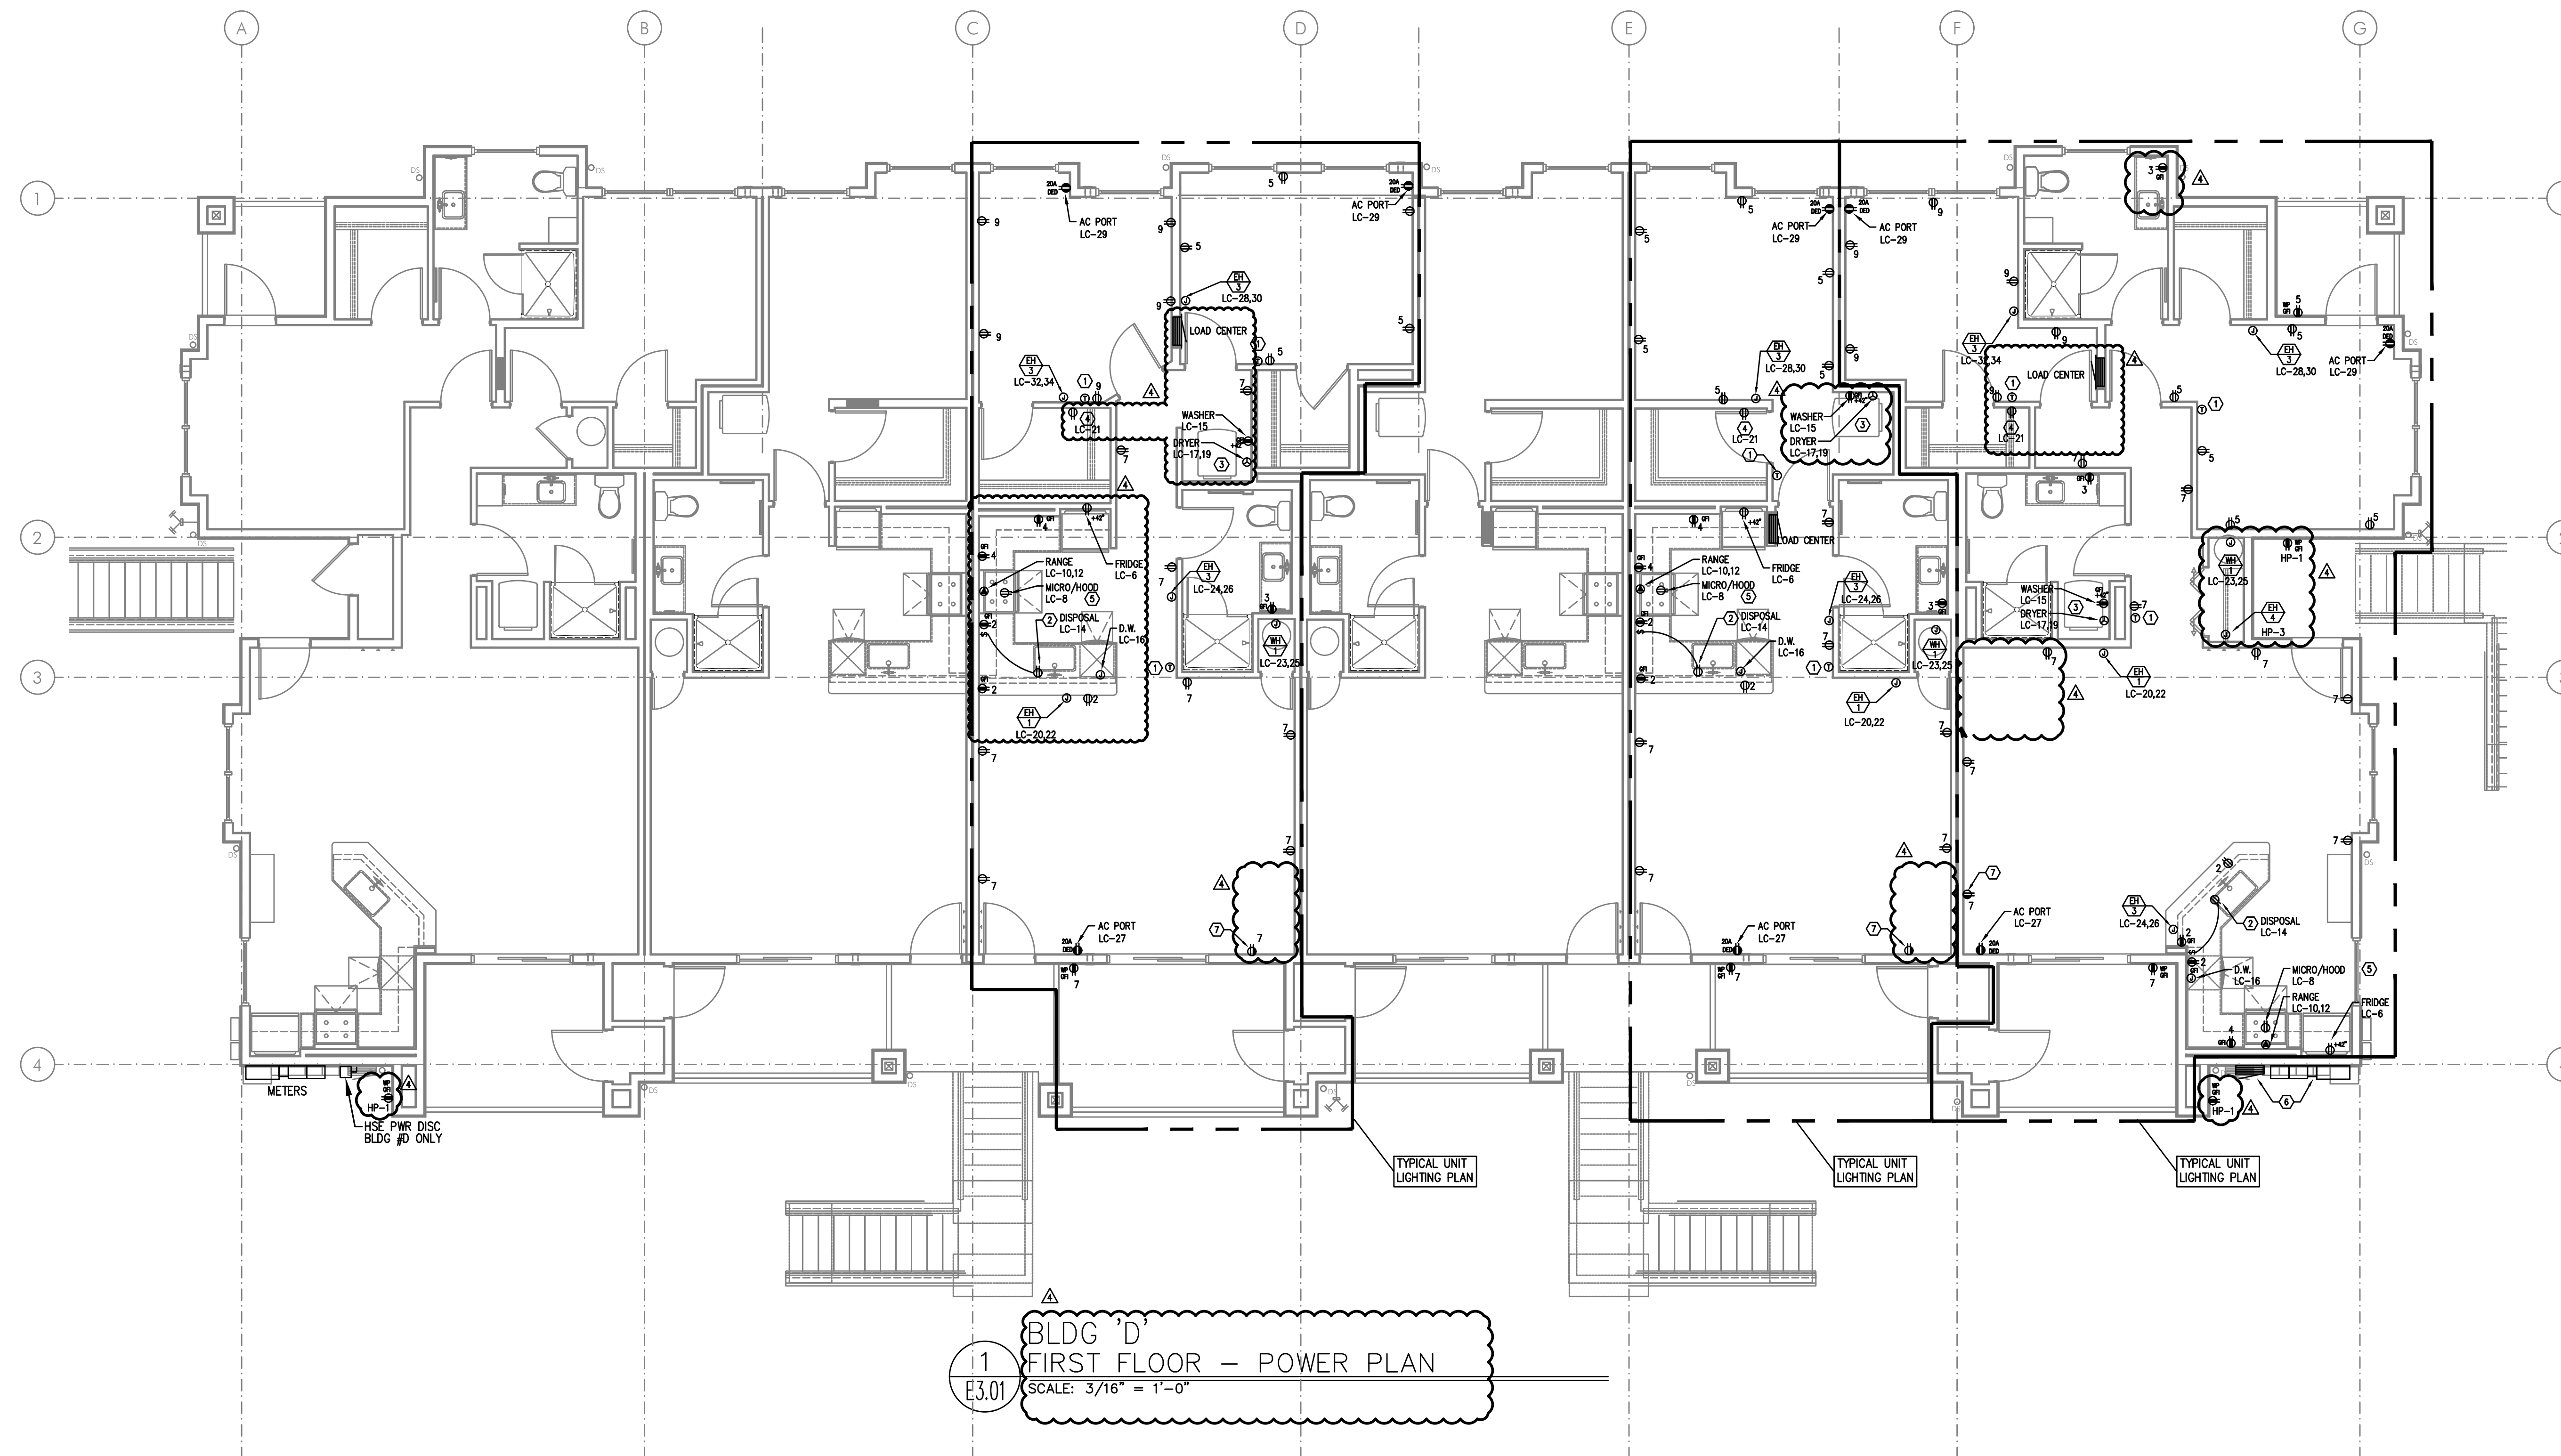


GENERAL POWER NOTES:

- ALL PLANS ARE CONSIDERED DIAGRAMMATICAL. THEREFORE ALL EQUIPMENT SIZES AND DEVICE LOCATIONS ARE APPROXIMATE AND SUBJECT TO FIELD CONDITIONS AND PRODUCT APPROVAL.
- NOT USED.
- ELECTRICAL CONTRACTOR SHALL PROVIDE INSTALLATION AND FINAL CONNECTION OF THERMOSTATS. CONSULT MECHANICAL CONTRACTOR FOR EXACT REQUIREMENTS PRIOR TO ROUGH IN.
- REFER TO INTERIOR DECORATOR AND/OR ARCHITECTURAL DRAWINGS FOR DIMENSIONED LOCATION(S) AND ELEVATIONS OF FIXTURES & DEVICES. OTHER DEVICES SHOWN ON THE ELECTRICAL PLANS AND NOT INDICATED ON THE DECORATOR'S OR ARCHITECT'S DRAWINGS, SHALL BE INSTALLED AT STANDARD MOUNTING HEIGHT AS INDICATED THE SYMBOL LIST.
- BUILDING ELECTRICAL EQUIPMENT SHOWN IS APPROXIMATE, BASED ON INDUSTRY STANDARD PRODUCTS. CONTRACTOR SHALL VERIFY ANY SUBMITTED EQUIPMENT WILL FIT WITHIN THE SPACE PROVIDED, PRIOR TO PRODUCT SUBMITTAL REVIEW.
- ELECTRICAL CONTRACTOR SHALL COORDINATE WITH THE LOW VOLTAGE ("T" SERIES) PLANS, INCLUDING FIRE ALARM AND SYSTEMS INSTALLER, AND PROVIDE ROUGH IN AS NEEDED.

KEYED POWER NOTES:

- PROVIDE WIRE CONNECTION FOR THERMOSTAT(S) PROVIDED BY MECHANICAL INSTALLER. COORDINATE WITH MECHANICAL INSTALLER FOR EXACT LOCATION AND POWER REQUIREMENTS PRIOR TO ROUGH IN. REFER TO ARCHITECTURAL INTERIOR ELEVATIONS FOR DIMENSIONED LOCATIONS OF THERMOSTATS.
- PROVIDE ONE 20A, 1P DUPLEX RECEPTACLE UNDER KITCHEN SINK FOR DISPOSAL POWER CONNECTION.
- REFER TO DETAIL 1/E1.13 FOR TYPICAL LAUNDRY ALCOVE RECEPTACLE LOCATIONS. COORDINATE INSTALLATION WITH MECHANICAL & PLUMBING CONTRACTOR.
- PROVIDE ONE 15A, RECEPTACLE CIRCUIT FROM TENANT LOAD CENTER FOR TELECOM SMART PANEL. COORDINATE WORK WITH SERVICE PROVIDER FOR EXACT LOCATION AND FINAL CONNECTION.
- CONTRACTOR TO VERIFY POWER CONNECTION TYPE FOR THE HOOD/MICROWAVE PRIOR TO ROUGH IN. PROVIDE ONE DEDICATED 20A, 1P DUPLEX RECEPTACLE LOCATED INSIDE THE CABINET OVER THE RANGE FOR APPLIANCES SUPPLIED WITH CORD & PLUG SET. HOOD/MICROWAVES THAT ARE TO BE HARDWIRED, SHALL BE PROVIDED WITH THE DEDICATED CIRCUIT GOING TO A J-BOX WHICH IS TO BE MOUNTED DIRECTLY BEHIND THE APPLIANCE.
- METER LOCATION PER UTILITY PROVIDER'S APPROVAL (PENDING). REFER TO ONE-LINE DIAGRAM ON SHEET E1.11. PROVIDE NEMA 3R LOCKING CABINET FOR HOUSE PANEL 'HP'. REFER TO SHEET E1.01 FOR METER & PANEL LOCATION(S) AT EACH BUILDING.
- 15A SWITCHED SPLIT DUPLEX RECEPTACLE. REFER TO LIGHTING PLANS (E2 SERIES SHEETS) FOR SWITCH LOCATION.

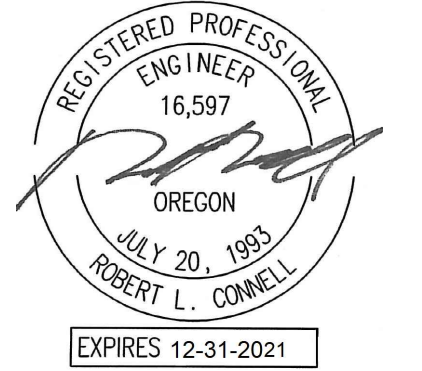

IN THE EVENT CONFLICTS ARE DISCOVERED BETWEEN THE ORIGINAL SIGNED AND SEALED DOCUMENT PREPARED BY THE ARCHITECT AND/OR THEIR CONSULTANTS, AND ANY COPY OF THE DOCUMENT TRANSMITTED BY ELECTRONIC, ELECTRONICALLY OR OTHERWISE, THE ORIGINAL SIGNED AND SEALED DOCUMENTS SHALL GOVERN.


PROJECT # 2019-179

DATE: 28 AUGUST 2020

REVISIONS

PLAN REVIEW 11.03.2020

PLAN REVIEW 03.19.2021

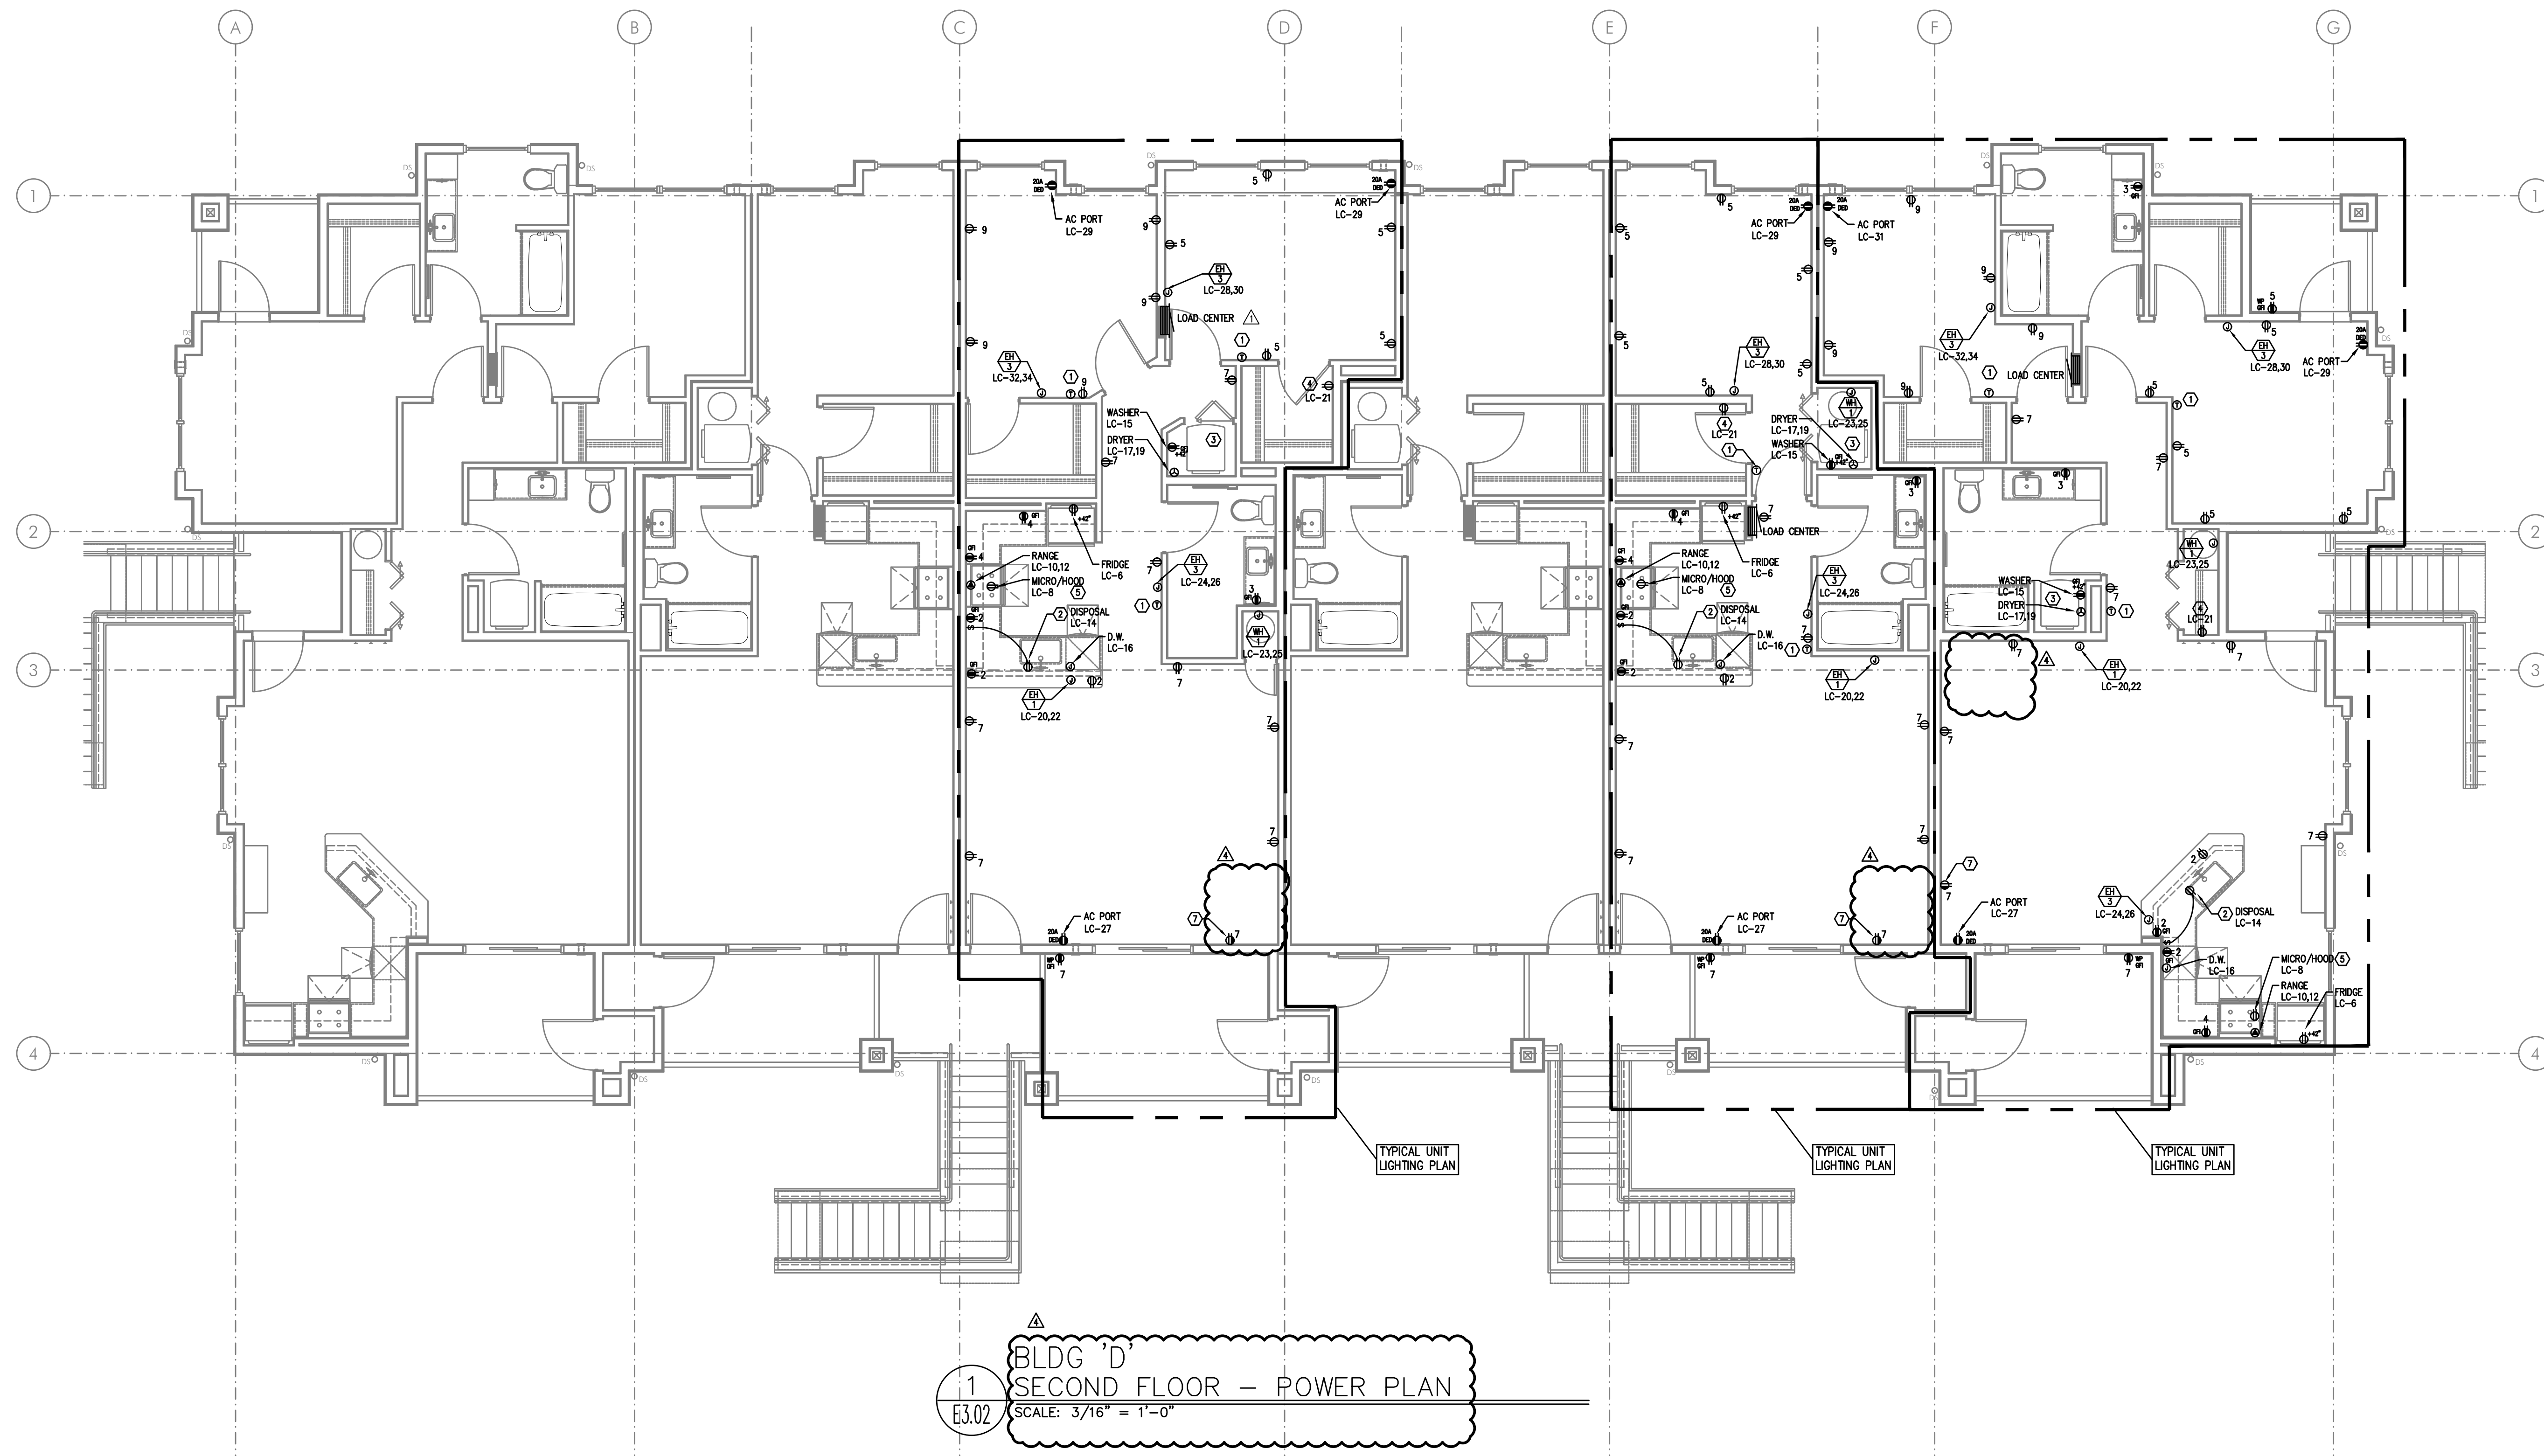

GENERAL POWER NOTES:

- A. ALL PLANS ARE CONSIDERED DIAGRAMMATICAL. THEREFORE ALL EQUIPMENT SIZES AND DEVICE LOCATIONS ARE APPROXIMATE AND SUBJECT TO FIELD CONDITIONS AND PRODUCT APPROVAL.
- B. NOT USED.
- C. ELECTRICAL CONTRACTOR SHALL PROVIDE INSTALLATION AND FINAL CONNECTION OF THERMOSTATS. CONSULT MECHANICAL CONTRACTOR FOR EXACT REQUIREMENTS PRIOR TO ROUGH IN.
- D. REFER TO INTERIOR DECORATOR AND/OR ARCHITECTURAL DRAWINGS FOR DIMENSIONED LOCATION(S) AND ELEVATIONS OF FIXTURES & DEVICES. OTHER DEVICES SHOWN ON THE ELECTRICAL PLANS AND NOT INDICATED ON THE DECORATOR'S OR ARCHITECT'S DRAWINGS, SHALL BE INSTALLED AT STANDARD MOUNTING HEIGHT AS INDICATED THE SYMBOL LIST.
- E. BUILDING ELECTRICAL EQUIPMENT SHOWN IS APPROXIMATE, BASED ON INDUSTRY STANDARD PRODUCTS. CONTRACTOR SHALL VERIFY ANY SUBMITTED EQUIPMENT WILL FIT WITHIN THE SPACE PROVIDED, PRIOR TO PRODUCT SUBMITTAL REVIEW.
- F. ELECTRICAL CONTRACTOR SHALL COORDINATE WITH THE LOW VOLTAGE ('T' SERIES) PLANS, INCLUDING FIRE ALARM AND SYSTEMS INSTALLER, AND PROVIDE ROUGH IN AS NEEDED.

KEYED POWER NOTES:

1. PROVIDE WIRE CONNECTION FOR THERMOSTAT(S) PROVIDED BY MECHANICAL INSTALLER. COORDINATE WITH MECHANICAL INSTALLER FOR EXACT LOCATION AND POWER REQUIREMENTS PRIOR TO ROUGH IN. REFER TO ARCHITECTURAL INTERIOR ELEVATIONS FOR DIMENSIONED LOCATIONS OF THERMOSTATS.
2. PROVIDE ONE 20A, 120V, 1P GFCI DUPLEX RECEPTACLE UNDER KITCHEN SINK FOR DISPOSAL POWER CONNECTION.
3. REFER TO DETAIL 1/E1.13 FOR TYPICAL LAUNDRY ALCOVE RECEPTACLE LOCATIONS. COORDINATE INSTALLATION WITH MECHANICAL & PLUMBING CONTRACTOR.
4. PROVIDE ONE 15A, RECEPTACLE CIRCUIT FROM TENANT LOAD CENTER FOR TELECOM SMART PANEL. COORDINATE WORK WITH SERVICE PROVIDER FOR EXACT LOCATION AND FINAL CONNECTION.
5. CONTRACTOR TO VERIFY POWER CONNECTION TYPE FOR THE HOOD/MICROWAVE PRIOR TO ROUGH IN. PROVIDE ONE DEDICATED 20A, 1P DUPLEX RECEPTACLE LOCATED INSIDE THE CABINET OVER THE RANGE FOR APPLIANCES SUPPLIED WITH CORD & PLUG SET. HOOD/MICROWAVES THAT ARE TO BE HARDWIRED, SHALL BE PROVIDED WITH THE DEDICATED CIRCUIT GOING TO A J-BOX WHICH IS TO BE MOUNTED DIRECTLY BEHIND THE APPLIANCE.
6. METER LOCATION PER UTILITY PROVIDER'S APPROVAL (PENDING). REFER TO ONE-LINE DIAGRAM ON SHEET E1.11. PROVIDE NEMA 3R LOCKING CABINET FOR HOUSE PANEL 'HP'. REFER TO SHEET E1.01 FOR METER & PANEL LOCATION(S) AT EACH BUILDING.
7. 15A SWITCHED SPLIT DUPLEX RECEPTACLE. REFER TO LIGHTING PLANS (E2 SERIES SHEETS) FOR SWITCH LOCATION.




IN THE EVENT CONFLICTS ARE DISCOVERED
BETWEEN THE ORIGINAL SIGNED AND SEALED
DOCUMENTS PREPARED BY THE ARCHITECT
AND/OR THEIR CONSULTANTS, AND ANY COPY OF
THE DOCUMENTS TRANSMITTED BY EMAIL, FAX,
ELECTRONICALLY OR OTHERWISE, THE ORIGINAL
SIGNED AND SEALED DOCUMENTS SHALL GOVERN.

PROJECT # 2019-179
DATE: 28 AUGUST 2020

REVISIONS

PLAN REVIEW 11.03.2020
PLAN REVIEW 03.19.2021

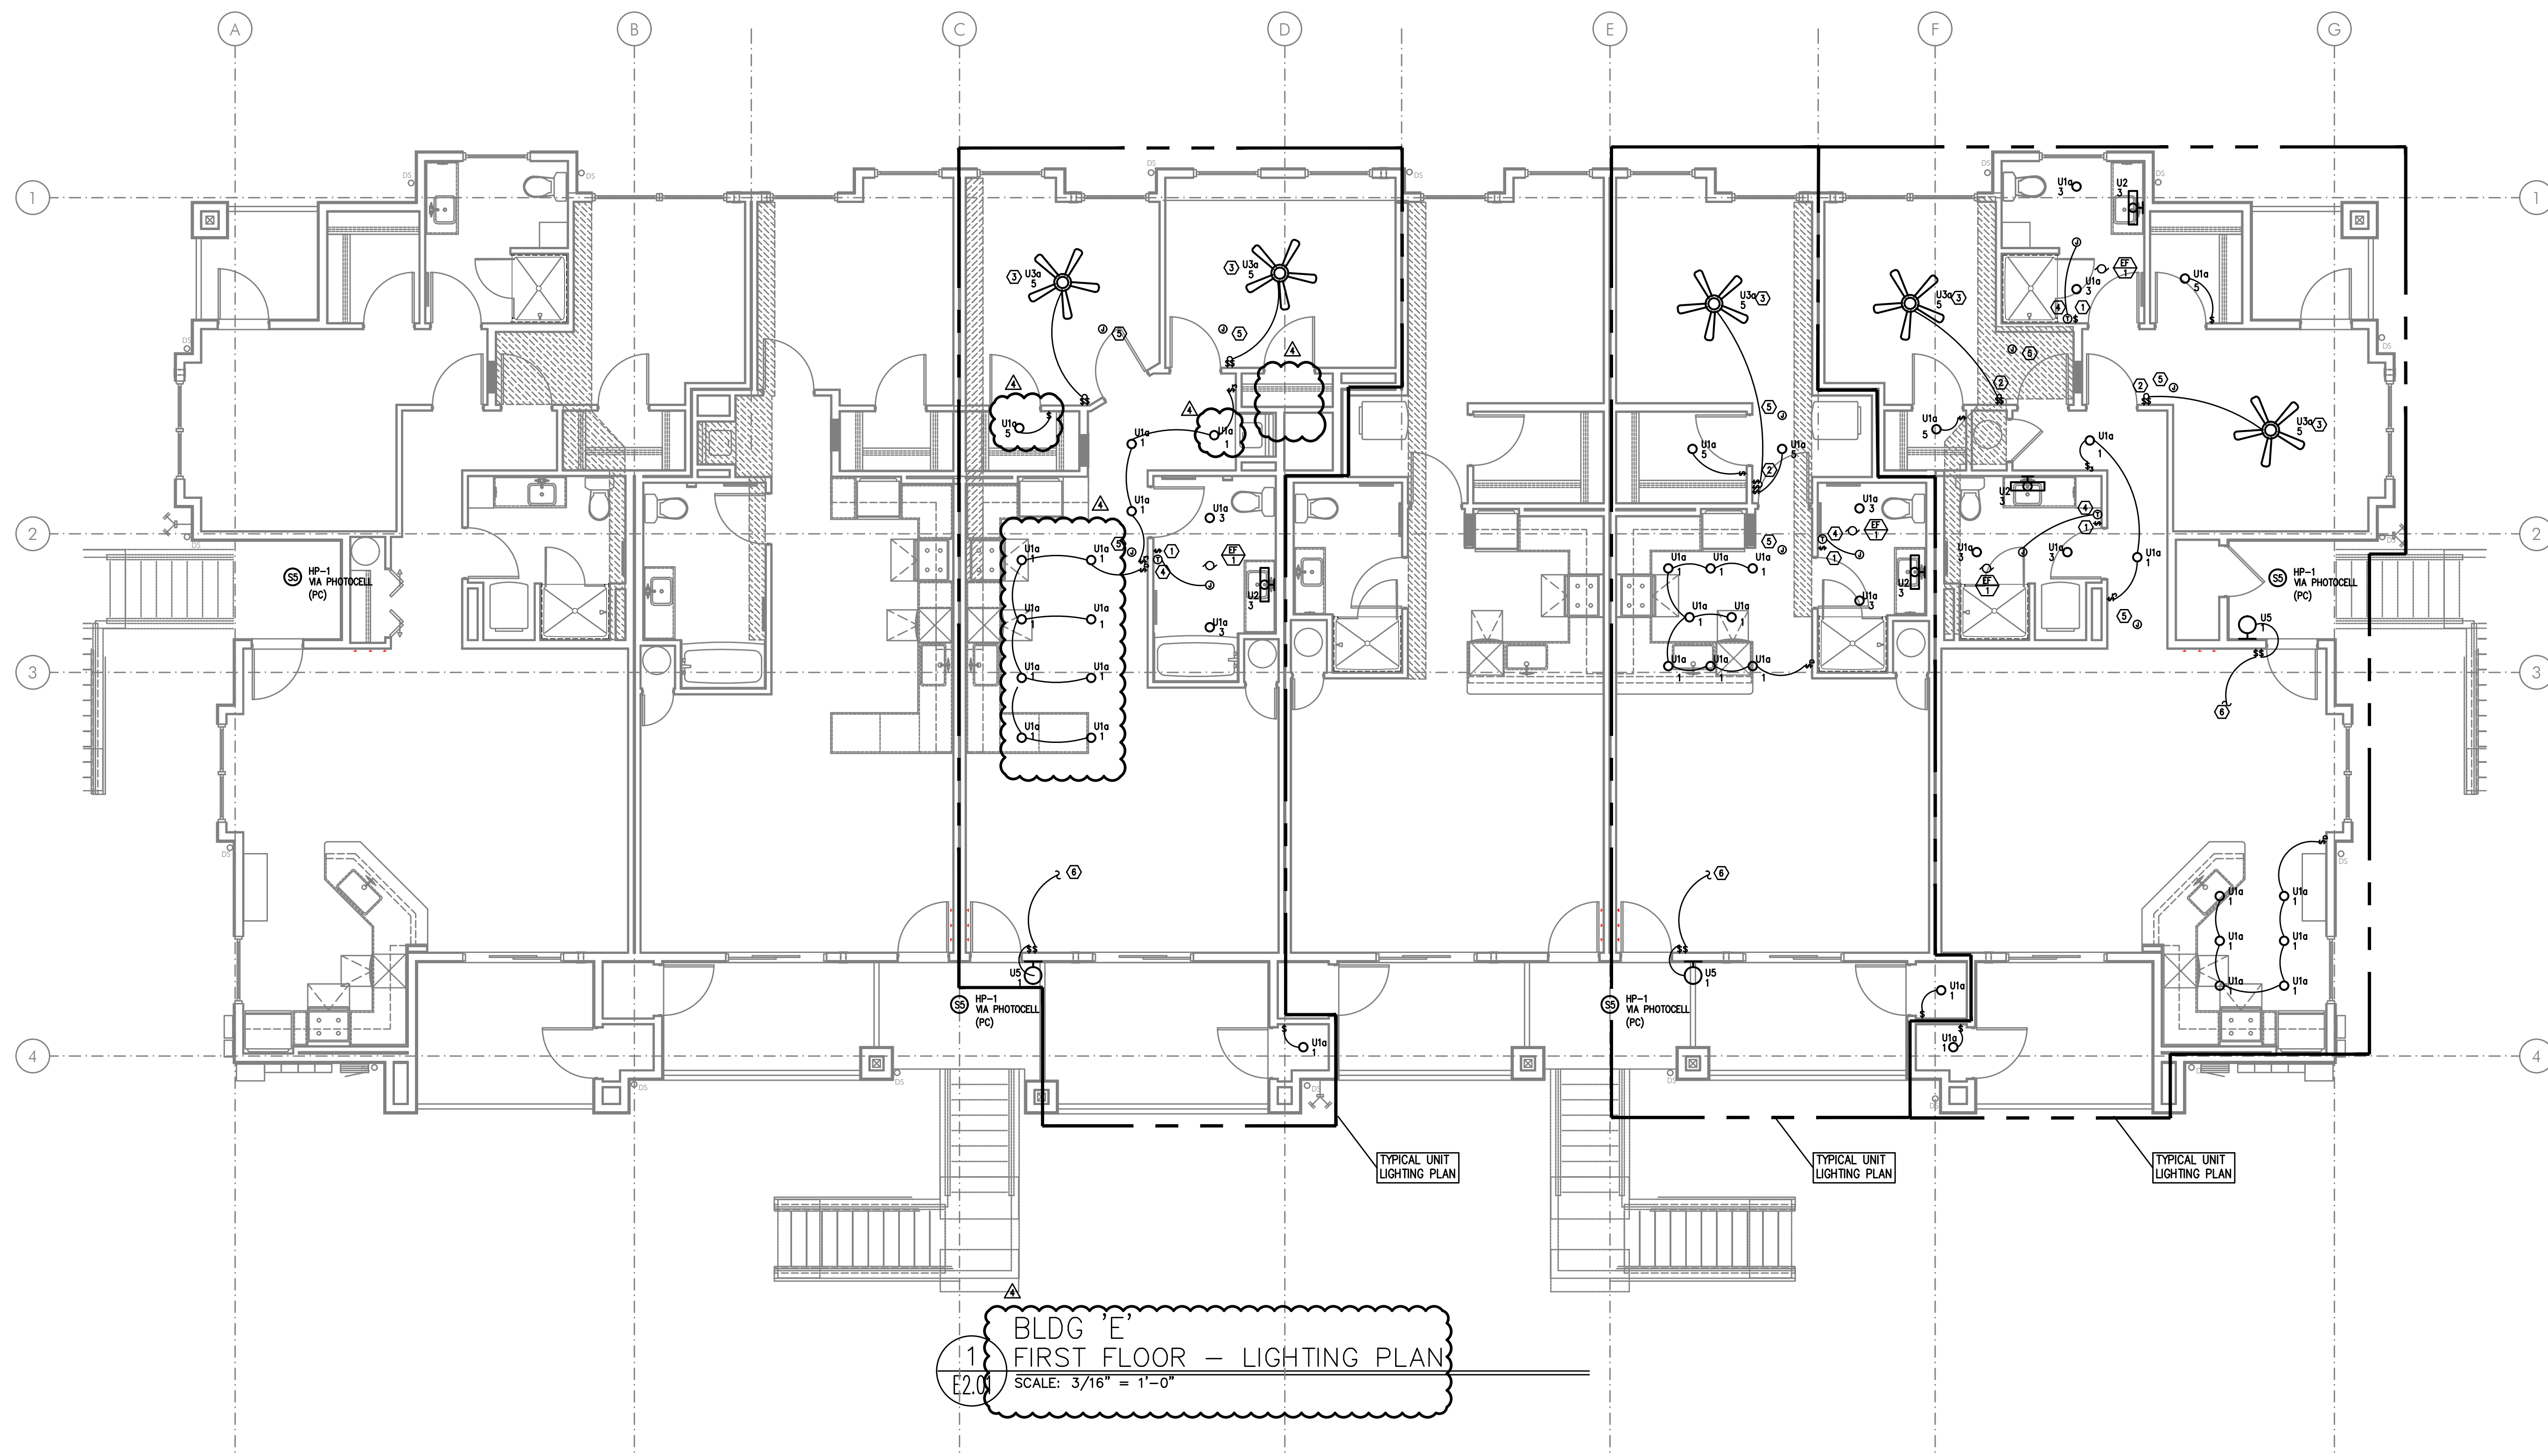

GENERAL LIGHTING NOTES:

- ELECTRICAL DRAWINGS ARE DIAGRAMMATICAL AND MAY NOT ACCURATELY REFLECT ACTUAL CONSTRUCTION CONDITIONS. THE ELECTRICAL CONTRACTOR SHALL BE RESPONSIBLE FOR COORDINATING THE INSTALLATION OF ALL ELECTRICAL EQUIPMENT, WITH ALL TRADES PRIOR TO AND DURING CONSTRUCTION.
- ALL DISCREPANCIES SHALL BE BROUGHT TO THE ATTENTION OF THE ARCHITECT IMMEDIATELY UPON DISCOVERY.
- REFER TO SHEET E1.21 FOR LIGHT FIXTURE SCHEDULES.
- THE ELECTRICAL CONTRACTOR SHALL REFER TO THE ARCHITECTURAL AND/OR INTERIORS PLAN SETS FOR DIMENSIONED LOCATIONS, MOUNTING HEIGHTS AND FINISHES OF DEVICES AND FIXTURES.
- REFER TO AVAILABLE ARCHITECTURAL AND/OR INTERIOR DESIGN DOCUMENTS & DRAWINGS FOR ADDITIONAL INFORMATION.
- EXTERIOR LIGHTING TO BE CONSTANT "ON" AND PROVIDED WITH PHOTOCELL, EITHER INTEGRAL OR REMOTE) FOR DUSK-TILL-DAWN OPERATION.
- ALL EXTERIOR BUILDING LIGHTS ON HOUSE POWER SHALL BE CONSIDERED EGRESS LIGHTING. FIXTURES ARE TO BE EQUIPPED WITH BATTERY BACK-UP (EITHER INTEGRAL OR REMOTE).
- REFER TO SHEET E1.14 FOR TYPICAL UNIT LOAD CENTER DIRECTORIES.
- ALL LIGHT SWITCHES SHALL BE ROCKER STYLE, SUCH AS LEVITON DECORA, OR APPROVED EQUAL.
- REFER TO ARCHITECTURAL REFLECTED CEILING PLANS FOR EXACT FIXTURE LOCATIONS (DIMENSIONS). CONSULT INTERIOR DESIGNER FOR MOUNTING HEIGHTS NOT SPECIFIED.

KEYED LIGHTING NOTES:

- REFER TO TYPICAL BATHROOM SWITCHING DETAILS ON SHEET E1.21.
- PROVIDE CEILING FAN CONTROL SWITCH(ES) AS DIRECTED BY MANUFACTURER.
- PROVIDE BLOCKING AT CEILING TO SUPPORT 35LB., MINIMUM, FOR CEILING FAN INSTALLATION.
- PROVIDE WIRE CONNECTION FOR THERMOSTAT(S) PROVIDED BY MECHANICAL INSTALLER. COORDINATE WITH MECHANICAL INSTALLER FOR EXACT LOCATION AND POWER REQUIREMENTS PRIOR TO ROUGH IN. CEILING HEATER (BY MECHANICAL) TO BE TIED INTO BATHROOM POWER CIRCUIT. REFER TO ARCHITECTURAL INTERIOR ELEVATIONS FOR DIMENSIONED LOCATIONS OF BATHROOM THERMOSTATS.
- COORDINATE LOCATION OF POWER CONNECTION FOR FIRE ALARM DEVICES WITH THE SYSTEM CONTRACTOR/INSTALLER.
- TO SWITCHED RECEPTACLE. REFER TO POWER PLANS (E3 SERIES SHEETS) FOR OUTLET LOCATION.

MCKINNEY LANE APARTMENTS PHASE II
RUSSELL DRIVE & MCKINNEY LANE
LEBANON, OREGON

E
E2.01



IN THE EVENT CONFLICTS ARE DISCOVERED
BETWEEN THE ORIGINAL SIGNED AND SEALED
DOCUMENTS PREPARED BY THE ARCHITECT
AND/OR THEIR CONSULTANTS, AND ANY COPY OF
THE DOCUMENTS TRANSMITTED BY EMAIL, FAX,
ELECTRONICALLY OR OTHERWISE, THE ORIGINAL
SIGNED AND SEALED DOCUMENTS SHALL GOVERN.

PROJECT # 2019-179
DATE: 28 AUGUST 2020

REVISIONS

PLAN REVIEW 11.03.2020
PLAN REVIEW 03.19.2021


MCKINNEY LANE APARTMENTS PHASE II
RUSSELL DRIVE & MCKINNEY LANE
LEBANON, OREGON

△△

E

E2.02

M
E
A
Consulting Engineers
2007 S.E. Ash St.
Portland, OR 97214
PH: (503) 234-0548
FAX: (503) 234-0677
INC. WWW.MEIA-ENG.COM
CONTACT: DENISE TAYLOR

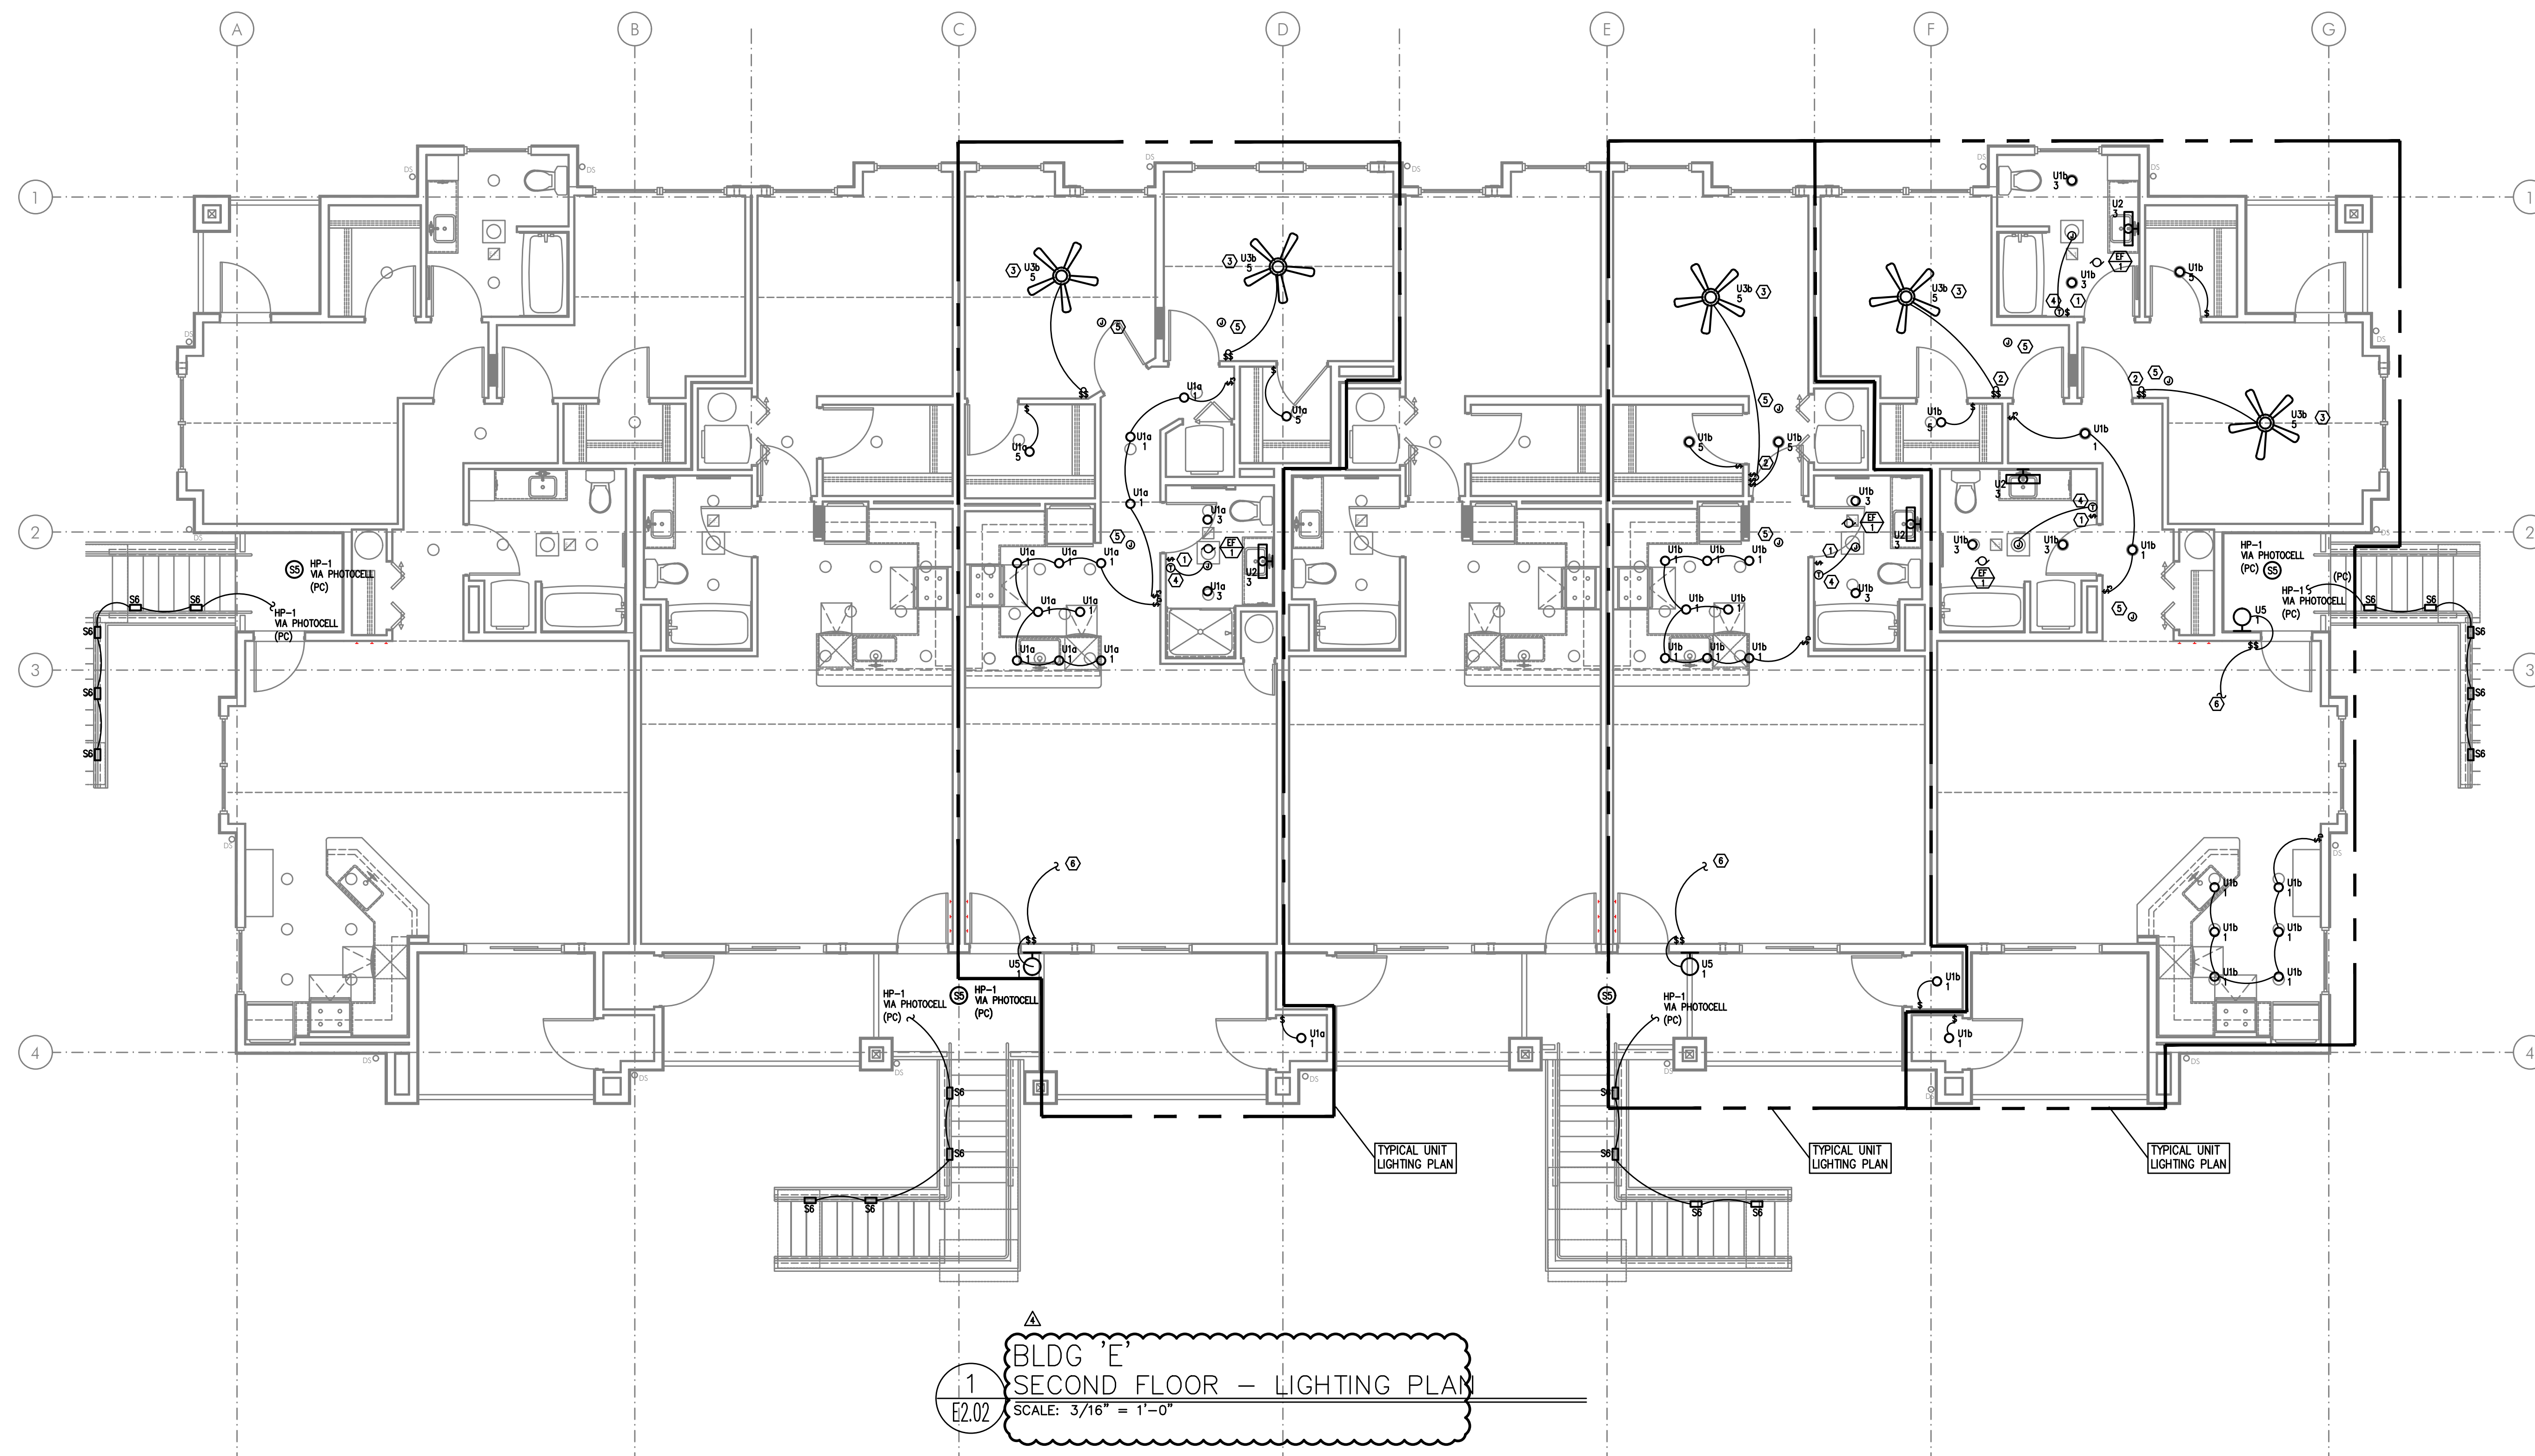


GENERAL LIGHTING NOTES:

- ELECTRICAL DRAWINGS ARE DIAGRAMMATICAL AND MAY NOT ACCURATELY REFLECT ACTUAL CONSTRUCTION CONDITIONS. THE ELECTRICAL CONTRACTOR SHALL BE RESPONSIBLE FOR COORDINATING THE INSTALLATION OF ALL ELECTRICAL EQUIPMENT, WITH ALL TRADES PRIOR TO AND DURING CONSTRUCTION.
- ALL DISCREPANCIES SHALL BE BROUGHT TO THE ATTENTION OF THE ARCHITECT IMMEDIATELY UPON DISCOVERY.
- REFER TO SHEET E1.21 FOR LIGHT FIXTURE SCHEDULES.
- THE ELECTRICAL CONTRACTOR SHALL REFER TO THE ARCHITECTURAL AND/OR INTERIORS PLAN SETS FOR DIMENSIONED LOCATIONS, MOUNTING HEIGHTS AND FINISHES OF DEVICES AND FIXTURES.
- REFER TO AVAILABLE ARCHITECTURAL AND/OR INTERIOR DESIGN DOCUMENTS & DRAWINGS FOR ADDITIONAL INFORMATION.
- EXTERIOR LIGHTING TO BE CONSTANT "ON" AND PROVIDED WITH PHOTOCELL, EITHER INTEGRAL OR REMOTE) FOR DUSK-TILL-DAWN OPERATION.
- ALL EXTERIOR BUILDING LIGHTS ON HOUSE POWER SHALL BE CONSIDERED EGRESS LIGHTING. FIXTURES ARE TO BE EQUIPPED WITH BATTERY BACK-UP (EITHER INTEGRAL OR REMOTE).
- REFER TO SHEET E1.14 FOR TYPICAL UNIT LOAD CENTER DIRECTORIES.
- ALL LIGHT SWITCHES SHALL BE ROCKER STYLE, SUCH AS LEVITON DECORA, OR APPROVED EQUAL.
- REFER TO ARCHITECTURAL REFLECTED CEILING PLANS FOR EXACT FIXTURE LOCATIONS (DIMENSIONS). CONSULT INTERIOR DESIGNER FOR MOUNTING HEIGHTS NOT SPECIFIED.

KEYED LIGHTING NOTES:

- REFER TO TYPICAL BATHROOM SWITCHING DETAILS ON SHEET E1.21.
- PROVIDE CEILING FAN CONTROL SWITCH(ES) AS DIRECTED BY MANUFACTURER.
- PROVIDE BLOCKING AT CEILING TO SUPPORT 35LB., MINIMUM, FOR CEILING FAN INSTALLATION.
- PROVIDE WIRE CONNECTION FOR THERMOSTAT(S) PROVIDED BY MECHANICAL INSTALLER. COORDINATE WITH MECHANICAL INSTALLER FOR EXACT LOCATION AND POWER REQUIREMENTS PRIOR TO ROUGH IN. CEILING HEATER (BY MECHANICAL) TO BE TIED INTO BATHROOM POWER CIRCUIT. REFER TO ARCHITECTURAL INTERIOR ELEVATIONS FOR DIMENSIONED LOCATIONS OF BATHROOM THERMOSTATS.
- COORDINATE LOCATION OF POWER CONNECTION FOR FIRE ALARM DEVICES WITH THE SYSTEM CONTRACTOR/INSTALLER.
- TO SWITCHED RECEPTACLE. REFER TO POWER PLANS (E3 SERIES SHEETS) FOR OUTLET LOCATION.

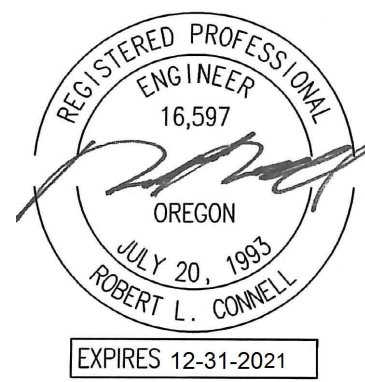


IN THE EVENT CONFLICTS ARE DISCOVERED
BETWEEN THE ORIGINAL SIGNED AND SEALED
DOCUMENT PREPARED BY THE ARCHITECT
AND/OR THEIR CONSULTANTS, AND ANY COPY OF
THE DOCUMENT TRANSMITTED BY EMAIL, FAX,
ELECTRONICALLY OR OTHERWISE, THE ORIGINAL
SIGNED AND SEALED DOCUMENTS SHALL GOVERN.

PROJECT # 2019-179
DATE: 28 AUGUST 2020

REVISIONS

△ PLAN REVIEW 11.03.2020
△ PLAN REVIEW 03.19.2021

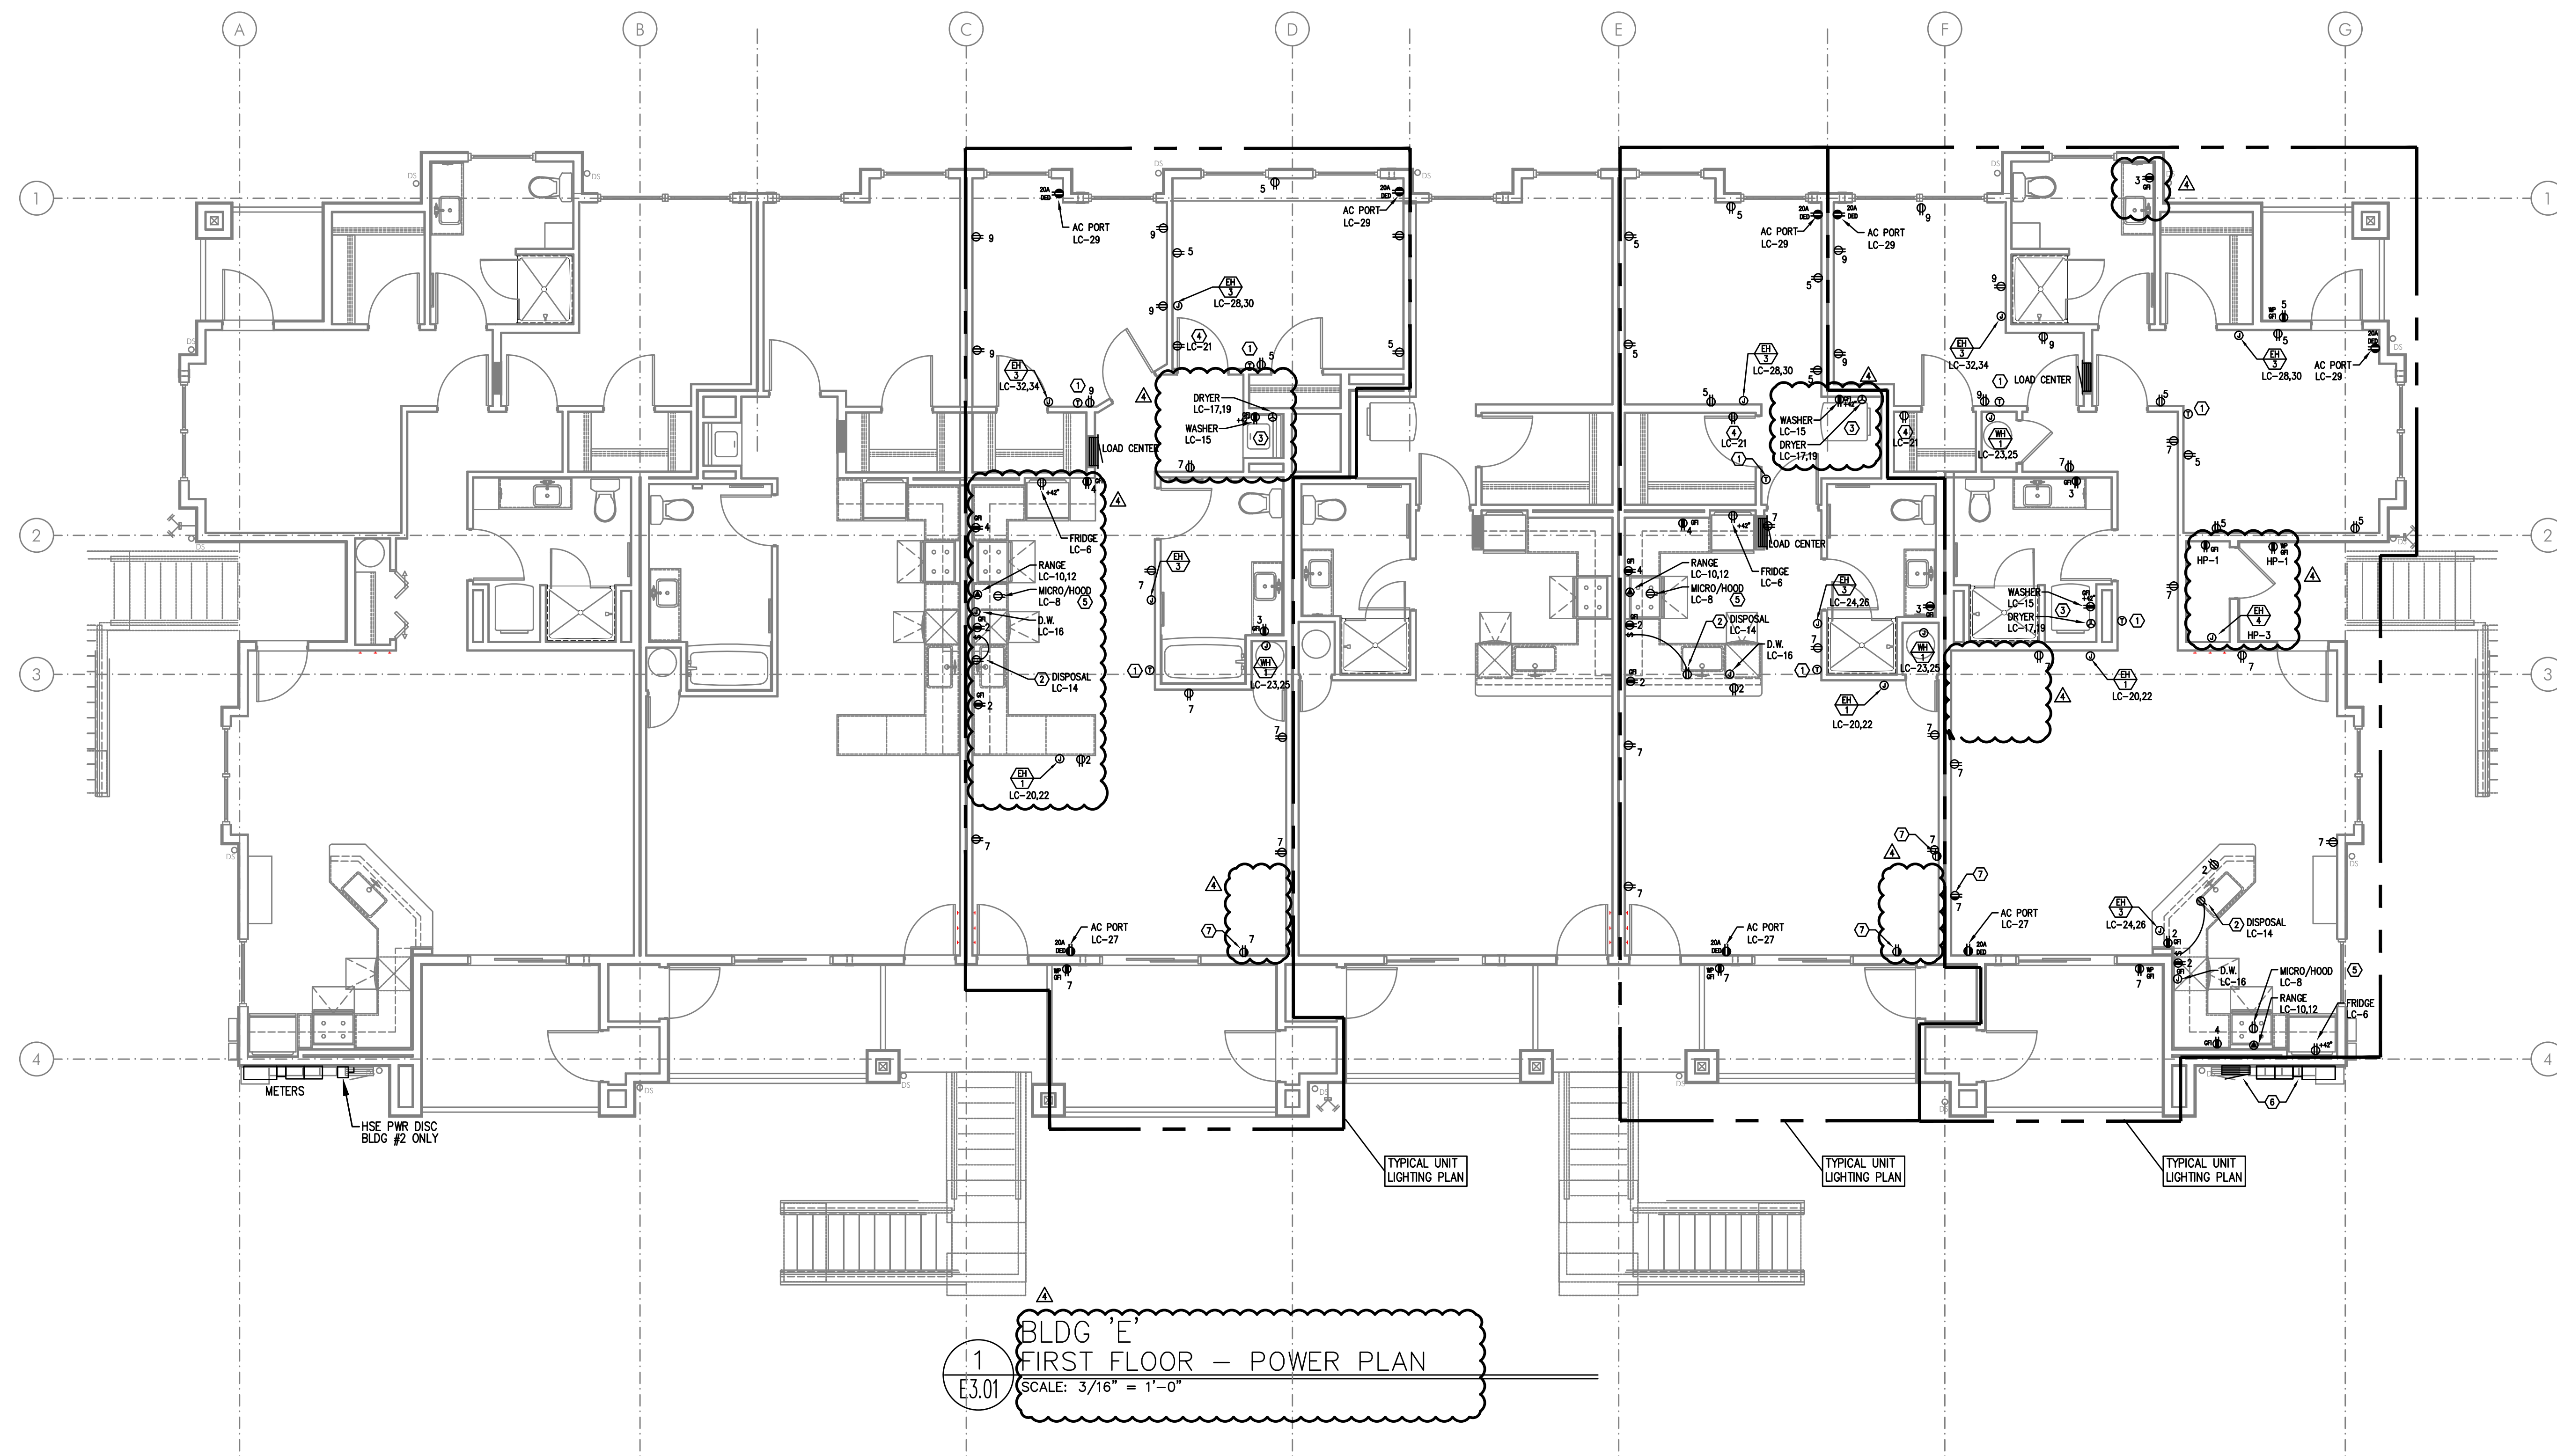


GENERAL POWER NOTES:

- ALL PLANS ARE CONSIDERED DIAGRAMMATICAL. THEREFORE ALL EQUIPMENT SIZES AND DEVICE LOCATIONS ARE APPROXIMATE AND SUBJECT TO FIELD CONDITIONS AND PRODUCT APPROVAL.
- NOT USED.
- ELECTRICAL CONTRACTOR SHALL PROVIDE INSTALLATION AND FINAL CONNECTION OF THERMOSTATS. CONSULT MECHANICAL CONTRACTOR FOR EXACT REQUIREMENTS PRIOR TO ROUGH IN.
- REFER TO INTERIOR DECORATOR AND/OR ARCHITECTURAL DRAWINGS FOR DIMENSIONED LOCATION(S) AND ELEVATIONS OF FIXTURES & DEVICES. OTHER DEVICES SHOWN ON THE ELECTRICAL PLANS AND NOT INDICATED ON THE DECORATOR'S OR ARCHITECT'S DRAWINGS, SHALL BE INSTALLED AT STANDARD MOUNTING HEIGHT AS INDICATED THE SYMBOL LIST.
- BUILDING ELECTRICAL EQUIPMENT SHOWN IS APPROXIMATE, BASED ON INDUSTRY STANDARD PRODUCTS. CONTRACTOR SHALL VERIFY ANY SUBMITTED EQUIPMENT WILL FIT WITHIN THE SPACE PROVIDED, PRIOR TO PRODUCT SUBMITTAL REVIEW.
- ELECTRICAL CONTRACTOR SHALL COORDINATE WITH THE LOW VOLTAGE ("T" SERIES) PLANS, INCLUDING FIRE ALARM AND SYSTEMS INSTALLER, AND PROVIDE ROUGH IN AS NEEDED.

KEYED POWER NOTES:

- PROVIDE WIRE CONNECTION FOR THERMOSTAT(S) PROVIDED BY MECHANICAL INSTALLER. COORDINATE WITH MECHANICAL INSTALLER FOR EXACT LOCATION AND POWER REQUIREMENTS PRIOR TO ROUGH IN. REFER TO ARCHITECTURAL INTERIOR ELEVATIONS FOR DIMENSIONED LOCATIONS OF THERMOSTATS.
- PROVIDE ONE 20A, 120V, 1P GFCI DUPLEX RECEPTACLE UNDER KITCHEN SINK FOR DISPOSAL POWER CONNECTION.
- REFER TO DETAIL 1/E1.13 FOR TYPICAL LAUNDRY ALCOVE RECEPTACLE LOCATIONS. COORDINATE INSTALLATION WITH MECHANICAL & PLUMBING CONTRACTOR.
- PROVIDE ONE 15A, RECEPTACLE CIRCUIT FROM TENANT LOAD CENTER FOR TELECOM SMART PANEL. COORDINATE WORK WITH SERVICE PROVIDER FOR EXACT LOCATION AND FINAL CONNECTION.
- CONTRACTOR TO VERIFY POWER CONNECTION TYPE FOR THE HOOD/MICROWAVE PRIOR TO ROUGH IN. PROVIDE ONE DEDICATED 20A, 1P DUPLEX RECEPTACLE LOCATED INSIDE THE CABINET OVER THE RANGE FOR APPLIANCES SUPPLIED WITH CORD & PLUG SET. HOOD/MICROWAVES THAT ARE TO BE HARDWIRED, SHALL BE PROVIDED WITH THE DEDICATED CIRCUIT GOING TO A J-BOX WHICH IS TO BE MOUNTED DIRECTLY BEHIND THE APPLIANCE.
- METER LOCATION PER UTILITY PROVIDER'S APPROVAL (PENDING). REFER TO ONE-LINE DIAGRAM ON SHEET E1.11. PROVIDE NEMA 3R LOCKING CABINET FOR HOUSE PANEL 'HP'. REFER TO SHEET E1.01 FOR METER & PANEL LOCATION(S) AT EACH BUILDING.
- 15A SWITCHED SPLIT DUPLEX RECEPTACLE. REFER TO LIGHTING PLANS (E2 SERIES SHEETS) FOR SWITCH LOCATION.

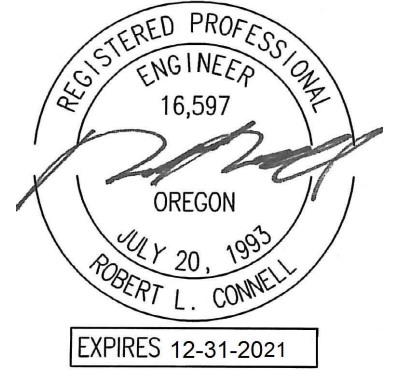

IN THE EVENT CONFLICTS ARE DISCOVERED BETWEEN THE ORIGINAL SIGNED AND SEALED DOCUMENT PREPARED BY THE ARCHITECT AND/OR THEIR CONSULTANTS, AND ANY COPY OF THE DOCUMENT TRANSMITTED BY ELECTRONIC, ELECTRONICALLY OR OTHERWISE, THE ORIGINAL SIGNED AND SEALED DOCUMENTS SHALL GOVERN.


PROJECT # 2019-179

DATE: 28 AUGUST 2020

REVISIONS

△ PLAN REVIEW 11.03.2020

△ PLAN REVIEW 03.19.2021

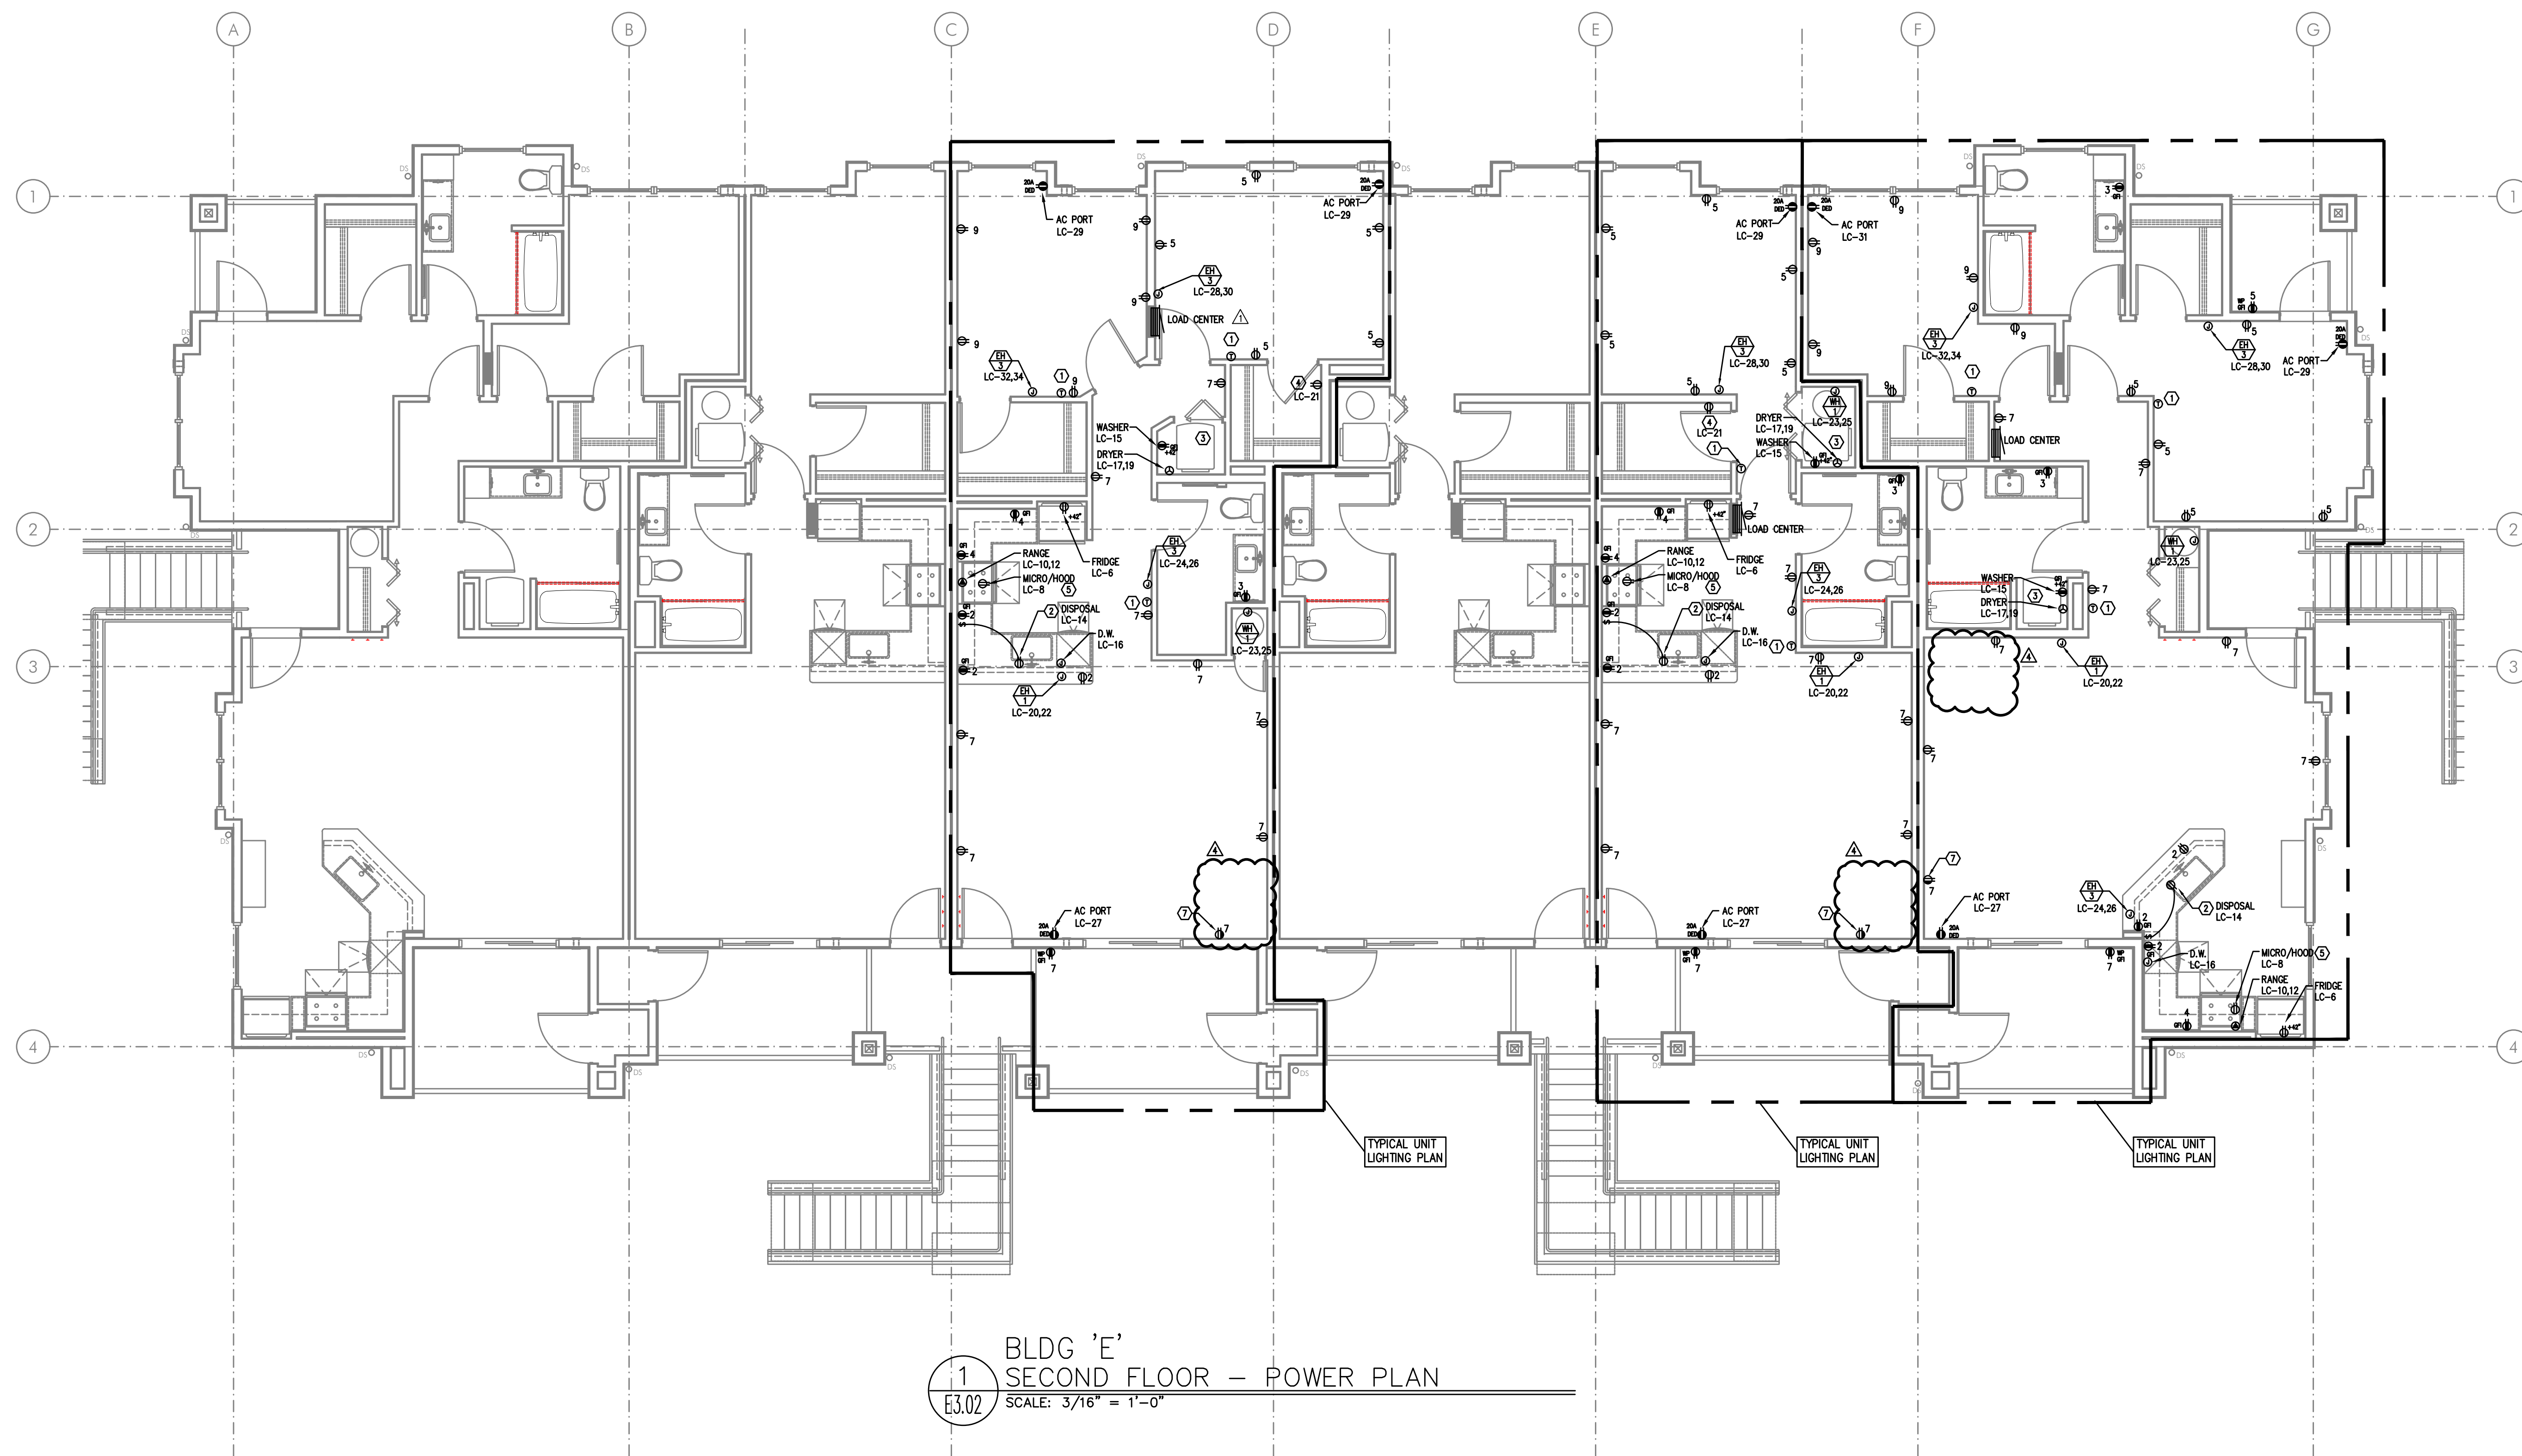


GENERAL POWER NOTES:

- ALL PLANS ARE CONSIDERED DIAGRAMMATICAL. THEREFORE ALL EQUIPMENT SIZES AND DEVICE LOCATIONS ARE APPROXIMATE AND SUBJECT TO FIELD CONDITIONS AND PRODUCT APPROVAL.
- NOT USED.
- ELECTRICAL CONTRACTOR SHALL PROVIDE INSTALLATION AND FINAL CONNECTION OF THERMOSTATS. CONSULT MECHANICAL CONTRACTOR FOR EXACT REQUIREMENTS PRIOR TO ROUGH IN.
- REFER TO INTERIOR DECORATOR AND/OR ARCHITECTURAL DRAWINGS FOR DIMENSIONED LOCATION(S) AND ELEVATIONS OF FIXTURES & DEVICES. OTHER DEVICES SHOWN ON THE ELECTRICAL PLANS AND NOT INDICATED ON THE DECORATOR'S OR ARCHITECT'S DRAWINGS, SHALL BE INSTALLED AT STANDARD MOUNTING HEIGHT AS INDICATED THE SYMBOL LIST.
- BUILDING ELECTRICAL EQUIPMENT SHOWN IS APPROXIMATE, BASED ON INDUSTRY STANDARD PRODUCTS. CONTRACTOR SHALL VERIFY ANY SUBMITTED EQUIPMENT WILL FIT WITHIN THE SPACE PROVIDED, PRIOR TO PRODUCT SUBMITTAL REVIEW.
- ELECTRICAL CONTRACTOR SHALL COORDINATE WITH THE LOW VOLTAGE ('T' SERIES) PLANS, INCLUDING FIRE ALARM AND SYSTEMS INSTALLER, AND PROVIDE ROUGH IN AS NEEDED.

KEYED POWER NOTES:

- PROVIDE WIRE CONNECTION FOR THERMOSTAT(S) PROVIDED BY MECHANICAL INSTALLER. COORDINATE WITH MECHANICAL INSTALLER FOR EXACT LOCATION AND POWER REQUIREMENTS PRIOR TO ROUGH IN. REFER TO ARCHITECTURAL INTERIOR ELEVATIONS FOR DIMENSIONED LOCATIONS OF THERMOSTATS.
- PROVIDE ONE 20A, 120V, 1P GFCI DUPLEX RECEPTACLE UNDER KITCHEN SINK FOR DISPOSAL POWER CONNECTION.
- REFER TO DETAIL 1/E1.13 FOR TYPICAL LAUNDRY ALCOVE RECEPTACLE LOCATIONS. COORDINATE INSTALLATION WITH MECHANICAL & PLUMBING CONTRACTOR.
- PROVIDE ONE 15A, RECEPTACLE CIRCUIT FROM TENANT LOAD CENTER FOR TELECOM SMART PANEL. COORDINATE WORK WITH SERVICE PROVIDER FOR EXACT LOCATION AND FINAL CONNECTION.
- CONTRACTOR TO VERIFY POWER CONNECTION TYPE FOR THE HOOD/MICROWAVE PRIOR TO ROUGH IN. PROVIDE ONE DEDICATED 20A, 1P DUPLEX RECEPTACLE LOCATED INSIDE THE CABINET OVER THE RANGE FOR APPLIANCES SUPPLIED WITH CORD & PLUG SET. HOOD/MICROWAVES THAT ARE TO BE HARDWIRED, SHALL BE PROVIDED WITH THE DEDICATED CIRCUIT GOING TO A J-BOX WHICH IS TO BE MOUNTED DIRECTLY BEHIND THE APPLIANCE.
- METER LOCATION PER UTILITY PROVIDER'S APPROVAL (PENDING). REFER TO ONE-LINE DIAGRAM ON SHEET E1.11. PROVIDE NEMA 3R LOCKING CABINET FOR HOUSE PANEL 'HP'. REFER TO SHEET E1.01 FOR METER & PANEL LOCATION(S) AT EACH BUILDING.
- 15A SWITCHED SPLIT DUPLEX RECEPTACLE. REFER TO LIGHTING PLANS (E2 SERIES SHEETS) FOR SWITCH LOCATION.

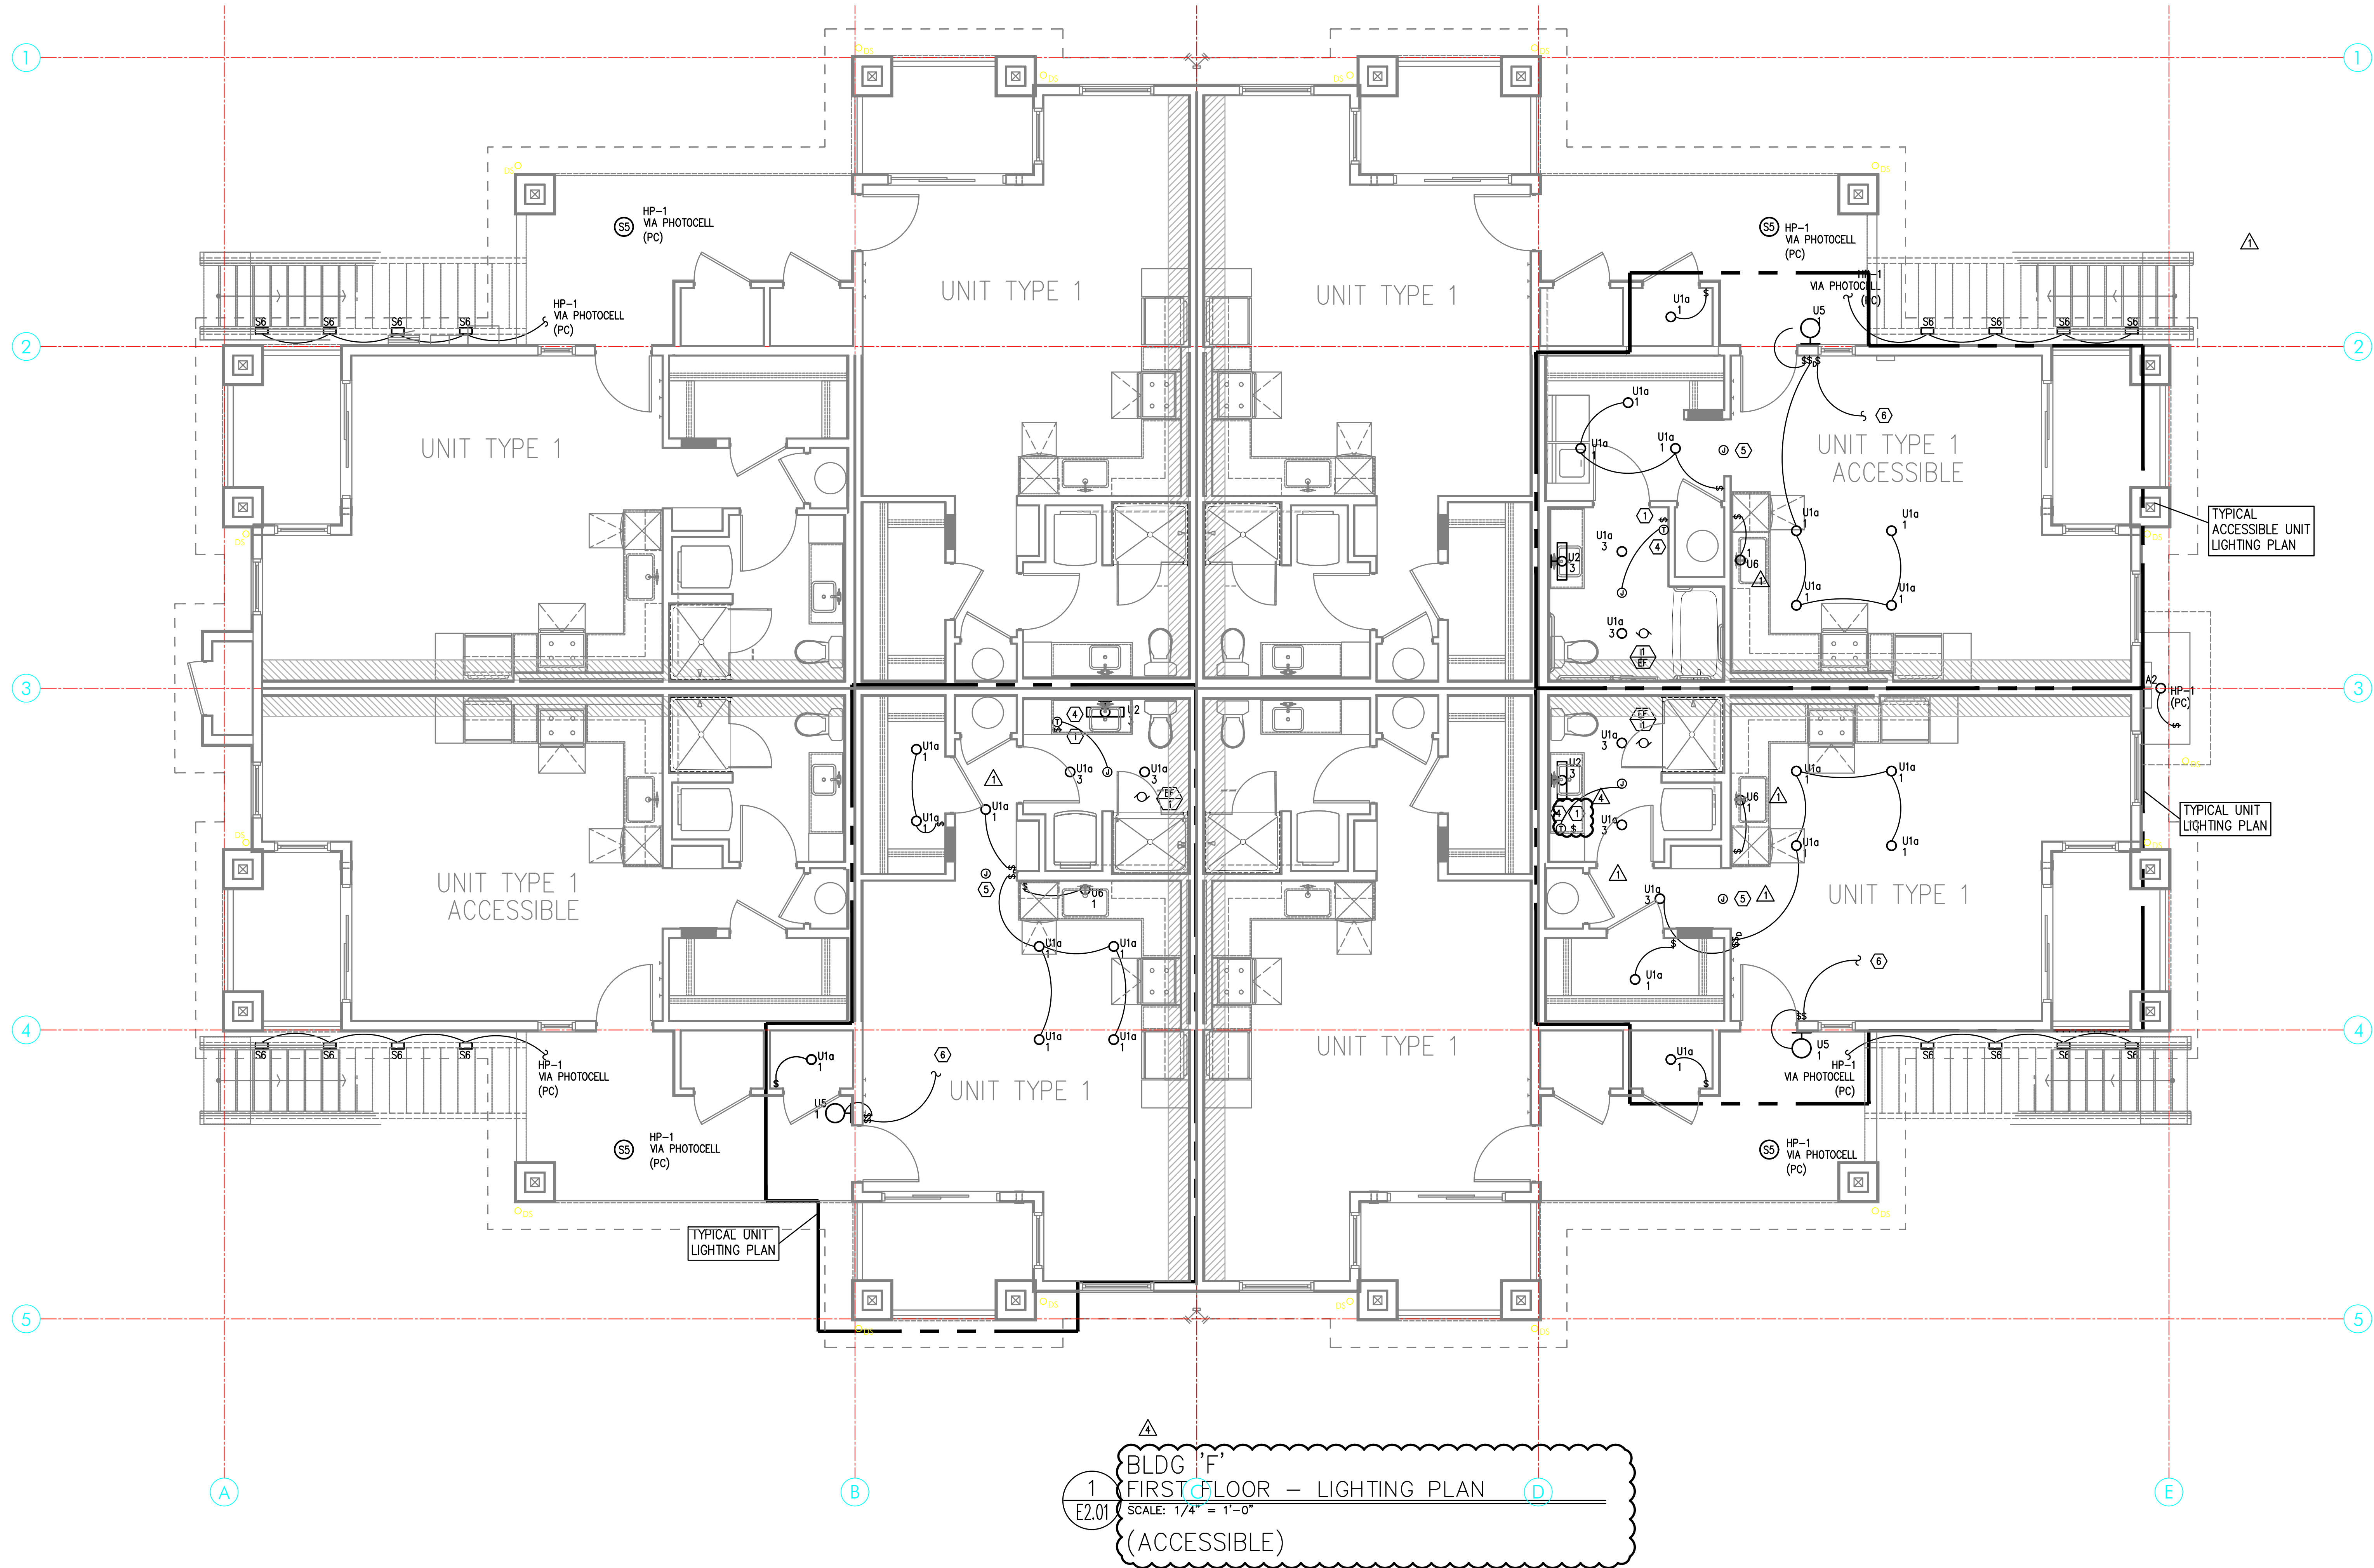


GENERAL LIGHTING NOTES:

- ELECTRICAL DRAWINGS ARE DIAGRAMMATICAL AND MAY NOT ACCURATELY REFLECT ACTUAL CONSTRUCTION CONDITIONS. THE ELECTRICAL CONTRACTOR SHALL BE RESPONSIBLE FOR COORDINATING THE INSTALLATION OF ALL ELECTRICAL EQUIPMENT, WITH ALL TRADES PRIOR TO AND DURING CONSTRUCTION.
- ALL DISCREPANCIES SHALL BE BROUGHT TO THE ATTENTION OF THE ARCHITECT IMMEDIATELY UPON DISCOVERY.
- REFER TO SHEET E1.21 FOR LIGHT FIXTURE SCHEDULES.
- THE ELECTRICAL CONTRACTOR SHALL REFER TO THE ARCHITECTURAL AND/OR INTERIORS PLAN SETS FOR DIMENSIONED LOCATIONS, MOUNTING HEIGHTS AND FINISHES OF DEVICES AND FIXTURES.
- REFER TO AVAILABLE ARCHITECTURAL AND/OR INTERIOR DESIGN DOCUMENTS & DRAWINGS FOR ADDITIONAL INFORMATION.
- EXTERIOR LIGHTING TO BE CONSTANT "ON" AND PROVIDED WITH PHOTOCELL, EITHER INTEGRAL OR REMOTE) FOR DUSK-TILL-DAWN OPERATION.
- ALL EXTERIOR BUILDING LIGHTS ON HOUSE POWER SHALL BE CONSIDERED EGRESS LIGHTING. FIXTURES ARE TO BE EQUIPPED WITH BATTERY BACK-UP (EITHER INTEGRAL OR REMOTE).
- REFER TO SHEET E1.14 FOR TYPICAL UNIT LOAD CENTER DIRECTORIES.
- ALL LIGHT SWITCHES SHALL BE ROCKER STYLE, SUCH AS LEVITON DECORA, OR APPROVED EQUAL.
- REFER TO ARCHITECTURAL REFLECTED CEILING PLANS FOR EXACT FIXTURE LOCATIONS (DIMENSIONS). CONSULT INTERIOR DESIGNER FOR MOUNTING HEIGHTS NOT SPECIFIED.
- REFER TO ARCHITECTURAL PLANS REGARDING "ACCESSIBLE" UNIT LOCATION(S), INTERIOR ELEVATIONS & DETAILS. COORDINATE INSTALLATION OF ALL DEVICES PER THE "AMERICAN DISABILITIES ACT" (ADA). REFER TO SHEET E1.21 FOR STANDARD ADA REACH REQUIREMENTS.

KEYED LIGHTING NOTES:

- REFER TO TYPICAL BATHROOM SWITCHING DETAILS ON SHEET E1.21.
- PROVIDE CEILING FAN CONTROL SWITCH(ES) AS DIRECTED BY MANUFACTURER.
- PROVIDE BLOCKING AT CEILING TO SUPPORT 35LB., MINIMUM, FOR CEILING FAN INSTALLATION.
- PROVIDE WIRE CONNECTION FOR THERMOSTAT(S) PROVIDED BY MECHANICAL INSTALLER. COORDINATE WITH MECHANICAL INSTALLER FOR EXACT LOCATION AND POWER REQUIREMENTS PRIOR TO ROUGH IN. CEILING HEATER (BY MECHANICAL) TO BE TIED INTO BATHROOM POWER CIRCUIT. REFER TO ARCHITECTURAL INTERIOR ELEVATIONS FOR DIMENSIONED LOCATIONS OF BATHROOM THERMOSTATS.
- COORDINATE LOCATION OF POWER CONNECTION FOR FIRE ALARM DEVICES WITH THE SYSTEM CONTRACTOR/INSTALLER.
- TO SWITCHED RECEPTACLE. REFER TO POWER PLANS (E3 SERIES SHEETS) FOR OUTLET LOCATION.

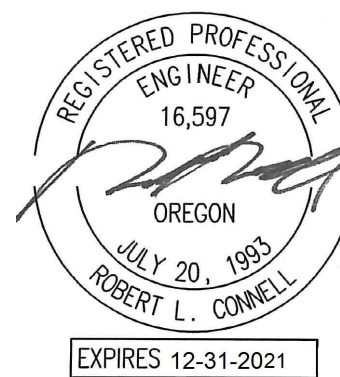


IN THE EVENT CONFLICTS ARE DISCOVERED
BETWEEN THE ORIGINAL SIGNED AND SEALED
DOCUMENT PREPARED BY THE ARCHITECT
AND/OR THEIR CONSULTANTS, AND ANY COPY OF
THE DOCUMENTS TRANSMITTED BY EMAIL, FAX,
ELECTRONICALLY OR OTHERWISE, THE ORIGINAL
SIGNED AND SEALED DOCUMENTS SHALL GOVERN.

PROJECT # 2019-179
DATE: 28 AUGUST 2020

REVISIONS

△ PLAN REVIEW 11.03.2020
△ PLAN REVIEW 03.19.2021

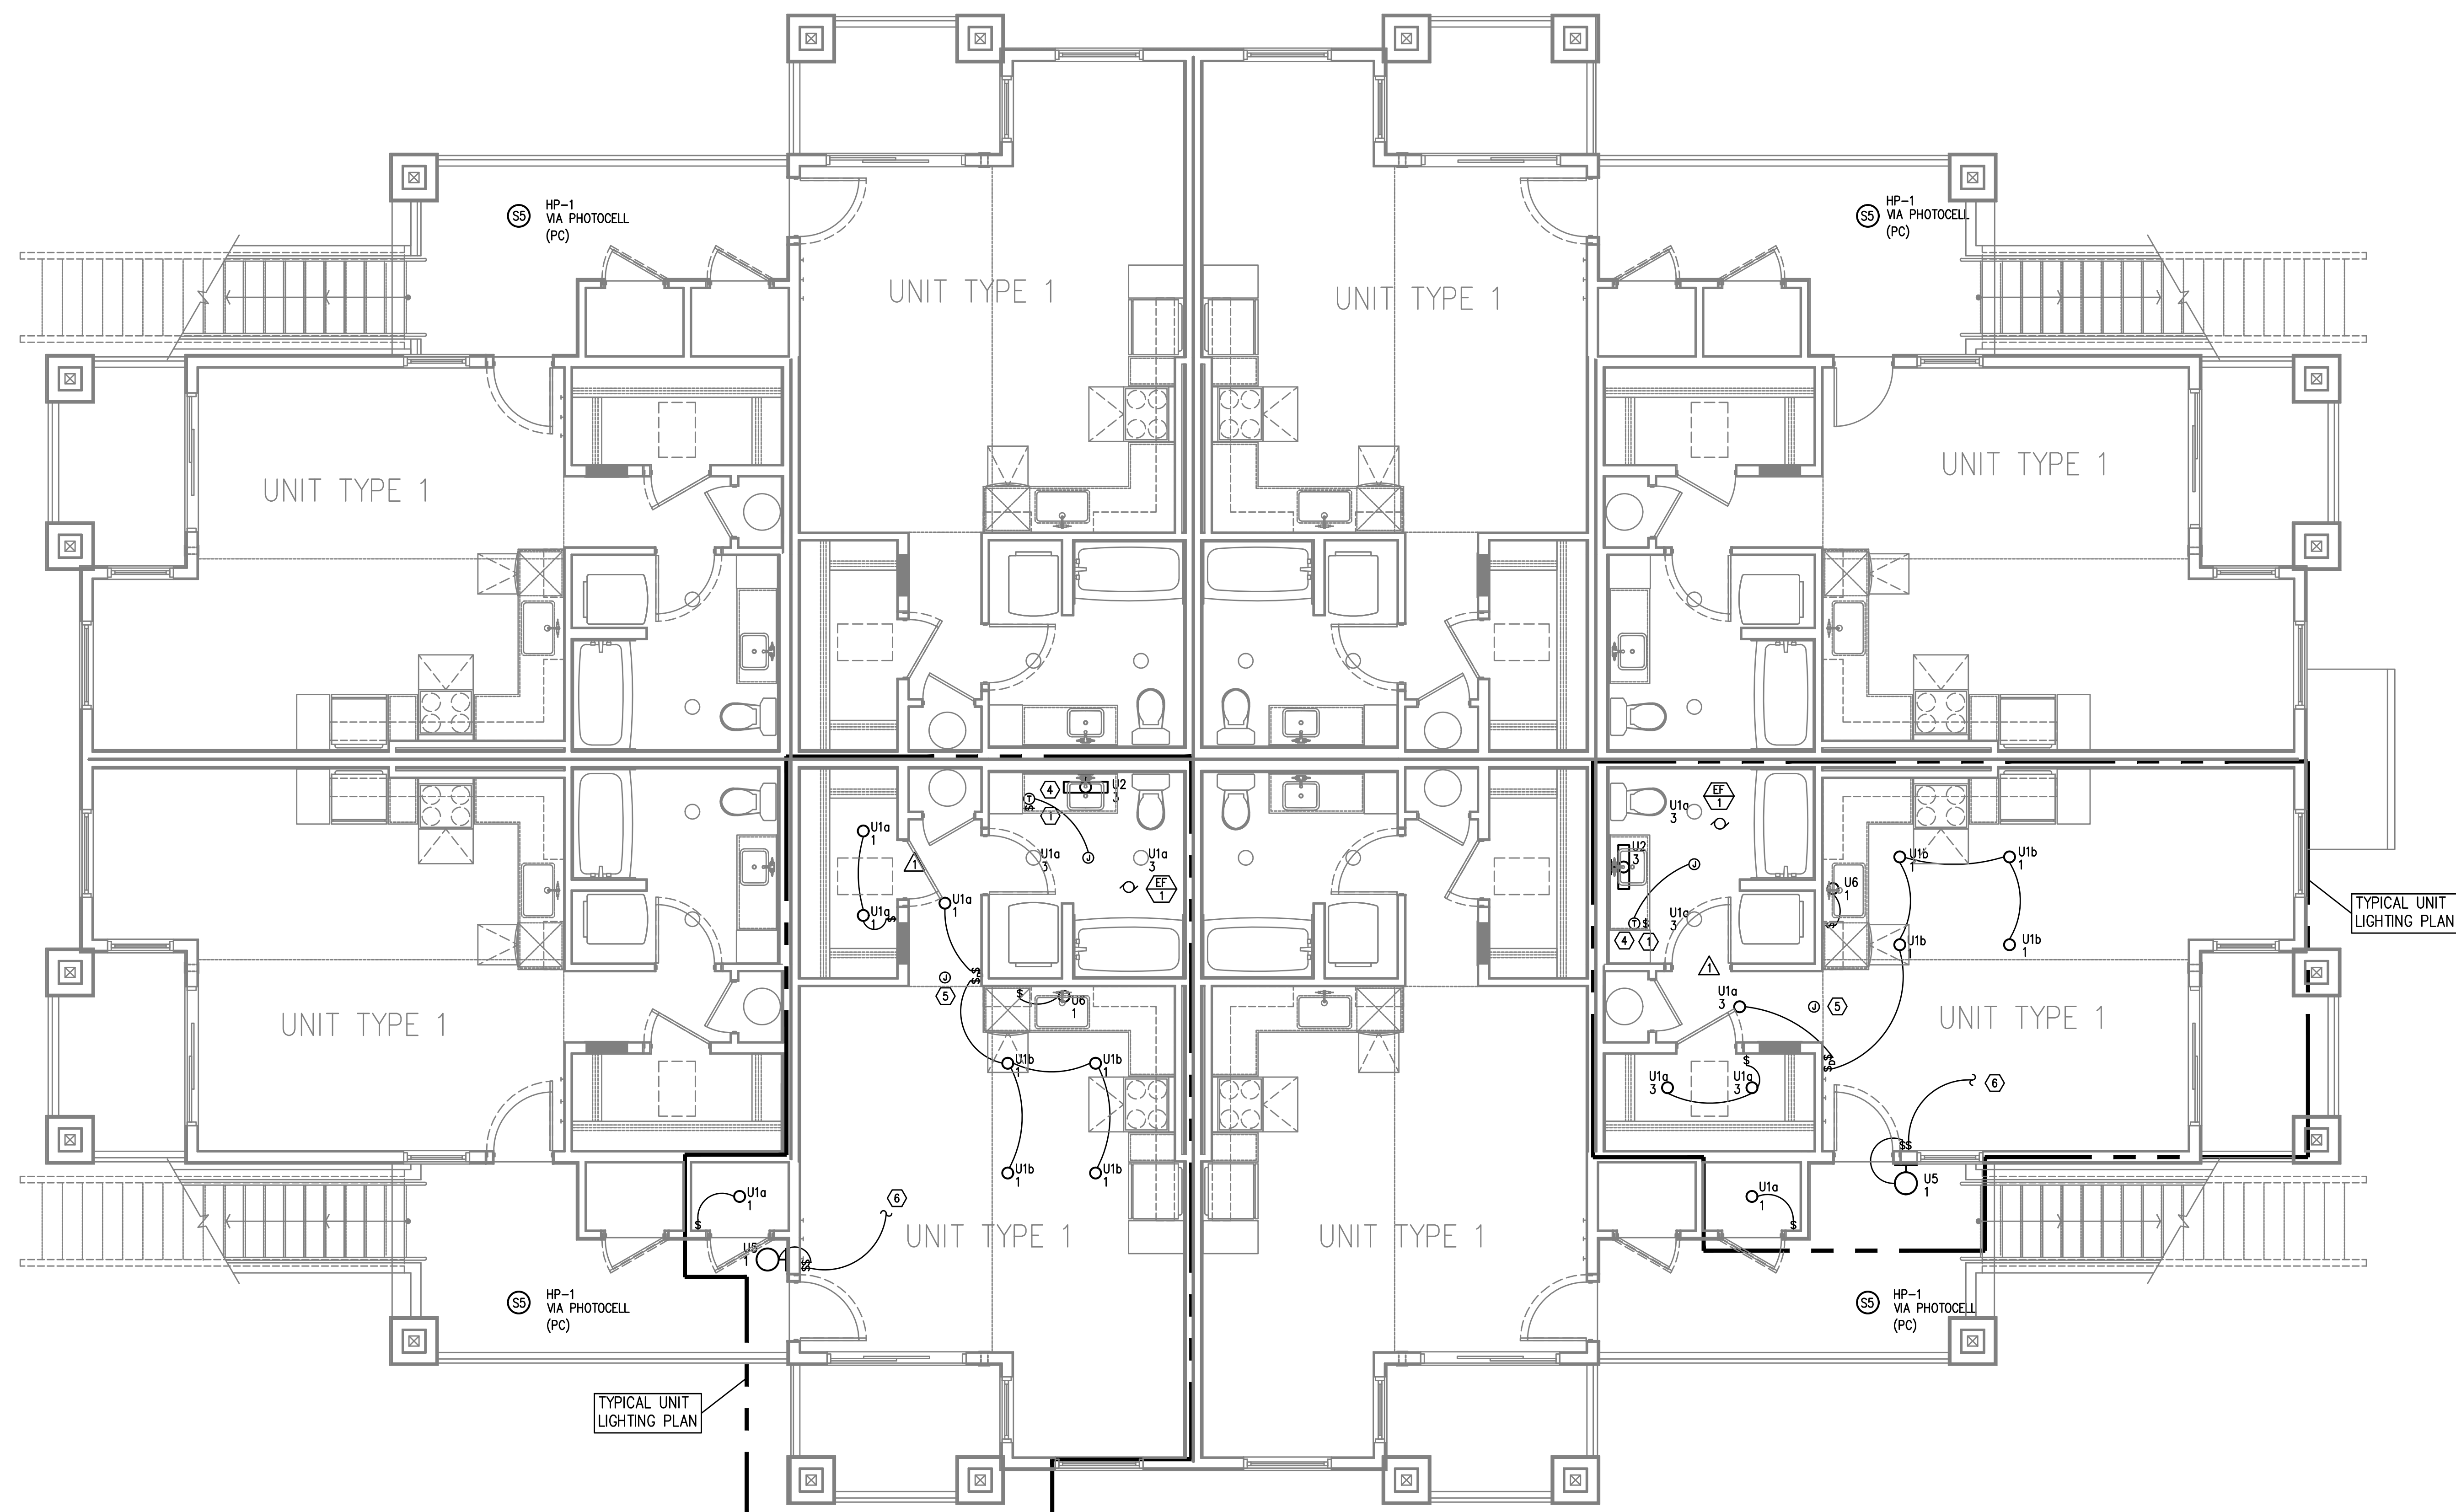

△
1
E2.02
BLDG 'F'
SECOND FLOOR - LIGHTING PLAN
SCALE: 1/4" = 1'-0"

GENERAL LIGHTING NOTES:

- ELECTRICAL DRAWINGS ARE DIAGRAMMATICAL AND MAY NOT ACCURATELY REFLECT ACTUAL CONSTRUCTION CONDITIONS. THE ELECTRICAL CONTRACTOR SHALL BE RESPONSIBLE FOR COORDINATING THE INSTALLATION OF ALL ELECTRICAL EQUIPMENT, WITH ALL TRADES PRIOR TO AND DURING CONSTRUCTION.
- △ ALL DISCREPANCIES SHALL BE BROUGHT TO THE ATTENTION OF THE ARCHITECT IMMEDIATELY UPON DISCOVERY.
- REFER TO SHEET E1.21 FOR LIGHT FIXTURE SCHEDULES.
- △ THE ELECTRICAL CONTRACTOR SHALL REFER TO THE ARCHITECTURAL AND/OR INTERIORS PLAN SETS FOR DIMENSIONED LOCATIONS, MOUNTING HEIGHTS AND FINISHES OF DEVICES AND FIXTURES.
- REFER TO AVAILABLE ARCHITECTURAL AND/OR INTERIOR DESIGN DOCUMENTS & DRAWINGS FOR ADDITIONAL INFORMATION.
- EXTERIOR LIGHTING TO BE CONSTANT "ON" AND PROVIDED WITH PHOTOCELL, EITHER INTEGRAL OR REMOTE) FOR DUSK-ILL-DAWN OPERATION.
- ALL EXTERIOR BUILDING LIGHTS ON HOUSE POWER SHALL BE CONSIDERED EGRESS LIGHTING. FIXTURES ARE TO BE EQUIPPED WITH BATTERY BACK-UP (EITHER INTEGRAL OR REMOTE).
- REFER TO SHEET E1.14 FOR TYPICAL UNIT LOAD CENTER DIRECTORIES.
- ALL LIGHT SWITCHES SHALL BE ROCKER STYLE, SUCH AS LEVITON DECORA, OR APPROVED EQUAL.
- REFER TO ARCHITECTURAL REFLECTED CEILING PLANS FOR EXACT FIXTURE LOCATIONS (DIMENSIONS). CONSULT INTERIOR DESIGNER FOR MOUNTING HEIGHTS NOT SPECIFIED.
- △ K. REFER TO ARCHITECTURAL PLANS REGARDING "ACCESSIBLE" UNIT LOCATION(S), INTERIOR ELEVATIONS & DETAILS. COORDINATE INSTALLATION OF ALL DEVICES PER THE "AMERICAN DISABILITIES ACT" (ADA). REFER TO SHEET E1.21 FOR STANDARD ADA REACH REQUIREMENTS.

○ KEYED LIGHTING NOTES:

- REFER TO TYPICAL BATHROOM SWITCHING DETAILS ON SHEET E1.21.
- PROVIDE CEILING FAN CONTROL SWITCH(ES) AS DIRECTED BY MANUFACTURER.
- PROVIDE BLOCKING AT CEILING TO SUPPORT 35LB., MINIMUM, FOR CEILING FAN INSTALLATION.
- △ PROVIDE WIRE CONNECTION FOR THERMOSTAT(S) PROVIDED BY MECHANICAL INSTALLER. COORDINATE WITH MECHANICAL INSTALLER FOR EXACT LOCATION AND POWER REQUIREMENTS PRIOR TO ROUGH IN. CEILING HEATER (BY MECHANICAL) TO BE TIED INTO BATHROOM POWER CIRCUIT. REFER TO ARCHITECTURAL INTERIOR ELEVATIONS FOR DIMENSIONED LOCATIONS OF BATHROOM THERMOSTATS.
- COORDINATE LOCATION OF POWER CONNECTION FOR FIRE ALARM DEVICES WITH THE SYSTEM CONTRACTOR/INSTALLER.
- TO SWITCHED RECEPTACLE. REFER TO POWER PLANS (E3 SERIES SHEETS) FOR OUTLET LOCATION.



IN THE EVENT CONFLICTS ARE DISCOVERED
BETWEEN THE ORIGINAL SIGNED AND SEALED
DOCUMENT PREPARED BY THE ARCHITECT
AND/OR THEIR CONSULTANTS, AND ANY COPY OF
THE DOCUMENTS TRANSMITTED BY EMAIL, FAX,
ELECTRONICALLY OR OTHERWISE, THE ORIGINAL
SIGNED AND SEALED DOCUMENTS SHALL GOVERN.

PROJECT # 2019-179
DATE: 28 AUGUST 2020


REVISIONS

PLAN REVIEW 11.03.2020
PLAN REVIEW 03.19.2021

McKINNEY LANE APARTMENTS PHASE II
RUSSELL DRIVE & MCKINNEY LANE
LEBANON, OREGON

F

E3.01

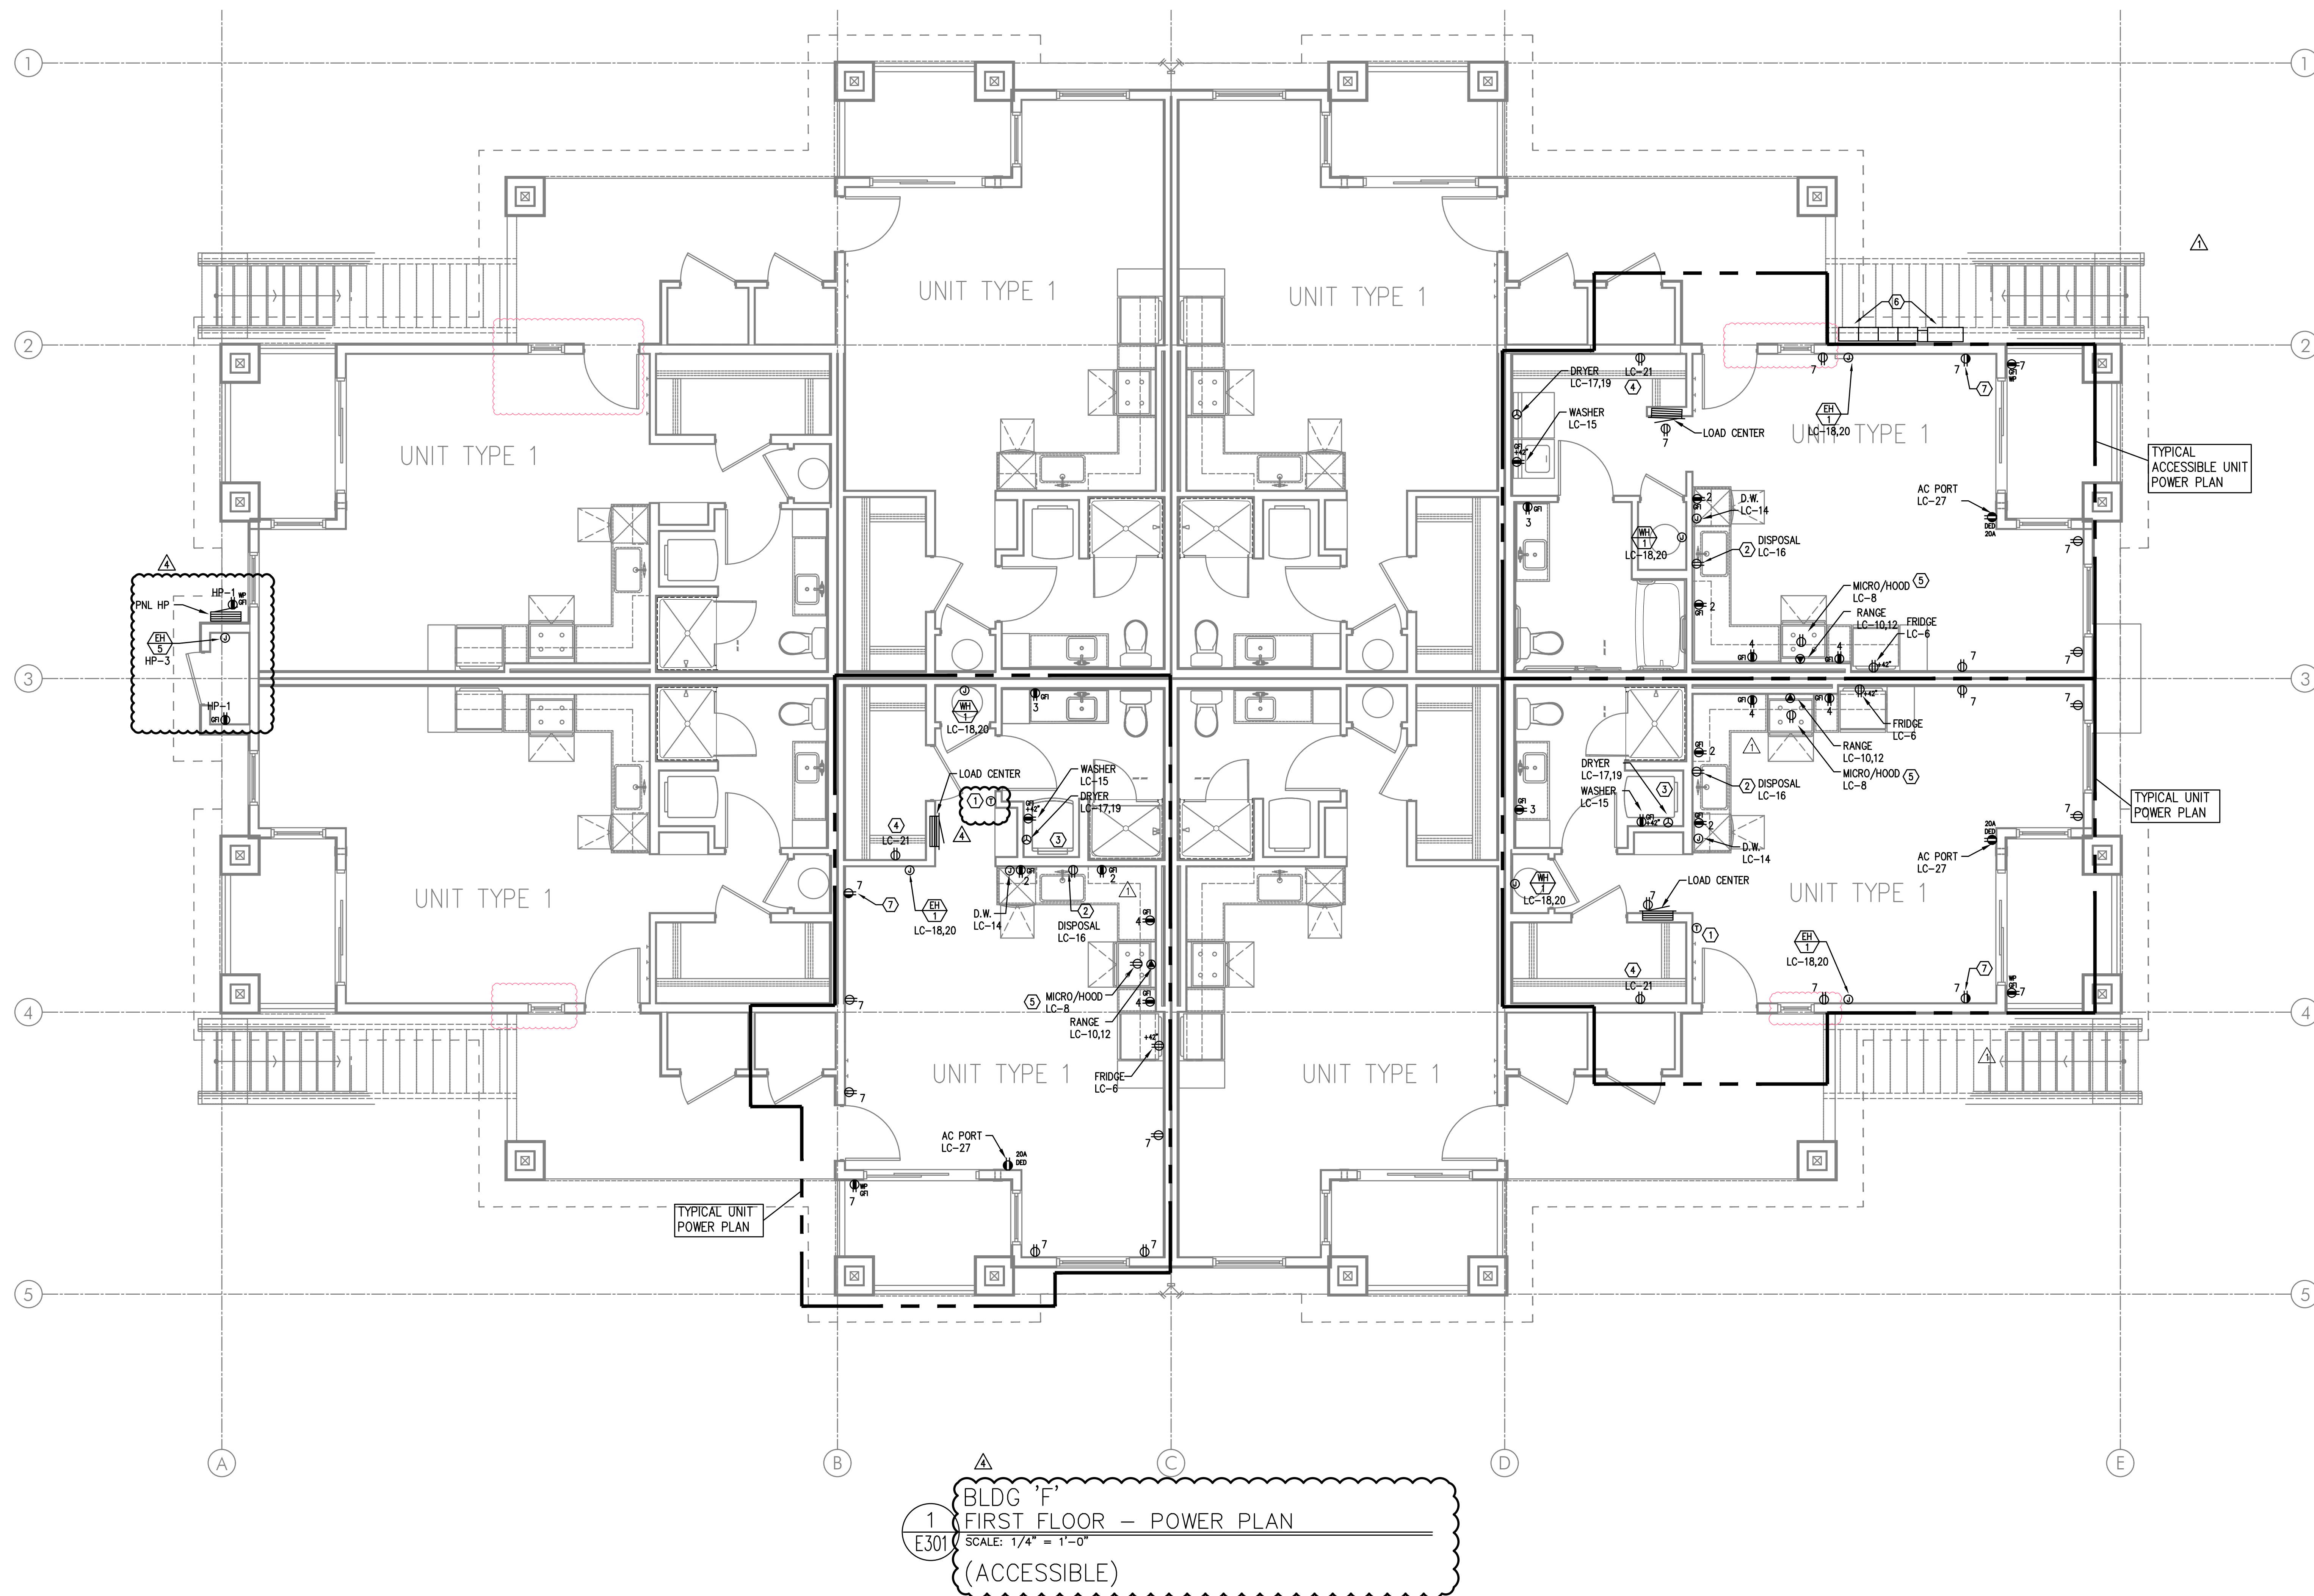

GENERAL POWER NOTES:

- A. ALL PLANS ARE CONSIDERED DIAGRAMMATICAL. THEREFORE ALL EQUIPMENT SIZES AND DEVICE LOCATIONS ARE APPROXIMATE AND SUBJECT TO FIELD CONDITIONS AND PRODUCT APPROVAL.
- B. NOT USED.
- C. ELECTRICAL CONTRACTOR SHALL PROVIDE INSTALLATION AND FINAL CONNECTION OF THERMOSTATS. CONSULT MECHANICAL CONTRACTOR FOR EXACT REQUIREMENTS PRIOR TO ROUGH IN.
- D. REFER TO INTERIOR DECORATOR AND/OR ARCHITECTURAL DRAWINGS FOR DIMENSIONED LOCATION(S) AND ELEVATIONS OF FIXTURES & DEVICES. OTHER DEVICES SHOWN ON THE ELECTRICAL PLANS AND NOT INDICATED ON THE DECORATOR'S OR ARCHITECT'S DRAWINGS, SHALL BE INSTALLED AT STANDARD MOUNTING HEIGHT AS INDICATED THE SYMBOL LIST.
- E. BUILDING ELECTRICAL EQUIPMENT SHOWN IS APPROXIMATE, BASED ON INDUSTRY STANDARD PRODUCTS. CONTRACTOR SHALL VERIFY ANY SUBMITTED EQUIPMENT WILL FIT WITHIN THE SPACE PROVIDED, PRIOR TO PRODUCT SUBMITTAL REVIEW.
- F. ELECTRICAL CONTRACTOR SHALL COORDINATE WITH THE LOW VOLTAGE ("T" SERIES) PLANS, INCLUDING FIRE ALARM AND SYSTEMS INSTALLER, AND PROVIDE ROUGH IN AS NEEDED.
- G. REFER TO ARCHITECTURAL PLANS REGARDING "ACCESSIBLE" UNIT LOCATION(S), INTERIOR ELEVATIONS & DETAILS. COORDINATE INSTALLATION OF ALL DEVICES PER THE "AMERICAN DISABILITIES ACT" (ADA). REFER TO SHEET E1.21 FOR STANDARD ADA REACH REQUIREMENTS.

KEYED POWER NOTES:

1. PROVIDE WIRE CONNECTION FOR THERMOSTAT(S) PROVIDED BY MECHANICAL INSTALLER. COORDINATE WITH MECHANICAL INSTALLER FOR EXACT LOCATION AND POWER REQUIREMENTS PRIOR TO ROUGH IN. REFER TO ARCHITECTURAL INTERIOR ELEVATIONS FOR DIMENSIONED LOCATIONS OF THERMOSTATS.
2. PROVIDE ONE 20A, 120V, 1P SPLIT DUPLEX RECEPTACLE UNDER KITCHEN SINK FOR DISPOSAL. POWER CONNECTION.
3. REFER TO DETAIL 1/E1.13 FOR TYPICAL LAUNDRY ALCOVE RECEPTACLE LOCATIONS. COORDINATE INSTALLATION WITH MECHANICAL & PLUMBING CONTRACTOR.
4. PROVIDE ONE 15A, RECEPTACLE CIRCUIT FROM TENANT LOAD CENTER FOR TELECOM SMART PANEL. COORDINATE WORK WITH SERVICE PROVIDER FOR EXACT LOCATION AND FINAL CONNECTION.
5. CONTRACTOR TO VERIFY POWER CONNECTION TYPE FOR THE HOOD/MICROWAVE PRIOR TO ROUGH IN. PROVIDE ONE DEDICATED 20A, 1P DUPLEX RECEPTACLE LOCATED INSIDE THE CABINET OVER THE RANGE FOR APPLIANCE SUPPLIED WITH CORD & PLUG SET. HOOD/MICROWAVES THAT ARE TO BE HARDWIRED, SHALL BE PROVIDED WITH THE DEDICATED CIRCUIT GOING TO A J-BOX WHICH IS TO BE MOUNTED DIRECTLY BEHIND THE APPLIANCE.
6. METER LOCATION PER UTILITY PROVIDER'S APPROVAL (PENDING). REFER TO ONE-LINE DIAGRAM ON SHEET E1.11. PROVIDE NEMA 3R LOCKING CABINET FOR HOUSE PANEL "HP". REFER TO SHEET E1.01 FOR METER & PANEL LOCATION(S) AT EACH BUILDING.
7. 15A SWITCHED SPLIT DUPLEX RECEPTACLE. REFER TO LIGHTING PLANS (E2 SERIES SHEETS) FOR SWITCH LOCATION.




IN THE EVENT CONFLICTS ARE DISCOVERED
BETWEEN THE ORIGINAL SIGNED AND SEALED
DOCUMENTS PREPARED BY THE ARCHITECT
AND/OR THEIR CONSULTANTS, AND ANY COPY OF
THE DOCUMENTS TRANSMITTED BY EMAIL, FAX,
ELECTRONICALLY OR OTHERWISE, THE ORIGINAL
SIGNED AND SEALED DOCUMENTS SHALL GOVERN.

PROJECT # 2019-179
DATE: 28 AUGUST 2020

REVISIONS

PLAN REVIEW 11.03.2020
PLAN REVIEW 03.19.2021

MCKINNEY LANE APARTMENTS PHASE II
RUSSELL DRIVE & MCKINNEY LANE
LEBANON, OREGON

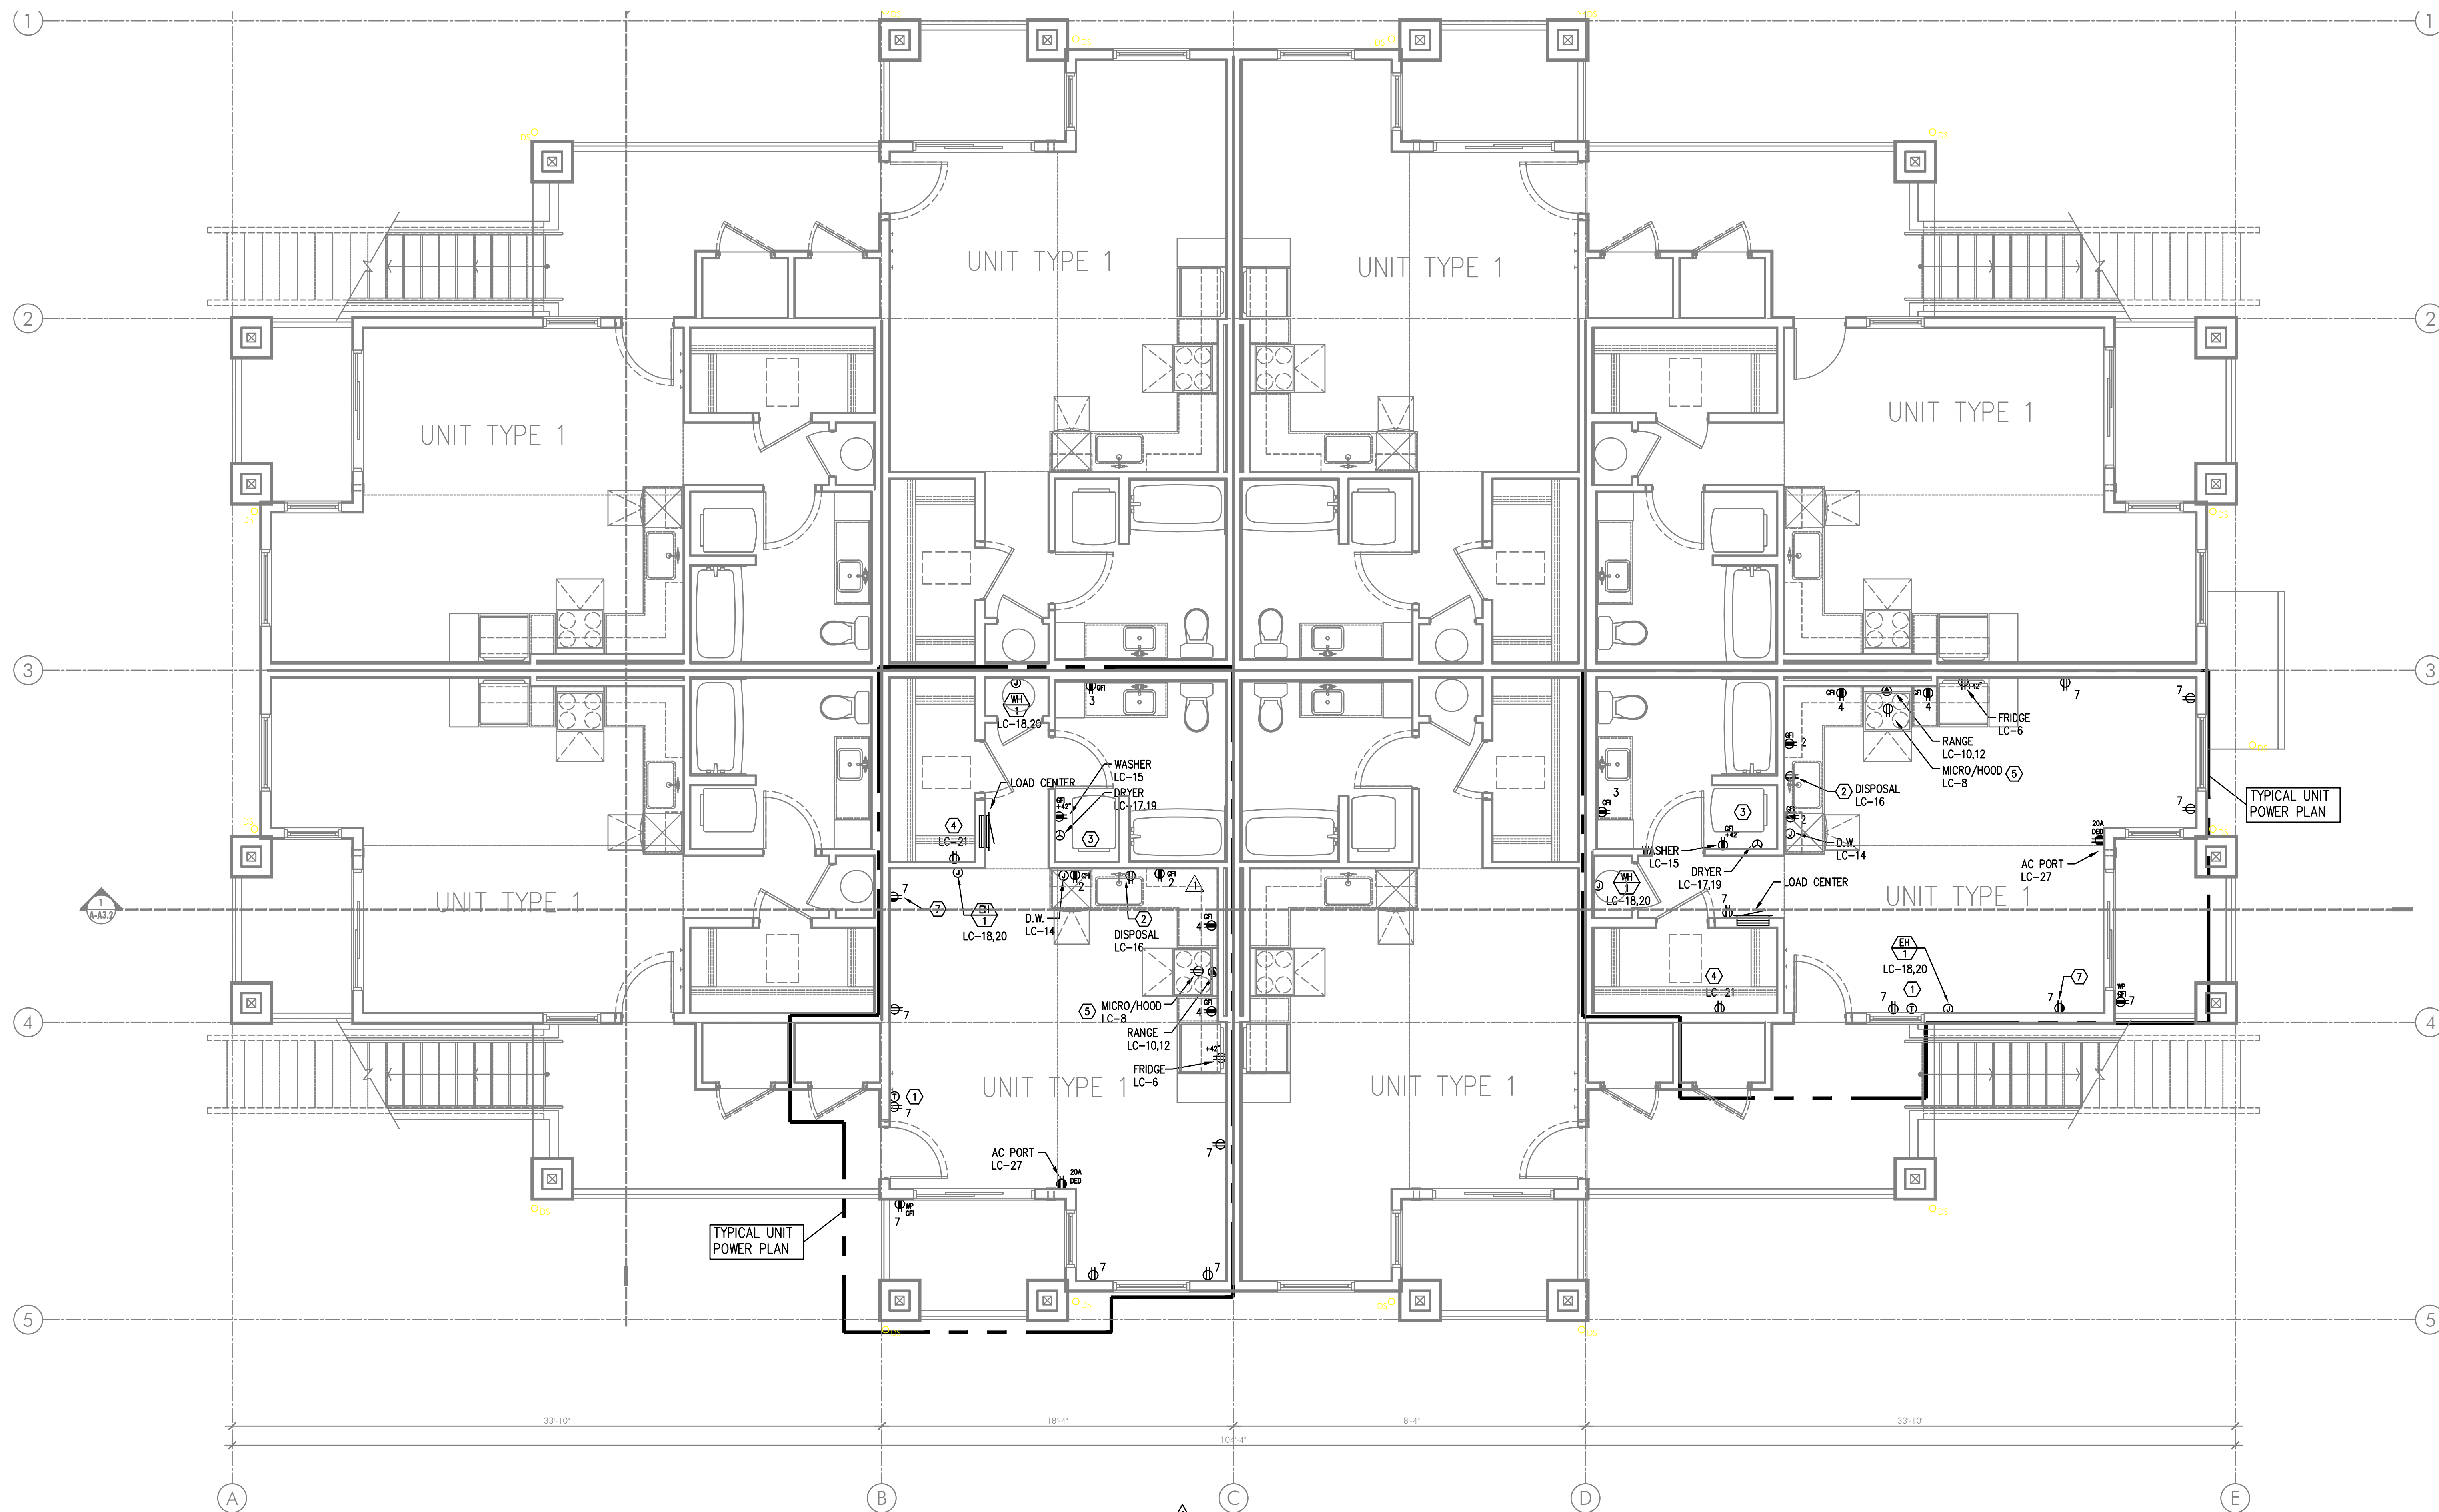


BLDG 'F'
1 SECOND FLOOR - POWER PLAN
E302 SCALE: 1/4" = 1'-0"

GENERAL POWER NOTES:

- ALL PLANS ARE CONSIDERED DIAGRAMMATICAL. THEREFORE ALL EQUIPMENT SIZES AND DEVICE LOCATIONS ARE APPROXIMATE AND SUBJECT TO FIELD CONDITIONS AND PRODUCT APPROVAL.
- NOT USED.
- ELECTRICAL CONTRACTOR SHALL PROVIDE INSTALLATION AND FINAL CONNECTION OF THERMOSTATS. CONSULT MECHANICAL CONTRACTOR FOR EXACT REQUIREMENTS PRIOR TO ROUGH IN.
- REFER TO INTERIOR DECORATOR AND/OR ARCHITECTURAL DRAWINGS FOR DIMENSIONED LOCATION(S) AND ELEVATIONS OF FIXTURES & DEVICES. OTHER DEVICES SHOWN ON THE ELECTRICAL PLANS AND NOT INDICATED ON THE DECORATOR'S OR ARCHITECT'S DRAWINGS, SHALL BE INSTALLED AT STANDARD MOUNTING HEIGHT AS INDICATED THE SYMBOL LIST.
- BUILDING ELECTRICAL EQUIPMENT SHOWN IS APPROXIMATE, BASED ON INDUSTRY STANDARD PRODUCTS. CONTRACTOR SHALL VERIFY ANY SUBMITTED EQUIPMENT WILL FIT WITHIN THE SPACE PROVIDED, PRIOR TO PRODUCT SUBMITTAL REVIEW.
- ELECTRICAL CONTRACTOR SHALL COORDINATE WITH THE LOW VOLTAGE ("T" SERIES) PLANS, INCLUDING FIRE ALARM AND SYSTEMS INSTALLER, AND PROVIDE ROUGH IN AS NEEDED.
- REFER TO ARCHITECTURAL PLANS REGARDING "ACCESSIBLE" UNIT LOCATION(S), INTERIOR ELEVATIONS & DETAILS. COORDINATE INSTALLATION OF ALL DEVICES PER THE "AMERICAN DISABILITIES ACT" (ADA). REFER TO SHEET E1.21 FOR STANDARD ADA REACH REQUIREMENTS.

KEYED POWER NOTES:

- PROVIDE WIRE CONNECTION FOR THERMOSTAT(S) PROVIDED BY MECHANICAL INSTALLER. COORDINATE WITH MECHANICAL INSTALLER FOR EXACT LOCATION AND POWER REQUIREMENTS PRIOR TO ROUGH IN. REFER TO ARCHITECTURAL INTERIOR ELEVATIONS FOR DIMENSIONED LOCATIONS OF THERMOSTATS.
- PROVIDE ONE 20A, 120V, 1P GFCI DUPLEX RECEPTACLE UNDER KITCHEN SINK FOR DISPOSAL POWER CONNECTION.
- REFER TO DETAIL 1/E1.13 FOR TYPICAL LAUNDRY ALCOVE RECEPTACLE LOCATIONS. COORDINATE INSTALLATION WITH MECHANICAL & PLUMBING CONTRACTOR.
- PROVIDE ONE 15A, RECEPTACLE CIRCUIT FROM TENANT LOAD CENTER FOR TELECOM SMART PANEL. COORDINATE WORK WITH SERVICE PROVIDER FOR EXACT LOCATION AND FINAL CONNECTION.
- CONTRACTOR TO VERIFY POWER CONNECTION TYPE FOR THE HOOD/MICROWAVE PRIOR TO ROUGH IN. PROVIDE ONE DEDICATED 20A, 1P DUPLEX RECEPTACLE LOCATED INSIDE THE CABINET OVER THE RANGE FOR APPLIANCES SUPPLIED WITH CORD & PLUG SET. HOOD/MICROWAVES THAT ARE TO BE HARDWIRED, SHALL BE PROVIDED WITH THE DEDICATED CIRCUIT GOING TO A J-BOX WHICH IS TO BE MOUNTED DIRECTLY BEHIND THE APPLIANCE.
- METER LOCATION PER UTILITY PROVIDER'S APPROVAL (PENDING). REFER TO ONE-LINE DIAGRAM ON SHEET E1.11. PROVIDE NEMA 3R LOCKING CABINET FOR HOUSE PANEL "HP". REFER TO SHEET E1.01 FOR METER & PANEL LOCATION(S) AT EACH BUILDING.
- 15A SWITCHED SPLIT DUPLEX RECEPTACLE. REFER TO LIGHTING PLANS (E2 SERIES SHEETS) FOR SWITCH LOCATION.

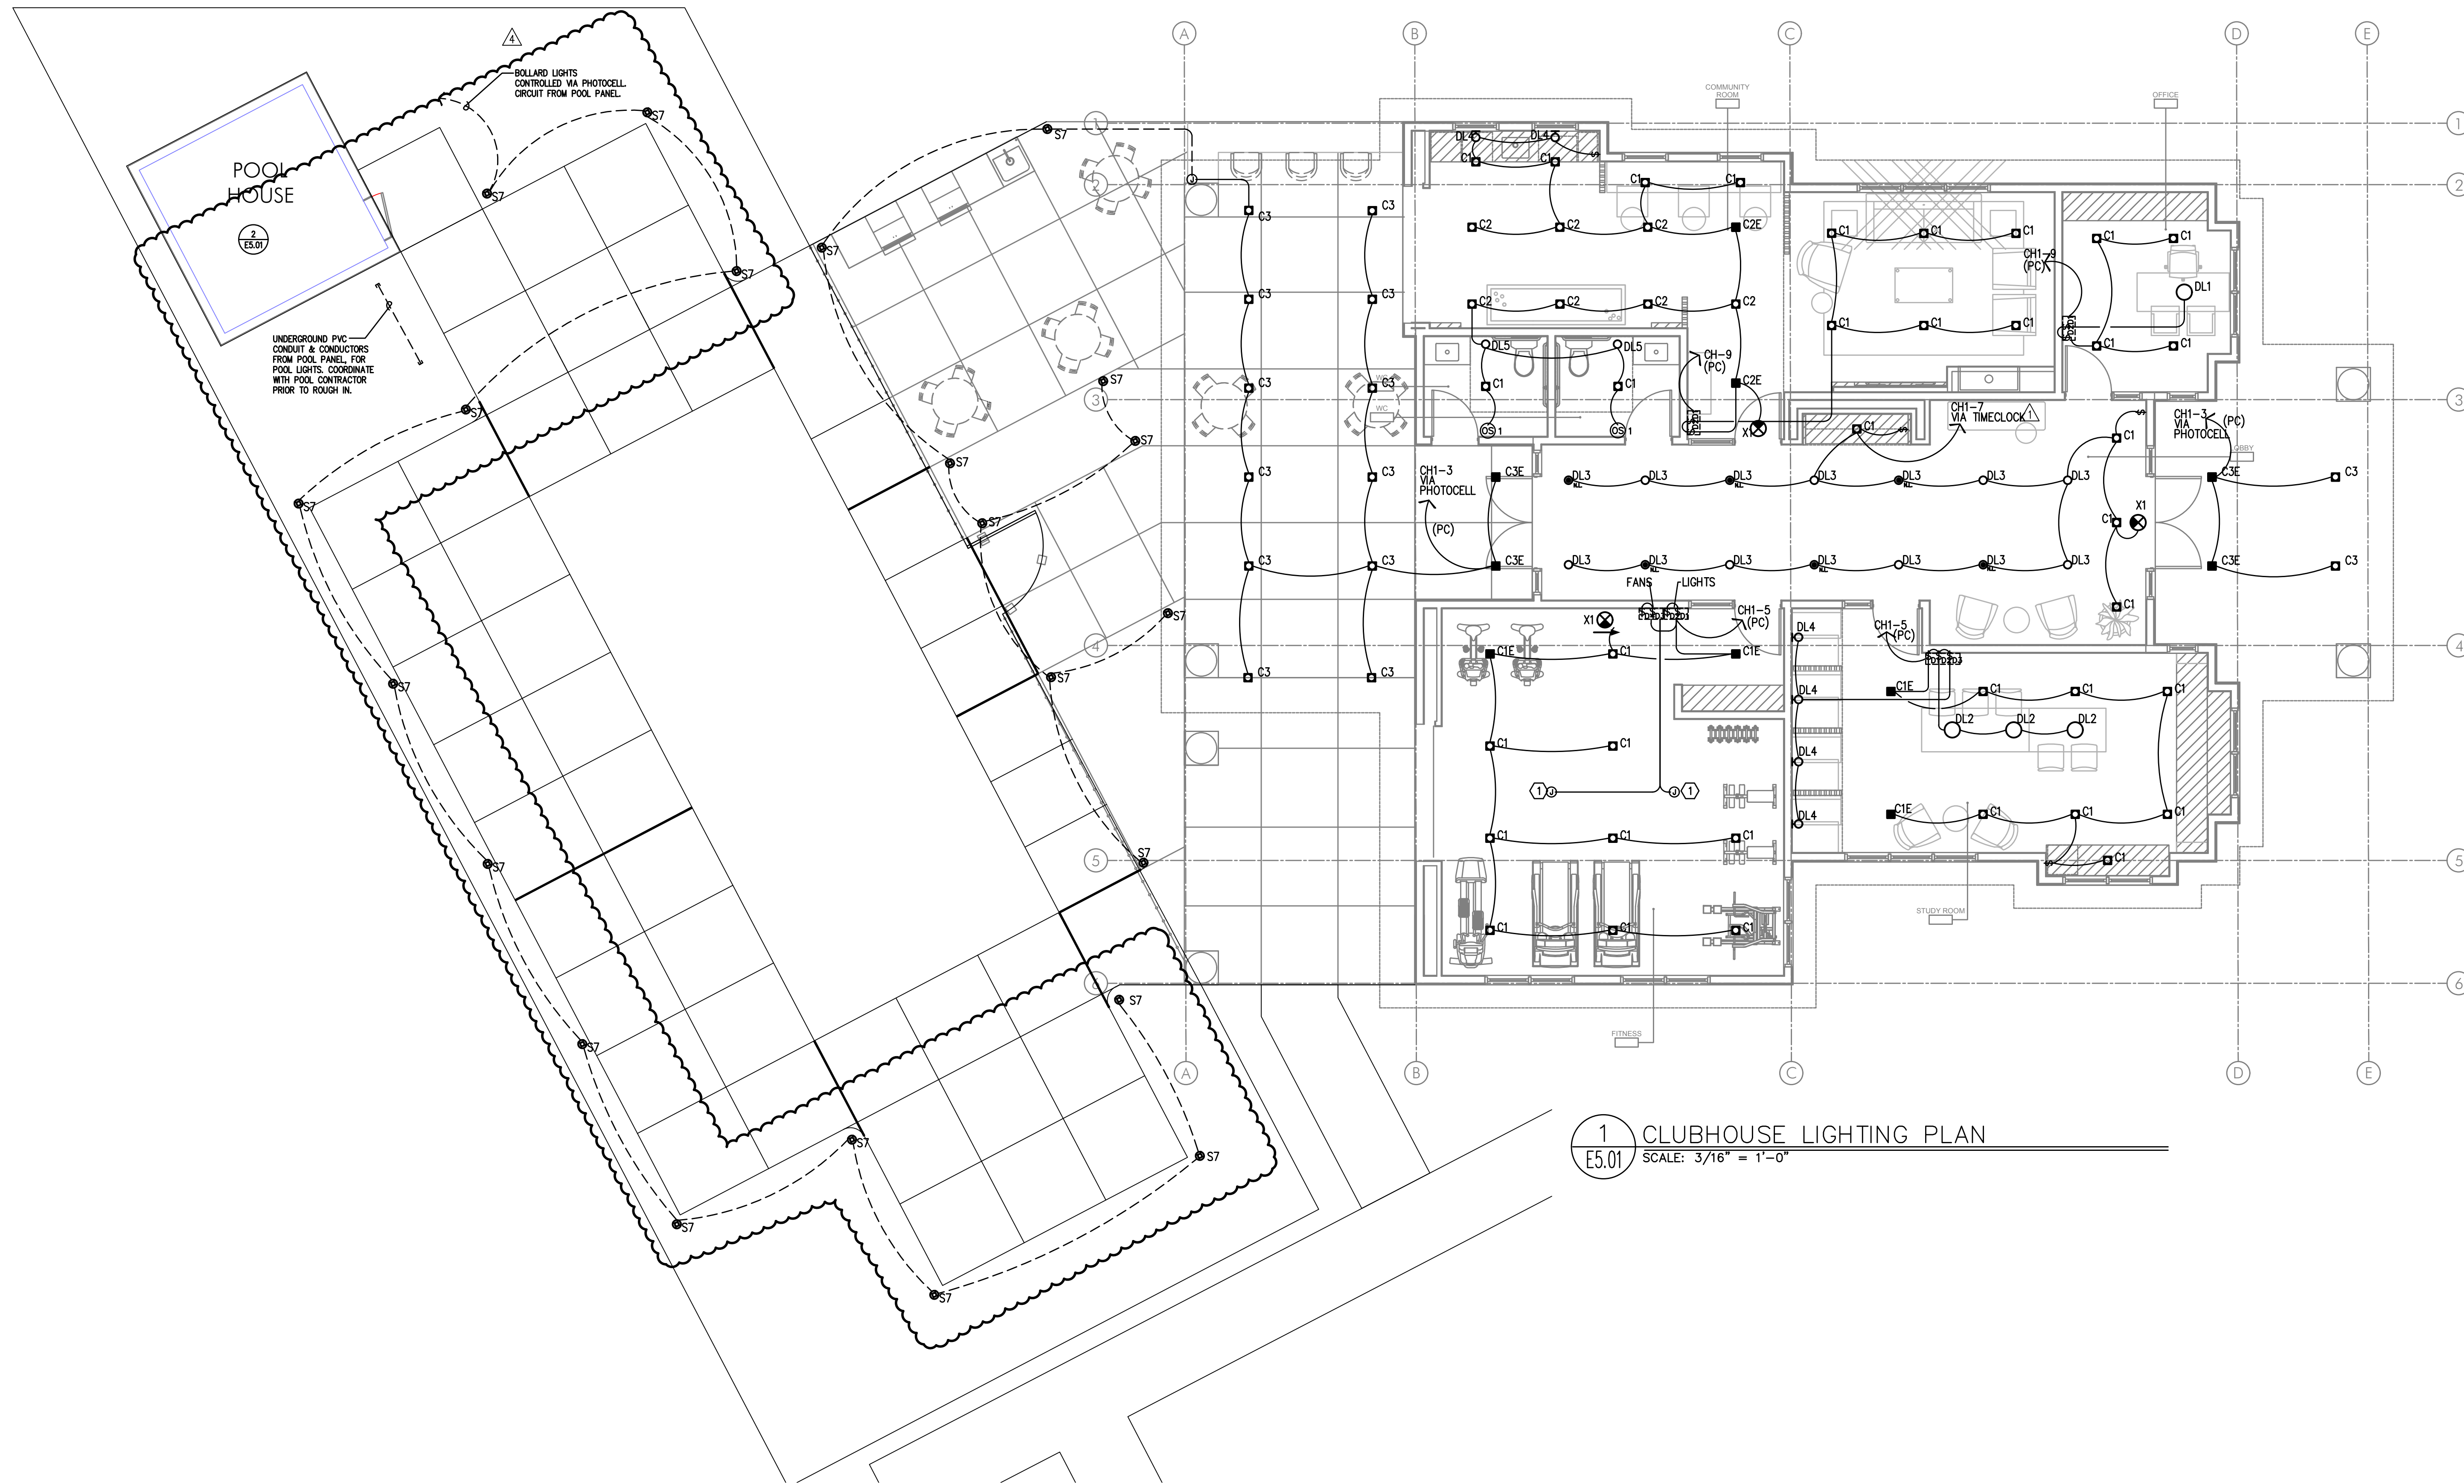

1 CLUBHOUSE LIGHTING PLAN
E5.01 SCALE: 3/16" = 1'-0"

GENERAL LIGHTING NOTES:


- ELECTRICAL DRAWINGS ARE DIAGRAMMATICAL AND MAY NOT ACCURATELY REFLECT ACTUAL CONSTRUCTION CONDITIONS. THE ELECTRICAL CONTRACTOR SHALL BE RESPONSIBLE FOR COORDINATING THE INSTALLATION OF ALL ELECTRICAL EQUIPMENT, WITH ALL TRADES PRIOR TO AND DURING CONSTRUCTION.
- THE ELECTRICAL CONTRACTOR SHALL REFER TO THE ARCHITECTURAL DRAWINGS FOR ALL MOUNTING HEIGHTS AND FINISHES OF DEVICES AND FIXTURES.
- REFER TO SHEET E1.21 FOR LIGHT FIXTURE SCHEDULES.
- THE CONTRACTOR SHALL CONSULT THE ARCHITECT AND/OR INTERIOR DESIGNER FOR THE EXACT LOCATION OF ALL LIGHT FIXTURES PRIOR TO THE START OF ANY ROUGH IN WORK.
- REFER TO AVAILABLE ARCHITECTURAL AND/OR INTERIOR DESIGN DOCUMENTS & DRAWINGS FOR ADDITIONAL INFORMATION.
- OCCUPANCY SENSORS SHALL BE FIELD ADJUSTED TO ENSURE COVERAGE AND PROPER CONTROL.
- ALL EGRESS FIXTURES SHALL BE WIRED SUCH THAT IN THE EVENT OF A POWER FAILURE, ALL LIGHTS WILL AUTOMATICALLY RETURN TO FULL POWER. REFER TO SWITCHING DETAILS ON SHEET E1.22.
- EXTERIOR BUILDING LIGHTS TO BE CONTROLLED VIA INTEGRAL AND/OR REMOTE PHOTOCELL FOR DUSK-TIL-DAWN OPERATION. REFER TO LIGHT FIXTURE SCHEDULE ON SHEET E1.21 FOR ADDITIONAL INFORMATION.
- ALL LIGHT FIXTURES DESIGNATED AS NIGHT LIGHTS (NL) SHALL BE CIRCUITED VIA TIME CLOCK TO AUTOMATICALLY TURN ON DURING PERIODS OF LOW ACTIVITY.
- COORDINATE WITH LANDSCAPE CONTRACTOR TO PROVIDE POWER FOR BOLLARD LIGHTS TO BE INSTALLED IN THE POOL AREA. POWER SOURCE SHALL BE FROM THE POOL BRANCH PANEL ONCE INSTALLED. CONSULT WITH LANDSCAPE CONTRACTOR REGARDING LOCATION(S) AND ROUTE EMPTY CONDUIT(S) WITH PULL STRING & CAPPED AT BOTH ENDS AS REQUIRED.

KEYED NOTES:


- CONTRACTOR TO PROVIDE BLOCKING ABOVE THE CEILING TO SUPPORT A MINIMUM OF 35LBS. FOR CEILING FANS. FANS ARE TO BE PROVIDED BY OTHERS AND INSTALLED BY ELECTRICAL CONTRACTOR.

POOL LIGHTING NOTES:

- LIGHT FIXTURES TO BE CIRCUITED TO THE BRANCH PANEL LOCATED IN THE POOL HOUSE.
- EXTERIOR LIGHTS TO BE CONTROLLED VIA PHOTOCELL OR TIME CLOCK PER OWNER'S PREFERENCE.
- ELECTRICAL CONTRACTOR TO PROVIDE UNDERGROUND CONDUIT WITH PULL STRING PER POOL CONTRACTOR'S REQUIREMENTS, FROM POOL HOUSE BRANCH PANEL FOR POOL LIGHTS.
- CONSULT POOL CONTRACTOR AND POOL PLAN SET FOR ADDITIONAL INFORMATION VERIFY EXACT ELECTRICAL REQUIREMENTS AND ROUTING, PRIOR TO THE START OF ANY WORK.
- ELECTRICAL CONTRACTOR TO INCLUDE "AS-CONSTRUCTED" INFORMATION ON CLOSE OUT DOCUMENTS AT THE END OF THE PROJECT.

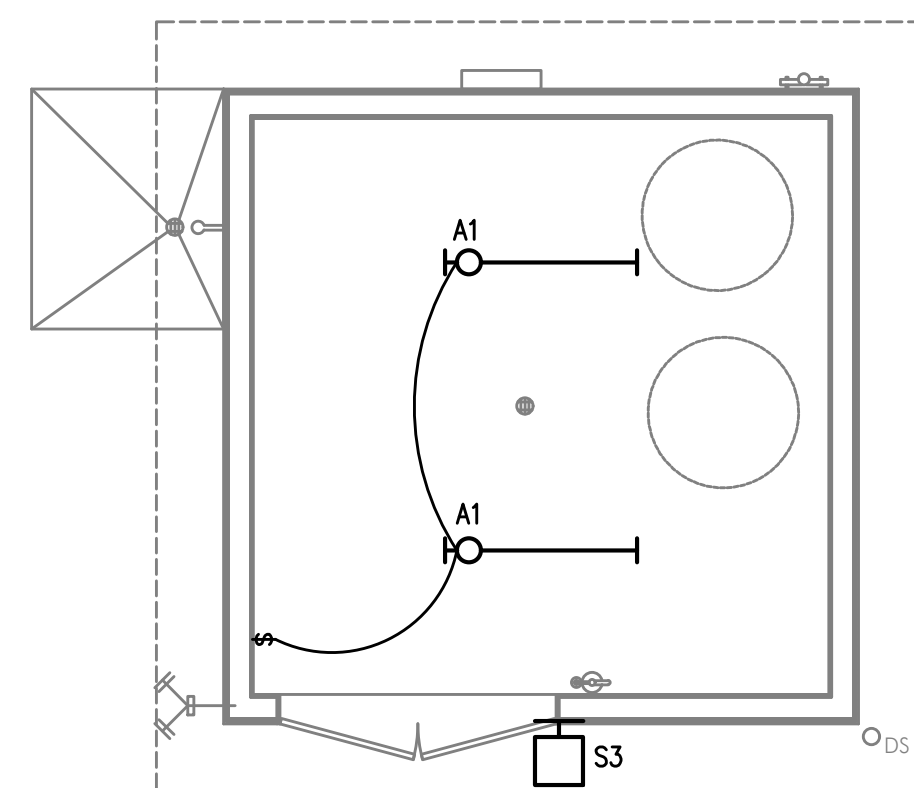

2 POOL HOUSE LIGHTING PLAN
E5.01 SCALE: 1/4" = 1'-0"

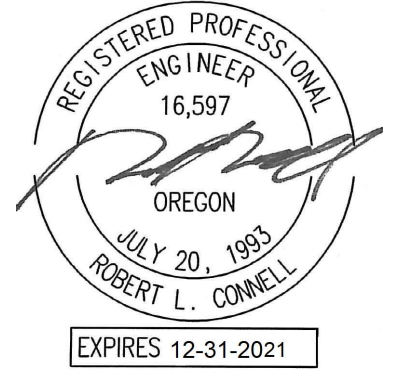

IN THE EVENT CONFLICTS ARE DISCOVERED BETWEEN THE ORIGINAL SIGNED AND SEALED DOCUMENTS PREPARED BY THE ARCHITECTS AND/OR THEIR CONSULTANTS, AND ANY COPY OF THE DOCUMENTS TRANSMITTED BY EMAIL, ELECTRONICALLY OR OTHERWISE, THE ORIGINAL SIGNED AND SEALED DOCUMENTS SHALL GOVERN.

PROJECT # 2019-179

DATE: 28 AUGUST 2020

REVISIONS

PLAN REVIEW 11.03.2020

PLAN REVIEW 03.19.2021

MCKINNEY LANE APARTMENTS PHASE II
RUSSELL DRIVE & MCKINNEY LANE
LEBANON, OREGON

GENERAL POWER NOTES:

- ELECTRICAL DRAWINGS ARE DIAGRAMMATICAL AND MAY NOT ACCURATELY REFLECT ACTUAL CONSTRUCTION CONDITIONS. THE ELECTRICAL CONTRACTOR SHALL BE RESPONSIBLE FOR COORDINATING THE INSTALLATION OF ALL ELECTRICAL EQUIPMENT, WITH ALL TRADES PRIOR TO AND DURING CONSTRUCTION.
- THE ELECTRICAL CONTRACTOR SHALL REFER TO THE ARCHITECTURAL AND/OR INTERIOR DESIGNER DRAWINGS FOR ALL MOUNTING HEIGHTS AND FINISHES OF DEVICES AND FIXTURES.
- REFER TO SHEET E1.11 FOR ELECTRICAL ONE-LINE DIAGRAM.
- THE CONTRACTOR SHALL CONSULT THE ARCHITECT AND/OR INTERIOR DESIGNER FOR THE EXACT LOCATION OF ALL AMENITY EQUIPMENT & APPLIANCES PRIOR TO THE START OF ANY ROUGH IN WORK.
- REFER TO AVAILABLE ARCHITECTURAL AND/OR INTERIOR DESIGN DOCUMENTS & DRAWINGS FOR ADDITIONAL INFORMATION.
- ELECTRICAL CONTRACTOR TO PROVIDE THERMOSTATS NOT SUPPLIED BY MECHANICAL CONTRACTOR. CONSULT MECHANICAL PLANS FOR ADDITIONAL INFORMATION.
- ELECTRICAL CONTRACTOR SHALL PROVIDE INSTALLATION AND FINAL CONNECTION OF THERMOSTATS. CONSULT MECHANICAL CONTRACTOR FOR EXACT REQUIREMENTS PRIOR TO ROUGH IN.
- PROVIDE ROUGH IN, FOR WIFI SYSTEM, FIRE ALARM DEVICES, TELECOM DEVICES, SECURITY AND AUDIO SYSTEMS AS REQUIRED. REFER TO 'T' SERIES SHEETS FOR ADDITIONAL INFORMATION.

KITCHEN EQUIPMENT KEY:

FOR ADDITIONAL INFORMATION, REFER TO THE INTERIOR DESIGNER'S PLAN SET.


- UNDER COUNTER REFRIGERATOR, PNL CH, CKT 28
- MICROWAVE OVEN, PNL CH, CKT 30
- UNDER COUNTER REFRIGERATOR, PNL CH, CKT 12
- UNDER COUNTER ICE MAKER, PNL CH, CKT 14
- KEGERATOR, PNL CH, CKT 8
- WARMING DRAWER, PNL CH, CKT 16
- MICROWAVE OVEN, PNL CH, CKT 18
- FIREPLACE INSERT, PNL CH, CKT 20
- FLAT SCREEN DISPLAY, PNL CH, CKT 6
- COFFEE MAKER, PNL CH, CKT 22
- PRINTER, PNL CH, CKT 4

KEYED NOTES:

- PROVIDE ONE 20A, 120V, 1P CIRCUIT FROM PANEL CH, CKT 38 FOR AUTOMATIC DOOR OPENERS.
- PROVIDE ONE 20A, 120V, 1P CIRCUIT FOR DRINKING FOUNTAIN FROM PANEL CH, CKT 24. CONSULT MECHANICAL AND/OR PLUMBING CONTRACTOR FOR EXACT ELECTRICAL REQUIREMENTS PRIOR TO ROUGH IN.
- PROVIDE RECEPTACLE WITH TYPES A & C USB PORTS, LEVITON T5633-T OR APPROVED EQUAL.
- CONSULT ARCHITECT AND/OR MECHANICAL PLANS FOR ADDITIONAL INFORMATION REGARDING THE FIREPLACE. PROVIDE ELECTRICAL CONNECTION(S) AS NEEDED FROM PANEL CH, CKT 20. PROVIDE 120V TWIST TIMER SWITCH (MAX. 60 MINUTES, "NO HOLD") FOR FIREPLACE IGNITER CONTROLS. INTERCONNECT WITH POWER VENT LOCATED ON ROOF. SEE DETAIL 4/E1.12 FOR EMERGENCY SHUT-OFF DIAGRAM.
- NOT USED.
- PROVIDE ONE 20A, 120V, 1P CIRCUIT FROM PANEL CH, CKT 36 FOR LANDSCAPE EQUIPMENT.
- PROVIDE ONE 20A, 120V, 1P CIRCUIT TO A WEATHER PROOF J-BOX IN THE GRILL CABINET, TIED INTO CIRCUIT CH-15, FOR GRILL LIGHT CONNECTION. COORDINATE LOCATION WITH THE LANDSCAPE DESIGNER PRIOR TO ROUGH IN.
- PROVIDE ONE 120V TWIST TIMER SWITCH (MAX. 60 MINUTES, "NO HOLD") IN WEATHER PROOF BOX AT EACH GAS GRILL FOR IGNITER CONTROLS. CIRCUIT FROM PANEL 'CH2'. SEE DETAIL 4/E1.12 FOR EMERGENCY SHUT-OFF DIAGRAM.
- PROVIDE EMERGENCY SHUTOFF CONTROLS FOR GAS APPLIANCES LOCATED ON TERRACE. COORDINATE INSTALLATION WITH MECHANICAL CONTRACTOR. CIRCUIT FROM PANEL 'CH2'. SEE DETAIL 4/E1.12 FOR EMERGENCY SHUT-OFF DIAGRAM. PROVIDE WEATHER PROOF LABEL EACH BUTTON WITH DEVICE IT CONTROLS.
- MOUNT WEATHER PROOF GFCI RECEPTACLE NEAR THE BOTTOM SIDE OF THE PERGOLA FOR OWNER INSTALLED STRING LIGHTS.
- PROVIDE ONE 20A, 120V, 1P CIRCUIT FROM PANEL CH, FOR ACCESS CONTROL. REFER TO THE TELECOM PLANS FOR ADDITIONAL INFORMATION & COORDINATE INSTALLATION.
- PROVIDE ONE 1" PVC CONDUIT WITH PULL STRING ROUTED UNDERGROUND FROM THE CLUBHOUSE TO THE POOL MACHINE HOUSE FOR BRANCH PANEL AND DISCONNECT SWITCH TO BE INSTALLED IN COORDINATION WITH THE POOL CONSTRUCTION. CONSULT POOL CONTRACTOR PRIOR TO THE START OF ANY WORK.
- AS PART OF THE POOL HOUSE CONSTRUCTION, THE ELECTRICAL CONTRACTOR SHALL PROVIDE ONE WEATHER PROOF 60A, 208V, 1P DISCONNECT SWITCH AT THE BUILDING EXTERIOR, WITH CONDUCTORS PULLED FROM THE CLUBHOUSE PANEL VIA THE CONDUIT NOTED IN KEY NOTE #12. THE ELECTRICAL CONTRACTOR SHALL INSTALL A 60A, 208V, 1P BRANCH PANEL INSIDE THE POOL EQUIPMENT BUILDING. REFER TO SHEET E1.11 FOR ADDITIONAL INFORMATION.

A.) COORDINATE WITH POOL INSTALLER TO PROVIDE & INSTALL ONE 50A, 208V, 1P CIRCUIT FROM BRANCH PANEL LOCATED IN THE POOL HOUSE AND PROVIDE ONE 50A, 220V RECEPTACLE (PER MANUFACTURER'S REQUIREMENTS) FOR PUMP MOTOR.

B.) COORDINATE WITH POOL INSTALLER TO PROVIDE & INSTALL ONE 20A, 120V, 1P CIRCUIT AND ASSOCIATED DEVICE(S) FROM BRANCH PANEL LOCATED IN THE POOL HOUSE FOR POOL LIGHTS.

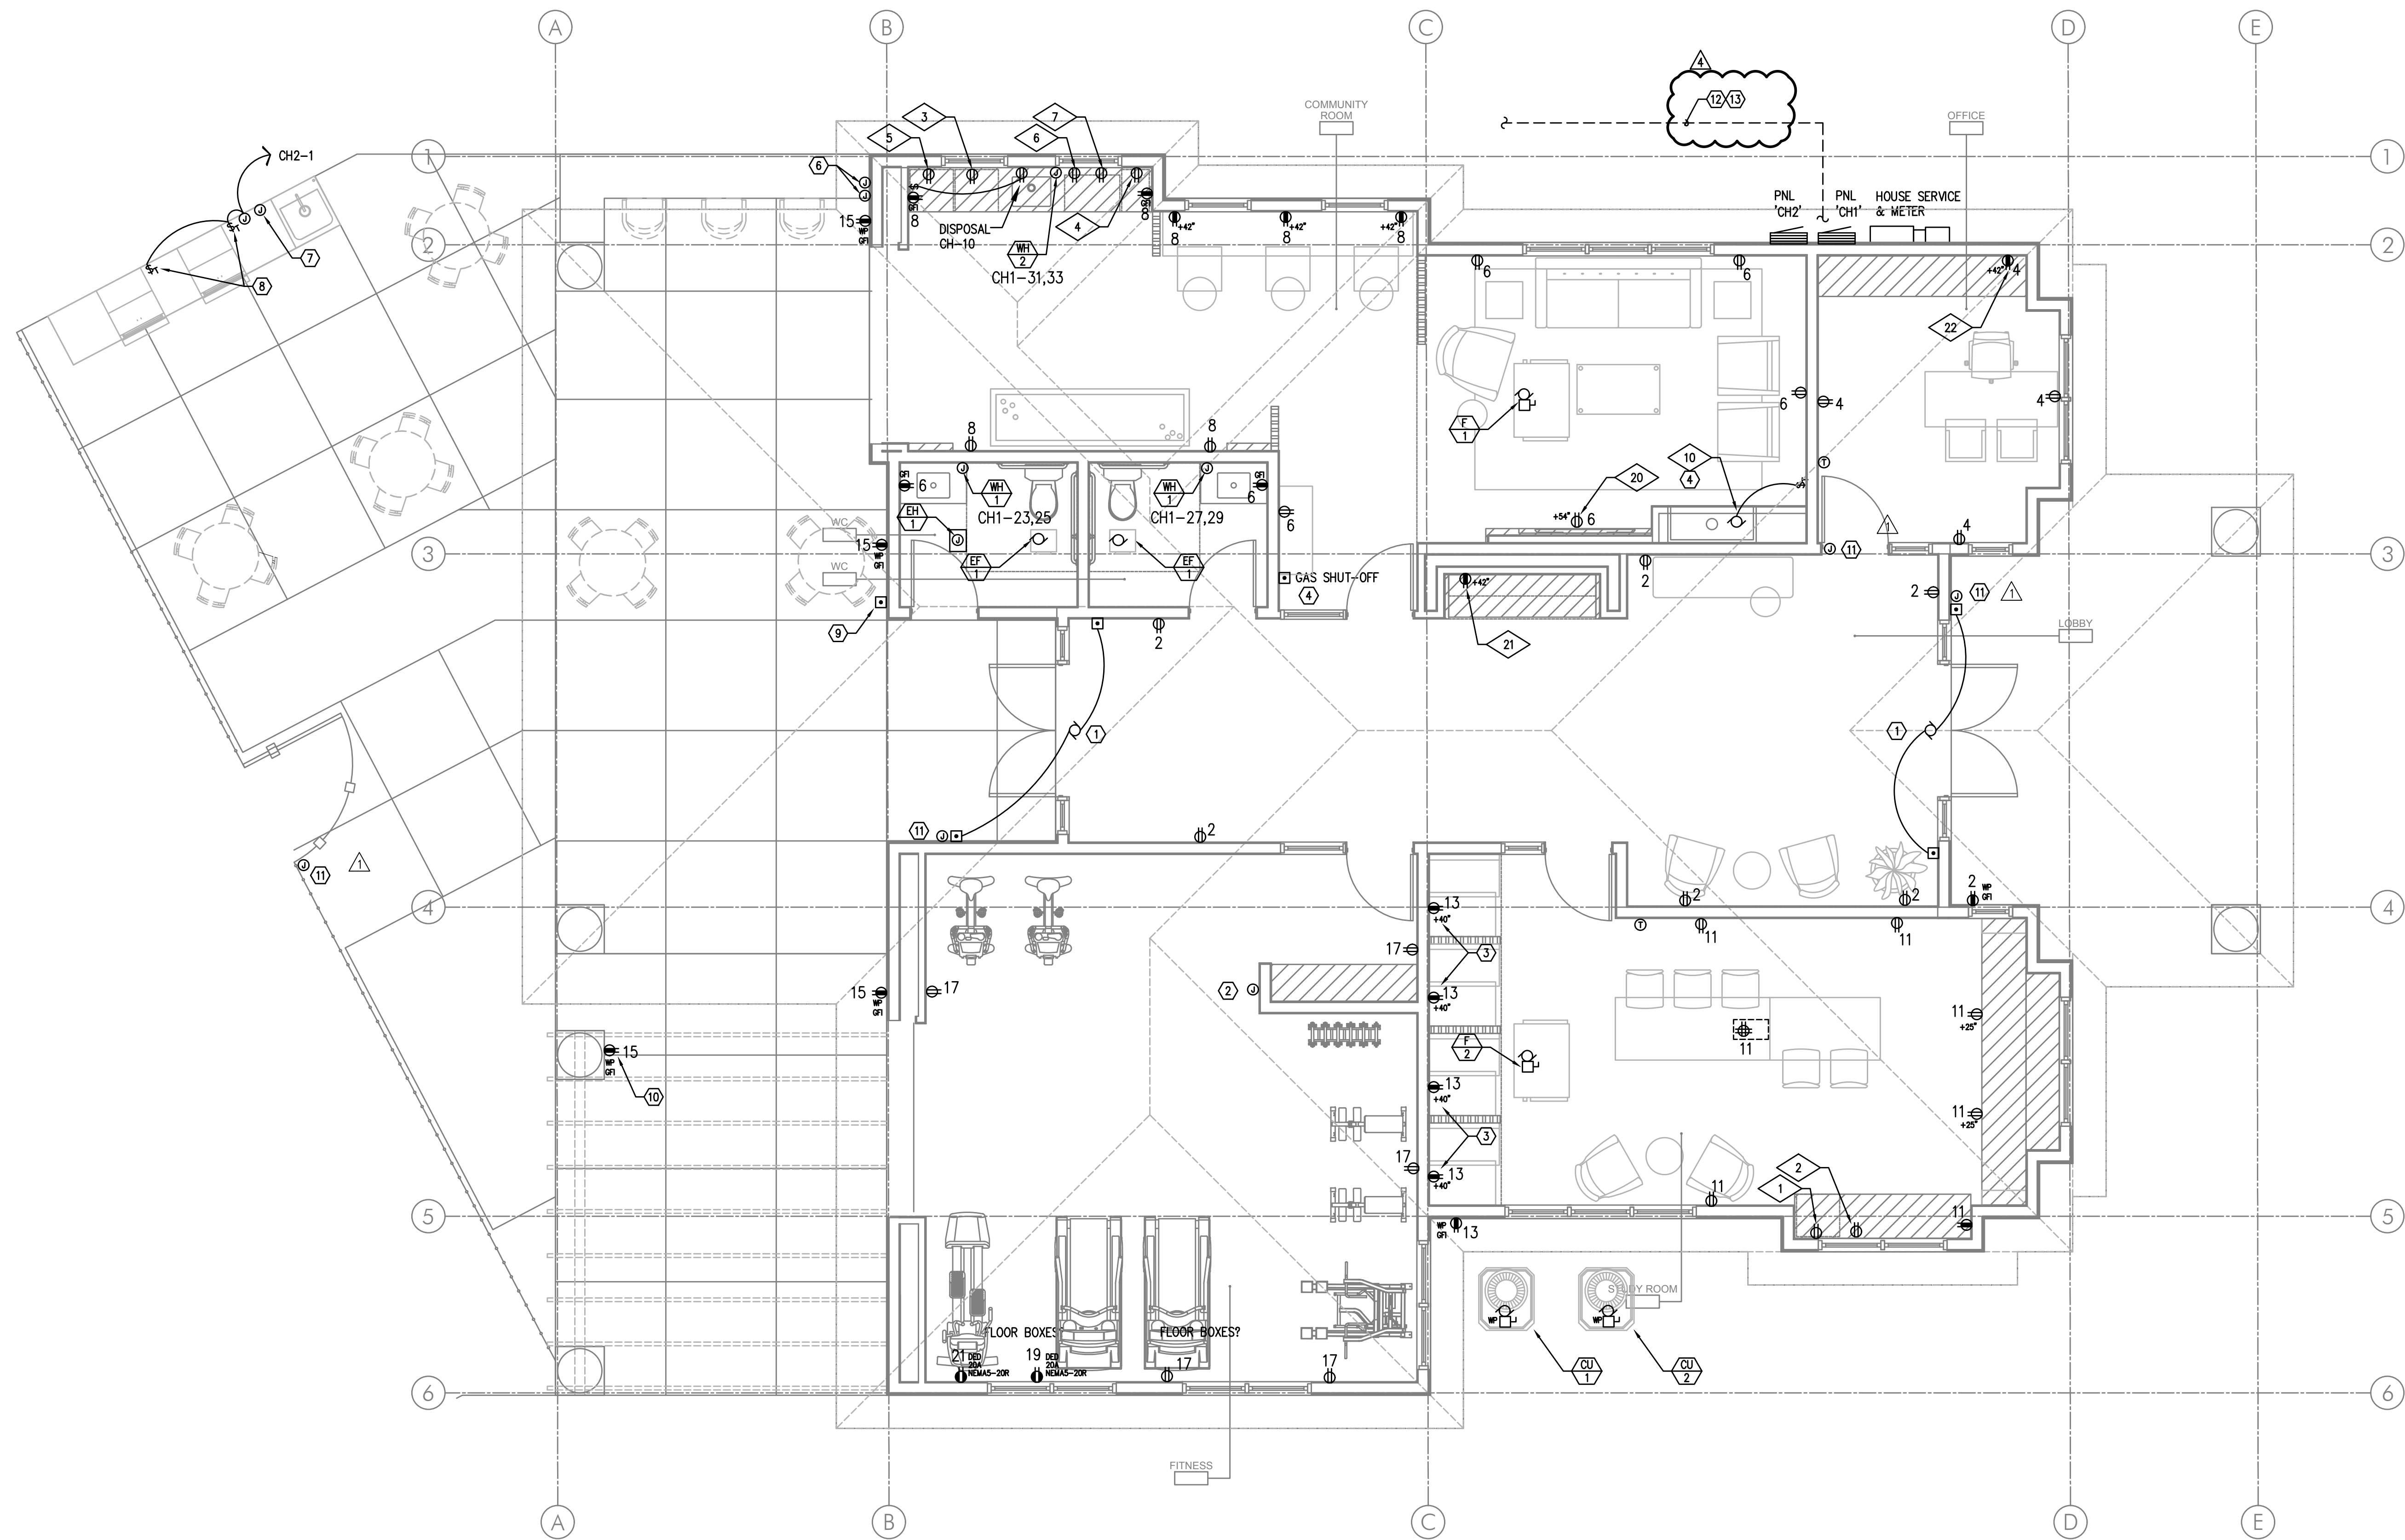


1 CLUBHOUSE POWER PLAN

SCALE: 1/4" = 1'-0"


POOL HOUSE NOTES:

- REFER TO PANEL SCHEDULE ON SHEET E1.12.
- GENERAL PURPOSE RECEPTACLES SHALL BE CIRCUITED FROM THE POOL HOUSE BRANCH PANEL.
- PROVIDE ONE 50A DEDICATED OUTLET FOR PUMP. COORDINATE LOCATION WITH THE POOL CONTRACTOR.
- PROVIDE ONE 1" PVC CONDUIT, EMPTY WITH PULL STRING, FROM POOL HOUSE TO THE POOL FOR POOL LIGHTS TO BE INSTALLED BY THE POOL CONTRACTOR.

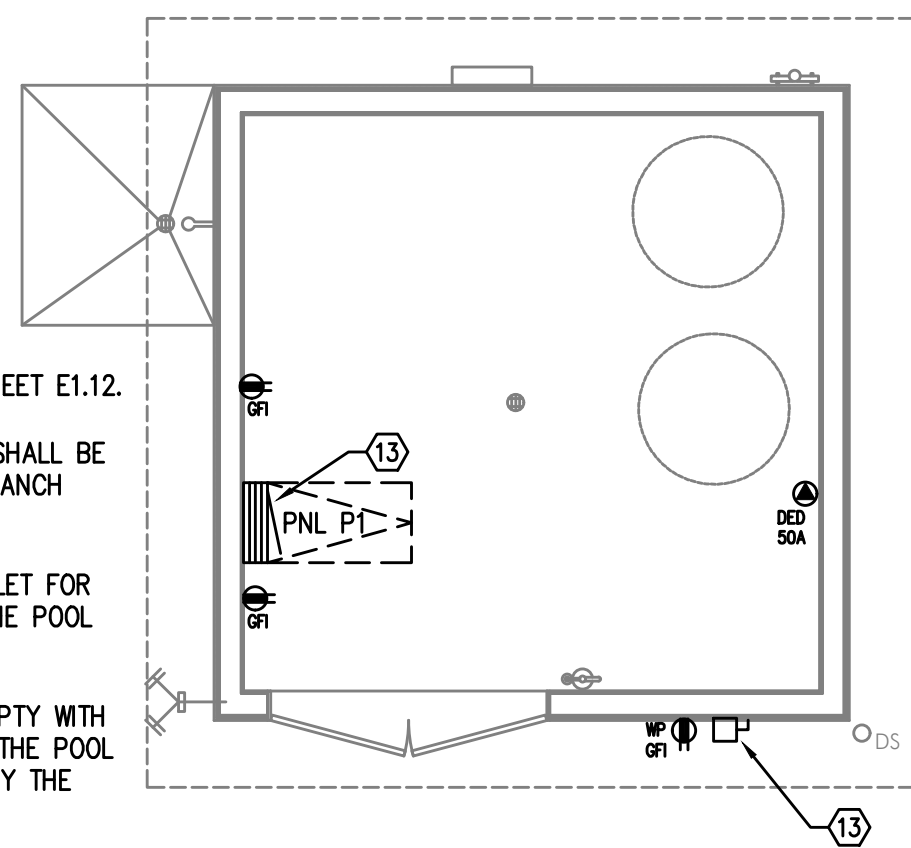

2 POOL HOUSE POWER PLAN

SCALE: 1/4" = 1'-0"

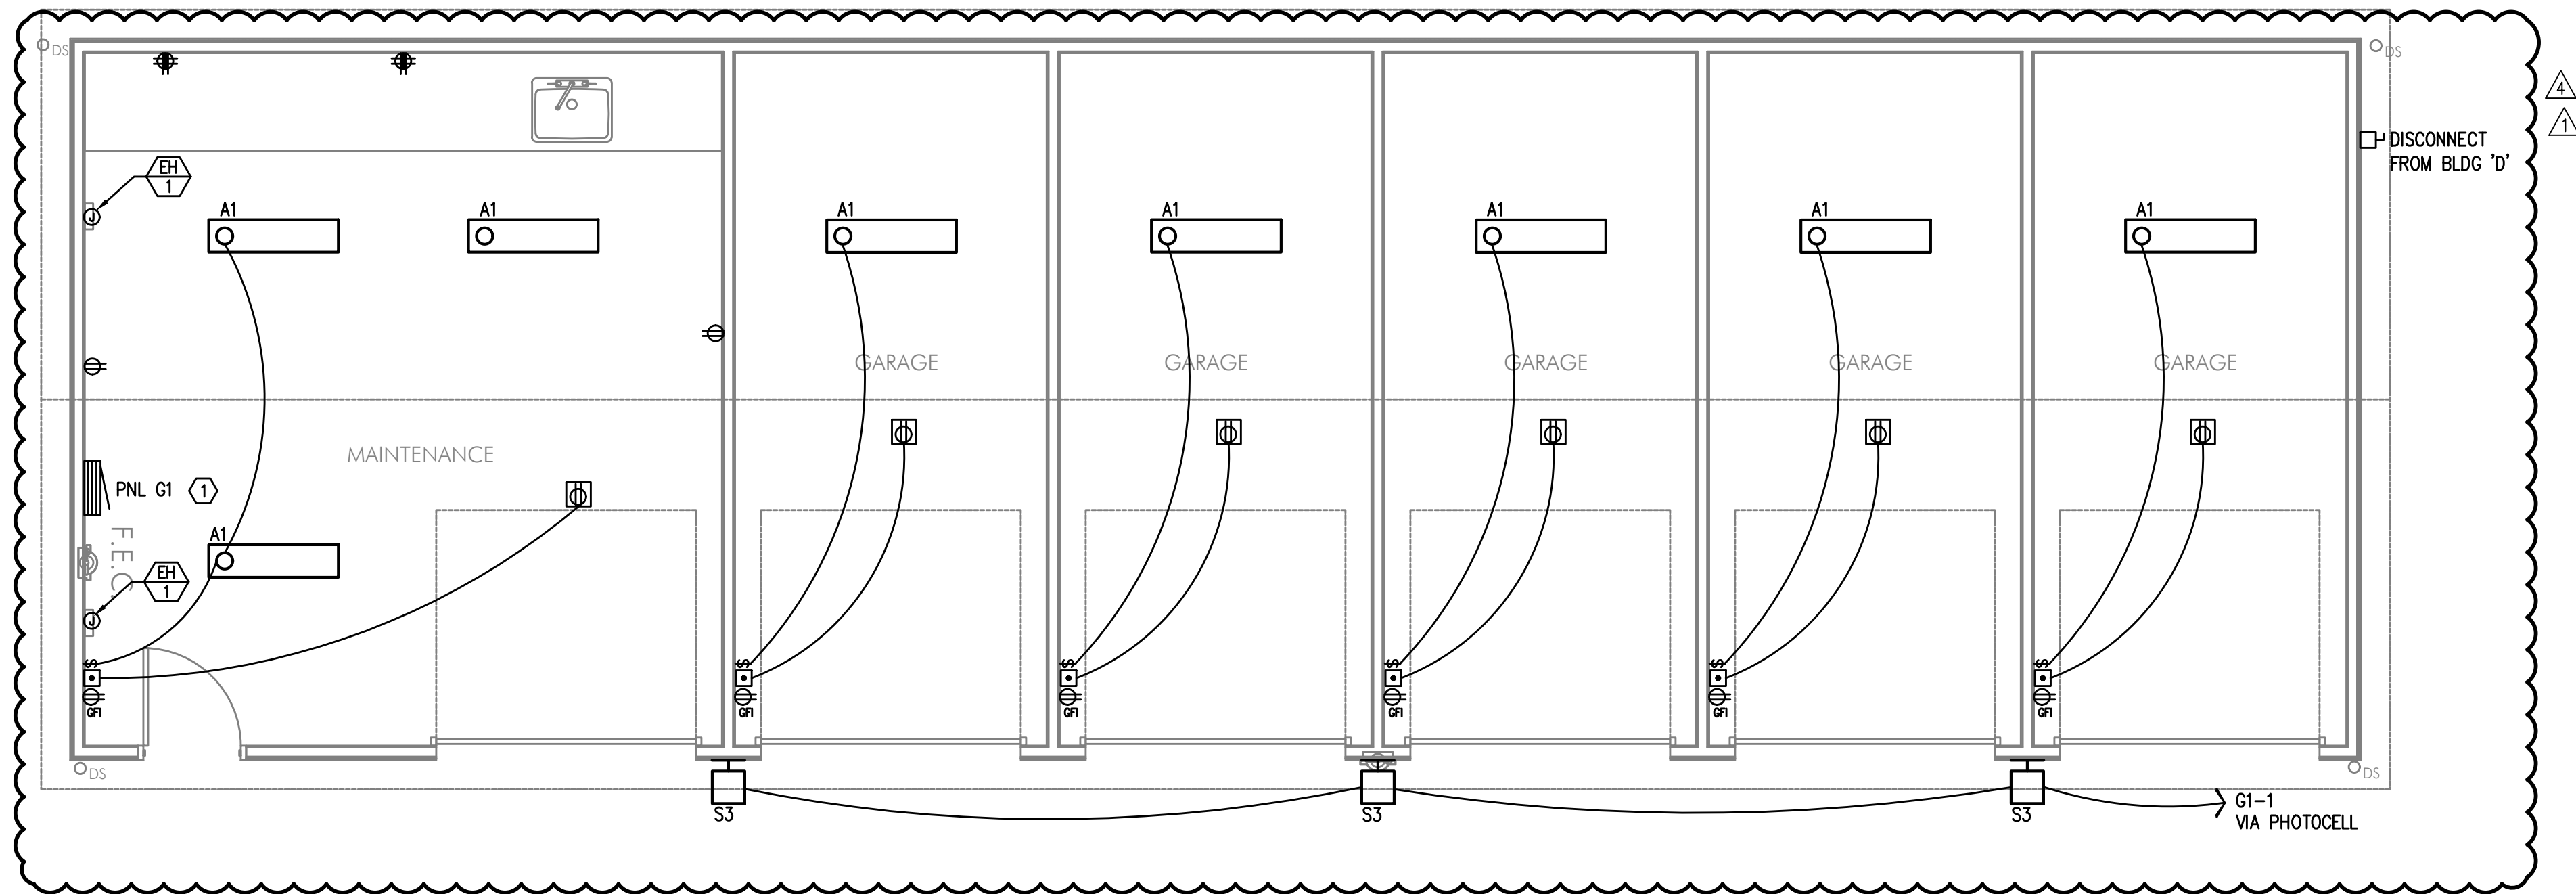


1
E6.01
TYPICAL GARAGE ELECTRICAL PLAN
SCALE: 1/4" = 1'-0"

GENERAL POWER NOTES:

- ELECTRICAL DRAWINGS ARE DIAGRAMMATICAL AND MAY NOT ACCURATELY REFLECT ACTUAL CONSTRUCTION CONDITIONS. THE ELECTRICAL CONTRACTOR SHALL BE RESPONSIBLE FOR COORDINATING THE INSTALLATION OF ALL ELECTRICAL EQUIPMENT, WITH ALL TRADES PRIOR TO AND DURING CONSTRUCTION.
- THE ELECTRICAL CONTRACTOR SHALL REFER TO THE ARCHITECTURAL AND/OR INTERIOR DESIGNER DRAWINGS FOR ALL MOUNTING HEIGHTS AND FINISHES OF DEVICES AND FIXTURES.
- REFER TO SHEET E1.11 FOR ELECTRICAL ONE-LINE DIAGRAM.
- THE CONTRACTOR SHALL CONSULT THE ARCHITECT AND/OR INTERIOR DESIGNER FOR THE EXACT LOCATION OF ALL AMENITY EQUIPMENT & APPLIANCES PRIOR TO THE START OF ANY ROUGH IN WORK.
- REFER TO AVAILABLE ARCHITECTURAL AND/OR INTERIOR DESIGN DOCUMENTS & DRAWINGS FOR ADDITIONAL INFORMATION.
- ELECTRICAL CONTRACTOR TO PROVIDE THERMOSTATS NOT SUPPLIED BY MECHANICAL CONTRACTOR. CONSULT MECHANICAL PLANS FOR ADDITIONAL INFORMATION.
- ELECTRICAL CONTRACTOR SHALL PROVIDE INSTALLATION AND FINAL CONNECTION OF THERMOSTATS. CONSULT MECHANICAL CONTRACTOR FOR EXACT REQUIREMENTS PRIOR TO ROUGH IN.
- ELECTRICAL CONTRACTOR SHALL COORDINATE WITH THE LOW VOLTAGE ("T" SERIES) PLANS, INCLUDING FIRE ALARM AND SYSTEMS INSTALLER, AND PROVIDE ROUGH IN AS NEEDED.

KEYED NOTES:

- EXTERIOR GARAGE PANELS ARE TO BE NEMA 3R WITH LOCKING COVER. GARAGES ARE FED FROM THE HOUSE PANEL AT BUILDING 'D'. PROVIDE xxa WEATHER PROOF DISCONNECT AHEAD OF THE PANEL AS SHOWN.

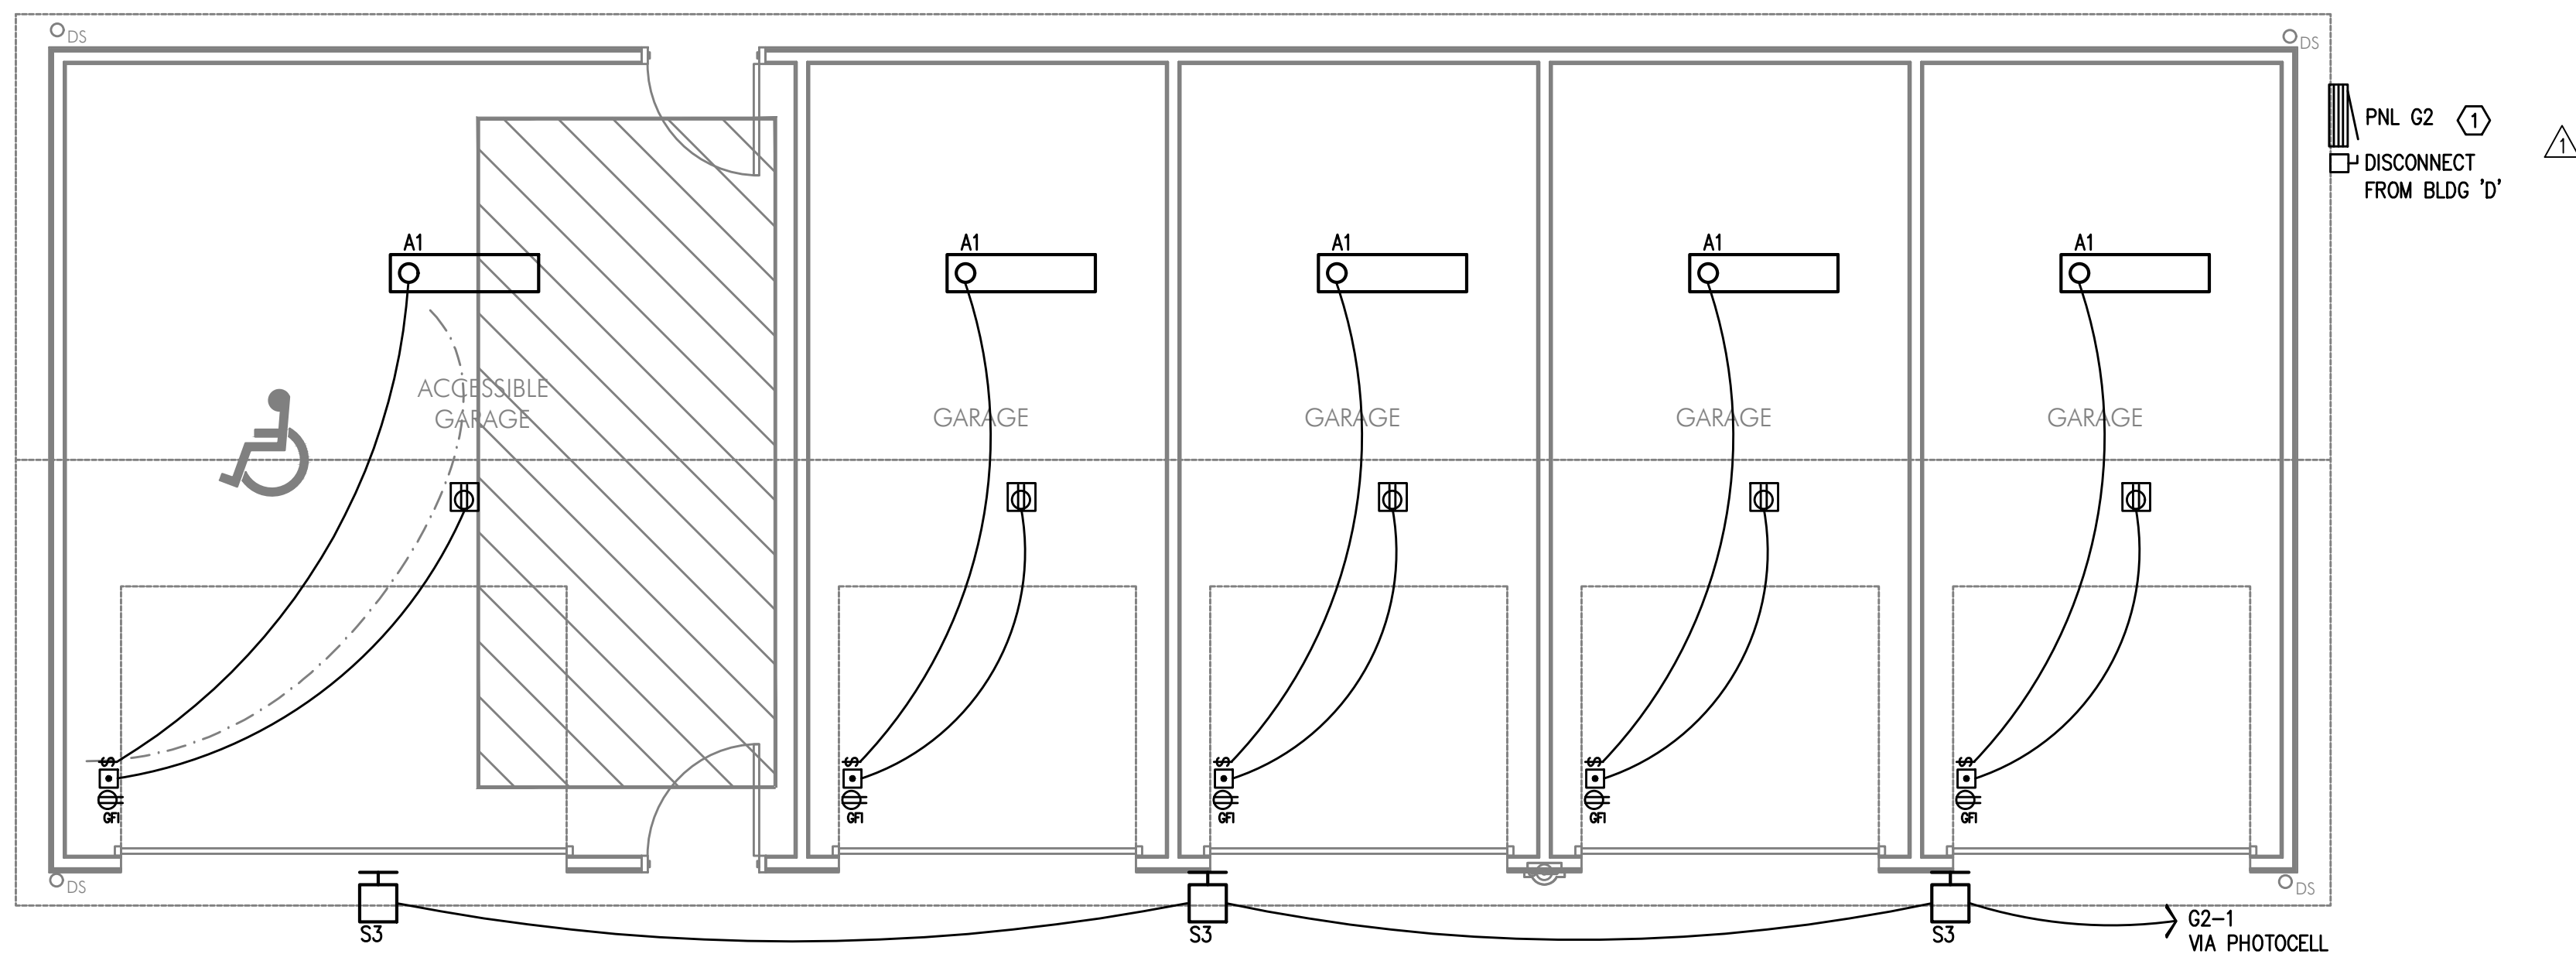

2
E6.01
TYPICAL ADA GARAGE ELECTRICAL PLAN
SCALE: 1/4" = 1'-0"