




TYPICAL UNIT TYPE E

E402 SCALE:1/4" = 1'-0"

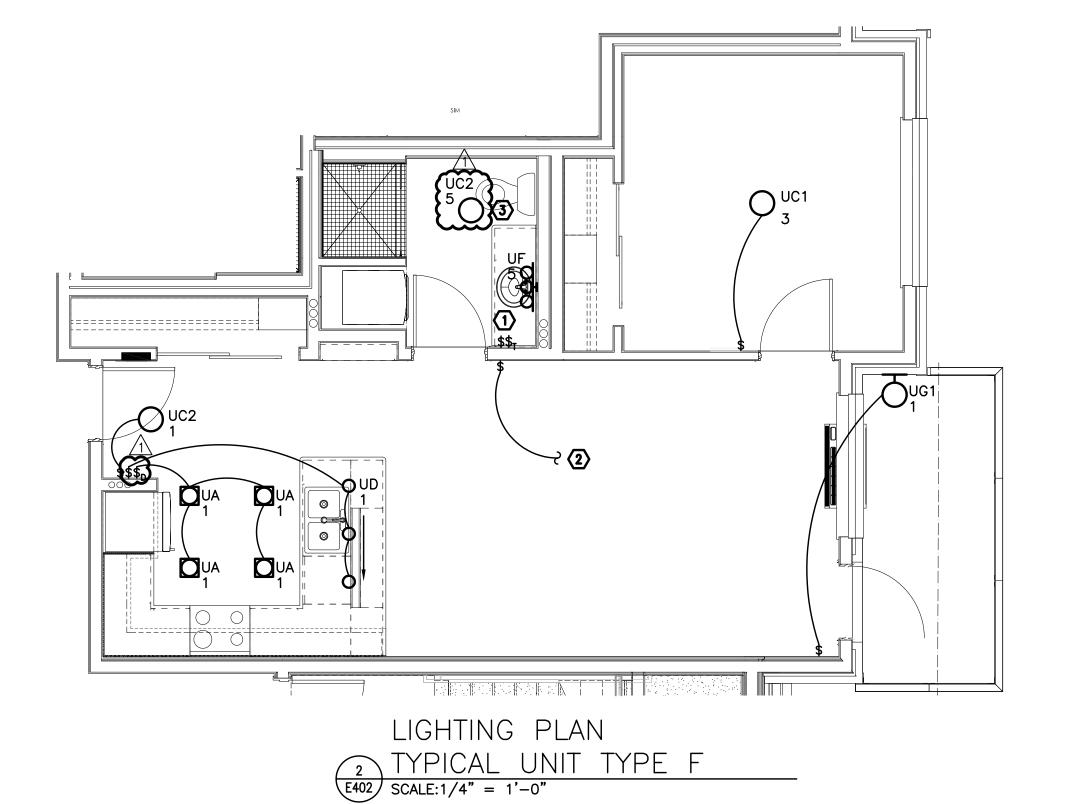

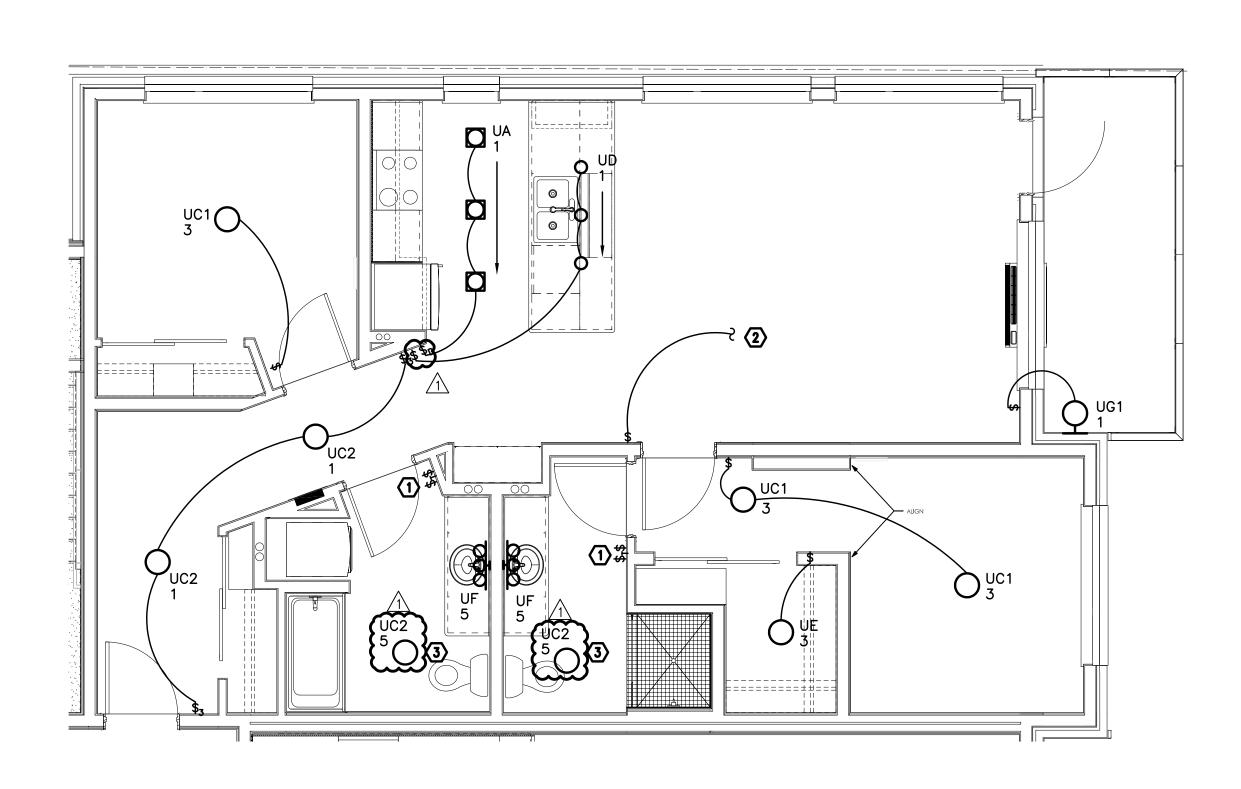

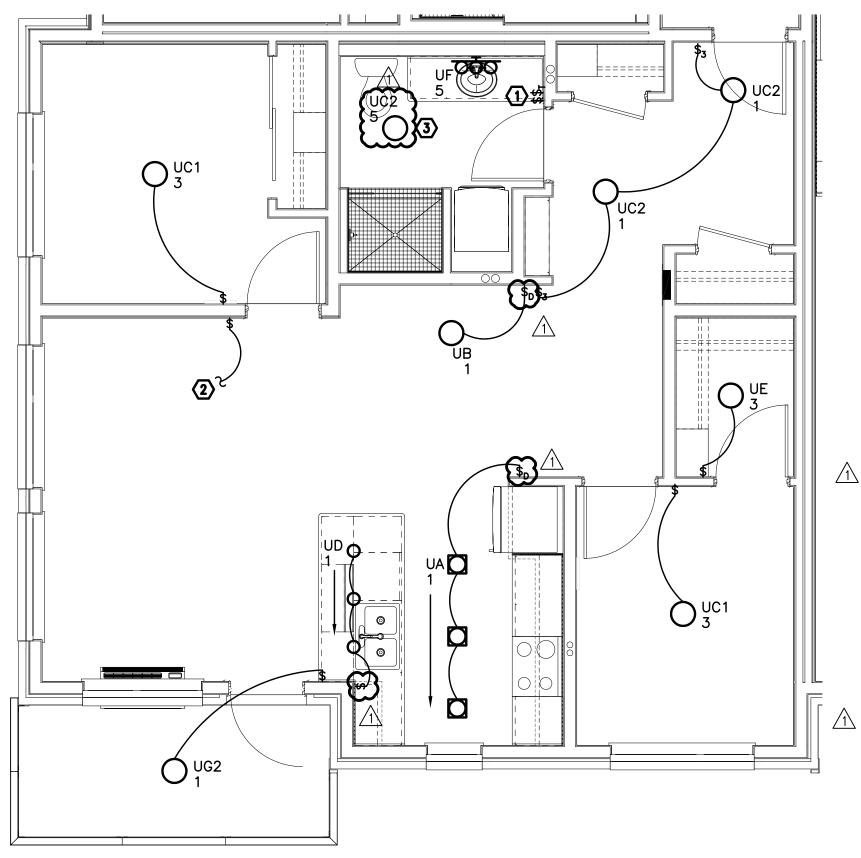

KEYED NOTES (APARTMENT UNITS):

GENERAL NOTES (APARTMENT UNITS):

B. REFER TO SHEET E1.14 FOR TYPICAL UNIT LOAD CENTER

A. ALL PLANS ARE DIAGRAMMATICAL. CONSULT ARCHITECTURAL PLANS FOR EXACT LOCATION OF ALL DEVICES AND FIXTURES.

C. ALL LIGHT SWITCHES SHALL BE ROCKER STYLE, SUCH AS LEVITON DECORA, OR APPROVED EQUAL.

REFER TO TYPICAL BATHROOM SWITCHING DETAILS ON SHEET E1.22.

SWITCHED RECEPTACLE. REFER TO SHEETS E4.11 THRU E4.13 FOR RECEPTACLE LOCATION.

PROVIDE CEILING MOUNTED LIGHT FIXTURE AS INDICATED IN BATHROOMS. FOR BATHROOMS ON EXTERIOR WALLS, PROVIDE FIXTURE TYPE "UH" IN LIEU OF TYPE "UC2".

LIGHTING PLAN

TYPICAL UNIT TYPE G

E402 SCALE: 1/4" = 1'-0"

LIGHTING PLAN

TYPICAL UNIT TYPE H

E402 SCALE:1/4" = 1'-0"

Consulting Engineers 2007 S.E. Ash St.
Portland, OR 97214
PHN: (503) 234-0548
FAX: (503) 234-0677
INC. WWW.MFIA-ENG.COM
CONTACT: DENISE TAYLOR

STUDIO

ARCHITECTURE INCORPORATED

222 COMMERCIAL ST. NE SALEM, OR 97301-3410 P: 503.390.6500 www.studio3architecture.com



IN THE EVENT CONFLICTS ARE DISCOVERED BETWEEN THE ORIGINAL SIGNED AND SEALED DOCUMENTS PREPARED BY THE ARCHITECTS AND/OR THEIR CONSULTANTS, AND ANY COPY OF THE DOCUMENTS TRANSMITTED BY MAIL, FAX, ELECTRONICALLY OR OTHERWISE, THE ORIGINAL SIGNED AND SEALED DOCUMENTS SHALL GOVERN.

PROJECT # 2014-75
DATE: 10-08-2015

VISIONIS

02.05.16 PLAN REVIEW

COUVER AVE PHASE IIIDING BOOK OF THE BOULDING

SHEET:

E4.02