


LIGHTING PLAN

TYPICAL UNIT TYPE K

E403 SCALE: 1/4" = 1'-0"

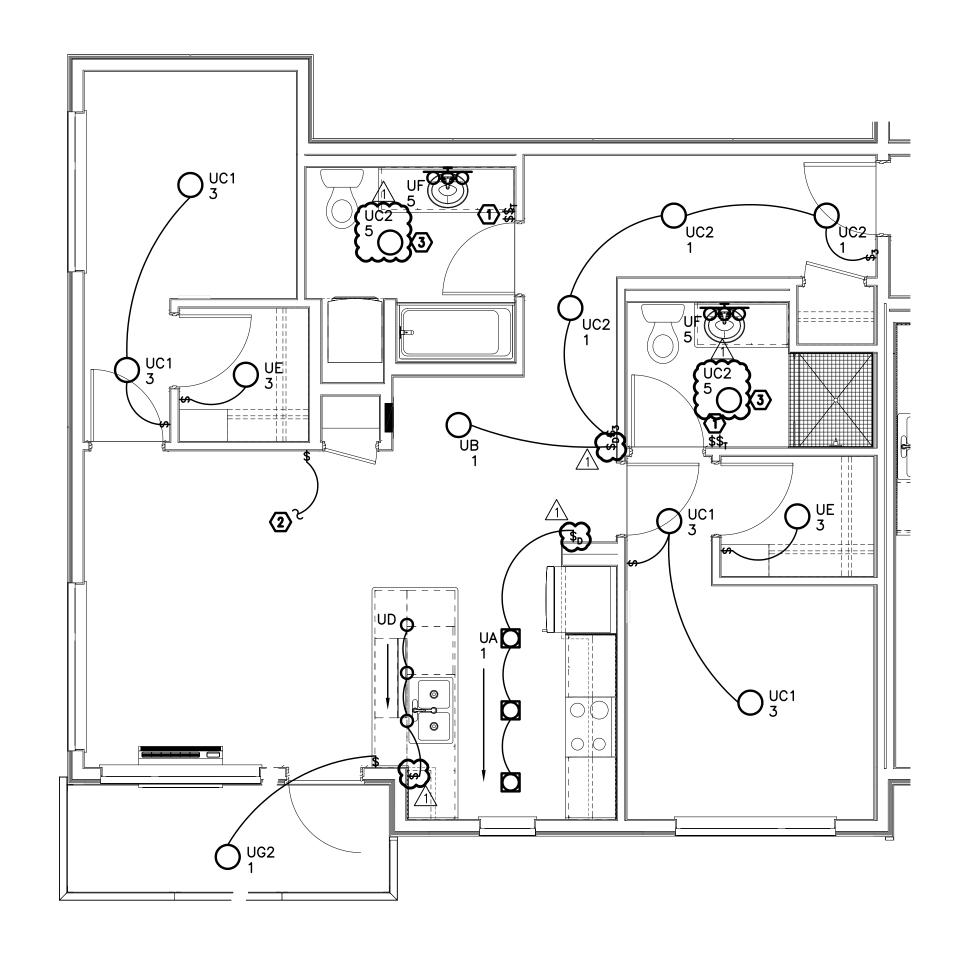

LIGHTING PLAN

TYPICAL UNIT TYPE J

E403 SCALE:1/4" = 1'-0"

(APARTMENT UNITS):

- A. ALL PLANS ARE DIAGRAMMATICAL. CONSULT ARCHITECTURAL PLANS FOR EXACT LOCATION OF ALL DEVICES AND FIXTURES.
- B. REFER TO SHEET E1.14 FOR TYPICAL UNIT LOAD CENTER DIRECTORIES.
- C. ALL LIGHT SWITCHES SHALL BE ROCKER STYLE, SUCH AS LEVITON DECORA, OR APPROVED EQUAL.


KEYED NOTES (APARTMENT UNITS):

- 2 SWITCHED RECEPTACLE. REFER TO SHEETS E4.11 THRU E4.13 FOR RECEPTACLE LOCATION.
- PROVIDE CEILING MOUNTED LIGHT FIXTURE AS INDICATED IN BATHROOMS. FOR BATHROOMS ON EXTERIOR WALLS, PROVIDE FIXTURE TYPE "UH" IN LIEU OF TYPE "UC2".

Consulting Engineers 2007 S.E. Ash St. Portland, OR 97214 PHN: (503) 234-0548 FAX: (503) 234-0677 INC. WWW.MFIA-ENG.COM

ARCHITECTURE INCORPORATED

222 COMMERCIAL ST. NE SALEM, OR 97301-3410 P: 503.390.6500 www.studio3architecture.com

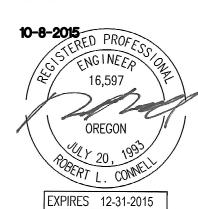

IN THE EVENT CONFLICTS ARE DISCOVER BETWEEN THE ORIGINAL SIGNED AND SEAL DOCUMENTS PREPARED BY THE ARCHITEC AND/OR THEIR CONSULTANTS, AND ANY COPY ITHE DOCUMENTS TRANSMITTED BY MAIL, F, ELECTRONICALLY OR OTHERWISE, THE ORIGIN

PROJECT # DATE:

REVISIONS

10-08-2015

02.05.16 PLAN REVIEW

COUVER AVE PHASE ISOUVER AVE A VE PHASE ISOUVER AVE & N SHAVER ST, PORTLAND, OR 97227

SHEET:

E4.03