



LIGHTING PLAN TYPICAL UNIT TYPE L E404 SCALE:1/4" = 1'-0"

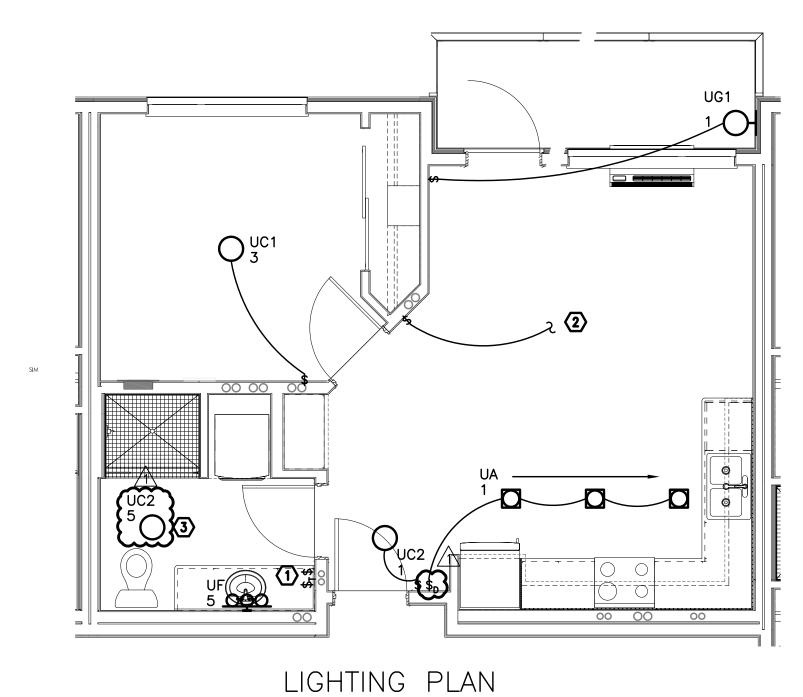

TYPICAL UNIT TYPE N

E404 SCALE:1/4" = 1'-0"

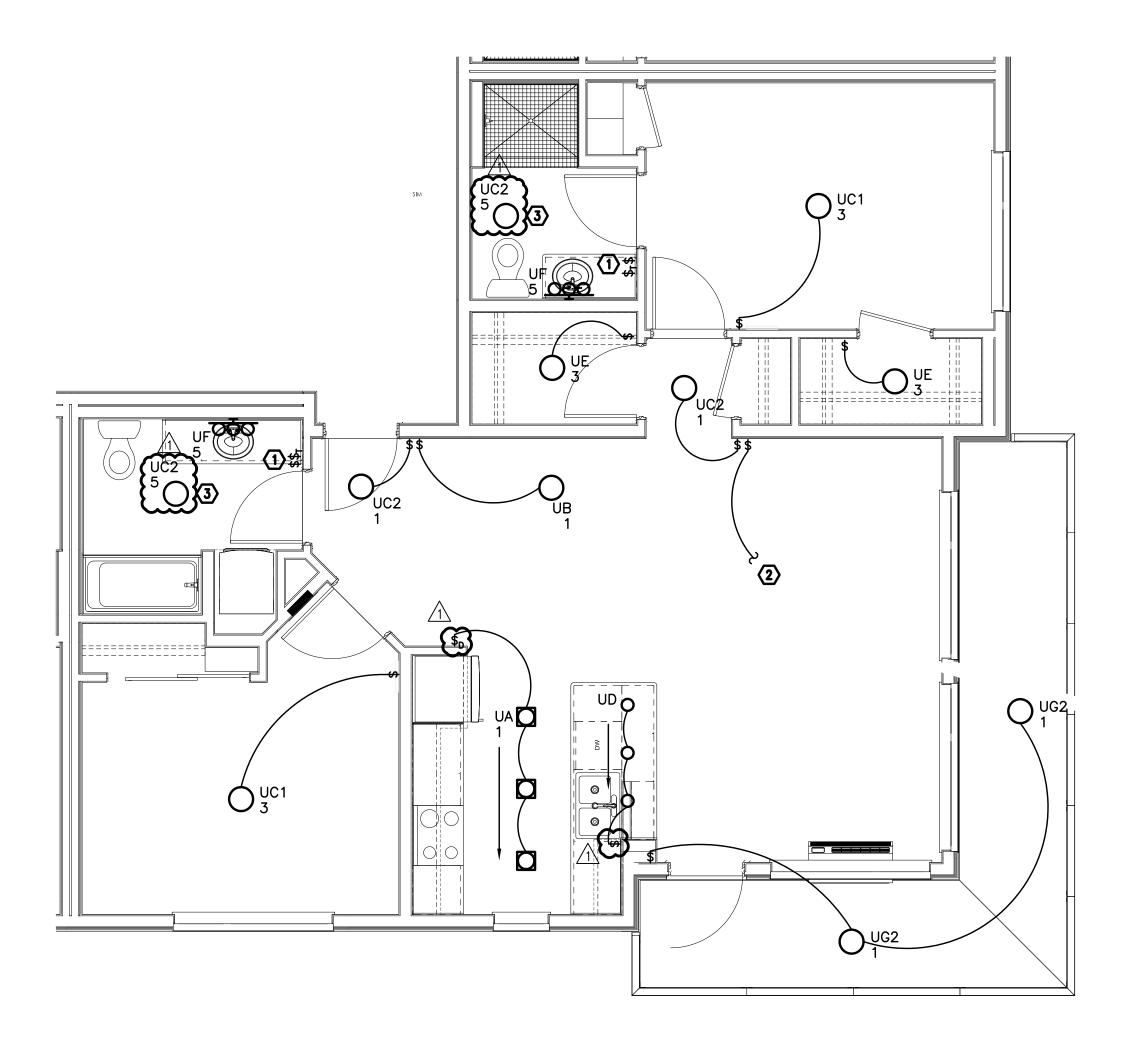

LIGHTING PLAN TYPICAL UNIT TYPE M E404 SCALE: 1/4" = 1'-0"

GENERAL NOTES (APARTMENT UNITS):

- A. ALL PLANS ARE DIAGRAMMATICAL. CONSULT ARCHITECTURAL PLANS FOR EXACT LOCATION OF ALL DEVICES AND FIXTURES.
- B. REFER TO SHEET E1.14 FOR TYPICAL UNIT LOAD CENTER DIRECTORIES.
- C. ALL LIGHT SWITCHES SHALL BE ROCKER STYLE, SUCH AS LEVITON DECORA, OR APPROVED EQUAL.

KEYED NOTES (APARTMENT UNITS):

- REFER TO TYPICAL BATHROOM SWITCHING DETAILS ON SHEET E1.22.
- SWITCHED RECEPTACLE. REFER TO SHEETS E4.11 THRU E4.13 FOR RECEPTACLE LOCATION.
- PROVIDE CEILING MOUNTED LIGHT FIXTURE AS INDICATED IN BATHROOMS. FOR BATHROOMS ON EXTERIOR WALLS, PROVIDE FIXTURE TYPE "UH" IN LIEU OF TYPE "UC2".

STUDIO ARCHITECTURE INCORPORATED

222 COMMERCIAL ST. NE SALEM, OR 97301-3410 P: 503.390.6500 www.studio3architecture.com



PROJECT # 10-08-2015

√1\ 02.05.16 PLAN REVIEW

SHEET:

Consulting Engineers 2007 S.E. Ash St. Portland, OR 97214 PHN: (503) 234-0548 FAX: (503) 234-0677 INC. WWW.MFIA-ENG.COM CONTACT: DENISE TAYLOR