

DISPOSALE 1/4" = 1'-0"

POWER PLAN


TYPICAL UNIT TYPE B

Early SCALE:1/4" = 1'-0"

POWER PLAN

TYPICAL UNIT TYPE A-ADA


E411 SCALE: 1/4" = 1'-0"

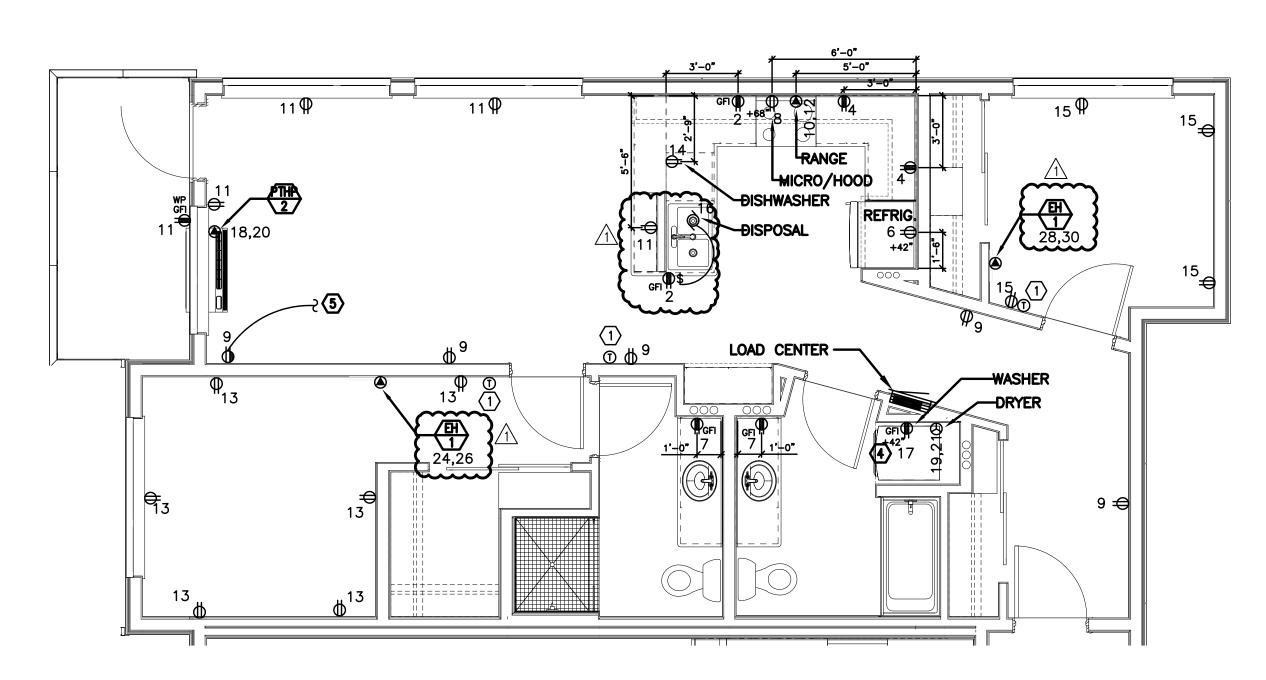

POWER PLAN

TYPICAL UNIT TYPE C

E411 SCALE:1/4" = 1'-0"

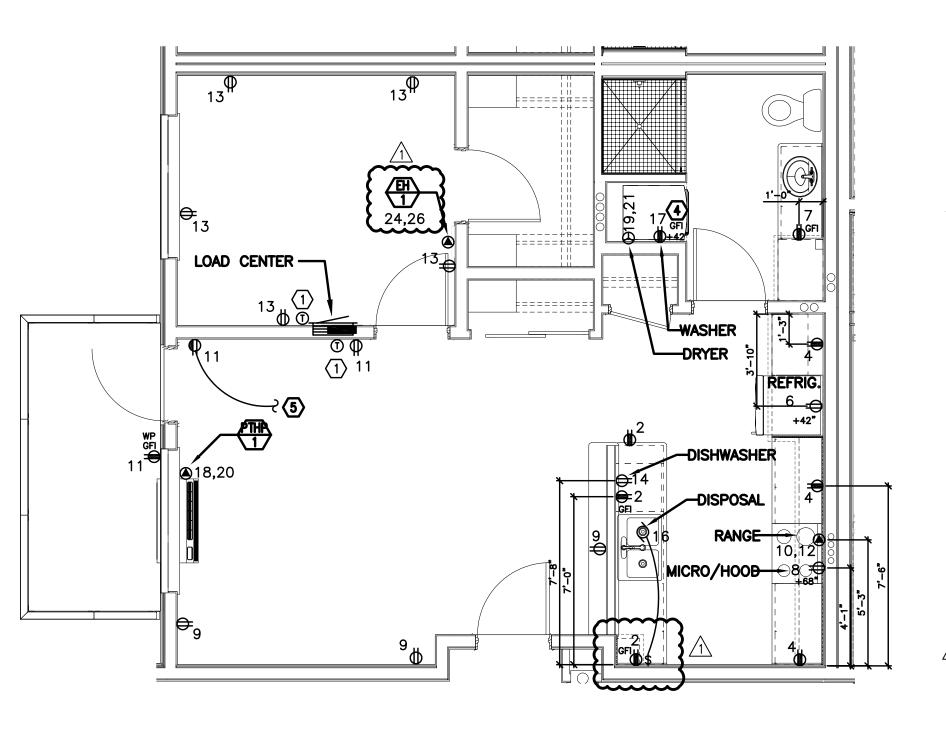

POWER PLAN

TYPICAL UNIT TYPE D

E411 SCALE: 1/4" = 1'-0"

GENERAL NOTES (APARTMENT UNITS):

A. KITCHEN RECEPTACLES LOCATED IN ISLANDS OR PENINSULAS WHERE THE BACK SPLASH WILL NOT ACCOMMODATE VERTICAL PLACEMENT OR THE DUPLEX RECEPTACLE, THE CONTRACTOR SHALL ROTATE THE DEVICE 90 DEGREES SO THAT THE RECEPTACLE IS INSTALLED HORIZONTALLY.

B. REFER TO DETAILS ON SHEET E1.22 AND G2.01 FOR ADDITIONAL INFORMATION REGARDING ADA REACH REQUIREMENTS FOR RECEPTACLE AND SWITCH MOUNTING HEIGHT.

C. STANDARD RECEPTACLE MOUNTING HEIGHT IS 18" A.F.F. UNLESS OTHERWISE SPECIFIED. RECEPTACLES LOCATED BELOW WINDOW SILLS SHALL NOT BE LESS THE 15" A.F.F.

KEYED NOTES (APARTMENT UNITS):

- PROVIDE WIRE CONNECTION FOR THERMOSTAT(S). COORDINATE WITH MECHANICAL INSTALLER FOR EXACT LOCATION AND POWER REQUIREMENTS PRIOR TO ROUGH IN.
- (2) CONTINUOUS OPERATION EXHAUST FAN TO BE CIRCUITED WITH LIGHTING AND SHALL NOT BE SWITCHED.
- REFER TO ARCHITECTURAL ELEVATIONS AND PROVIDE JUNCTION BOX AND BLANK COVER FOR FUTURE RECEPTACLE AND/OR SWITCH AT FALSE DRAWER FRONT TO MEET ADA REQUIREMENTS. CIRCUIT TO NEAREST KITCHEN APPLIANCE RECEPTACLE CIRCUIT AT EACH LOCATION.
- REFER TO DETAIL 1/E1.23 FOR TYPICAL LAUNDRY ALCOVE RECEPTACLE LOCATIONS. COORDINATE INSTALLATION WITH MECHANICAL & PLUMBING CONTRACTOR.
- SWITCHED RECEPTACLE. SEE SHEETS E4.01 THRU E4.03 FOR SWITCH LOCATION.

Consulting Engineers 2007 S.E. Ash St. Portland, OR 97214 PHN: (503) 234-0548 FAX: (503) 234-0677 INC. WWW.MFIA-ENG.COM

STUDIO 3

ARCHITECTURE
INCORPORATED

222 COMMERCIAL ST. NE
SALEM, OR 97301-3410
P: 503.390.6500
www.studio3architecture.com

10-8-2015
PROFESS
16,597
OREGON
OREGON
EXPIRES 12-31-2015

IN THE EVENT CONFLICTS ARE DISCOVERED BETWEEN THE ORIGINAL SIGNED AND SEALED DOCUMENTS PREPARED BY THE ARCHITECTS AND/OR THEIR CONSULTANTS, AND ANY COPY OF THE DOCUMENTS TRANSMITTED BY MAIL, FAX,

PROJECT # 2014-75
DATE: 10-08-2015

'ISIONS

1 02.05.16 PLAN REVIEW

UVER AVE PHASE II
USE BUILDING
ER AVE & N SHAVER ST, PORTLAND, OR 97227

SHEET:

E4.11