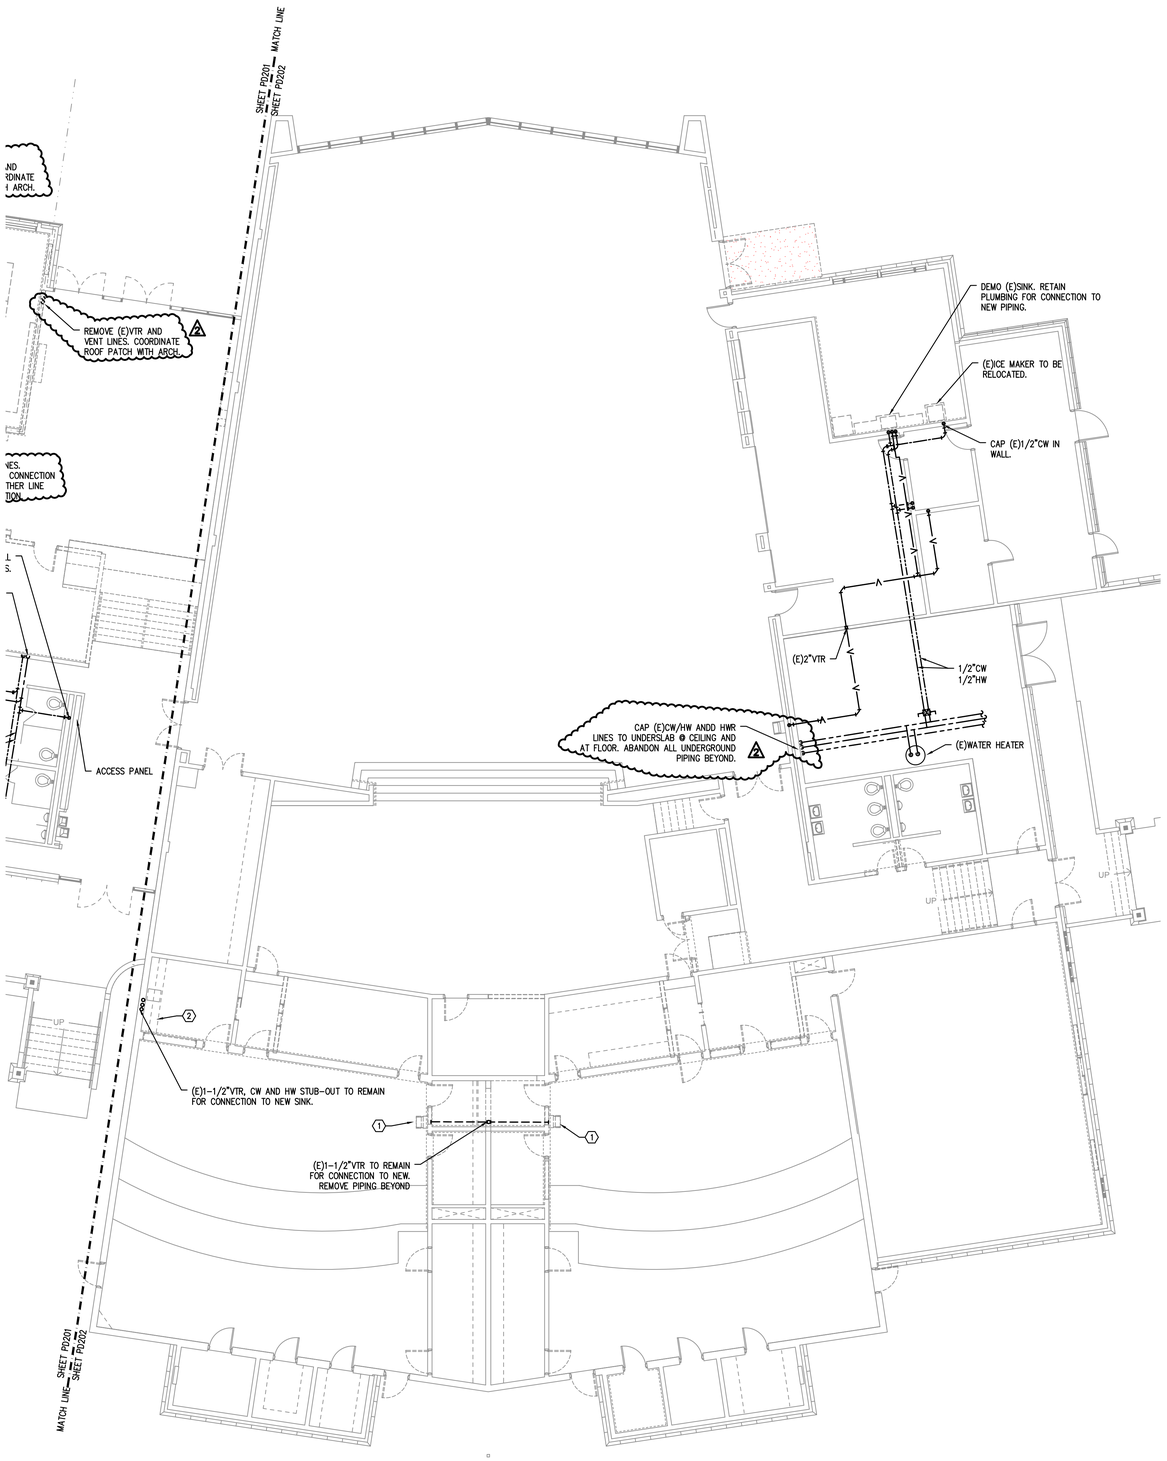

1 PD2.02 PLUMBING DEMO PLAN – BUILDING F
SCALE: 1/8"=1'-0"

1. REMOVE PLUMBING FIXTURE. DEMO CW & HW LINES AND ABANDON PIPES TO BELOW SLAB. ALL PIPING BEYOND TO BE ABANDONED IN PLACE.
2. REMOVE PLUMBING FIXTURE. DEMO CW&HW PIPE TO WALL. ALL PIPING BEYOND TO BE ABANDONED IN PLACE.

City Of Bend Approval Stamp:

#	Date	Description
3	3/15/18	PLAN REVIEW COMMENTS
2	3/13/18	ADDENDUM 1
1	2/19/18	DISTRICT REVIEW COMMENTS

Revision Schedule

PERMIT & CONSTRUCTON SET

PILOT BUTTE MIDDLE SCHOOL - BLDGS E&F
1501 NE Neff Road,
Bend OR 97701

BLRB architects

TACOMA | SPOKANE | PORTLAND | **BEND**

1250 Pacific Avenue Suite 700 Washington 98402 253.627.5599
505 W Riverside Suite 500 Washington 99201 509.252.5080
1001 SW 5th Avenue Suite 1100 Oregon 97204 503.535.6707
404 SW Columbia St Suite 120 Oregon 97702 541.330.6506

BLRB.com

Drawing Title:

PLUMBINGL DEMO PLAN
BUILDING F

Date : 02.19.2018	Drawn By : TB
Revised Date :	Project No. 17.34B

Stamp

REGISTERED PROFESSIONAL ENGINEER
17887
JULY 25, 1995
SCOTT W. MILLER
EXPIRES: 31DEC18

Sheet No.

PD2.02

MFIA Consulting Engineers
2007 S.E. Ash St.
Portland, OR 97214
PHN: (503) 234-0548
FAX: (503) 234-0677
INC. WWW.MFIA-ENG.COM
CONTACT: TAKAKO BAKER