COPYRIGHT © BBT ARCHITECTS

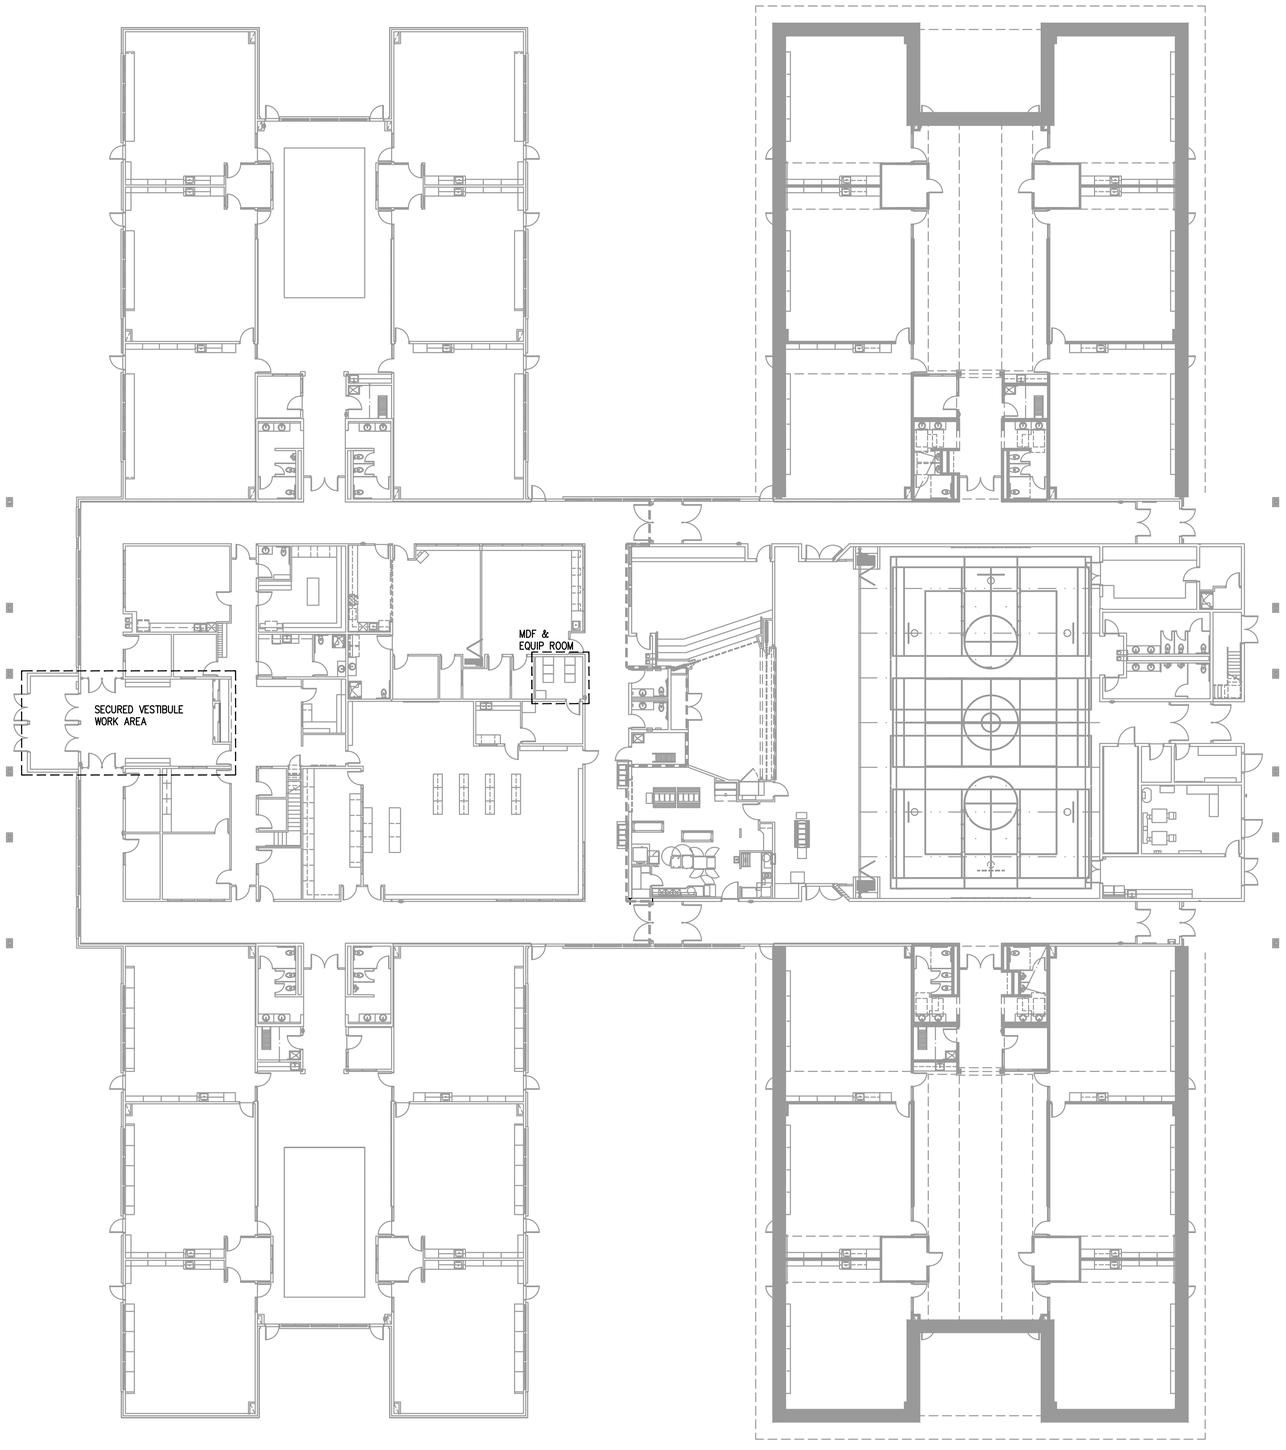

1 / T1.1 OVERALL FLOOR PLAN – TELCOM
SCALE: 1/16" = 1'-0"

RECORD DRAWING:

THIS DRAWING HAS BEEN UPDATED TO REFLECT CHANGES MADE DURING CONSTRUCTION BASED UPON INFORMATION FURNISHED TO THE ENGINEER BY THE INSTALLATION CONTRACTOR. NO WARRANTY EITHER EXPLICIT OR IMPLIED IS GIVEN BY MFIA, INC. AS TO THE ACCURACY AND/OR COMPLETENESS OF THIS INFORMATION.

BBT ARCHITECTS
1160 nw Simpson Ave. - Suite 100 - Bend, Oregon 97702
t 541.382.5535 | f 541.389.8033

Bend-La Pine Schools SECURITY UPGRADES
High Lakes Elementary School
2500 NW High Lakes Loop
Bend, Oregon 97703

ISSUED:	DATE:
PERMIT SET / BID SET	02/14/18
CONFORMANCE SET	03/28/18
APR-11	06/08/18
AS-BUILT	09/04/18

JOB NUMBER:	
DRAWN BY:	GMA
CHECKED BY:	RLC

SHEET TITLE
OVERALL
FLOOR PLAN
TELCOM

SHEET NUMBER
T1.1

G:\Bonfire Stored Turner Arch\1X74_Bend-LaPine SD secure vestibule remodels\1stConfs\Record\1X74_HL_A1.11.dwg Dec 17 2018 - 2:01pm